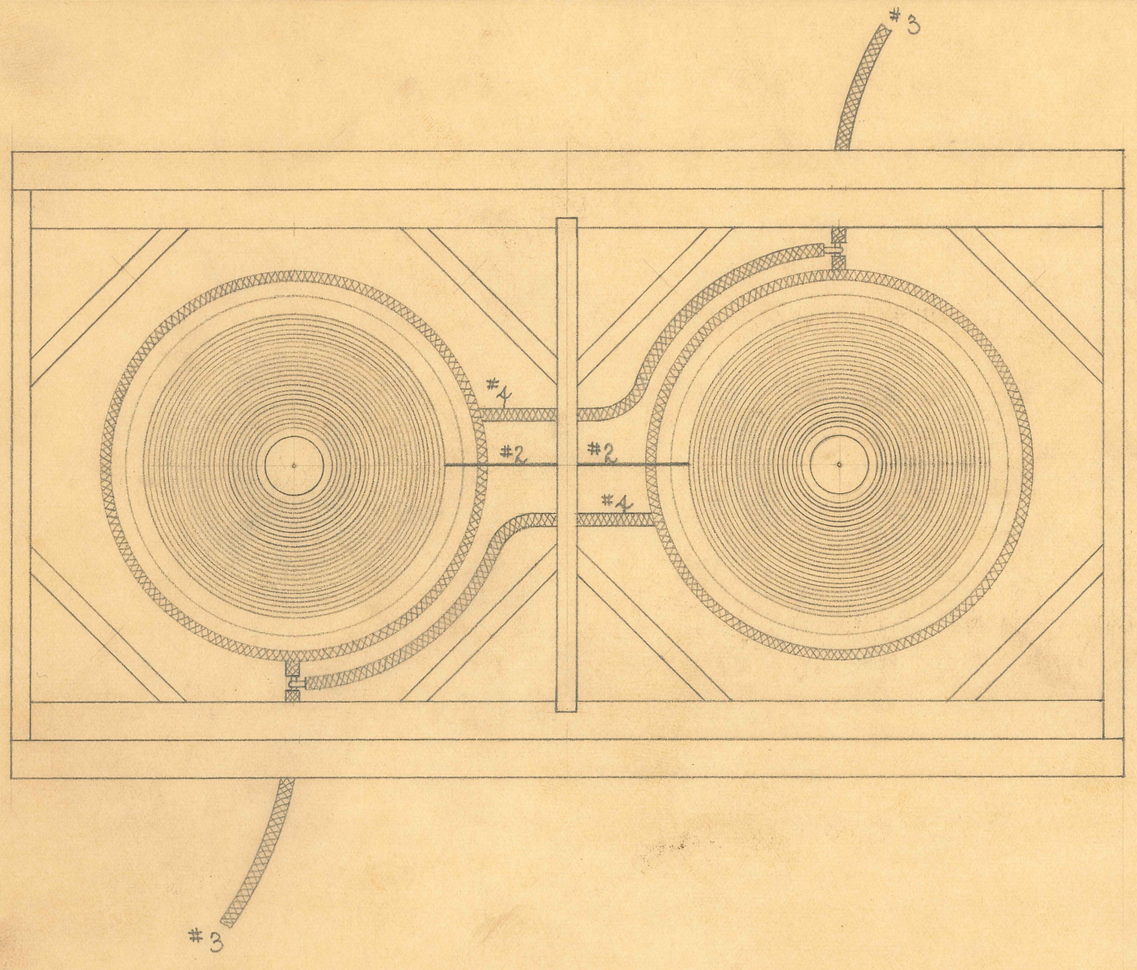

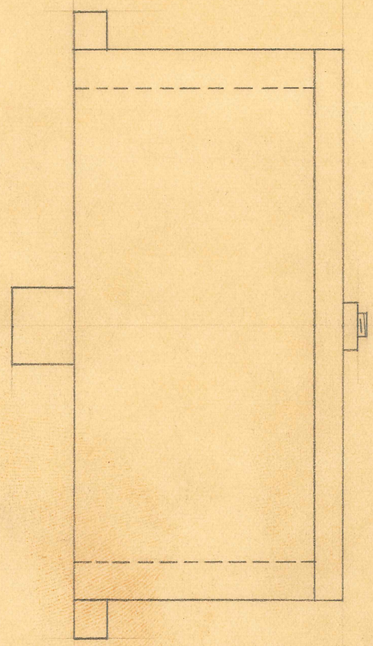

PRIMARY

USE #18 STRANDED WIRE.
ANCHOR LEAD #3 ON H-711-PRI. RING & WIND 24¾ TURNS AND ANCHOR END-LEAD #4. WHEN ASSEMBLING, CONNECT ALL LEADS AS SHOWN.

WINDING DATA

USE #26 SILK ENAMEL WIRE. FASTEN START TO POLE & WIND 70 TURNS ON POLE. 2 LAYERS OF 5007 OILED PAPER. 2ND LAYER OF WIRE TO 140 TURNS. 2 LAYERS OF PAPER. 3RD LAYER OF WIRE TO 210 TURNS,

| | | |

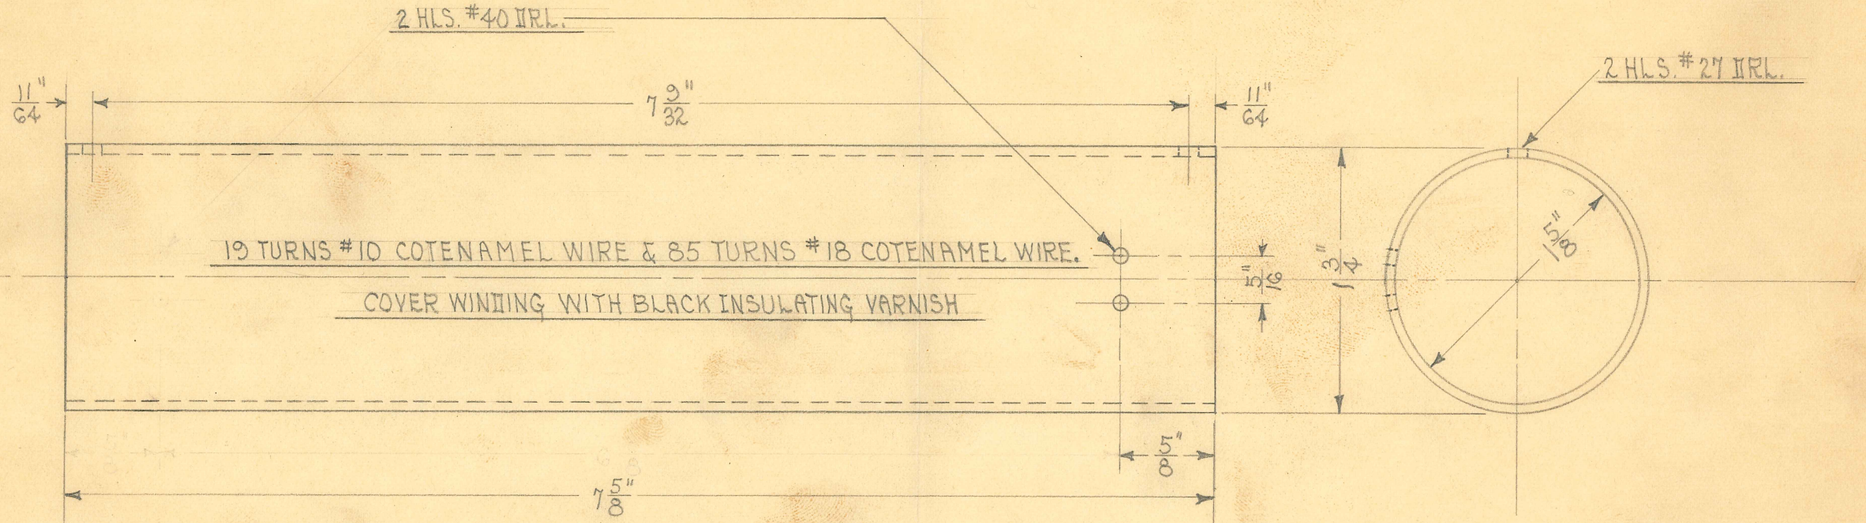

OBSOLETE

SIZE	1 5/8" I.D. X 1 3/4" O.D.	ISSUE 1-23-32	H.E.	TITLE: CUTTING CUR. GEN. FOR MODEL "H" - COIL TUBE (DRILLED & WOUND)
KIND	FIBRE TUBING	CHANGED 3-30-34	H.E.	
SHAPE		" "		
FINISH		" "		
TEMP.		" "		H. G. FISCHER & CO. 2335 WABANSIA AVE. CHICAGO, ILL. — CAT. NO. — PART NO. 7496GA
PATT.		" "		

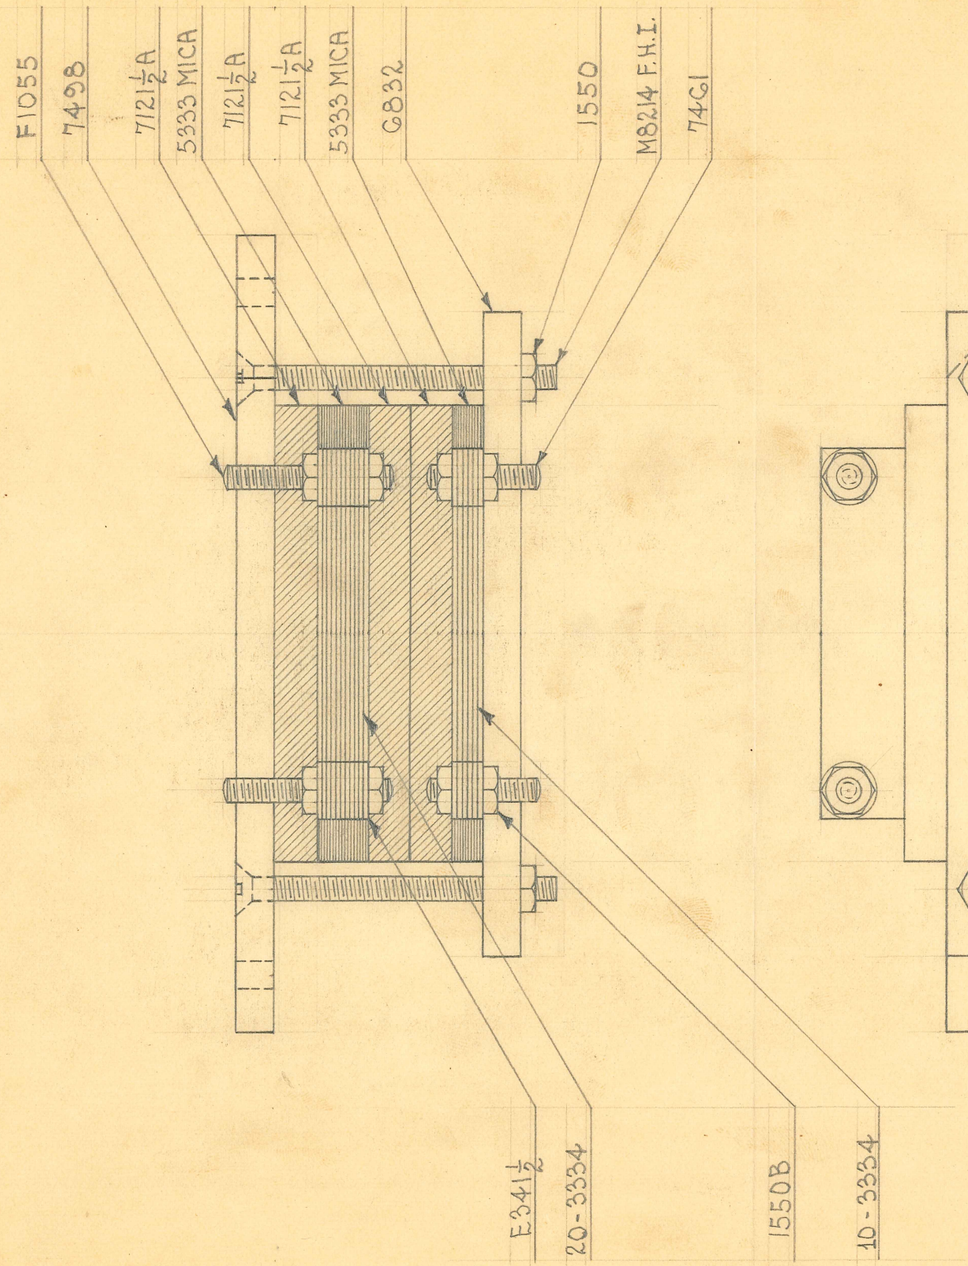

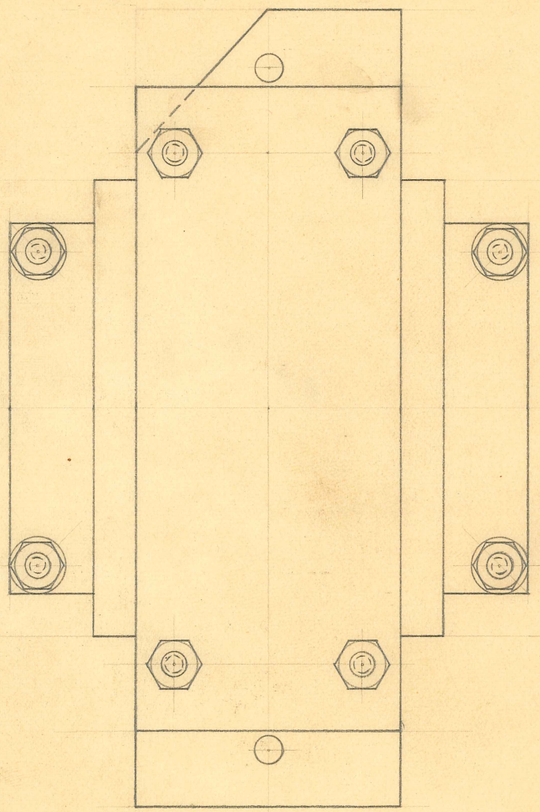

NOTE:-

MICA SPLIT TO .012 (4-7 SHEETS)

1-10 PLATE CONN. 1-20 PLATE CONN. JIG #4126

OBSOLETE

SIZE		ISSUE 12-1-32	N.E.
KIND		CHANGED	
SHAPE		" "	
FINISH		" "	
TEMP.		" "	
PATT.		" "	

TITLE: CUTTING CURRENT GEN. FOR MODEL "H" CONDENSER

H. G. FISCHER & CO.
2335 WABANSIA AVE.
CHICAGO, ILL.

CAT. NO.

PART NO. 7497G

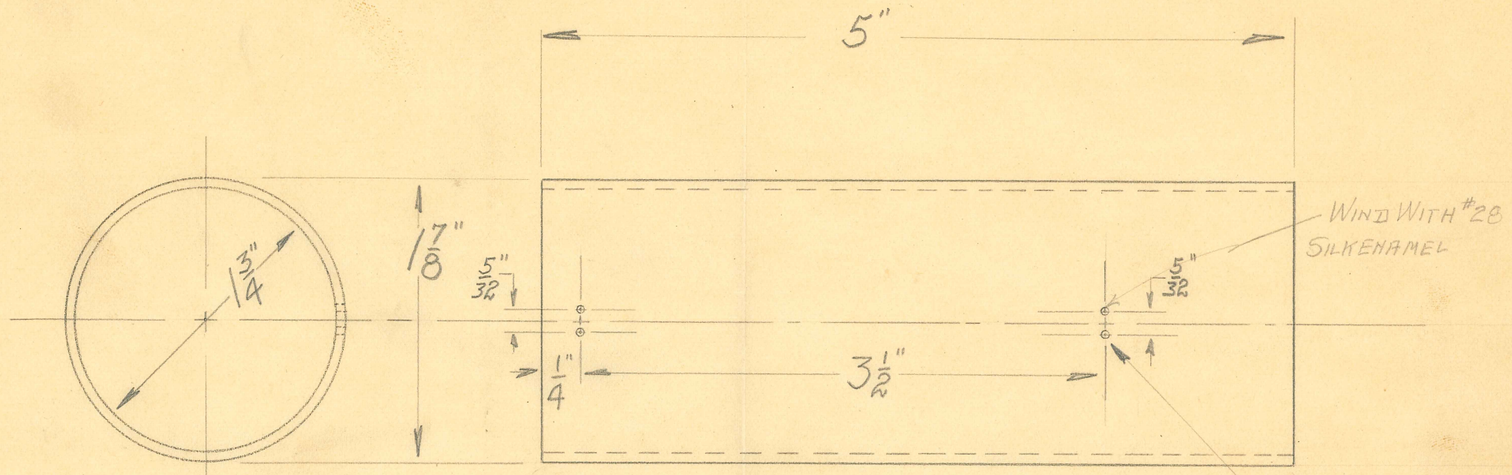

1~ REQ'D.

OBSOLETE

SIZE	1 7/8" O.D. X 1 3/4" I.D.	ISSUE	7-27-32
KIND	BROWN BAKELITE	CHANGED	
SHAPE	TUBING	" "	
FINISH		" "	
TEMP.		" "	
PATT.		" "	

TITLE: HIGH VOLTAGE COIL SECONDARY TUBE

H. G. FISCHER & CO.
2335 WABANSIA AVE.
CHICAGO, ILL.

CAT. NO.

PART NO. 7578

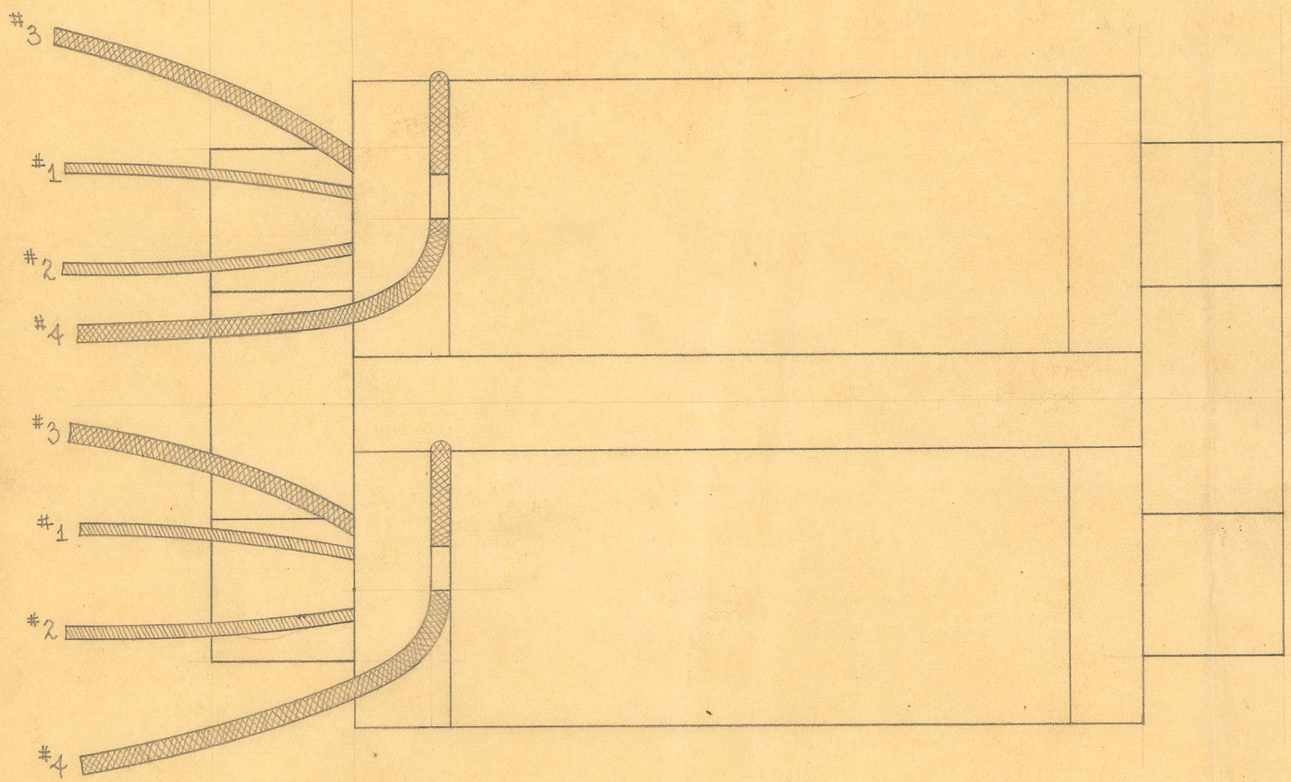

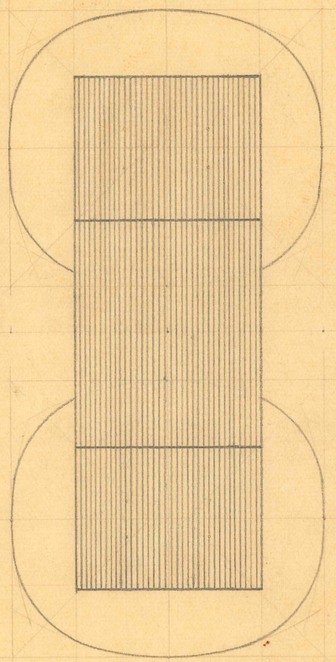

SCALE ~ $\frac{3}{4}$" = 1"

STEEL SIZES

PC. NO. 5043

CORE LAMS. CUT- $8\frac{1}{4}$" X $1\frac{1}{4}$" BUILT UP TO $1\frac{5}{8}$".
END PIECES CUT- $3\frac{1}{4}$" X $1\frac{1}{4}$".
BIND CORES WITH FRICTION TAPE.

WINDING DATA

3 LAYER OF 5024½ FIBROID PAPER ON CORE. USE #18 COTENAMEL WIRE. ANCHOR LEAD #1 WITH FRICTION TAPE & WIND 200 TURNS, 2 LAYERS, WITH 1 LAYER OF FIBROID BETWEEN LAYERS OF WIRE. ANCHOR END WITH FRICTION TAPE-LEAD #2. COVER WITH 3 LAYERS OF FIBROID. USE # 26 COTENAMEL WIRE. ANCHOR LEAD #3 WITH FRICTION TAPE & WIND 2000 TURNS, 250 TURNS PER LAYER, WITH 1 LAYER OF FIBROID BETWEEN EACH LAYER OF WIRE. ANCHOR END WITH LINEN TAPE-LEAD #4. LEADS #3 & 4 ARE 1603-#18 STRANDED WIRE. SHELLAC WINDING. WIND OTHER CORE THE SAME.

SIZE		ISSUE 10-31-32	A.E.
KIND		CHANGED	
SHAPE		" "	
FINISH		" "	
TEMP.		" "	
PATT.		" "	

TITLE: LOW "A" TRANSFORMER

OBSOLETE

H. G. FISCHER & CO.
2335 WABANSIA AVE.
CHICAGO, ILL.

CAT. NO.

PART NO. H736G

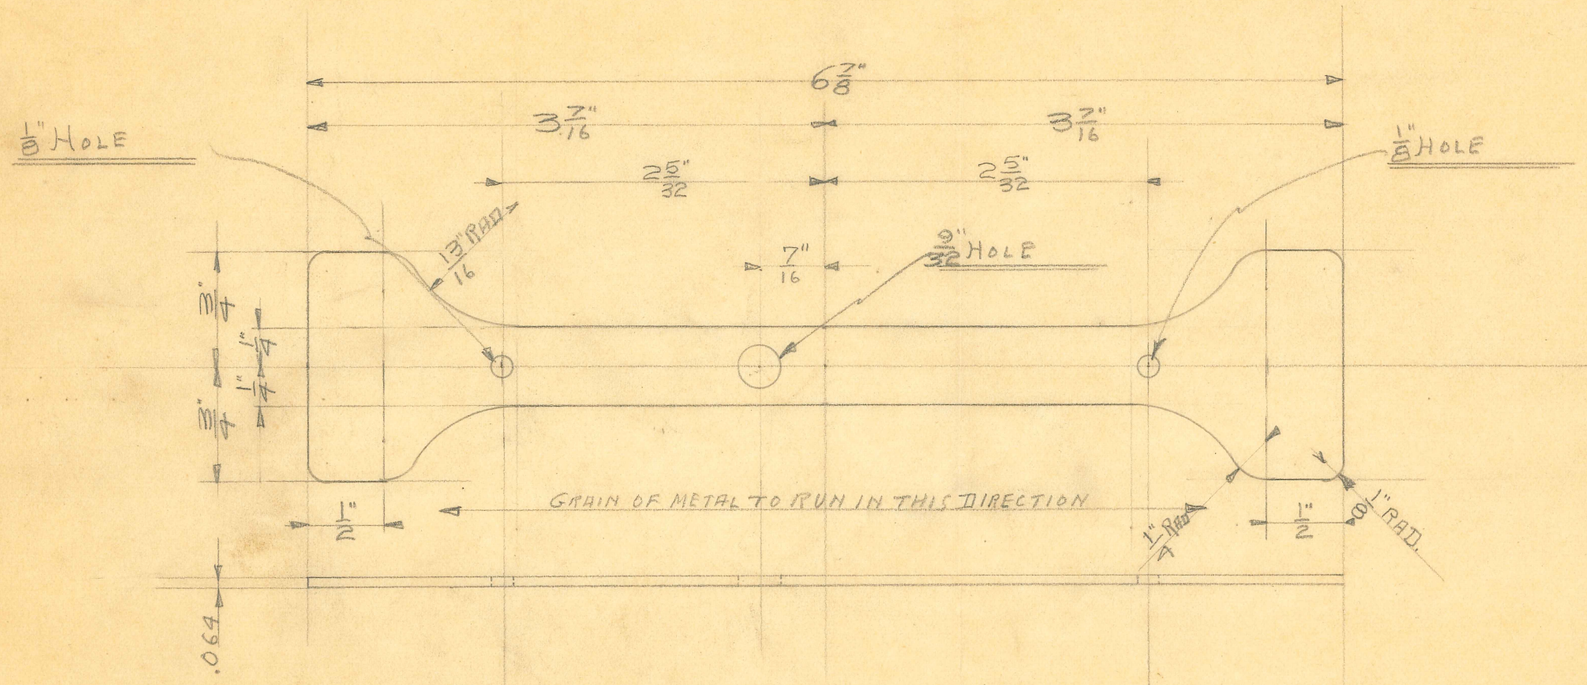

№ 14 B+S. GAUGE HALF HARD SHEET BRASS

2 REQUIRED

OBSOLETE

SIZE		ISSUE		TITLE: YAZUJIAN HEAD BAND, EAR ELECTRODE SUPPORT
KIND		CHANGED		
SHAPE		" "		
FINISH		" "		
TEMP.		" "		H. G. FISCHER & CO. 2335 WABANSIA AVE. CHICAGO, ILL. / CAT. NO. / PART NO. 8957
PATT.		" "		

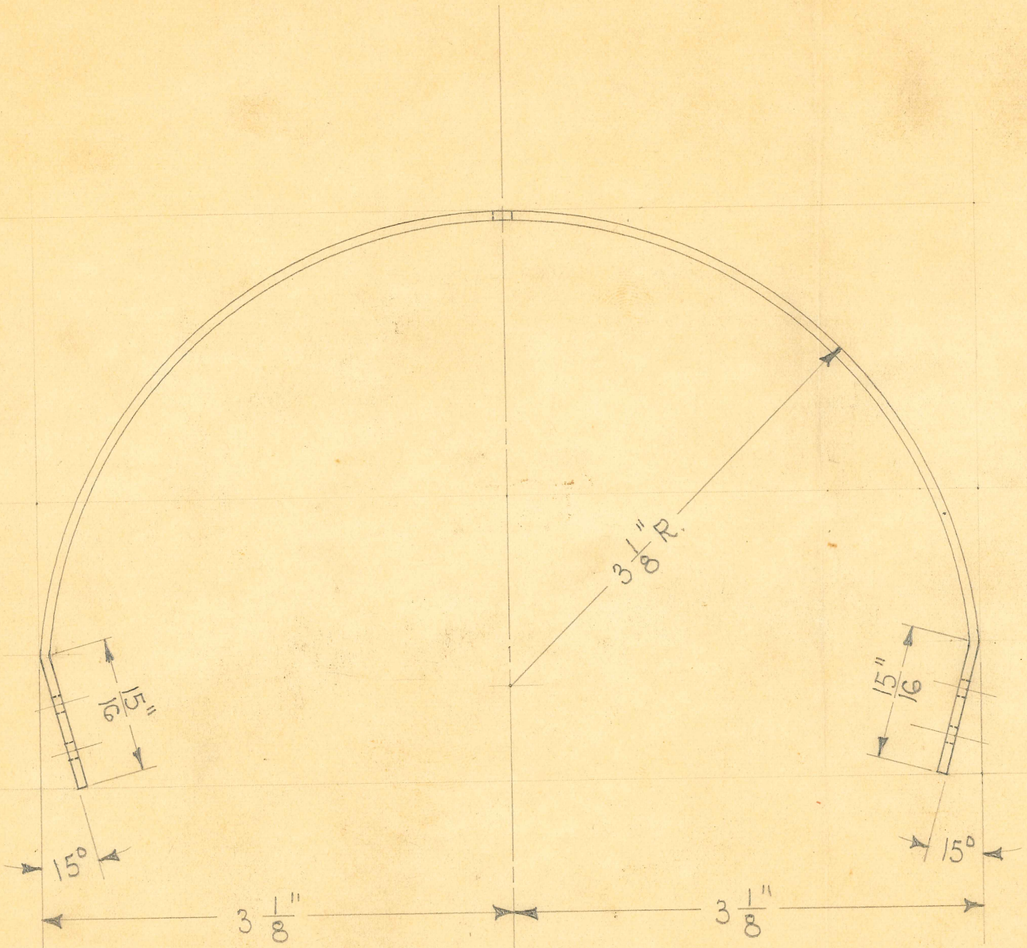

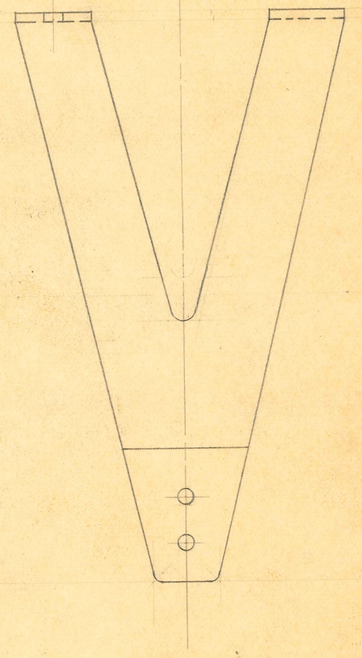

REMOVE ALL EDGES
1 REQUIRED

OBSOLETE

SIZE		ISSUE 7-26-34	A.E.
KIND		CHANGED	
SHAPE		" "	
FINISH	NICKEL #12	" "	
TEMP.		" "	
PATT.		" "	

TITLE: YAZUJIAN HEADBAND SPRING HEAD PIECE SUPPORT

H. G. FISCHER & CO.
2335 WABANSIA AVE.
CHICAGO, ILL.

CAT. NO.

PART NO. 8956F

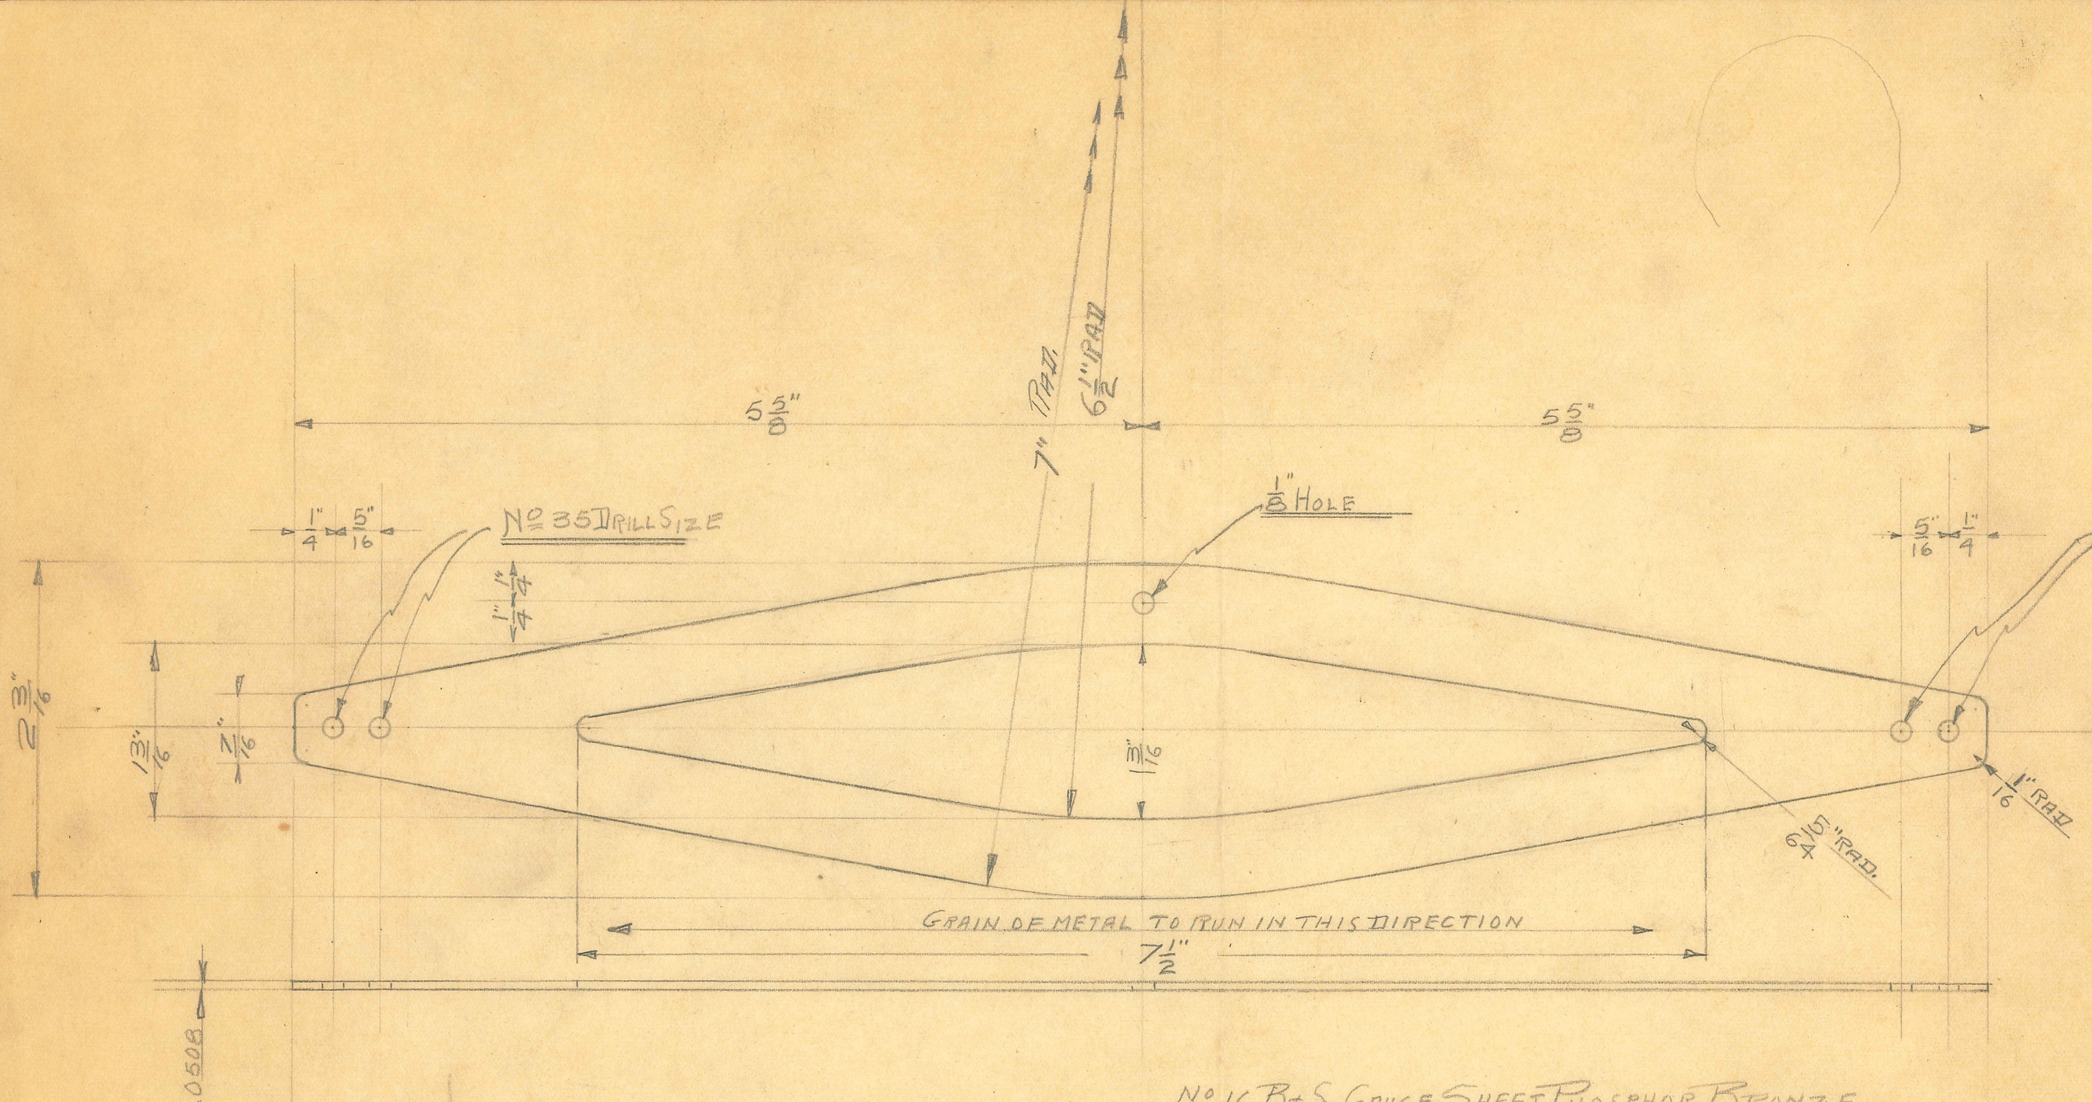

No 16 B+S. GAUGE SHEET PHOSPHOR BRONZE

REQUIRED

OBSOLETE

SIZE		ISSUE	
KIND		CHANGED	
SHAPE		" "	
FINISH		" "	
TEMP.		" "	
PATT.		" "	

TITLE: YAZUJIAN HEAD BAND, SPRING HEAD PIECE SUPPORT - BLANK

H. G. FISCHER & CO.
2335 WABANSIA AVE.
CHICAGO, ILL.

CAT. NO.

PART NO. 8956

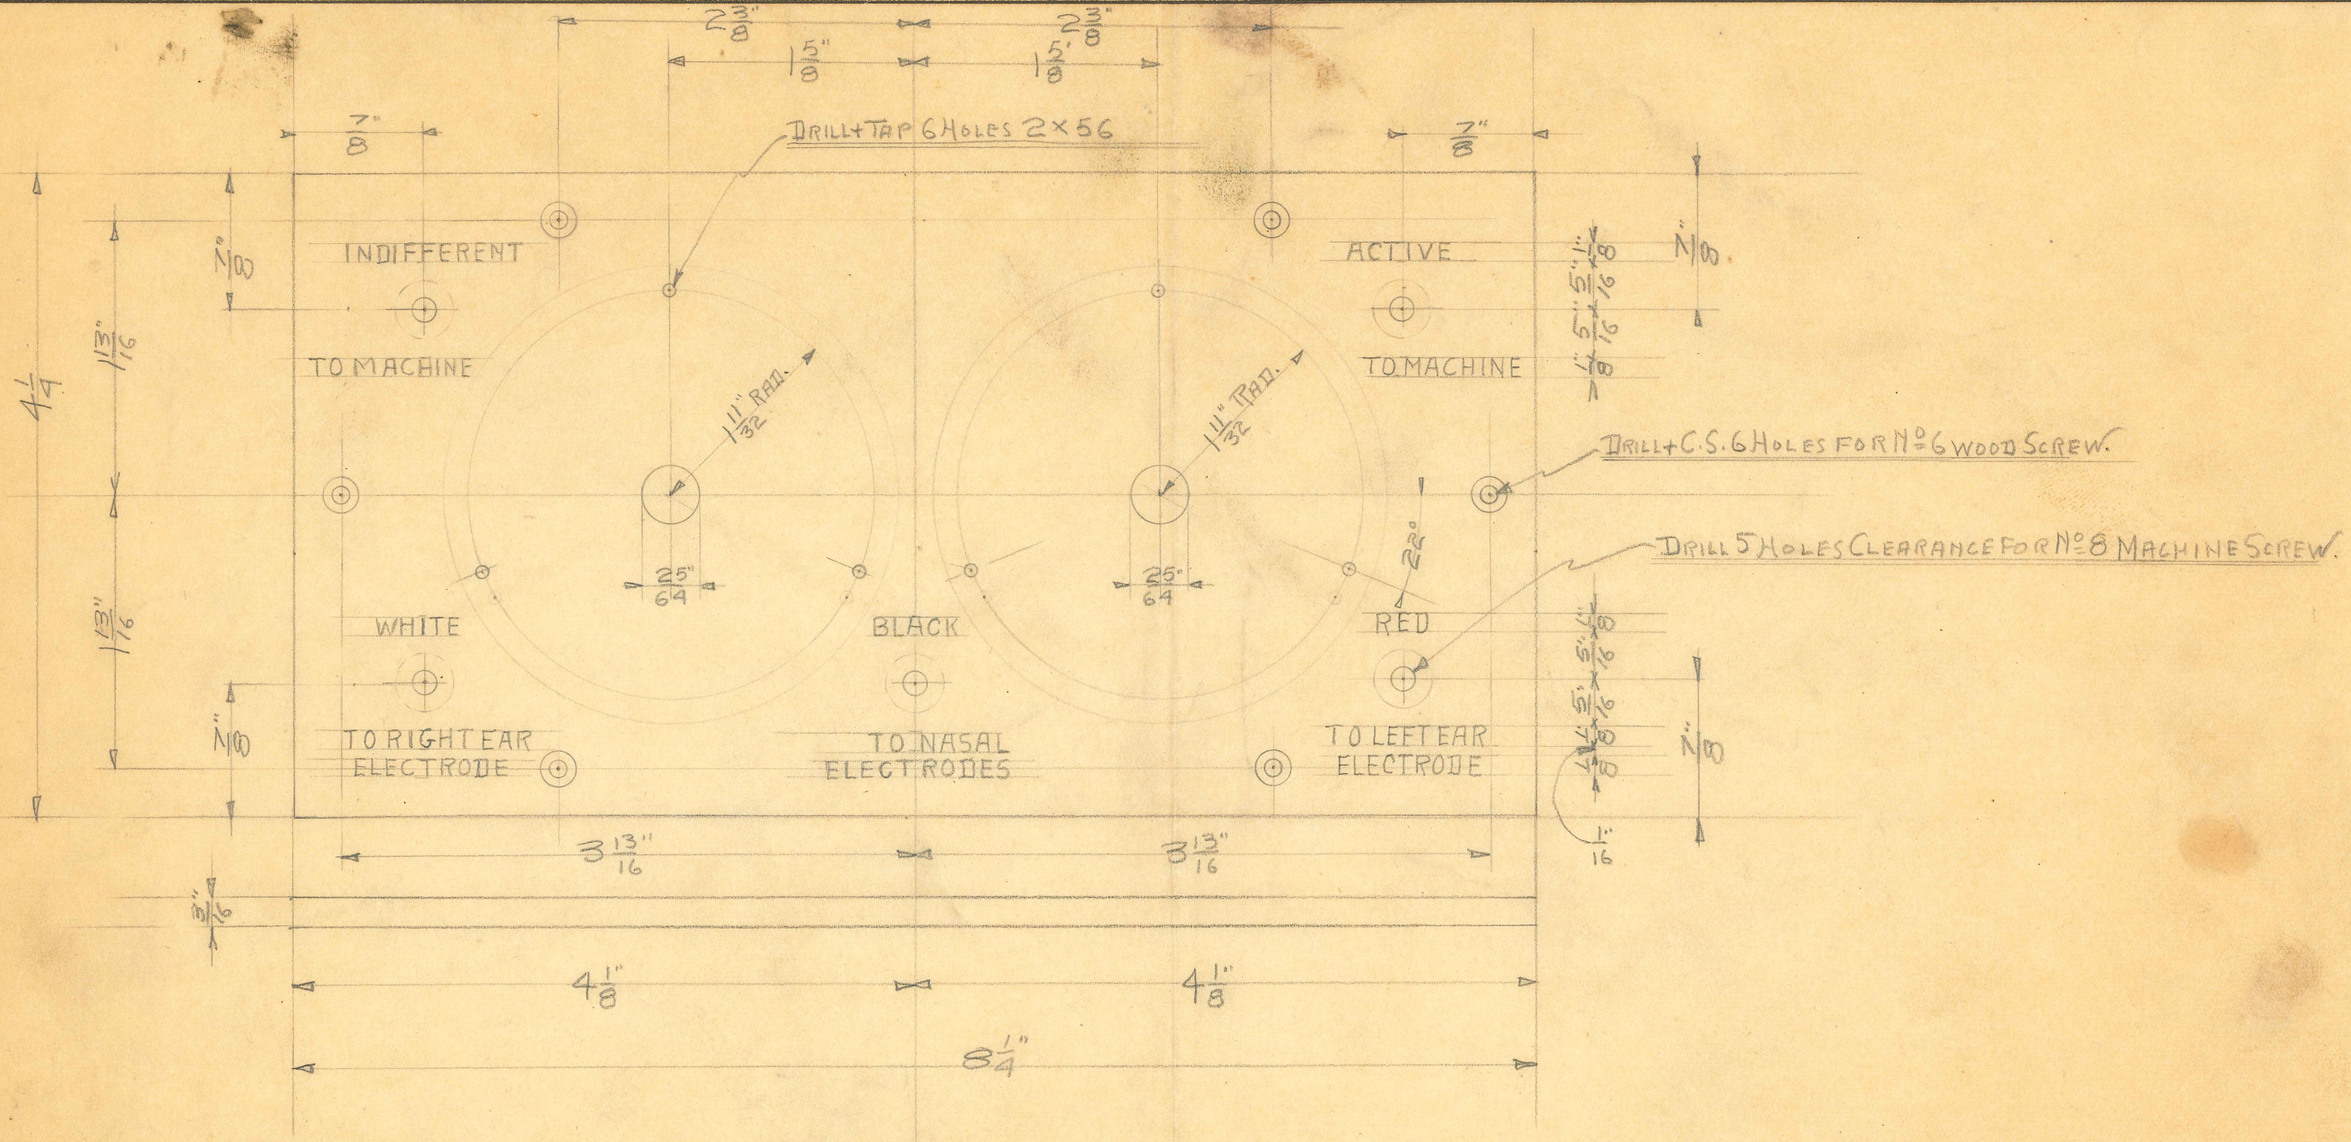
2 3/8"
1 5/8"
2 3/8"
1 5/8"
7/8"
7/8"
DRILL+TAP 6 HOLES 2×56
INDIFFERENT
TO MACHINE
ACTIVE
TO MACHINE
4 1/4"
1 13/16"
1 13/16"
1/8"
1/8"
1/8





































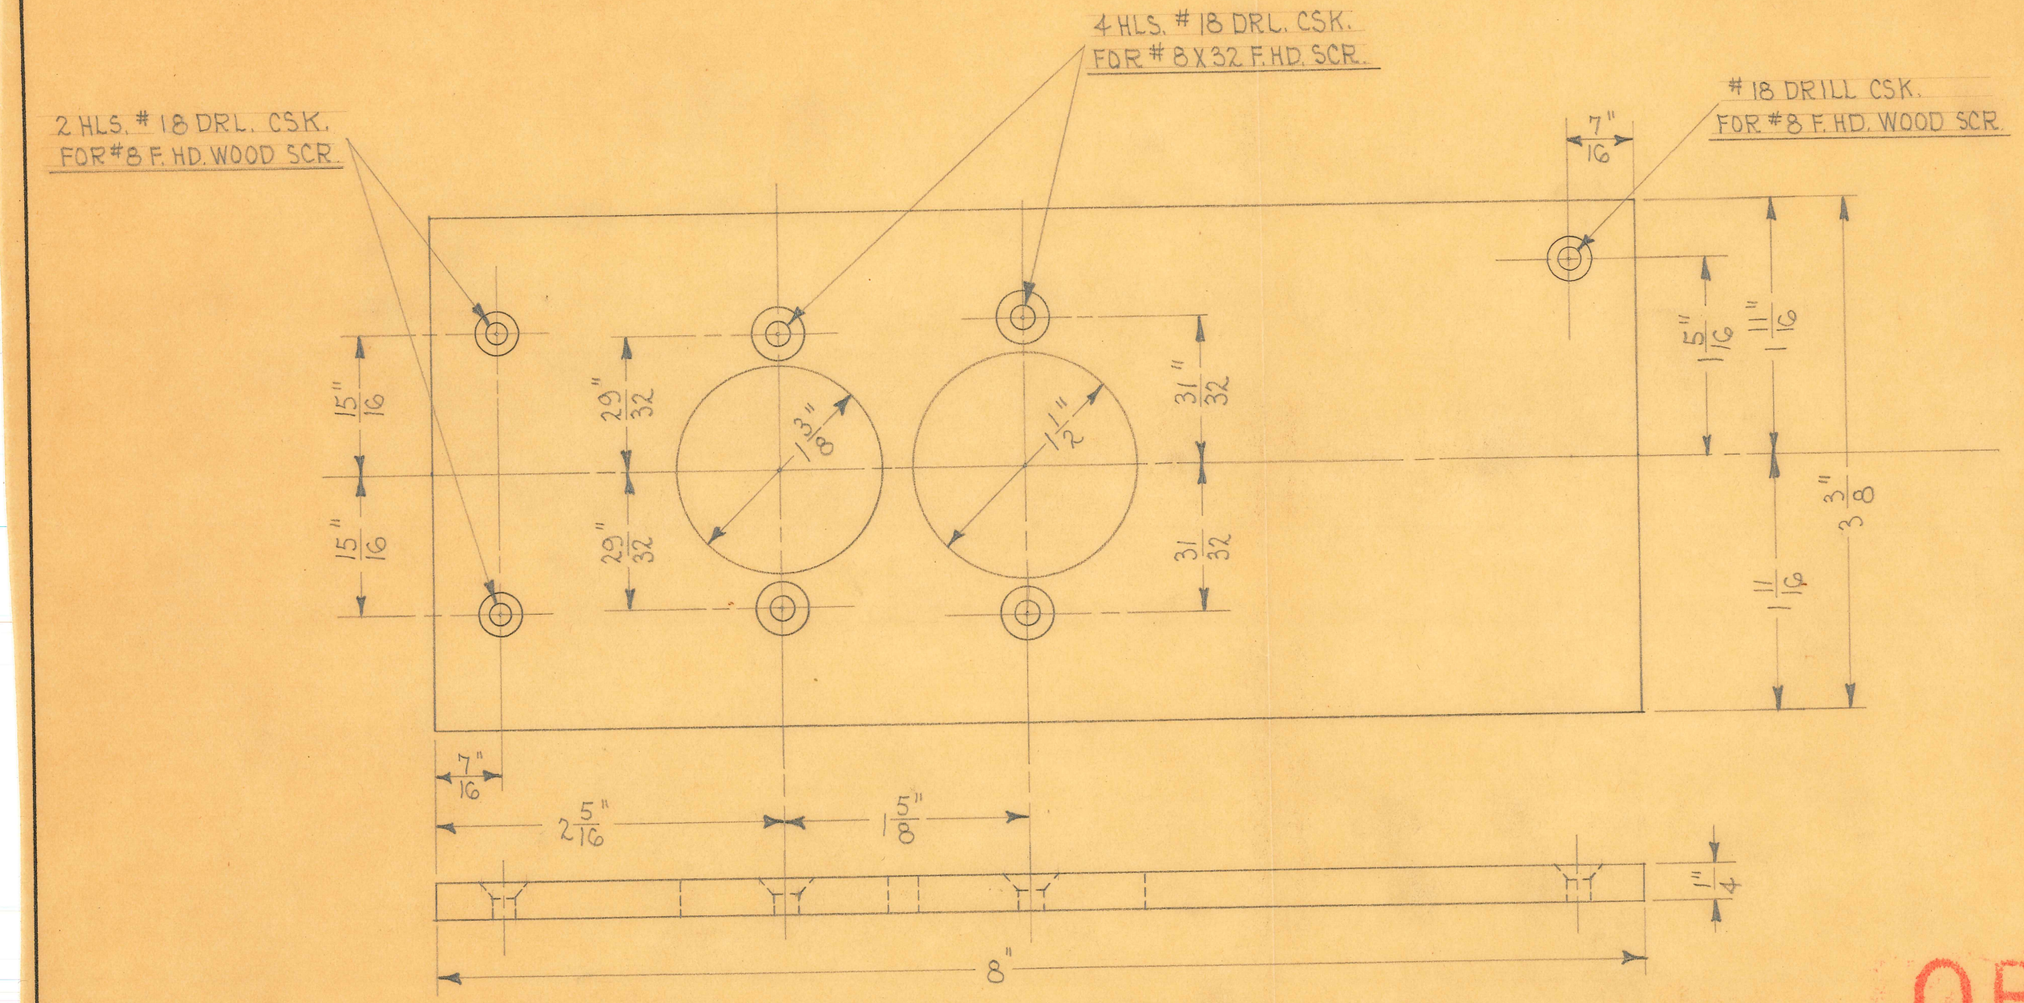

1 REQUIRED

OBSOLETE

SIZE	1/4"	ISSUE 3-16-36	3/6.	TITLE: "CSW" OUTFIT - LINE & FT. SW. REC. MTG. BOARD
KIND	PLY WOOD	CHANGED		
SHAPE		" "		
FINISH		" "		
TEMP.		" "		
PATT.		" "		

H. G. FISCHER & CO.
2335 WABANSIA AVE.
CHICAGO, ILL.

CAT. NO.

PART NO. 10141F

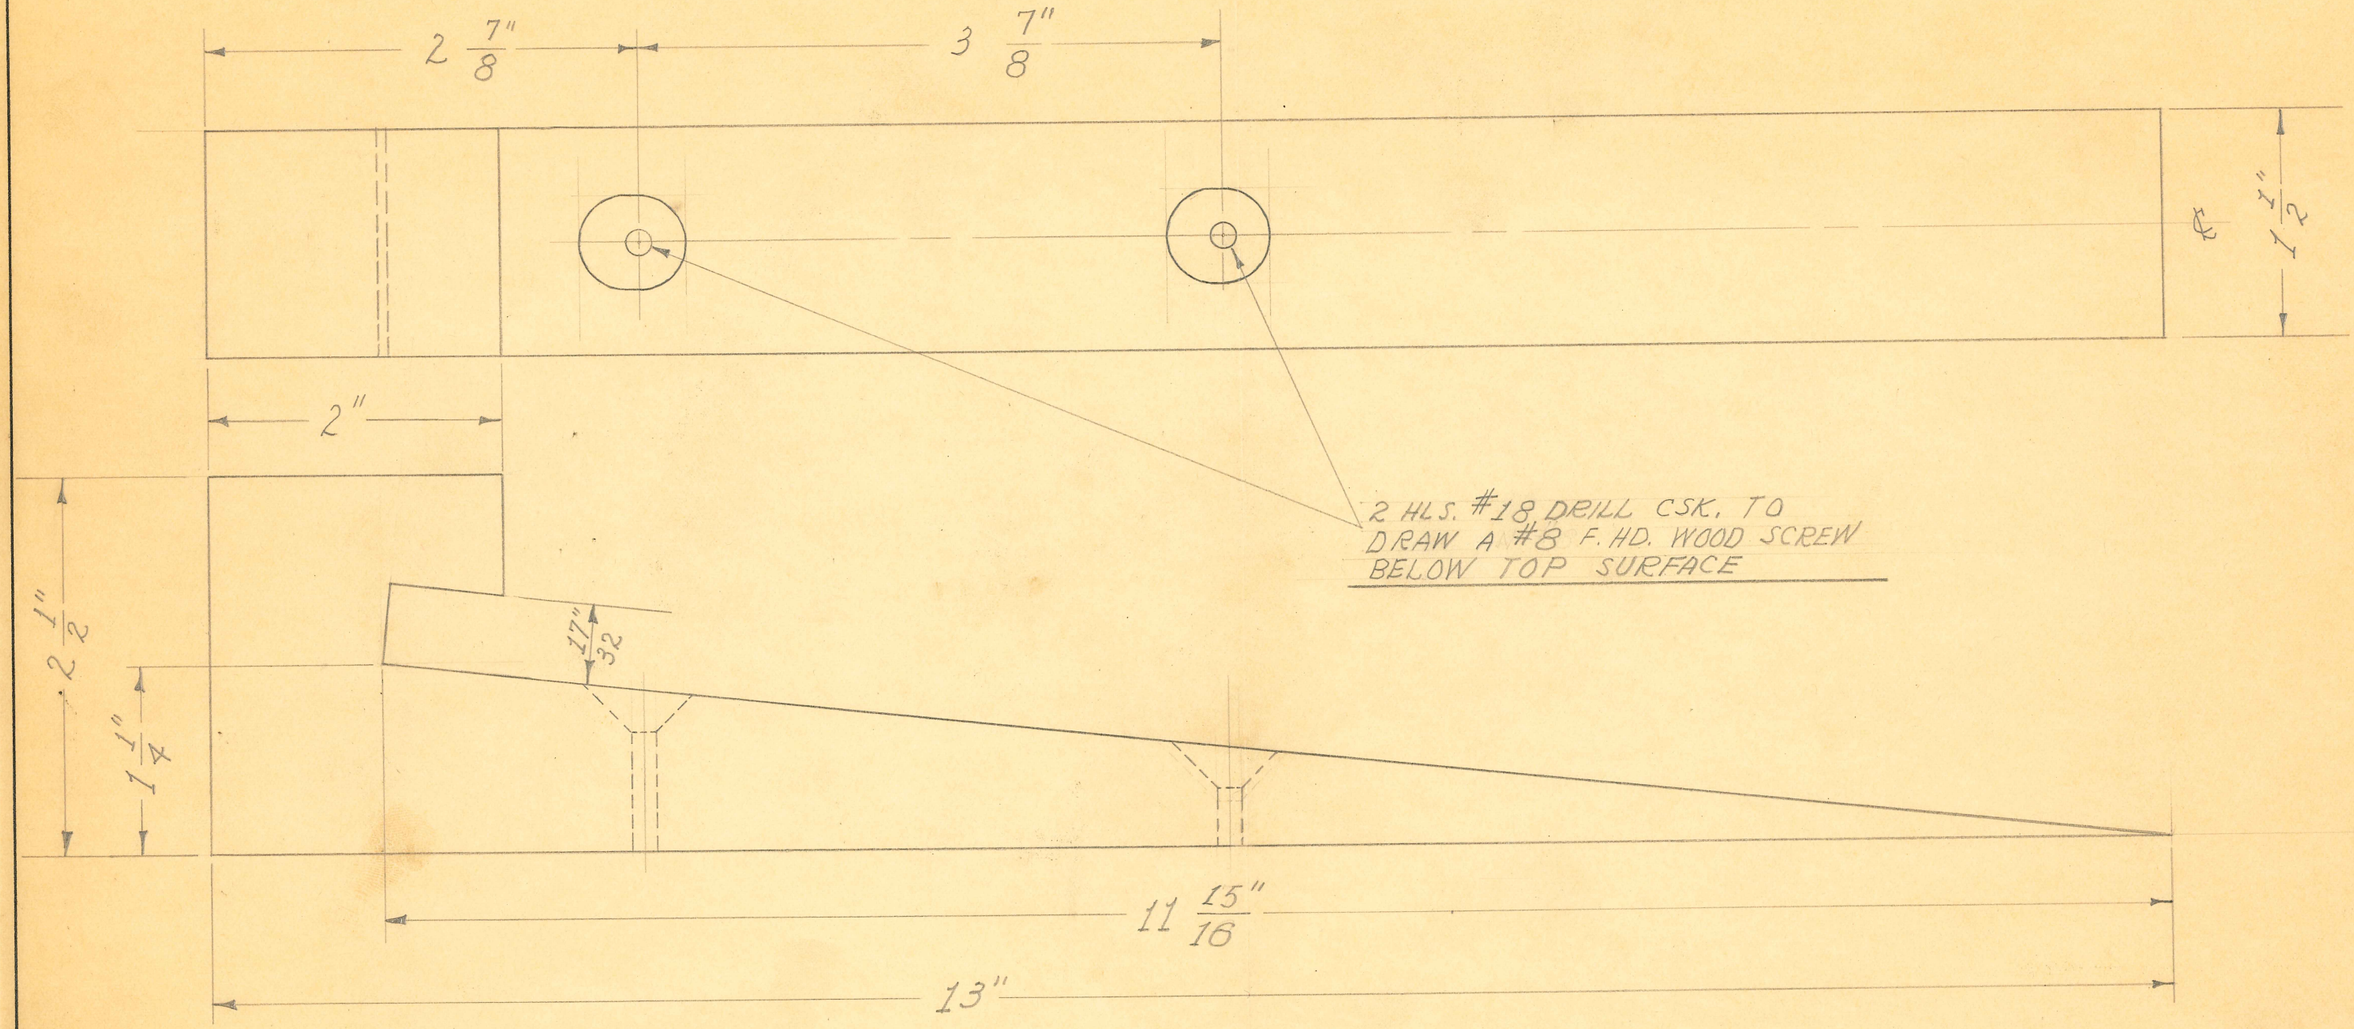

2 REQUIRED

OBSOLETE

SIZE		ISSUE 3-18-37	J.W.
KIND	FIR	CHANGED	
SHAPE		"	
FINISH		"	
TEMP.		"	
DATE		"	

TITLE: TABLE MODEL "CDDG" UNIT GUIDE BLOCK

H. G. FISCHER & CO.
2335 WABANSIA AVE.
CHICAGO, ILL.

CAT. NO.

PART NO. 10139

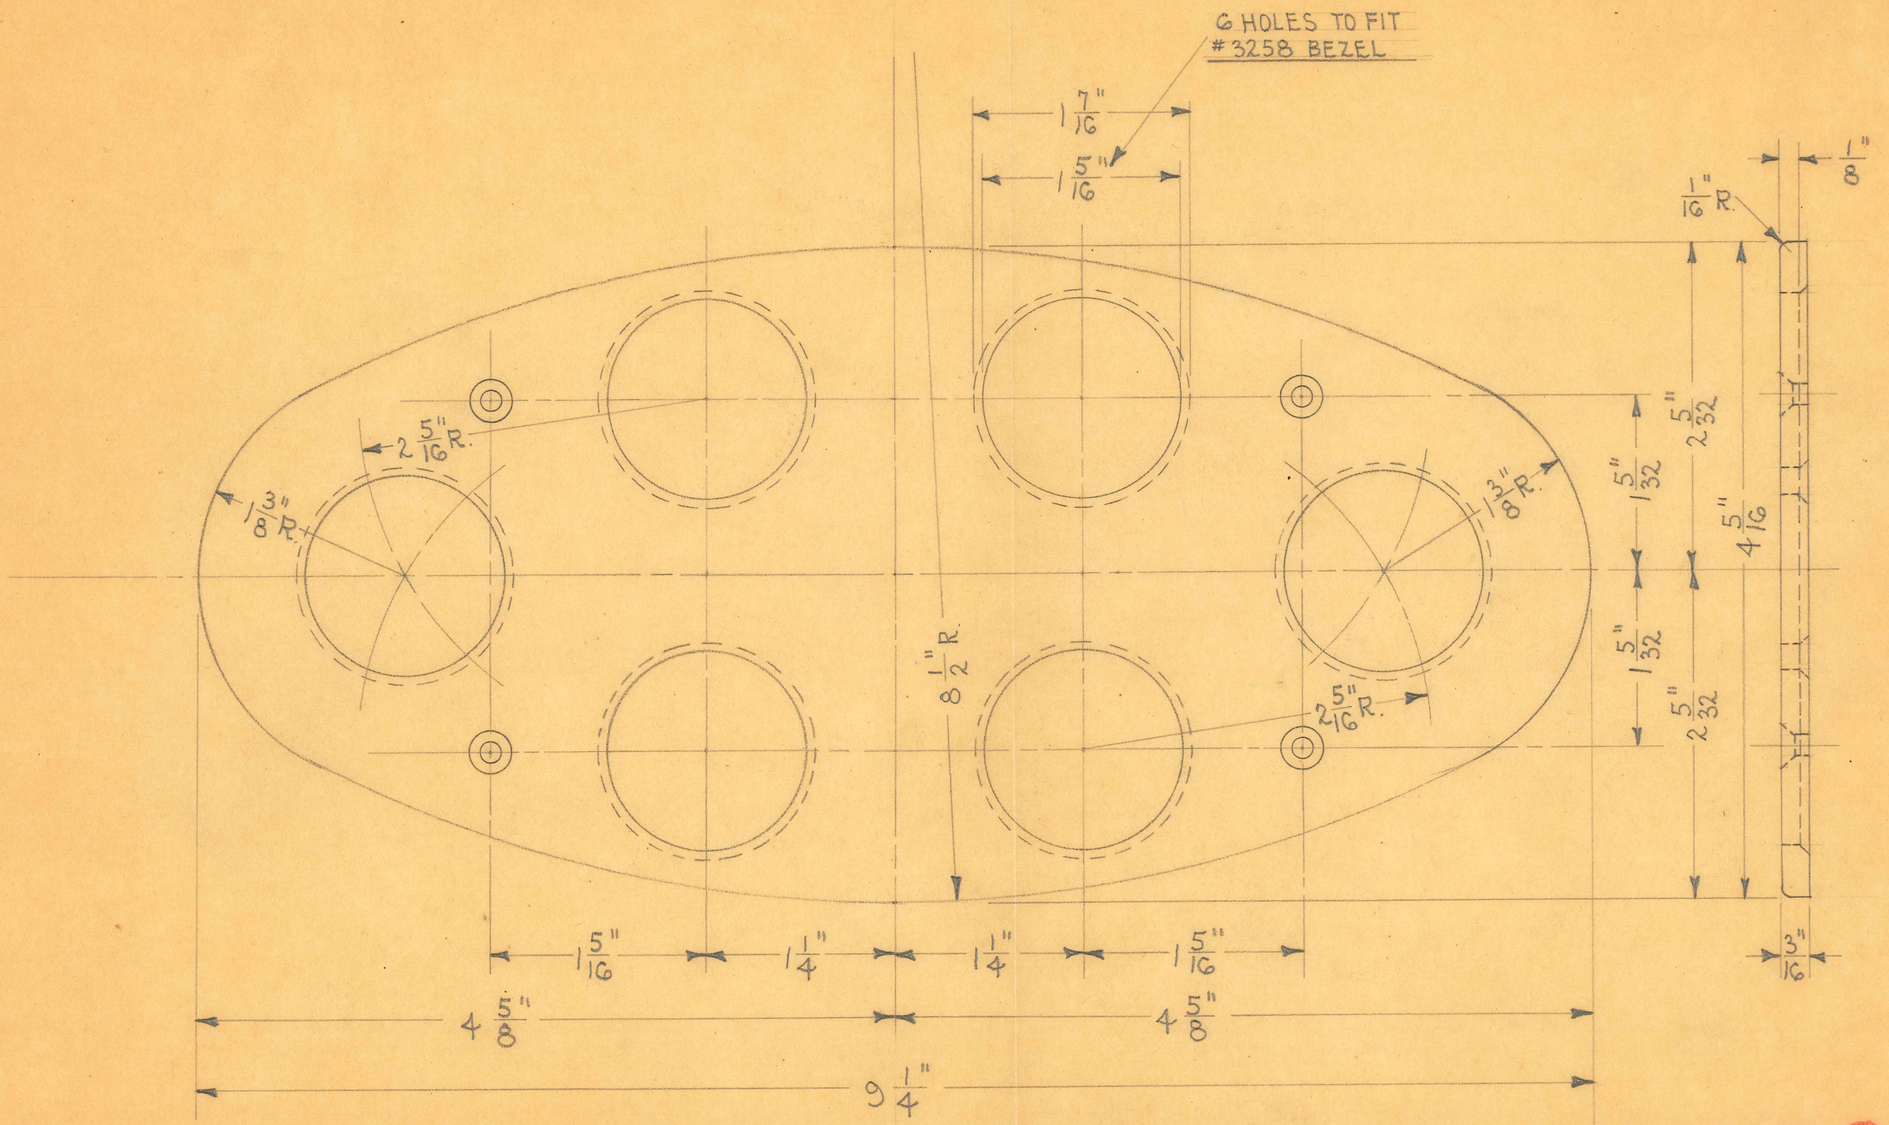

1 REQUIRED

OBSOLETE

SIZE	3/16" SHEET	ISSUE 3-4-36	J.E.
KIND	BAKELITE	CHANGED	
SHAPE		" "	
FINISH		" "	
TEMP.		" "	
DATE		" "	

TITLE:
"CSW" OUTFIT
BOTTLE HOLDER PLATE

H. G. FISCHER & CO.
2335 WABANSIA AVE.
CHICAGO, ILL.

CAT. NO.

PART NO. 10070

#25 DRILL CSK. FOR #6 O.HD. WOOD SCR.

6 1/4"

29/64" DRILL

2 1/4"

2 1/4"

#9 DRILL

#25 DRILL CSK. FOR #6 O.HD. WOOD SCR.

6 1/4"

3 HLS. #4X36 TAP

1" 1/4

1" 1/2

5

1" 1/2

25

#25 DRILL CSK. FOR #6X32 F.HD. SCR.

25/64" DRILL

7/8"

7/8"

3/8" DRILL

3 HLS-#2X56 TAP USE #6719 AS TEMPLATE

DIAGNOSTIC CONTROL

DESICCATION ON

2 HLS. #4X36 TAP

1" 8

3/8"

3/8"

1" 8

1" 8

1" 8

OFF

DESICCATION CONTROL

3/4"

120°

120°

1 7/16" R.

2 9/16" D.

5 11/16"

1"

1"

C.D.G. ON

#17 DRILL

C.D.G.

21/64" DRILL

15/16"

21/32"

1 1/16"

FOOT SWITCH

2 HLS. #25 DRILL CSK. FOR #6X32 F.HD. SCR.

1" 2

3"

1" 2

7/8"

1/4

CAUTERY

DIAGNOSTIC

GALVANIC

7/8"

1/4

1 3/4"

1 3/4"

1 1/4"

1 1/4"

3/16"

1 1/8"

4 1/2"

1 1/8"

1 7/8"

4 1/2"

6"

6"

6 7/8"

6 7/8"

13 3/4"

3 HLS. #17 DRILL CSK. FOR #8 O.HD. WOOD SCR.

OBSOLETE

SIZE	3/16" SHEET	ISSUE 2-5-37	J.W.
KIND	LAMICOID	CHANGED	
SHAPE		"	
FINISH		"	
TEMP.		"	
PATT.		"	

TITLE: "CSWI" — C.D.D.G UNIT WITH DESICCATION PANEL (DRILLED & ENG.)

H. G. FISCHER & CO.
2335 WABANSIA AVE.
CHICAGO, ILL.

CAT. NO.

PART NO. 10102AF

#25 DRL. CSK. FOR #6 O.HD. WOOD SCR.

2 HLS. #25 DRL. CSK. FOR #6 X 32 F.HD. SCR.

5/8" — 1/4"

29/64" DRILL

2 1/4" — 2 1/4"

1 3/4" — 1 3/4"

#9 DRILL

#25 DRL. CSK. FOR #6 O.HD. WOOD SCR.

29/64" DRILL

3 HLS. #4 X 36 TAP

5/8" — 1/4" — 1/2"

5 — 1/2" — 25

DESICCATION

FOOT SWITCH — ON — CONTROL

2 HLS. #17 DRL. CSK. FOR #8 X 32 O.HD. SCR.

25/64" DRILL

2 HLS. #4 X 36 TAP

120° — 120°

1/16" R. — 2 9/16"

29/32" — 29/32"

3/16" — 1 3/8"

7/8" — 7/8"

3/8" — 3/8"

ON — OFF

3" — 1 1/2" — 2 1/2"

5 11/16"

7/8" — 1/4"

7/8" — 7/8"

3 HLS. #56 DRILL
USE 6719 AS TEMPLATE

3" DRILL

C.D.G.

21/64" DRILL

C.D.G. ON

21/64" DRILL

#17 DRILL

CAUTERY

DIAGNOSTIC

GALVANIC

1/2" — 1/4"

1 1/4" — 1 1/4"

1 1/4" — 1 1/4"

1 1/4" — 1 1/4"

4 1/2"

4 1/2"

6"

6"

6 7/8"

6 7/8"

13 3/4"

1/4"

3 HLS. #17 DRL. CSK. FOR #8 O.HD. WOOD SCR.

OBSOLETE

SIZE	1/4" SHEET	ISSUE 3-3-36	A.E.
KIND	LAMICOID	CHANGED 12-9-36	J.W.
SHAPE		" " 2-1-37	J.W.
FINISH		" "	
TEMP.		" "	

TITLE:

"CSW" OUTFIT

CAUTERY, DIAG., GALV. & DESICCATION UNIT PANEL

H. G. FISCHER & CO.
2335 WABANSIA AVE.

CAT. NO.

PART NO. 10102 FA

4 HLS. #27 DRL. CSK.
FOR #6X32 O.HD. SCR.

3 HLS. #4X36 TAP

FILAMENT

PATIENT'S CONTROL

PLATE

31/64 DRL.

31/64 DRILL

VOLUME CONTROL

TYPE SW1

H. G. FISCHER & CO.
CHICAGO, ILL. MADE IN U.S.A.

12 METER

OBSOLETE

SIZE	5½"X14⅞"X⅛"	ISSUE 4-24-36	J.E.	TITLE: INTERMEDIATE MOD. "SW-12" SHORT WAVE H.F. OUTFIT PANEL (DRILLED)
KIND	SHEET LAMICOID	CHANGED		
SHAPE		" " 6-22-37	J.W.	
FINISH		" "		
TEMP.		" "		
PATT.		" "		

H. G. FISCHER & CO.
2335 WABANSIA AVE.
CHICAGO, ILL.

CAT. NO.

PART NO. 9908FA

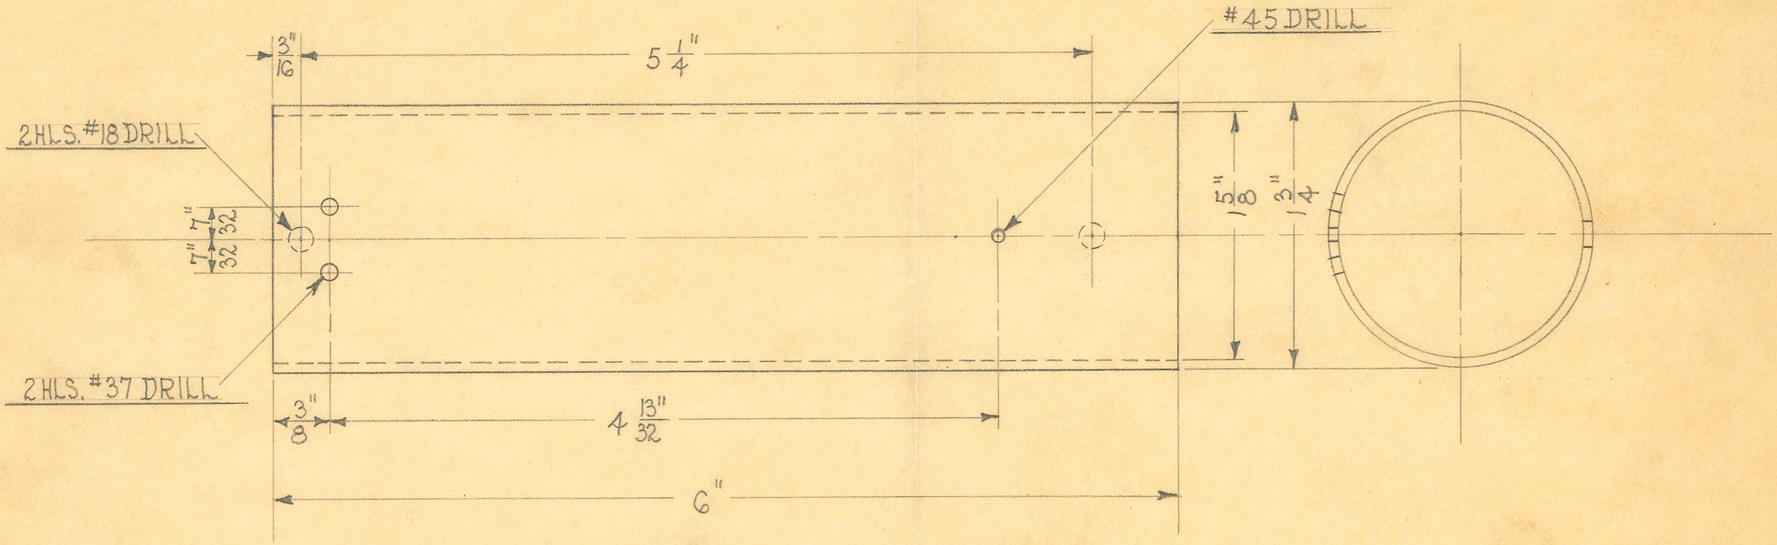

OBSOLETE

SIZE	15/8" I.D. X 1 3/4" O.D.	ISSUE 2-17-33	W.E.	TITLE: MOD. "A", "G2" & "SPD" CUTTING ATTACHMENT CUTTING COIL TUBE
KIND	FIBRE TUBE	CHANGED		
SHAPE		" "		
FINISH		" "		
TEMP.		" "		
PATT.		" "		

H. G. FISCHER & CO.
2335 WABANSIA AVE.
CHICAGO, ILL.

CAT. NO.

PART NO. 7704F

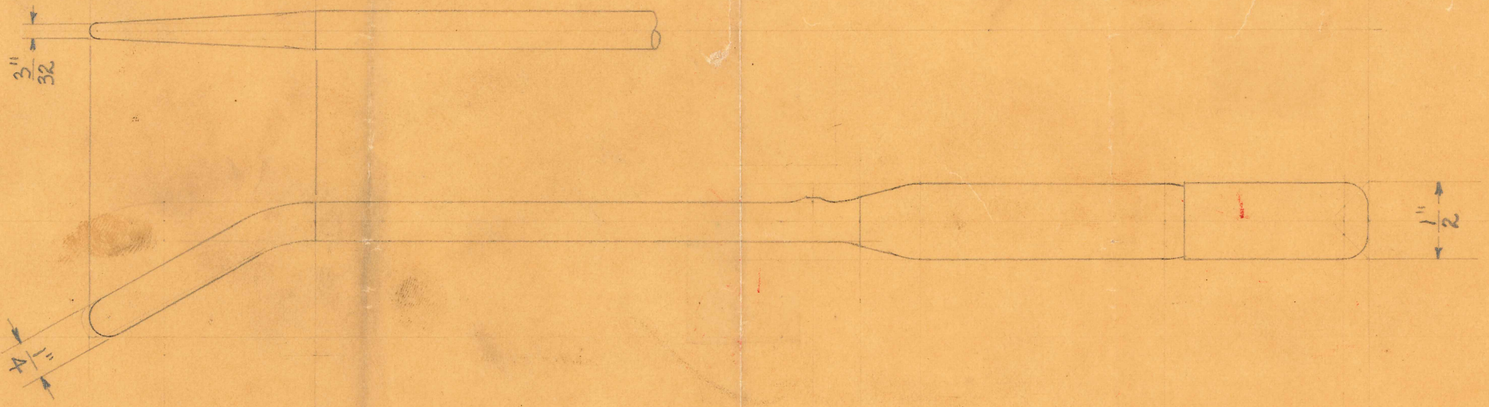

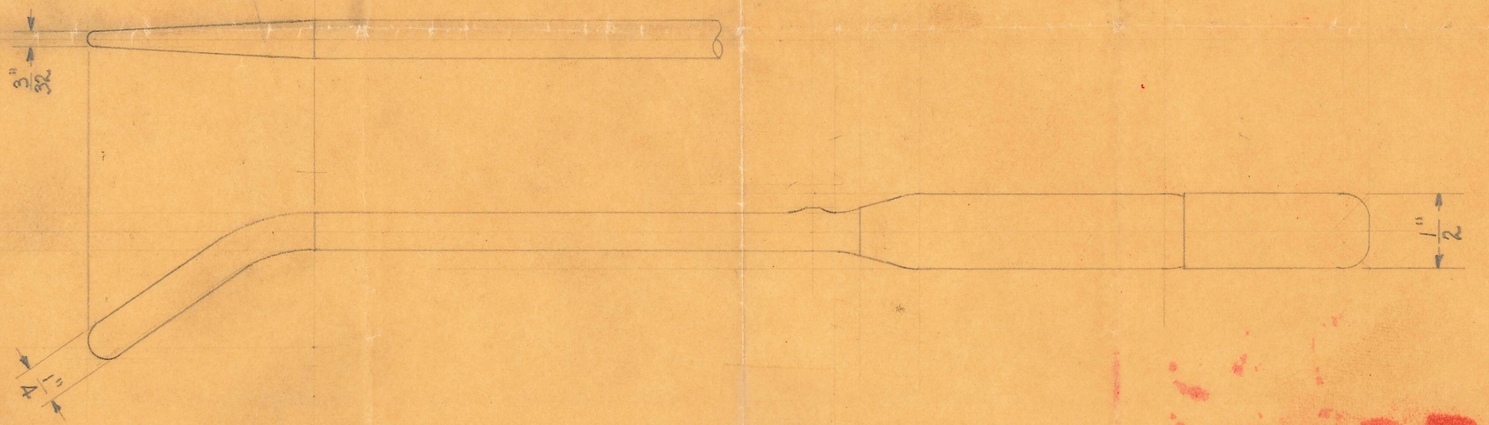

OBSOLETE
OFFICE ORDER C48261

SIZE		ISSUE 8-26-30	A.E.
KIND		CHANGED	
SHAPE		" "	
FINISH		" "	
TEMP.		" "	
PATT.		" "	

TITLE: SPEC. NON VAC. H.F. INSULATED NASAL ELECTS.
FOR DR. WETHERBEE - EUGENE, ORE. OUR ORDER # C48261

H. G. FISCHER & CO.
2335 WABANSIA AVE.
CHICAGO, ILL.

CAT. NO.

PART NO. S108

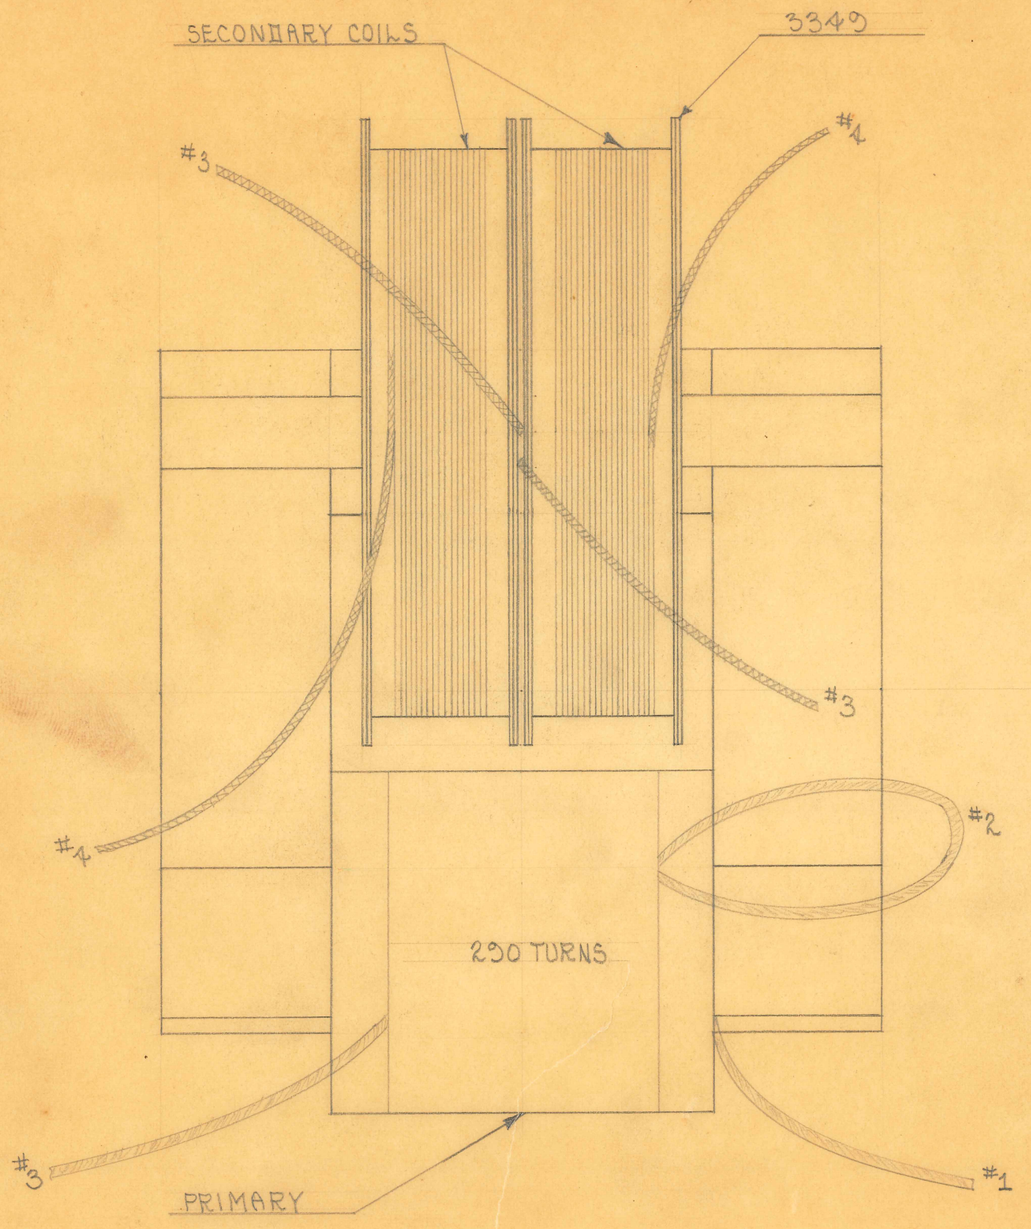

SCALE ~ $\frac{3}{4}$" = 1"

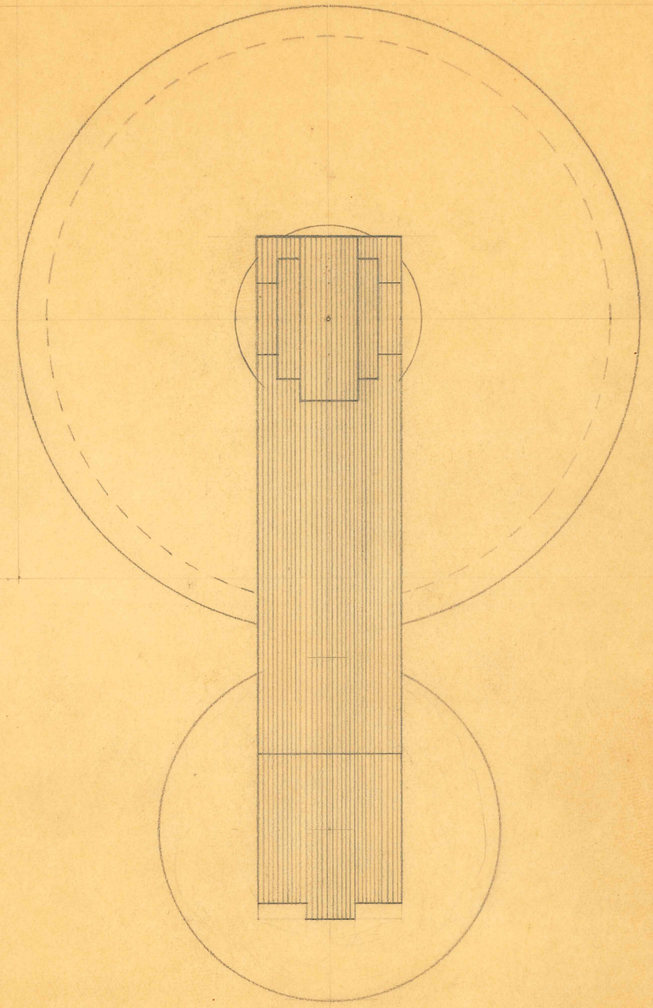

STEEL SIZES
PC. NO. 5043

$4\frac{7}{8}$" X $1\frac{5}{16}$" BUILT UP TO $1\frac{1}{4}$" (PRI. CORE)
$4\frac{7}{8}$" X $1\frac{7}{16}$" BUILT UP TO $\frac{1}{2}$"
$4\frac{7}{8}$" X $1\frac{1}{16}$" BUILT UP TO $\frac{3}{8}$"
$4\frac{7}{8}$" X $\frac{5}{8}$" BUILT UP TO $\frac{3}{8}$"
} SEC. CORE (JIG # 3005)

END PCS. $4\frac{1}{2}$ X $1\frac{1}{2}$"
BIND CORES WITH FRICTION TAPE

WINDING DATA

PRIMARY

USE # 14 COTENAMEL WIRE.

4 LAYERS OF 5026 $\frac{1}{4}$ OILED CLOTH ON CORE. ANCHOR LEAD #1 WITH LINEN TAPE AND WIND TO 275 TURNS AND BRING OUT TAP #2. WIND 15 TURNS MORE AND END WITH LEAD #3. TOTAL - 290 TURNS. ANCHOR LEAD #3 WITH LINEN TAPE. NO DEFINITE NUMBER OF TURNS TO EACH LAYER BUT INSULATE WITH 2 LAYERS OF 5026 $\frac{1}{4}$ BETWEEN EACH LAYER OF WIRE. COVER LAST LAYER OF WIRE WITH 5004 OILED TAPE AND SHELLAC.

SECONDARY

USE # 29 ENAMEL WIRE.

WIND 8" STRIP OF 5009 OILED PAPER ON 3344F TUBE. ANCHOR LEAD #4 (SEC. LEADS ARE APPROX. 7" OF 1631) AND WIND 88 LAYERS, 70 TURNS TO A LAYER. INSULATE BETWEEN EACH LAYER OF WIRE WITH 1 LAYER OF 5009 OILED PAPER. TOTAL 6160 TURNS. COVER 88 TH LAYER WITH 1 LAYER OF 5009 OILED PAPER AND FINISH WITH 1 LAYER (NO DEFINITE NUMBER OF TURNS) OF # 22 ENAMEL WIRE, ANCHORING LEAD #4 WITH LINEN TAPE. END OF # 29 E. WIRE CONNECTED TO START OF # 22 E. WIRE. SHELLAC LAST LAYER.

SIZE		ISSUE 3-4-32	H.E.
KIND		CHANGED	
SHAPE		" "	
FINISH		" "	
TEMP.		" "	
PATT.		" "	

TITLE: PORTABLE DIATHERMY TRANSFORMER

OBSOLETE

H. G. FISCHER & CO.
2335 WABANSIA AVE.
CHICAGO, ILL.

CAT. NO.

PART NO. 3343G

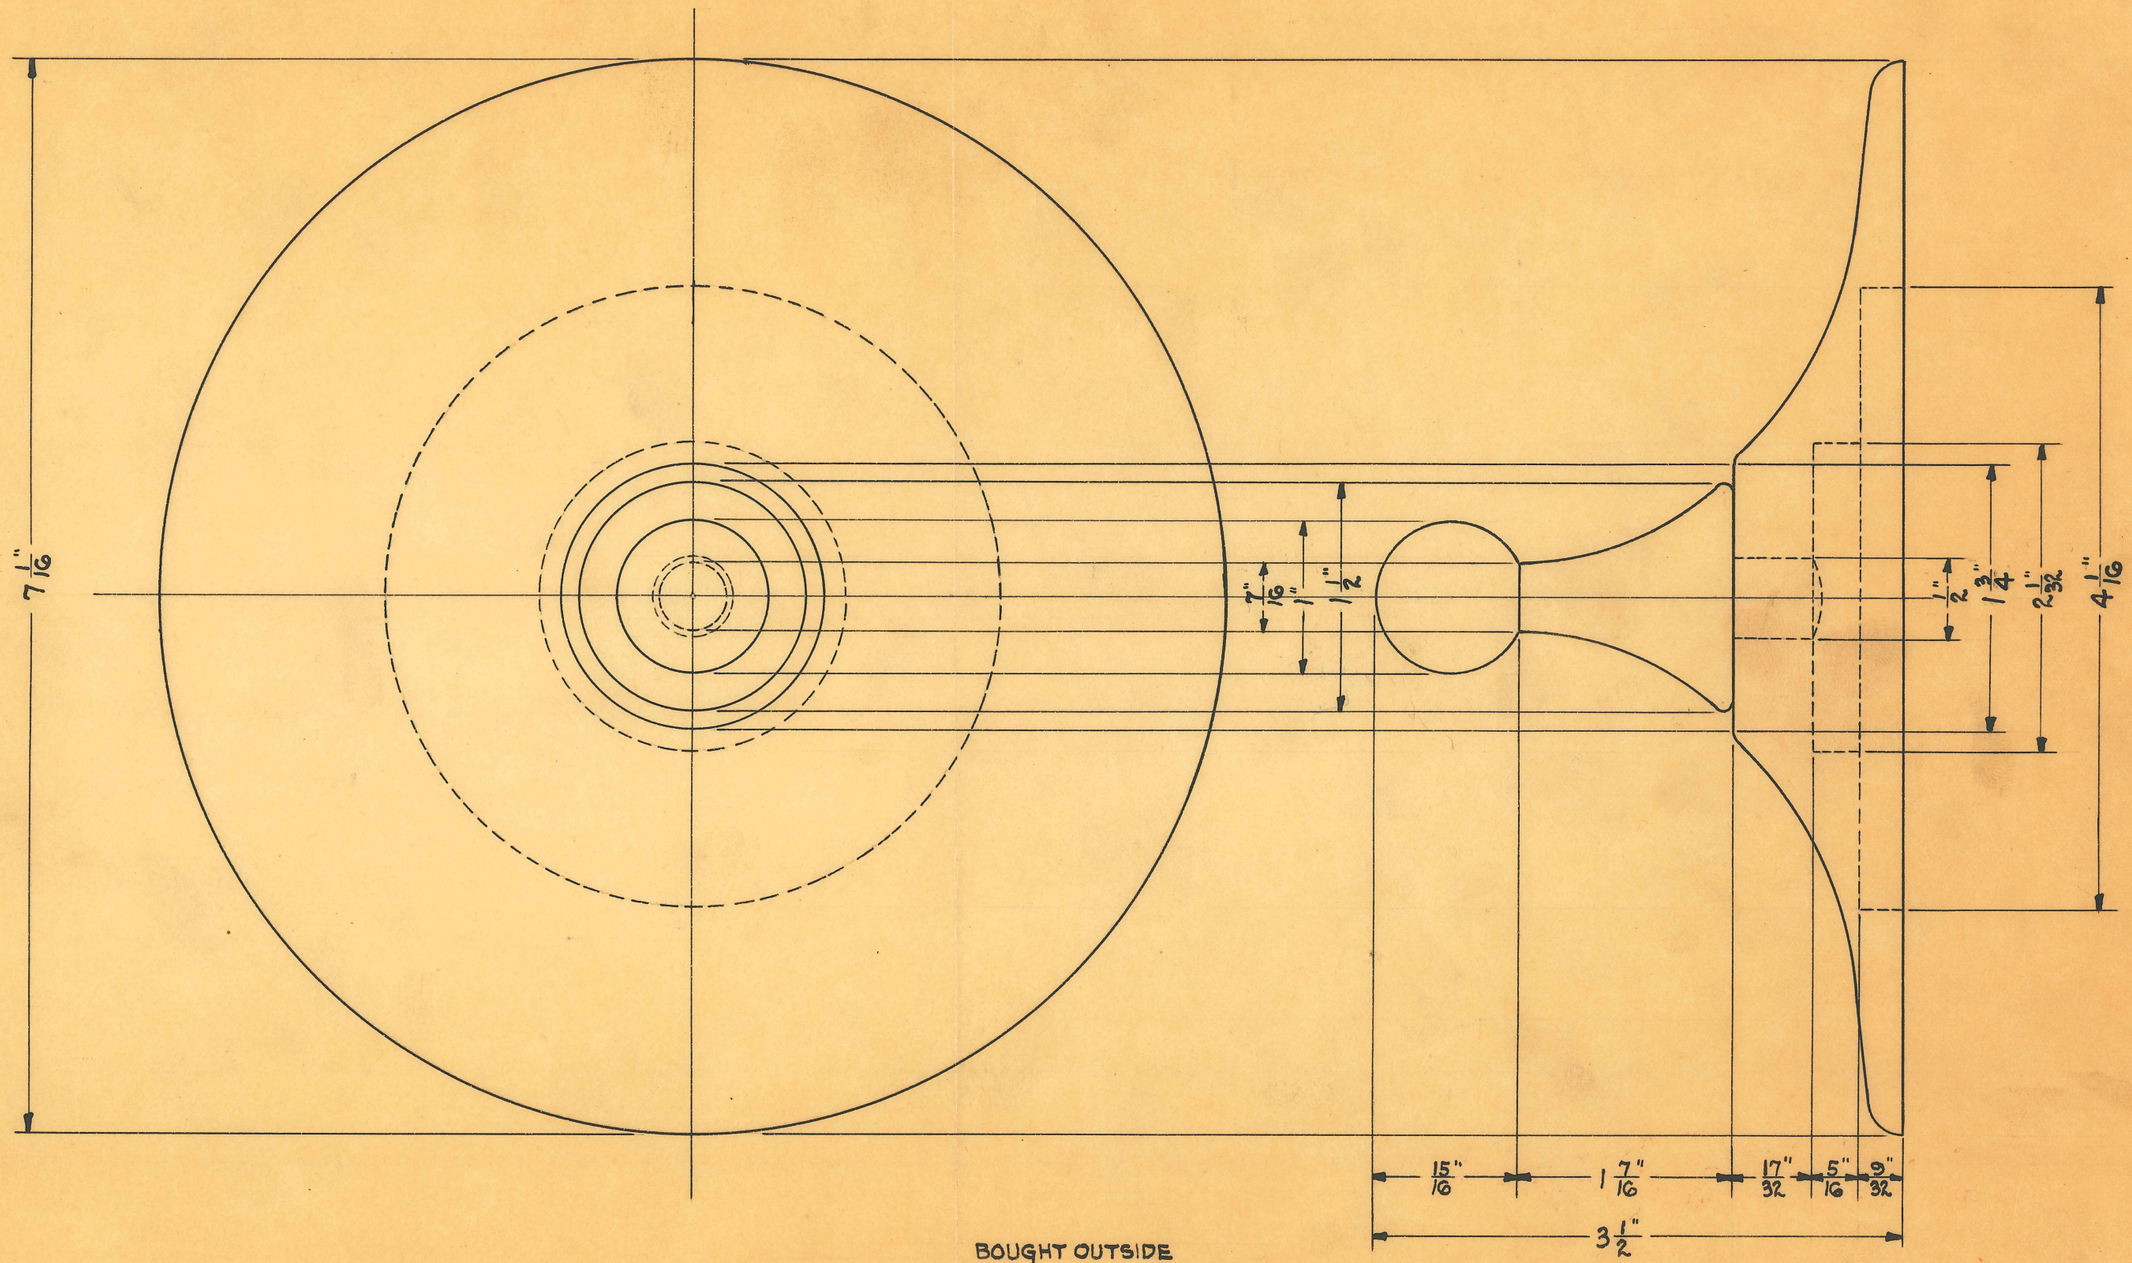

BOUGHT OUTSIDE

SIZE		ISSUE H.E.	3-6-30	TITLE: FISCHER ADJ. ELEC. SUPPORT WOOD BASE OBSOLETE
KIND		CHANGED		
SHAPE		" "		
FINISH		" "		
TEMP.		" "		H. G. FISCHER & CO. 2335 WABANSIA AVE. CHICAGO, ILL.
PATT.		" "		CAT. NO.
				PART NO. 3976

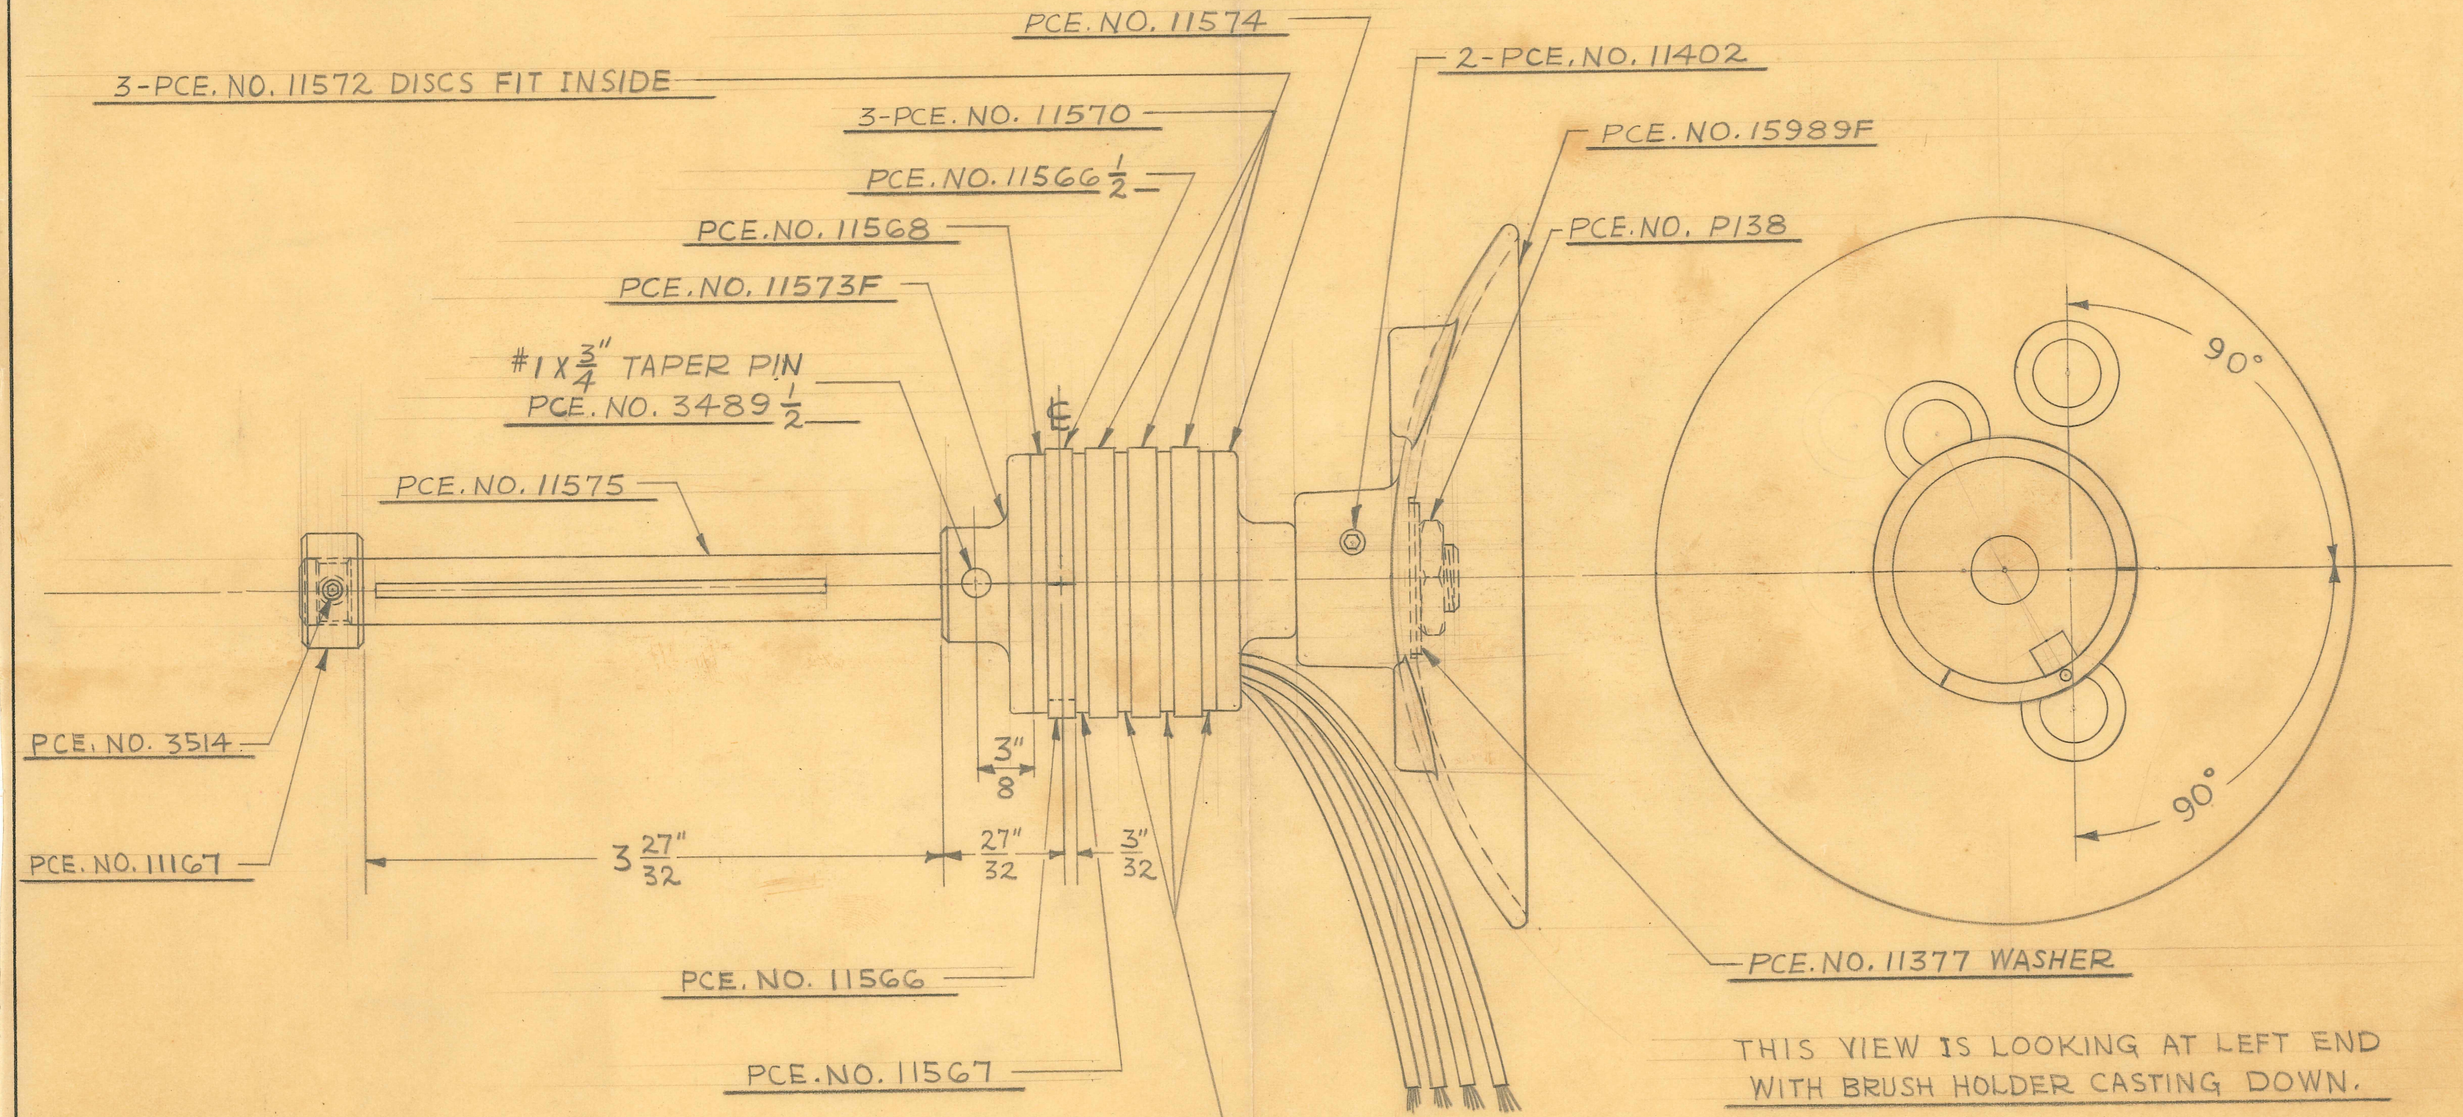

THIS VIEW IS LOOKING AT LEFT END WITH BRUSH HOLDER CASTING DOWN.

BRUSH HOLDER CASTING ASSEMBLED ON SHAFT IN CONNECTION WITH SPLIT RING AS SHOWN

OBSOLETE

SIZE		ISSUE 2-25-46	J.V.W.
KIND		CHANGED	
SHAPE		"	
FINISH		"	
TEMP.		"	
PATT.		"	

TITLE: FISCHER MOD. "J" GALV. & CONT. CURR. GEN. SURGE UNIT-COLLECTOR RING ASSEMBLY

H. G. FISCHER & CO.
2335 WABANSIA AVE.
CHICAGO, ILL.

CAT. NO.

PART NO. 15988G

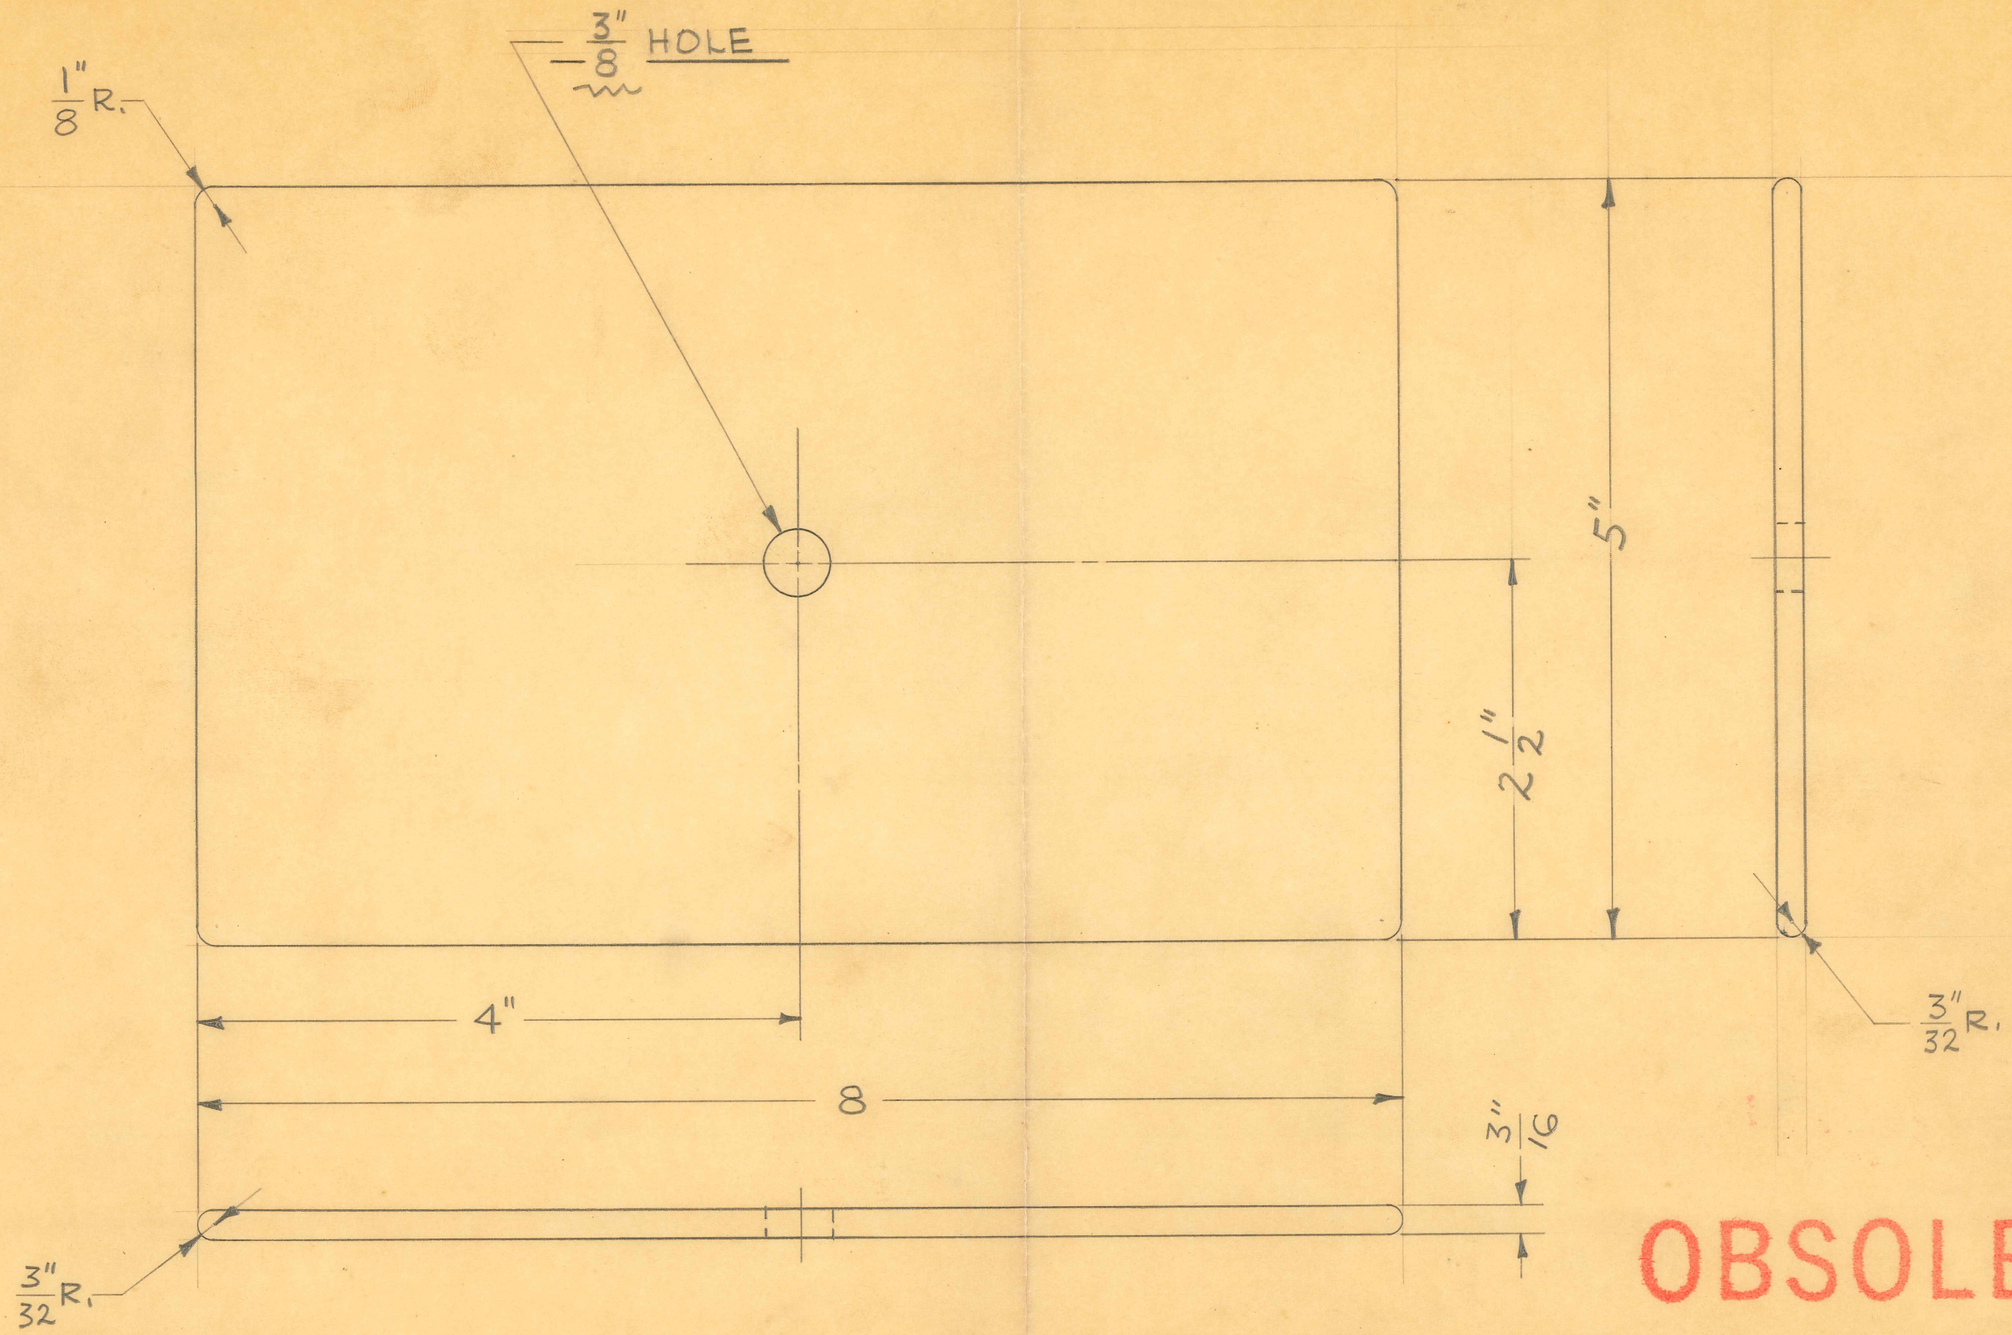

OBSOLETE

SIZE		ISSUE 6-19-47	J.V.W.	TITLE: FISCHER MOD. "J" GALV. & CONT. CURR. GEN. ELECT. PAD 5"X8"
KIND		CHANGED		
SHAPE		"		
FINISH		"		
TEMP.		"		H. G. FISCHER & CO. 2335 WABANSIA AVE. CHICAGO, ILL. — CAT. NO. — PART NO. 16454
PATT.		"		

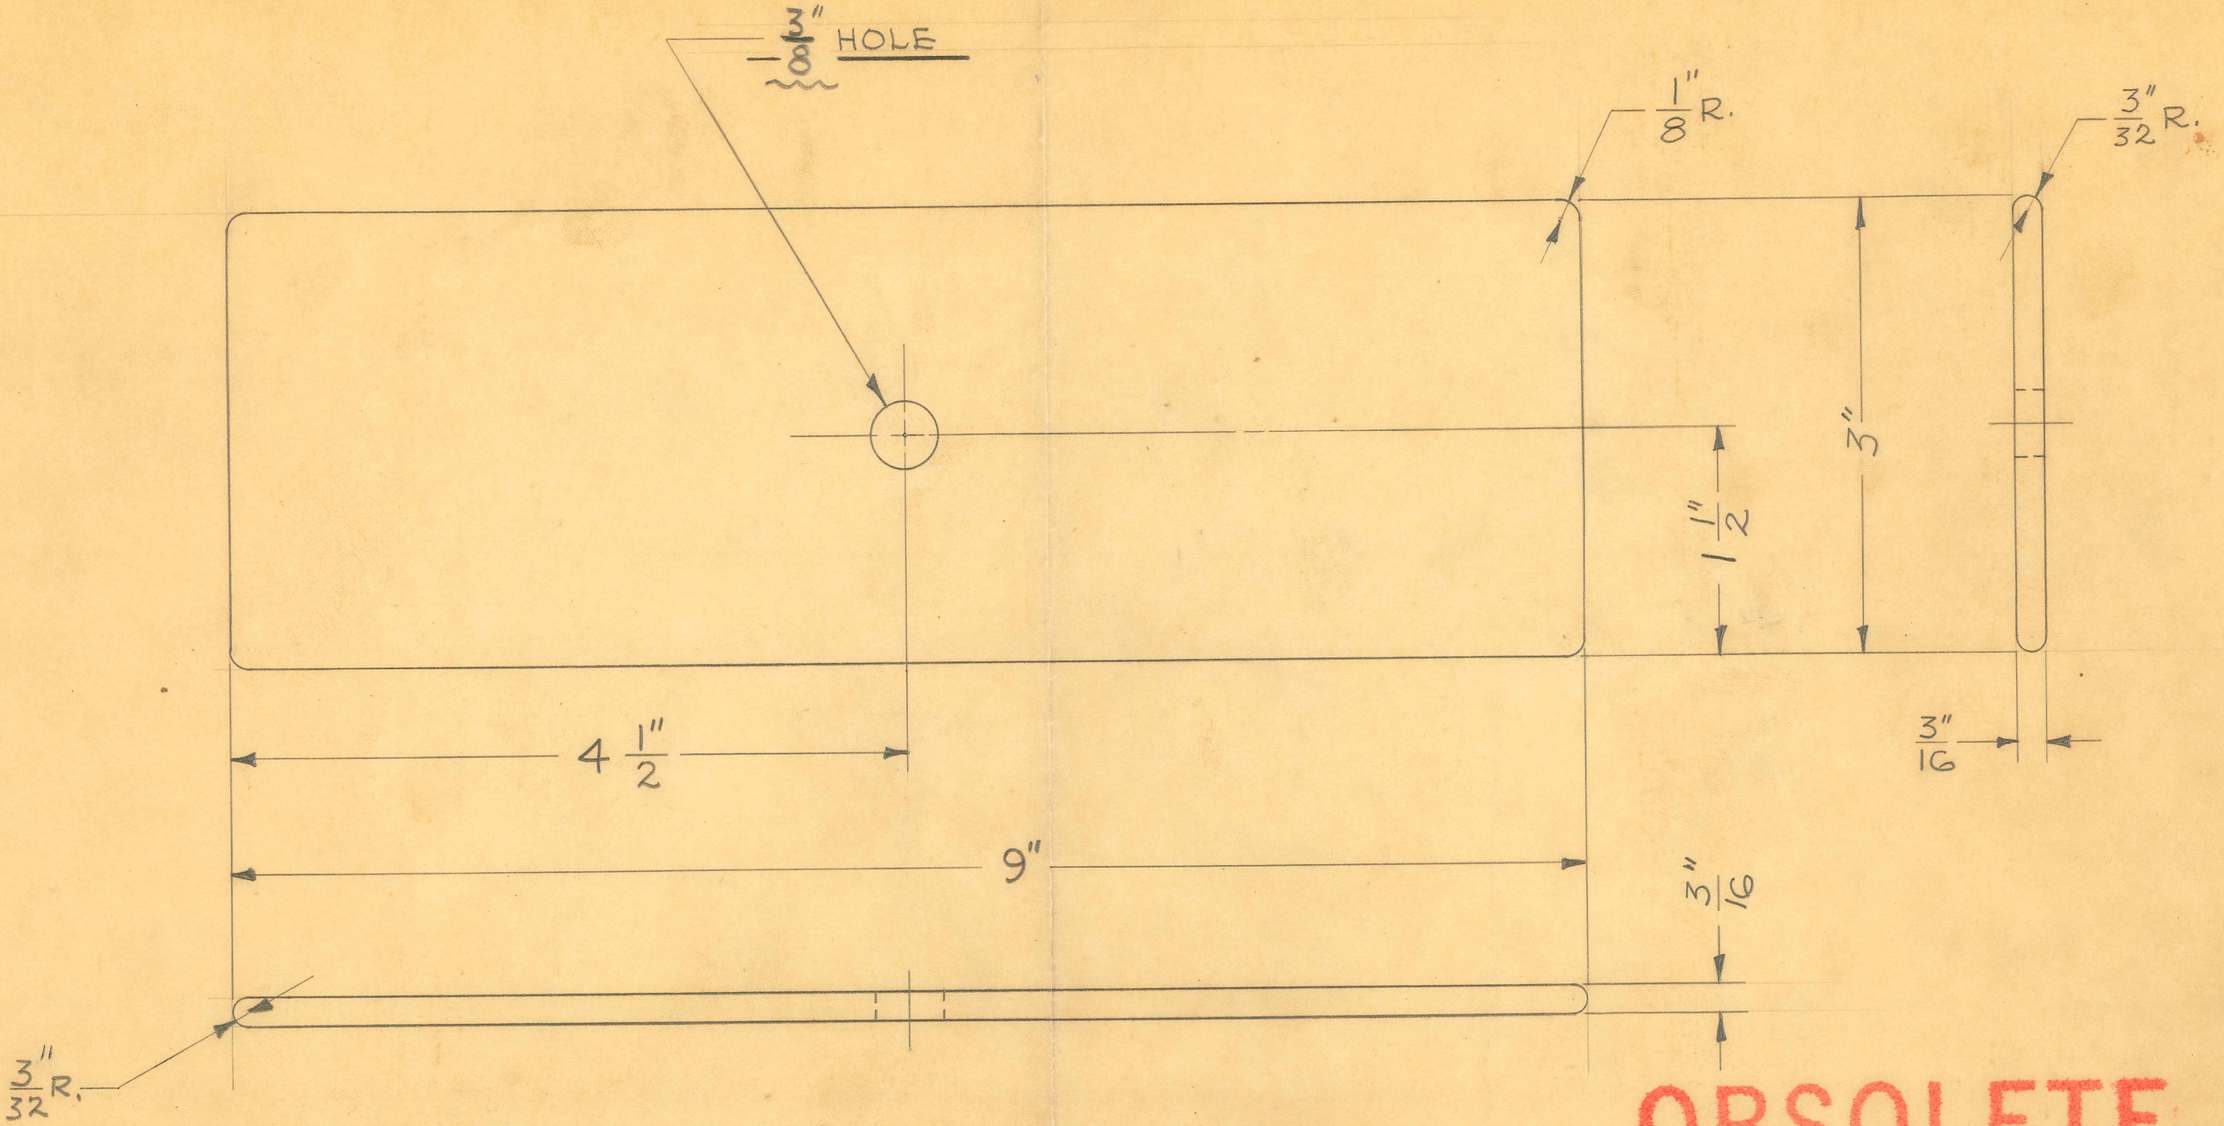

OBSOLETE

SIZE		ISSUE 6-19-47	J.V.W.
KIND		CHANGED	
SHAPE		"	
FINISH		"	
TEMP.		"	
PATT.		"	

TITLE: FISCHER MOD. "J" GALV. & CONT. CURR GEN. ELECT. PAD 3"X9"

H. G. FISCHER & CO.
2333 WABANSIA AVE.
CHICAGO, ILL.

CAT. NO.

PART NO. 16453

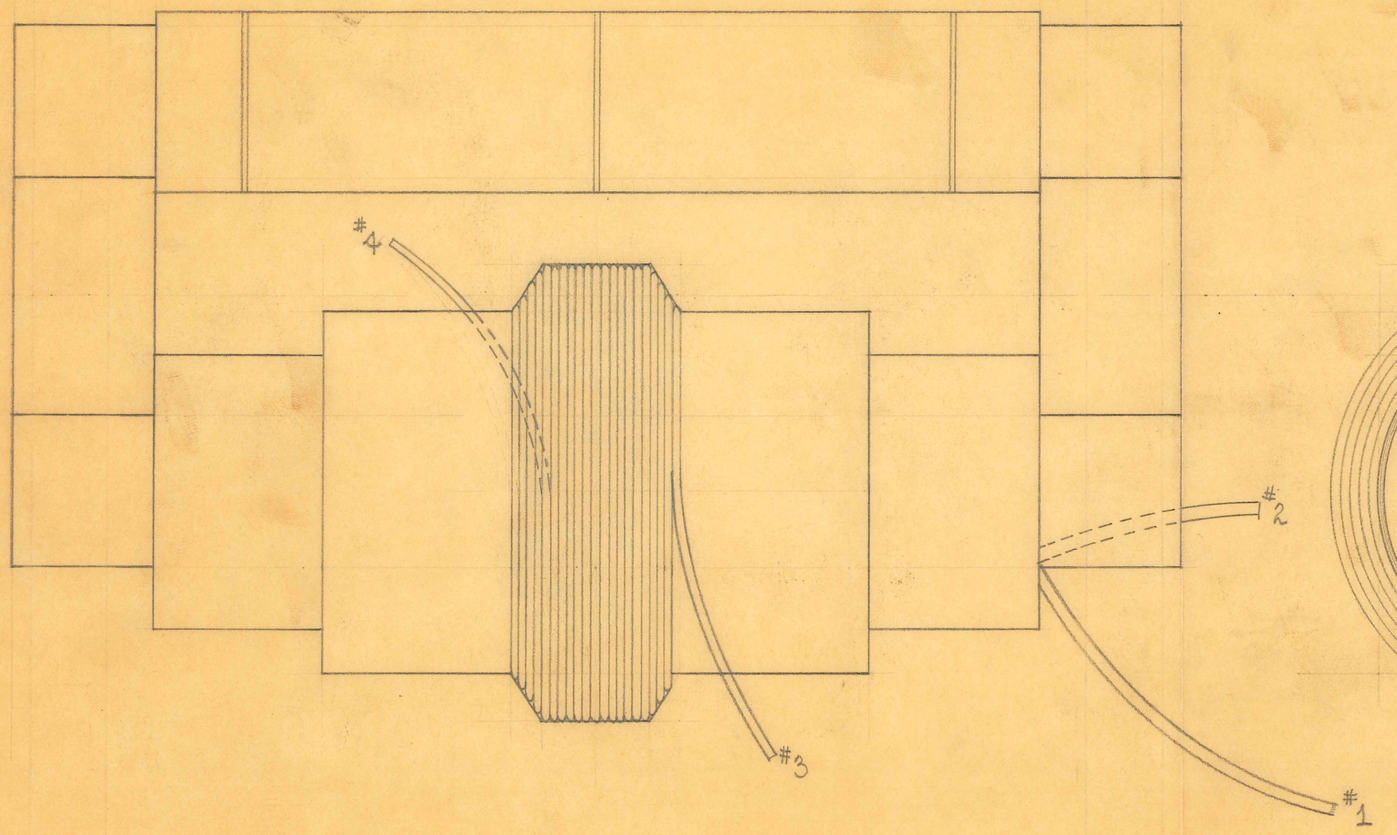

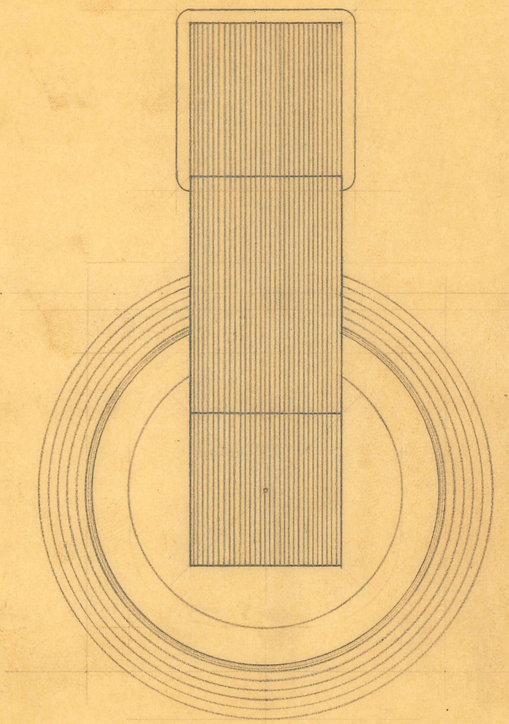

STEEL SIZE

PC. NO. 5043

CORE LAMS. CUT 6 13/16" X 1" BUILT UP TO 1".
END PIECES CUT 2 9/16" X 15/16"
BIND CORES WITH FRICTION TAPE.

WINDING DATA

PRIMARY

USE #24 ENAMEL WIRE

3 LAYER OF 5024 FIBROID PAPER ON CORE. ANCHOR LEAD #1 WITH FRICTION TAPE AND WIND 700 TURNS (ABOUT 200 TURNS PER LAYER). 1 LAYER OF FIBROID PAPER BETWEEN EACH LAYER OF WIRE. ANCHOR END WITH FRICTION TAPE - LEAD #2. LEADS ARE 12" EACH OF 1648 - #20 WEATHERPROOF WIRE. COVER PRI. WITH 15 LAYERS OF 5026 OILED CLOTH CUT 5 7/8", 45 FEET OF 5020 FIBROID PAPER (EQUAL TO 1/4" THICK) AND 12 LAYERS OF 5026 OILED CLOTH CUT 3 1/2". 3 FIBROID & 3 1/2" OILED CLOTH MUST BE IN CENTER OF CORE.

SECONDARY

USE #16 COTENAMEL WIRE

WINDING MUST BE IN CENTER OF CORE. ANCHOR LEAD #3 WITH FRICTION TAPE AND WIND 1 LAYER OF 18 TURNS, 1 LAYER OF 16 TURNS, 1 LAYER OF 15 TURNS, 1 LAYER OF 14 TURNS & 1 LAYER OF 12 TURNS. ANCHOR END WITH FRICTION TAPE - LEAD #4.

WRAP OTHER CORE WITH 10 LAYERS OF 5026 OILED CLOTH CUT 5 7/8" AND TIE IN 3 PLACES WITH STORE STRING.

OBSOLETE

SIZE		ISSUE 3-22-32	H.E.
KIND		CHANGED	
SHAPE		" "	
FINISH		" "	
TEMP.		" "	
PATT.		" "	

TITLE: COOLIDGE FILAMENT TRANSFORMER

H. G. FISCHER & CO.
2335 WABANSIA AVE.
CHICAGO, ILL.

CAT. NO.

PART NO. 1181G

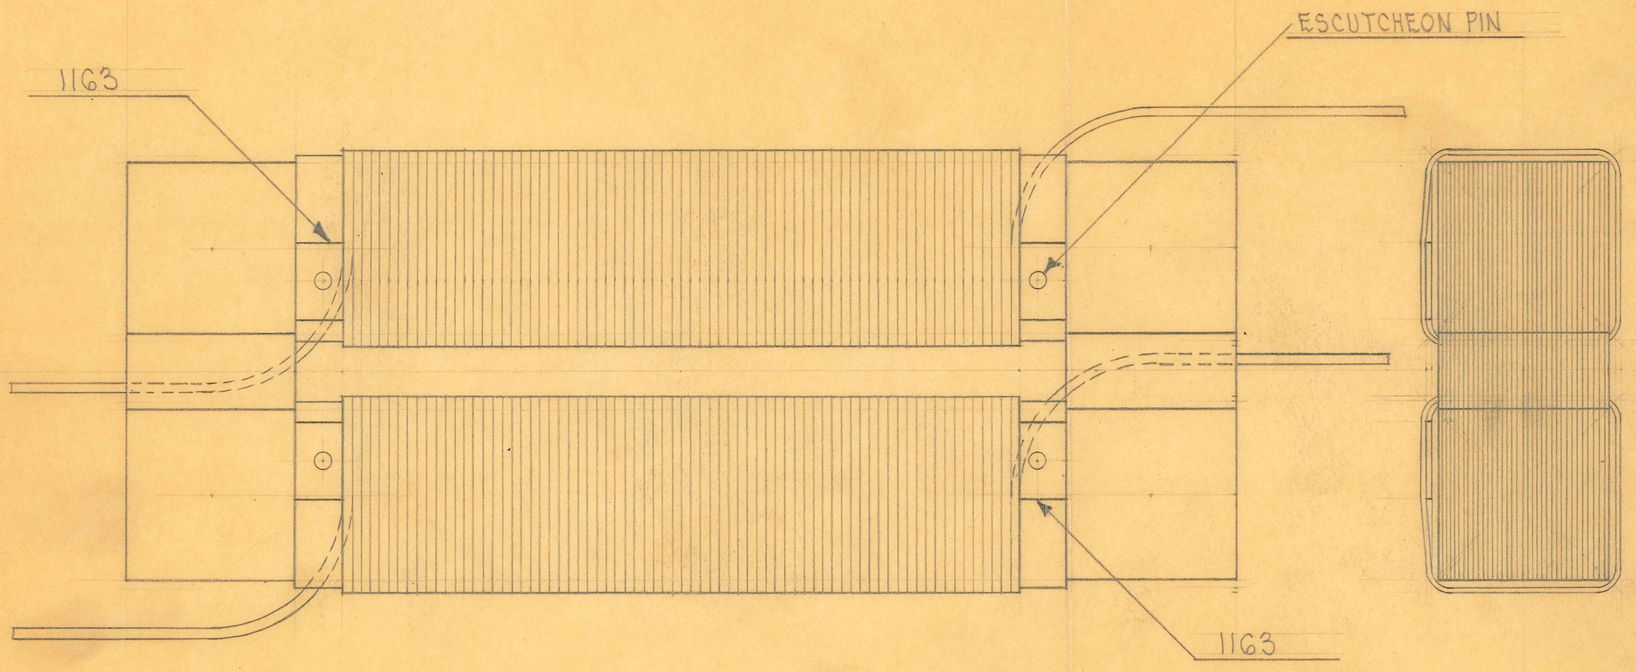

STEEL SIZES

PC. NO. 5043

CORE LAMS. CUT $6\frac{1}{4}$" X $1\frac{1}{8}$" BUILT UP TO $1\frac{1}{8}$".
END PIECES CUT $1\frac{5}{8}$" X $1\frac{1}{8}$".
BIND CORES WITH FRICTION TAPE.

WINDING DATA

3 LAYERS OF 5021 FIBROID PAPER, CUT $5\frac{1}{8}$" ON EACH CORE. PLACE 1-1163 STRIP ON TOP OF PAPER ON EACH CORE AS SHOWN AND HOLD DOWN WITH TAPE WHILE DRILLING HOLES FOR ESCUTCHEON PINS.
USE #22 ENAMEL WIRE. ANCHOR 12" LEAD OF SAME WIRE WITH FRICTION TAPE ON OPPOSITE SIDE FROM FIBRE STRIP AND WIND ONE FULL LAYER ON EACH CORE. END WITH 12" LEAD OF SAME WIRE & ANCHOR WITH FRICTION TAPE ON SAME SIDE AS START LEAD. KEEP START & FINISH OF WINDING ABOUT $\frac{1}{16}$" FROM ESCUTCHEON PINS.

OBSOLETE

SIZE		ISSUE 3-28-32	J.E.	TITLE: COOLIDGE FILAMENT CONTROL
KIND		CHANGED		
SHAPE		" "		
FINISH		" "		
TEMP.		" "		H. G. FISCHER & CO. 2335 WABANSIA AVE. CHICAGO, ILL. — CAT. NO. — PART NO. 1169½G
PATT.		" "		

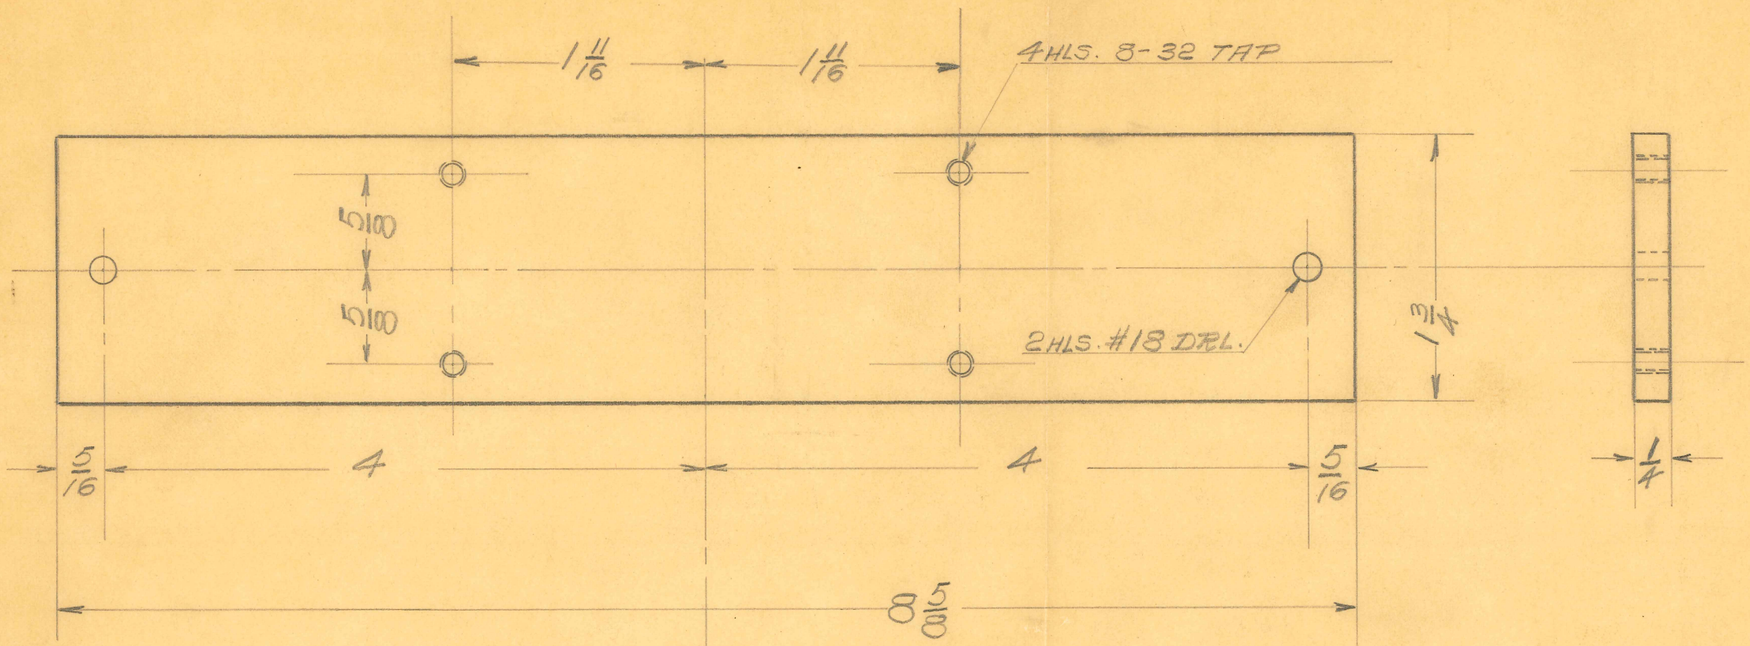

C.R. STEEL

1 REQ.

SCALE FULL SIZE

OBSOLETE

SIZE		ISSUE 6-15-31	C.M.	TITLE: HIGH FREQUENCY POTENTIOMETER CONDENSER BRACKET
KIND		CHANGED		
SHAPE		" "		
FINISH	W.P.	" "		
TEMP.		" "		H. G. FISCHER & CO. 2335 WABANSIA AVE. CHICAGO, ILL. — CAT. NO. — PART NO. 6620
PATT.		" "		

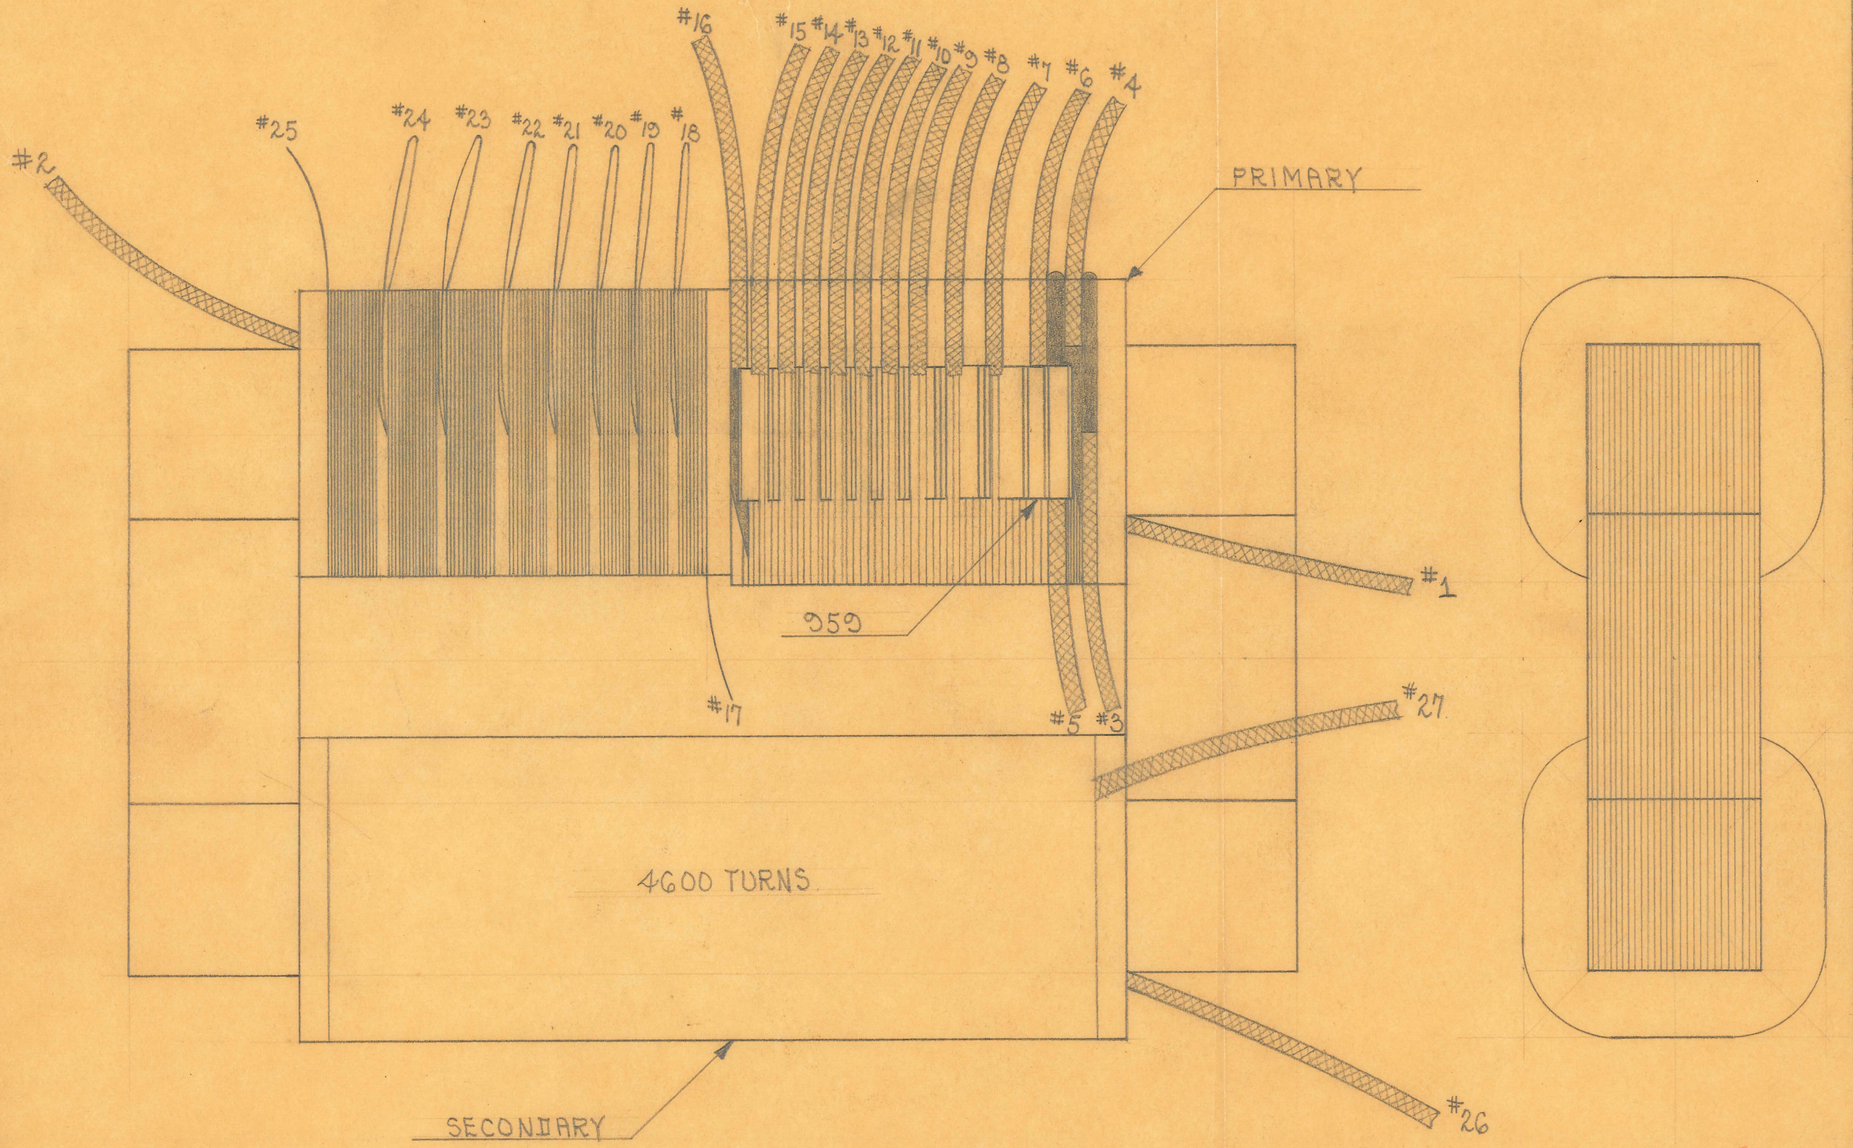

STEEL SIZES

PC. NO. 5043

PRI. & SEC. CORES CUT 6 $\frac{5}{8}$" X 1 $\frac{1}{8}$" BUILT UP TO 1 $\frac{1}{8}$". (JIG. #310)
END PIECES CUT 3" X 1 $\frac{1}{8}$"
BIND CORES WITH FRICTION TAPE.

WINDING DATA

PRIMARY

3 LAYERS OF 5021 $\frac{1}{2}$ FIBROID PAPER ON CORE. USE #20 ENAMEL WIRE. ANCHOR LEAD #1 WITH FRICTION TAPE AND WIND 400 TURNS (ABOUT 3 LAYERS) WITH 1 LAYER OF 5021 $\frac{1}{2}$ FIBROID PAPER BETWEEN EACH LAYER OF WIRE. ANCHOR END WITH FRICTION TAPE - LEAD #2. COVER WITH 3 LAYERS OF 5021 $\frac{1}{2}$ FIBROID PAPER.

SINUSOIDAL

ANCHOR LEAD #3 WITH FRICTION TAPE AND WIND 20 TURNS OF #26 COTENAMEL WIRE. ANCHOR END WITH FRICTION TAPE - LEAD #4.

CAUTERY & DIAGNOSTIC

ANCHOR LEAD #5 WITH FRICTION TAPE AND WIND, WITH #16 COTENAMEL WIRE, 3 TURNS & TAP - LEAD #6. WIND 1 TURN & TAP - LEAD #7. WIND 1 TURN & TAP - LEAD #8. WIND 1 TURN & TAP - LEAD #9. WIND 1 TURN & TAP - LEAD #10. WIND 2 TURNS & TAP LEAD #11. WIND 2 TURNS & TAP - LEAD #12. WIND 3 TURNS & TAP - LEAD #13. WIND 3 TURNS & TAP - LEAD #14. WIND 4 TURNS & TAP - LEAD #15. WIND 5 TURNS & ANCHOR END WITH FRICTION TAPE - LEAD #16. TAPS #6 TO #15 INCL. EACH INSULATED WITH 1 - 959 FIBRE SEPARATOR.

SINUSOIDAL

USE #26 C.E. WIRE. ANCHOR LEAD #17 WITH FRICTION TAPE & WIND 7 TURNS & BRING OUT TAP #18. ANCHOR WITH LINEN TAPE. WIND 8 TURNS & BRING OUT TAP #19. ANCHOR WITH LINEN TAPE. WIND 9 TURNS & BRING OUT TAP #20.
" " " " " 10 " " " " " #21.
" " " " " 12 " " " " " #22.
" " " " " 15 " " " " " #23.
" " " " " 18 " " " " " #24.
" " " " " 20 " " ANCHOR END WITH LINEN TAPE - LEAD #25. SHELLAC TOP LAYER.
LEADS #1 - 16 INCL. ARE 1603 - #18 STRANDED WIRE.

SECONDARY

3 LAYER OF 5021 $\frac{1}{2}$ FIBROID PAPER ON CORE. USE #28 ENAMEL WIRE. ANCHOR LEAD #26 WITH FRICTION TAPE AND WIND 4600 TURNS, PLACING 1 LAYER OF FIBROID PAPER BETWEEN EACH LAYER OF WIRE. ANCHOR END WITH FRICTION TAPE - LEAD #27. COVER WITH 5004 OILED TAPE AND SHELLAC. LEADS ARE 1603 - #18 STRANDED WIRE.

SIZE		ISSUE 3-14-32	H.E.
KIND		CHANGED	
SHAPE		" "	
FINISH		" "	
TEMP.		" "	
PATT.		" "	

TITLE: "E" TRANSFORMER

OBSOLETE

H. G. FISCHER & CO.
2335 WABANSIA AVE.
CHICAGO, ILL.

CAT. NO.

PART NO. E 371 G

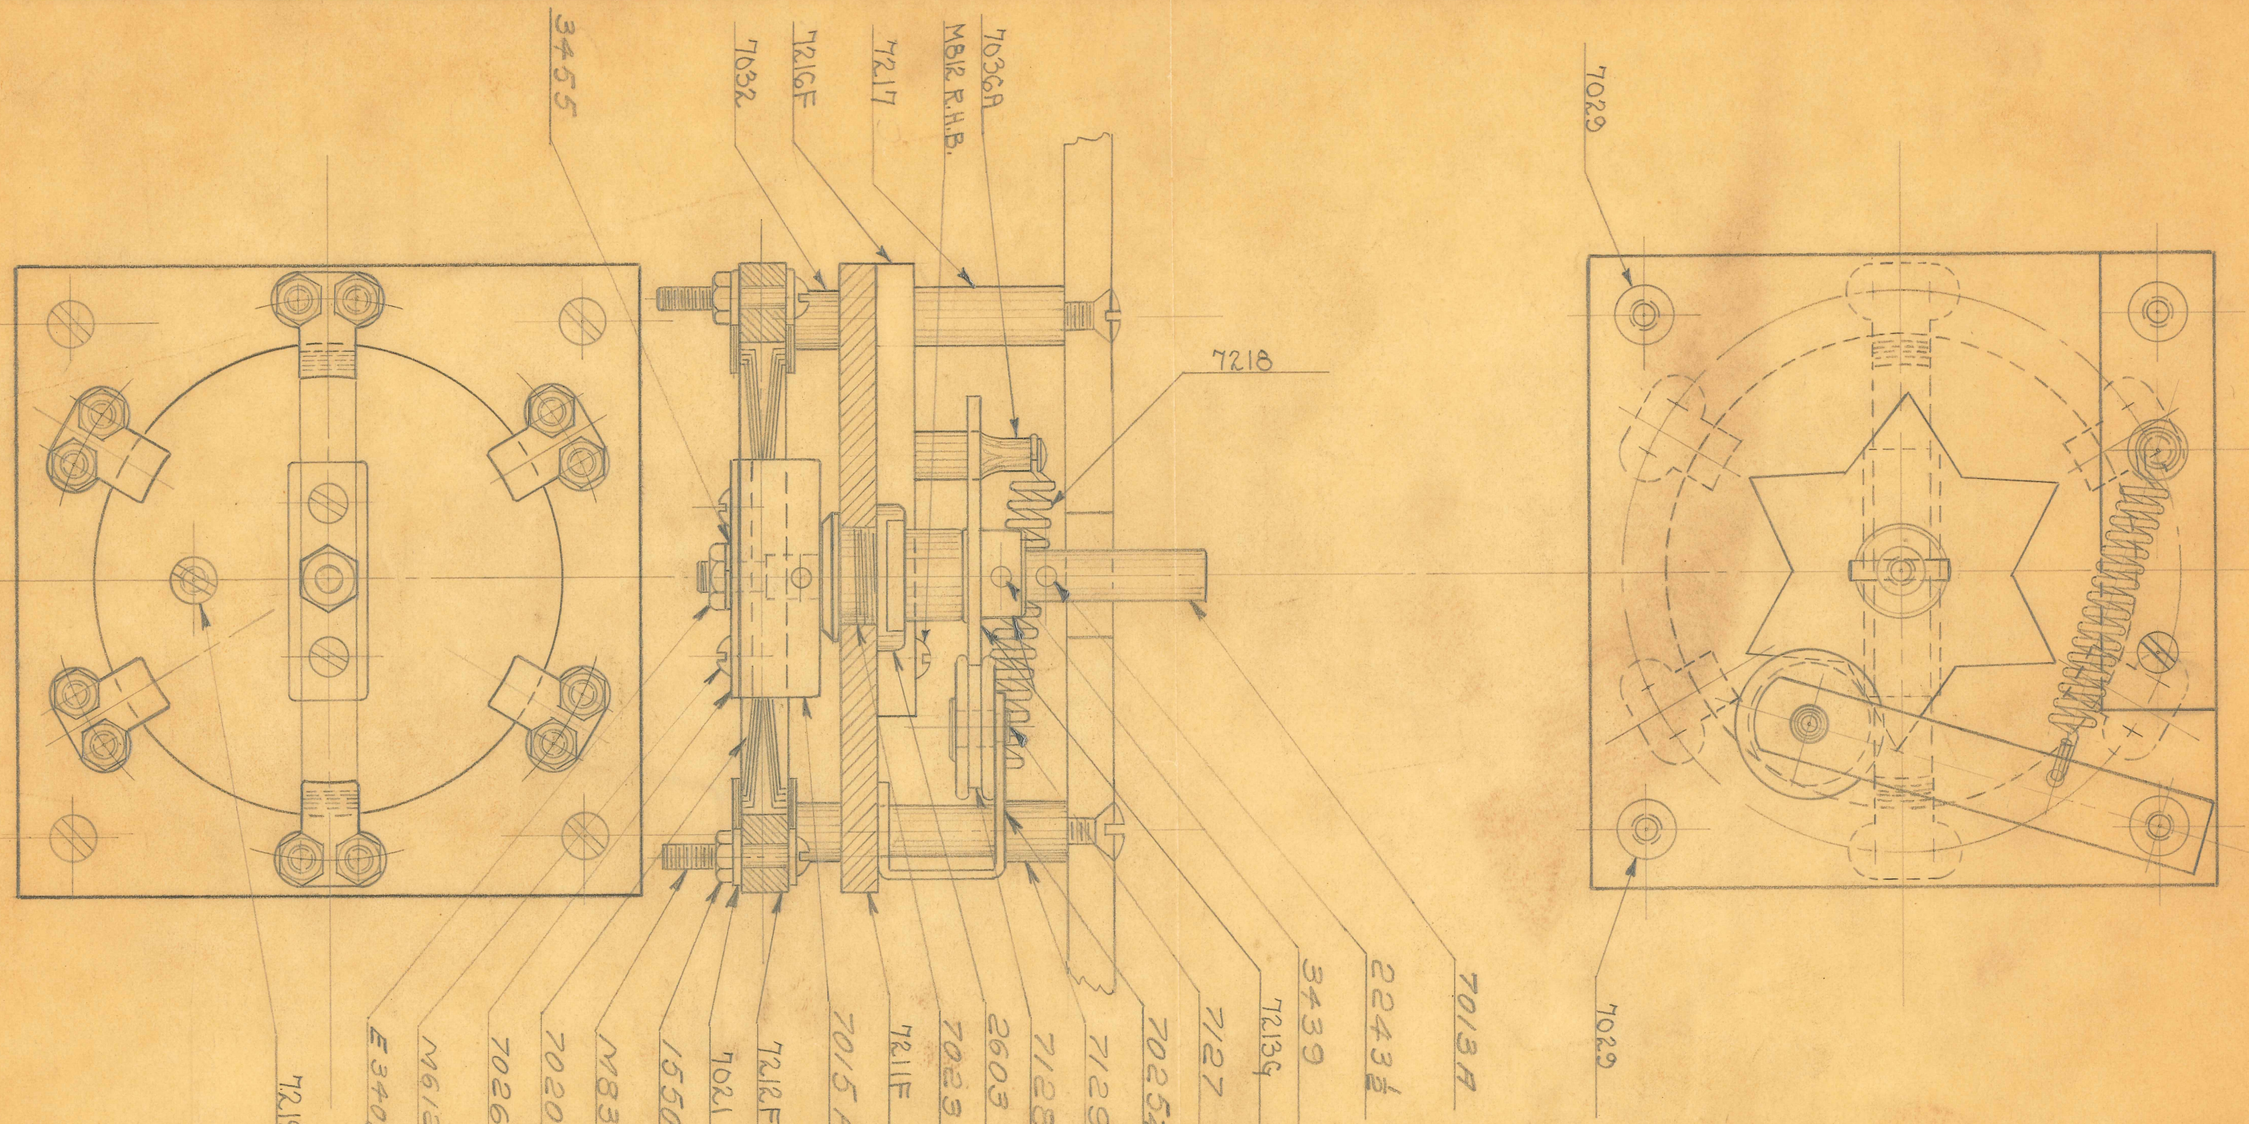

OBSOLETE

SIZE		ISSUE 5-26-31	C.M.	TITLE: FISCHER MODEL "SPD" UNIT METER SELECTOR SWITCH ASSEMBLY
KIND		CHANGED		
SHAPE		" "		
FINISH		" "		
TEMP.		" "		H. G. FISCHER & CO. 2335 WABANSIA AVE. CHICAGO, ILL. — CAT. NO. — PART NO. 7210G
PATT.		" "		

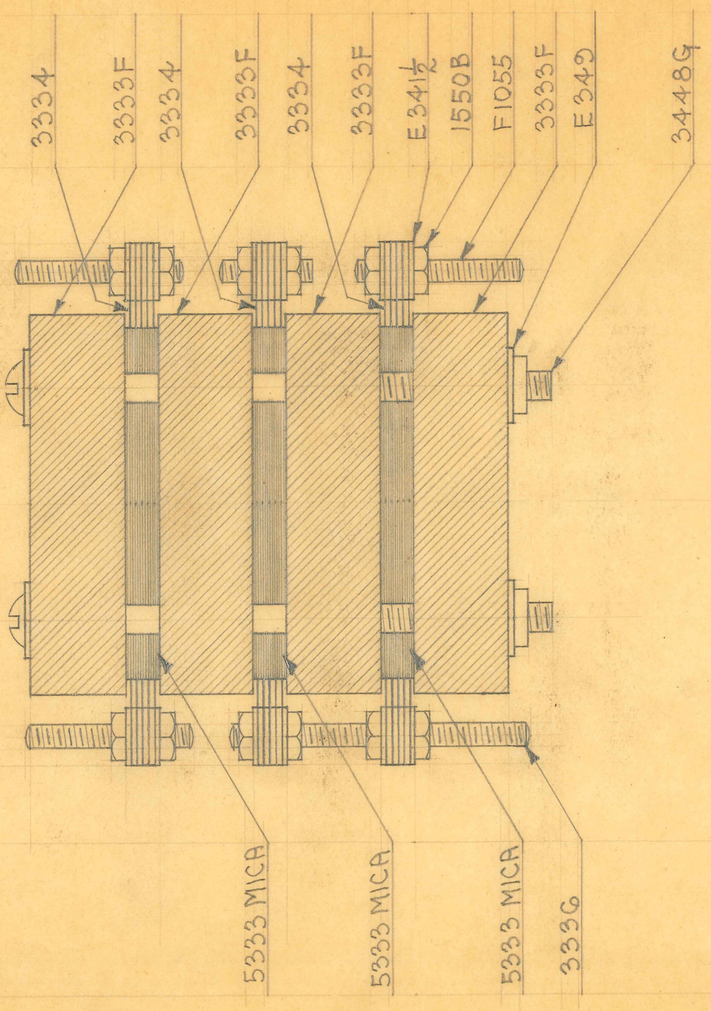

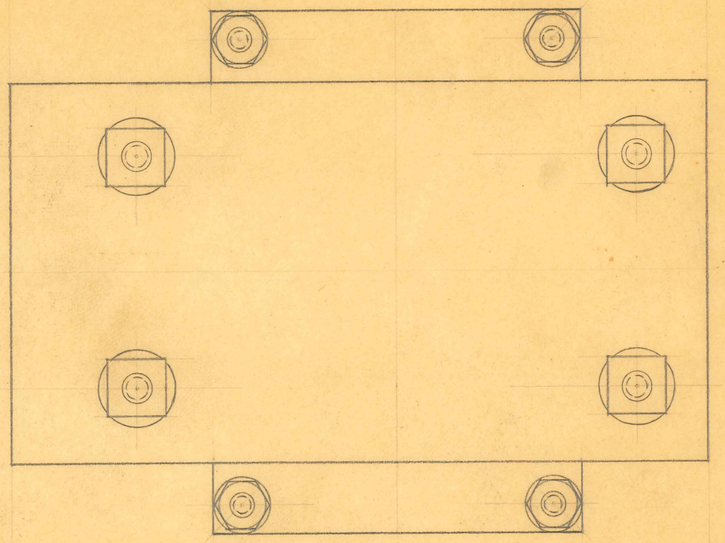

NOTE:-
MICA SPLIT TO .012" (4-7 SHEETS)
3-10 PLATE CONDS. JIG.# 4126

OBSOLETE

SIZE		ISSUE 3-2-32	A.E.	TITLE: FISCHER TISSUE CUTTING OUTFIT CONDENSER
KIND		CHANGED		
SHAPE		" "		
FINISH		" "		
TEMP.		" "		
PATT.		" "		

H. G. FISCHER & CO.
2335 WABANSIA AVE.
CHICAGO, ILL.

CAT. NO.

PART NO. 4626G

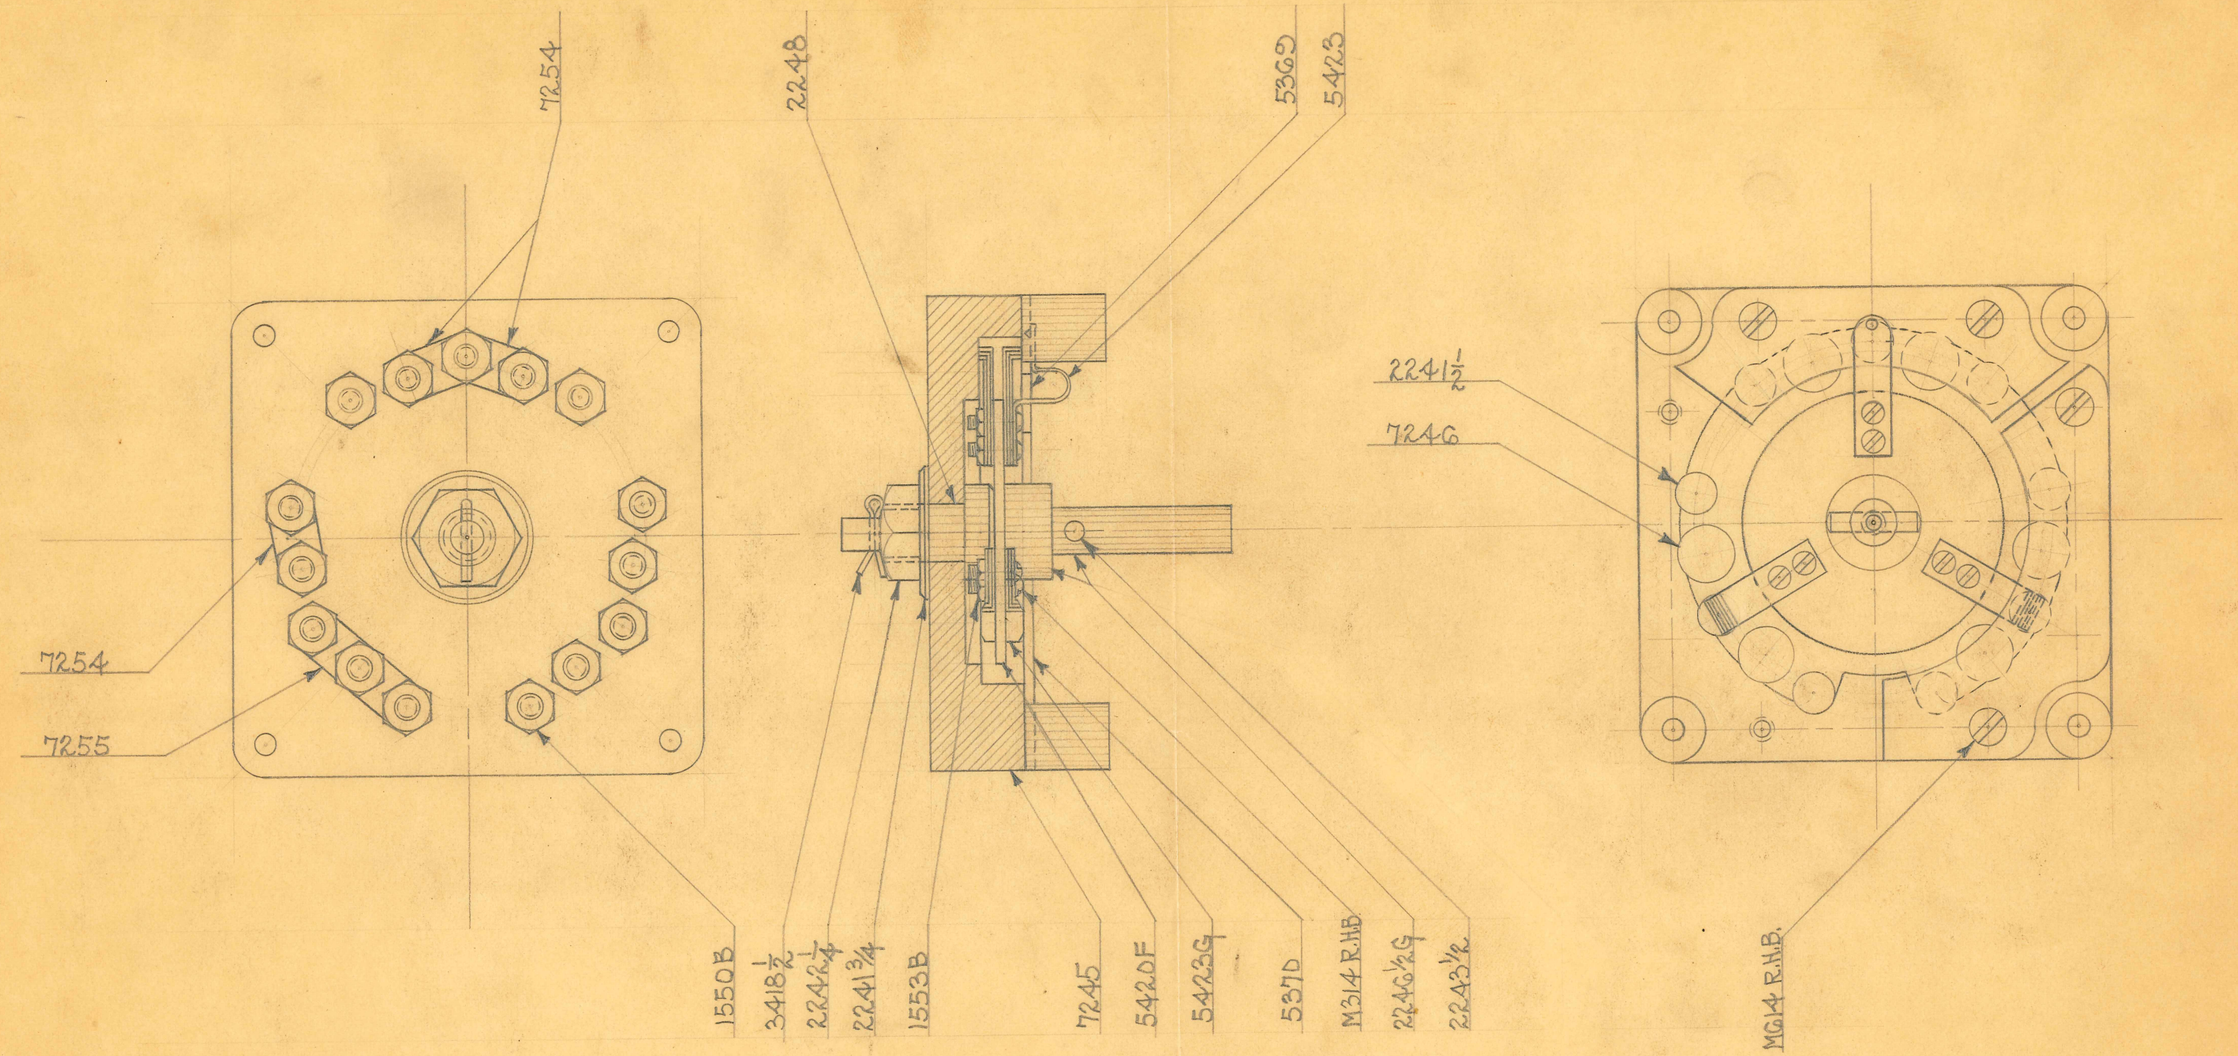

OBSOLETE

SIZE		ISSUE 1-5-32	H.E.
KIND		CHANGED	
SHAPE		" "	
FINISH		" "	
TEMP.		" "	
PATT.		" "	

TITLE: FISCHER MODEL "SPII" UNIT ACTIVE OUTLET SELECTOR SWITCH ASSEMBLY

H. G. FISCHER & CO.
2335 WABANSIA AVE.
CHICAGO, ILL.

CAT. NO.

PART NO. 7245G

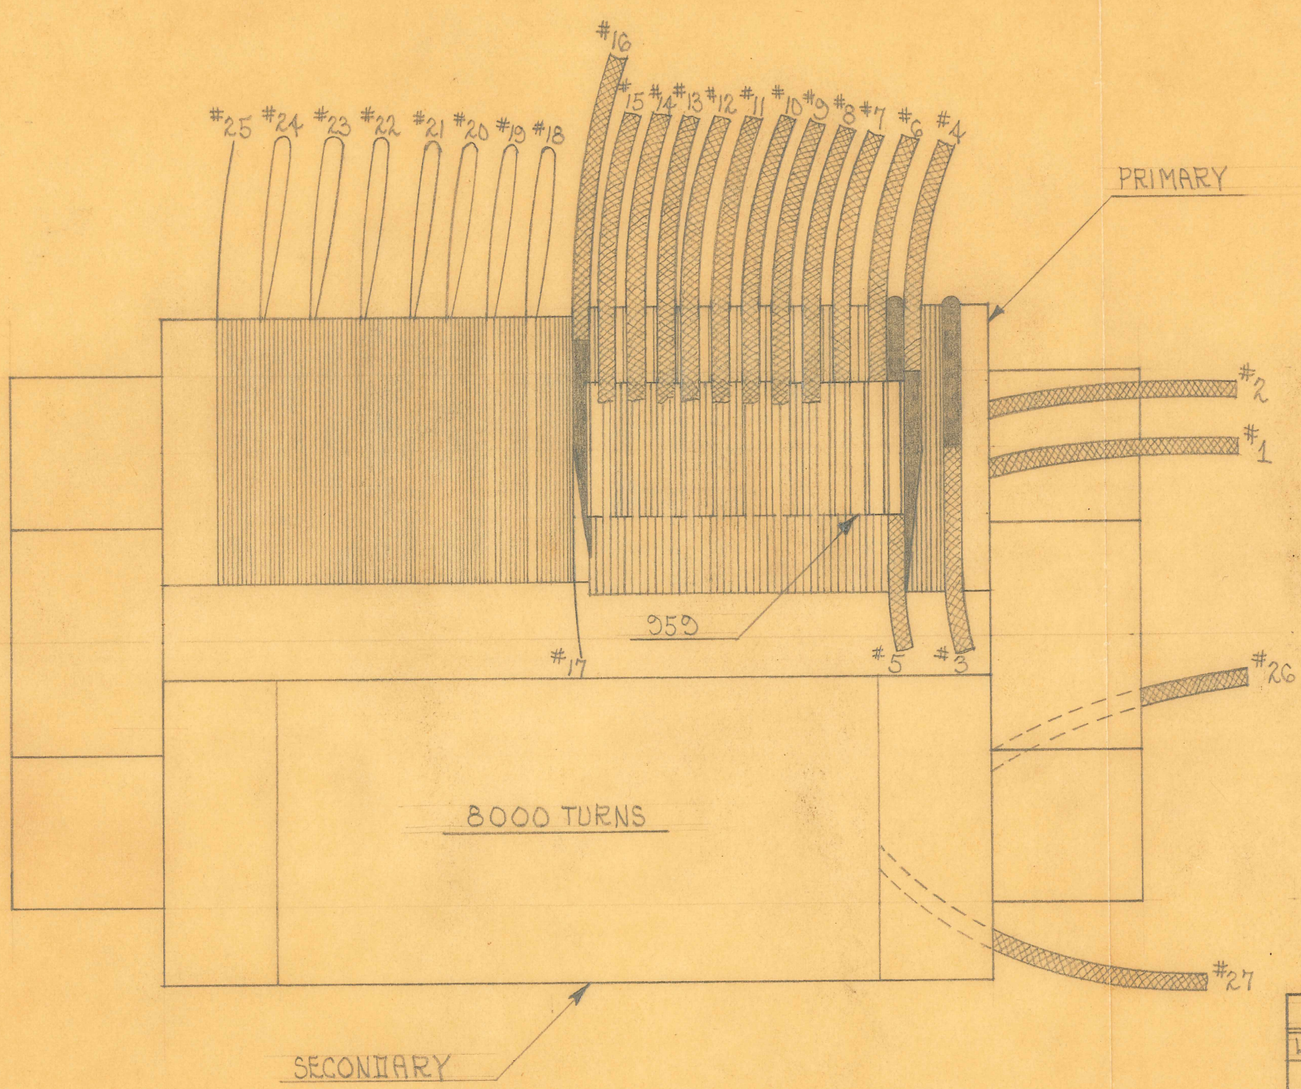

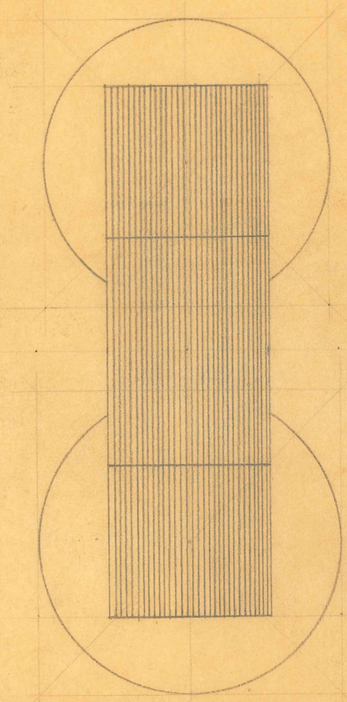

STEEL SIZES

PC. NO. 5043

PRI. & SEC. CORES CUT 6½" X 1" BUILT UP TO 1"
END PIECES CUT 2½" X 1".
BIND CORES WITH FRICTION TAPE.

WINDING DATA

PRIMARY

3 LAYERS OF 5021½ FIBROID PAPER ON CORE. USE #22 ENAMEL WIRE. ANCHOR LEAD #1 WITH FRICTION TAPE AND WIND 500 TURNS WITH 1 LAYER OF 5021½ FIBROID PAPER BETWEEN EACH LAYER OF WIRE. ANCHOR END WITH FRICTION TAPE - LEAD #2. COVER WITH 3 LAYERS OF 5021½ FIBROID PAPER.

SINUSOIDAL

ANCHOR LEAD #3 WITH FRICTION TAPE AND WIND 20 TURNS OF #26 COTENAMEL WIRE. ANCHOR END WITH FRICTION TAPE - LEAD #4.

CAUTERY & DIAGNOSTIC

ANCHOR LEAD #5 WITH FRICTION TAPE AND WIND, WITH #16 COTENAMEL WIRE, 3 TURNS & TAP-LEAD #6. WIND 1 TURN & TAP-LEAD #7. WIND 2 TURNS & TAP-LEAD #8. WIND 1 TURN & TAP-LEAD #9. WIND 2 TURNS & TAP-LEAD #10. WIND 2 TURNS & TAP-LEAD #11. WIND 3 TURNS & TAP-LEAD #12.
" 4 " " " - " #13. " 5 " " " - " #14.
" 6 " " " - " #15. " 6 " " ANCHOR END WITH FRICTION TAPE - LEAD #16. TAPS #6 TO #15 INCL. EACH INSULATED WITH 1-959 FIBRE SEPARATOR. LEADS #1 TO #16 INCL. ARE 1603-#18 STRANDED WIRE.

SINUSOIDAL

USE #26 C.E. WIRE. ANCHOR LEAD #17 WITH FRICTION TAPE & WIND 8 TURNS & BRING OUT TAP #18. ANCHOR WITH LINEN TAPE. WIND 9 TURNS & BRING OUT TAP #19. ANCHOR WITH LINEN TAPE. WIND 10 TURNS & BRING OUT TAP #20.
" " " " " 11 " " " " " #21.
" " " " " 12 " " " " " #22.
" " " " " 15 " " " " " #23.
" " " " " 17 " " " " " #24.
" " " " " 20 " " ANCHOR END WITH LINEN TAPE - LEAD #25. SHELLAC TOP LAYER.

SECONDARY

3 LAYERS OF 5021½ FIBROID PAPER ON CORE. USE #32 E. WIRE. ANCHOR LEAD #26 WITH FRICTION TAPE AND WIND 8000 TURNS (SEE CHART). ANCHOR END WITH FRICTION TAPE - LEAD #27. 1 LAYER OF 5021½ FIBROID PAPER BETWEEN EACH LAYER OF WIRE. COVER WITH 5004 OILED TAPE AND SHELLAC. LEADS ARE 1603-#18 STRANDED WIRE.

SECONDARY WINDING CHART

LAYER No.	WOUND TO	LAYER No.	WOUND TO
1	500	11	4950
2	930	12	5340
3	1470	13	5720
4	1940	14	6090
5	2400	15	6450
6	2850	16	6800
7	3290	17	7140
8	3720	18	7470
9	4140	19	7788
10	4550	20	8000

SIZE		ISSUE 4-11-32	H.E.	TITLE: "K" TRANSFORMER
KIND		CHANGED		
SHAPE		" "		
FINISH		" "		
TEMP.		" "		
PATT.		" "		

OBSOLETE

H. G. FISCHER & CO.
2335 WABANSIA AVE.
CHICAGO, ILL.

CAT. NO.

PART NO. 956G

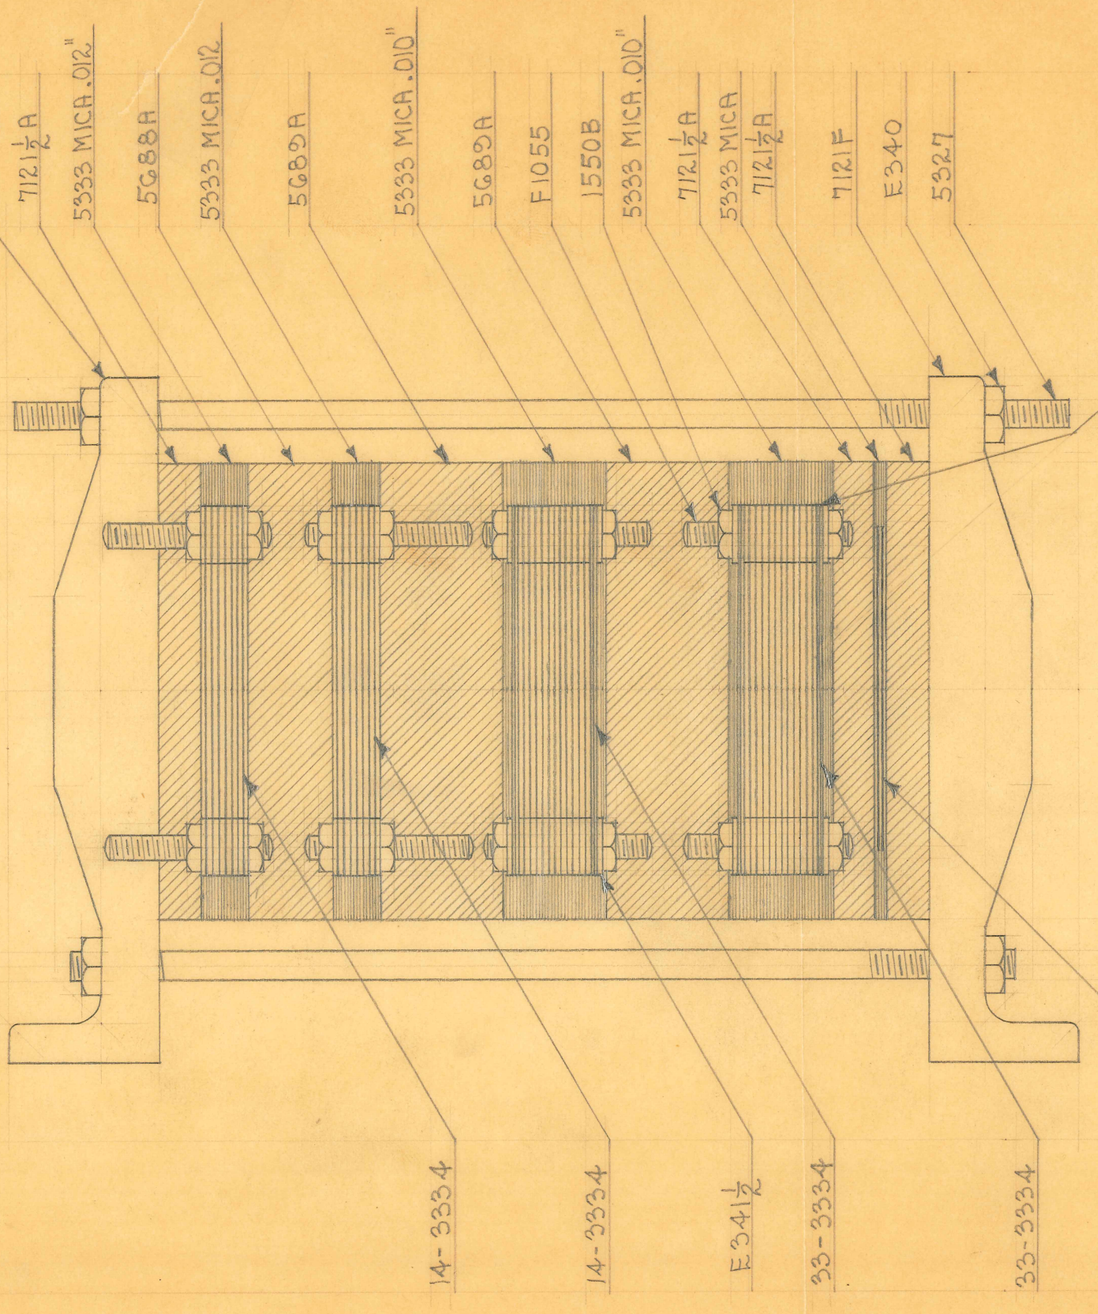

NOTE:- THERE ARE NO WASHERS BETWEEN FIRST THREE PLATES & LAST THREE PLATES ON BOTH SIDES OF 33 PLATE CONN., BUT ALL PLATES HAVE MICA BETWEEN THEM. IN PLATE SIDE OF EACH 33 PLATE CONN. SHOULD BE BOTH ON SAME SIDE.

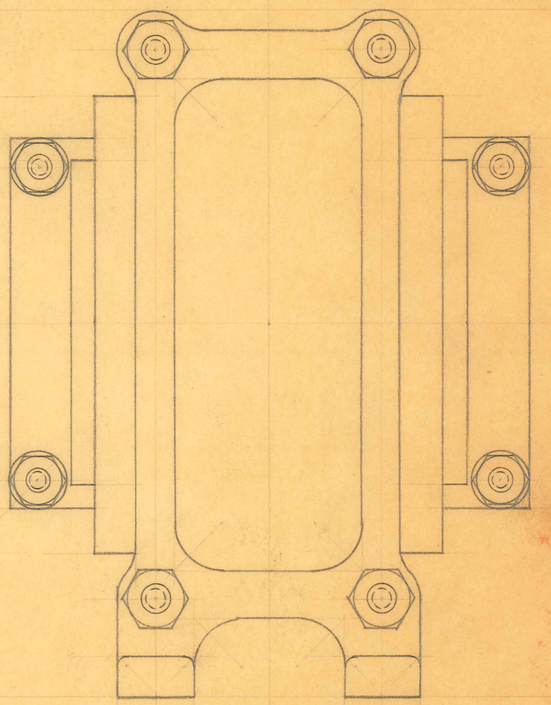

OBSOLETE

NOTE:-
MICA SPLIT TO .012" & .010" (SEE ABOVE)
2-14 PLATE CONNS. 2-33 PLATE CONNS. JIG #4126
1-3 PLATE GRN. CONN.
CONN. BUILDING FIXTURE TOOL #3229. GAUGE #3230-3231

SIZE		ISSUE 2-16-32	A.E.	TITLE: COMBINATION "Y" CONDENSER ASSEMBLY
KIND		CHANGED		
SHAPE		" "		
FINISH		" "		
TEMP.		" "		H. G. FISCHER & CO. 2335 WABANSIA AVE. CHICAGO, ILL. — CAT. NO. — PART NO. 3920½G
PATT.		" "		

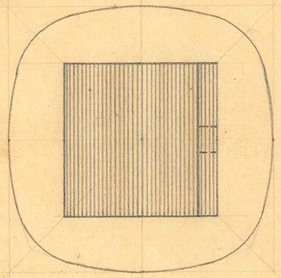

STEEL SIZES

PC. NO. 5043

CUT- $5\frac{1}{4}$" X 1" BUILT UP TO $\frac{7}{8}$".
CUT- $6\frac{1}{4}$" X 1" BUILT UP TO $\frac{1}{8}$"
BIND WITH FRICTION TAPE.

WINDING DATA

3 LAYERS OF 5021 FYBROID PAPER ON CORE. ANCHOR LEAD #1 WITH FRICTION TAPE & WIND 165 TURNS WITH #22 ENAMEL WIRE & BRING OUT TAP #2. WIND 165 TURNS & ANCHOR END OF #22 E. WIRE & START OF #24 E. WIRE WITH LINEN TAPE- TAP #3. WIND 2 LAYERS & BRING OUT TAP #4. WIND 2 LAYERS & BRING OUT TAP #5. WIND 1 LAYER & ANCHOR END WITH LINEN TAPE- LEAD #6. 1 LAYER OF FIBROID BETWEEN EACH LAYER OF WIRE. LEADS #1 & #6 ARE 1603- #18 STRANDED WIRE. SHELLAC WINDING.

OBSOLETE

SIZE		ISSUE 11-8-32	J.E.B.
KIND		CHANGED	
SHAPE		" "	
FINISH		" "	
TEMP.		" "	
PART		" "	

TITLE: "K" LINE CHOKE

H. G. FISCHER & CO.
2335 WABANSIA AVE.
CHICAGO, ILL.

CAT. NO.

PART NO. C639G

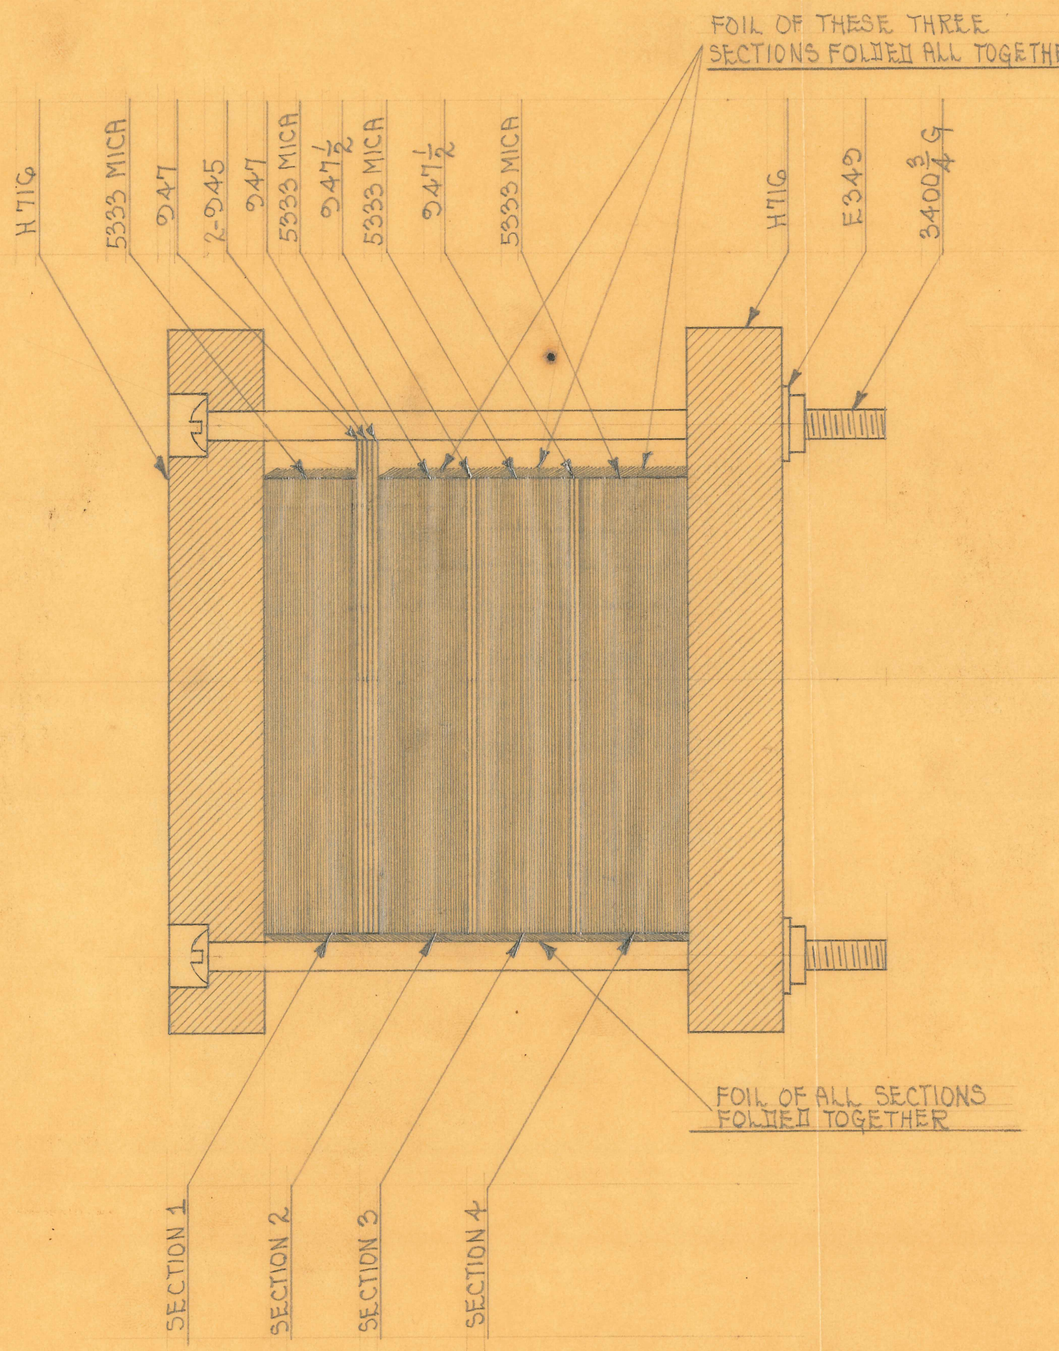

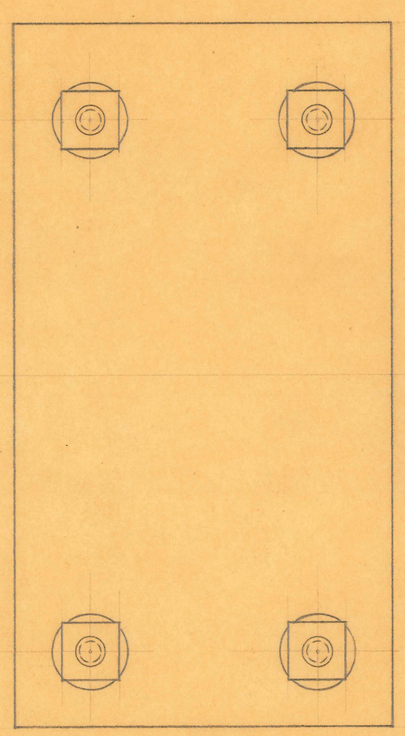

NOTE ~

MICA SPLIT TO .004 (AT LEAST 3 SHEETS)
SECT. 1 - 120 SHEETS OF 348 FOIL. 60 ON EACH SIDE.
SECTS. 2 & 3 - 125 SHEETS OF 348 FOIL. 63 ON ONE SIDE & 62 ON THE OTHER.
SECT. 4 - 126 SHEETS OF 348 FOIL. 63 ON EACH SIDE.

SIZE		ISSUE 2-29-32	H.E.
KIND		CHANGED	
SHAPE		" "	
FINISH		" "	
TEMP.		" "	
PATT.		" "	

TITLE: "H" CONDENSER

OBSOLETE

H. G. FISCHER & CO.
2335 WABANSIA AVE.
CHICAGO, ILL.

CAT. NO.

PART NO. H 716 G

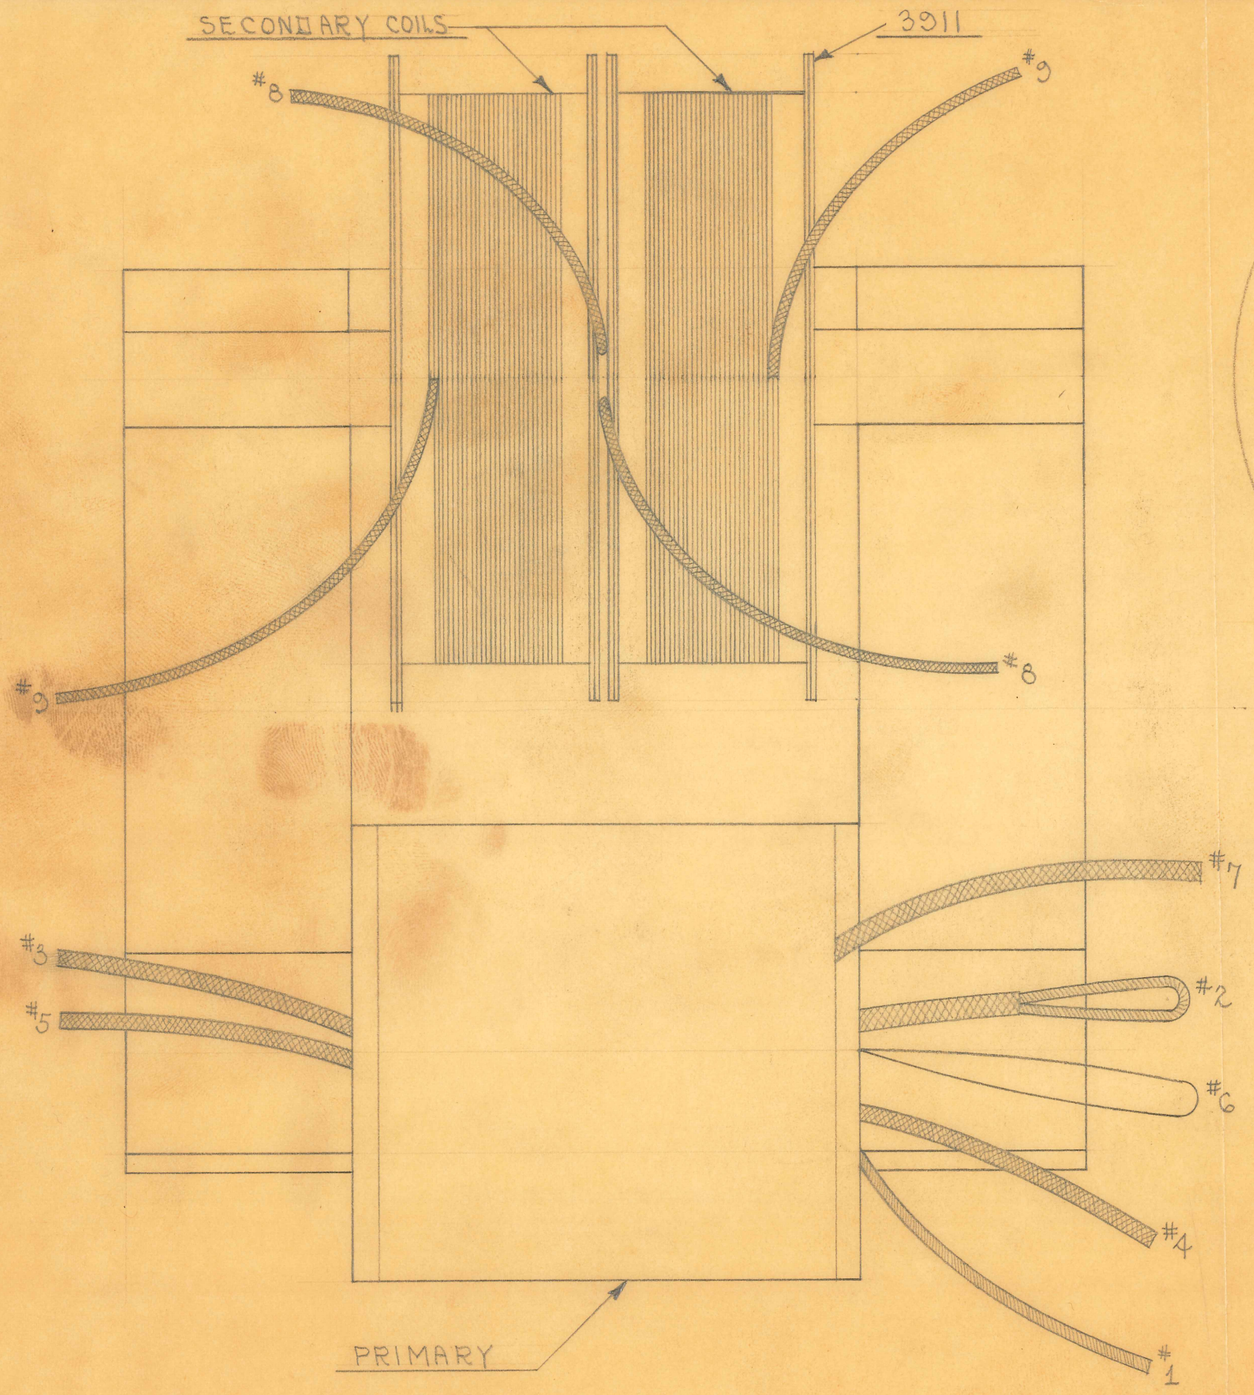

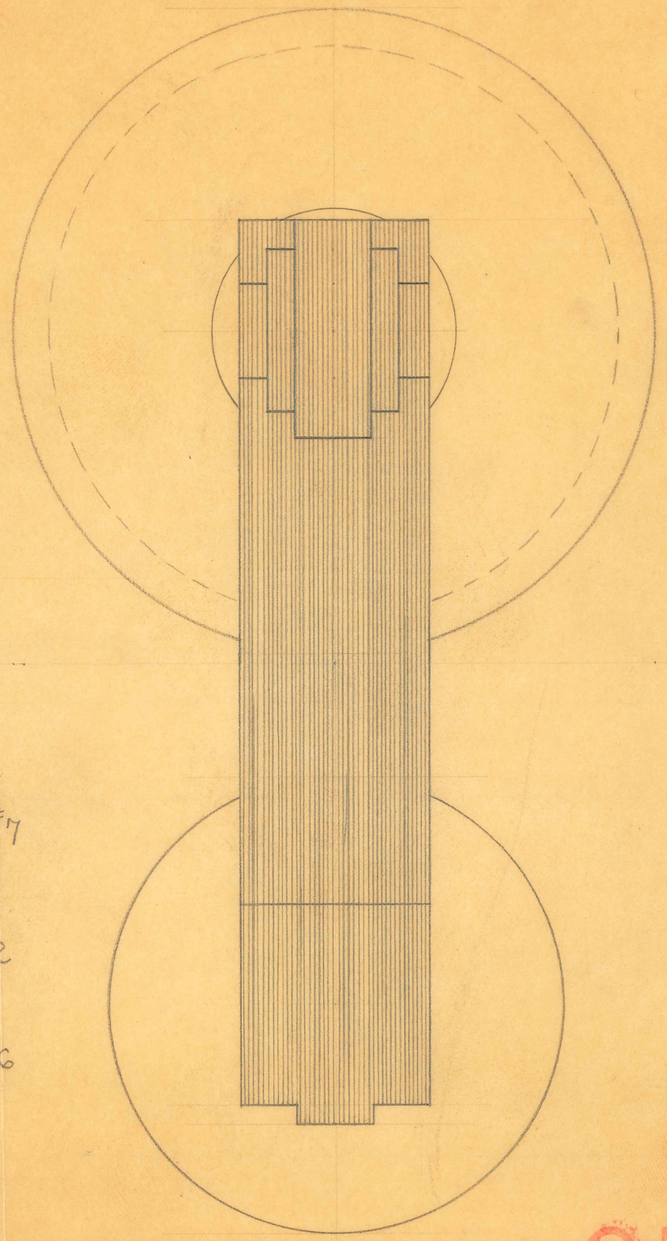

STEEL SIZES

PC. NO. 5043

PRI. CORE - $4\frac{7}{8}$" X $1\frac{5}{16}$" BUILT UP TO $1\frac{1}{4}$".
SEC. CORE - $4\frac{7}{8}$" X $1\frac{7}{16}$" BUILT UP TO $\frac{1}{2}$"
$4\frac{7}{8}$" X $1\frac{1}{16}$" BUILT UP TO $\frac{3}{8}$"
$4\frac{7}{8}$" X $\frac{5}{8}$" BUILT UP TO $\frac{3}{8}$"

JIG. #3005
END PIECES - $4\frac{1}{2}$" X $1\frac{1}{2}$"
BIND CORES WITH FRICTION TAPE.

WINDING DATA

PRIMARY

4 LAYERS OF 502G $\frac{1}{4}$ OILED CLOTH ON CORE. ANCHOR LEAD #1 WITH FRICTION TAPE AND WIND 15 TURNS OF #16 C.E. WIRE & BRING OUT TAP #2. WIND TO 340 TURNS AND END #16 C.E. WIRE & START #18 C.E. WIRE. SOLDER LEAD #3 TO END OF #16 C.E. & START OF #18 C.E. WIND 1 LAYER AND END #18 C.E. & START #20 E. WIRE. SOLDER LEAD #4 TO END OF #18 C.E. & START OF #20 E. WIND 1 LAYER AND END #20 E. & START #22 E. WIRE. SOLDER LEAD #5 TO END OF #20 E. & START OF #22 E. WIND 1 LAYER AND BRING OUT TAP #6. WIND 2 LAYERS AND ANCHOR END WITH LINEN TAPE - LEAD #7. 2 LAYERS OF 502G $\frac{1}{4}$ OILED CLOTH BETWEEN EACH LAYER OF WIRE. COVER LAST LAYER OF WIRE WITH 5004 OILED TAPE & SHELLAC. LEADS #3, 4, 5 & 7 ARE 1603 - #18 STRANDED WIRE.

SECONDARY

USE #31 ENAMEL WIRE

WIND 8" STRIP OF 5009 OILED PAPER ON 3344 F TUBE. ANCHOR LEAD #8 AND WIND 66 LAYERS, 90 TURNS PER LAYER. 1 LAYER OF 5009 OILED PAPER BETWEEN EACH LAYER OF WIRE. TOTAL 5940 TURNS. COVER 66TH LAYER WITH 1 LAYER OF 5009 OILED PAPER & FINISH WITH 1 LAYER OF #22 ENAMEL WIRE. ANCHOR END WITH LINEN TAPE - LEAD #9. SHELLAC LAST LAYER END OF #31 E. CONNECTED TO START OF #22 E. LEADS ARE APPROX. 7" OF 1631.

OBSOLETE

SIZE		ISSUE 3-31-32	J.E.
KIND		CHANGED	
SHAPE		" "	
FINISH		" "	
TEMP.		" "	
PATT.		" "	

TITLE: "Y" TRANSFORMER

H. G. FISCHER & CO.
2335 WABANSIA AVE.
CHICAGO, ILL.

CAT. NO.

PART NO. 3910G

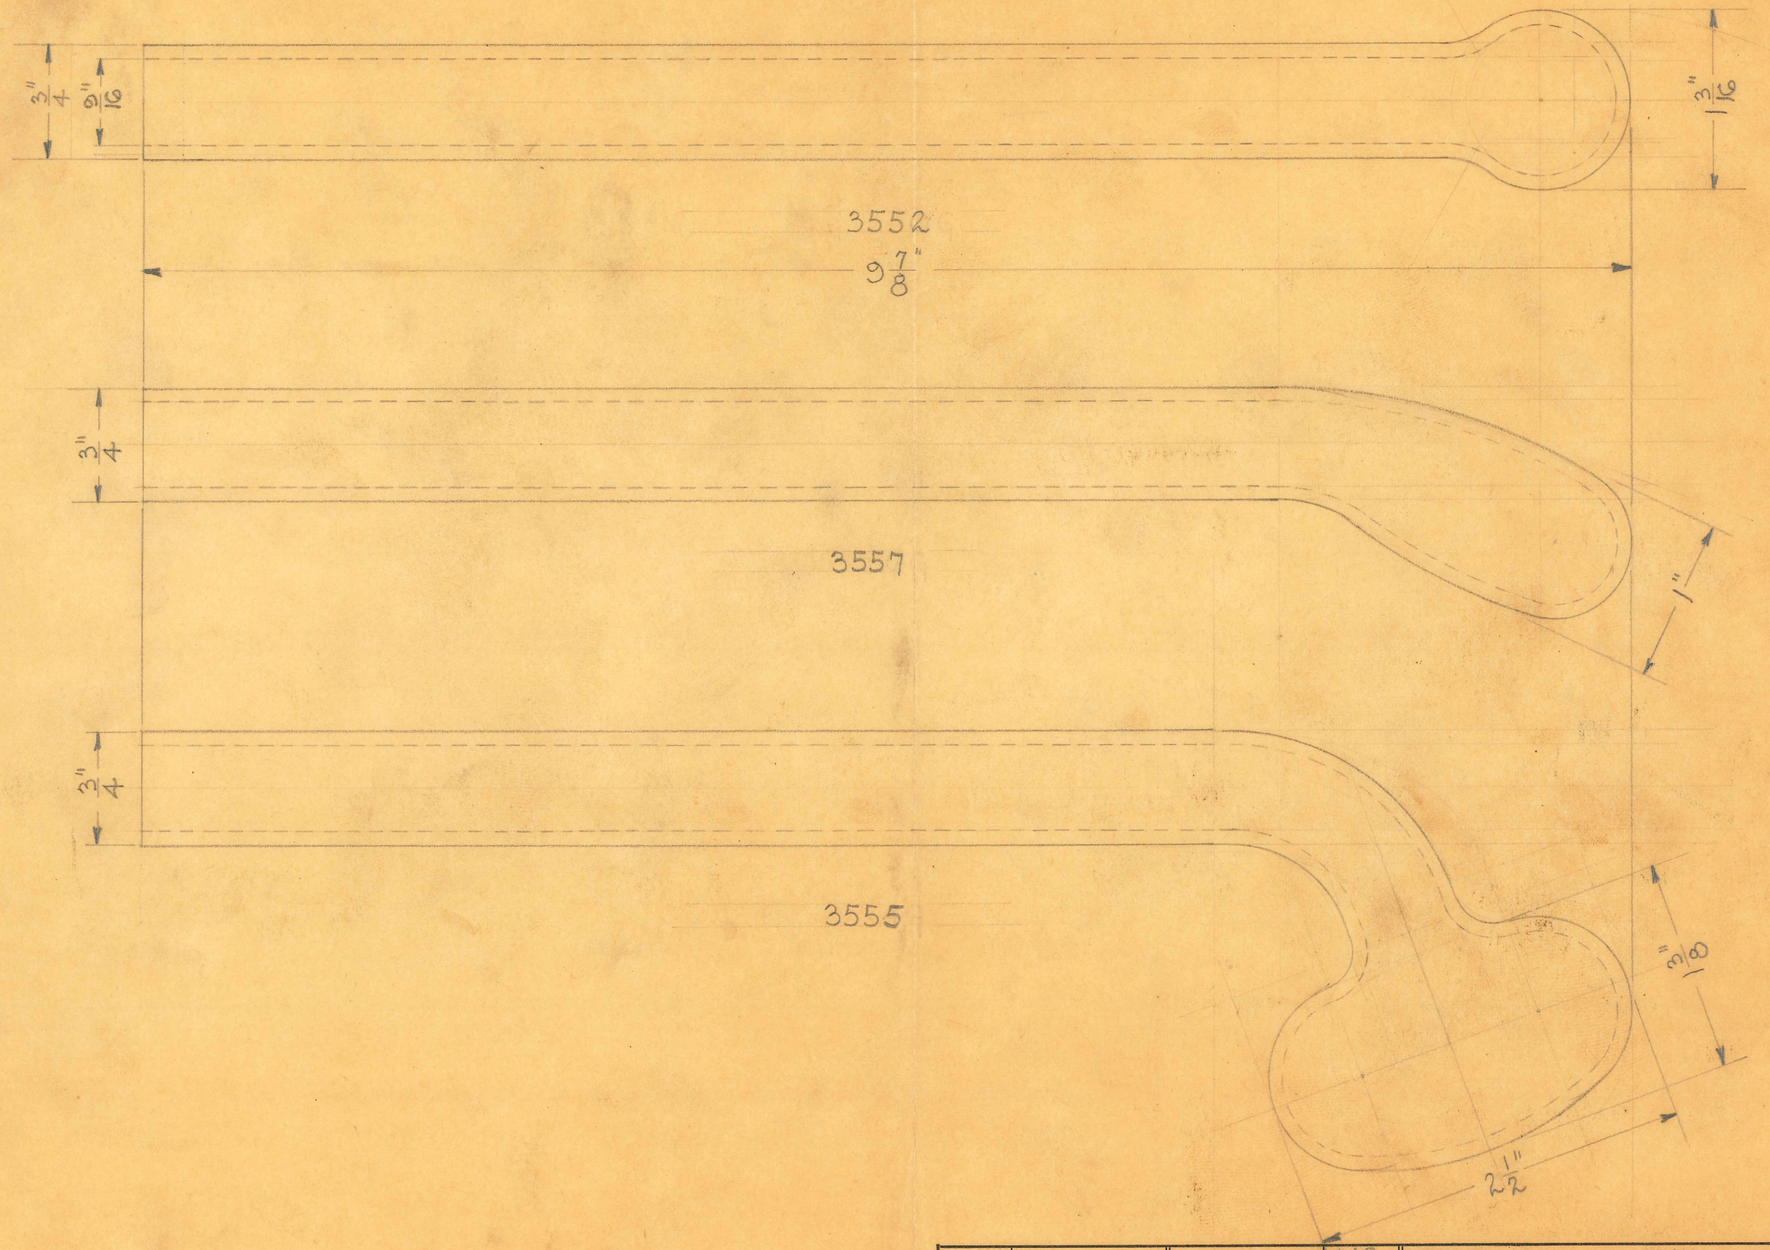

SIZE		ISSUE 10-6-30	28
KIND	GLASS	CHANGED	
SHAPE		" "	
FINISH		" "	
TEMP.		" "	
PATT.		" "	

TITLE: NAGEL SCHMIDT CONDENSATION ELECTRODES

OBSOLETE

H. G. FISCHER & CO.
2335 WABANSIA AVE.
CHICAGO, ILL.

CAT. NO.

PATT. NO. 3550G

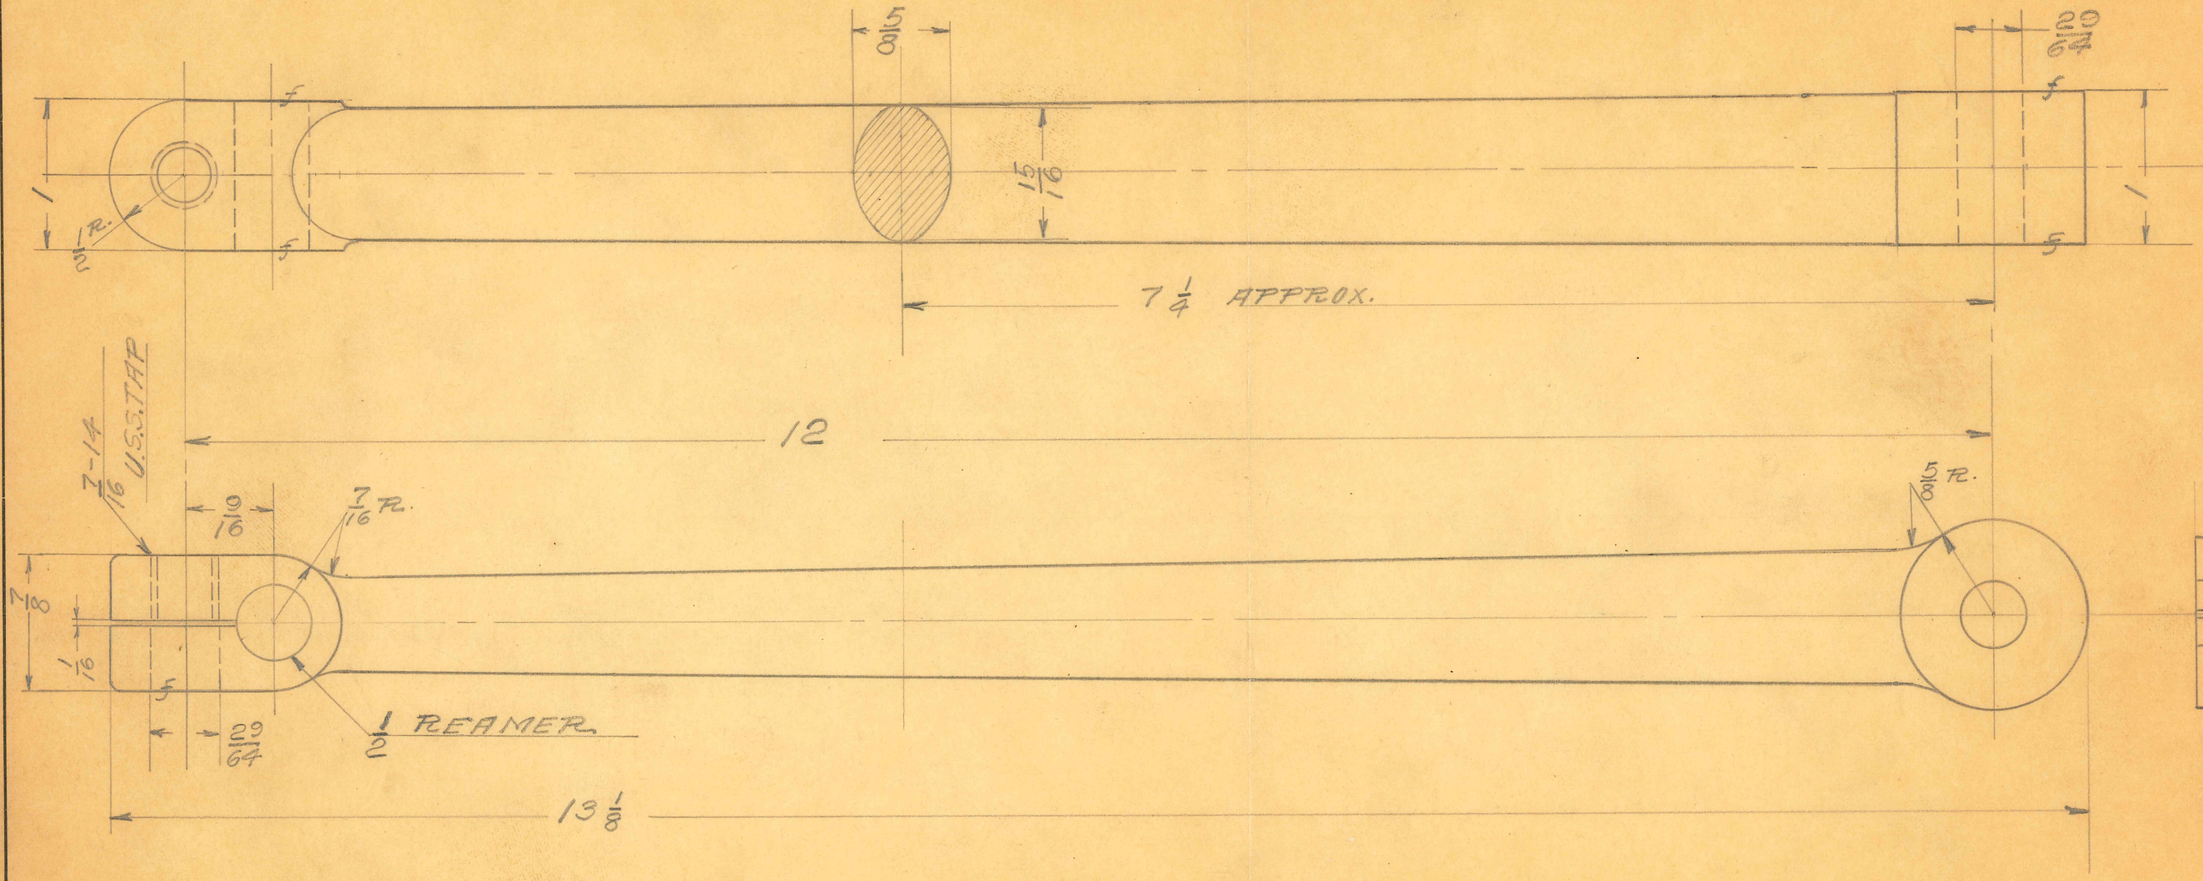

CAST IRON

1 REQ.

SCALE FULL SIZE

OBSOLETE

SIZE		ISSUE 10-13-30	C.M.	TITLE: COLONIC IRRIGATOR VALVE ARM
KIND		CHANGED		
SHAPE		" "		
FINISH	W. ENAMEL	" "		
TEMP.		" "		
PATT.		" "		

H. G. FISCHER & CO.
2335 WABANSIA AVE.
CHICAGO, ILL.

CAT. NO.

PART NO. 6556F

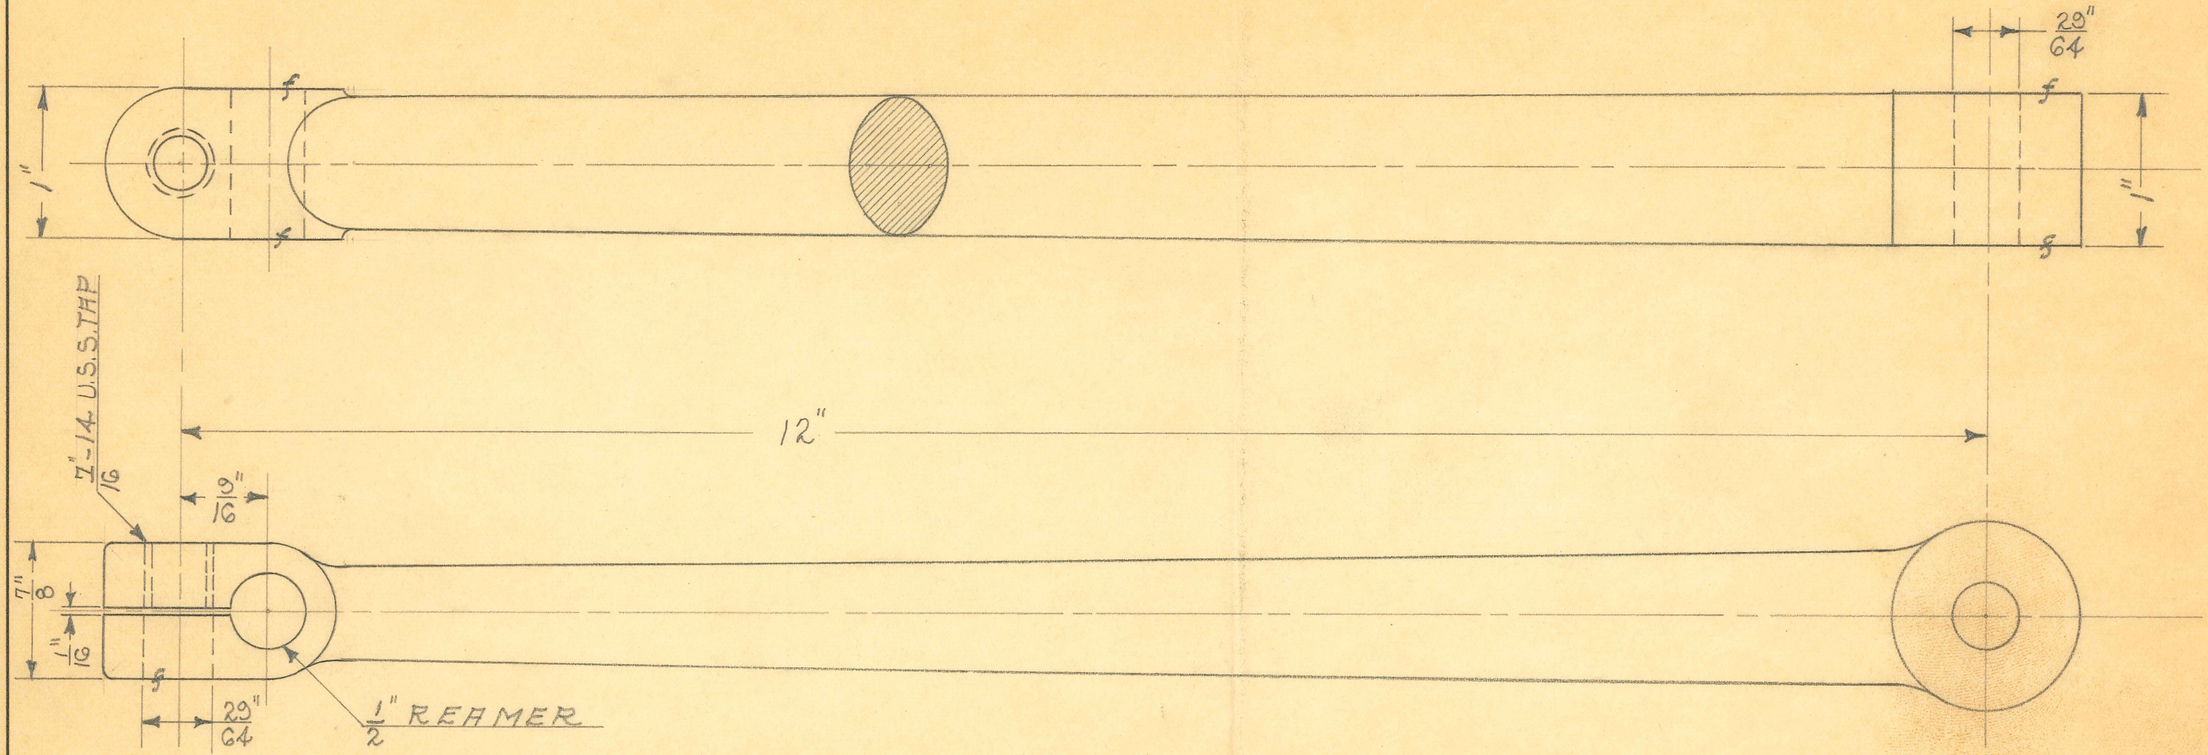

CAST IRON

1REQ.

SCALE FULL SIZE

OBSOLETE

SIZE		ISSUE 10-13-30	C.M.	TITLE: COLONIC IRRIGATOR VALVE ARM
KIND		CHANGED		
SHAPE		" "		
FINISH	W. ENAMEL	" "		
TEMP.		" "		
PATT.		" "		

H. G. FISCHER & CO.
2335 WABANSIA AVE.
CHICAGO, ILL.

CAT. NO.

PART NO. G55GF

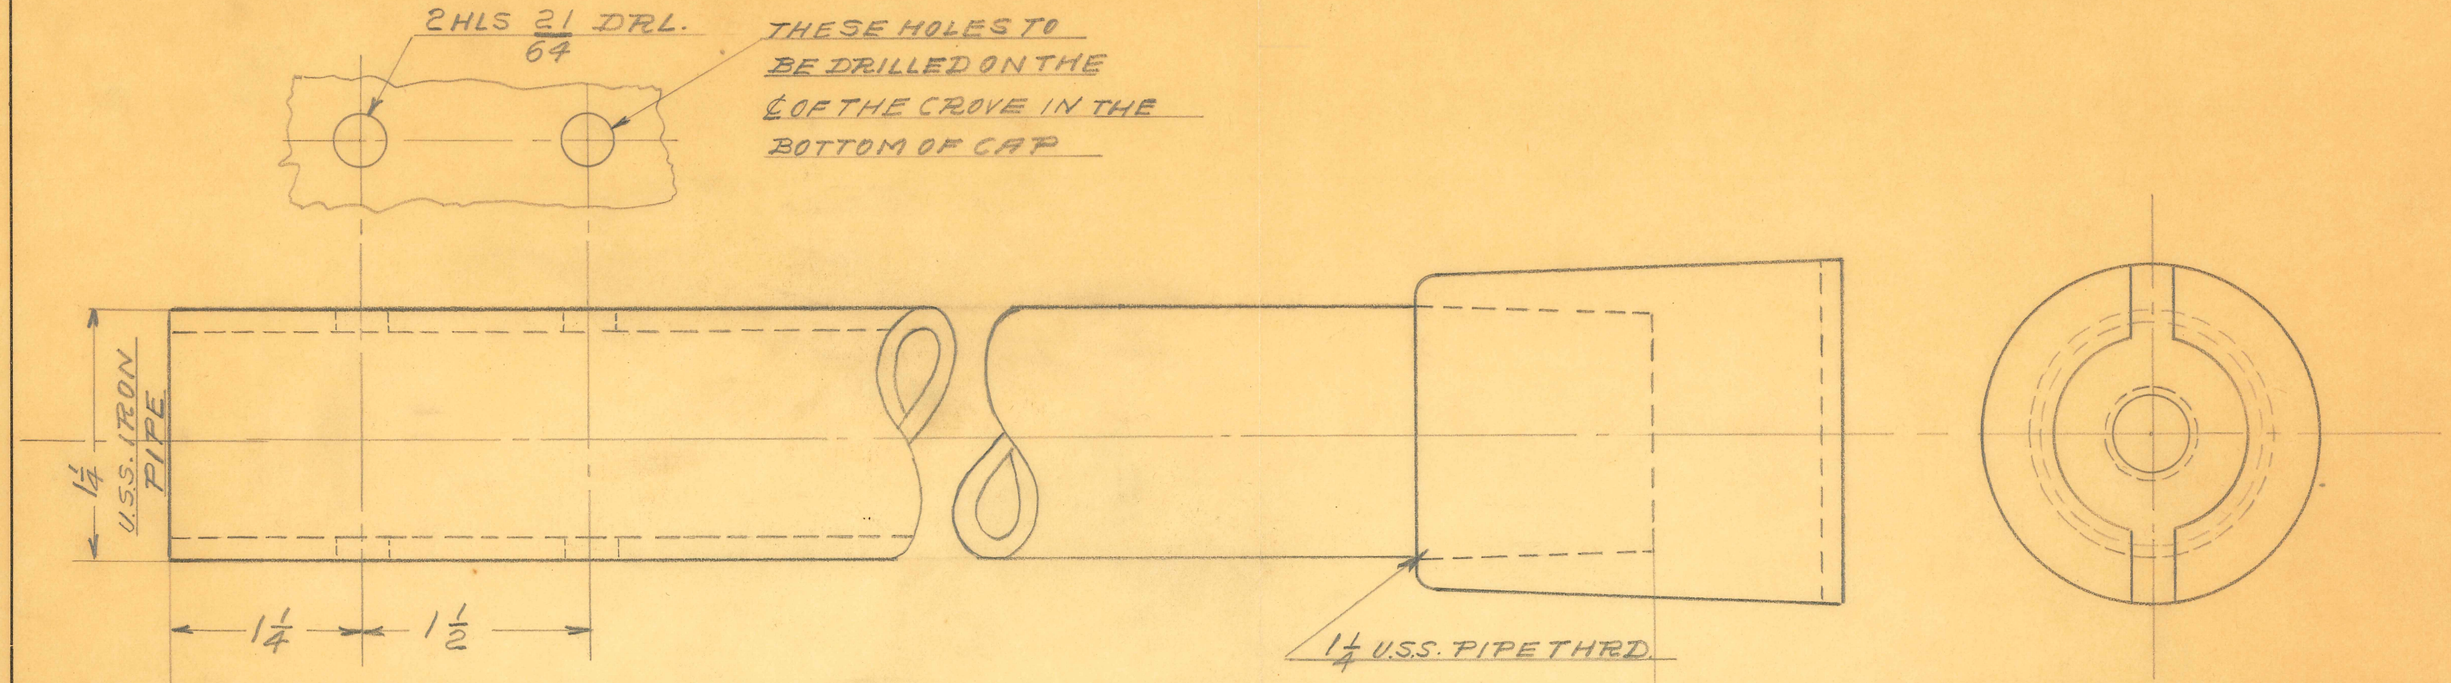

OBSOLETE

SIZE		ISSUE 1-5-30	C.H.
KIND		CHANGED	
SHAPE		" "	
FINISH	W. EML.	" "	
TEMP.		" "	
PATT.		" "	

TITLE: COLONIC IRRIGATOR
UPRIGHT PIPE

H. G. FISCHER & CO.
2335 WABANSIA AVE.
CHICAGO, ILL.

CAT. NO.

PART NO. 6554F

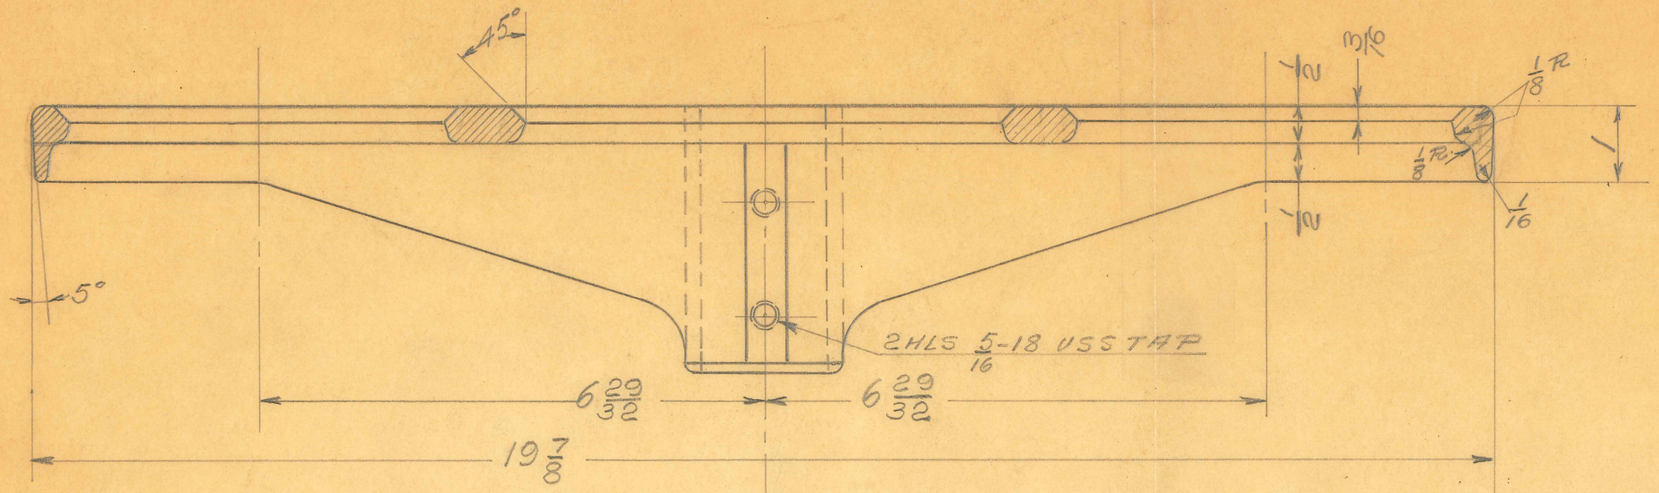

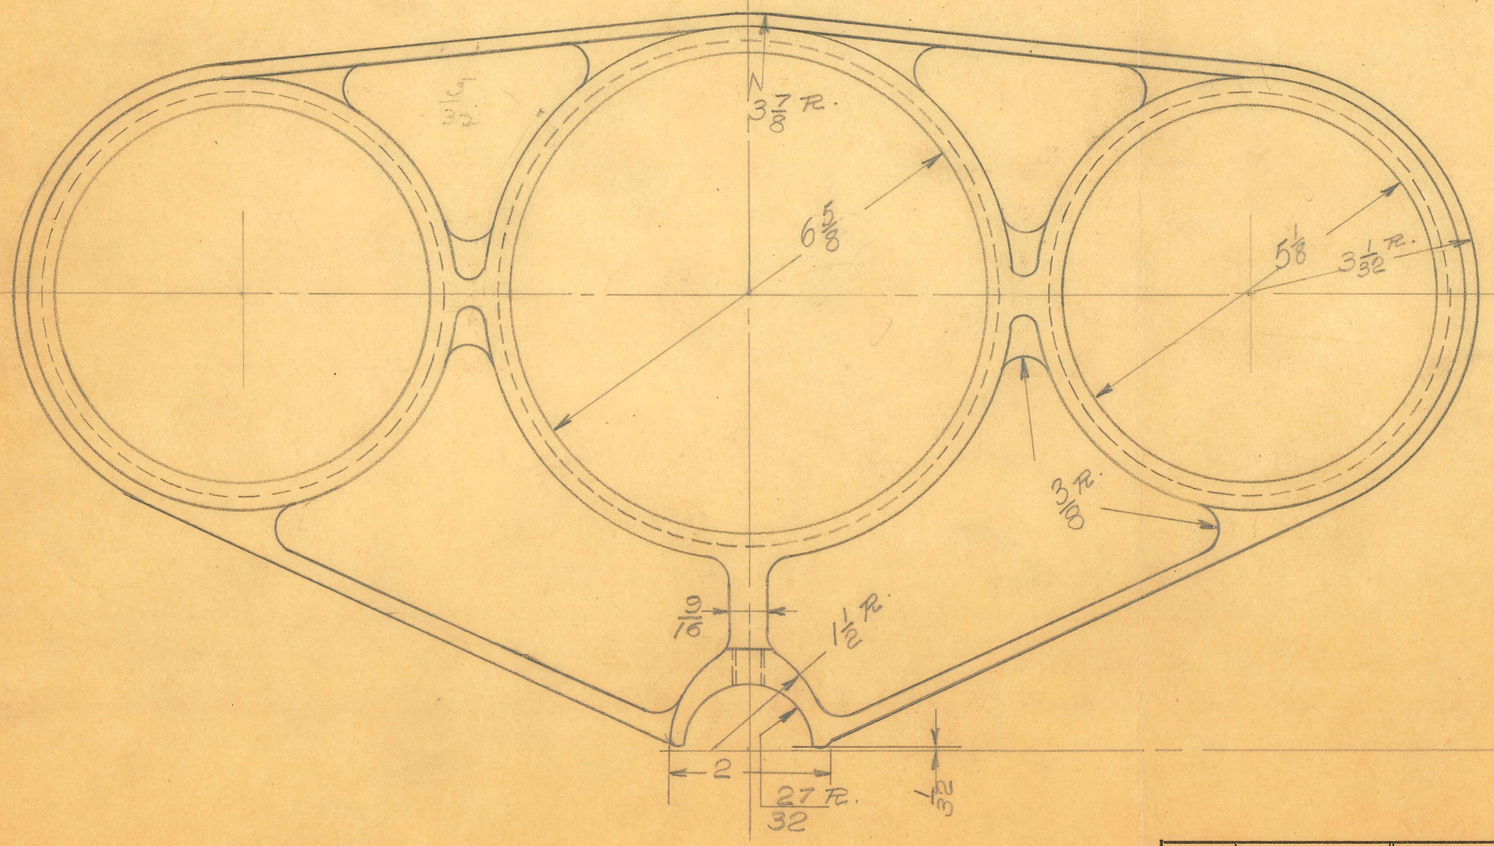

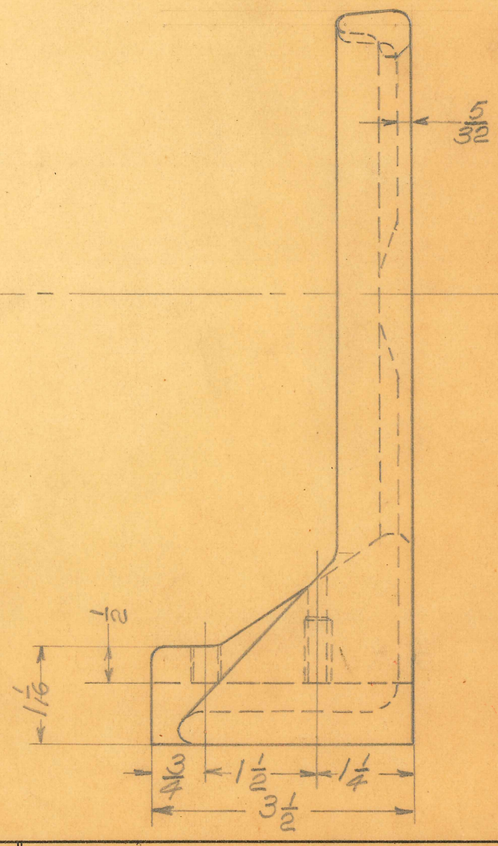

OBSOLETE

CAST IRON
1 REQ
SCALE HALF SIZE

SIZE		ISSUE 10-10-30	C.M.
KIND		CHANGED	
SHAPE		" "	
FINISH	W. ENAMEL	" "	
TEMP.		" "	
PATT.		" "	

TITLE: COLONIC IRRIGATOR PERCOLATOR SUPPORT

H. G. FISCHER & CO.
2335 WABANSIA AVE.
CHICAGO, ILL.

CAT. NO.

PART NO. G552F

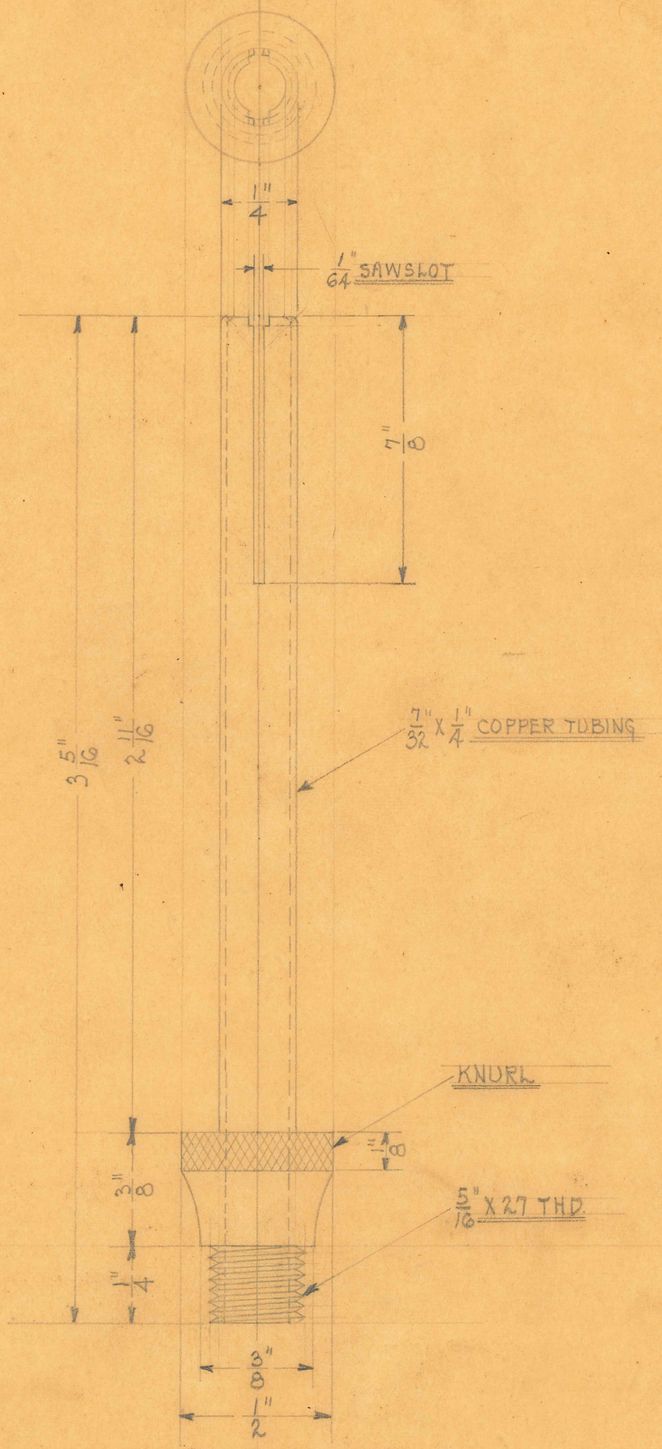

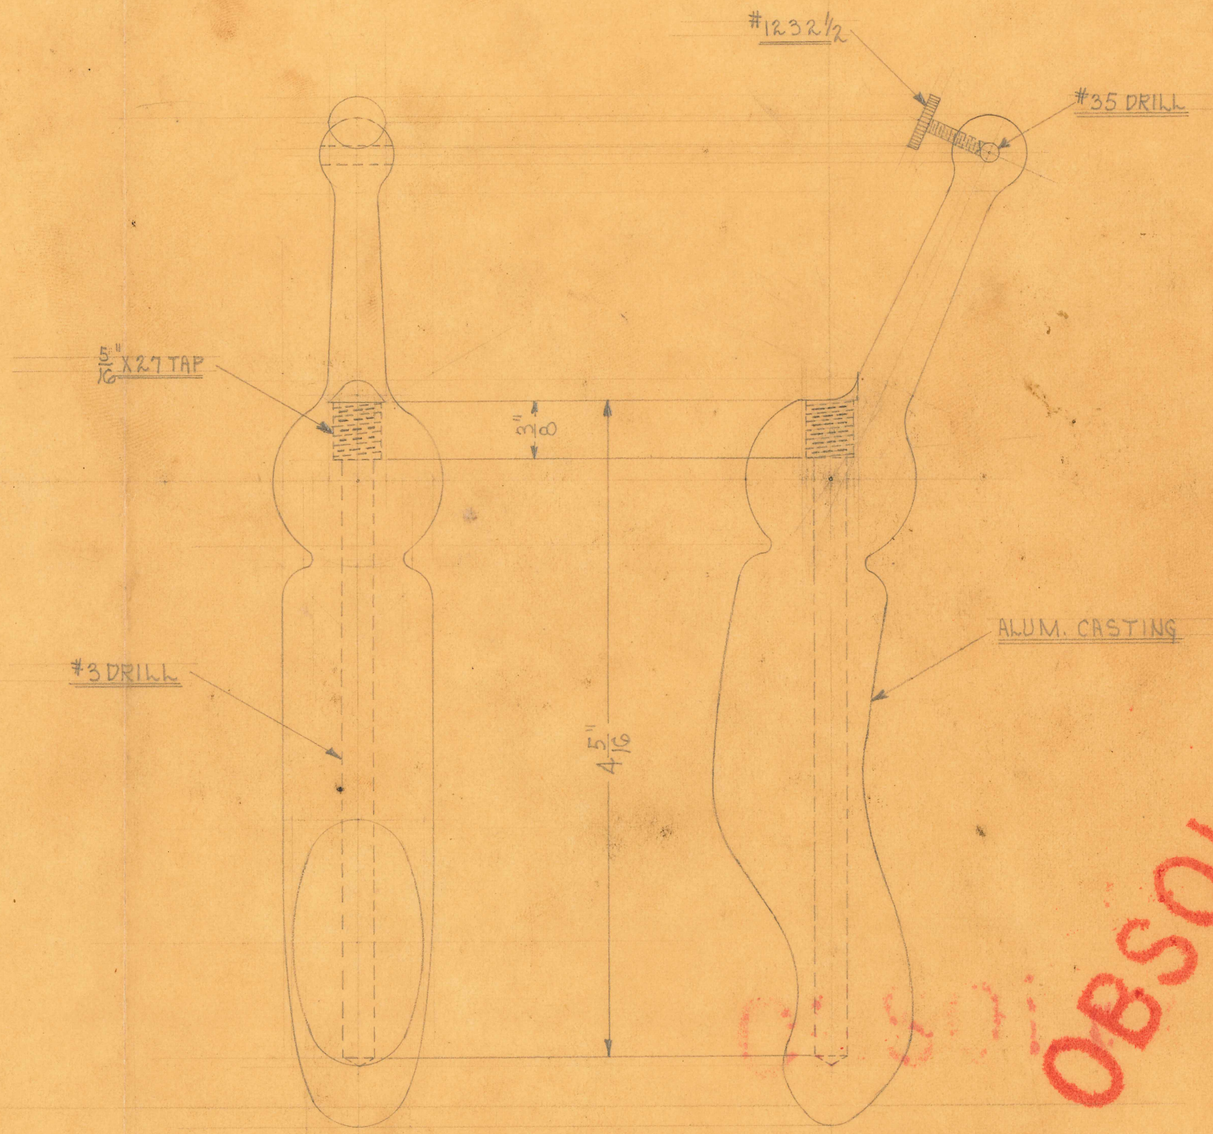

OBSOLETE

SIZE		ISSUE 10-3-30	24.6	TITLE: PROSTATIC ELECTRODE
KIND		CHANGED		
SHAPE		" "		
FINISH		" "		
TEMP.		" "		H. G. FISCHER & CO. 2335 WABANSIA AVE. CHICAGO, ILL. — CAT. NO. — ~~PART~~ NO. S-110
PATT.		" "		

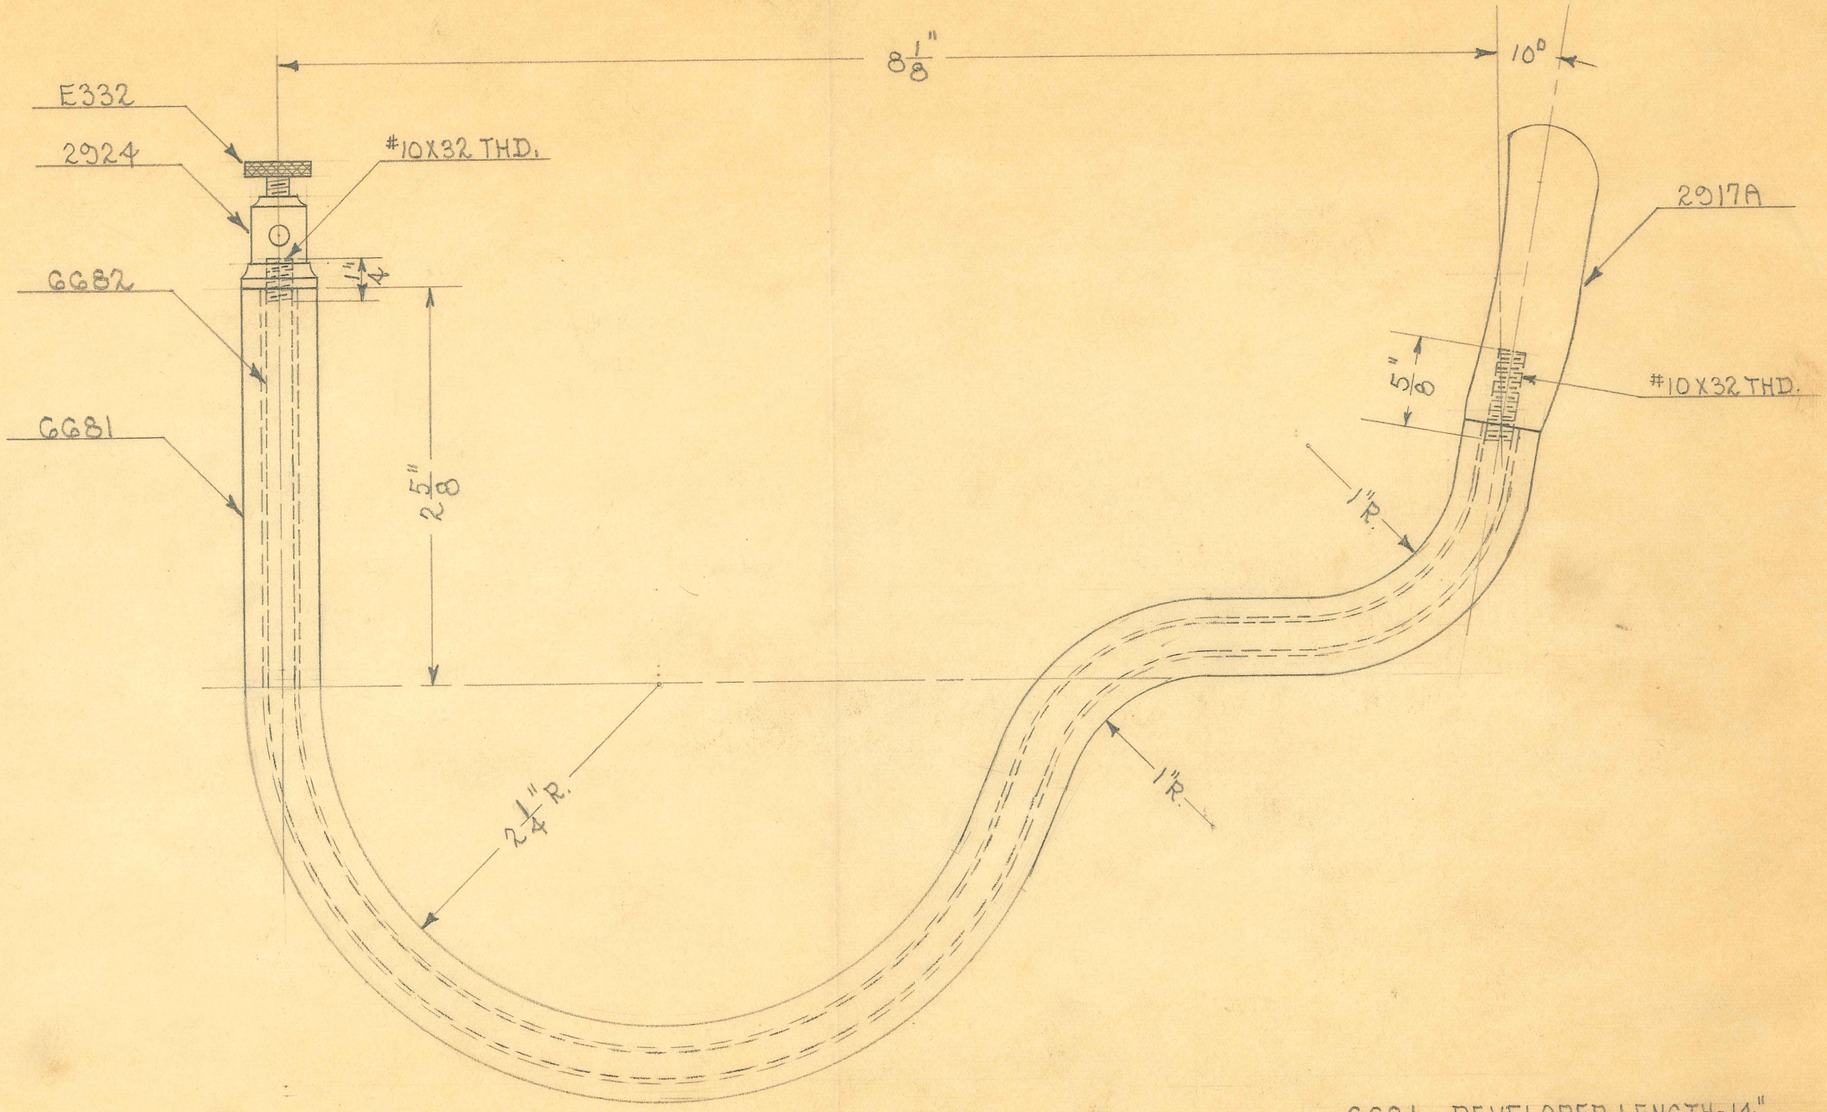

GG81 - DEVELOPED LENGTH-14"
GG82 - DEVELOPED LENGTH-14 11/16"

OBSOLETE

SIZE		ISSUE 2-14-33	A.E.	TITLE: MILLS TYPE PROSTATIC ELECTRODE
KIND		CHANGED		
SHAPE		" "		
FINISH		" "		
TEMP.		" "		H. G. FISCHER & CO. 2335 WABANSIA AVE. CHICAGO, ILL. — CAT. NO. — PART NO. GG80G
PATT.		" "		

P10832

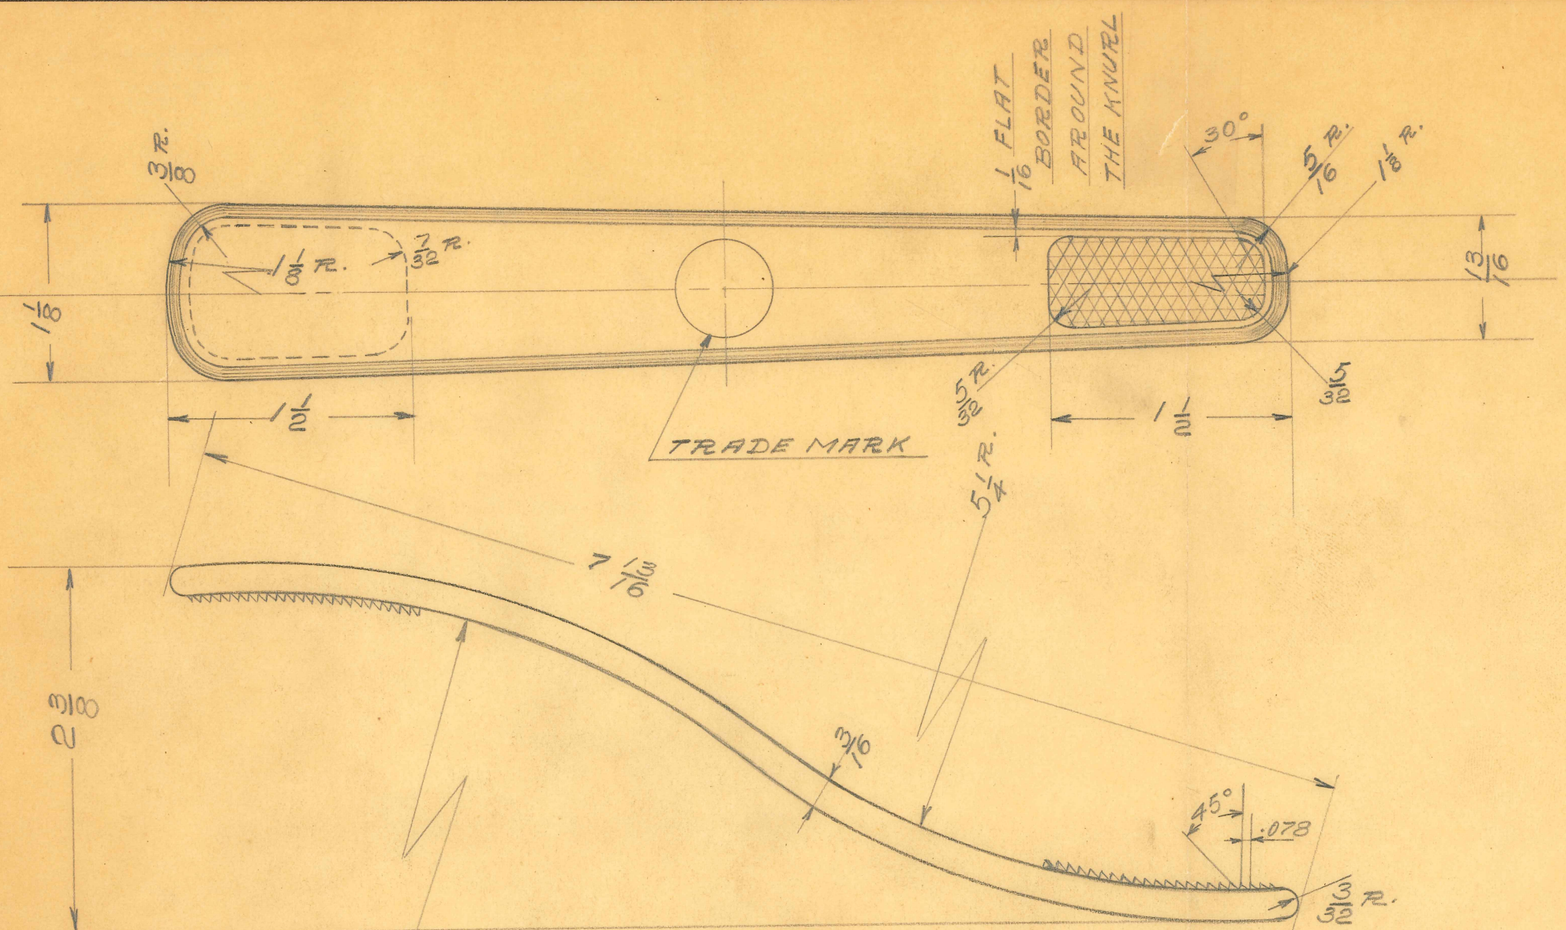

BAKELITE

SCALE FULL SIZE

OBSOLETE

SIZE		ISSUE 2-25-31	C.A.	TITLE: TONGUE DEPRESSOR (DR. DILLINGER)	
KIND		CHANGED			
SHAPE		" "			
FINISH		" "			
TEMP.		" "		H. G. FISCHER & CO. 2335 WABANSIA AVE. CHICAGO, ILL.	CAT. NO.
PATT.		" "			PART NO. 6640

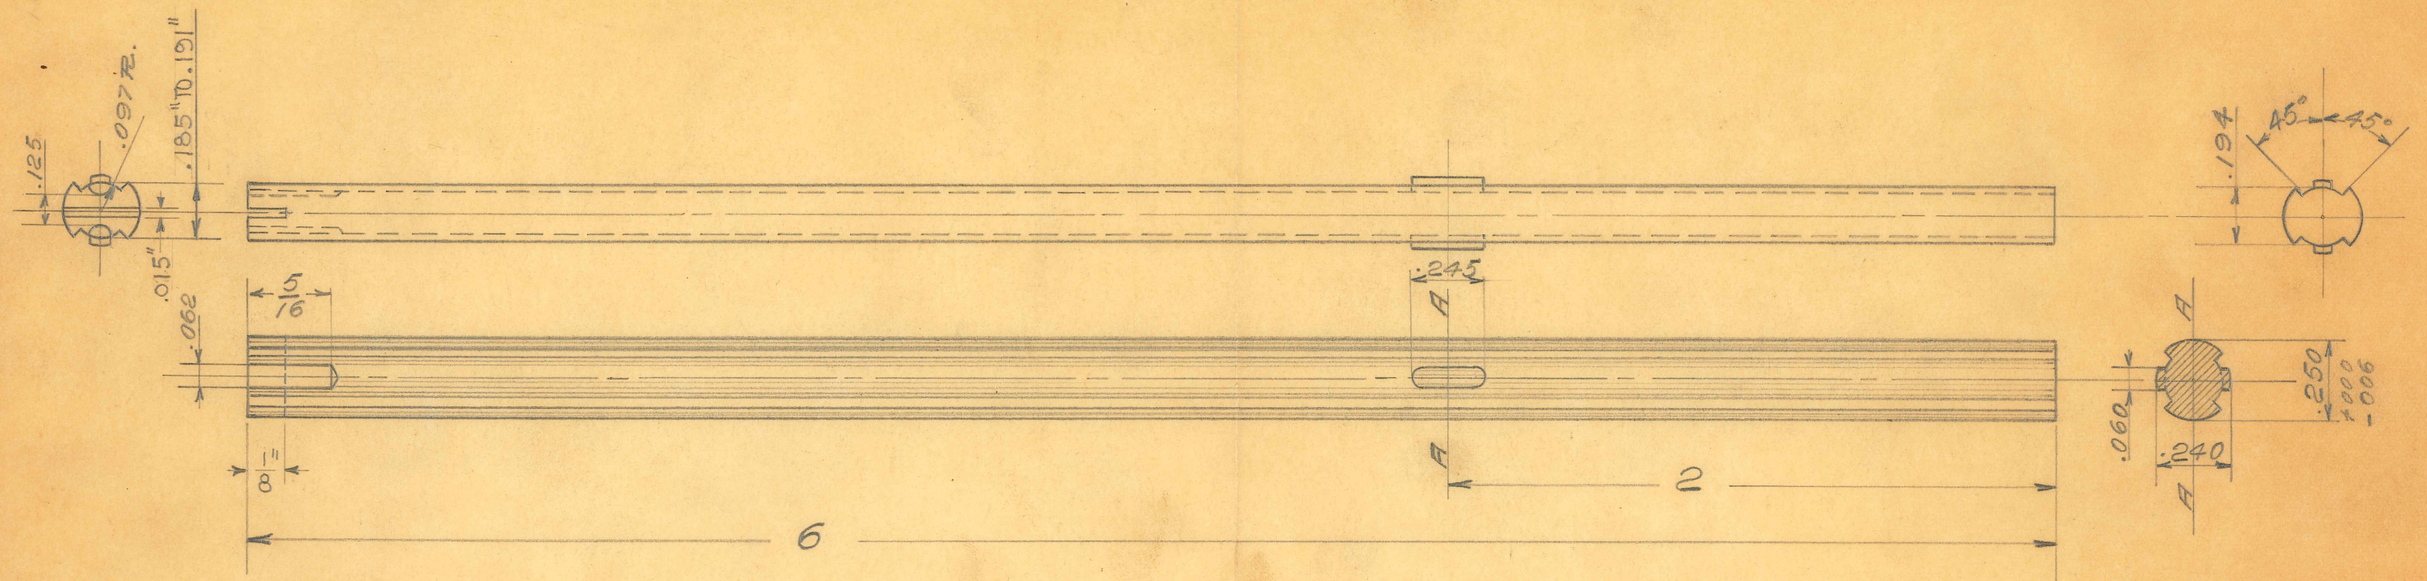

BAKELITE MOULDED

1 REQ.

SCALE 2 x SIZE

OBSOLETE

SIZE		ISSUE 2-6-31	C.W.	TITLE: ENDE-CHERRY CERVICAL ELECTRODE CORE	
KIND		CHANGED			
SHAPE		" "			
FINISH		" "			
TEMP.		" "		H. G. FISCHER & CO. 2335 WABANSIA AVE. CHICAGO, ILL.	CAT. NO.
PATT.		" "			PART NO. 6629F

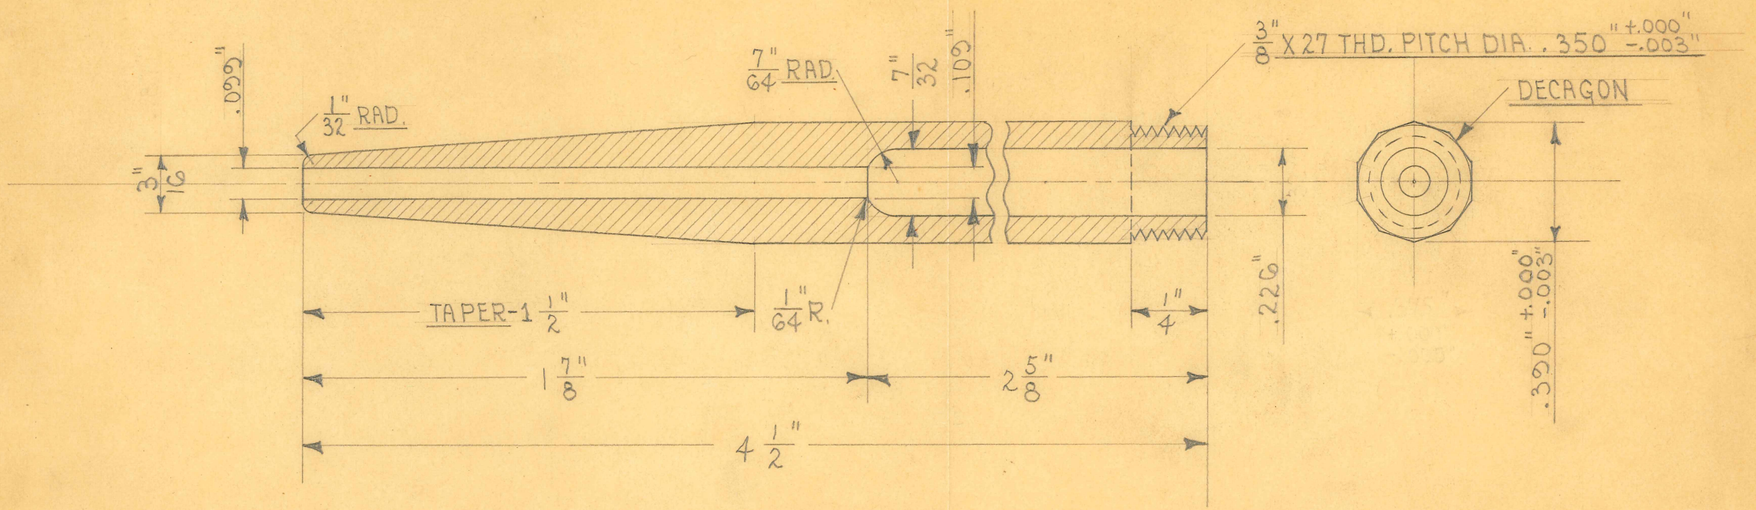

SCALE ~ 1" = 1/2"

OBSOLETE

C.M.P.C. MOLD # 1789

SIZE		ISSUE 12-18-35	A.E.	TITLE: TISSUE CUTTING KNIFE ELECTRODE HANDLE-BODY
KIND	MOLDED BAKELITE	CHANGED		
~~SHAPE~~	MOLD # 1781	" "		
FINISH		" "		
TEMP.		" "		H. G. FISCHER & CO. 2335 WABANSIA AVE. CHICAGO, ILL. — CAT. NO. — PART NO. 4511A
PATT.		" "		

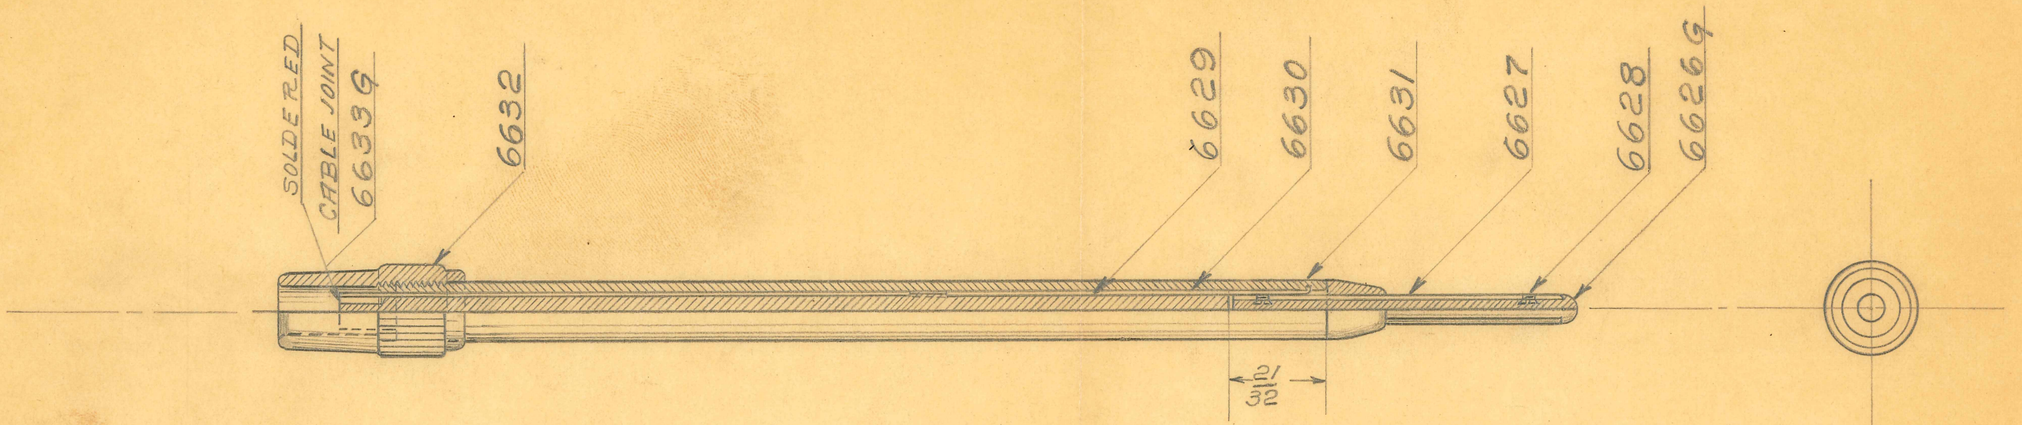

SCALE FULL SIZE

OBSOLETE

SIZE		ISSUE 2-10-31	C.M.	TITLE: ENDE-CHERRY CERVICAL ELECTRODE	
KIND		CHANGED			
SHAPE		" "			
FINISH		" "			
TEMP.		" "		H. G. FISCHER & CO. 2335 WABANSIA AVE. CHICAGO, ILL.	CAT. NO.
PATT. #		" "			PART NO. 6625 G

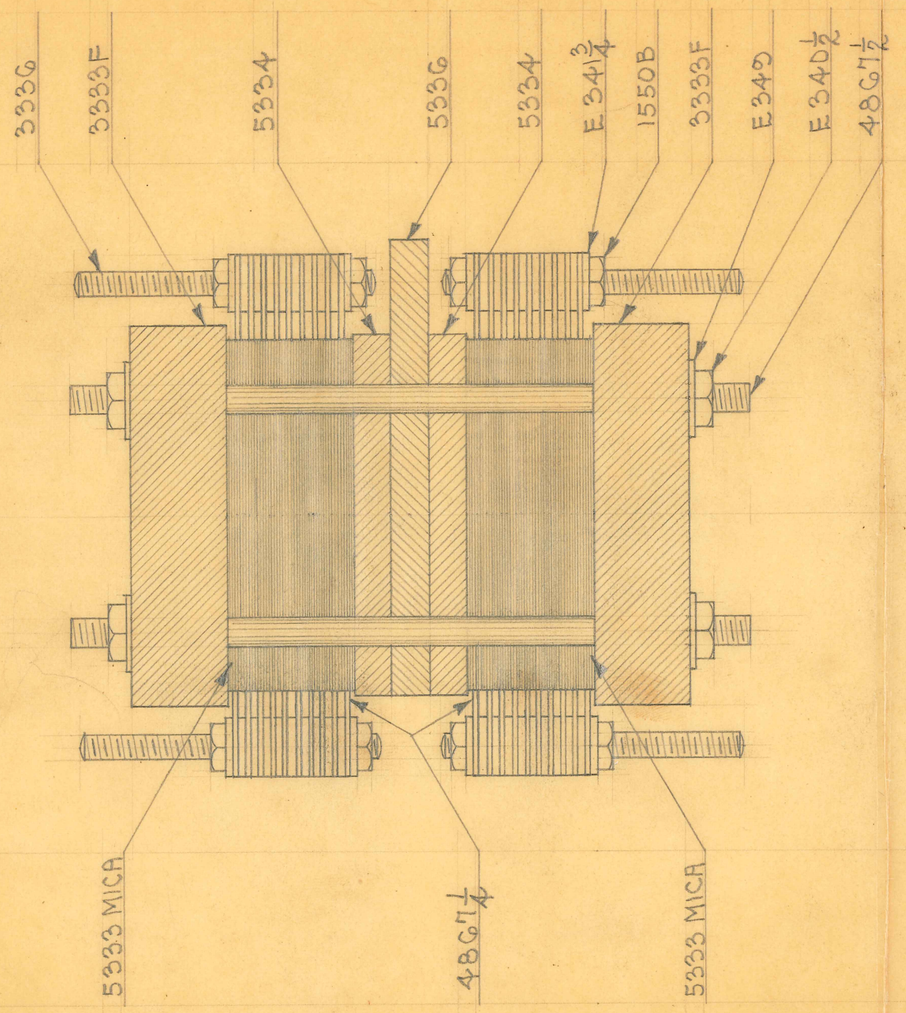

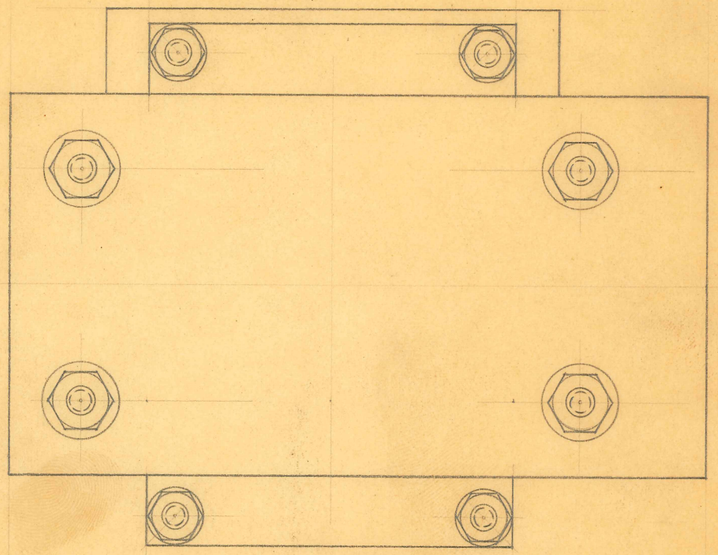

NOTE:-
MICA SPLIT TO .012 (4-7 SHEETS)
2-19 PLATE CONDS. JIG. # 4126

OBSOLETE

SIZE		ISSUE 3-3-32	A.E.	TITLE: SENIOR "V" CONDENSER
KIND		CHANGED		
SHAPE		" "		
FINISH		" "		
TEMP.		" "		H. G. FISCHER & CO. 2335 WABANSIA AVE. CHICAGO, ILL. — CAT. NO. — PART NO. 4867 1/4 G
PATT.		" "		

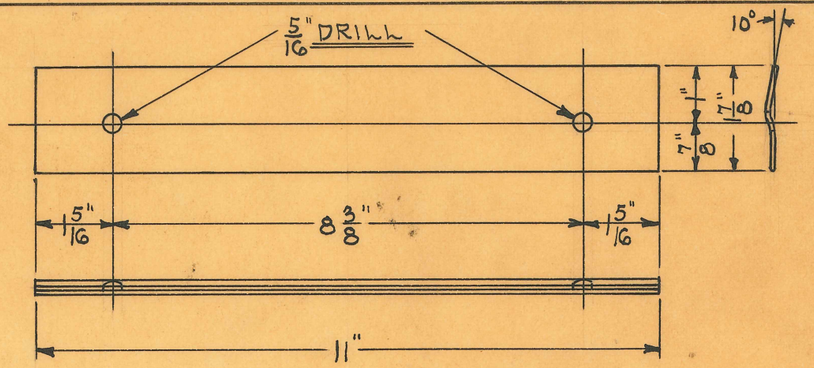

SCALE ~ 3/8" = 1"

2 REQUIRED

#16 B&S.GA. SCRAP SHEET STEEL

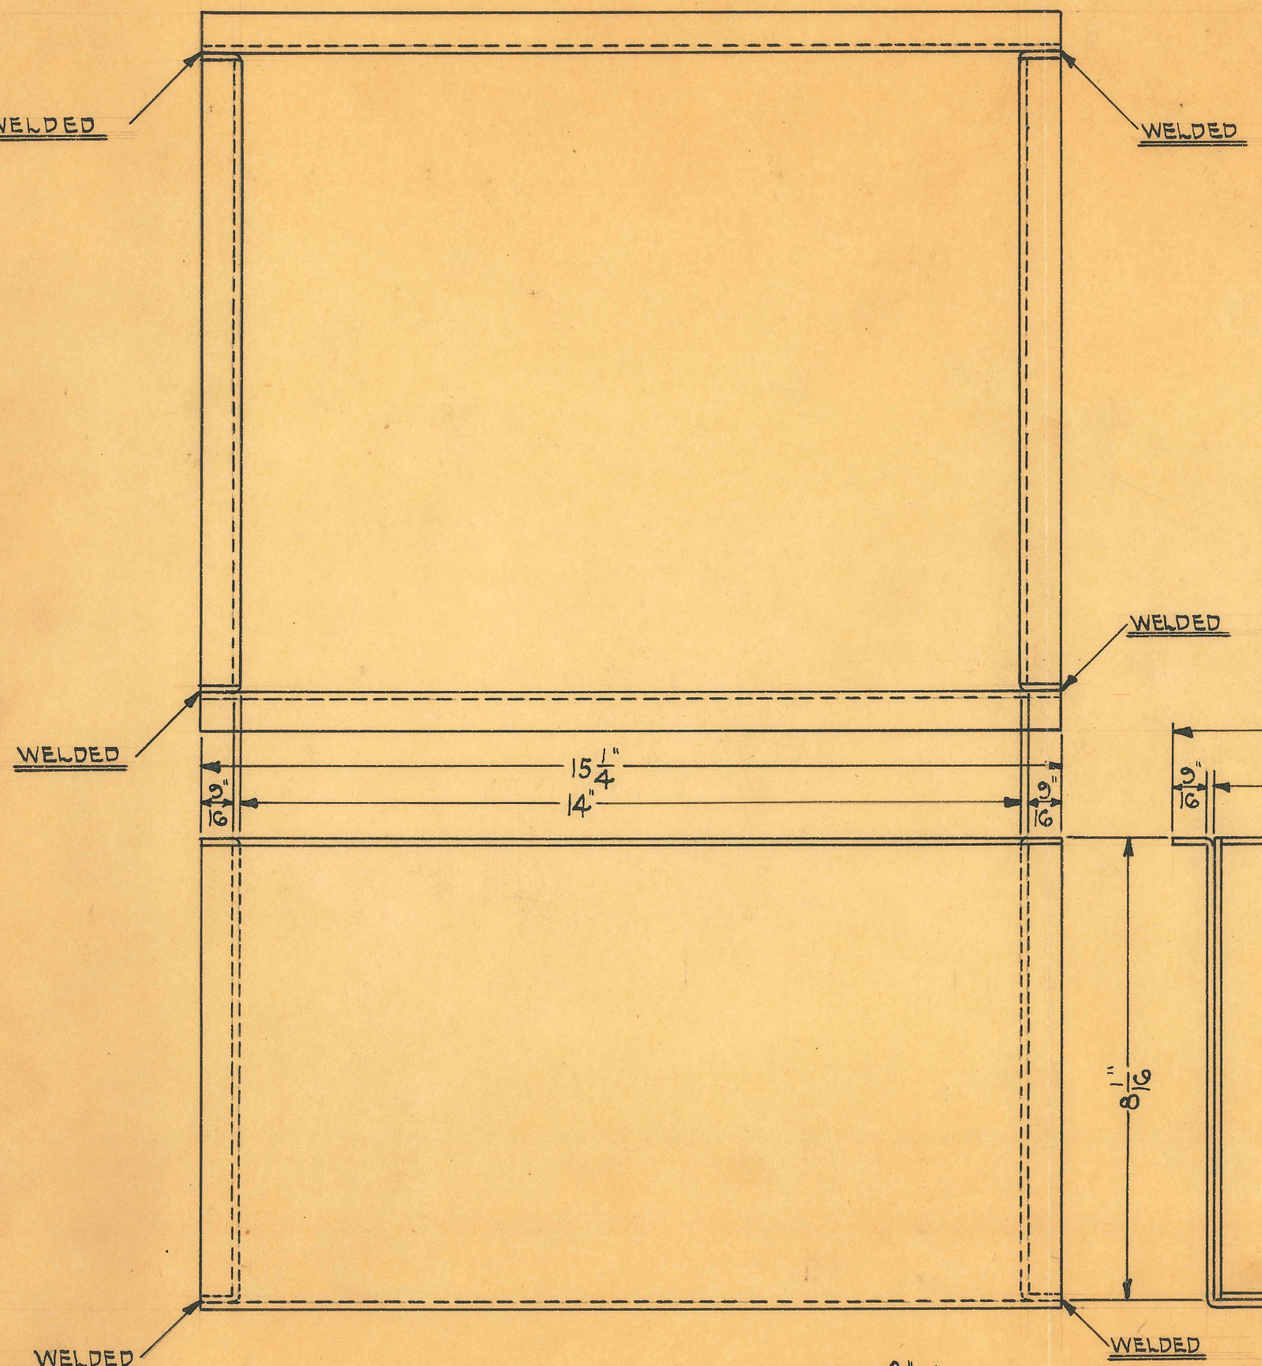

SCALE ~ 3/8" = 1"

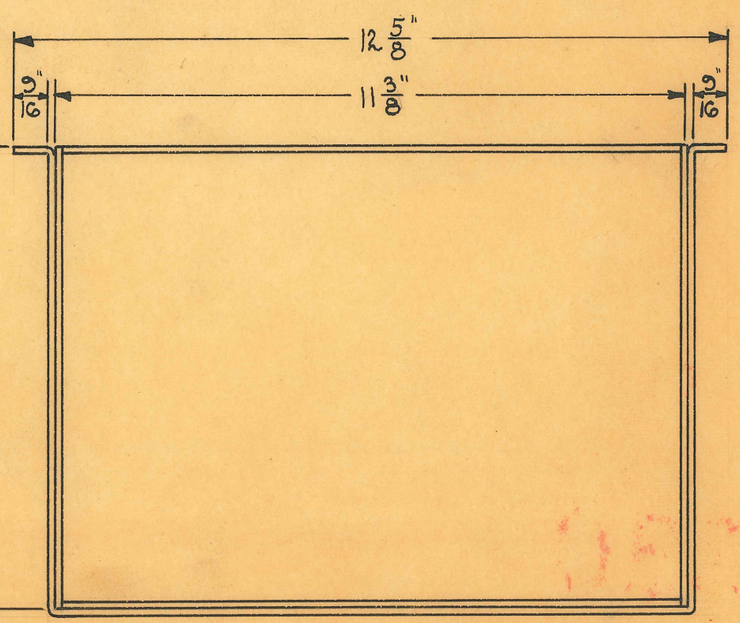

SIZE	1/16"	ISSUE 11-15-30	H.E.
KIND	FURNITURE STEEL	CHANGED	
SHAPE	SHEET	" "	
FINISH		" "	
TEMP.		" "	
PATT.		" "	

TITLE: SENIOR "F" IN OIL TRANSFORMER TANK

OBSOLETE

H. G. FISCHER & CO.
2335 WABANSIA AVE.
CHICAGO, ILL.

CAT. NO.

PART NO. F1072

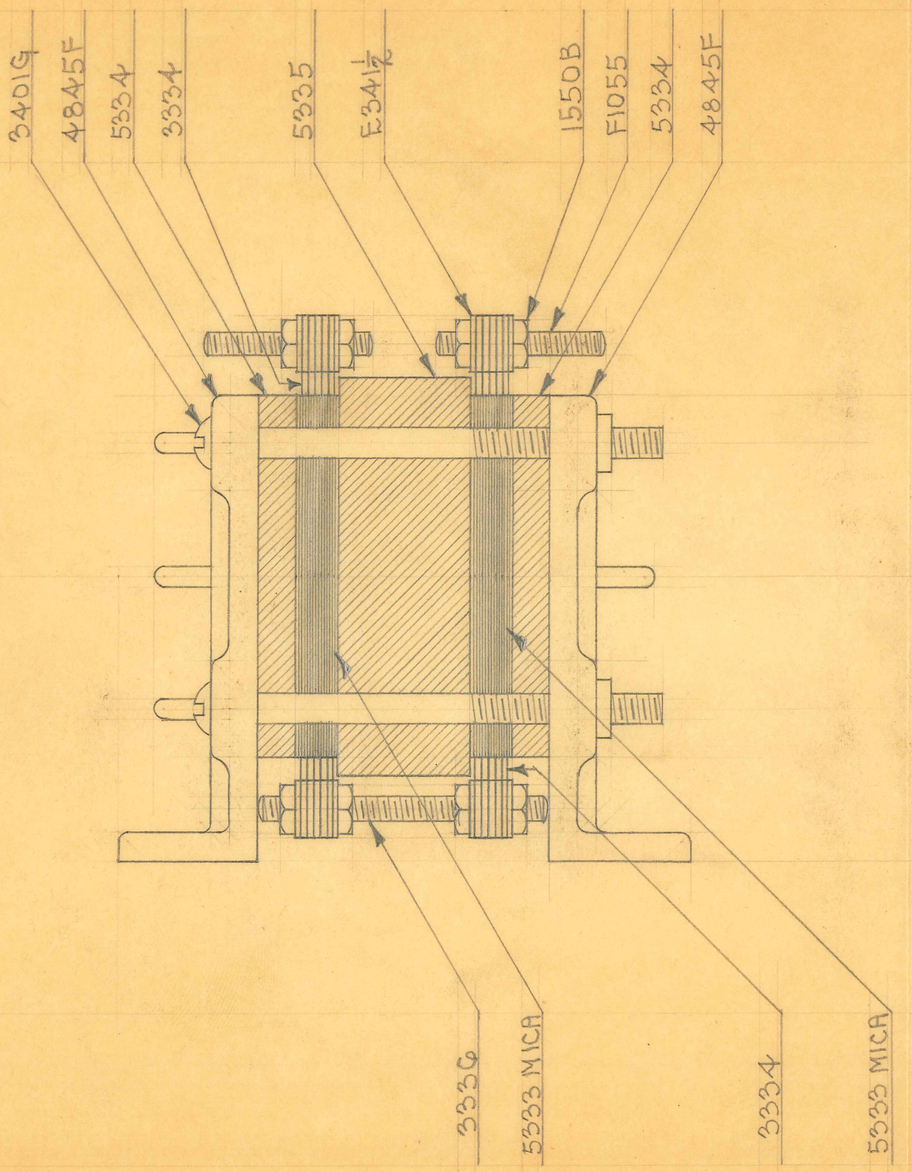

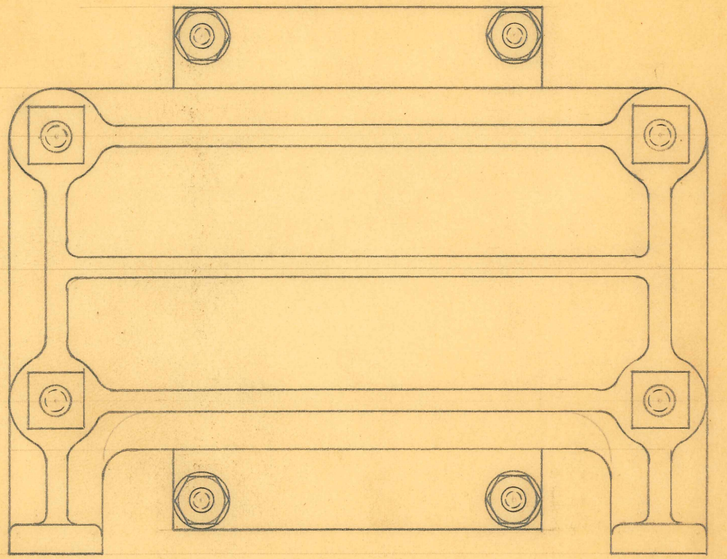

NOTE~
MICA SPLIT TO .012" (4-7 SHEETS)
2-12 PLATE CONDS. JIG #4126

OBSOLETE

SIZE		ISSUE 2-26-32	H.E.	TITLE: SENIOR "V" BLOCKING CONDENSER
KIND		CHANGED		
SHAPE		" "		
FINISH		" "		
TEMP.		" "		H. G. FISCHER & CO. 2335 WABANSIA AVE. CHICAGO, ILL. — CAT. NO. — PART NO. 4845G
PATT.		" "		

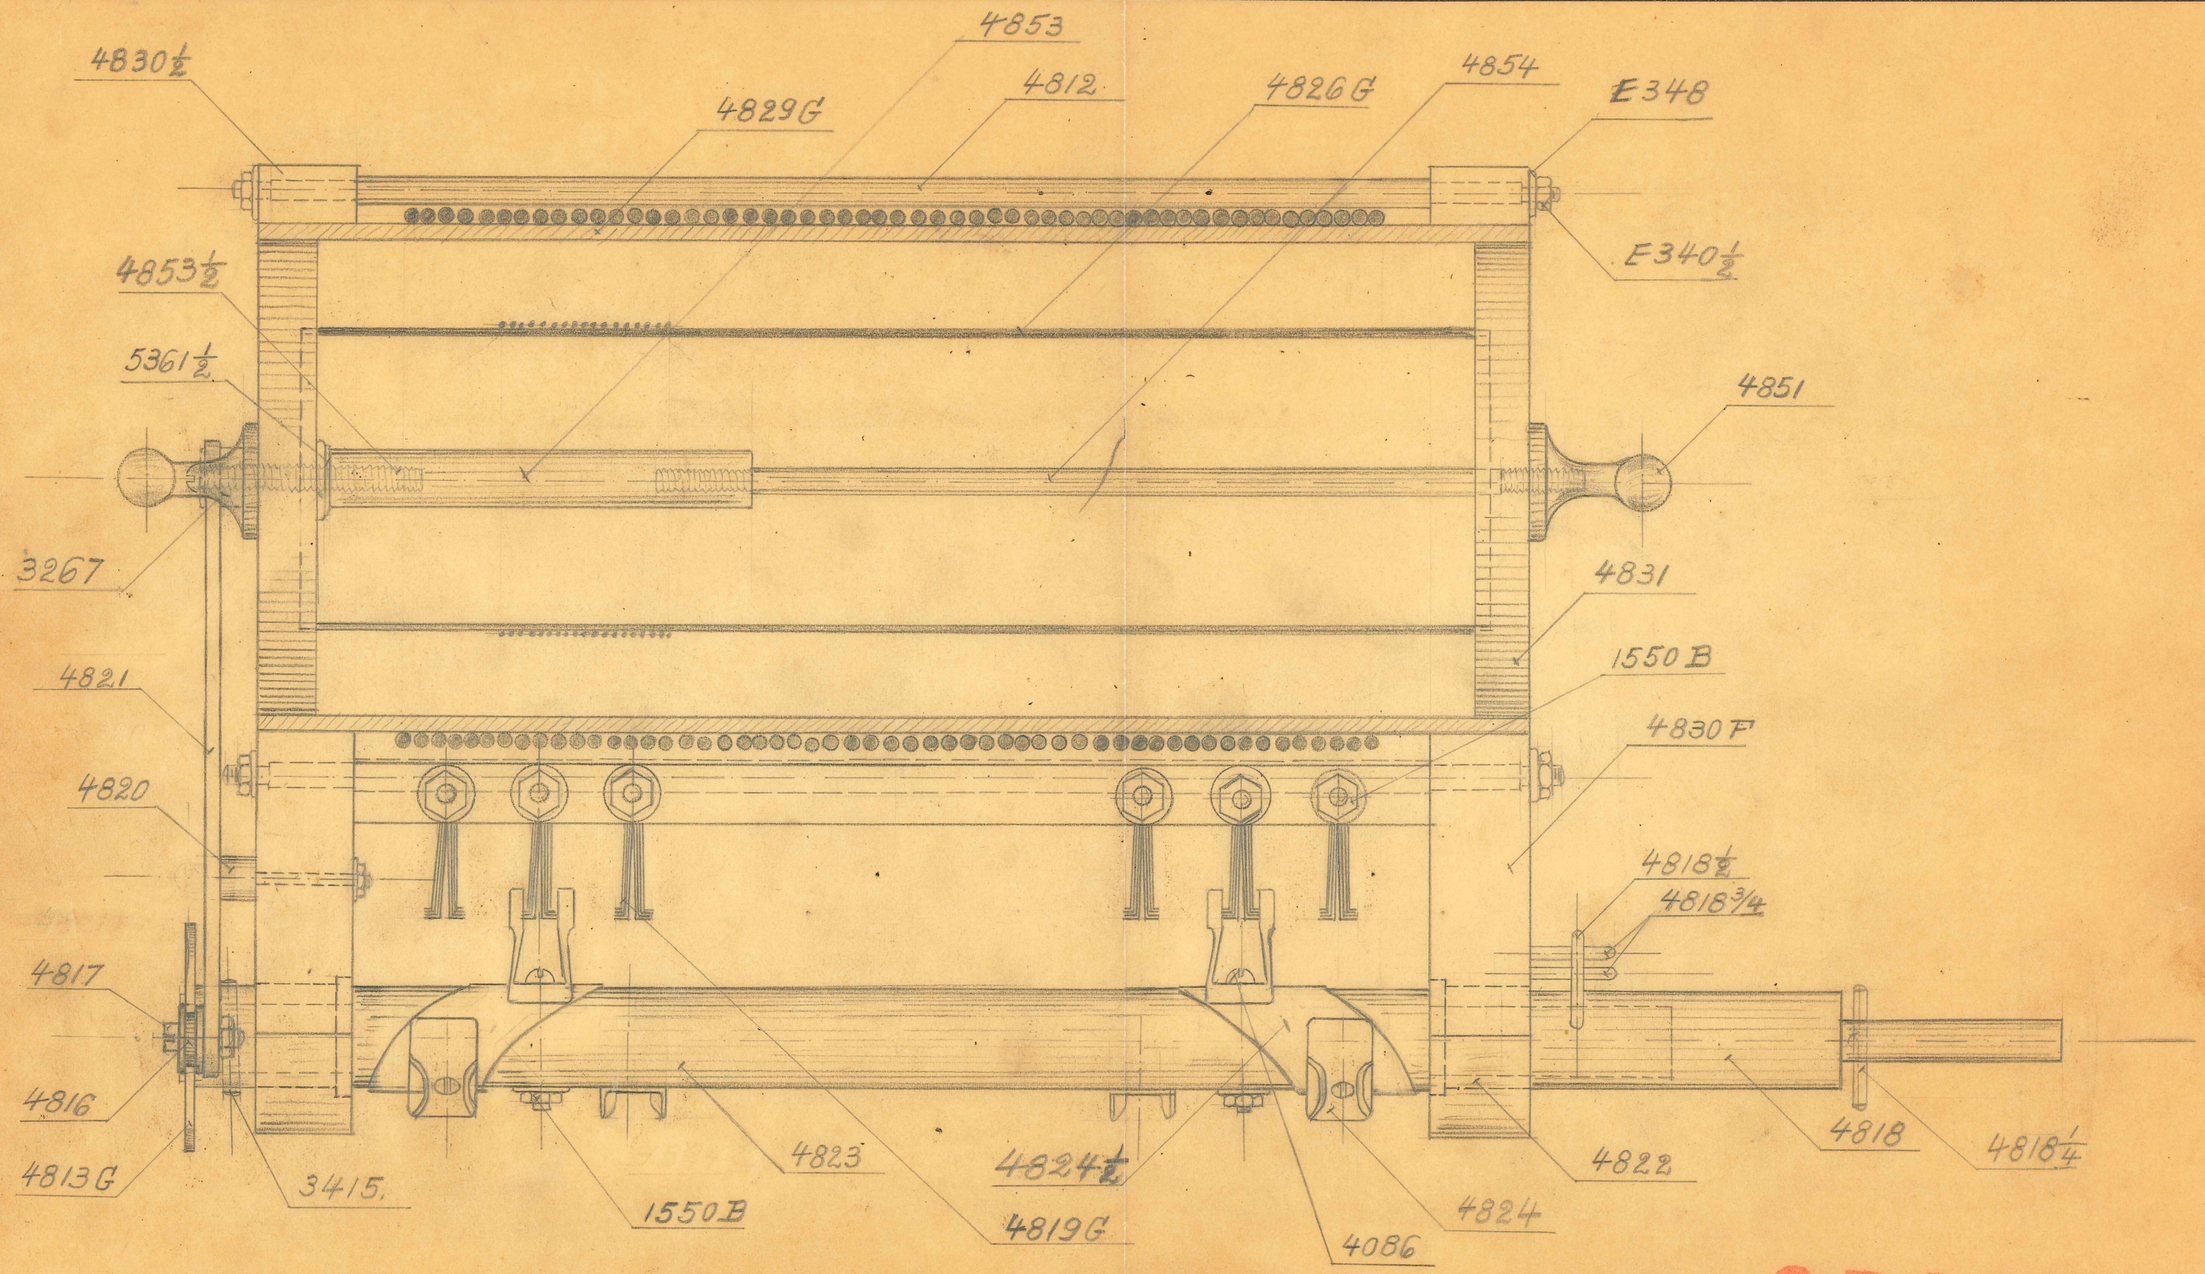

OBSOLETE

SIZE		ISSUE 5/2 27	PV
KIND		CHANGED	
SHAPE		" "	
FINISH		" "	
TEMP.		" "	
PATT.		" "	

TITLE: SELECTOR SWITCH & COIL ASSEM. SR "V"

H. G. FISCHER & CO.
2335 WABANSIA AVE.
CHICAGO, ILL.

CAT. NO.

PART NO. 4808G

(1)

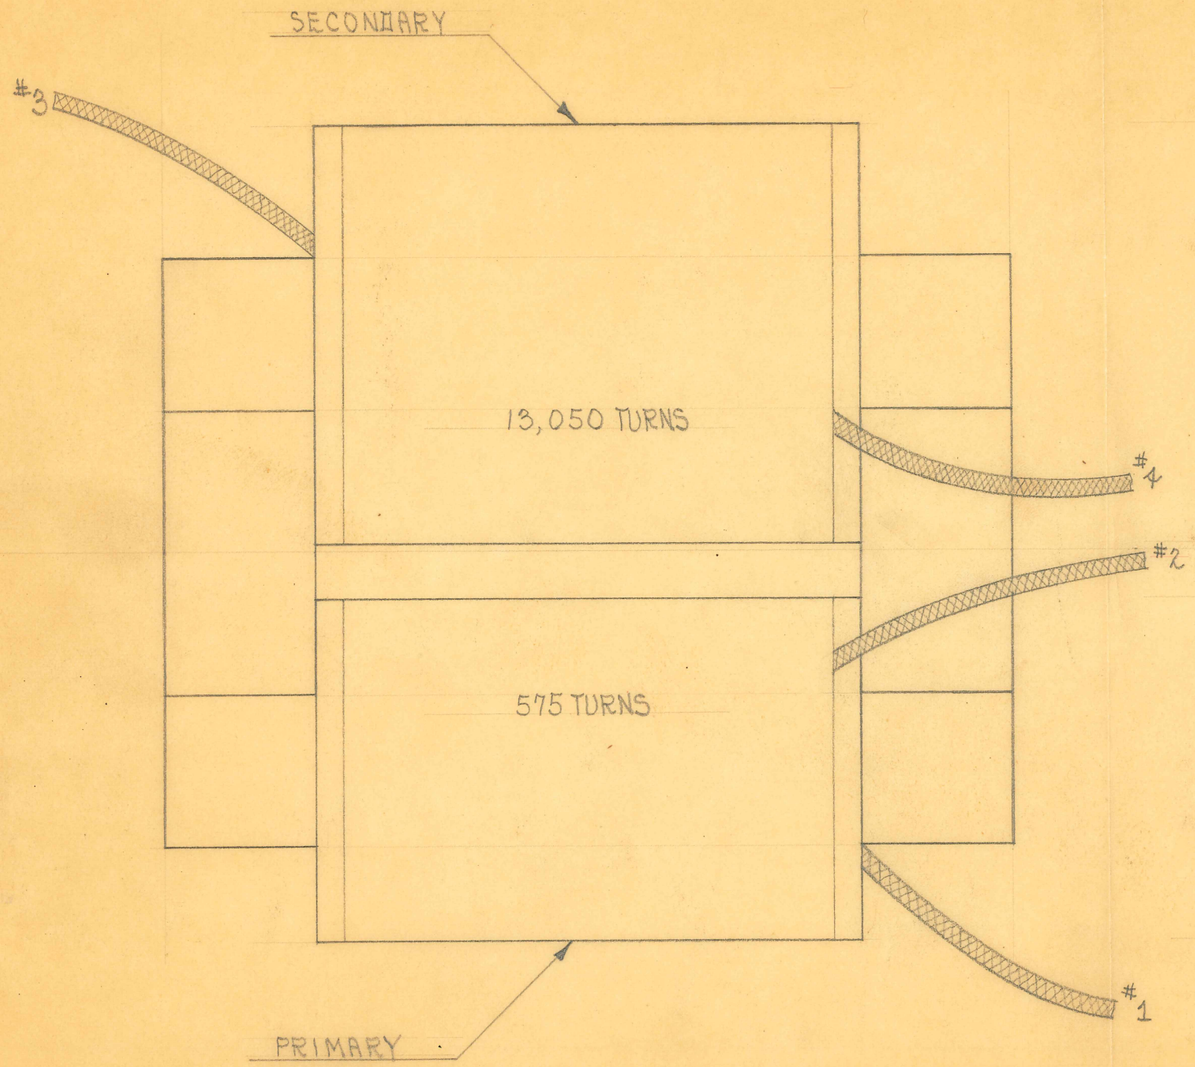

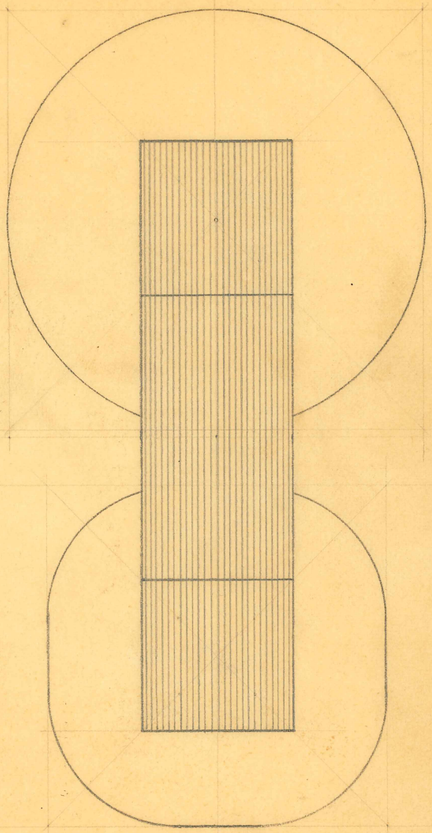

STEEL SIZES

PC. NO. 5043

PRI. & SEC. CORES. CUT $4\frac{5}{8}$" X 1" BUILT UP TO 1"
JIG. # $287\frac{1}{2}$.
END PIECES CUT $2\frac{7}{8}$" X 1".
BIND CORES WITH FRICTION TAPE.

WINDING DATA

PRIMARY

USE # 18 COTENAMEL WIRE.
3 LAYERS OF $5020\frac{1}{2}$ FIBROID PAPER ON CORE.
ANCHOR LEAD #1 WITH FRICTION TAPE AND WIND 9 LAYERS OF 60 TURNS EACH & A TENTH LAYER OF 35 TURNS. TOTAL 575 TURNS. ANCHOR END WITH FRICTION TAPE-LEAD #2. 1 LAYER OF $5020\frac{1}{2}$ FIBROID PAPER BETWEEN EACH LAYER OF WIRE. COVER TENTH LAYER OF WIRE WITH 5004 OILED TAPE & SHELLAC. LEADS ARE 1603-#18 STRANDED WIRE.

SECONDARY

USE # 31 ENAMEL WIRE.
3 LAYERS OF $5020\frac{1}{2}$ FIBROID PAPER ON CORE.
ANCHOR LEAD #3 WITH FRICTION TAPE AND WIND 46 LAYERS OF 280 TURNS EACH & A 47TH LAYER OF 170 TURNS. TOTAL 13,050 TURNS. ANCHOR END WITH FRICTION TAPE-LEAD #4. 1 LAYER OF $5020\frac{1}{2}$ FIBROID PAPER BETWEEN EACH LAYER OF WIRE. COVER 47TH LAYER OF WIRE WITH 5004 OILED TAPE & SHELLAC. LEADS ARE 1648-#20 WEATHERPROOF WIRE.
WIND 1 LAYER OF $502G\frac{3}{4}$ EMPIRE CLOTH BETWEEN 1ST & 2ND AND 2ND & 3RD LAYERS OF WIRE IN ADDITION TO $5020\frac{1}{2}$ FIBROID.

OBSOLETE

SIZE		ISSUE 3-14-32	A.E.	TITLE: "SII" OUTFIT TRANSFORMER
KIND		CHANGED		
SHAPE		" "		
FINISH		" "		
TEMP.		" "		H. G. FISCHER & CO. 2335 WABANSIA AVE. CHICAGO, ILL. — CAT. NO. — PART NO. G835G
PATT.		" "		

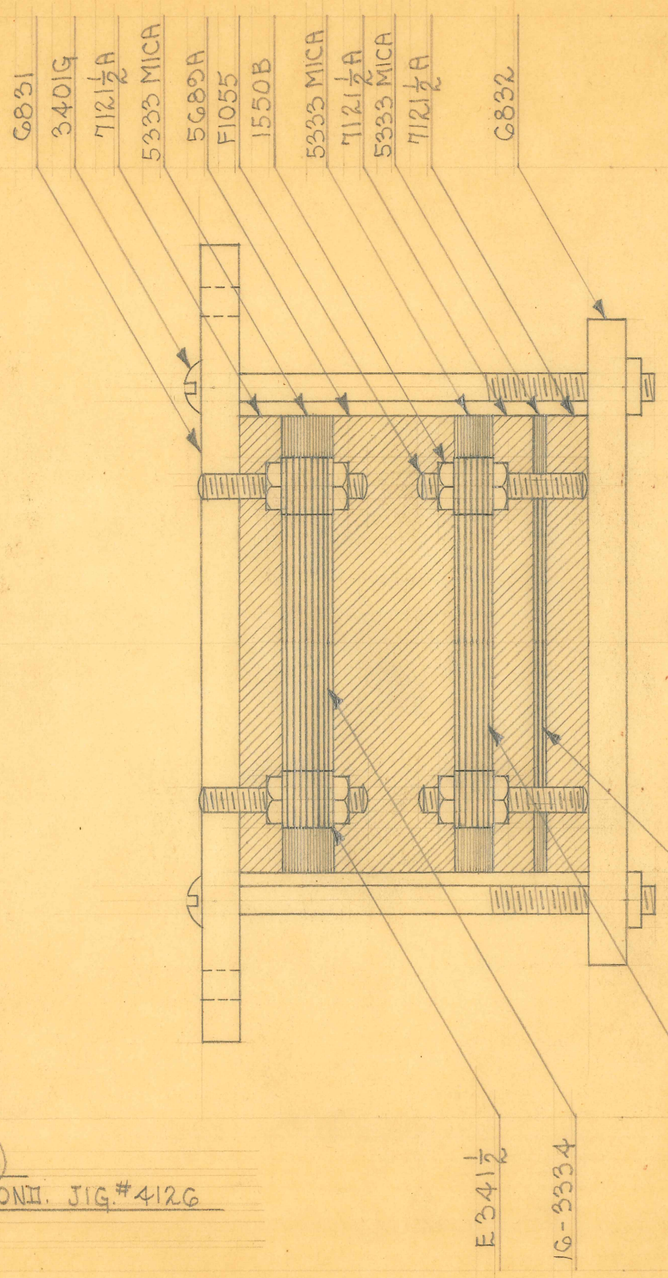

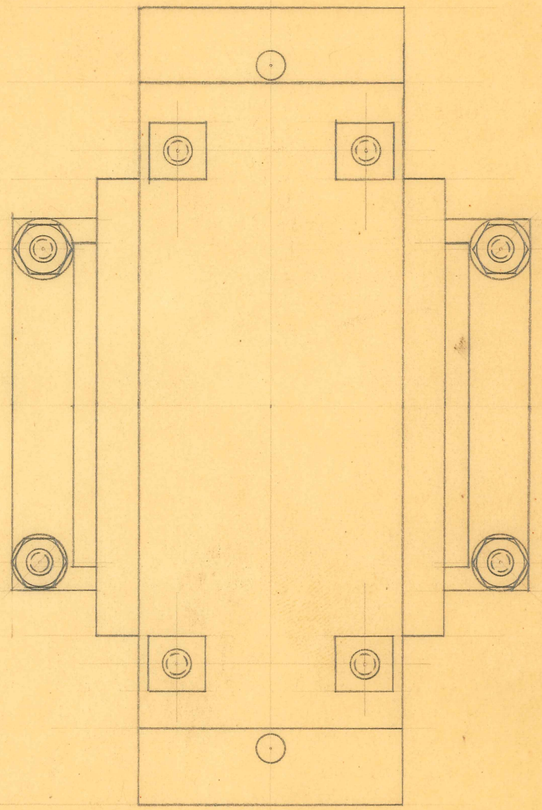

NOTE:-
MICA SPLIT TO .012" (4-7 SHEETS)
1-12 PLATE CONN. 1-16 PLATE CONN. JIG.#4126
1-3 PLATE GRN. CONN.

SIZE		ISSUE 2-17-32	A.E.
KIND		CHANGED	
SHAPE		" "	
FINISH		" "	
TEMP.		" "	
PATT.		" "	

TITLE: SURGICAL DIATHERMY OUTFIT CONDENSER ASSEM.

OBSOLETE

H. G. FISCHER & CO.
2335 WABANSIA AVE.
CHICAGO, ILL.

CAT. NO.

PART NO. G830G

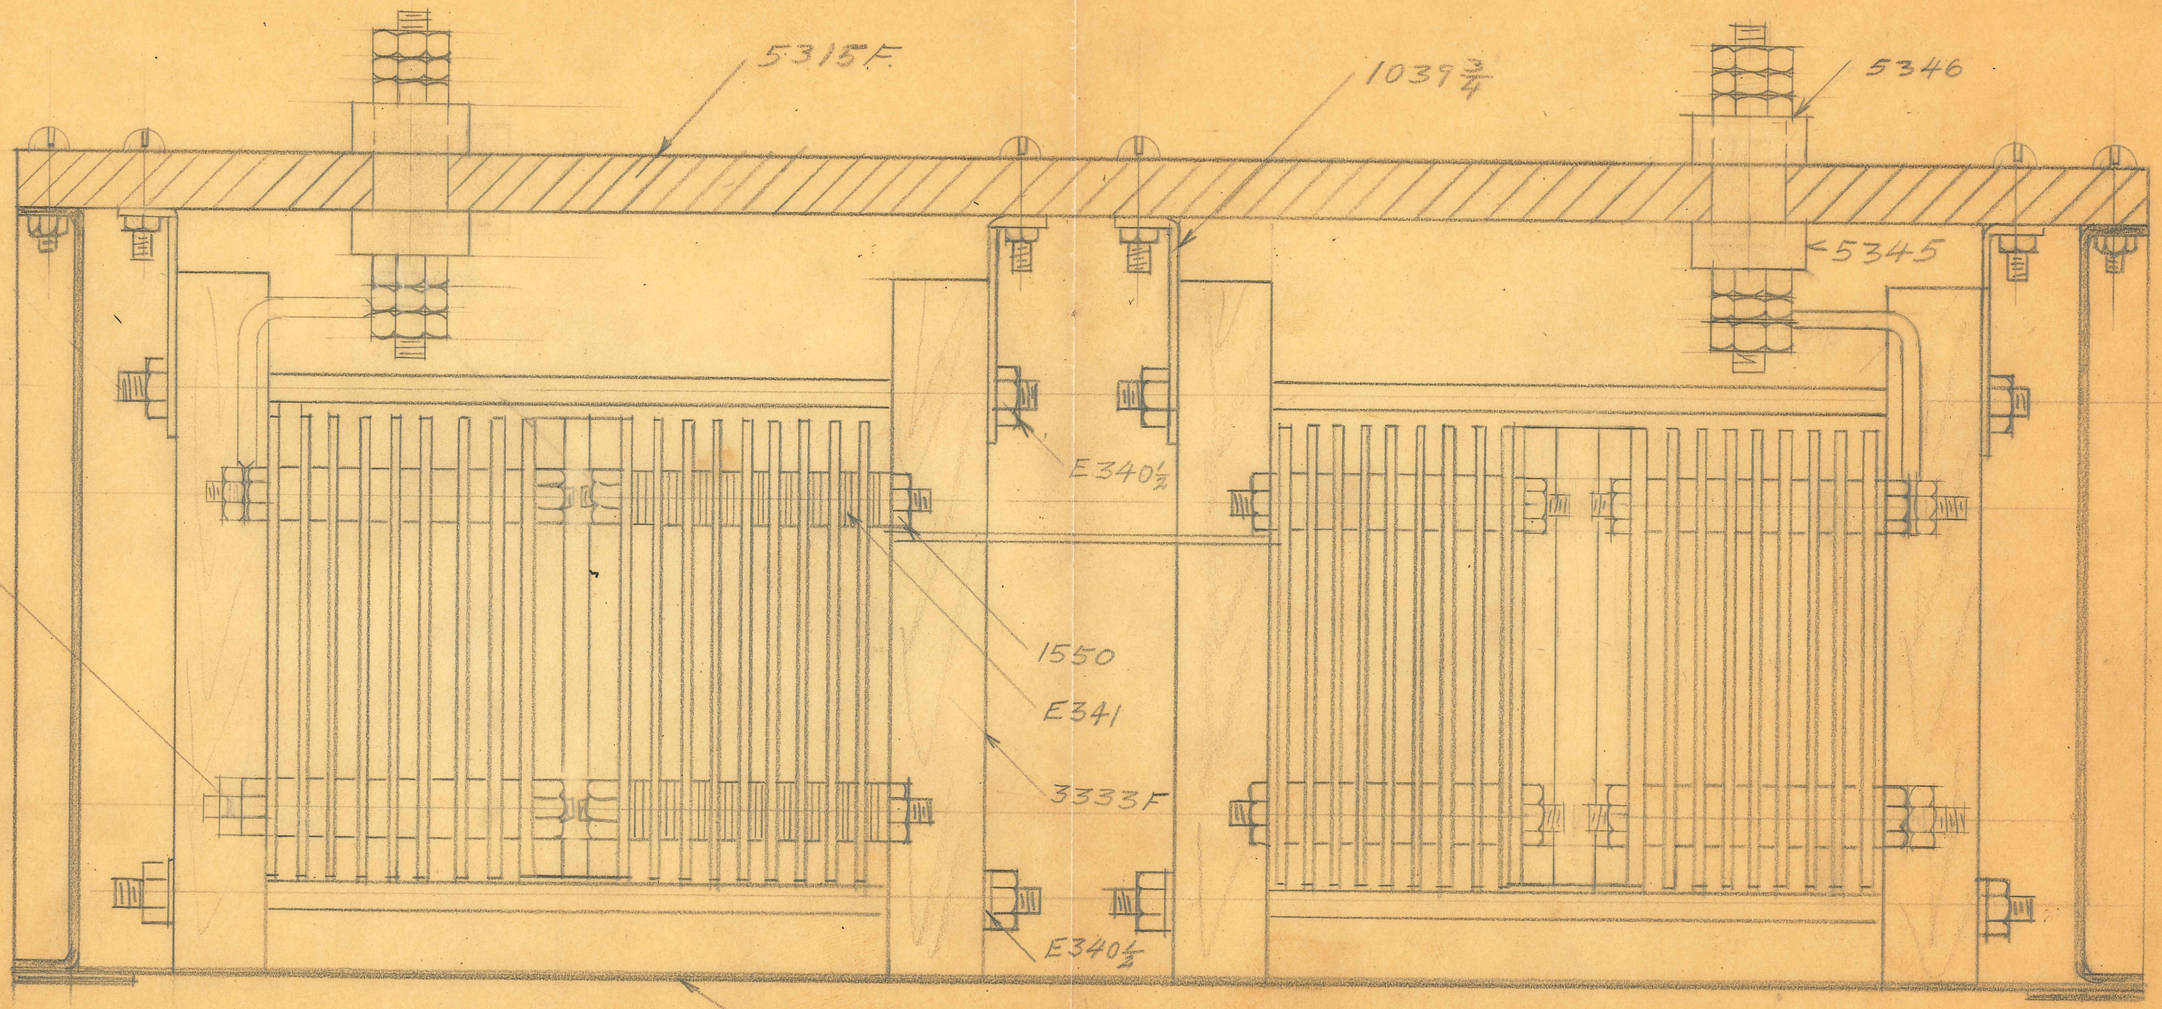

OBSOLETE

SIZE		ISSUED 3-24-26	CP.
KIND		CHANGED	
SHAPE		" "	
FINISH		" "	
TEMP.		" "	
PATT.		" "	

TITLE: TYPE "V" MED. DIA. CONDENSER COMPL.

H. G. FISCHER & CO.
2335 WABANSIA AVE.
CHICAGO, ILL.

CAT. NO.

PART NO. 5331G

(1)

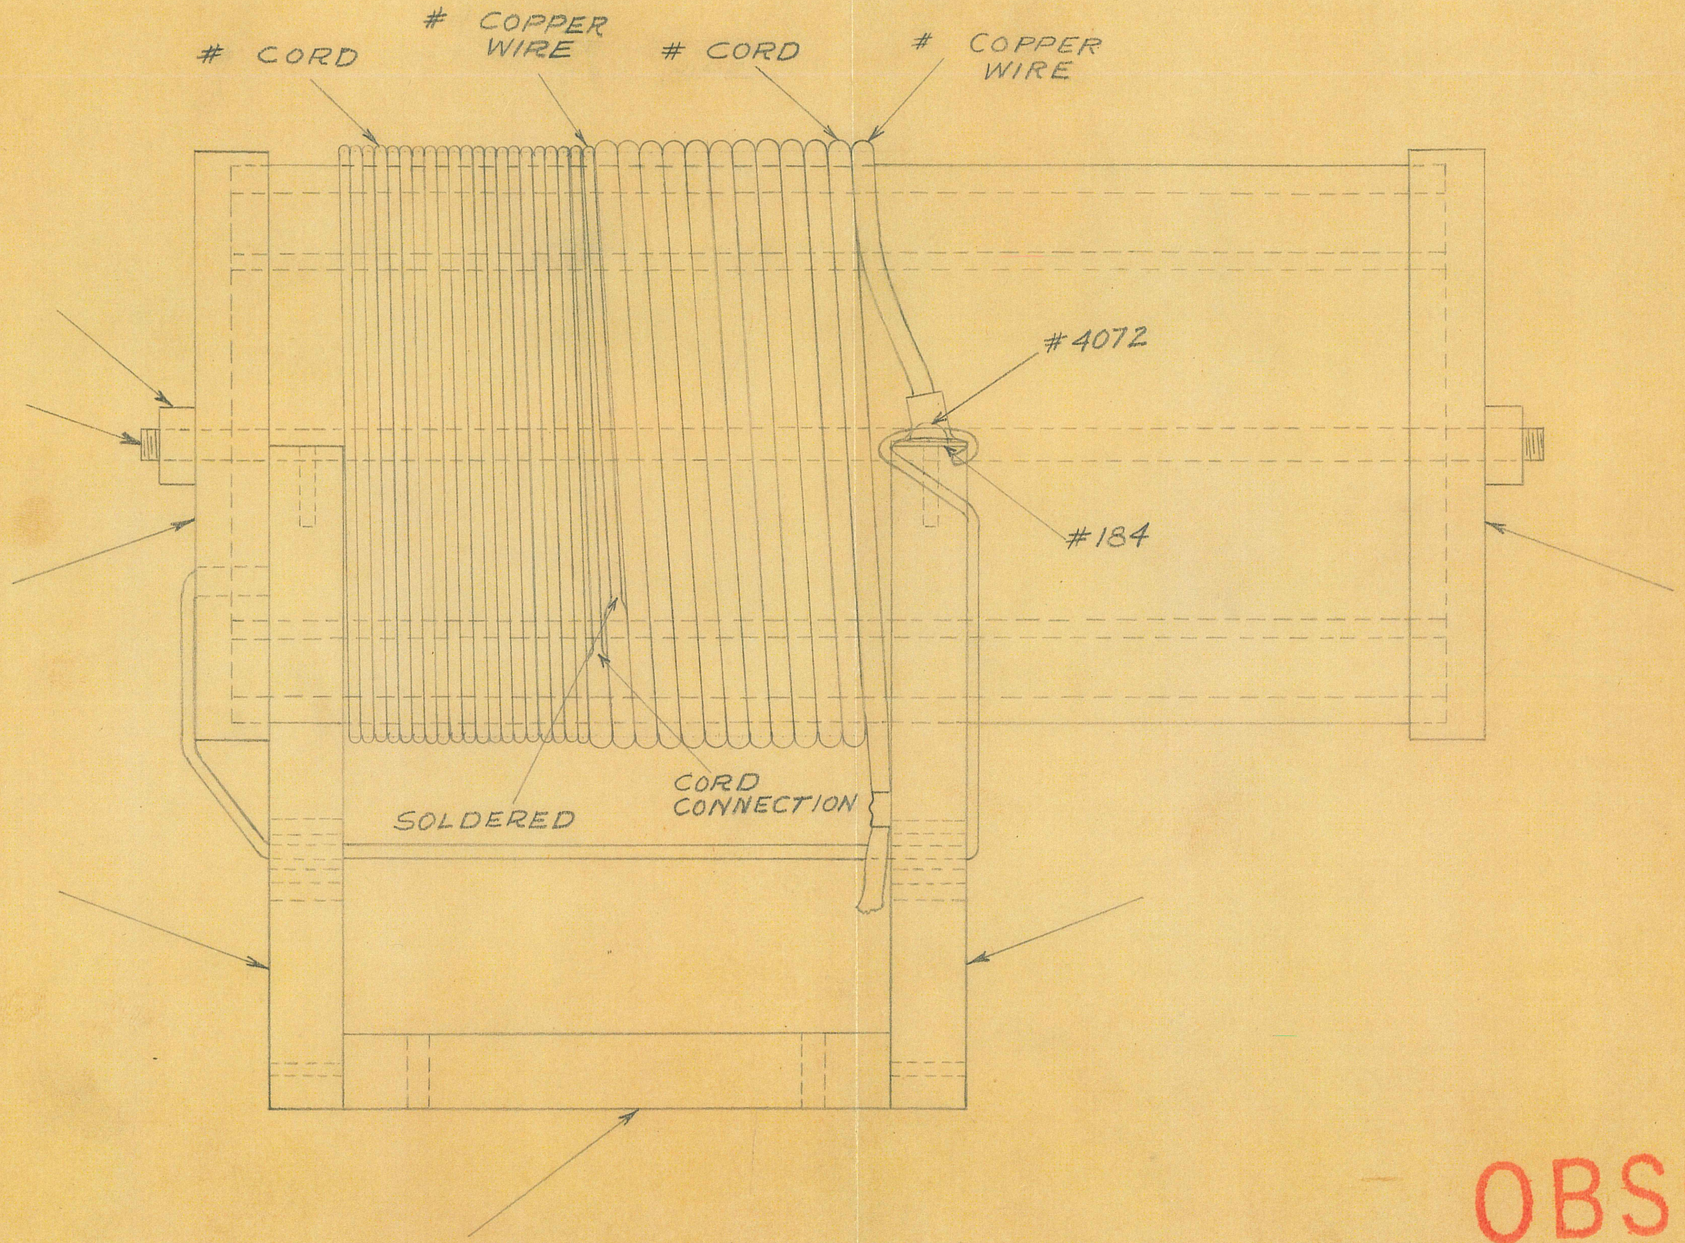

OBSOLETE

SIZE		ISSUE	
KIND		CHANGED	
SHAPE		" "	
FINISH		" "	
TEMP.		" "	
PATT.		" "	

TITLE:

TYPE "G"
TESLA COIL

H. G. FISCHER & CO.
2335 WABANSIA AVE.
CHICAGO, ILL.

CAT. NO.

PART NO. 3359G

3359G

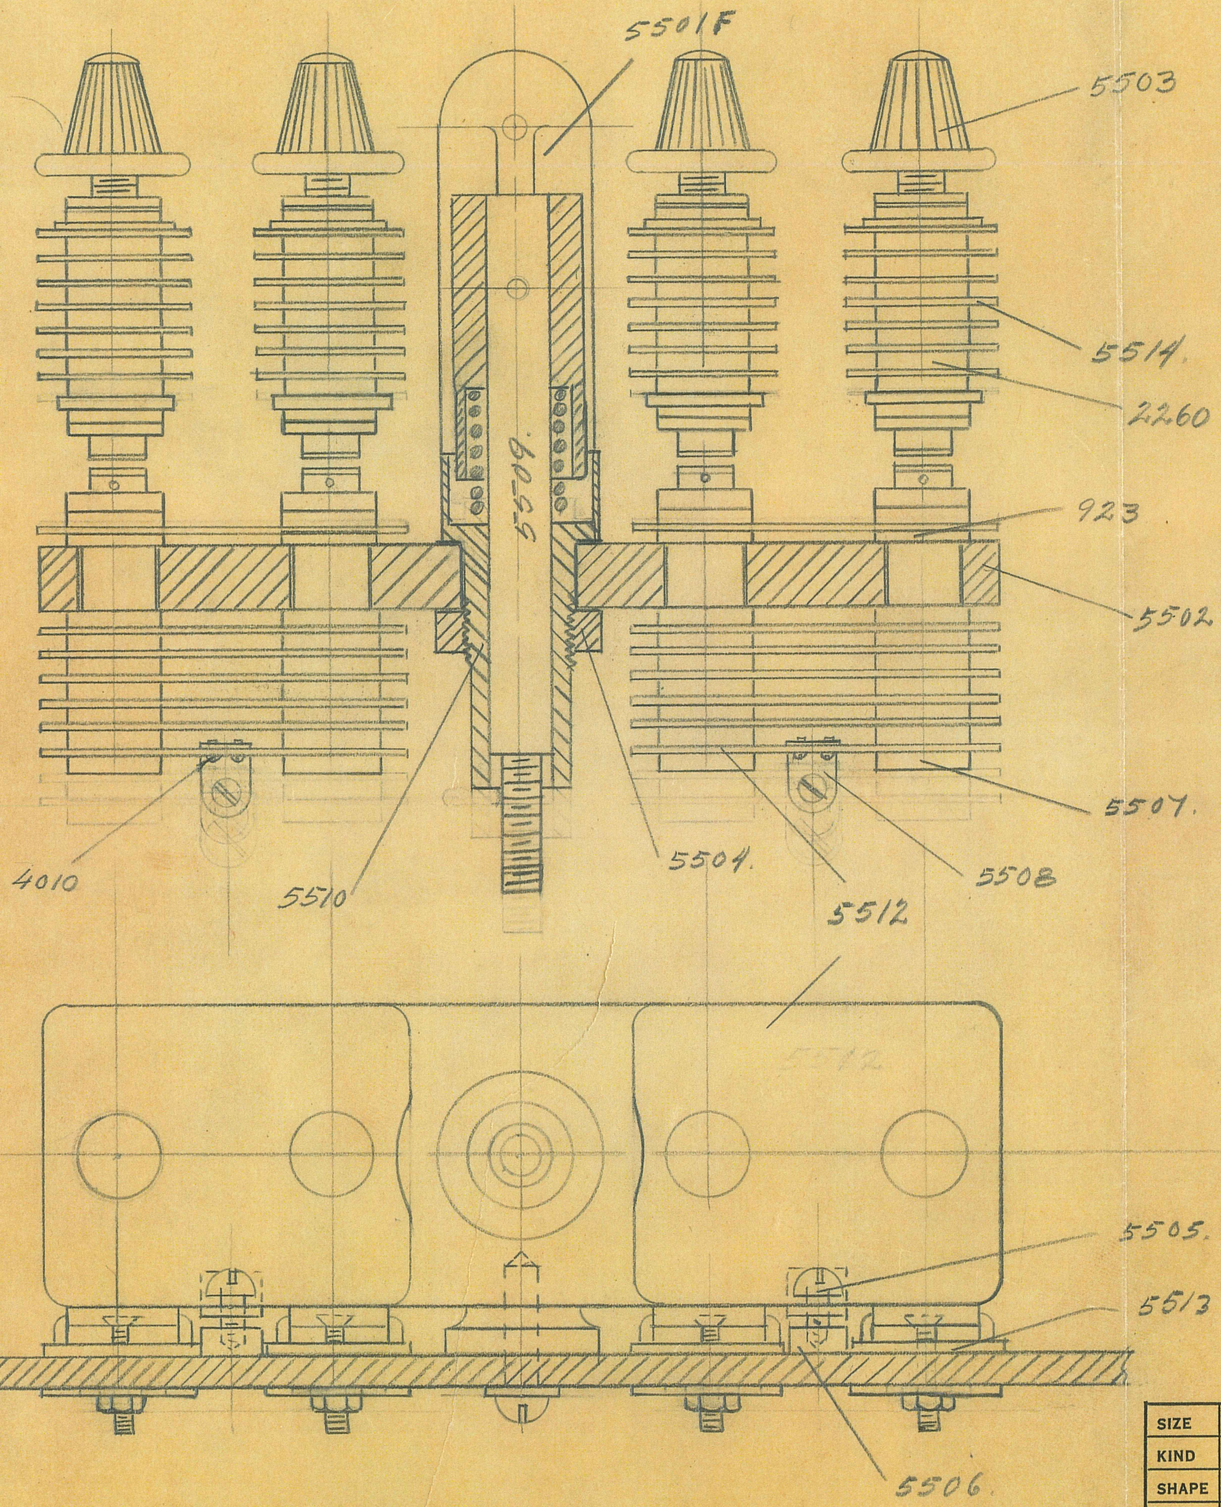

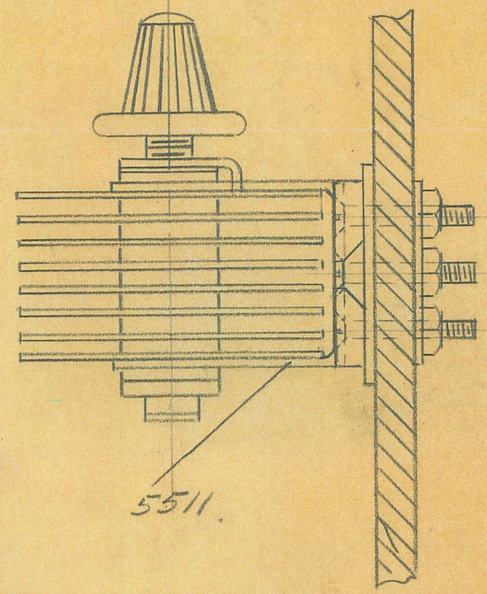

OBSOLETE

SIZE		ISSUE 4-1-26	
KIND		CHANGED	
SHAPE		" "	
FINISH		" "	
TEMP.		" "	
PATT.		" "	

TITLE: FOUR-UNIT-GAP TYPE G

H. G. FISCHER & CO.
2335 WABANSIA AVE.
CHICAGO, ILL.

CAT. NO.

PART NO. 5500G

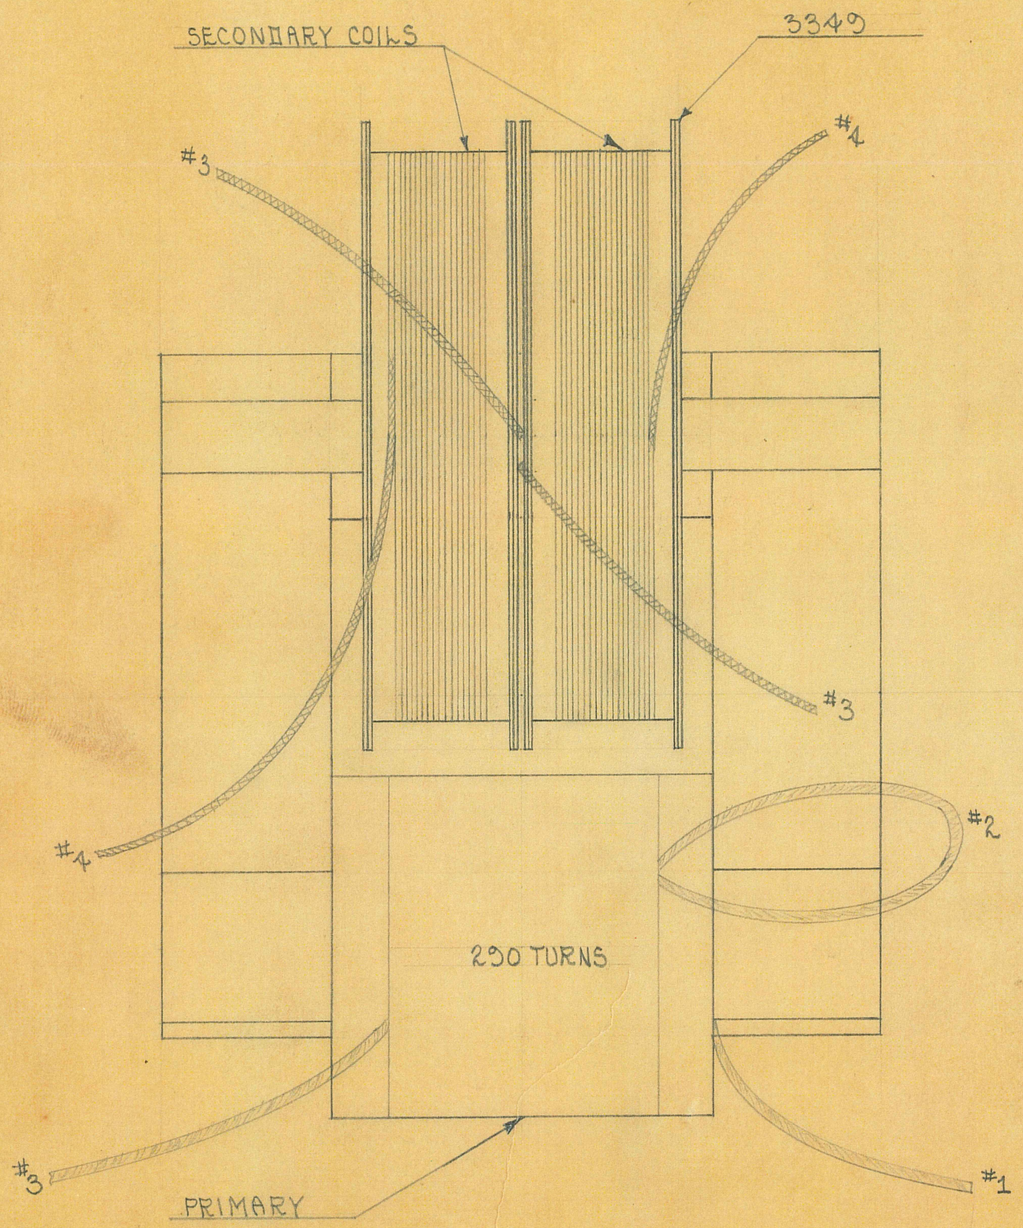

SCALE ~ 3/4" = 1"

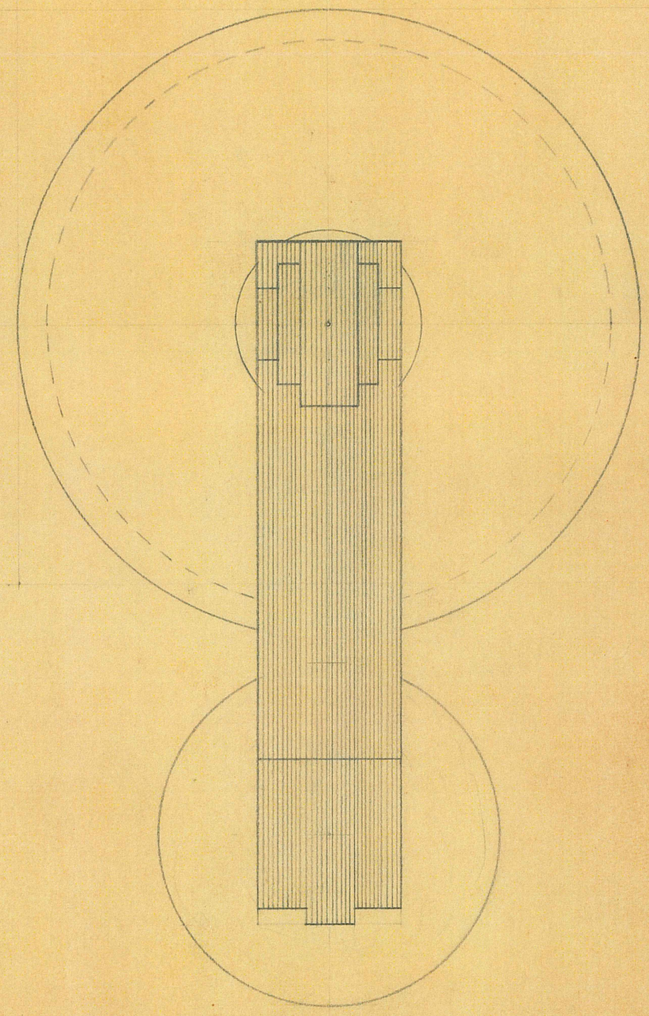

STEEL SIZES
PC. NO. 5043

$4\frac{7}{8}$" X $1\frac{5}{16}$" BUILT UP TO $1\frac{1}{4}$" (PRI. CORE)

$4\frac{7}{8}$" X $1\frac{7}{16}$" BUILT UP TO $1\frac{1}{2}$"
$4\frac{7}{8}$" X $1\frac{1}{16}$" BUILT UP TO $\frac{3}{16}$"
$4\frac{7}{8}$" X $\frac{5}{8}$" BUILT UP TO $\frac{3}{16}$"
} SEC. CORE (JIG # 3005)

END PCS. $4\frac{1}{2}$ X $1\frac{1}{2}$"

BIND CORES WITH FRICTION TAPE

WINDING DATA

PRIMARY

USE # 14 COTENAMEL WIRE.

4 LAYERS OF 5026 $\frac{1}{4}$ OILED CLOTH ON CORE. ANCHOR LEAD #1 WITH LINEN TAPE AND WIND TO 275 TURNS AND BRING OUT TAP #2. WIND 15 TURNS MORE AND END WITH LEAD #3. TOTAL - 290 TURNS. ANCHOR LEAD #3 WITH LINEN TAPE. NO DEFINITE NUMBER OF TURNS TO EACH LAYER BUT INSULATE WITH 2 LAYERS OF 5026 $\frac{1}{4}$ BETWEEN EACH LAYER OF WIRE. COVER LAST LAYER OF WIRE WITH 5004 OILED TAPE AND SHELLAC.

SECONDARY

USE # 29 ENAMEL WIRE.

WIND 8" STRIP OF 5009 OILED PAPER ON 3344F TUBE. ANCHOR LEAD #4 (SEC. LEADS ARE APPROX. 7" OF 1631) AND WIND 88 LAYERS, 70 TURNS TO A LAYER. INSULATE BETWEEN EACH LAYER OF WIRE WITH 1 LAYER OF 5009 OILED PAPER, TOTAL 6160 TURNS. COVER 88TH LAYER WITH 1 LAYER OF 5009 OILED PAPER AND FINISH WITH 1 LAYER (NO DEFINITE NUMBER OF TURNS) OF # 22 ENAMEL WIRE, ANCHORING LEAD #4 WITH LINEN TAPE. END OF # 29 E. WIRE CONNECTED TO START OF # 22 E. WIRE. SHELLAC LAST LAYER.

SIZE		ISSUE 3-4-32	H.E.
KIND		CHANGED	
SHAPE		" "	
FINISH		" "	
TEMP.		" "	
PATT.		" "	

TITLE: PORTABLE DIATHERMY TRANSFORMER

OBSOLETE

H. G. FISCHER & CO.
2335 WABANSIA AVE.
CHICAGO, ILL.

CAT. NO.

PART NO. 3343G

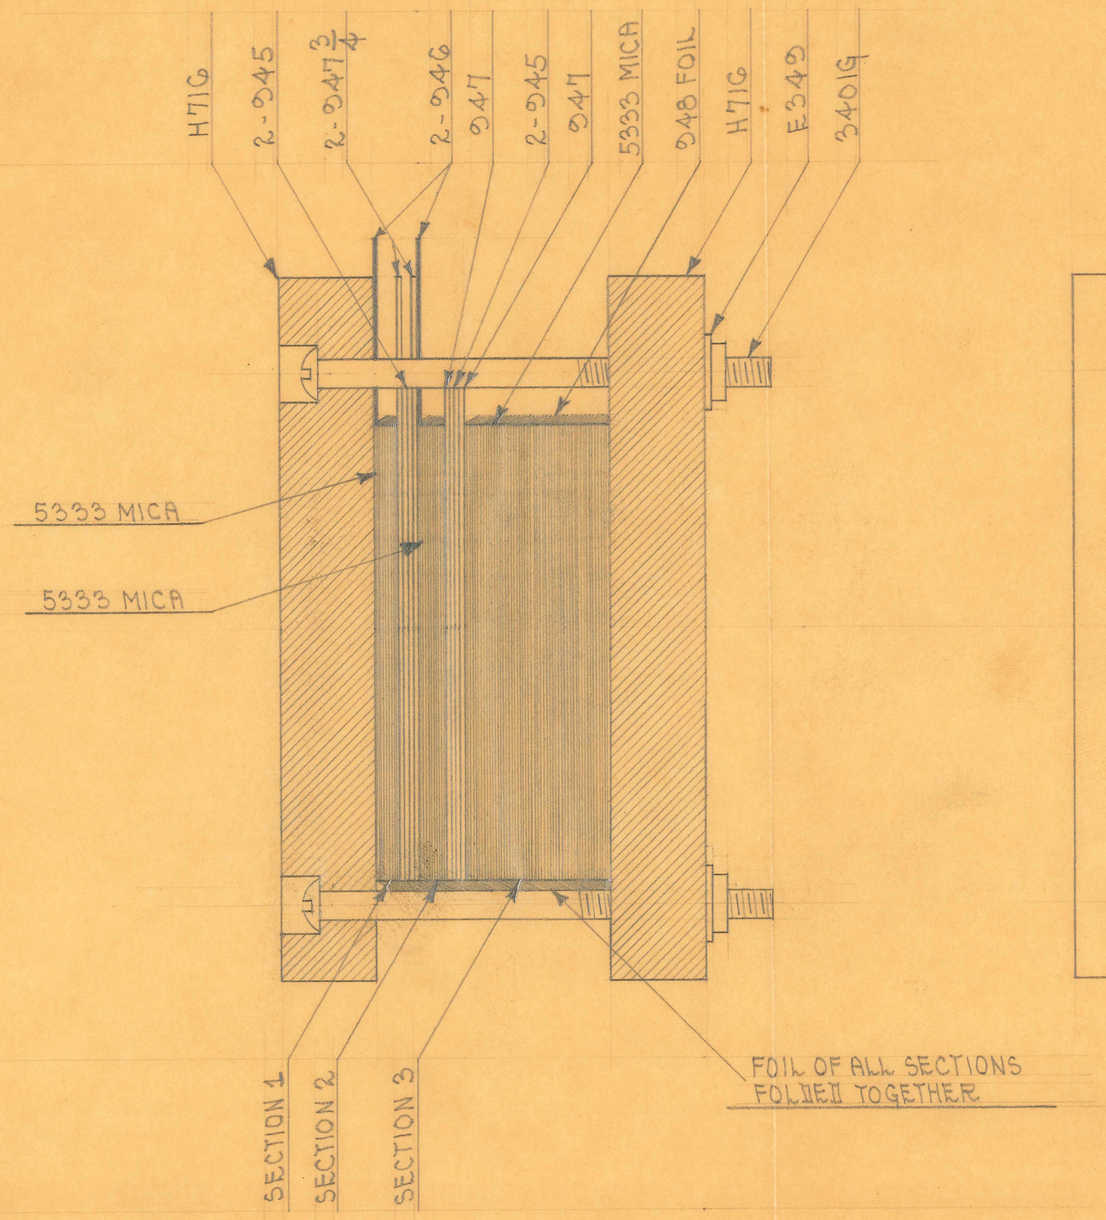

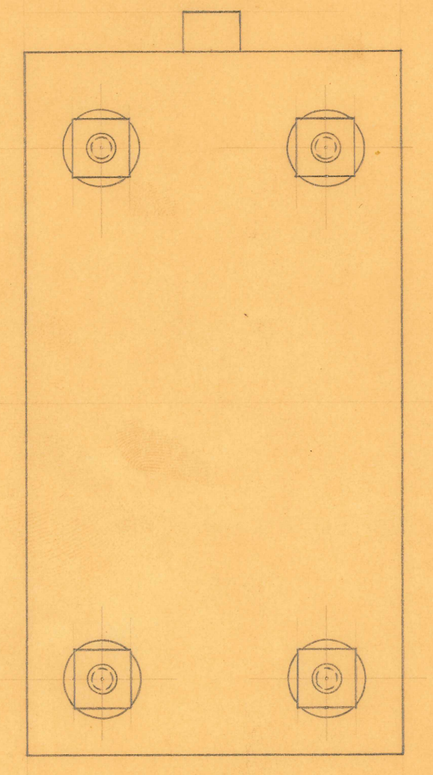

NOTE:-
MICA SPLIT .004" (AT LEAST 3 SHEETS)
SECT. 1 - 24 SHEETS OF 348 FOIL. 12 ON EACH SIDE.
SECT. 2 - 32 SHEETS OF 348 FOIL. 16 ON EACH SIDE.
SECT. 3 - 180 SHEETS OF 348 FOIL. 90 ON EACH SIDE.

SIZE		ISSUE 3-1-32	A.E.
KIND		CHANGED	
SHAPE		" "	
FINISH		" "	
TEMP.		" "	
PATT.		" "	

TITLE: "E" CONDENSER

OBSOLETE

H. G. FISCHER & CO.
2335 WABANSIA AVE.
CHICAGO, ILL.

CAT. NO.

PART NO. E[illegible]G

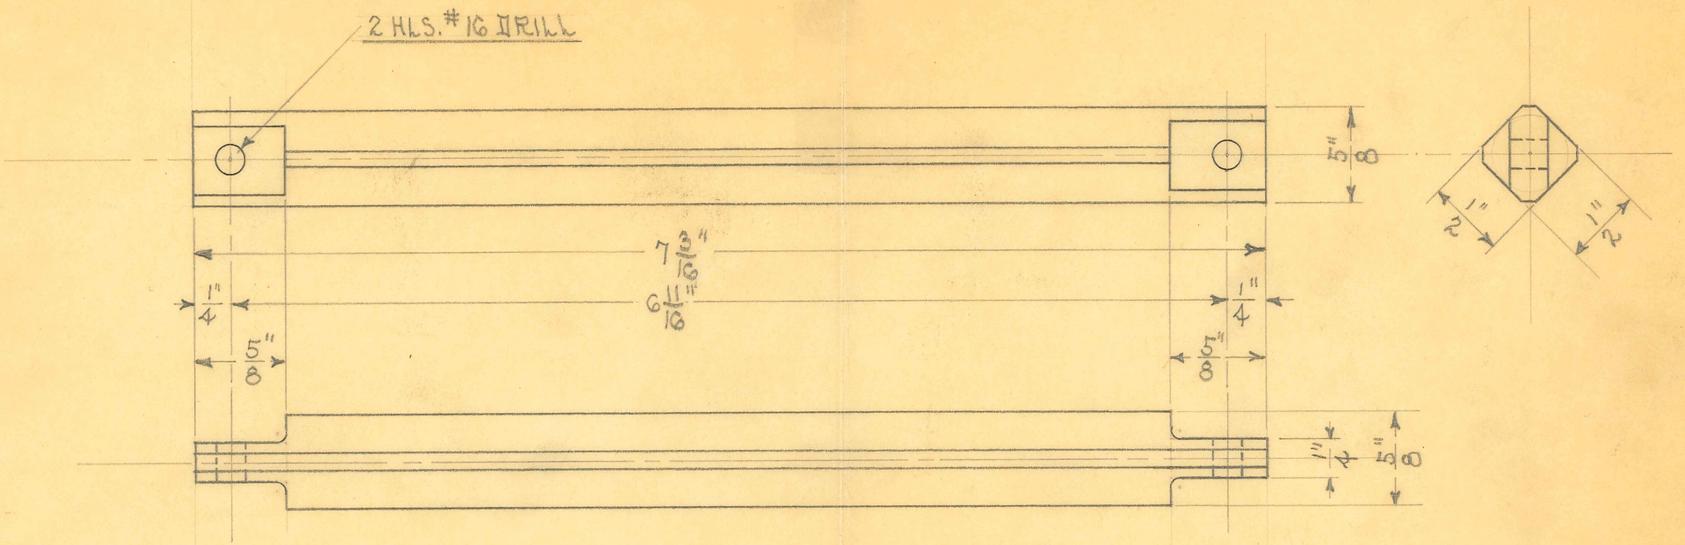

SCALE ~ FULL SIZE

OBSOLETE

SIZE		ISSUE 1-16-32	H.E.	TITLE: MODEL "M" LAMP ISOLANTITE ROD
KIND	ISOLANTITE	CHANGED		
SHAPE		" "		
FINISH		" "		
TEMP.		" "		H. G. FISCHER & CO. 2335 WABANSIA AVE. CHICAGO, ILL. — CAT. NO. — PART NO. 5713A
PATT.		" "		

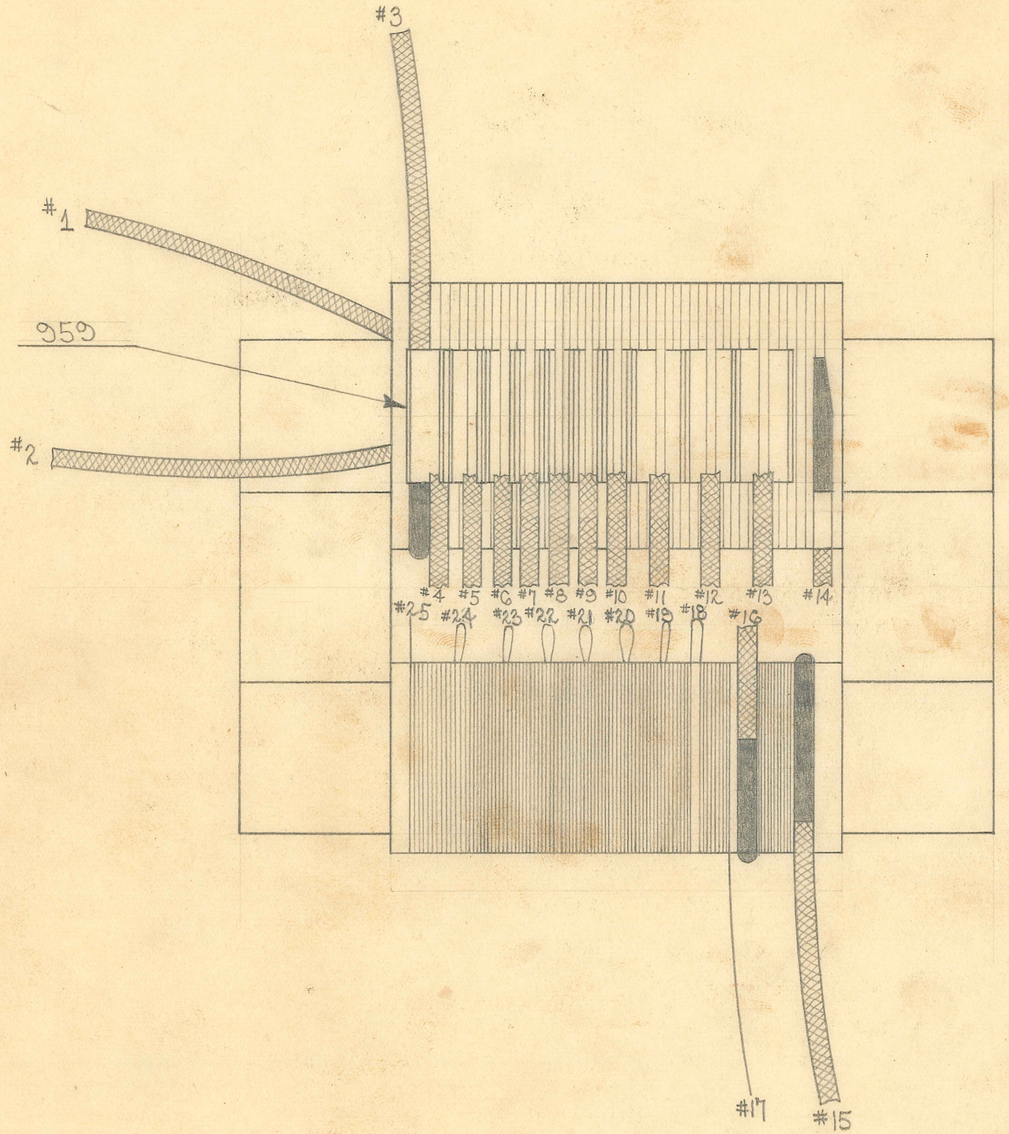

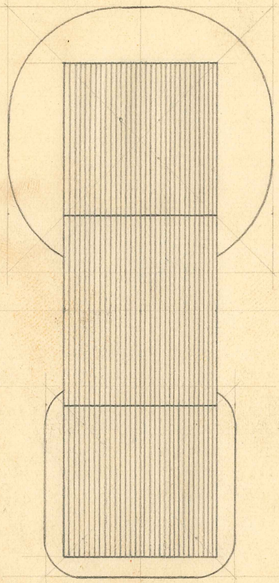

STEEL SIZES

PC. NO. 5043

CORE LAMS. CUT - 4" X 1" BUILT UP TO 1".
END PIECES CUT - 2 1/4" X 1".
BIND CORES WITH FRICTION TAPE.

WINDING DATA

PRIMARY

USE #24 ENAMEL WIRE

3 LAYERS OF 502D FIBROID PAPER ON CORE.
ANCHOR LEAD #1 WITH FRICTION TAPE & WIND 600 TURNS & ANCHOR LEAD #2 WITH FRICTION TAPE.
1 LAYER OF FIBROID BETWEEN EACH LAYER OF WIRE.
COVER PRI. WITH 3 LAYERS OF FIBROID.

CAUTERY & DIAGNOSTIC

USE #16 COTENAMEL WIRE

ANCHOR LEAD #3 WITH FRICTION TAPE & WIND 3 TURNS & TAP - LEAD #4 (TAPS #4 TO #13 INCL. EACH INSULATED WITH 1 - 959 FIBRE SEPARATOR), WIND 1 TURN & TAP - LEAD #5. WIND 2 TURNS & TAP - LEAD #6. WIND 2 TURNS & TAP - LEAD #7. WIND 3 TURNS & TAP - LEAD #8. WIND 3 TURNS & TAP - LEAD #9. WIND 4 TURNS & TAP - LEAD #10. WIND 5 TURNS & TAP - LEAD #11. WIND 6 TURNS & TAP - LEAD #12. WIND 7 TURNS & TAP - LEAD #13. WIND 8 TURNS & ANCHOR END WITH FRICTION TAPE - LEAD #14. SHELLAC WINDING.

SINUSOIDAL

USE #26 COTENAMEL WIRE

3 LAYERS OF 5D20 FIBROID ON OTHER CORE. ANCHOR LEAD # 15 WITH FRICTION TAPE & WIND 40 TURNS & ANCHOR END WITH LINEN TAPE - LEAD #16. LEAD #1 - #16 INCL. ARE 1603 - #18 STRANDED WIRE. ANCHOR LEAD #17 WITH FRICTION TAPE & WIND 9 TURNS & BRING OUT TAP #18. WIND 10 TURNS & BRING OUT TAP #19. WIND 11 TURNS & BRING OUT TAP #20. WIND 12 TURNS & BRING OUT TAP #21. WIND 13 TURNS & BRING OUT TAP #22. WIND 15 TURNS & BRING OUT TAP #23. WIND 18 TURNS & BRING OUT TAP #24. WIND 21 TURNS & ANCHOR END WITH LINEN TAPE - LEAD #25. SHELLAC WINDING.

SIZE		ISSUE 10-31-32	A.E.
KIND		CHANGED	
SHAPE		" "	
FINISH		" "	
TEMP.		" "	
PATT.		" "	

TITLE: C. D. S. TRANSFORMER

OBSOLETE

H. G. FISCHER & CO.
2335 WABANSIA AVE.
CHICAGO, ILL.

CAT. NO.

PART NO. 600G

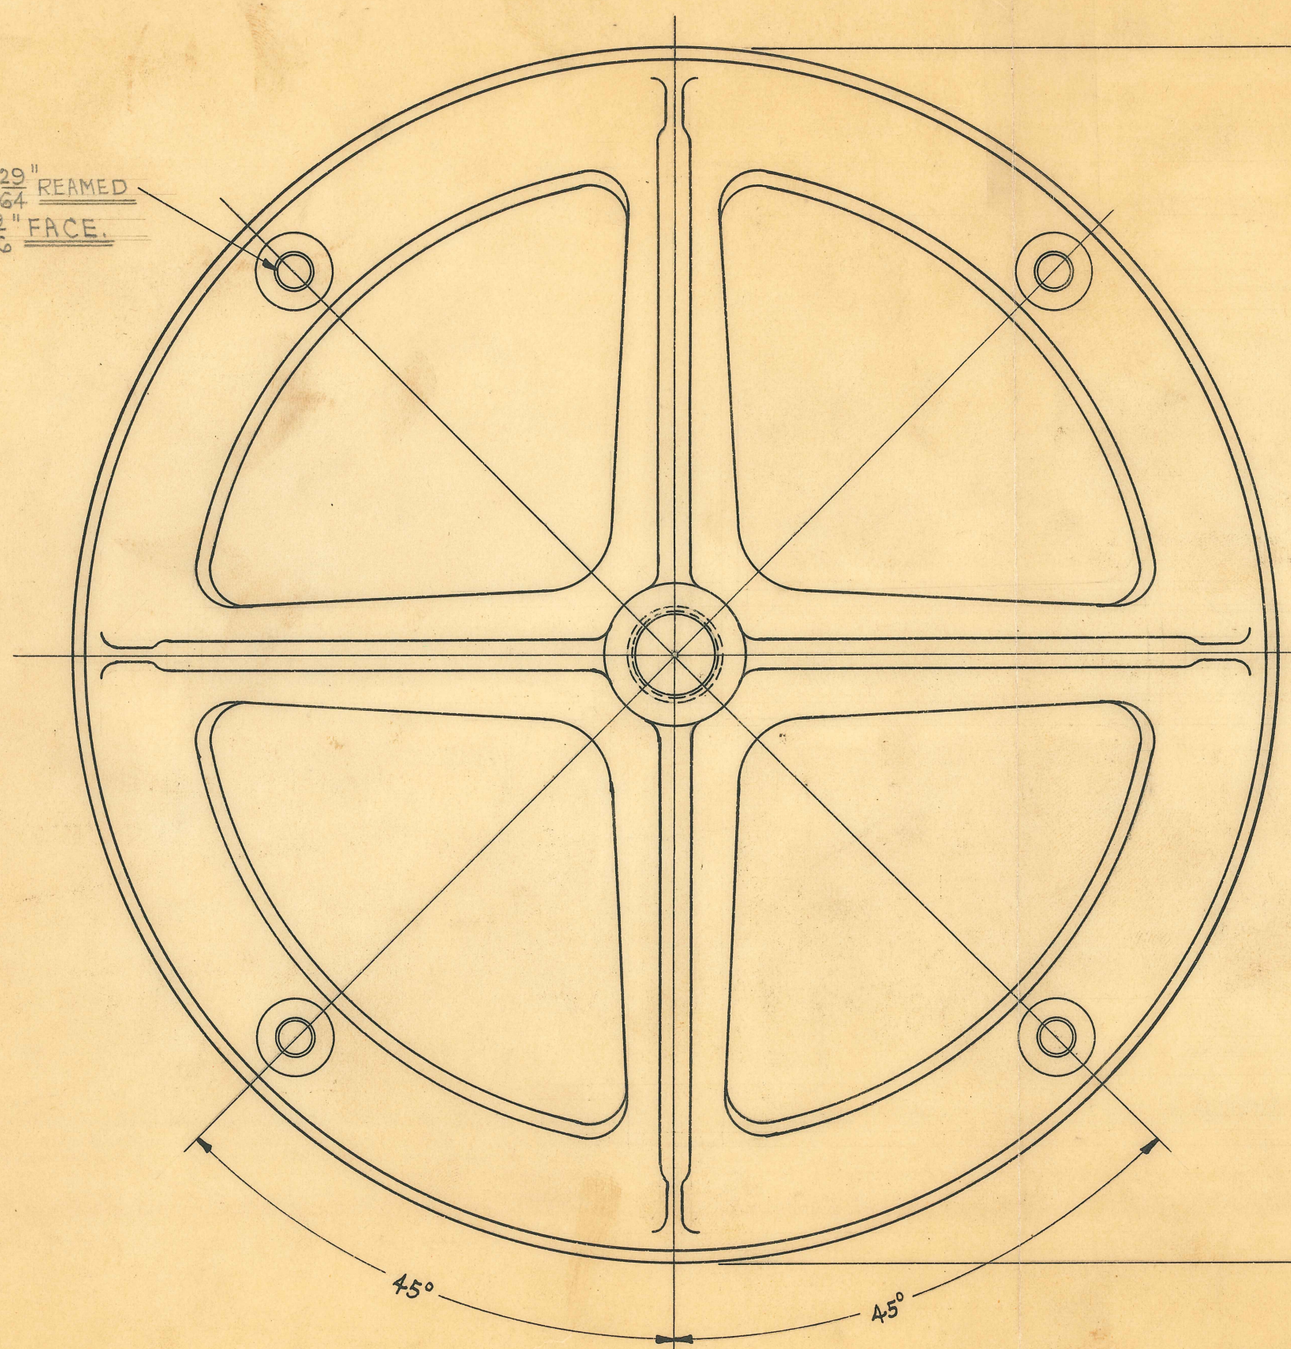

SCALE ~ 1/2 SIZE

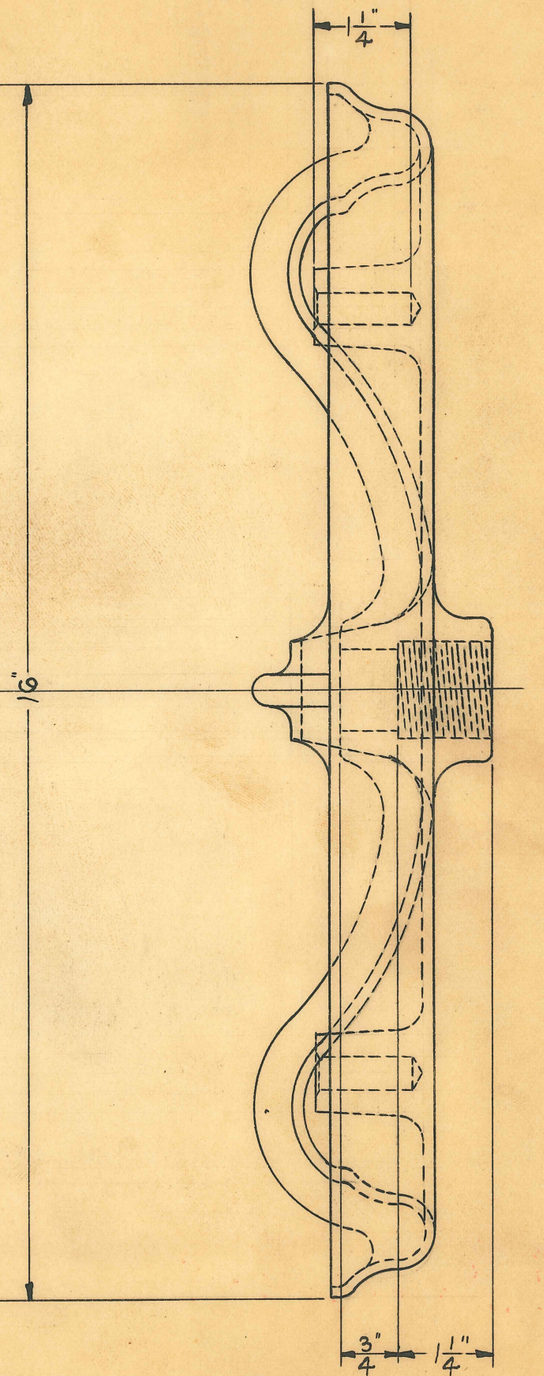

SIZE		ISSUE H.E.	5-2-30
KIND	IRON CASTING	CHANGED	
SHAPE		" "	
FINISH		" "	
TEMP.		" "	
PATT.		" "	

TITLE: PHYSICIANS MODEL ARC-LAMP BASE (FINISHED)

OBSOLETE

H. G. FISCHER & CO.
2335 WABANSIA AVE.
CHICAGO, ILL.

CAT. NO.

PART NO. 5821F

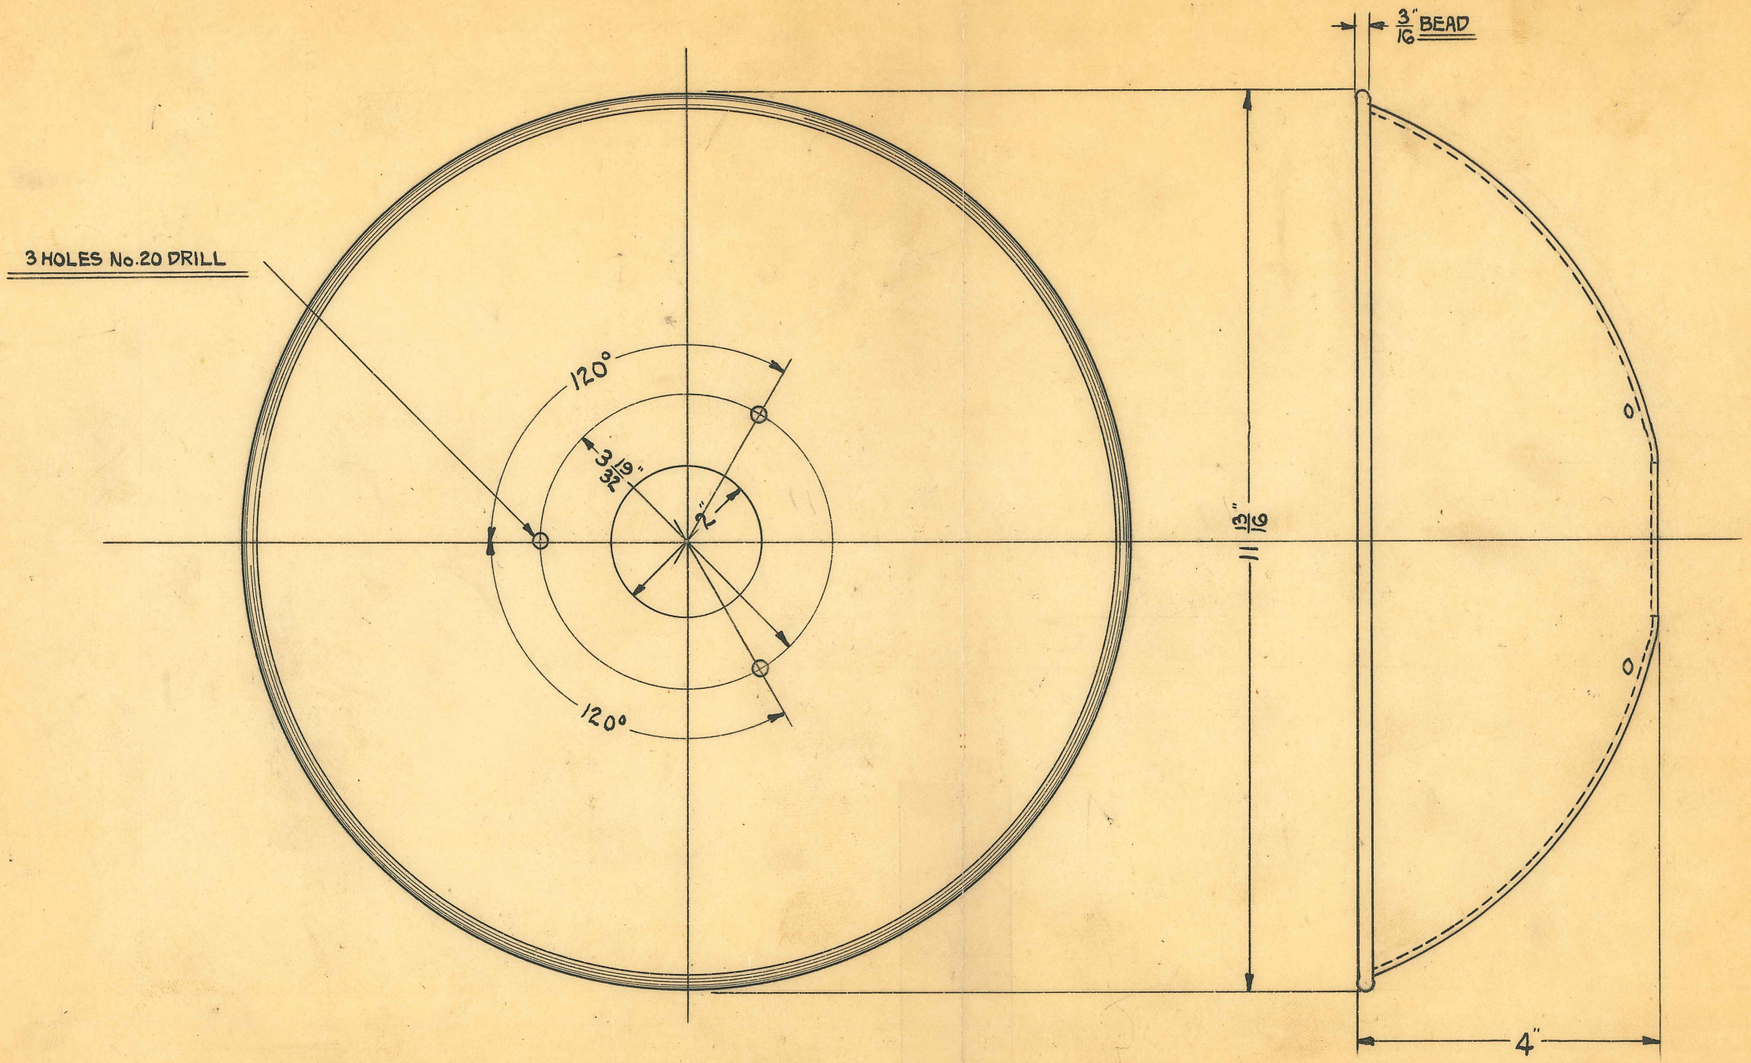

SCALE ≈ ½ SIZE

BOUGHT OUTSIDE

OBSOLETE

SIZE		ISSUE	11-6-29
KIND		CHANGED	
SHAPE		" "	
FINISH	POL. INSIDE & OUT	" "	
TEMP.		" "	
PATT.		" "	

TITLE: LAYMAN'S INFRA RED RAY GENERATOR HOOD

H. G. FISCHER & CO.
2335 WABANSIA AVE.
CHICAGO, ILL.

CAT. NO.

PART NO. 5779F

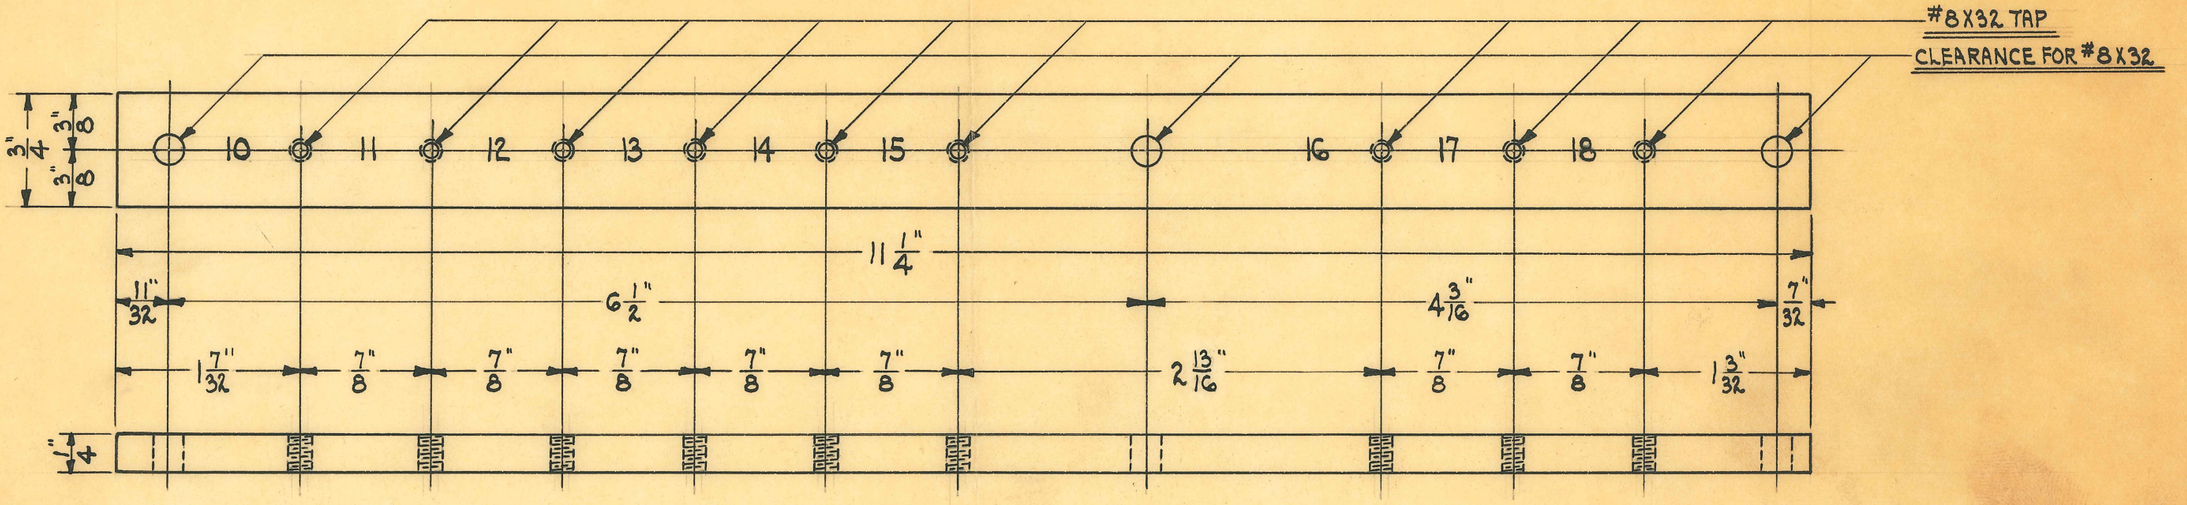

DRILL JIG #4533

OBSOLETE

SIZE	1/4" x 3/4" x 11 1/4"	ISSUE 10-16-30	A.E.	TITLE: WAVE GEN. FRONT CONNECTION BOARD
KIND	BAKELITE	CHANGED		
SHAPE	STRIP	" "		
FINISH		" "		
TEMP.		" "		H. G. FISCHER & CO. 2335 WABANSIA AVE. CHICAGO, ILL. — CAT. NO. — PART NO. 5635
PATT.		" "		

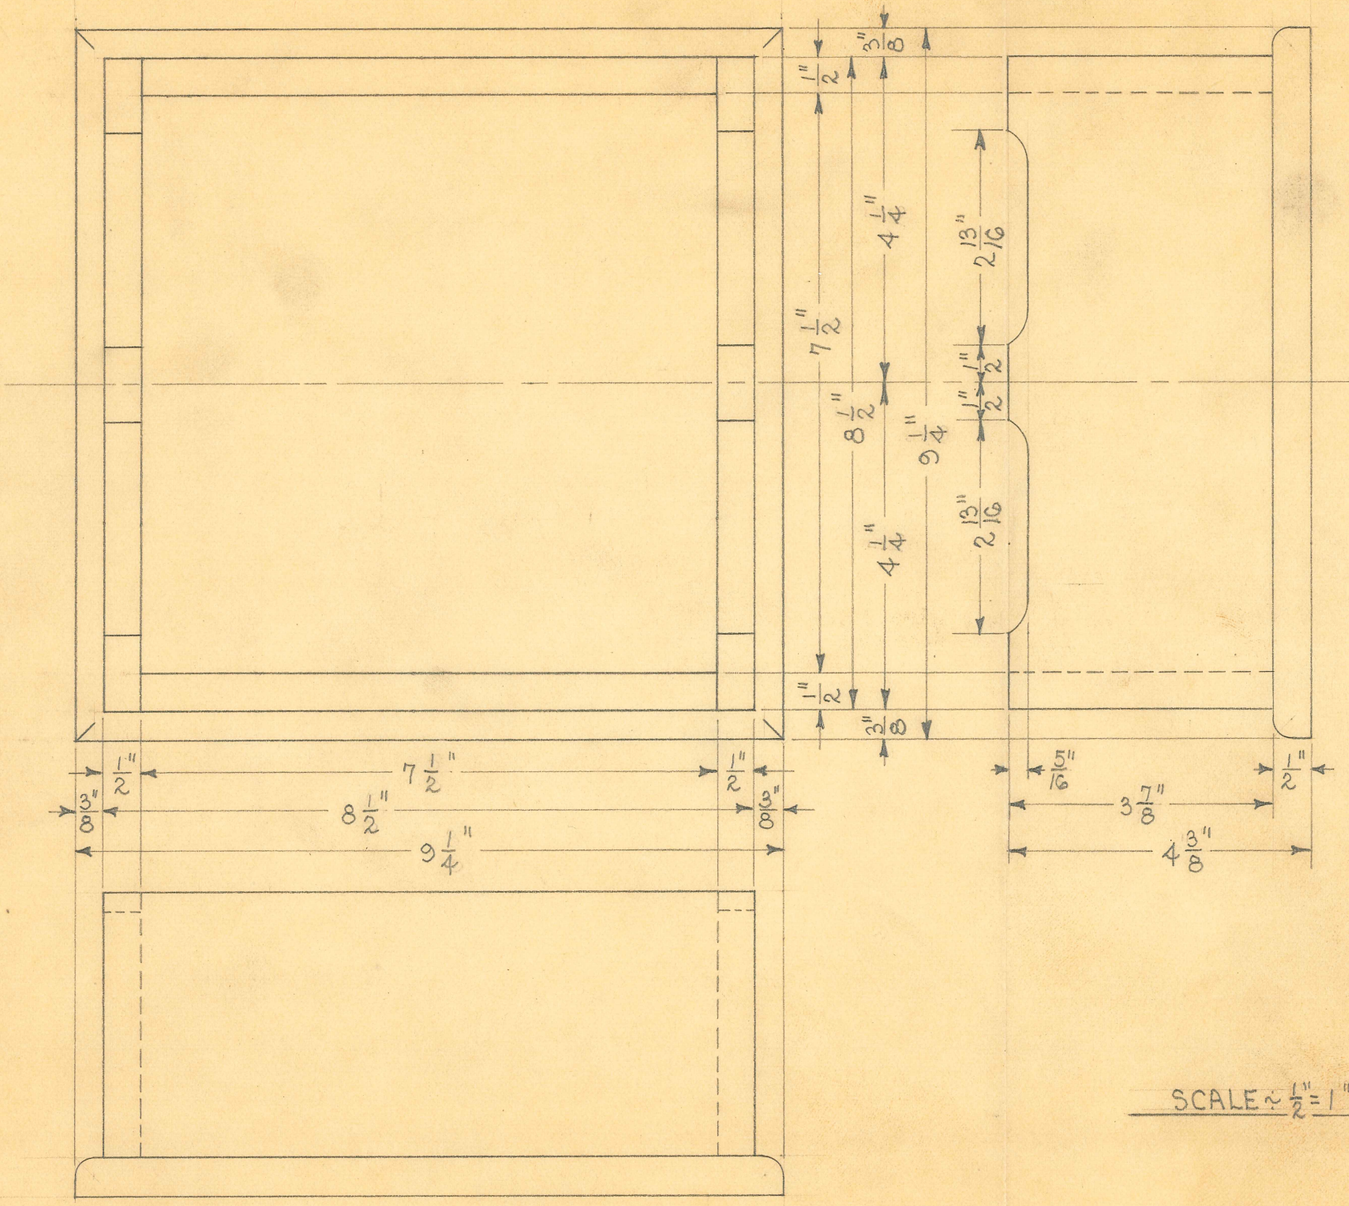

SCALE ~ 1/2" = 1"

SIZE		ISSUE 2-16-33	A.E.	TITLE: MOD. "A" "G2" & SPD. CUTTING ATTACHMENT BOX
KIND		CHANGED		
SHAPE		" "		
FINISH	WALNUT	" "		
TEMP.		" "		
PATT.		" "		

OBSOLETE

H. G. FISCHER & CO.
2335 WABANSIA AVE.
CHICAGO, ILL.

CAT. NO.

PART NO. 7701

1952

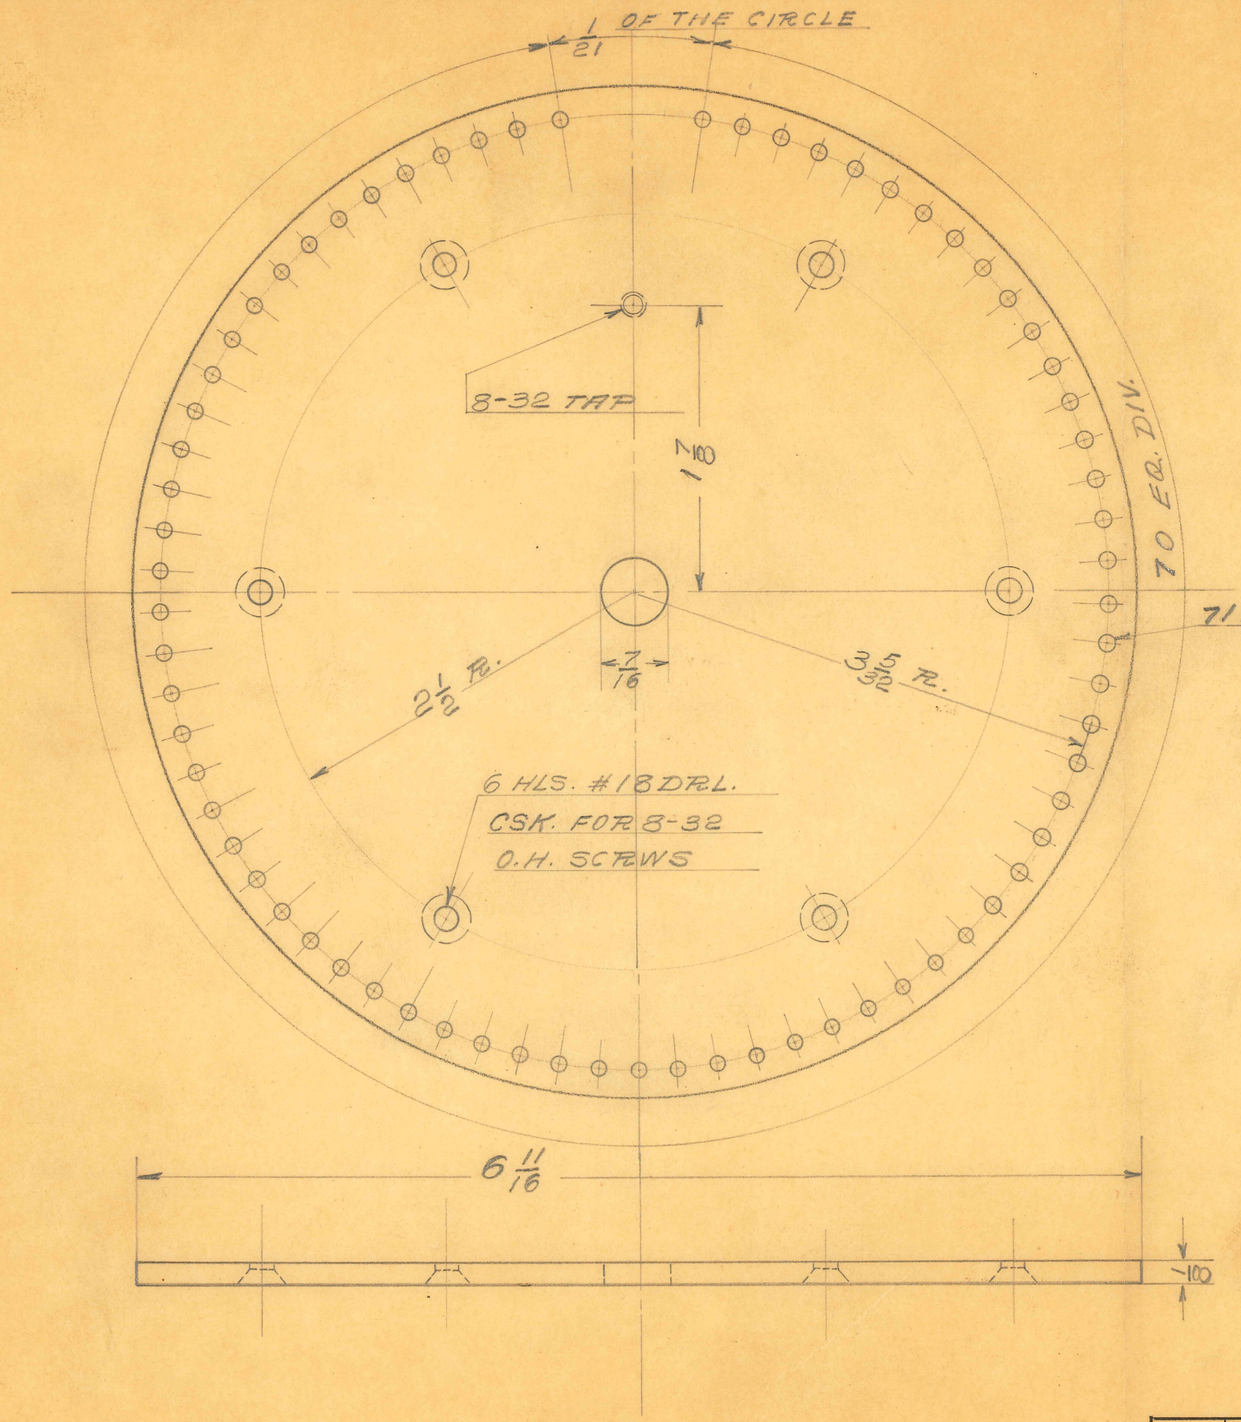

BAKELITE

1 REQ.

SCALE FULL SIZE

OBSOLETE

SIZE		ISSUE 1-27-31	C.H.
KIND		CHANGED	
SHAPE		" "	
FINISH		" "	
TEMP.		" "	
PATT.		" "	

TITLE: HIGH FREQUENCY POTENTIOMR.

LOWER PLATE

H. G. FISCHER & CO.
2335 WABANSIA AVE.
CHICAGO, ILL.

CAT. NO.

PART NO. 6604

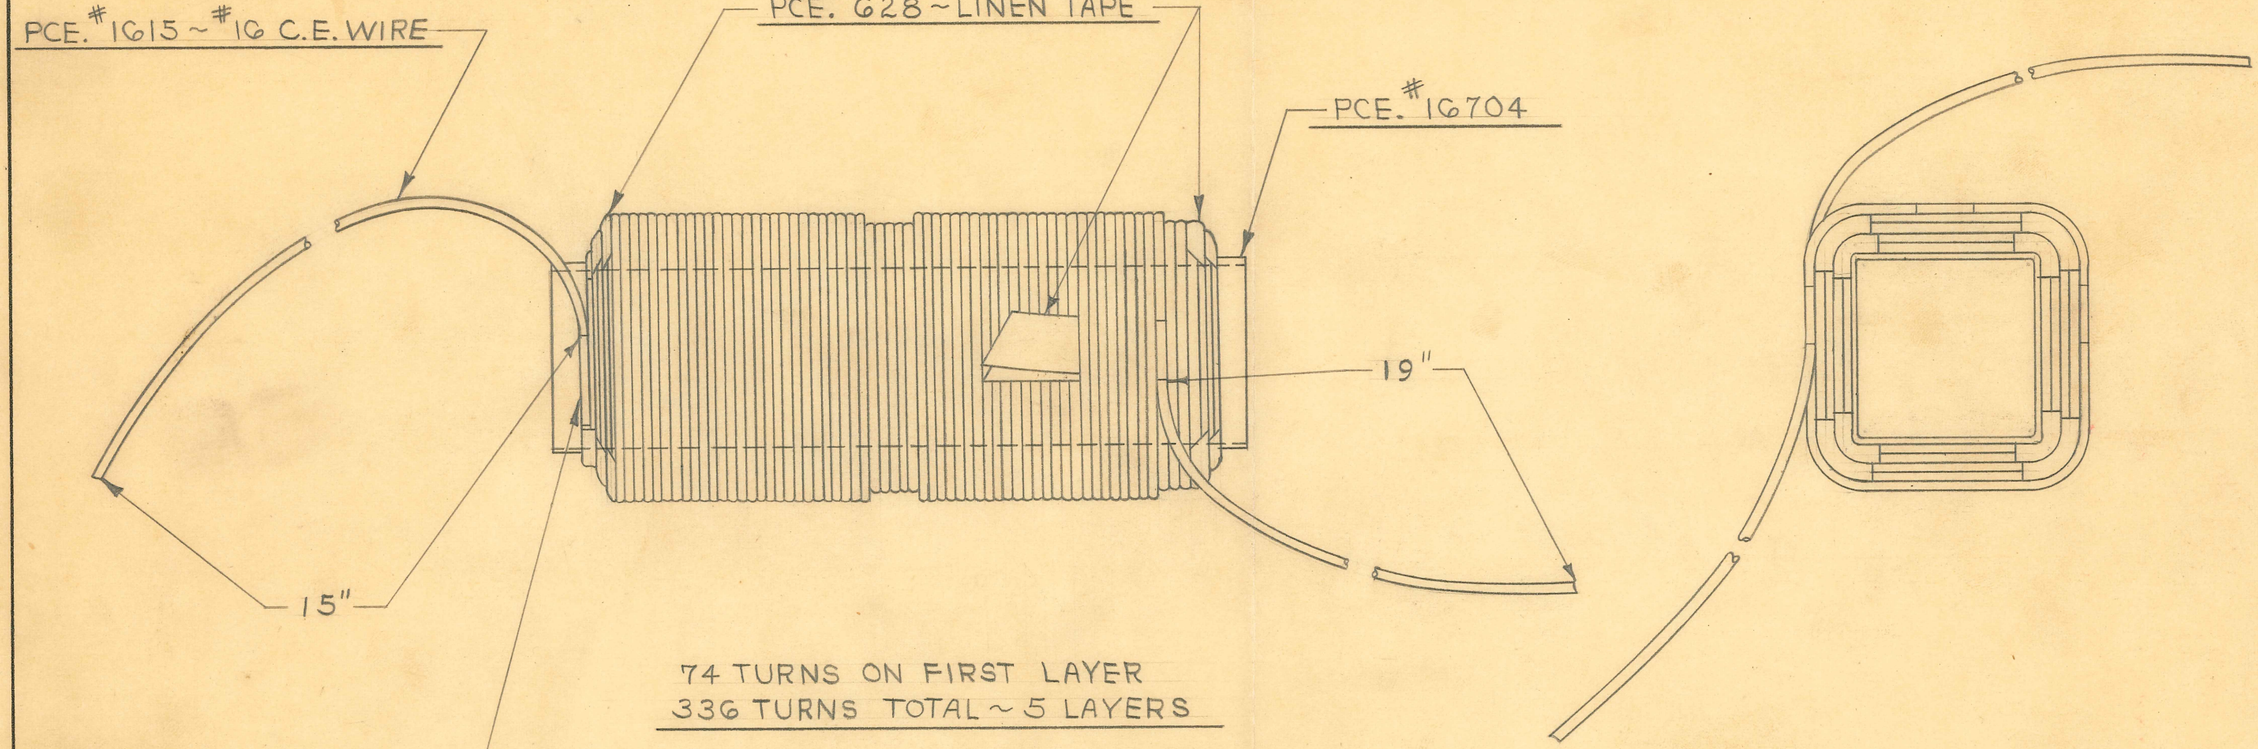

74 TURNS ON FIRST LAYER
336 TURNS TOTAL ~ 5 LAYERS

KEEP FIRST LAYER $\frac{3}{16}$" FROM
EITHER END OF CARDBOARD TUBE

OBSOLETE

SIZE		ISSUE 9-23-47	W.J.	TITLE: FISCHER "MP-10" X-RAY UNIT MAIN PRIMARY WINDING PART OF
KIND		CHANGED		
SHAPE		"		
FINISH		"		
TEMP.		"		
PATT.		"		

H. G. FISCHER & CO.
2338 WABANSIA AVE.
CHICAGO, ILL.

CAT. NO.

PART NO. 16711G

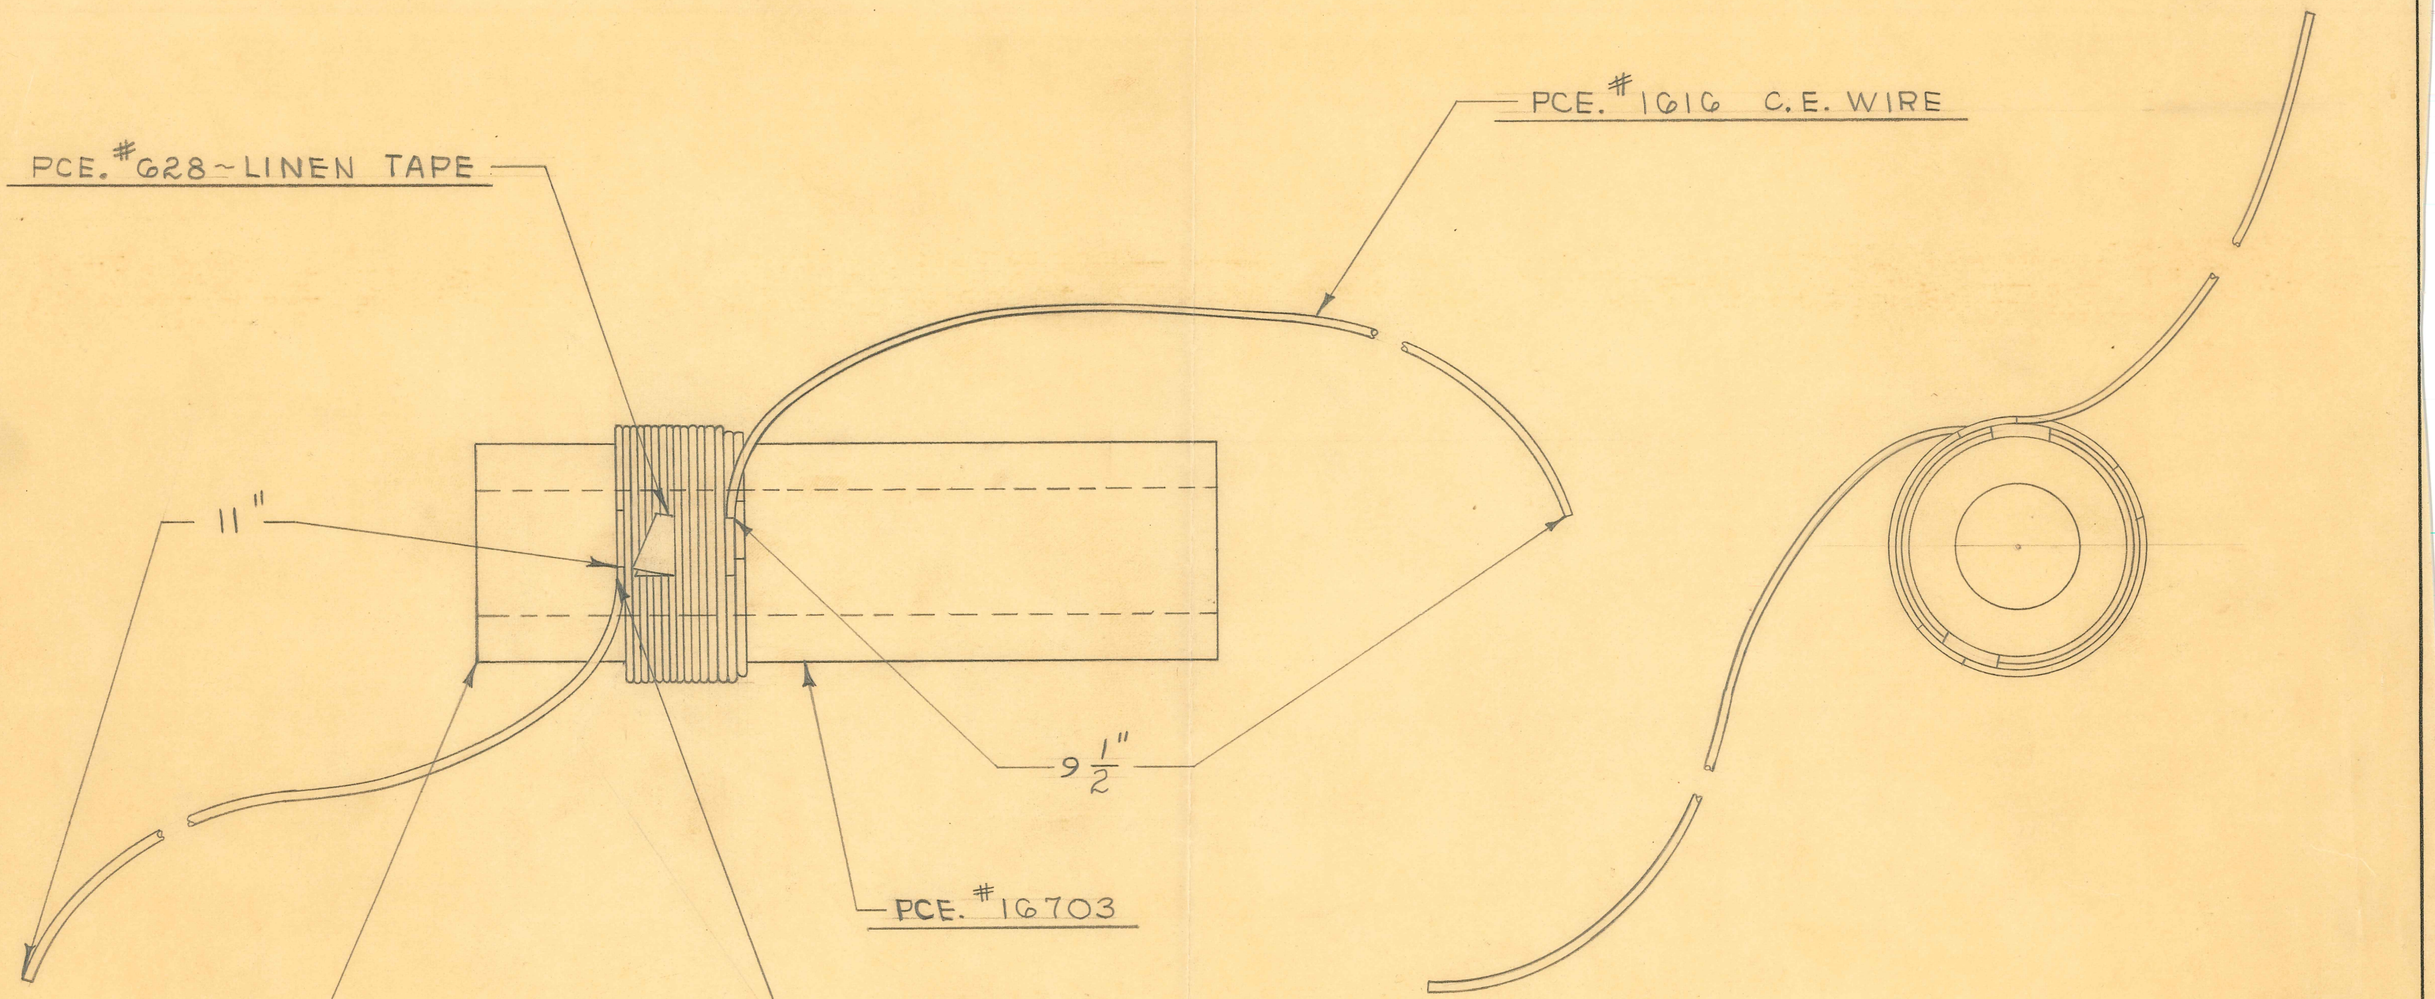

1 REQUIRED

18 TURNS ON FIRST LAYER
17 TURNS ON SECOND LAYER
15 TURNS ON THIRD LAYER
50 TURNS TOTAL

OBSOLETE

SIZE		ISSUE 9-23-47	W. J.	TITLE: FISCHER "MP-10" X-RAY UNIT SECONDARY FILAMENT WINDING PART OF
KIND		CHANGED		
SHAPE		"		
FINISH		"		
TEMP.		"		
PATT.		"		

H. G. FISCHER & CO.
2335 WABANSIA AVE.
CHICAGO, ILL.

CAT. NO.

PART NO. 16710G

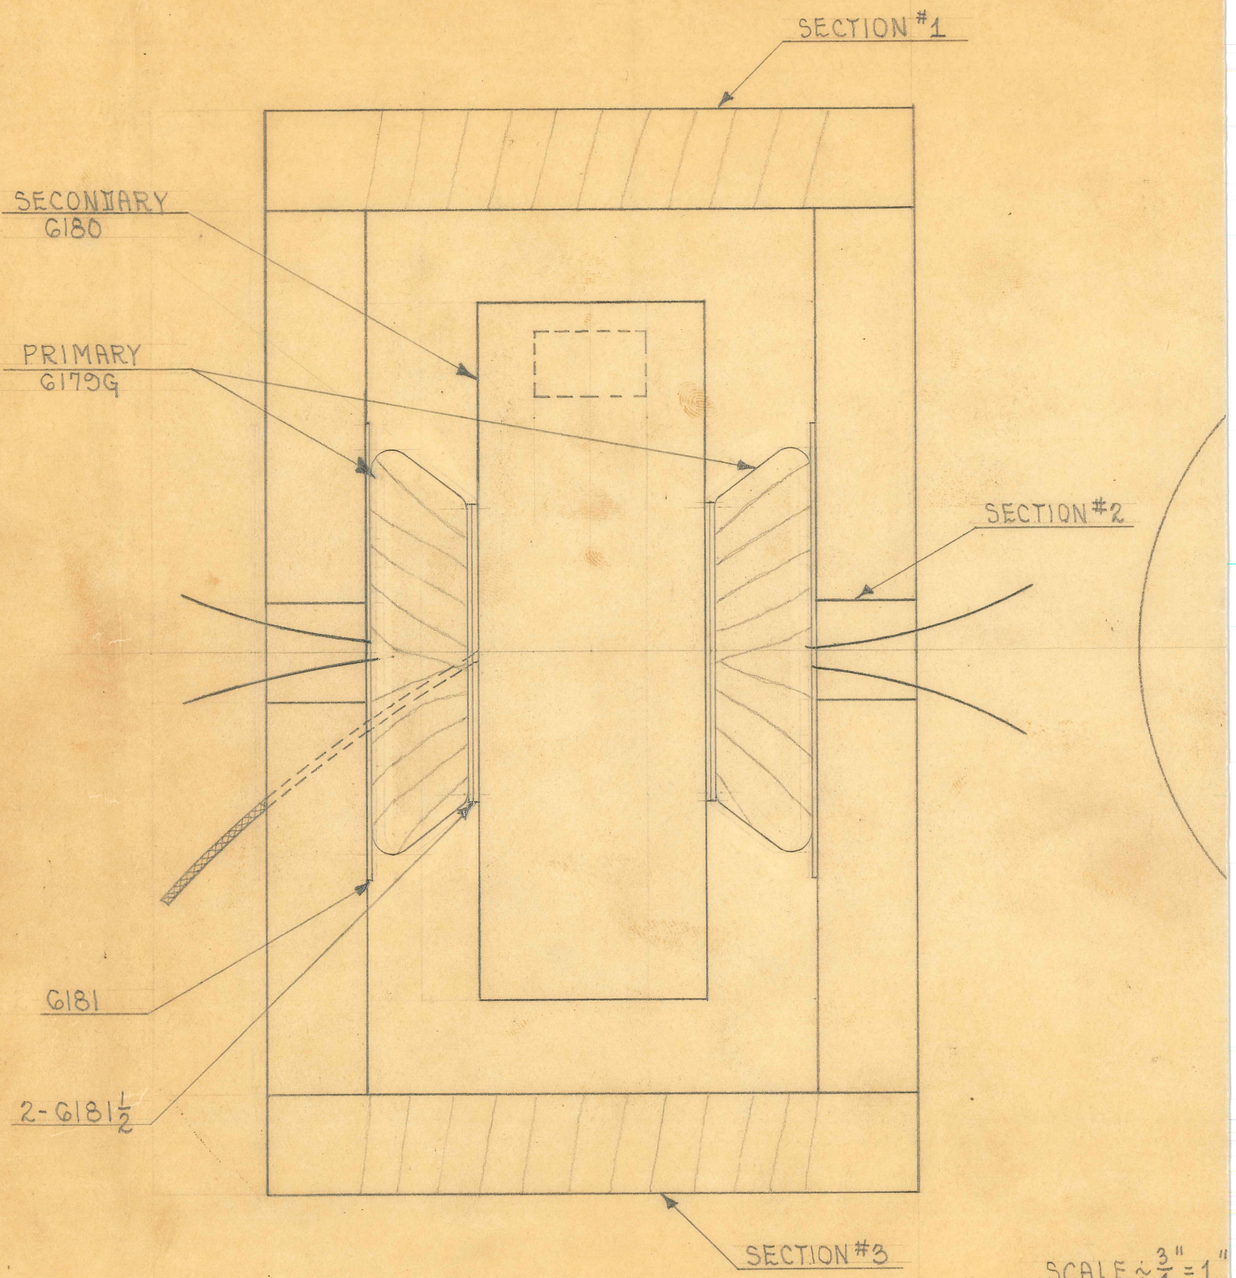
SECTION #1
SECONDARY
G180
PRIMARY
G179G
SECTION #2
G181
2-G181½
SECTION #3

SCALE ~ 3/4" = 1"

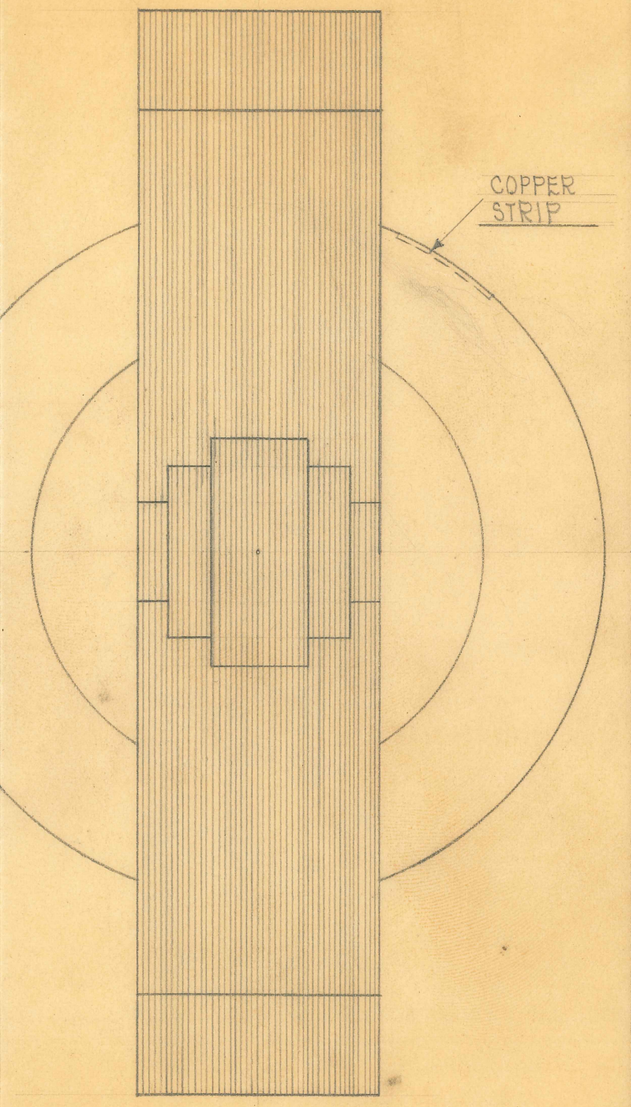

STEEL SIZES

PC. NO. 5043

SECTS. #1 & #3 - LAMS. CUT $4\frac{31}{32}$" X $\frac{7}{8}$" BUILT UP TO APPROX. 2". (JIG. #2912)

SECT. #2 - 46 LAMS. CUT $4\frac{31}{32}$" X 2".
34 LAMS. CUT $4\frac{31}{32}$" X $1\frac{1}{2}$".
24 LAMS. CUT $4\frac{31}{32}$" X $\frac{7}{8}$".

END PIECES - $7\frac{3}{4}$" X $\frac{7}{8}$"
$4\frac{5}{16}$" X $\frac{7}{8}$"
4" X $\frac{7}{8}$"
$3\frac{3}{4}$" X $\frac{7}{8}$"

BIND SECTS. #1, #2 & #3 WITH FRICTION TAPE AND THEN WRAP SECTS. #1 & #3 WITH LINEN TAPE. WRAP SECT. #2 WITH FIBROID PAPER TO FIT SEC. PLACE 1-6179G AND 6180 ON SECT. #2, PACK WITH SCRAP FIBRE STRIPS TO HOLD IN PLACE AND THEN PUT ON OTHER 6179G PRI. COIL.

OBSOLETE

SIZE		ISSUE 3-16-32	A.E.	TITLE: DENTAL X TRANSFORMER
KIND		CHANGED		
SHAPE		" "		
FINISH		" "		
TEMP.		" "		
PATT.		" "		

H. G. FISCHER & CO.
2335 WABANSIA AVE.
CHICAGO, ILL.

CAT. NO.

PART NO. 6170G

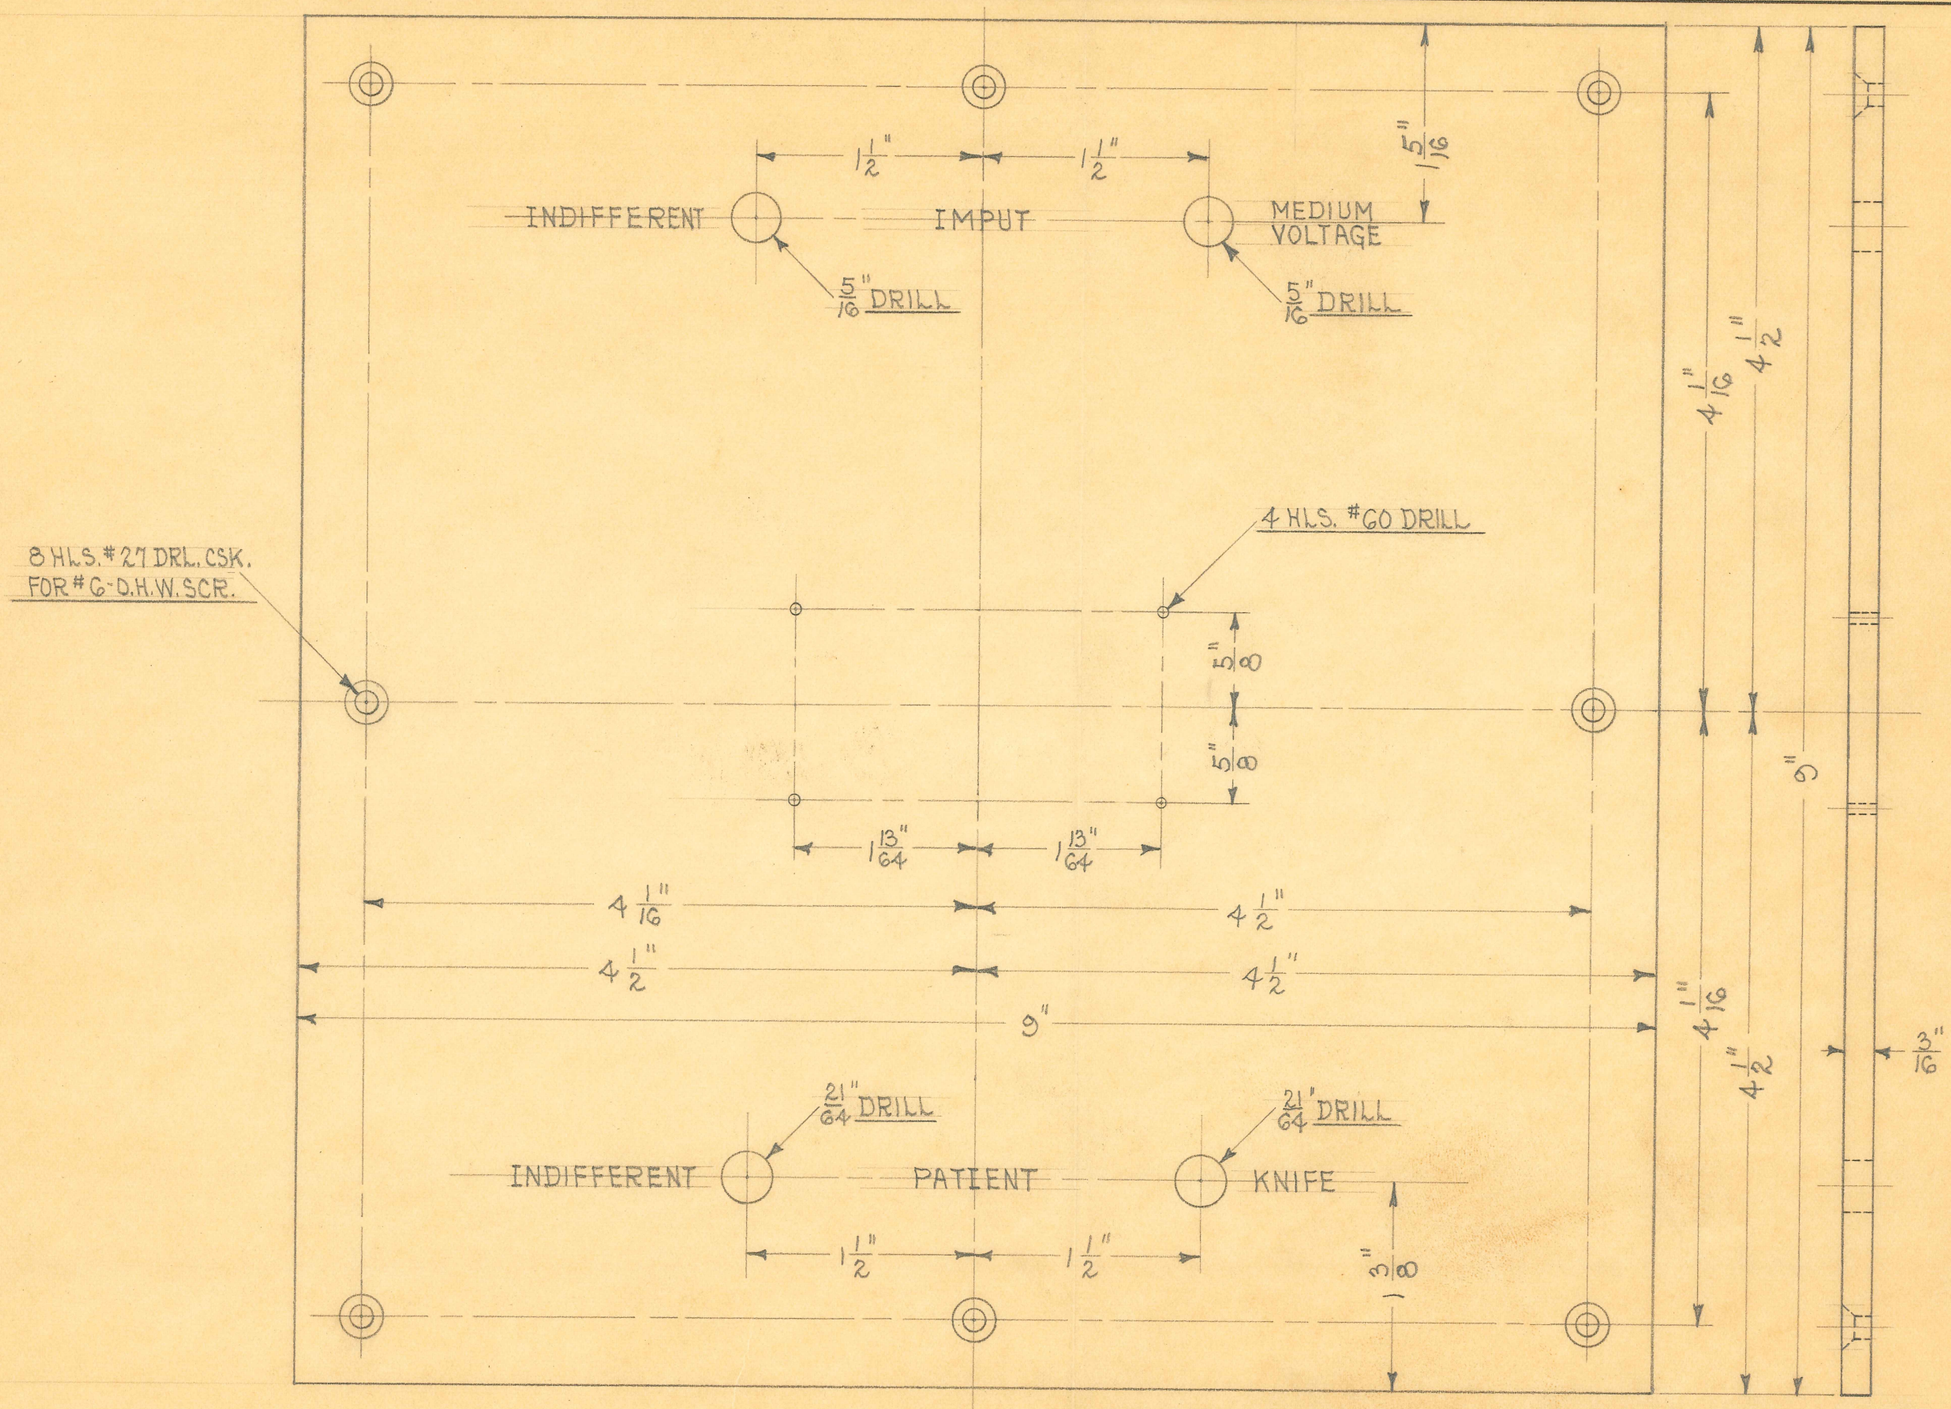

SIZE	9"X9"X3/16"	ISSUE 2-16-33	A.E.
KIND	BAKELITE	CHANGED	
SHAPE		" "	
FINISH		" "	
TEMP.		" "	
PATT.		" "	

TITLE: MOD. "A" "G2" & "SPD" CUTTING ATTACHMENT PANEL

OBSOLETE

H. G. FISCHER & CO.
2335 WABANSIA AVE.
CHICAGO, ILL.

CAT. NO.

PART NO. 7702F

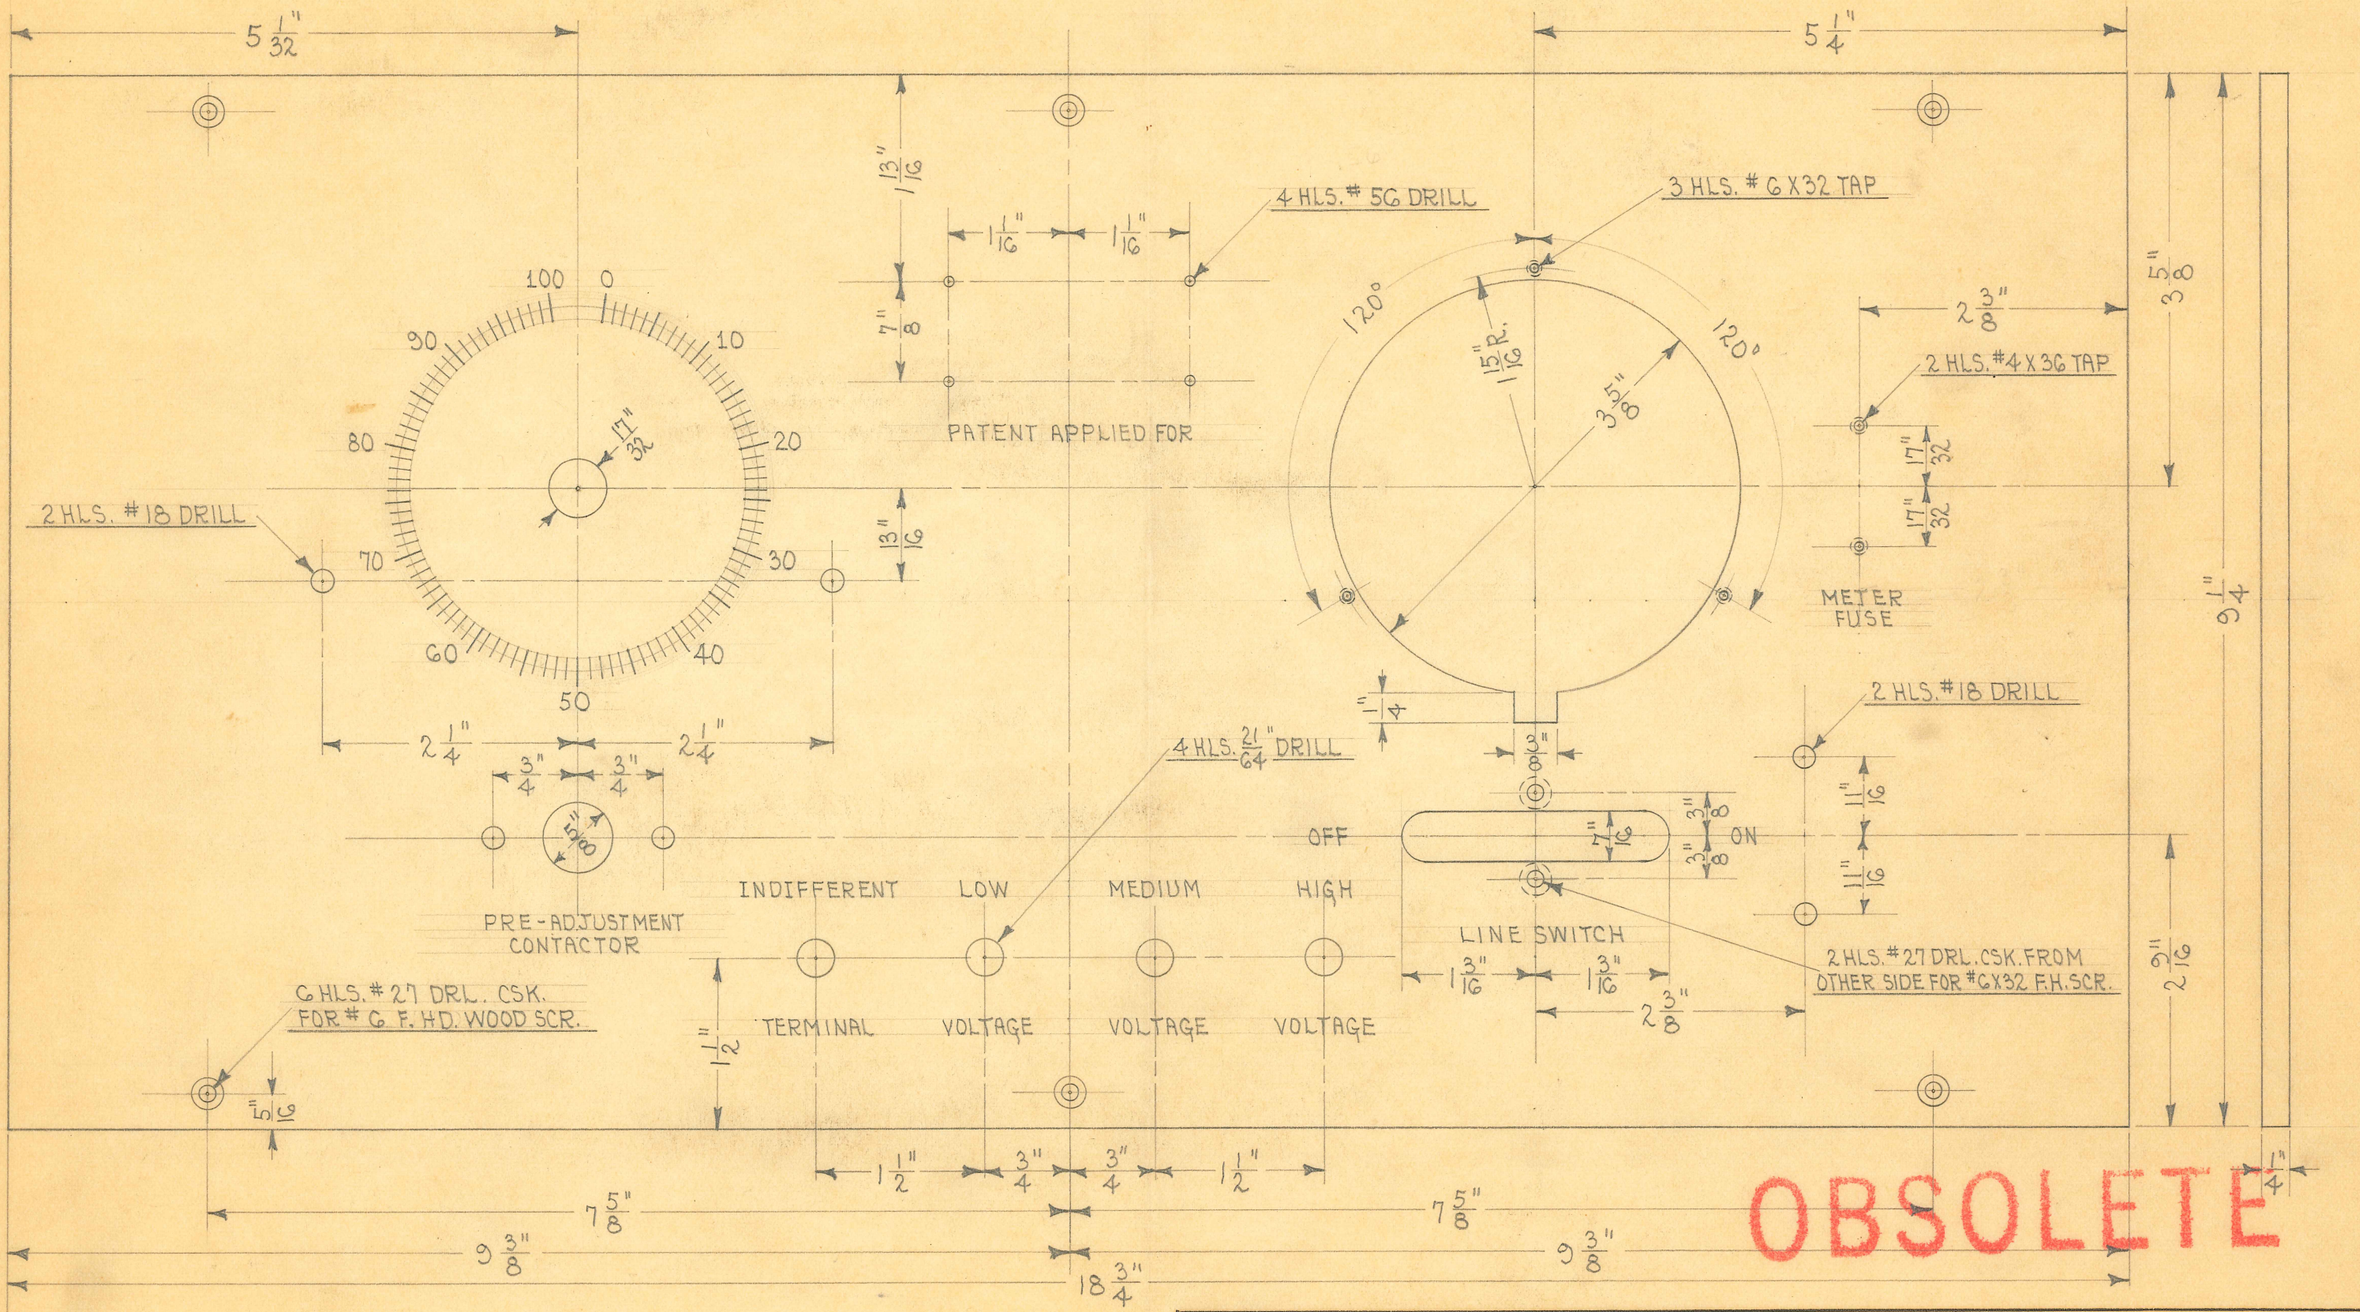

SCALE ~ 3/4" = 1"

OBSOLETE

SIZE	9½"X18¾"X¼"	ISSUE C-2-34	A.E.
KIND	RICHELAIN	CHANGED	
SHAPE	BAKELITE	" "	
FINISH		" "	
TEMP.		" "	
PATT.		" "	

TITLE:
CHASSIS STYLE MODEL "H" OUTFIT PANEL
(DRILLED & ENGRAVED)

H. G. FISCHER & CO.
2335 WABANSIA AVE.
CHICAGO, ILL.

CAT. NO.

PART NO. 7453AF

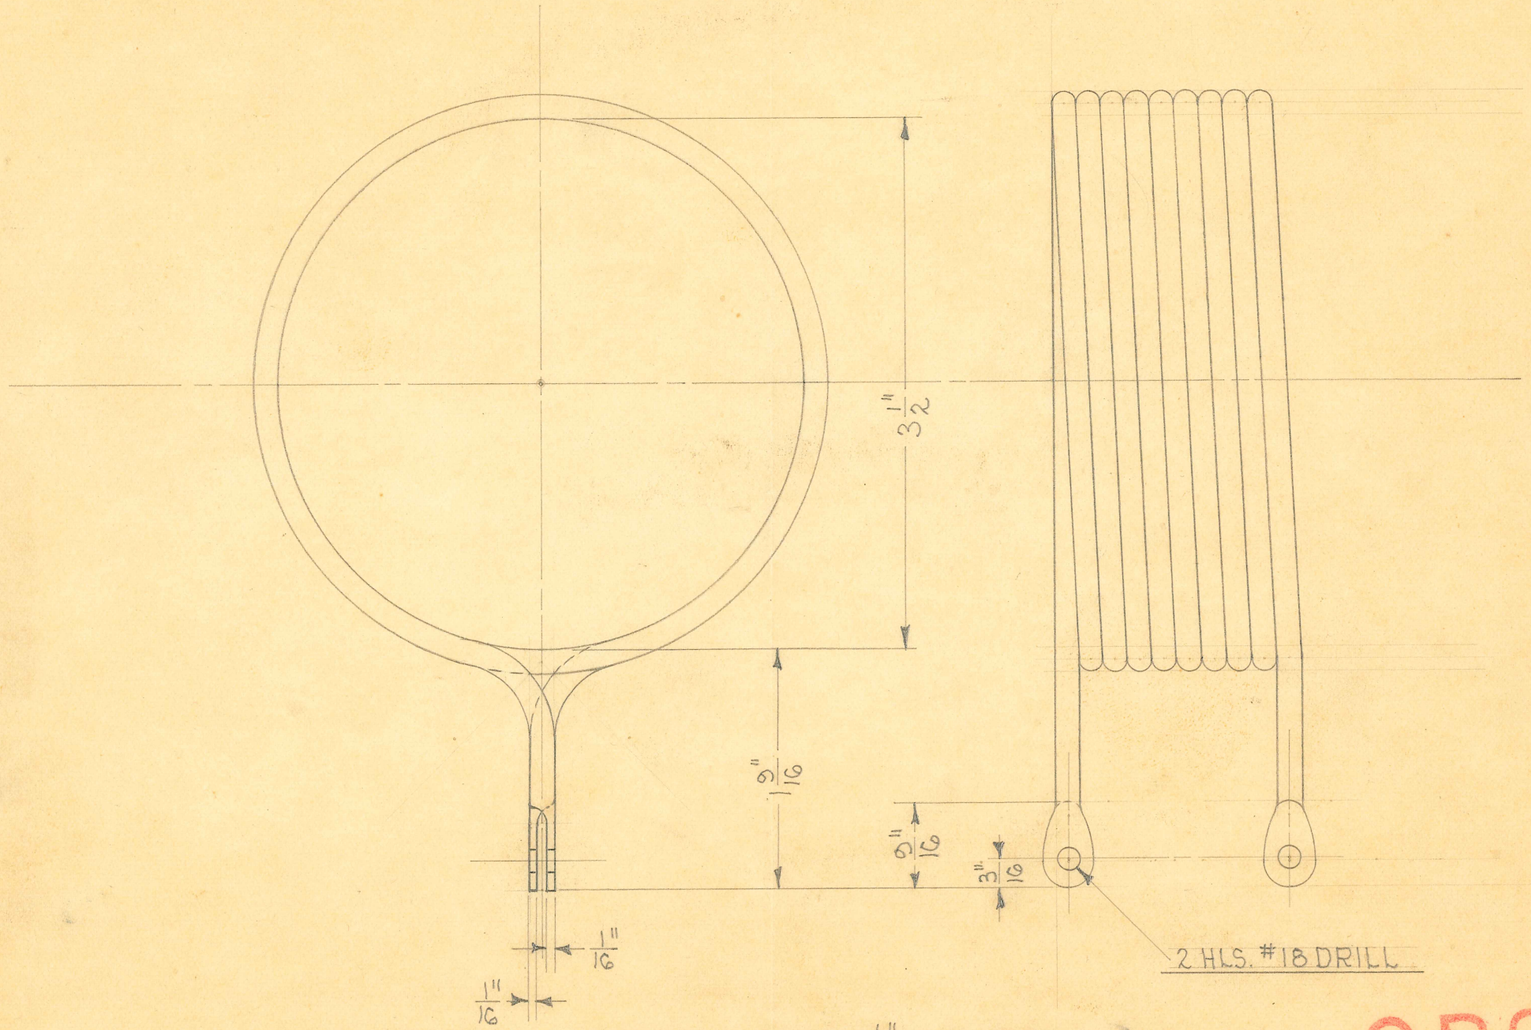

9 TURNS WOUND ON 3 1/4" O.D. MANDREL

1 REQUIRED

OBSOLETE

SIZE	#6 BARE	ISSUE 7-6-34	J.E.
KIND	COPPER WIRE	CHANGED	
SHAPE		" "	
FINISH	SILVER PLATE	" "	
TEMP.		" "	
PATT.		" "	

TITLE:
FISCHER MOD. "H" DIA. OUTFIT VARIOMETER
STATIONARY COIL

H. G. FISCHER & CO.
2335 WABANSIA AVE.
CHICAGO, ILL.

CAT. NO.

PART NO. 7467 1/2

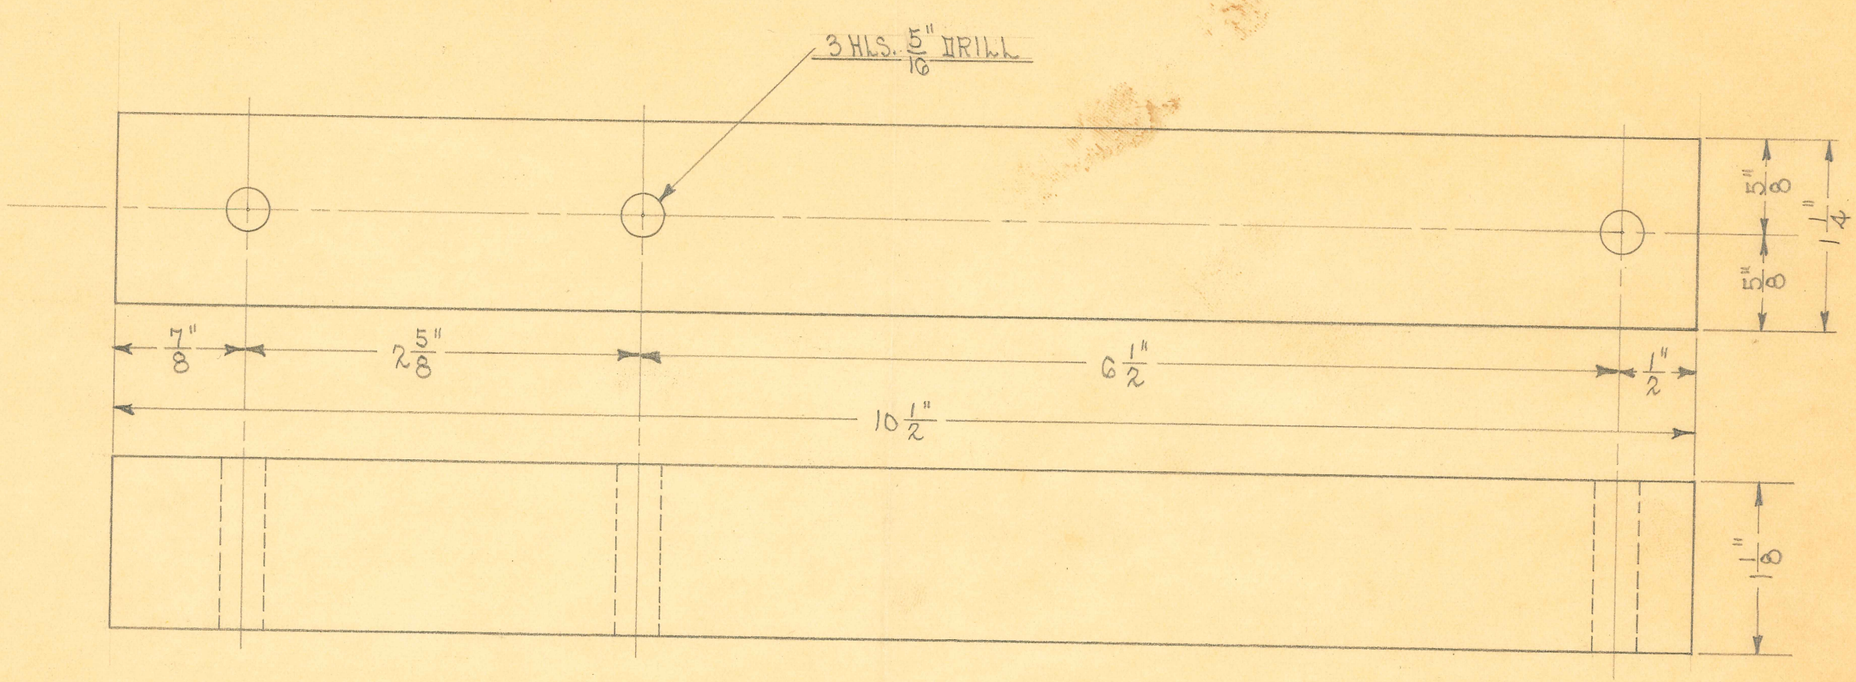

2 REQUIRED

OBSOLETE

SIZE	10½"X1¼"X1⅛"	ISSUE	10-22-32	A.E.
KIND	H. WOOD	CHANGED		
SHAPE		" "		
FINISH		" "		
TEMP.		" "		
PATT.		" "		

TITLE: FISCHER MOD. "H" DIA. OUTFIT TRANS. BLOCK - LOWER

H. G. FISCHER & CO.
2335 WABANSIA AVE.
CHICAGO, ILL.

CAT. NO.

PART NO. 7458F

14 – # 8 F.H. WOOD SCREWS 1" LONG
LOCATED AS SHOWN

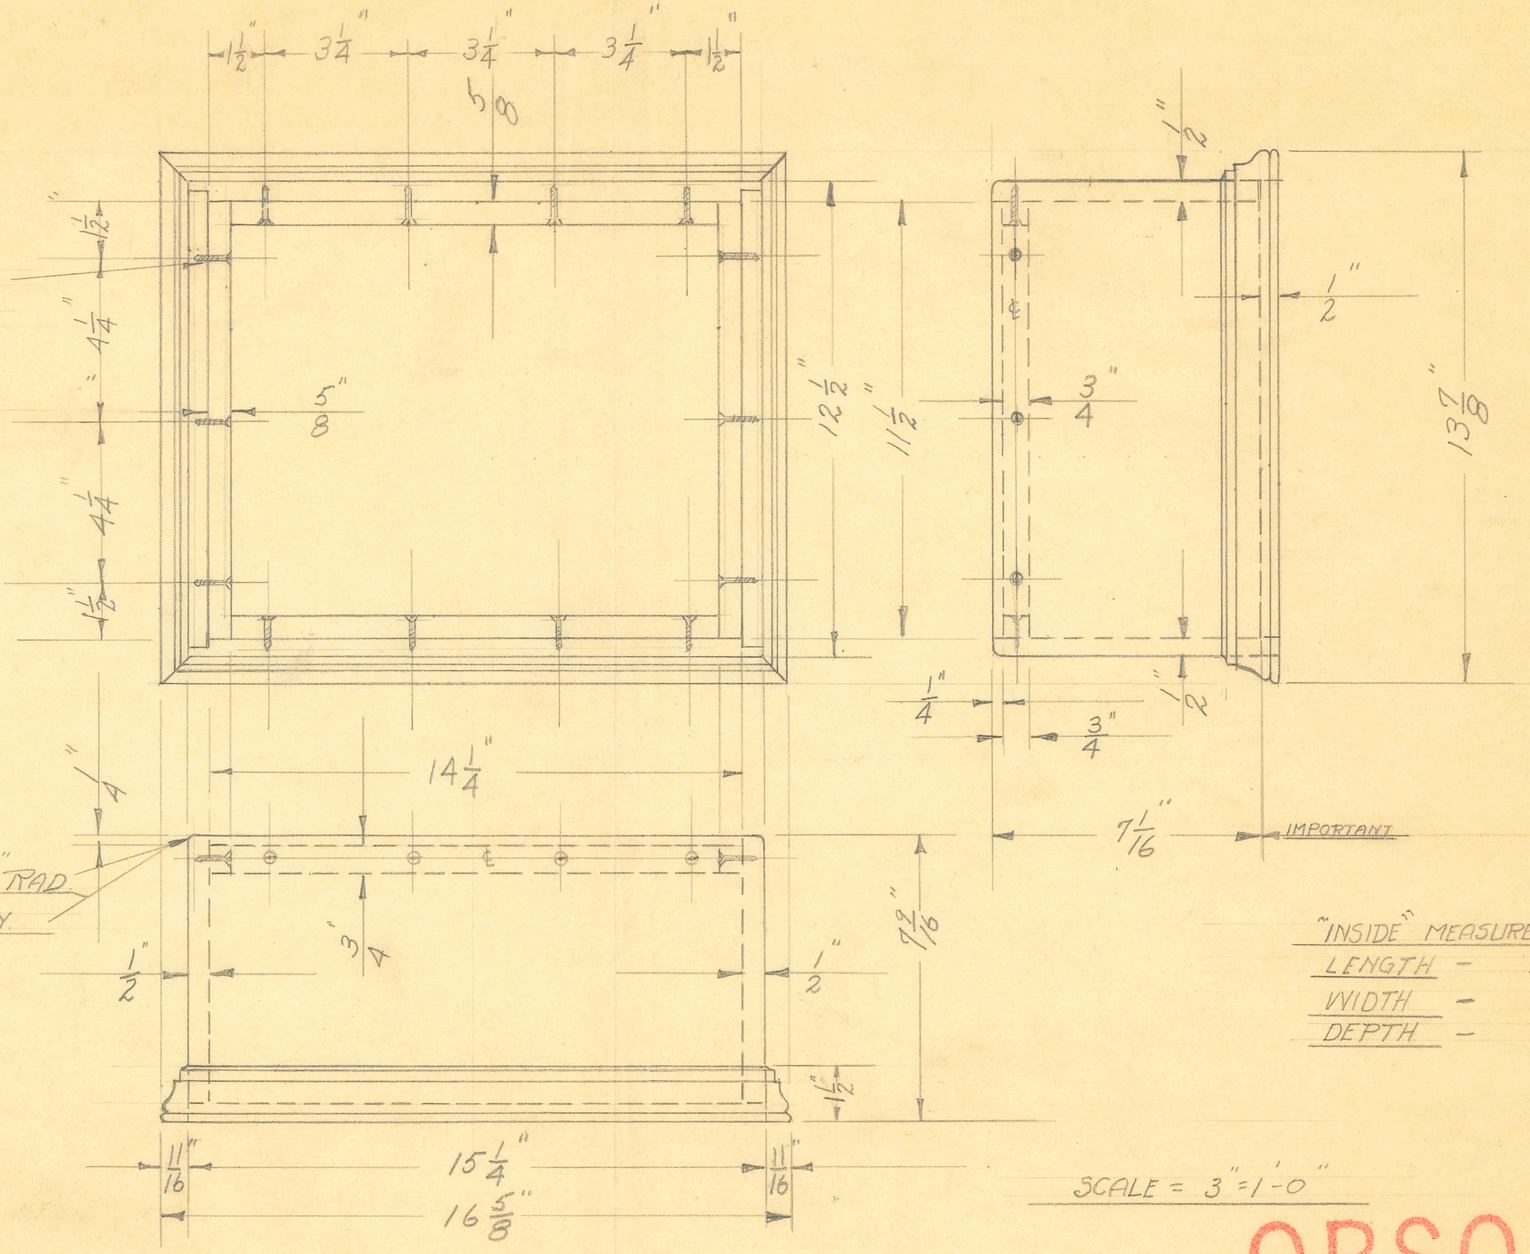

"INSIDE" MEASUREMENTS

LENGTH	–	14¼"
WIDTH	–	11½"
DEPTH	–	7 1/16"

SCALE = 3" = 1'-0"

OBSOLETE

SIZE		ISSUE 9-18-33	N.P.
KIND		CHANGED	
SHAPE		" "	
FINISH		" "	
TEMP.		" "	
PATT.		" "	

TITLE: "CDM" OUTFIT CABINET

H. G. FISCHER & CO.
2335 WABANSIA AVE.
CHICAGO, ILL.

CAT. NO.

PART NO. 7901

10PT

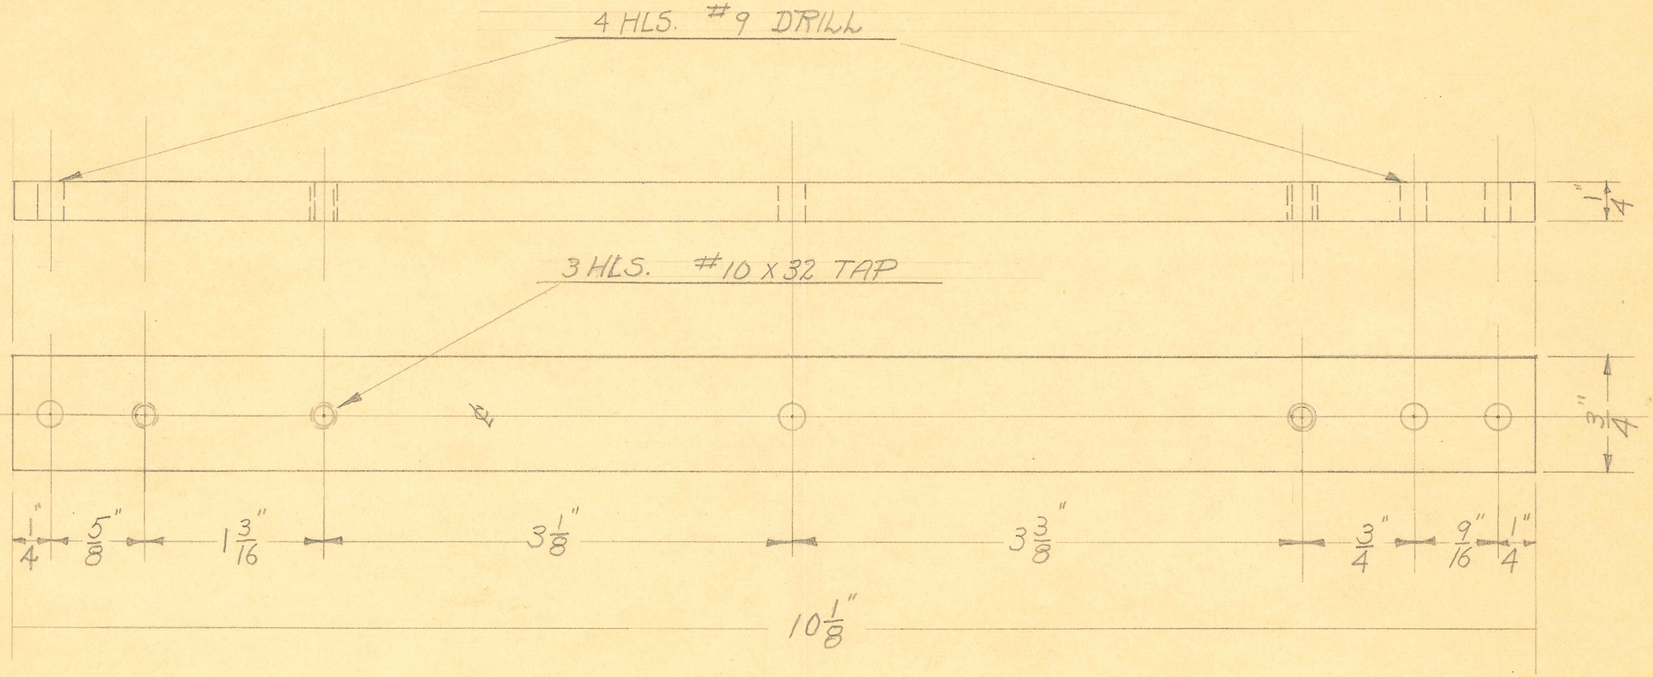

2 REQUIRED

OBSOLETE

SIZE	1/4 X 3/4 STRIP	ISSUE 7-20-33	N.P.
KIND	C.R. STEEL	CHANGED	
SHAPE		" "	
FINISH	BLK. LACQUER	" "	
TEMP.		" "	
PATT.		" "	

TITLE: MODEL "CDM" OUTFIT TRANS., CHOKE, GAP & COND. SUPPORT STRIP.

H. G. FISCHER & CO.
2335 WABANSIA AVE.
CHICAGO, ILL.

CAT. NO.

PART NO. 7905

2005

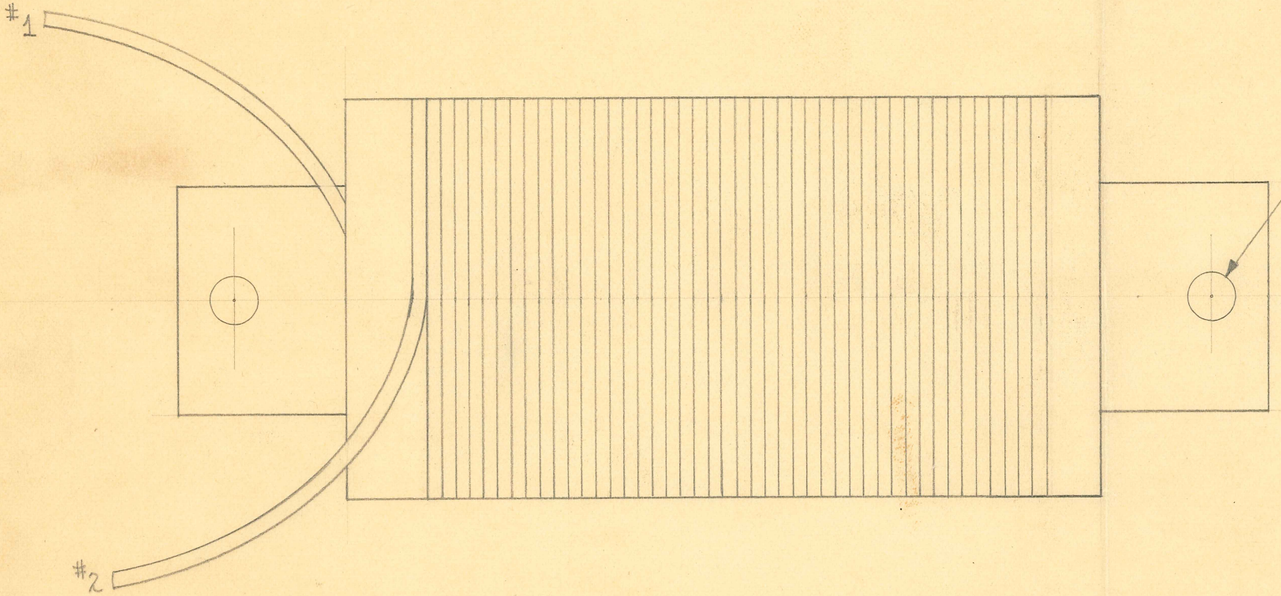

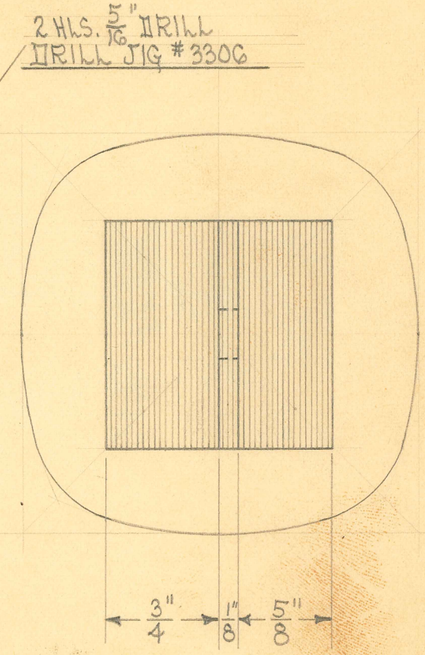

STEEL SIZES

Pc. No. 5043

CUT 6 PCS. 1½" X 7¼" & THE REST 1½" X 5 & BUILD UP TO 1½" AS SHOWN. BIND WITH FRICTION TAPE AND DRILL AS SHOWN.

WINDING DATA

#12 COTENAMEL WIRE

3 LAYERS OF 5021½ FIBROID PAPER ON CORE. ANCHOR LEAD #1 WITH FRICTION TAPE & WIND 190 TURNS WITH 1 LAYER OF 5021½" FIBROID PAPER BETWEEN EACH LAYER OF WIRE. ANCHOR END WITH LINEN TAPE-LEAD #2. COVER ENTIRE CHOKE WITH BLACK INSULATING VARNISH.

OBSOLETE

JIG 3306

SIZE		ISSUE	10-20-32	A.E.	TITLE: FISCHER MOD. "H" MIA. OUTFIT LINE CHOKE
KIND		CHANGED			
SHAPE		" "			
FINISH		" "			
TEMP.		" "			
PATT.		" "			

H. G. FISCHER & CO.
2335 WABANSIA AVE.
CHICAGO, ILL.

CAT. NO.

PART NO. 7485G

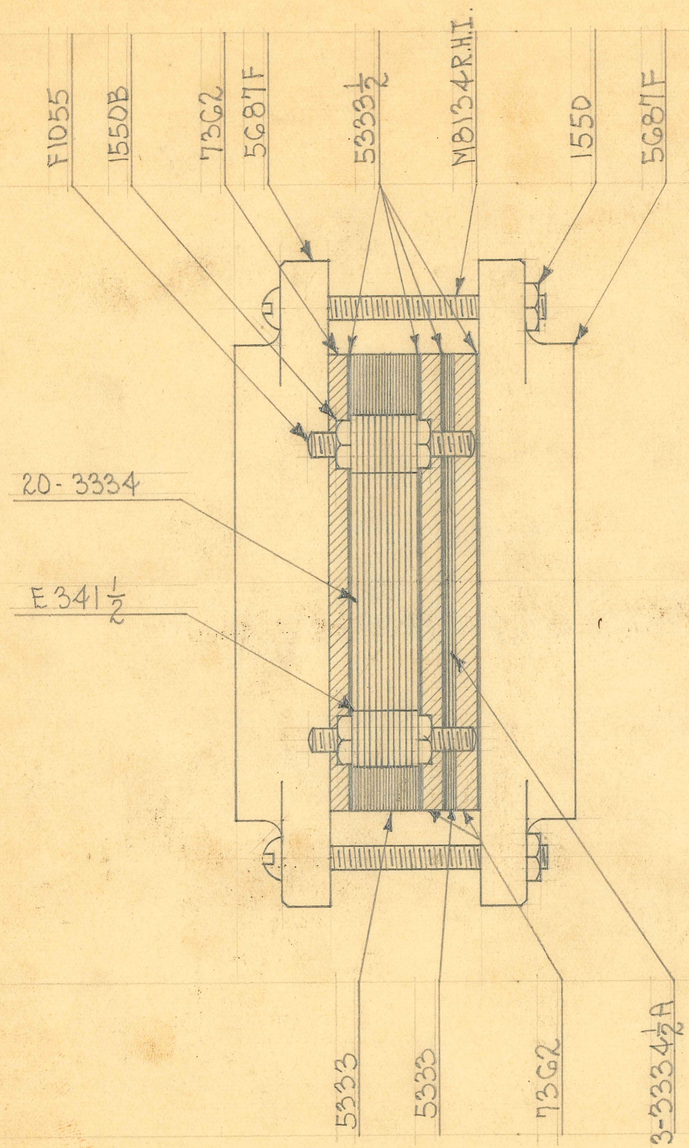

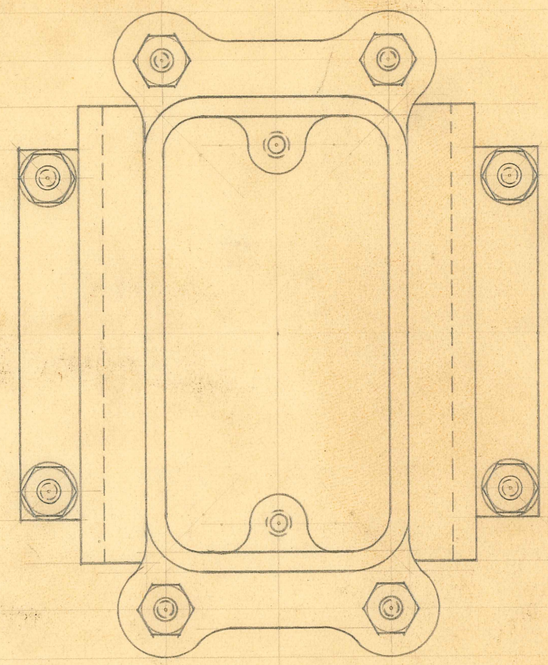

OBSOLETE

NOTE:-

5333 MICA SPLIT TO .012"

5333½ MICA SINGLE SHEET ONLY

1-20 PLATE COND.

1-3 PLATE GRD. COND.

SIZE		ISSUE 7-19-32	A.E.	TITLE: FISCHER MODEL "H" IIA. OUTFIT BLOCKING COND.
KIND		CHANGED		
SHAPE		" "		
FINISH		" "		
TEMP.		" "		H. G. FISCHER & CO. 2335 WABANSIA AVE. CHICAGO, ILL.
PATT.		" "		CAT. NO.
				PART NO. 7477G

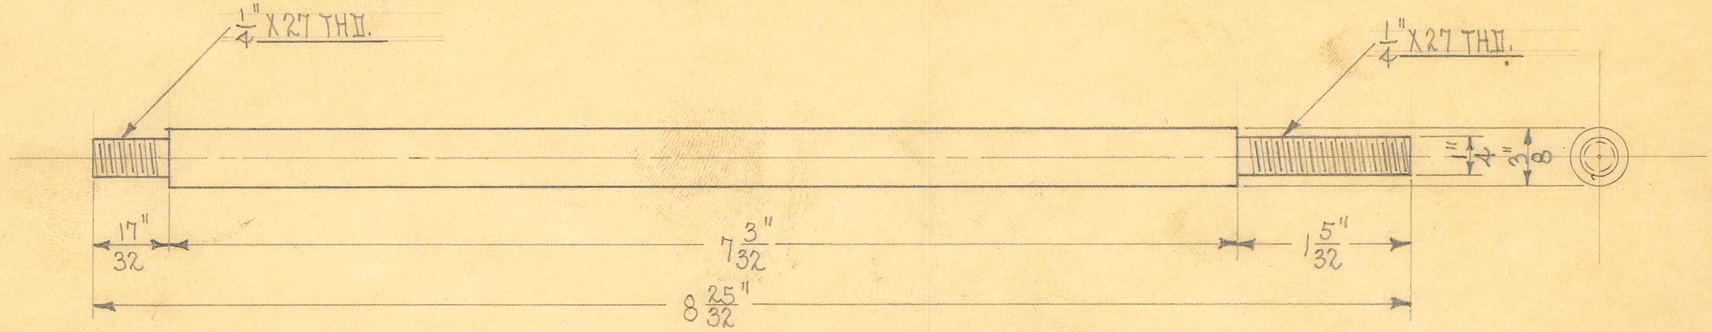

1 REQUIRED

OBSOLETE

SIZE	3/8"	ISSUE 9-19-32	H.E.	TITLE: FISCHER MODEL "H" DIA. OUTFIT VARIOMETER GUIDE ROD
KIND	BRASS ROD	CHANGED		
SHAPE		" "		
FINISH		" "		
TEMP.		" "		
PATT.		" "		

H. G. FISCHER & CO.
2335 WABANSIA AVE.
CHICAGO, ILL.

CAT. NO.

PART NO. 7472

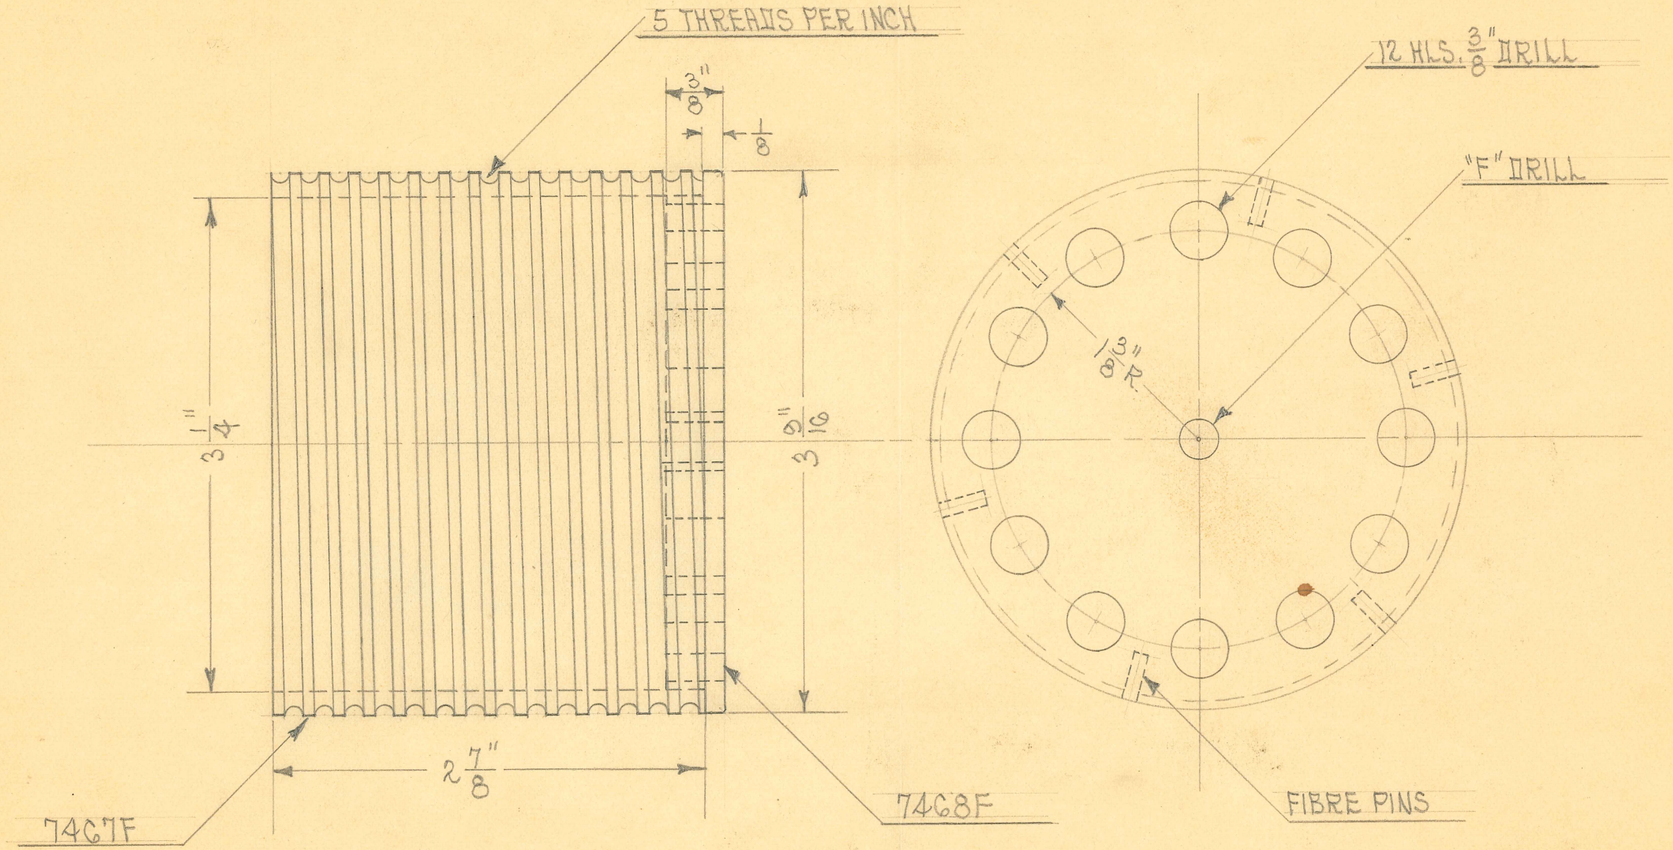

OBSOLETE

SIZE		ISSUE 10-25-32	A.E.	**TITLE:** FISCHER MOD. "H" DIA. OUTFIT VARIOMETER STATIONARY COIL TUBE ASSEM.
KIND		CHANGED		
SHAPE		" "		
FINISH		" "		
TEMP.		" "		H. G. FISCHER & CO. 2335 WABANSIA AVE. CHICAGO, ILL. — CAT. NO. — PART NO. 7467G
PATT.		" "		

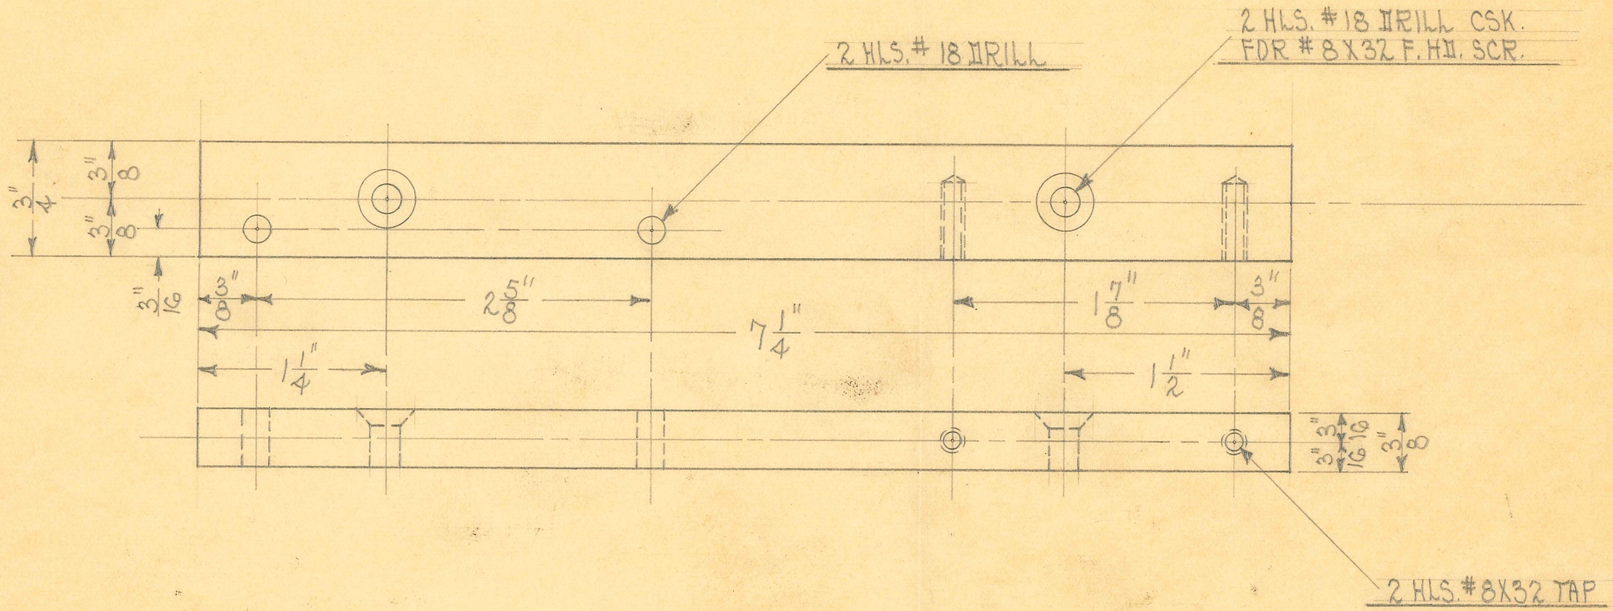

OBSOLETE

SIZE	3/8"	ISSUE 8-31-32	A.E.	TITLE: FISCHER MOD. "H" DIA. OUTFIT VARIOMETER TERM. STRIP
KIND	SHEET BAKELITE	CHANGED		
SHAPE		" "		
FINISH		" "		
TEMP.		" "		
PATT.		" "		

H. G. FISCHER & CO.
2335 WABANSIA AVE.
CHICAGO, ILL.

CAT. NO.

PART NO. 7463 1/2

#8 X 32 TAP

#8X32 TAP

1 7/16"

1/4" REAMED

OIL HOLE #40 DRL.

30°

#8X32 TAP

1/4"

1/4"

3/8"

7/32"

1/4"

#8X32 TAP

5/8"

7 15/32"

1/2"

#8X32 TAP

7/8"

7/8"

2 3/8"

3/4"

1/4" X 27 TAP

#10 DRILL

15/32"

13/16"

45°

3/8"

1 5/8"

3/32"

1/8"

3/8"

7/32"

17/64" DRILL

1/8"

9/16"

#10X32 TAP

5/8"

5/8"

SIZE		ISSUED 9-9-32	J.E.
KIND	ALUM. CASTING	CHANGED	
SHAPE		" "	
FINISH		" "	
TEMP.		" "	
PATT.		" "	

TITLE: FISCHER MODEL "H" DIA. OUTFIT VARIOMETER FRAME

OBSOLETE

H. G. FISCHER & CO.
2335 WABANSIA AVE.
CHICAGO, ILL.

CAT. NO.

PART NO. 7462F

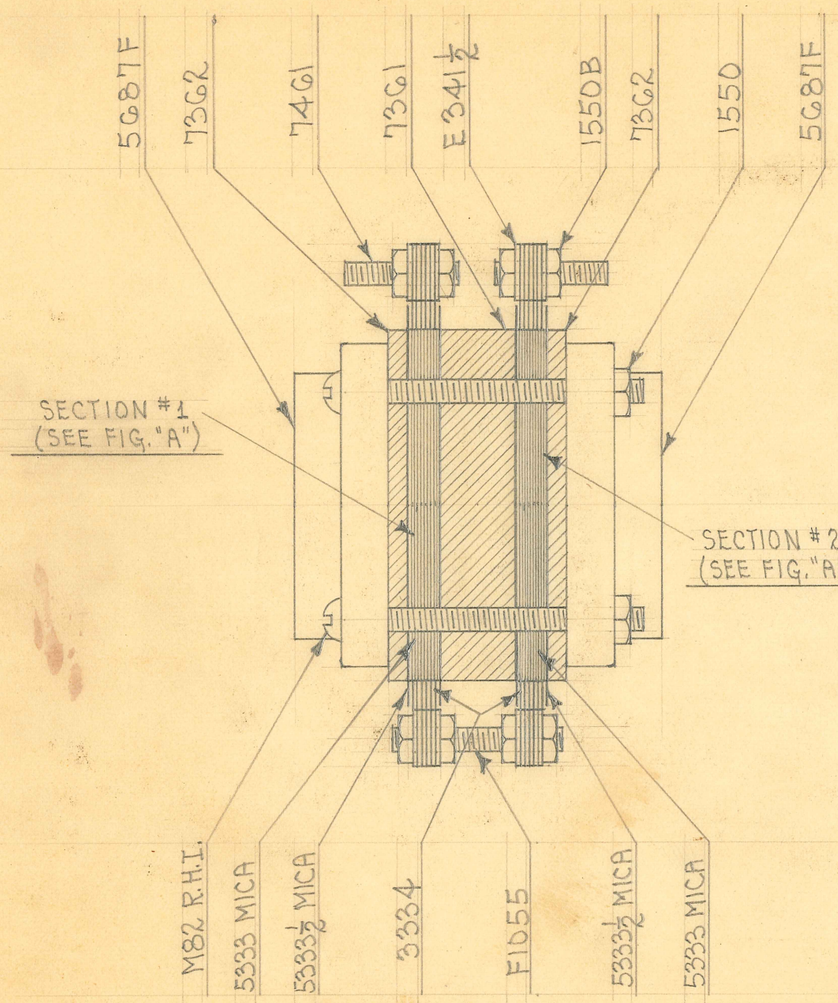

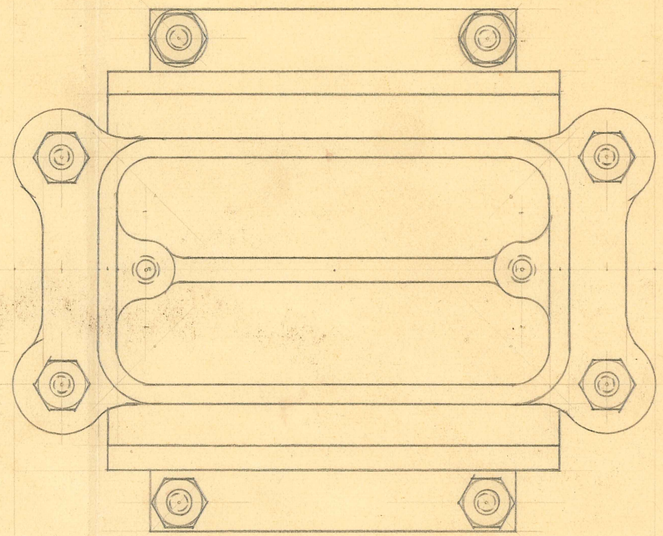

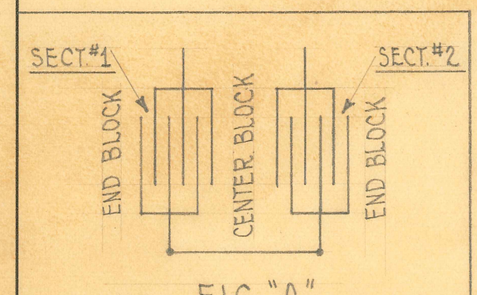

FIG. "A"

NOTE:-
5333 MICA SPLIT TO .006"
5333½ MICA - ONE SHEET ONLY
2-12 PLATE CONDS.

OBSOLETE

SIZE		ISSUE 7-14-32	A.E.	TITLE: FISCHER MODEL "H" IIA. OUTFIT OSCIL. CONN.
KIND		CHANGED		
SHAPE		" "		
FINISH		" "		
TEMP.		" "		H. G. FISCHER & CO. 2335 WABANSIA AVE. CHICAGO, ILL. / CAT. NO. / PART NO. 7460G
PATT.		" "		

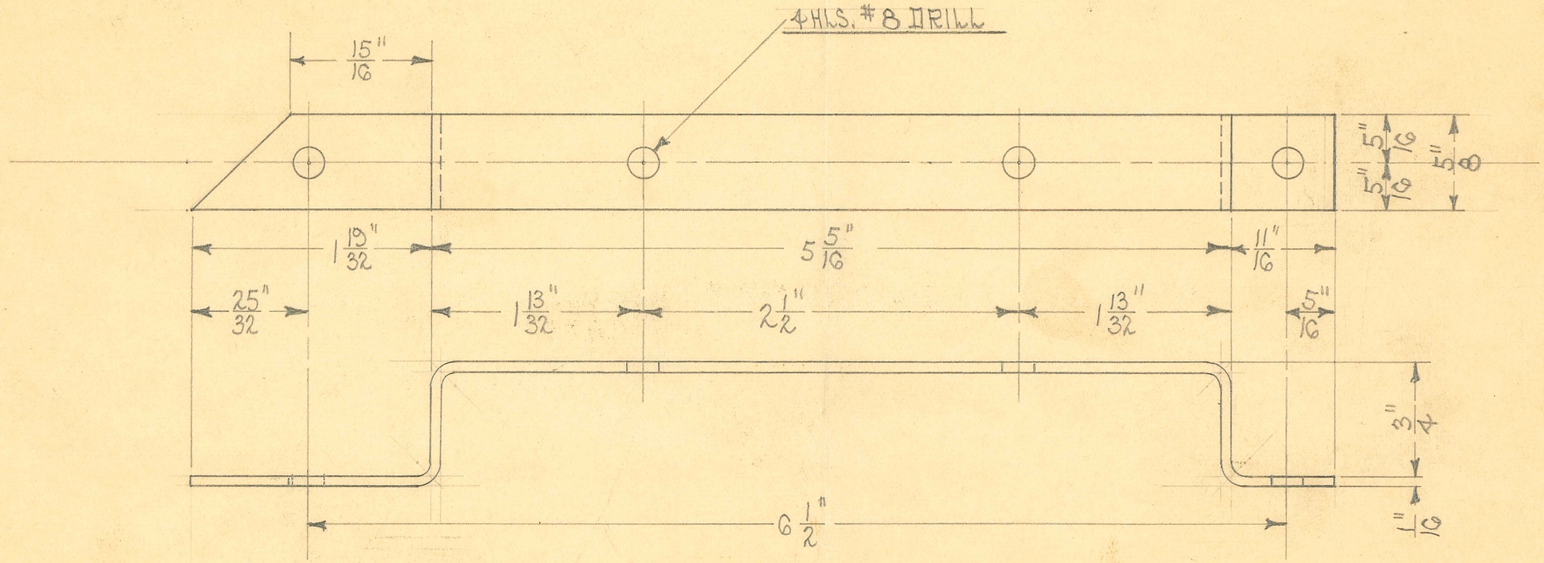

DEVELOPED LENGTH - 8 7/8"
DRILL JIG. #3289
FORMING FIXTURE #3290

OBSOLETE

SIZE	1/16" X 5/8"	ISSUED 10-24-32	J.E.
KIND	COLD ROLLED	CHANGED	
SHAPE		" "	
FINISH	BLK. ENAMEL	" "	
TEMP.		" "	
PATT.		" "	

TITLE: FISCHER MOD. "H" DIA. OUTFIT DSCIL. CONN. SUPP. STRIP

H. G. FISCHER & CO.
2335 WABANSIA AVE.
CHICAGO, ILL.

CAT. NO.

PART NO. 7460

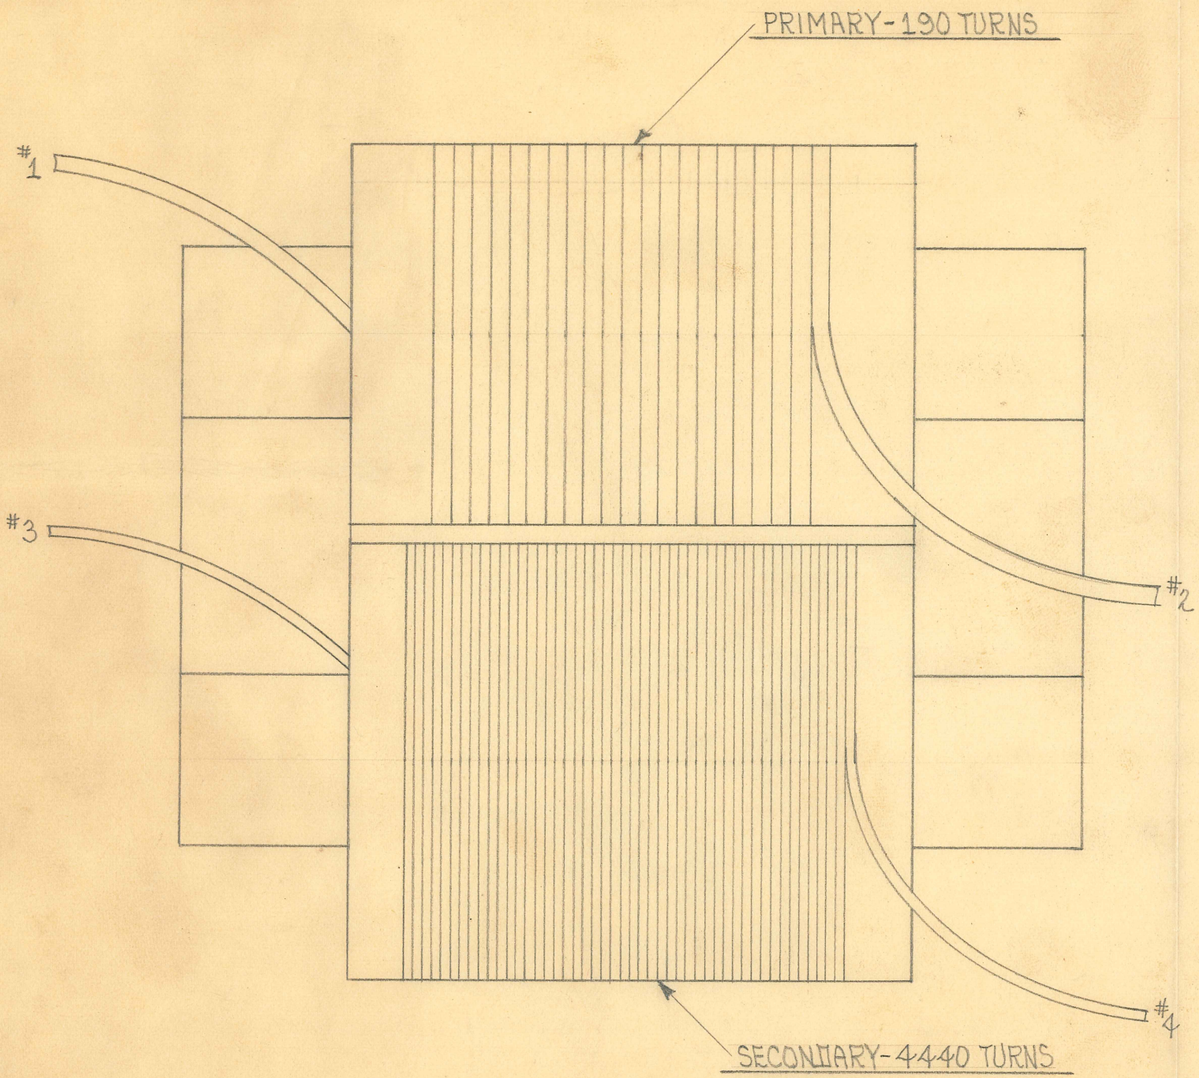

SCALE ~ $\frac{3}{4}$" = 1"

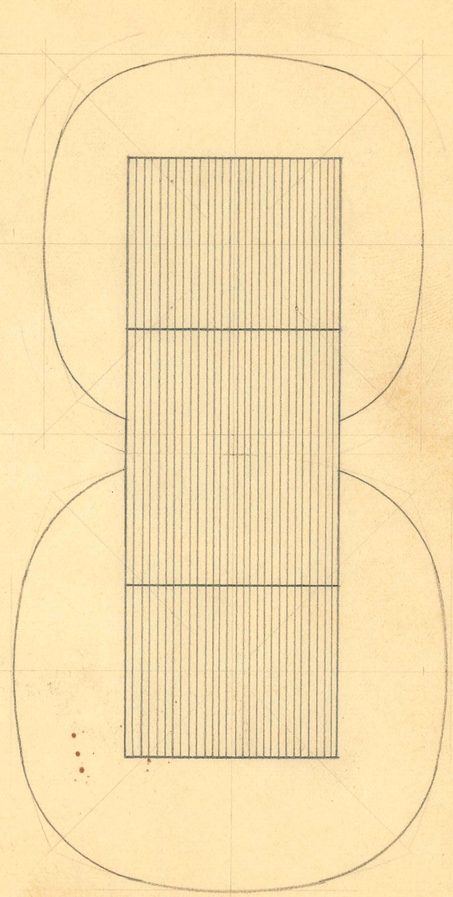

STEEL SIZES

Pc. No. 5043

PRI. & SEC. CORES
CUT $6\frac{1}{2}$" X $1\frac{9}{16}$" BUILT UP TO $1\frac{3}{4}$"
END PIECES CUT $3\frac{3}{4}$" X $1\frac{9}{16}$".
BIND PRI. & SEC. CORES WITH FRICTION TAPE.

WINDING DATA

PRIMARY

USE # 11 COTENAMEL WIRE
4 LAYERS HEAVY WRAPPING PAPER & 3 LAYERS OF 5026 $\frac{3}{4}$ OILED CLOTH ON CORE. ANCHOR LEAD #1-$\frac{1}{4}$" FROM LEFT END WITH FRICTION TAPE & WIND TO 190 TURNS WITH 2 LAYERS OF 5026 $\frac{3}{4}$ OILED CLOTH BETWEEN EACH LAYER OF WIRE, ANCHOR END WITH LINEN TAPE- LEAD #2.

SECONDARY

USE # 23 ENAMEL WIRE
4 LAYERS OF 5022 FIBROID PAPER ON CORE. ANCHOR LEAD #3 WITH FRICTION TAPE & WIND 40 TURNS SPACED ON 1st LAYER. THEN 4 LAYERS OF 5022 FIBROID PAPER. WIND TO 254 TURNS & COVER WITH 1 DOUBLE LAYER OF 5022 FIBROID. WIND TO 468 TURNS & COVER WITH 1 DOUBLE LAYER OF 5022 FIBROID. WIND TO 682 TURNS & COVER WITH 1 DOUBLE LAYER OF 5022 FIBROID. WIND 17 MORE LAYERS OF 214 TURNS EACH WITH 1 LAYER OF 5022 FIBROID BETWEEN EACH LAYER OF WIRE. TOTAL 4320 TURNS. COVER WITH 1 LAYER OF 5022 FIBROID. WIND 1 LAYER OF #20 ENAMEL WIRE TO 4440 TURNS. ANCHOR END WITH LINEN TAPE- LEAD #4. LEADS #3 & 4 ARE 1662- CELATSITE WIRE. COVER ENTIRE TRANS. EXCEPT ENDS WITH BLACK INSULATING VARNISH.

OBSOLETE

SIZE		ISSUE 10-13-32	H.E.	TITLE: FISCHER MOD. "H" DIA. OUTFIT TRANSFORMER
KIND		CHANGED		
SHAPE		" "		
FINISH		" "		
TEMP.		" "		H. G. FISCHER & CO. 2335 WABANSIA AVE. CHICAGO, ILL. — CAT. NO. — PART NO. 7458G
PATT.		" "		

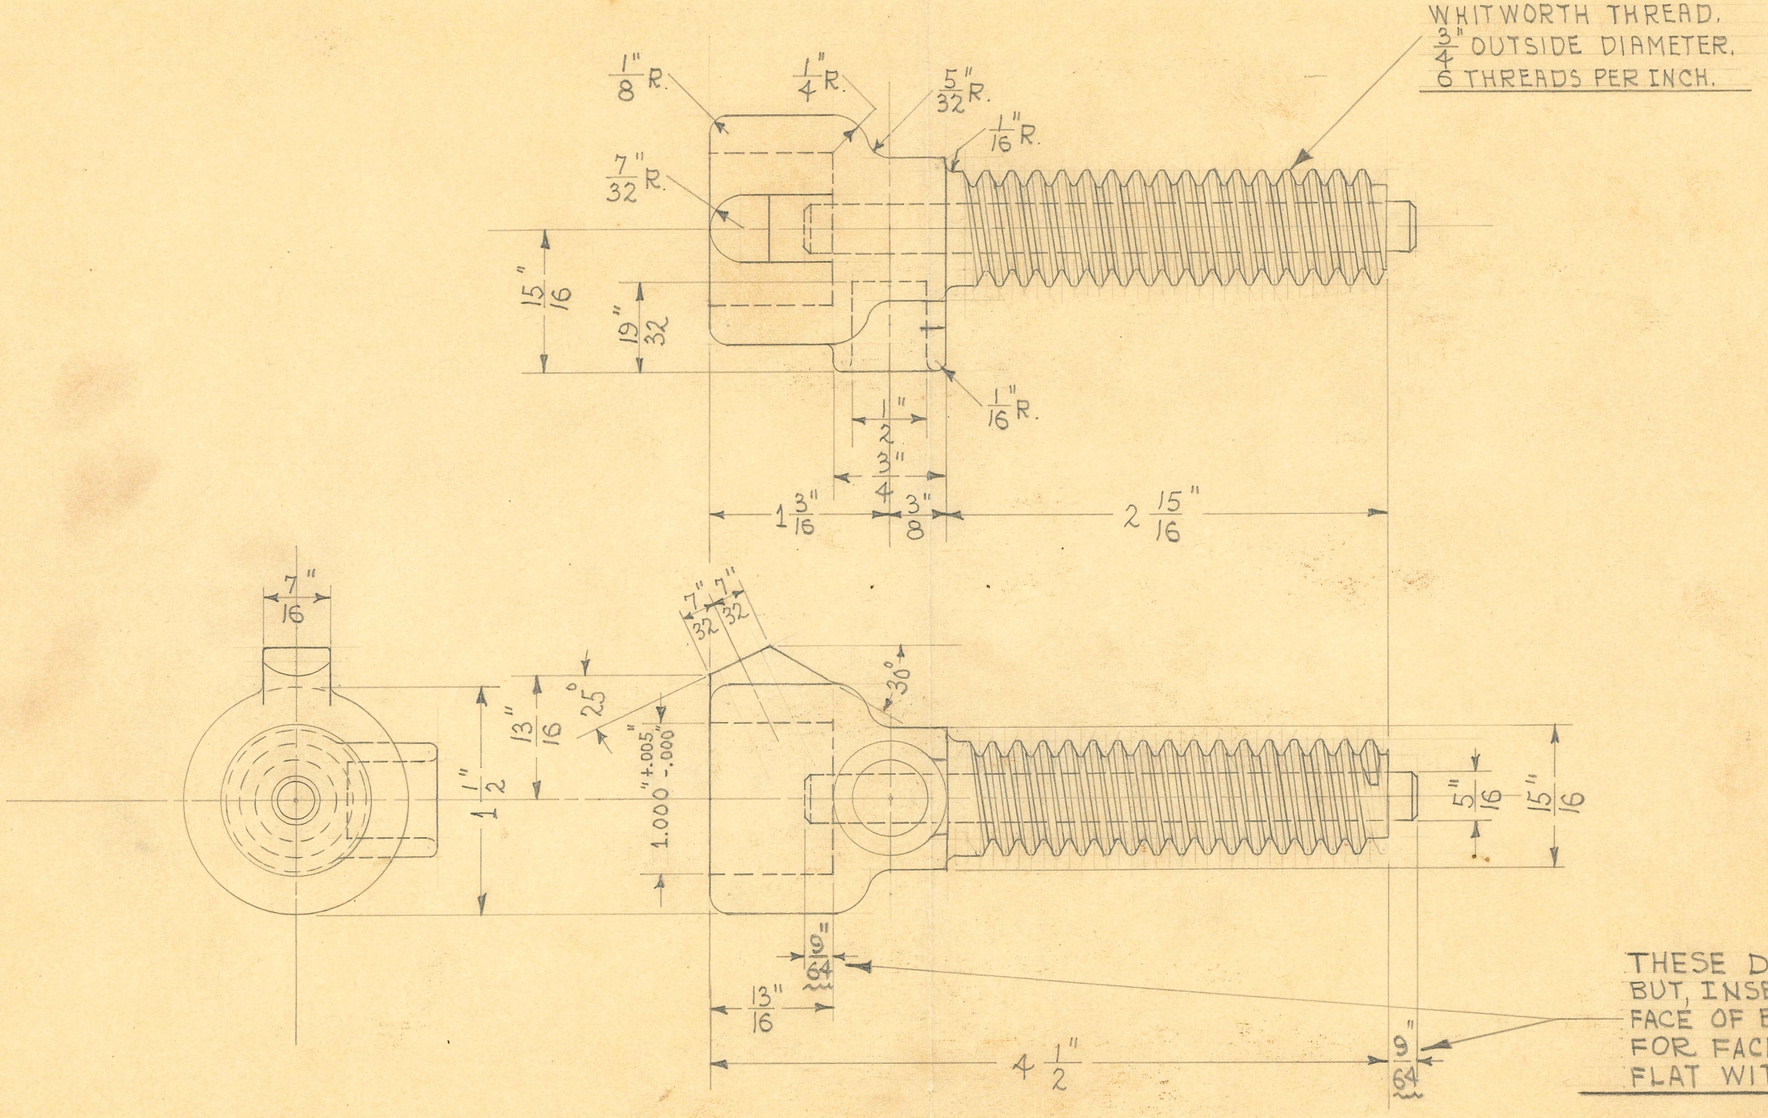

THESE DIMENSIONS NOT IMPORTANT BUT, INSERT MUST PROTRUDE FROM FACE OF BAKELITE ON EITHER END FOR FACING BOTH ENDS OF INSERT FLAT WITH BAKELITE FACE.

OBSOLETE

C. M. P. C. MOLD # M-2435

SIZE	MOLDED	ISSUE 9-20-38	H.E.
KIND	BAKELITE	CHANGED	
SHAPE		"	
FINISH		"	
TEMP.		"	
MOLD PATT.	1806	"	

TITLE: AIR-SPACED ELECTRODE - ADJUSTMENT SCREW

H. G. FISCHER & CO.
2335 WABANSIA AVE.
CHICAGO, ILL.

CAT. NO.

PART NO. 12117G

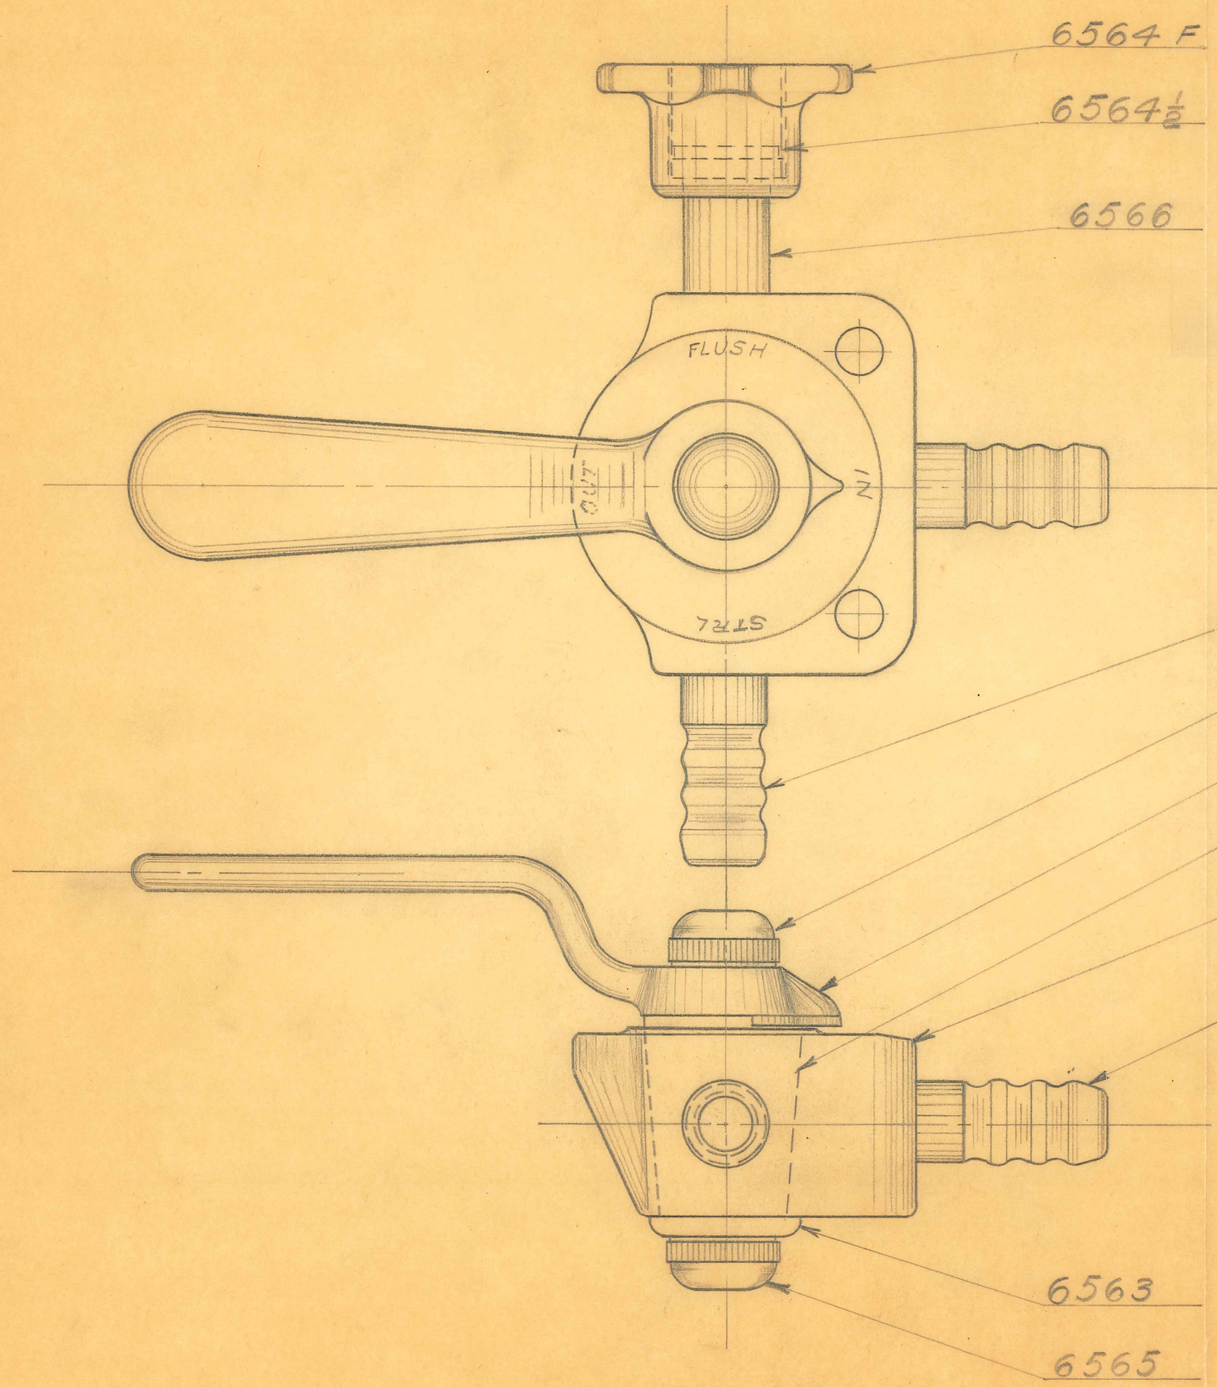

6564 F

6564 ½

6566

6567

6565

6562 F

6561 F

6560 F

6567

6563

6565

OBSOLETE

SIZE		ISSUE 2-16-31	C.H.
KIND		CHANGED	
SHAPE		" "	
FINISH		" "	
TEMP.		" "	
PATT.		" "	

TITLE: COLONIC IRRIGATOR VALVE ASSEMBLY

H. G. FISCHER & CO.
2335 WABANSIA AVE.
CHICAGO, ILL.

CAT. NO.

PART NO. 6560 G

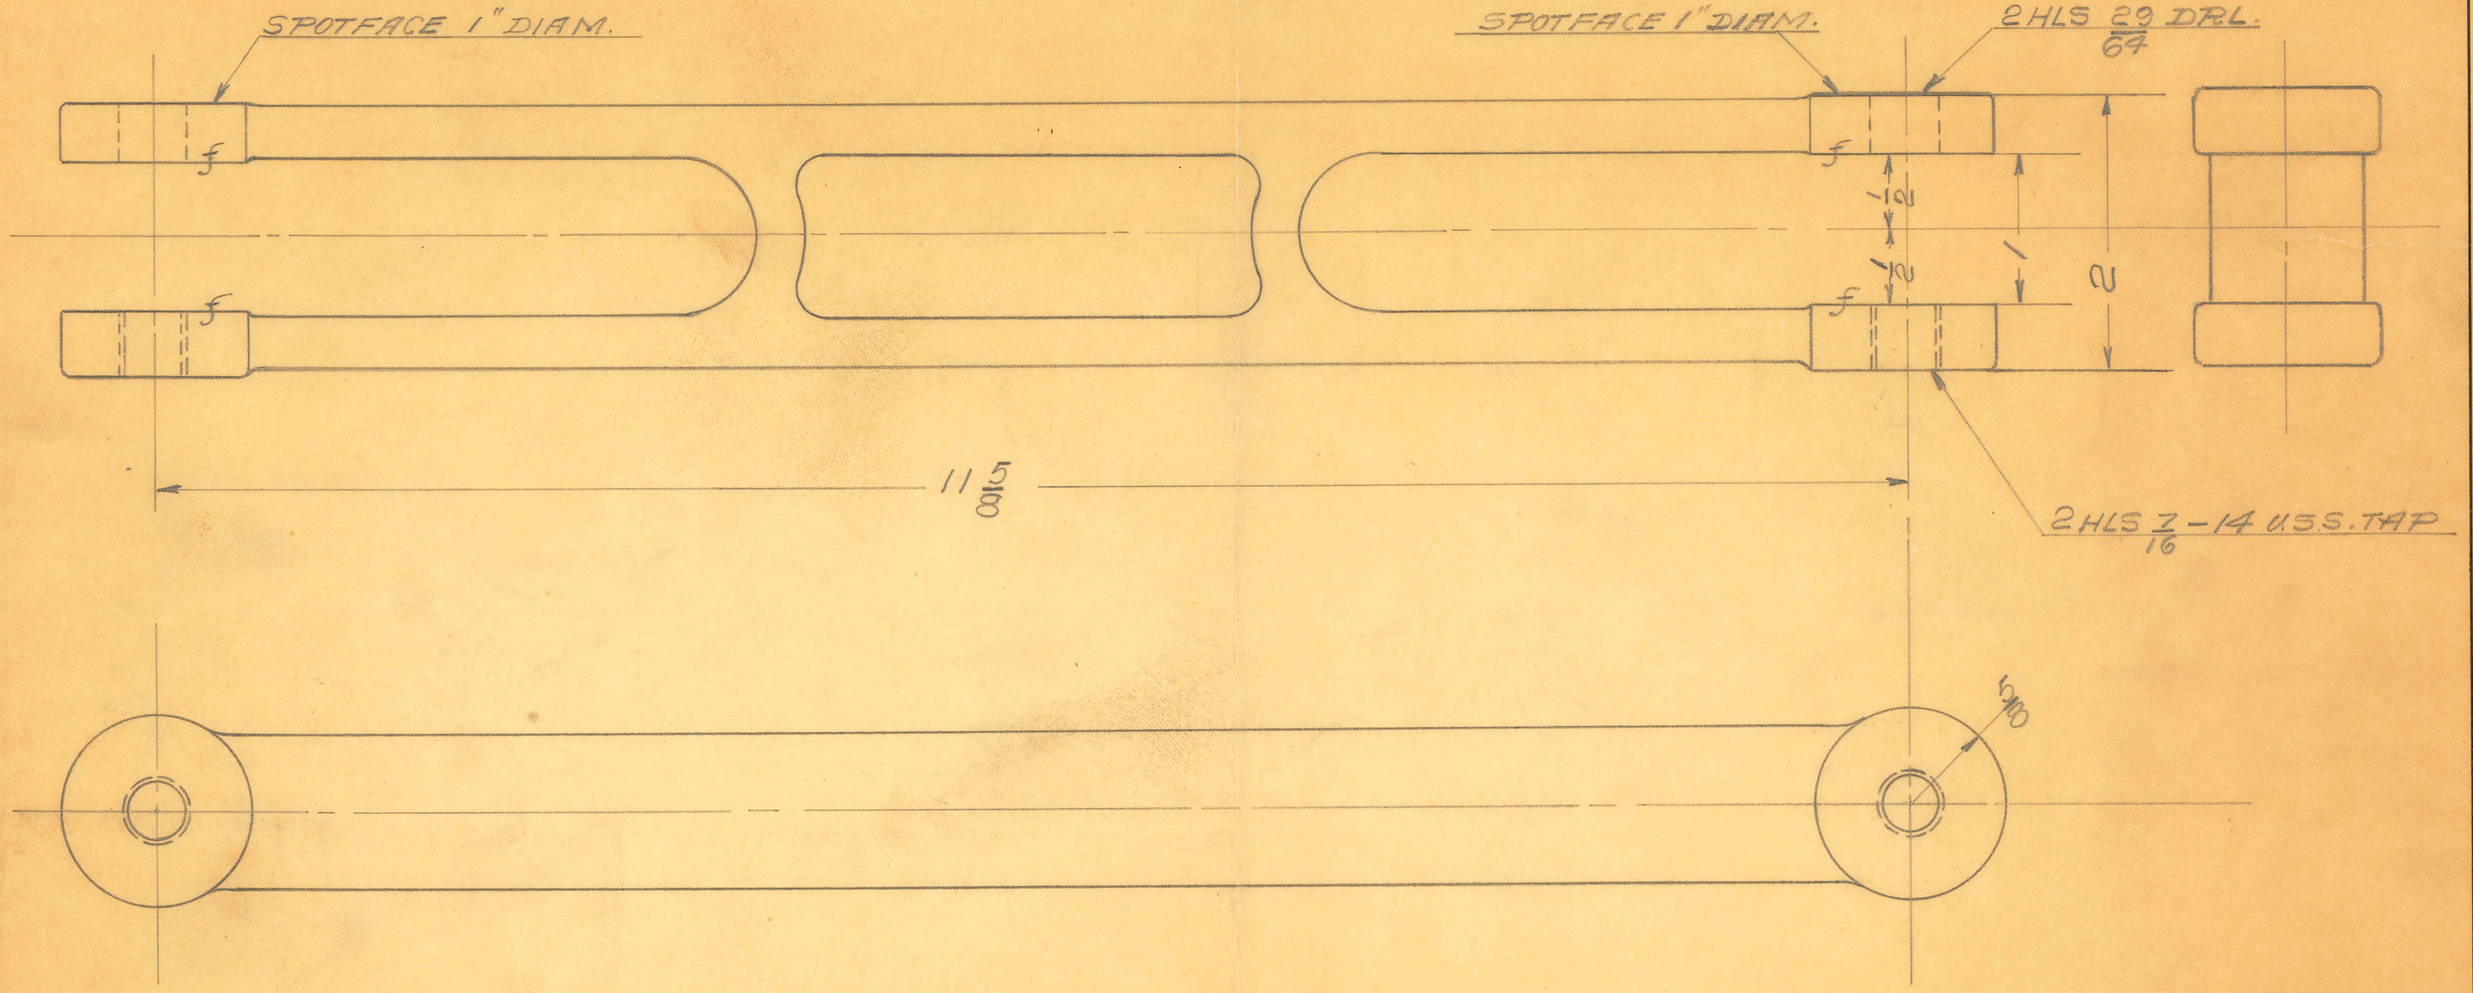

OBSOLETE

SIZE		ISSUE 1-16-31	C#.	TITLE: COLONIC IRRIGATOR SWING ARM
KIND		CHANGED		
SHAPE		" "		
FINISH		" "		
TEMP.		" "		H. G. FISCHER & CO. 2335 WABANSIA AVE. CHICAGO, ILL. — CAT. NO. — PART NO. 6557F
PATT.		" "		

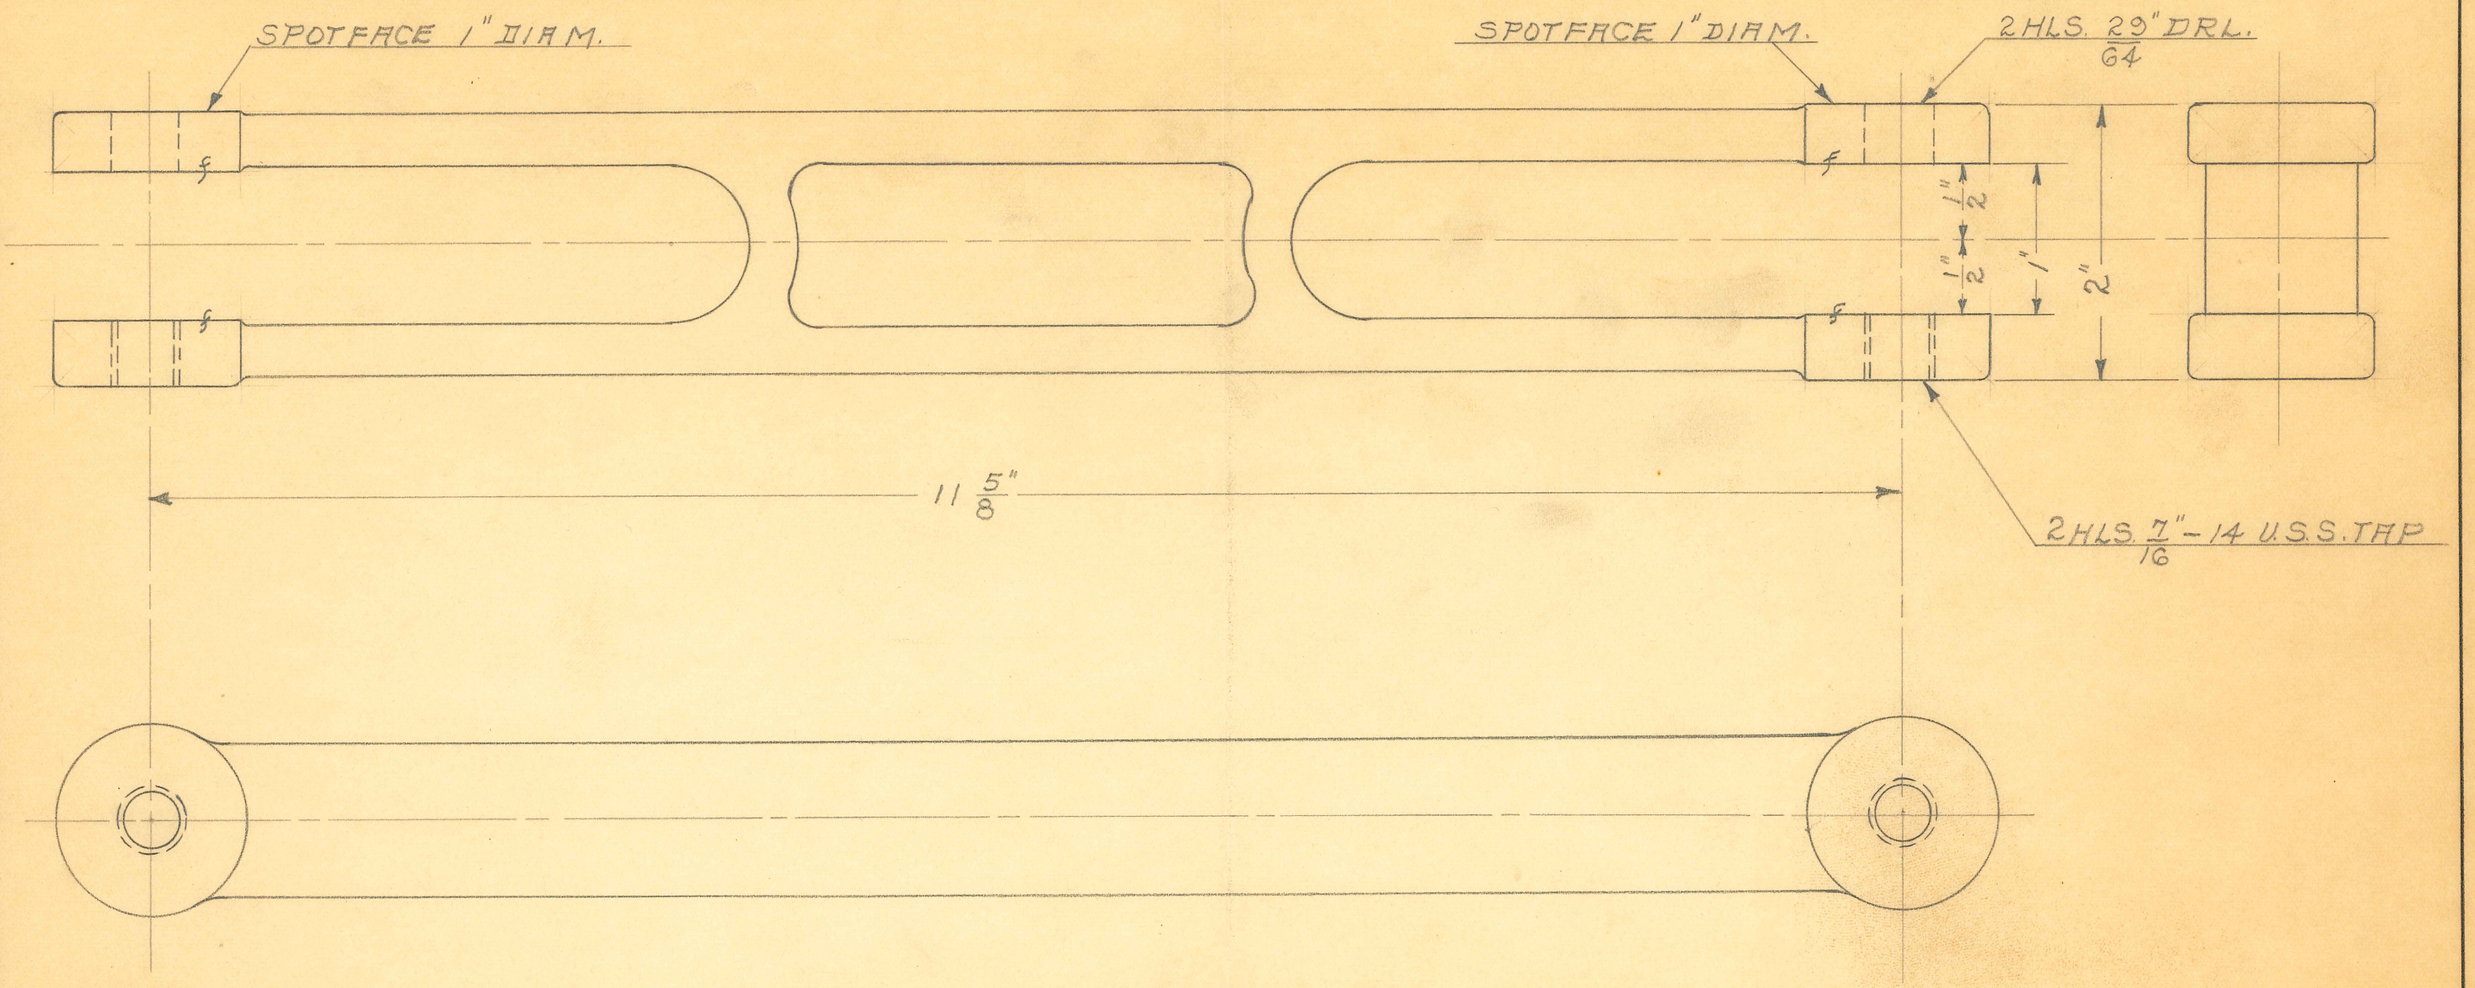

CAST IRON

1 REQ.

SCALE FULL SIZE

OBSOLETE

SIZE		ISSUE 1-16-31	C.M.	TITLE: COLONIC IRRIGATOR SWING ARM
KIND		CHANGED		
SHAPE		" "		
FINISH	W. LACQUER	" "		
TEMP.		" "		H. G. FISCHER & CO. 2335 WABANSIA AVE. CHICAGO, ILL. — CAT. NO. — PART NO. 6557F
PATT.		" "		

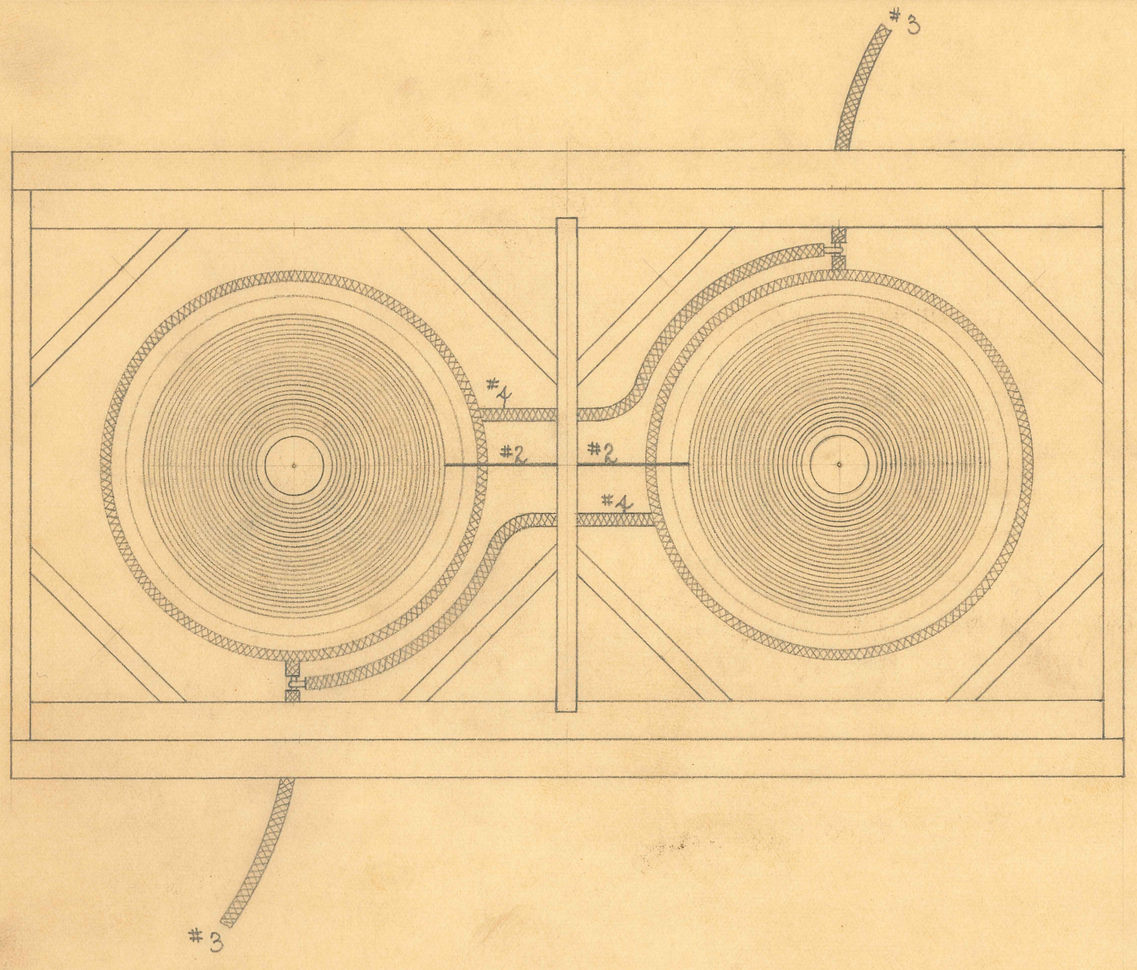

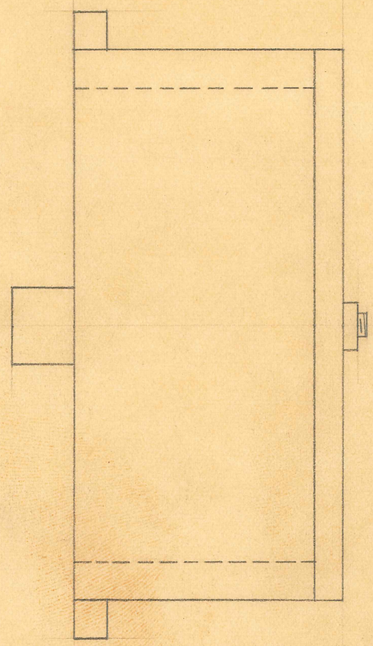

PRIMARY

USE #18 STRANDED WIRE.
ANCHOR LEAD #3 ON H-711-PRI. RING & WIND 24¾ TURNS AND ANCHOR END-LEAD #4. WHEN ASSEMBLING, CONNECT ALL LEADS AS SHOWN.

WINDING DATA

USE #26 SILK ENAMEL WIRE. FASTEN START TO POLE & WIND 70 TURNS ON POLE. 2 LAYERS OF 5007 OILED PAPER. 2ND LAYER OF WIRE TO 140 TURNS. 2 LAYERS OF PAPER. 3RD LAYER OF WIRE TO 210 TURNS,

| | | |

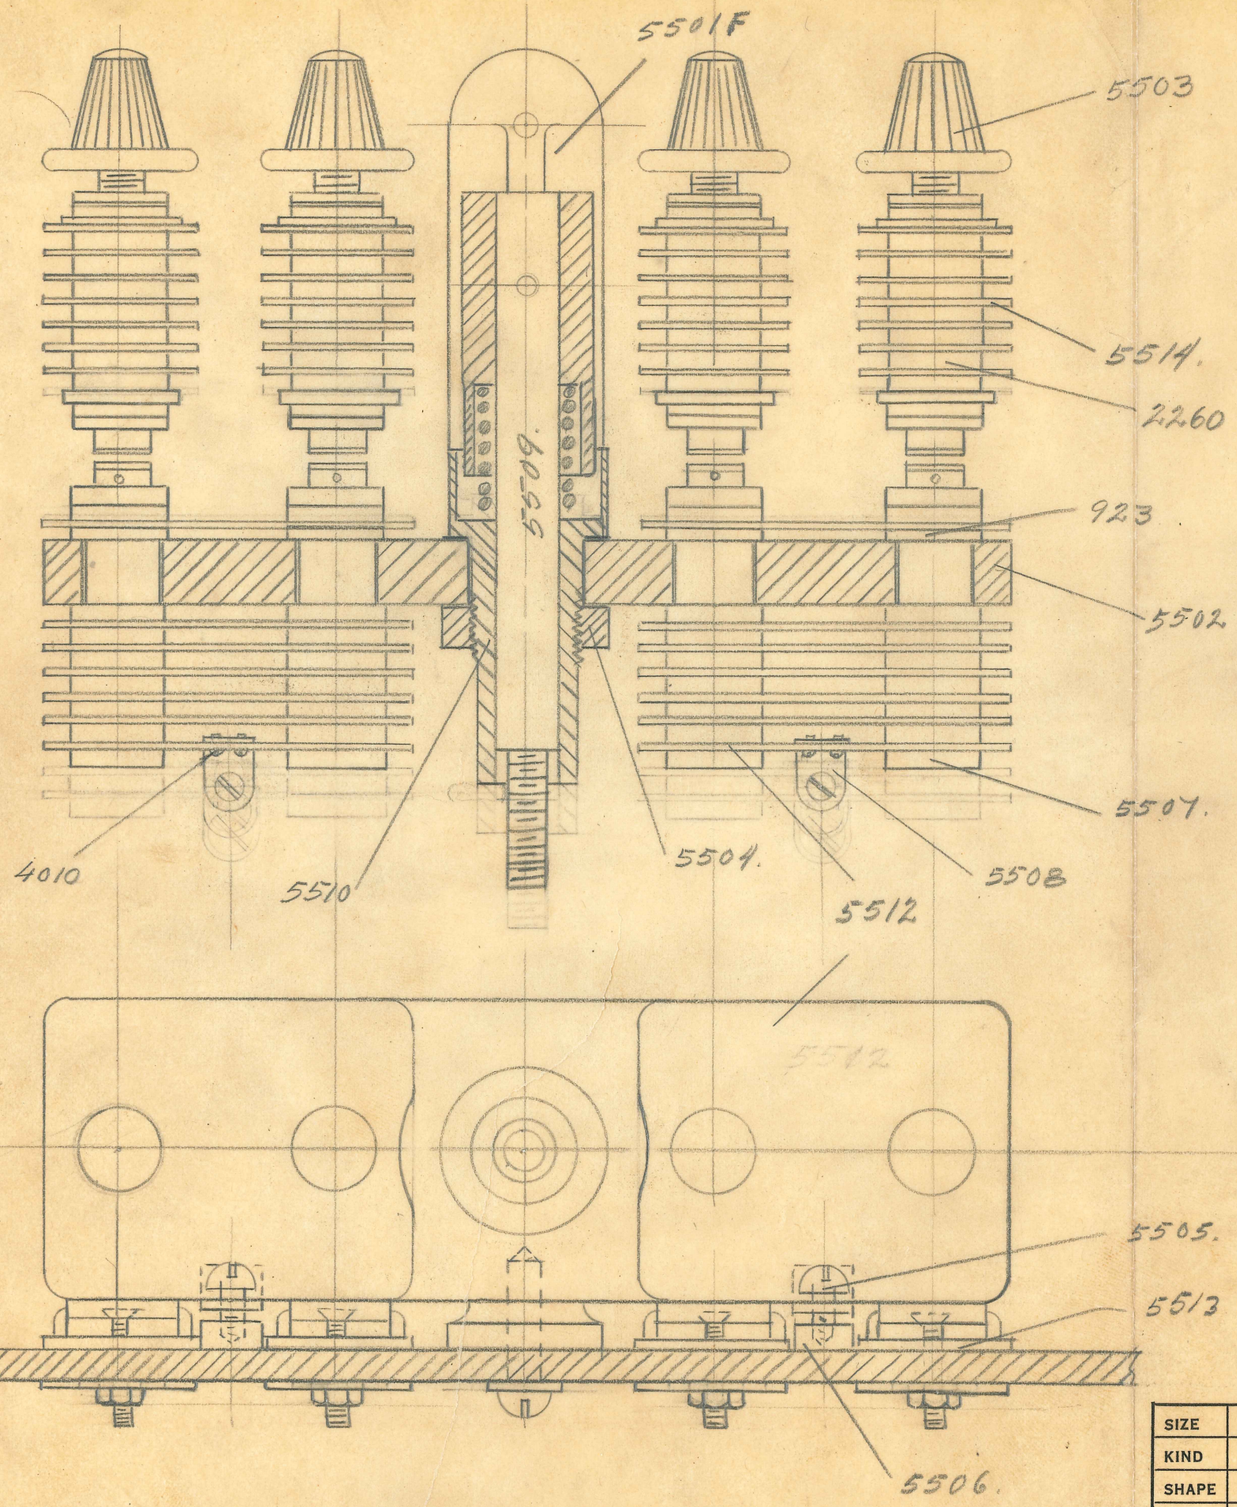

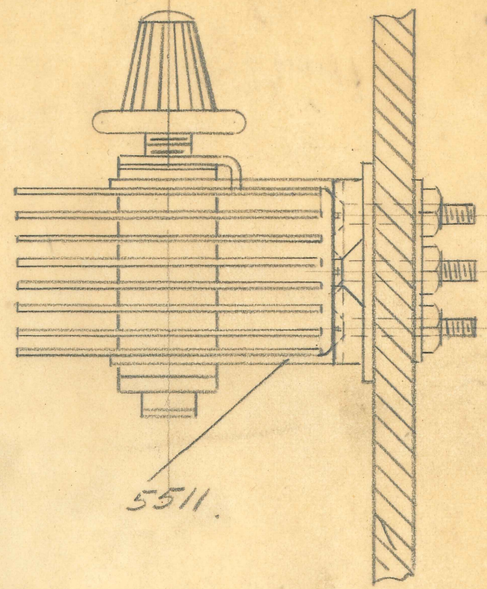

OBSOLETE

SIZE		ISSUE 4-1-26	PF
KIND		CHANGED	
SHAPE		" "	
FINISH		" "	
TEMP.		" "	
PATT.		" "	

TITLE: FOUR-UNIT-GAP TYPE G

H. G. FISCHER & CO.
2335 WABANSIA AVE.
CHICAGO, ILL.

CAT. NO.

PART NO. 5500G

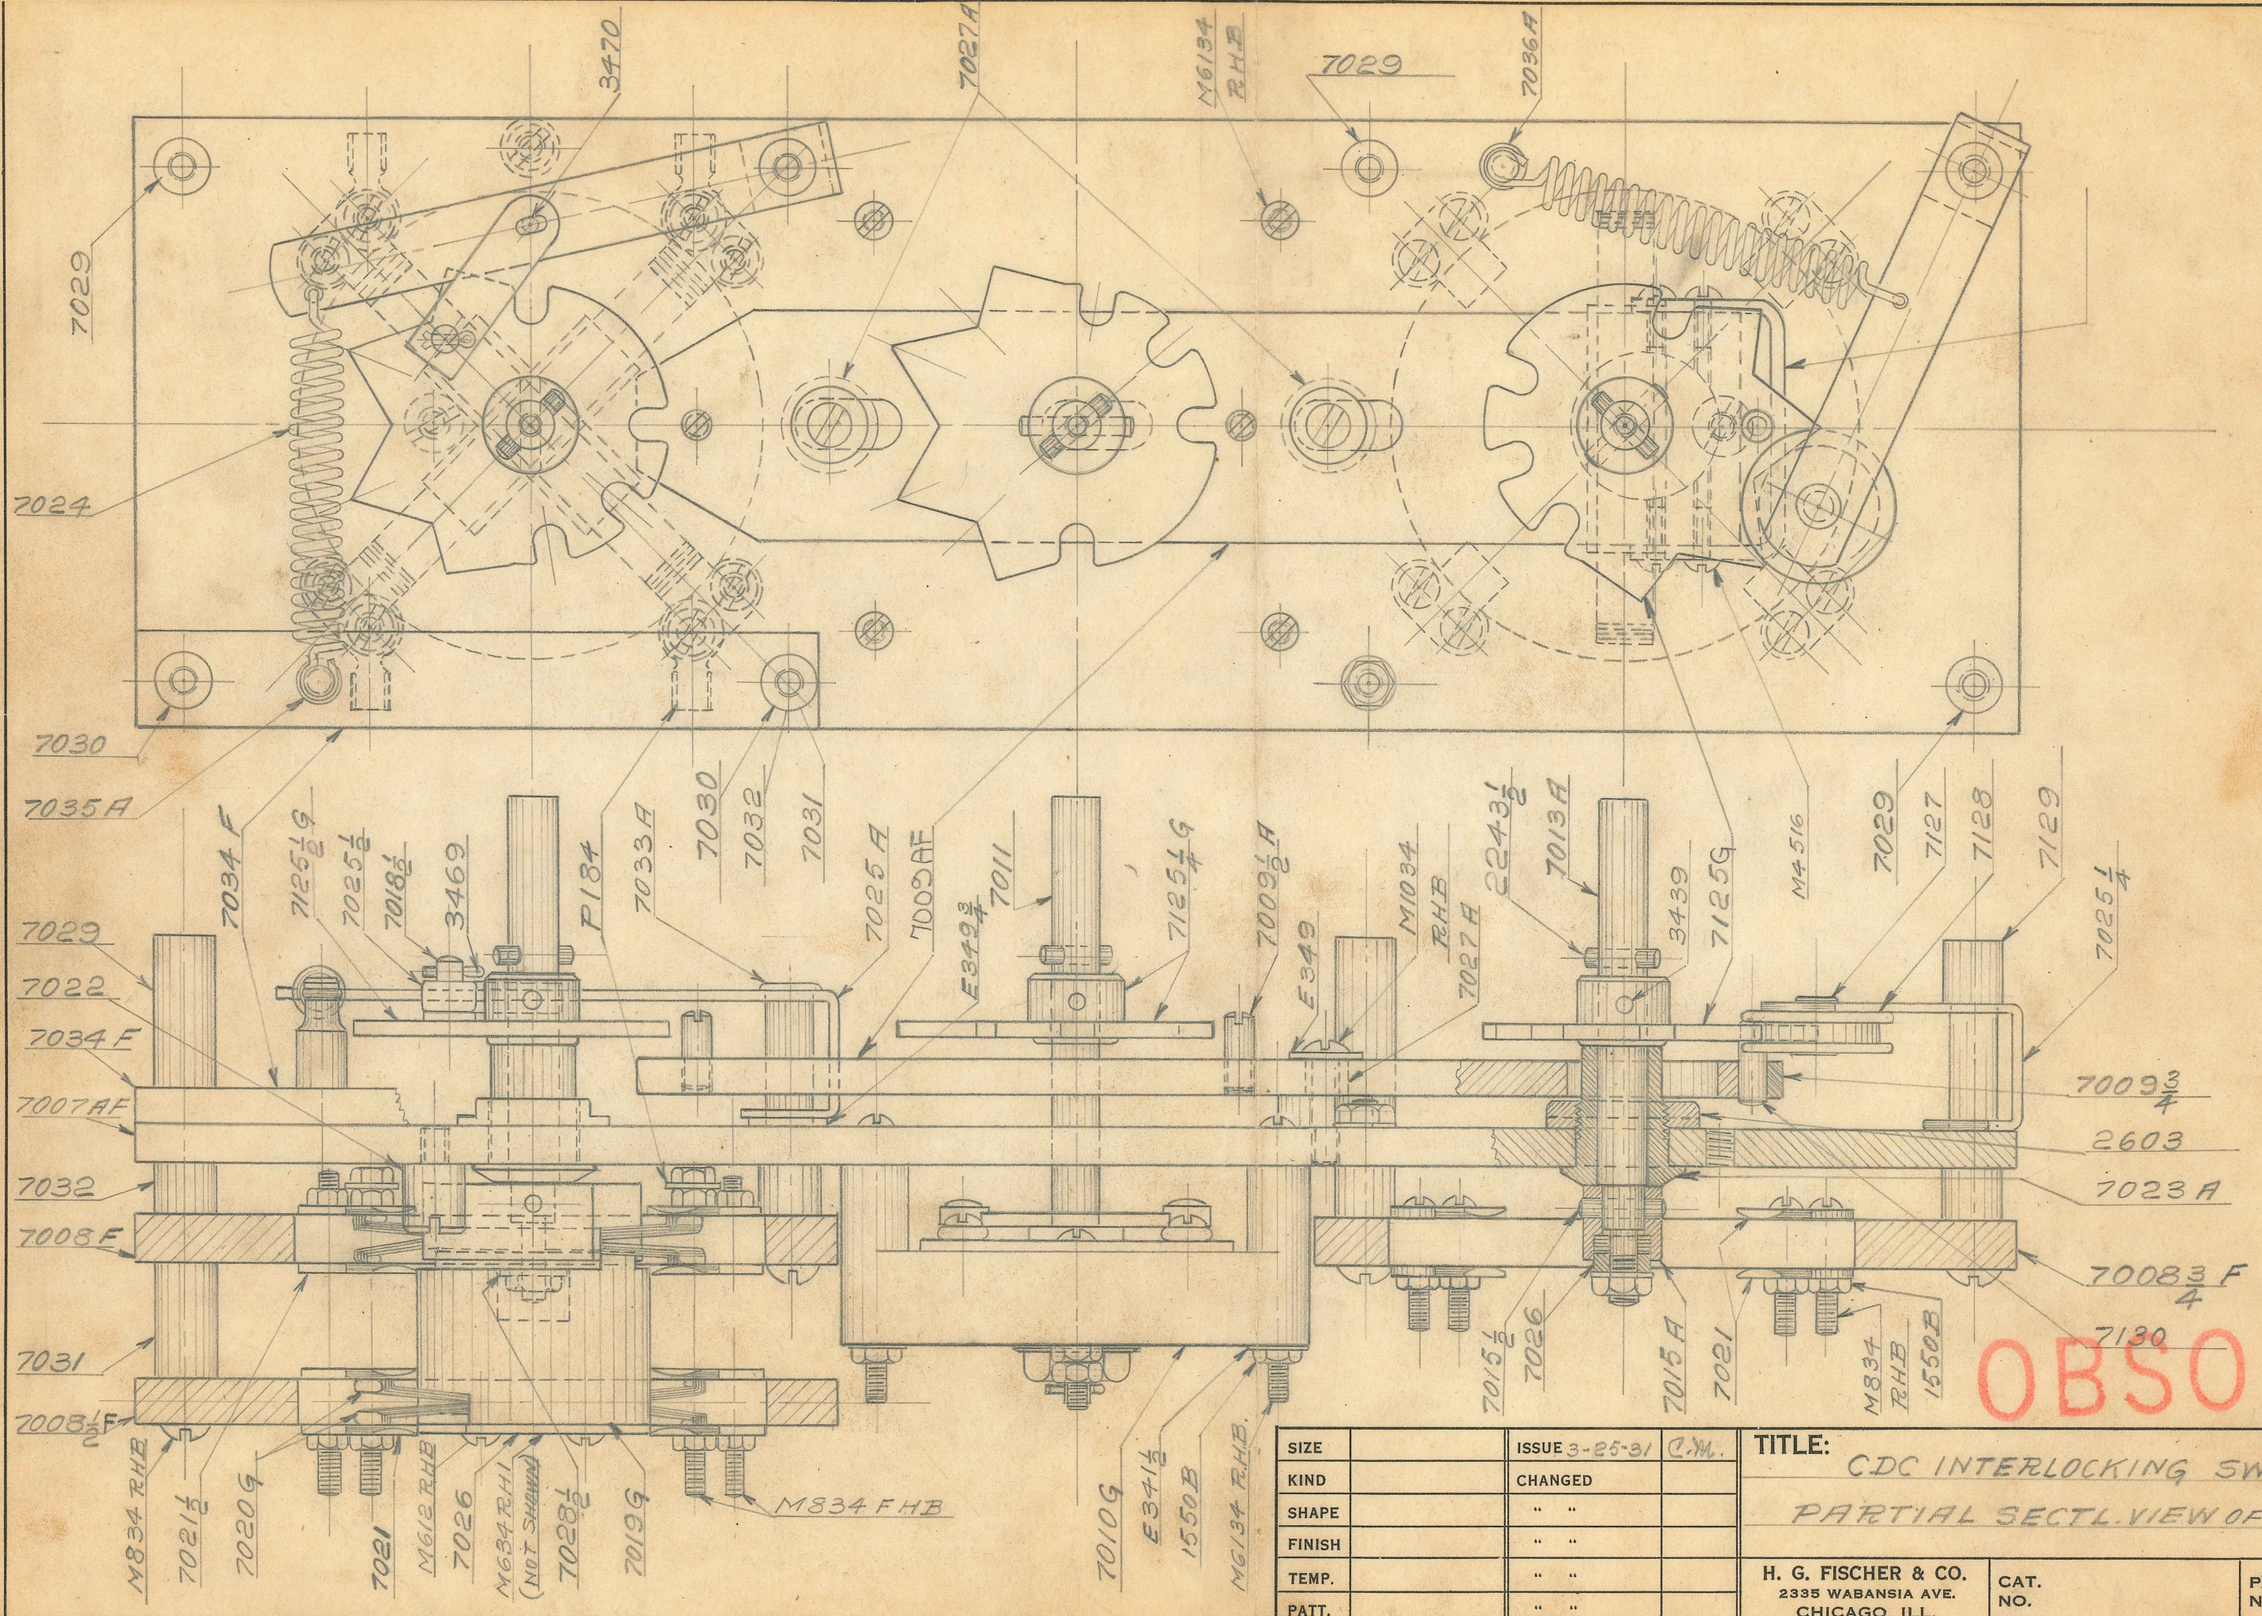

OBSOLETE

SIZE		ISSUE 3-25-31	C.M.
KIND		CHANGED	
SHAPE		" "	
FINISH		" "	
TEMP.		" "	
PATT.		" "	

TITLE: CDC INTERLOCKING SWITCH
PARTIAL SECTL. VIEW OF ASSEMBLY

H. G. FISCHER & CO.
2335 WABANSIA AVE.
CHICAGO, ILL.

CAT. NO.

PART NO. 7006GA

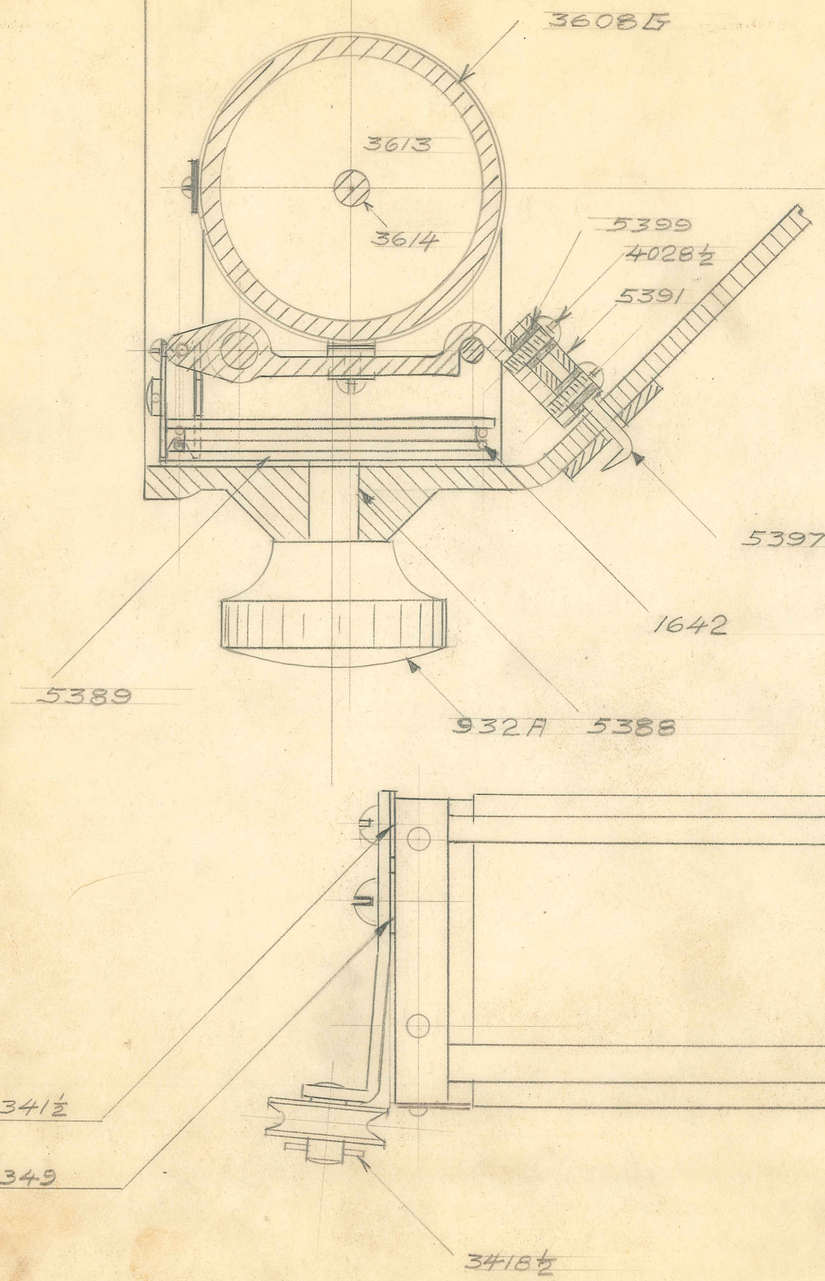

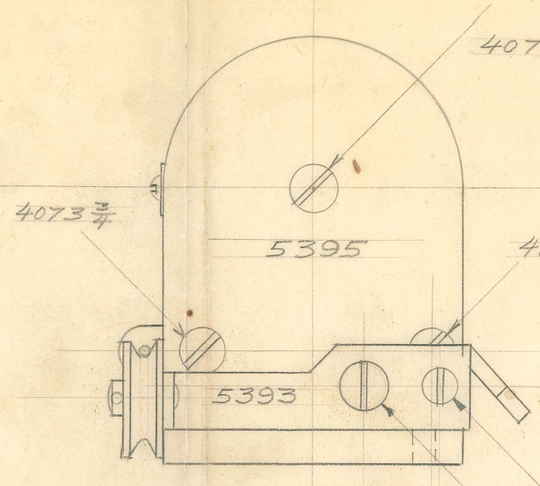

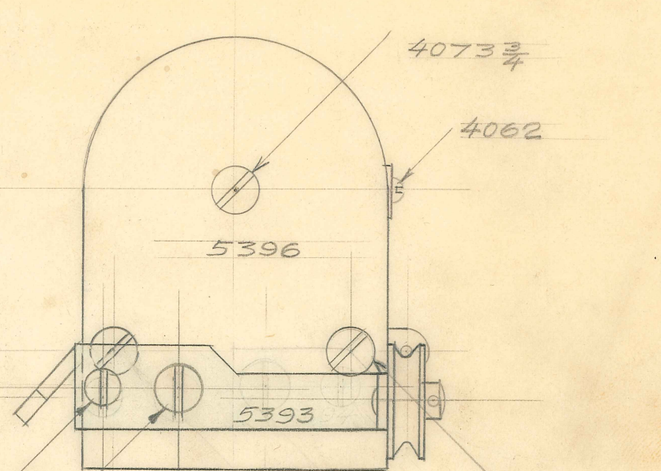

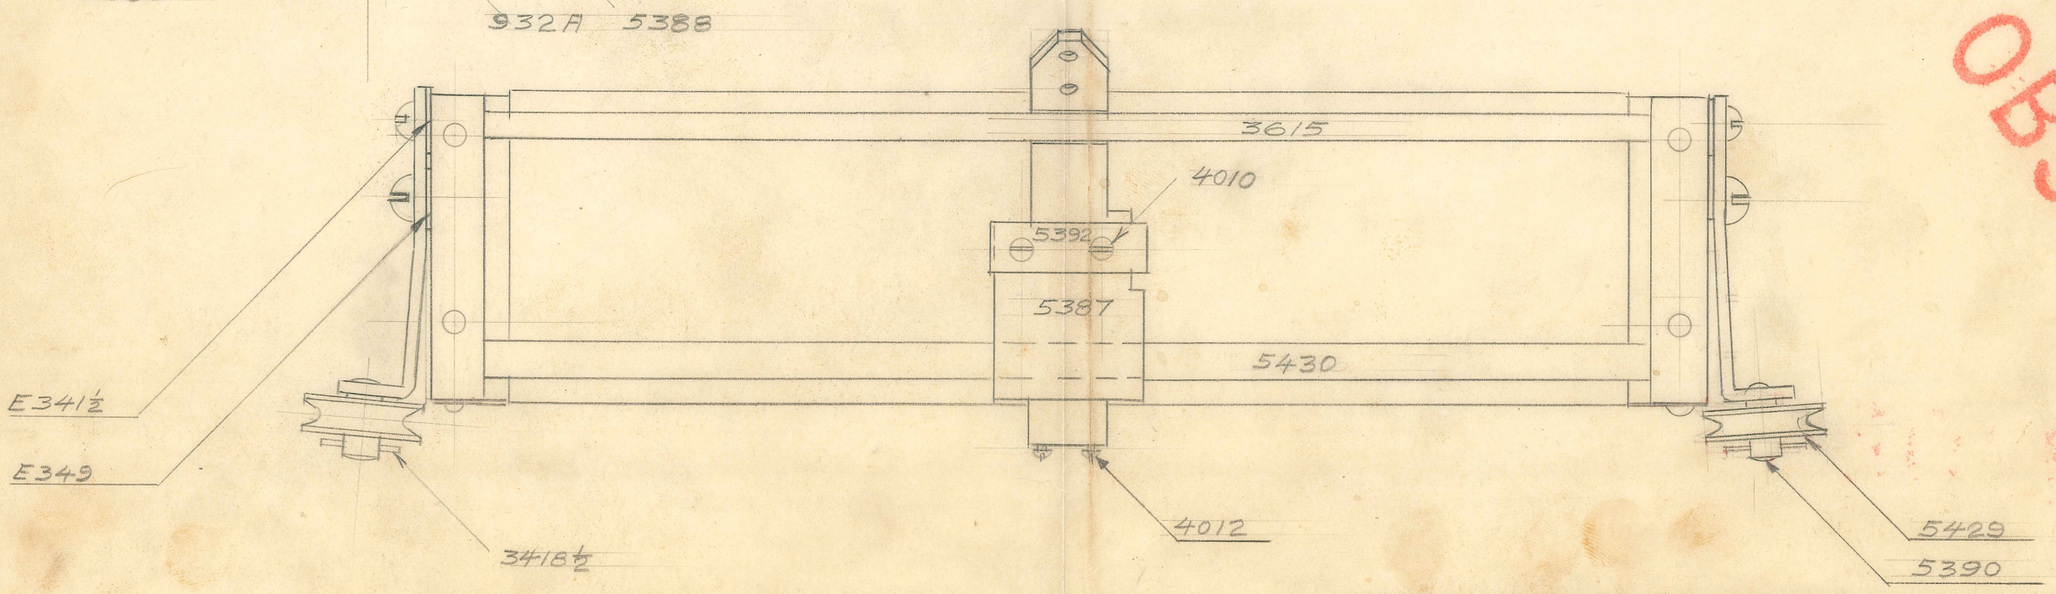

OBSOLETE

SIZE		ISSUE 9-3-26	OP
KIND		CHANGED	
SHAPE		" "	
FINISH		" "	
TEMP.		" "	
PATT.		" "	

TITLE: WAVE-GENERATOR RHEOSTAT COIL COMPL.

H. G. FISCHER & CO.
2335 WABANSIA AVE.
CHICAGO, ILL.

CAT. NO.

PART NO. 5386G

(1)

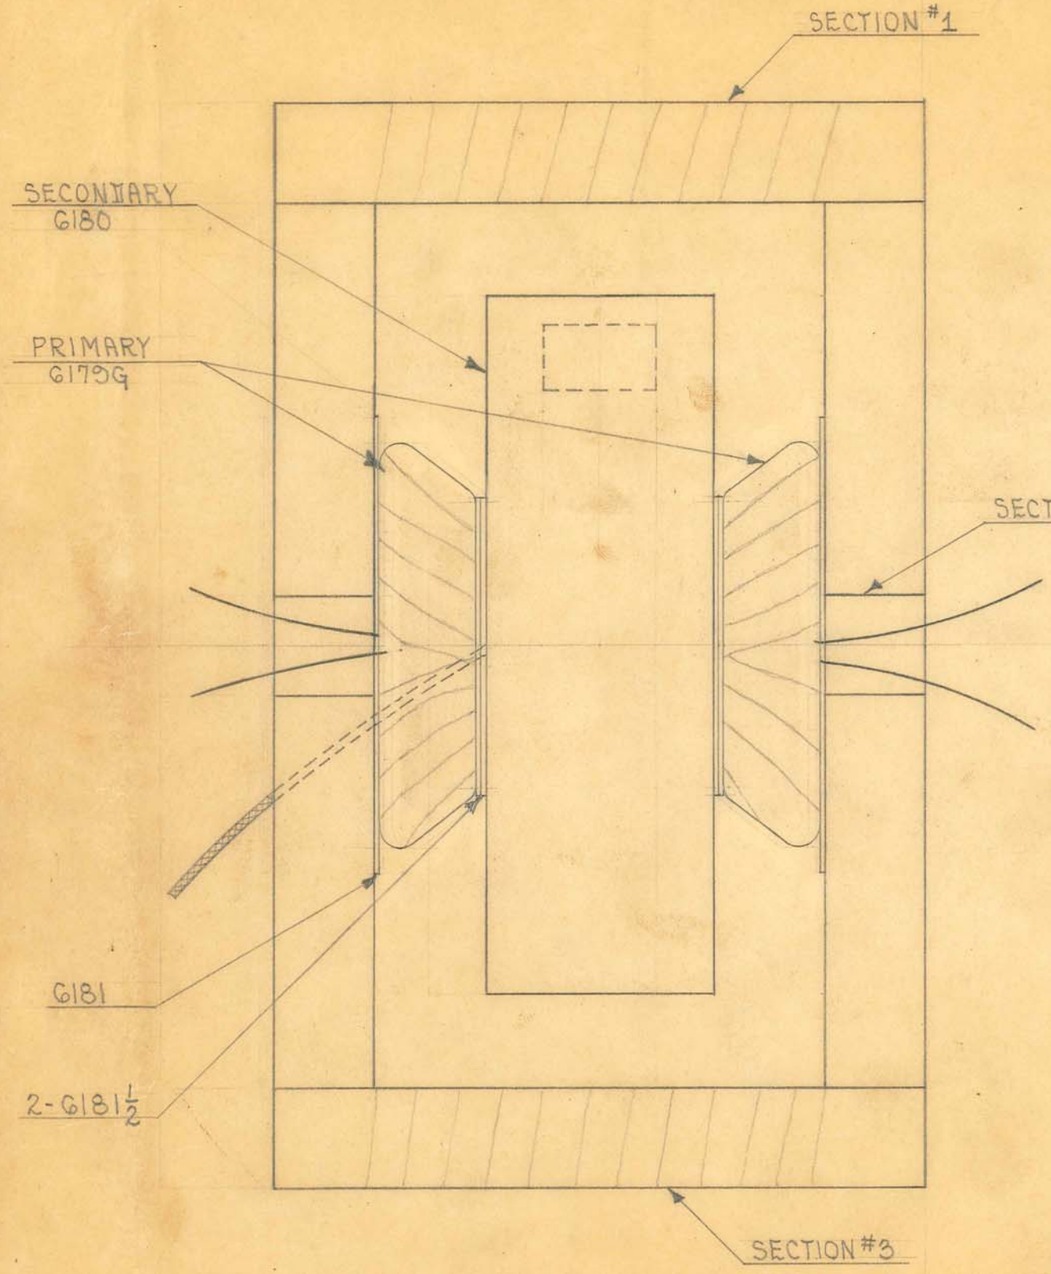

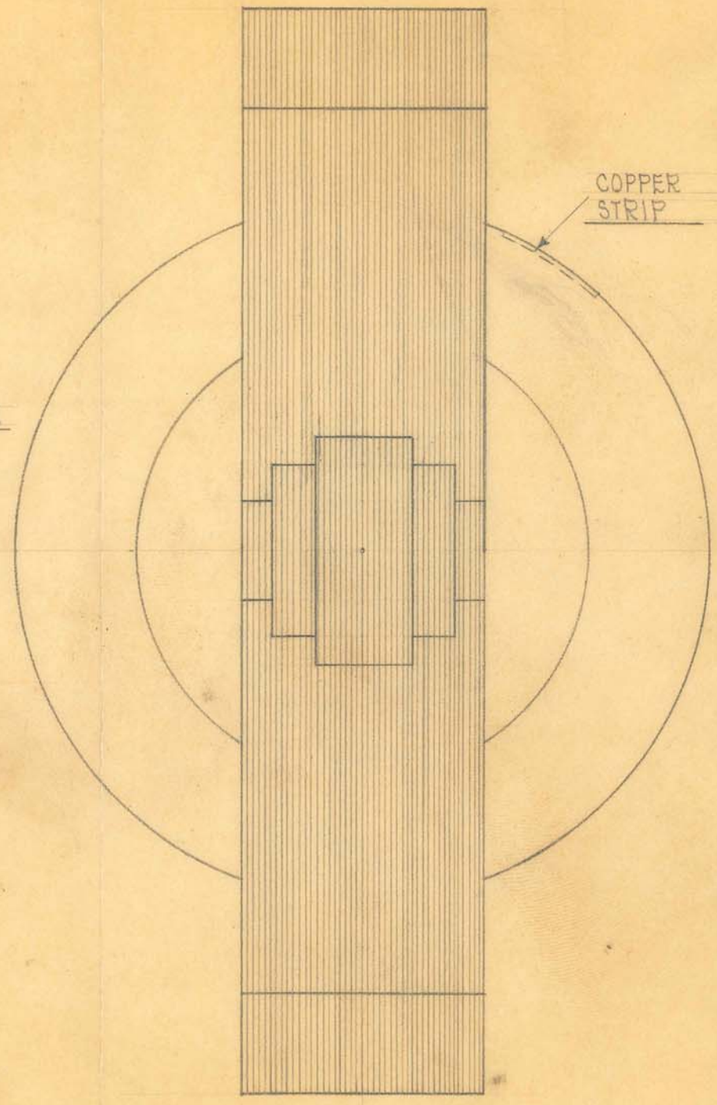

SCALE ~ 3/4" = 1"

STEEL SIZES

PC. NO. 5043

SECTS. #1 & #3 - LAMS. CUT $4\frac{31}{32}$" X $\frac{7}{8}$" BUILT UP TO APPROX. 2". (JIG. # 2912)

SECT. #2 - 46 LAMS. CUT $4\frac{31}{32}$" X 2".
34 LAMS. CUT $4\frac{31}{32}$" X $1\frac{1}{2}$".
24 LAMS. CUT $4\frac{31}{32}$" X $\frac{7}{8}$".

END PIECES - $7\frac{3}{4}$" X $\frac{7}{8}$"
$4\frac{5}{16}$" X $\frac{7}{8}$"
4" X $\frac{7}{8}$"
$3\frac{3}{4}$" X $\frac{7}{8}$"

BIND SECTS. #1, #2 & #3 WITH FRICTION TAPE AND THEN WRAP SECTS. #1 & #3 WITH LINEN TAPE. WRAP SECT. #2 WITH FIBROID PAPER TO FIT SEC. PLACE 1-G179G AND G180 ON SECT. #2, PACK WITH SCRAP FIBRE STRIPS TO HOLD IN PLACE AND THEN PUT ON OTHER G179G PRI. COIL.

OBSOLETE

SIZE		ISSUE 3-16-32	A.E.	TITLE: DENTAL X TRANSFORMER
KIND		CHANGED		
SHAPE		" "		
FINISH		" "		
TEMP.		" "		H. G. FISCHER & CO. 2335 WABANSIA AVE. CHICAGO, ILL. — CAT. NO. — PART NO. G170G
PATT.		" "		

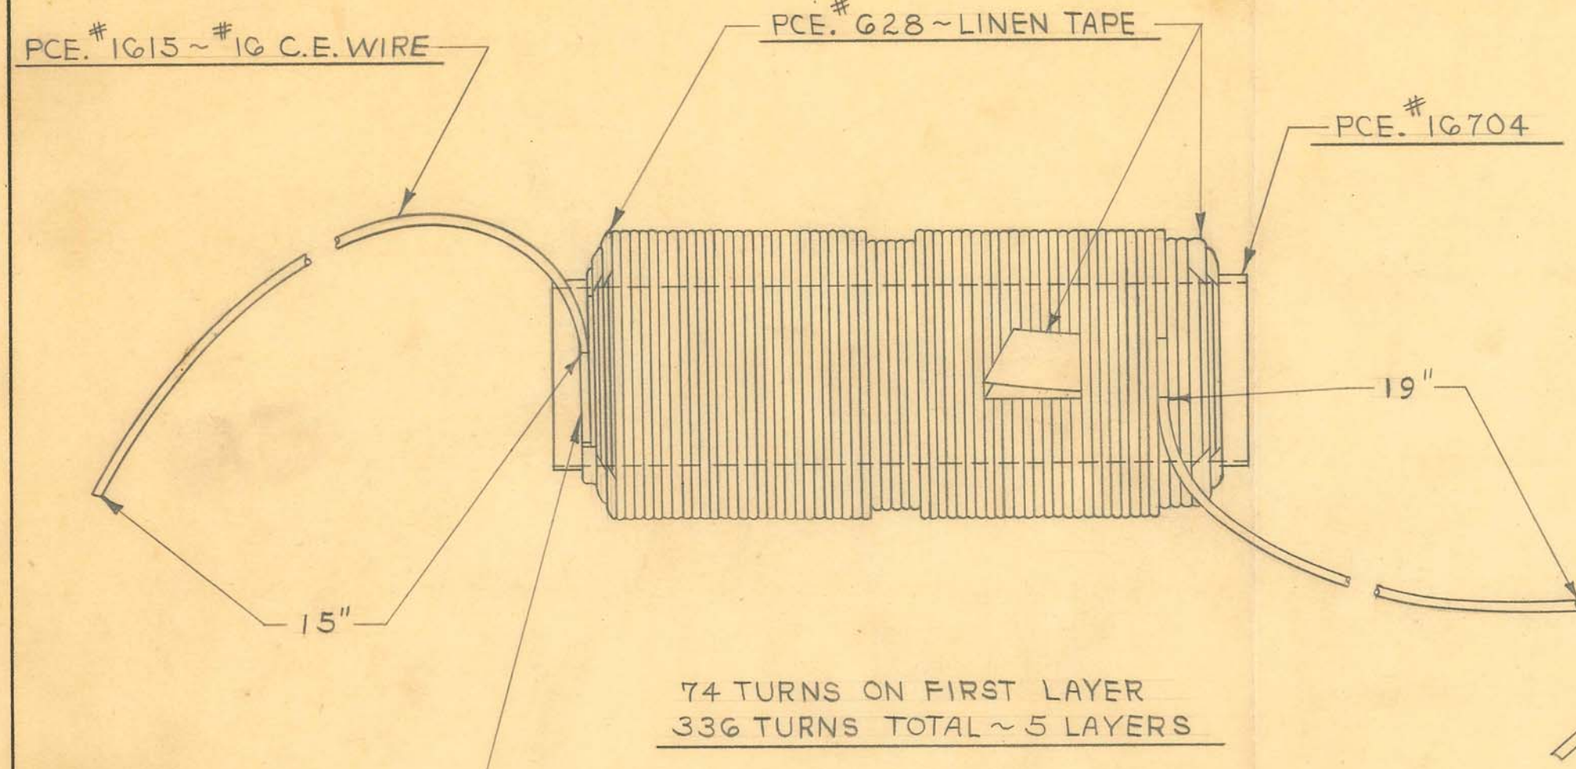

74 TURNS ON FIRST LAYER
336 TURNS TOTAL ~ 5 LAYERS

KEEP FIRST LAYER $\frac{3}{16}$" FROM
EITHER END OF CARDBOARD TUBE

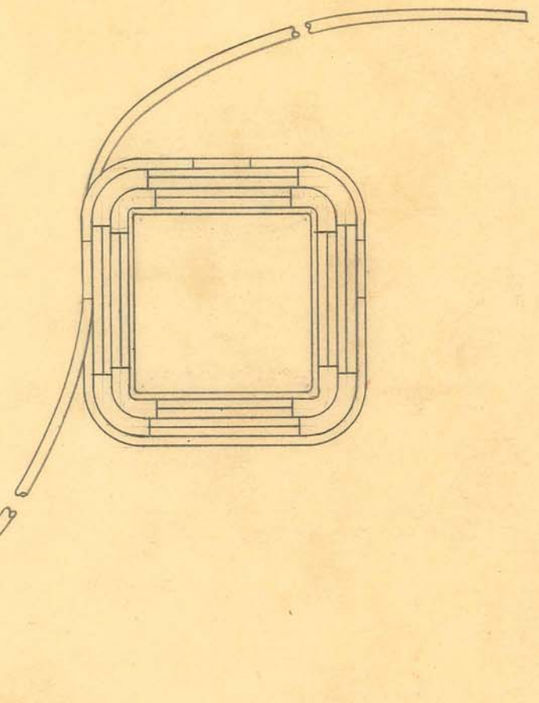

OBSOLETE

SIZE		ISSUE 9-23-47	W.J.	TITLE: FISCHER "MP-10" X-RAY UNIT MAIN PRIMARY WINDING PART OF
KIND		CHANGED		
SHAPE		"		
FINISH		"		
TEMP.		"		
PATT.		"		

H. G. FISCHER & CO.
2335 WABANSIA AVE.
CHICAGO, ILL.

CAT. NO.

PART NO. 16711G

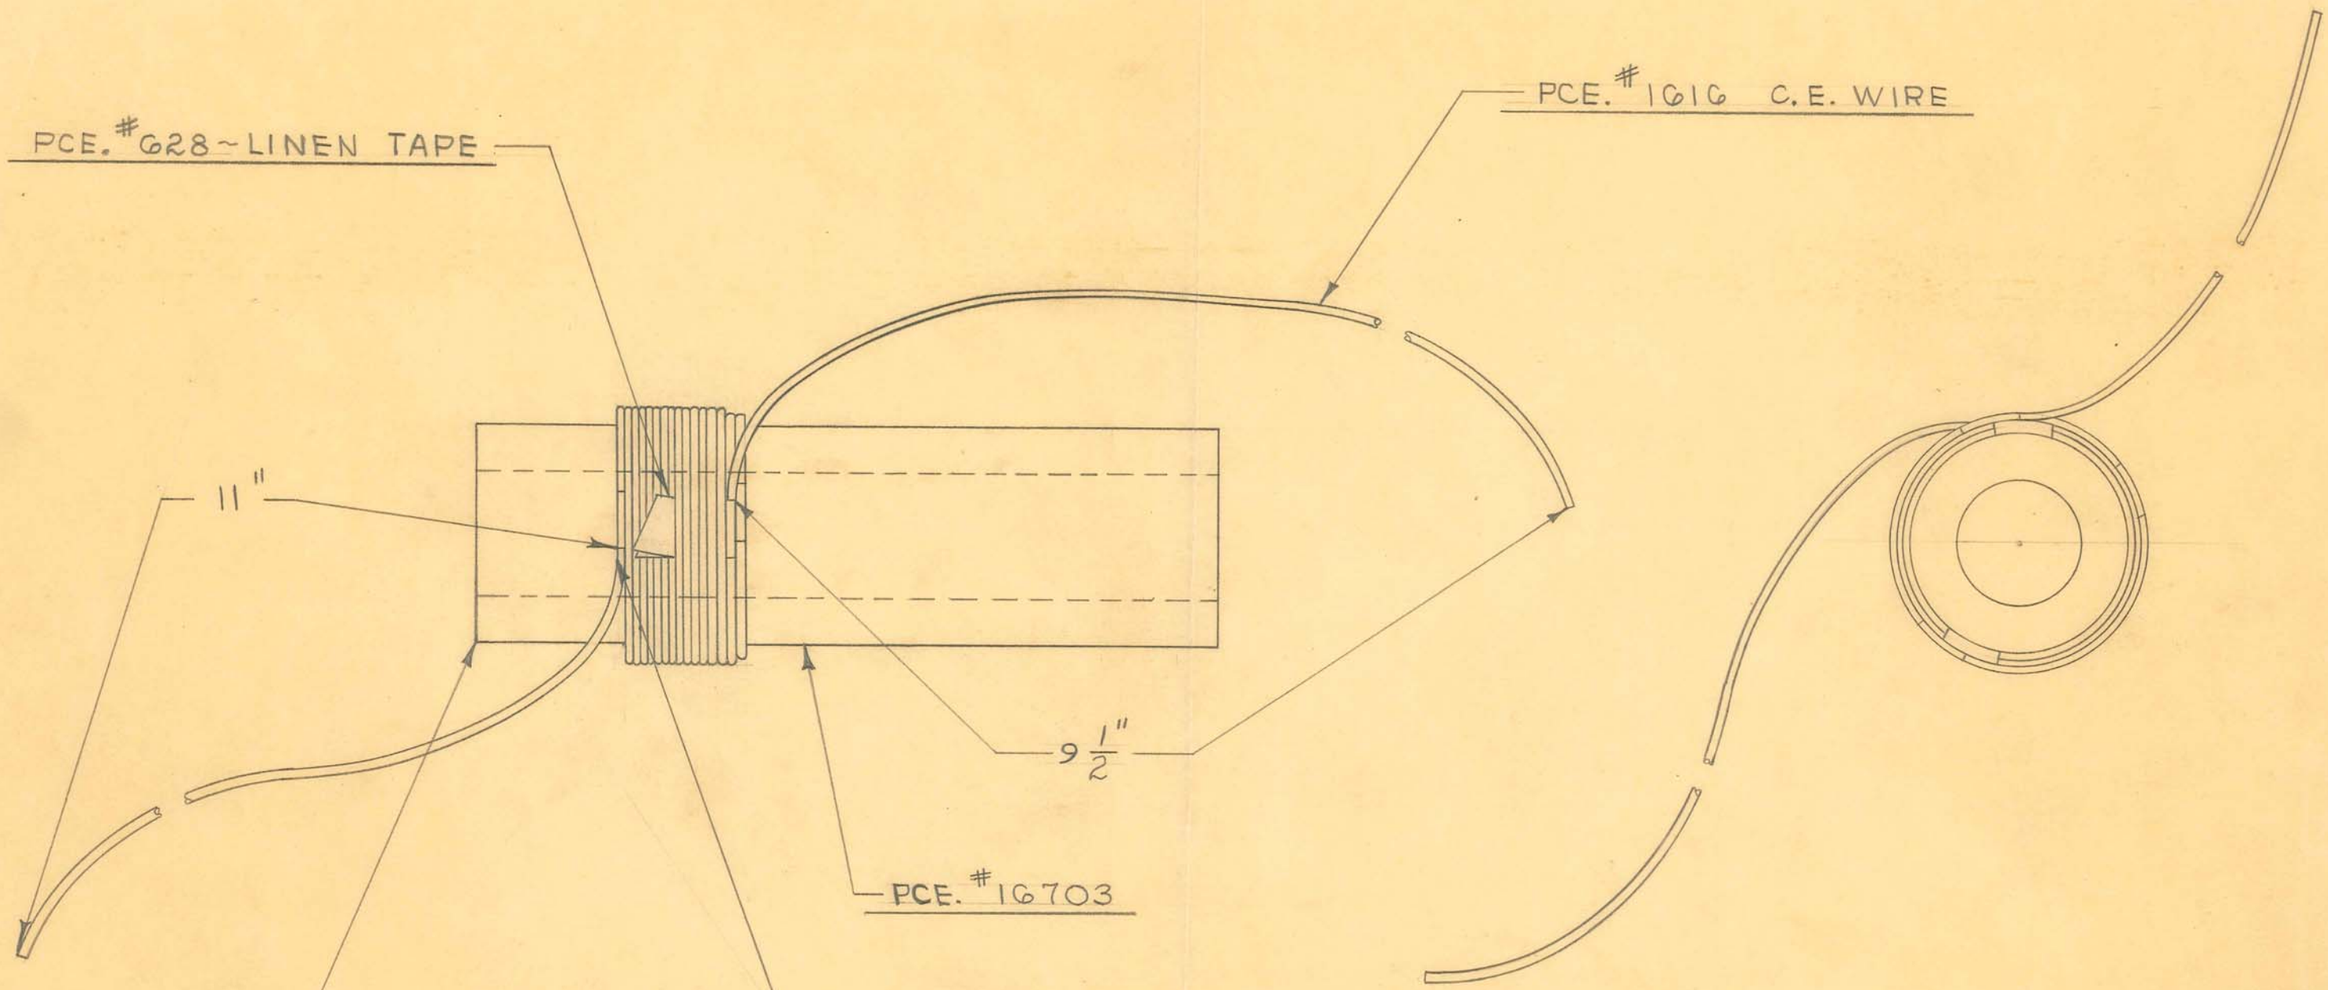

18 TURNS ON FIRST LAYER
17 TURNS ON SECOND LAYER
15 TURNS ON THIRD LAYER
50 TURNS TOTAL

1 REQUIRED

OBSOLETE

SIZE		ISSUE 9-23-47	W. J.	TITLE: FISCHER "MP-10" X-RAY UNIT SECONDARY FILAMENT WINDING PART OF
KIND		CHANGED		
SHAPE		"		
FINISH		"		
TEMP.		"		
PATT.		"		H. G. FISCHER & CO. 2338 WABANSIA AVE. CHICAGO, ILL. — CAT. NO. — PART NO. 16710G

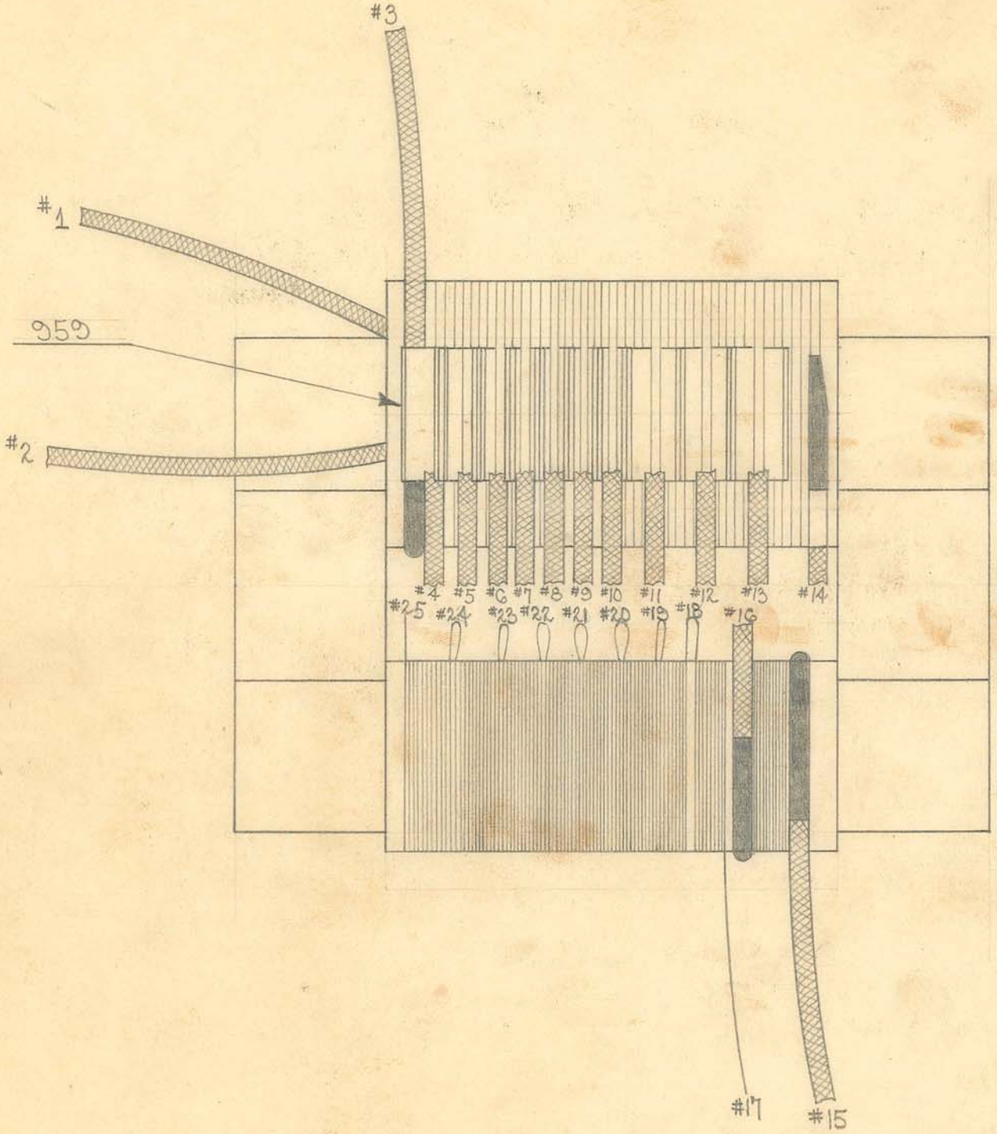

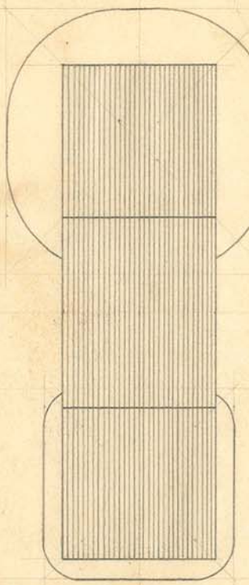

STEEL SIZES

PC. NO. 5043

CORE LAMS. CUT - 4" X 1" BUILT UP TO 1".
END PIECES CUT - 2¼" X 1".
BIND CORES WITH FRICTION TAPE.

WINDING DATA

PRIMARY

USE #24 ENAMEL WIRE

3 LAYERS OF 502D FIBROID PAPER ON CORE.
ANCHOR LEAD #1 WITH FRICTION TAPE & WIND 600 TURNS & ANCHOR LEAD #2 WITH FRICTION TAPE.
1 LAYER OF FIBROID BETWEEN EACH LAYER OF WIRE.
COVER PRI. WITH 3 LAYERS OF FIBROID.

CAUTERY & DIAGNOSTIC

USE #16 COTENAMEL WIRE

ANCHOR LEAD #3 WITH FRICTION TAPE & WIND 3 TURNS & TAP-LEAD #4 (TAPS #4 TO #13 INCL. EACH INSULATED WITH 1-959 FIBRE SEPARATOR). WIND 1 TURN & TAP-LEAD #5. WIND 2 TURNS & TAP-LEAD #6. WIND 2 TURNS & TAP-LEAD #7. WIND 3 TURNS & TAP-LEAD #8. WIND 3 TURNS & TAP-LEAD #9. WIND 4 TURNS & TAP-LEAD #10. WIND 5 TURNS & TAP-LEAD #11. WIND 6 TURNS & TAP-LEAD #12. WIND 7 TURNS & TAP-LEAD #13. WIND 8 TURNS & ANCHOR END WITH FRICTION TAPE-LEAD #14. SHELLAC WINDING.

SINUSOIDAL

USE #26 COTENAMEL WIRE

3 LAYERS OF 5020 FIBROID ON OTHER CORE. ANCHOR LEAD # 15 WITH FRICTION TAPE & WIND 40 TURNS & ANCHOR END WITH LINEN TAPE-LEAD #16. LEAD #1 - #16 INCL. ARE 1603-#18 STRANDED WIRE. ANCHOR LEAD #17 WITH FRICTION TAPE & WIND 9 TURNS & BRING OUT TAP #18. WIND 10 TURNS & BRING OUT TAP #19. WIND 11 TURNS & BRING OUT TAP #20. WIND 12 TURNS & BRING OUT TAP #21. WIND 13 TURNS & BRING OUT TAP #22. WIND 15 TURNS & BRING OUT TAP #23. WIND 18 TURNS & BRING OUT TAP #24. WIND 21 TURNS & ANCHOR END WITH LINEN TAPE - LEAD #25. SHELLAC WINDING.

SIZE		ISSUE 10-31-32	A.E.
KIND		CHANGED	
SHAPE		" "	
FINISH		" "	
TEMP.		" "	
PATT.		" "	

TITLE: C. D. S. TRANSFORMER

OBSOLETE

H. G. FISCHER & CO.
2335 WABANSIA AVE.
CHICAGO, ILL.

CAT. NO.

PART NO. 600G

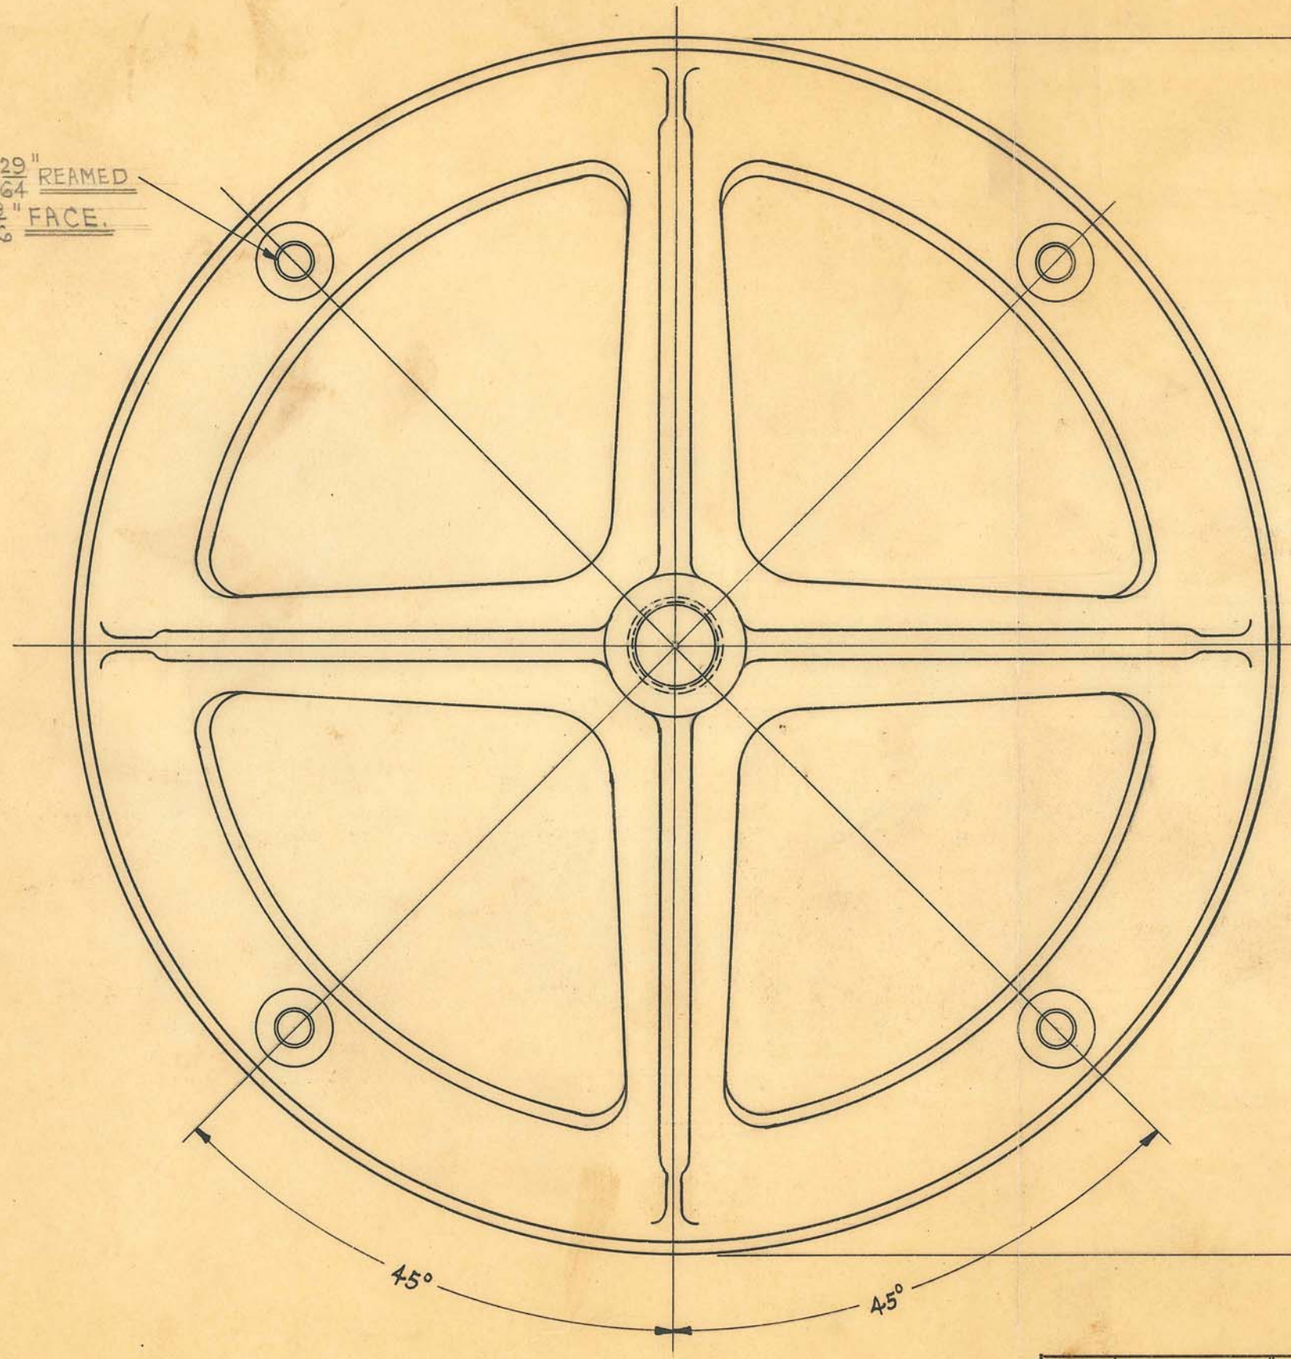

SCALE ~ 1/2 SIZE

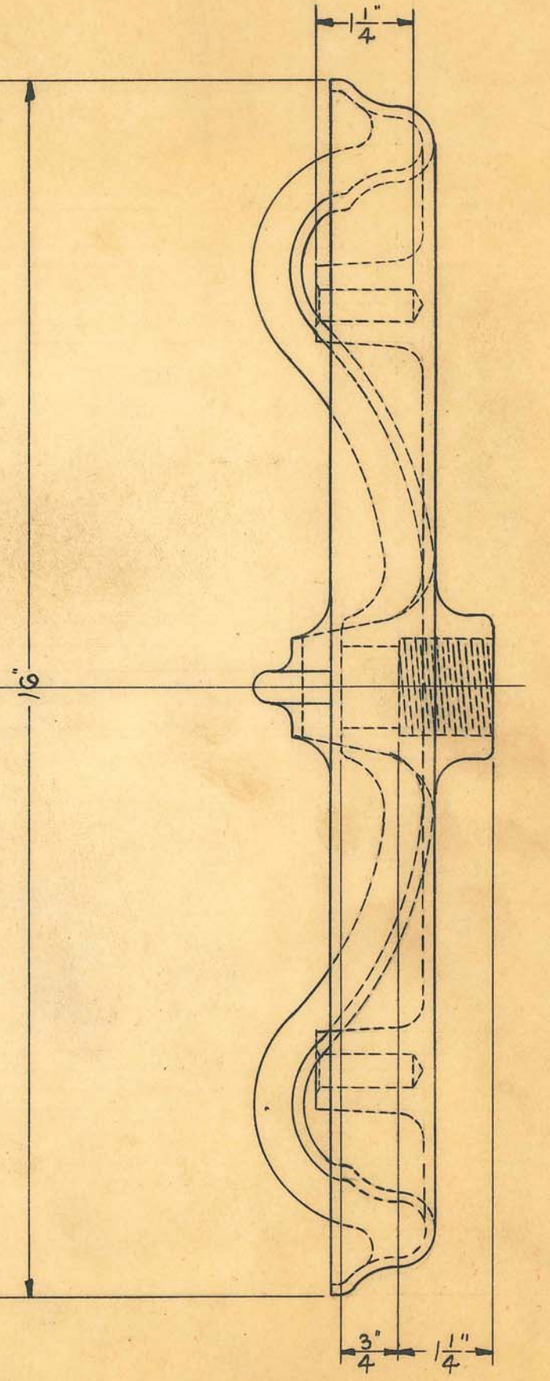

SIZE		ISSUE H.E.	5-2-30	
KIND	IRON CASTING	CHANGED		
SHAPE		" "		
FINISH		" "		
TEMP.		" "		
PATT.		" "		

TITLE: PHYSICIANS MODEL ARC-LAMP BASE (FINISHED)

OBSOLETE

H. G. FISCHER & CO.
2335 WABANSIA AVE.
CHICAGO, ILL.

CAT. NO.

PART NO. 5821F

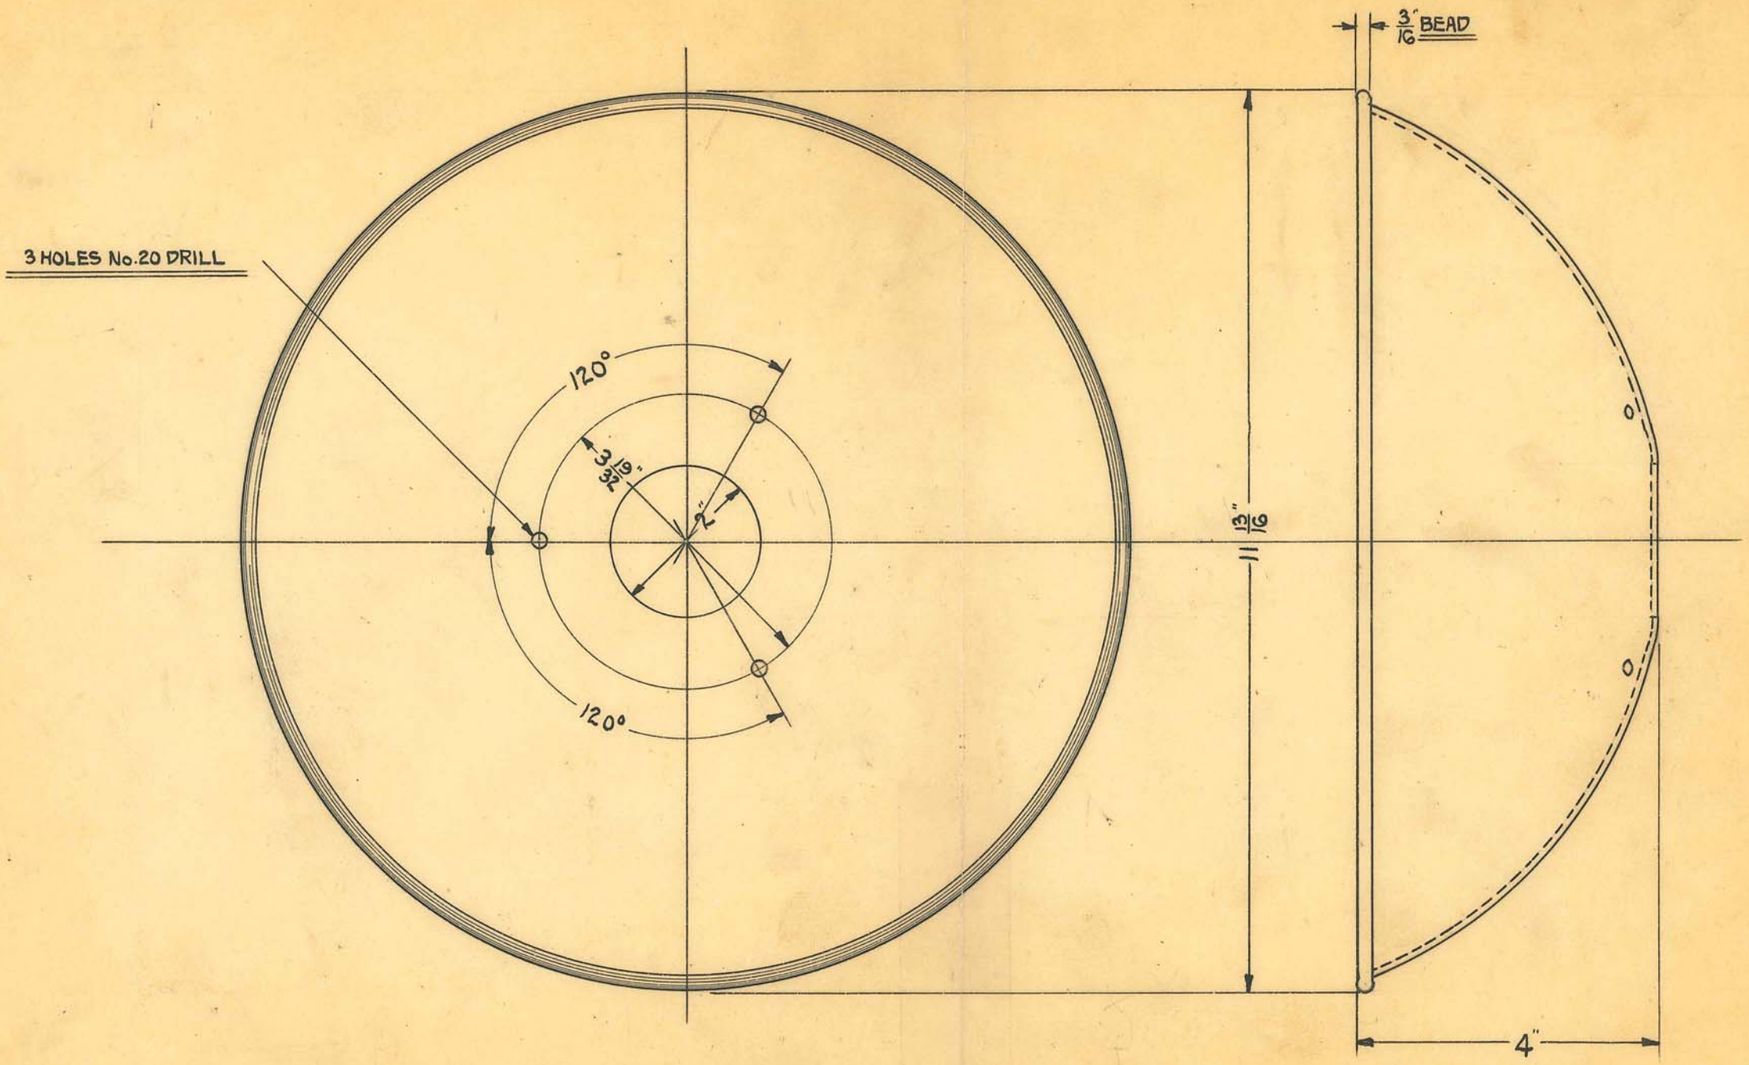

SCALE ~ 1/2 SIZE

BOUGHT OUTSIDE

OBSOLETE

SIZE		ISSUE	11-6-29
KIND		CHANGED	
SHAPE		" "	
FINISH	POL. INSIDE & OUT	" "	
TEMP.		" "	
PATT.		" "	

TITLE: LAYMAN'S INFRA RED RAY GENERATOR HOOD

H. G. FISCHER & CO.
2335 WABANSIA AVE.
CHICAGO, ILL.

CAT. NO.

PART NO. 5779F

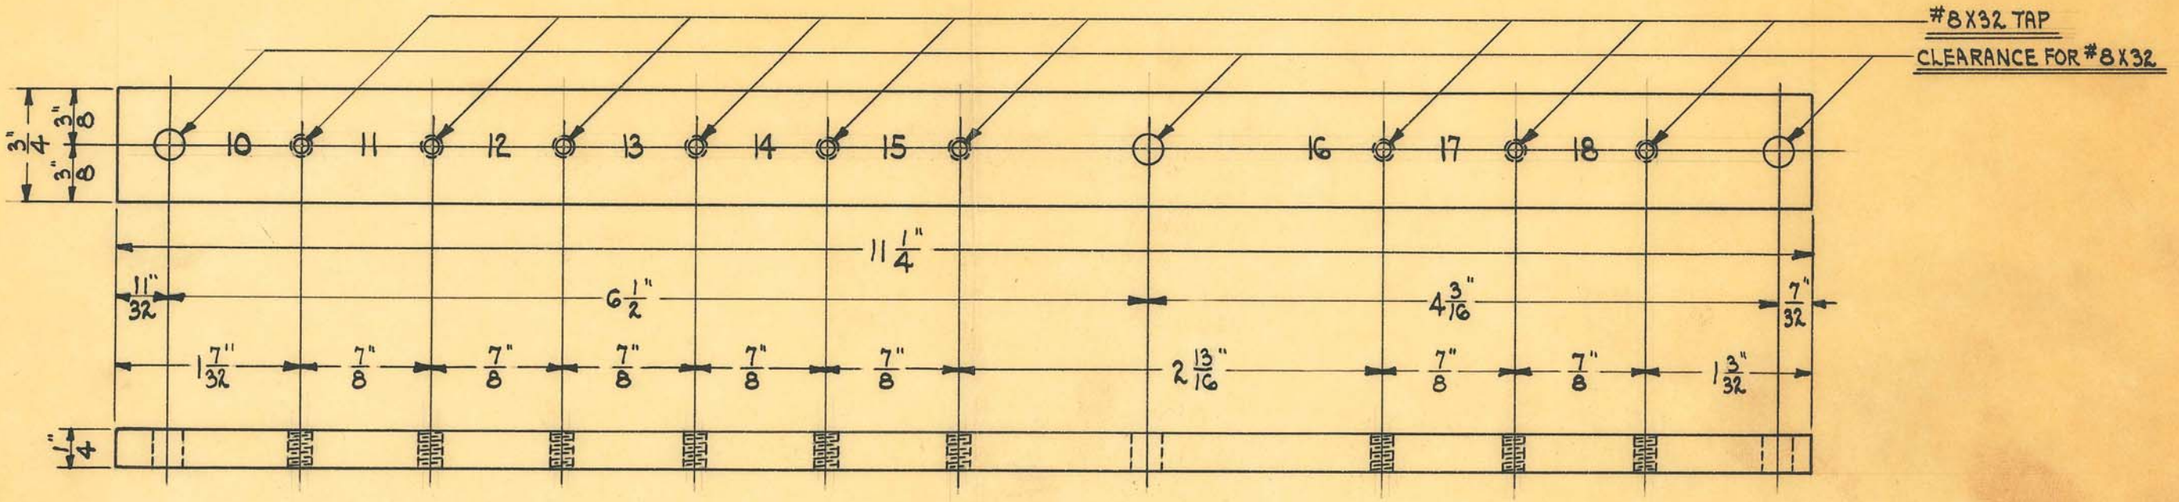

DRILL JIG #4533

OBSOLETE

SIZE	1/4"x3/4"x11/4"	ISSUE 10-16-30	W.E.
KIND	BAKELITE	CHANGED	
SHAPE	STRIP	" "	
FINISH		" "	
TEMP.		" "	
PATT.		" "	

TITLE: WAVE GEN. FRONT CONNECTION BOARD

H. G. FISCHER & CO.
2335 WABANSIA AVE.
CHICAGO, ILL.

CAT. NO.

PART NO. 5635
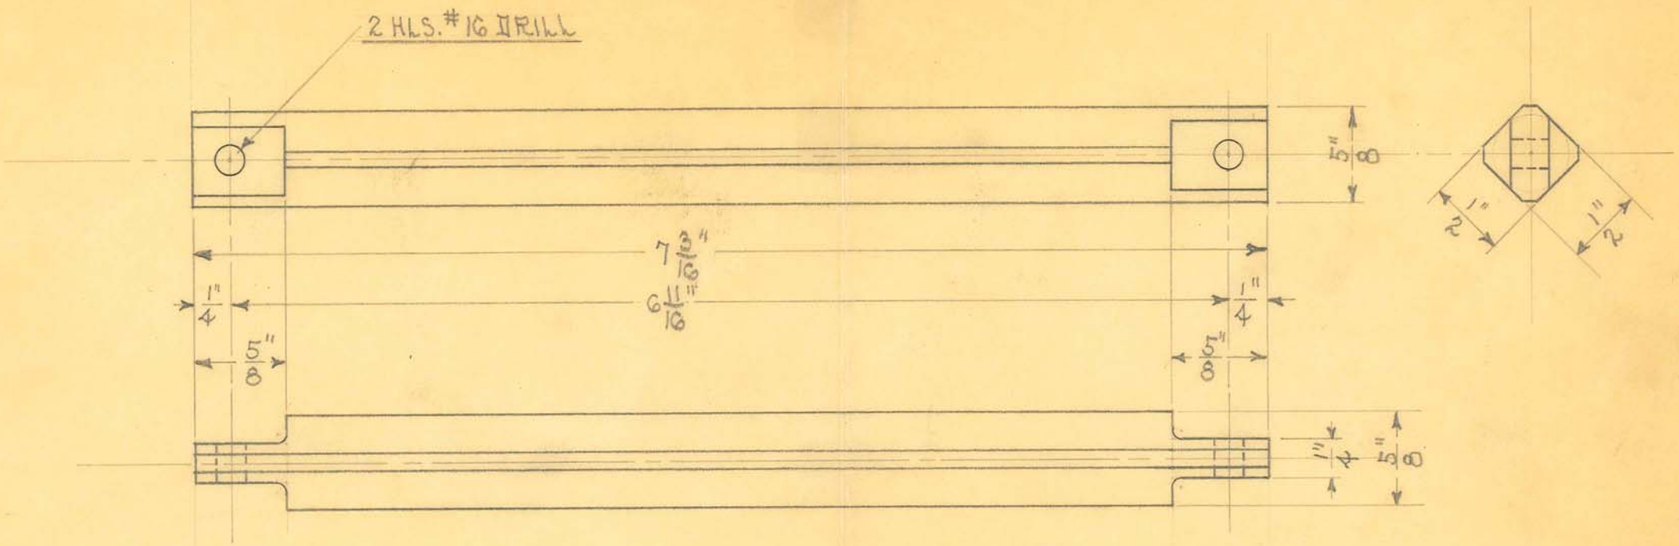
SCALE ~ FULL SIZE

OBSOLETE

SIZE		ISSUE 1-16-32	J.E.	TITLE: MODEL "M" LAMP ISOLANTITE ROD
KIND	ISOLANTITE	CHANGED		
SHAPE		" "		
FINISH		" "		
TEMP.		" "		H. G. FISCHER & CO. 2335 WABANSIA AVE. CHICAGO, ILL. — CAT. NO. — PART NO. 5713A
PATT.		" "		

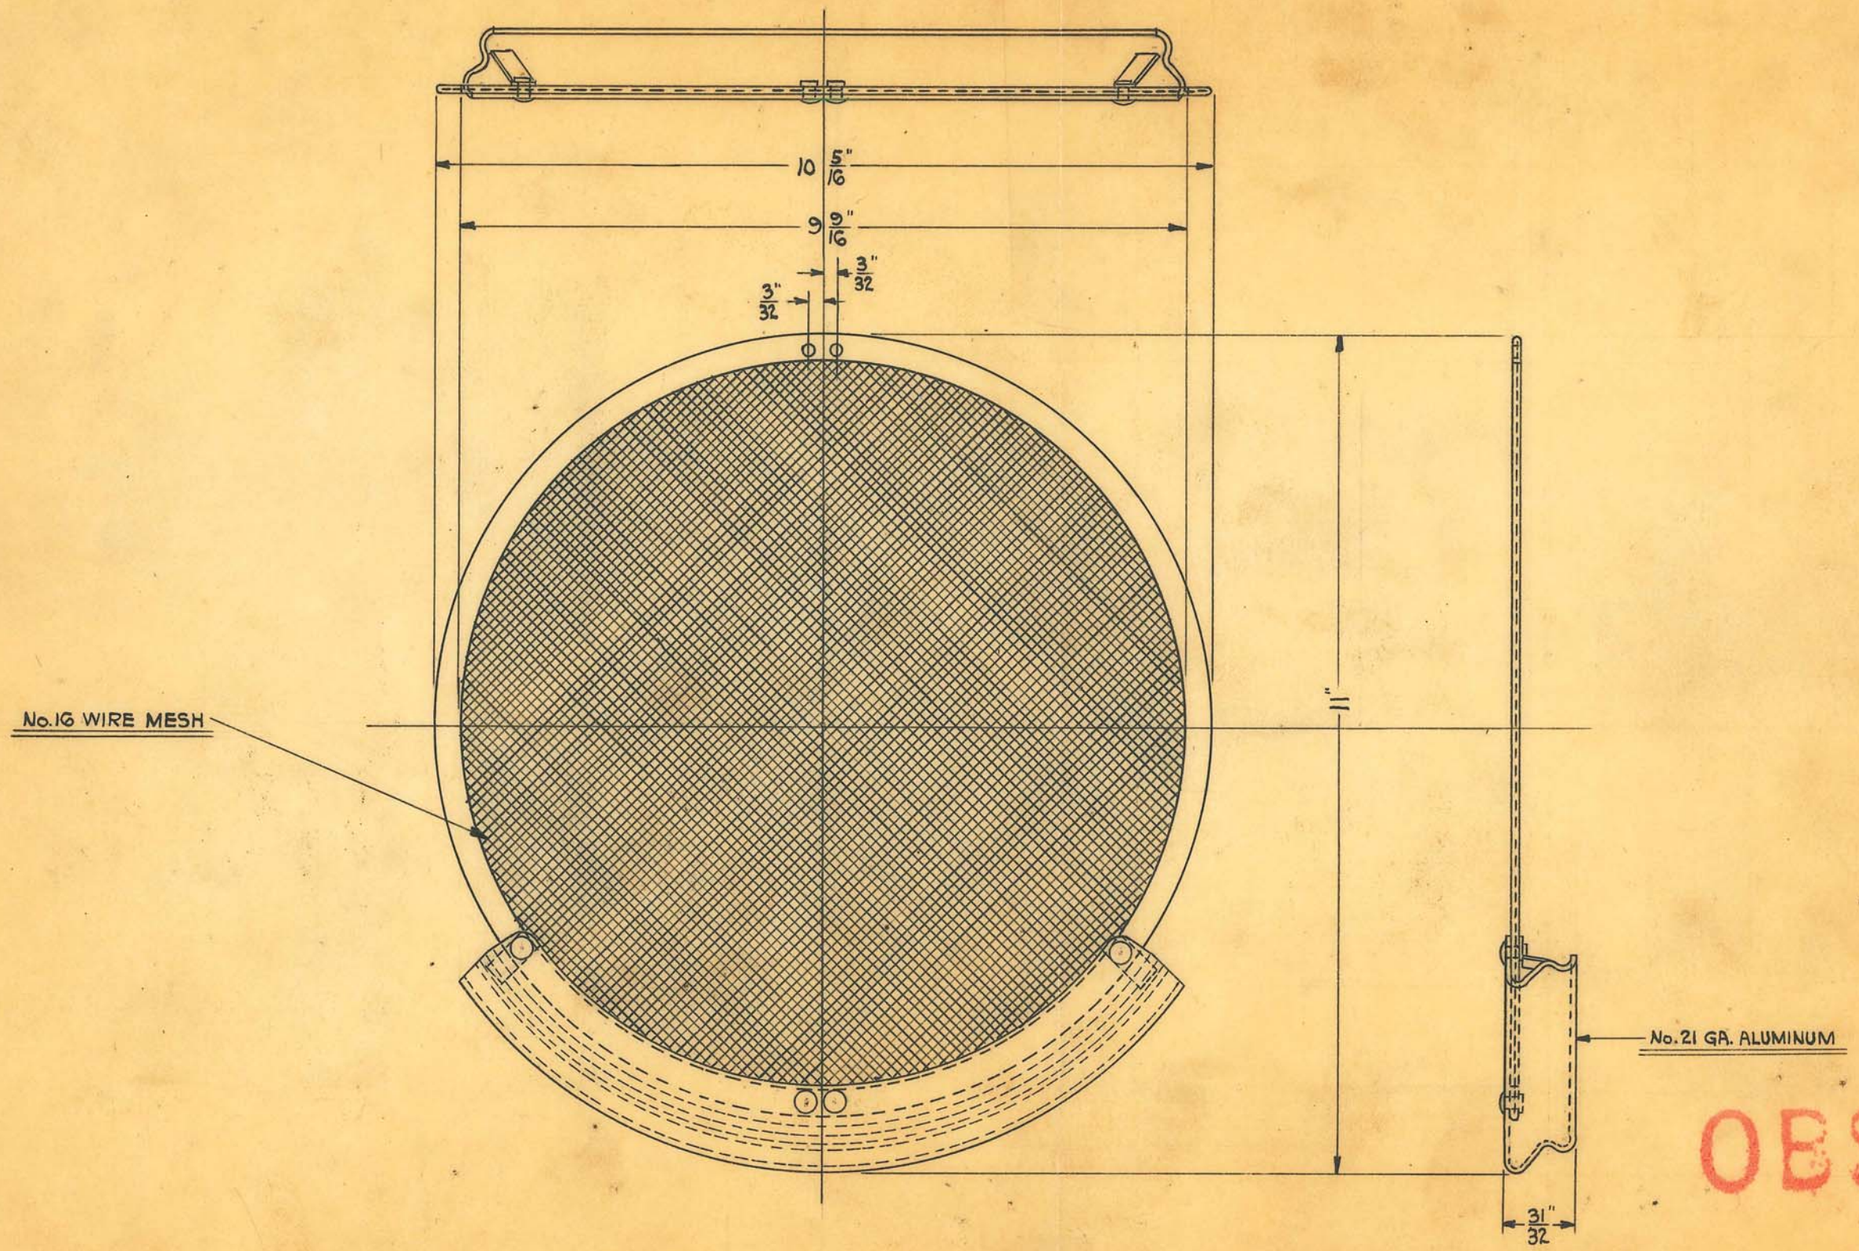

OBSOLETE

SCALE ~ 1/2 SIZE

BOUGHT OUTSIDE

SIZE		ISSUE	10-30-29
KIND		CHANGED	
SHAPE		" "	
FINISH		" "	
TEMP.		" "	
PATT.		" "	

TITLE: MODEL #9 & #10 CARBON ARC LAMP SCREEN

H. G. FISCHER & CO.
2335 WABANSIA AVE.
CHICAGO, ILL.

CAT. NO.

PART NO. 4760F

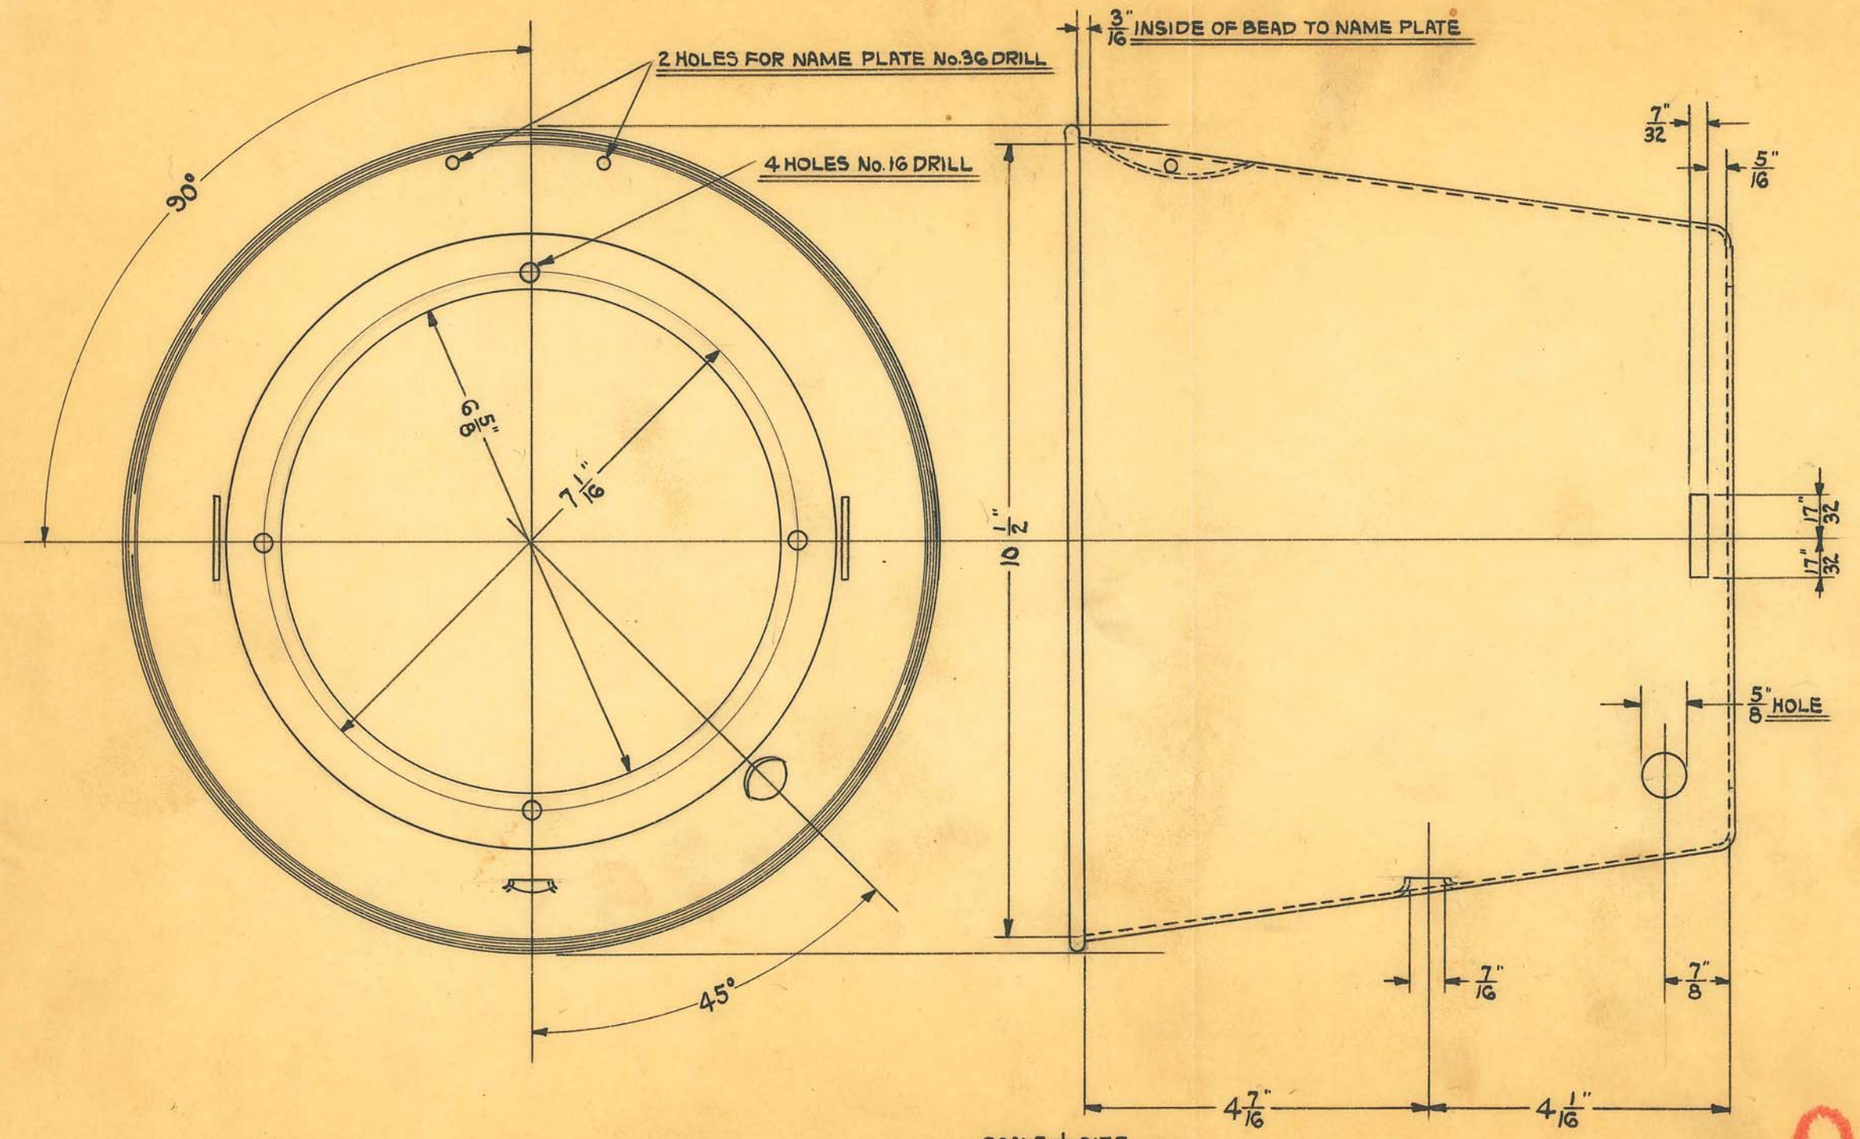

SCALE: 1/2 SIZE

BOUGHT OUTSIDE

OBSOLETE

SIZE		ISSUE	10-26-29
KIND		CHANGED	
SHAPE		" "	
FINISH		" "	
TEMP.		" "	
PATT.		" "	

TITLE: MODEL #9 & #10 CARBON ARC LAMP HOOD

H. G. FISCHER & CO.
2335 WABANSIA AVE.
CHICAGO, ILL.

CAT. NO.

PART NO. 4738

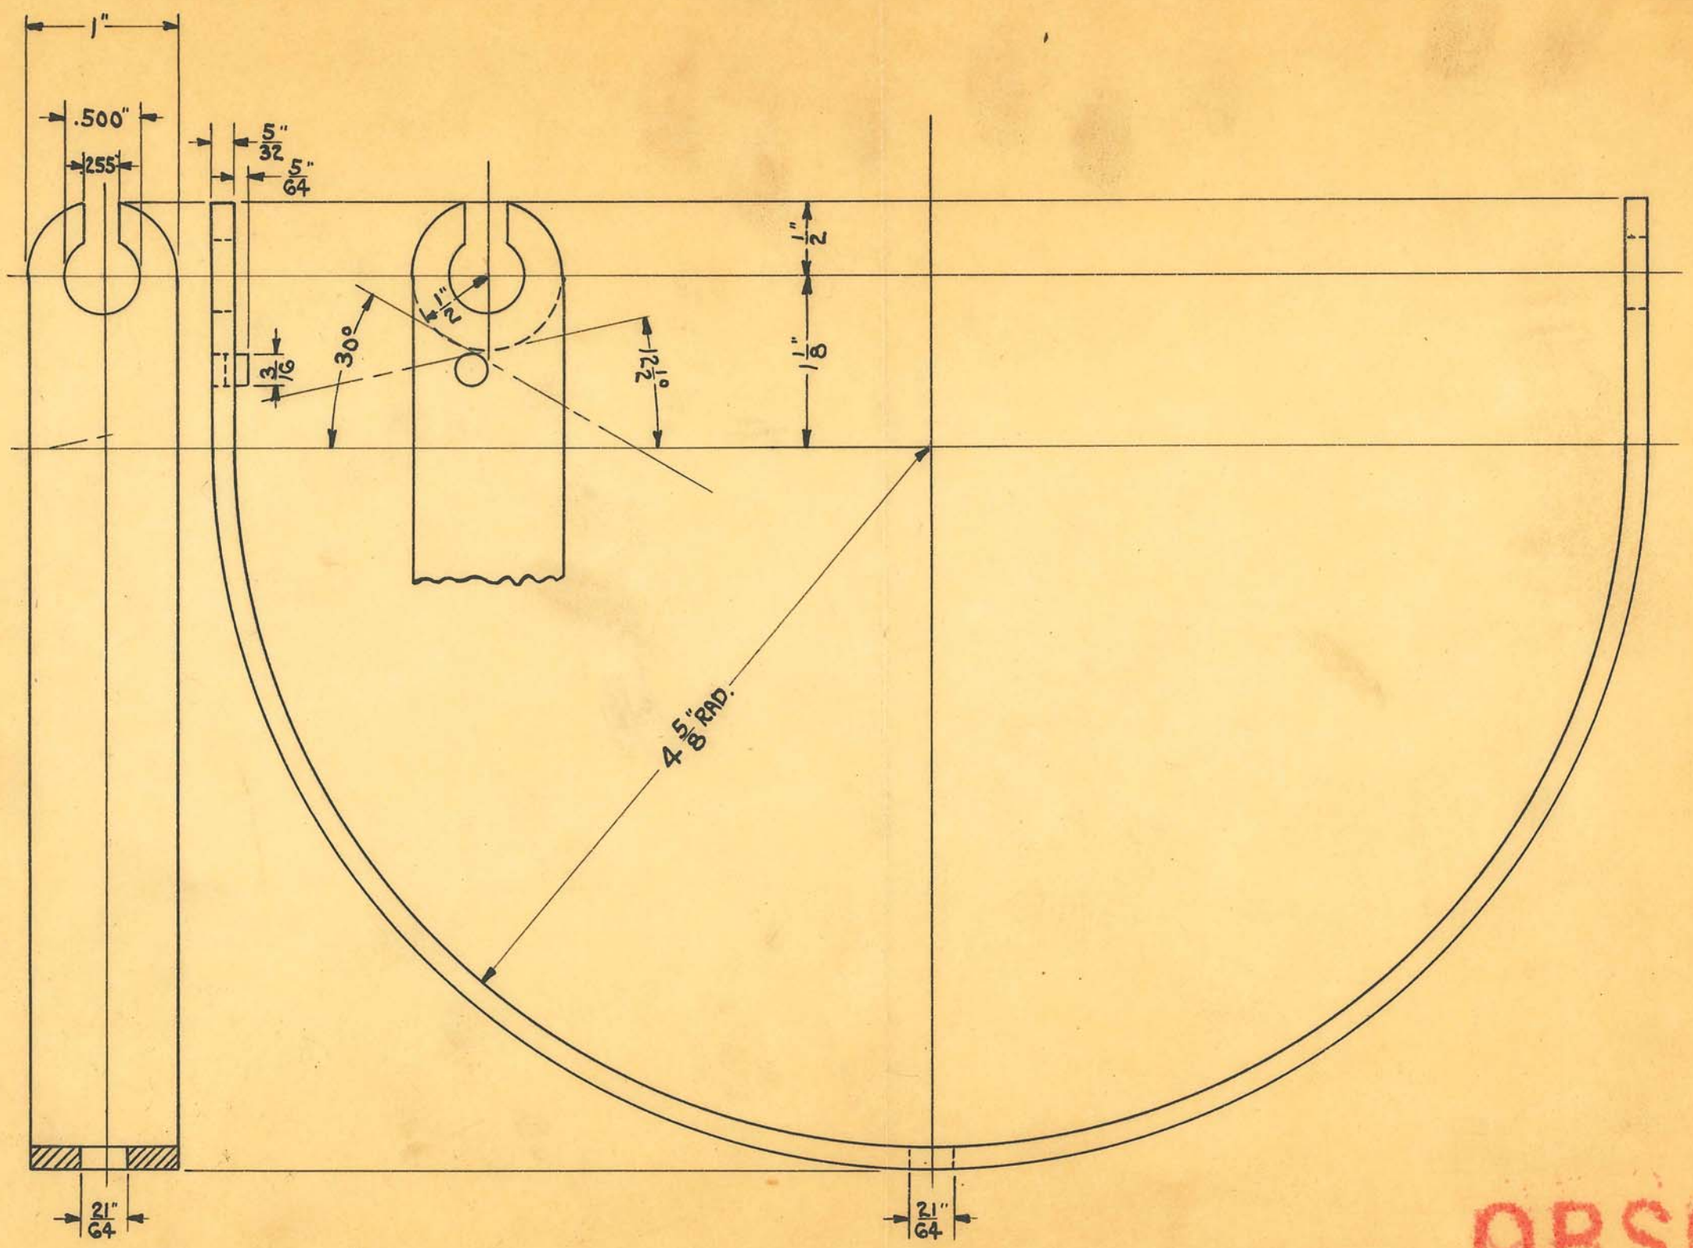

OBSOLETE

SIZE	1" X 5/32"	ISSUE	10-14-29
KIND	BAND IRON	CHANGED	
SHAPE		" "	
FINISH		" "	
TEMP.		" "	
PATT.		" "	

TITLE: MODEL #9 & #10 CARBON ARC LAMP
HOOD FORK

H. G. FISCHER & CO.
2335 WABANSIA AVE.
CHICAGO, ILL.

CAT. NO.

PART NO. 4732

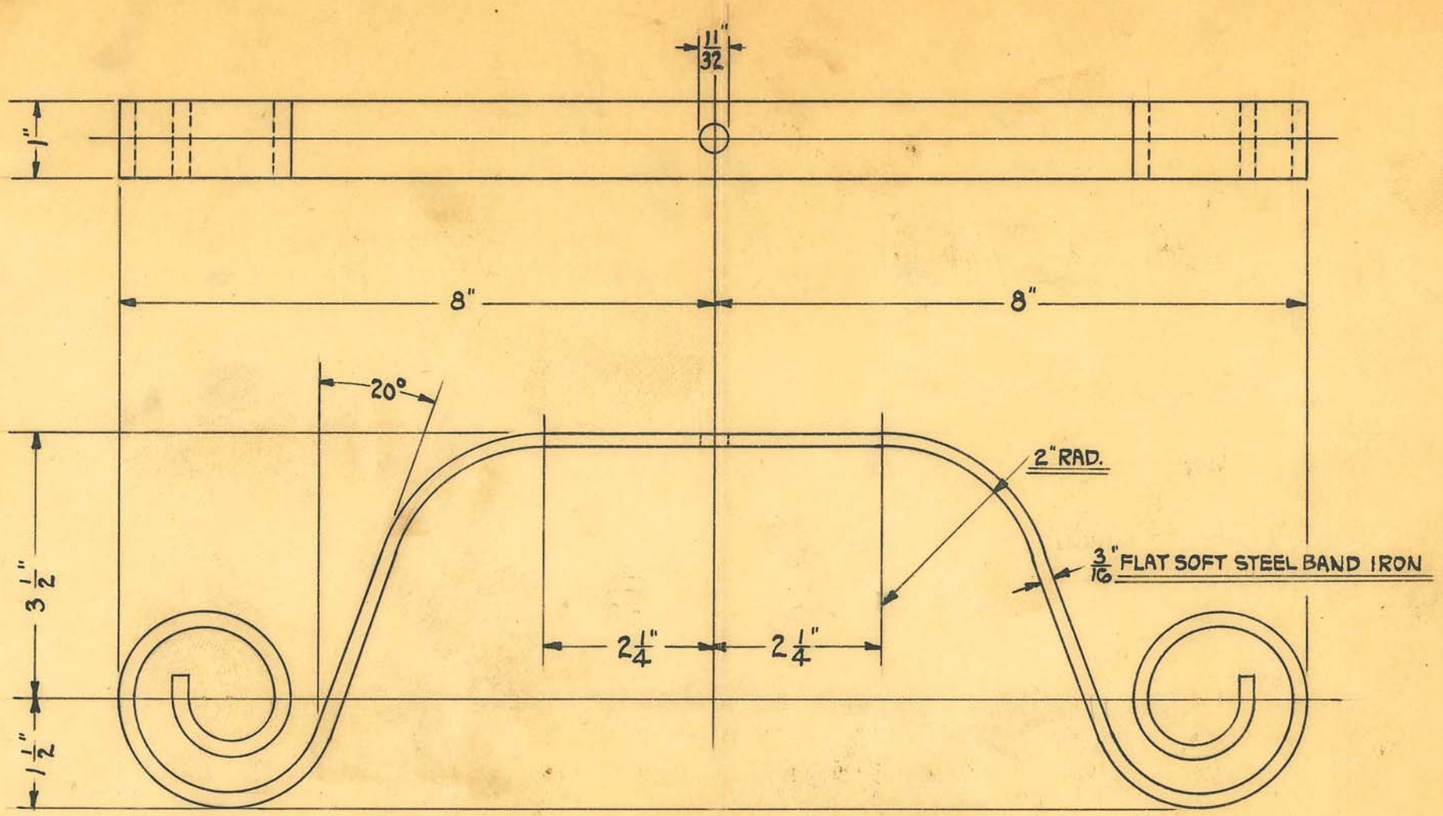

SCALE ~ 1/2 SIZE

BOUGHT OUTSIDE

OBSOLETE

SIZE	3/16" X 1"	ISSUE	10-26-29
KIND	F.S. BAND IRON	CHANGED	
SHAPE	FLAT	" "	
FINISH		" "	
TEMP.		" "	
PATT.		" "	

TITLE: MODEL #10 CARBON ARC LAMP
BASE SCROLL (BOTTOM)

H. G. FISCHER & CO.
2335 WABANSIA AVE.
CHICAGO, ILL.

CAT. NO.

PART NO. 4731

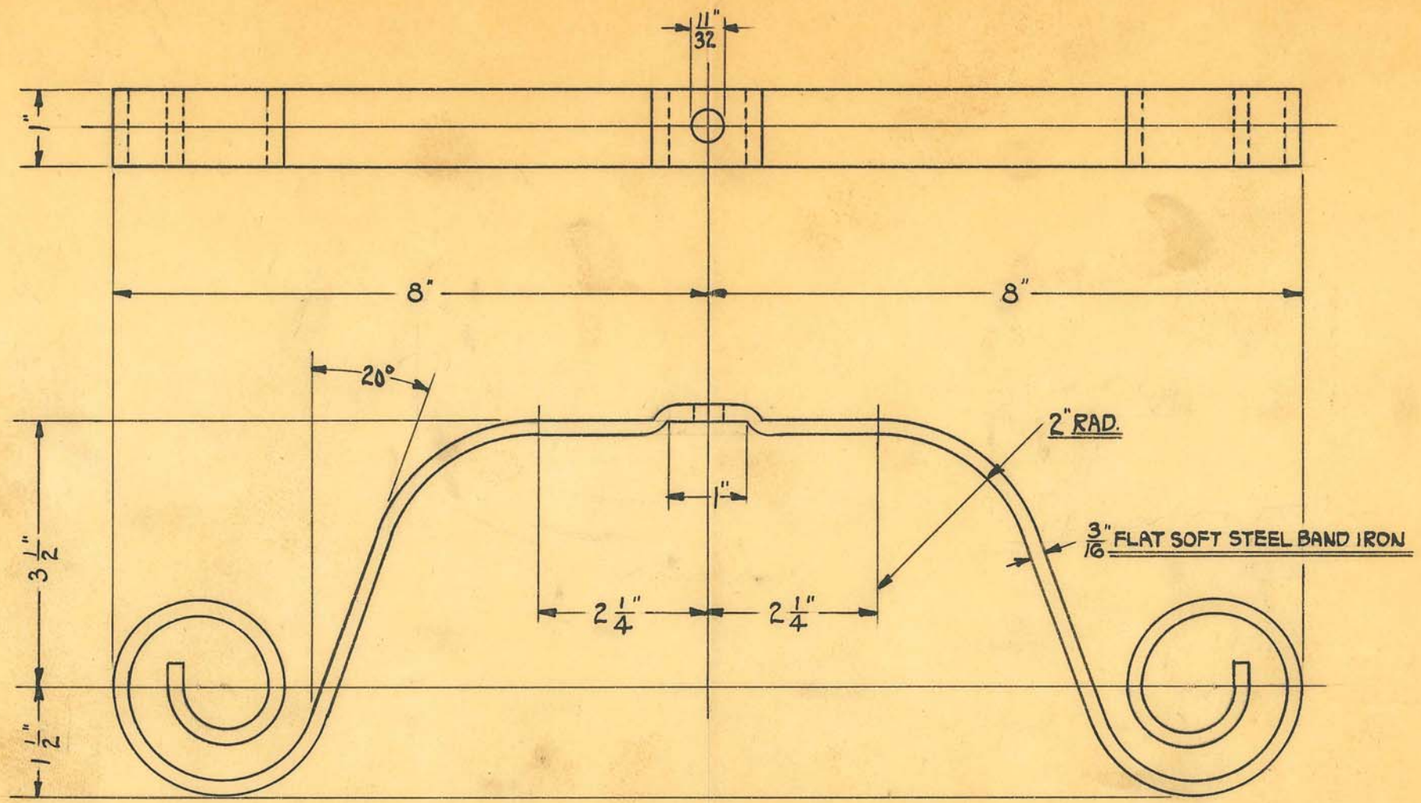

SCALE ~ 1/2 SIZE

BOUGHT OUTSIDE

OBSOLETE

SIZE	3/16" X 1"	ISSUE	10-26-29
KIND	F.S. BAND IRON	CHANGED	
SHAPE	FLAT	" "	
FINISH		" "	
TEMP.		" "	
PATT.		" "	

TITLE: MODEL #10 CARBON ARC LAMP
BASE SCROLL (TOP)

H. G. FISCHER & CO.
2335 WABANSIA AVE.
CHICAGO, ILL.

CAT. NO.

PART NO. 4730

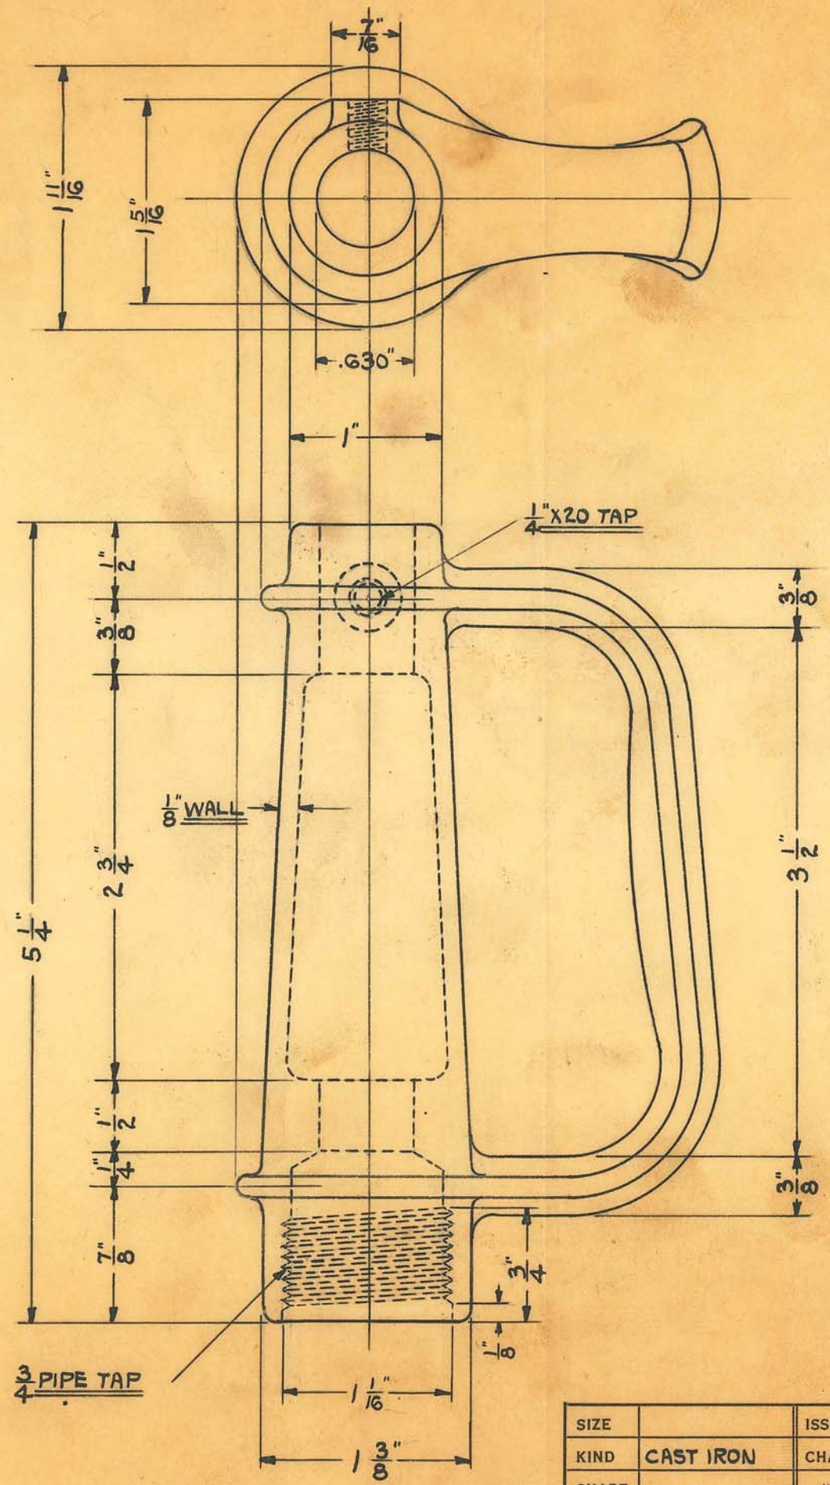

OBSOLETE

SIZE		ISSUE	10-19-29
KIND	CAST IRON	CHANGED	
SHAPE		" "	
FINISH		" "	
TEMP.		" "	
PATT.	No. 453	" "	

TITLE: MODEL No. 10 CARBON ARC LAMP HANDLE

H. G. FISCHER & CO.
2335 WABANSIA AVE.
CHICAGO, ILL.

CAT. NO.

PART NO. 4723F

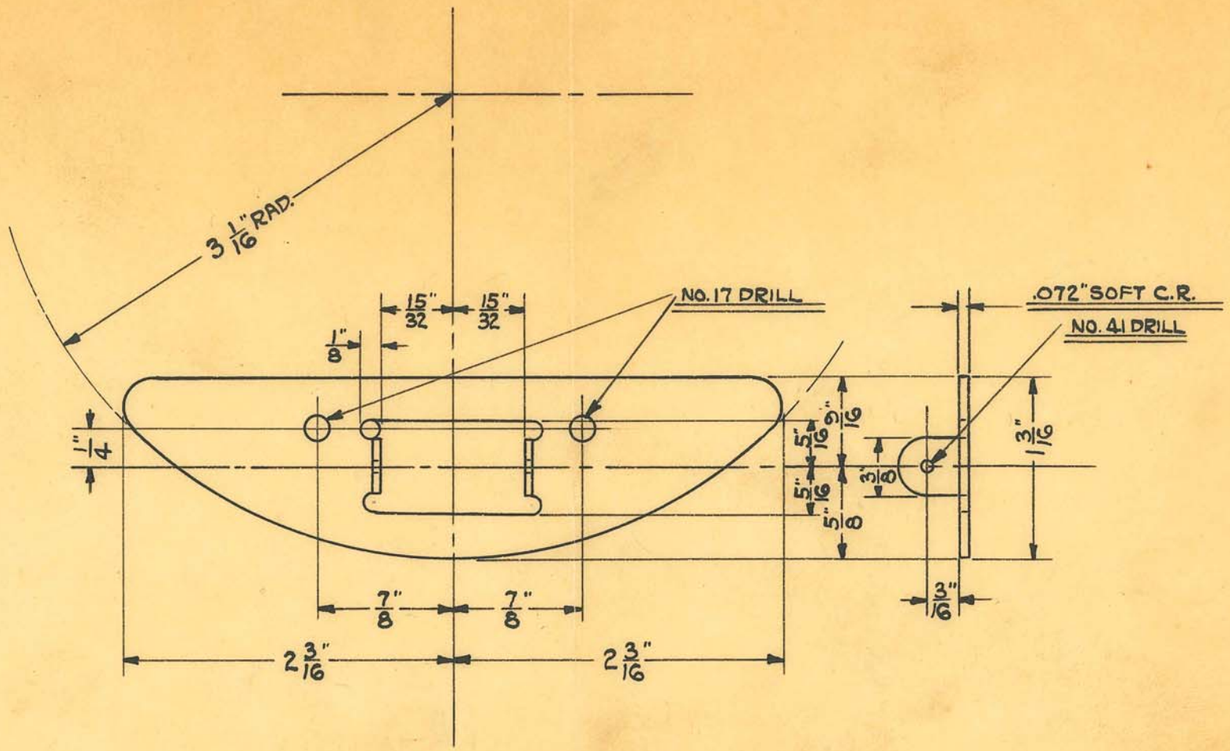

BLANKING DIE # 2881
FORMING DIE # 2882

OBSOLETE

SIZE	.072" X 1 1/2"	ISSUE	10-14-29
KIND	D.S.C.R. STRIP STEEL	CHANGED	
SHAPE	STRIP	" "	
FINISH	W.P.	" "	
TEMP.		" "	
PATT.		" "	

TITLE: MODEL #9 & #10 CARBON ARC LAMP
COUNTERWEIGHT LEVER LOWER SUPPORT

H. G. FISCHER & CO.
2335 WABANSIA AVE.
CHICAGO, ILL.

CAT. NO.

PART NO. 4708

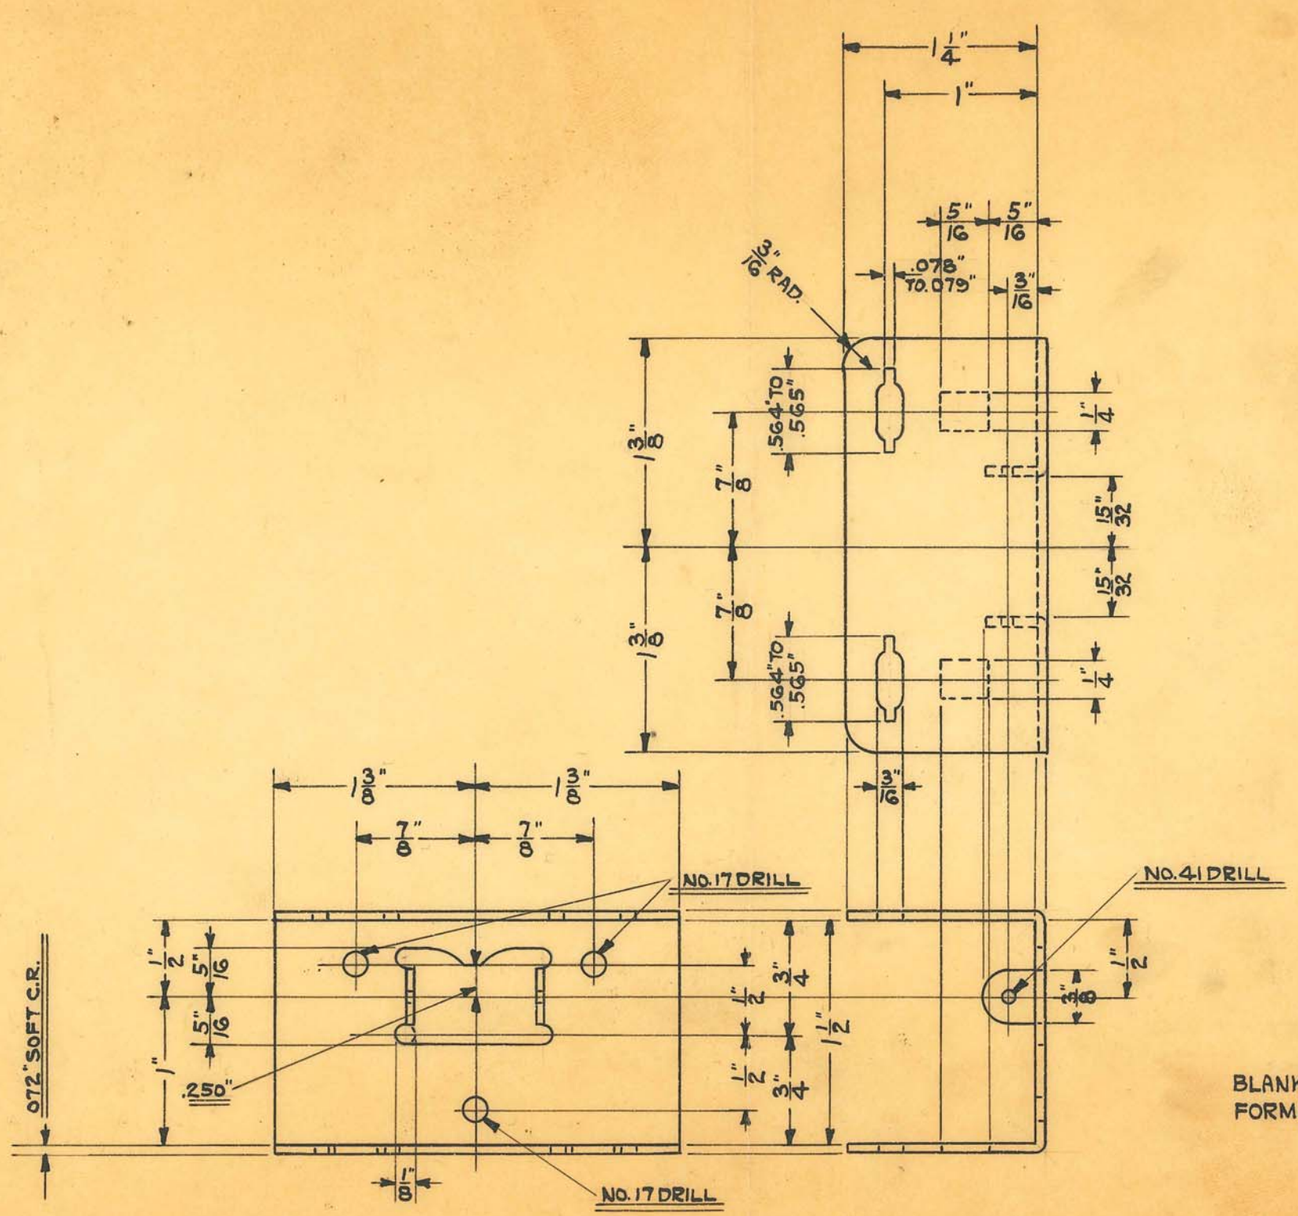

BLANKING DIE No. X1068
FORMING DIE No. X1069

OBSOLETE

SIZE	.072" X 4 5/16"	ISSUE	10-14-29
KIND	D.S.C.R. STEEL	CHANGED	
SHAPE	STRIP	" "	
FINISH	W.P.	" "	
TEMP.		" "	
PATT.		" "	

TITLE: MODEL #9 & #10 CARBON ARC LAMP
MAIN SUPPORT FRAME

H. G. FISCHER & CO.
2335 WABANSIA AVE.
CHICAGO, ILL.

CAT. NO.

PART NO. 4704

OBSOLETE

SOURCE:
DUNLEE CORP. NO. DL-5

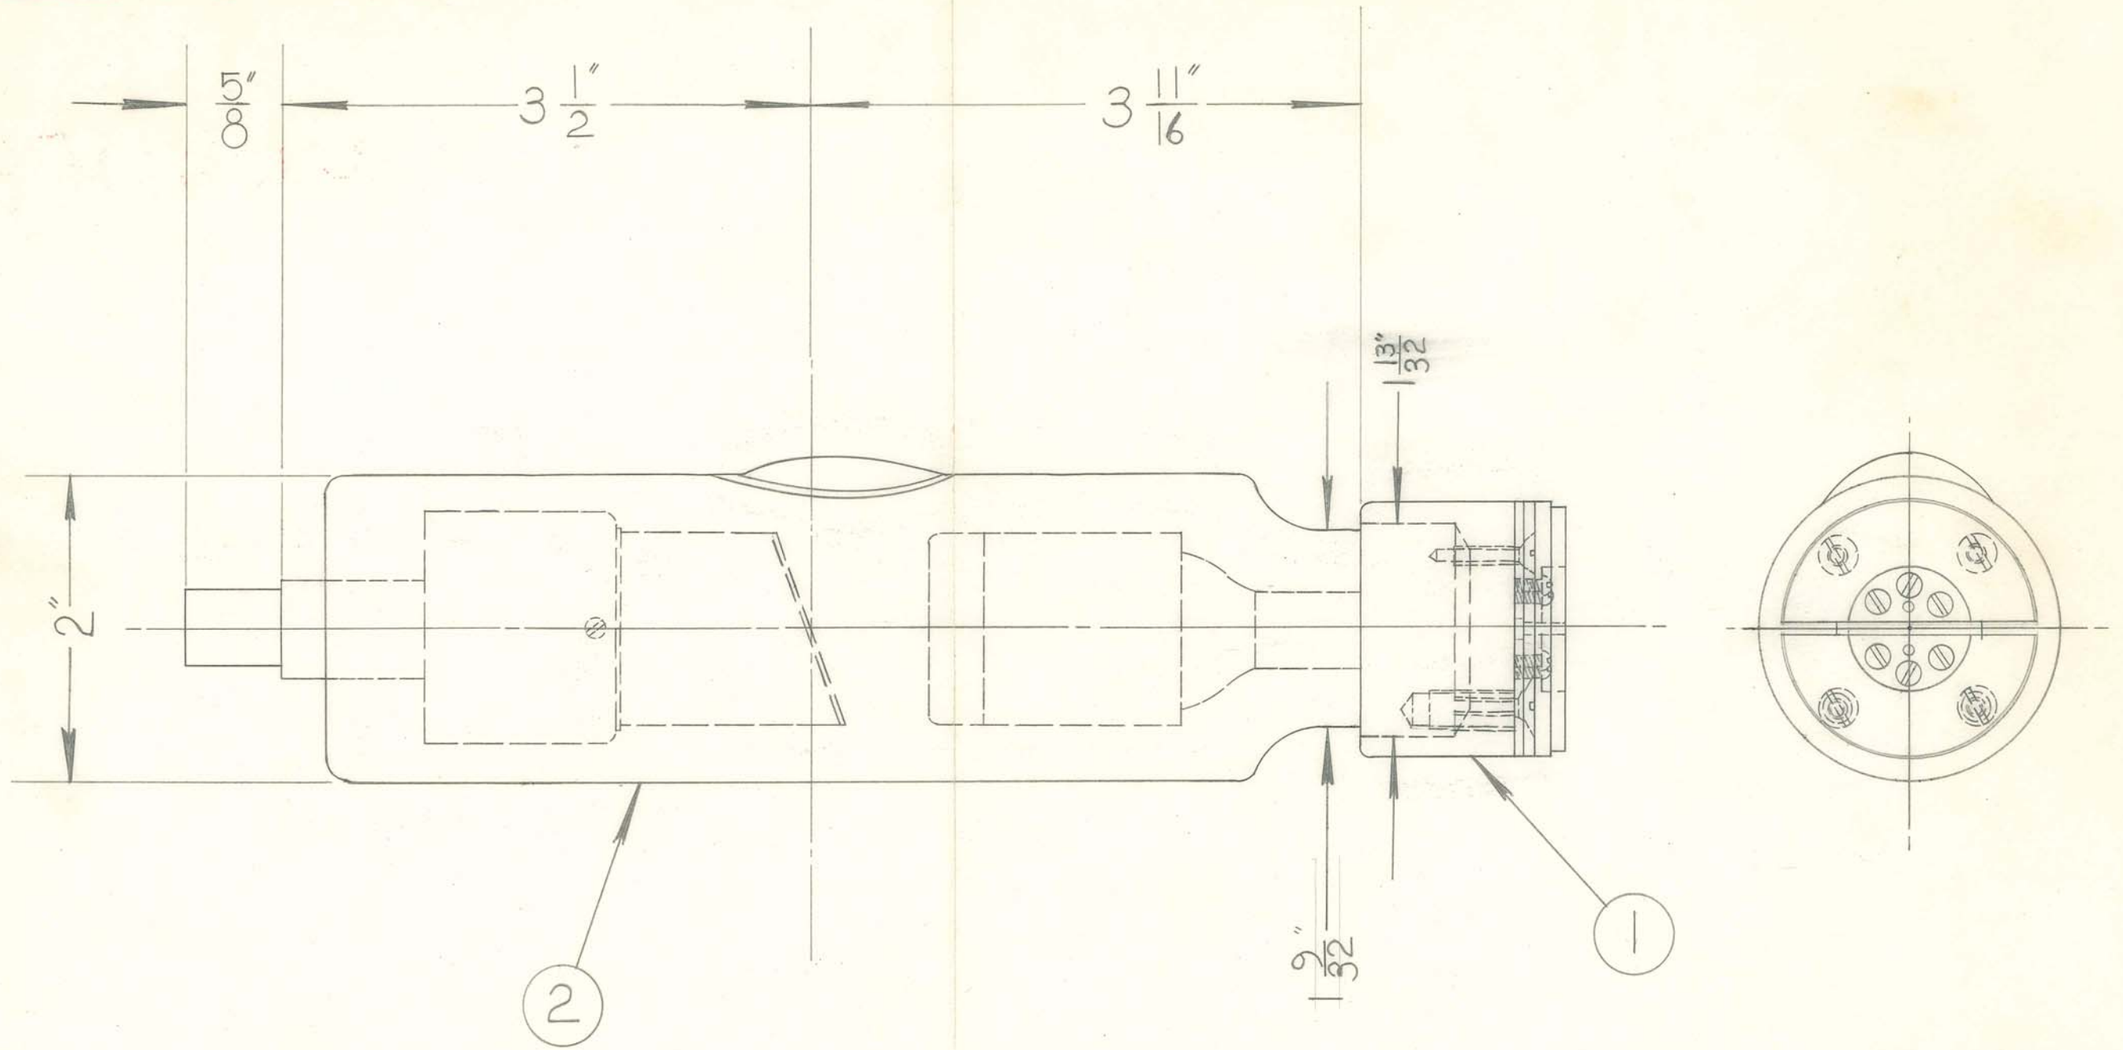

O. S.	1	2.	X-RAY TUBE	9648
P. S	1	1.	X-RAY TUBE CAP ASSEM.	9583GB
DEPT.	AMT.	NO.	NAME	PART NO.

H. G. FISCHER & CO.
FRANKLIN PARK, ILLINOIS

PART NO. 9617G

REVISION	DATE	BY

DATE 9.17.63 | DR BY D.A.K. | CH'K'D.

DIMENSIONS UNLESS OTHERWISE SPECIFIED
FRACTIONAL ±.015
DECIMAL ±.005
ANGULAR ±½°

SCALE FULL

TITLE FISCHER TUBE & CAP ASSEM.
FOR DSP-20 & SPDX.

PATTERN | FINISH | MATERIAL | TOOLS

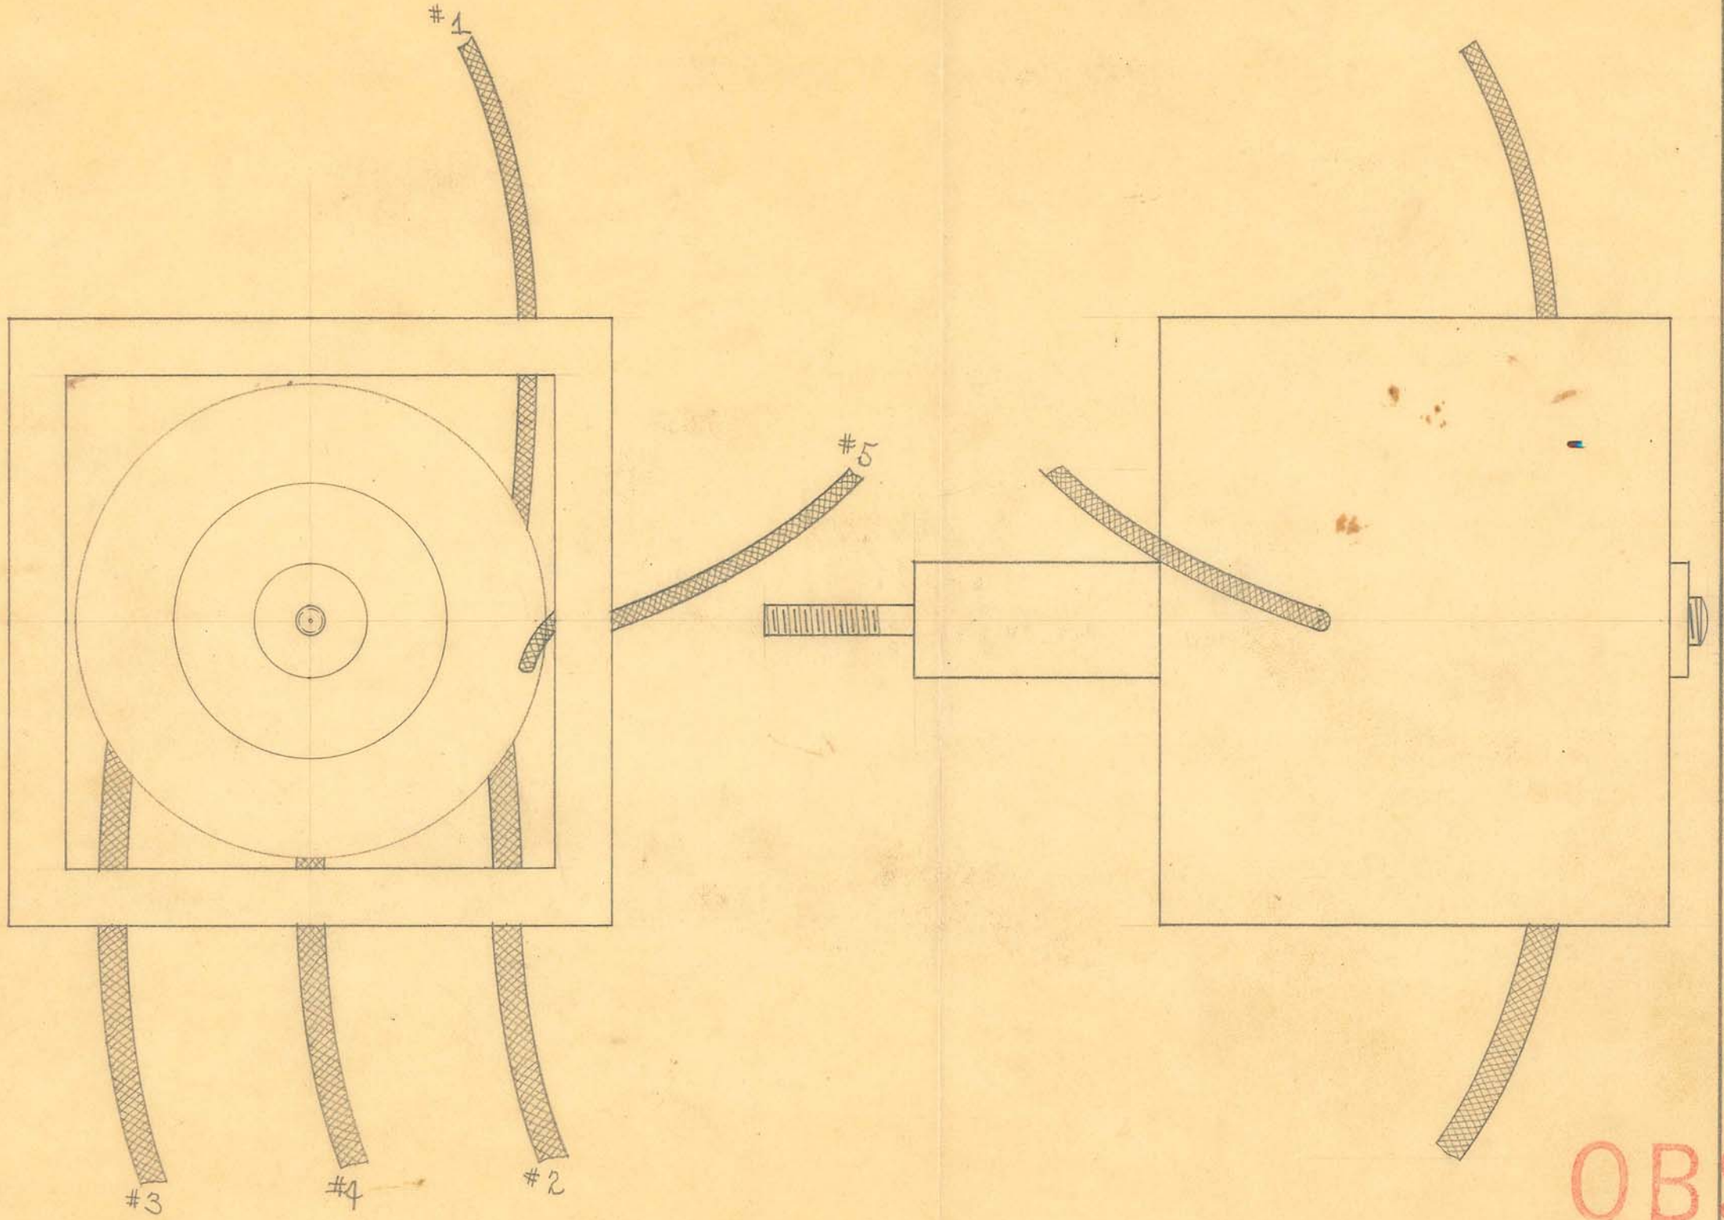

WINDING DATA

USE #28 E. WIRE. FASTEN START TO POLE & WIND 20 TURNS ON POLE, 8 LAYERS OF 500G PAPER, 4 TURNS OF WIRE, 8 LAYERS OF PAPER, 4 TURNS
" " , " " " " , " "
" " , " " " " , " "
" " , " " " " , " "
" " , " " " " , 8 "
" ". CUT WIRE & FINISH WITH 8 LAYERS OF PAPER. TOTAL 96 T. WIRE. IN WINDING 8L. PAPER YOU ALSO WIND 8 T. WIRE. COIL MUST NOW BE WAXED & RESIN DIPPED AROUND POST TO KEEP FROM SLIPPING.

USE #22 C.E. WIRE. SPLICE END OF #28 E. TO START OF #22 C.E. & BRING OUT TAP #1 - #18 STRANDED WIRE. WIND 22 TURNS. CUT WIRE & PUT ON 8 LAYERS OF PAPER. SOLDER END OF #22 C.E. TO START OF 5052 COPPER RIBBON & BRING OUT TAP #2 - CAUTERY WIRE. WIND 1½ TURNS OF RIBBON & BRING OUT TAP # 3 - CAUTERY WIRE. WIND 2⅝" TURNS OF RIBBON & END WITH TAP #4 - CAUTERY WIRE. SOLDER CHARGE WIRE TO RIBBON END & PUT ON 8 LAYERS OF PAPER.

USE #22 E. WIRE. CONNECT START OF #22 E. TO CHARGE WIRE & WIND 22 TURNS & END WITH #18 STRANDED LEAD #5. FINISH WITH 8 LAYERS OF PAPER.

OBSOLETE

SIZE		ISSUE 5-26-32	A.E.	TITLE: ALOE "K" TESLA COIL
KIND		CHANGED		
SHAPE		" "		
FINISH		" "		
TEMP.		" "		H. G. FISCHER & CO. 2335 WABANSIA AVE. CHICAGO, ILL. — CAT. NO. — PART NO. 988G
PATT.		" "		

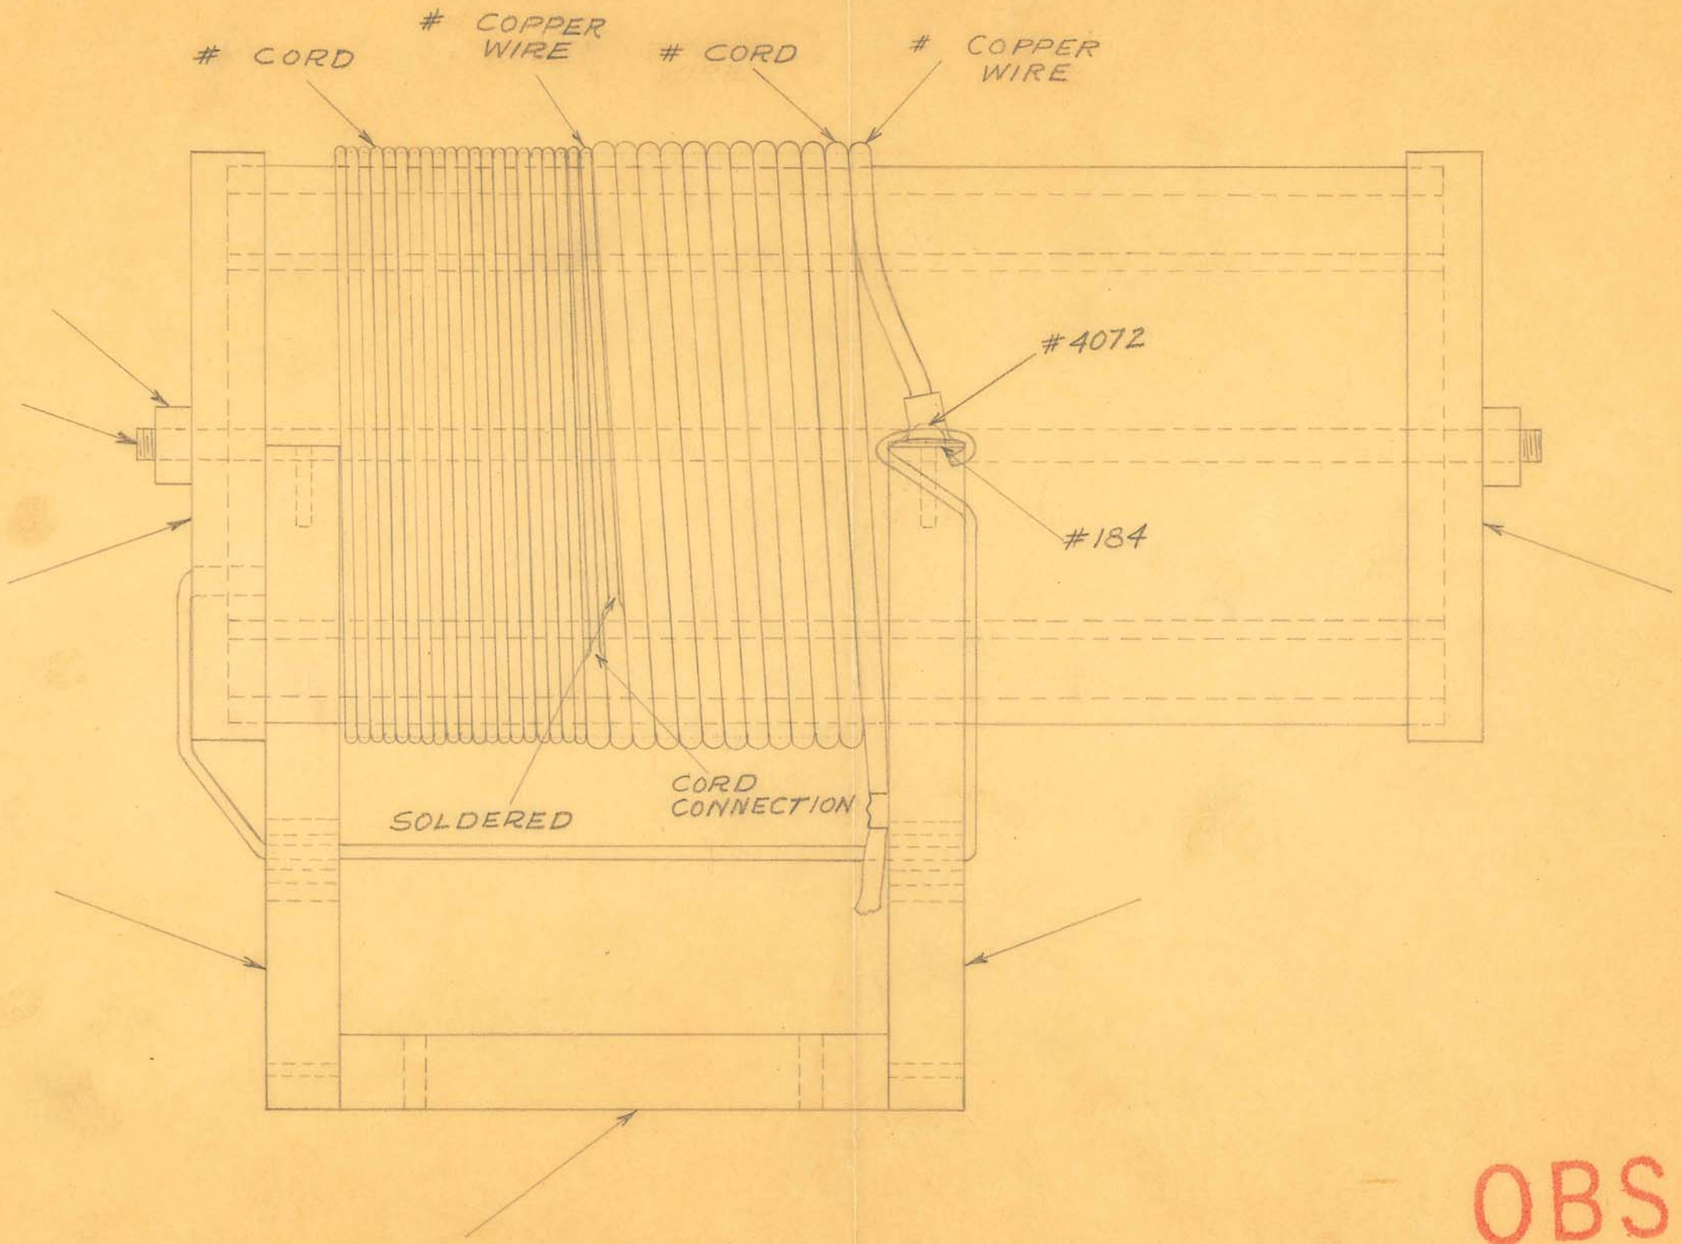

OBSOLETE

SIZE		ISSUE	
KIND		CHANGED	
SHAPE		" "	
FINISH		" "	
TEMP.		" "	
PATT.		" "	

TITLE:

TYPE "G"
TESLA COIL

H. G. FISCHER & CO.
2335 WABANSIA AVE.
CHICAGO, ILL.

CAT. NO.

PART NO. 3359G

33596

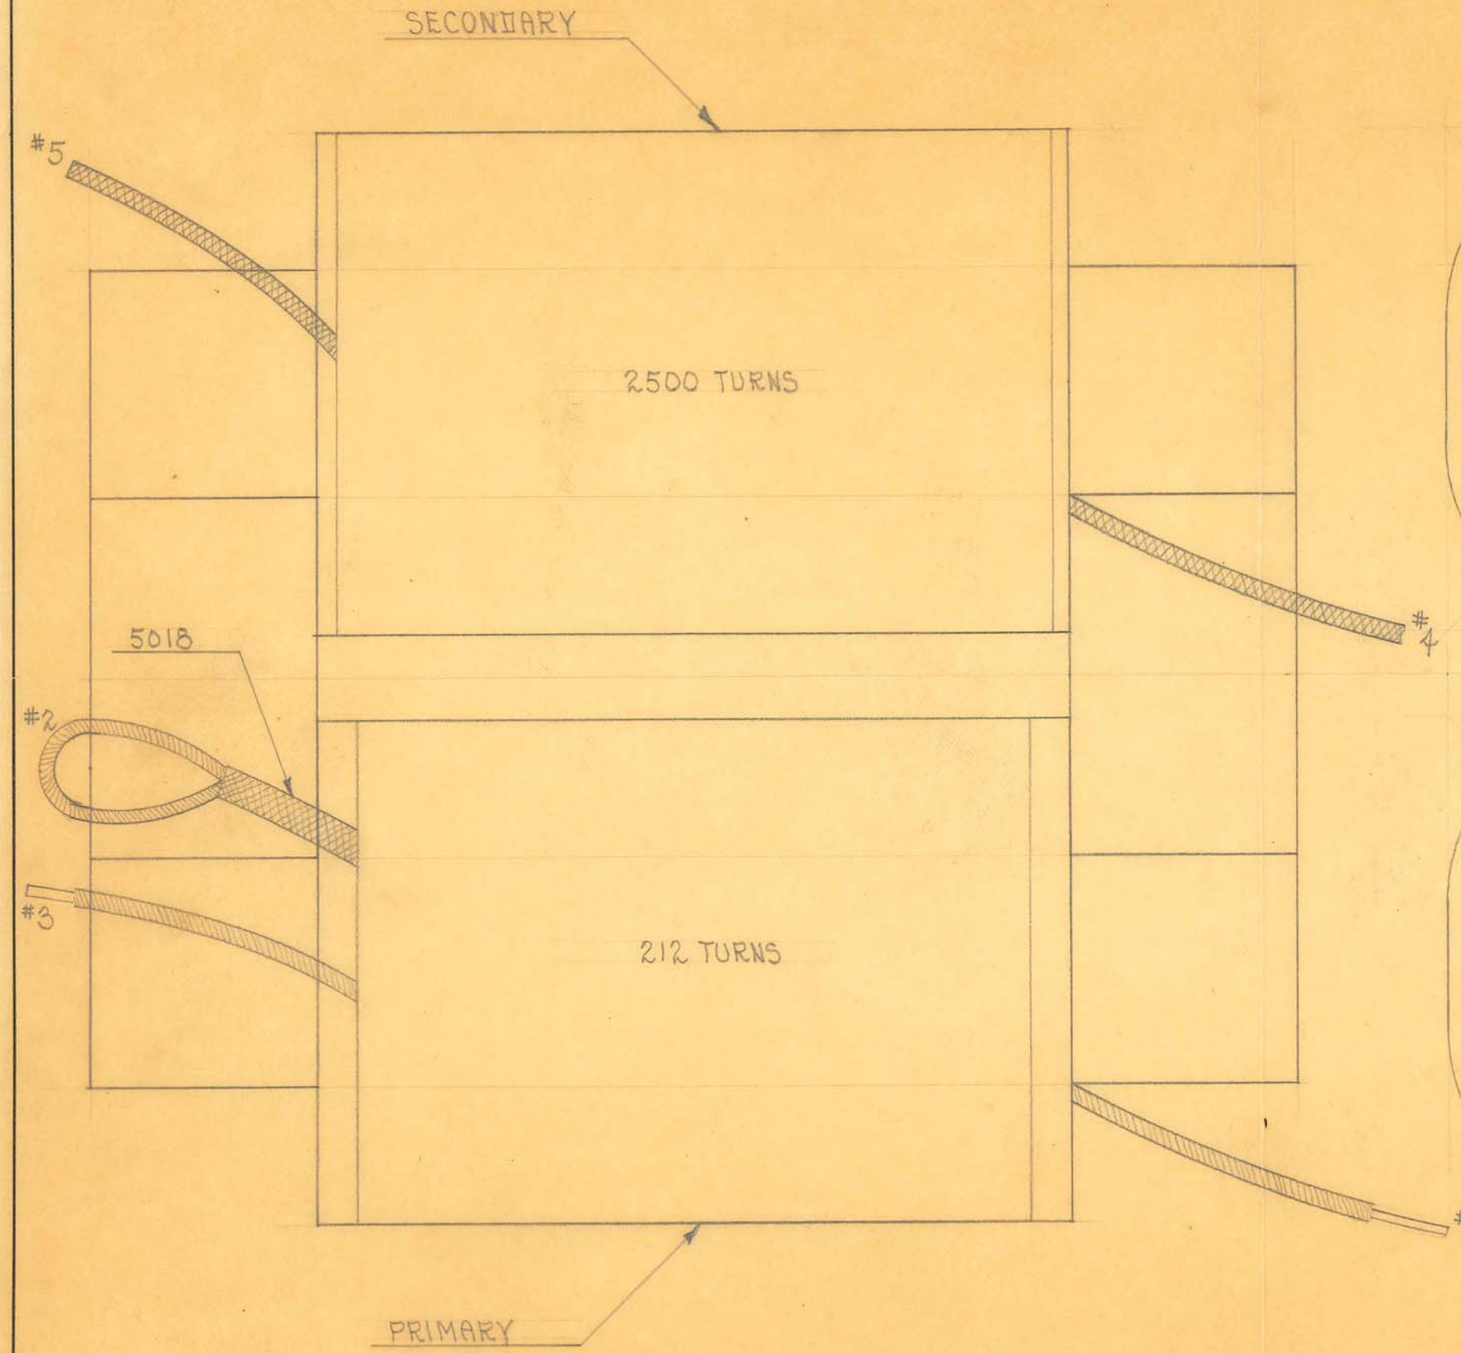

STEEL SIZES

PC. NO. 5043

PRI. & SEC. CORES CUT $6\frac{1}{2}$" X $1\frac{2}{16}$" BUILT UP TO $1\frac{3}{4}$".

END PIECES CUT $3\frac{7}{8}$" X $1\frac{2}{16}$".

BIND PRI. & SEC. CORES WITH FRICTION TAPE.

WINDING DATA

PRIMARY

USE #12 COTENAMEL WIRE.

3 LAYERS OF 5026 $\frac{1}{2}$ OILED CLOTH ON CORE. ANCHOR LEAD #1 WITH FRICTION TAPE AND WIND TO 206 TURNS & BRING OUT TAP #2. WIND 6 MORE TURNS AND ANCHOR END WITH FRICTION TAPE-LEAD #3. TOTAL 212 TURNS. 3 LAYERS OF 5026 $\frac{1}{2}$ OILED CLOTH BETWEEN EACH LAYER OF WIRE. COVER LAST LAYER OF WIRE WITH 5004 OILED TAPE AND SHELLAC.

SECONDARY

USE #22 ENAMEL WIRE.

3 LAYERS OF 5022 FIBROID PAPER ON CORE. ANCHOR LEAD #4 WITH FRICTION TAPE AND WIND 16 LAYERS OF 150 TURNS EACH & A 17TH LAYER OF 100 TURNS. TOTAL 2500 TURNS. 1 LAYER OF 5022 FIBROID PAPER BETWEEN EACH LAYER OF WIRE. COVER 17TH LAYER OF WIRE WITH 5004 OILED TAPE AND SHELLAC. LEADS ARE 1603-#18 STRANDED WIRE.

OBSOLETE

SIZE		ISSUE 3-19-32	A.E.	TITLE: FISCHER TISSUE CUTTING OUTFIT TRANSFORMER
KIND		CHANGED		
SHAPE		" "		
FINISH		" "		
TEMP.		" "		H. G. FISCHER & CO. 2335 WABANSIA AVE. CHICAGO, ILL. — CAT. NO. — PART NO. 4620G
PATT.		" "		

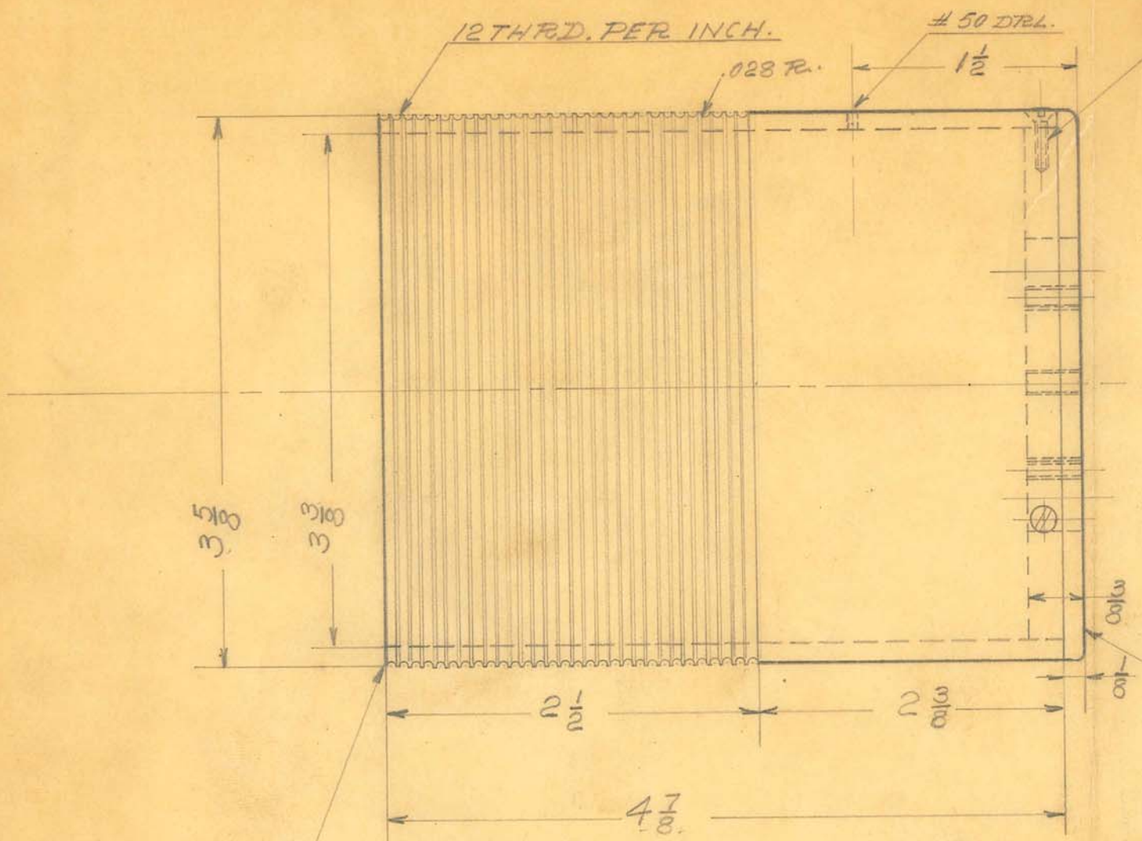

CELLULAC TUBING
1 REQ.
SCALE FULL SIZE

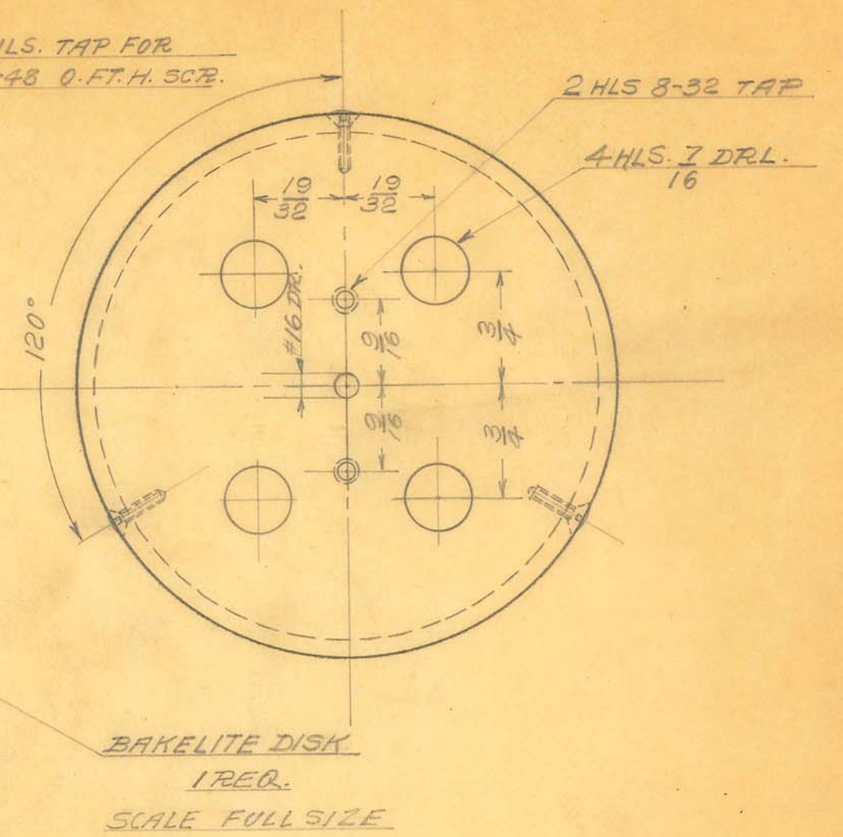

BAKELITE DISK
1 REQ.
SCALE FULL SIZE

COIL 20 TURNS .0508 (#16 B.&S.) COPPER WIRE

OBSOLETE

SIZE		ISSUE 10-20-30	C.M.	TITLE: "CDC" VARIOMETER STATIONARY COIL TUBE
KIND		CHANGED		
SHAPE		" "		
FINISH		" "		
TEMP.		" "		H. G. FISCHER & CO. 2335 WABANSIA AVE. CHICAGO, ILL. — CAT. NO. — PART NO. 7039G
PATT.		" "		

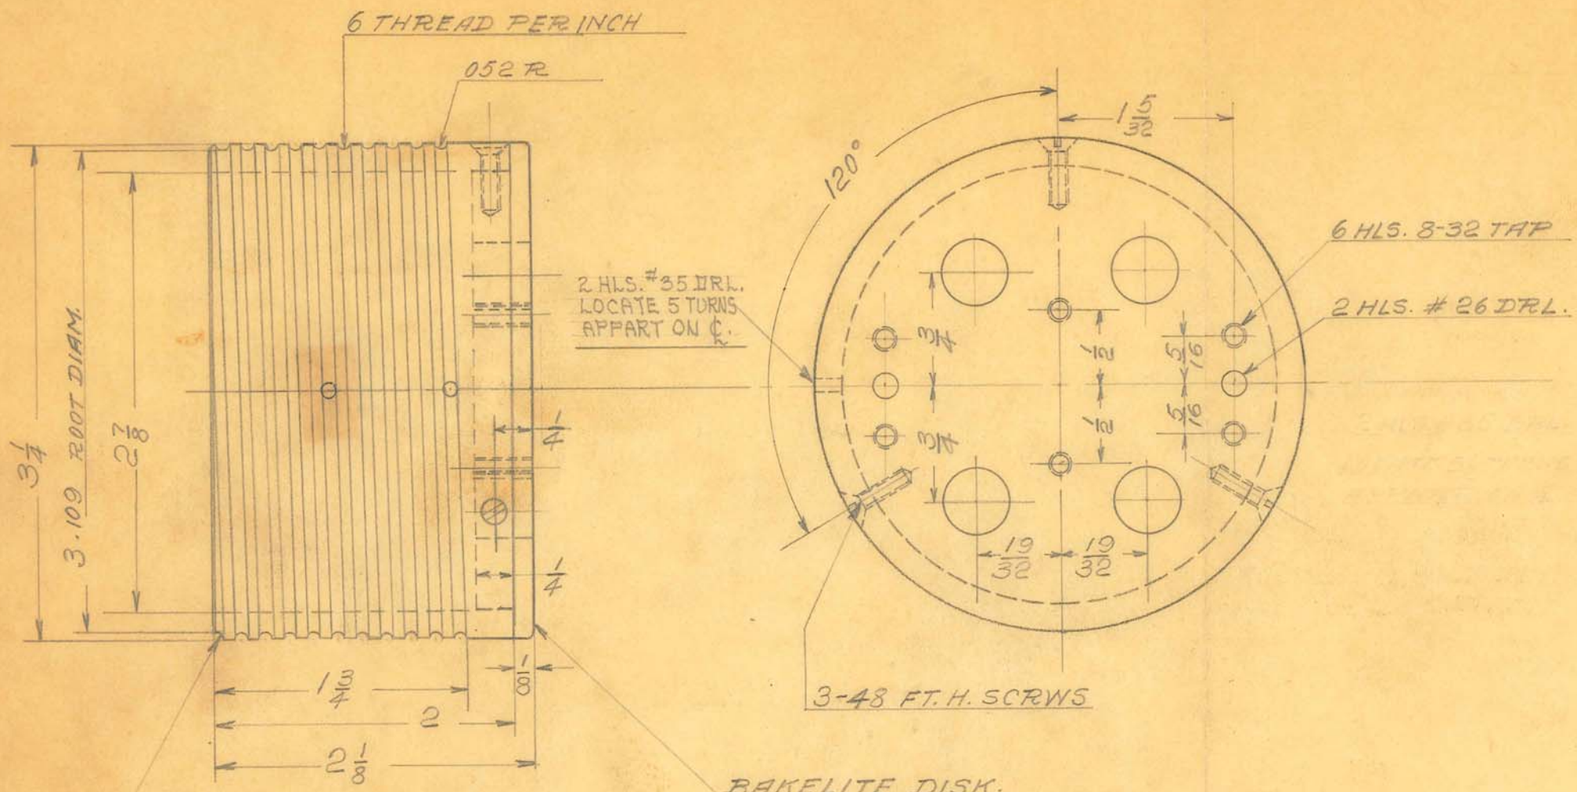

COIL 5½ TURNS OF #10 (.101) COPPER WIRE

OBSOLETE

SIZE		ISSUE 10-18-30	C.H.L.	TITLE: "CDC" VARIOMETER MOVABLE COIL TUBE
KIND		CHANGED		
SHAPE		" "		
FINISH		" "		
TEMP.		" "		
PATT.		" "		

H. G. FISCHER & CO.
2335 WABANSIA AVE.
CHICAGO, ILL.

CAT. NO.

PART NO. 7040½G

SECTION A-A

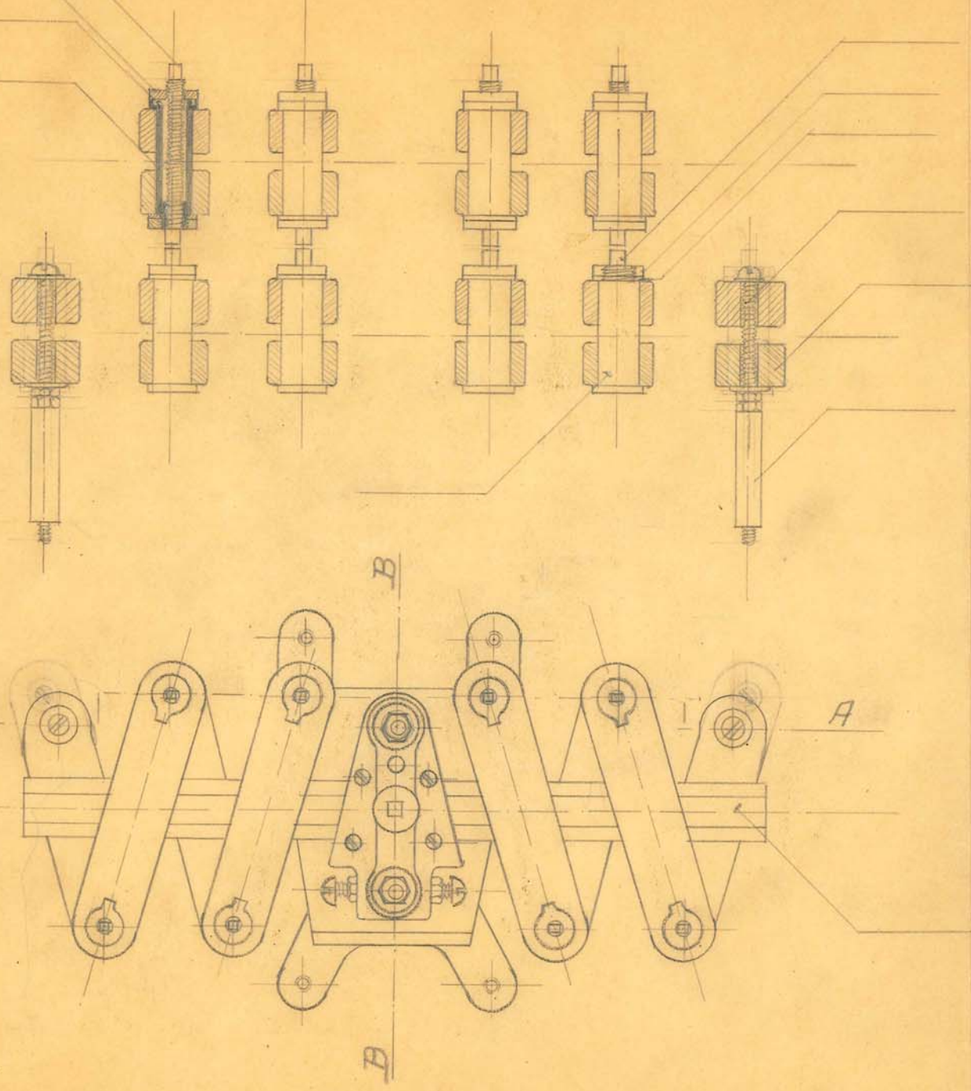

HALF SIZE

SECTION B-B

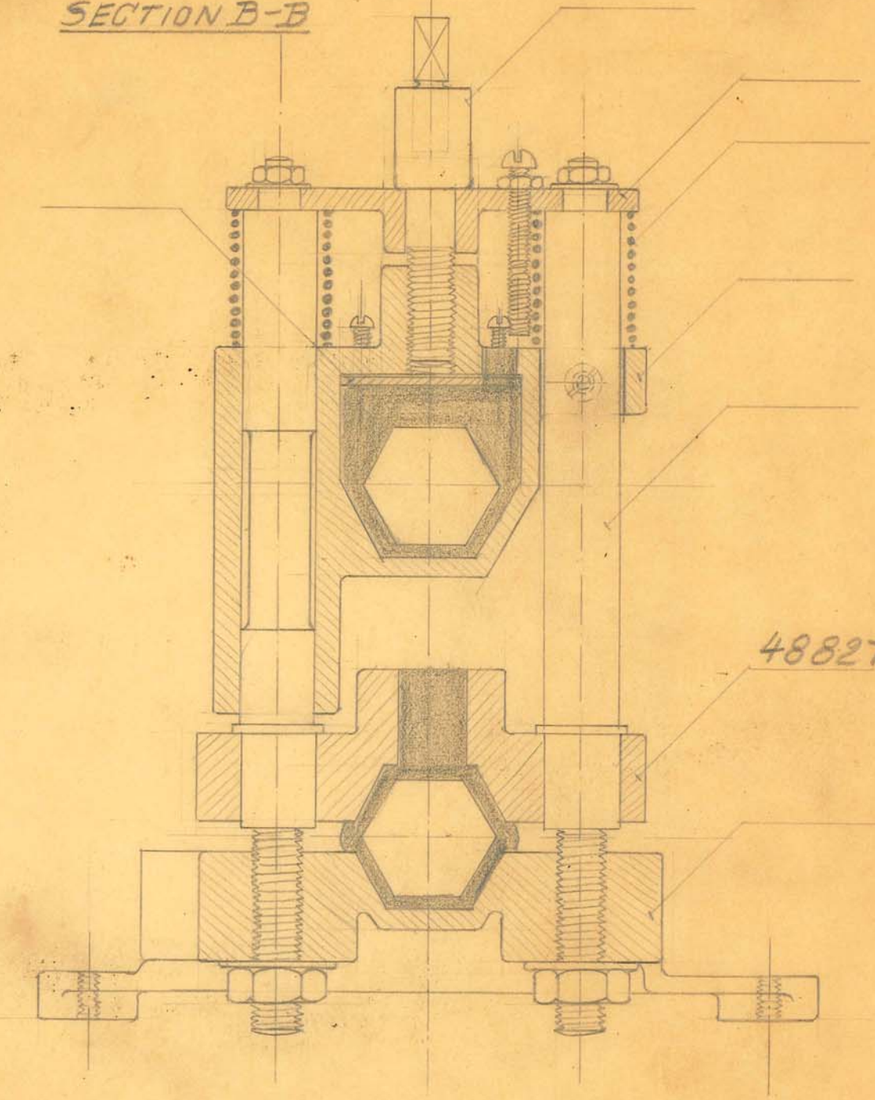

48827

OBSOLETE

FULL SIZE

SIZE		ISSUE		TITLE: SENIOR "V" GAP ASSEM.
KIND		CHANGED		
SHAPE		" "		
FINISH		" "		
TEMP.		" "		H. G. FISCHER & CO. 2335 WABANSIA AVE. CHICAGO, ILL. — CAT. NO. — PART NO. 4875G
PATT.		" "		

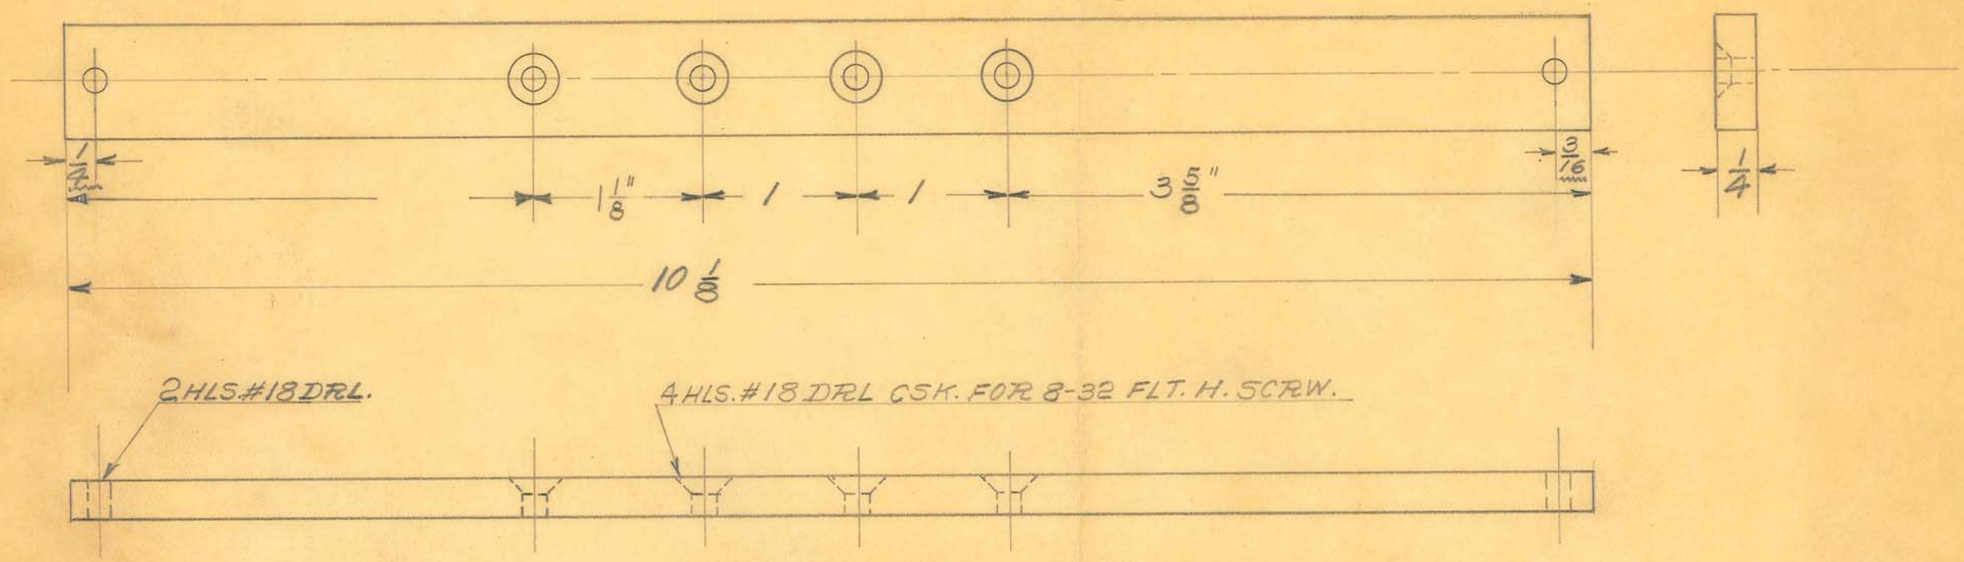

BAKELITE

1 REQ.

SCALE FULL SIZE

OBSOLETE

SIZE		ISSUE 10-16-30	C.H.	TITLE: "CDC" VARIOMETER TERM. STRIP
KIND		CHANGED 11-20-30	C.H.	
SHAPE		" " 2-27-31		
FINISH		" "		
TEMP.		" "		H. G. FISCHER & CO. 2335 WABANSIA AVE. CHICAGO, ILL. — CAT. NO. — PART NO. 7057AF
PATT.		" "		

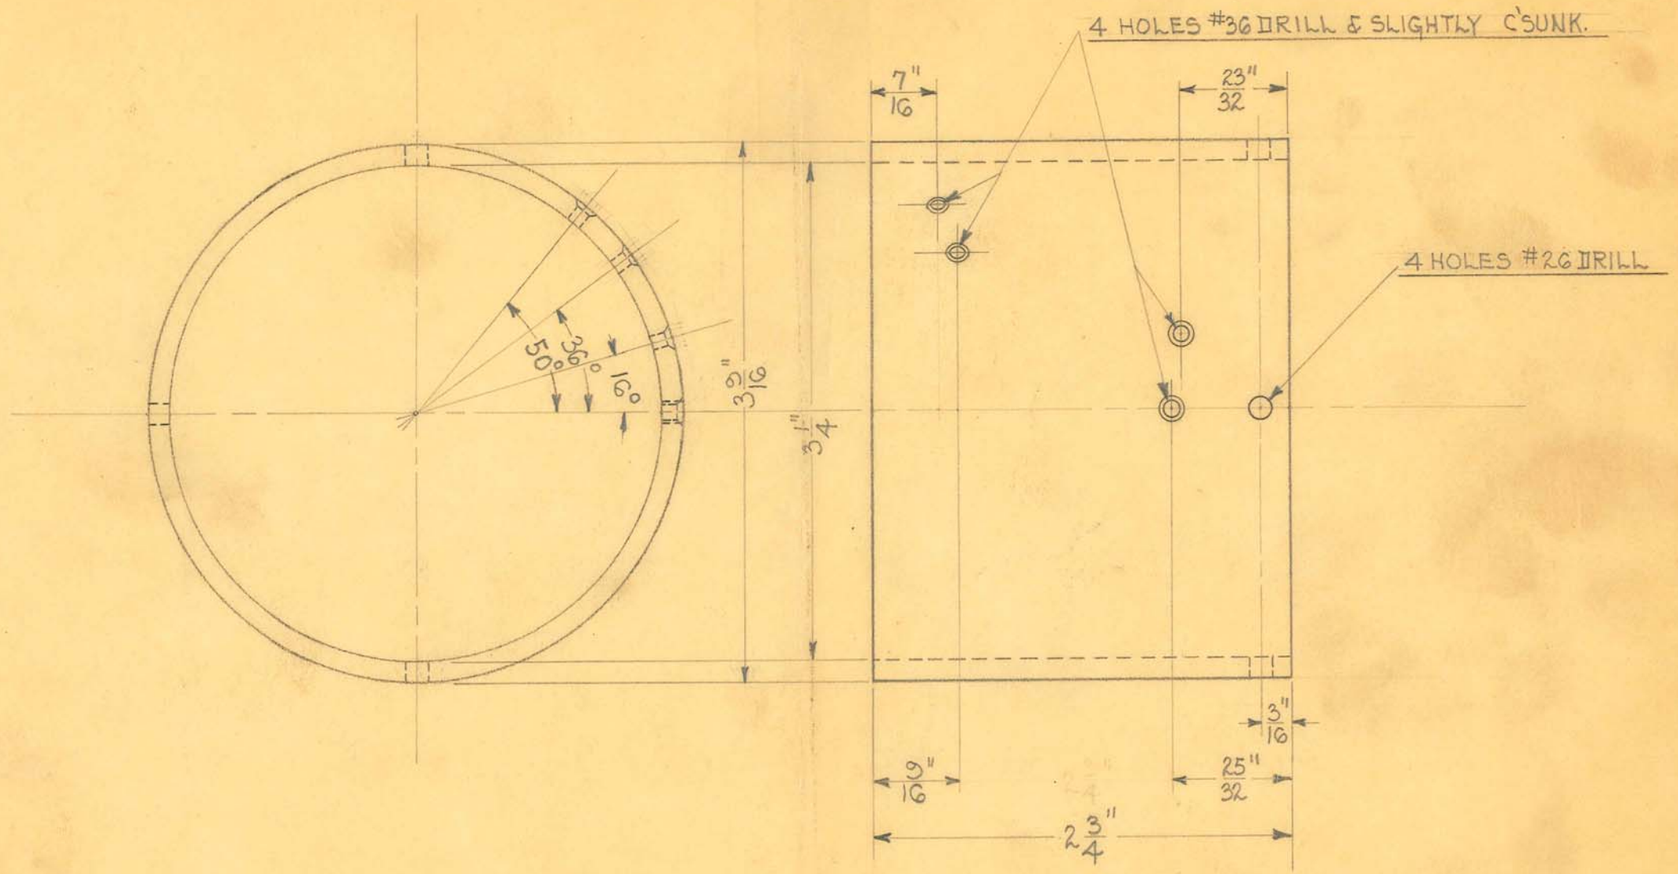

1 REQUIRED

SCALE ~ FULL SIZE

OBSOLETE

SIZE		ISSUE 2-16-31	W.E.
KIND	CELLULAC TUBE	CHANGED	
SHAPE		" "	
FINISH		" "	
TEMP.		" "	
PATT.		" "	

TITLE: "CDC" OSCILATING COIL TUBE (DRILLED)

H. G. FISCHER & CO.
2335 WABANSIA AVE.
CHICAGO, ILL.

CAT. NO.

PART NO. 7080F

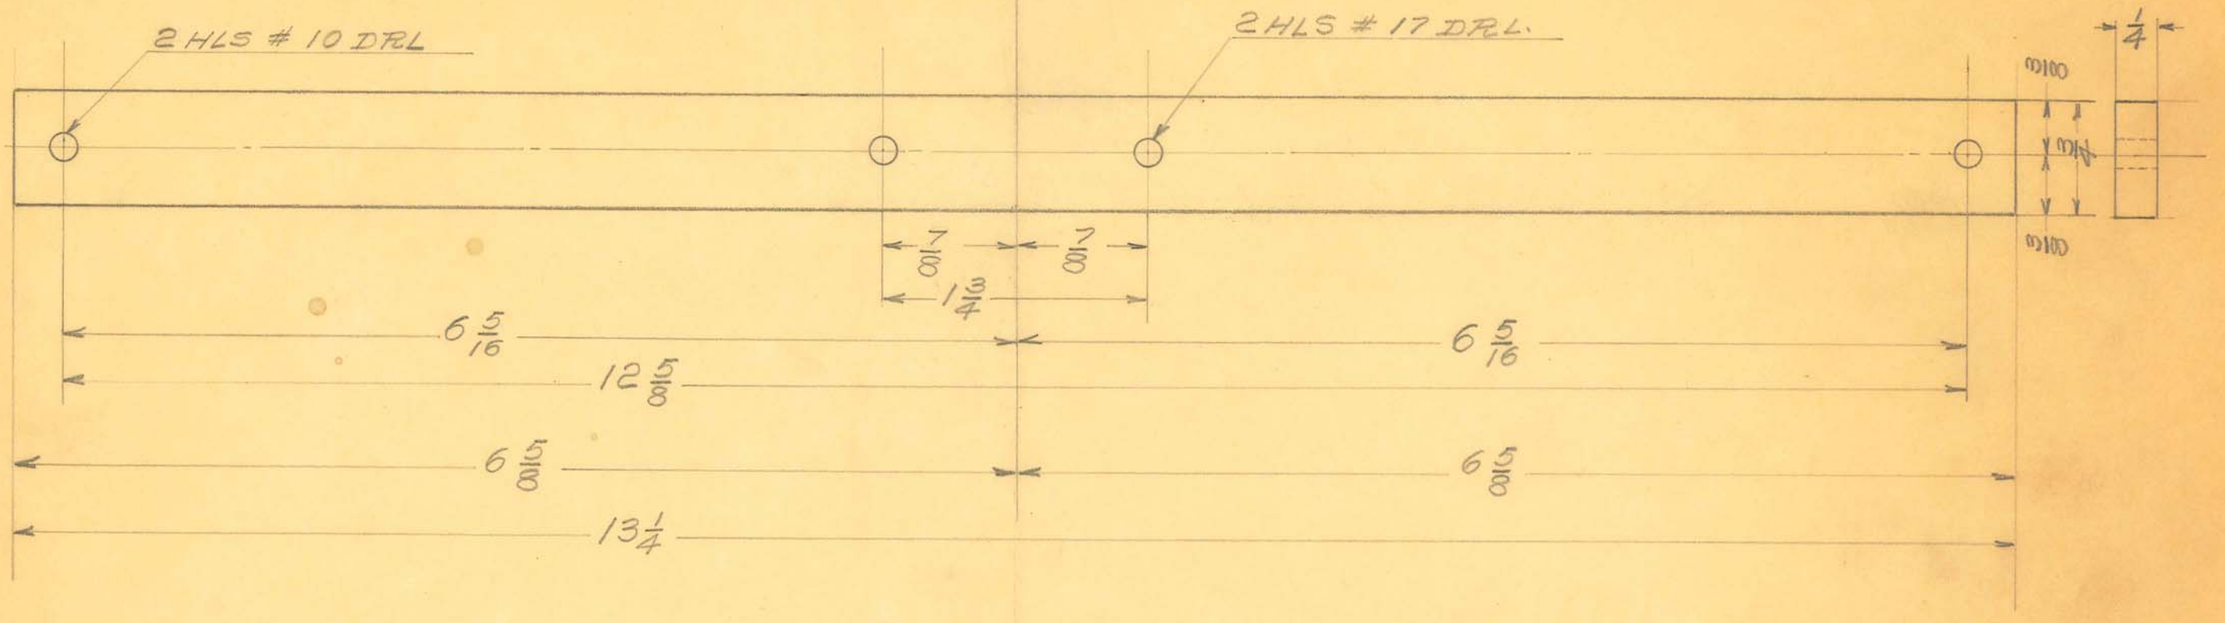

C. R. STEEL

2 REQ.

SCALE FULL SIZE

OBSOLETE

SIZE		ISSUE 12-10-30	CAL.	TITLE: CDC SPARK CAP SUPPORT STRIP
KIND		CHANGED		
SHAPE		" "		
FINISH		" "		
TEMP.		" "		H. G. FISCHER & CO. 2335 WABANSIA AVE. CHICAGO, ILL. — CAT. NO. — PART NO. 7082
PATT.		" "		

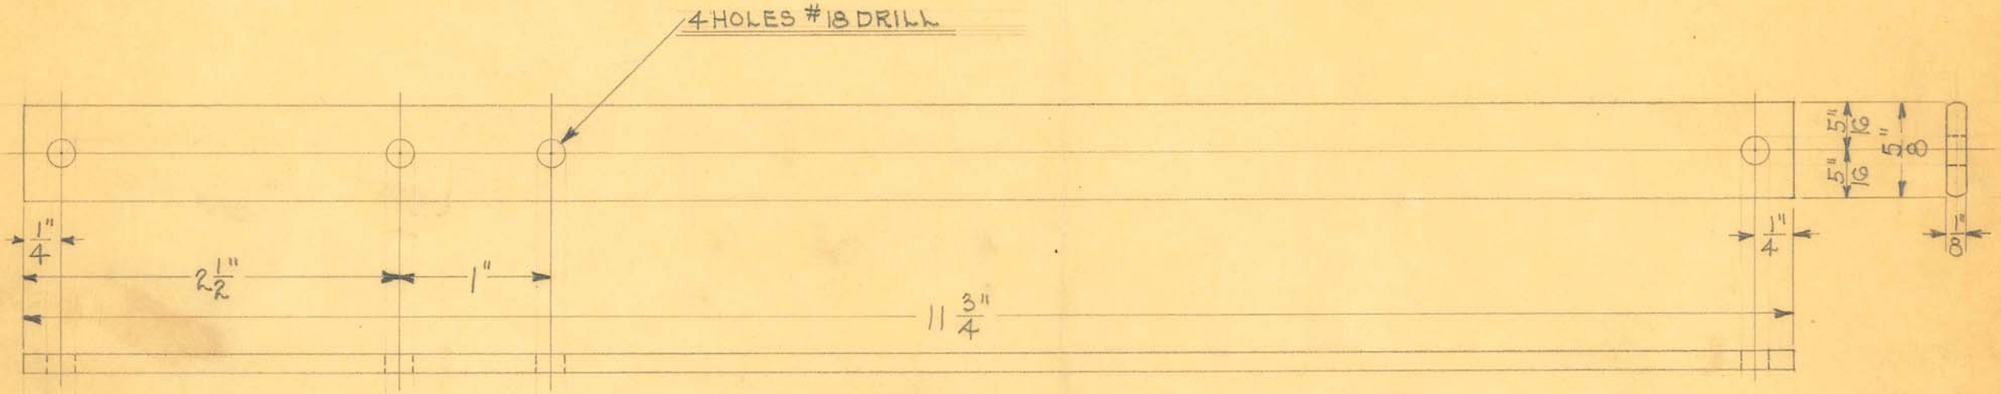

1 REQUIRED

OBSOLETE

SIZE	5/8" X 1/8"	ISSUE 11-7-30	2/8	TITLE: "C DC" OSCILATING COIL SUPPORT STRIP
KIND	R.E. COLD ROLL	CHANGED		
SHAPE	STRIP	" "		
FINISH	BLACK ENAMEL	" "		
TEMP.		" "		
PATT.		" "		

H. G. FISCHER & CO.
2335 WABANSIA AVE.
CHICAGO, ILL.

CAT. NO.

PART NO. 7084

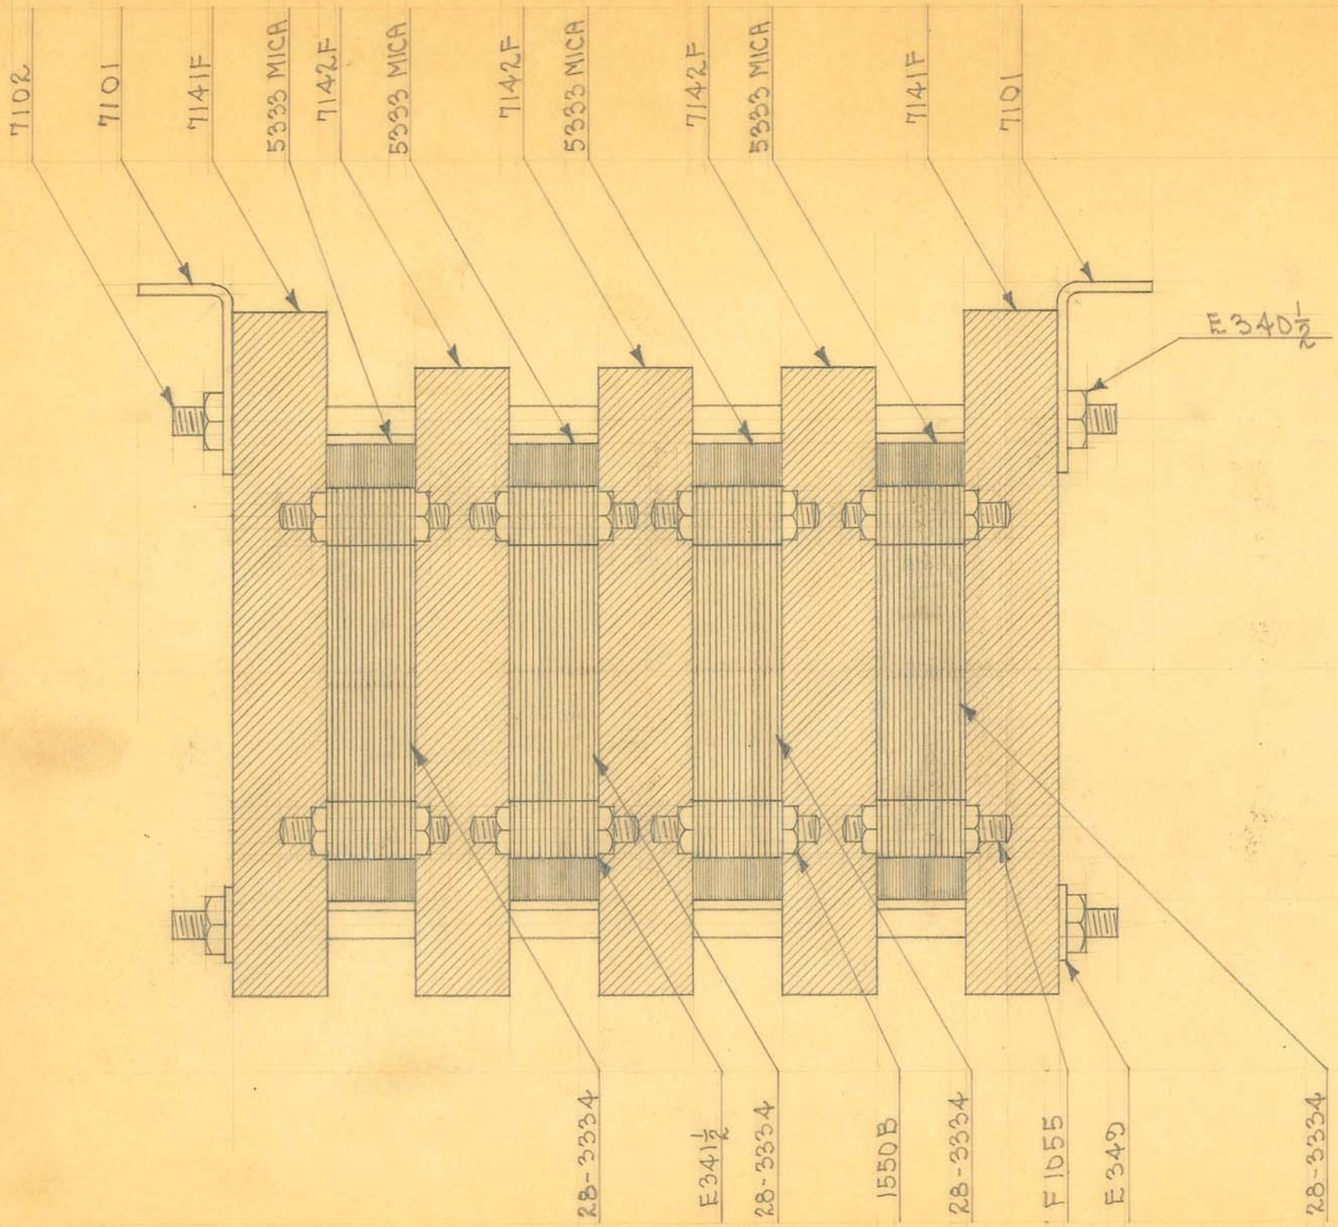

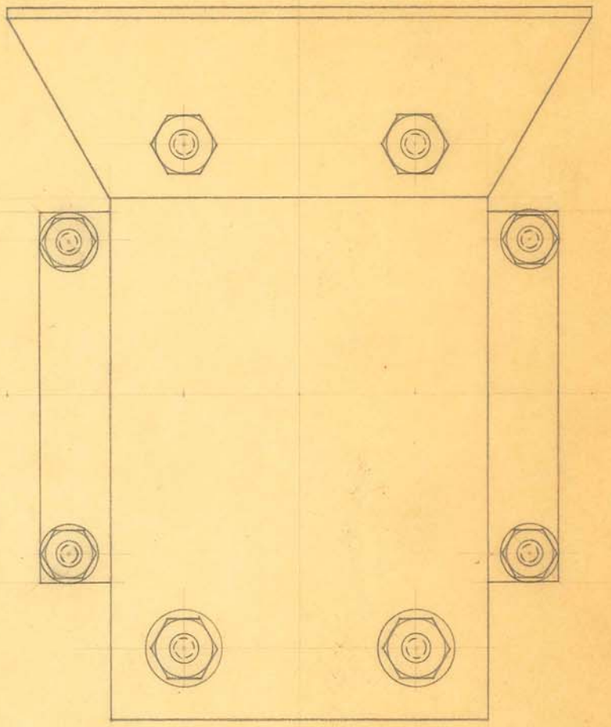

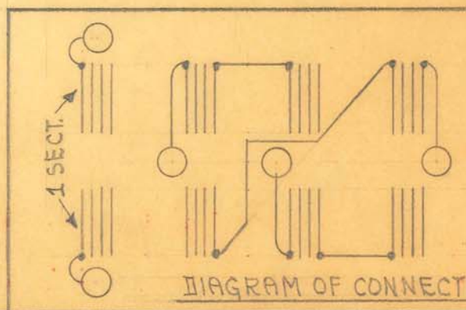

DIAGRAM OF CONNECTIONS

NOTE:-
MICA SPLIT TO .012" (4-7 SHEETS)
4-28 PLATE CONNS. JIG. # 4126

SIZE		ISSUE 2-19-32	H.E.
KIND		CHANGED	
SHAPE		" "	
FINISH		" "	
TEMP.		" "	
PATT.		" "	

TITLE: "CIIC" CONDENSER LESS TANK & COVER

OBSOLETE

H. G. FISCHER & CO.
2335 WABANSIA AVE.
CHICAGO, ILL.

CAT. NO.

PART NO. 7100G

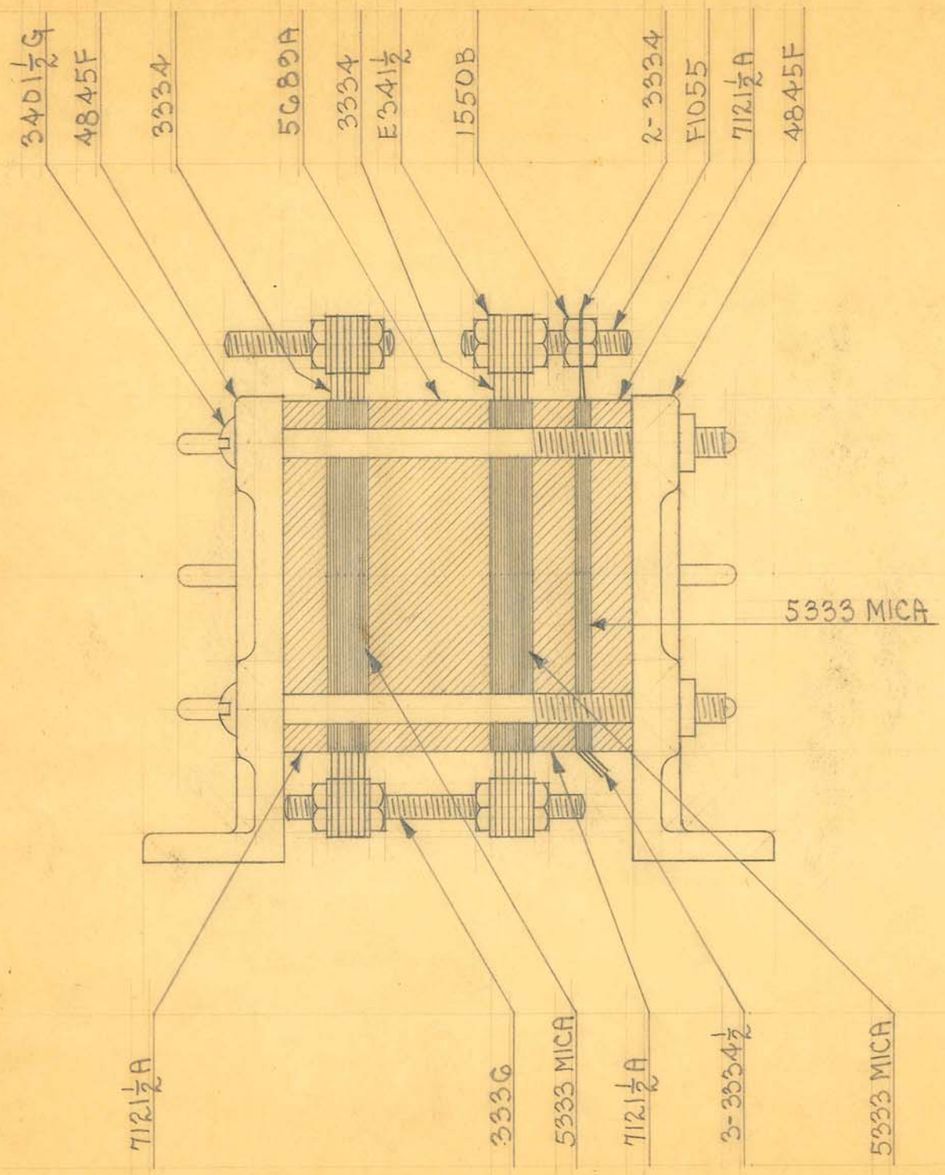

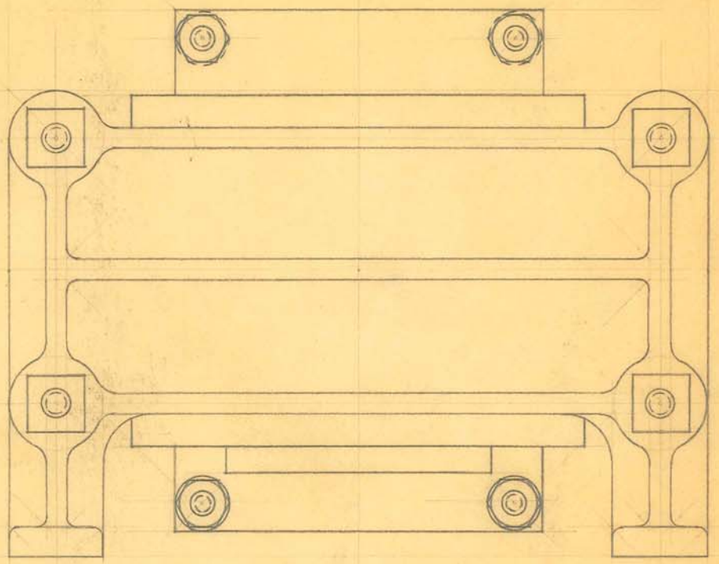

NOTE:-
MICA SPLIT TO .012" (4-7 SHEETS)
2-12 PLATE CONNS. JIG. #4126
1-5 PLATE GRD. CONN.

OBSOLETE

SIZE		ISSUE 2-23-32	H.E.	TITLE: "CHC" BLOCKING & GROUND CONDENSER
KIND		CHANGED		
SHAPE		" "		
FINISH		" "		
TEMP.		" "		H. G. FISCHER & CO. 2335 WABANSIA AVE. CHICAGO, ILL. — CAT. NO. — PART NO. 7121¼G
PATT.		" "		

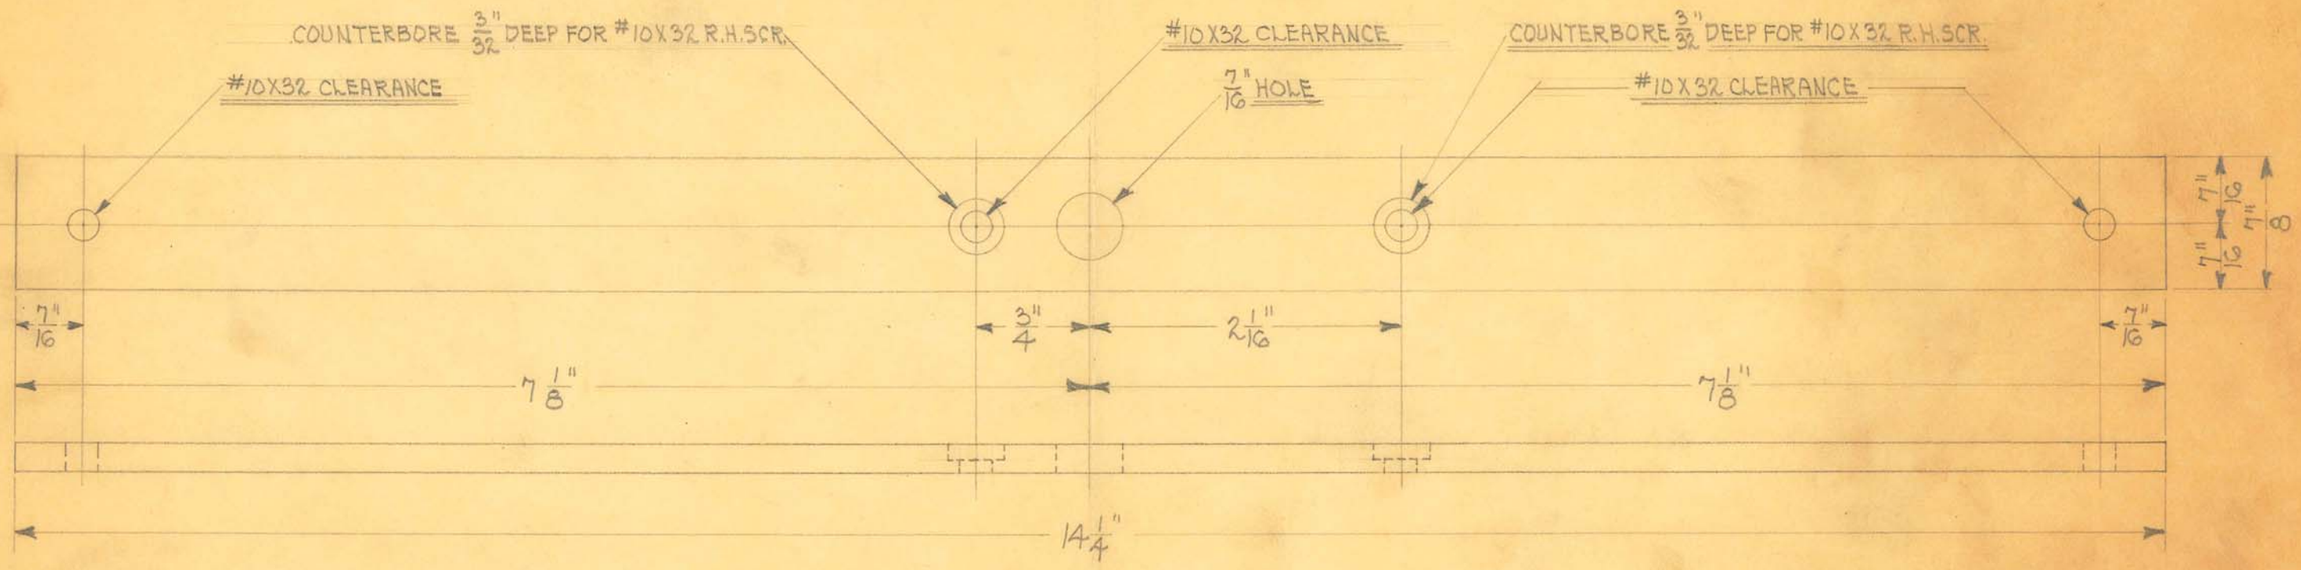

1 REQUIRED

SIZE	7/8" X 3/16"	ISSUE 11-8-30	J.E.
KIND	COND ROLLED	CHANGED	
SHAPE	STRIP	" "	
FINISH	BLACK ENAMEL	" "	
TEMP.		" "	
PATT.		" "	

TITLE: "CDC" FAN SUPPORT STRIP

OBSOLETE

H. G. FISCHER & CO.
2335 WABANSIA AVE.
CHICAGO, ILL.

CAT. NO.

PART NO. 7098

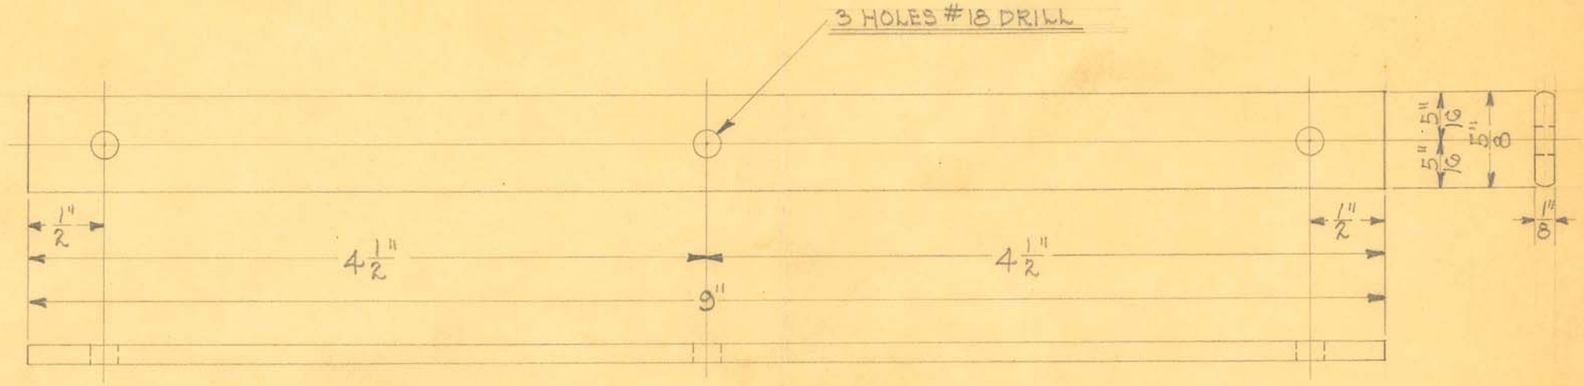

2 REQUIRED

OBSOLETE

SIZE	5/8" X 1/2"	ISSUE 11-7-30	A.B.	TITLE: "C D C" PUSH BUTTON SUPPORT STRIP	
KIND	R.E. COLD ROLLED	CHANGED			
SHAPE	STRIP	" "			
FINISH	BLACK ENAMEL	" "			
TEMP.		" "		H. G. FISCHER & CO. 2335 WABANSIA AVE. CHICAGO, ILL.	CAT. NO.
PATT.		" "			PART NO. 7095

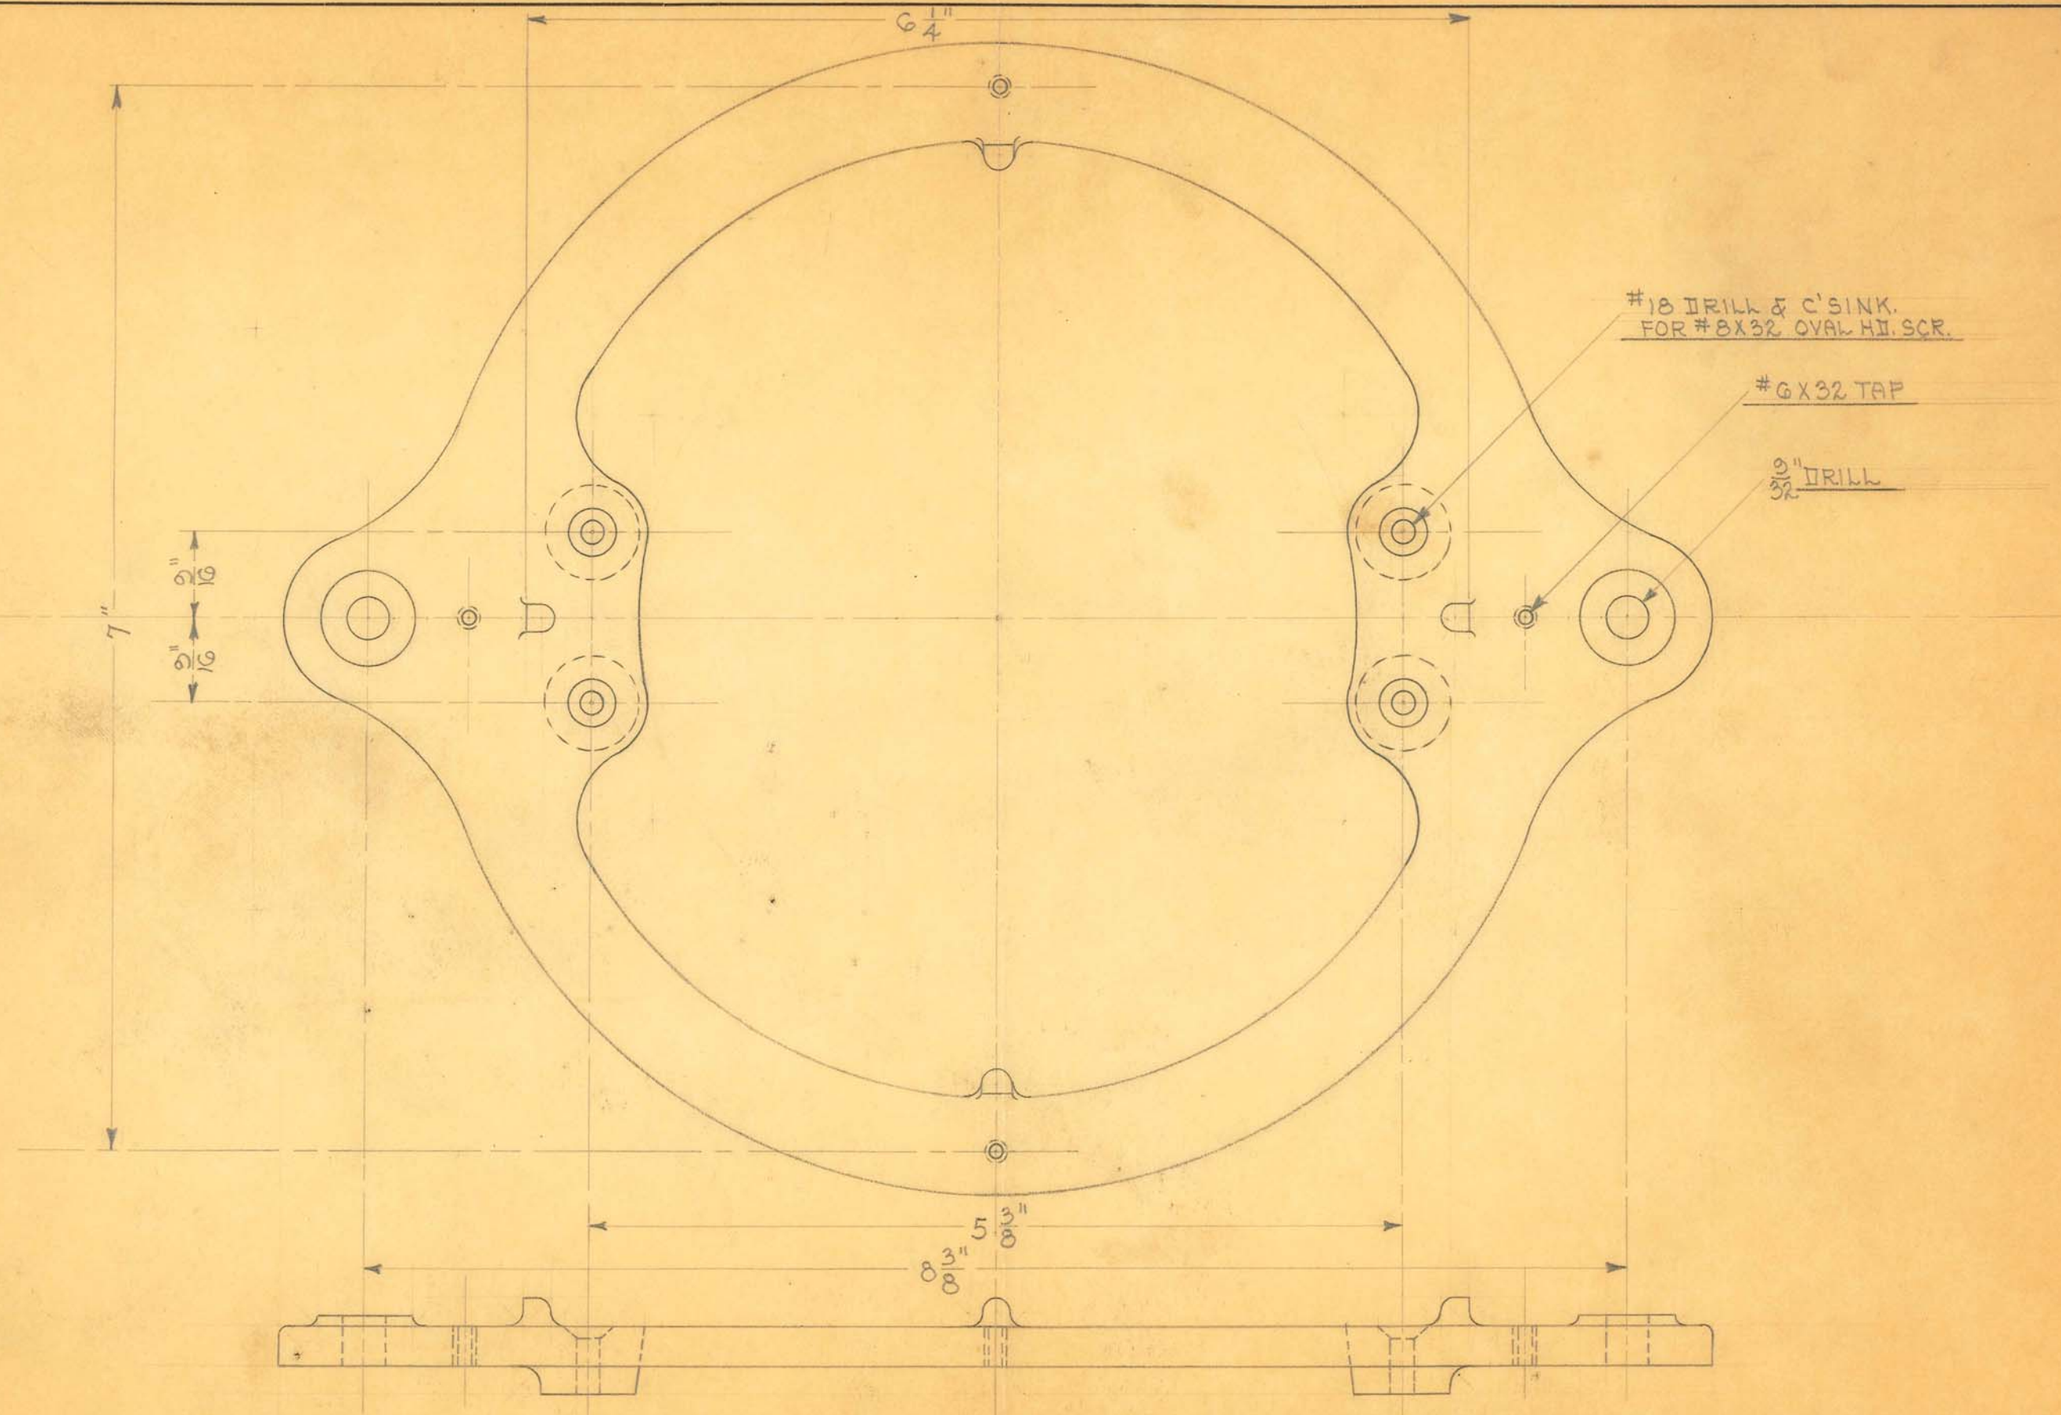

SCALE ✱ FULL SIZE

1 REQUIRED

SIZE		ISSUE 4-23-31	A.E.
KIND	ALUM. CASTING	CHANGED	
SHAPE		" "	
FINISH	BLK. ENAMEL	" "	
TEMP.		" "	
PATT.		" "	

TITLE: "CDC" SPARK GAP COVER PLATE BASE

OBSOLETE

H. G. FISCHER & CO.
2335 WABANSIA AVE.
CHICAGO, ILL.

CAT. NO.

PART NO. 7112 1/2 F

#27 DRILL & C'SINK.
FOR #6X32 OVAL HD. SCR.

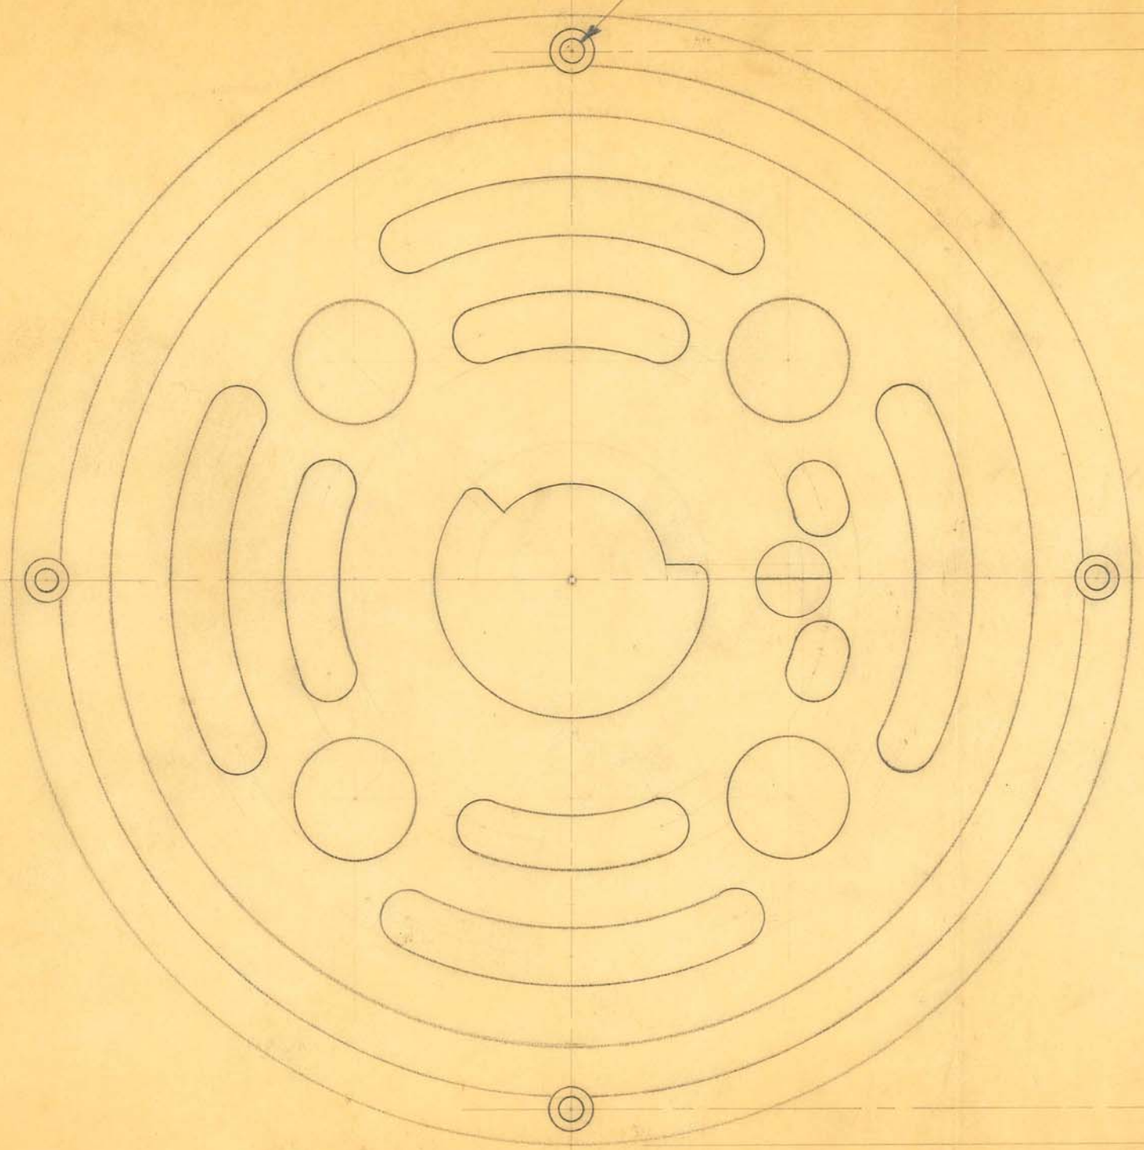

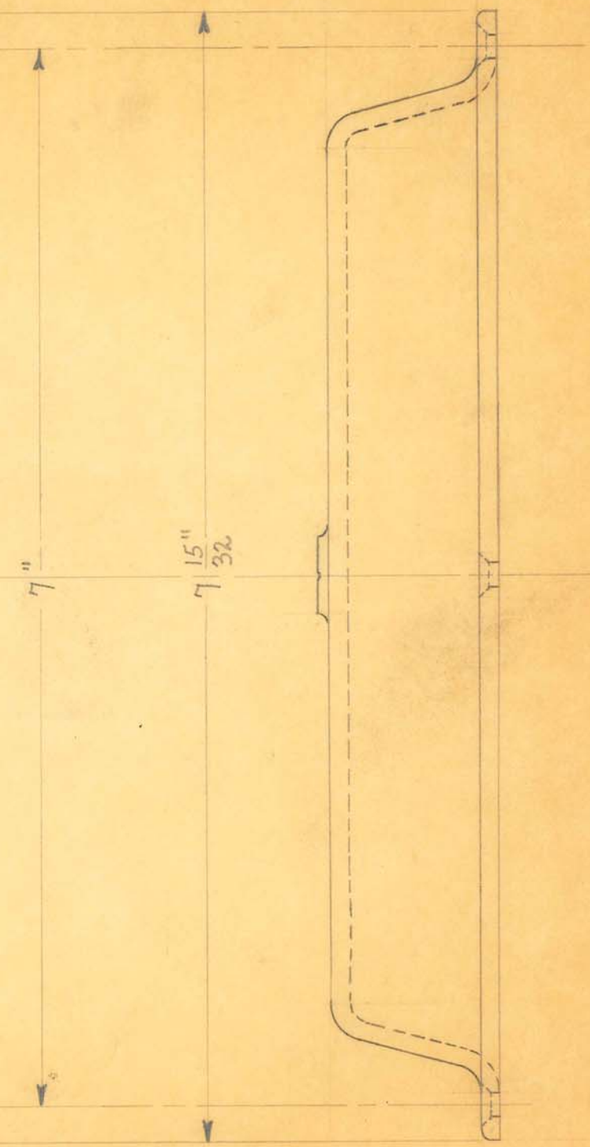

SCALE ≈ FULL SIZE
1 REQUIRED

OBSOLETE

SIZE		ISSUE 4-22-31	A.E.
KIND	ALUM. CASTING	CHANGED	
SHAPE		" "	
FINISH	BLK. ENAMEL	" "	
TEMP.		" "	
PATT.		" "	

TITLE: "CDC" SPARK GAP COVER PLATE

H. G. FISCHER & CO.
2335 WABANSIA AVE.
CHICAGO, ILL.

CAT. NO.

PART NO. 7112 FA

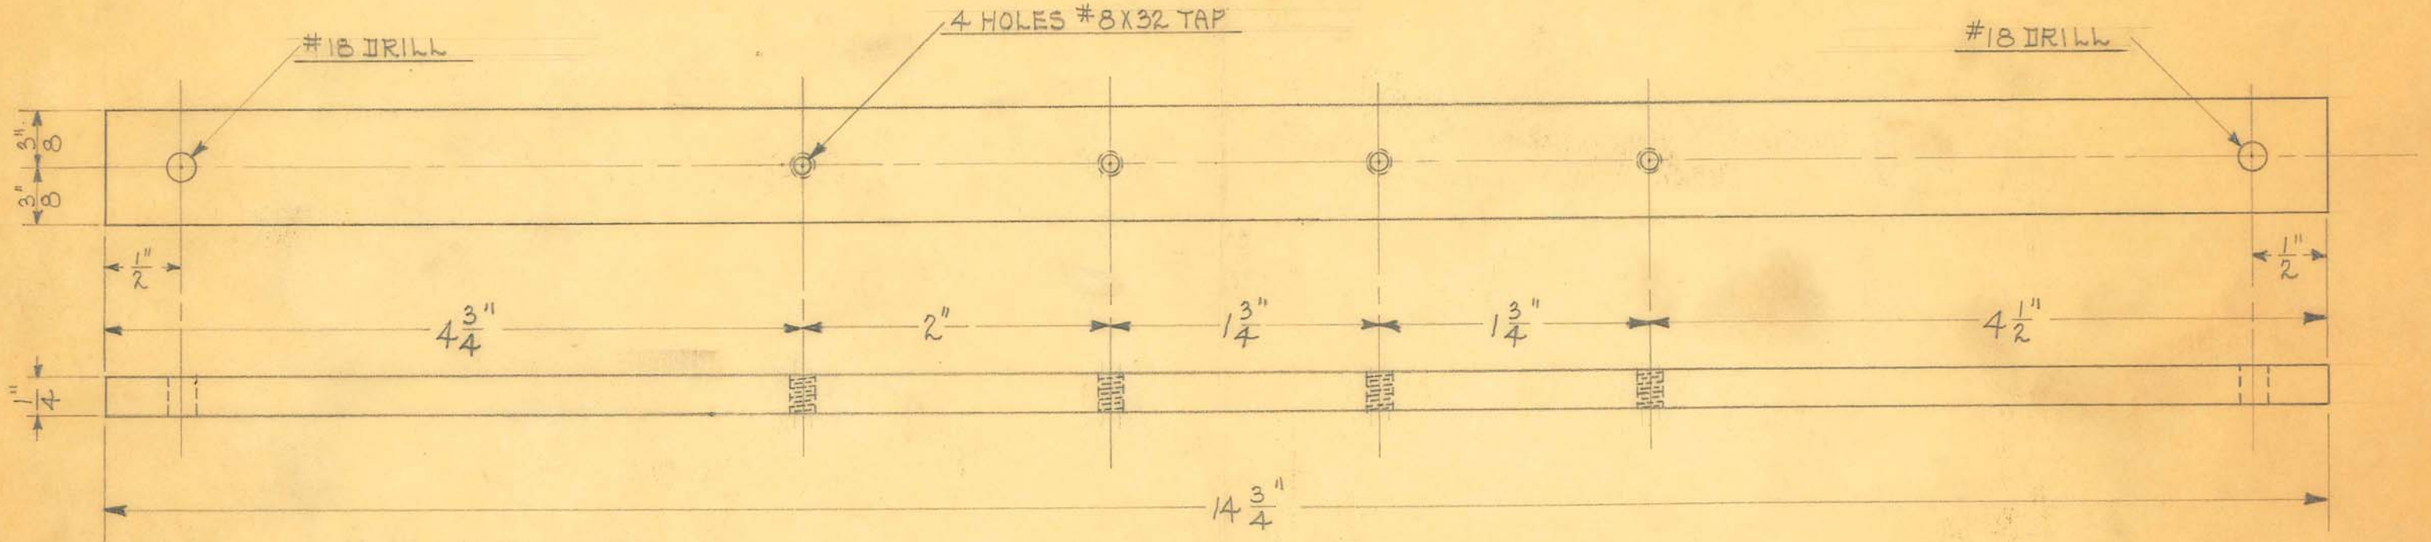

SCALE ~ FULL SIZE
1 REQUIRED

OBSOLETE

SIZE		ISSUE 1-5-31	A.B.	TITLE: "CDC" TRANSFORMER TERMINAL STRIP
KIND	BAKELITE	CHANGED		
SHAPE		" "		
FINISH		" "		
TEMP.		" "		H. G. FISCHER & CO. 2335 WABANSIA AVE. CHICAGO, ILL. — CAT. NO. — PART NO. 7111F
PATT.		" "		

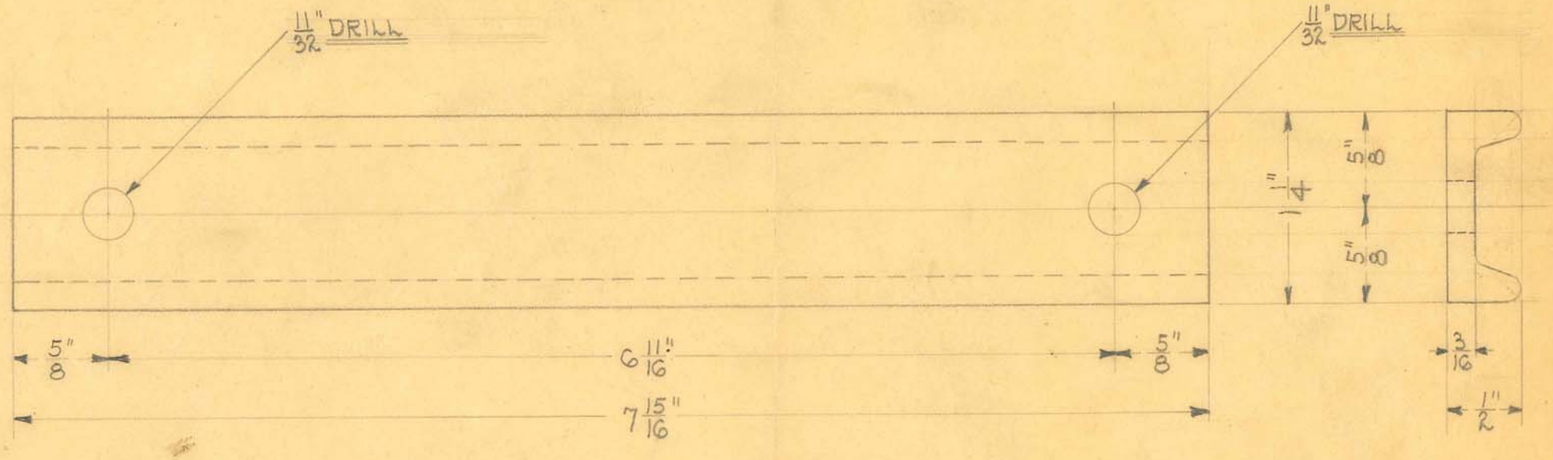

OBSOLETE

SIZE	1 1/4" X 1/2"	ISSUE 10-16-30	A.E.	TITLE: "CDC" TRANSFORMER CHANNEL IRON
KIND	CHANNEL IRON	CHANGED		
SHAPE		" "		
FINISH		" "		
TEMP.		" "		H. G. FISCHER & CO. 2335 WABANSIA AVE. CHICAGO, ILL. — CAT. NO. — PART NO. 7108
PATT. "		" "		

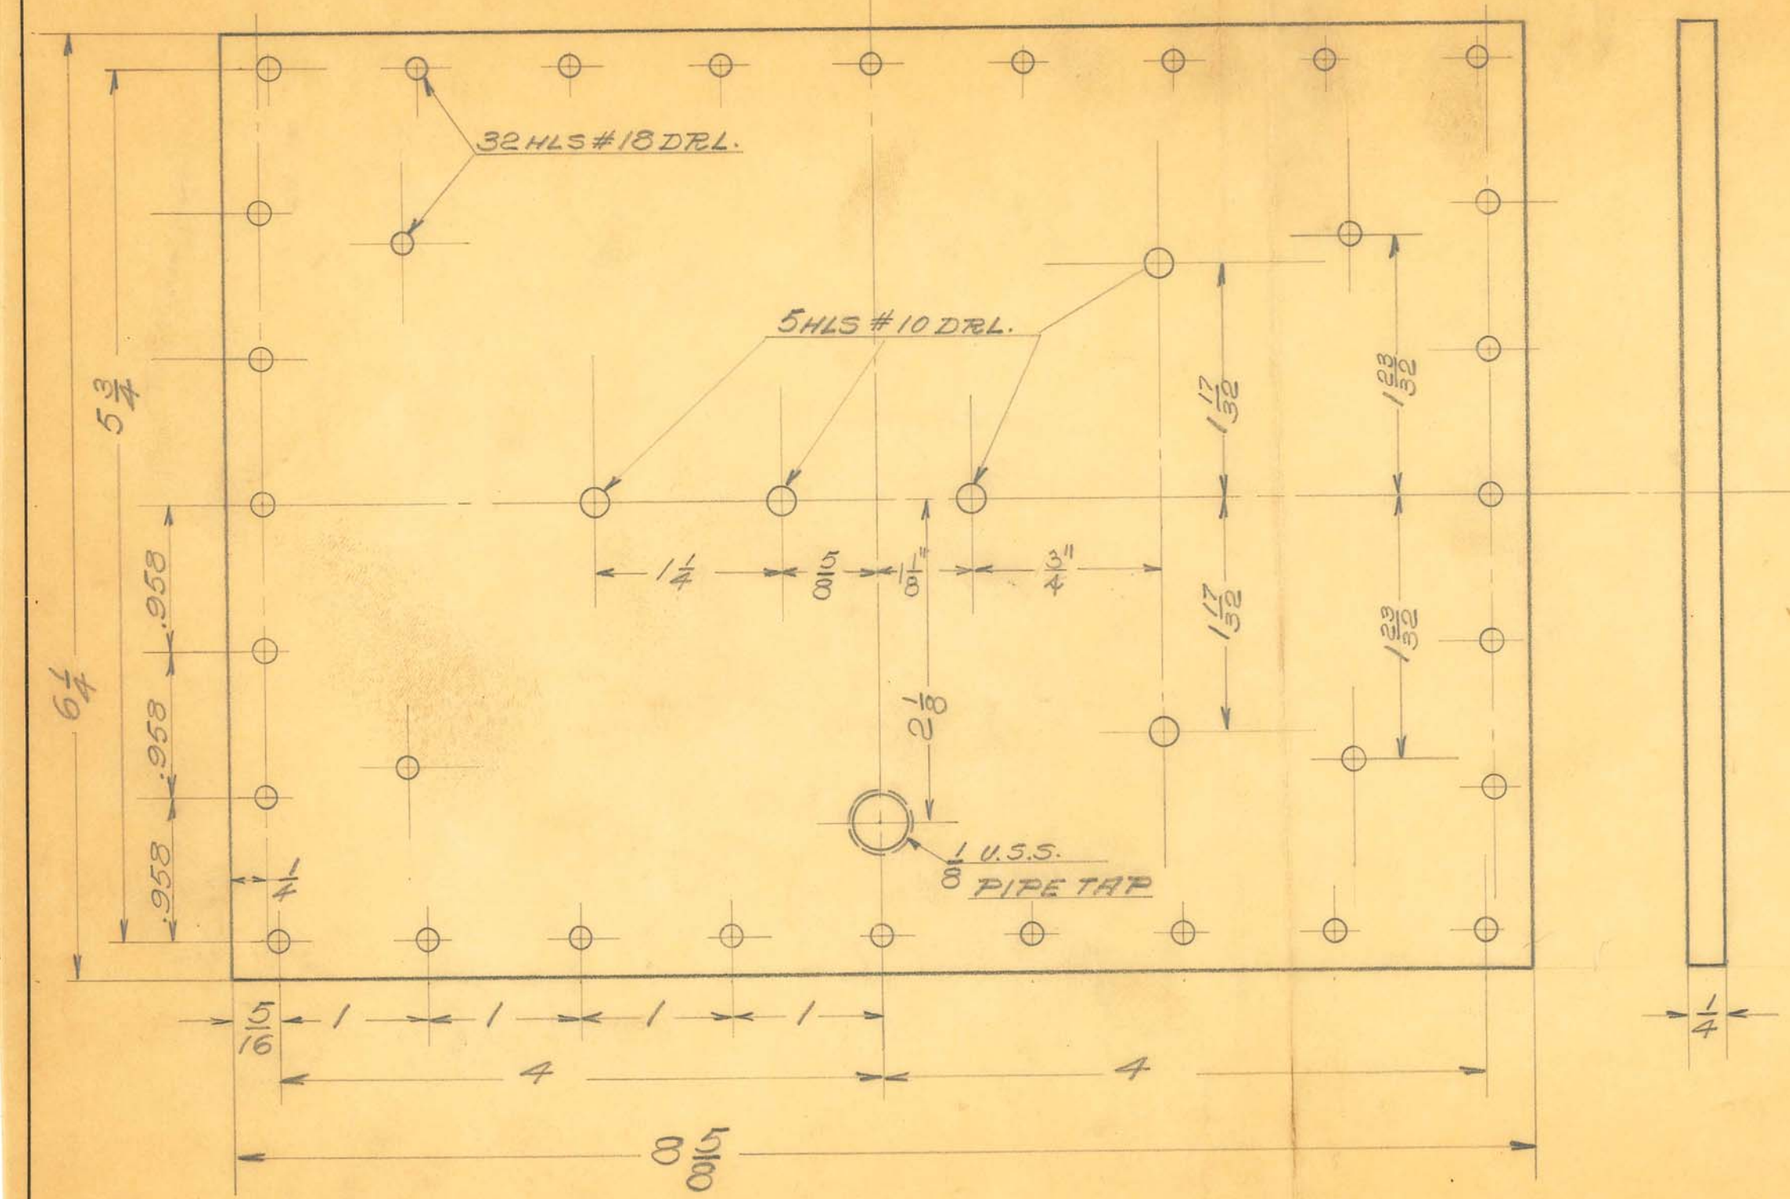

FIBER
1 REQ.
SCALE FULL SIZE

OBSOLETE

SIZE		ISSUE 4-2-31	C.M.	TITLE: CDC CONDENSER TANK COVER
KIND		CHANGED 12-2-31	A.E.	
SHAPE		" "		
FINISH		" "		
TEMP.		" "		H. G. FISCHER & CO. 2335 WABANSIA AVE. CHICAGO, ILL. — CAT. NO. — PART NO. 7100 1/2 FA
PATT.		" "		

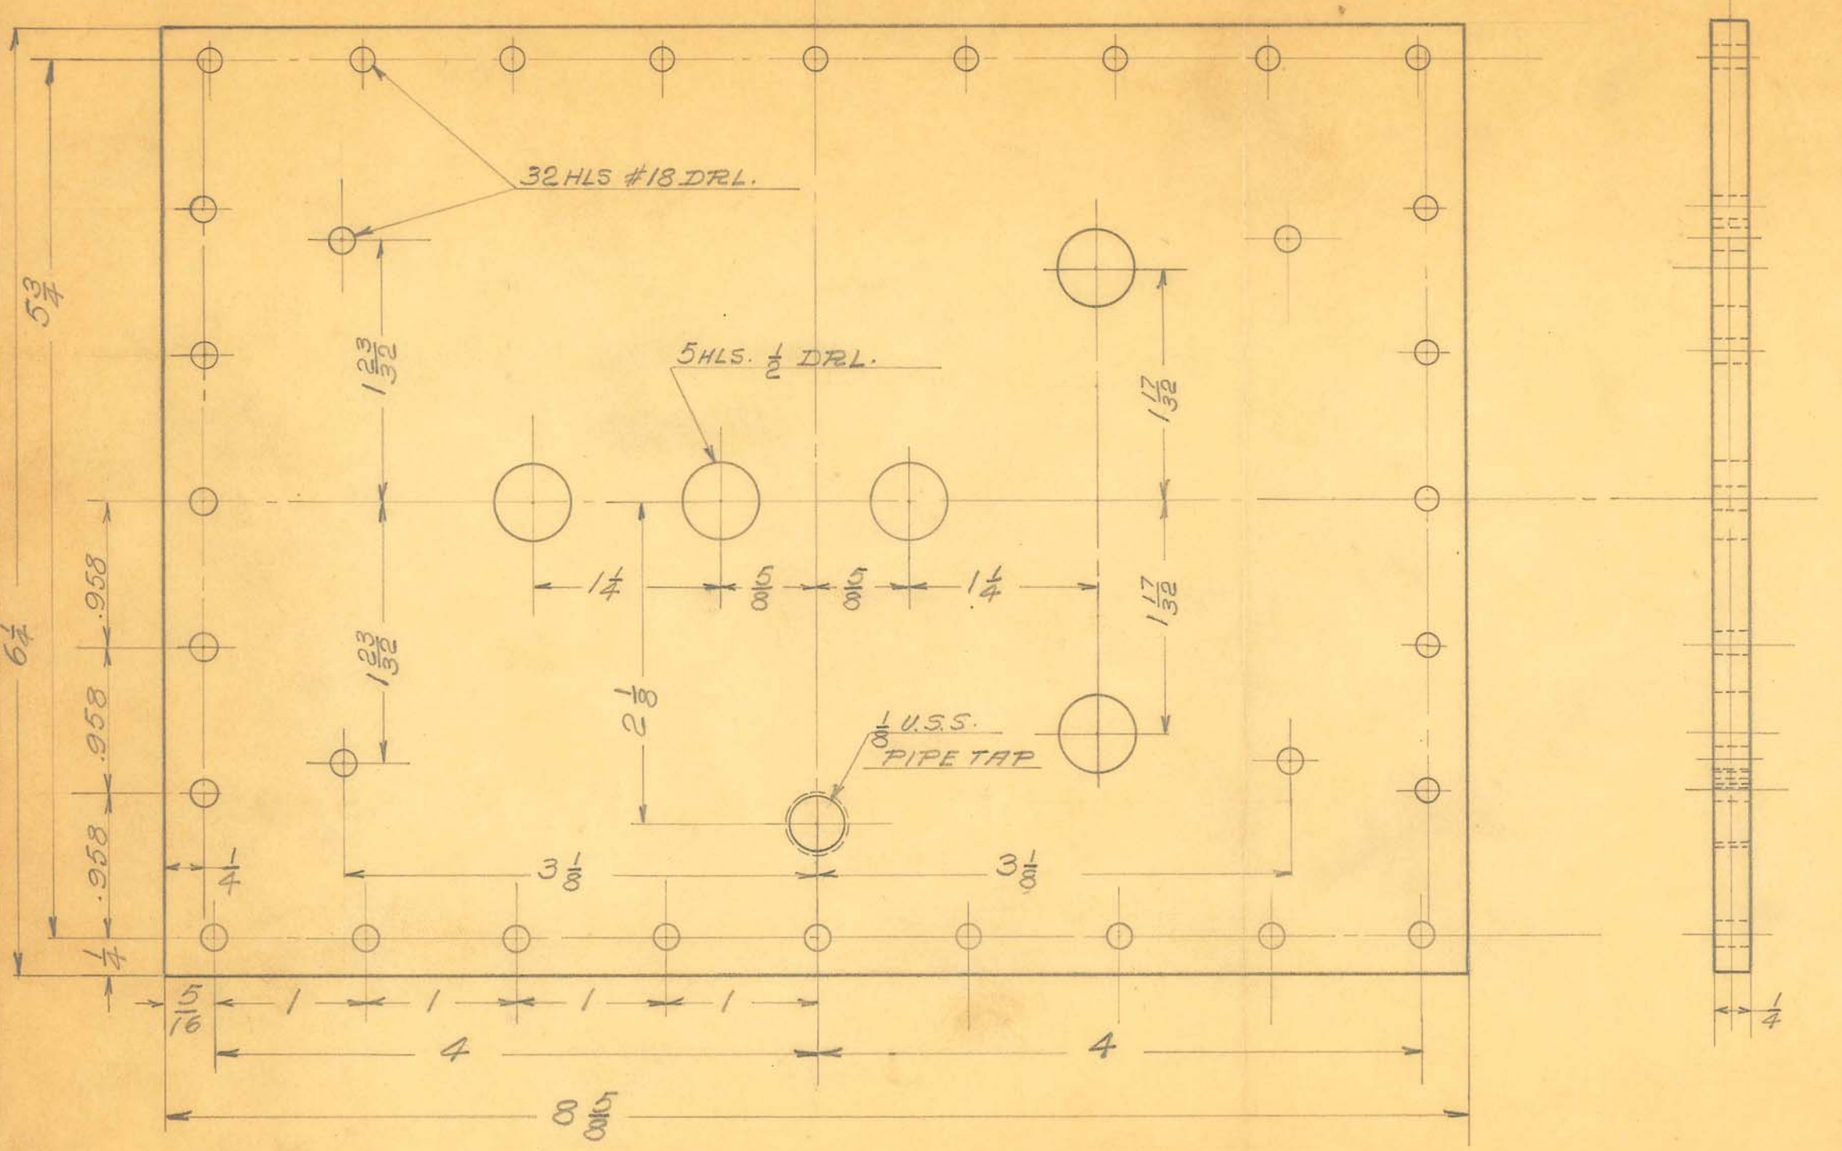

FIBER
1 REQ.
SCALE FULL SIZE

OBSOLETE

SIZE		ISSUE 10-20-30	Q.M.
KIND		CHANGED	
SHAPE		" "	
FINISH		" "	
TEMP.		" "	
PATT.		" "	

TITLE: "CDC" CONDENSER TANK COVER

H. G. FISCHER & CO.
2335 WABANSIA AVE.
CHICAGO, ILL.

CAT. NO.

PART NO. 7100 1/2

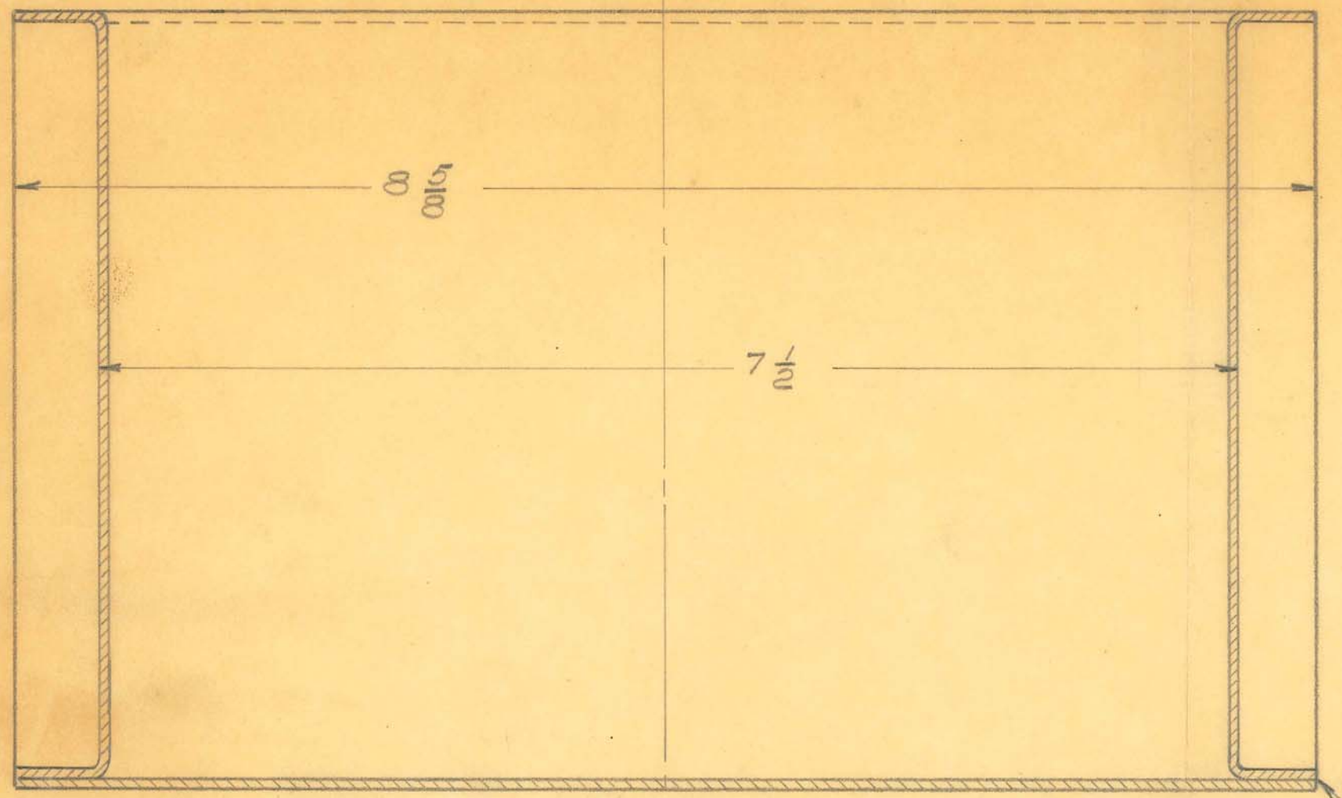

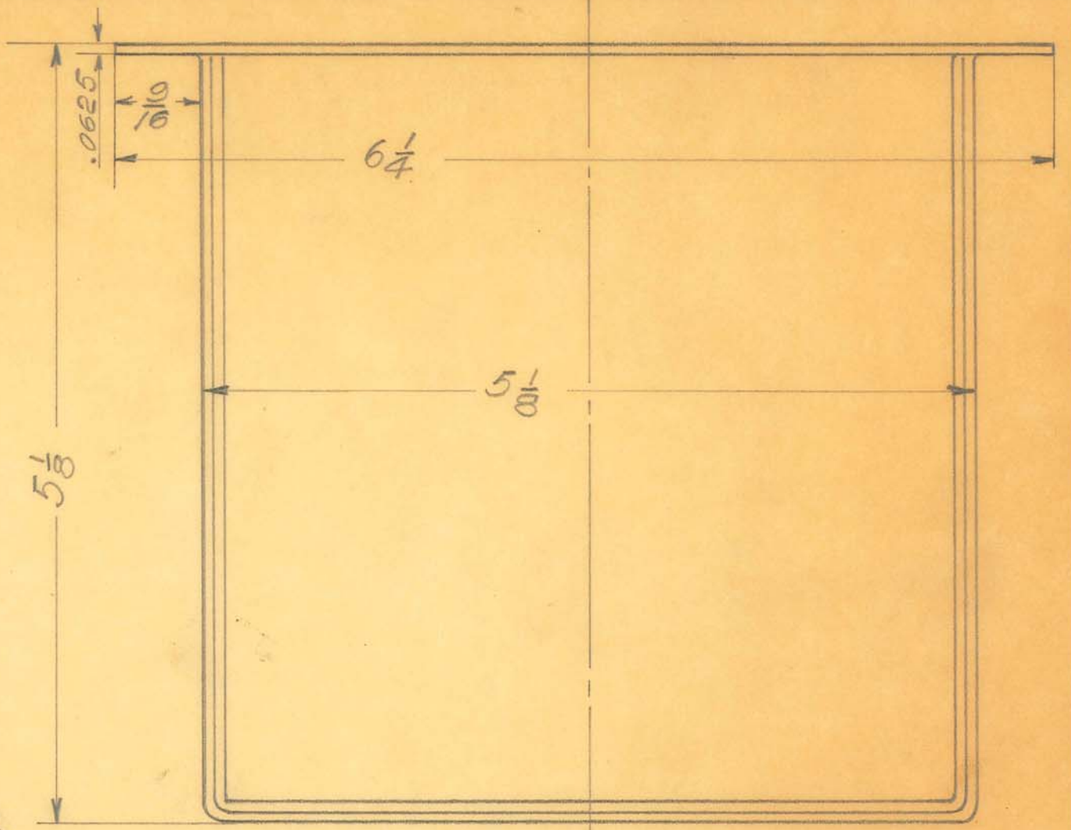

WELDED JOINT

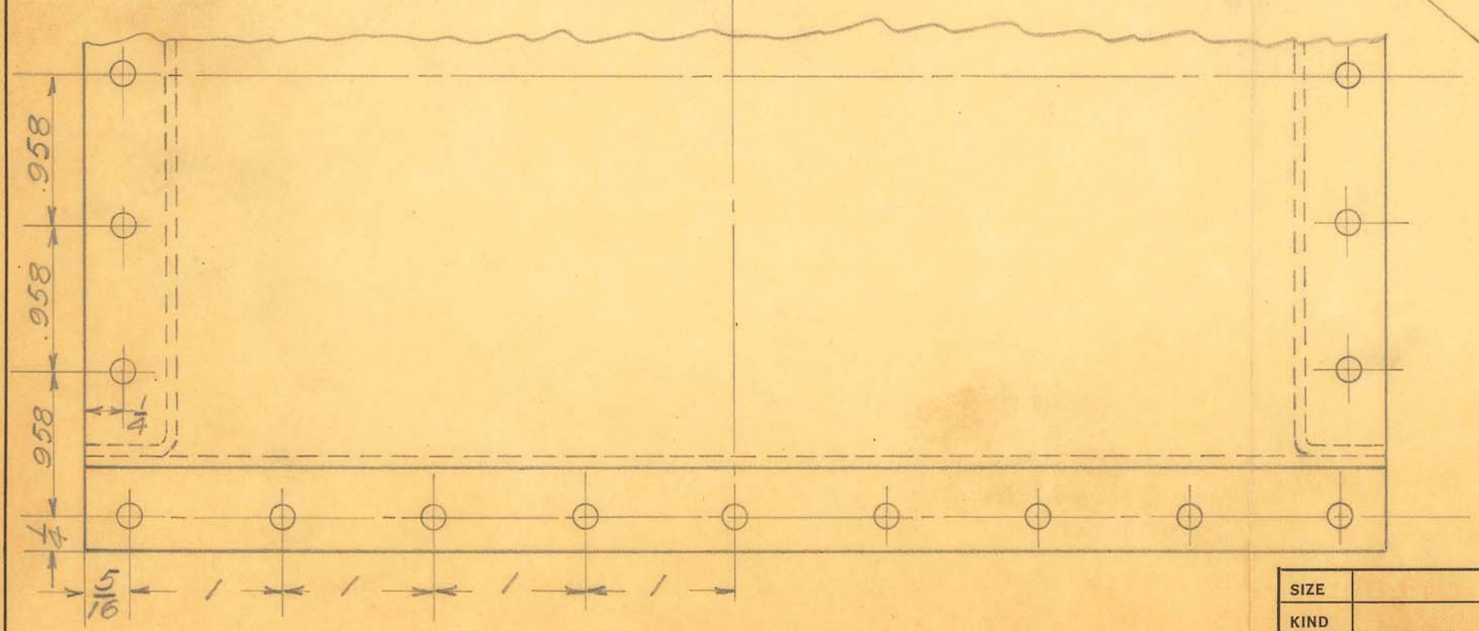

COLD ROLLED STEEL BOX ANNEALED AND PICKLED STOCK

1 REQ

SCALE FULL SIZE

OBSOLETE

SIZE		ISSUE 11-26-30	C.M.	TITLE: "CDC" CONDENSER TANK
KIND		CHANGED		
SHAPE		" "		
FINISH		" "		
TEMP.		" "		H. G. FISCHER & CO. 2335 WABANSIA AVE. CHICAGO, ILL. — CAT. NO. — PART NO. 7100
PATT.		" "		

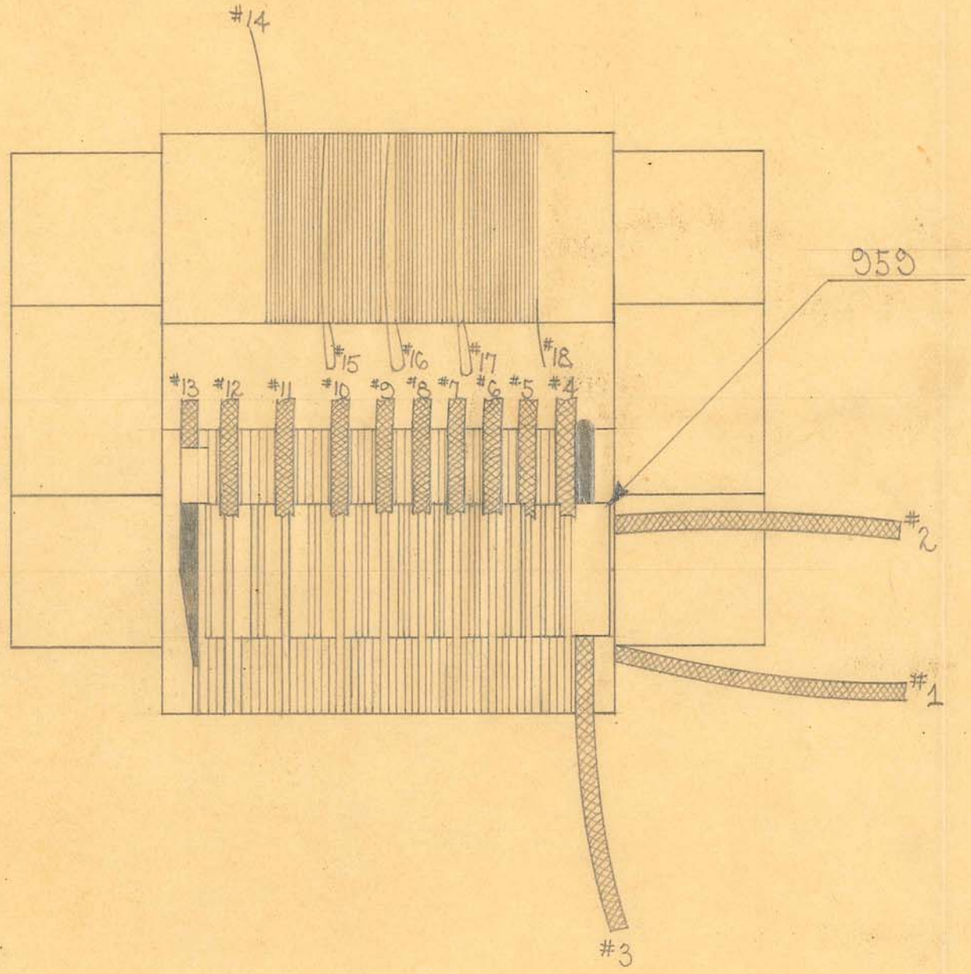

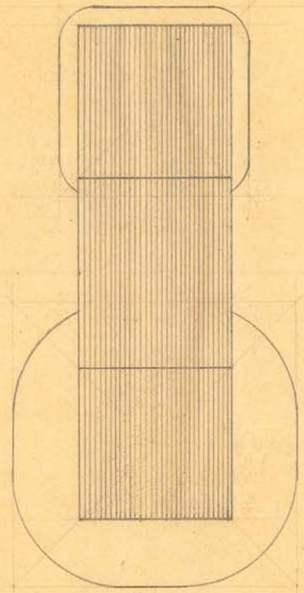

STEEL SIZES

PC. NO. 5043

CORE LAMS. CUT- 4"X1" BUILT UP TO 1"
END PCS. CUT- 2¼"X1"
BIND CORES WITH FRICTION TAPE.

WINDING DATA

PRIMARY

USE #24 ENAMEL WIRE
3 LAYERS OF 5020 FIBROID PAPER ON CORE.
ANCHOR LEAD #1 WITH FRICTION TAPE & WIND 600 TURNS & ANCHOR LEAD #2 WITH FRICTION TAPE.
1 LAYER OF PAPER BETWEEN EACH LAYER OF WIRE.
COVER PRI. WITH 3 LAYERS OF PAPER.

CAUTERY

USE #16 COTENAMEL WIRE
ANCHOR LEAD #3 WITH FRICTION TAPE & WIND 1 TURN & TAP-LEAD #4. WIND 2 TURNS & TAP-LEAD #5. WIND 2 TURNS & TAP-LEAD #6. WIND 3 TURNS & TAP-LEAD #7. WIND 3 TURNS & TAP-LEAD #8. WIND 4 TURNS & TAP-LEAD #9. WIND 5 TURNS & TAP-LEAD #10. WIND 6 TURNS & TAP-LEAD #11. WIND 7 TURNS & TAP-LEAD #12. WIND 8 TURNS & ANCHOR END WITH FRICTION TAPE-LEAD #13. TAPS #4 TO #12 INCL. EACH INSULATED WITH 1-959 FIBRE SEPARATOR. SHELLAC WINDING.

DIAGNOSTIC

USE #26 COTENAMEL WIRE
3 LAYERS OF 5020 FIBROID ON OTHER CORE.
ANCHOR LEAD #14 WITH LINEN TAPE & WIND 13 TURNS & BRING OUT TAP #15. WIND 15 TURNS & BRING OUT TAP #16. WIND 18 TURNS & BRING OUT TAP #17. WIND 21 TURNS & ANCHOR END WITH LINEN TAPE-LEAD #18.
LEADS #1-#13 INCL. ARE 1603-#18 STRANDED WIRE.
SHELLAC DIAGNOSTIC WINDING.

OBSOLETE

SIZE		ISSUE 6-6-32	A.E.	TITLE: "C" & "D" TRANSFORMER.
KIND		CHANGED		
SHAPE		" "		
FINISH		" "		
TEMP.		" "		H. G. FISCHER & CO. 2335 WABANSIA AVE. CHICAGO, ILL. — CAT. NO. — PART NO. 671G
PATT.		" "		

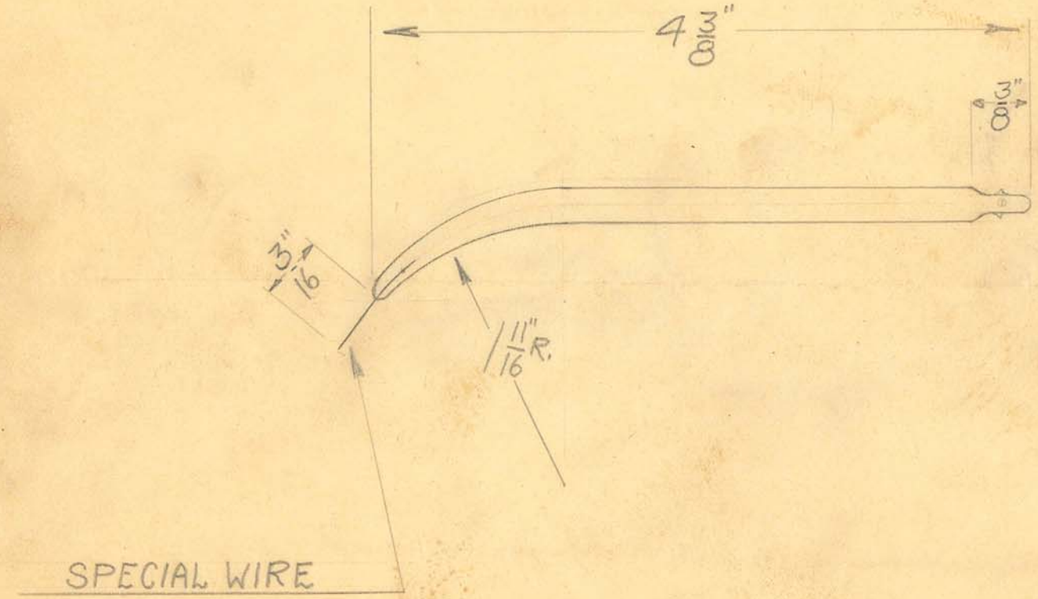

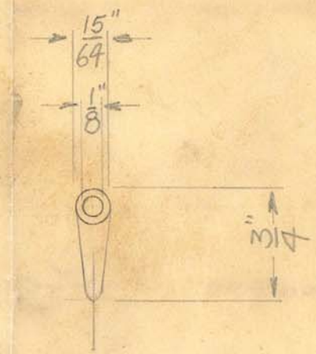

OBSOLETE

SIZE		ISSUE	7-21-38
KIND	GLASS CAP.	CHANGED	
SHAPE	RD. TUBE	" "	
FINISH		" "	
TEMP.		" "	
PATT.		" "	

TITLE: HIGH VOLTAGE FULG. ELECT. GLASS ELECTRODE

H. G. FISCHER & CO.
2335 WABANSIA AVE.
CHICAGO, ILL.

CAT. NO.

PART NO. 7590

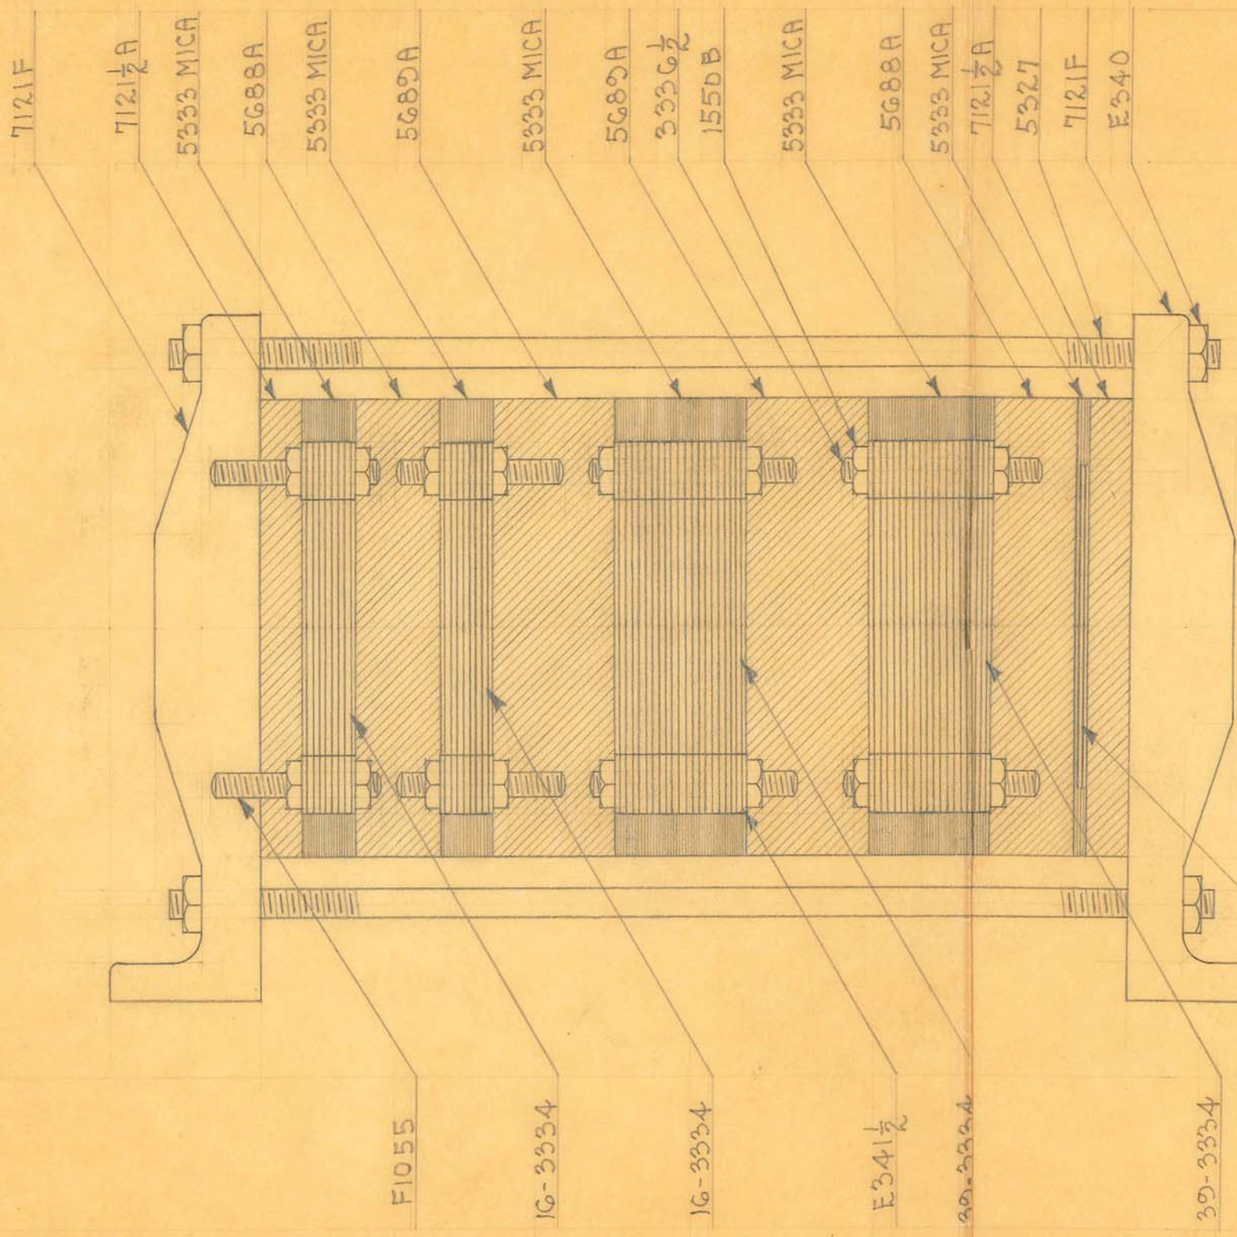

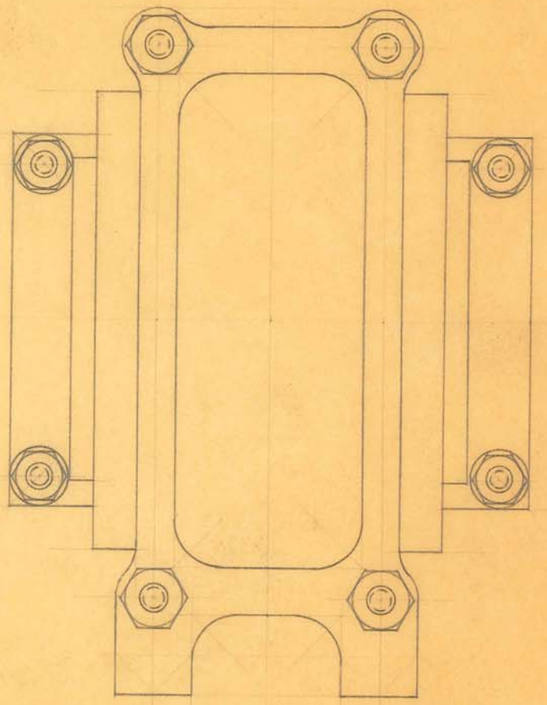

NOTE:-

MICA SPLIT TO .012" (4-7 SHEETS)

2-16 PLATE CONNS. 2-39 PLATE CONNS. JIG # 4126

1-3 PLATE GRN. CONN.

CONN. BUILDING FIXTURE TOOL # 3229. GAUGE # 3230-3231

2D PLATE SIDE OF EACH 39 PLATE CONN. SHOULD BE BOTH ON SAME SIDE

SIZE		ISSUE 2-18-32	2.E.	TITLE: COMBINATION "NEURISCO" CONDENSER ASSEM.
KIND		CHANGED		OBSOLETE
SHAPE		" "		
FINISH		" "		
TEMP.		" "		H. G. FISCHER & CO. 2335 WABANSIA AVE. CHICAGO, ILL.
PATT.		" "		CAT. NO.

PART NO. 3670½C

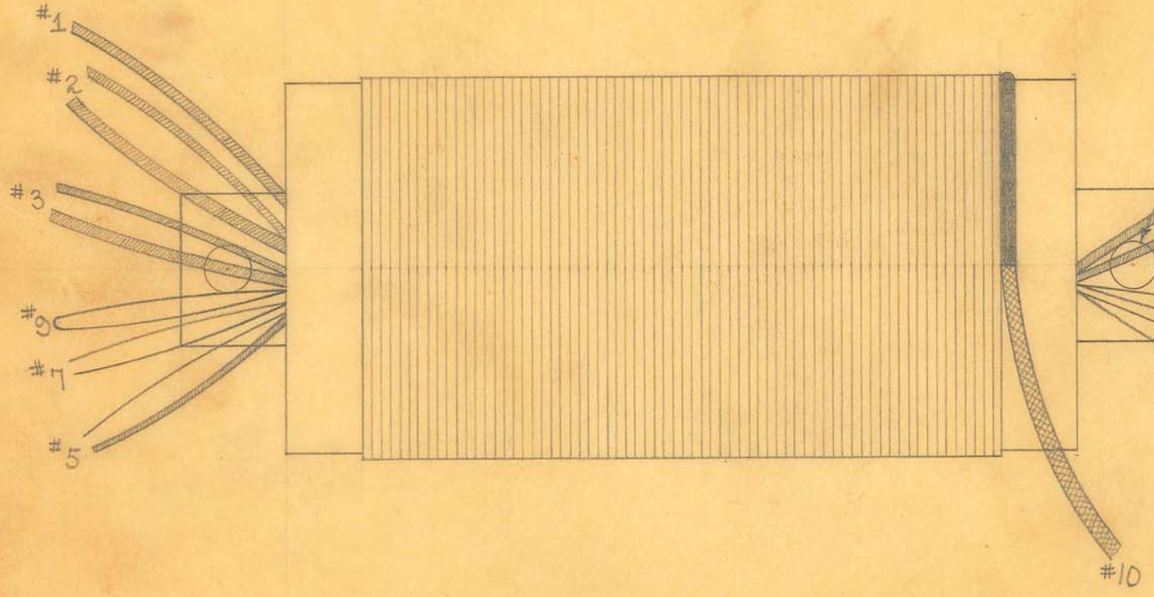

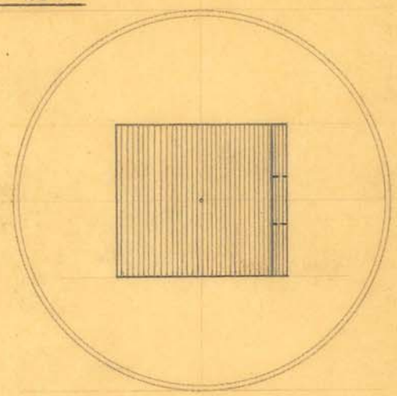

STEEL SIZES

PC. NO. 5043

CUT $5\frac{1}{4}$" X 1" BUILT UP TO 1"
CUT $6\frac{5}{8}$" X 1" BUILT UP TO $\frac{1}{8}$"
BIND CORE WITH FRICTION TAPE

WINDING DATA

3 LAYERS OF 5021 FIBROID PAPER ON CORE. ANCHOR LEAD #1 WITH FRICTION TAPE & WIND 2 LAYERS OF #14 COTENAMEL WIRE. END #14 C.E. & START #16 COTENAMEL WIRE WITH TAP #2. ANCHOR WITH LINEN TAPE & WIND 2 LAYERS. END #16 C.E. & START #18 COTENAMEL WIRE WITH TAP #3. ANCHOR WITH LINEN TAPE & WIND 1 LAYER AND BRING OUT TAP #4. WIND 1 LAYER AND END #18 C.E. & START #20 ENAMEL WIRE WITH TAP #5. ANCHOR WITH LINEN TAPE & WIND 1 LAYER AND BRING OUT TAP #6. WIND 1 LAYER AND END #20 E. & START #22 E. WIRE WITH TAP #7. ANCHOR WITH LINEN TAPE & WIND 1 LAYER AND BRING OUT TAP #8. WIND 1 LAYER & BRING TAP #9. WIND 1 LAYER & END WITH 1603-#18 STRANDED WIRE - LEAD #10. ANCHOR WITH LINEN TAPE & TAPE CONNECTION WITH FRICTION TAPE. COVER LAST LAYER WITH SHELLAC. 1 LAYER OF 5021 FIBROID PAPER BETWEEN EACH LAYER OF WIRE. LEADS & TAPS ABOUT 13" LONG.

OBSOLETE

SIZE		ISSUE 3-20-32	N.E.
KIND		CHANGED	
SHAPE		" "	
FINISH		" "	
TEMP.		" "	
PATT.		" "	

TITLE: T. P. PORT. IIA. LINE CHOKE

H. G. FISCHER & CO.
2335 WABANSIA AVE.
CHICAGO, ILL.

CAT. NO.

PART NO. 36930

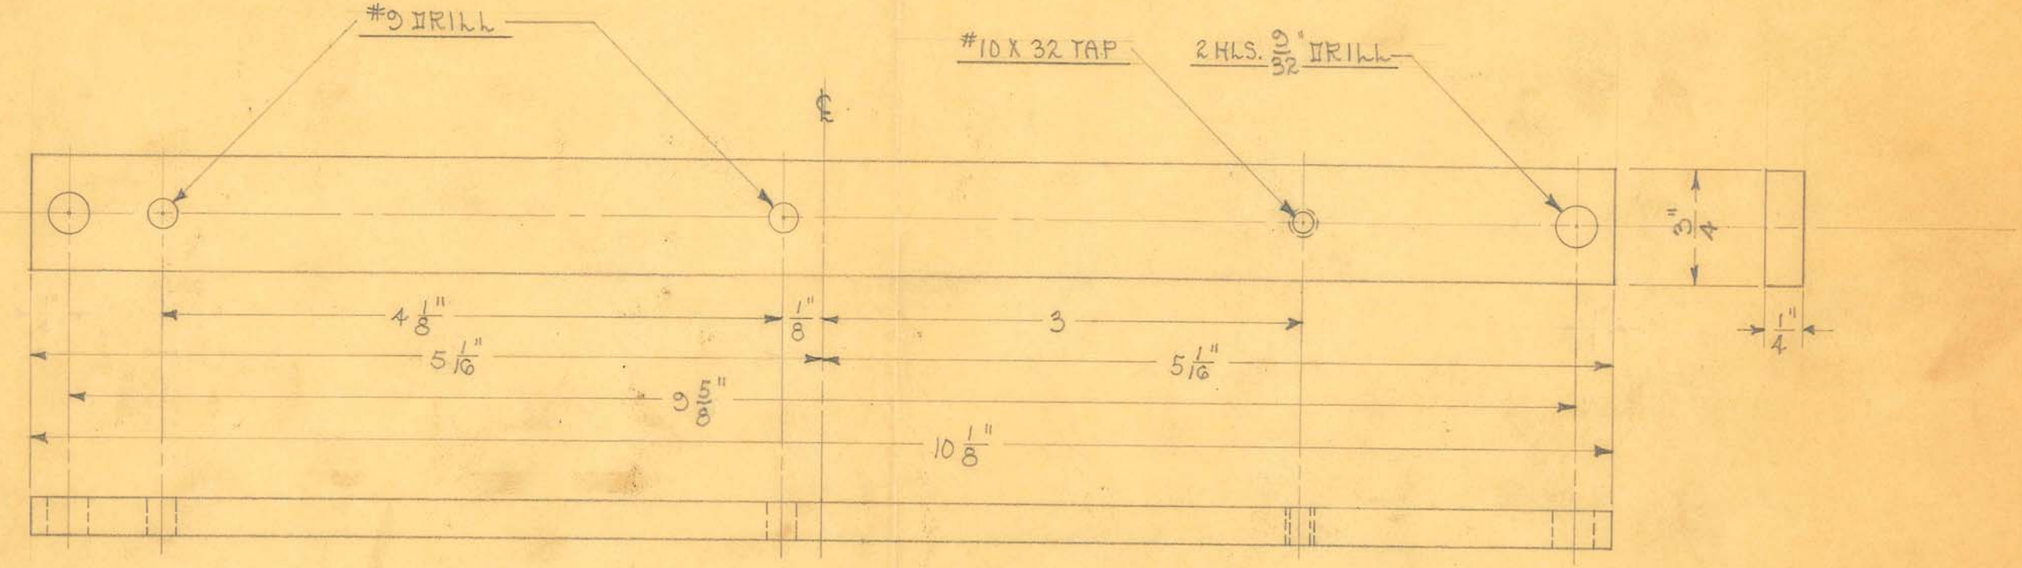

SCALE ~ FULL SIZE
1 REQUIRED

OBSOLETE

SIZE	1/4" X 3/4"	ISSUE 9-28-31	A.E.	TITLE: COAG. OUTFIT TRANS. & CONDENSER SUPP. STRIP
KIND	C.R. STEEL	CHANGED		
SHAPE		" "		
FINISH	BLACK DIP	" "		
TEMP.		" "		
PATT.		" "		

H. G. FISCHER & CO.
2335 WABANSIA AVE.
CHICAGO, ILL.

CAT. NO.

PART NO. 6840

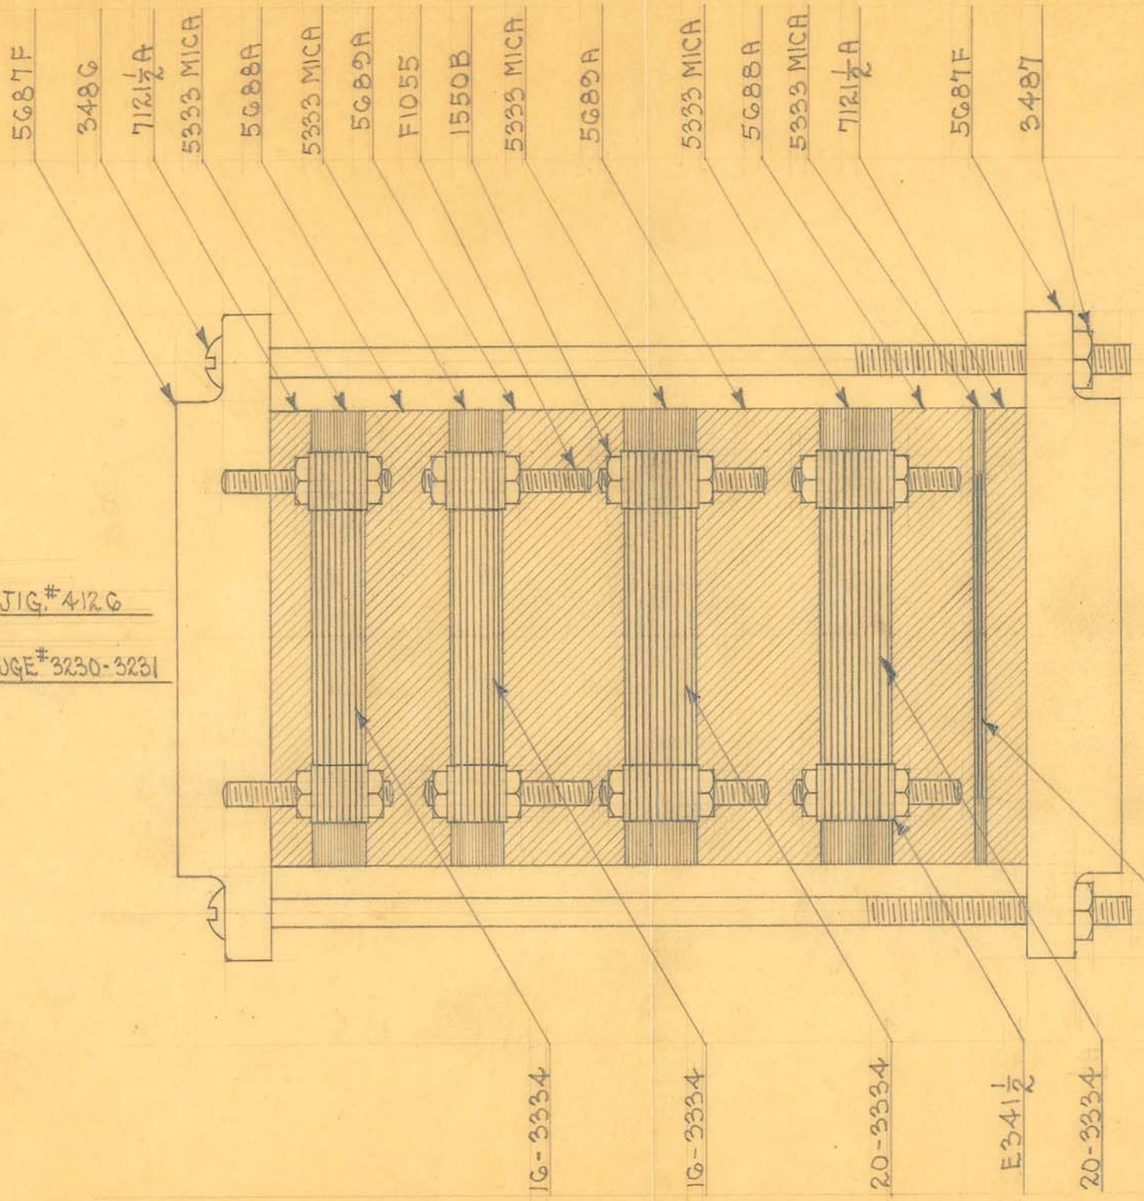

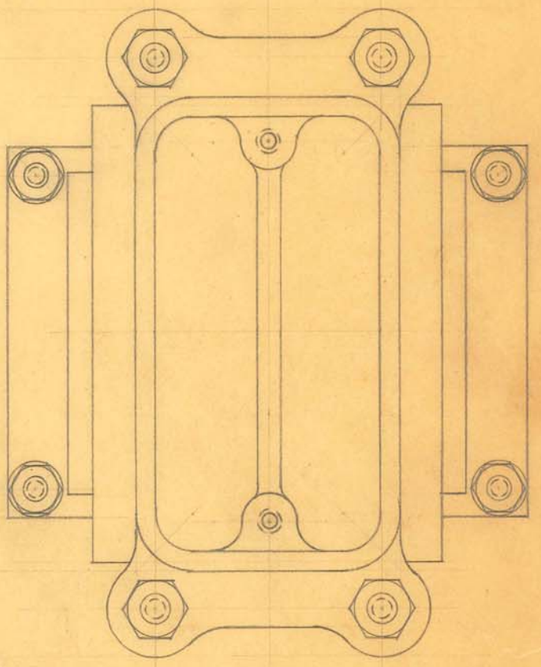

NOTE:-

MICA SPLIT TO .012" (4-7 SHEETS)

2-20 PLATE CONNS. 2-16 PLATE CONNS. JIG.# 4126

1-3 PLATE GRD. CONN.

CONN. BUILDING FIXTURE TOOL# 3229. GAUGE# 3230-3231

OBSOLETE

SIZE		ISSUE 2-15-32	A.E.	TITLE: COMBINATION "G" CONDENSER ASSEMBLY
KIND		CHANGED		
SHAPE		" "		
FINISH		" "		
TEMP.		" "		H. G. FISCHER & CO. 2335 WABANSIA AVE. CHICAGO, ILL. — CAT. NO. — PART NO. 5687G
PATT.		" "		

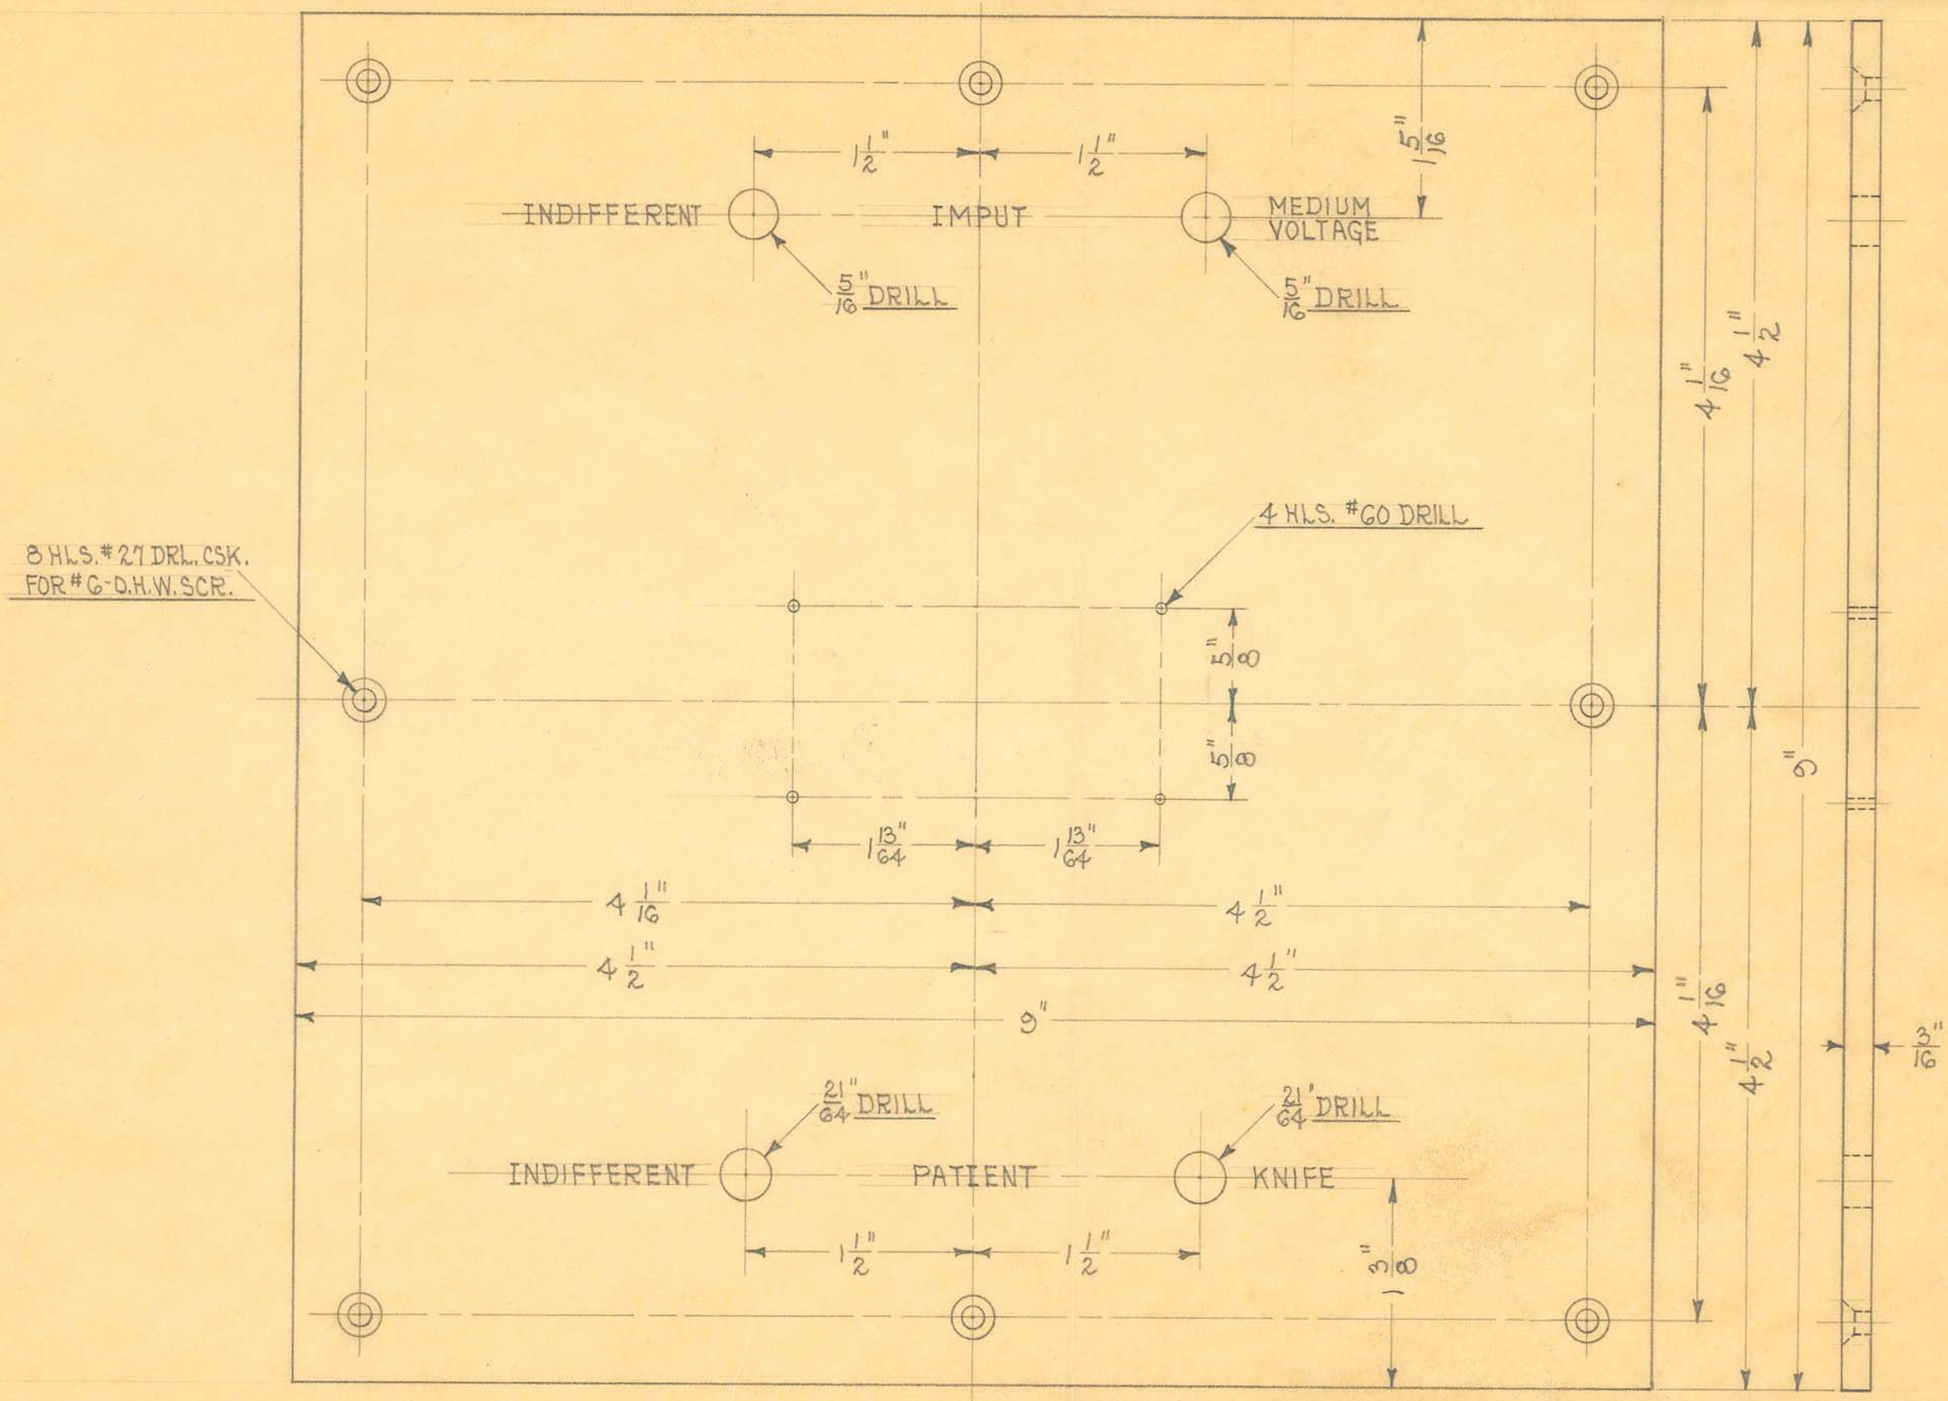

SIZE	9"X9"X3/16"	ISSUED	2-16-33	A.E.
KIND	BAKELITE	CHANGED		
SHAPE		" "		
FINISH		" "		
TEMP.		" "		
PATT.		" "		

TITLE: MOD. A", "G2 E" & "SPD" CUTTING ATTACHMENT PANEL

OBSOLETE

H. G. FISCHER & CO.
2335 WABANSIA AVE.
CHICAGO, ILL.

CAT. NO.

PART NO. 7702F

5 1/32"

5 1/4"

3 HLS. # 6 X 32 TAP

4 HLS. # 56 DRILL

1 13/16"

1 1/16" 1 1/16"

7/8"

PATENT APPLIED FOR

100 0 10 20 30 40 50 60 70 80 90

17/32"

13/16"

2 HLS. #18 DRILL

2 1/4" 2 1/4"

3/4" 3/4"

5/16"

PRE-ADJUSTMENT CONTACTOR

120° 120°

15/16" R.

3 5/8"

2 3/8"

2 HLS. #4 X 36 TAP

17/32" 17/32"

METER FUSE

3 5/8"

9 1/4"

1/4"

3/8"

4 HLS. 21/64" DRILL

2 HLS. #18 DRILL

11/16" 11/16"

OFF ON

3/8" 3/8"

1/16"

LINE SWITCH

1 3/16" 1 3/16"

2 3/8"

2 HLS. #27 DRL. CSK. FROM OTHER SIDE FOR #6 X 32 F.H. SCR.

2 1/16"

INDIFFERENT LOW MEDIUM HIGH

TERMINAL VOLTAGE VOLTAGE VOLTAGE

1 1/2"

6 HLS. # 27 DRL. CSK. FOR # 6 F. H. D. WOOD SCR.

5/16"

1 1/2" 3/4" 3/4" 1 1/2"

7 5/8" 7 5/8"

9 3/8" 9 3/8"

18 3/4"

OBSOLETE

SCALE ÷ 3/4" = 1"

SIZE	9 1/4" X 18 3/4" X 1/4"	ISSUE 6-2-34	H.E.	
KIND	RICHELAIN	CHANGED		
~~SHADE~~	BAKELITE	" "		
FINISH		" "		
TEMP.		" "		
PATT.		" "		

TITLE:
CHASSIS STYLE MODEL "H" OUTFIT PANEL
(DRILLED & ENGRAVED)

H. G. FISCHER & CO.
2335 WABANSIA AVE.
CHICAGO, ILL.

CAT. NO.

PART NO. 7453 AF

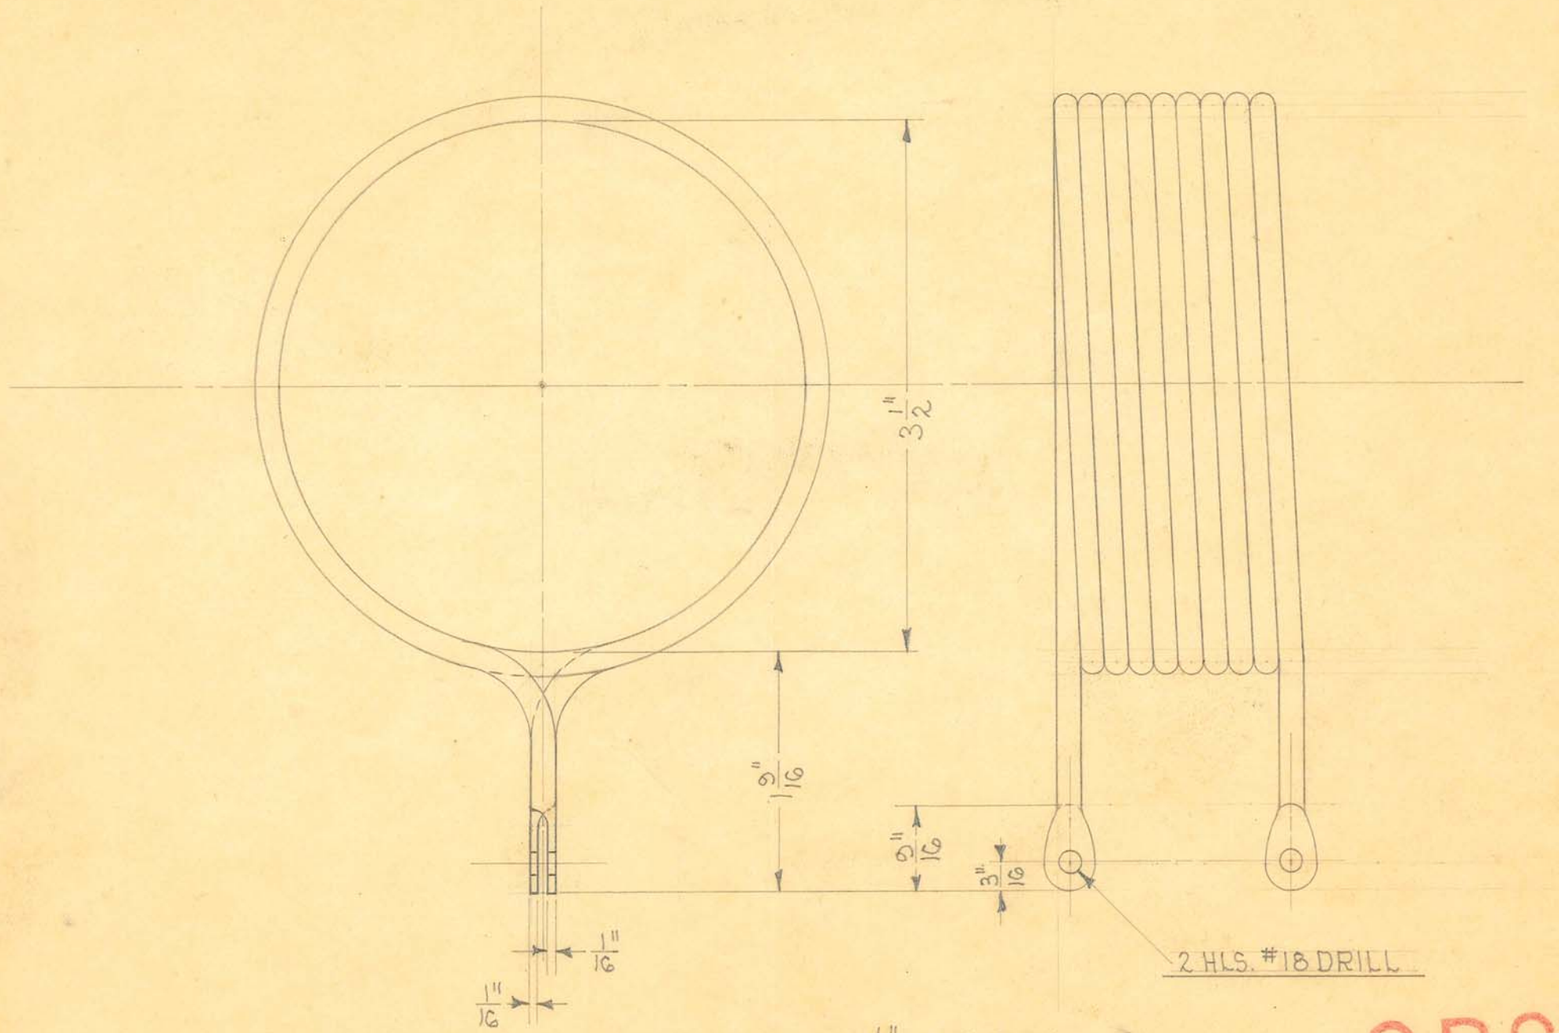

9 TURNS WOUND ON 3¼" O.D. MANDREL
1 REQUIRED

OBSOLETE

SIZE	#6 BARE	ISSUE 7-6-34	A.E.
KIND	COPPER WIRE	CHANGED	
SHAPE		" "	
FINISH	SILVER PLATE	" "	
TEMP.		" "	
PATT.		" "	

TITLE:
FISCHER MOD. "H" DIA. OUTFIT VARIOMETER
STATIONARY COIL

H. G. FISCHER & CO.
2335 WABANSIA AVE.
CHICAGO, ILL.

CAT. NO.

PART NO. 7467½

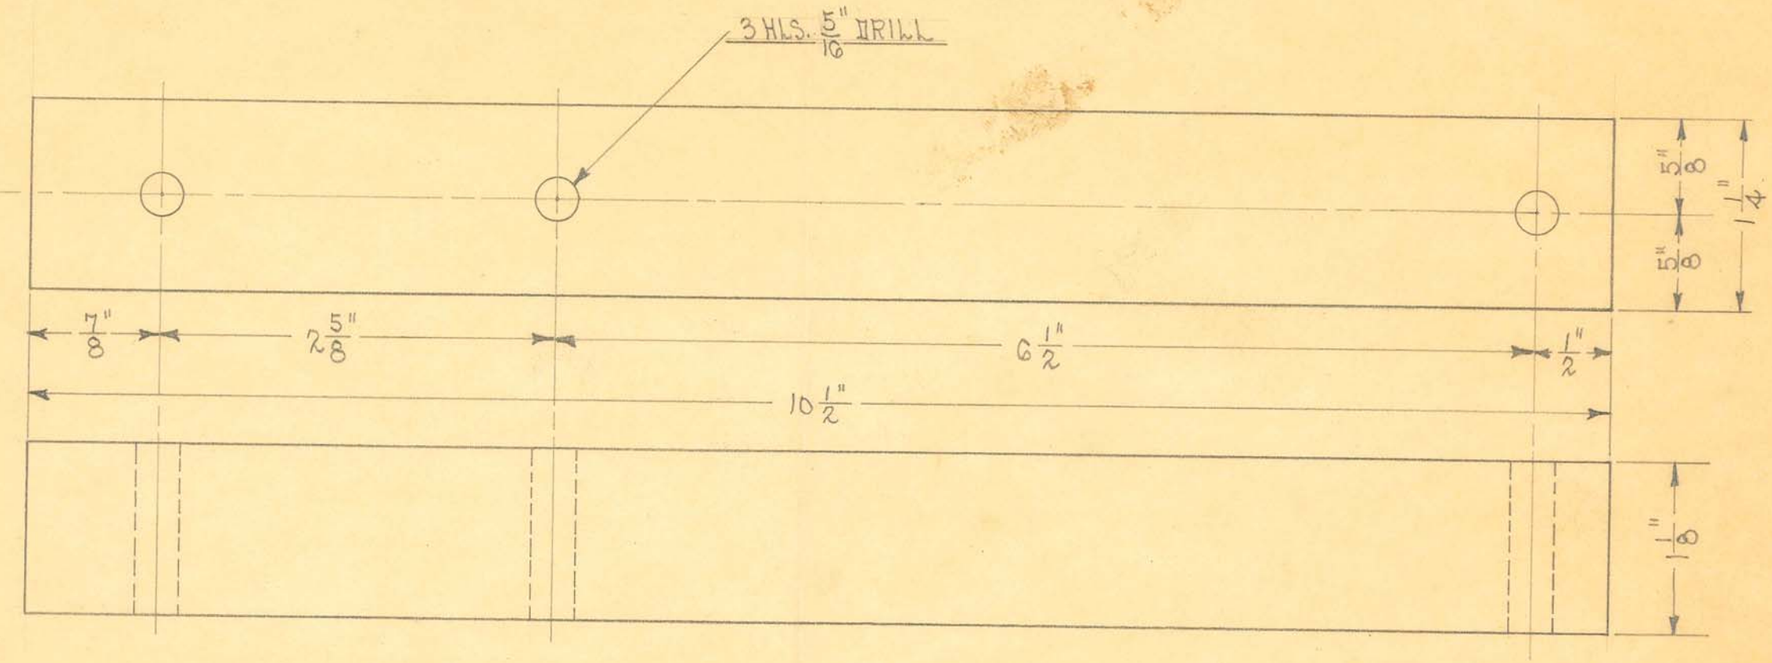

2 REQUIRED

OBSOLETE

SIZE	10½"X1¼"X1⅛"	ISSUE 10-22-32	W.E.	TITLE: FISCHER MOD. "H" DIA. OUTFIT TRANS. BLOCK-LOWER
KIND	H. WOOD	CHANGED		
SHAPE		" "		
FINISH		" "		
TEMP.		" "		
PATT.		" "		

H. G. FISCHER & CO.
2335 WABANSIA AVE.
CHICAGO, ILL.

CAT. NO.

PART NO. 7458F

14 – # 8 F.H. WOOD SCREWS 1" LONG
LOCATED AS SHOWN

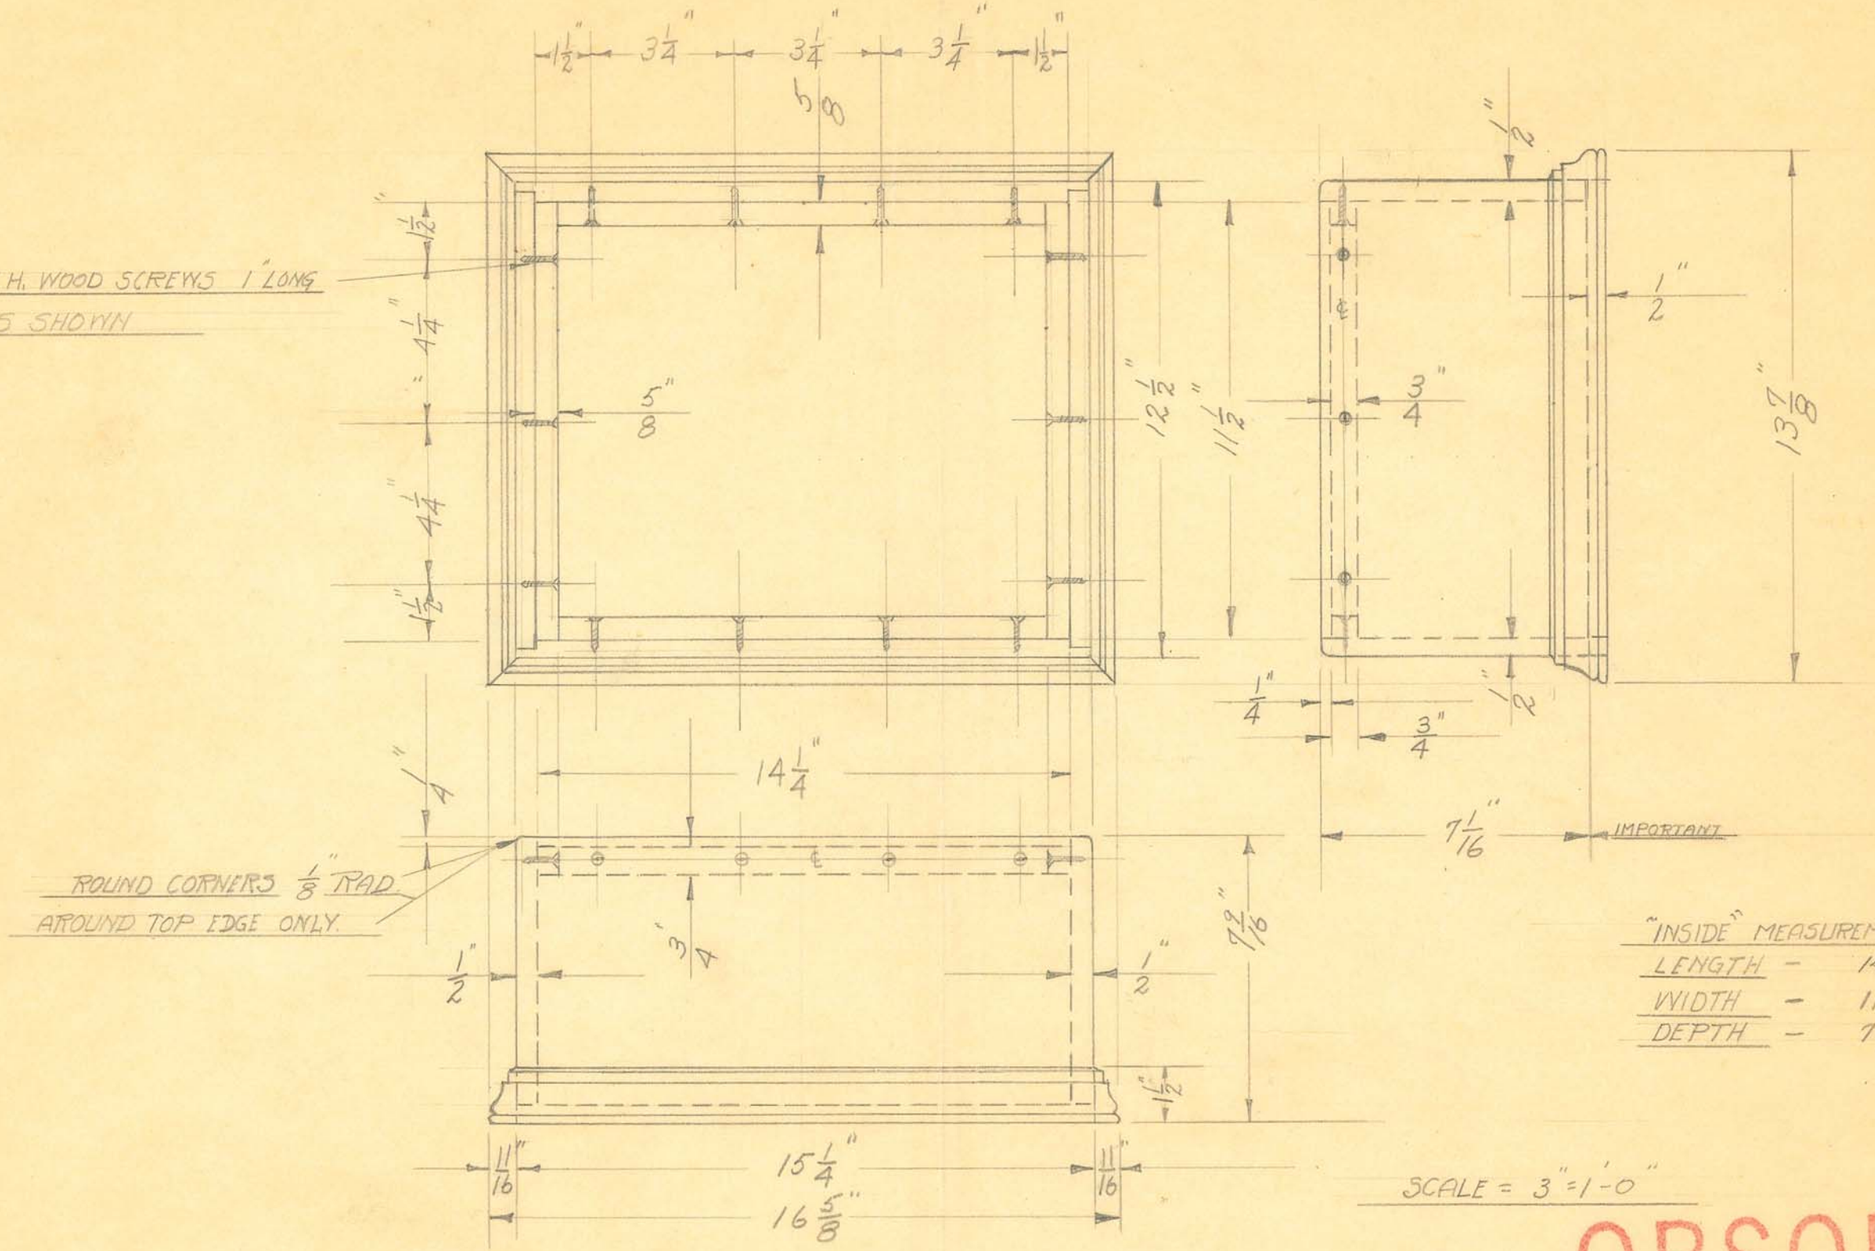

"INSIDE" MEASUREMENTS
LENGTH – 14¼"
WIDTH – 11½"
DEPTH – 7 1/16"

SCALE = 3" = 1'-0"

OBSOLETE

SIZE		ISSUE 9-18-33	N.P.
KIND		CHANGED	
SHAPE		" "	
FINISH		" "	
TEMP.		" "	
PATT.		" "	

TITLE: "CDM" OUTFIT CABINET

H. G. FISCHER & CO.
2335 WABANSIA AVE.
CHICAGO, ILL.

CAT. NO.

PART NO. 7901

10FT

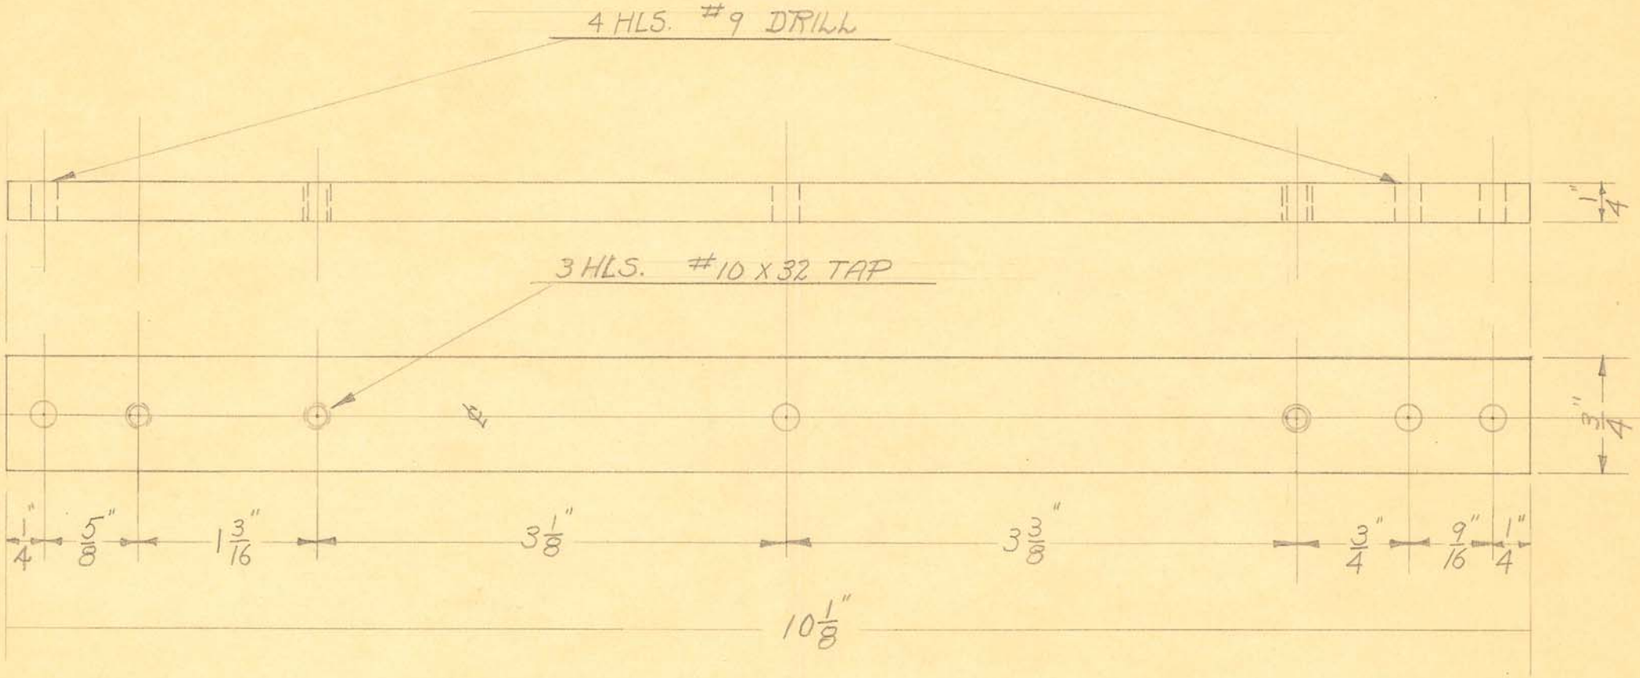

2 REQUIRED

OBSOLETE

SIZE	1/2 X 3/4 STRIP	ISSUE 7-20-33	N.P.
KIND	C.R. STEEL	CHANGED	
SHAPE		" "	
FINISH	BLK. LACQUER	" "	
TEMP.		" "	
PATT.		" "	

TITLE: MODEL "CDM" OUTFIT TRANS., CHOKE, GAP & COND. SUPPORT STRIP.

H. G. FISCHER & CO.
2335 WABANSIA AVE.
CHICAGO, ILL.

CAT. NO.

PART NO. 7905

7905

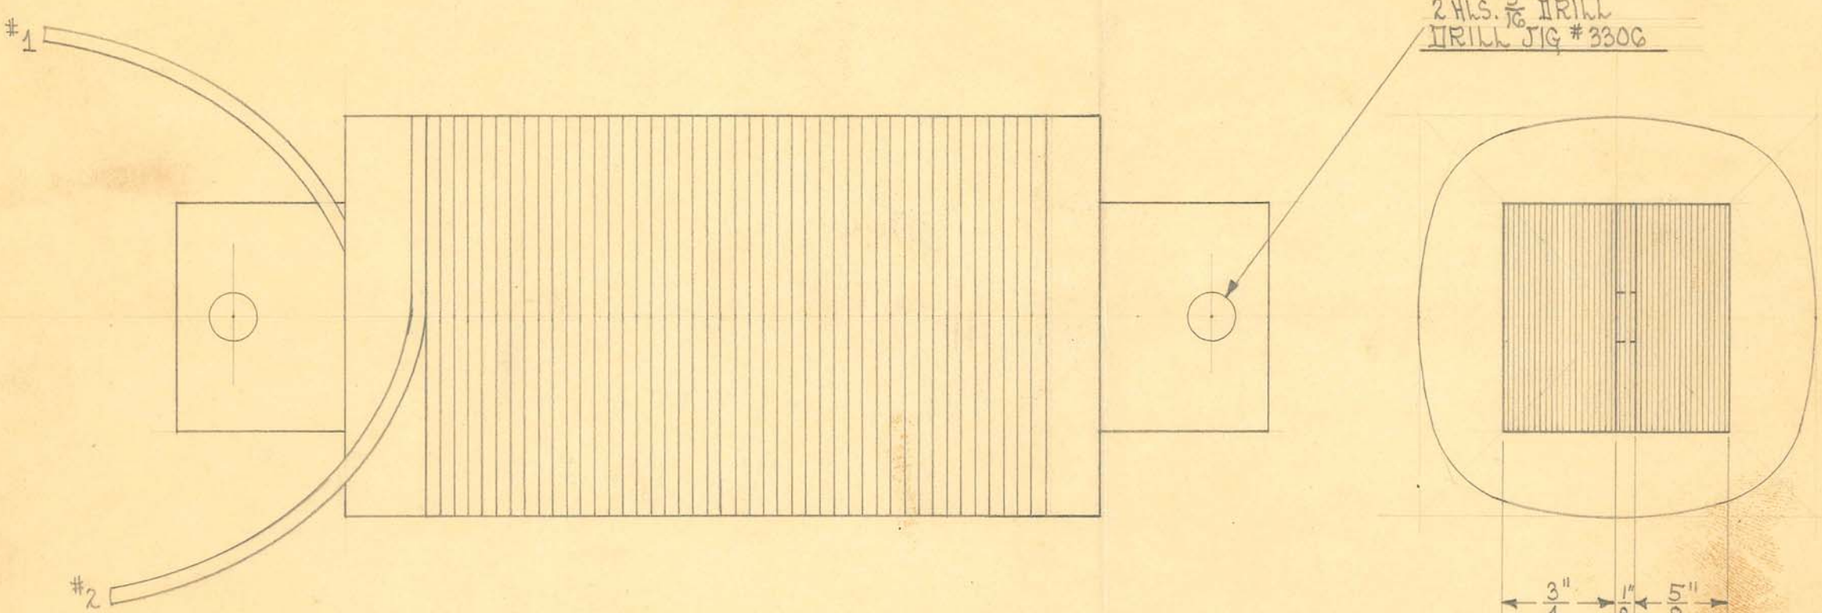

STEEL SIZES

Pc. No. 5043

CUT 6 PCS. 1½" X 7¼" & THE REST 1½" X 5 & BUILD UP TO 1½" AS SHOWN. BIND WITH FRICTION TAPE AND DRILL AS SHOWN.

WINDING DATA

#12 COTENAMEL WIRE

3 LAYERS OF 5021½ FIBROID PAPER ON CORE: ANCHOR LEAD #1 WITH FRICTION TAPE & WIND 190 TURNS WITH 1 LAYER OF 5021½" FIBROID PAPER BETWEEN EACH LAYER OF WIRE. ANCHOR END WITH LINEN TAPE-LEAD #2. COVER ENTIRE CHOKE WITH BLACK INSULATING VARNISH.

OBSOLETE

JIG 3306

SIZE		ISSUE 10-20-32	A.E.	TITLE: FISCHER MOD. "H" DIA. OUTFIT LINE CHOKE
KIND		CHANGED		
SHAPE		" "		
FINISH		" "		
TEMP.		" "		H. G. FISCHER & CO. 2335 WABANSIA AVE. CHICAGO, ILL. — CAT. NO. — PART NO. 7485G
PATT.		" "		

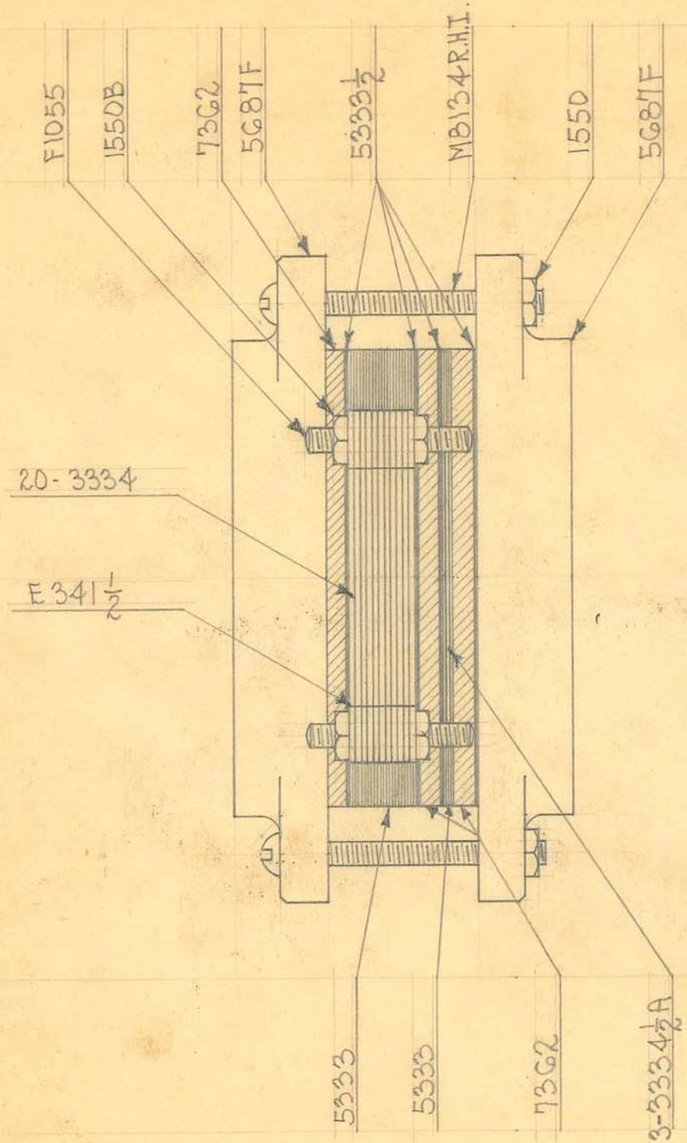

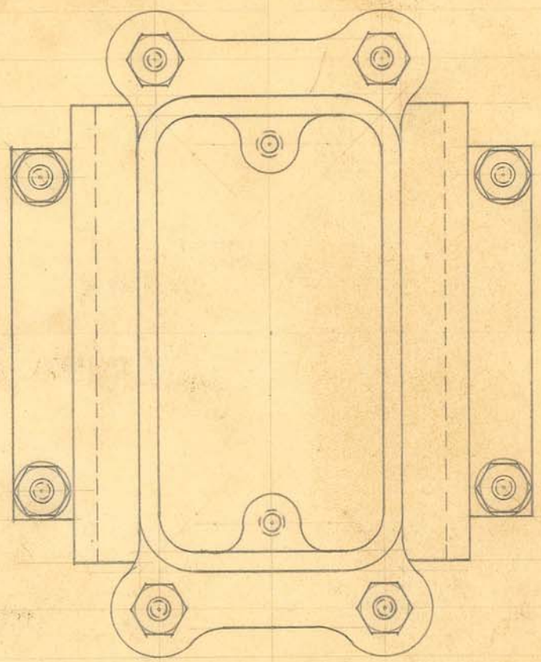

OBSOLETE

NOTE:-

5333 MICA SPLIT TO .012"

5333½ MICA SINGLE SHEET ONLY

1-20 PLATE COND.

1-3 PLATE GRD. COND.

SIZE		ISSUE 7-19-32	J.E.
KIND		CHANGED	
SHAPE		" "	
FINISH		" "	
TEMP.		" "	
PATT.		" "	

TITLE: FISCHER MODEL "H" IIA OUTFIT BLOCKING COND.

H. G. FISCHER & CO.
2335 WABANSIA AVE.
CHICAGO, ILL.

CAT. NO.

PART NO. 7477G

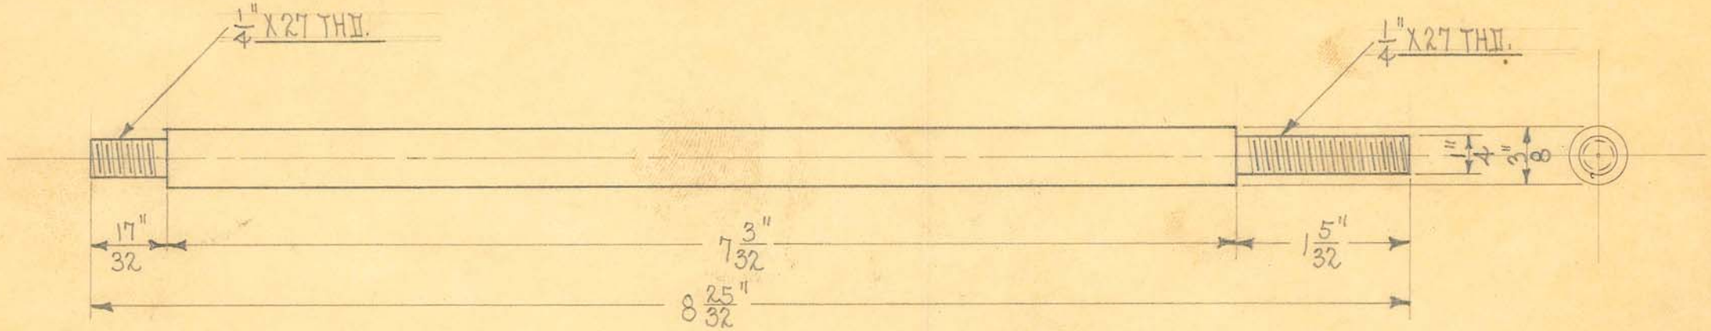

1 REQUIRED

OBSOLETE

SIZE	3/8"	ISSUE 9-19-32	A.E.	TITLE: FISCHER MODEL "H" DIA. OUTFIT VARIOMETER GUIDE ROD
KIND	BRASS ROD	CHANGED		
SHAPE		" "		
FINISH		" "		
TEMP.		" "		
PATT.		" "		

H. G. FISCHER & CO.
2335 WABANSIA AVE.
CHICAGO, ILL.

CAT. NO.

PART NO. 7472

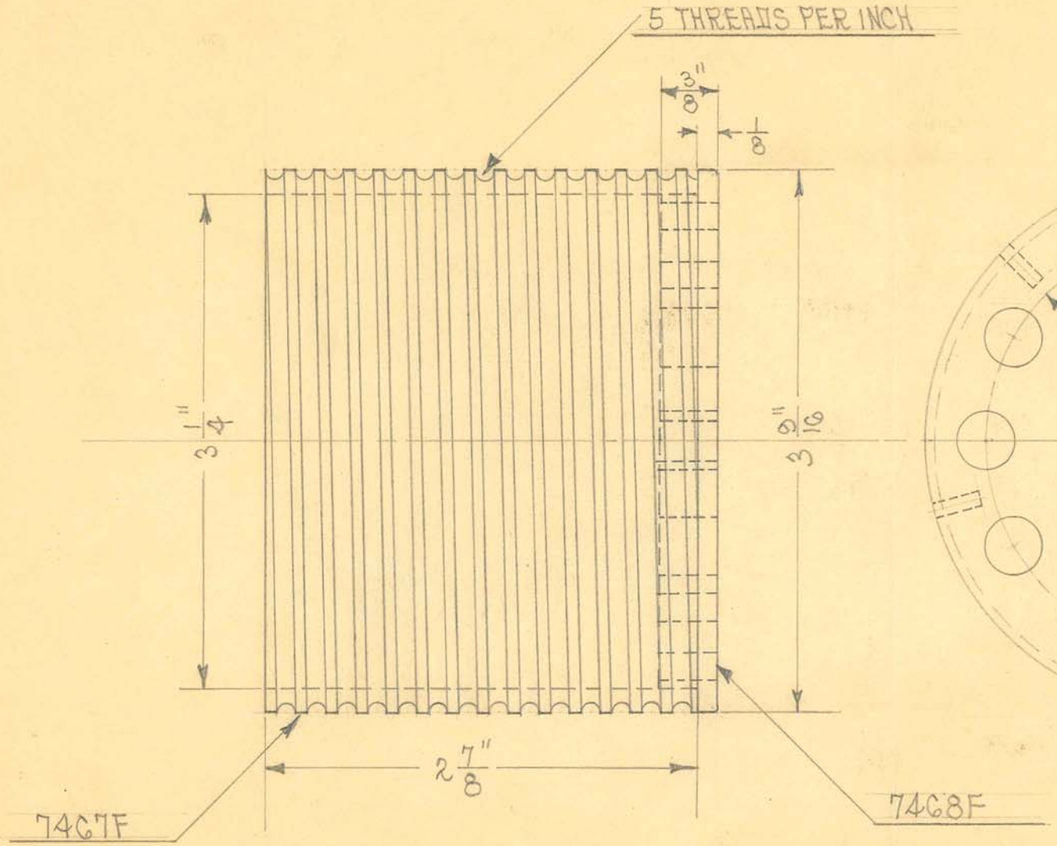

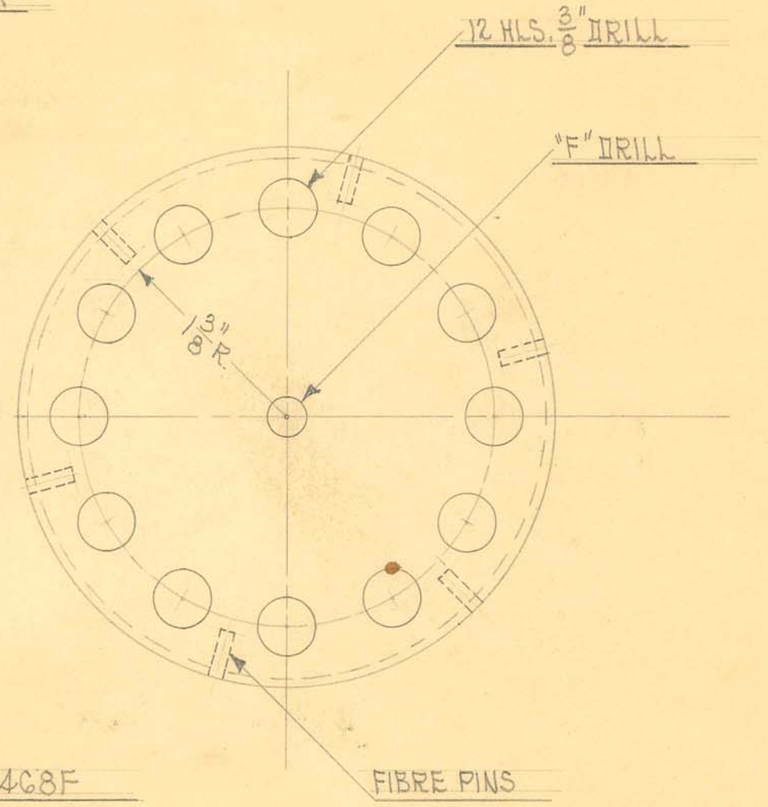

OBSOLETE

SIZE		ISSUE 10-25-32	A.E.	TITLE: FISCHER MOD. "H" DIA. OUTFIT VARIOMETER STATIONARY COIL TUBE ASSEM.
KIND		CHANGED		
SHAPE		" "		
FINISH		" "		
TEMP.		" "		H. G. FISCHER & CO. 2335 WABANSIA AVE. CHICAGO, ILL. — CAT. NO. — PART NO. 7467G
PATT.		" "		

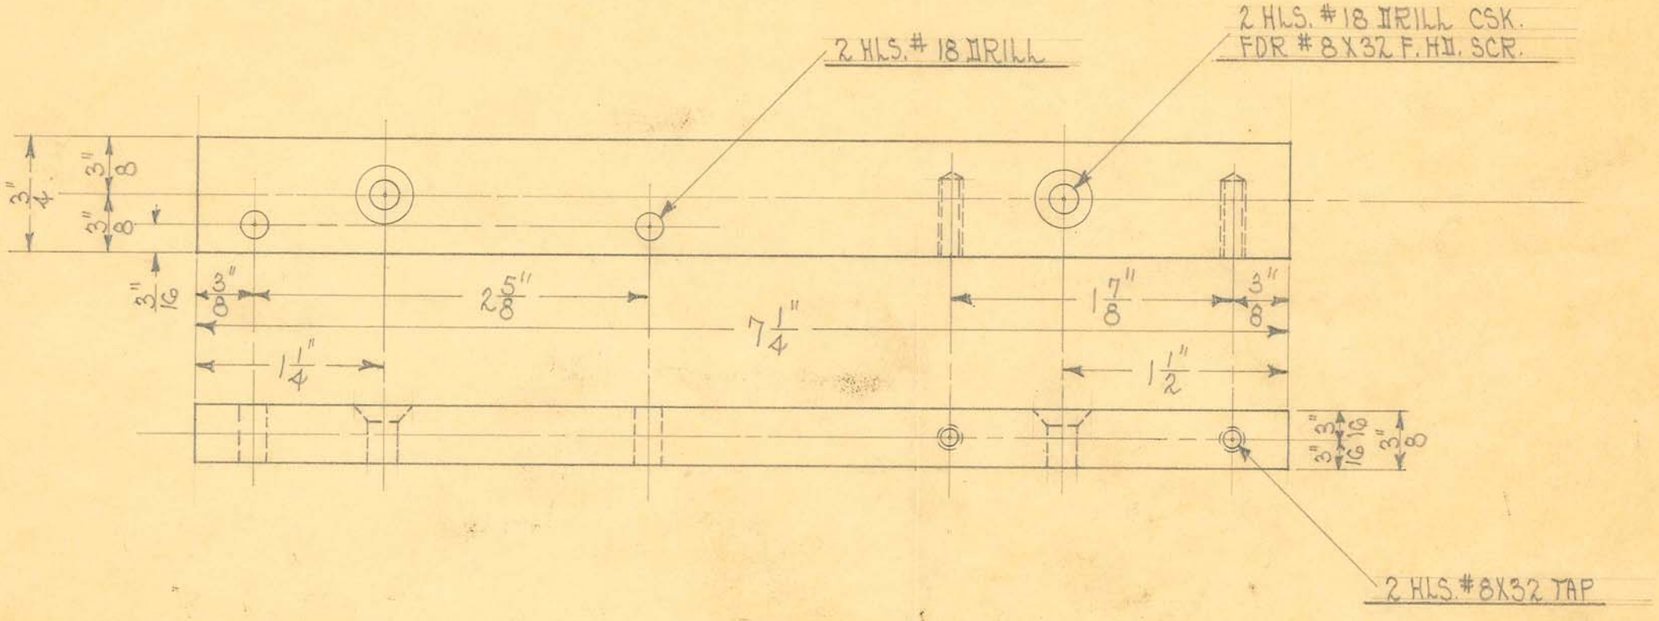

OBSOLETE

SIZE	3/8"	ISSUE 8-31-32	H.E.	TITLE: FISCHER MOD. "H" DIA. OUTFIT VARIOMETER TERM. STRIP
KIND	SHEET BAKELITE	CHANGED		
SHAPE		" "		
FINISH		" "		
TEMP.		" "		
PATT.		" "		

H. G. FISCHER & CO.
2335 WABANSIA AVE.
CHICAGO, ILL.

CAT. NO.

PART NO. 7463 1/2

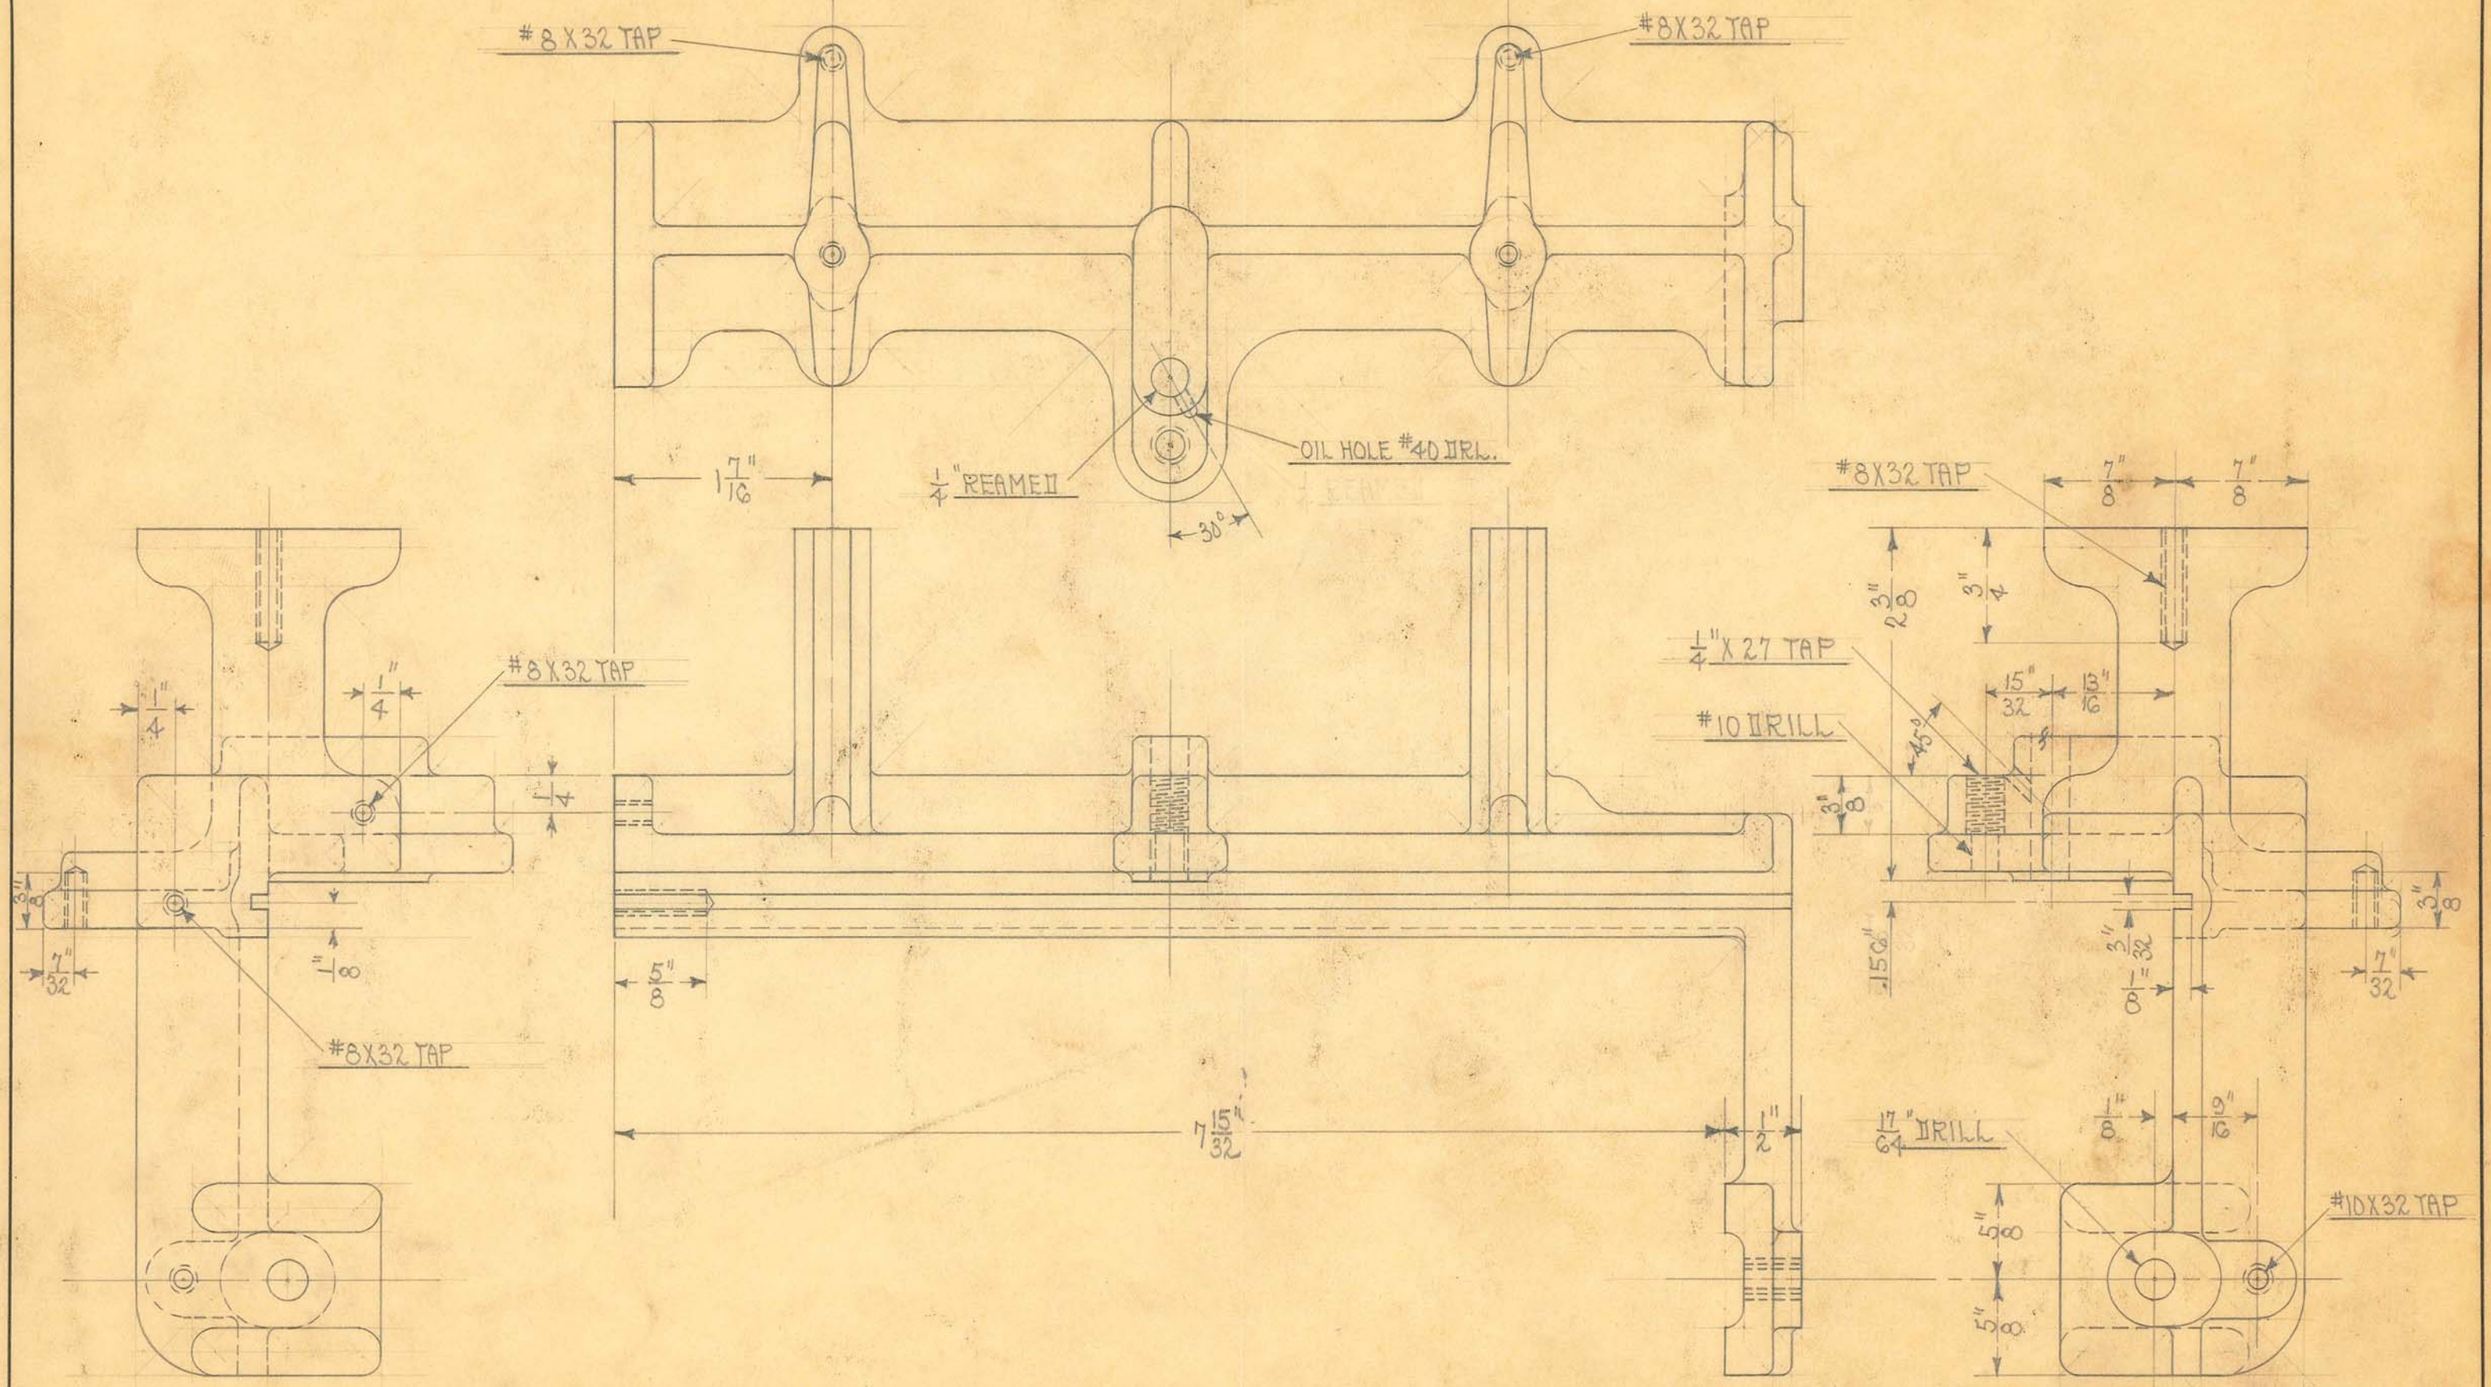

SIZE		ISSUED 9-9-32	J.E.	
KIND	ALUM. CASTING	CHANGED		
SHAPE		" "		
FINISH		" "		
TEMP.		" "		
PATT.		" "		

TITLE: FISCHER MODEL "H" DIA. OUTFIT VARIOMETER FRAME

OBSOLETE

H. G. FISCHER & CO.
2335 WABANSIA AVE.
CHICAGO, ILL.

CAT. NO.

PART NO. 7462F

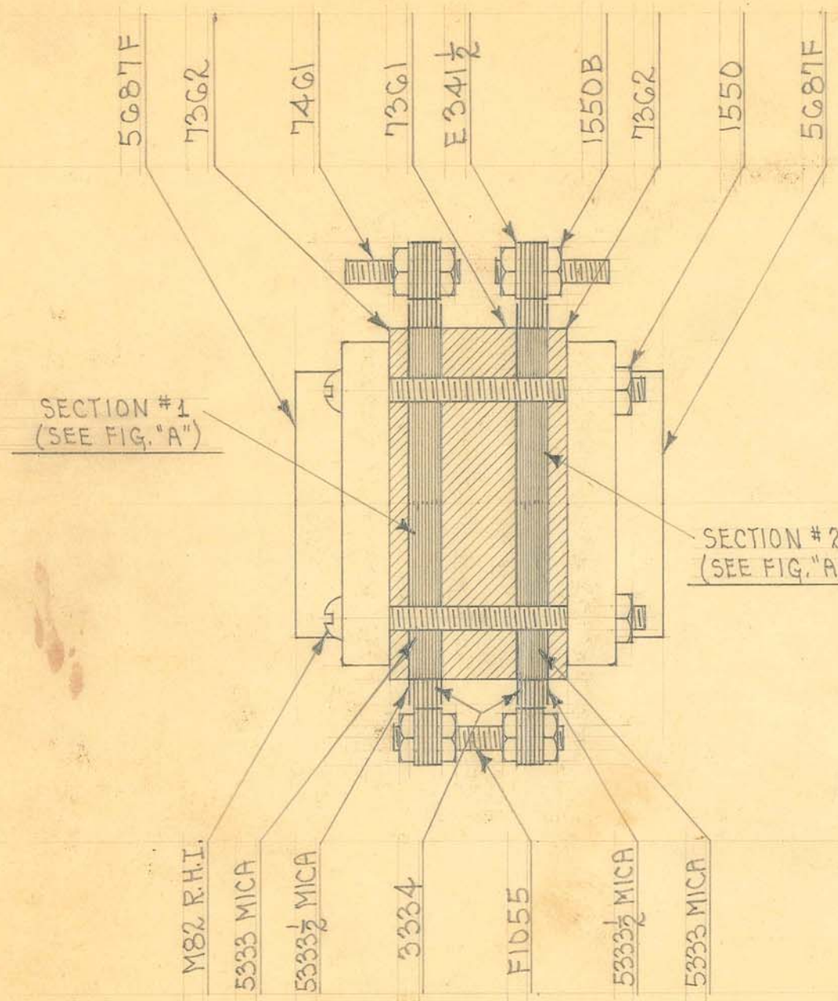

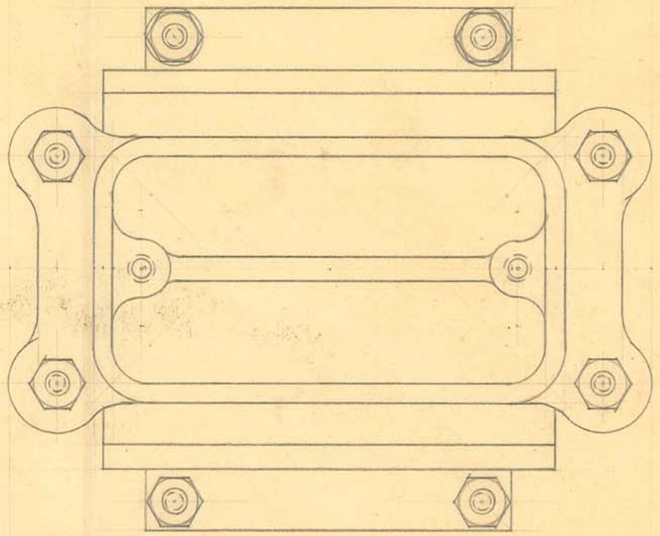

NOTE:-
5333 MICA SPLIT TO .006"
5333½ MICA - ONE SHEET ONLY
2-12 PLATE CONDS.

OBSOLETE

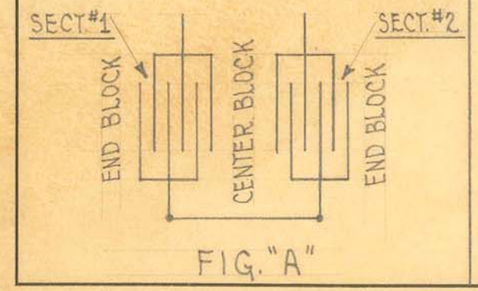

FIG. "A"

SIZE		ISSUE 7-14-32	H.E.	TITLE: FISCHER MODEL "H" DIA. OUTFIT OSCIL. CONN.
KIND		CHANGED		
SHAPE		" "		
FINISH		" "		
TEMP.		" "		H. G. FISCHER & CO. 2335 WABANSIA AVE. CHICAGO, ILL. / CAT. NO. / PART NO. 7460G
PATT.		" "		

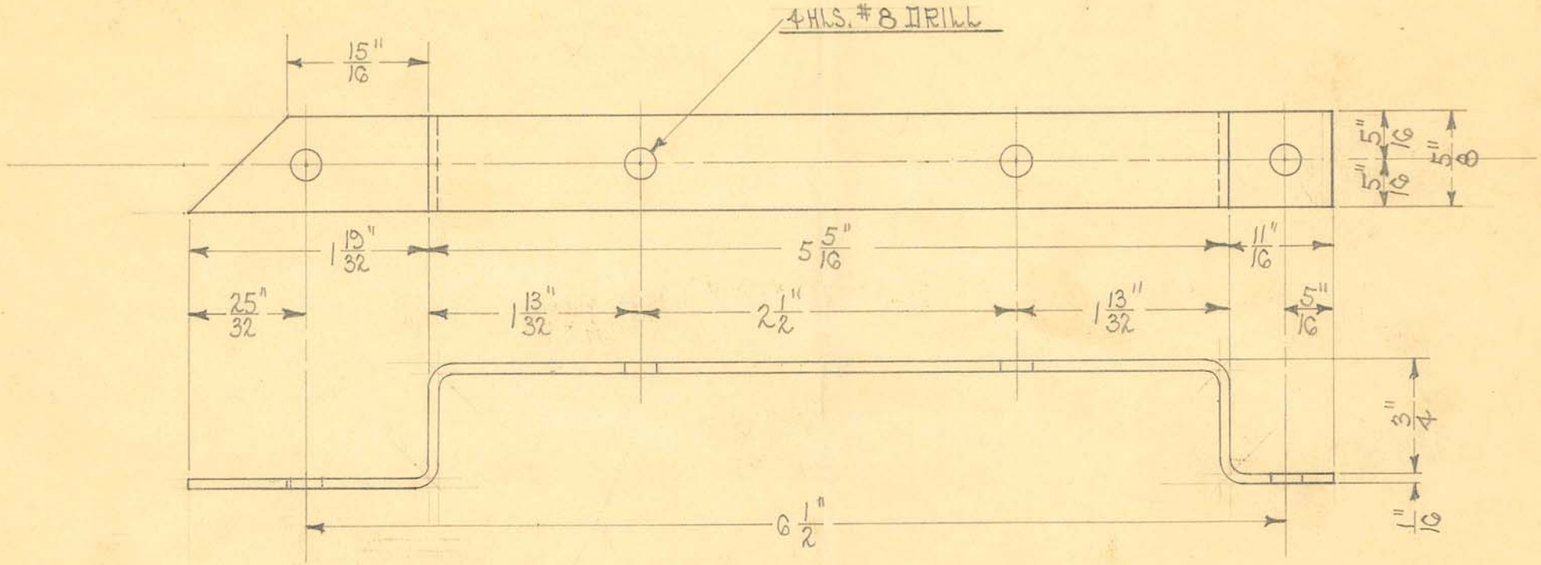

DEVELOPED LENGTH - 8 7/8"
DRILL JIG. #3289
FORMING FIXTURE #3290

OBSOLETE

SIZE	1/16" X 5/8"	ISSUE 10-24-32	2.8
KIND	COLD ROLLED	CHANGED	
SHAPE		" "	
FINISH	BLK. ENAMEL	" "	
TEMP.		" "	
PATT.		" "	

TITLE: FISCHER MOD. "H" DIA. OUTFIT OSCIL. CONE. SUPP. STRIP

H. G. FISCHER & CO.
2335 WABANSIA AVE.
CHICAGO, ILL.

CAT. NO.

PART NO. 7460

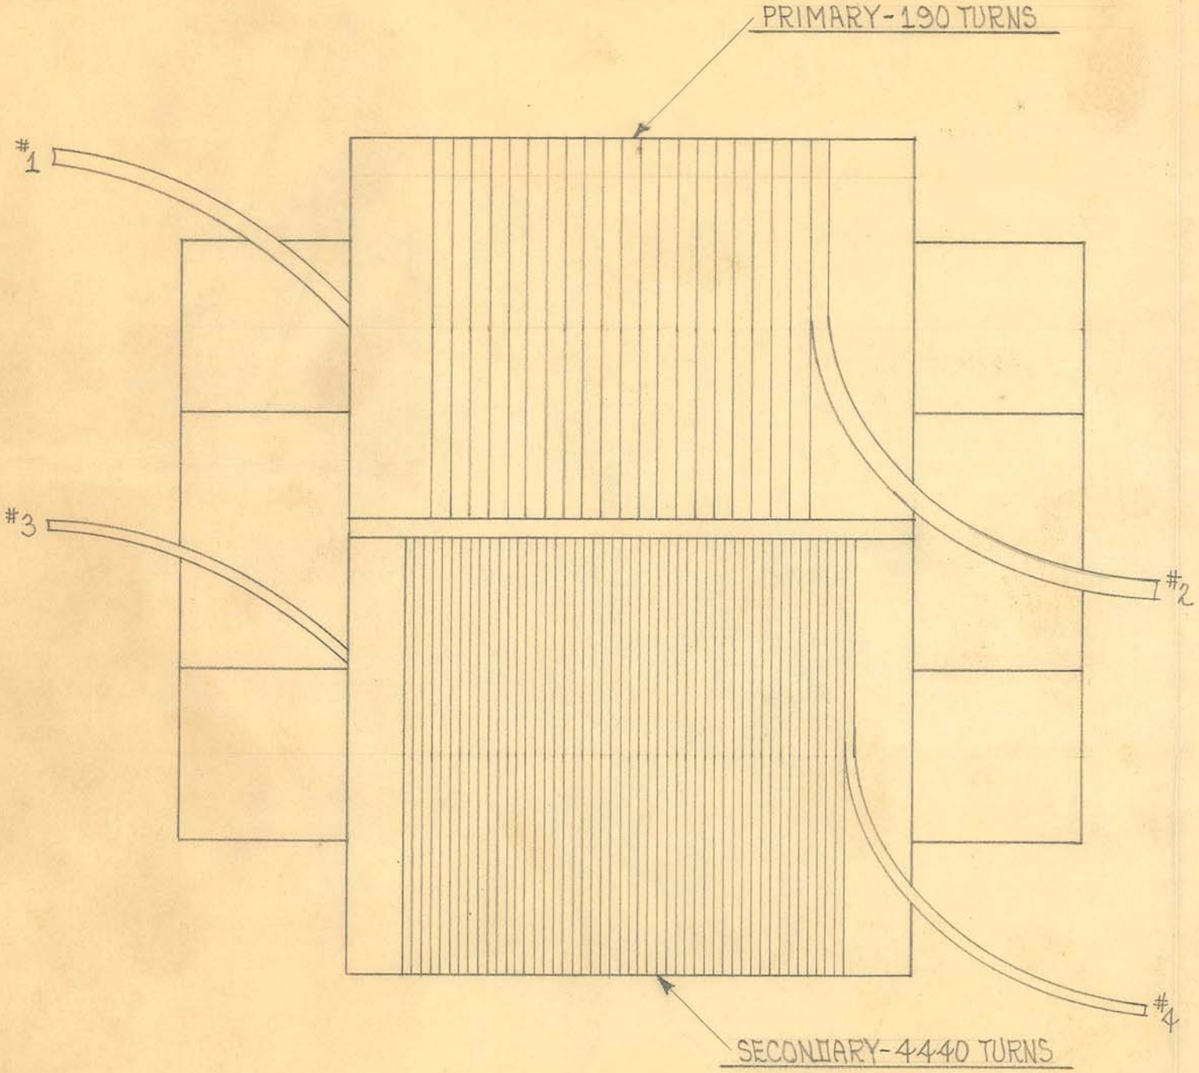

SCALE ~ $\frac{3}{4}$" = 1"

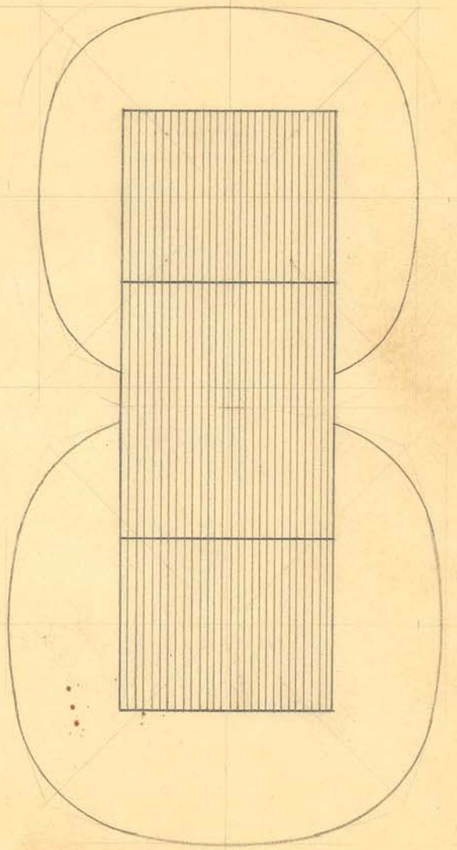

STEEL SIZES

Pc. No. 5043

PRI. & SEC. CORES
CUT $6\frac{1}{2}$" X $1\frac{9}{16}$" BUILT UP TO $1\frac{3}{4}$"
END PIECES CUT $3\frac{3}{4}$" X $1\frac{9}{16}$".
BIND PRI. & SEC. CORES WITH FRICTION TAPE.

WINDING DATA

PRIMARY

USE # 11 COTENAMEL WIRE
4 LAYERS HEAVY WRAPPING PAPER & 3 LAYERS OF 5026 $\frac{3}{4}$ OILED CLOTH ON CORE. ANCHOR LEAD #1-$\frac{1}{4}$" FROM LEFT END WITH FRICTION TAPE & WIND TO 190 TURNS WITH 2 LAYERS OF 5026 $\frac{3}{4}$ OILED CLOTH BETWEEN EACH LAYER OF WIRE, ANCHOR END WITH LINEN TAPE- LEAD #2.

SECONDARY

USE # 23 ENAMEL WIRE
4 LAYERS OF 5022 FIBROID PAPER ON CORE. ANCHOR LEAD #3 WITH FRICTION TAPE & WIND 40 TURNS SPACED ON 1ST LAYER. THEN 4 LAYERS OF 5022 FIBROID PAPER. WIND TO 254 TURNS & COVER WITH 1 DOUBLE LAYER OF 5022 FIBROID. WIND TO 468 TURNS & COVER WITH 1 DOUBLE LAYER OF 5022 FIBROID. WIND TO 682 TURNS & COVER WITH 1 DOUBLE LAYER OF 5022 FIBROID. WIND 17 MORE LAYERS OF 214 TURNS EACH WITH 1 LAYER OF 5022 FIBROID BETWEEN EACH LAYER OF WIRE. TOTAL 4320 TURNS. COVER WITH 1 LAYER OF 5022 FIBROID. WIND 1 LAYER OF #20 ENAMEL WIRE TO 4440 TURNS. ANCHOR END WITH LINEN TAPE- LEAD #4. LEADS #3 & 4 ARE 1662- CELATSITE WIRE. COVER ENTIRE TRANS. EXCEPT ENDS WITH BLACK INSULATING VARNISH.

OBSOLETE

SIZE		ISSUE	10-13-32	N.E.
KIND		CHANGED		
SHAPE		" "		
FINISH		" "		
TEMP.		" "		
PATT.		" "		

TITLE: FISCHER MOD. "H" DIA. OUTFIT TRANSFORMER

H. G. FISCHER & CO.
2335 WABANSIA AVE.
CHICAGO, ILL.

CAT. NO.

PART NO. 7458G

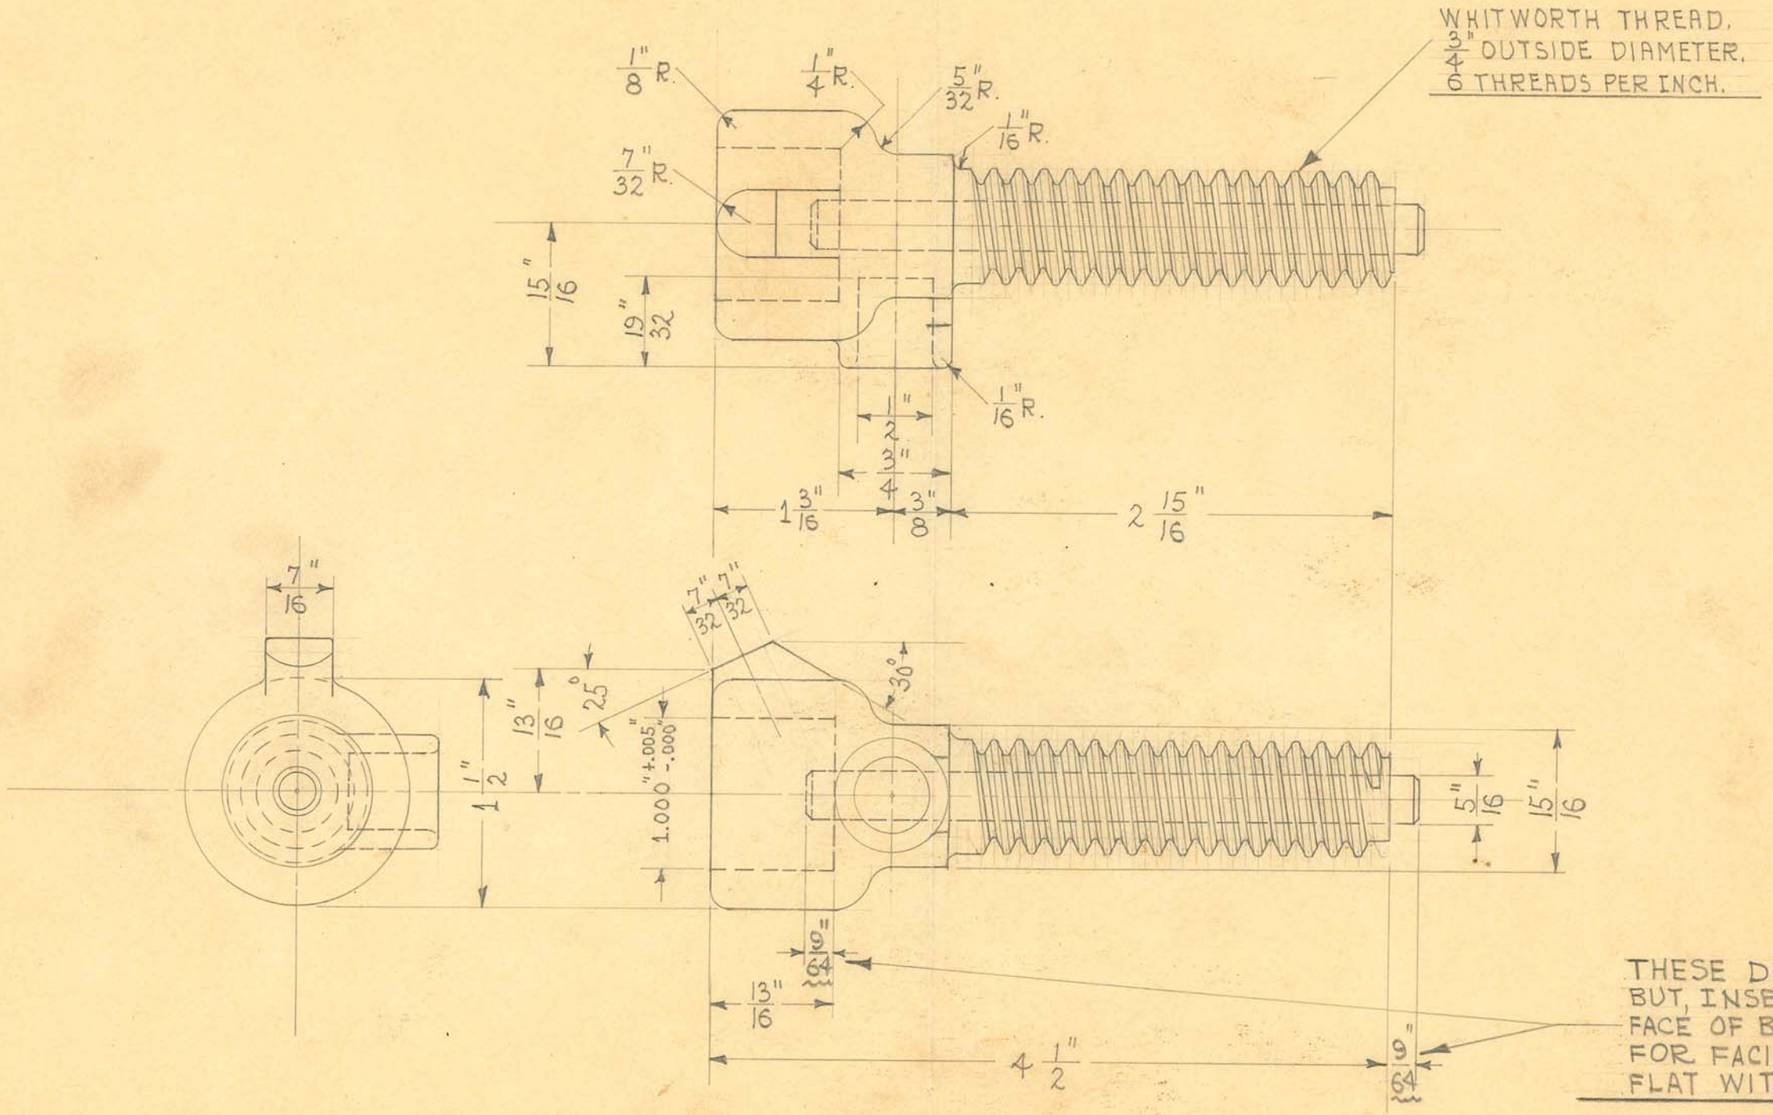

THESE DIMENSIONS NOT IMPORTANT BUT, INSERT MUST PROTRUDE FROM FACE OF BAKELITE ON EITHER END FOR FACING BOTH ENDS OF INSERT FLAT WITH BAKELITE FACE.

OBSOLETE

C. M. P. C. MOLD # M-2435

SIZE	MOLDED	ISSUE 9-20-38	H.E.
KIND	BAKELITE	CHANGED	
SHAPE		"	
FINISH		"	
TEMP.		"	
MOLD PART.	1806	"	

TITLE: AIR-SPACED ELECTRODE - ADJUSTMENT SCREW

H. G. FISCHER & CO.
2335 WABANSIA AVE.
CHICAGO, ILL.

CAT. NO.

PART NO. 12117G

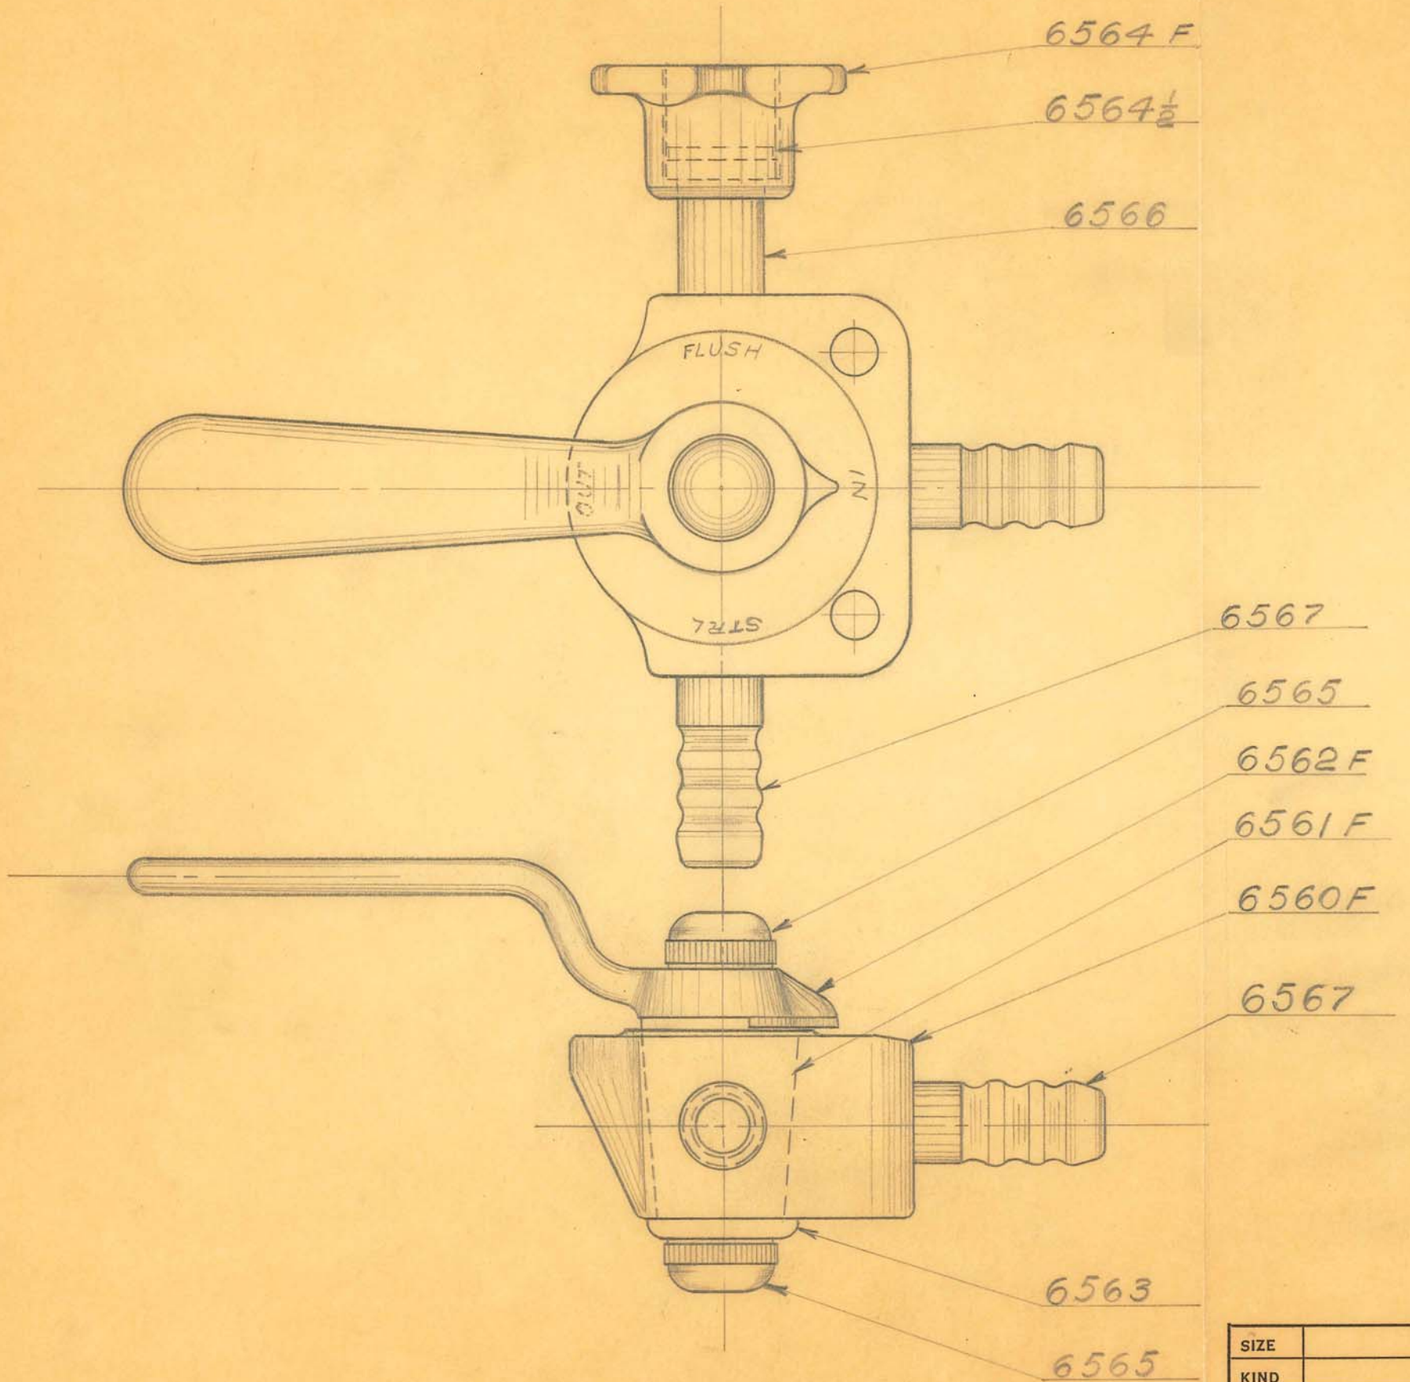

OBSOLETE

SIZE		ISSUE 2-16-31	Q'TY.
KIND		CHANGED	
SHAPE		" "	
FINISH		" "	
TEMP.		" "	
PATT.		" "	

TITLE: COLONIC IRRIGATOR VALVE ASSEMBLY

H. G. FISCHER & CO.
2335 WABANSIA AVE.
CHICAGO, ILL.

CAT. NO.

PART NO. 6560 G

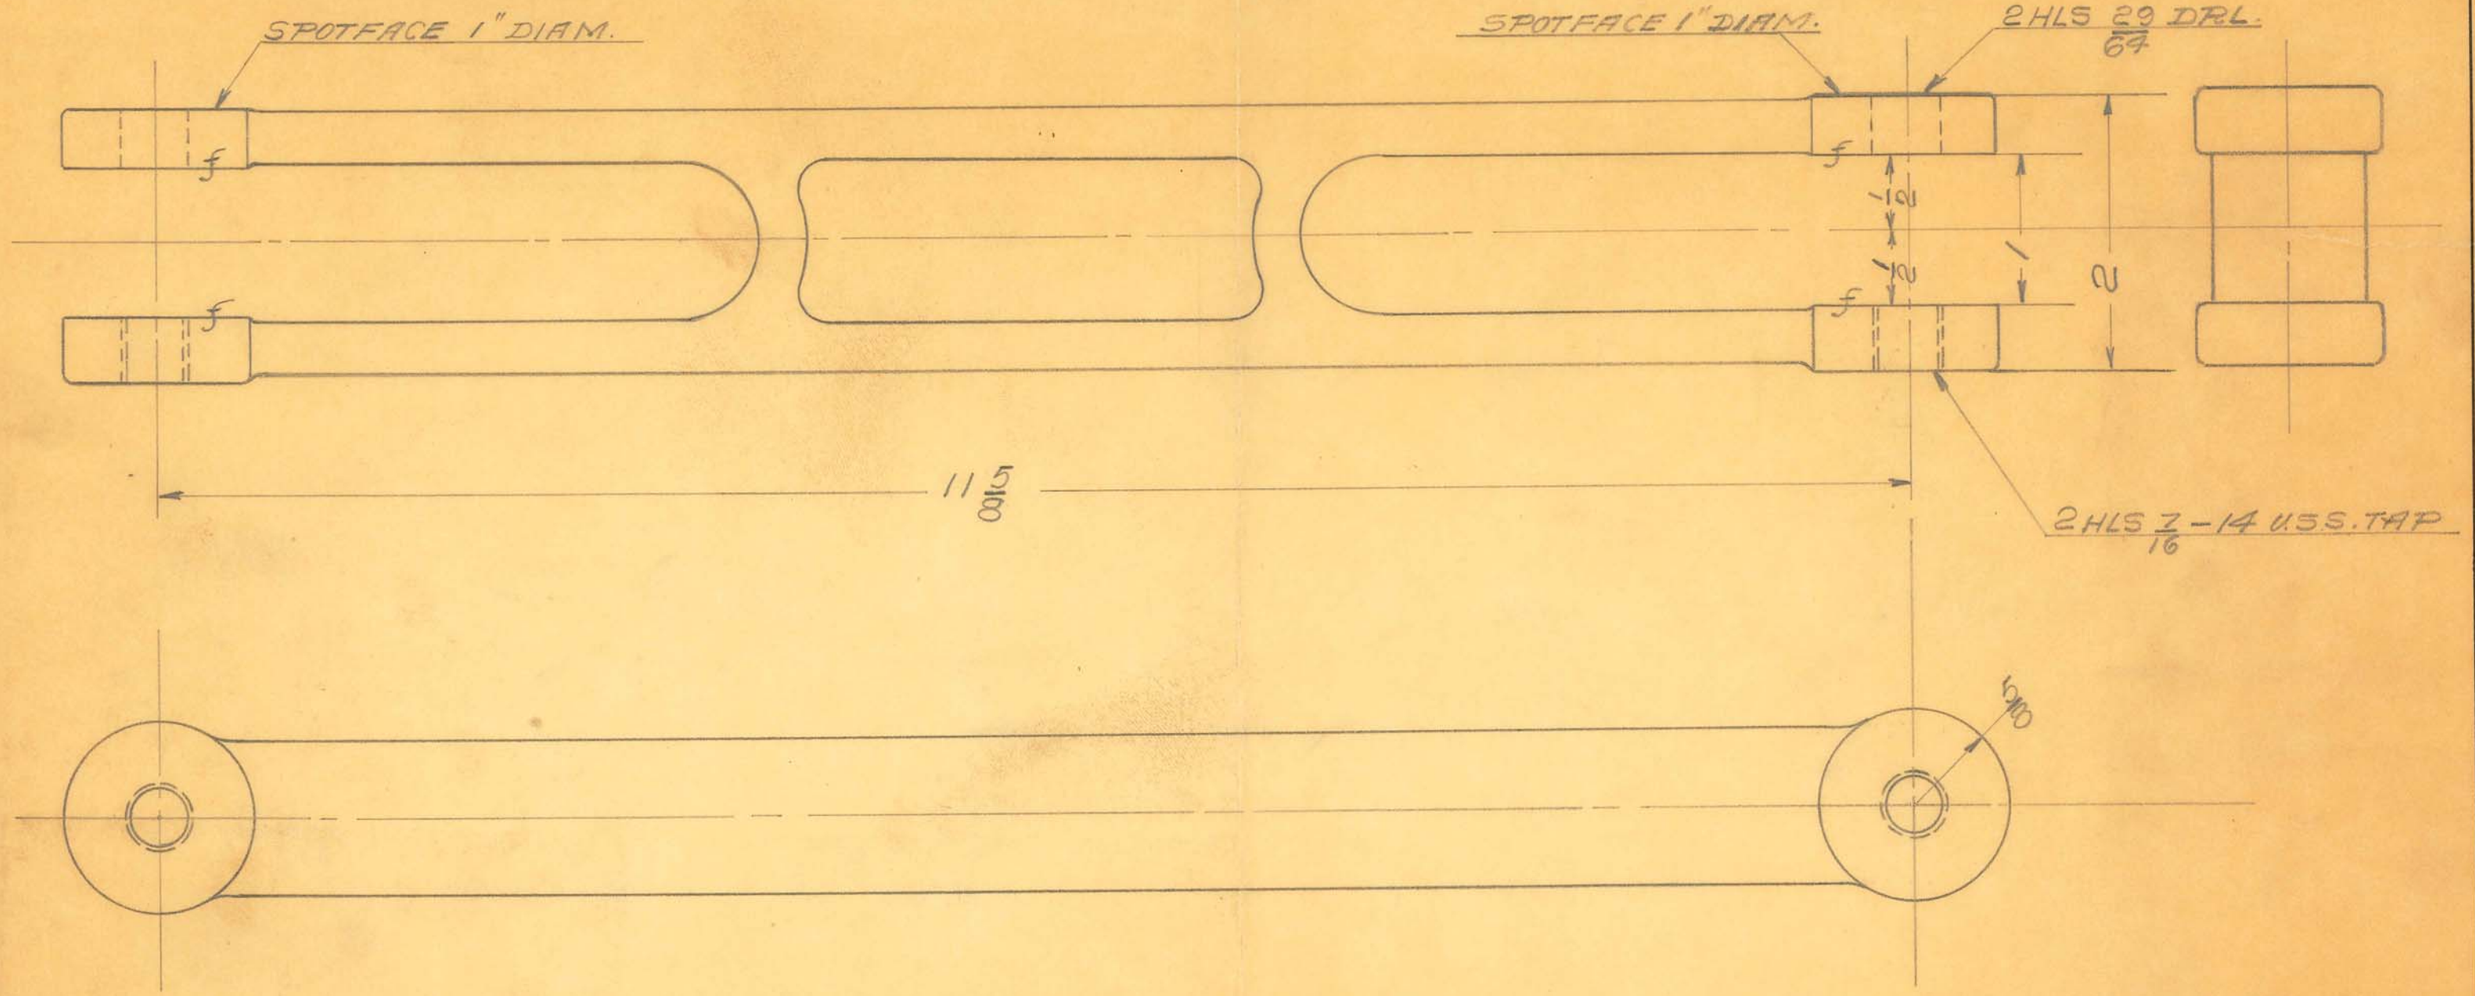

OBSOLETE

SIZE		ISSUE 1-16-31	C.M.	TITLE: COLONIC IRRIGATOR SWING ARM
KIND		CHANGED		
SHAPE		" "		
FINISH		" "		
TEMP.		" "		H. G. FISCHER & CO. 2335 WABANSIA AVE. CHICAGO, ILL. — CAT. NO. — PART NO. 6557F
PATT.		" "		

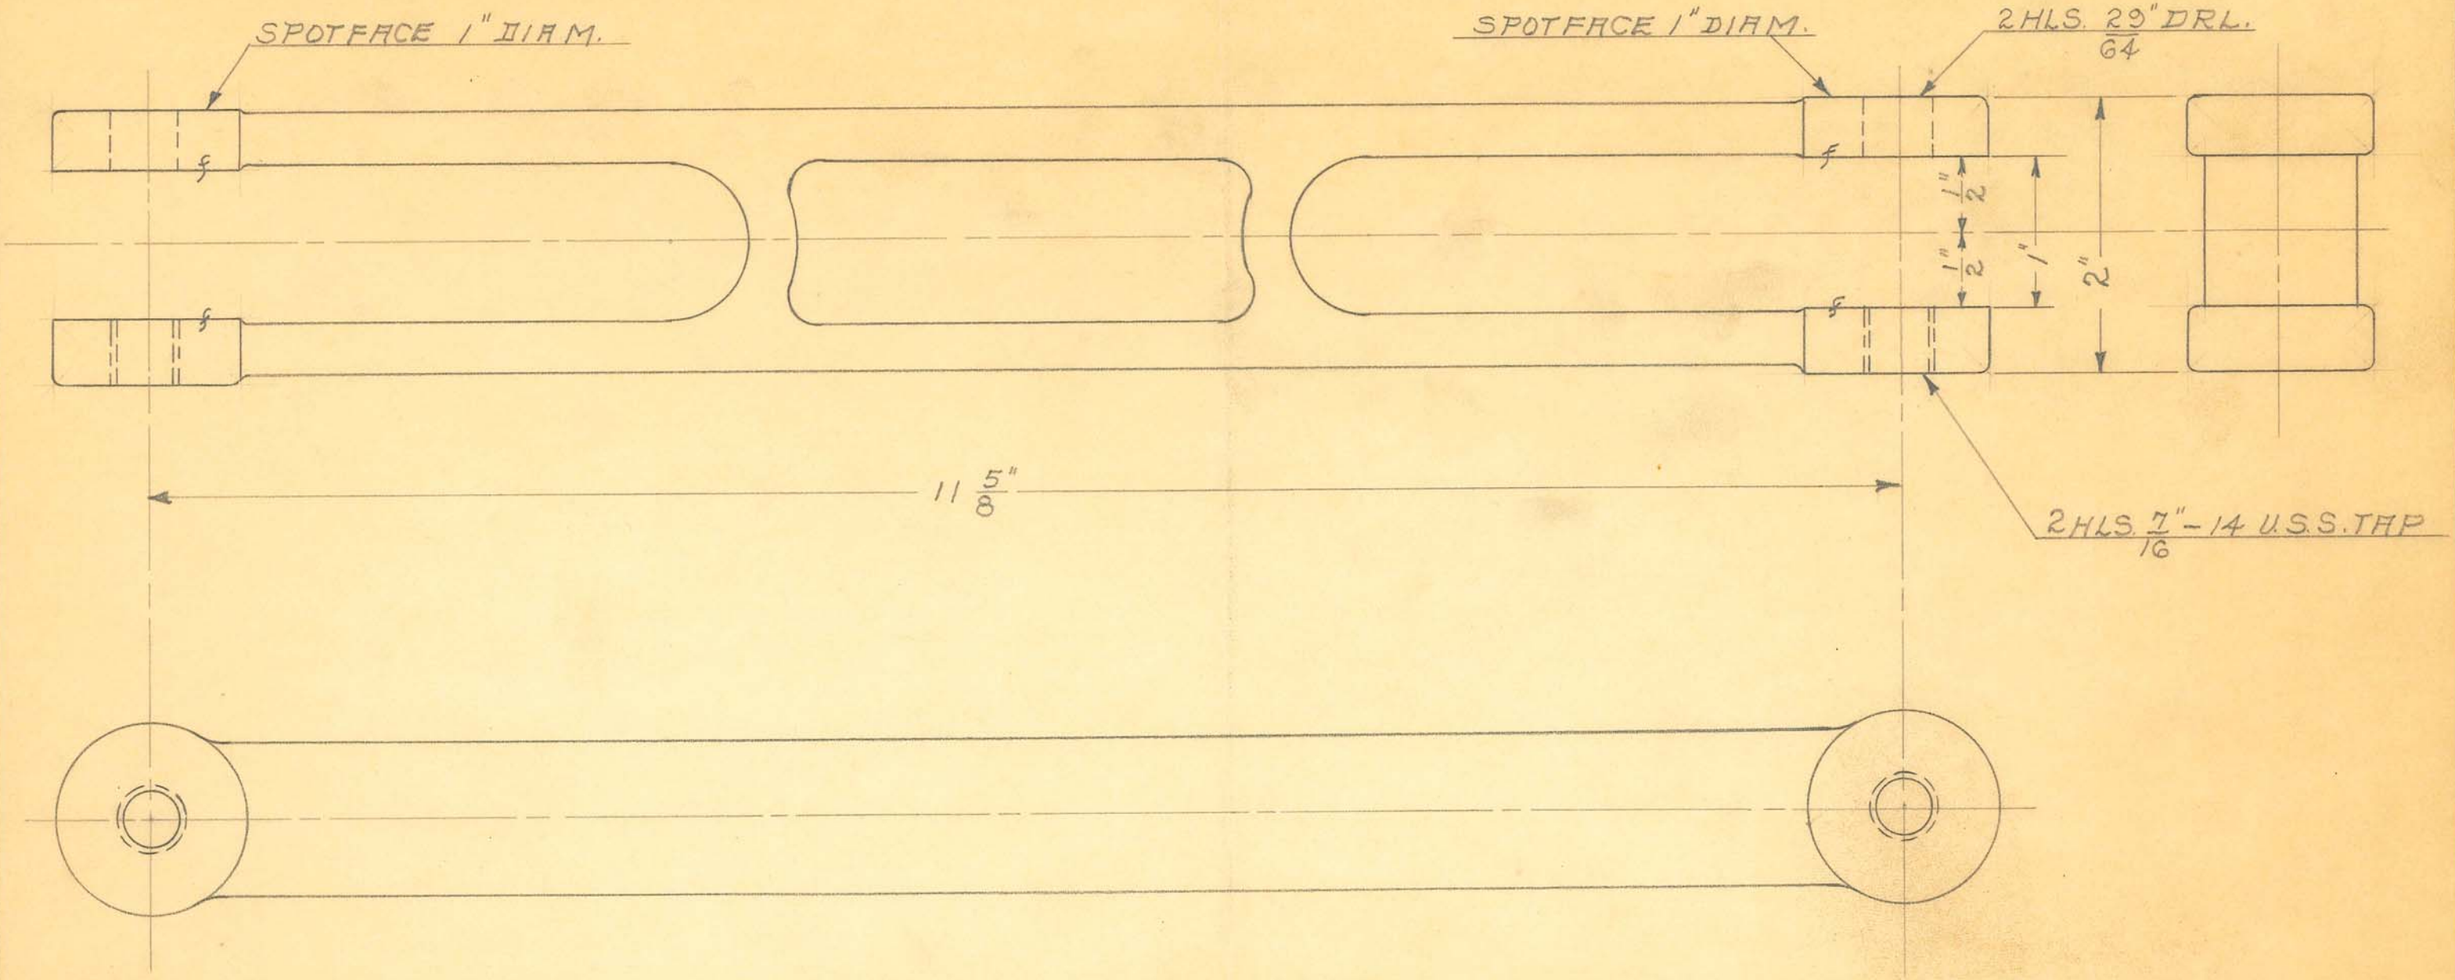

CAST IRON

1 REQ.

SCALE FULL SIZE

OBSOLETE

SIZE		ISSUE 1-16-31	C.M.	TITLE: COLONIC IRRIGATOR SWING ARM
KIND		CHANGED		
SHAPE		" "		
FINISH	W. LACQUER	" "		
TEMP.		" "		H. G. FISCHER & CO. 2335 WABANSIA AVE. CHICAGO, ILL. — CAT. NO. — PART NO. 6557F
PATT.		" "		

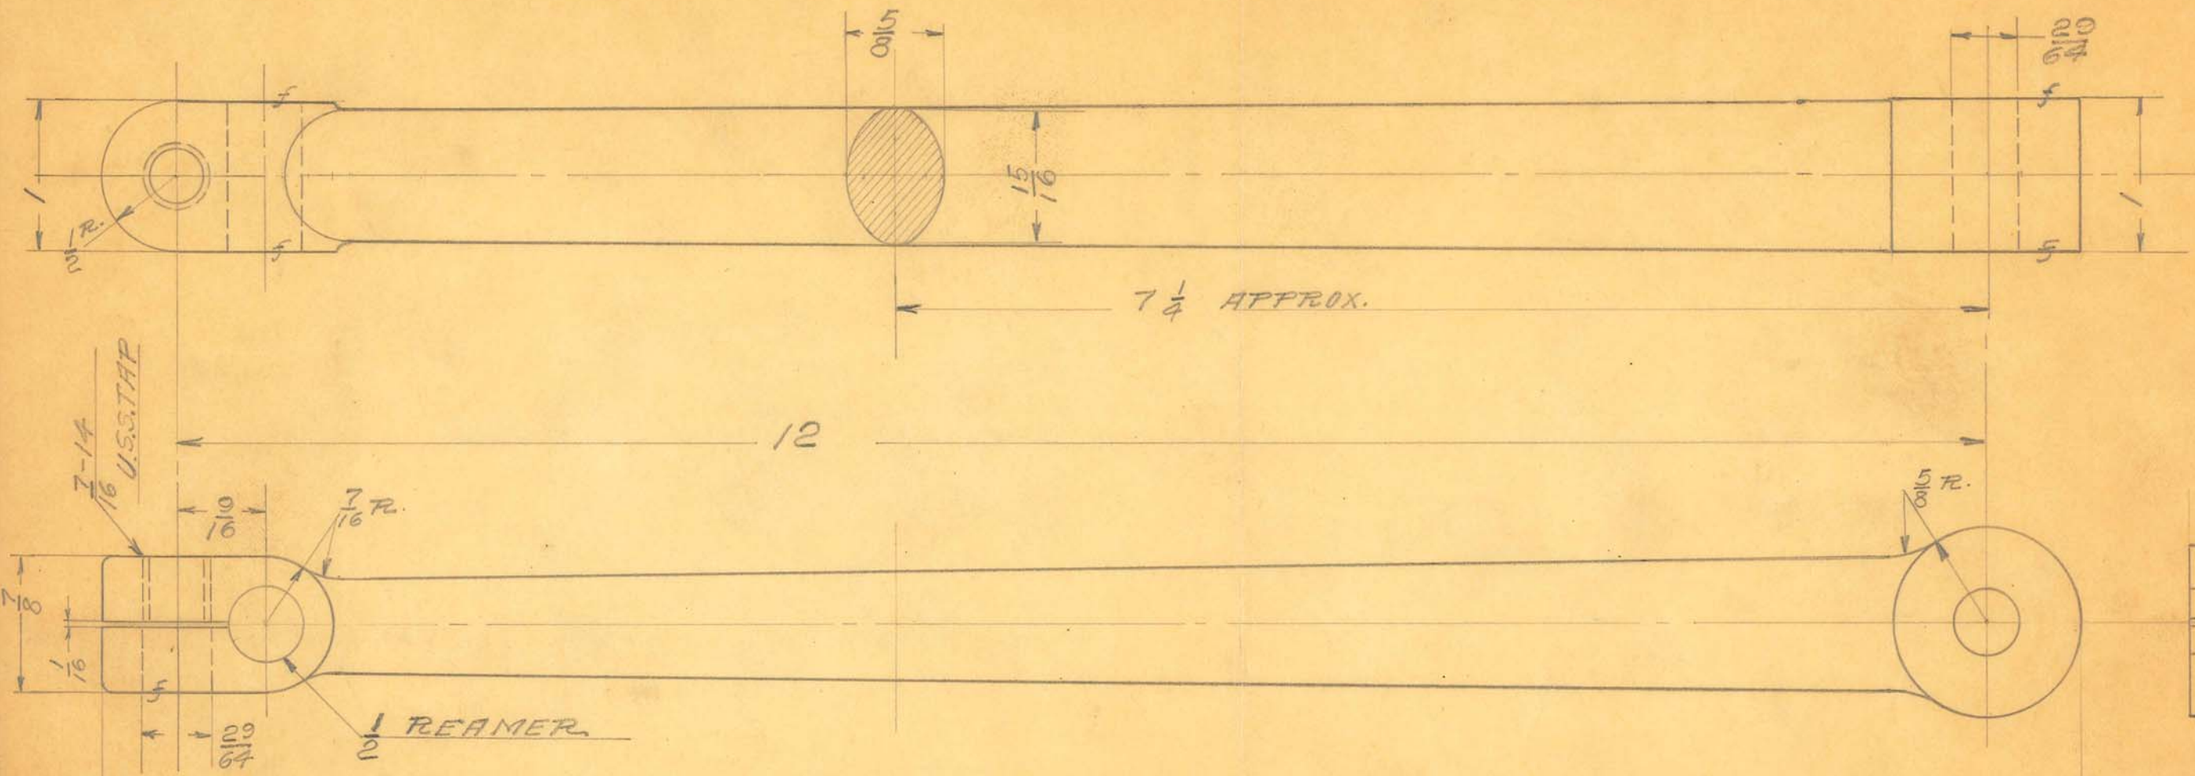

CAST IRON

1 REQ.

SCALE FULL SIZE

OBSOLETE

SIZE		ISSUE 10-13-30	C.M.	TITLE: COLONIC IRRIGATOR VALVE ARM
KIND		CHANGED		
SHAPE		" "		
FINISH	W. ENAMEL	" "		
TEMP.		" "		H. G. FISCHER & CO. 2335 WABANSIA AVE. CHICAGO, ILL. — CAT. NO. — PART NO. 6556F
PATT.		" "		

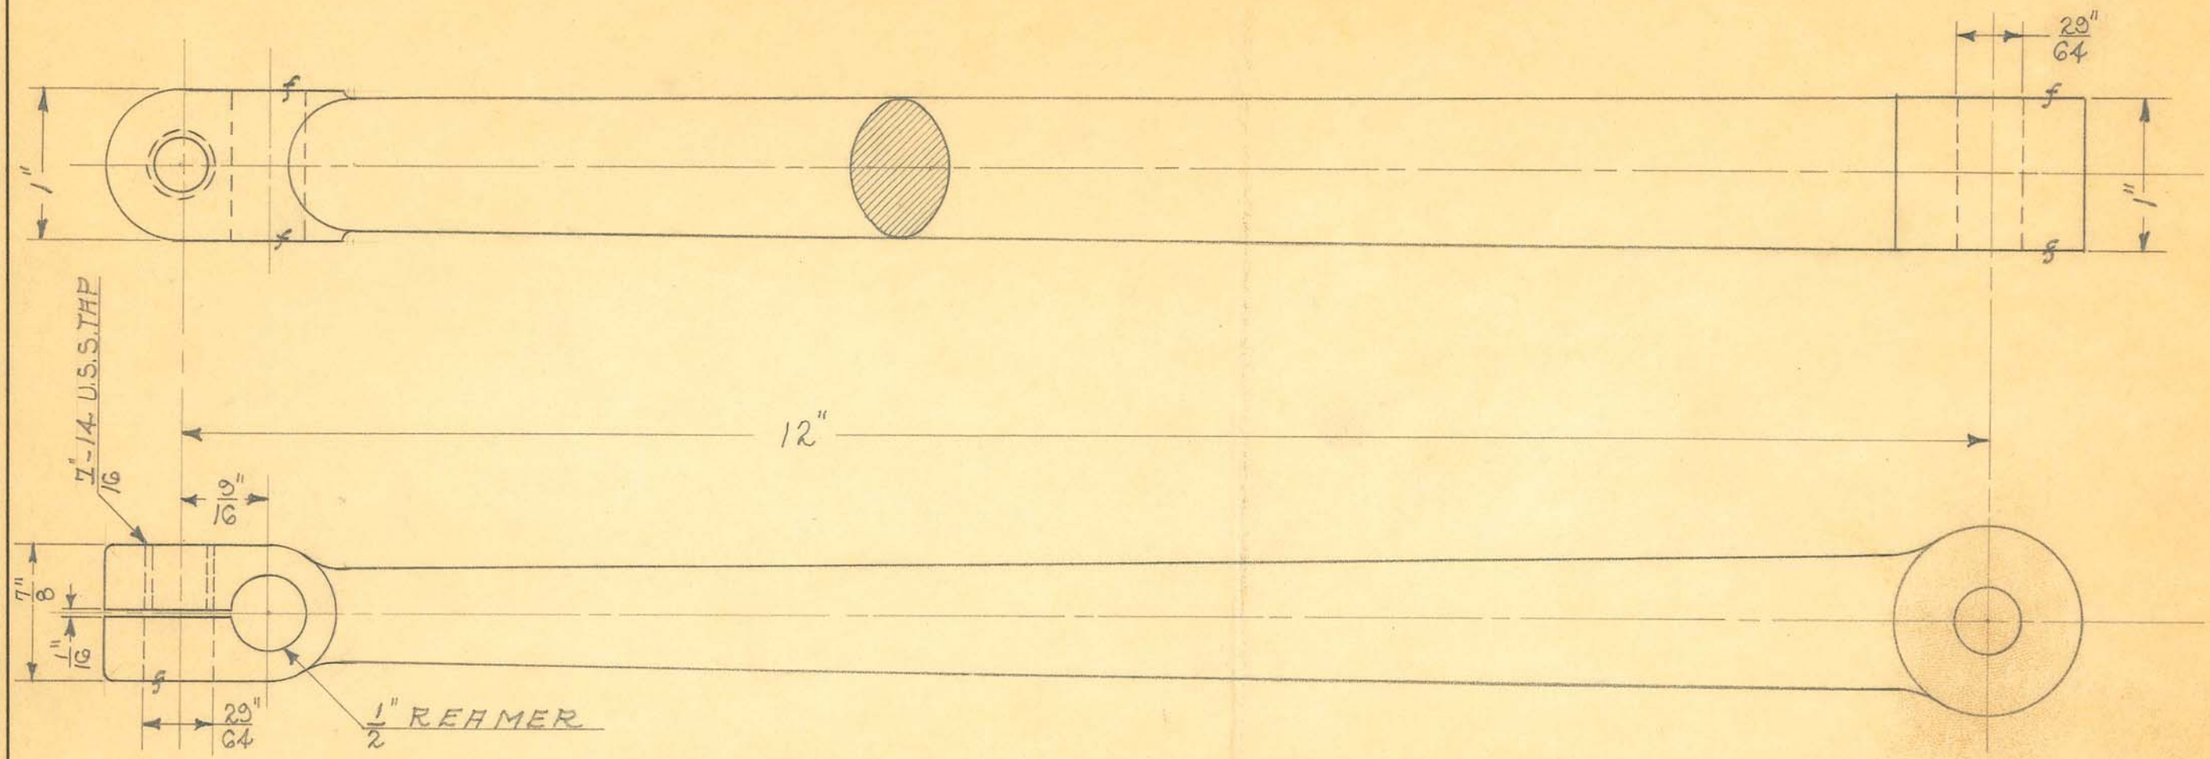

CAST IRON

1 REQ.

SCALE FULL SIZE

OBSOLETE

SIZE		ISSUE 10-13-30	C.M.
KIND		CHANGED	
SHAPE		" "	
FINISH	W. ENAMEL	" "	
TEMP.		" "	
PATT.		" "	

TITLE: COLONIC IRRIGATOR VALVE ARM

H. G. FISCHER & CO.
2335 WABANSIA AVE.
CHICAGO, ILL.

CAT. NO.

PART NO. G556F

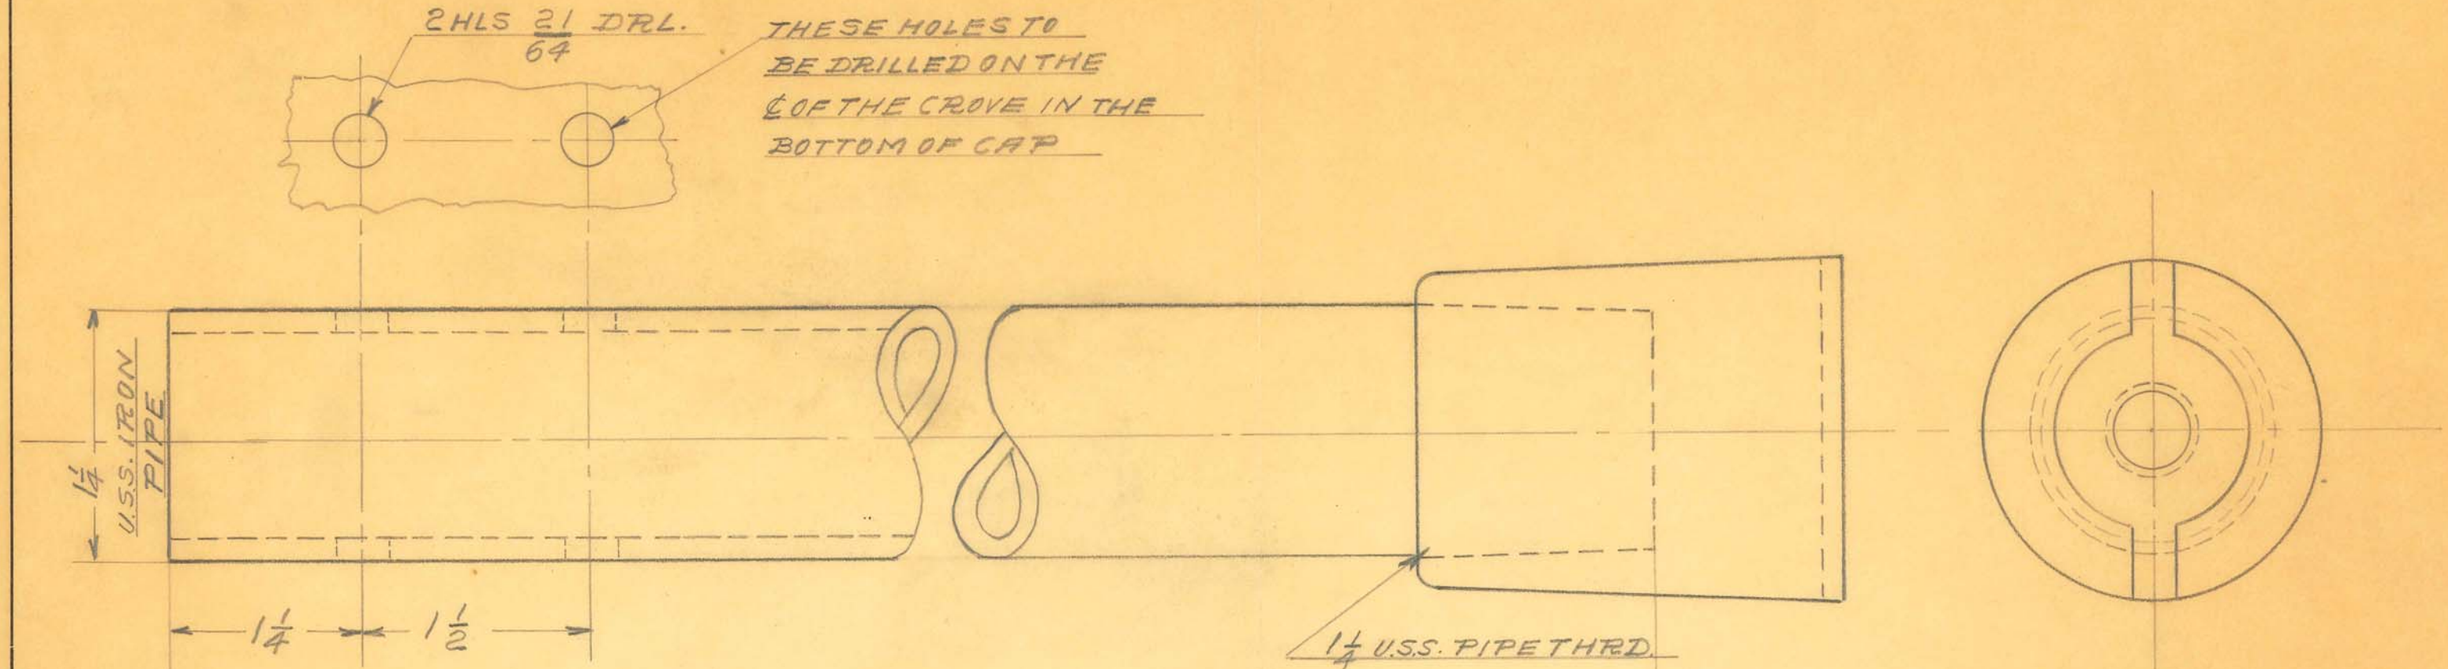

OBSOLETE

SIZE		ISSUE 1-5-30	C.M.	TITLE: COLONIC IRRIGATOR UPRIGHT PIPE
KIND		CHANGED		
SHAPE		" "		
FINISH	W. EML.	" "		
TEMP.		" "		H. G. FISCHER & CO. 2335 WABANSIA AVE. CHICAGO, ILL. — CAT. NO. — PART NO. 6554F
PATT.		" "		

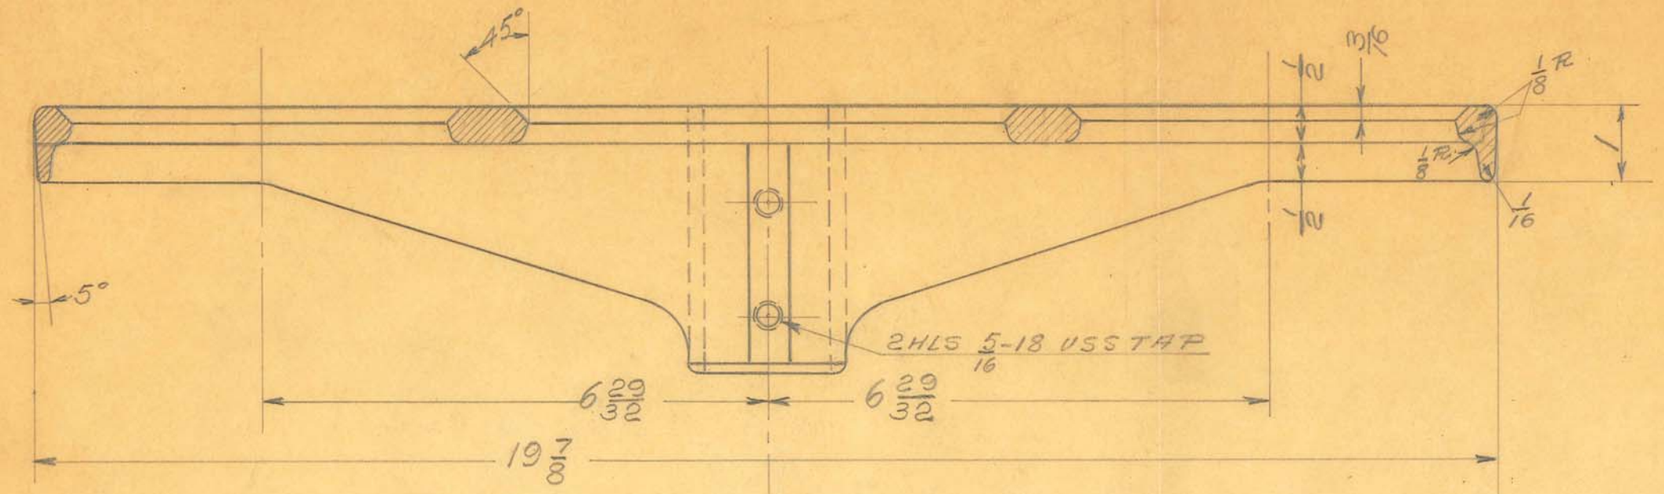

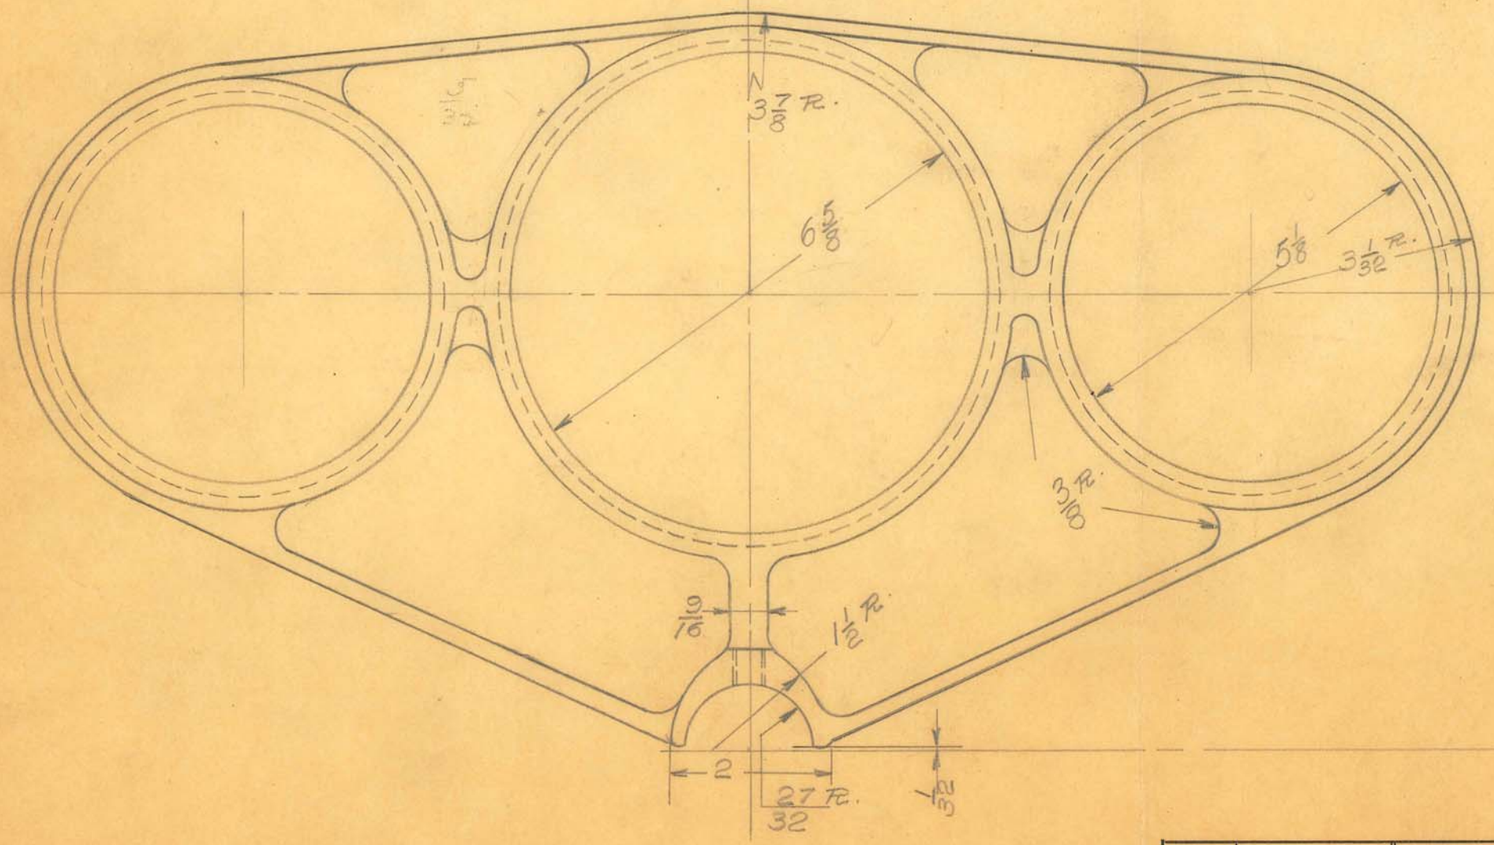

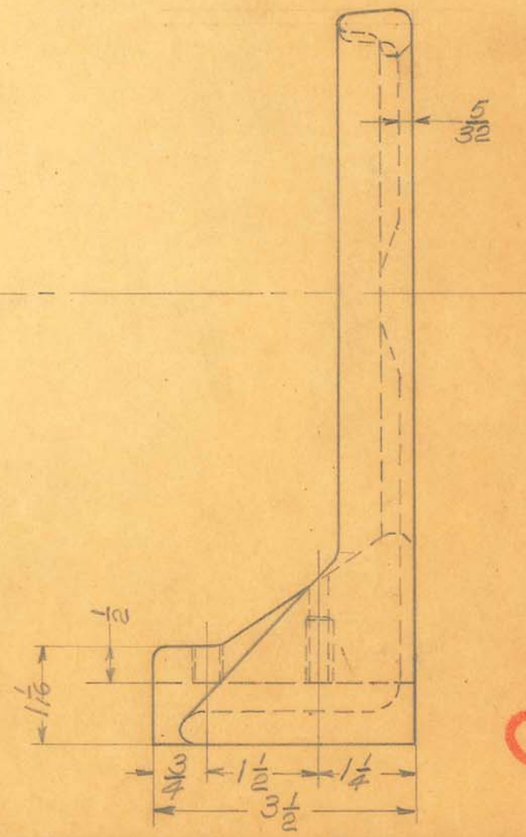

CAST IRON
1 REQ
SCALE HALF SIZE

OBSOLETE

SIZE		ISSUE 10-10-30	C.M.
KIND		CHANGED	
SHAPE		" "	
FINISH	W. ENAMEL	" "	
TEMP.		" "	
PATT.		" "	

TITLE: COLONIC IRRIGATOR PERCOLATOR SUPPORT

H. G. FISCHER & CO.
2335 WABANSIA AVE.
CHICAGO, ILL.

CAT. NO.

PART NO. G552F

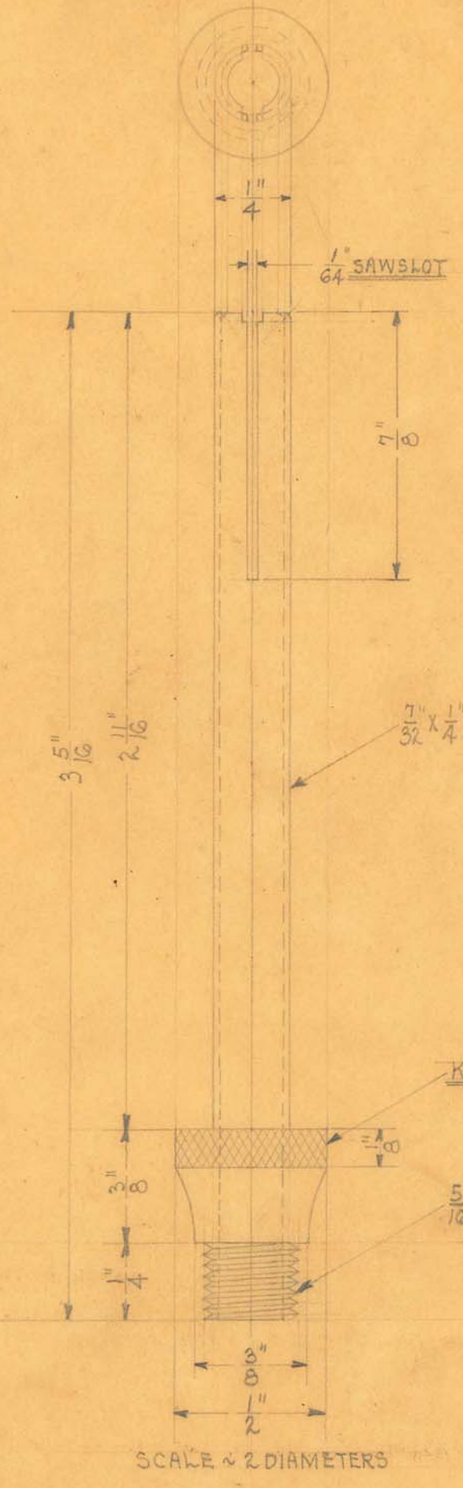

SCALE ~ 2 DIAMETERS

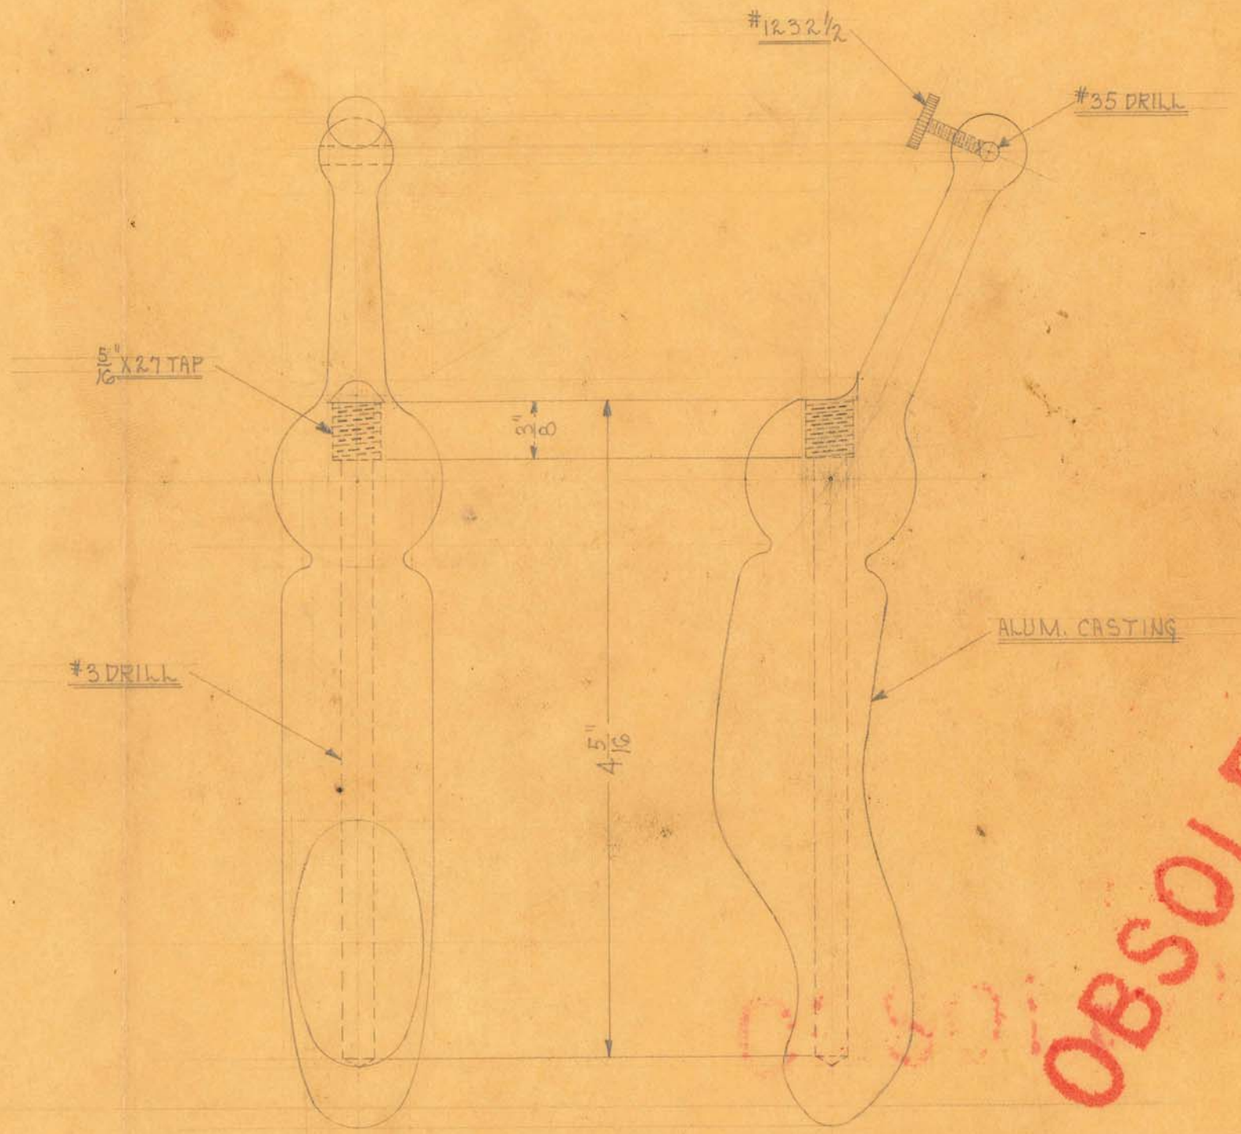

OBSOLETE

SIZE		ISSUE 10-3-30	W.E.	TITLE: PROSTATIC ELECTRODE
KIND		CHANGED		
SHAPE		" "		
FINISH		" "		
TEMP.		" "		H. G. FISCHER & CO. 2335 WABANSIA AVE. CHICAGO, ILL. — CAT. NO. — ~~PART~~ NO. S-110
PATT.		" "		

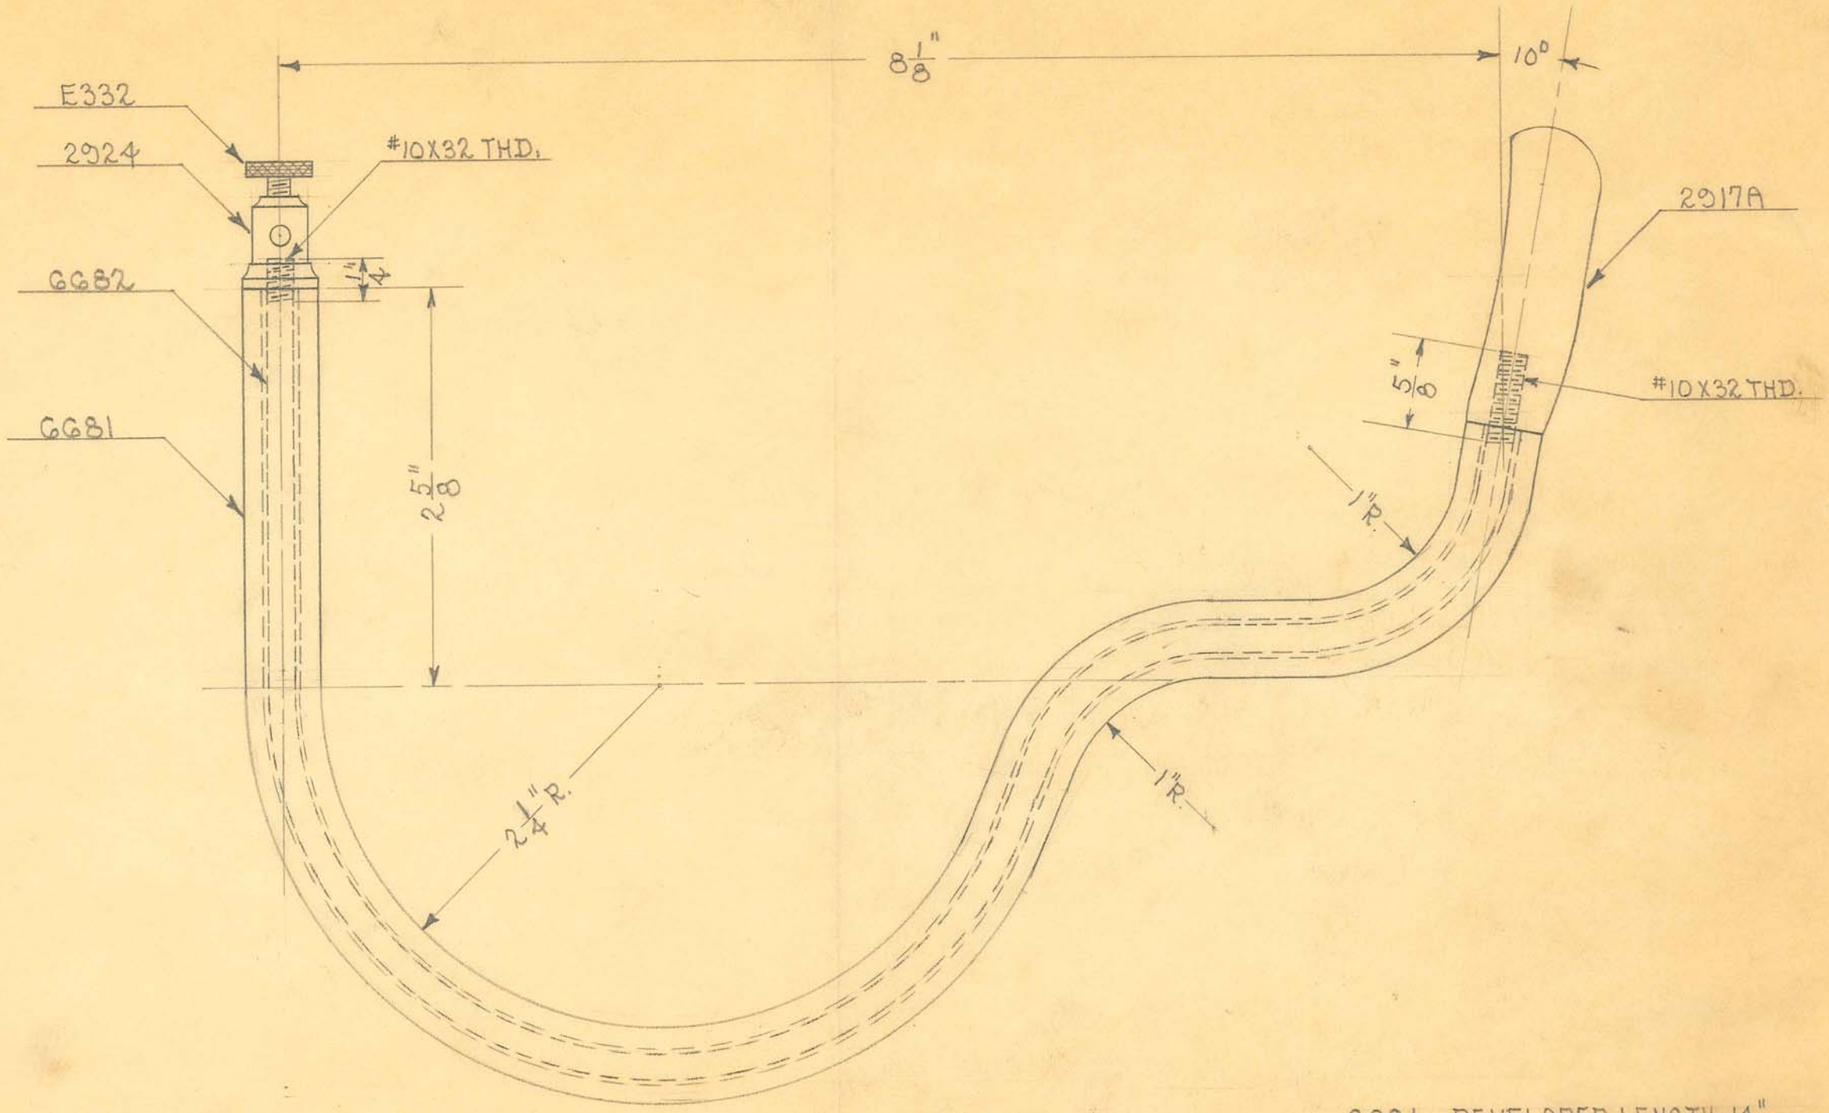

GG81 - DEVELOPED LENGTH-14"
GG82 - DEVELOPED LENGTH-14 11/16"

OBSOLETE

SIZE		ISSUE 2-14-33	J.E.	TITLE: MILLS TYPE PROSTATIC ELECTRODE
KIND		CHANGED		
SHAPE		" "		
FINISH		" "		
TEMP.		" "		H. G. FISCHER & CO. 2335 WABANSIA AVE. CHICAGO, ILL. — CAT. NO. — PART NO. GG80G
PATT.		" "		

P18822

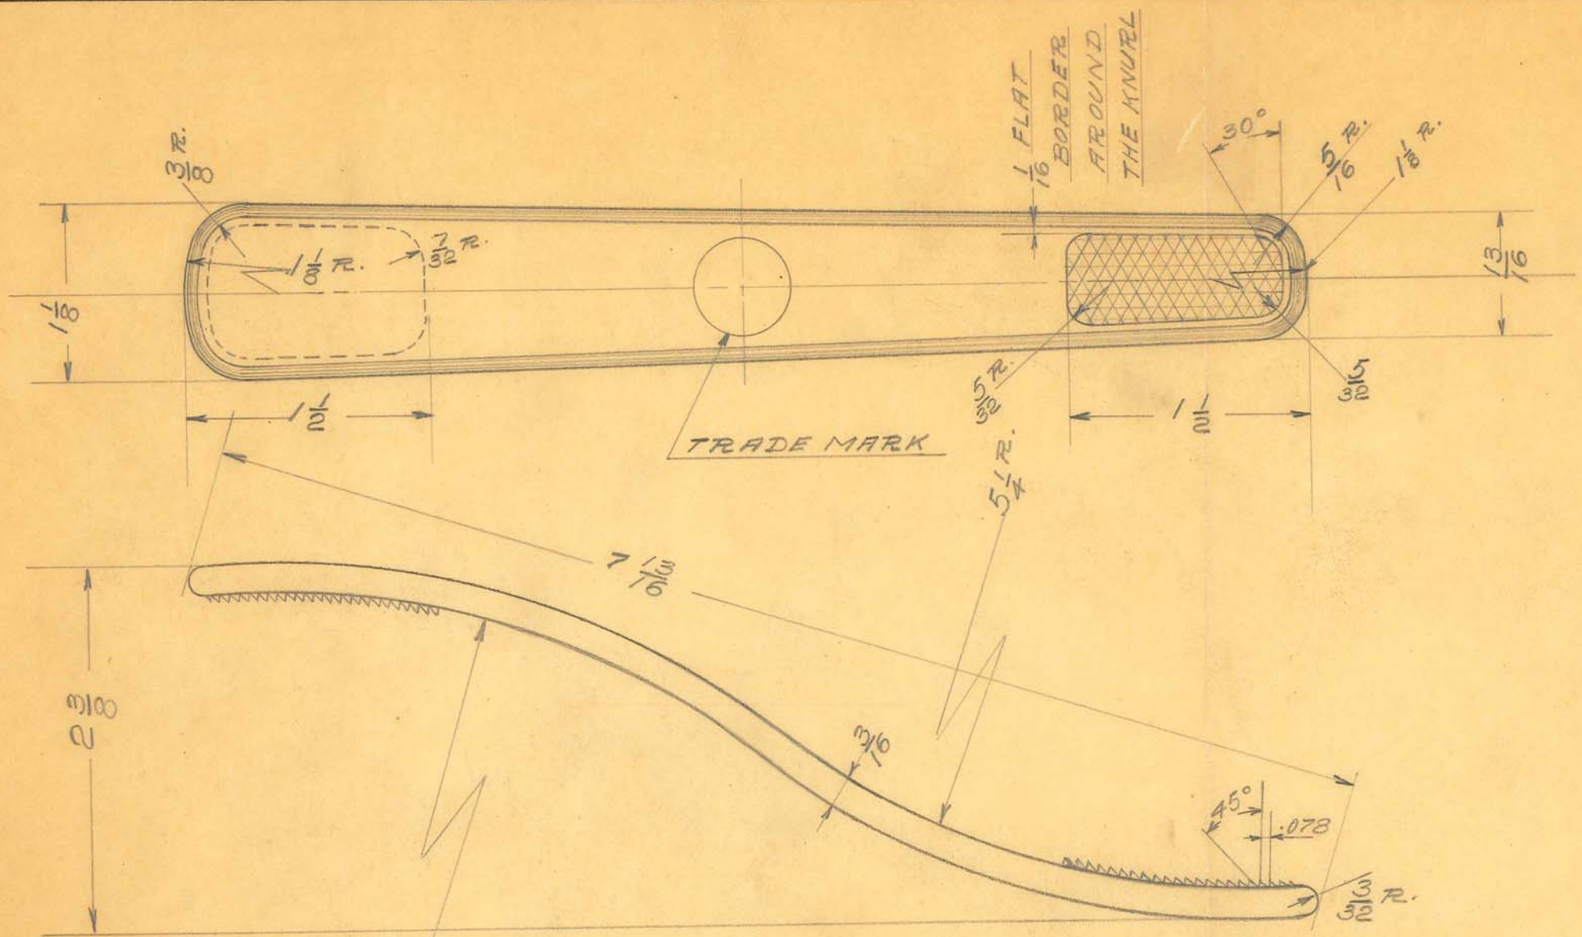

BAKELITE

SCALE FULL SIZE

OBSOLETE

SIZE		ISSUE 2-25-31	@ 8R.
KIND		CHANGED	
SHAPE		" "	
FINISH		" "	
TEMP.		" "	
PATT.		" "	

TITLE: TONGUE DEPRESSOR (DR. DILLINGER)

H. G. FISCHER & CO.
2335 WABANSIA AVE.
CHICAGO, ILL.

CAT. NO.

PART NO. 6640

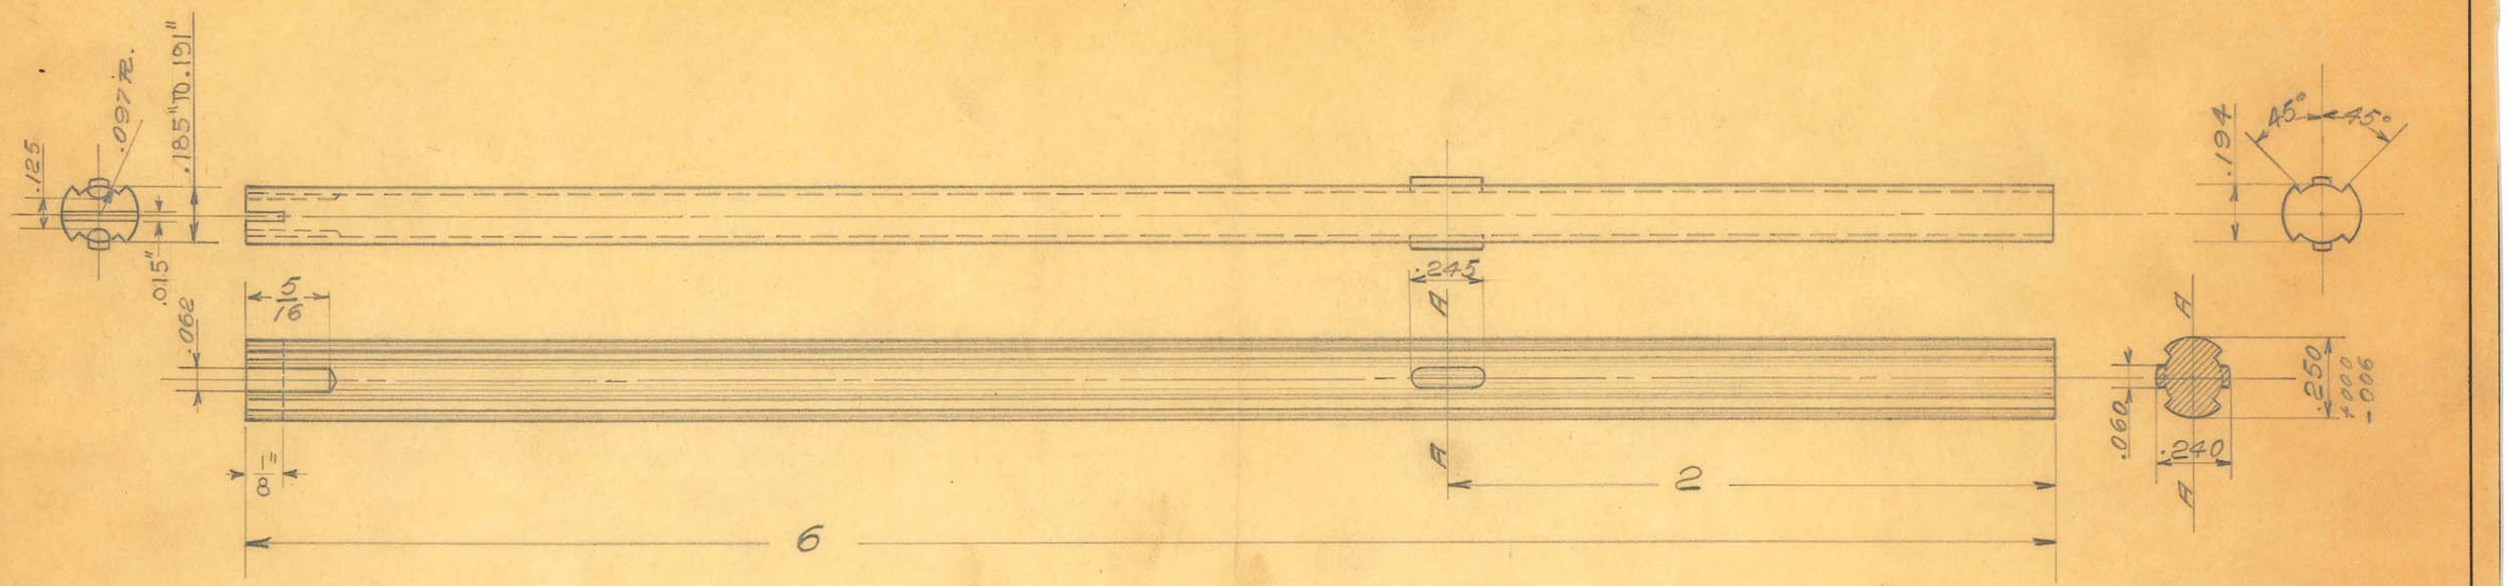

BAKELITE MOULDED

1 REQ.

SCALE 2 x SIZE

OBSOLETE

SIZE		ISSUE 2-6-31	C.W.	TITLE: ENDE-CHERRY CERVICAL ELECTRODE CORE
KIND		CHANGED		
SHAPE		" "		
FINISH		" "		
TEMP.		" "		H. G. FISCHER & CO. 2335 WABANSIA AVE. CHICAGO, ILL. — CAT. NO. — PART NO. 6629F
PATT.		" "		

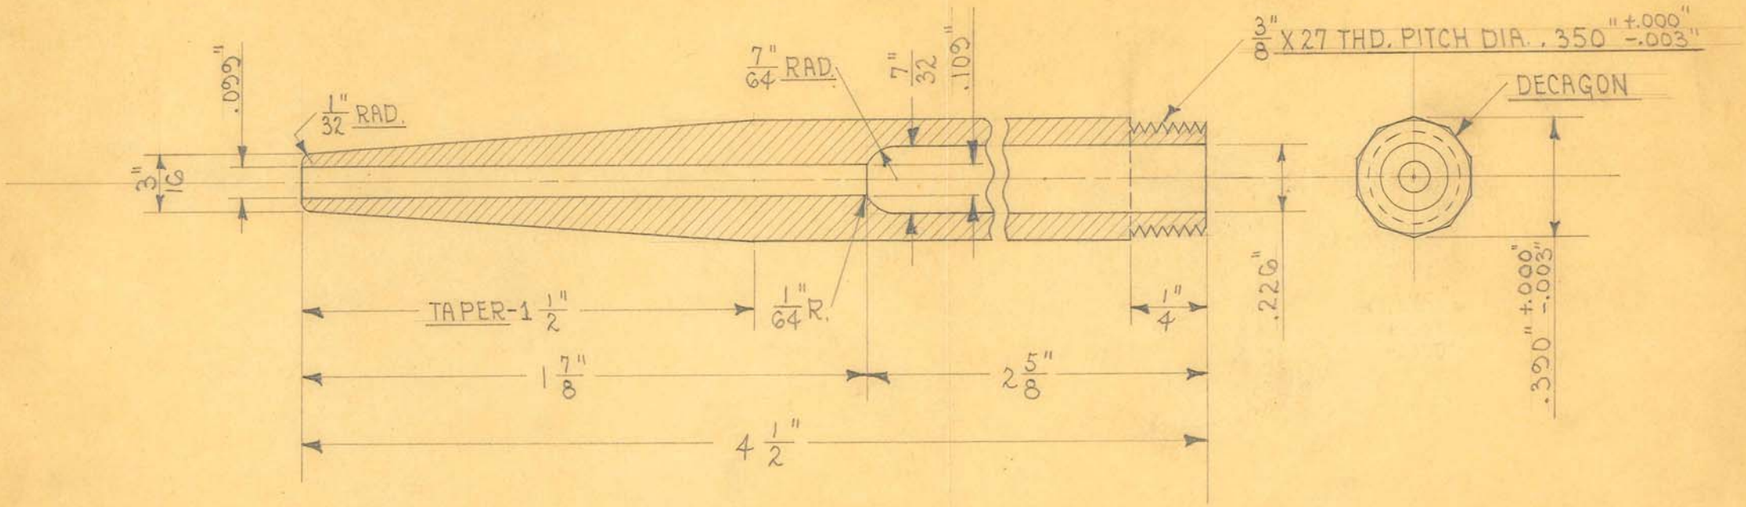

SCALE ~ 1" = 1/2"

OBSOLETE

C. M. P. C. MOLD # 1789

SIZE		ISSUE 12-18-35	H.E
KIND	MOLDED BAKELITE	CHANGED	
~~SHAPE~~	MOLD # 1781	" "	
FINISH		" "	
TEMP.		" "	
PATT.		" "	

TITLE: TISSUE CUTTING KNIFE ELECTRODE HANDLE-BODY

H. G. FISCHER & CO.
2335 WABANSIA AVE.
CHICAGO, ILL.

CAT. NO.

PART NO. 4511A

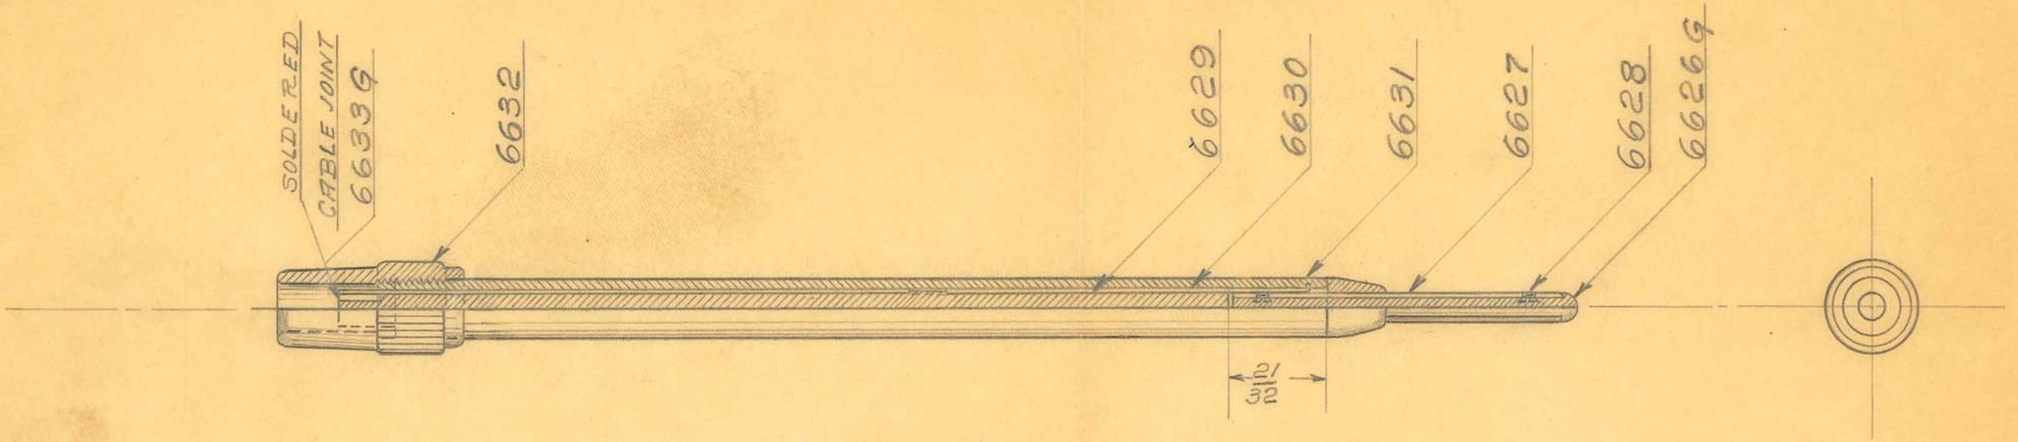

SCALE FULL SIZE

OBSOLETE

SIZE		ISSUE 2-10-31	C.M.
KIND		CHANGED	
SHAPE		" "	
FINISH		" "	
TEMP.		" "	
PATT. *		" "	

TITLE: ENDE-CHERRY CERVICAL ELECTRODE

H. G. FISCHER & CO.
2335 WABANSIA AVE.
CHICAGO, ILL.

CAT. NO.

PART NO. 6625 G

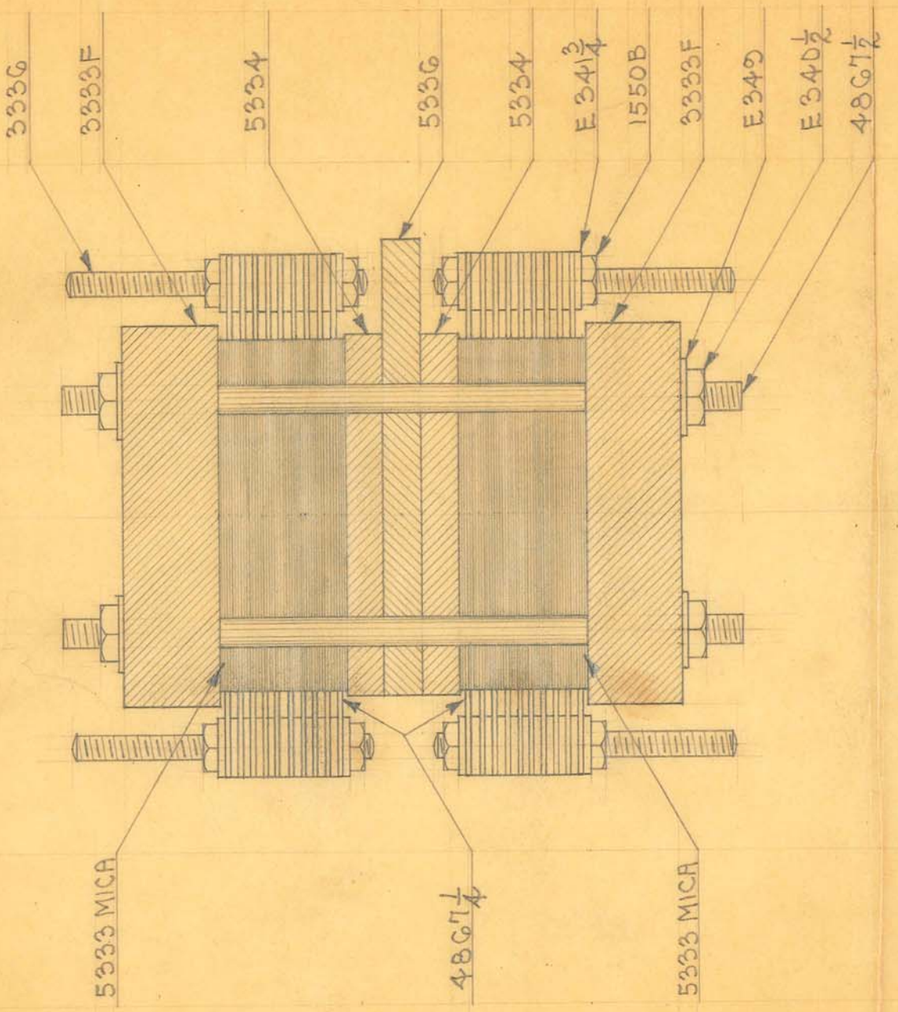

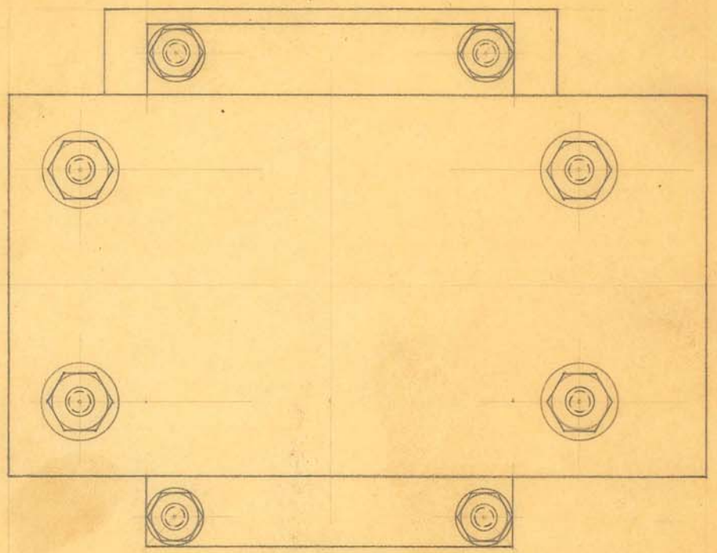

NOTE ~
MICA SPLIT TO .012 (4-7 SHEETS)
2-19 PLATE CONDS. JIG. # 4126

OBSOLETE

SIZE		ISSUE 3-3-32	A.E.	TITLE: SENIOR "V" CONDENSER
KIND		CHANGED		
SHAPE		" "		
FINISH		" "		
TEMP.		" "		H. G. FISCHER & CO. 2335 WABANSIA AVE. CHICAGO, ILL.
PATT.		" "		CAT. NO.
				PART NO. 4867 1/4 G

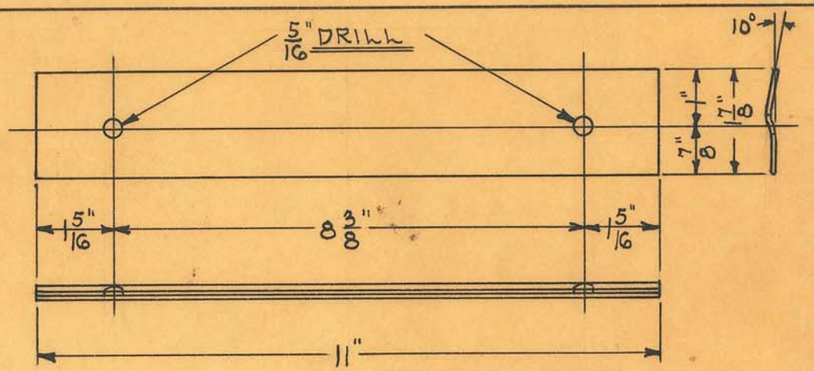

SCALE ~ 3/8" = 1"

2 REQUIRED

#16 B&S.GA. SCRAP SHEET STEEL

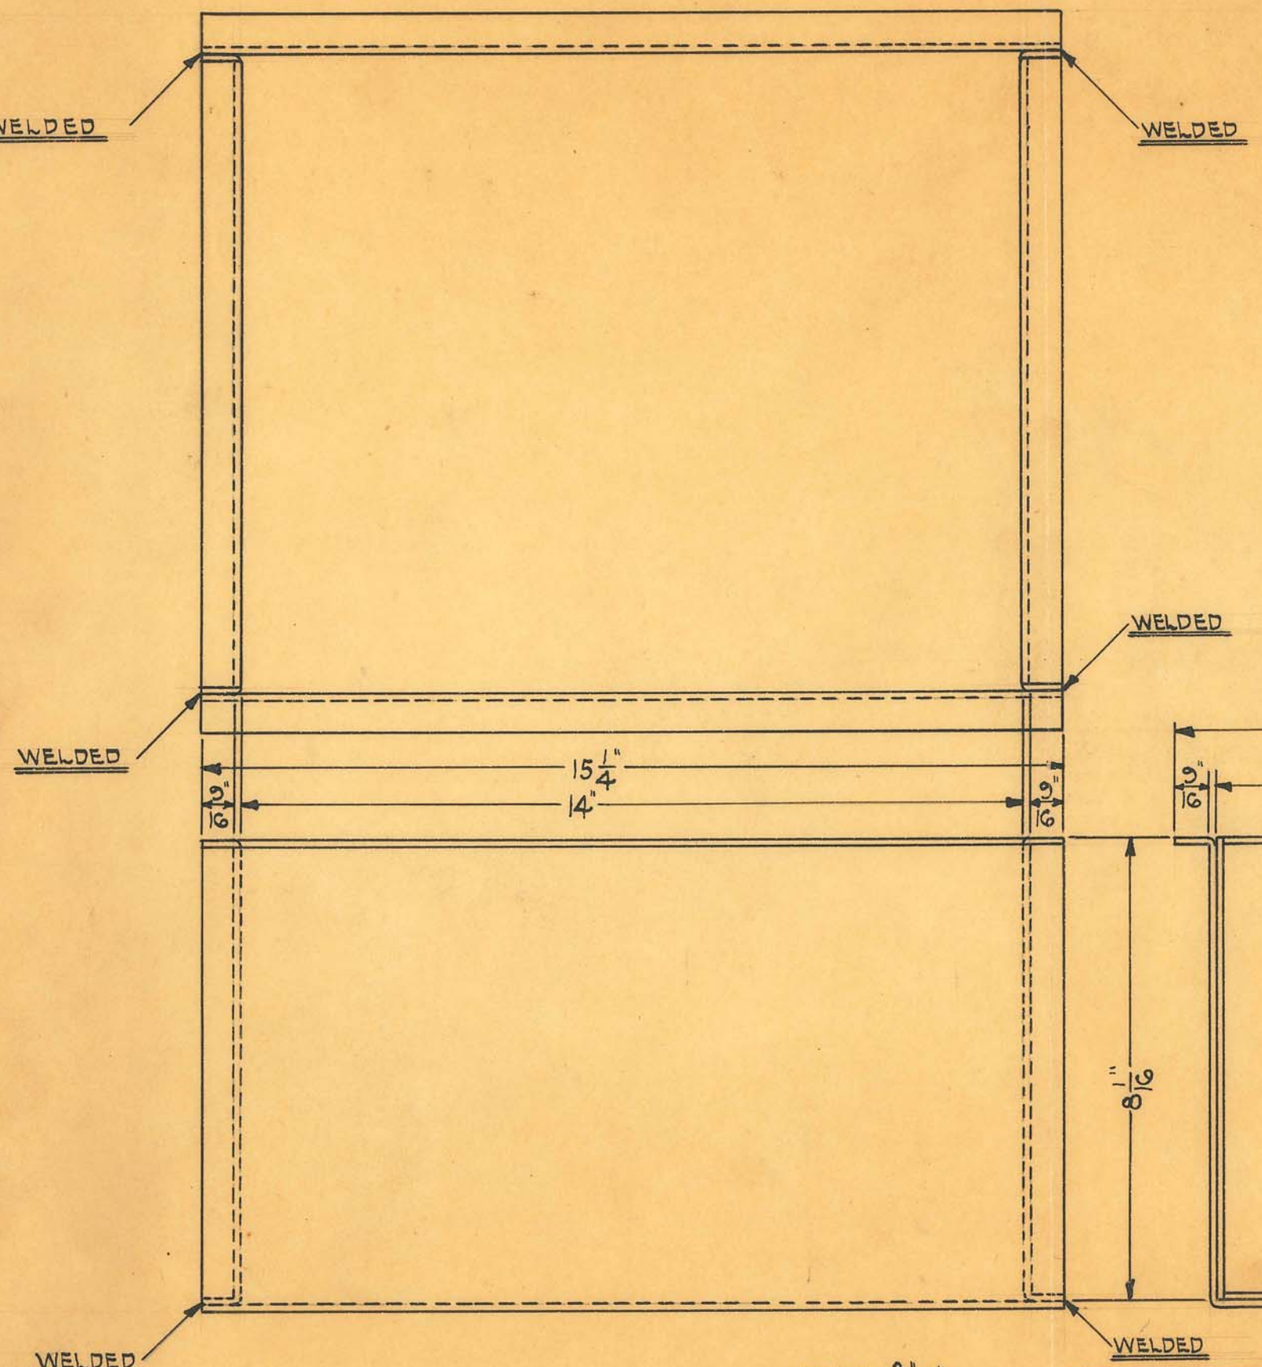

SCALE ~ 3/8" = 1"

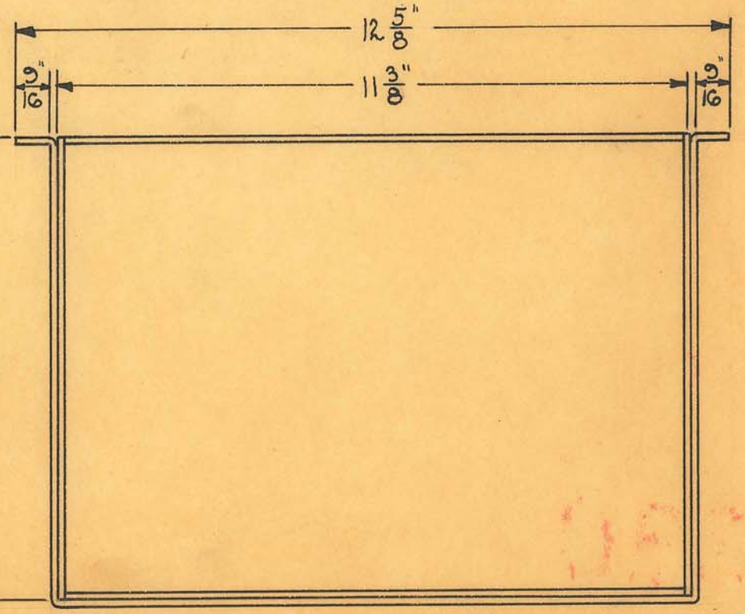

SIZE	1/16"	ISSUE 11-15-30	H.E.
KIND	FURNITURE STEEL	CHANGED	
SHAPE	SHEET	" "	
FINISH		" "	
TEMP.		" "	
PATT.		" "	

TITLE: SENIOR "F" IN OIL TRANSFORMER TANK

OBSOLETE

H. G. FISCHER & CO.
2335 WABANSIA AVE.
CHICAGO, ILL.

CAT. NO.

PART NO. F1072

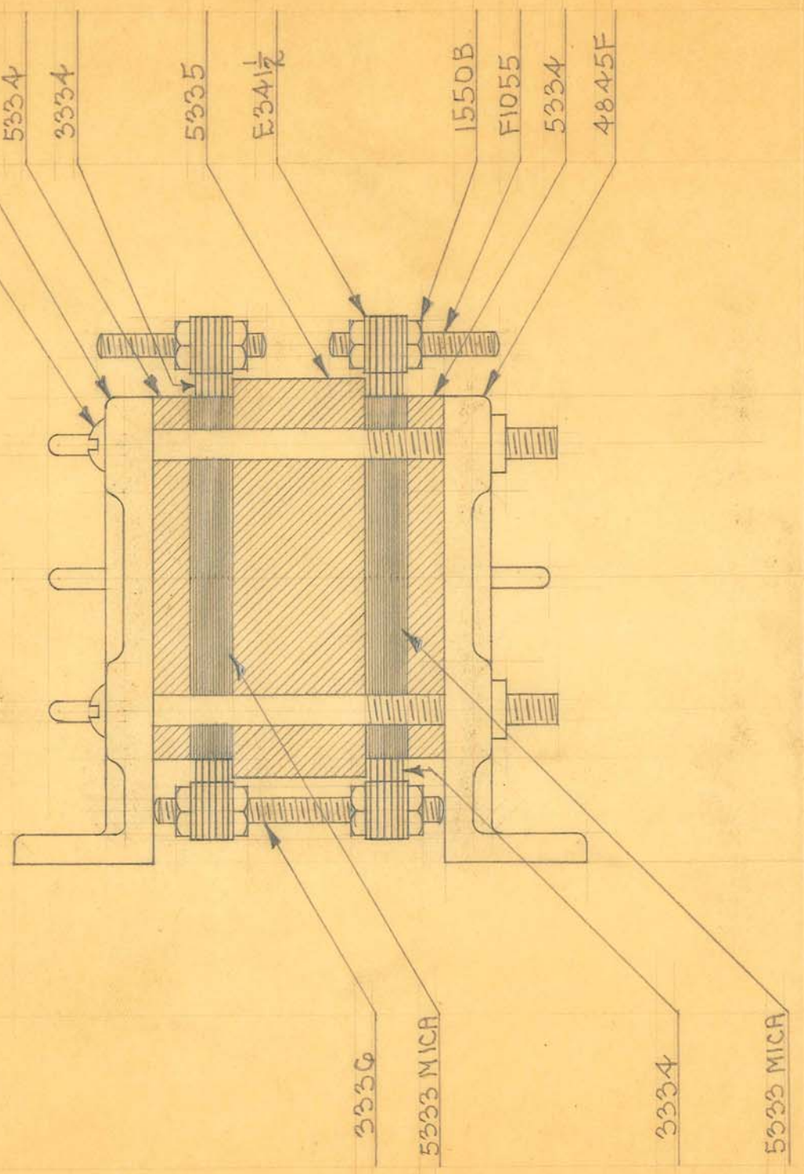

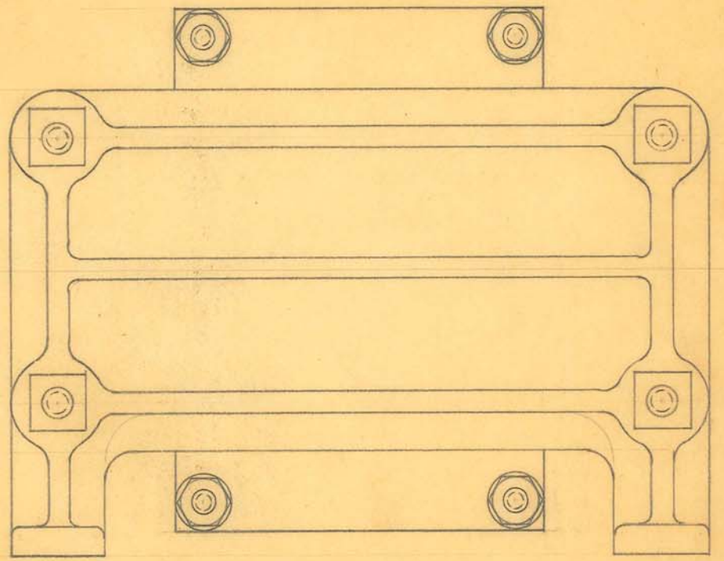

NOTE~
MICA SPLIT TO .012" (4-7 SHEETS)
2-12 PLATE CONDS. JIG #4126

OBSOLETE

SIZE		ISSUE 2-26-32	A.E.	TITLE: SENIOR "V" BLOCKING CONDENSER
KIND		CHANGED		
SHAPE		" "		
FINISH		" "		
TEMP.		" "		H. G. FISCHER & CO. 2335 WABANSIA AVE. CHICAGO, ILL. — CAT. NO. — PART NO. 4845G
PATT.		" "		

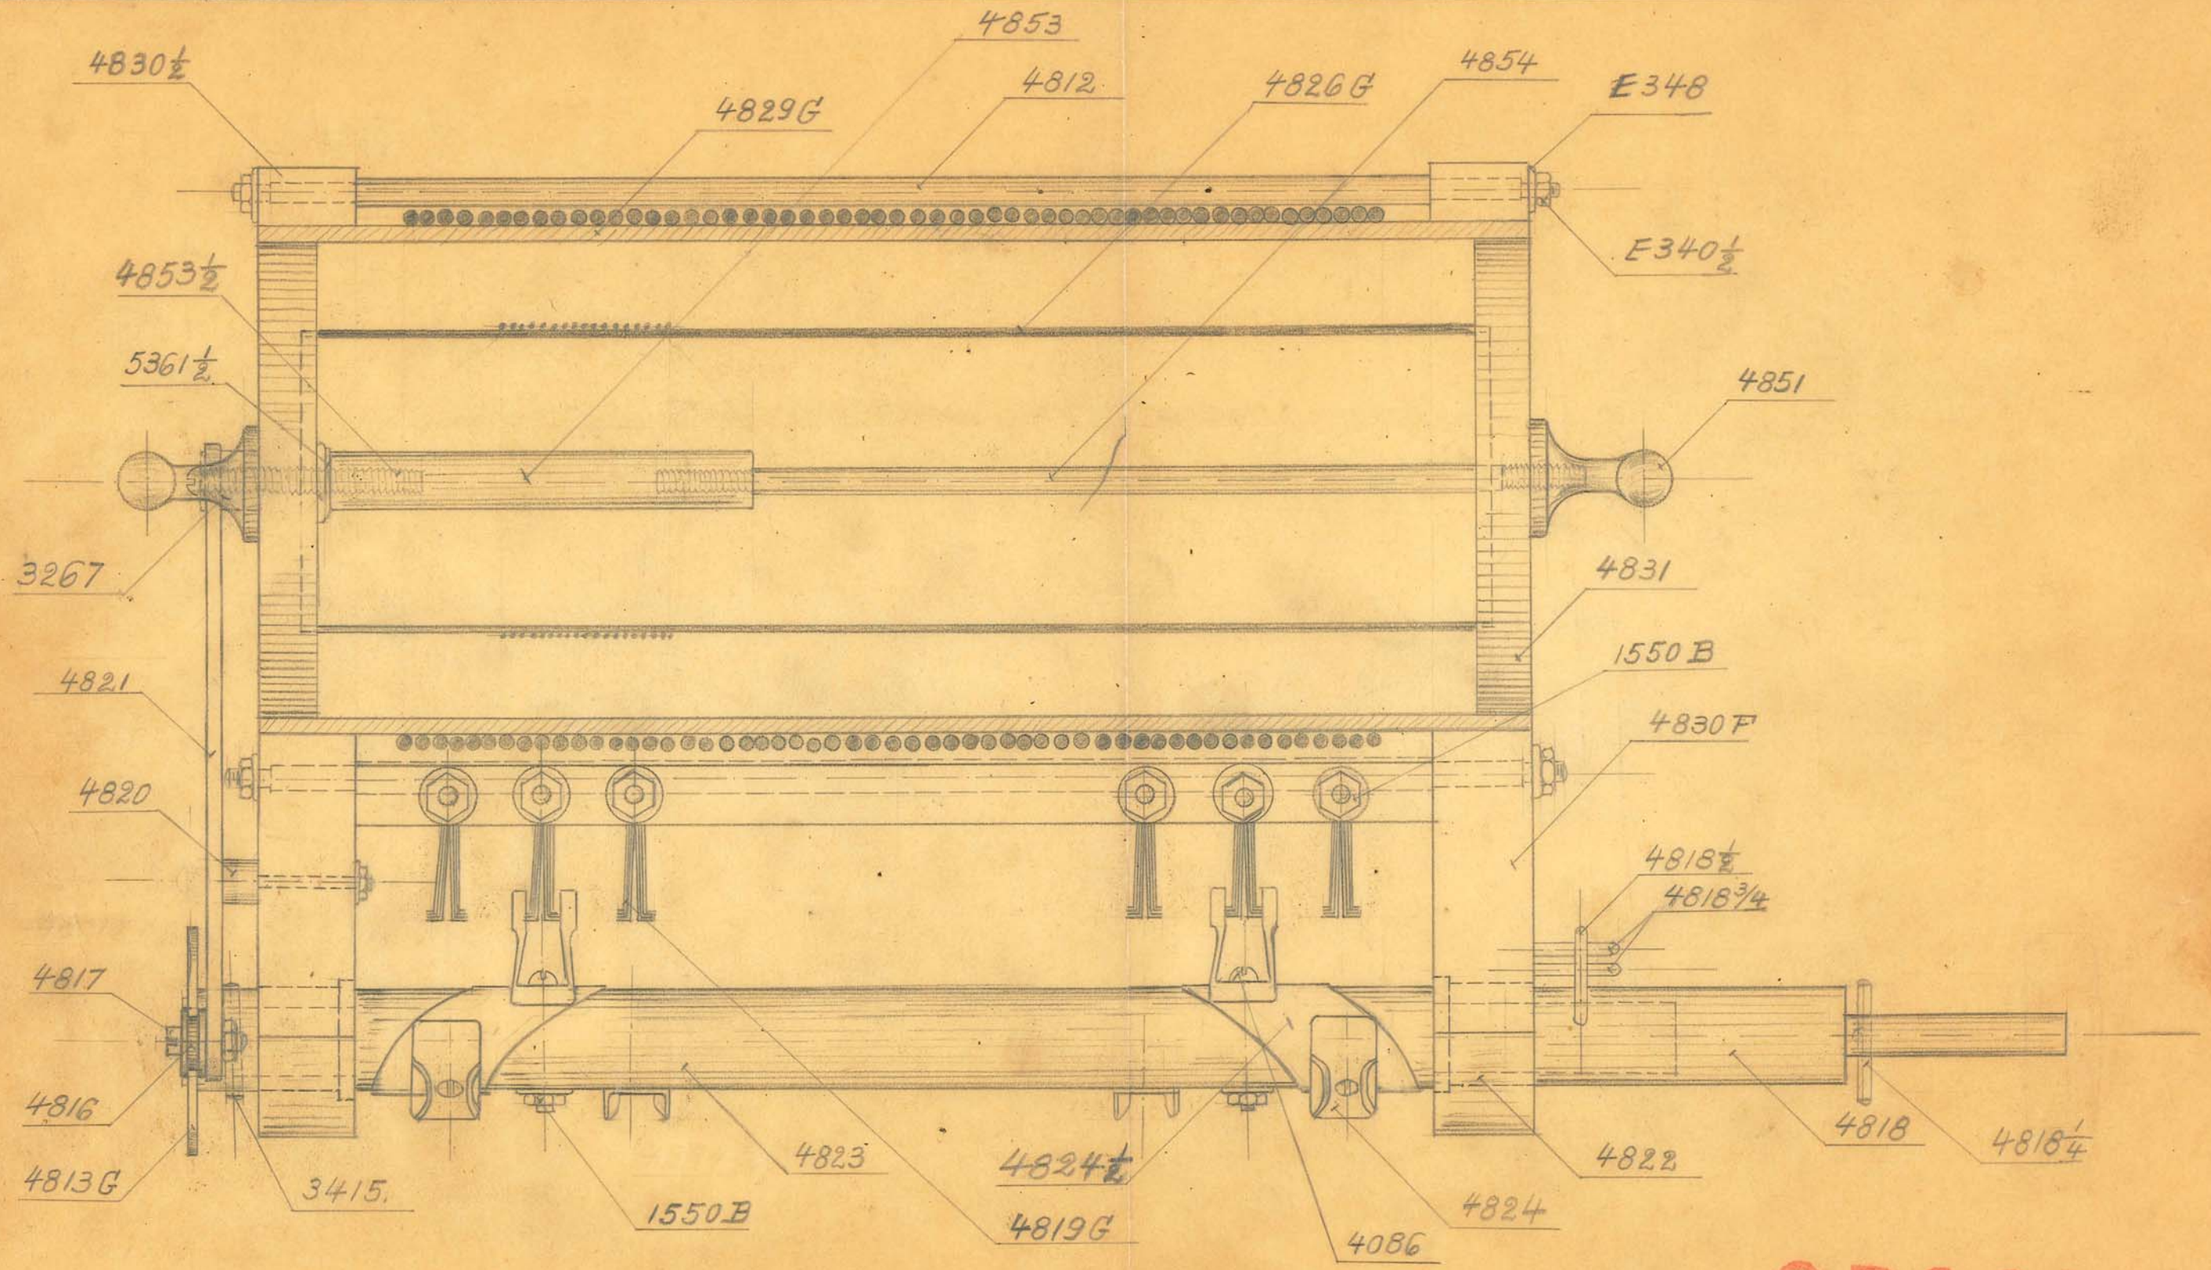

OBSOLETE

SIZE		ISSUE 5/2.27	P.U.
KIND		CHANGED	
SHAPE		" "	
FINISH		" "	
TEMP.		" "	
PATT.		" "	

TITLE: SELECTOR SWITCH & COIL ASSEM. SR "V"

H. G. FISCHER & CO.
2335 WABANSIA AVE.
CHICAGO, ILL.

CAT. NO.

PART NO. 4808G

(1)

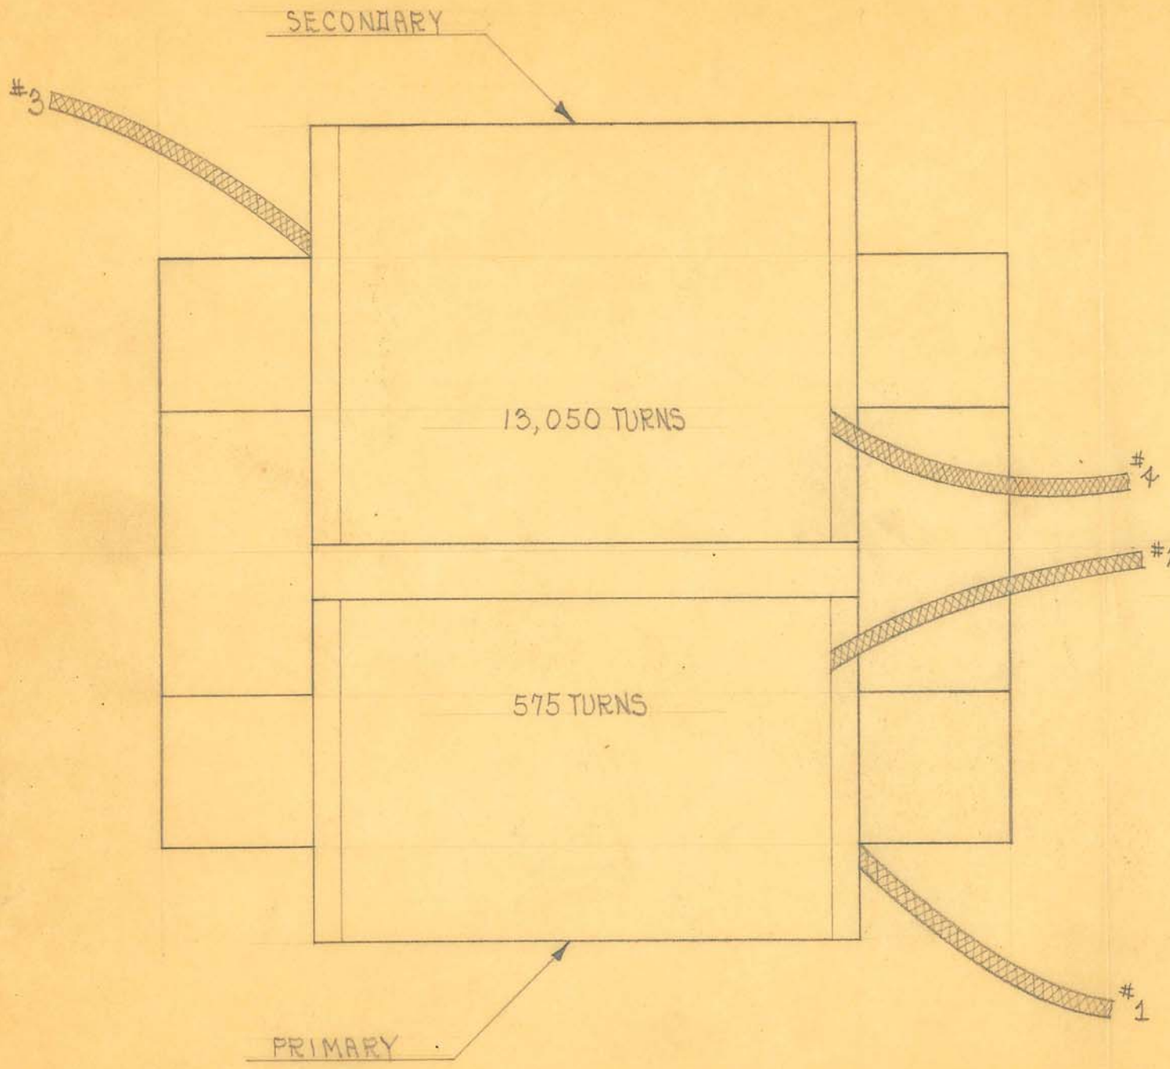

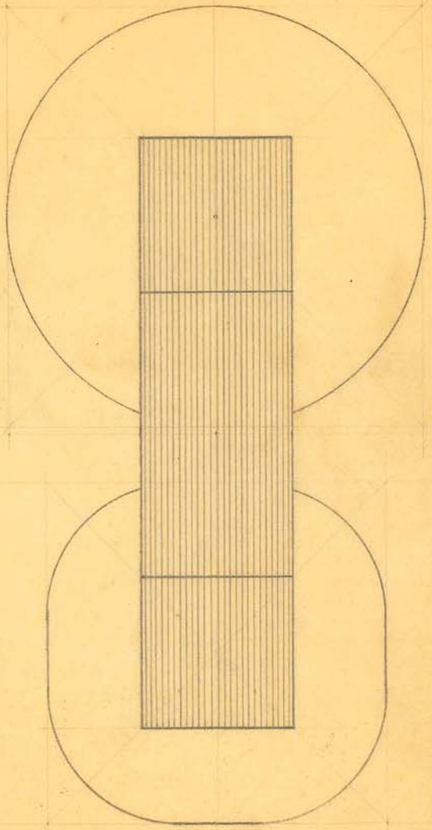

STEEL SIZES

PC. NO. 5043

PRI. & SEC. CORES. CUT $4\frac{5}{8}$" X 1" BUILT UP TO 1"
JIG. # $287\frac{1}{2}$.
END PIECES CUT $2\frac{7}{8}$" X 1".
BIND CORES WITH FRICTION TAPE.

WINDING DATA

PRIMARY

USE # 18 COTENAMEL WIRE.
3 LAYERS OF $5020\frac{1}{2}$ FIBROID PAPER ON CORE.
ANCHOR LEAD #1 WITH FRICTION TAPE AND WIND 9 LAYERS OF 60 TURNS EACH & A TENTH LAYER OF 35 TURNS. TOTAL 575 TURNS. ANCHOR END WITH FRICTION TAPE-LEAD #2. 1 LAYER OF $5020\frac{1}{2}$ FIBROID PAPER BETWEEN EACH LAYER OF WIRE. COVER TENTH LAYER OF WIRE WITH 5004 OILED TAPE & SHELLAC. LEADS ARE 1603-#18 STRANDED WIRE.

SECONDARY

USE # 31 ENAMEL WIRE.
3 LAYERS OF $5020\frac{1}{2}$ FIBROID PAPER ON CORE.
ANCHOR LEAD #3 WITH FRICTION TAPE AND WIND 46 LAYERS OF 280 TURNS EACH & A 47TH LAYER OF 170 TURNS. TOTAL 13,050 TURNS. ANCHOR END WITH FRICTION TAPE-LEAD #4. 1 LAYER OF $5020\frac{1}{2}$ FIBROID PAPER BETWEEN EACH LAYER OF WIRE. COVER 47TH LAYER OF WIRE WITH 5004 OILED TAPE & SHELLAC. LEADS ARE 1648-#20 WEATHERPROOF WIRE.
WIND 1 LAYER OF $5026\frac{3}{4}$ EMPIRE CLOTH BETWEEN 1ST & 2ND AND 2ND & 3RD LAYERS OF WIRE IN ADDITION TO $5020\frac{1}{2}$ FIBROID.

OBSOLETE

SIZE		ISSUE 3-14-32	A.E.	TITLE: "S" OUTFIT TRANSFORMER
KIND		CHANGED		
SHAPE		" "		
FINISH		" "		
TEMP.		" "		
PATT.		" "		

H. G. FISCHER & CO.
2335 WABANSIA AVE.
CHICAGO, ILL.

CAT. NO.

PART NO. 6835G

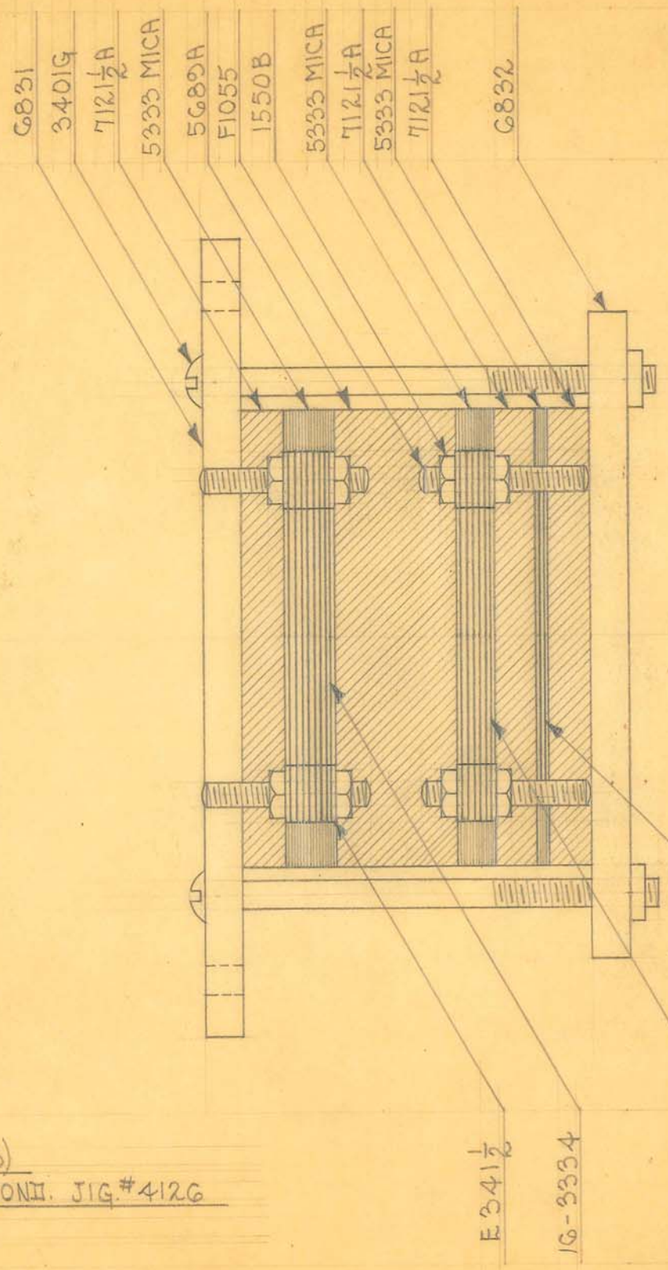

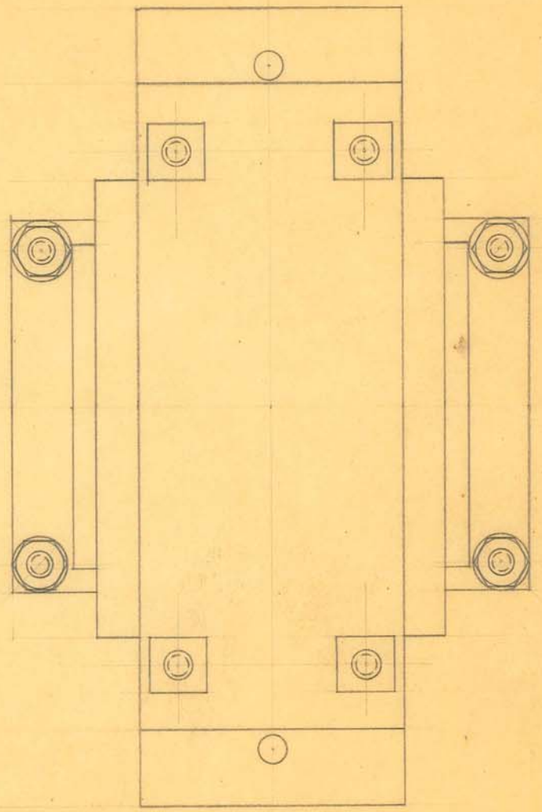

NOTE:-
MICA SPLIT TO .012" (4-7 SHEETS)
1-12 PLATE CONN. 1-16 PLATE CONN. JIG. #4126
1-3 PLATE GRN. CONN.

SIZE		ISSUE 2-17-32	A.E.
KIND		CHANGED	
SHAPE		" "	
FINISH		" "	
TEMP.		" "	
PATT.		" "	

TITLE: SURGICAL DIATHERMY OUTFIT CONDENSER ASSEM.

OBSOLETE

H. G. FISCHER & CO.
2335 WABANSIA AVE.
CHICAGO, ILL.

CAT. NO.

PART NO. G830G

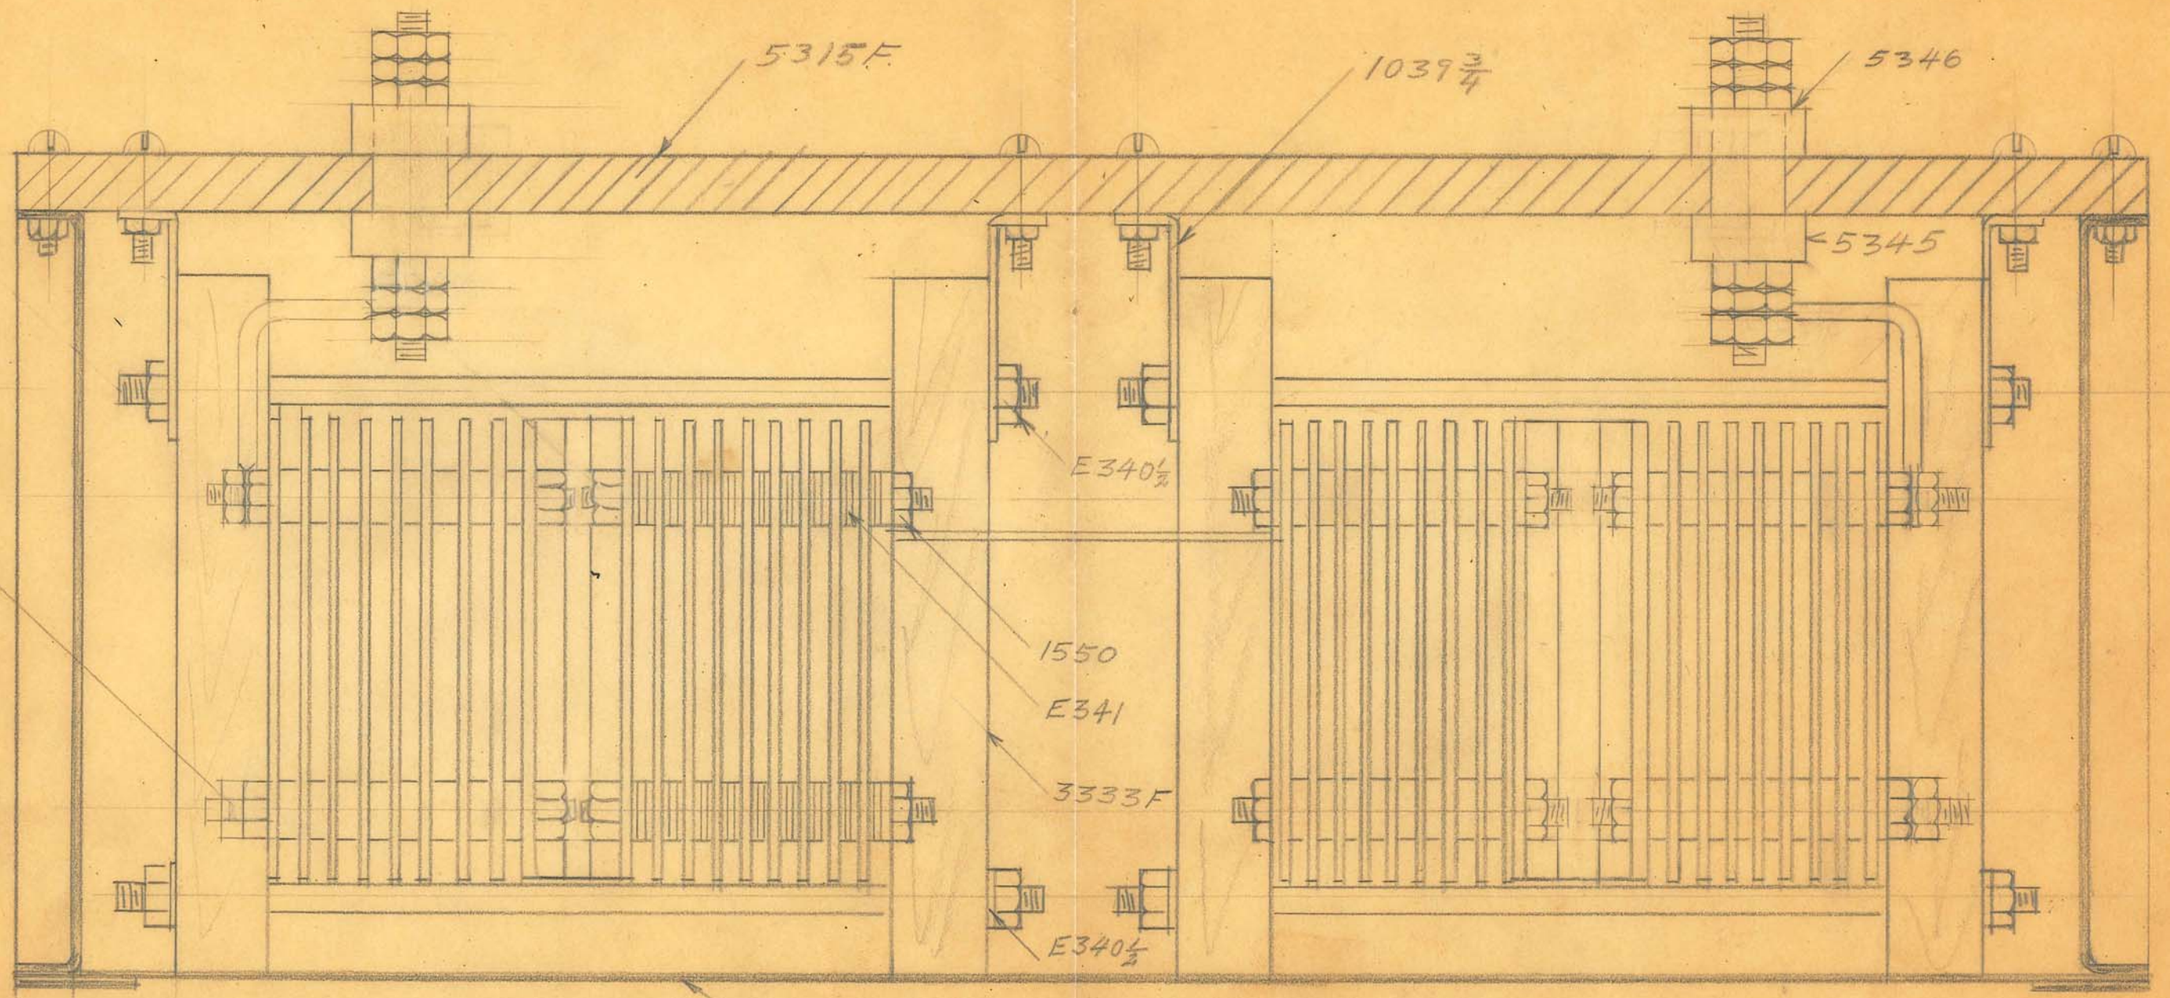

OBSOLETE

SIZE		ISSUE 3-24-26	DP.
KIND		CHANGED	
SHAPE		" "	
FINISH		" "	
TEMP.		" "	
PATT.		" "	

TITLE: TYPE "V" MED. DIA. CONNDENSER COMPL.

H. G. FISCHER & CO.
2335 WABANSIA AVE.
CHICAGO, ILL.

CAT. NO.

PART NO. 5331G

(1)

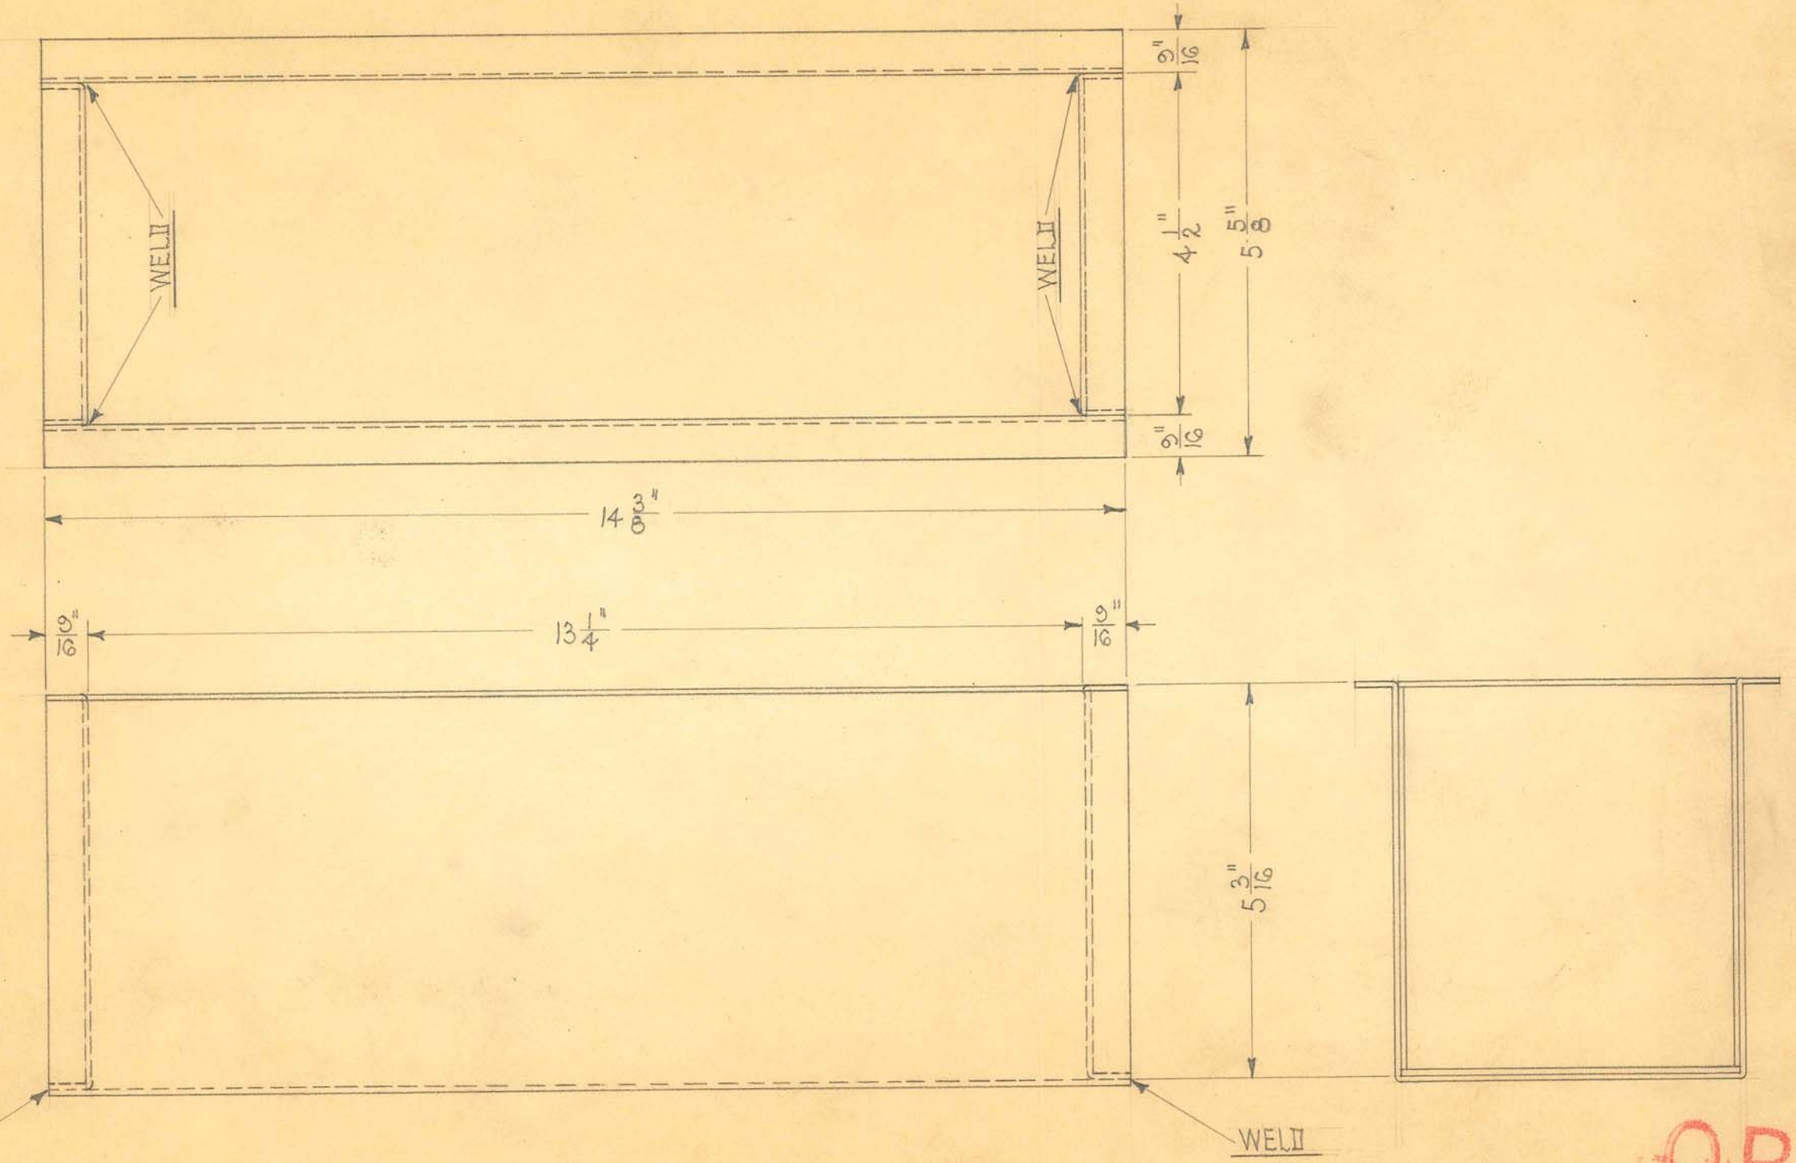

SCALE ~ HALF SIZE

MAT'L. ~ #16 U.S.S. GA. (.064") FURNITURE STEEL

OBSOLETE

SIZE		ISSUE 12-14-32	H.E.	TITLE: TYPE "V" CONDENSER TANK
KIND		CHANGED		
SHAPE		" "		
FINISH		" "		
TEMP.		" "		H. G. FISCHER & CO. 2335 WABANSIA AVE. CHICAGO, ILL. — CAT. NO. — PART NO. 5314
PATT.		" "		

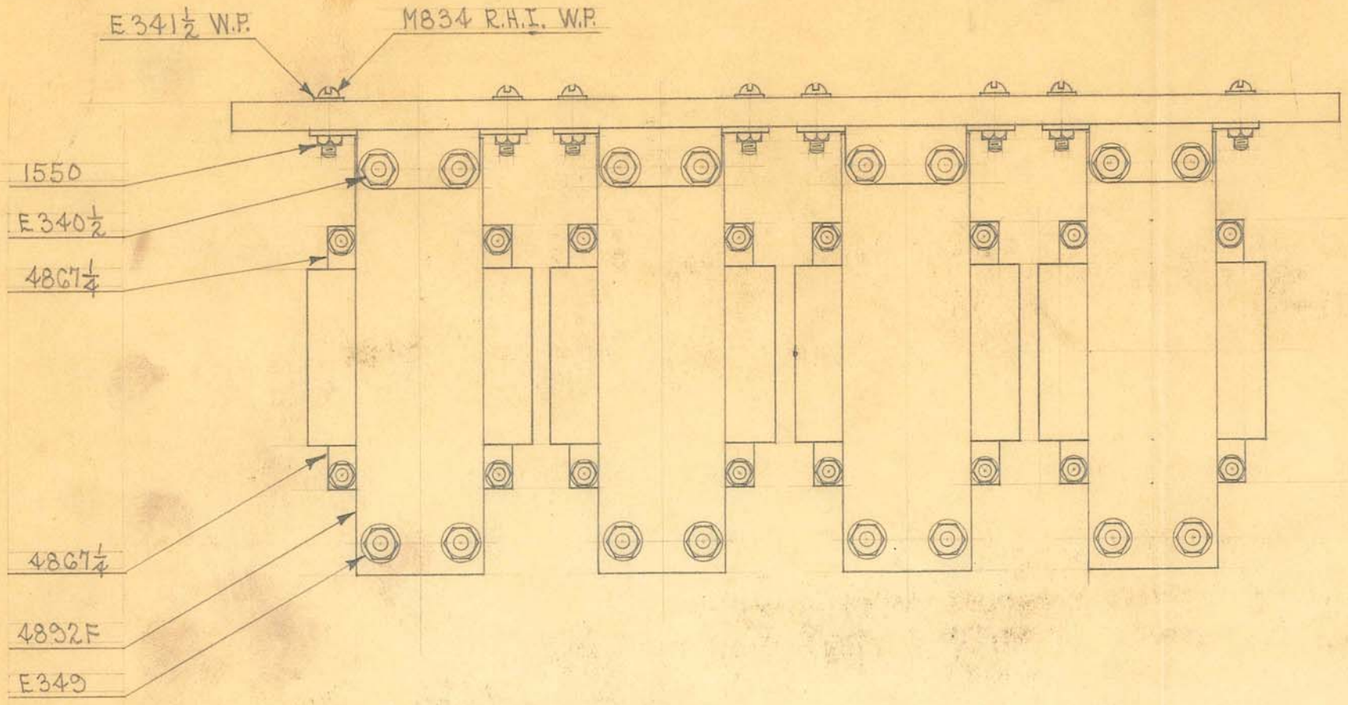

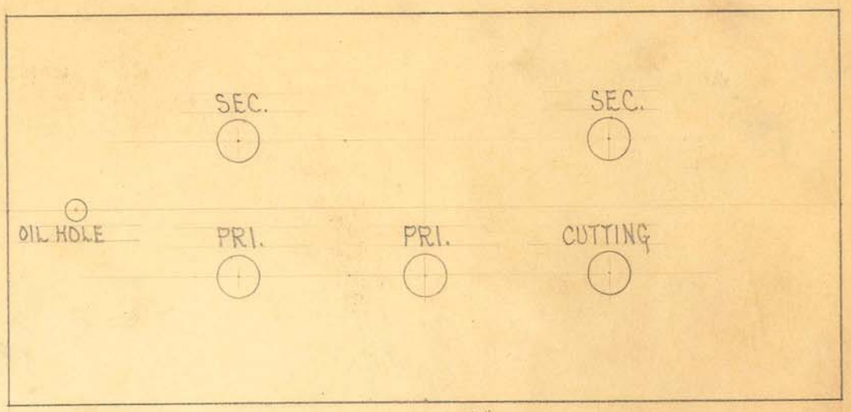

SCALE~ 3/8" = 1"

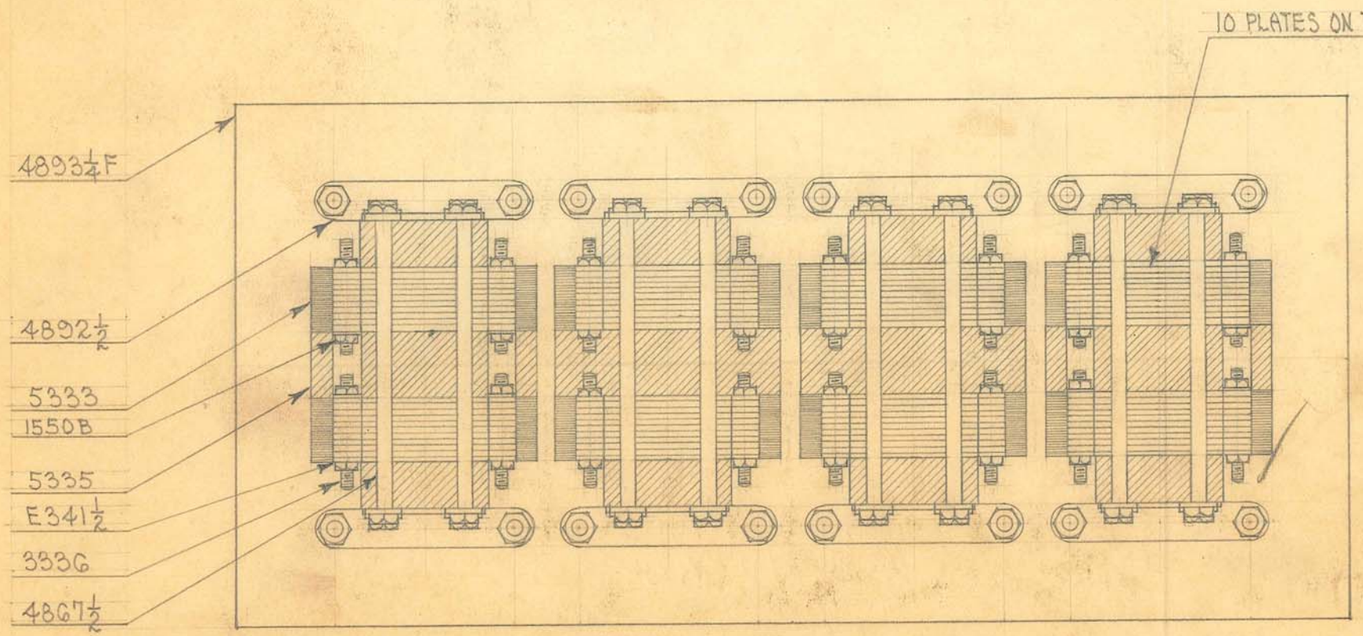

SCALE~ ½" = 1"

NOTE~

MICA SPLIT TO .012" (4-7 SHEETS).
8-10 PLATE CONDS. JIG.#4126.
2-E341½ WASHERS BETWEEN EACH PLATE
EXCEPT BETWEEN END PLATES & NUTS.

OBSOLETE

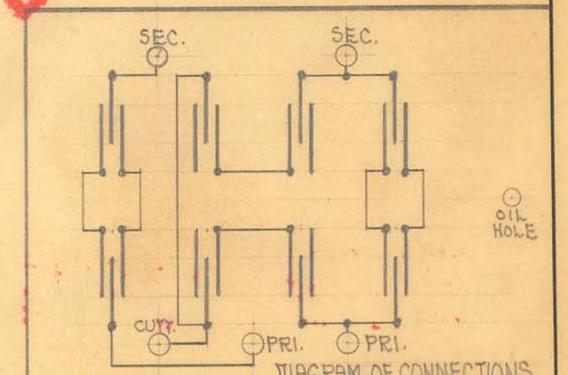

DIAGRAM OF CONNECTIONS

SIZE		ISSUE 11-3-32	A.C.
KIND		CHANGED	
SHAPE		" "	
FINISH		" "	
TEMP.		" "	
PATT.		" "	

TITLE: SENIOR "V" CUTTING CONDENSER & TANK
(DRAWING LESS TANK)

H. G. FISCHER & CO.
2335 WABANSIA AVE.
CHICAGO, ILL.

CAT. NO.

PART NO. 4893G

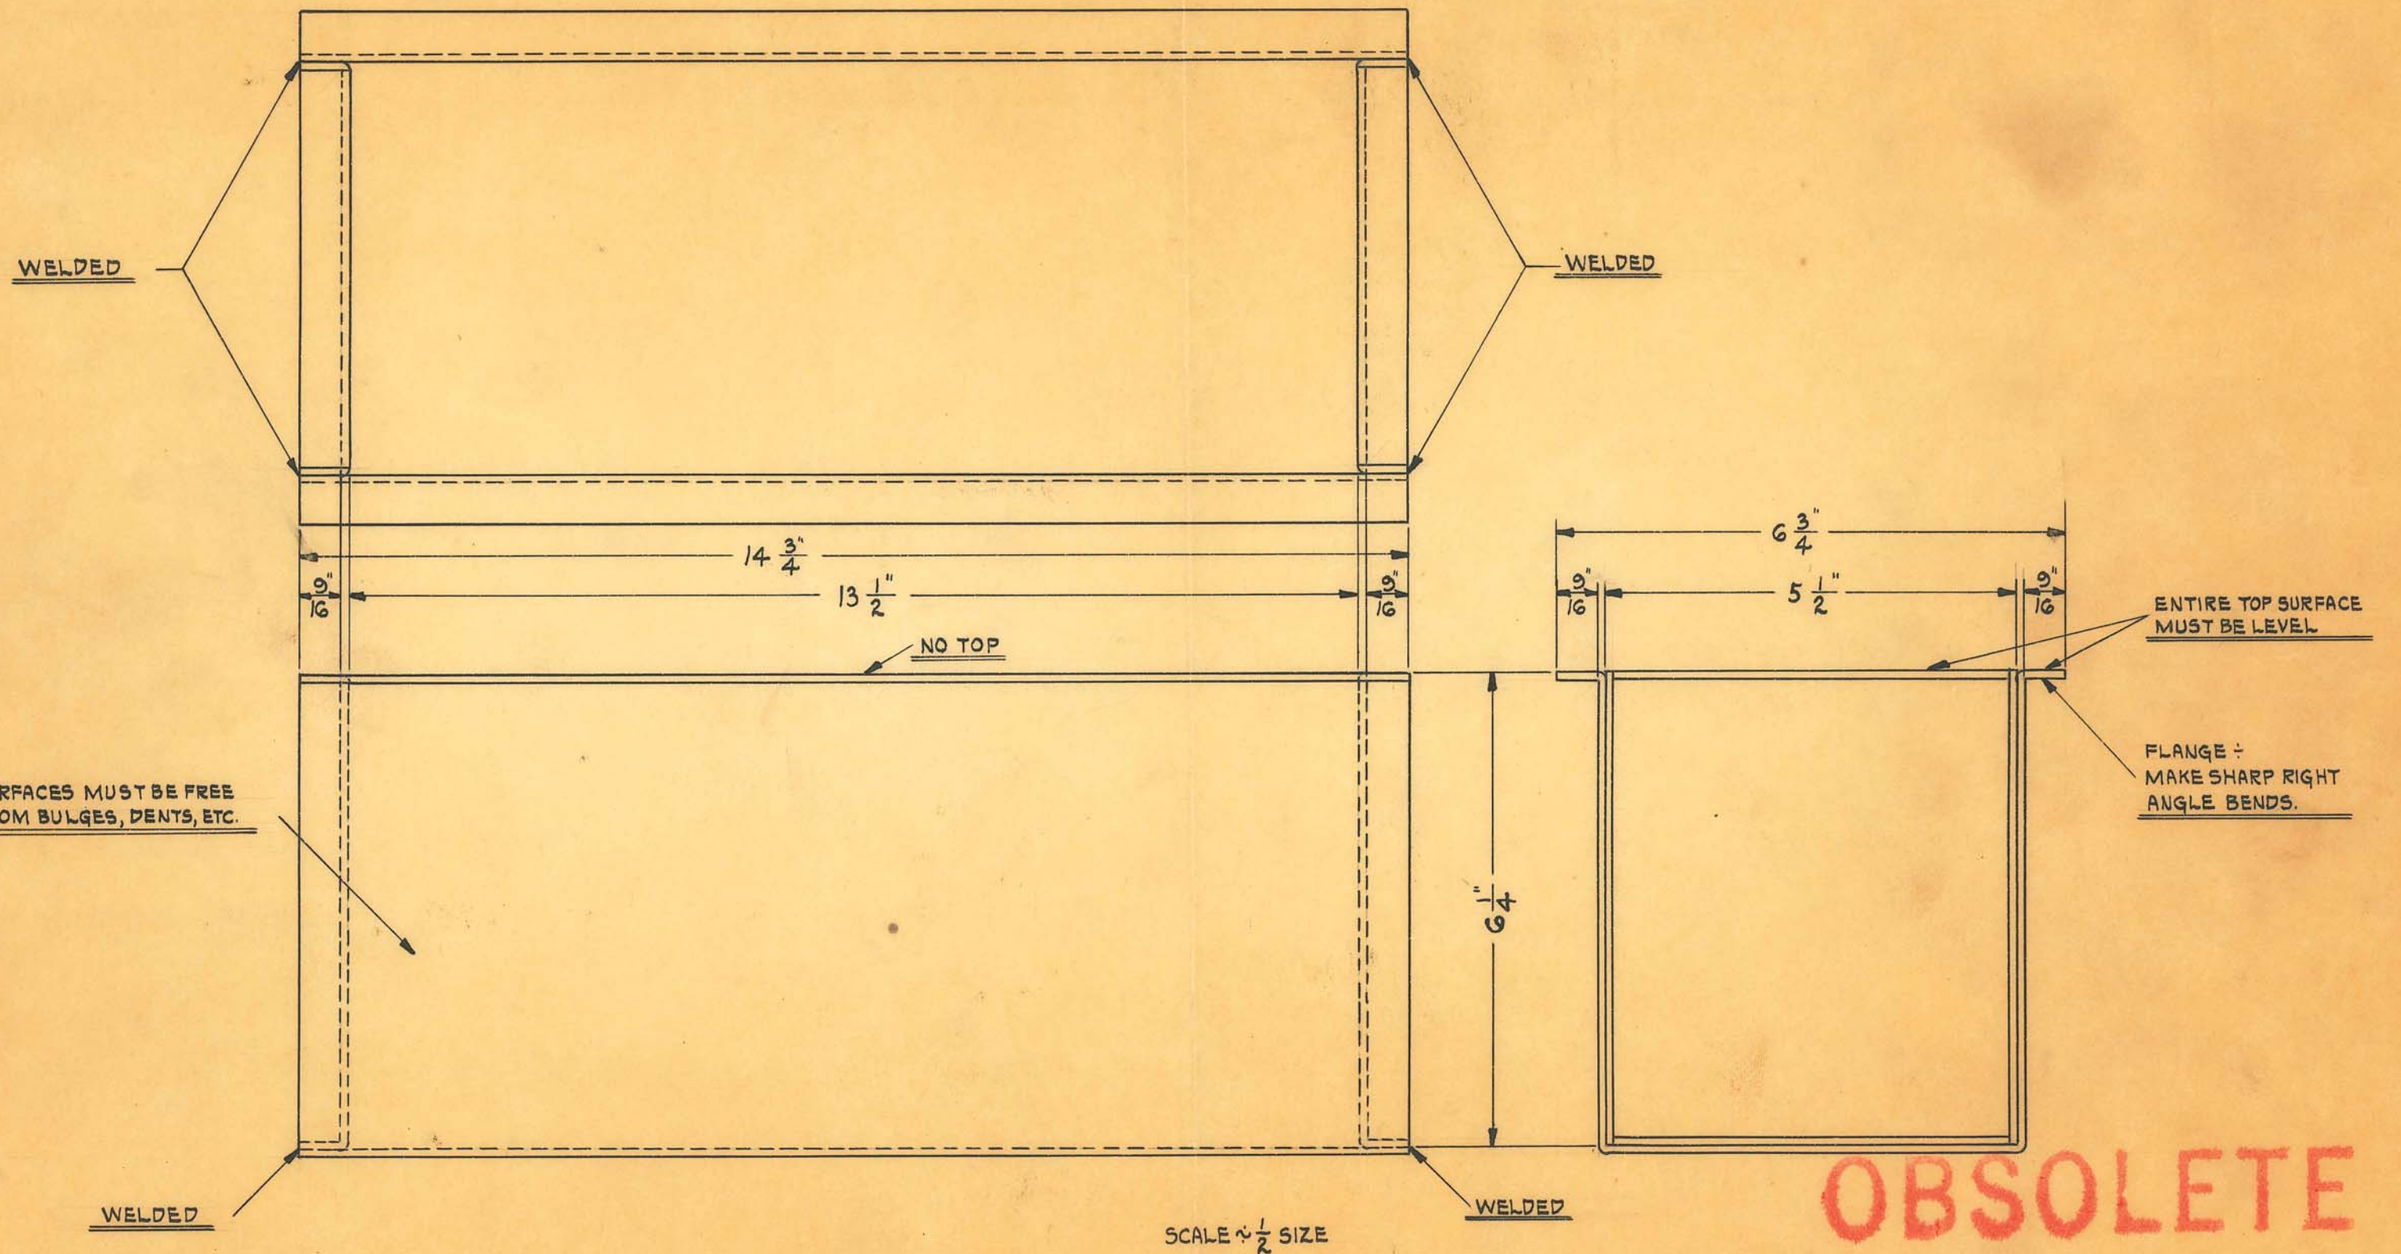

SCALE ~ 1/2 SIZE

OBSOLETE

WELDED÷ MUST BE OIL TIGHT. TEST FOR LEAKS WITH KEROSENE. GIVE OUTSIDE OF TANK KEROSENE BATH TO KEEP FROM RUSTING.

SIZE	1/16"	ISSUE H.E	6-20-30
KIND	FURNITURE STEEL	CHANGED	
SHAPE	SHEET	" "	
FINISH		" "	
TEMP.		" "	
PATT.		" "	

TITLE: SENIOR "V" CUTTING CONDENSER TANK

H. G. FISCHER & CO.
2335 WABANSIA AVE.
CHICAGO, ILL.

CAT. NO.

PART NO. 4893

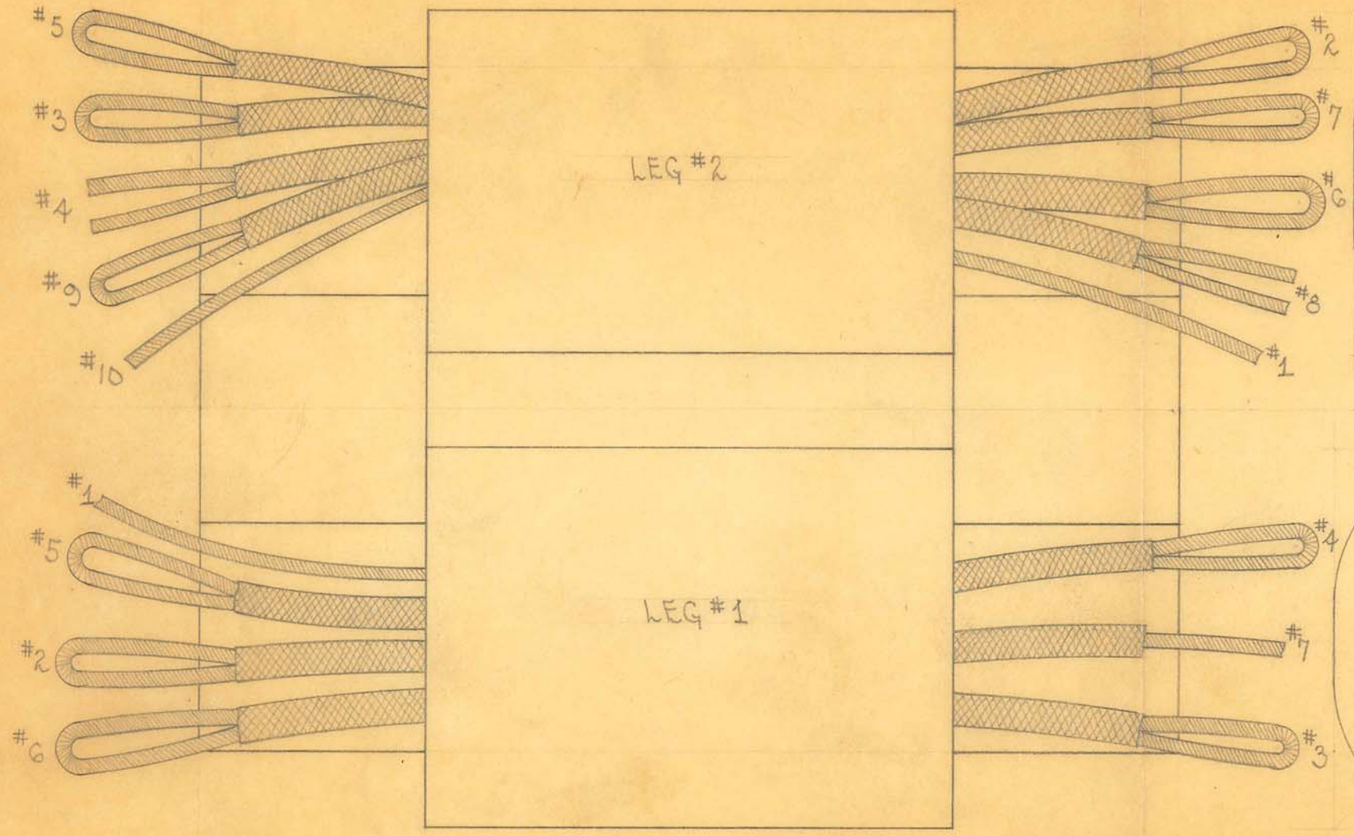

STEEL SIZES

PC. No. 5043

LEGS #1 & #2 - CUT 5" X 1½" BUILT UP TO 1¾".
END PIECES - CUT 3" X 1½"
BIND LEGS WITH FRICTION TAPE.

WINDING DATA

LEG #1

USE #12 COTENAMEL WIRE
3 LAYERS OF 502G OILED CLOTH ON CORE.
ANCHOR LEAD #1 WITH FRICTION TAPE.
WIND 14 TURNS & BRING OUT TAP #2. ANCHOR WITH FRICTION TAPE. WIND 14 TURNS & BRING OUT TAP #3. ANCHOR WITH FRICTION TAPE. WIND 14 TURNS & BRING OUT TAP #4. ANCHOR WITH FRICTION TAPE. WIND 14 TURNS & BRING OUT TAP #5. ANCHOR WITH FRICTION TAPE. WIND 14 TURNS & BRING OUT TAP #6. ANCHOR WITH FRICTION TAPE. WIND 14 TURNS & ANCHOR END WITH FRICTION TAPE - LEAD #7. 3 LAYERS OF 502G OILED CLOTH BETWEEN EACH LAYER OF WIRE. COVER LAST LAYER OF WIRE WITH 5004 OILED TAPE & SHELLAC.

LEG #2

3 LAYERS OF 502G OILED CLOTH ON CORE. ANCHOR LEAD #1 & WIND 14 TURNS WITH #14 C.E. & BRING OUT TAP #2. ANCHOR WITH FRICTION TAPE. WIND 14 TURNS & BRING OUT TAP #3. ANCHOR WITH FRICTION TAPE. WIND 14 TURNS & ANCHOR END OF #14 C.E & START OF #16 C.E. WITH FRICTION TAPE - TAP #4. WIND 15 TURNS & BRING OUT TAP #5. ANCHOR WITH FRICTION TAPE. WIND 15 TURNS & BRING OUT TAP #6. ANCHOR WITH FRICTION TAPE. WIND 15 TURNS & BRING OUT TAP #7. ANCHOR WITH FRICTION TAPE. WIND 15 TURNS & ANCHOR END OF #16 C.E. & START OF #18 C.E, WITH FRICTION TAPE - TAP #8. WIND 15 TURNS & BRING OUT TAP #9. ANCHOR WITH FRICTION TAPE. WIND 15 TURNS & ANCHOR END WITH FRICTION TAPE - LEAD #10. 3 LAYERS OF 502G OILED CLOTH BETWEEN EACH LAYER OF WIRE. COVER LAST LAYER OF WIRE WITH 5004 OILED TAPE & SHELLAC.

SIZE		ISSUE 5-3-32	H.E.
KIND		CHANGED	
SHAPE		" "	
FINISH		" "	
TEMP.		" "	
PATT.		" "	

TITLE: SENIOR "V" AUTO CONTROL

OBSOLETE

H. G. FISCHER & CO.
2335 WABANSIA AVE.
CHICAGO, ILL.

CAT. NO.

PART NO. 4885G

REAR-VIEW

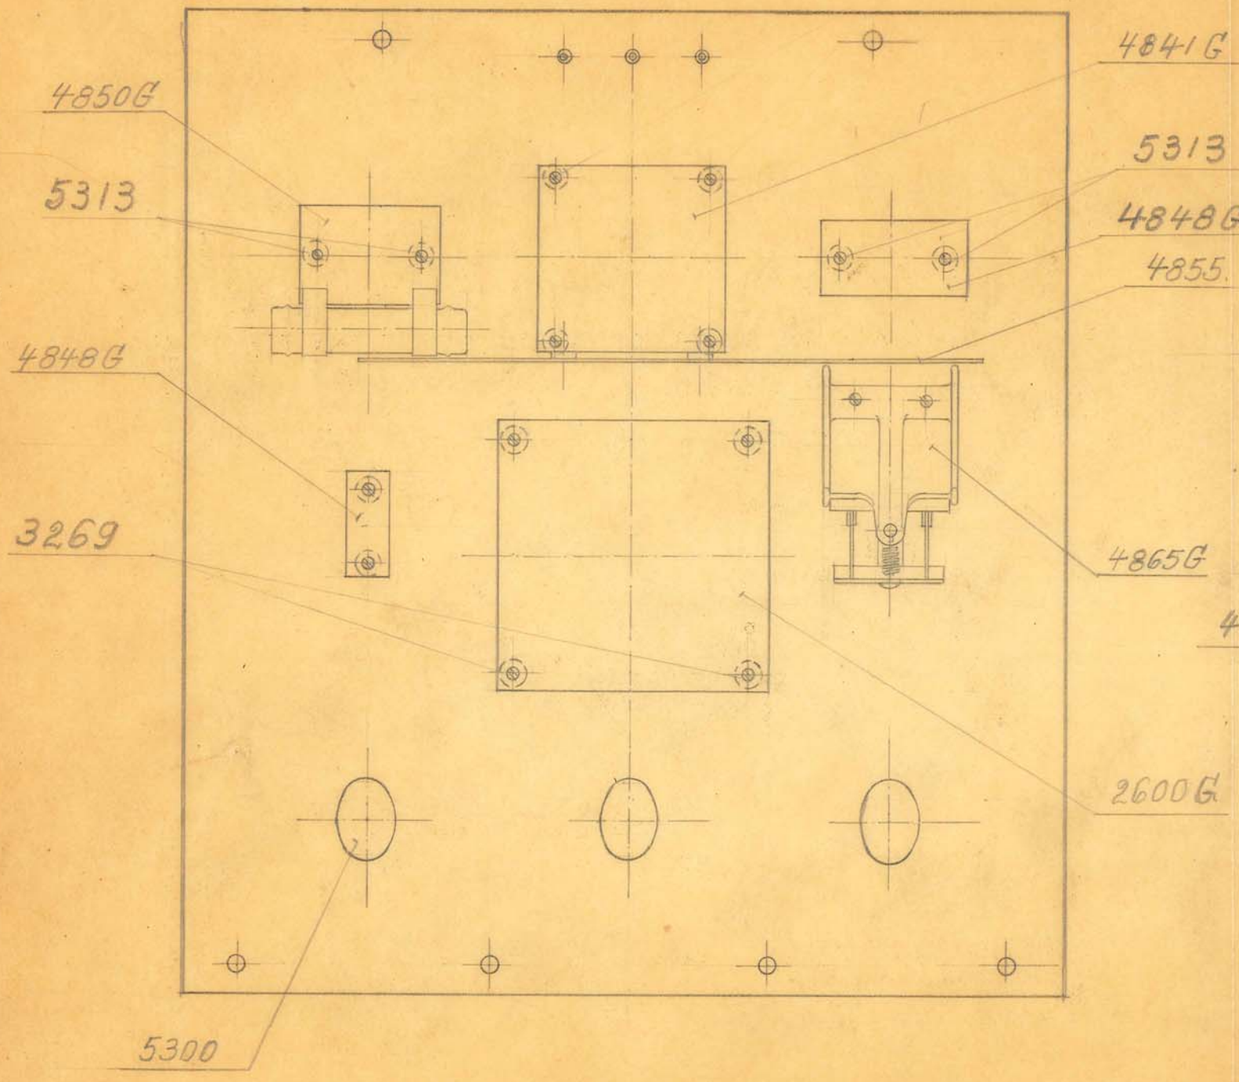

FRONT-VIEW

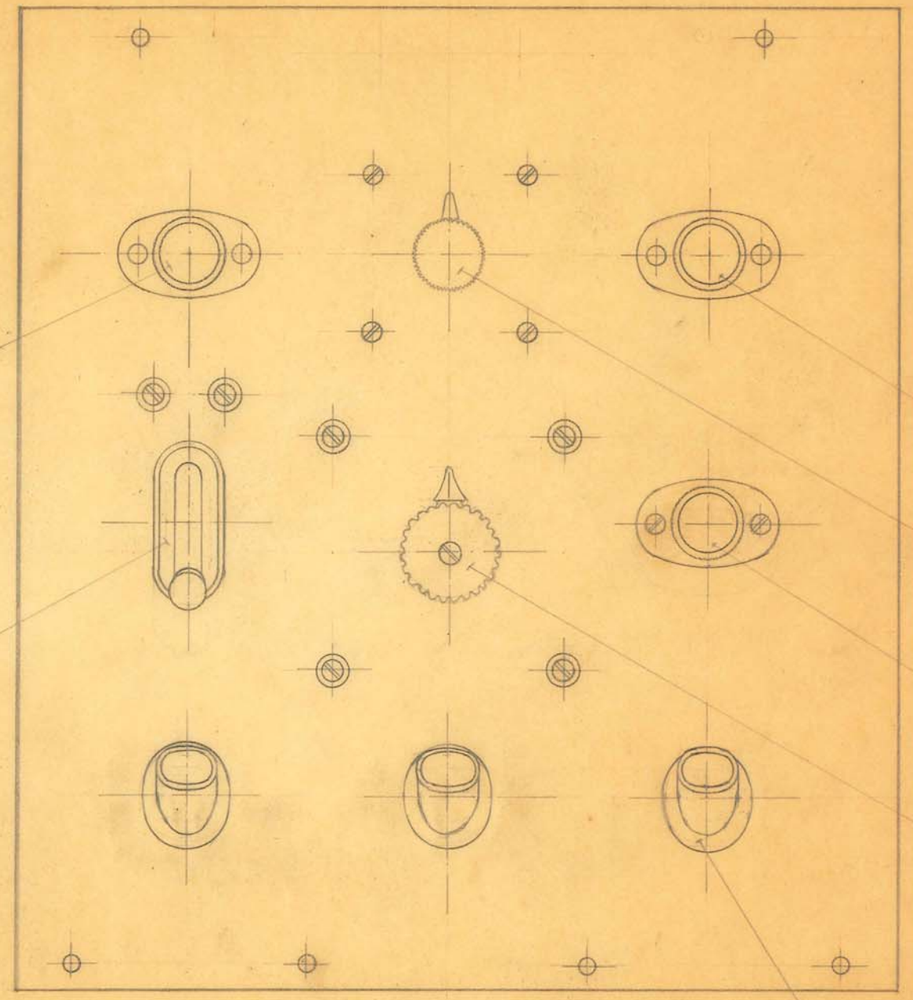

OBSOLETE

SIZE		ISSUE 9/31/27	P.D.	TITLE: PANEL ASSEMBLY SR "V"	
KIND		CHANGED			
SHAPE		" "			
FINISH		" "			
TEMP.		" "			
PATT.		" "		H. G. FISCHER & CO. 2335 WABANSIA AVE. CHICAGO, ILL.	CAT. NO.
					PART NO. 4860G

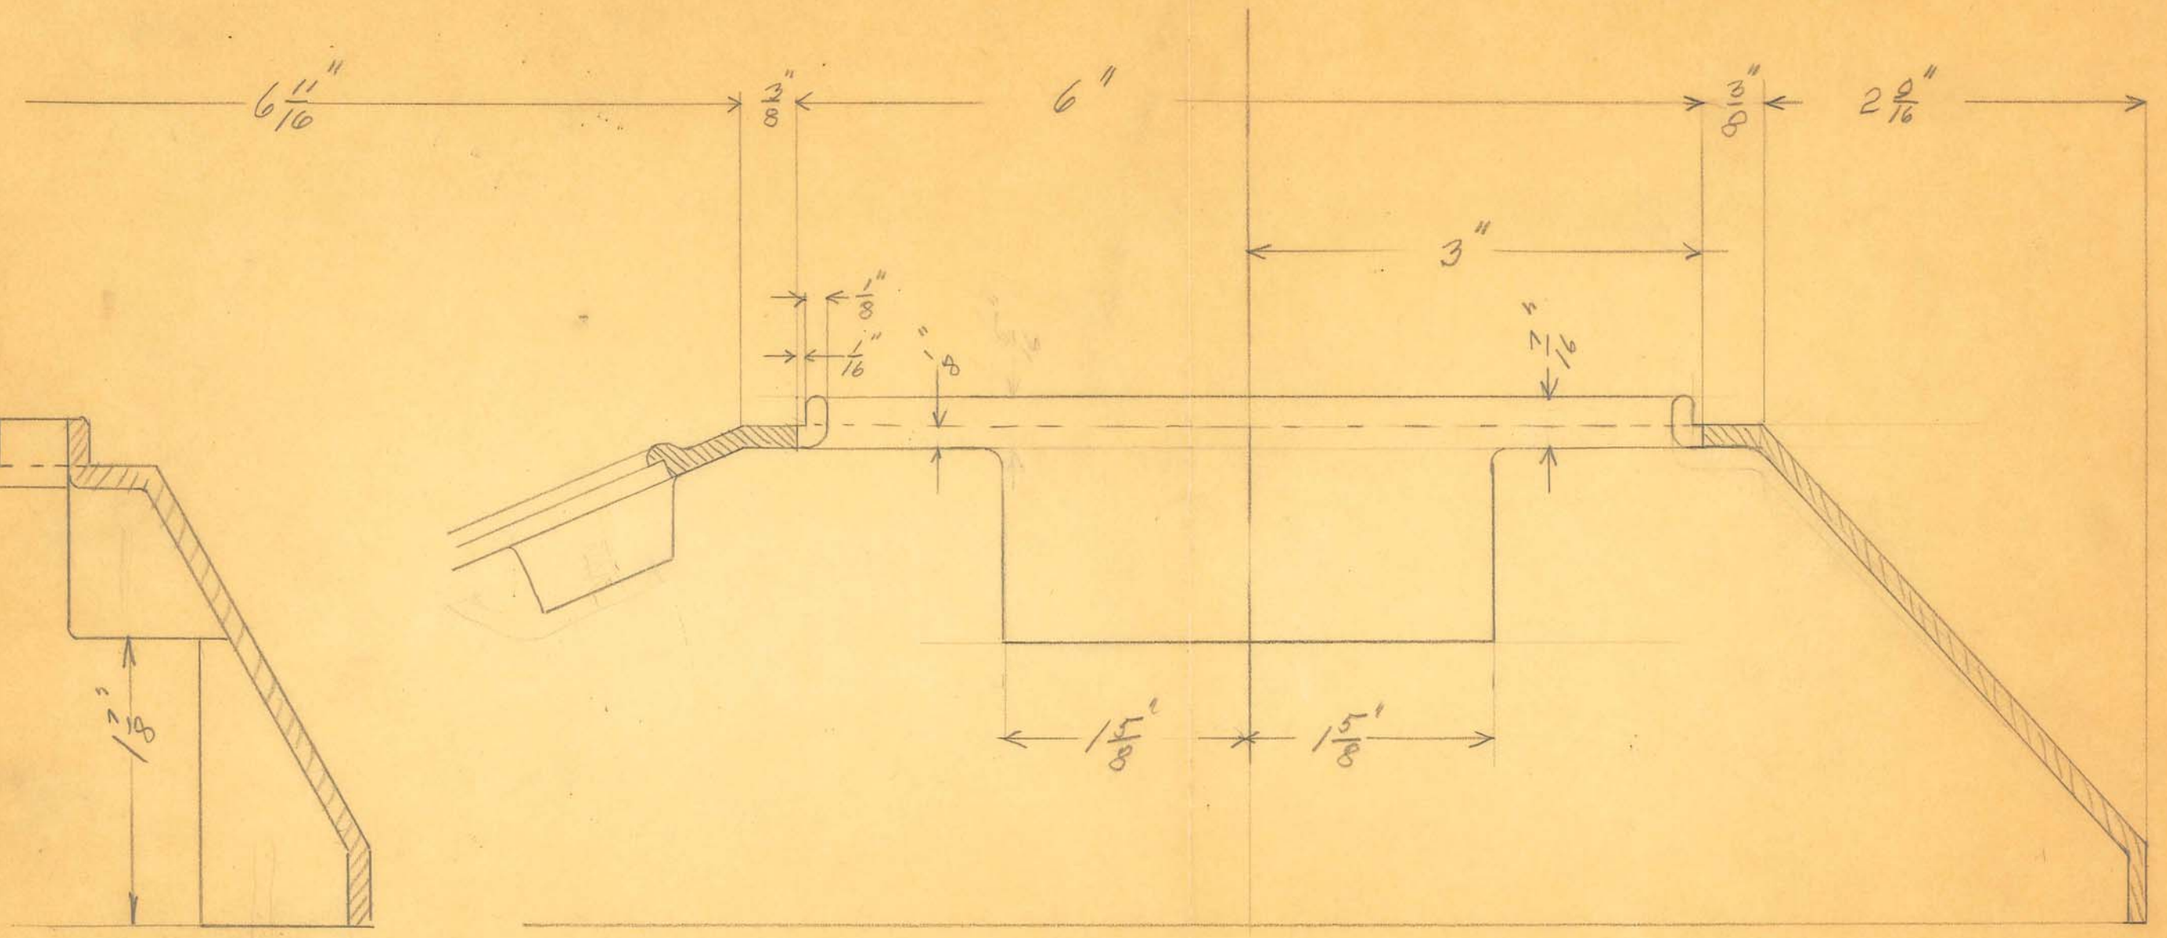

OTHER DIMENSIONS UNCHANGED.

OBSOLETE

SIZE		ISSUE	
KIND		CHANGED	
SHAPE		" "	
FINISH		" "	
TEMP.		" "	
PATT.		" "	

TITLE: Tap for TYPE "V" Intermediate Cleat

H. G. FISCHER & CO.
2335 WABANSIA AVE.
CHICAGO, ILL.

CAT. NO.

PART NO. 4990

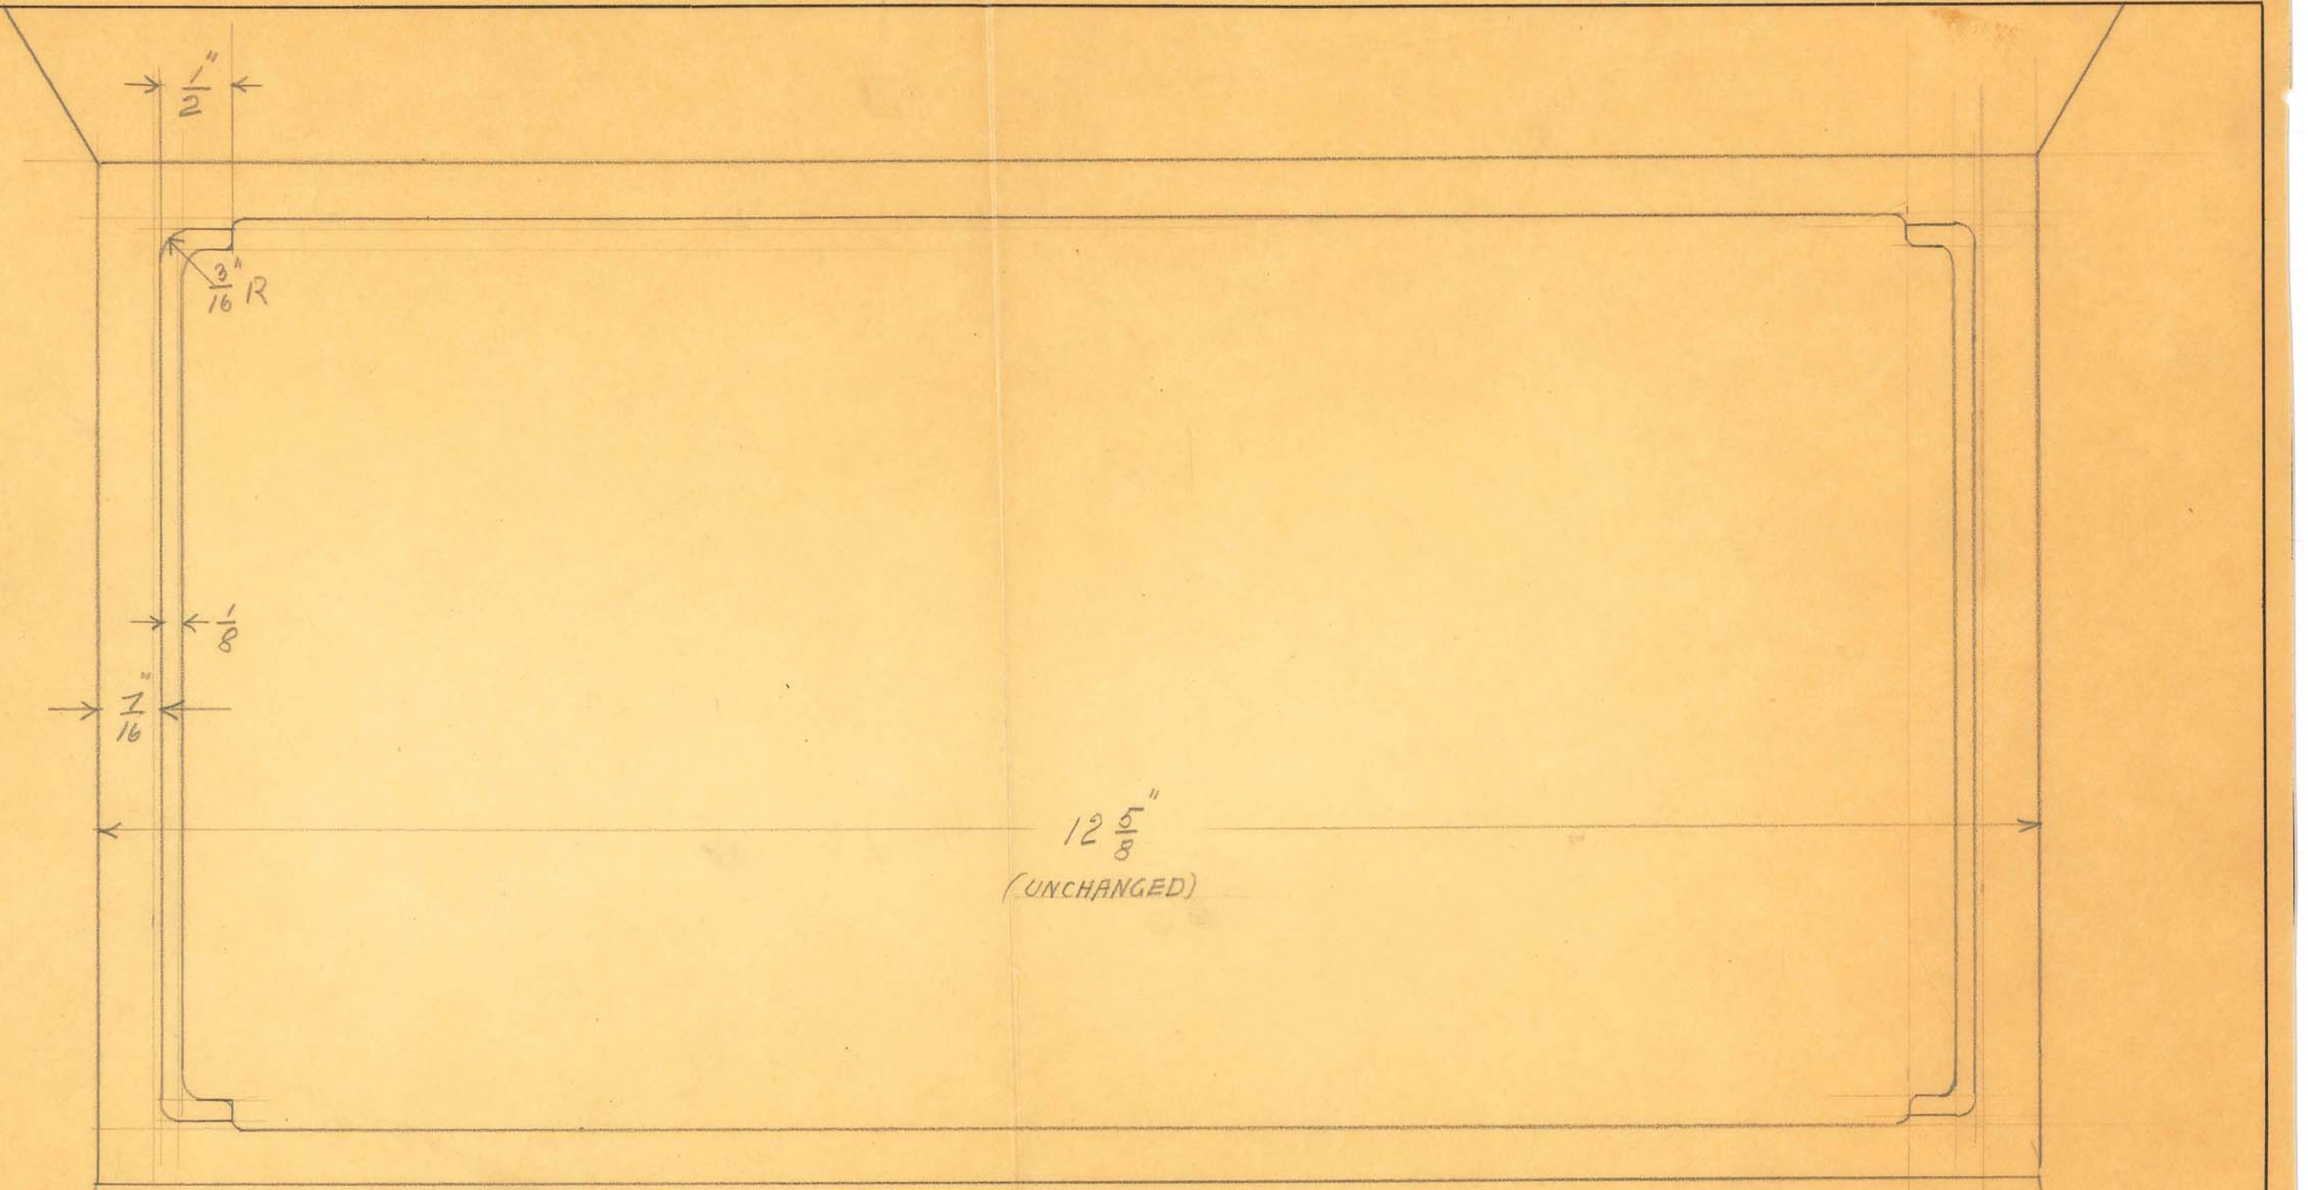

OBSOLETE

SIZE		ISSUE	
KIND		CHANGED	
SHAPE		" "	
FINISH		" "	
TEMP.		" "	
PATT.		" "	

TITLE: Tap for Intermediate Width TYPE "V"

H. G. FISCHER & CO.
2335 WABANSIA AVE.
CHICAGO, ILL.

CAT. NO.

PART NO. 4990.T

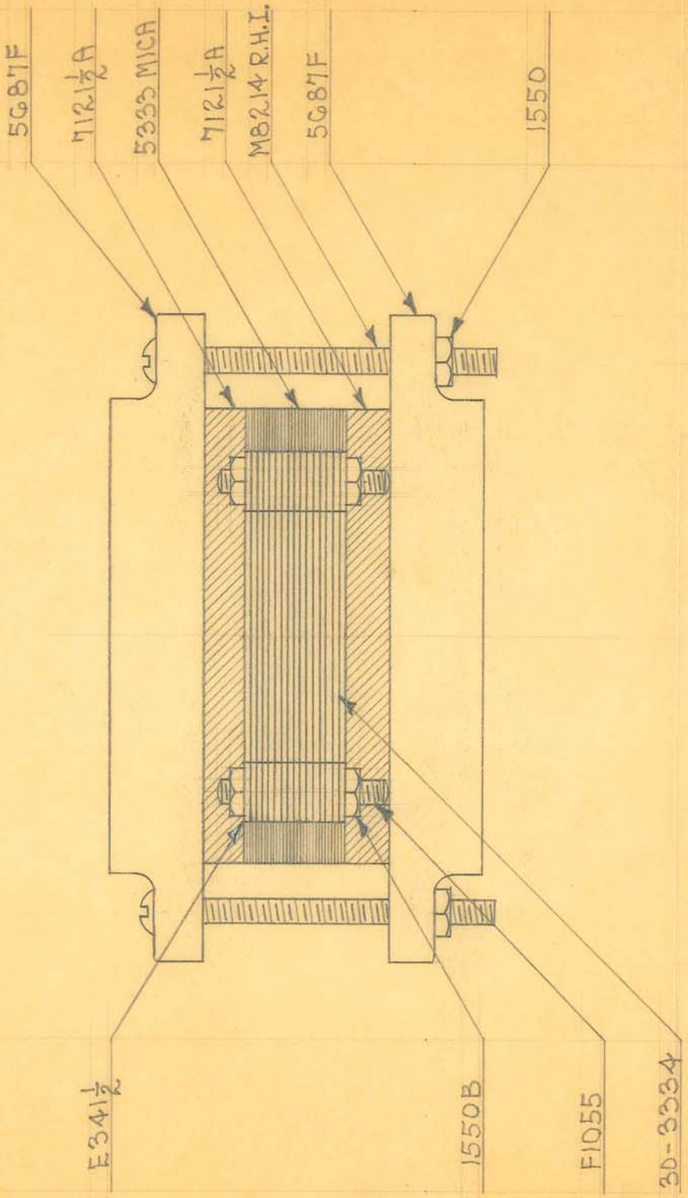

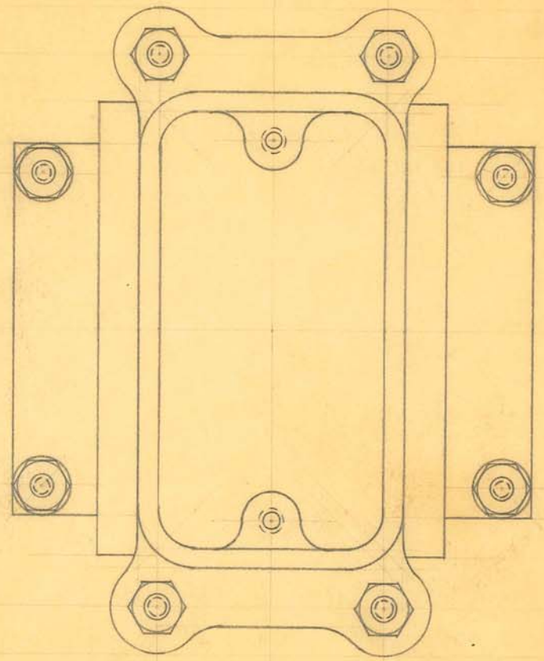

NOTE:-
MICA SPLIT TO .012" (4-7 SHEETS)
1-30 PLATE CONN. JIG. #4126

OBSOLETE

SIZE		ISSUE 2-23-32	H.E.	TITLE: FISCHER MODEL "SPII" UNIT BLOCKING CONN.
KIND		CHANGED		
SHAPE		" "		
FINISH		" "		
TEMP.		" "		H. G. FISCHER & CO. 2335 WABANSIA AVE. CHICAGO, ILL.
PATT.		" "		CAT. NO.
				PART NO. 7220G

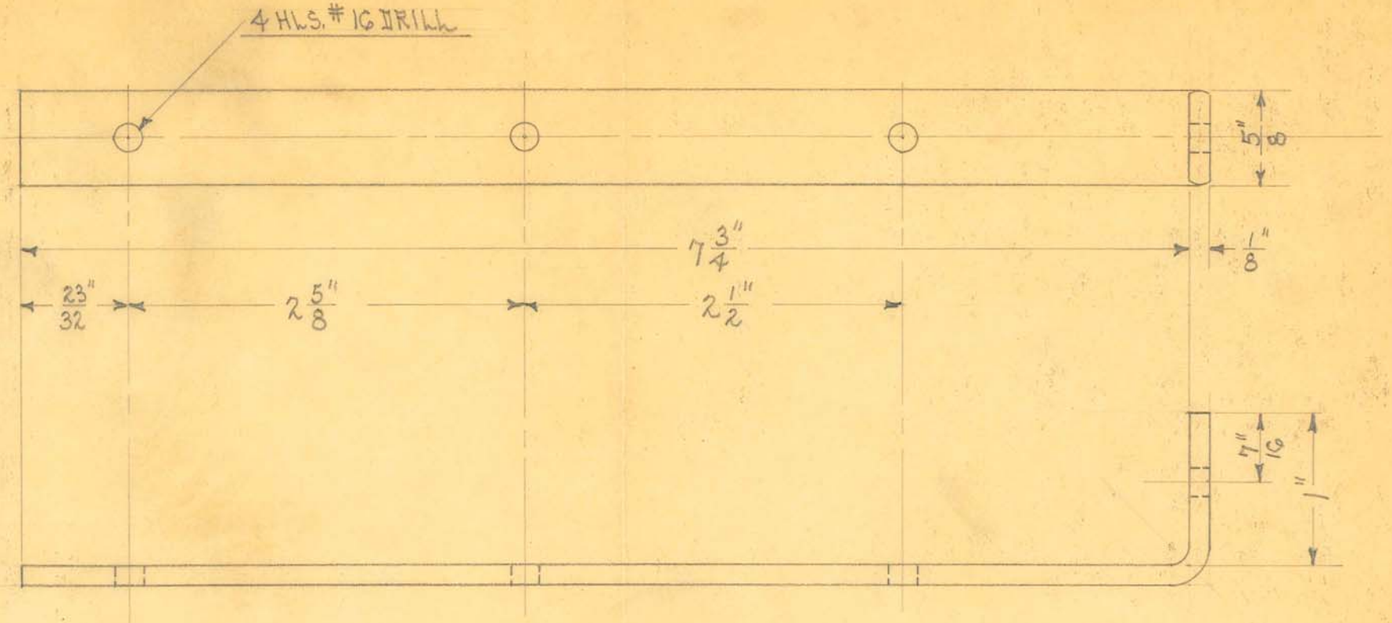

SCALE ¼ FULL SIZE
1 REQUIRED
DEVELOPED LENGTH 8 13/16"

OBSOLETE

SIZE		ISSUE 12-22-31	J.H.E.
KIND	COLD ROLLED	CHANGED	
SHAPE		" "	
FINISH	BL. ENAMEL	" "	
TEMP.		" "	
PATT.		" "	

TITLE: FISCHER MODEL "SP" UNIT BLOCKING COND. SUPP. STRIP

H. G. FISCHER & CO.
2335 WABANSIA AVE.
CHICAGO, ILL.

CAT. NO.

PART NO. 7220 1/2

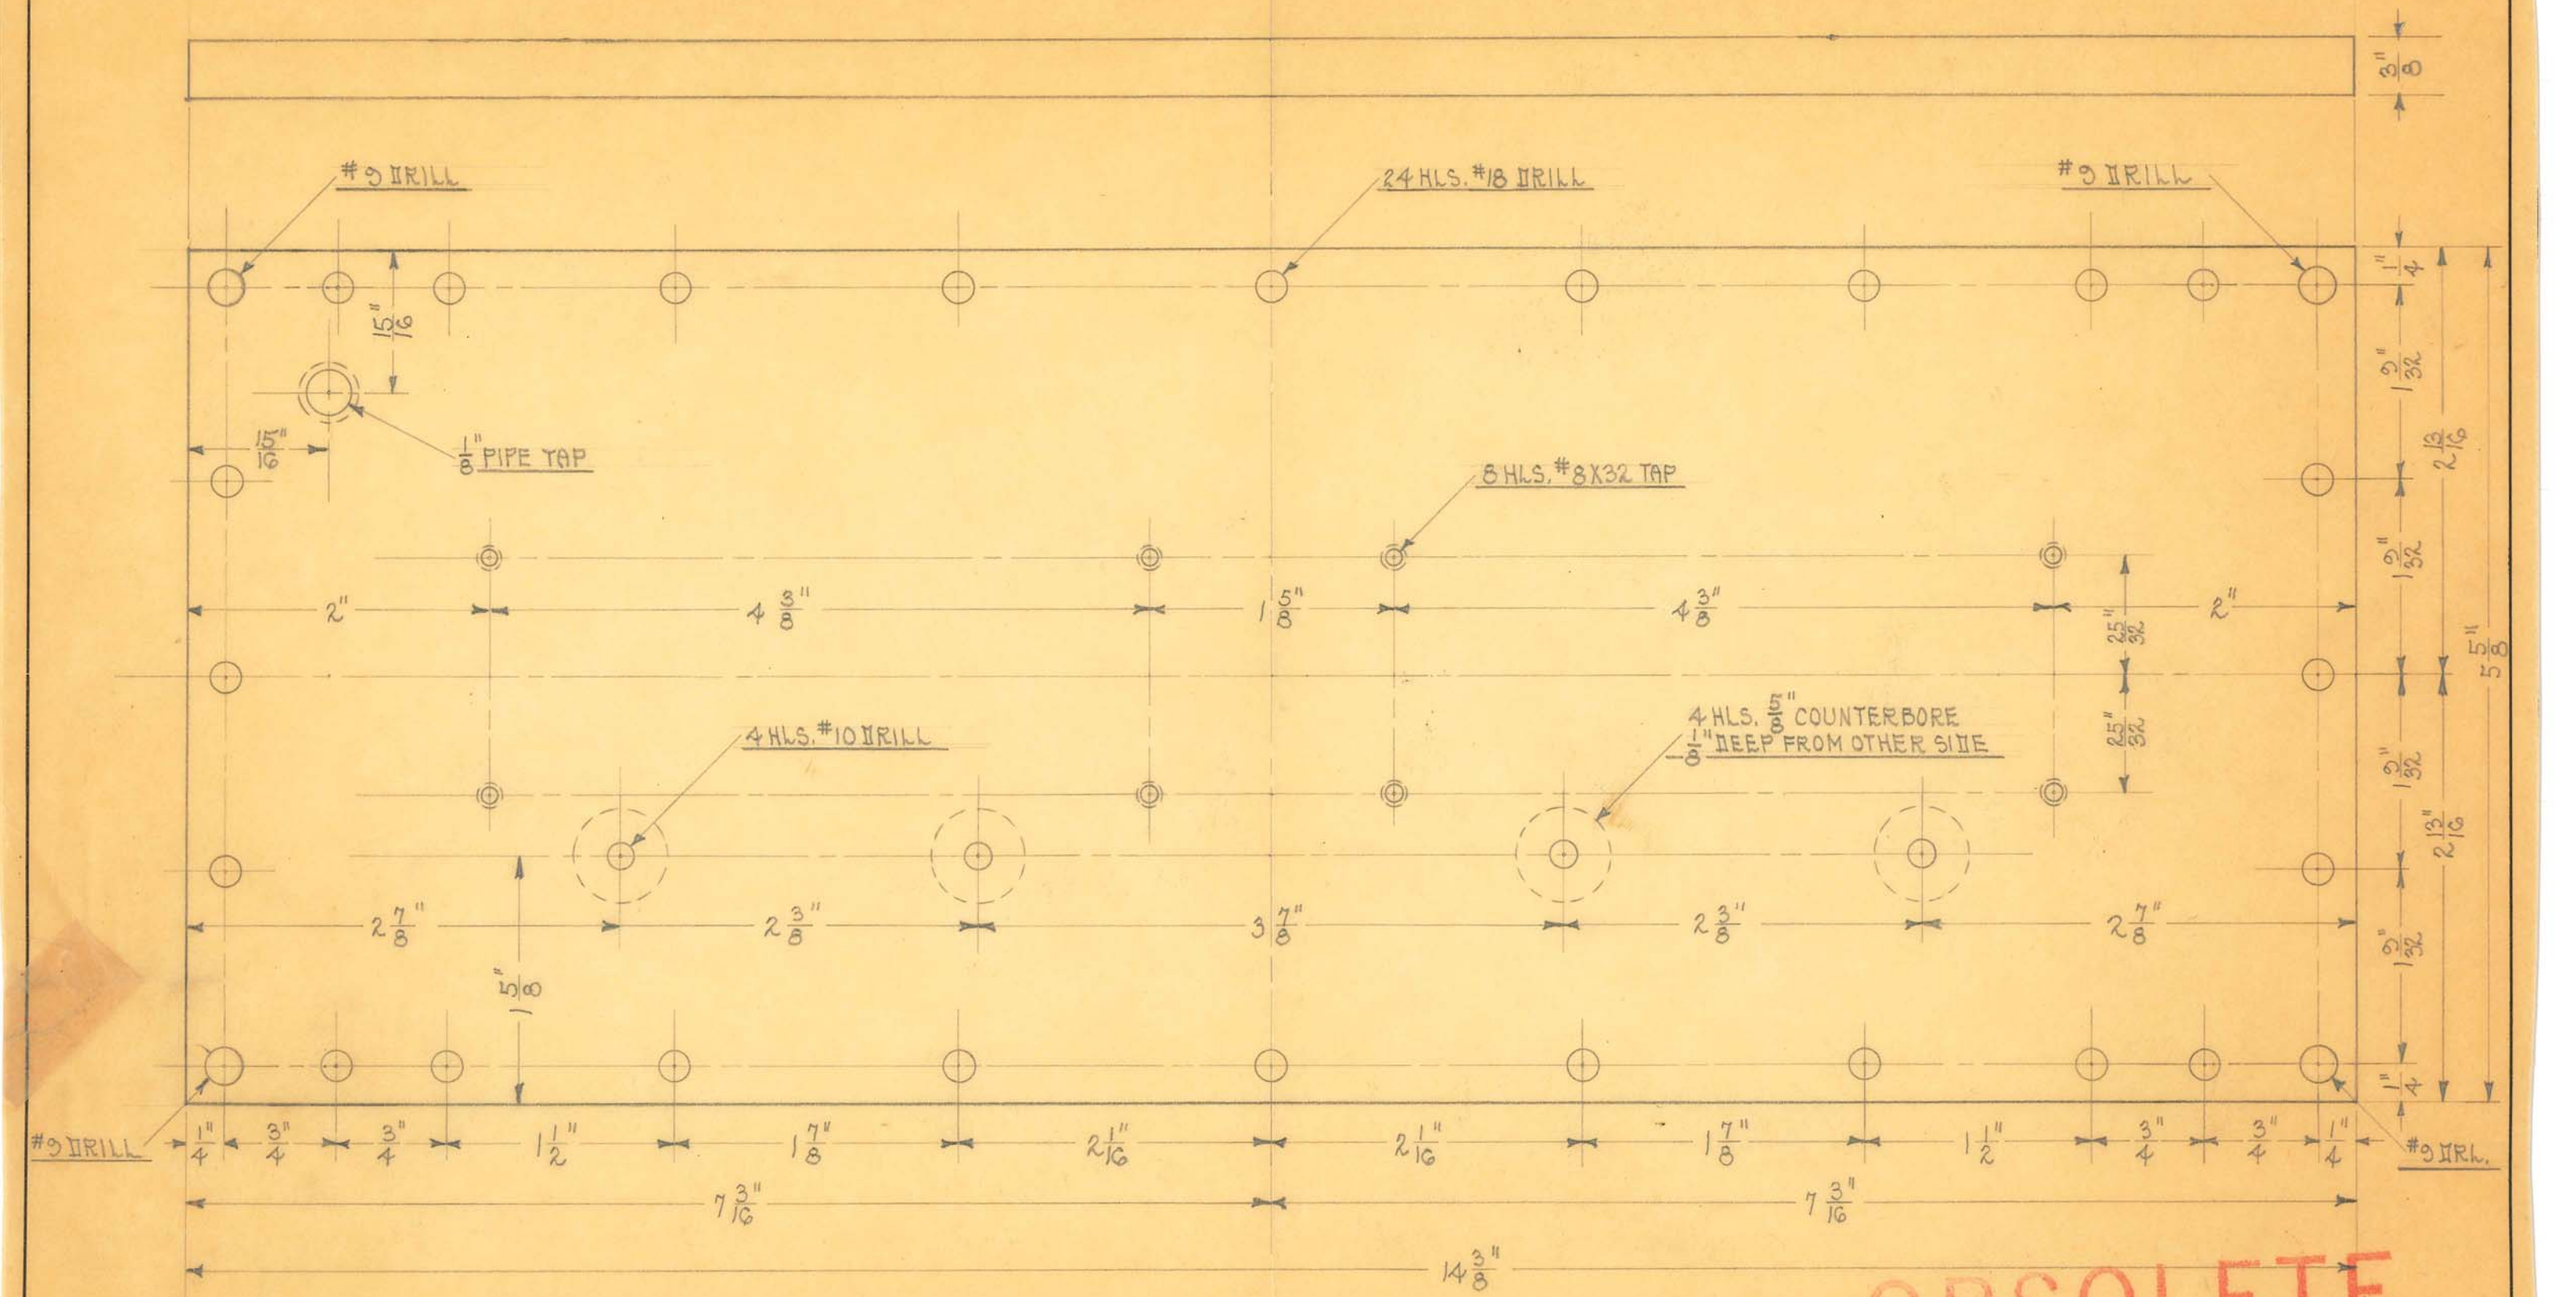

OBSOLETE

SCALE ~ FULL SIZE
1 REQUIRED

SIZE		ISSUE 12-10-31	H.E.
KIND	FIBRE	CHANGED	
SHAPE		" "	
FINISH		" "	
TEMP.		" "	
PATT.		" "	

TITLE: FISCHER MODEL "SPI" UNIT CONN. TANK COVER

H. G. FISCHER & CO.
2335 WABANSIA AVE.
CHICAGO, ILL.

CAT. NO.

PART NO. 7221 1/2

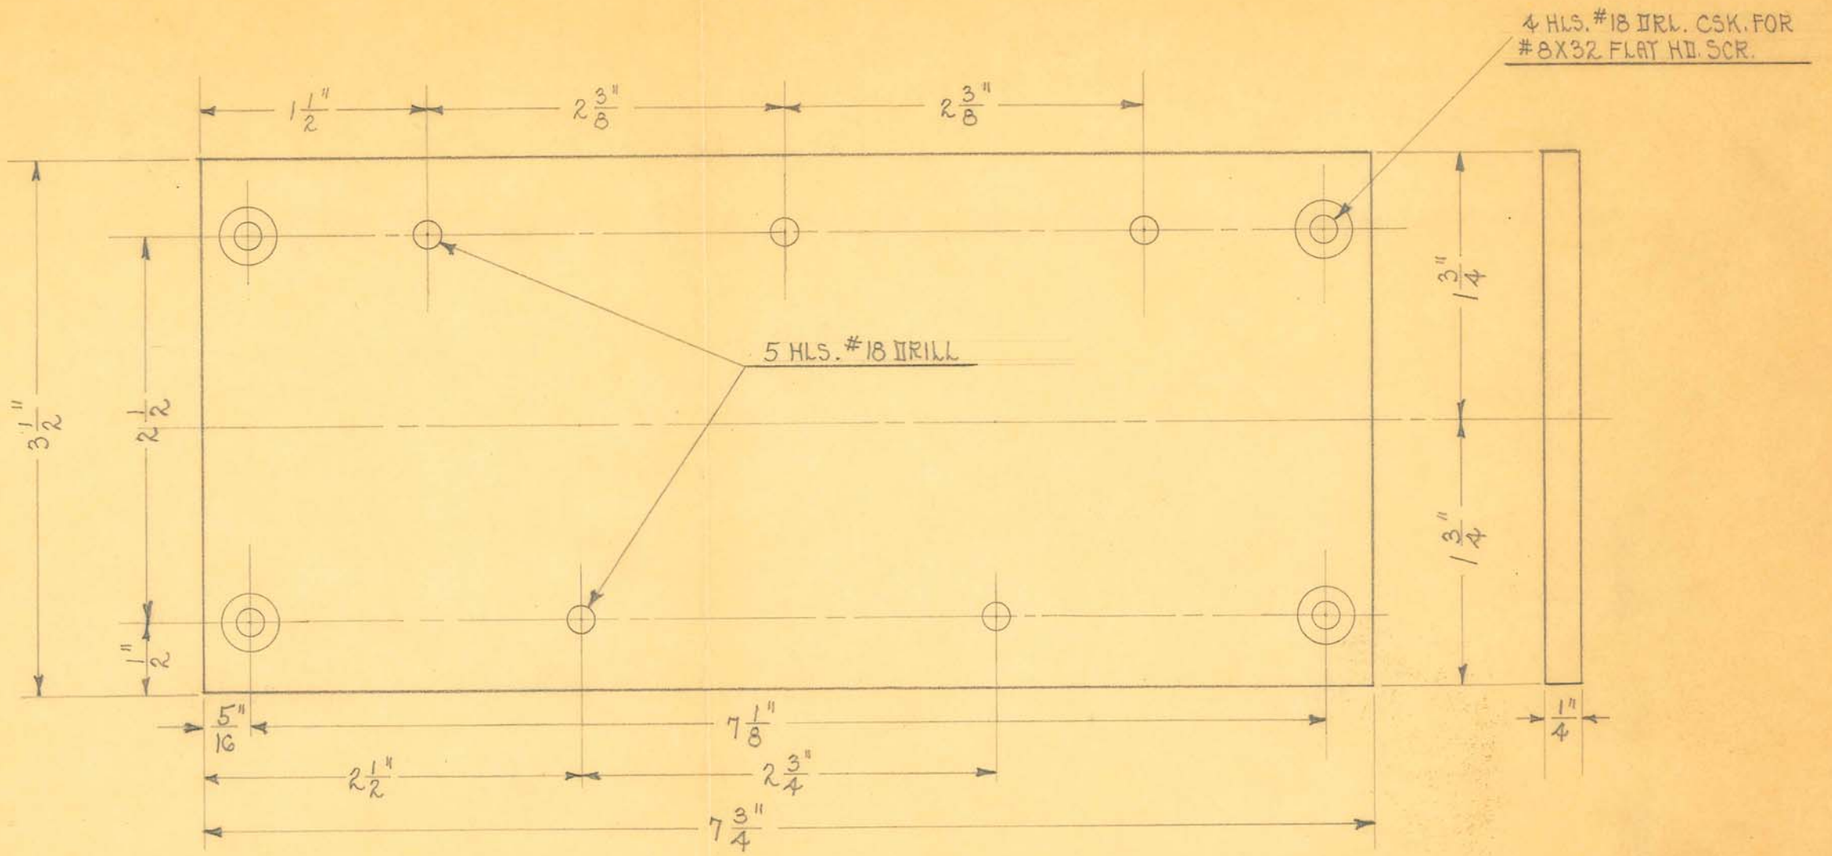

SCALE = FULL SIZE

1 REQUIRED

OBSOLETE

SIZE		ISSUE 12-11-31	A.E.
KIND	N. BAKELITE	CHANGED	
SHAPE		" "	
FINISH		" "	
TEMP.		" "	
PATT.		" "	

TITLE: FISCHER MODEL "SPII" UNIT TRANS. TERM. PLATE

H. G. FISCHER & CO.
2335 WABANSIA AVE.
CHICAGO, ILL.

CAT. NO.

PART NO. 7222 1/2 F

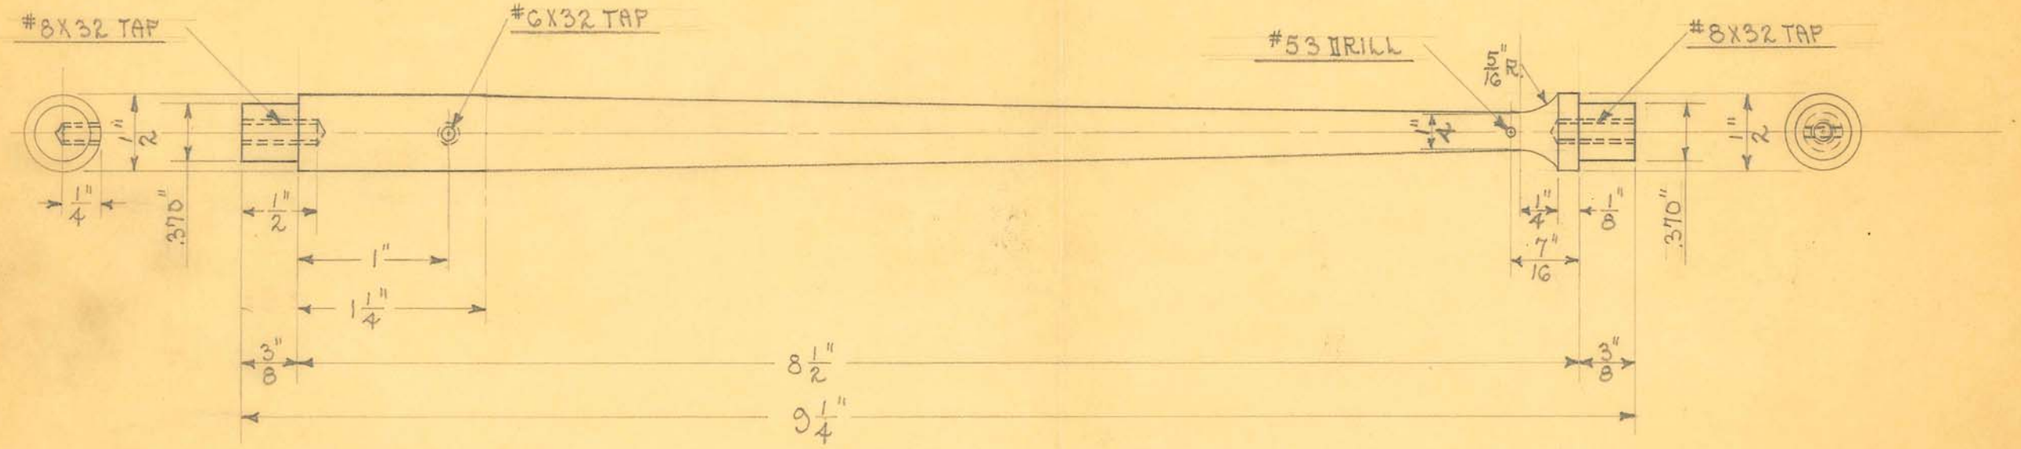

SCALE ~ FULL SIZE

2 REQUIRED

OBSOLETE

SIZE	1/2"	ISSUE 12-16-31	A.E.	TITLE: FISCHER MODEL "SP II" UNIT CURRENT CONTROL COIL CORE
KIND	BAKELITE RODII	CHANGED		
SHAPE		" "		
FINISH		" "		
TEMP.		" "		H. G. FISCHER & CO. 2335 WABANSIA AVE. CHICAGO, ILL. — CAT. NO. — PART NO. 7235
PATT.		" "		

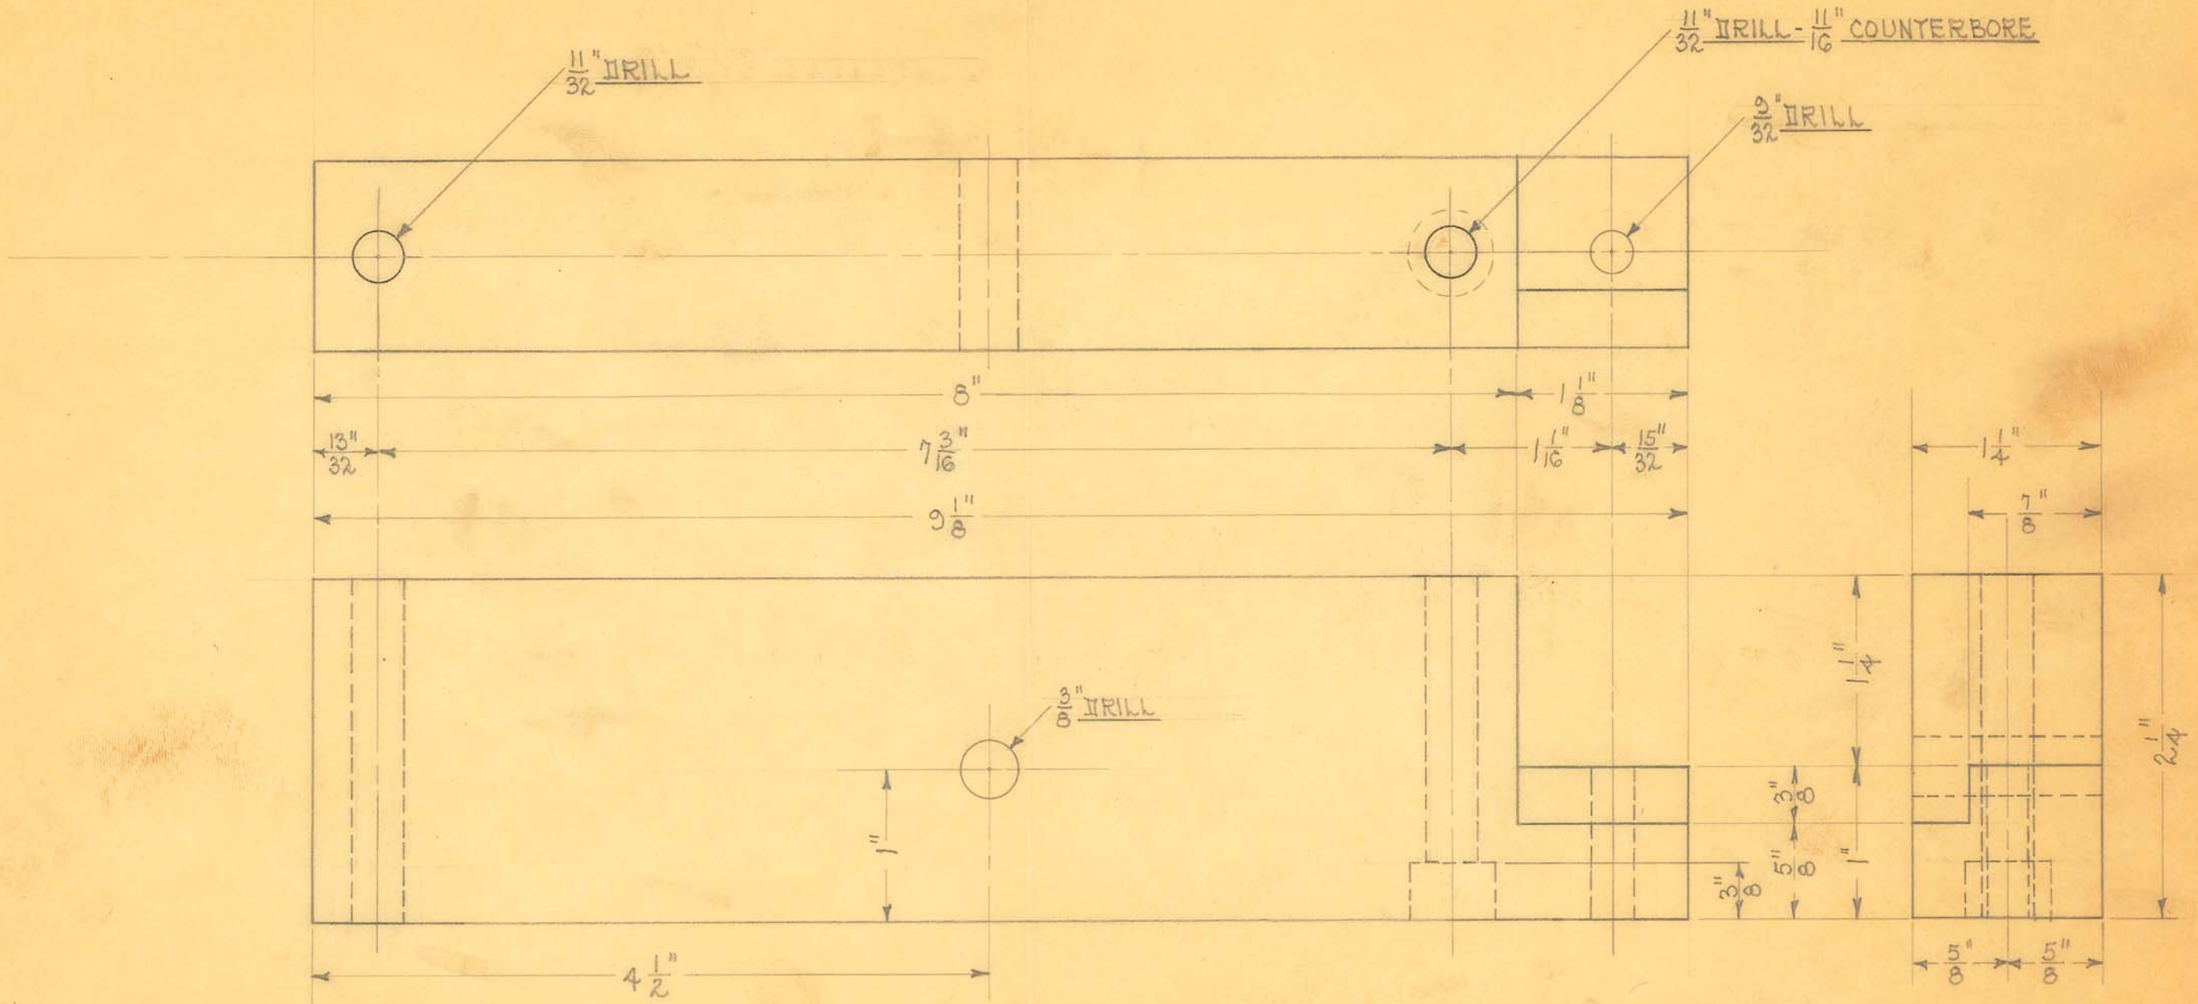

SCALE ¼ FULL SIZE
1 REQUIRED

OBSOLETE

SIZE		ISSUE 12-11-31	H.E.
KIND	BIRCH	CHANGED 1-9-32	H.E.
SHAPE		" "	
FINISH		" "	
TEMP.		" "	
PATT.		" "	

TITLE: FISCHER MODEL "SP II" UNIT TRANSFORMER
LOWER SUPP. BLOCK (DRILLED) LEFT

H. G. FISCHER & CO.
2335 WABANSIA AVE.
CHICAGO, ILL.

CAT. NO.

PART NO. 7248F

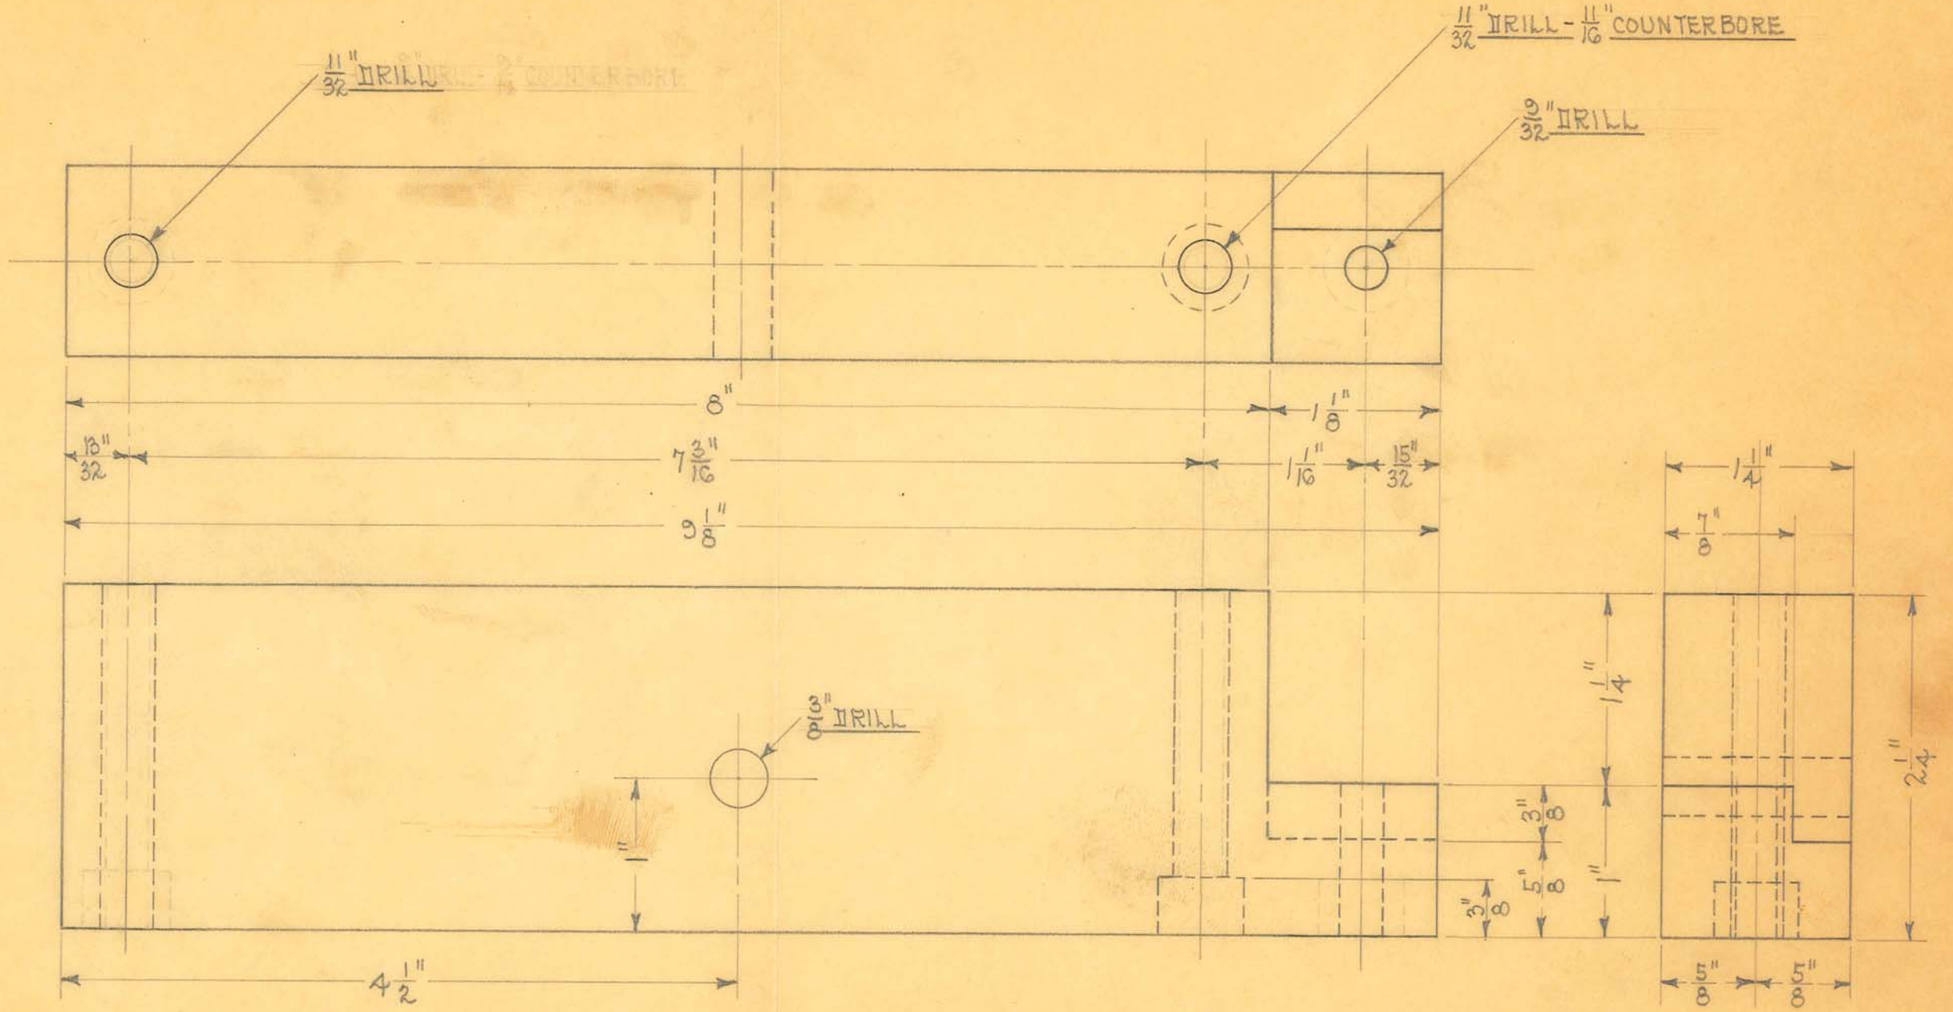

SCALE ~ FULL SIZE
1 REQUIRED

OBSOLETE

SIZE		ISSUE 12-11-31	A.E.
KIND	BIRCH	CHANGED 1-8-32	A.E.
SHAPE		" "	
FINISH		" "	
TEMP.		" "	
PATT.		" "	

TITLE: FISCHER MODEL "SP II" UNIT TRANSFORMER
LOWER SUPP. BLOCK (DRILLED) RIGHT

H. G. FISCHER & CO.
2335 WABANSIA AVE.
CHICAGO, ILL.

CAT. NO.

PART NO. 7248 1/2 F

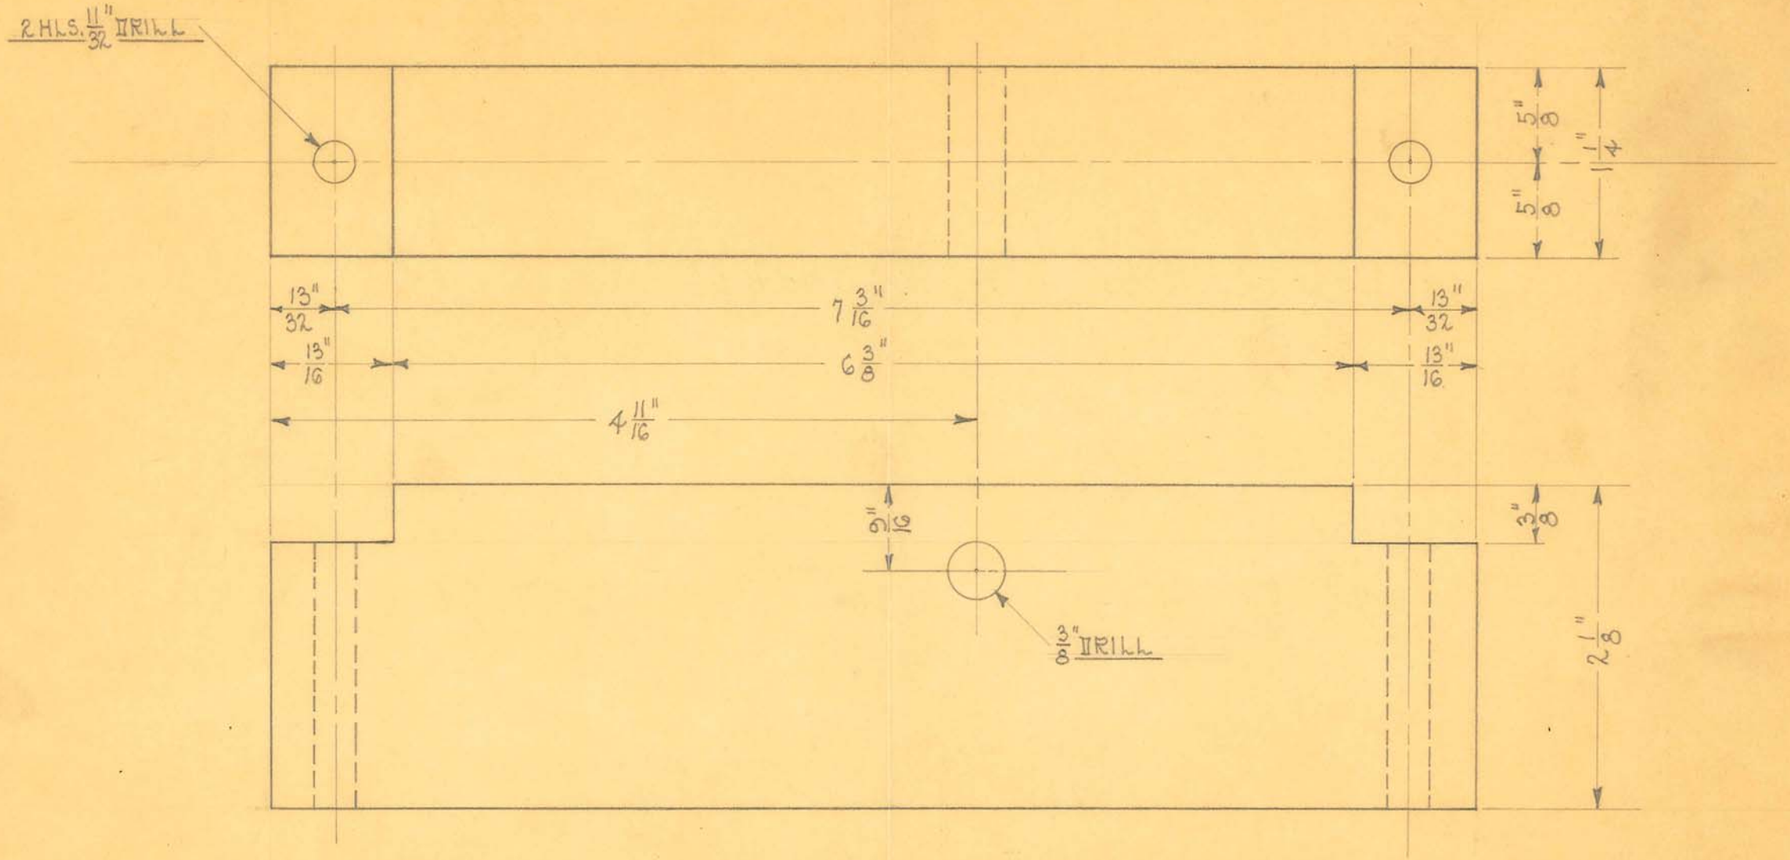

SCALE ~ FULL SIZE
2 REQUIRED

OBSOLETE

SIZE		ISSUE 12-11-31	A.E.
KIND	BIRCH	CHANGED 1-9-32	A.E.
SHAPE		" "	
FINISH		" "	
TEMP.		" "	
PATT.		" "	

TITLE: FISCHER MODEL "SPD" UNIT TRANSFORMER
UPPER SUPP. BLOCK (DRILLED)

H. G. FISCHER & CO.
2335 WABANSIA AVE.
CHICAGO, ILL.

CAT. NO.

PART NO. 7249F

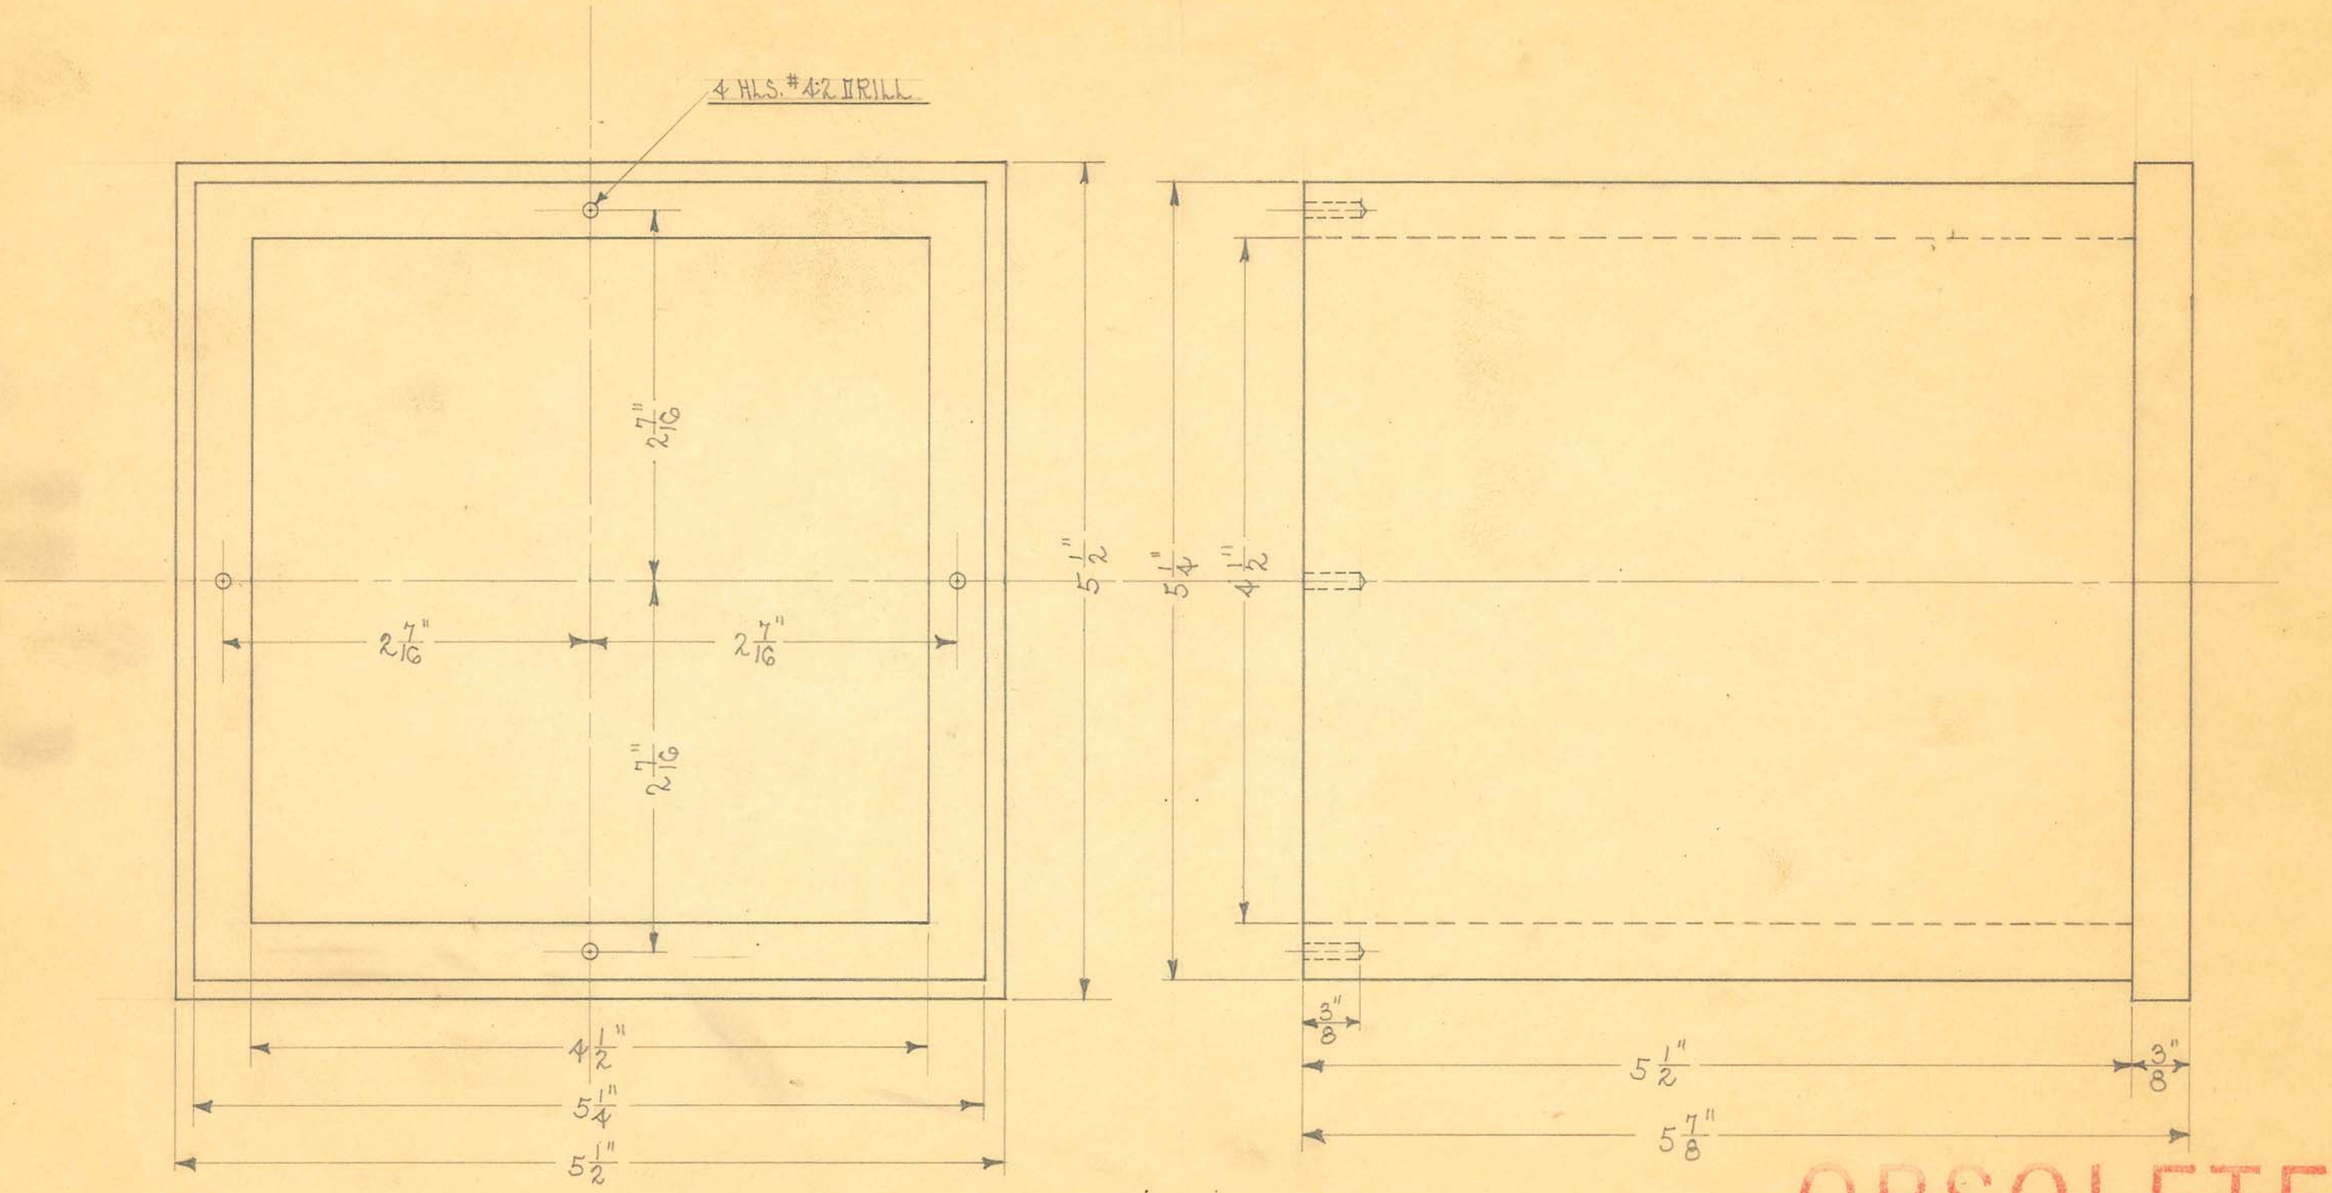

OBSOLETE

SIZE		ISSUE 10-5-32	A.E.	TITLE: AUXILIARY CONTROL BOX
KIND		CHANGED		
SHAPE		" "		
FINISH		" "		
TEMP.		" "		H. G. FISCHER & CO. 2335 WABANSIA AVE. CHICAGO, ILL. — CAT. NO. — PART NO. 7261
PATT.		" "		

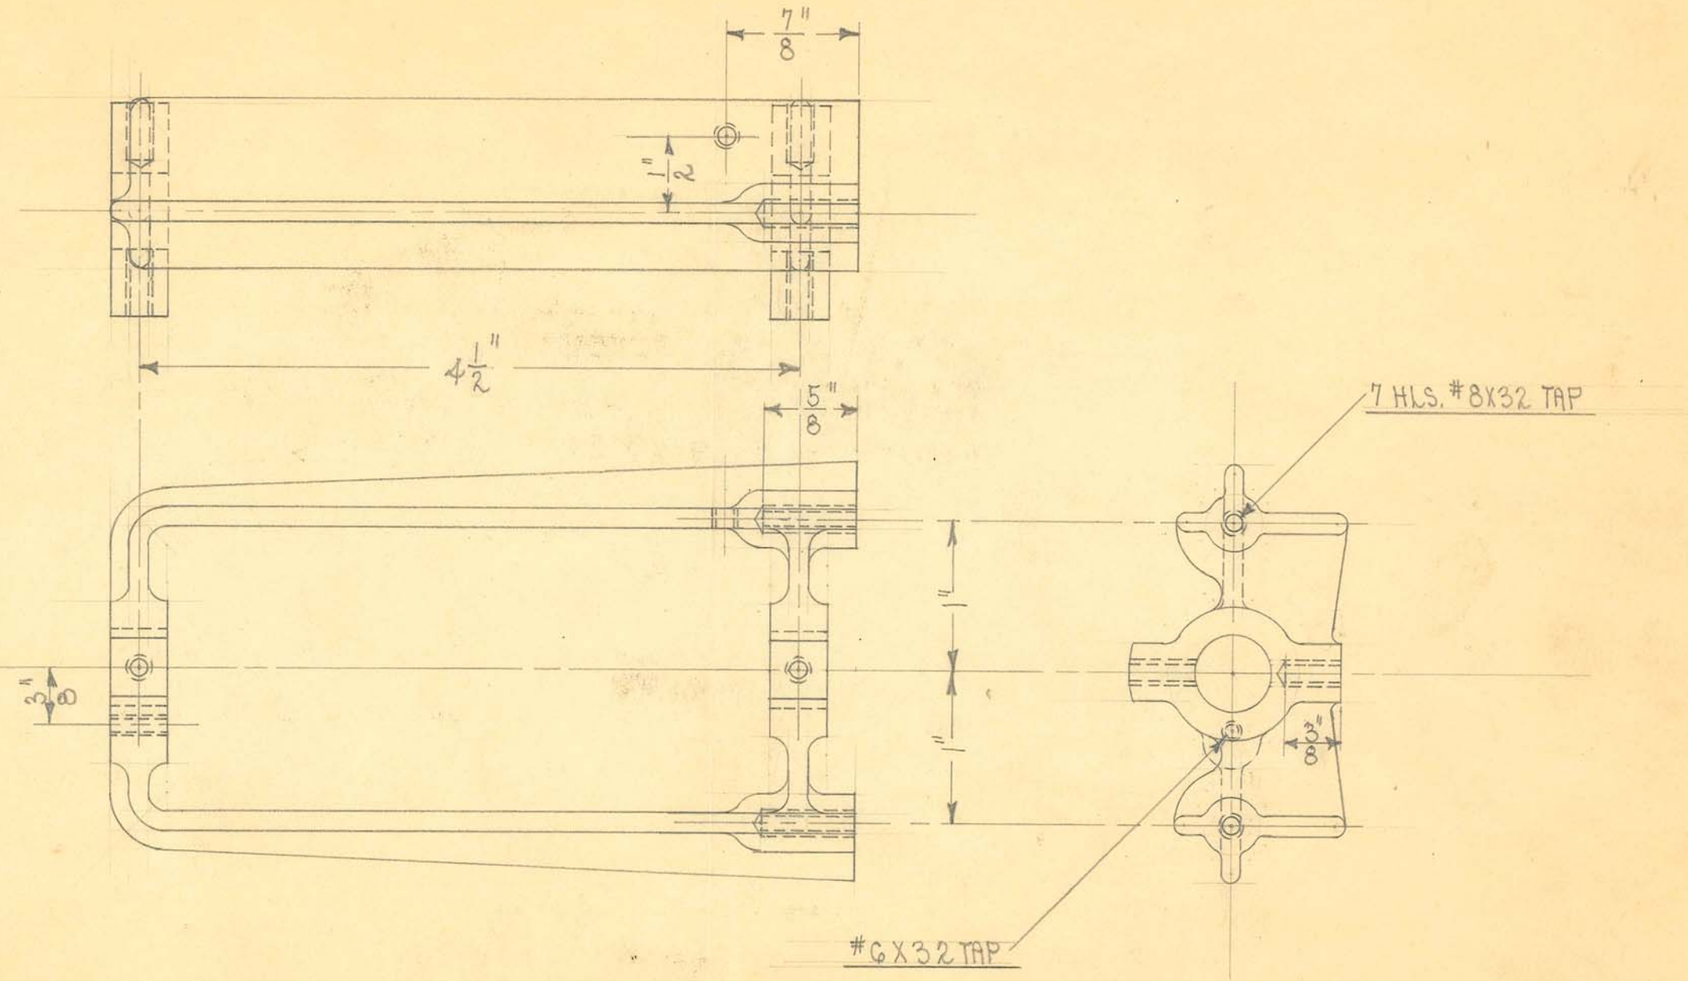

1 REQUIRED

OBSOLETE

SIZE		ISSUE 5-25-32	D.E.	TITLE: FISCHER MODEL "SPII" UNIT AUX. CONT. FRAME
KIND	ALUM. CASTING	CHANGED		
SHAPE		" "		
FINISH		" "		
TEMP.		" "		H. G. FISCHER & CO. 2335 WABANSIA AVE. CHICAGO, ILL. — CAT. NO. — PART NO. 7262F
PATT.		" "		

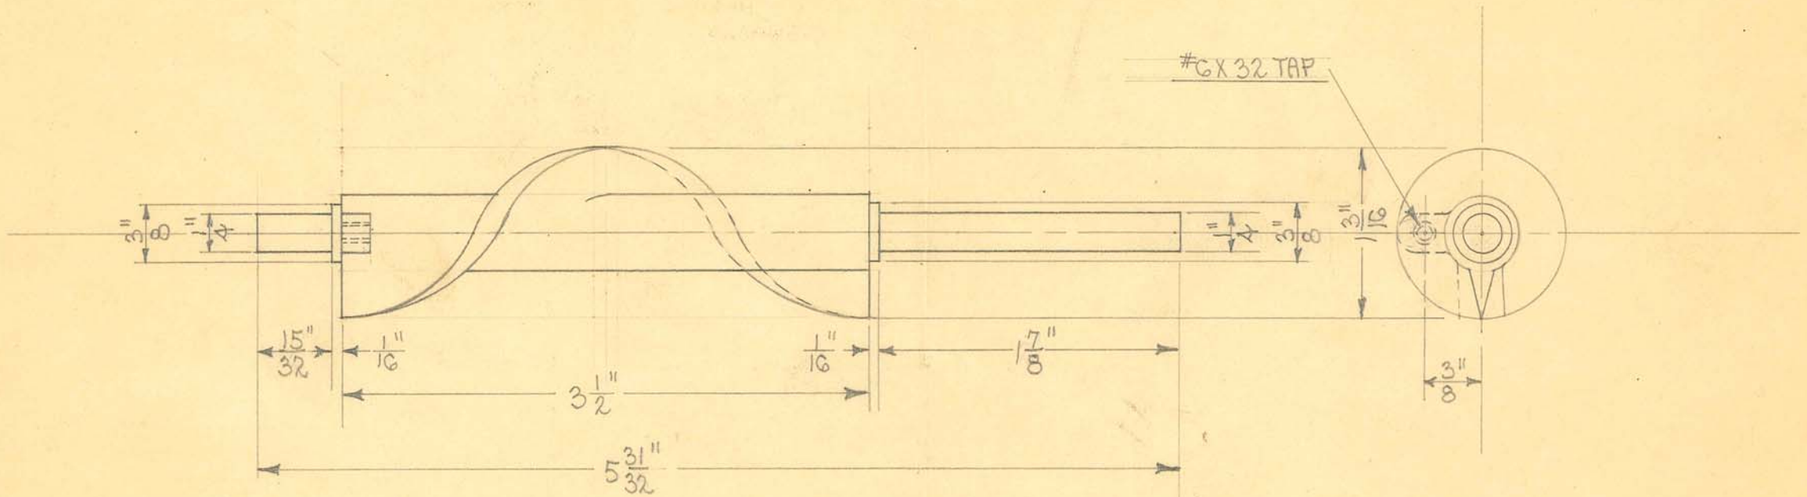

1 REQUIRED

OBSOLETE

SIZE		ISSUE 5-25-32	A.E.	TITLE: FISCHER MODEL "SPII" UNIT AUX. CONT. SPIRAL
KIND	BRASS CASTING	CHANGED		
SHAPE		" "		
FINISH		" "		
TEMP.		" "		H. G. FISCHER & CO. 2335 WABANSIA AVE. CHICAGO, ILL. — CAT. NO. — PART NO. 7263F
PATT.		" "		

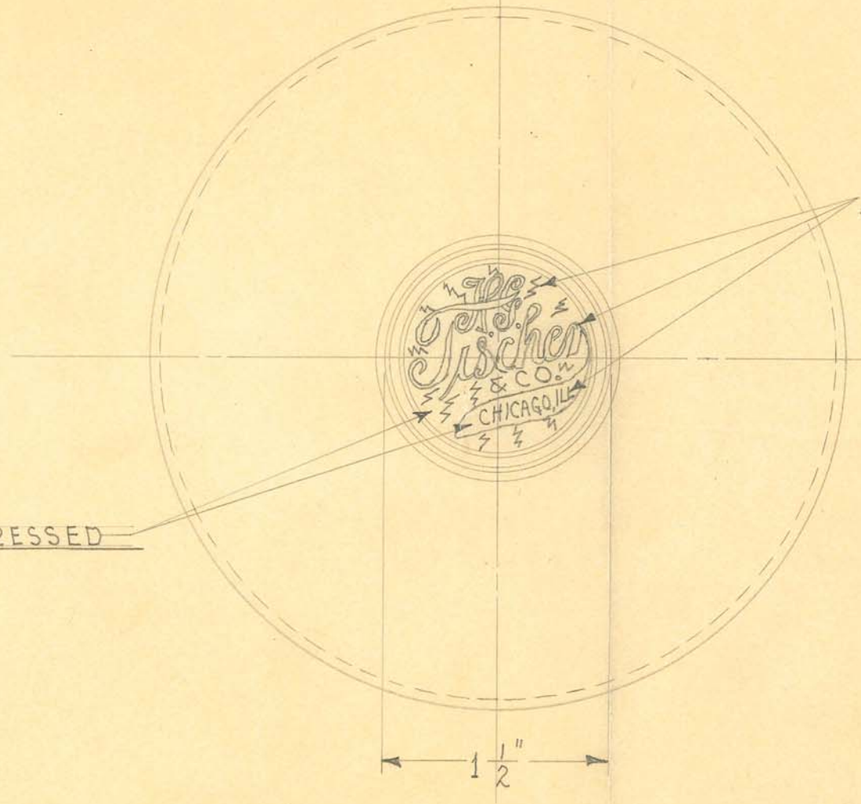

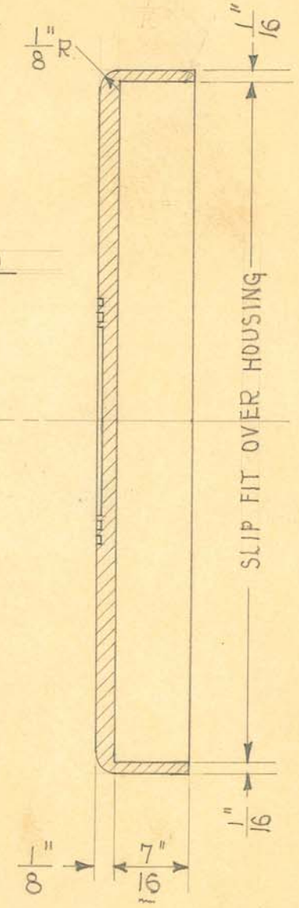

NOTE:-

LETTERS, LIGHTNING MARKS & TWO RINGS AROUND TRADE MARK MUST BE FLUSH WITH OUTSIDE SURFACE OF COVER.

C.M.P.C. MOLD # M-2437

OBSOLETE

SIZE	MOLDED	ISSUE 9-19-38	HE.
KIND	LUCITE	CHANGED	
SHAPE		REMOVED 1/16 R	J.B. 9-26-38
FINISH		"	
TEMP.		"	
MOLD PATT.	1805	"	

TITLE: AIR-SPACED ELECTRODE-HOUSING COVER

H. G. FISCHER & CO.
2338 WABANSIA AVE.
CHICAGO, ILL.

CAT. NO.

PART NO. 12119

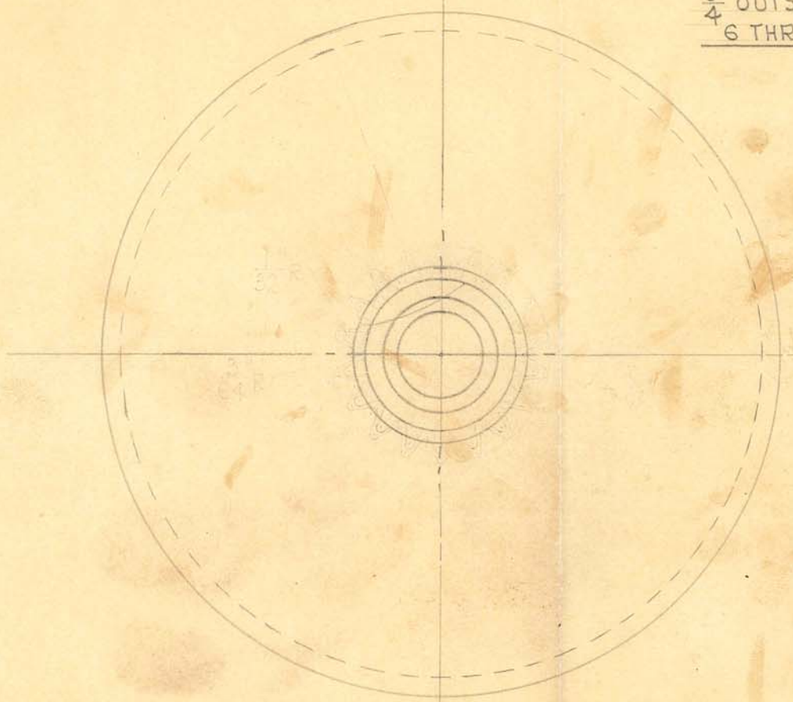

WHITWORTH THREAD.
$\frac{3}{4}$" OUTSIDE DIAMETER.
6 THREADS PER INCH.

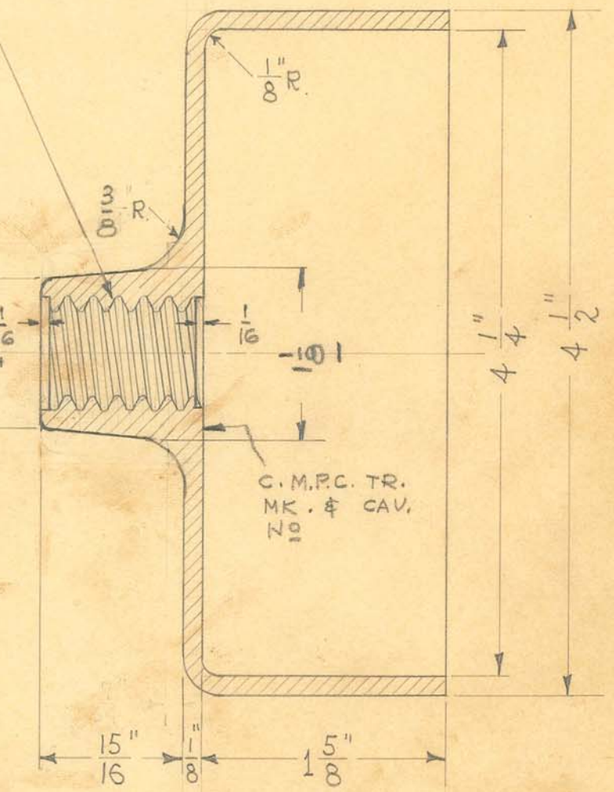

OBSOLETE

C.M.P.C. MOLD # M2436

SIZE	MOLDED	ISSUE 9-19-38	H.E.
KIND	LUCITE	CHANGED	
SHAPE	REDESIGNED	"	B 9-22-38
FINISH		"	
TEMP.		"	
MOLD PATT.	1805	"	

TITLE: AIR-SPACED ELECTRODE-HOUSING

H. G. FISCHER & CO. 2335 WABANSIA AVE. CHICAGO, ILL.	CAT. NO.	PART NO. 12118

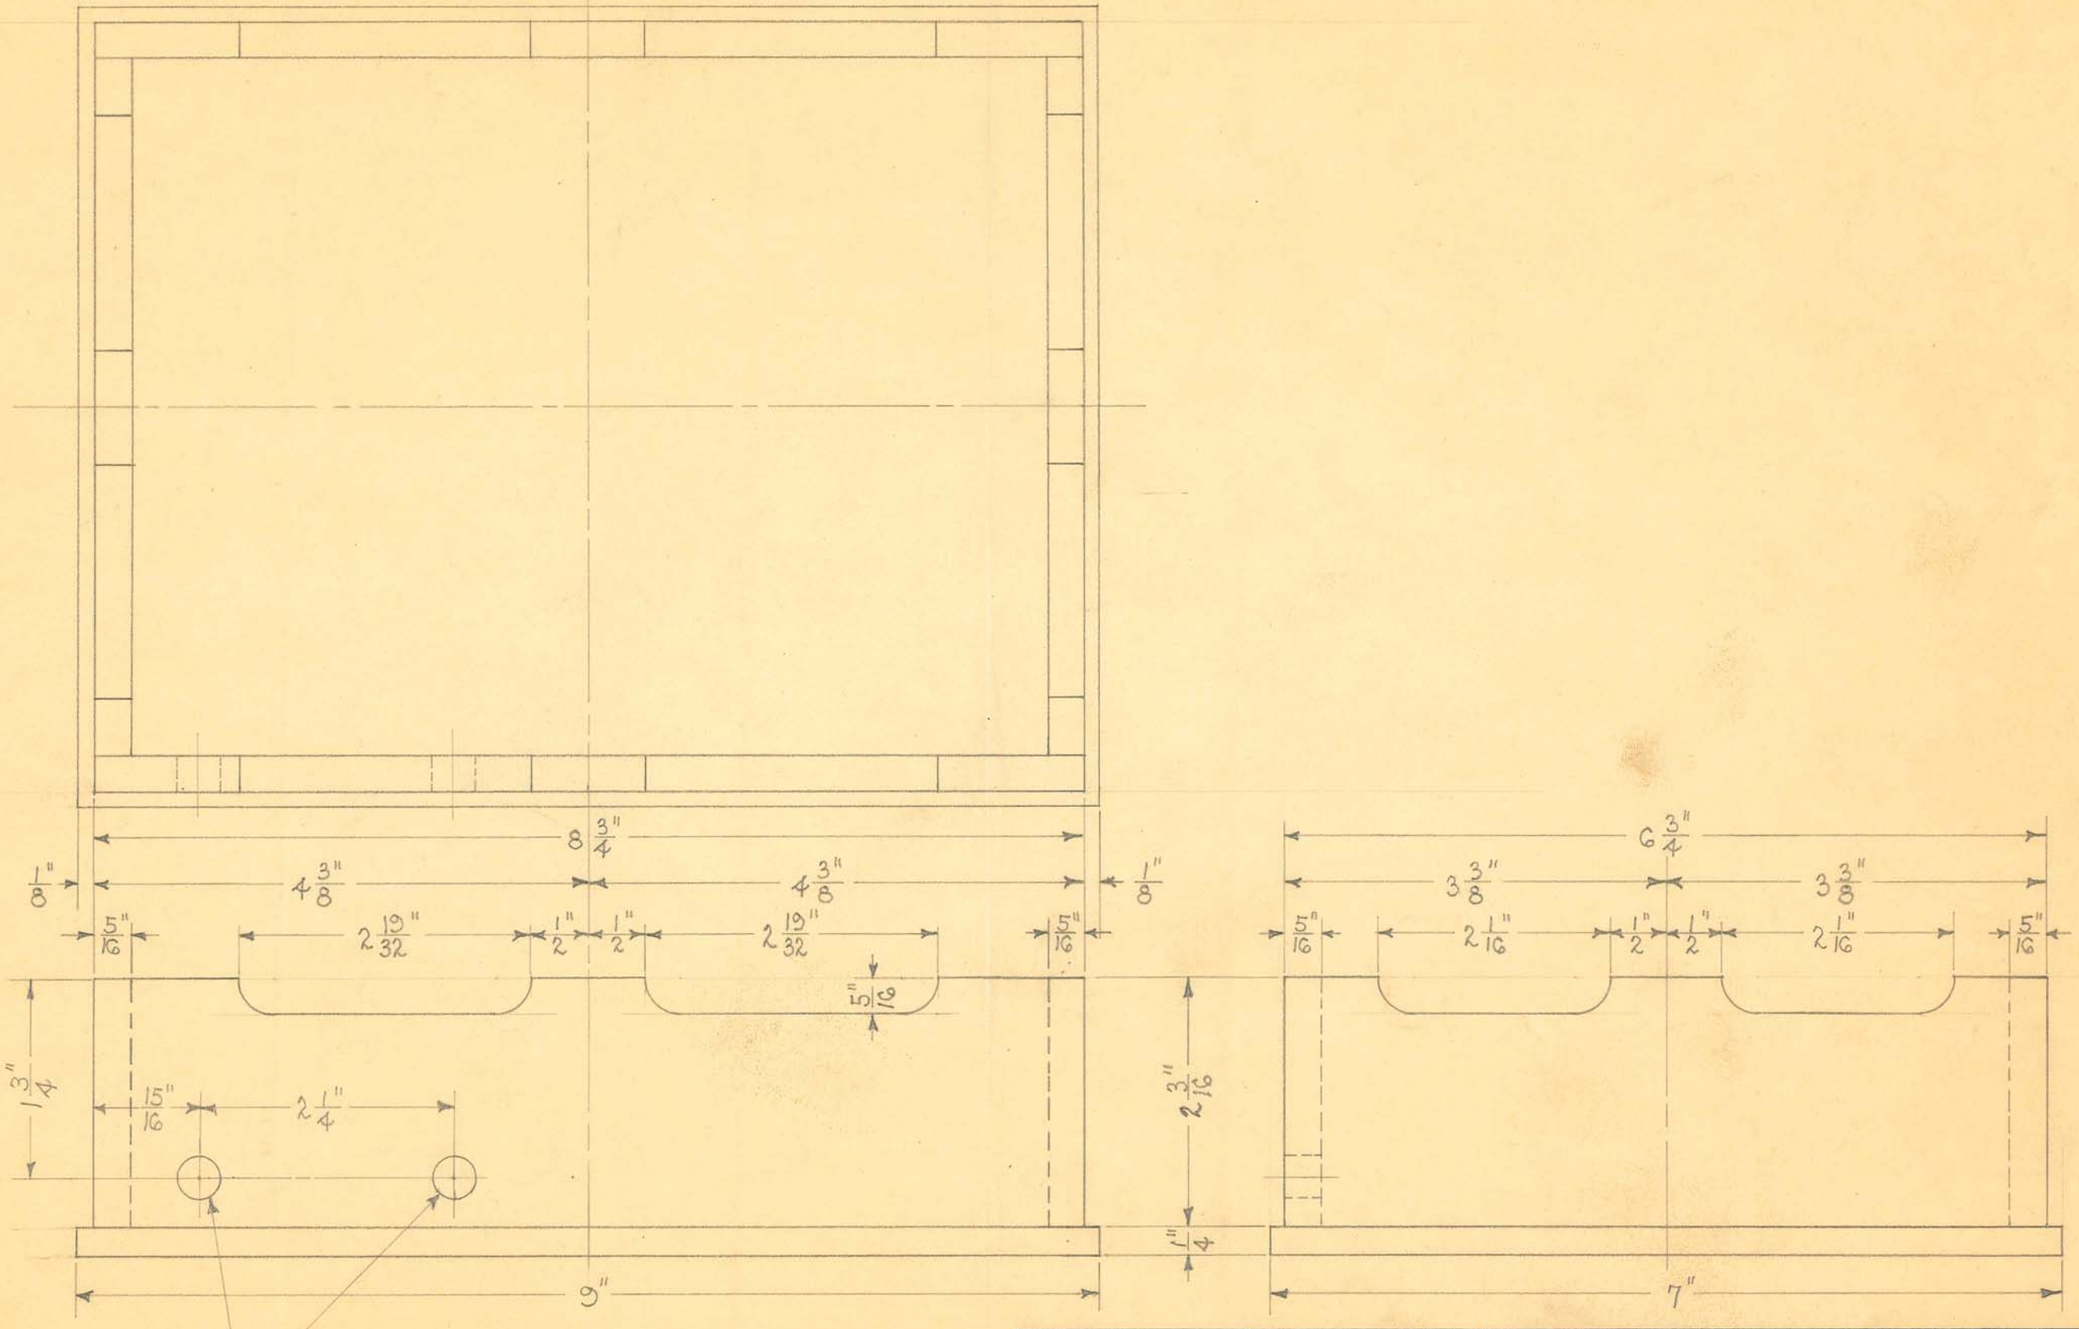

2 HLS. DRILL FOR 1/8" COMPOSITION BUSHING

SCALE ≈ 3/4" = 1"

SIZE		ISSUE 11-23-32	A.E.
KIND		CHANGED	
SHAPE		" "	
FINISH		" "	
TEMP.		" "	
PATT.		" "	

TITLE: CUTTING CUR. GEN. FOR MODEL "H" - BOX

OBSOLETE

H. G. FISCHER & CO.
2335 WABANSIA AVE.
CHICAGO, ILL.

CAT. NO.

PART NO. 7494F

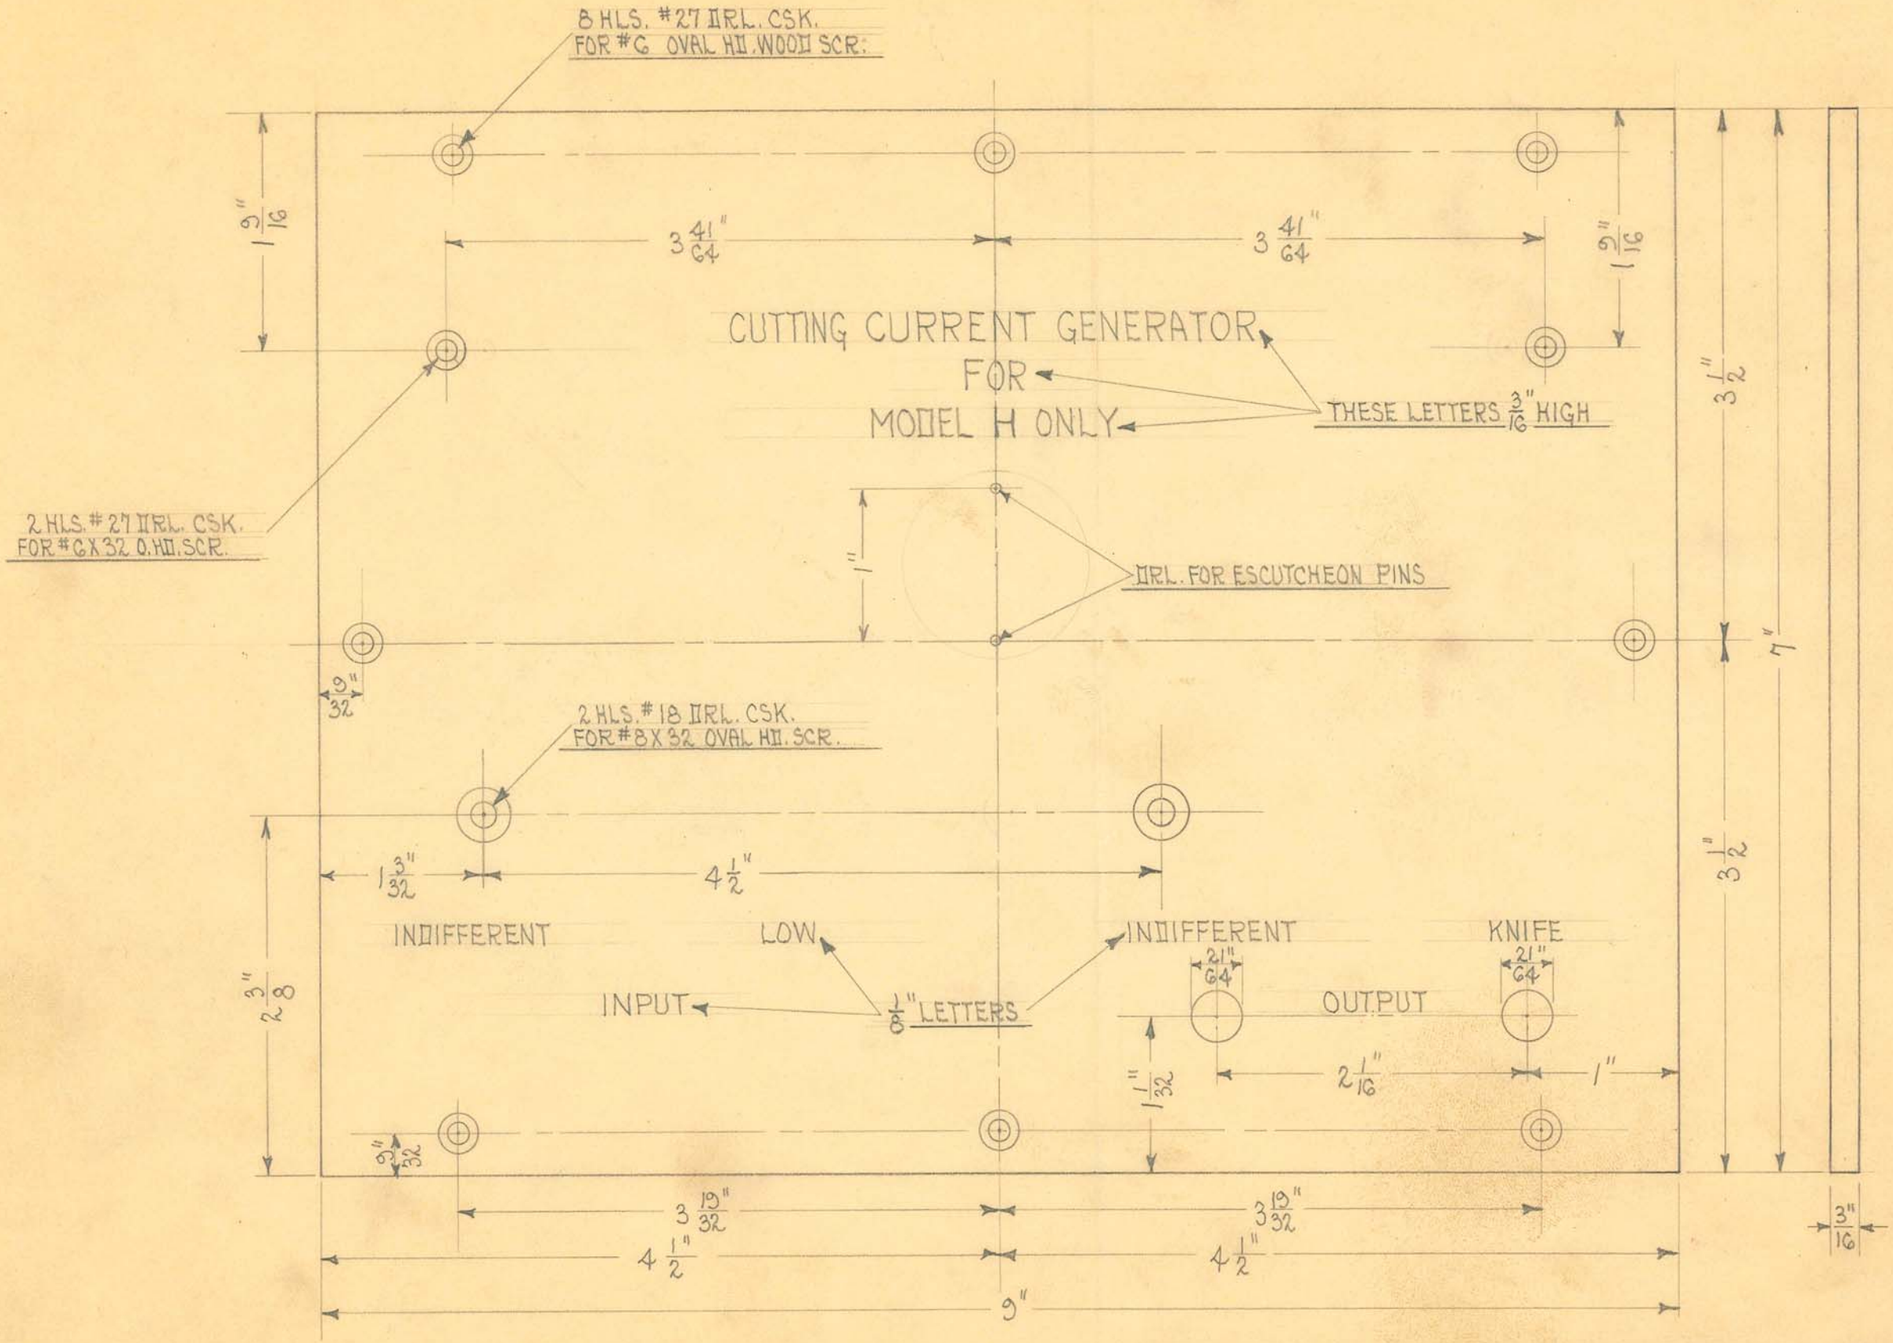

SIZE	7"X9"X 3/16"	ISSUE 11-23-32	A.E.	TITLE: CUTTING CUR. GEN. FOR MODEL "H" - PANEL
KIND	BAKELITE	CHANGED		OBSOLETE
SHAPE		" "		
FINISH		" "		
TEMP.		" "		
PATT.		" "		

H. G. FISCHER & CO.
2335 WABANSIA AVE.
CHICAGO, ILL.

CAT. NO.

PART NO. 7495F

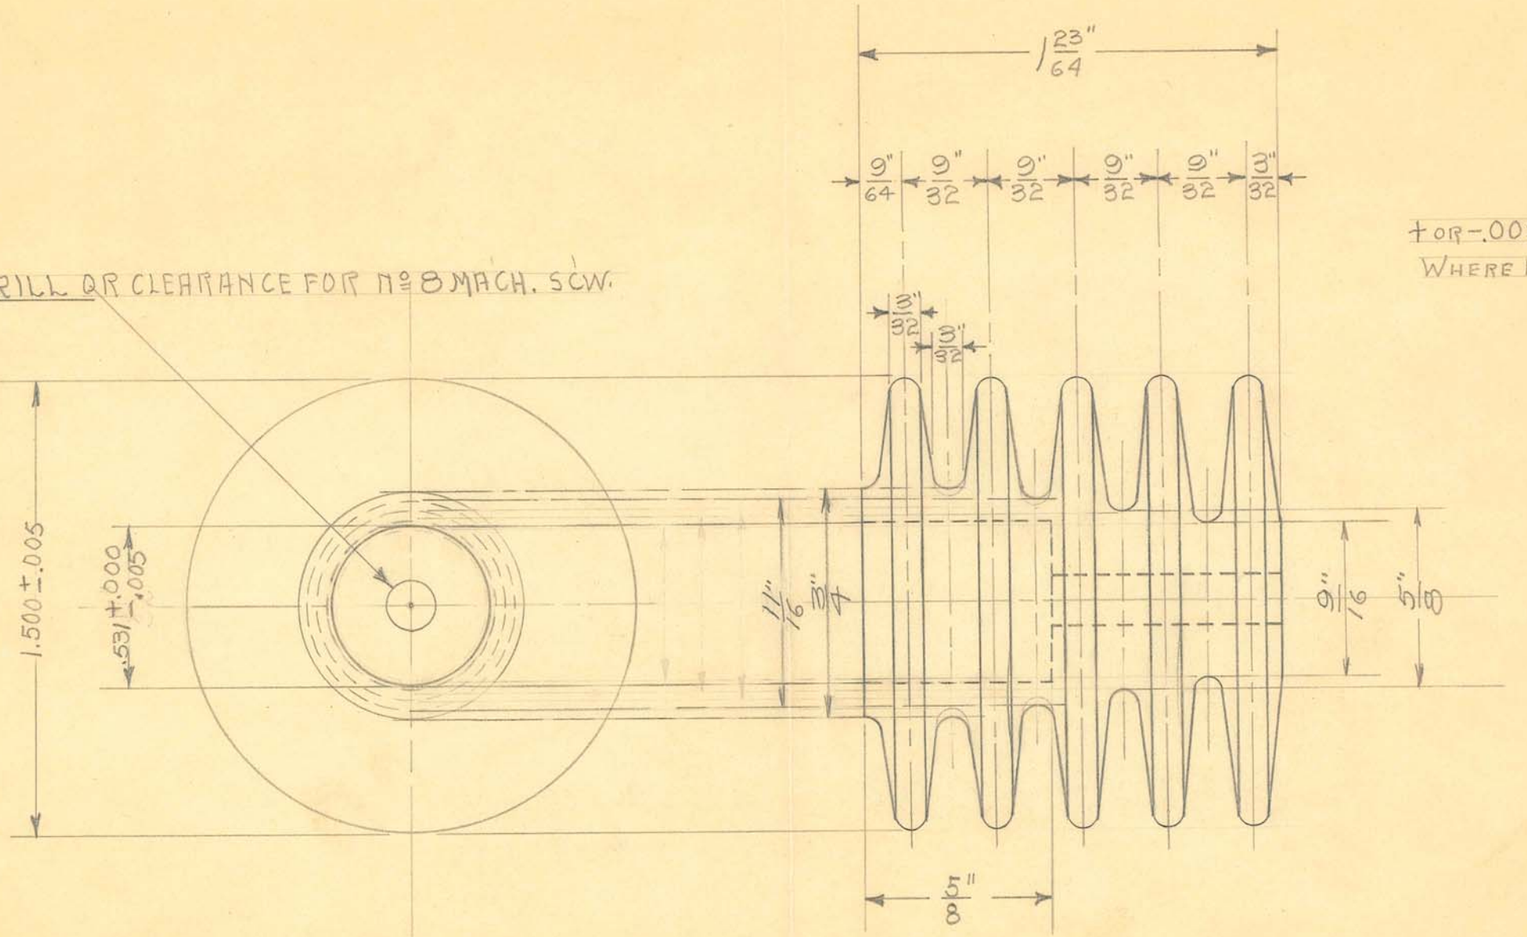

± OR −.005 ALLOWED ON ALL DIMENSIONS WHERE NO TOLERANCE IS INDICATED

SCALE ½ DOUBLE SIZE

OBSOLETE

SIZE		ISSUE 6-17-32	A.E.
KIND		CHANGED	
SHAPE		" "	
FINISH		" "	
TEMP.		" "	
PATT.		" "	

TITLE: LARGE SIZE FIXED GAP COOLING FLANGE

H. G. FISCHER & CO.
2335 WABANSIA AVE.
CHICAGO, ILL.

CAT. NO.

PART NO. 7305F

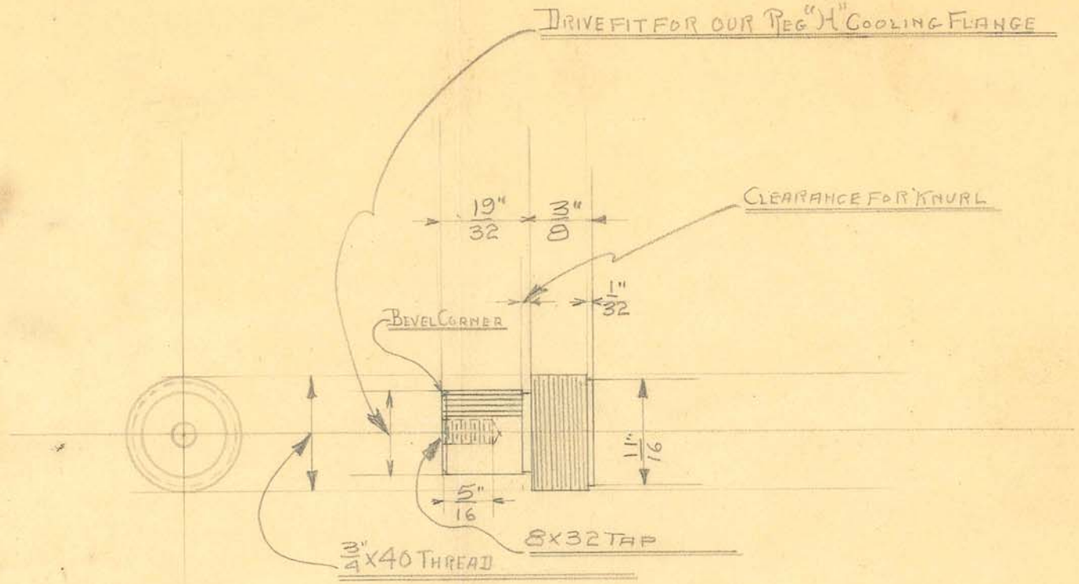

MATERIAL C.R. STEEL

OBSOLETE

SIZE		ISSUE		TITLE: LARGE SIZE FIXED GAP TIP BLANK	
KIND		CHANGED			
SHAPE		" "			
FINISH		" "			
TEMP.		" "		H. G. FISCHER & CO. 2335 WABANSIA AVE. CHICAGO, ILL.	CAT. NO.
PATT.		" "			PART NO. 7310A

ASSEMBLY

PART # 7455F
PART # 7456A
PART # 7316A
PART # 7316 1/2 A
PART # E340 1/2
PART # E348
PART # M812
PART # P184
PART # 3696
PART # 3435 1/2
PART # 7320

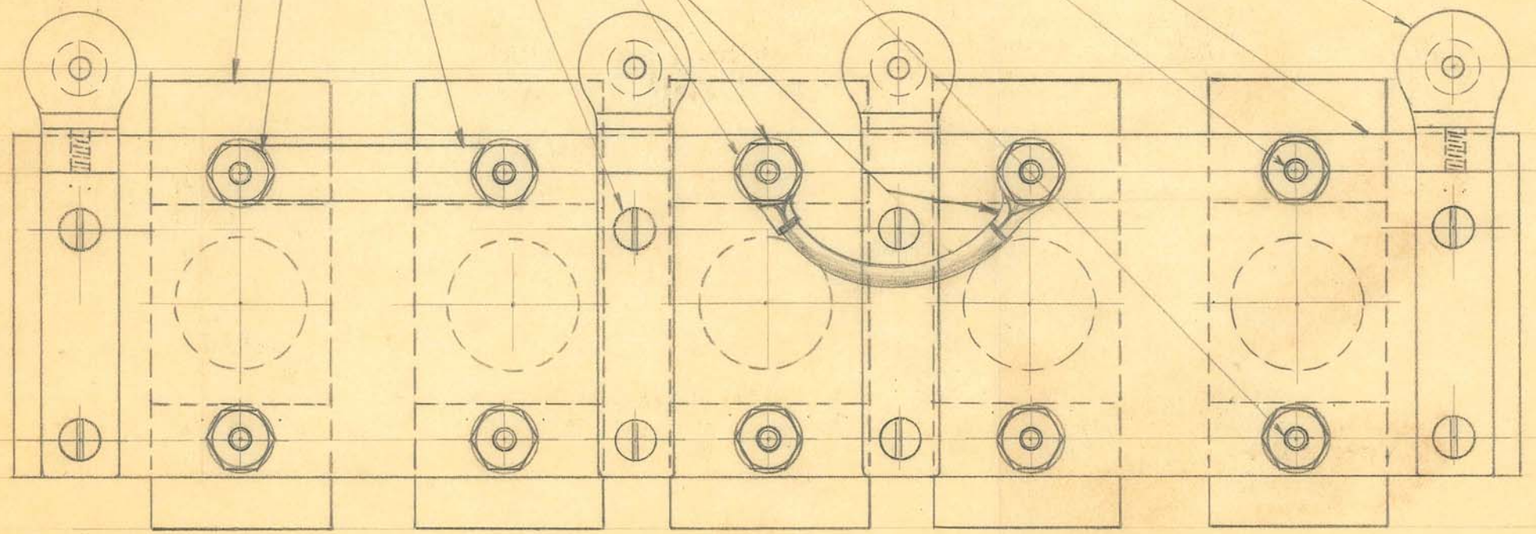

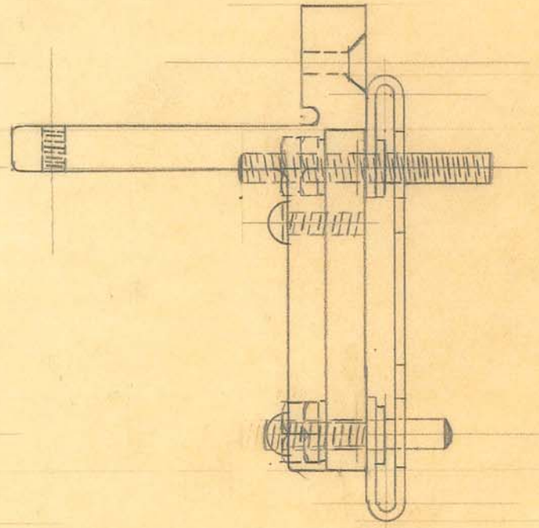

OBSOLETE

SIZE		ISSUE 12-4-33	N.R.
KIND		CHANGED	
SHAPE		" "	
FINISH		" "	
TEMP.		" "	
PATT.		" "	

TITLE: FISCHER MODEL "H" DIATHERMY OUTFIT
GAP SUPPORT

H. G. FISCHER & CO.
2335 WABANSIA AVE.
CHICAGO, ILL.

CAT. NO.

PART NO. 7454GA

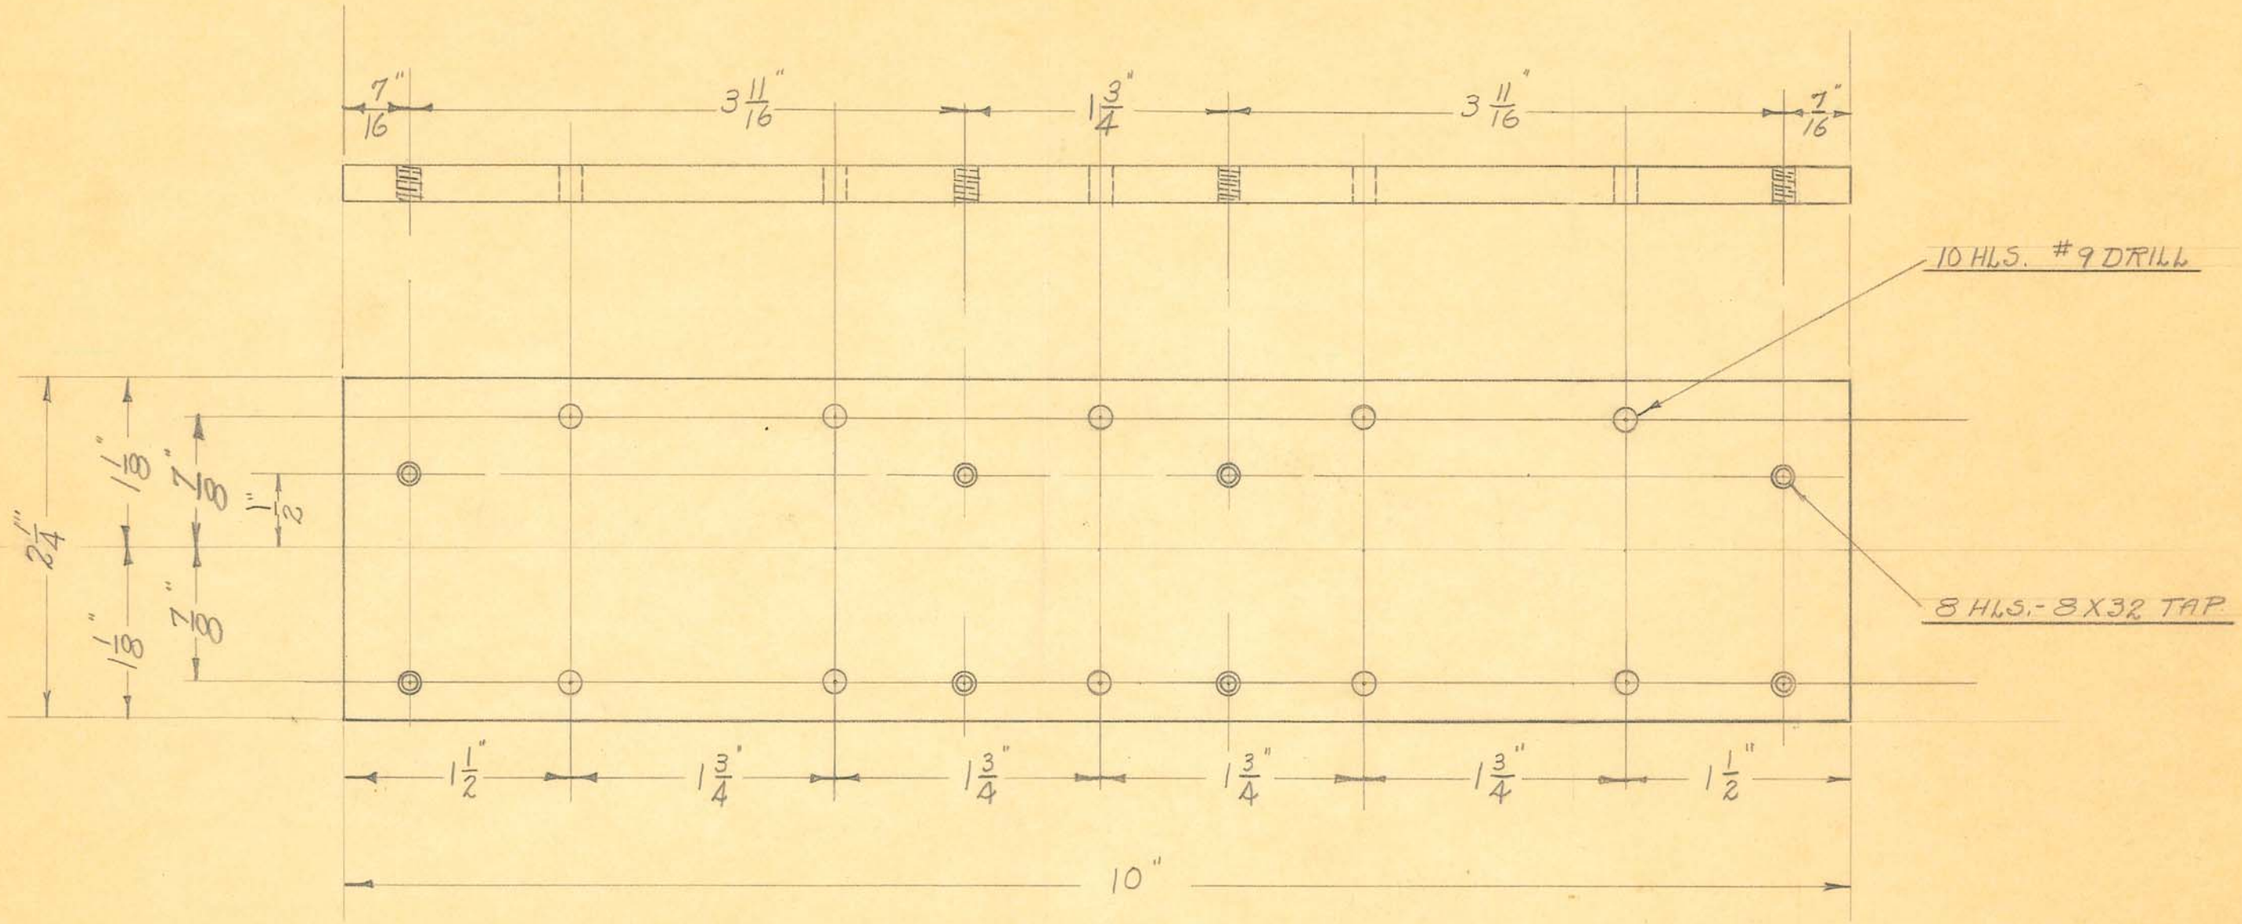

1 REQUIRED

OBSOLETE

SIZE	½ SHEET	ISSUE 11-4-33	N P
KIND	BAKELITE	CHANGED	
SHAPE		" "	
FINISH	BLACK	" "	
TEMP.		" "	
PATT.		" "	

TITLE: FISCHER MODEL "H" DIATHERMY OUTFIT
GAP SUPPORT STRIP

H. G. FISCHER & CO.
2335 WABANSIA AVE.
CHICAGO, ILL.

CAT. NO.

PART NO. 7456A

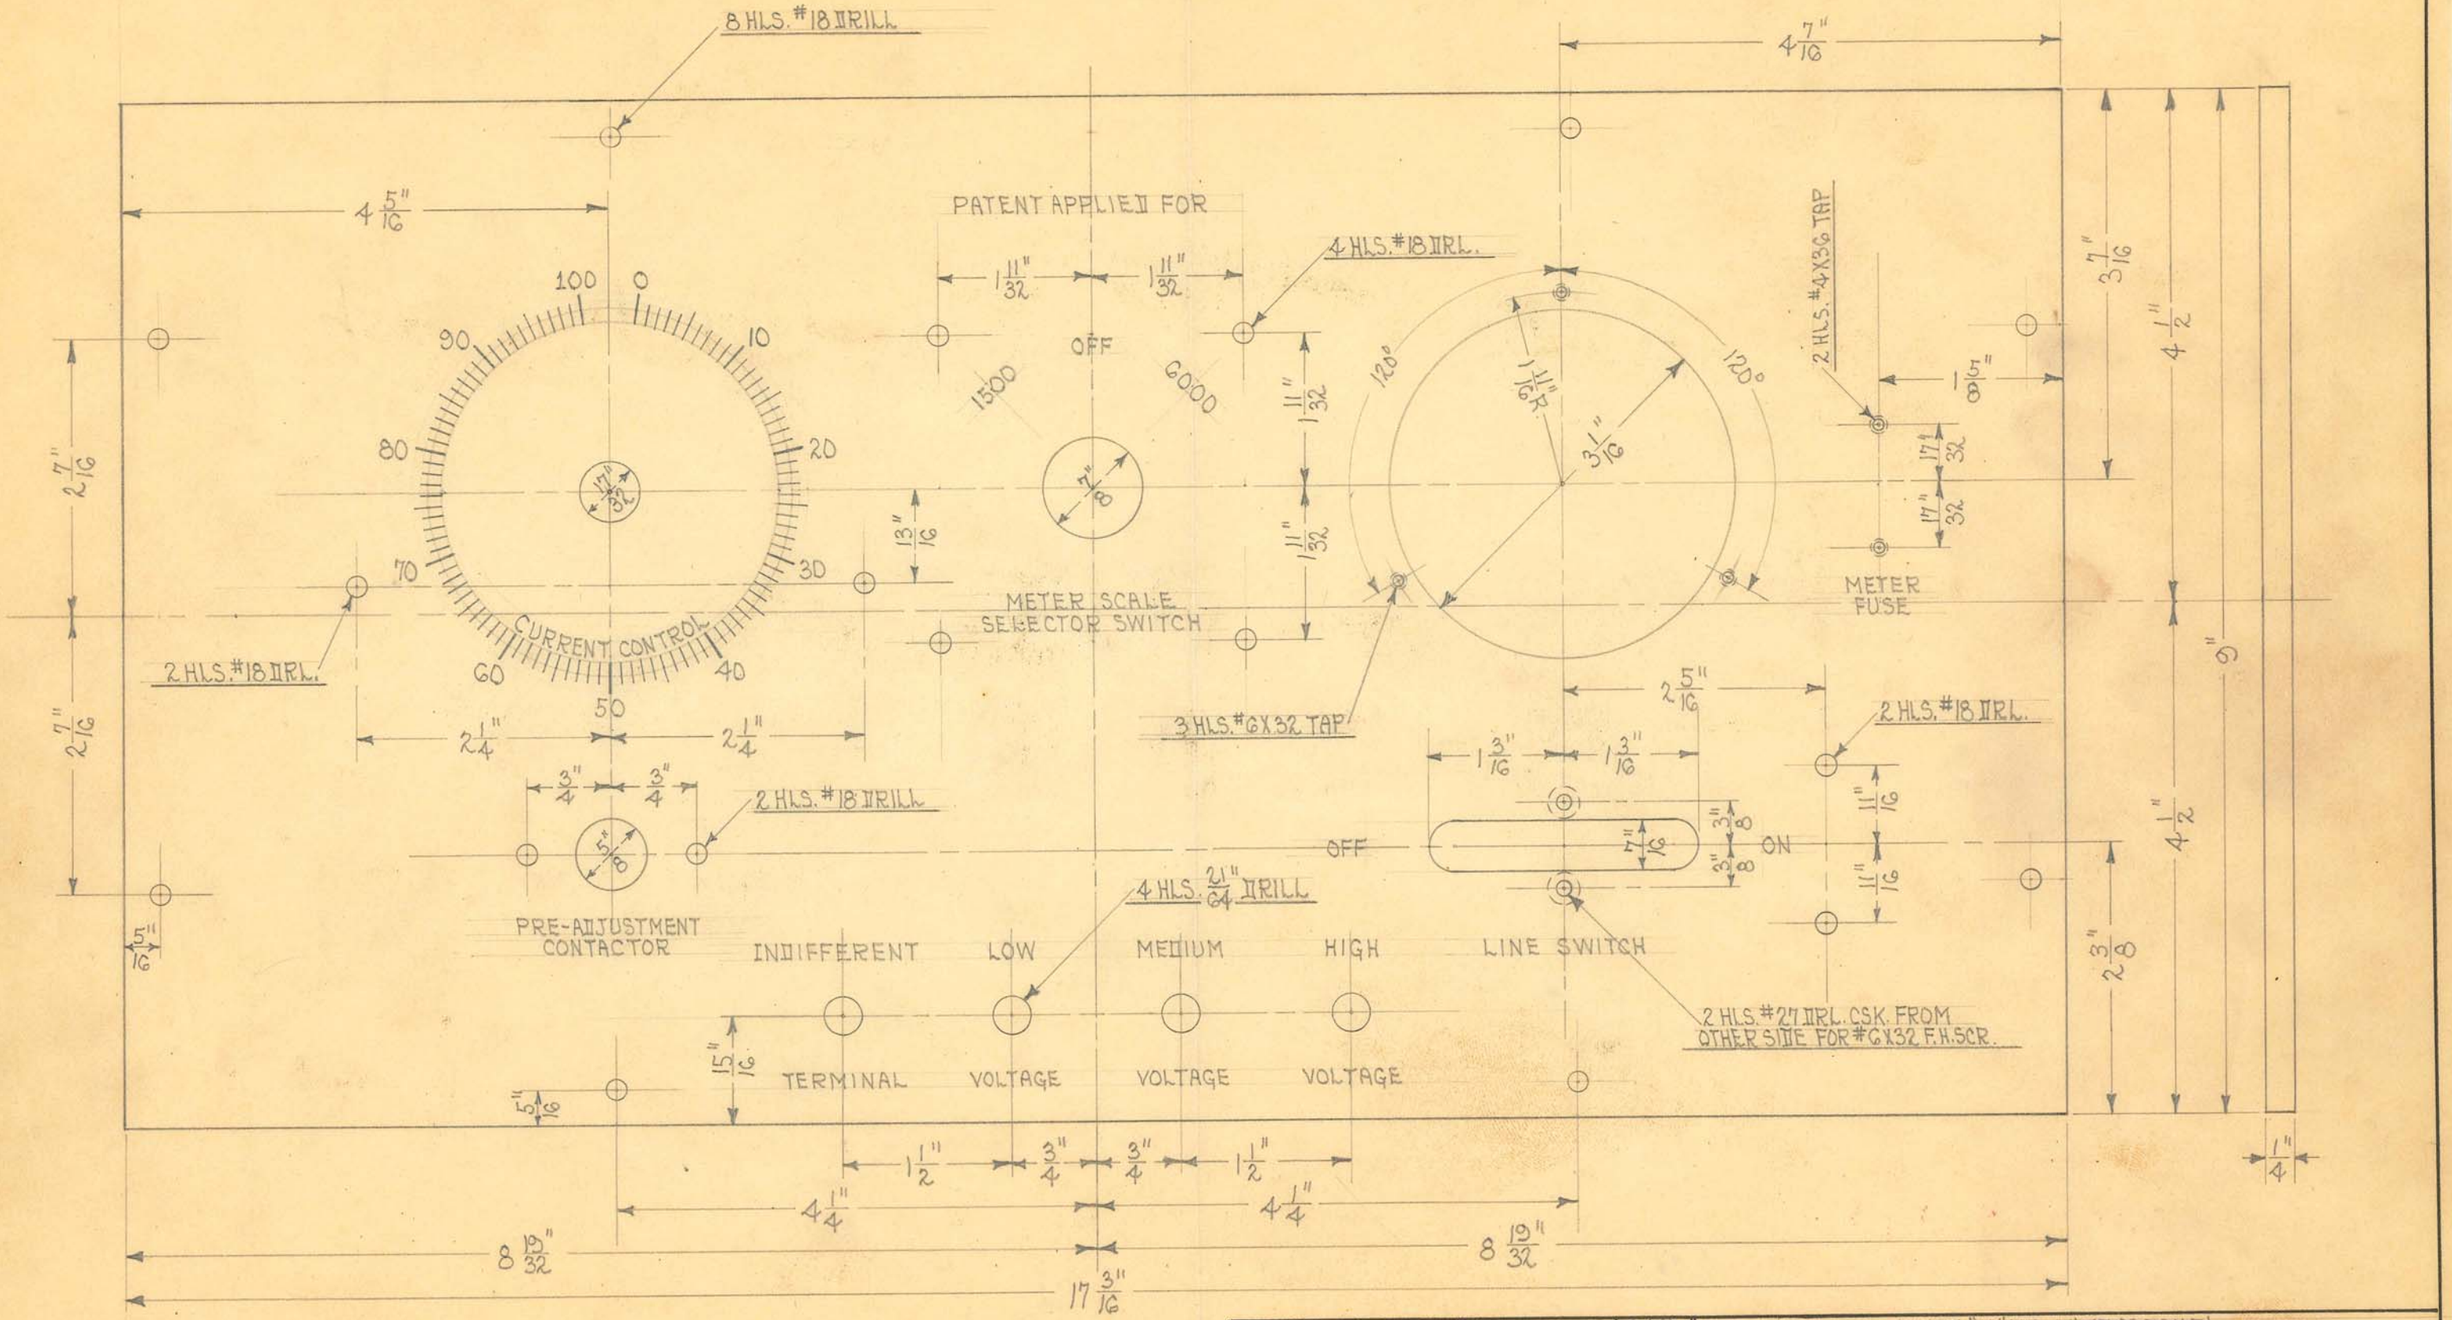

SCALE ≈ 3/4 = 1"

SIZE	3"X17 3/16"X1/4"	ISSUE 10-26-32	A.E.	TITLE: FISCHER MODEL "H" DIA OUTFIT PANEL
KIND	BAKELITE	CHANGED		OBSOLETE
SHAPE		" "		
FINISH		" "		
TEMP.		" "		
PATT.		" "		

H. G. FISCHER & CO.
2335 WABANSIA AVE.
CHICAGO, ILL.

CAT. NO.

PART NO. 7453F

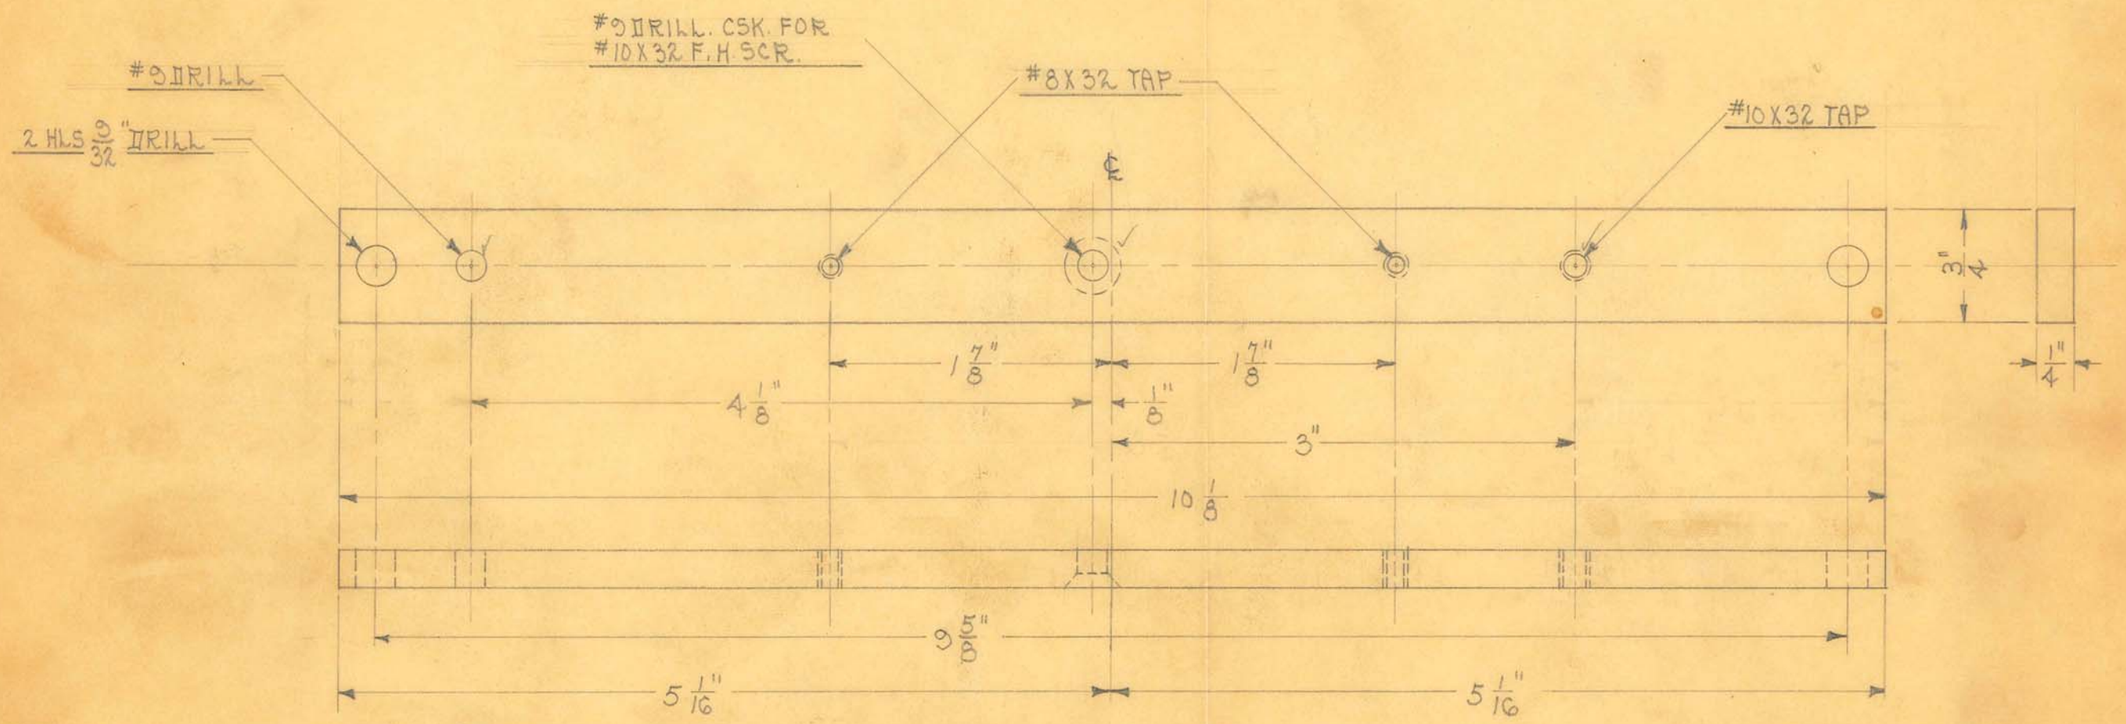

SCALE ~ FULL SIZE

1 REQUIRED

OBSOLETE

SIZE	1/4" X 3/4"	ISSUED 2-28-31	A.E.
KIND	C.R. STEEL	CHANGED	
SHAPE		" "	
FINISH	BLACK DIP	" "	
TEMP.		" "	
PATT.		" "	

TITLE: COAG. OUTFIT TRANS., SPARK GAP & CONDENSER SUPPORT STRIP.

H. G. FISCHER & CO.
2335 WABANSIA AVE.
CHICAGO, ILL.

CAT. NO.

PART NO. 6839

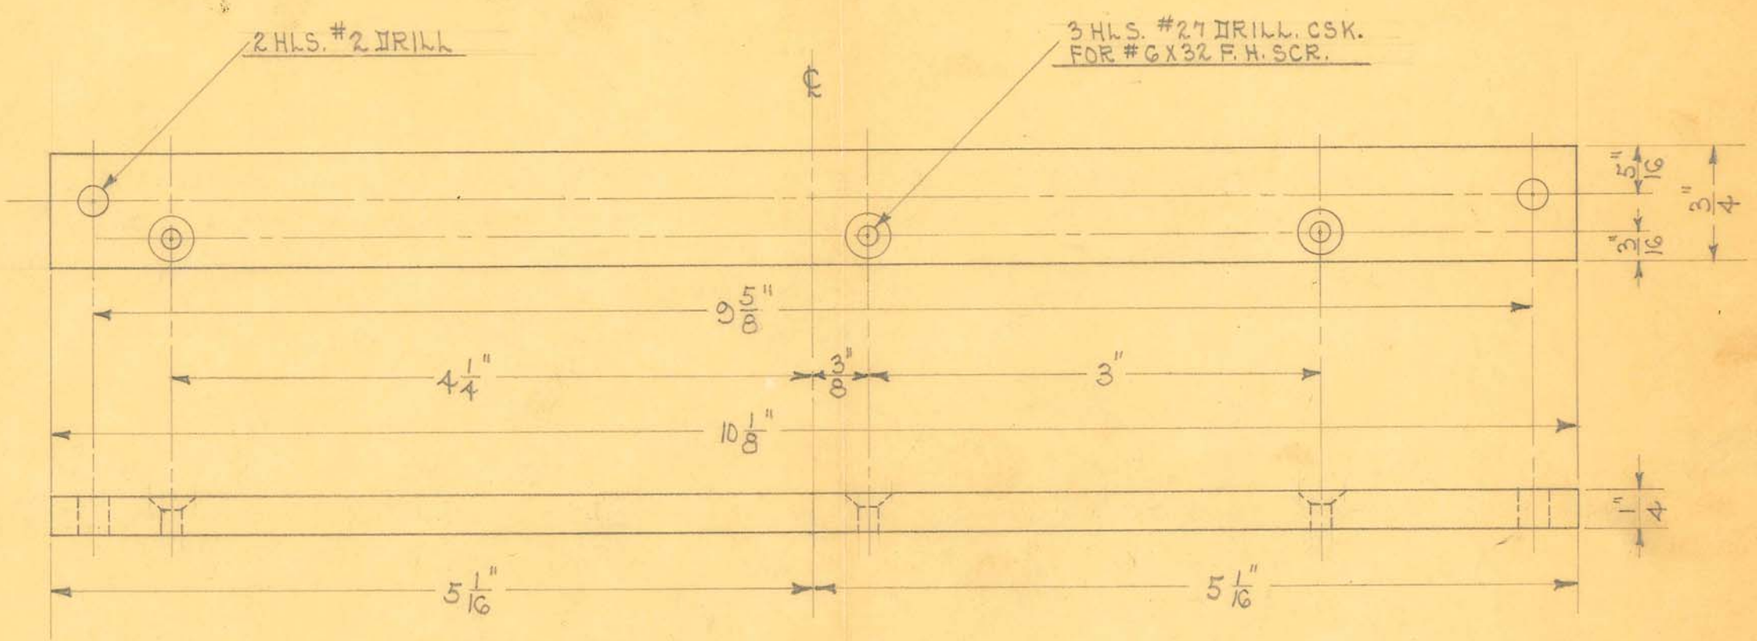

SCALE ÷ FULL SIZE
1 REQ'D.

SIZE	1/4" X 3/4"	ISSUE 10-5-31	H.E.
KIND	COLD ROLLED	CHANGED	
SHAPE		" "	
FINISH	BLACK DIP	" "	
TEMP.		" "	
PATT.		" "	

TITLE: CORG. OUTFIT VARIOMETER SUPPORT STRIP (STEEL)

OBSOLETE

H. G. FISCHER & CO.
2335 WABANSIA AVE.
CHICAGO, ILL.

CAT. NO.

PART NO. 6824

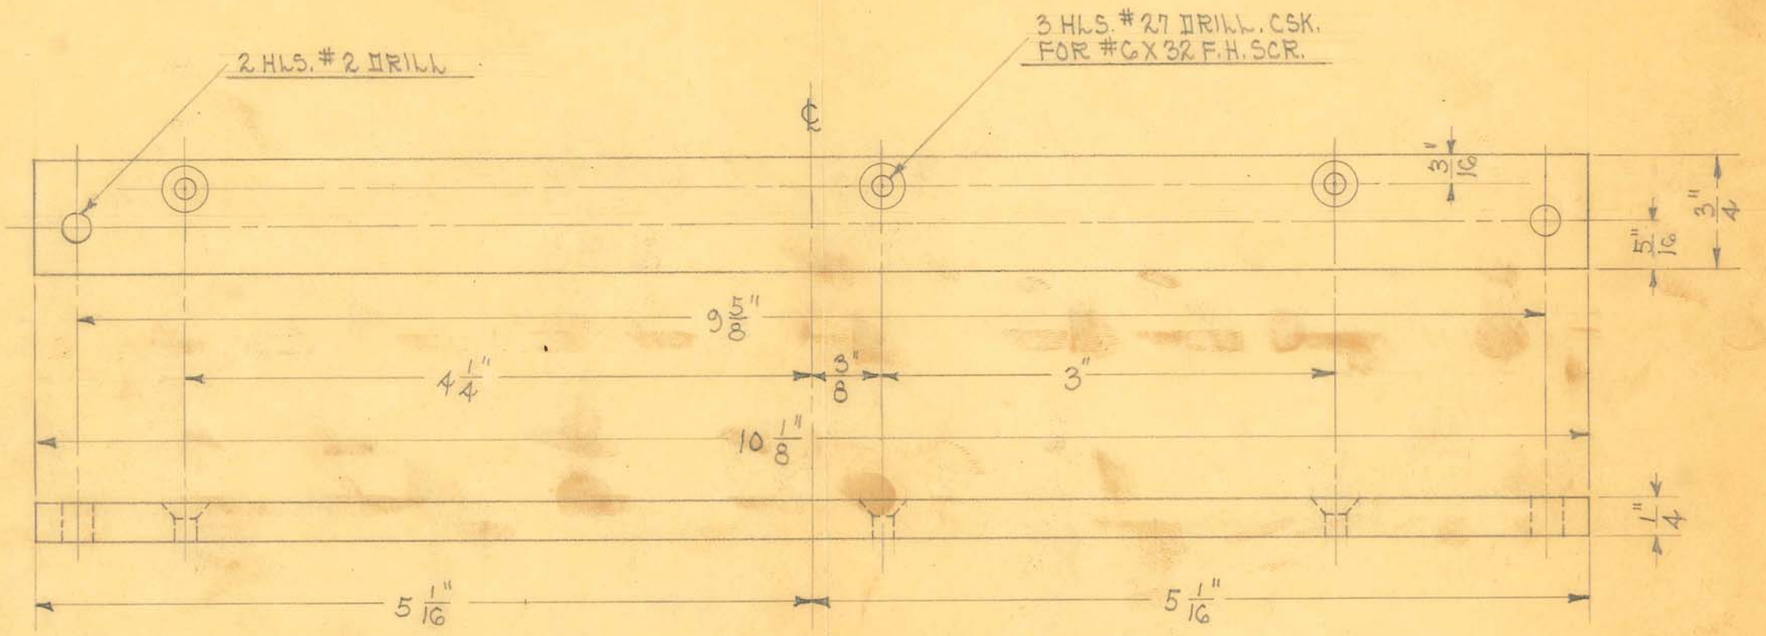

SCALE ~ FULL SIZE
1 REQ'D.

SIZE	1/4"	ISSUE 9-4-31	A.E.
KIND	BAKELITE	CHANGED	
SHAPE		" "	
FINISH		" "	
TEMP.		" "	
PATT.		" "	

TITLE: COAG. OUTFIT VARIOMETER SUPPORT STRIP. (BAKELITE)

OBSOLETE

H. G. FISCHER & CO.
2335 WABANSIA AVE.
CHICAGO, ILL.

CAT. NO.

PART NO. 6823F

USE PERFORATING DIE # 1058

14 HOLES #27 DRILL

USE DIE # 3228 FOR CORNERS

$2\frac{1}{4}$" $2\frac{1}{4}$"

$7\frac{9}{16}$" $7\frac{9}{16}$"

$4\frac{3}{8}$" $2\frac{7}{32}$" $2\frac{7}{32}$" $4\frac{3}{8}$"

$7\frac{11}{16}$" $7\frac{11}{16}$"

$15\frac{3}{8}$"

$5\frac{15}{32}$" $4\frac{17}{32}$" $5\frac{9}{16}$" $11\frac{1}{8}$"

SCALE ~ $\frac{3}{4}$" = 1"

1 REQUIRED

SIZE	.028"	ISSUE 11-6-31	A.B.
KIND	SHEET ZINC	CHANGED	
SHAPE		" "	
FINISH		" "	
TEMP.		" "	
PATT. "		" "	

TITLE: COAG. OUTFIT BOTTOM PLATE

OBSOLETE

H. G. FISCHER & CO.
2335 WABANSIA AVE.
CHICAGO, ILL.

CAT. NO.

PART NO. G814

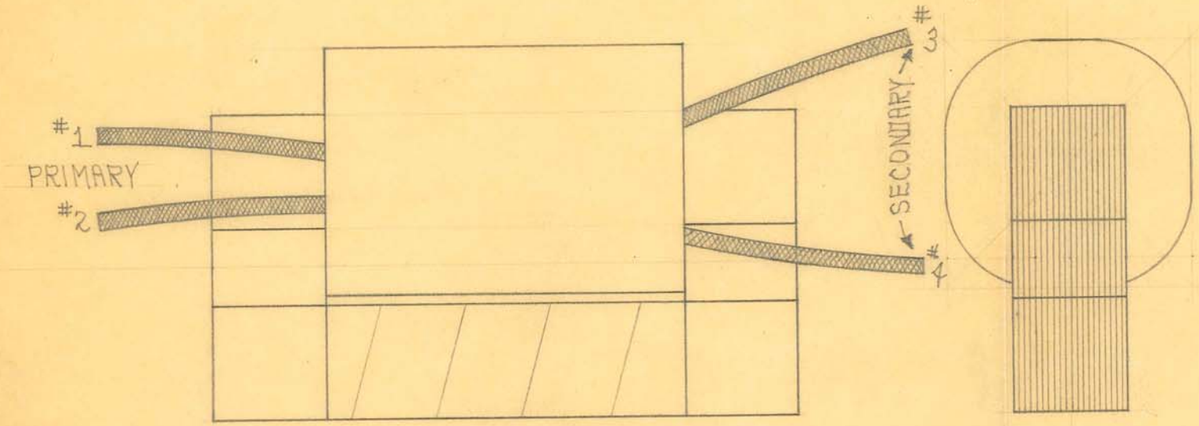

STEEL SIZES

PC. No. 5043

CORE LAMS.- CUT $3\frac{1}{8}$" X $\frac{3}{4}$" BUILT UP TO $\frac{3}{4}$".
END PCS.- CUT $1\frac{1}{4}$" X $\frac{3}{4}$"
BIND CORES WITH FRICTION TAPE.

WINDING DATA

PRIMARY

3 LAYERS OF 5020 $\frac{1}{4}$ FIBROID PAPER ON CORE. ANCHOR LEAD #1 WITH FRICTION TAPE & WIND 800 TURNS OF # 29 ENAMEL WIRE. ANCHOR END WITH FRICTION TAPE-LEAD #2. 1 LAYER OF 5020 $\frac{1}{4}$ FIBROID BETWEEN EACH LAYER OF WIRE. COVER PRI. WITH 2 LAYERS OF 5020 $\frac{1}{4}$ FIBROID.

SECONDARY

ANCHOR LEAD #3 WITH FRICTION TAPE & WIND 110 TURNS OF # 26 ENAMEL WIRE. ANCHOR END WITH FRICTION TAPE-LEAD #4. COVER WITH 5004 OILED TAPE & SHELLAC. 1 LAYER OF 5020 $\frac{1}{4}$ FIBROID BETWEEN EACH LAYER OF WIRE. ALL LEADS ARE 1648-# 20 WEATHERPROOF WIRE.

OBSOLETE

SIZE		ISSUE 5-7-32	A.E.	TITLE: FISCHER DIAGNOSTIC LAMP REGULATOR TRANS.	
KIND		CHANGED			
SHAPE		" "			
FINISH		" "			
TEMP.		" "		H. G. FISCHER & CO. 2335 WABANSIA AVE. CHICAGO, ILL.	CAT. NO.
PATT.		" "			PART NO. 6782G

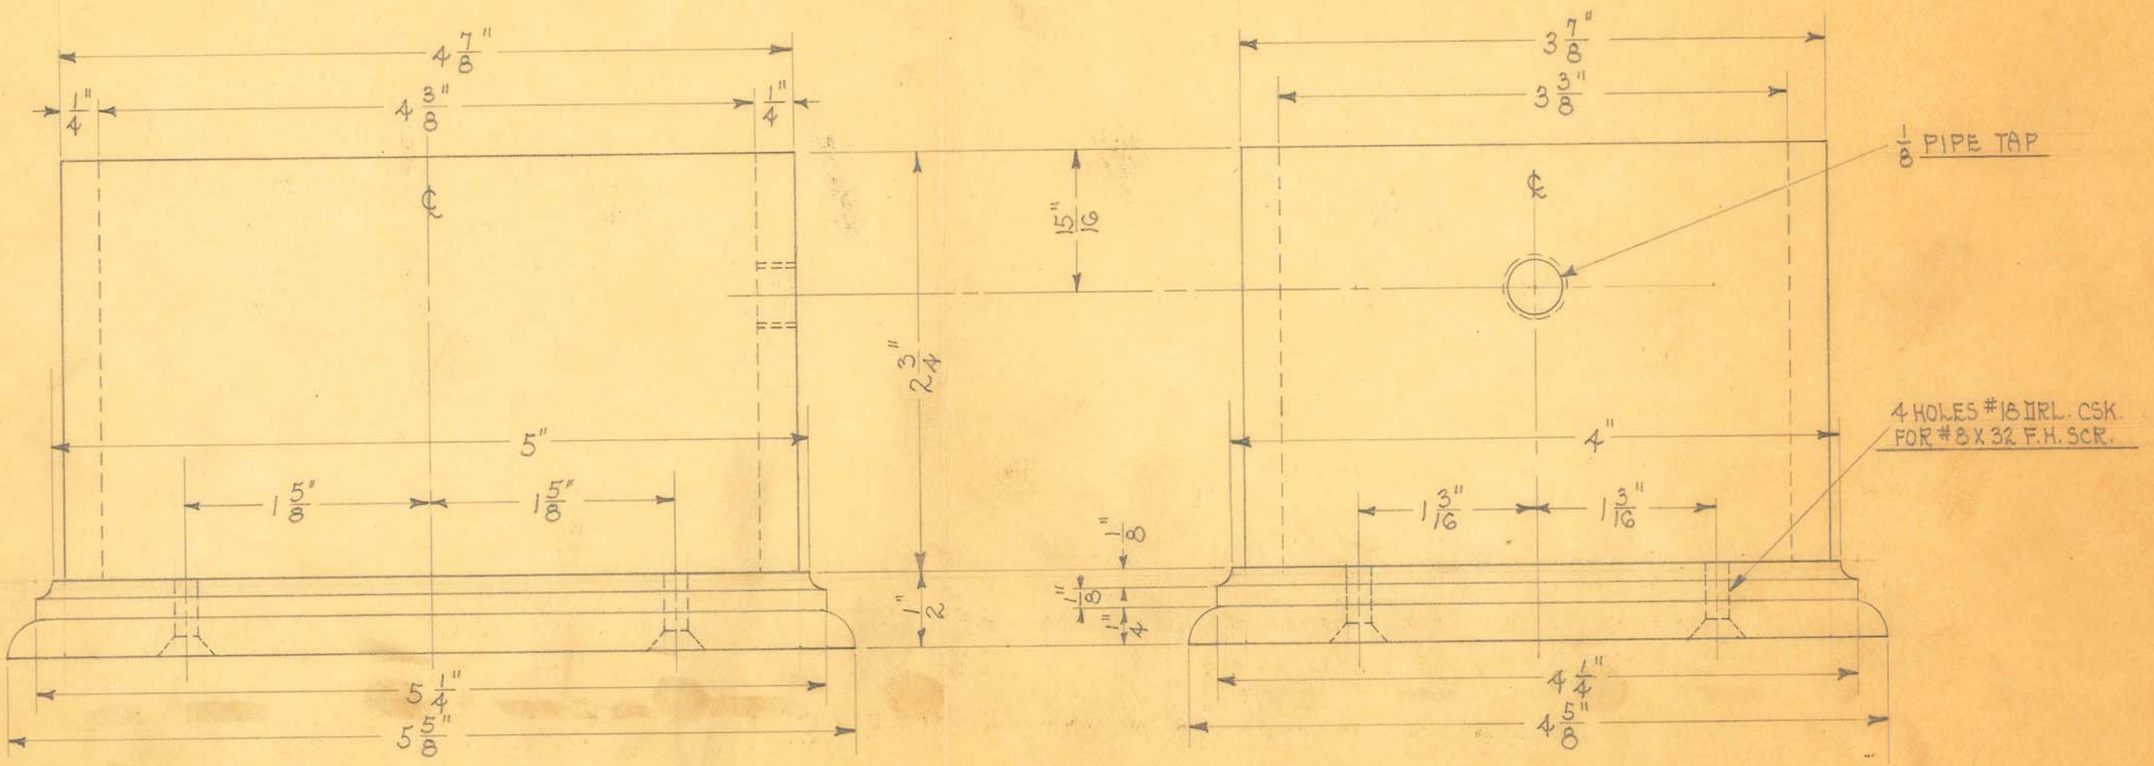

SCALE ½ FULL SIZE
1 REQUIRED

OBSOLETE

SIZE		ISSUE 10-22-31	A.E.
KIND	WALNUT	CHANGED	
SHAPE		" "	
FINISH		" "	
TEMP.		" "	
PATT.		" "	

TITLE: FISCHER DIAGNOSTIC LAMP REGULATOR CABINET

H. G. FISCHER & CO.
2335 WABANSIA AVE.
CHICAGO, ILL.

CAT. NO.

PART NO. 6780F

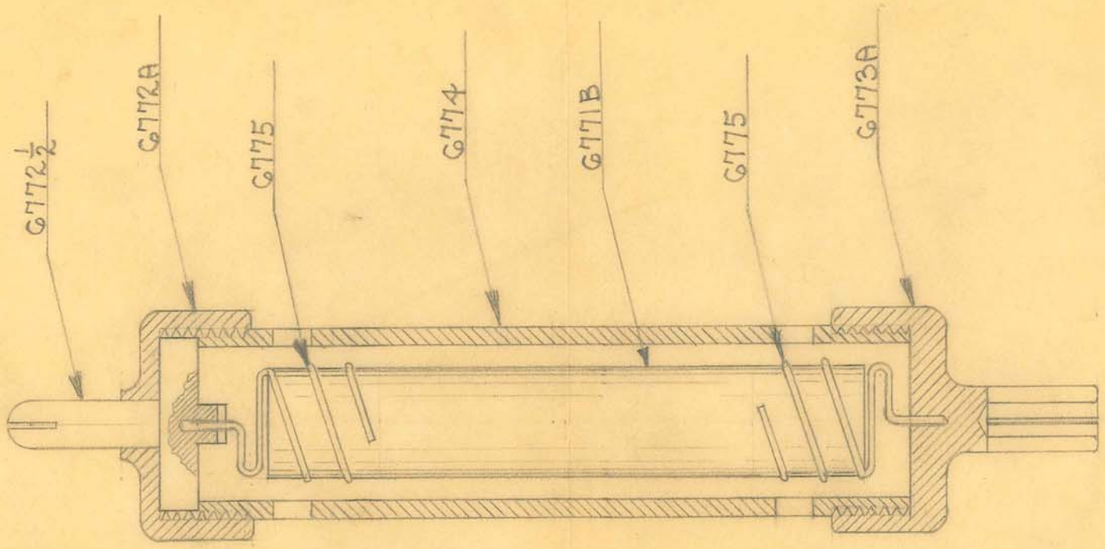

OBSOLETE

SIZE		ISSUE 1-4-32	H.E.
KIND		CHANGED	
SHAPE		" "	
FINISH		" "	
TEMP.		" "	
PATT.		" "	

TITLE: DIATH. PRE-ADJUSTMENT UNIT ASSEMBLY

H. G. FISCHER & CO.
2335 WABANSIA AVE.
CHICAGO, ILL.

CAT. NO.

PART NO. 6770G

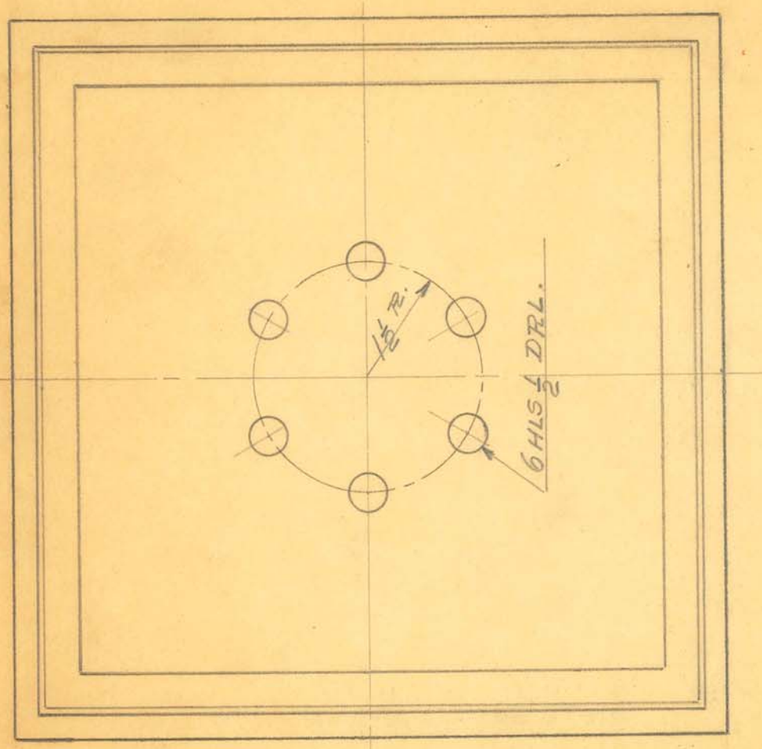

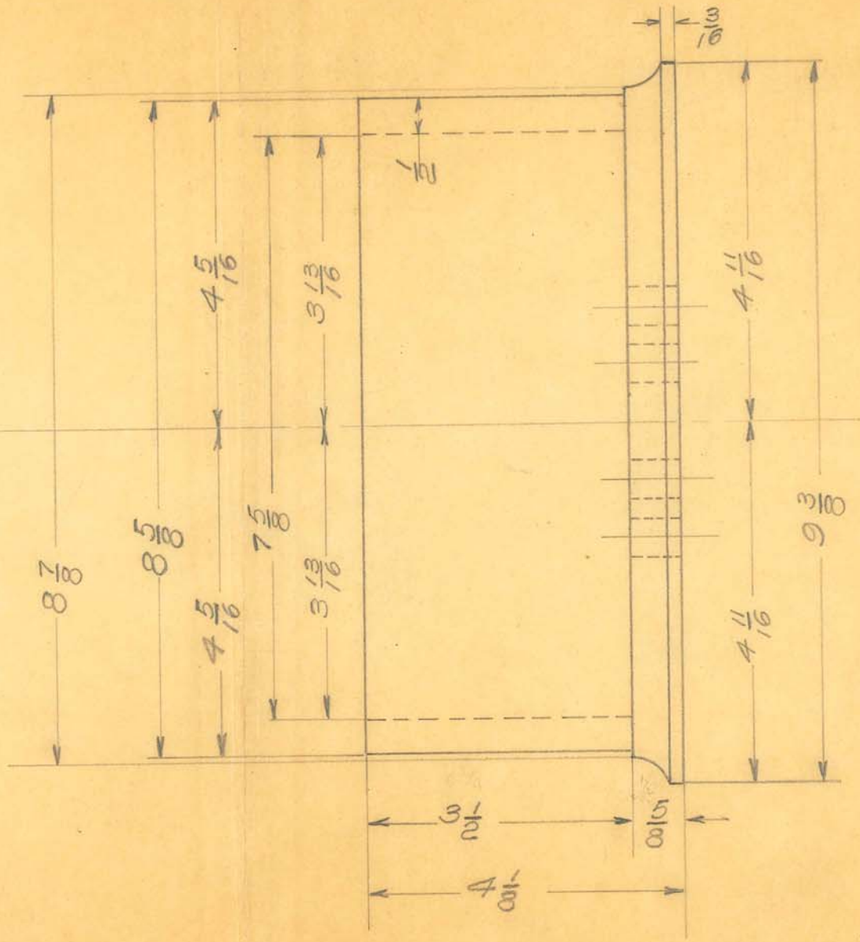

WALNUT CABINET

1 REQ.

SCALE HALF SIZE

OBSOLETE

SIZE		ISSUE 1-29-31	C.H.	TITLE: HIGH FREQUENCY POTENTIOMETER. CABINET
KIND		CHANGED		
SHAPE		" "		
FINISH		" "		
TEMP.		" "		H. G. FISCHER & CO. 2335 WABANSIA AVE. CHICAGO, ILL. — CAT. NO. — PART NO. 6601
PATT.		" "		

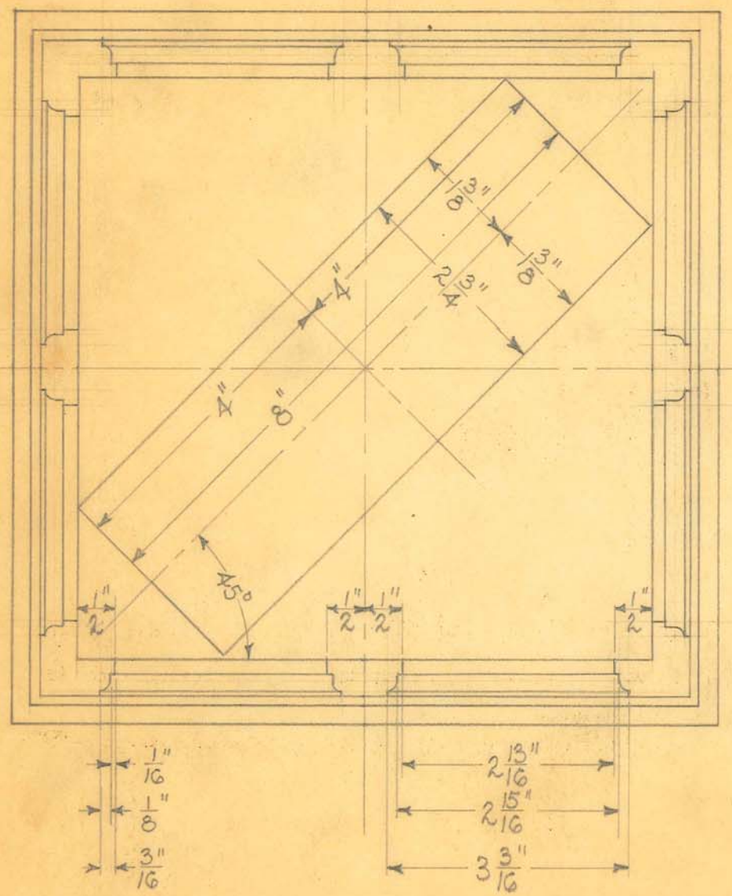

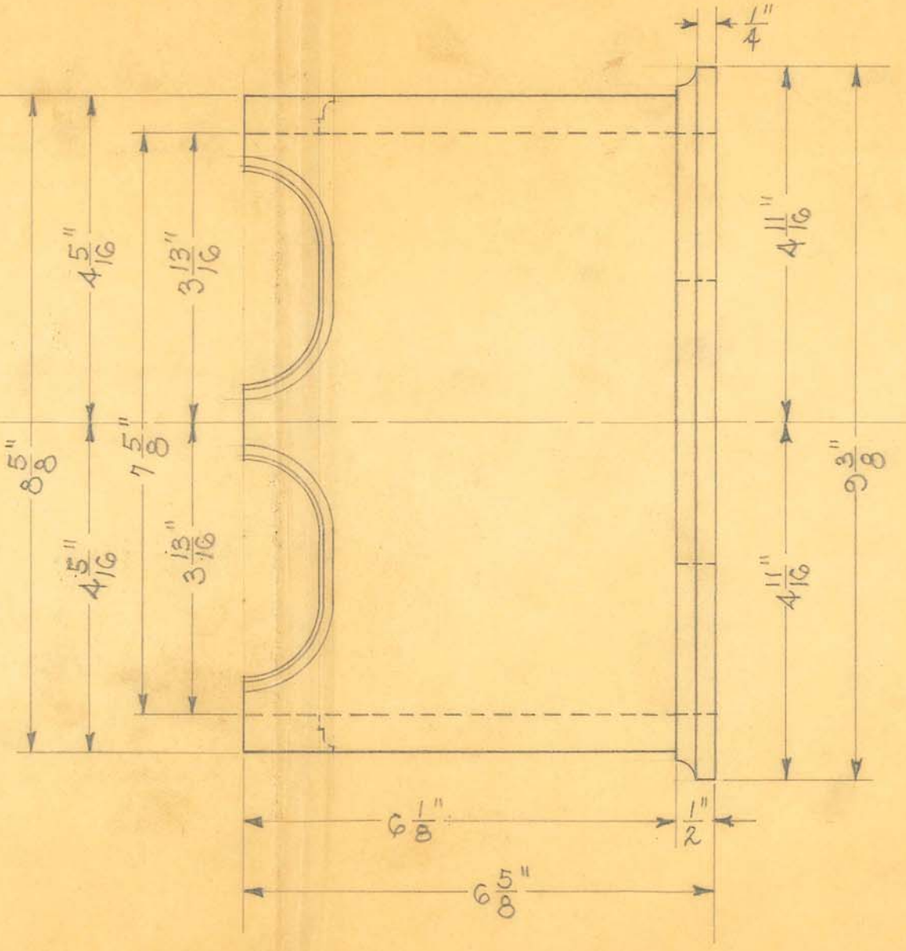

WALNUT CABINET

1 REQ.

SCALE ½ HALF SIZE

OBSOLETE

SIZE		ISSUE 8-24-31	H.E.
KIND		CHANGED	
SHAPE		" "	
FINISH		" "	
TEMP.		" "	
PATT.		" "	

TITLE: IIIA. PRECISION CONTROL UNIT CABINET

H. G. FISCHER & CO.
2335 WABANSIA AVE.
CHICAGO, ILL.

CAT. NO.

PART NO. 6601A

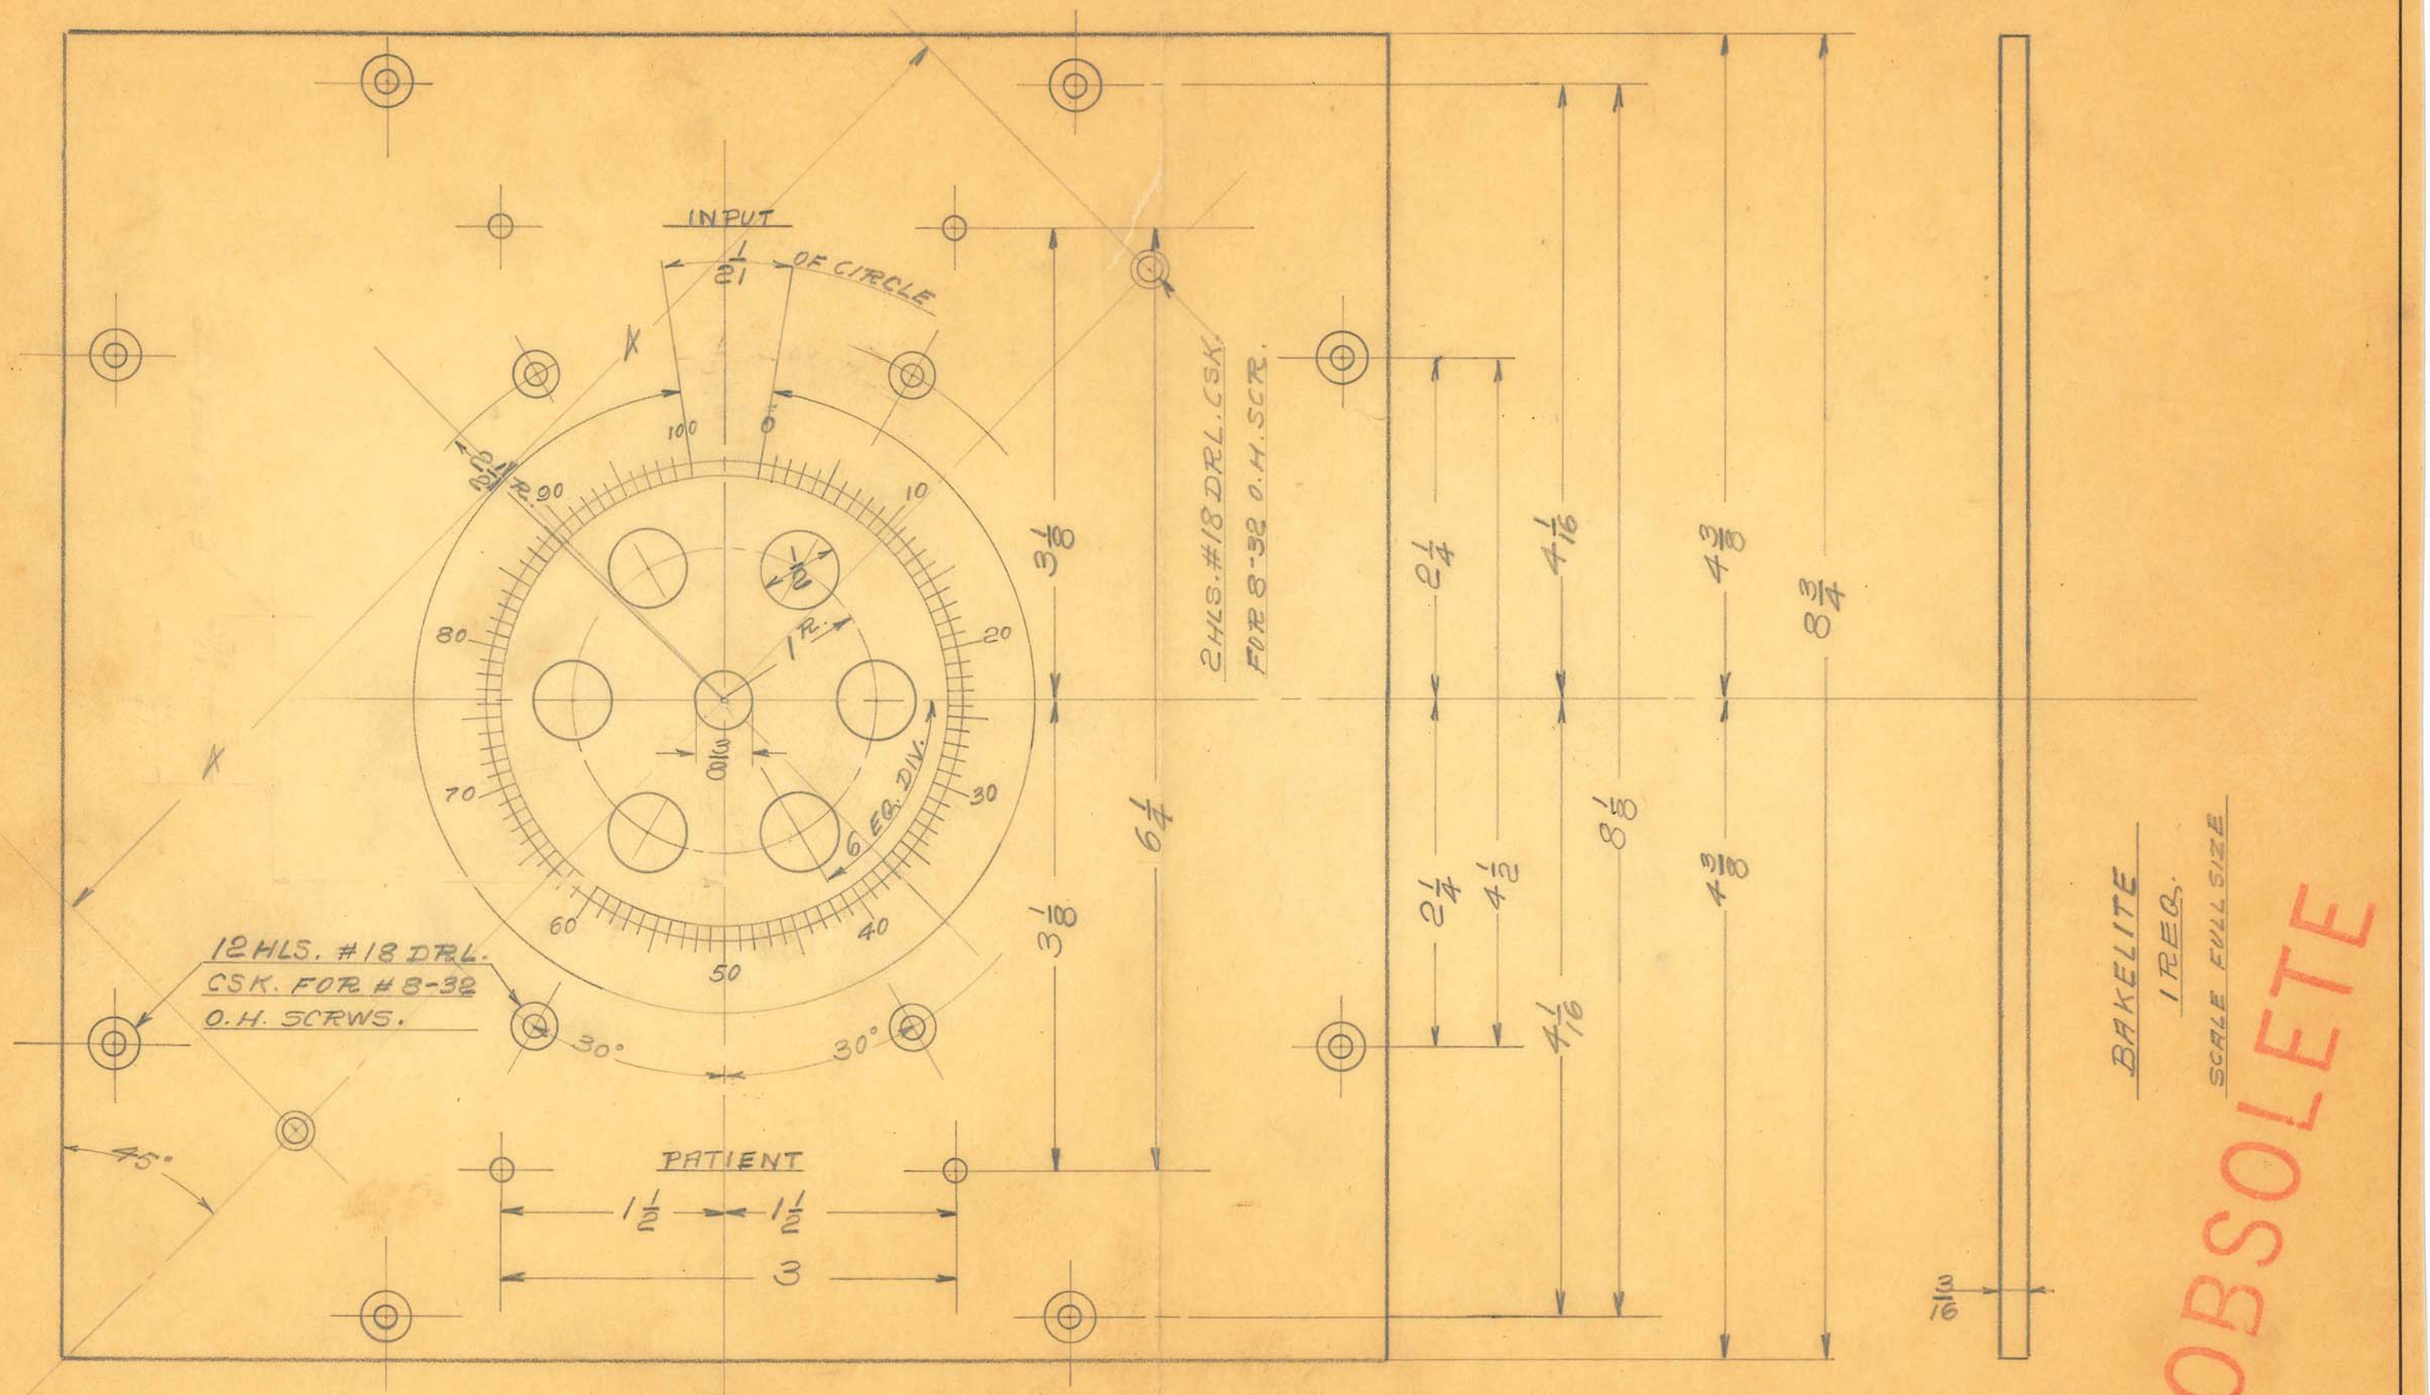

SIZE		ISSUE 1-26-31	C.M.
KIND		CHANGED	
SHAPE		" "	
FINISH		" "	
TEMP.		" "	
PATT.		" "	

TITLE: HIGH FREQUENCY POTENTIOMETER DIAL PANEL

H. G. FISCHER & CO.
2335 WABANSIA AVE.
CHICAGO, ILL.

CAT. NO.

PART NO. 6602 F

8 HLS. #27 IRL. CSK FOR #6X32 O.H. SCREW

INDIFFERENT

INPUT

ACTIVE

4 HLS. #18 IRL.

1/21 OF CIRCLE

A"

100 0 10 20 30 40 50 60 70 80 90

2 1/2" R.

1" R.

1/2"

9/32"

6 EQ. SP.

3 1/8"

1 1/2"

4"

4 1/2"

8"

6"

6 HLS. #18 IRL. CSK. FOR #8X32 O.H. SCREWS

30° 30°

45°

INDIFFERENT PATIENT ACTIVE

1 1/2" 1 1/2"

3"

1/2"

3/16"

SIZE	9"X9"X 3/16"	ISSUE 8-22-31	A.E.
KIND	BAKELITE	CHANGED	
SHAPE		" "	
FINISH		" "	
TEMP.		" "	
PATT.		" "	

TITLE: IIA. PRECISION CONTROL UNIT PANEL

OBSOLETE

H. G. FISCHER & CO.
2335 WABANSIA AVE.
CHICAGO, ILL.

CAT. NO.

PART NO. 6602FA

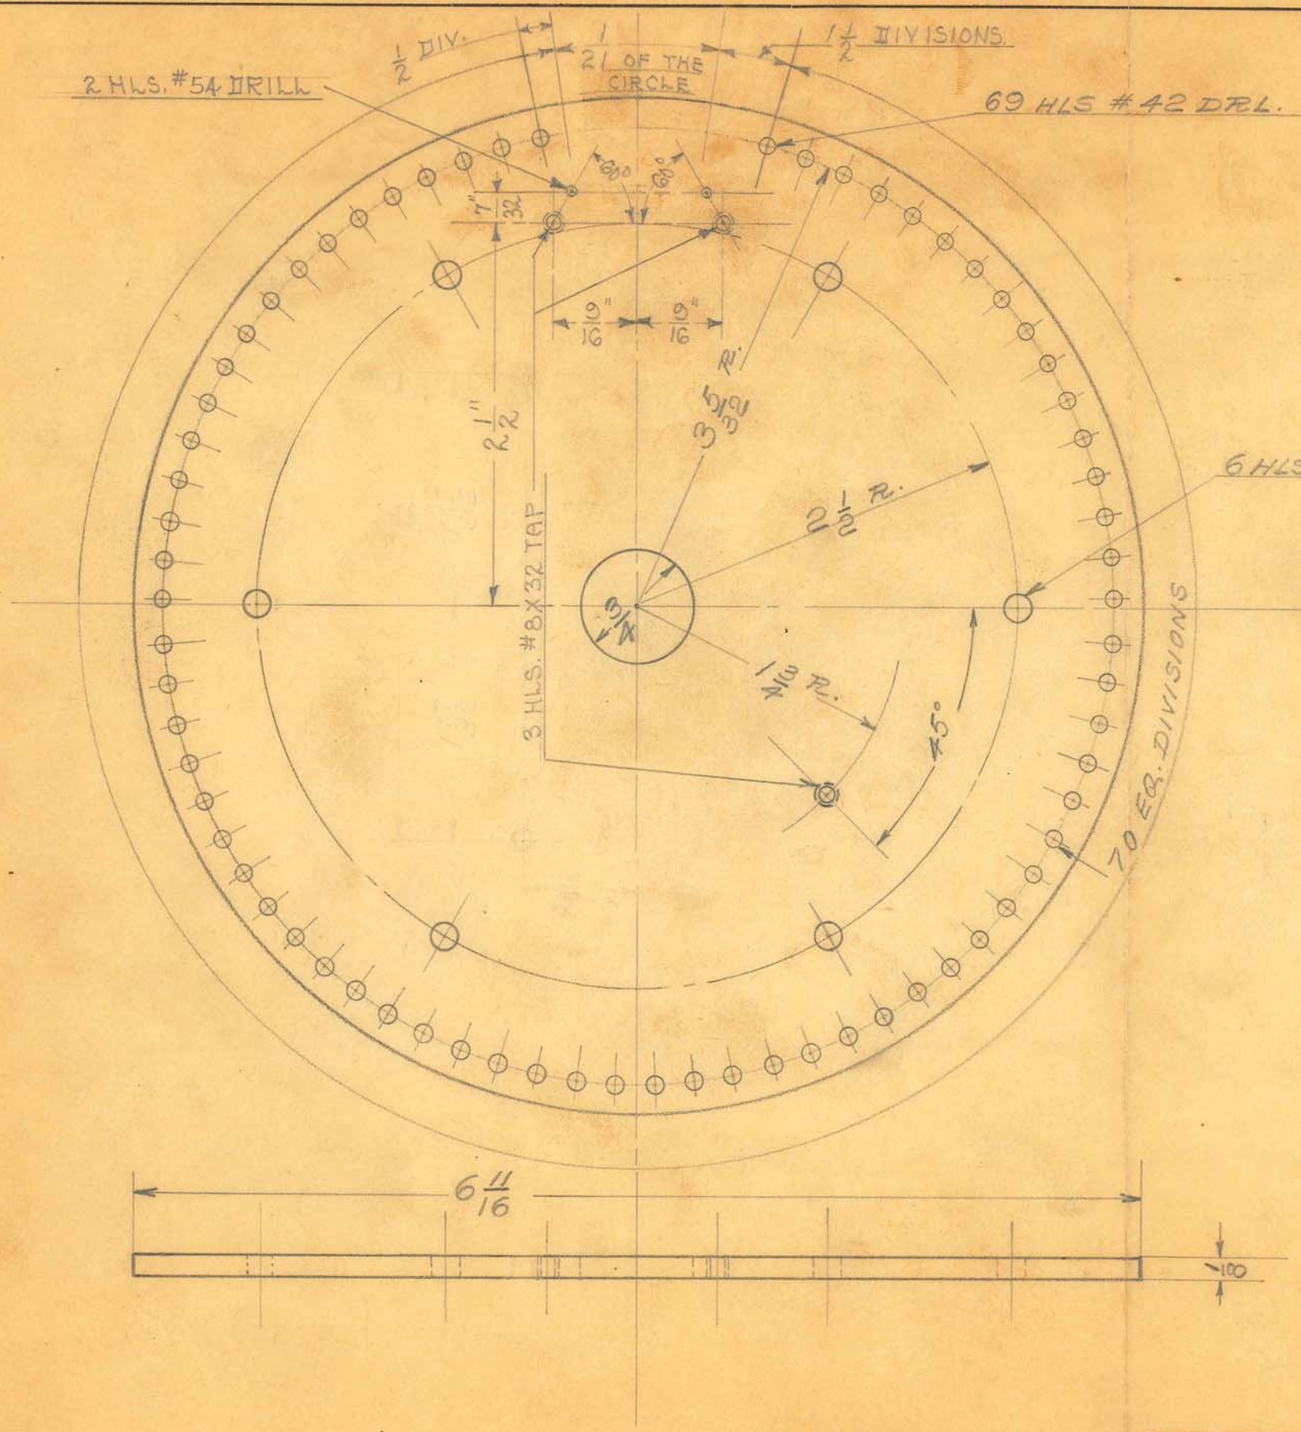

BAKELITE

1 REQ.

SCALE FULL SIZE

OBSOLETE

SIZE		ISSUE 3-2-31	C.W.
KIND		CHANGED	
SHAPE		" "	
FINISH		" "	
TEMP.		" "	
PATT.		" "	

TITLE: HIGH FREQUENCY POTETIOMETER

UPPER PLATE

H. G. FISCHER & CO.
2335 WABANSIA AVE.
CHICAGO, ILL.

CAT. NO.

PART NO. 6603

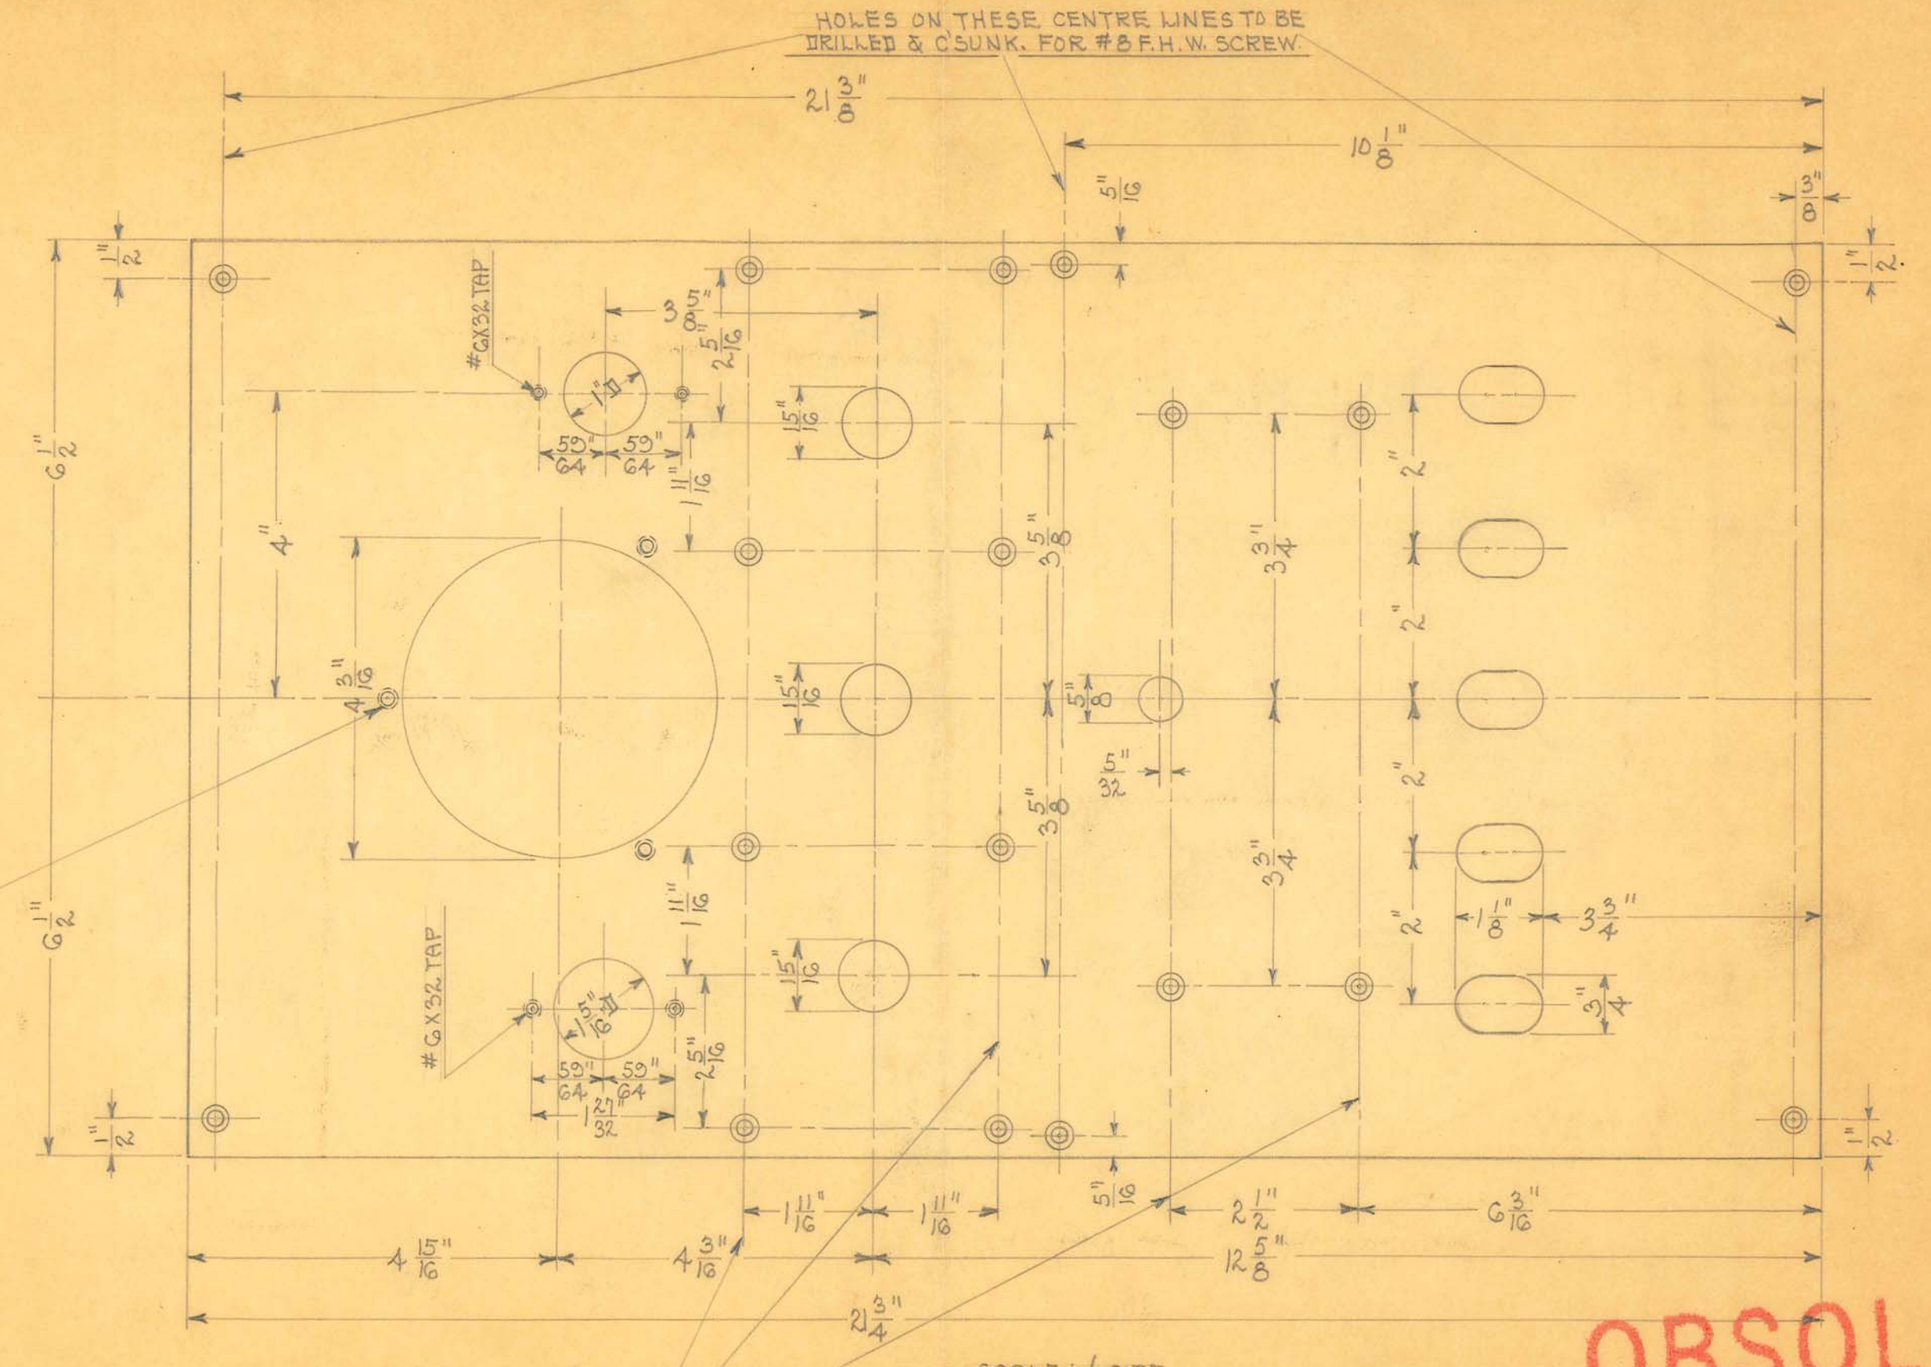

SCALE ÷ 1/2 SIZE

OBSOLETE

SIZE	1/4"	ISSUE 6-25-30	A.E.
KIND	BAKELITE	CHANGED 10-14-30	A.E.
SHAPE	SHEET	" " 11-24-30	C.M.
FINISH		RETRACED 6-19-31	A.E.
TEMP.		" "	
PATT.		" "	

TITLE: "CDC" PANEL

H. G. FISCHER & CO.
2335 WABANSIA AVE.
CHICAGO, ILL.

CAT. NO.

PART NO. 7005F

HOLES ON THESE CENTRE LINES TO BE DRILLED
& COUNTER SUNK FOR #8 F.H.W. SCREW

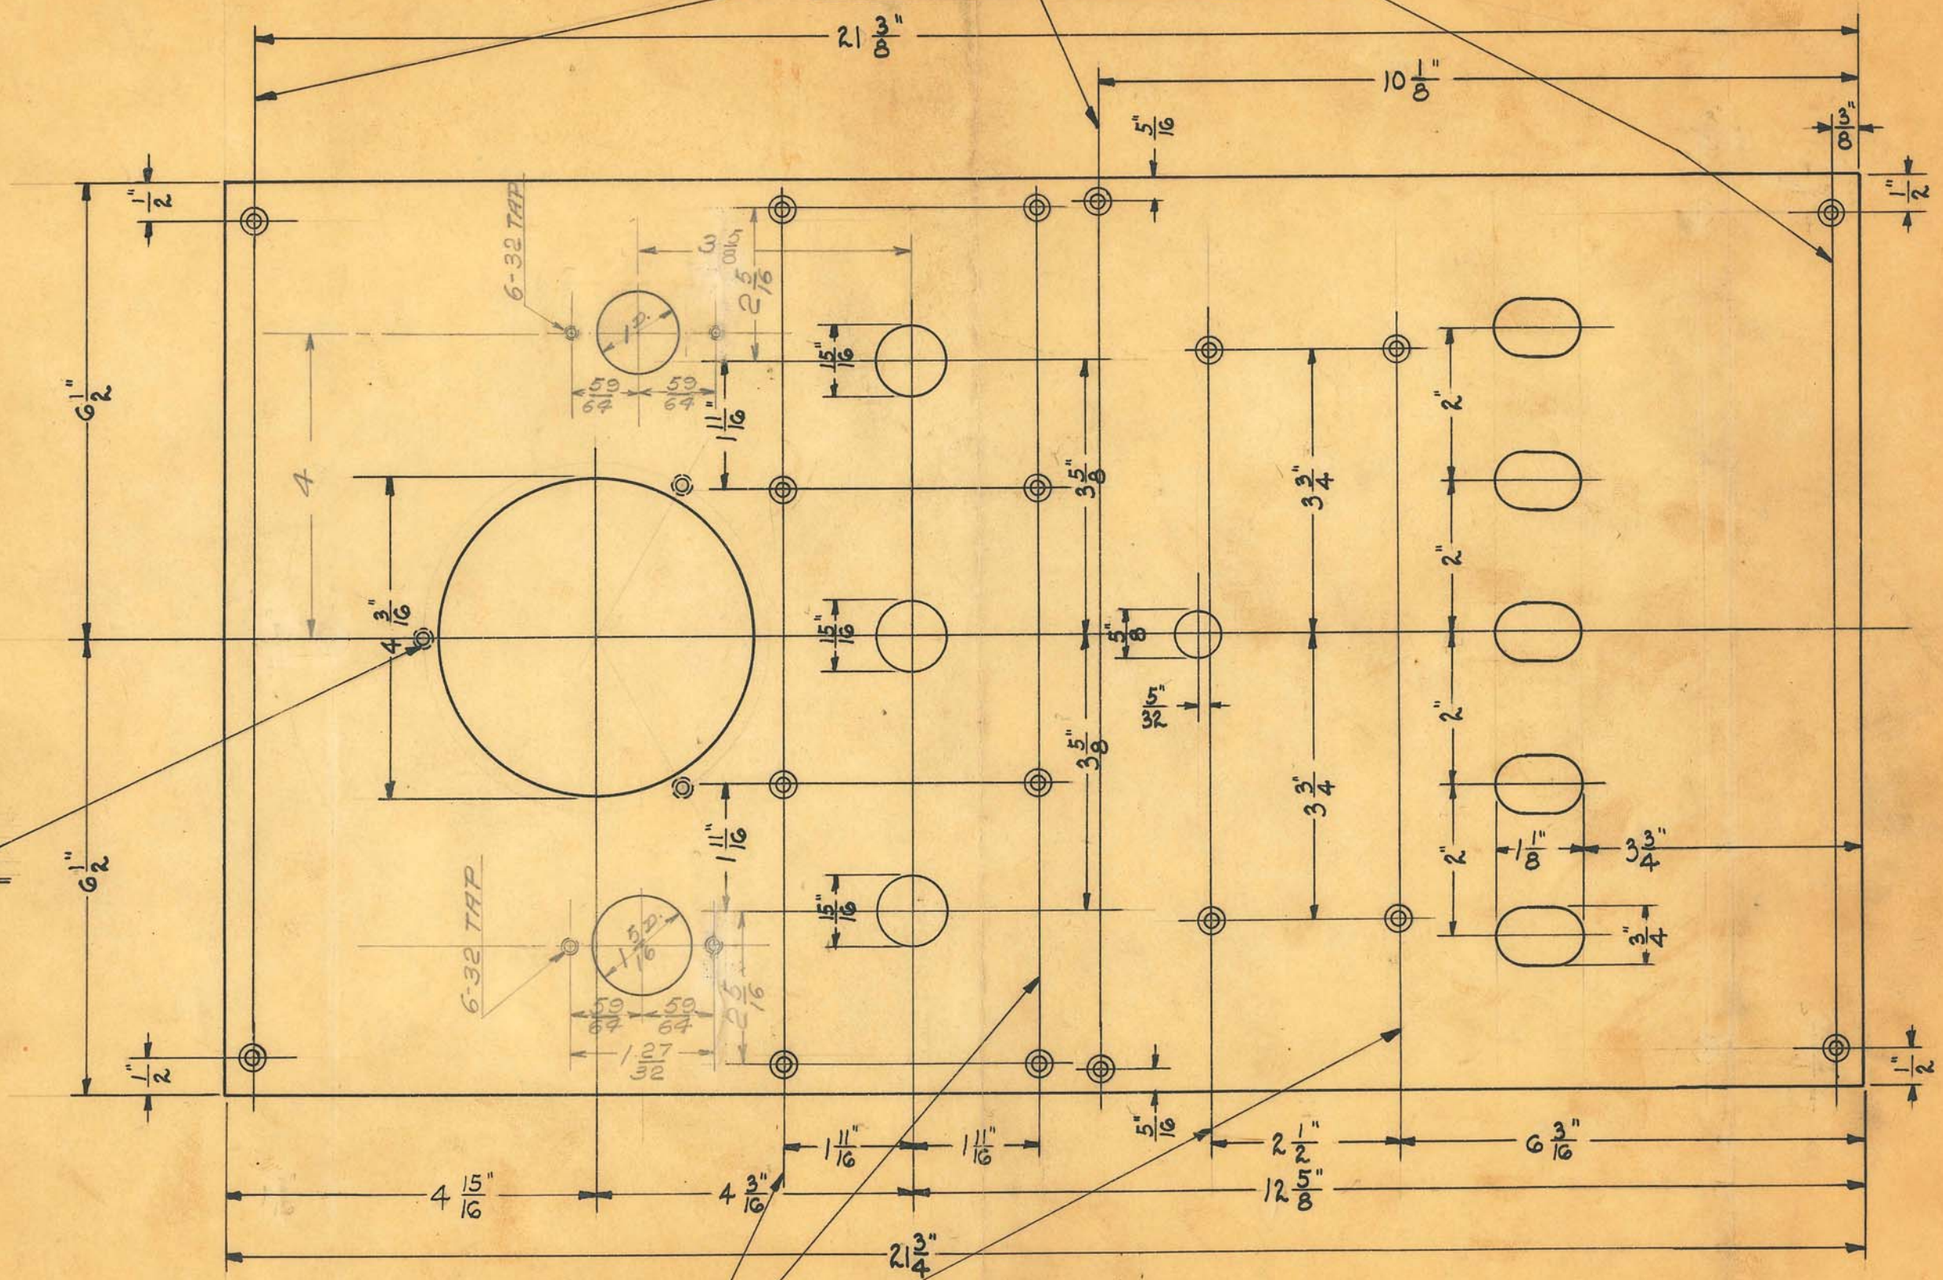

3 HOLES #6 X 32 TAP.
USE METER BEZEL
AS A TEMPLATE.

HOLES ON THESE CENTRE LINES TO BE DRILLED &
COUNTERSUNK FOR #8 X 32 O. H. M. SCREW

SCALE ~ 1/2 SIZE

SIZE		ISSUE H.E.	6-25-30
KIND		CHANGED 10-14-30	H.E.
SHAPE		" " 11-24-30	C. H.
FINISH		" "	
TEMP.		" "	
PATT.		" "	

TITLE: "C D C" PANEL (DRILLED)

OBSOLETE

H. G. FISCHER & CO.
2335 WABANSIA AVE.
CHICAGO, ILL.

CAT. NO.

PART NO. 7005 F

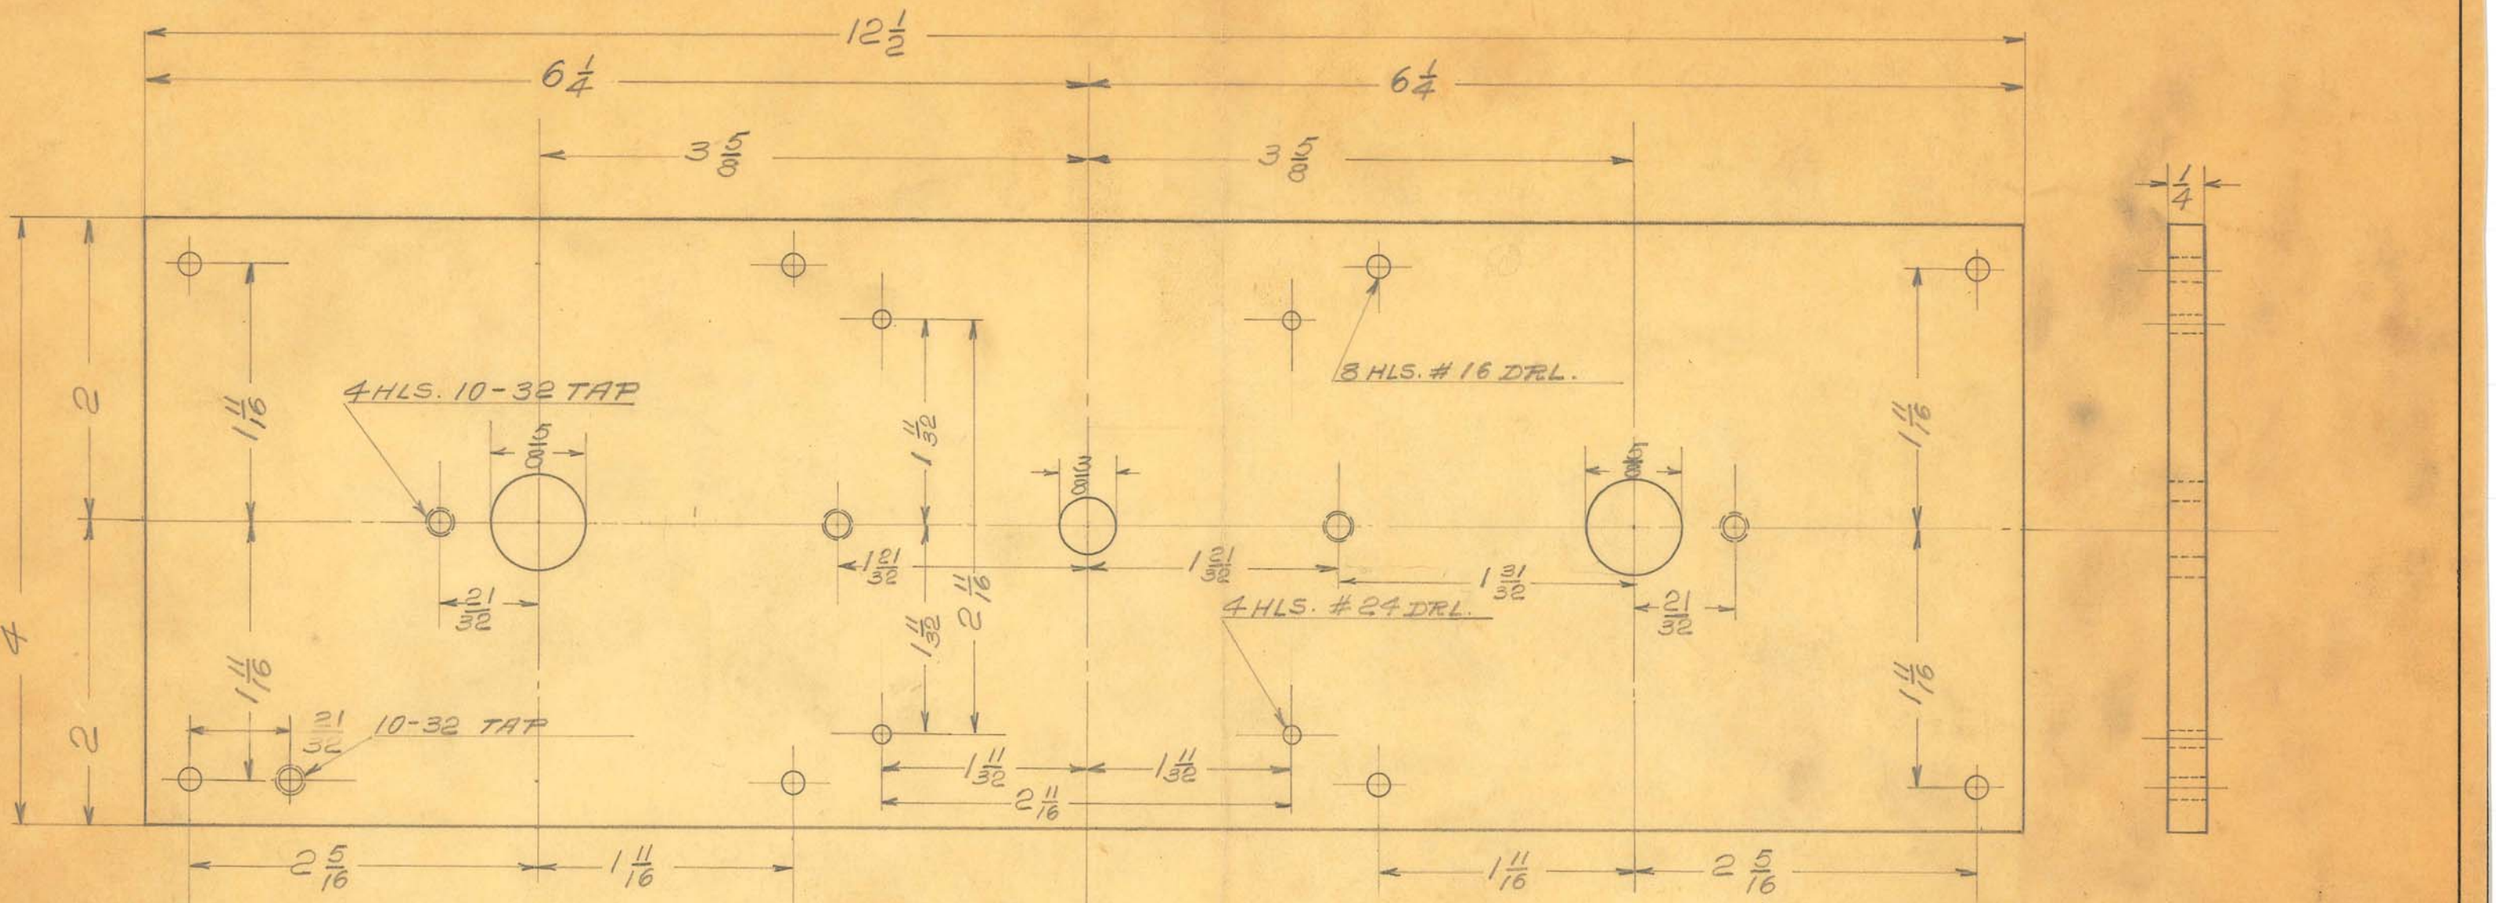

BAKELITE

1 REQ.

SCALE FULL SIZE

OBSOLETE

SIZE		ISSUE 12-3-30	C.M.	TITLE: CDC INTERLOCKING SW. BASE
KIND		CHANGED		
SHAPE		" "		
FINISH		" "		
TEMP.		" "		
PATT.		" "		

H. G. FISCHER & CO.
2335 WABANSIA AVE.
CHICAGO, ILL.

CAT. NO.

PART NO. 7007 F

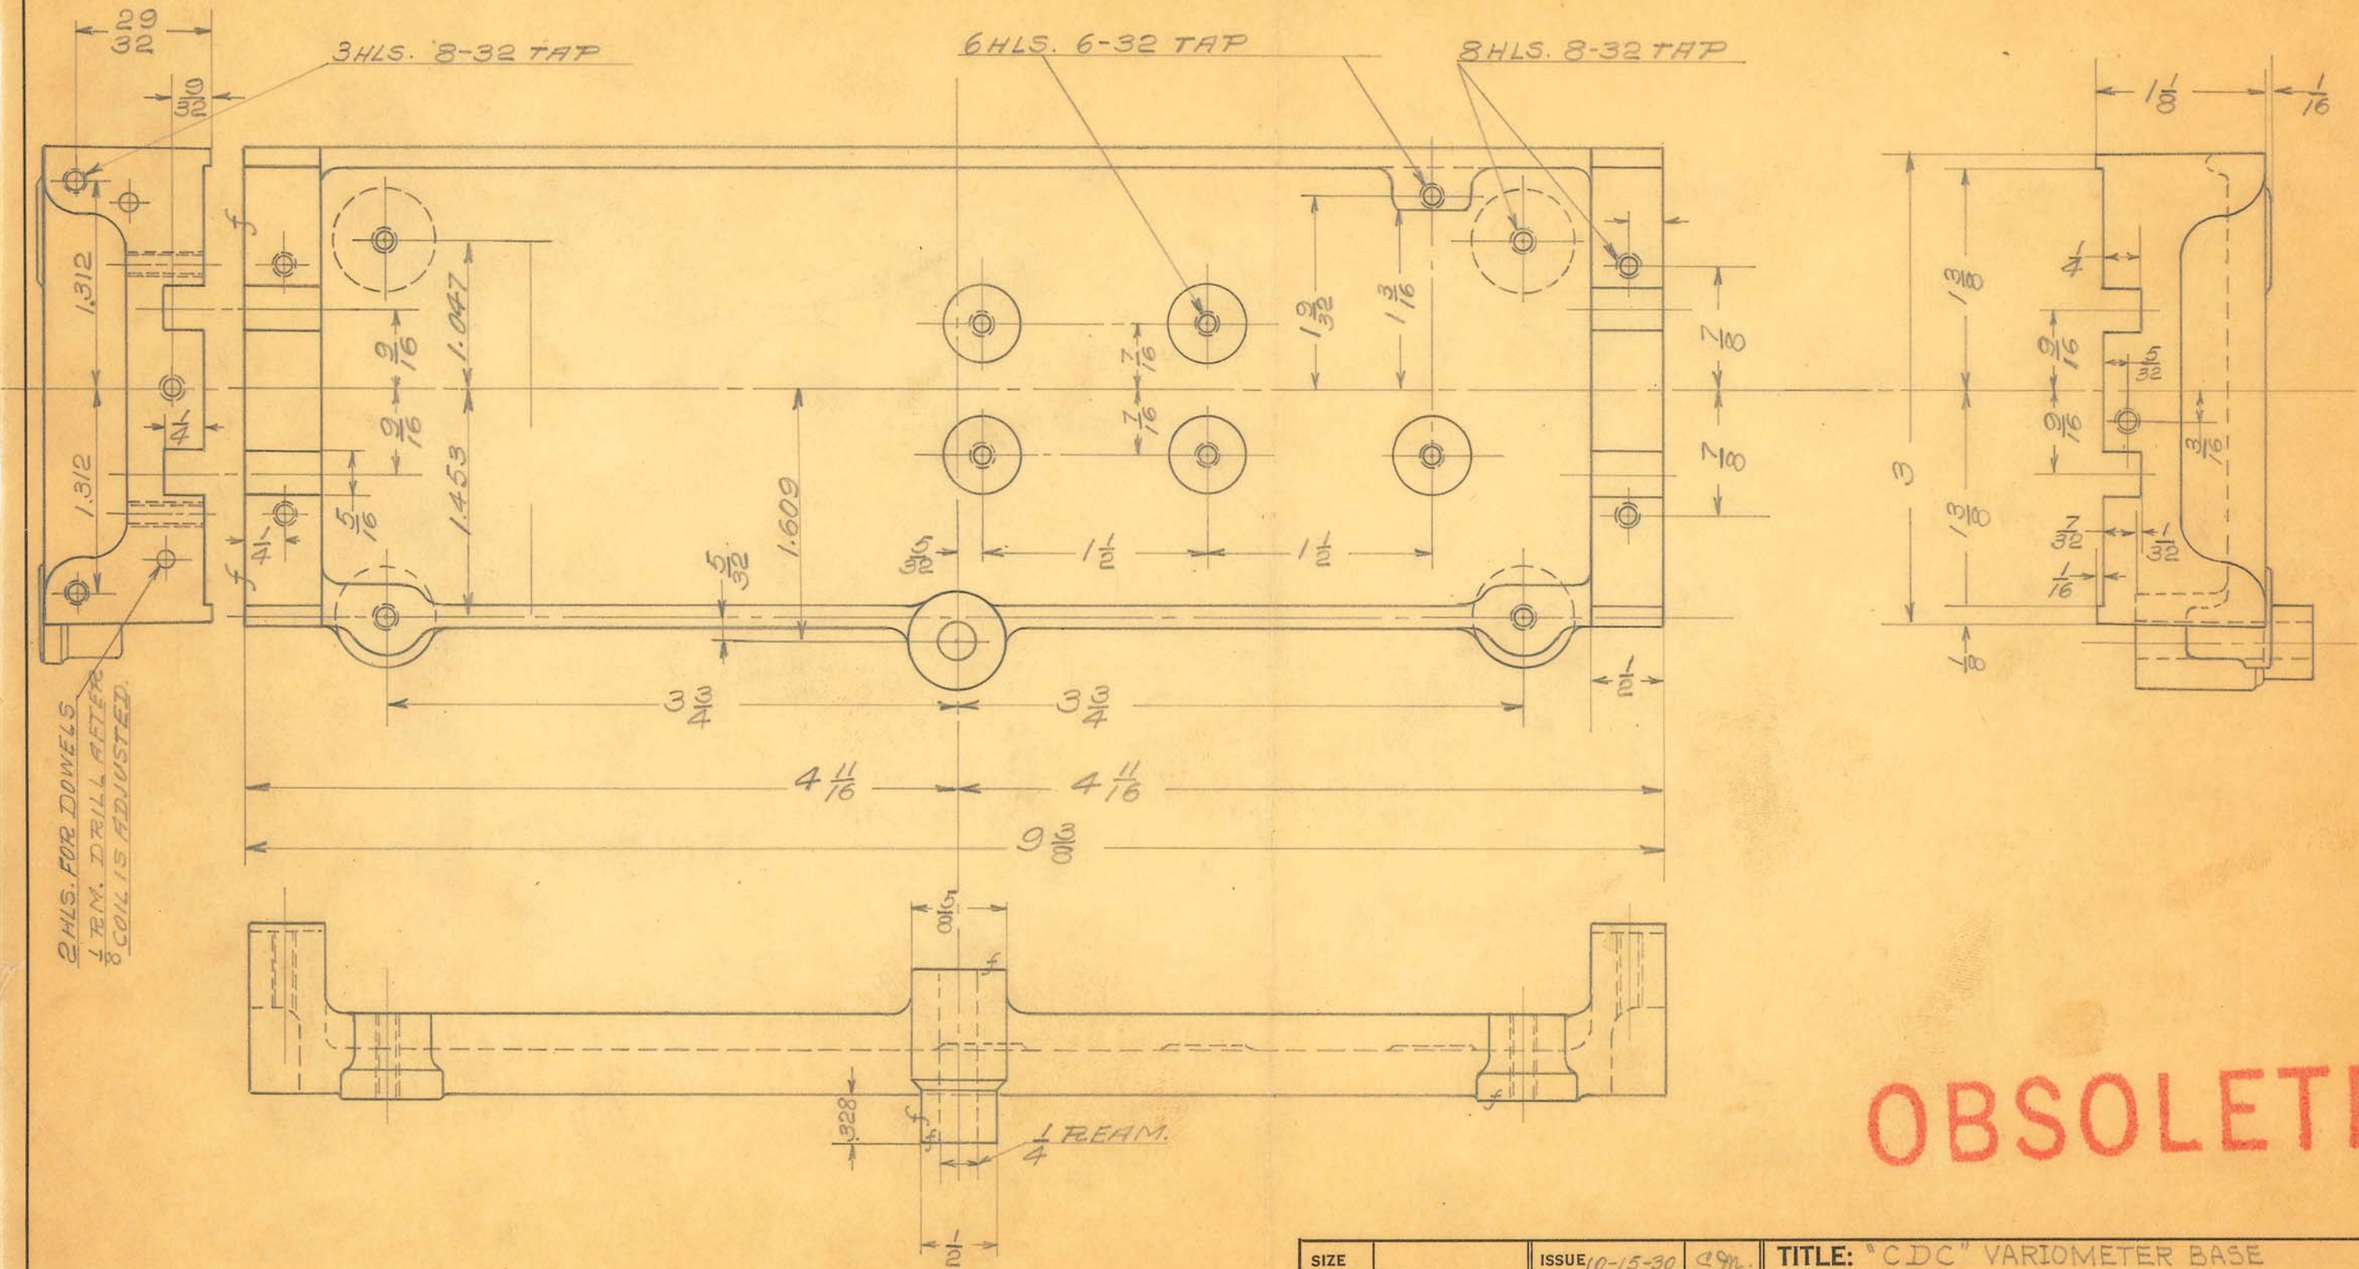

OBSOLETE

SIZE		ISSUE 10-15-30	C.M.	TITLE: "CDC" VARIOMETER BASE
KIND		CHANGED 11-21-30	C.M.	
SHAPE		" " 1-23-31	C.M.	
FINISH		" "		
TEMP.		" "		
PATT.		" "		

H. G. FISCHER & CO.
2335 WABANSIA AVE.
CHICAGO, ILL.

CAT. NO.

PART NO. 7038F

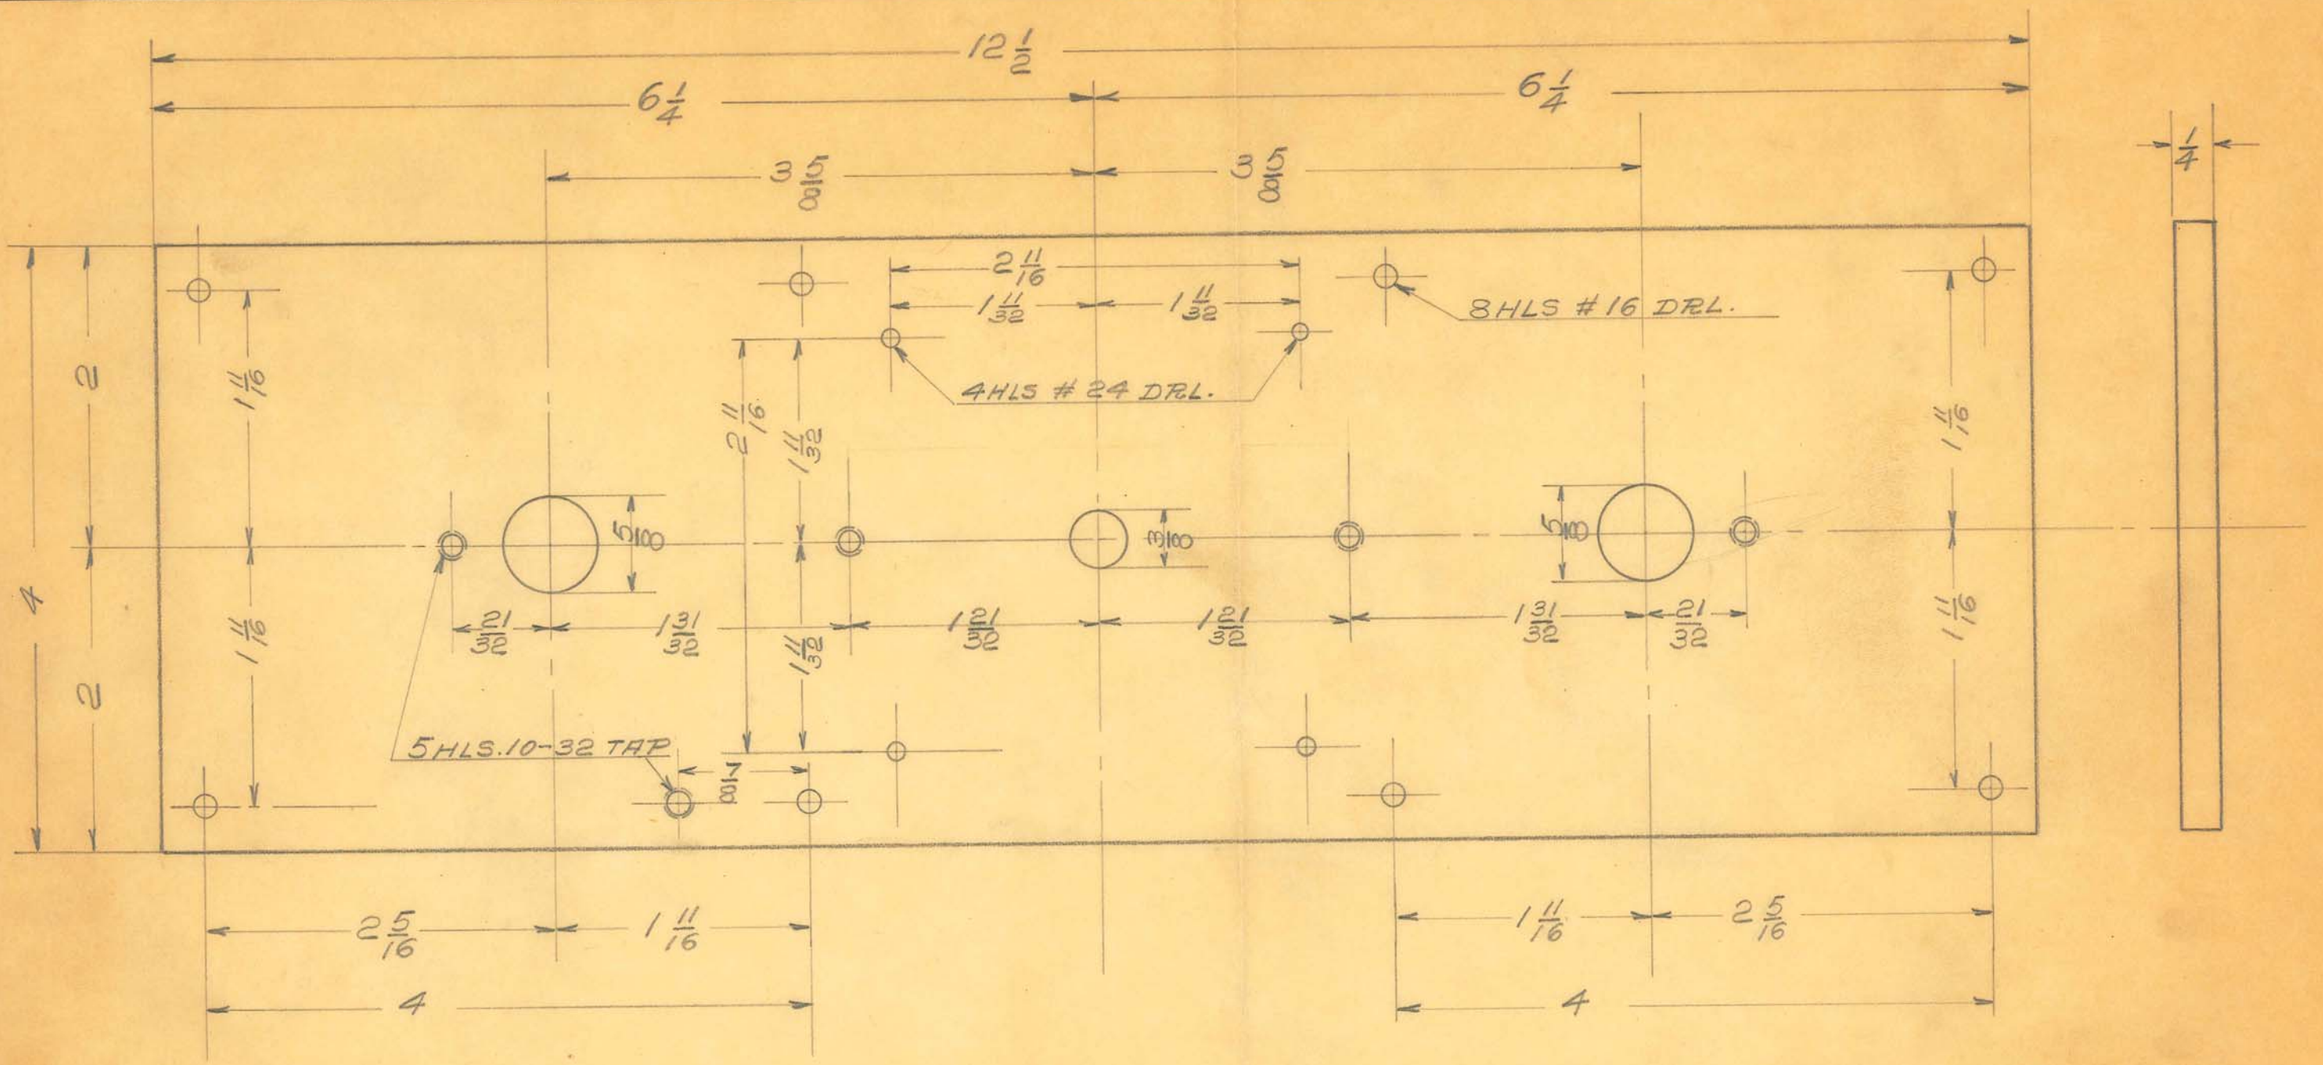

NATURAL BAKELITE

1 REQ.

SCALE FULL SIZE

OBSOLETE

SIZE		ISSUE 3-24-31	C.M.	TITLE: CDC INTERLOCKING SWITCH BASE
KIND		CHANGED		
SHAPE		" "		
FINISH		" "		
TEMP.		" "		H. G. FISCHER & CO. 2335 WABANSIA AVE. CHICAGO, ILL. — CAT. NO. — PART NO. 7007A.F.
PATT.		" "		

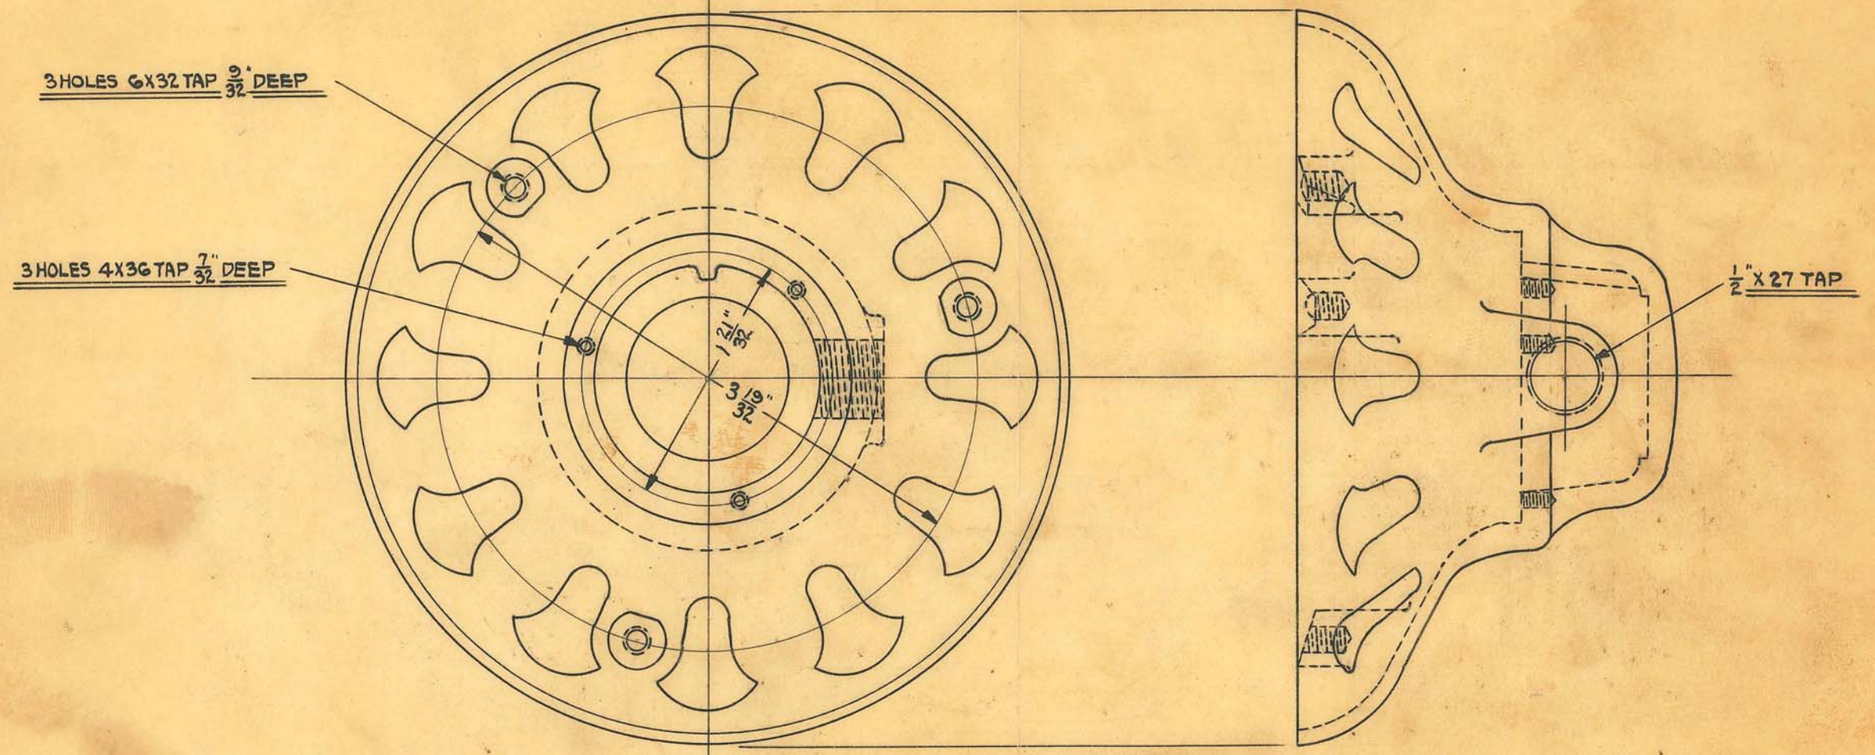

OBSOLETE

SIZE		ISSUE	11-5-29
KIND	ALUM. CASTING	CHANGED	
SHAPE		" "	
FINISH	BUFF	" "	
TEMP.		" "	
PATT.		" "	

TITLE: LAYMAN'S INFRA RED RAY GENERATOR
HOOD VENTILATING CAP

H. G. FISCHER & CO.
2335 WABANSIA AVE.
CHICAGO, ILL.

CAT. NO.

PART NO. 5901F

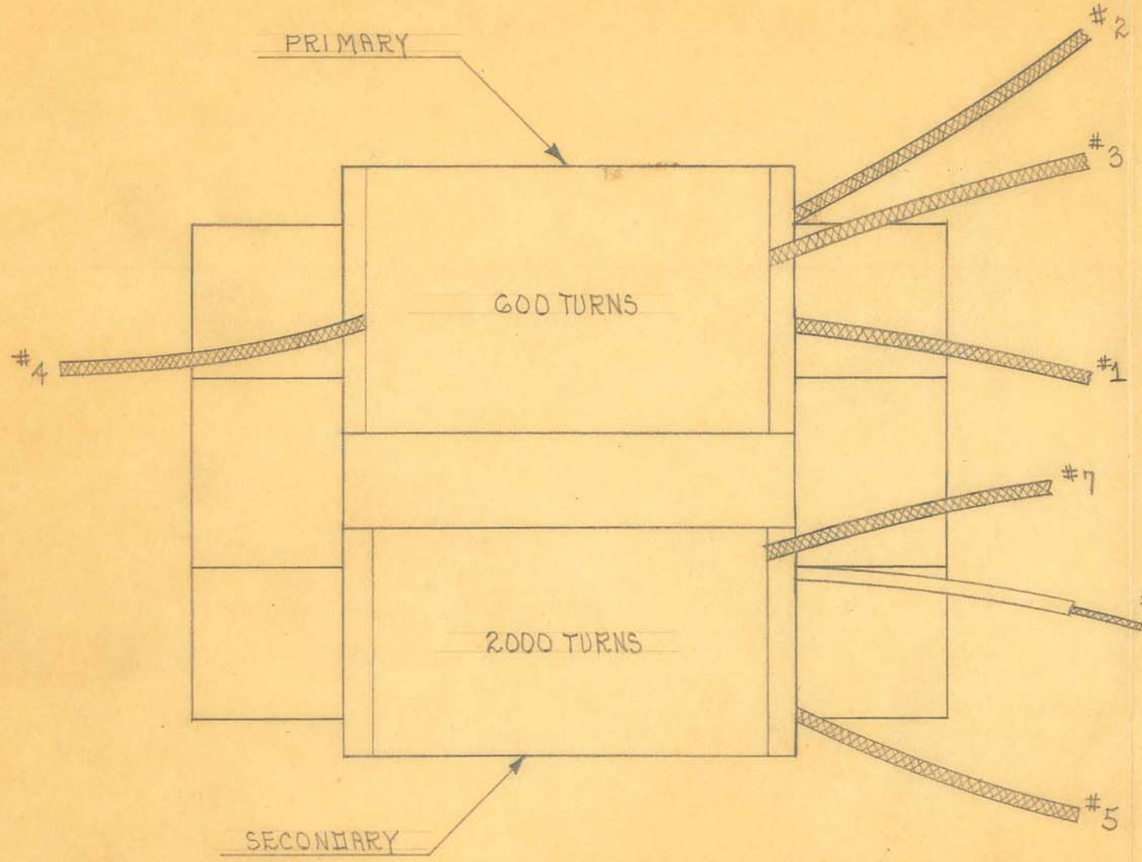

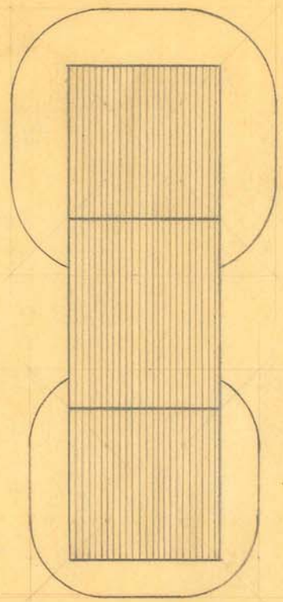

STEEL SIZES

PC. NO. 5043

PRI. & SEC. CORE LAMS. 4"X1" BUILT UP TO 1".
JIG. # 287½
END PIECES CUT 2¼"X 1"
BIND CORES WITH FRICTION TAPE

WINDING DATA

PRIMARY

3 LAYERS OF 5020 FIBROID PAPER ON CORE. USE #26 C.E. WIRE. ANCHOR LEAD #1 WITH LINEN TAPE AND WIND 6 LAYERS OF 100 TURNS EACH. 1 LAYER OF 5020 FIBROID BETWEEN EACH LAYER OF WIRE. ANCHOR END WITH LINEN TAPE - LEAD #2. TOTAL 600 TURNS. 5 LAYERS OF 5020 FIBROID PAPER. ANCHOR LEAD #3 WITH LINEN TAPE AND WIND 33 TURNS WITH #20 COTENAMEL WIRE. ANCHOR END WITH LINEN TAPE - LEAD #4. COVER WITH 5004 OILED TAPE AND SHELLAC. LEADS ARE EACH 12" OF 1603 - #18 STRANDED WIRE.

SECONDARY

3 LAYERS OF 5020 FIBROID PAPER ON CORE. USE #33 ENAMEL WIRE. ANCHOR LEAD #5 WITH LINEN TAPE. WIND 1000 TURNS AND TAP - LEAD #6. ANCHOR LEAD #6 WITH LINEN TAPE. WIND 1000 MORE TURNS AND ANCHOR END WITH LINEN TAPE - LEAD #7. 1 LAYER OF 5020 FIBROID BETWEEN EACH LAYER OF WIRE. COVER LAST LAYER OF WIRE WITH 5004 OILED CLOTH AND SHELLAC. LEADS #5 & #7 ARE EACH 12" OF 1600 WEATHER-PROOF WIRE. LEAD #6 IS 12" OF 1631 CHARADE COVERED WITH 5032 TUBING.

OBSOLETE

SIZE		ISSUE 3-7-32	H.E.
KIND		CHANGED	
SHAPE		" "	
FINISH		" "	
TEMP.		" "	
PATT.		" "	

TITLE: FISCHER IMPROVED GALV. CUR. GEN. TRANSFORMER

H. G. FISCHER & CO.
2335 WABANSIA AVE.
CHICAGO, ILL.

CAT. NO.

PART NO. 6703G

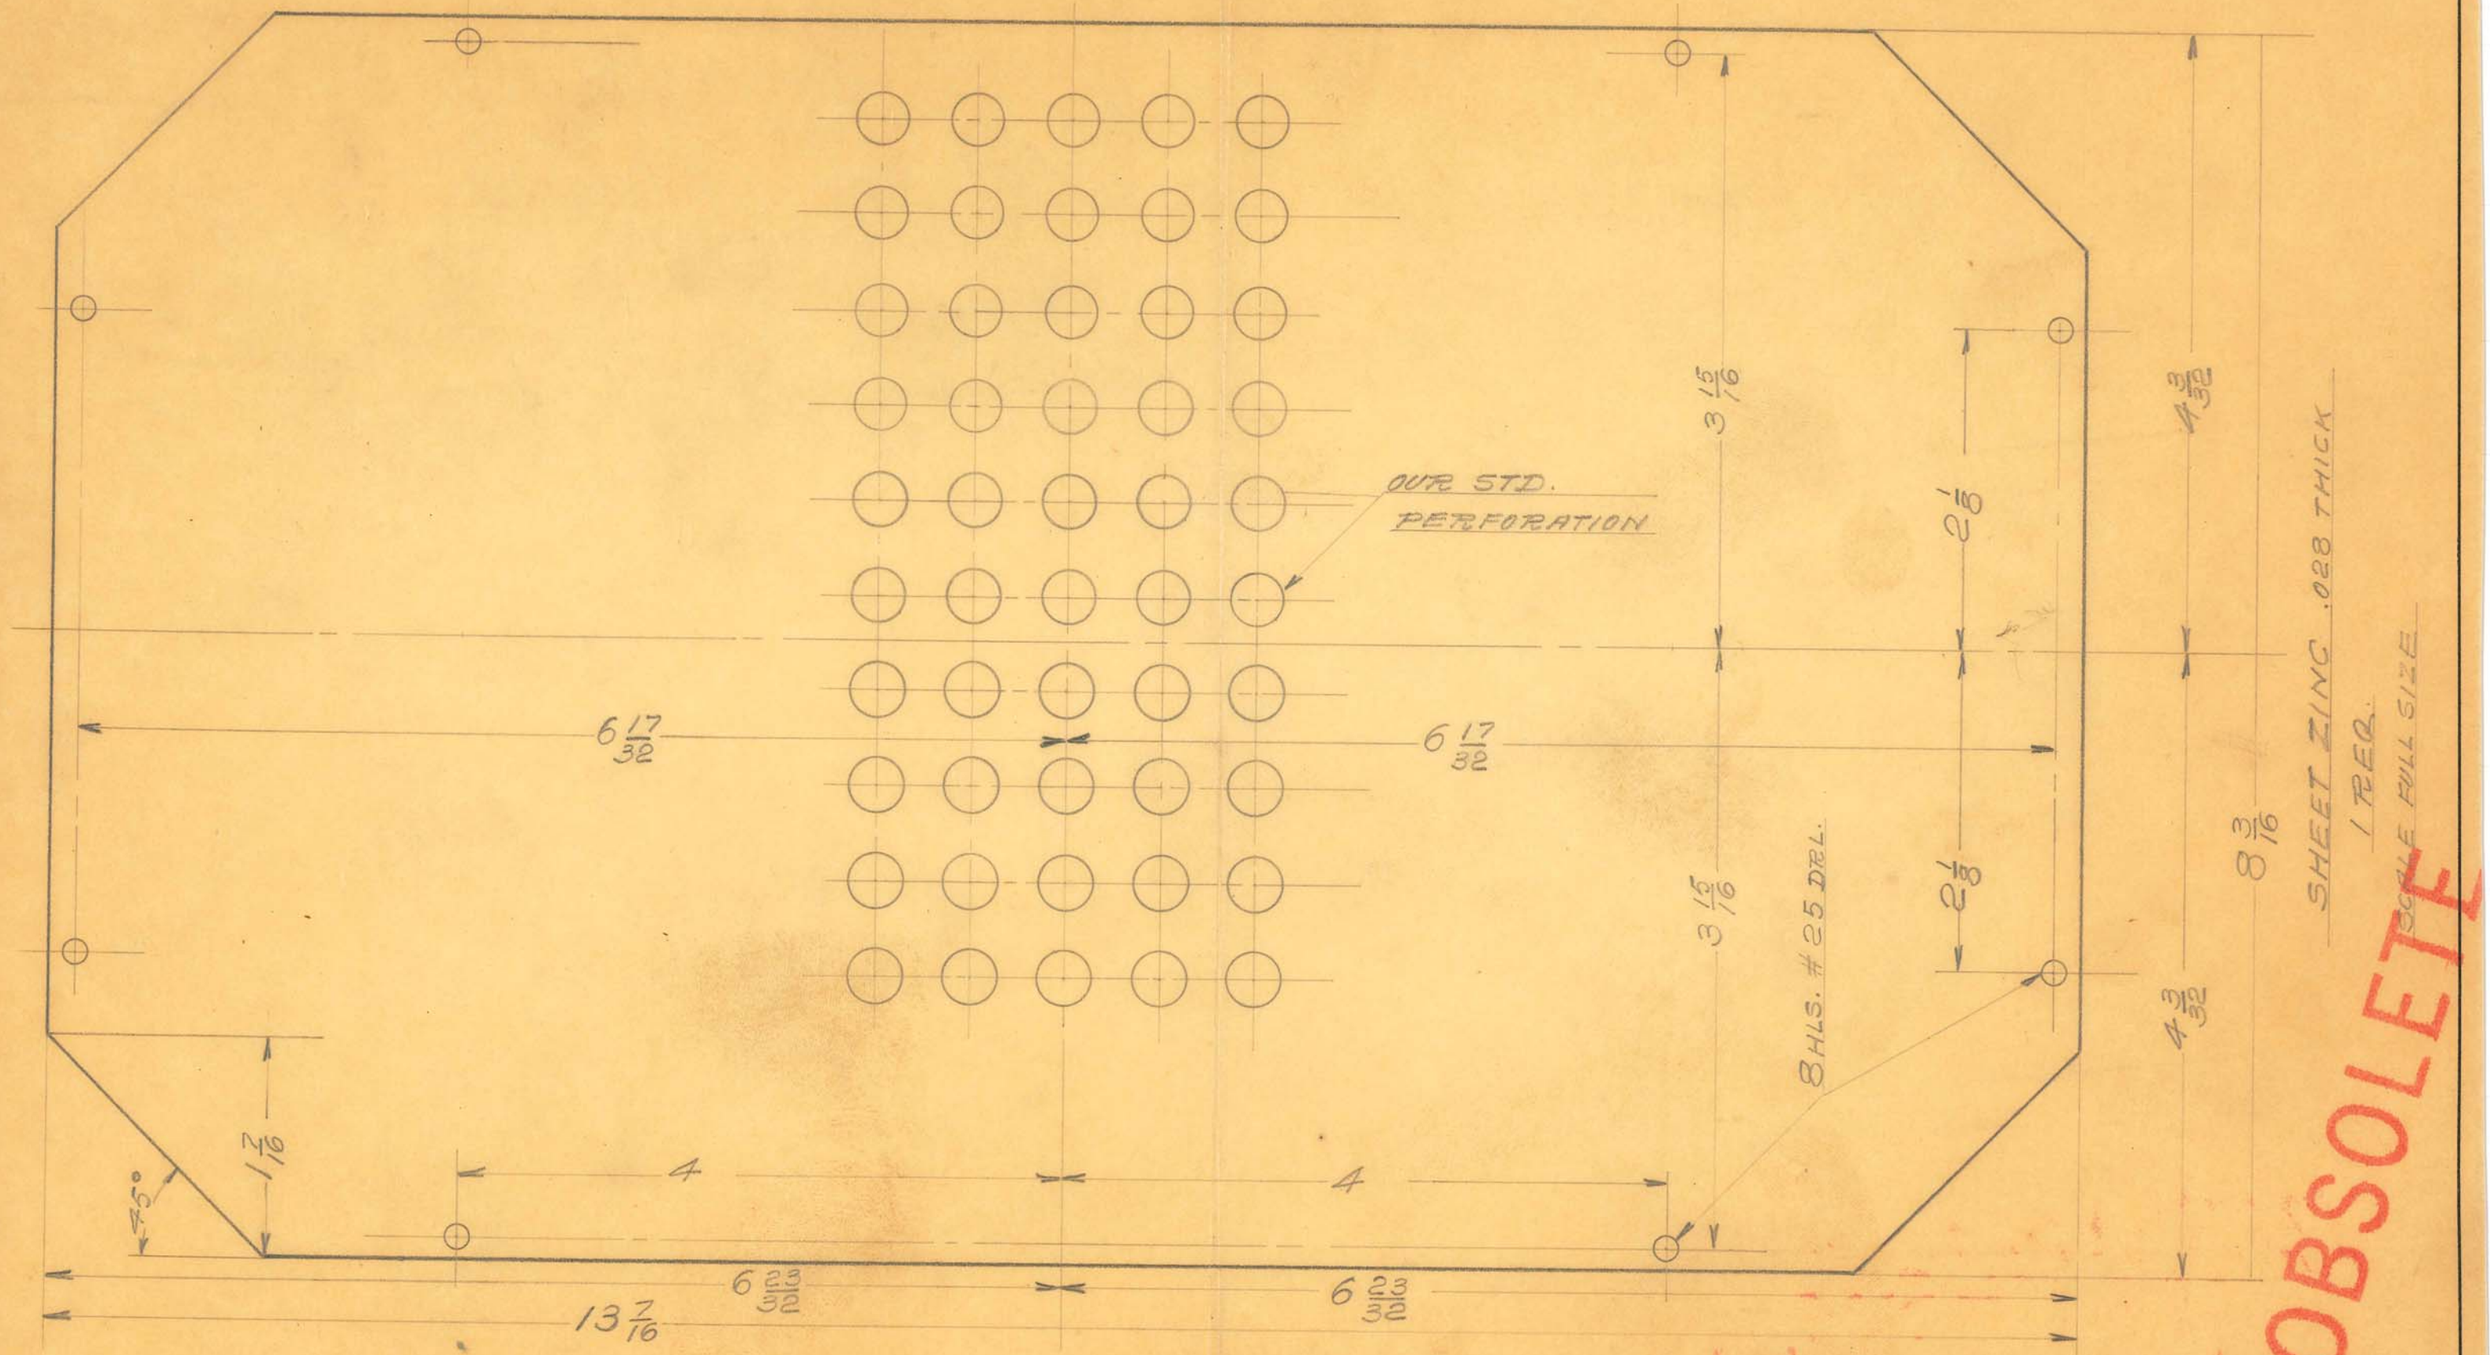

OBSOLETE

SIZE		ISSUE 5-27-31	C.M.
KIND		CHANGED	
SHAPE		" "	
FINISH	BLACK #80	" "	
TEMP.		" "	

TITLE: GALVANIC GENERATOR BOTTOM PLATE

H. G. FISCHER & CO.
2335 WABANSIA AVE.

CAT. NO.

PART NO. 6702

SHEET 2 OF 2 SHEETS
1 REQ.
SCALE FULL SIZE

.028 THICK ZINC

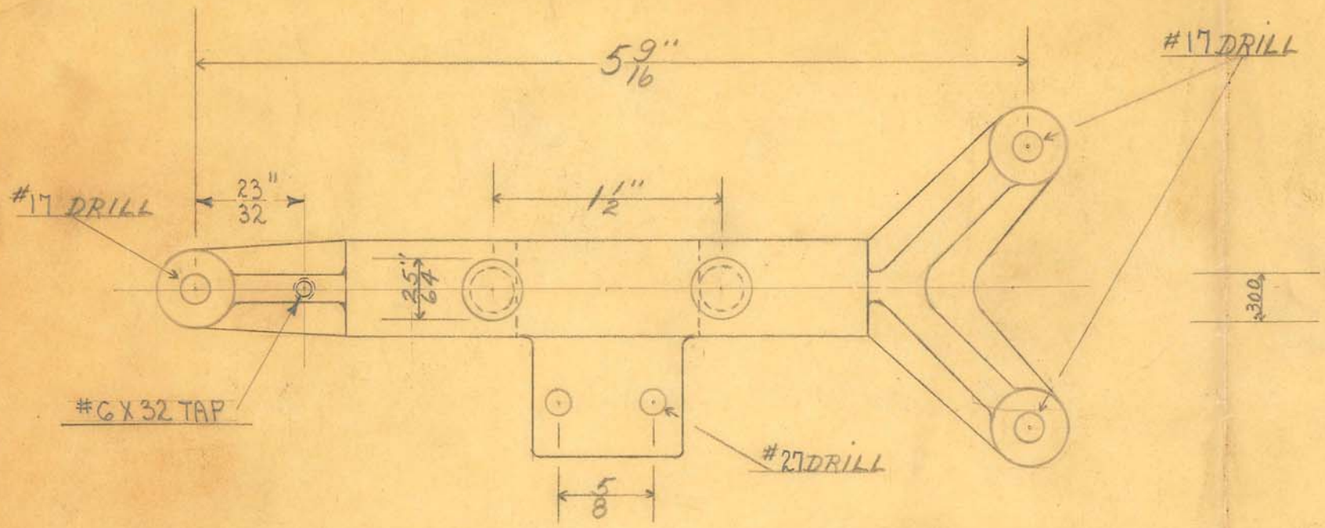

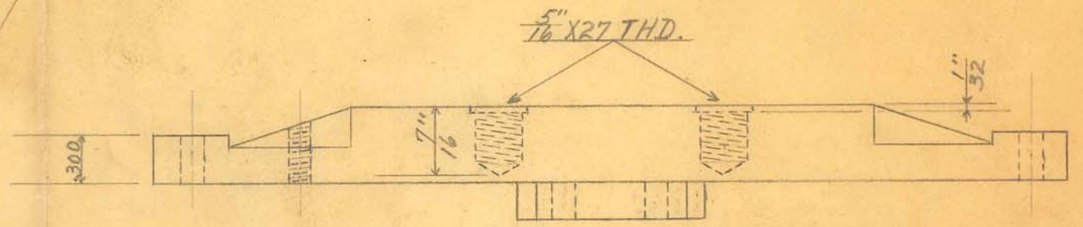

OBSOLETE

SIZE		ISSUE	4-5-28	TITLE: WAVE-GEN. COMM. BASE	
KIND	CAST-IRON	CHANGED			
SHAPE		" "			
FINISH	BLK.-JAPAN	" "			
TEMP.		" "			
PATT.		" "			

H. G. FISCHER & CO.
2335 WABANSIA AVE.
CHICAGO, ILL.

CAT. NO.

PART NO. 5499F

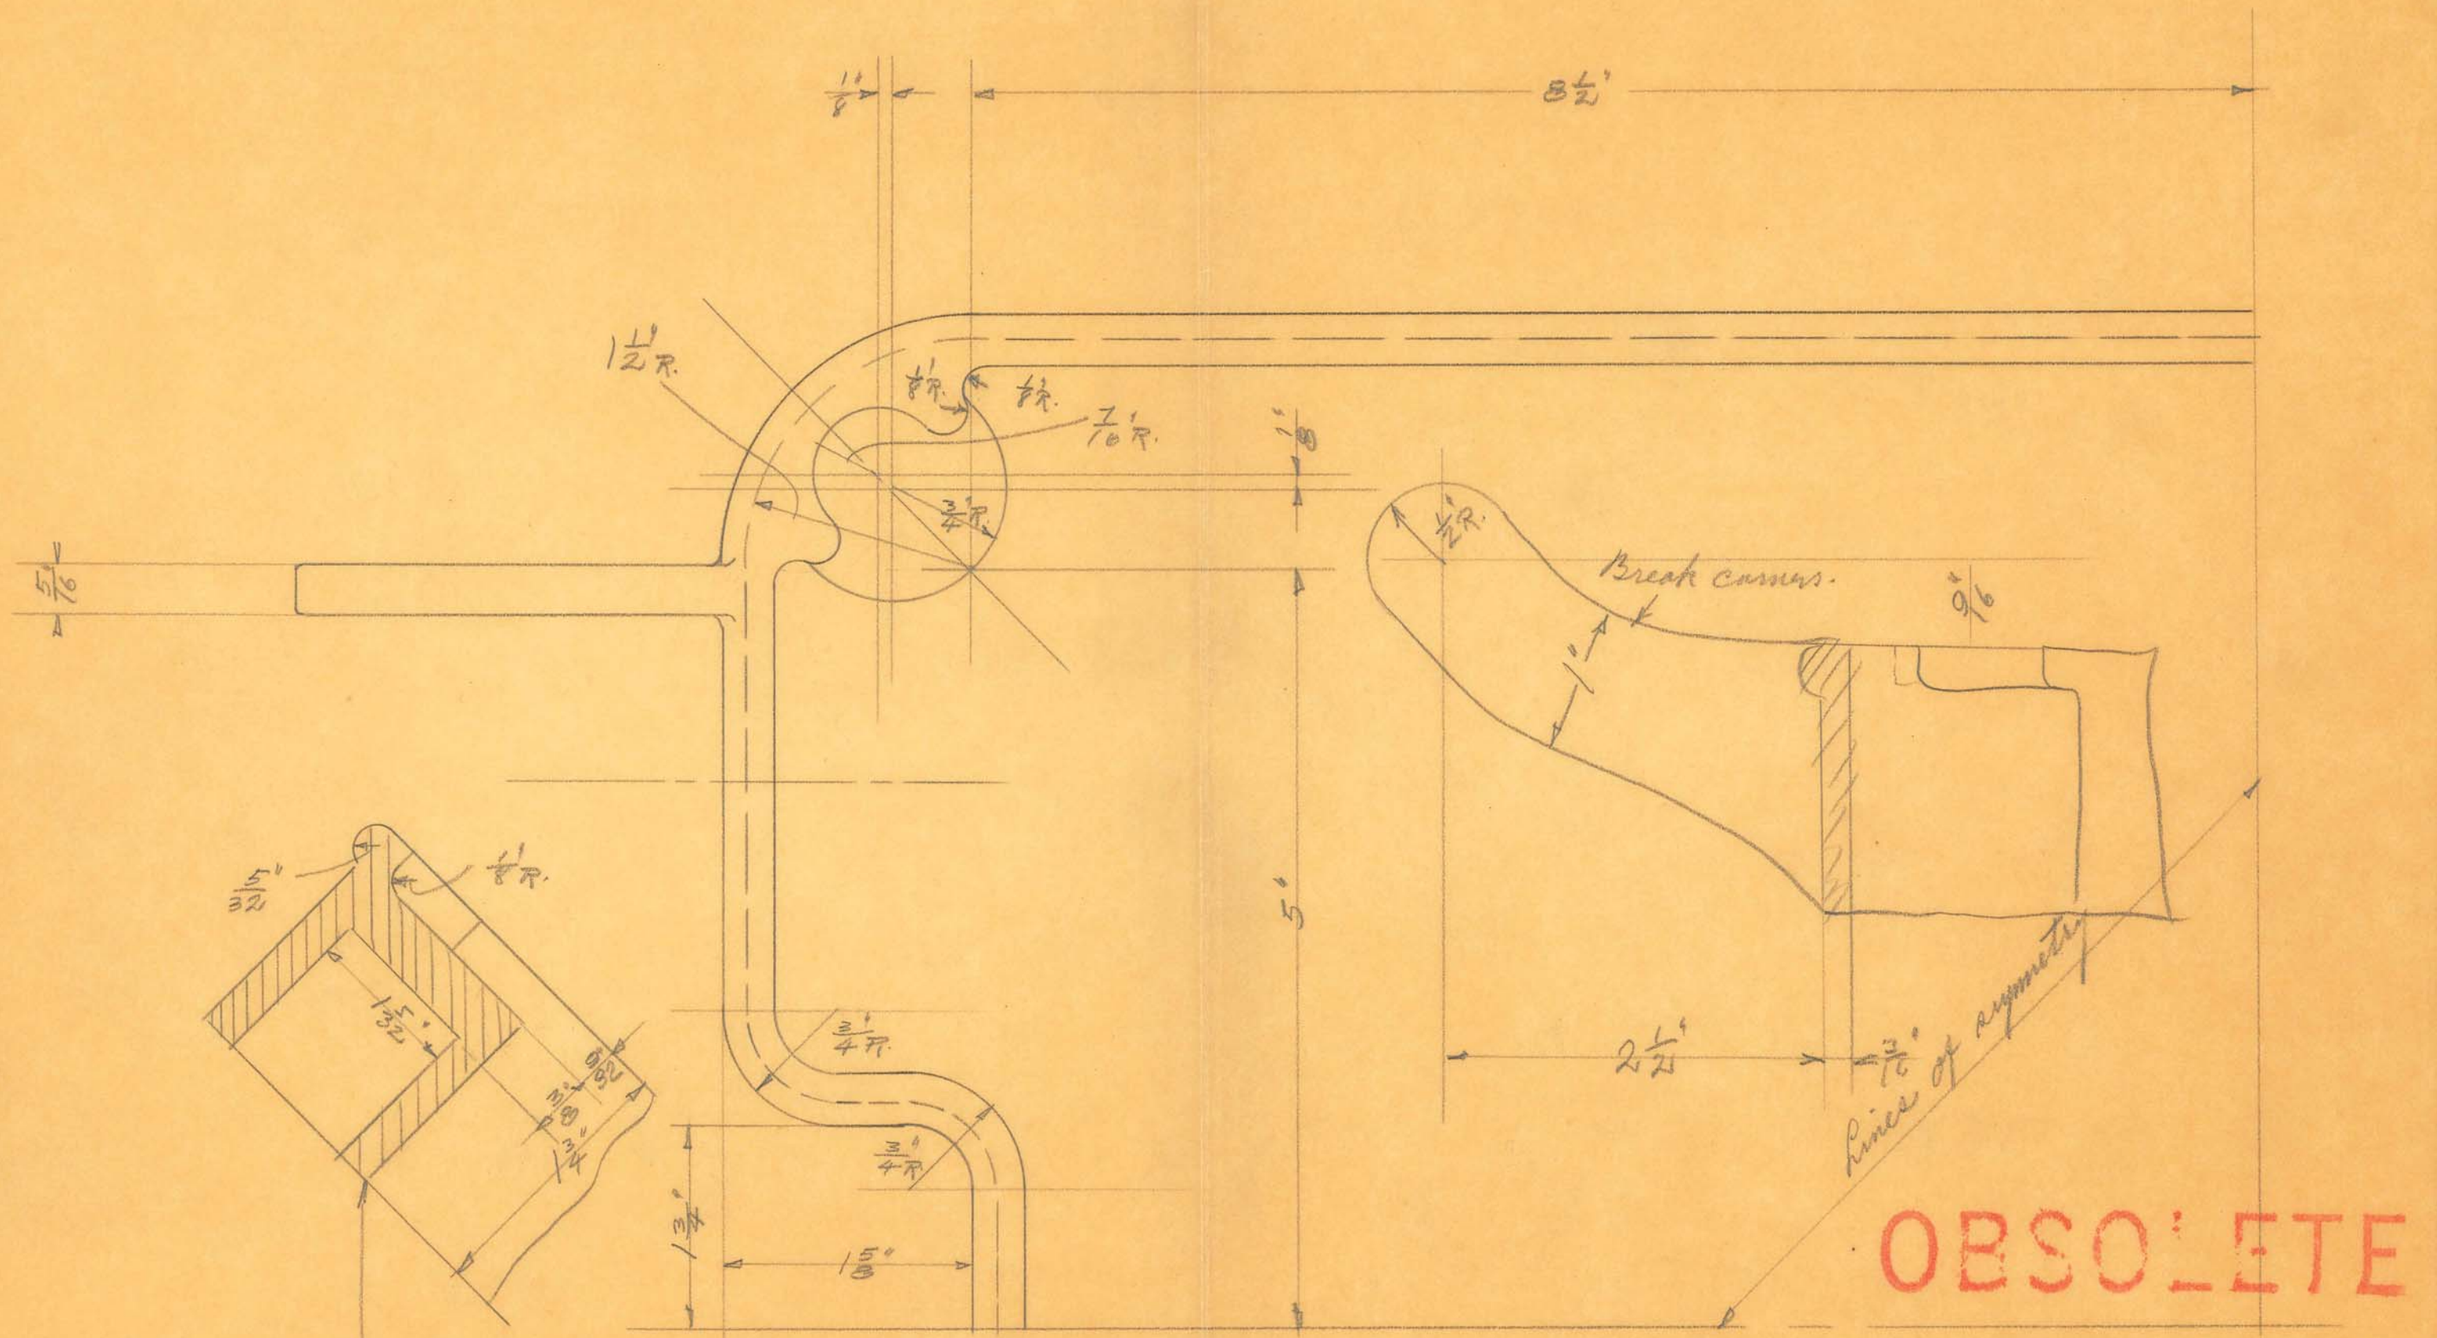

OBSOLETE

SIZE		ISSUE	
KIND		CHANGED	
SHAPE		" "	
FINISH		" "	
TEMP.		" "	
PATT.		" "	

TITLE: Wave-Generator Retainer

H. G. FISCHER & CO.
2335 WABANSIA AVE.
CHICAGO, ILL.

CAT. NO.

~~PART~~ NO. 197

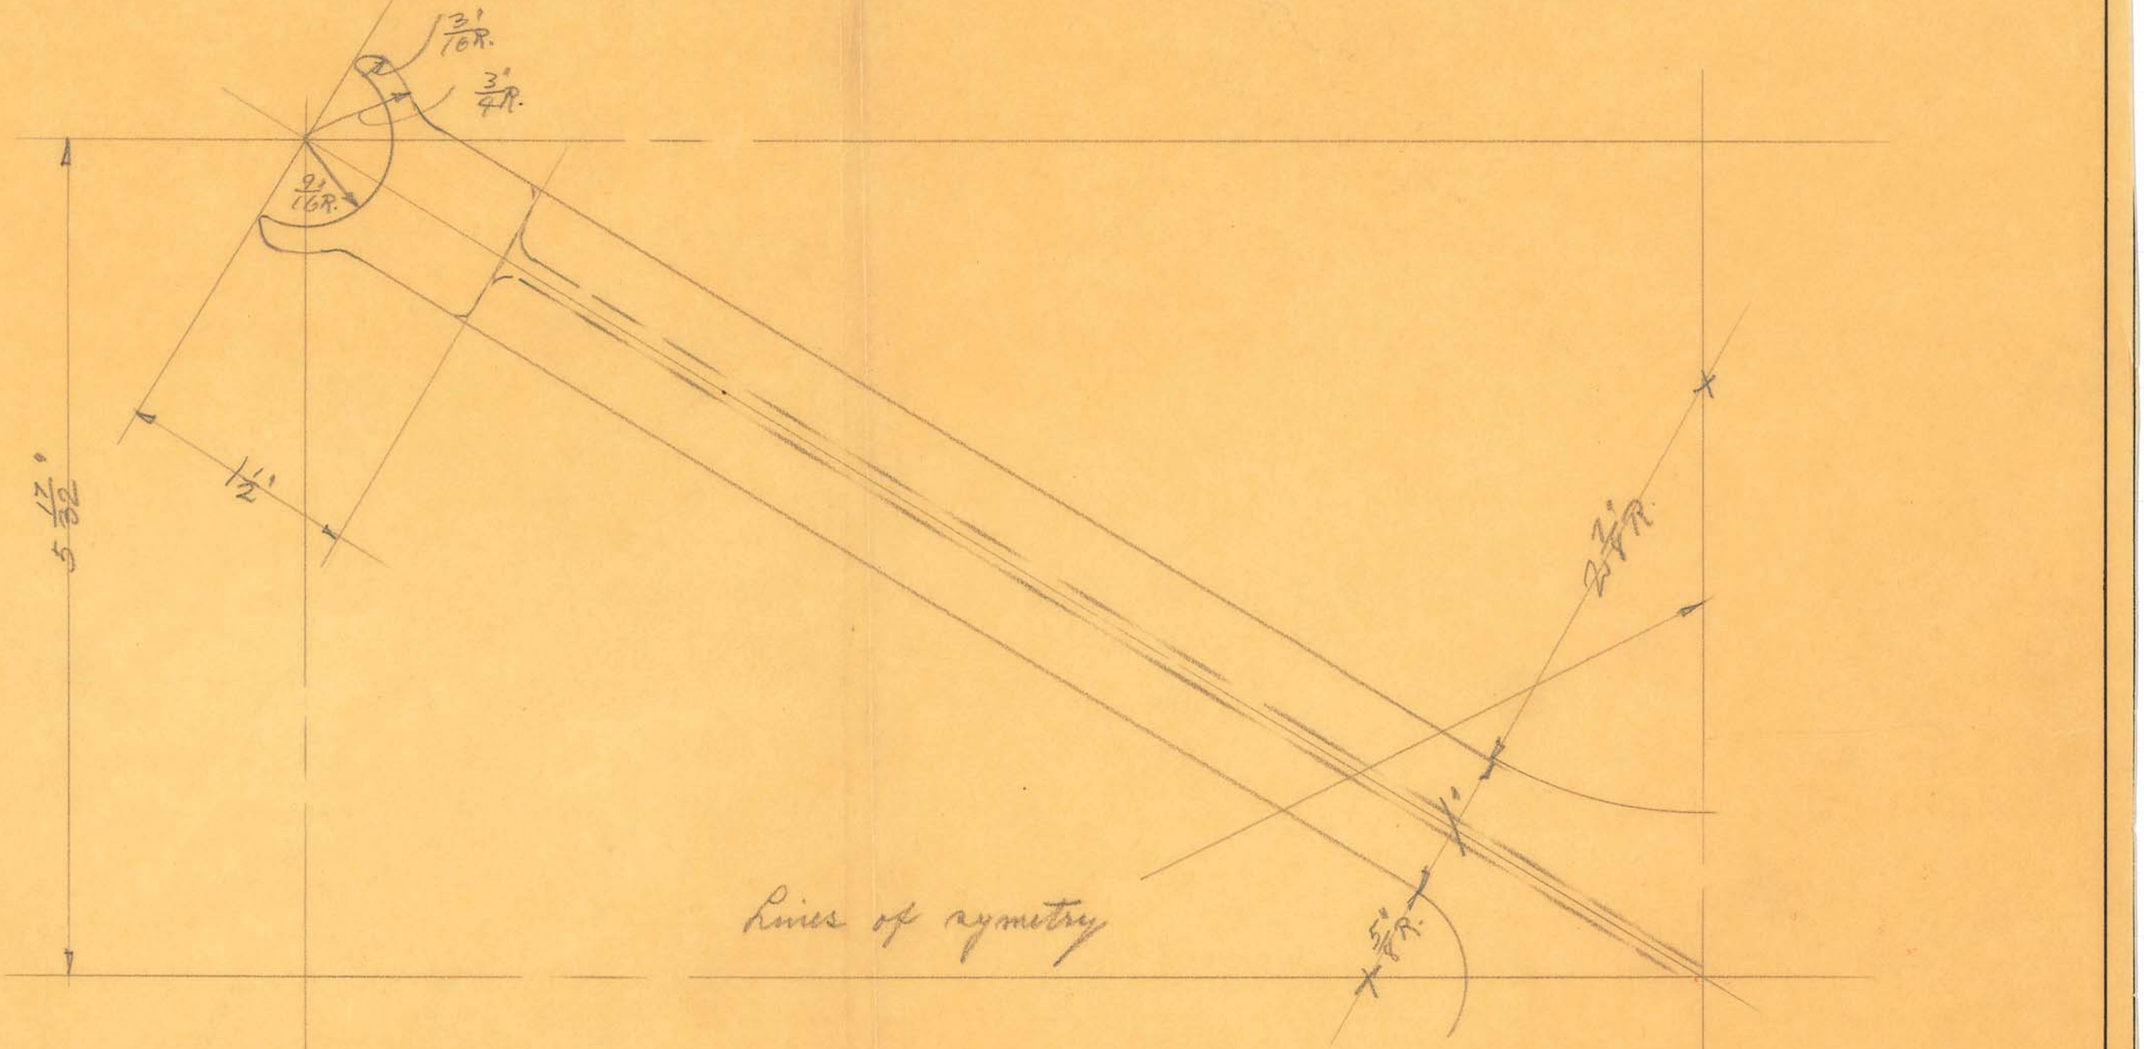

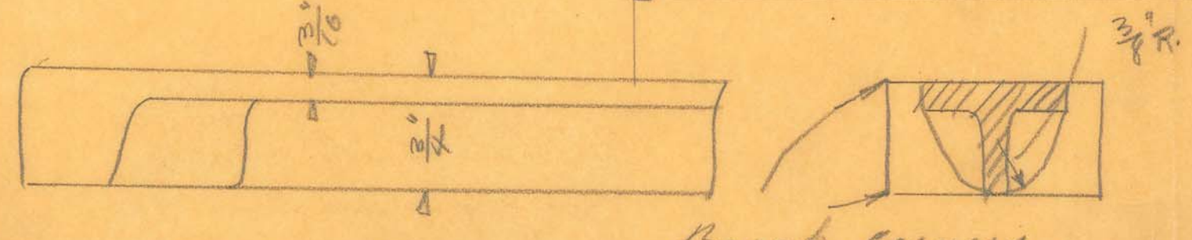

Break corners.

OBSOLETE

SIZE		ISSUE	
KIND		CHANGED	
SHAPE		" "	
FINISH		" "	
TEMP.		" "	
PATT.		" "	

TITLE: Ware - generator stand

H. G. FISCHER & CO.
2335 WABANSIA AVE.
CHICAGO, ILL.

CAT. NO.

~~PART~~ NO. 796.

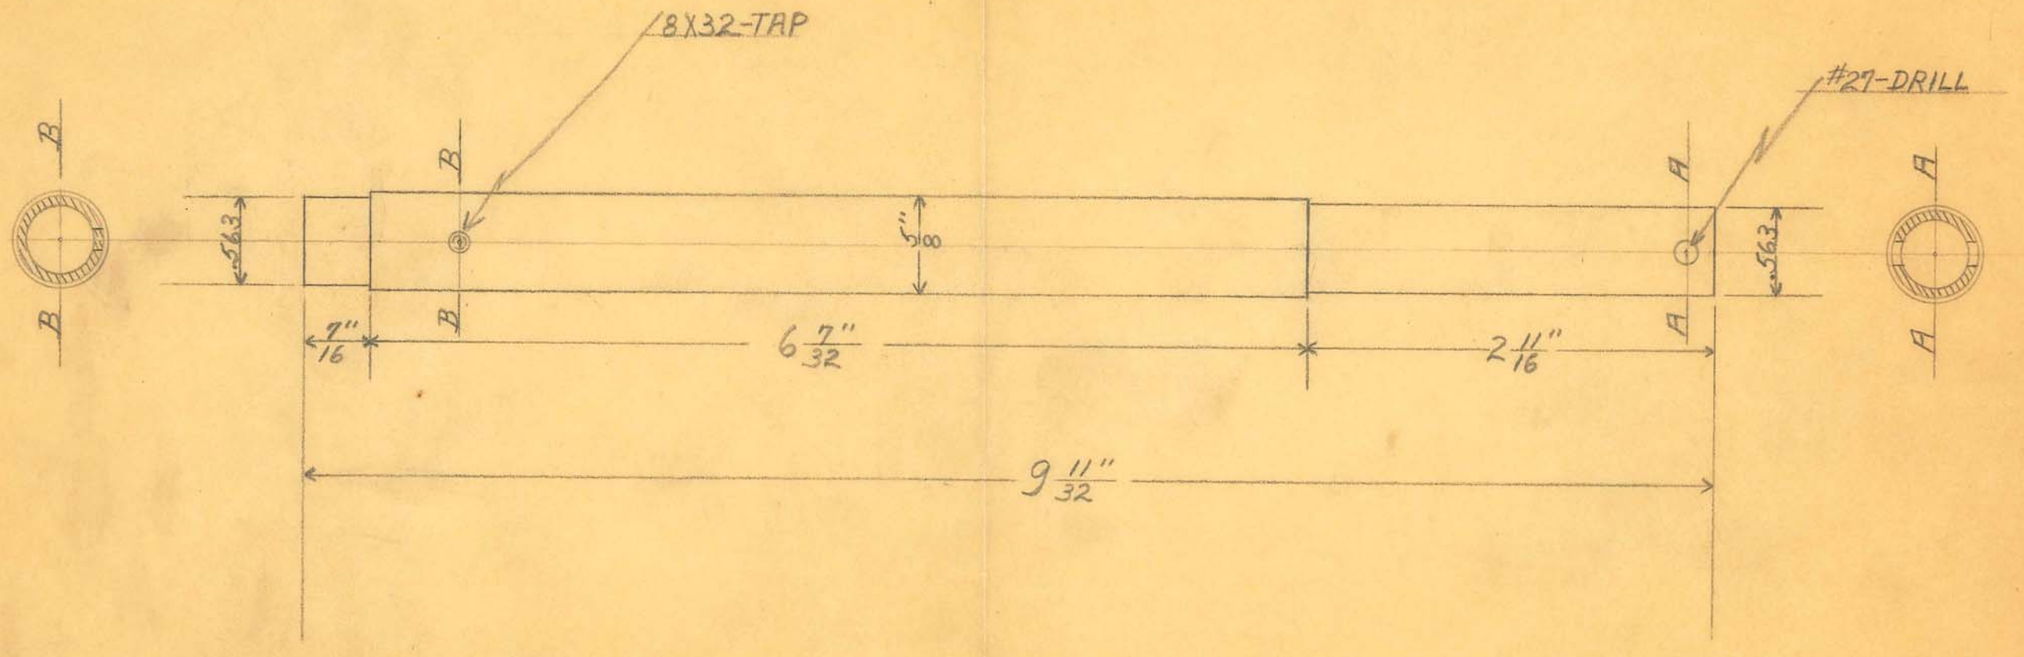

OBSOLETE

SIZE	5/8	ISSUE	
KIND	STEEL-TUBING	CHANGED	
SHAPE		" "	
FINISH		" "	
TEMP.		" "	
PATT.		" "	

TITLE: WAVE-GEN.-AUTOMATIC-RHEOSTAT SHAFT

H. G. FISCHER & CO.
2335 WABANSIA AVE.
CHICAGO, ILL.

CAT. NO.

PART NO. 5409 AB

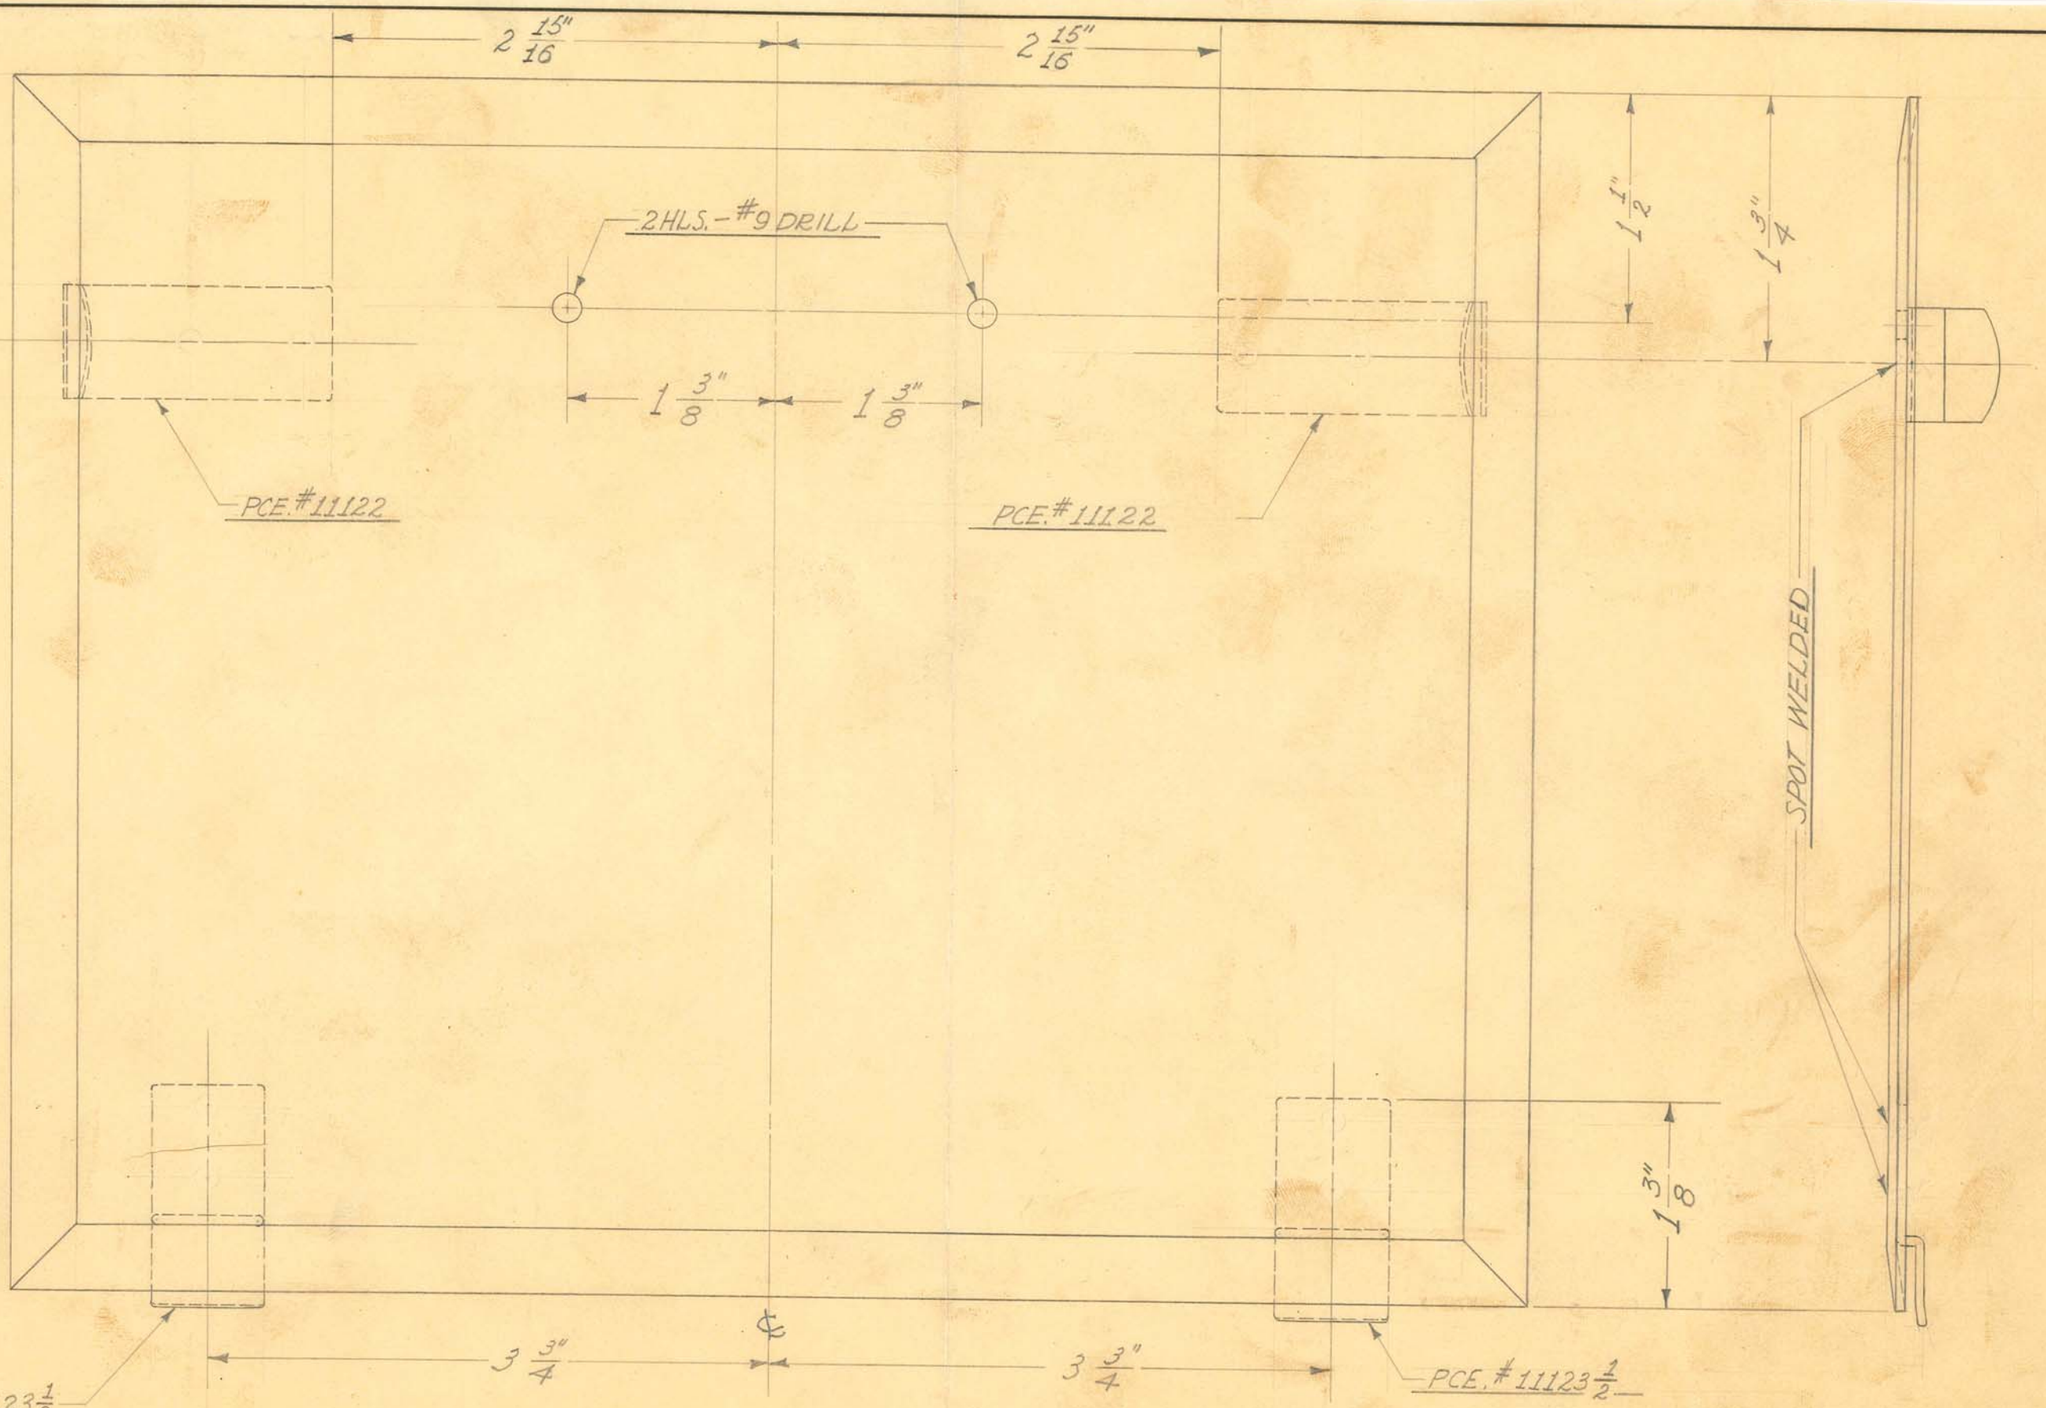

1 REQUIRED

SIZE		ISSUE 8-22-38	J.W.	
KIND		CHANGED		
SHAPE		"		
FINISH		"		
TEMP.		"		
PATT.		"		

TITLE:
FISCHER MOD. "J" GALV. & CONT. CURR. GEN. CABINET - REMOVABLE FRONT ASSEM.

H. G. FISCHER & CO.
2335 WABANSIA AVE.
CHICAGO, ILL.

CAT. NO.

PART NO. PART OF 11195GF

OBSOLETE

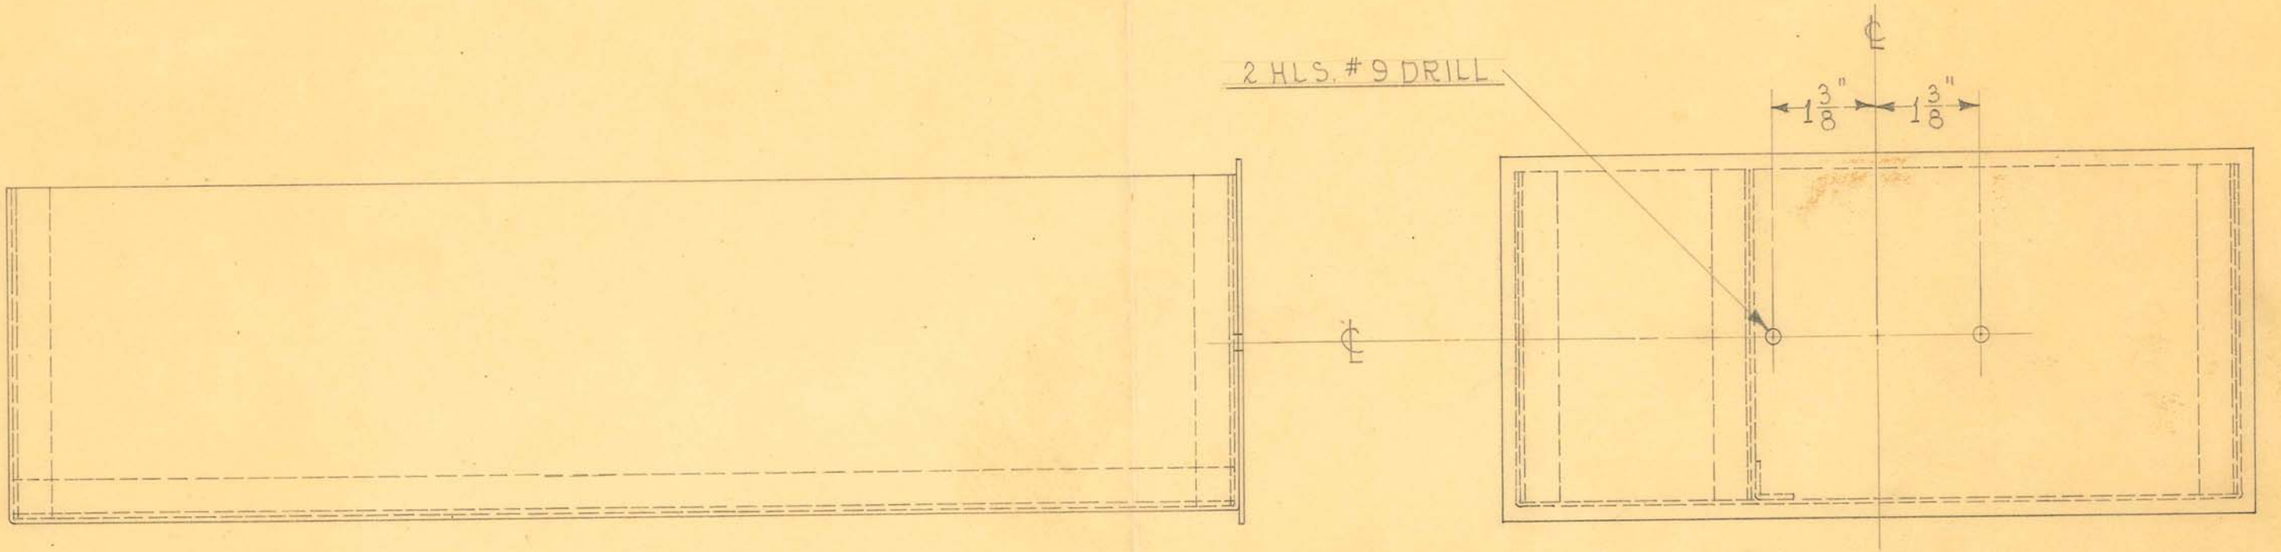

SCALE ÷ 1/2" = 1"

1 REQUIRED

OBSOLETE

SIZE		ISSUE 5-17-38	N.E.
KIND		CHANGED	
SHAPE		"	
FINISH		"	
TEMP.		"	
PATT.		"	

TITLE: FISCHER MOD. "J" GALV. & CONT CURR. GEN.-CABINET DRAWER (DRILLED)

H. G. FISCHER & CO.
2335 WABANSIA AVE.
CHICAGO, ILL.

CAT. NO.

PART NO. PART OF 11195GF

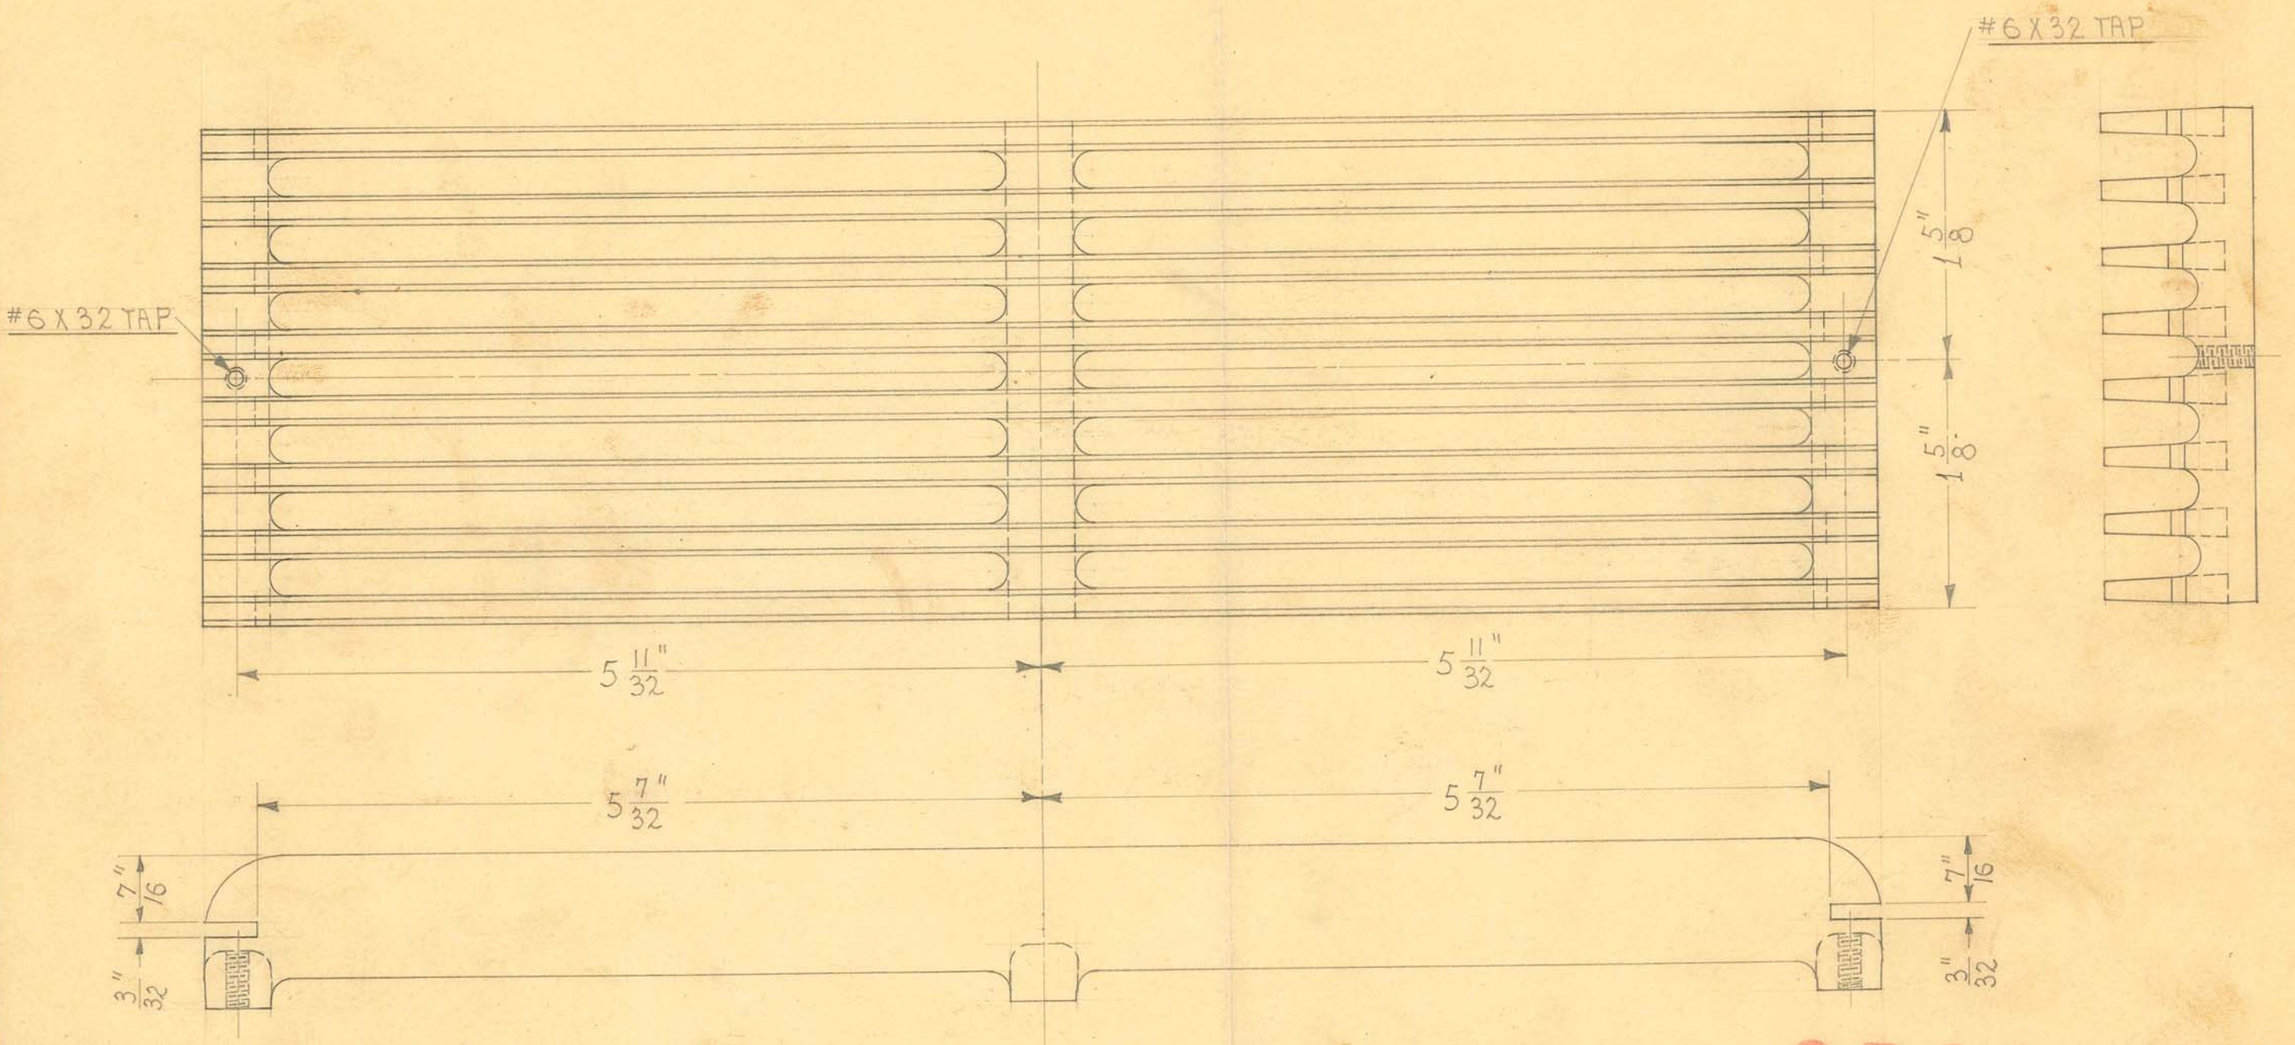

2 REQUIRED

OBSOLETE

SIZE		ISSUE 1-28-38	A.E.
KIND	ALUM. CASTING	CHANGED	
SHAPE		"	
FINISH	IVORY	"	
TEMP.		"	
PATT.	8386-1180	"	

TITLE: FISCHER MODEL "J" GALVANIC & CONTRACTILE CURRENTS GEN. - CABINET LOUVRE - LONG

H. G. FISCHER & CO.
2335 WABANSIA AVE.
CHICAGO, ILL.

CAT. NO.

PART NO. 11197F

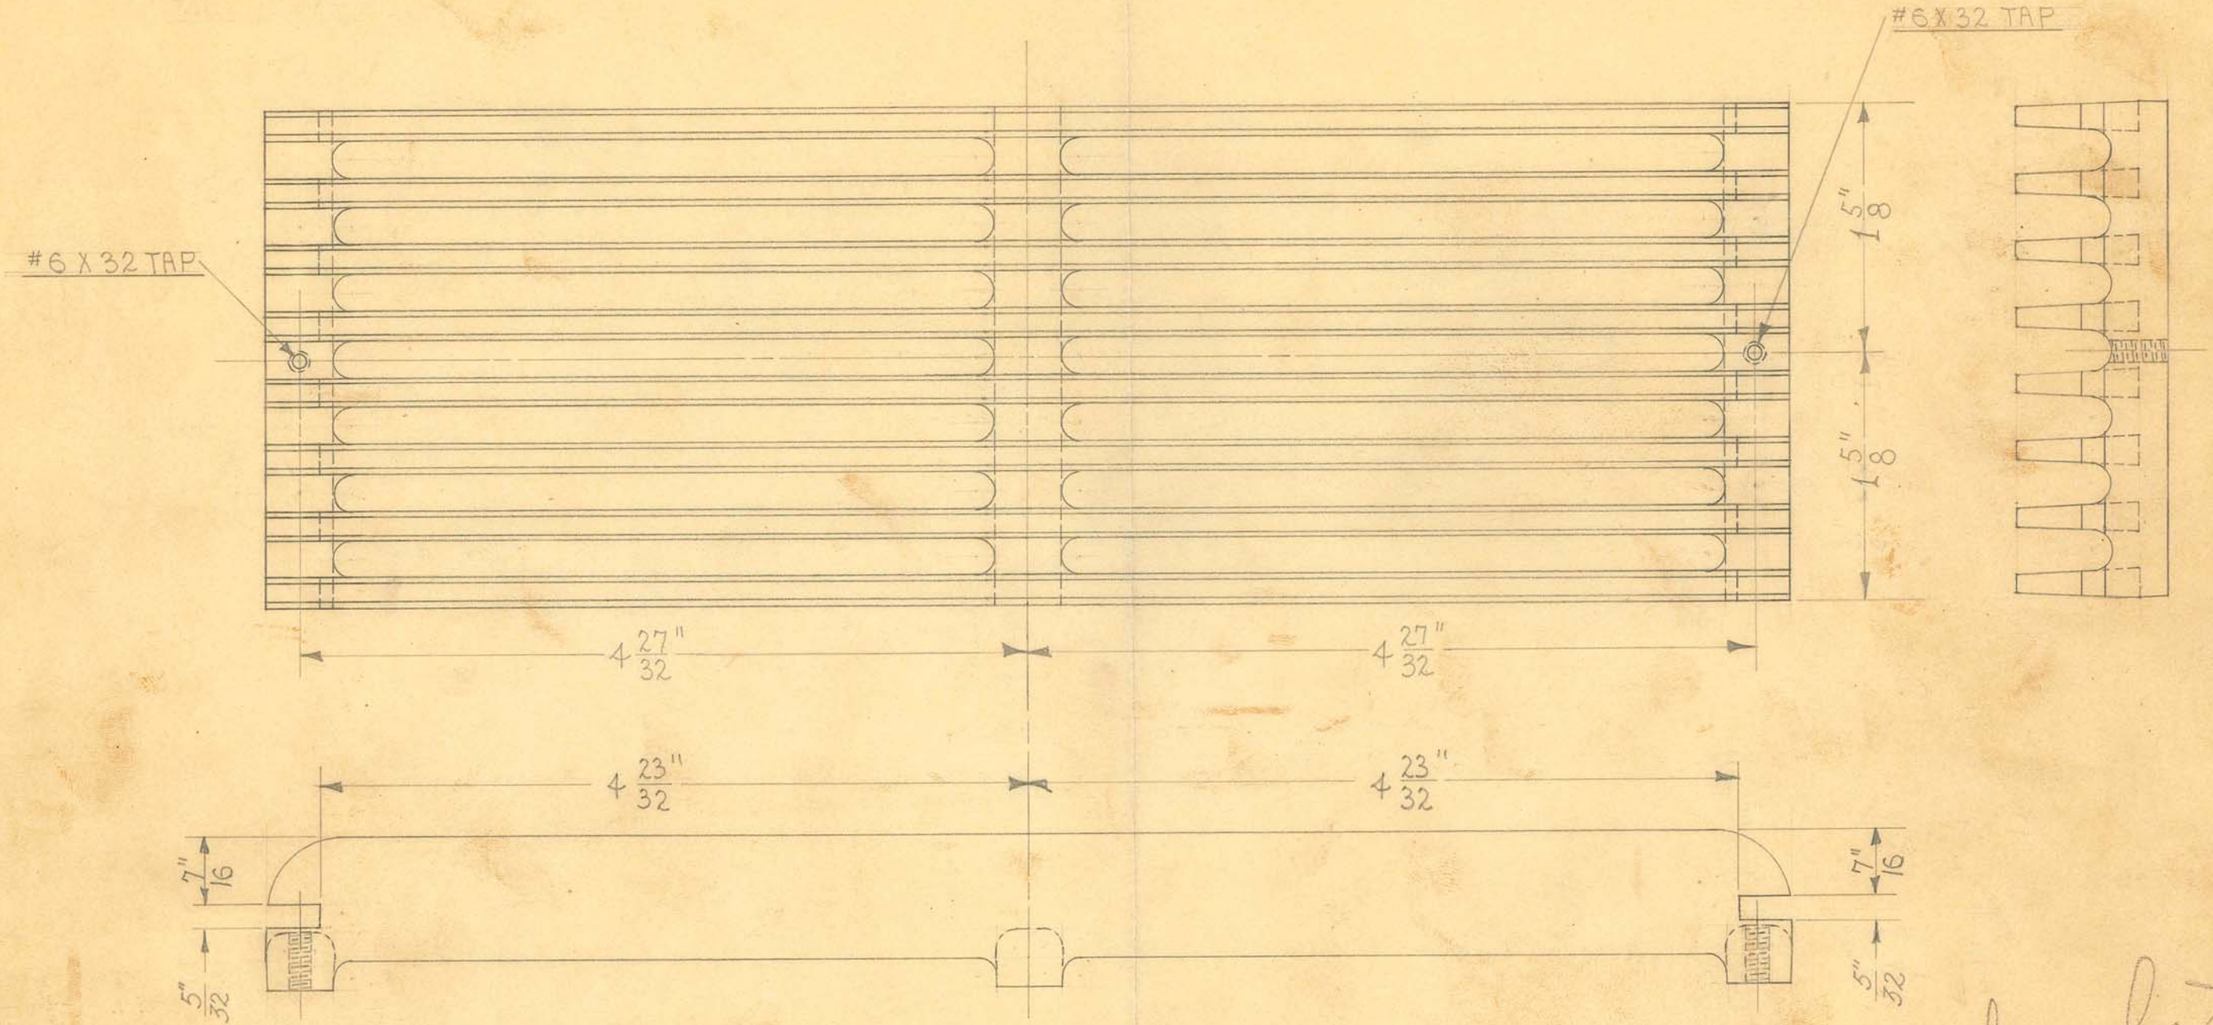

1 REQUIRED

Obsolete

OBSOLETE

SIZE		ISSUE 2-2-38	A.E.
KIND	ALUM. CASTING	CHANGED	
SHAPE		"	
FINISH	IVORY	"	
TEMP.		"	
PATT.	8387-1181	"	

TITLE: FISCHER MODEL "J" GALV. & CONTRACTILE CURRENTS GEN.- CABT. LOUVRE-SHORT

H. G. FISCHER & CO.
2335 WABANSIA AVE.
CHICAGO, ILL.

CAT. NO.

PART NO. 11198F

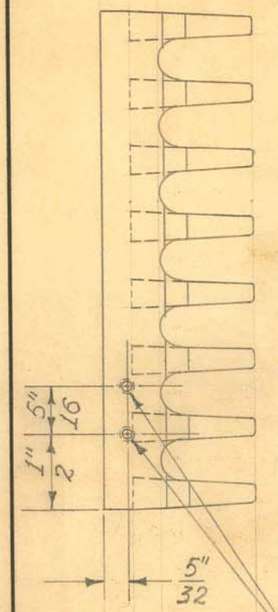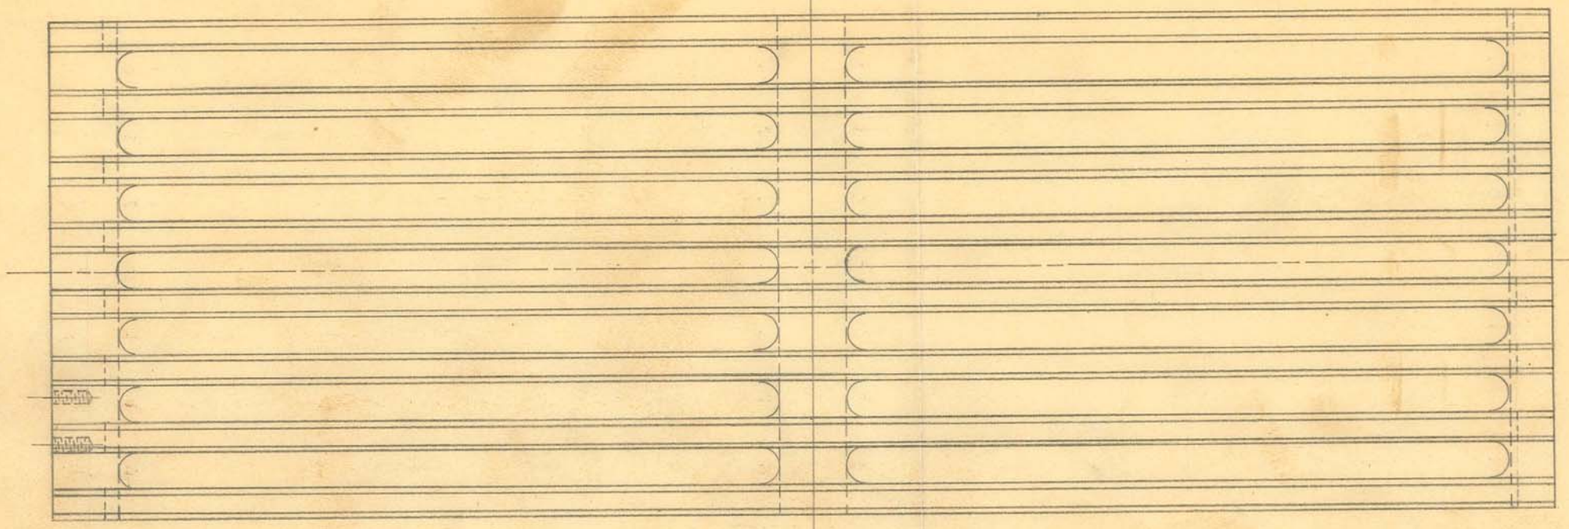

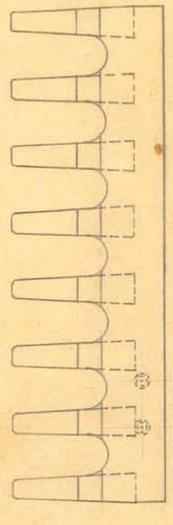

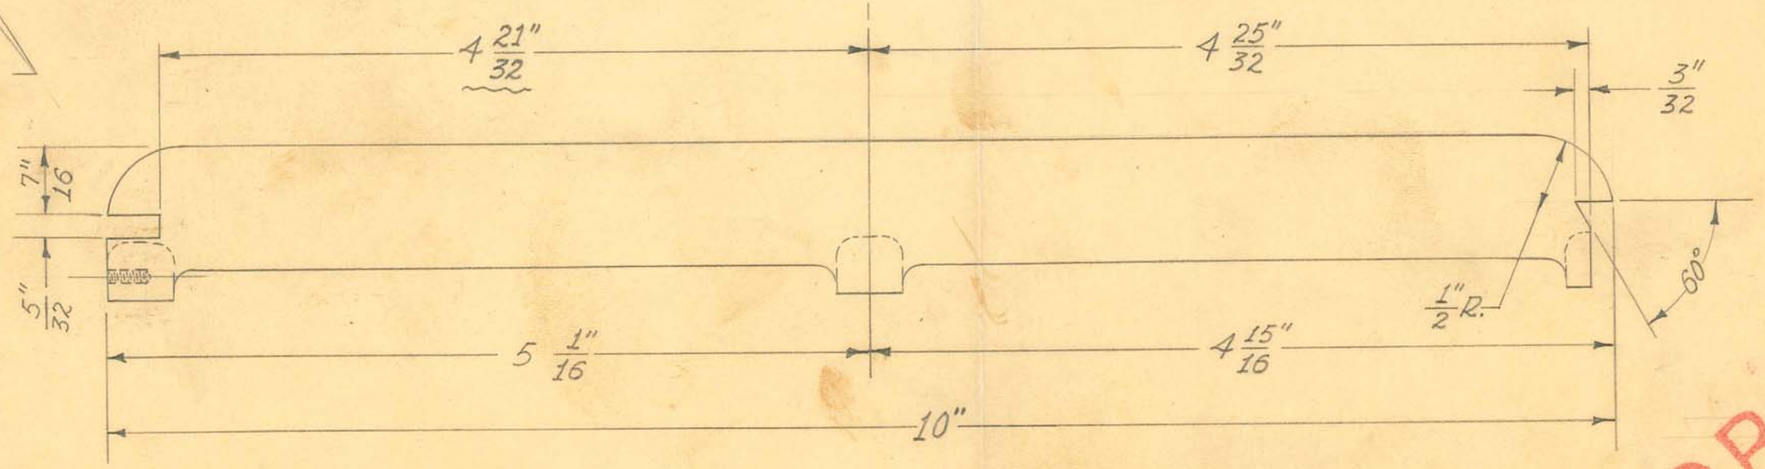

OBSOLETE

1 REQUIRED

SIZE		ISSUE 3-8-39	J.W.
KIND	ALUM. CASTING	C.M. CHANGED 4-10-39	J.W.
SHAPE		"	
FINISH	PAINTED	"	
TEMP.		"	
PATT.	8387-1181	"	

TITLE: FISCHER MODEL "J" GALV. & CONTRACTILE CURRENTS GEN.-CAB'T. LOUVRE-SHORT

H. G. FISCHER & CO.
2338 WABANSIA AVE.
CHICAGO, ILL.

CAT. NO.

PART NO. 11198FA

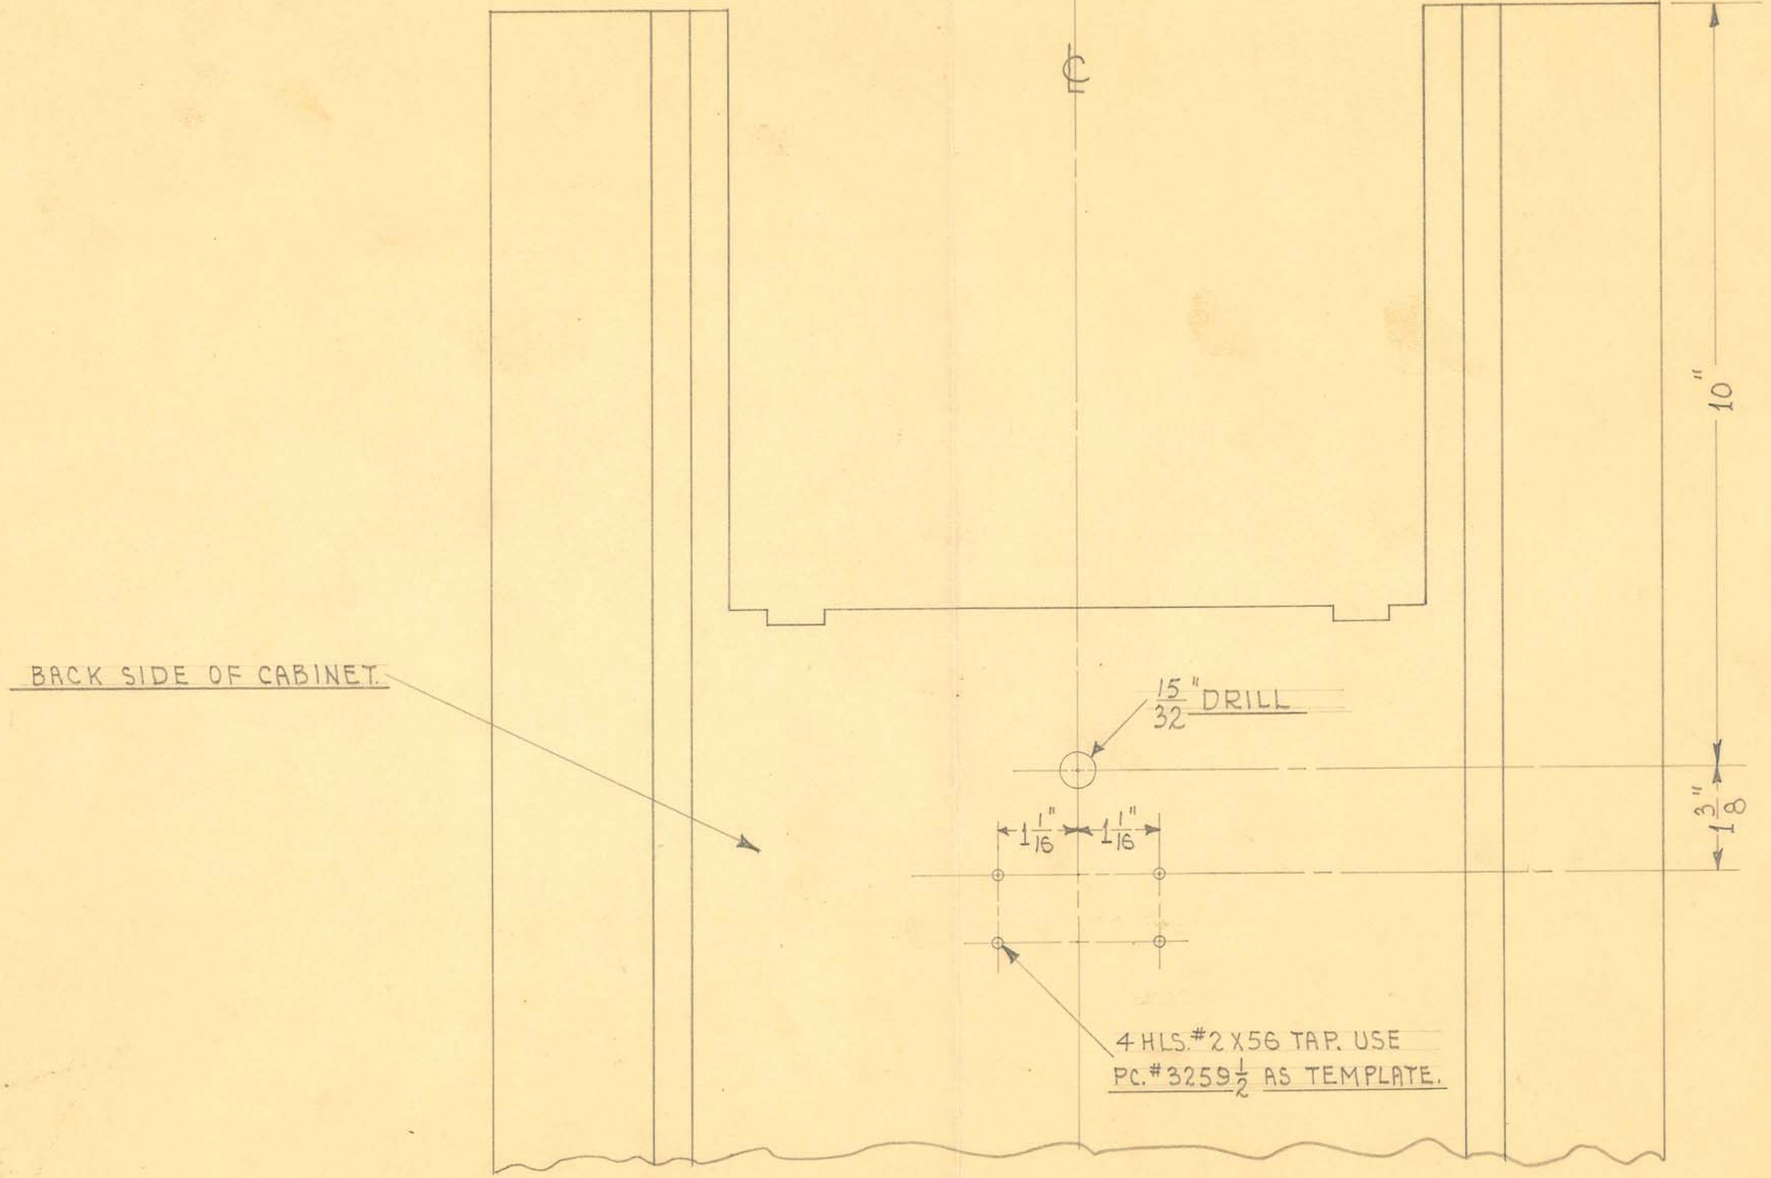

OBSOLETE

SCALE ~ 1/2" = 1"

SIZE		ISSUE 8-18-38	HE
KIND		CHANGED	
SHAPE		"	
FINISH		"	
TEMP.		"	
PATT.		"	

TITLE: FISCHER MODEL "J" GALV. & CONTRACTILE CURRENTS GEN. - CABINET (DRILLED)

H. G. FISCHER & CO.
2335 WABANSIA AVE.
CHICAGO, ILL.

CAT. NO.

PART NO. PART OF 11195GF

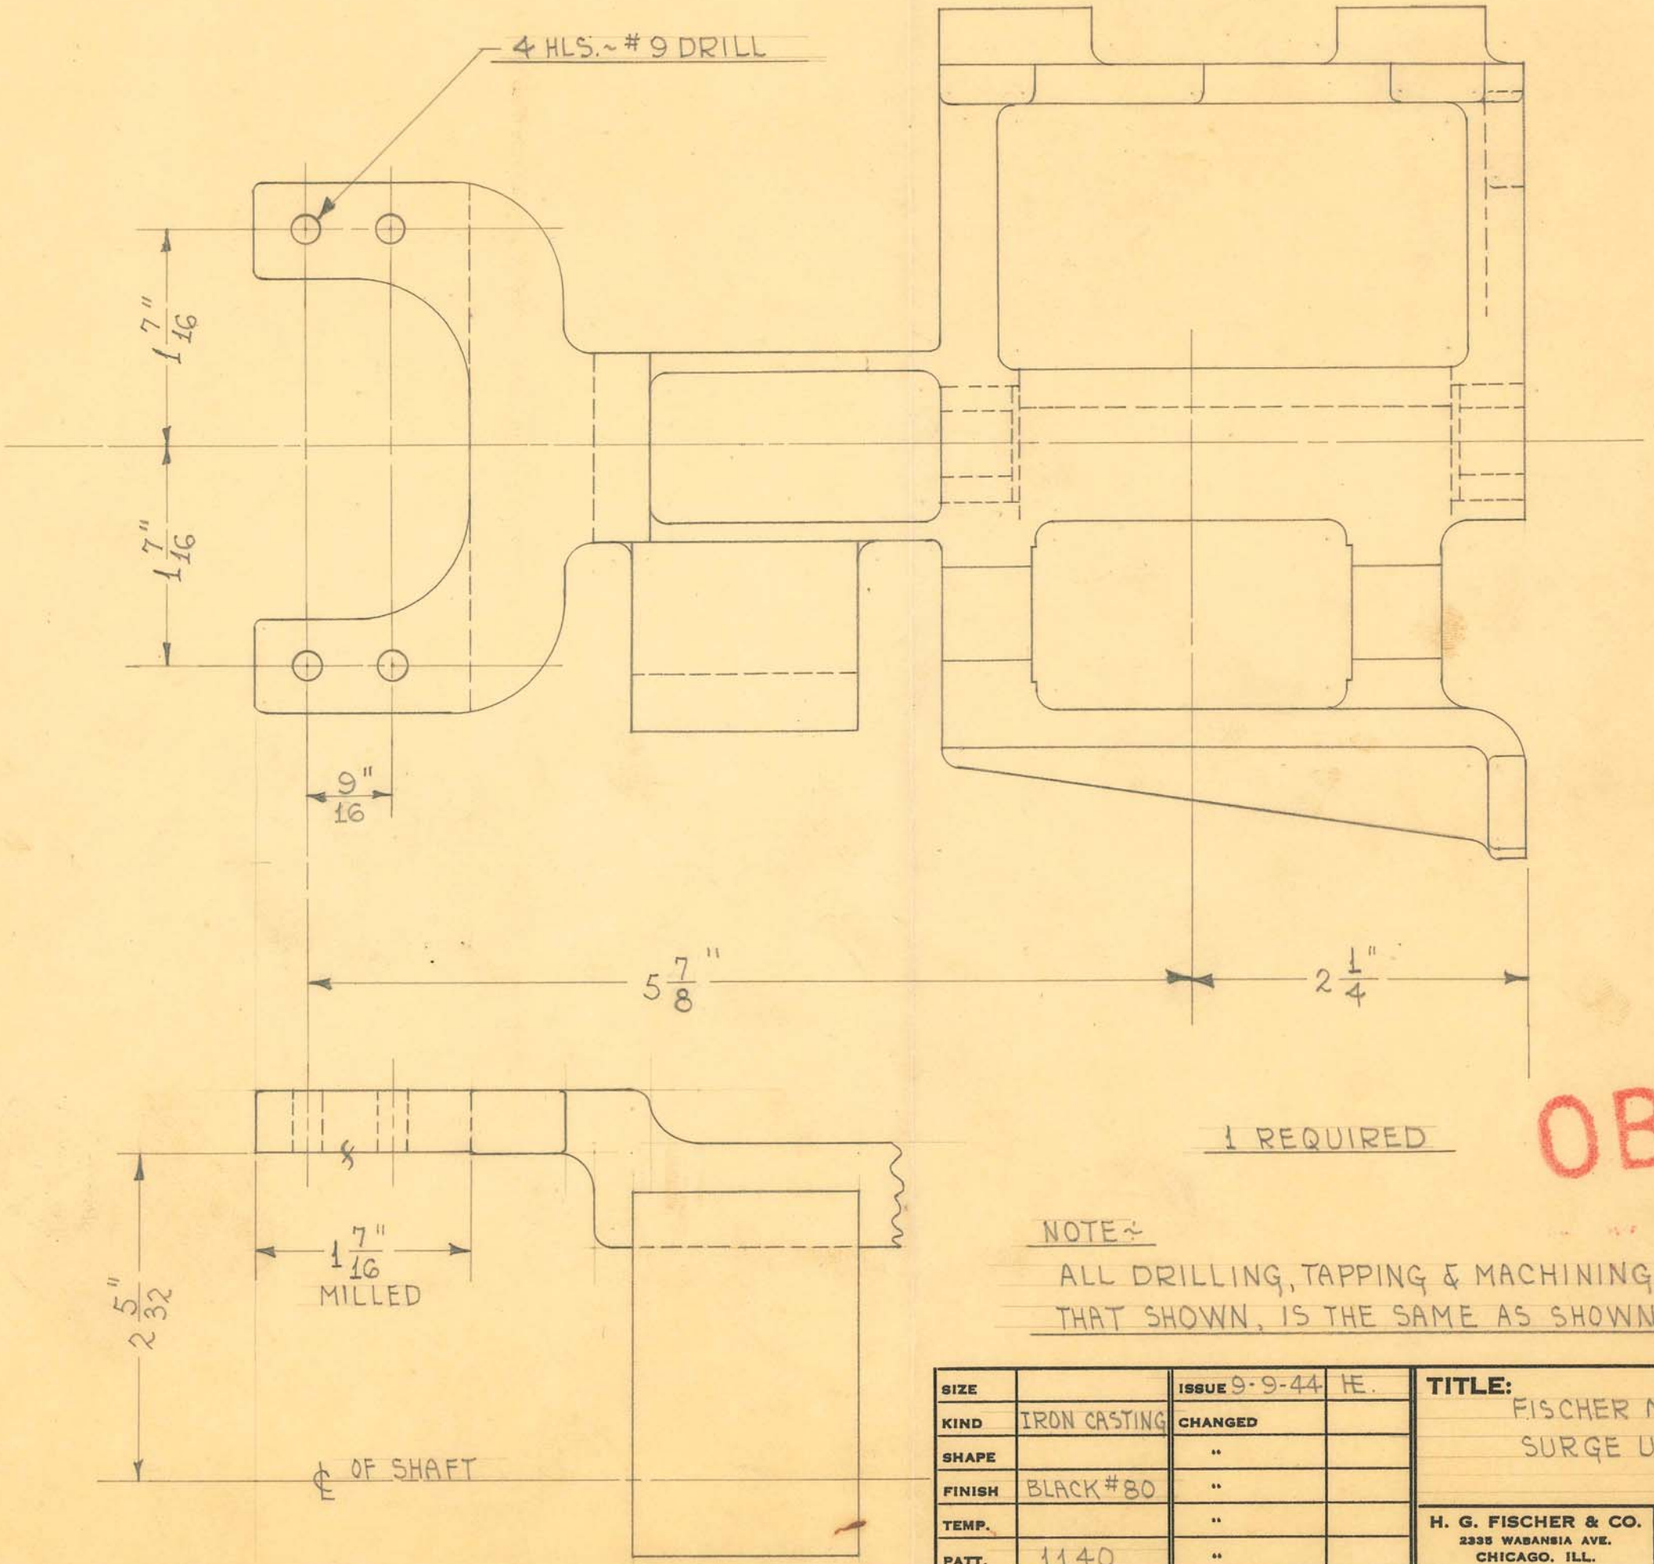

1 REQUIRED

OBSOLETE

NOTE:-

ALL DRILLING, TAPPING & MACHINING, OTHER THAN THAT SHOWN, IS THE SAME AS SHOWN ON DRG. # 11171G

SIZE		ISSUE 9-9-44	HE.
KIND	IRON CASTING	CHANGED	
SHAPE		"	
FINISH	BLACK #80	"	
TEMP.		"	
PATT.	1140	"	

TITLE: FISCHER MOD. "J" GALV. & CONT. CURR. GEN. SURGE UNIT MOUNTING FRAME

H. G. FISCHER & CO.
2335 WABANSIA AVE.
CHICAGO, ILL.

CAT. NO.

PART NO. 11171GA

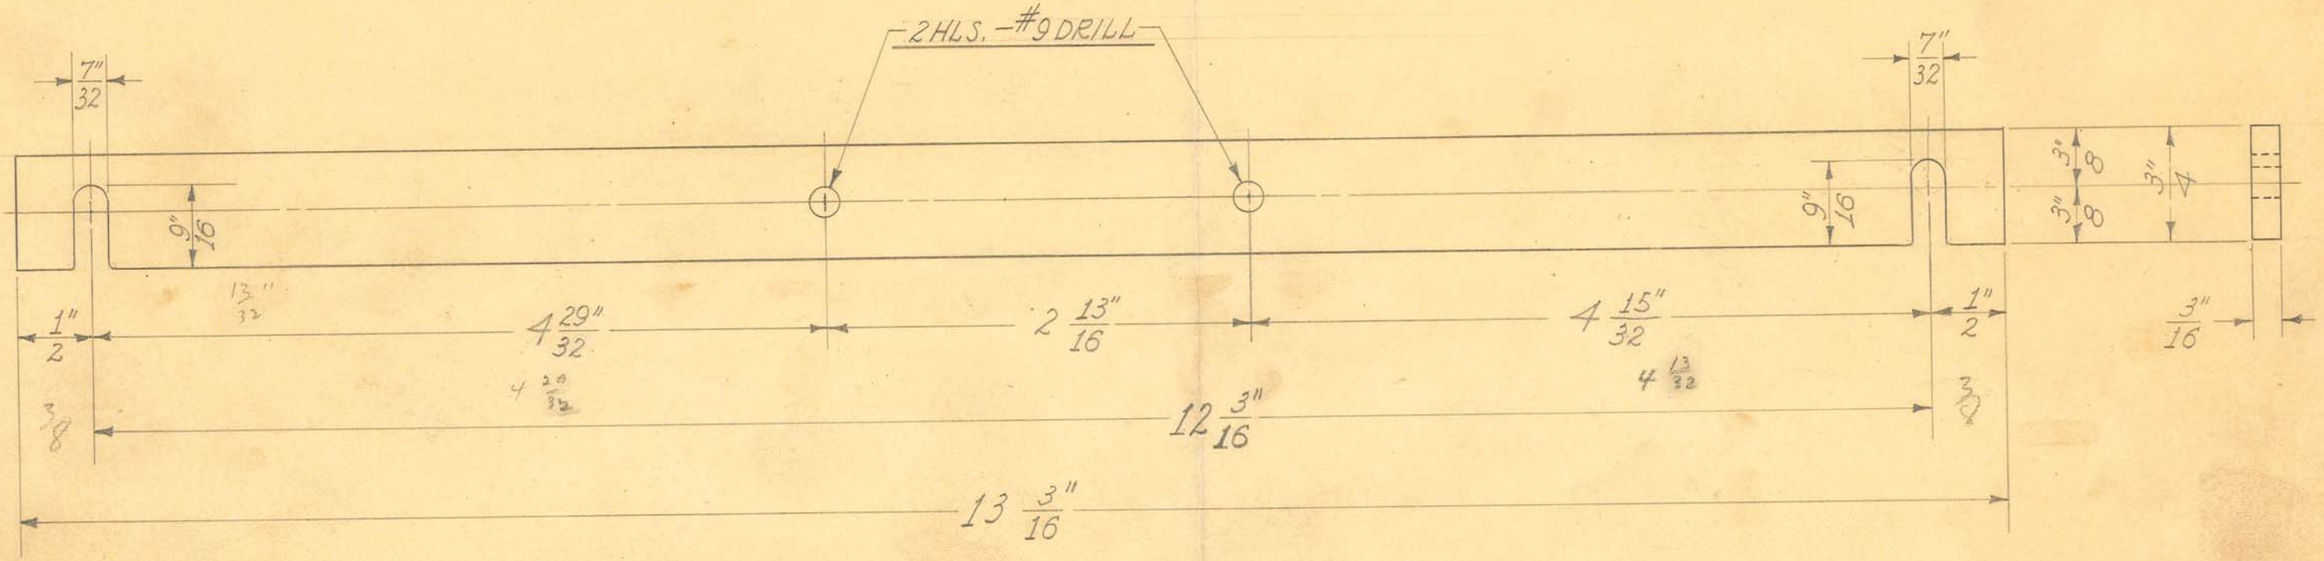

2 REQUIRED

OBSOLETE

SIZE	3/4" X 3/16"	ISSUE	5-23-38	J.W.
KIND	C.R. STEEL	CHANGED		
SHAPE	BAR	"		
FINISH	BLACK #80	"		
TEMP.		"		
PATT.		"		

TITLE: FISCHER MOD. "J" GALV. & CONT. CURR. GEN. SURGE UNIT – MOUNTING FRAME SUPP. STRIP

H. G. FISCHER & CO.
2335 WABANSIA AVE.
CHICAGO, ILL.

CAT. NO.

PART NO. 11172

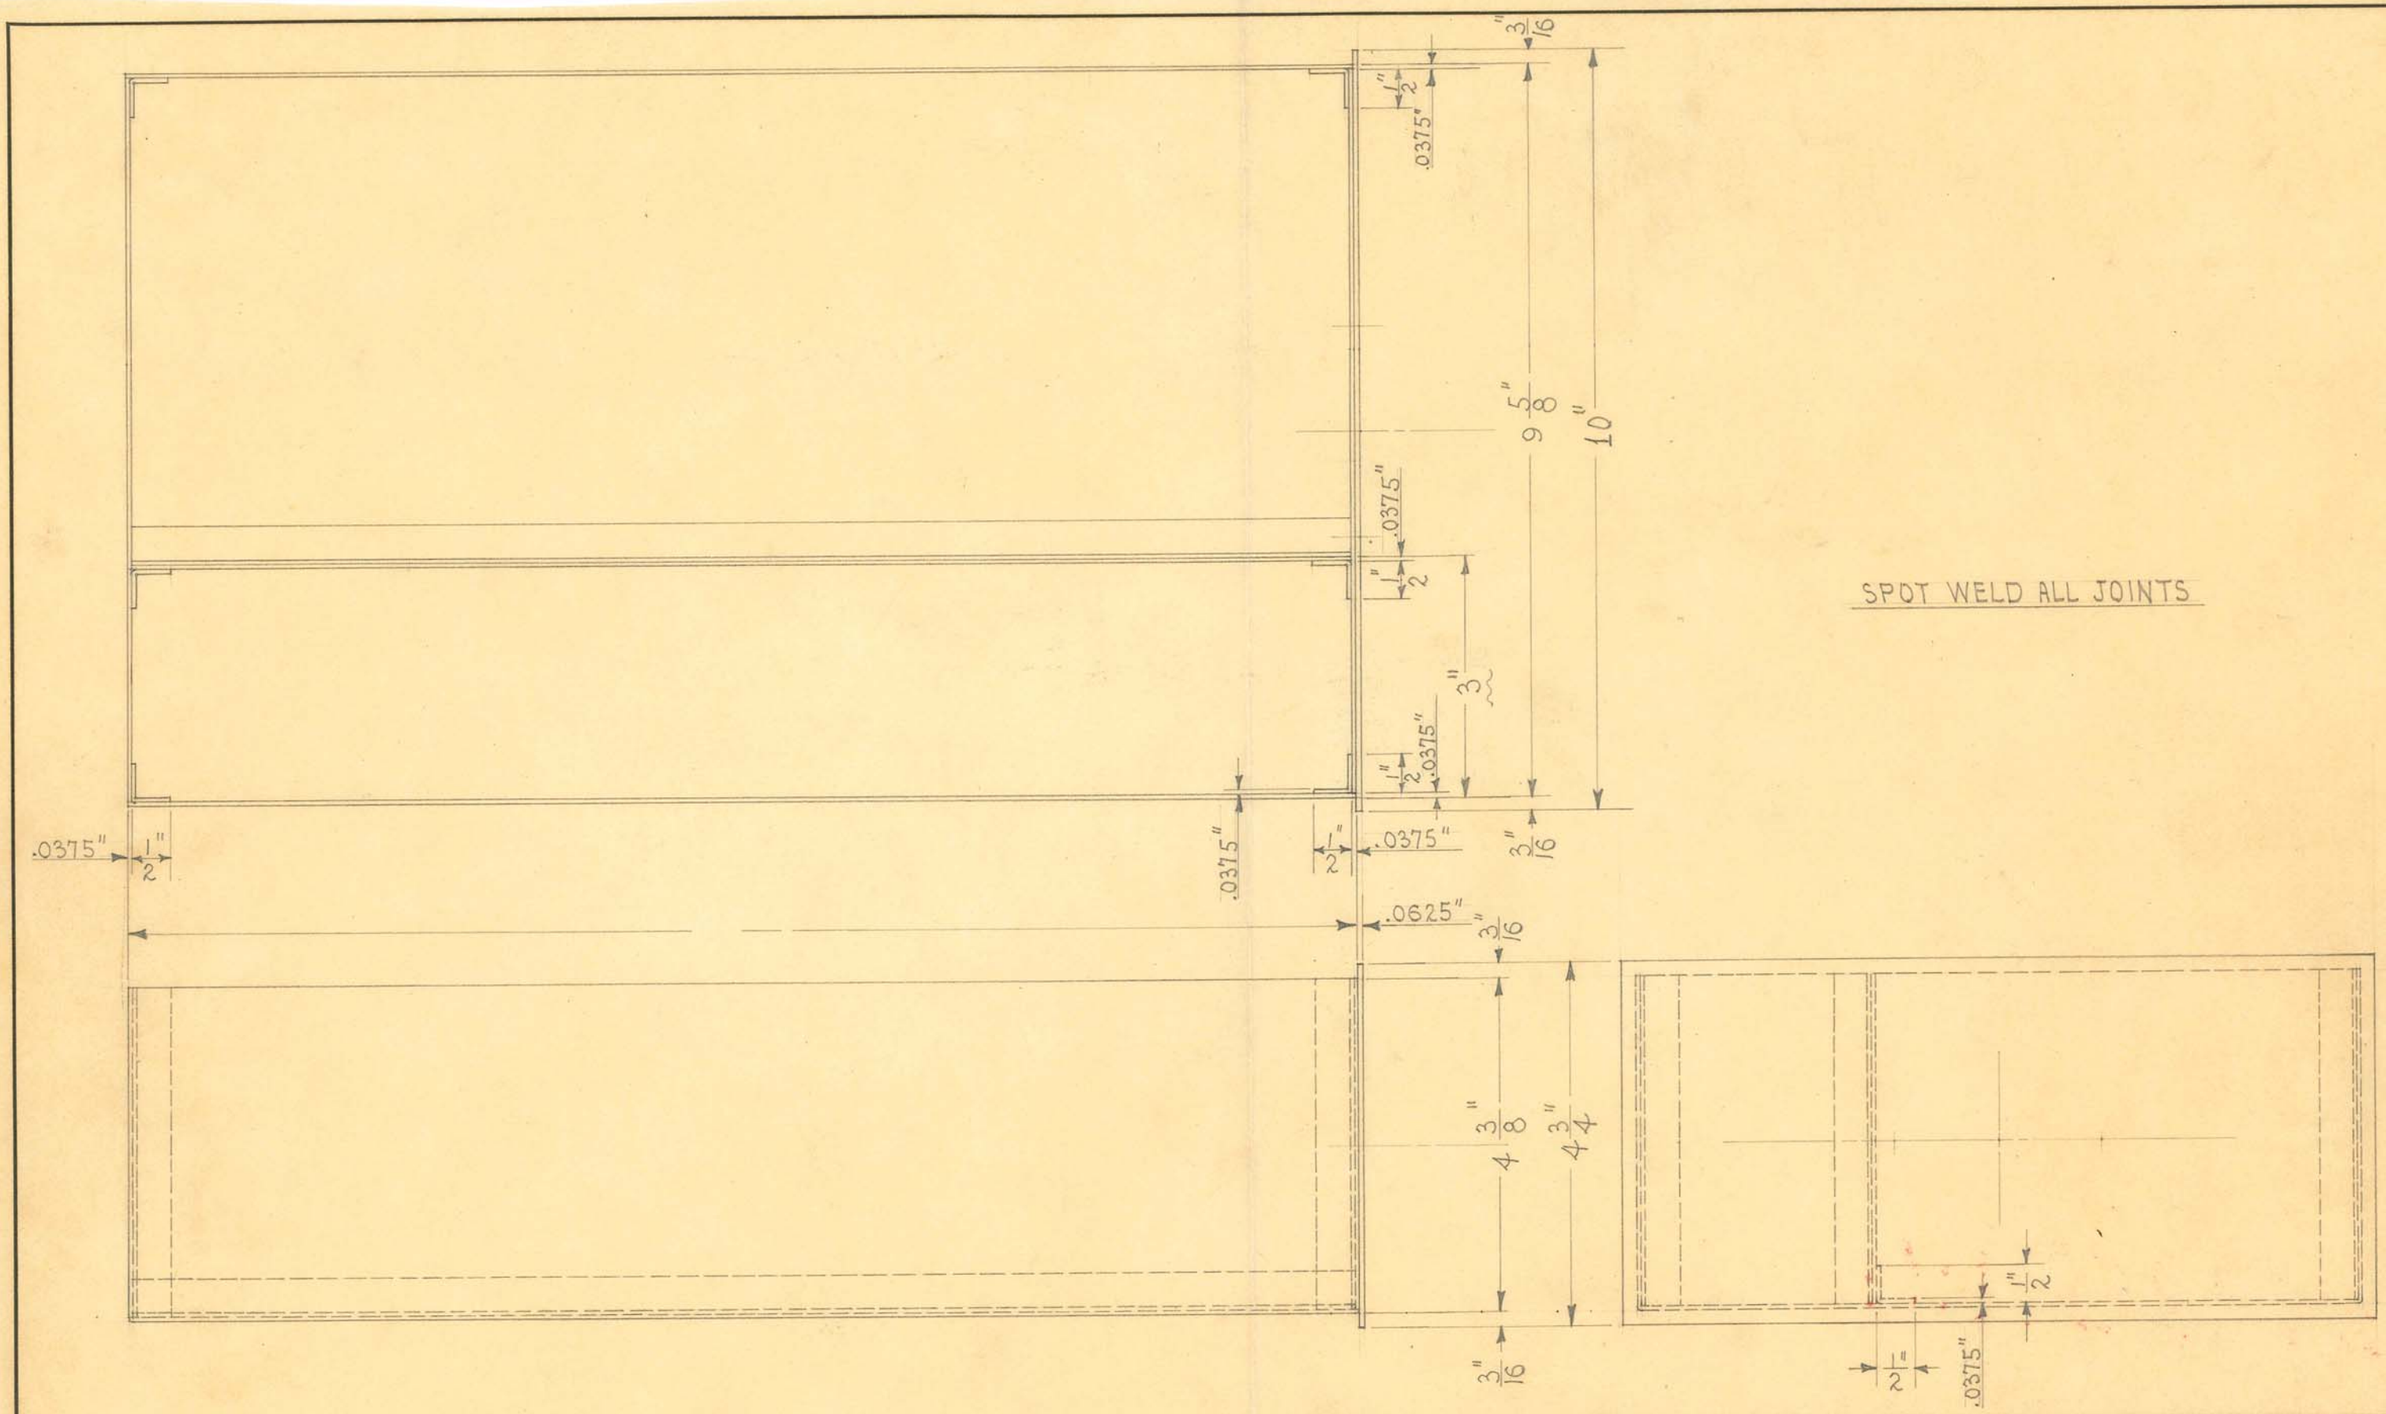

SPOT WELD ALL JOINTS

OBSOLETE

SCALE ≈ 1/2" = 1"

1 REQUIRED

SIZE		ISSUE 1-26-38	J.E.
KIND	C.R. STEEL	CHANGED	
SHAPE		"	
FINISH		"	
TEMP.		"	
PATT.		"	

TITLE: FISCHER MODEL "J" GALV. & CONTRACTILE CURRENTS GEN.- CABINET DRAWER

H. G. FISCHER & CO.
2335 WABANSIA AVE.
CHICAGO, ILL.

CAT. NO.

PART NO. PART OF 11195G

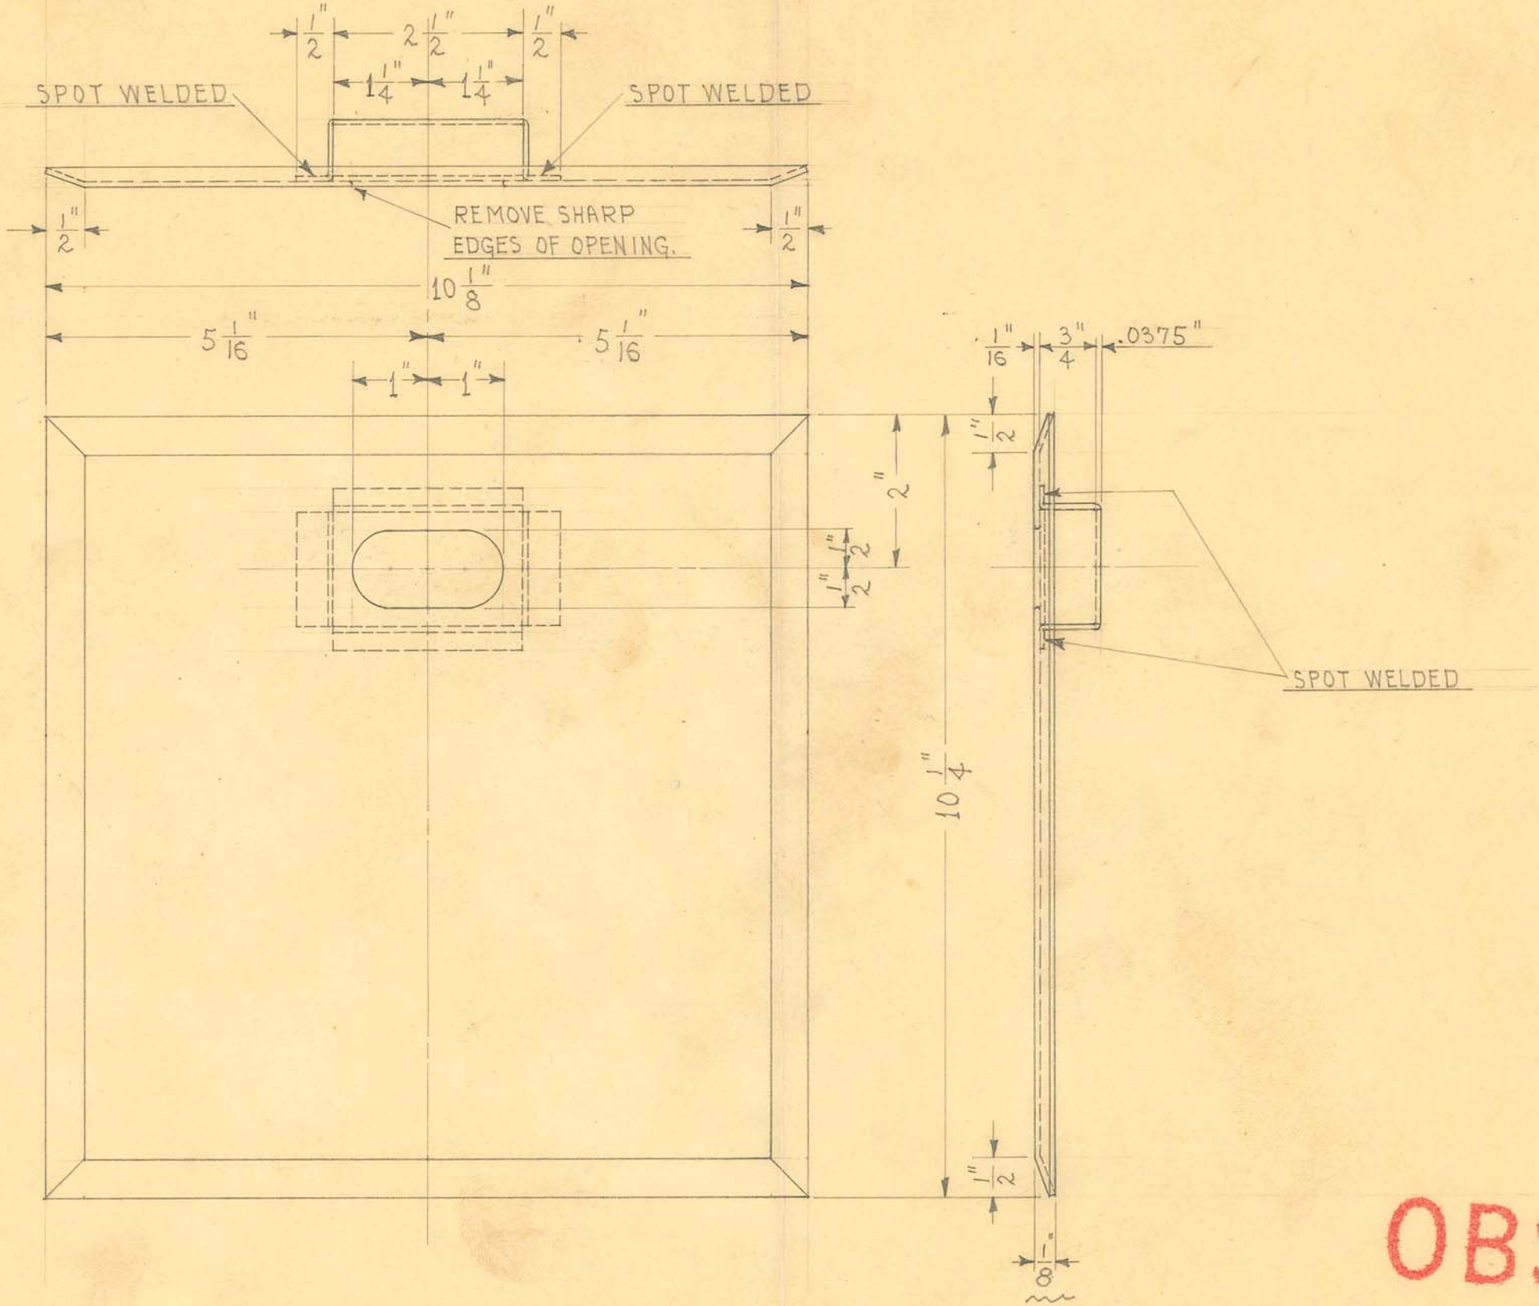

SCALE ÷ 1/2" = 1"

1 REQUIRED

OBSOLETE

SIZE		ISSUE 1-26-38	N.E.
KIND	C.R. STEEL	CHANGED	
SHAPE		"	
FINISH		"	
TEMP.		"	
PATT.		"	

TITLE: FISCHER MODEL "J" GALV. & CONTRACTILE CURRENTS GEN. CABINET-REMOVABLE BACK

H. G. FISCHER & CO.
2338 WABANSIA AVE.
CHICAGO, ILL.

CAT. NO.

PART NO. PART OF 11195G

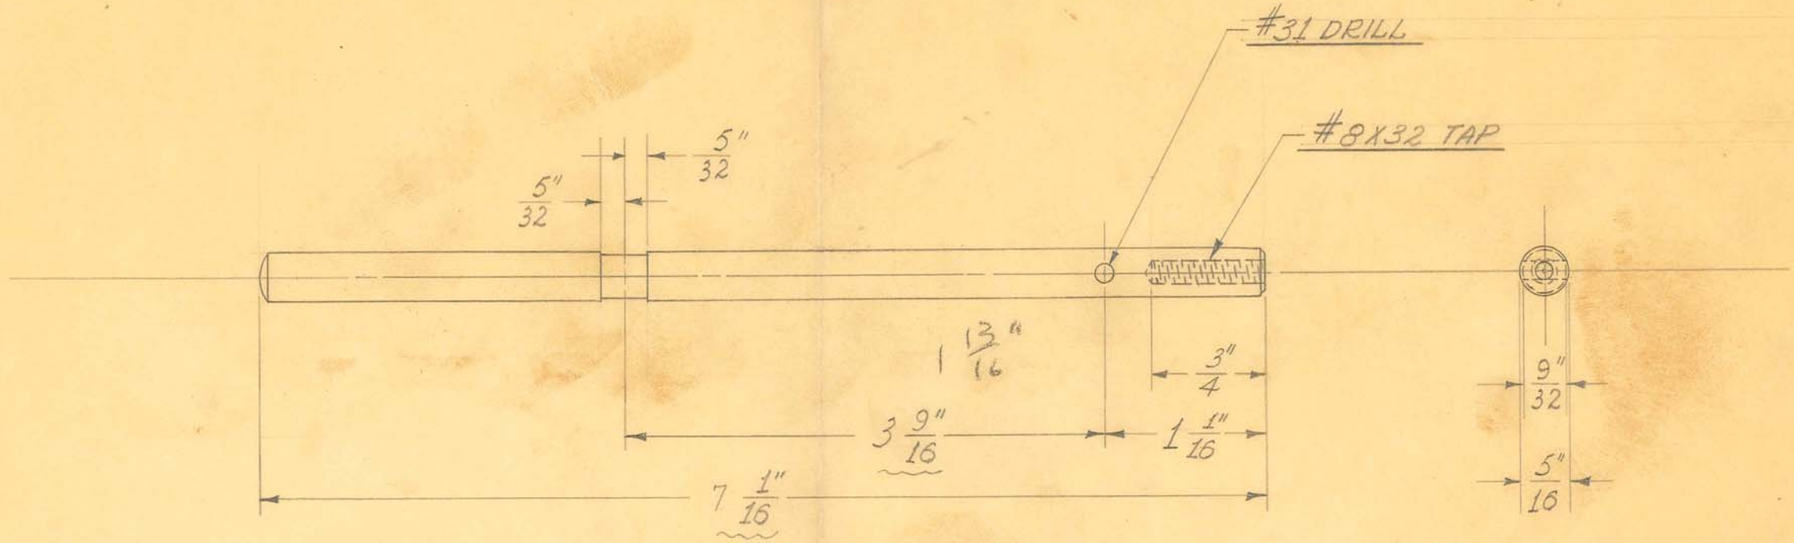

1 REQUIRED

OBSOLETE
Obsolete

SIZE	5/16" DIAM.	ISSUE 5-13-38	J.W.
KIND	SCREW STOCK	CHANGED	
SHAPE		" 6-21-38	J.W.
FINISH		"	
TEMP.		"	
PATT.		"	

TITLE: FISCHER MOD. "J" GALV. & CONT. CURR GEN. SURGE UNIT-VARIABLE SURGE REGULATING ROD

H. G. FISCHER & CO.
2335 WABANSIA AVE.
CHICAGO, ILL.

CAT. NO.

PART NO. 11165

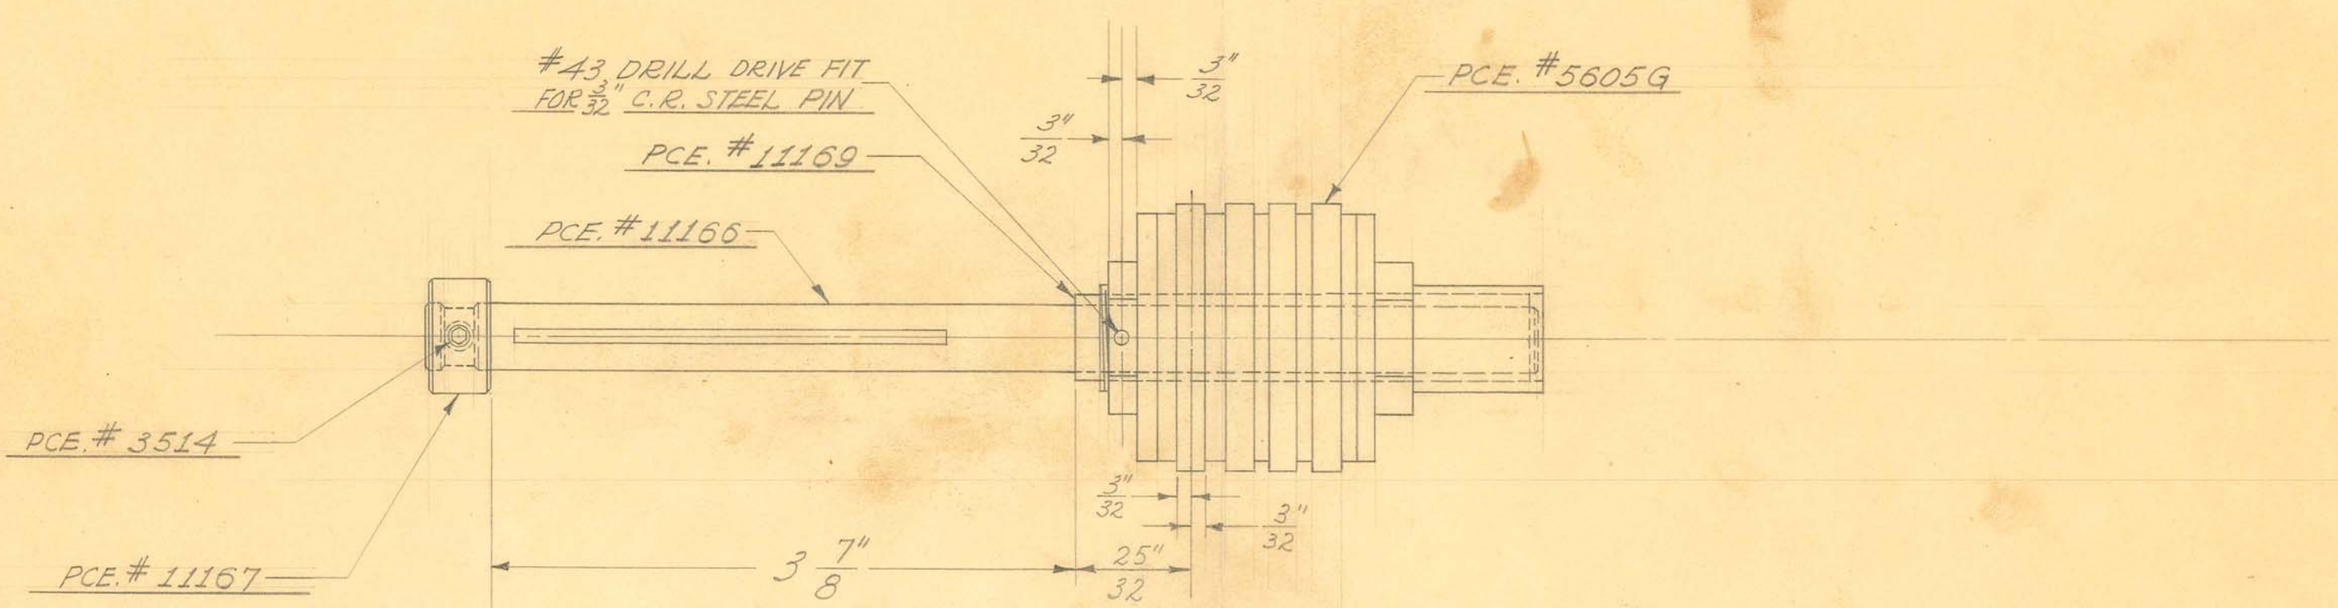

1 REQUIRED

OBSOLETE

Obsolete

SIZE		ISSUE 5-12-38	J.W.
KIND		CHANGED	
SHAPE		"	
FINISH		"	
TEMP.		"	
DATE		"	

TITLE: FISCHER MOD. "J" GALV. & CONT. CURR. GEN. SURGE UNIT-COLLECTOR RING ASSEMBLY

H. G. FISCHER & CO.
2335 WABANSIA AVE.

CAT. NO.

PART NO. 11168G

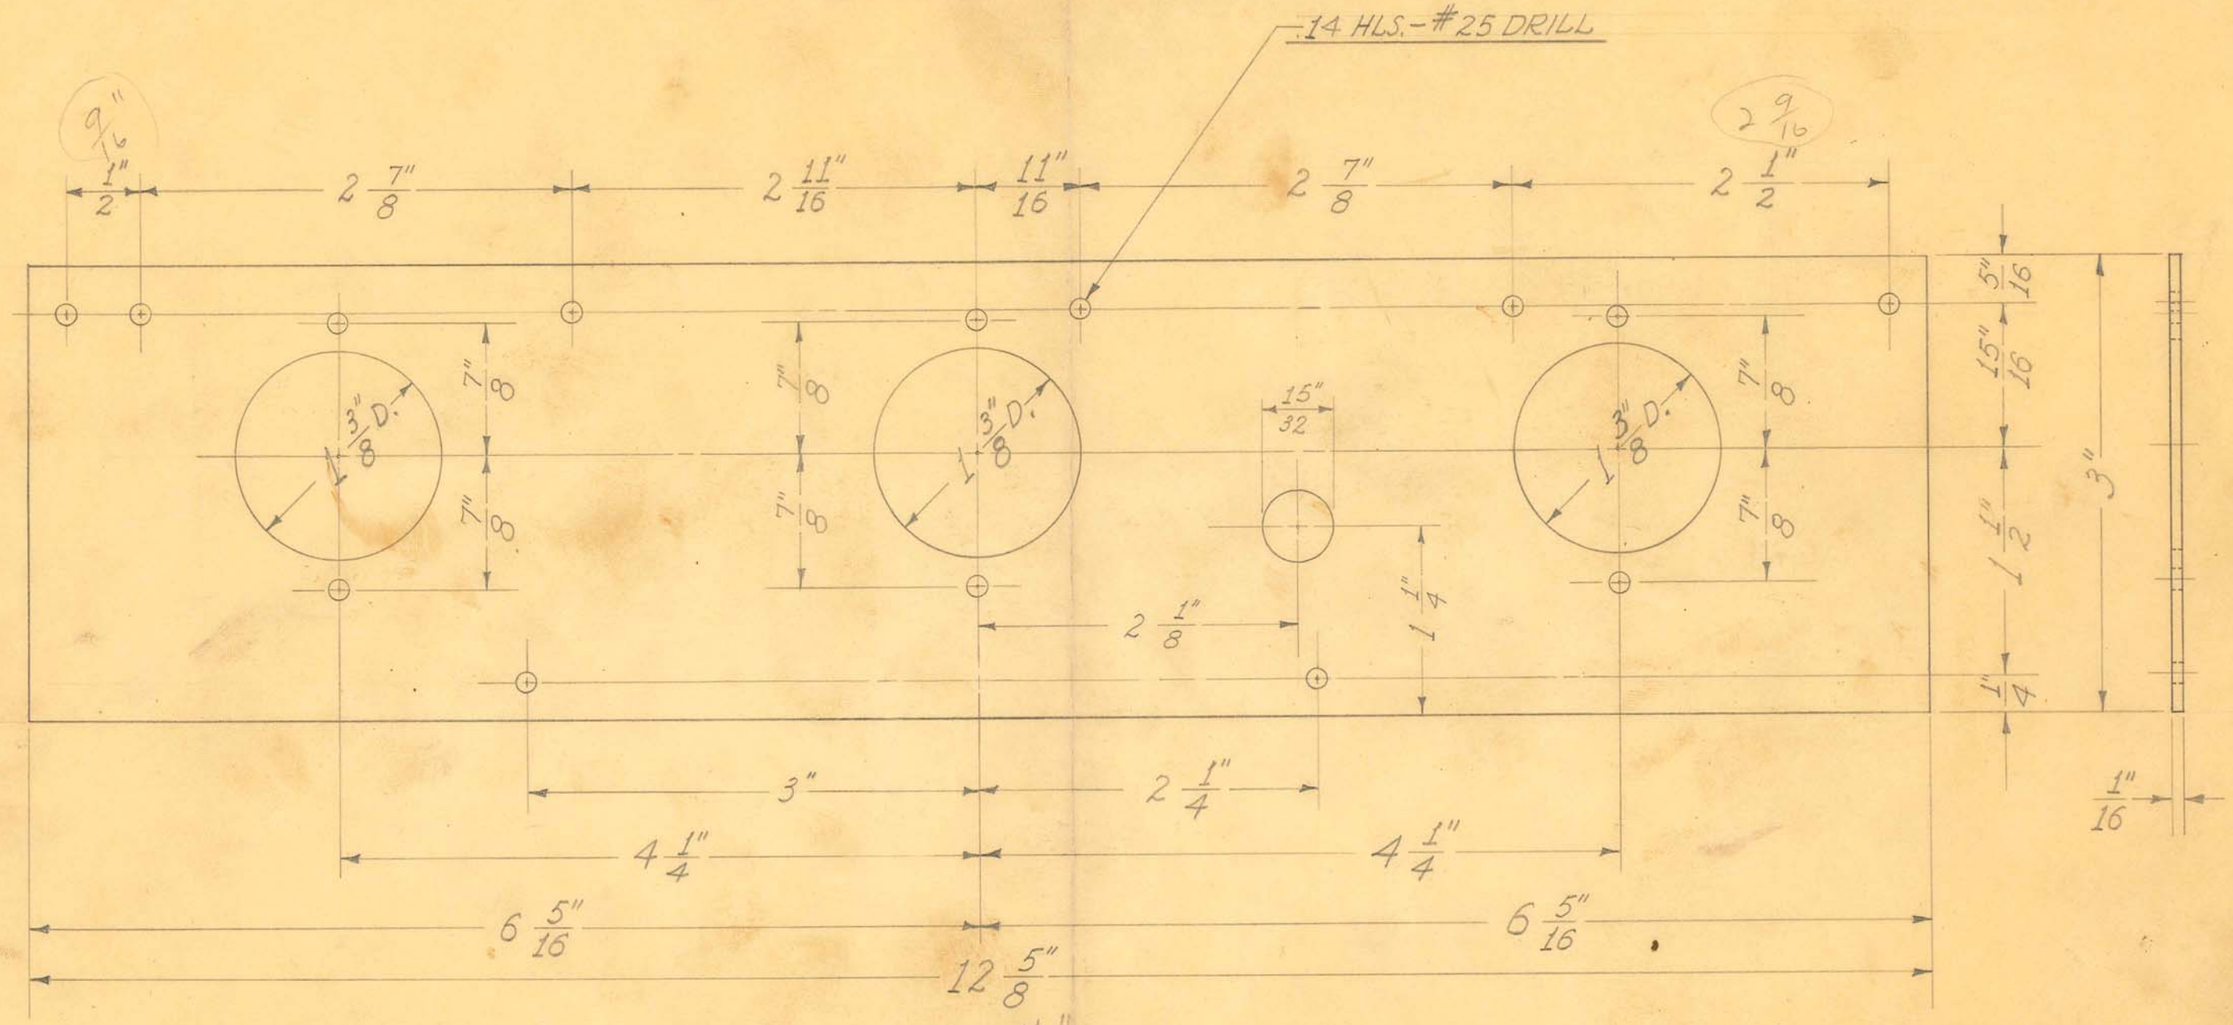

1 REQUIRED

OBSOLETE

SIZE	1/16" SHEET	ISSUED 5-16-38	J.W.
KIND	C.R. STEEL	CHANGED 8-25-38	J.W.
SHAPE		"	
FINISH	BLACK #80	"	
TEMP.		"	
PATT.		"	

TITLE: FISCHER MOD. "J" GALV. & CONT. CURR. GEN. OSCILLATING & RECTIFIER TUBE SOCKET MOUNTING PLATE

H. G. FISCHER & CO.
2335 WABANSIA AVE.
CHICAGO, ILL.

CAT. NO.

PART NO. 11158A

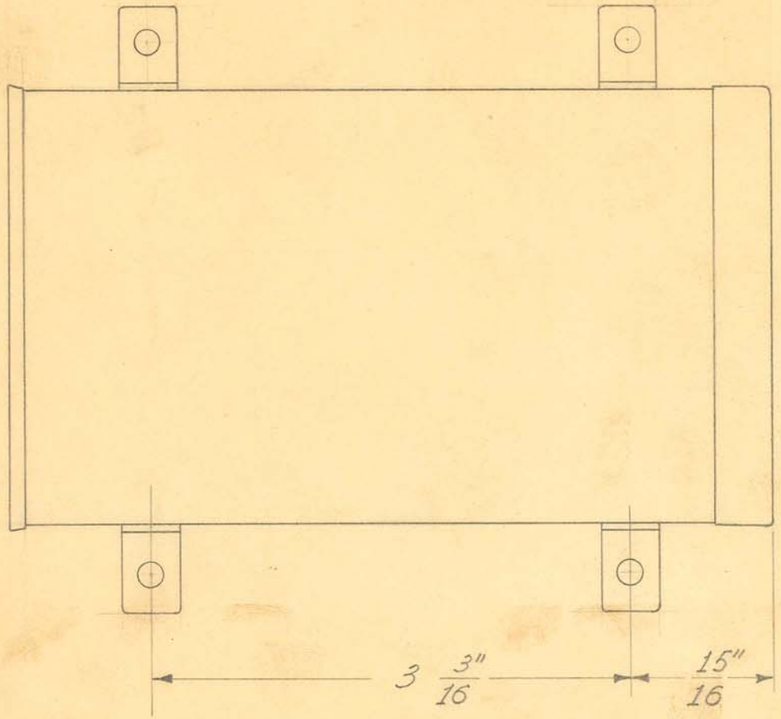

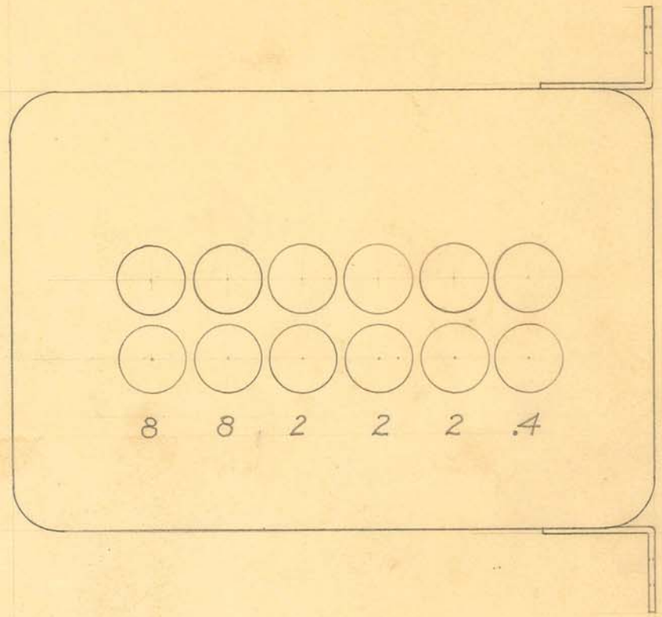

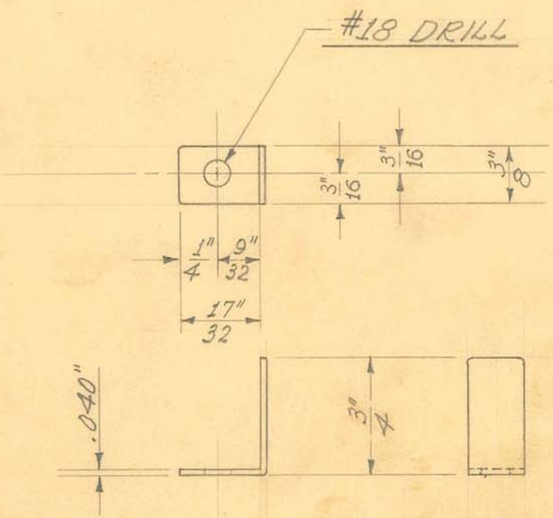

OBSOLETE

SIZE		ISSUE 1-18-38	J.W.	TITLE: FISCHER MOD. "J" GALV. & CONT. CURR. GEN. FILTER BLOCK
KIND		CHANGED		
SHAPE		"		
FINISH		"		
TEMP.		"		
PATT.		"		

H. G. FISCHER & CO.
2335 WABANSIA AVE.
CHICAGO, ILL.

CAT. NO.

PART NO. 11155G

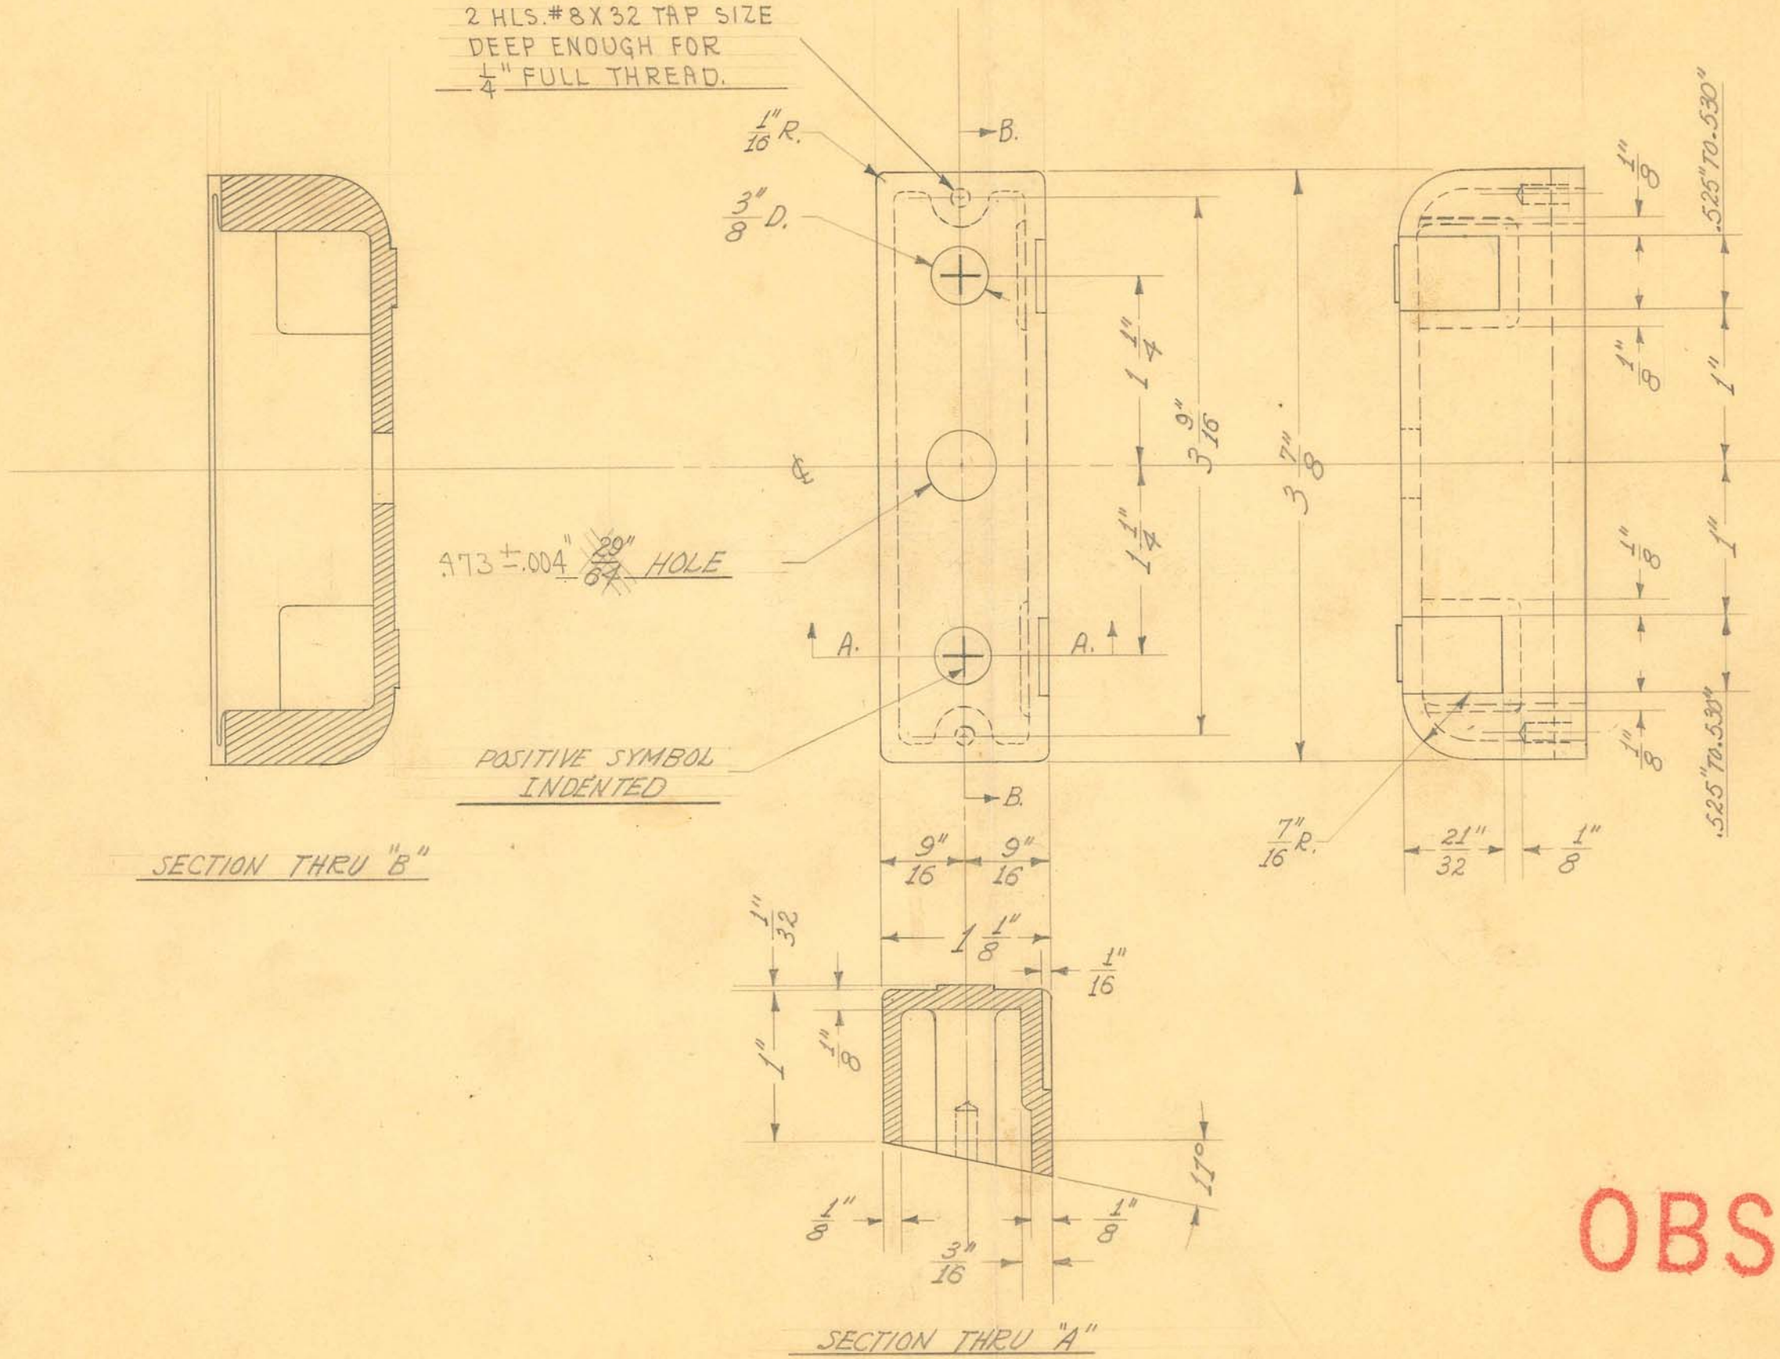

SECTION THRU "B"

SECTION THRU "A"

OBSOLETE

SIZE		ISSUE 1-11-38	J.W.	TITLE: FISCHER MOD. "J" GALV. & CONT. CURR. GEN. POLARITY SWITCH BOX
KIND		CHANGED		
SHAPE		"		
FINISH		"		
TEMP.		"		
PATT.		"		

H. G. FISCHER & CO.
2335 WABANSIA AVE.
CHICAGO, ILL.

CAT. NO.

PART NO. 11126

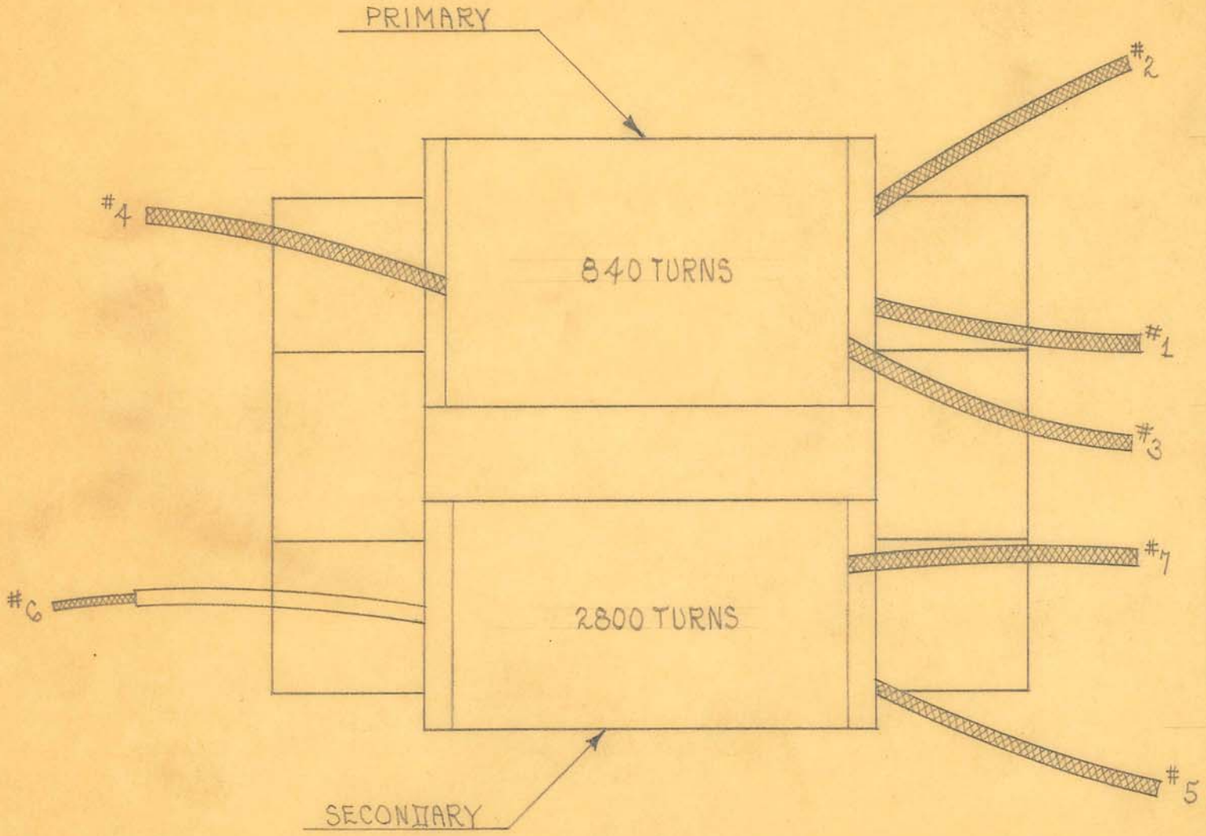

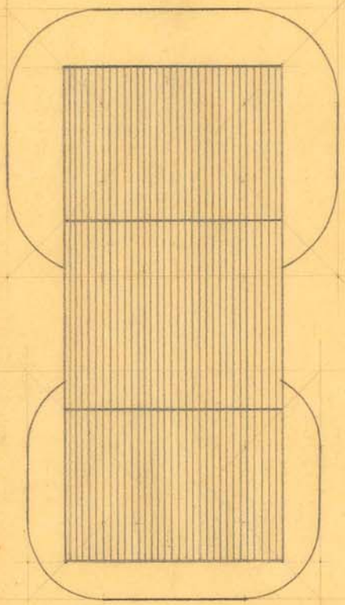

STEEL SIZES

PC. NO. 5043

PRI. & SEC. CORE LAMS. 4"X1" BUILT UP TO $1\frac{7}{16}$".
JIG. # $287\frac{1}{2}$
END PIECES CUT $2\frac{1}{4}$"X1"
BIND CORES WITH FRICTION TAPE

WINDING DATA

PRIMARY

3 LAYERS OF 5020 FIBROID PAPER ON CORE. USE #26 C.E. WIRE. ANCHOR LEAD #1 WITH LINEN TAPE AND WIND 8 LAYERS OF 100 TURNS EACH & 1 LAYER OF 40 TURNS. 1 LAYER OF 5020 FIBROID BETWEEN EACH LAYER OF WIRE. ANCHOR END WITH LINEN TAPE - LEAD #2. TOTAL 840 TURNS. 5 LAYERS OF 5020 FIBROID PAPER. ANCHOR LEAD #3 WITH LINEN TAPE AND WIND 28 TURNS WITH #20 COTENAMEL WIRE. ANCHOR END WITH LINEN TAPE-LEAD #4. COVER WITH 5004 OILED TAPE AND SHELLAC. LEADS ARE EACH 12" OF 1603-#18 STRANDED WIRE.

SECONDARY

3 LAYERS OF 5020 FIBROID PAPER ON CORE. USE #33 ENAMEL WIRE. ANCHOR LEAD #5 WITH LINEN TAPE. WIND 1400 TURNS AND TAP-LEAD #6. ANCHOR LEAD #6 WITH LINEN TAPE. WIND 1400 MORE TURNS AND ANCHOR END WITH LINEN TAPE-LEAD #7. 1 LAYER OF 5020 FIBROID BETWEEN EACH LAYER OF WIRE. COVER LAST LAYER OF WIRE WITH 5004 OILED CLOTH AND SHELLAC. LEADS #5 & #7 ARE EACH 12" OF 1600 WEATHER-PROOF WIRE. LEAD #6 IS 12" OF 1631 CHARADE COVERED WITH 5032 TUBING.

OBSOLETE

SIZE		ISSUE 5-4-32	H.E.
KIND		CHANGED	
SHAPE		" "	
FINISH		" "	
TEMP.		" "	
PATT. #		" "	

TITLE: FISCHER IMPROVED GALV. CUR. GEN. TRANSFORMER

H. G. FISCHER & CO.
2335 WABANSIA AVE.
CHICAGO, ILL.

CAT. NO.

PART NO. 110-25 6703G

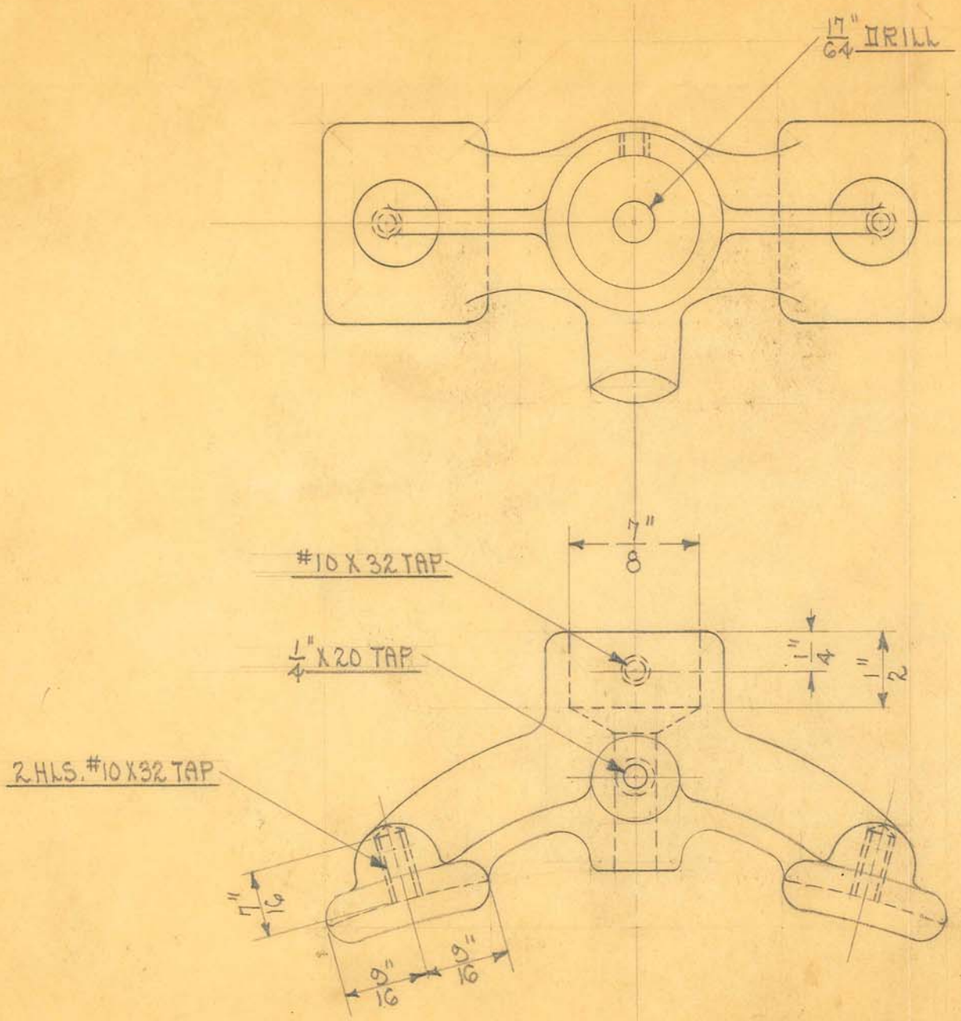

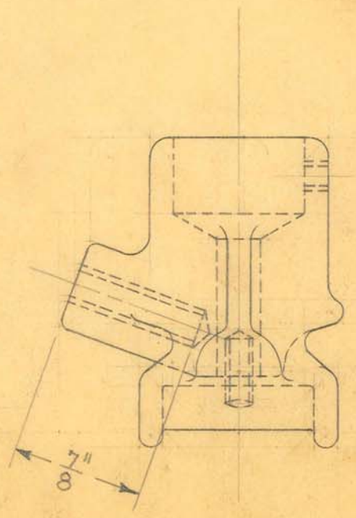

SCALE ½ FULL SIZE

OBSOLETE

SIZE		ISSUE 1-28-32	A.E.
KIND	IRON CASTING	CHANGED	
SHAPE		" "	
FINISH	SEE CARD	" "	
TEMP.		" "	
PATT.		" "	

TITLE: PHYS. MODEL ARC LAMP FORK SUPP.

H. G. FISCHER & CO.
2335 WABANSIA AVE.
CHICAGO, ILL.

CAT. NO.

PART NO. 5828F

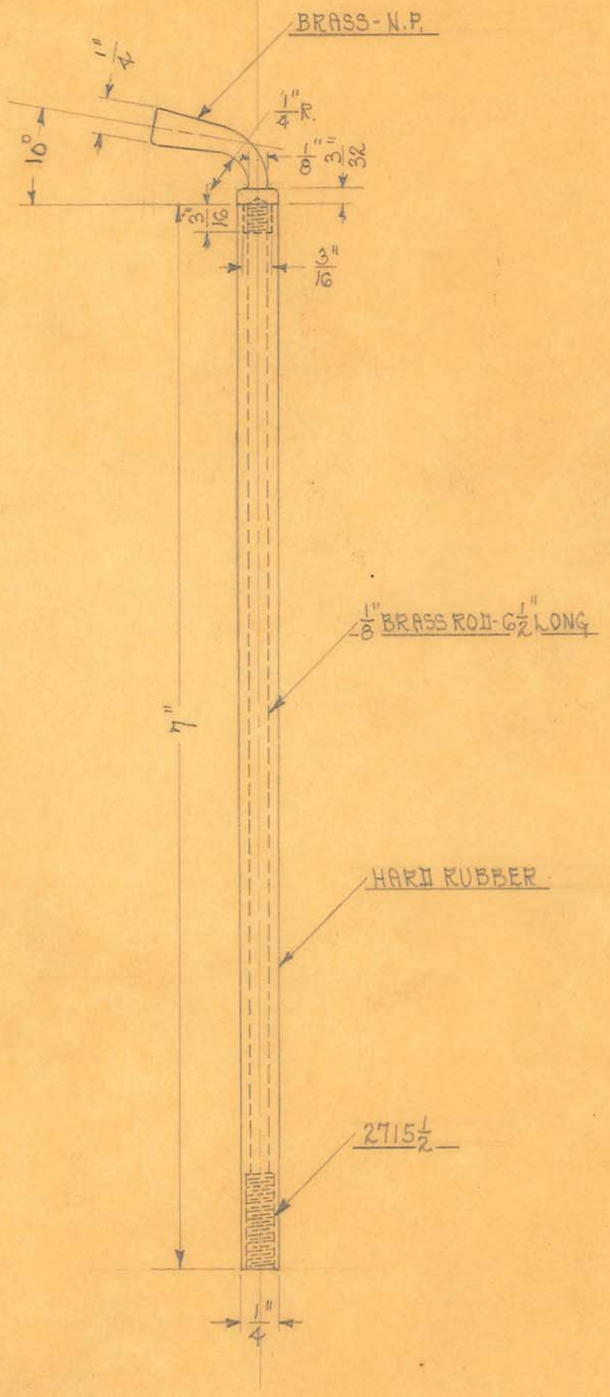

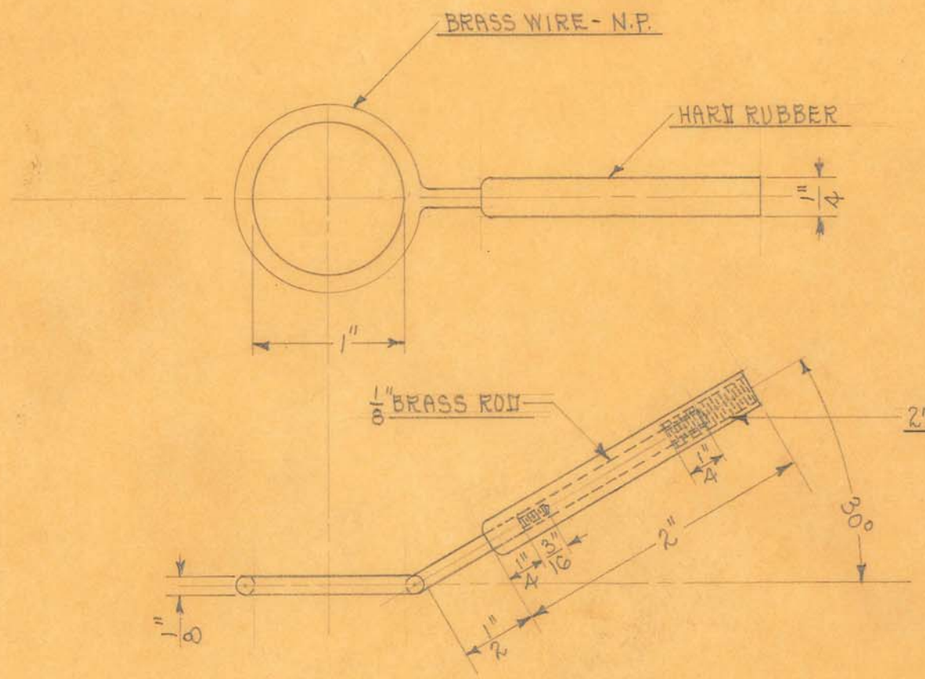

ONE 3/4" INSIDE DIAM. OF LOOP
ONE 1" INSIDE DIAM. OF LOOP

OBSOLETE

SIZE		ISSUE 10-29-31	A.E.	TITLE: SPECIAL COAG. ELECTRODES FOR DR. LURIE
KIND		CHANGED		
SHAPE		" "		
FINISH		" "		
TEMP.		" "		H. G. FISCHER & CO. 2335 WABANSIA AVE. CHICAGO, ILL. — CAT. NO. — PART NO. S120
PATT.		" "		

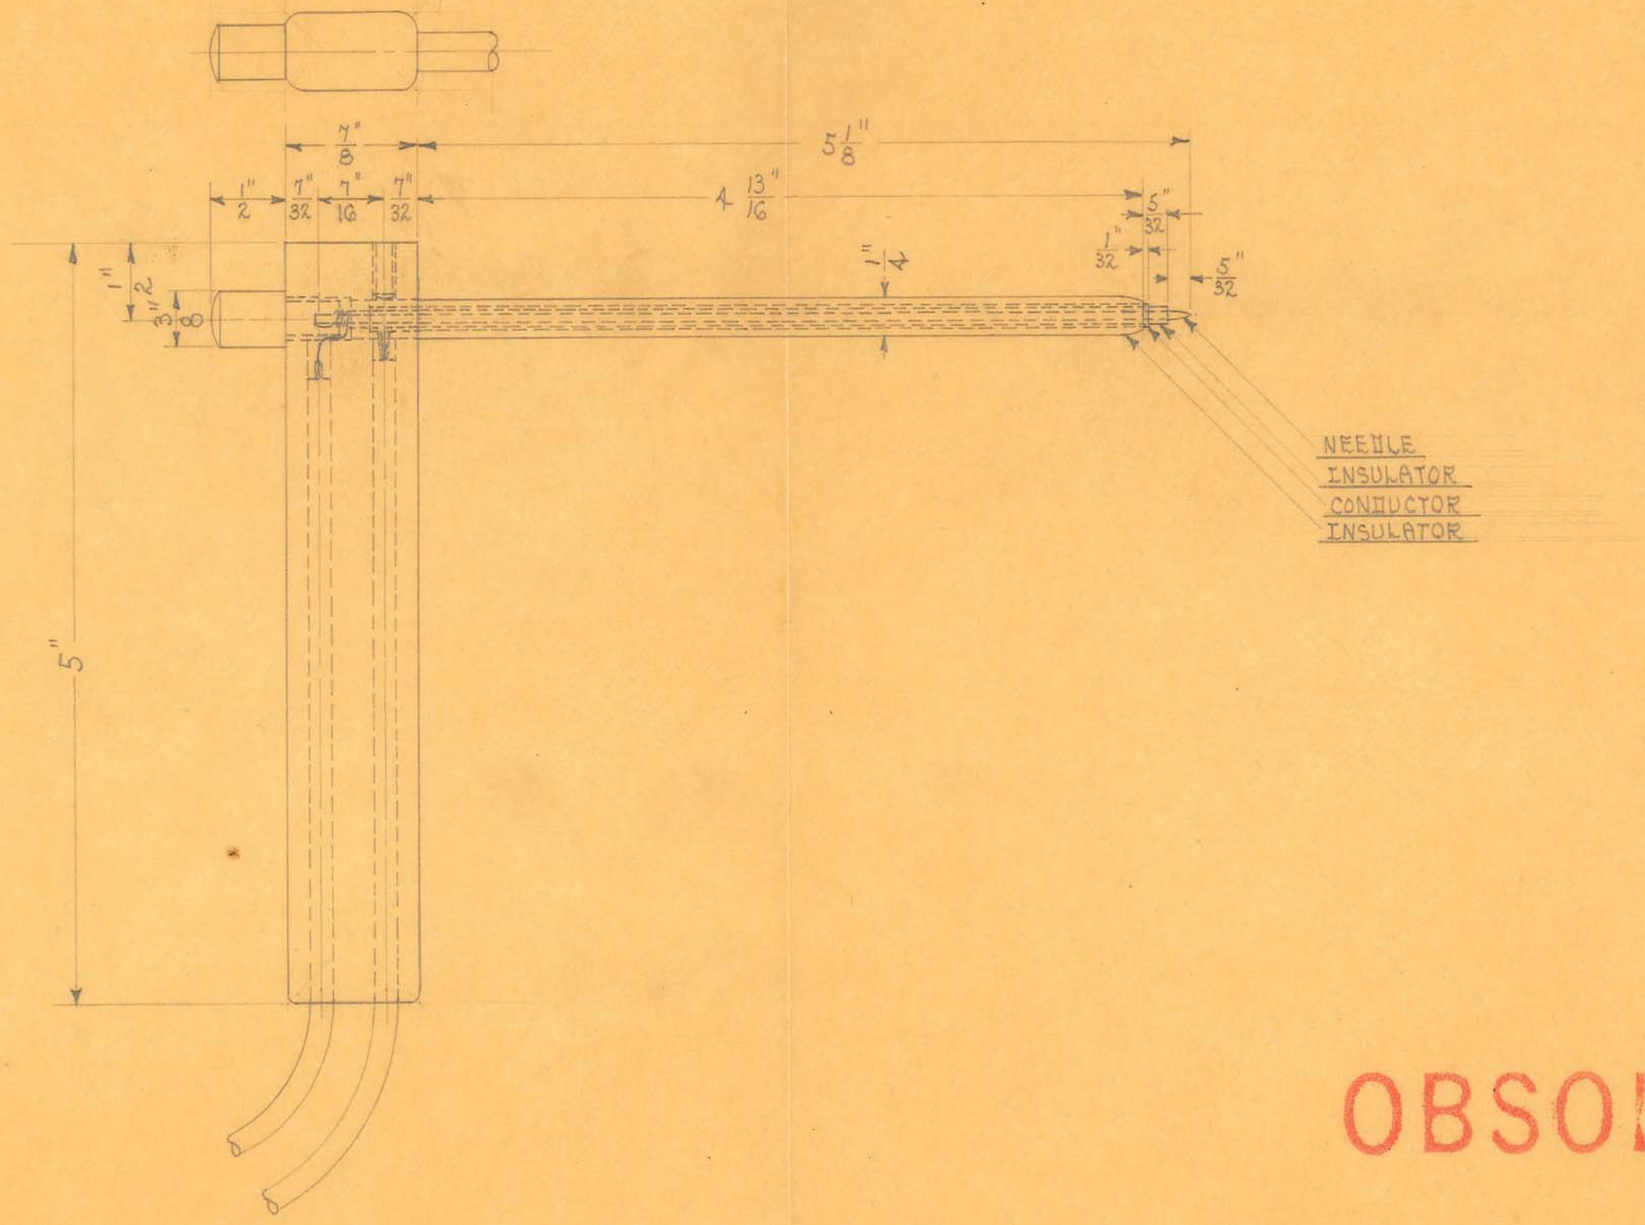

OBSOLETE

SIZE		ISSUE 10-2-31	A.E.	TITLE: SPECIAL BIACTIVE ELECTRODE
KIND		CHANGED		
SHAPE		" "		
FINISH		" "		
TEMP.		" "		H. G. FISCHER & CO. 2335 WABANSIA AVE. CHICAGO, ILL. — CAT. NO. — PART NO. 5119
PATT.		" "		

OBSOLETE

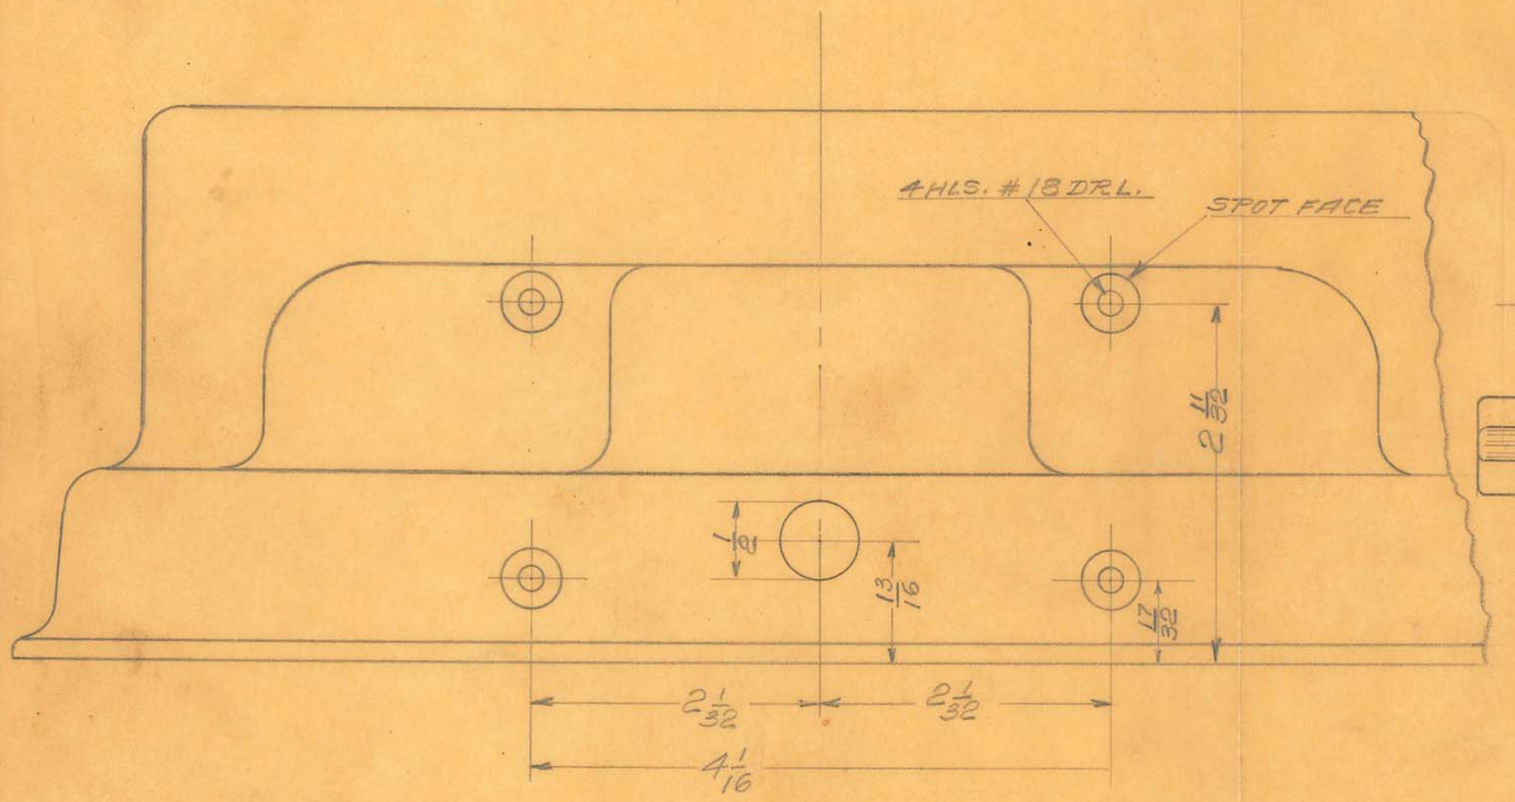

LAYOUT OF HOLES FOR POLARITY SWITCH
ON CALV. GENERATOR.

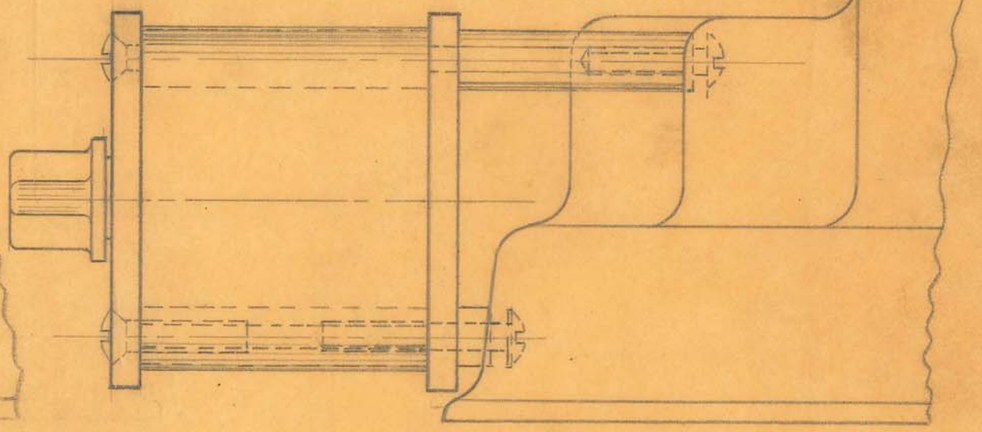

SIDE VIEW OF POLARITY SWITCH
ASSEMBLY ON CALV. GENERATOR.

OBSOLETE

SIZE		ISSUE	
KIND		CHANGED	
SHAPE		" "	
FINISH		" "	
TEMP.		" "	
PATT.		" "	

TITLE: SPECIAL CALV. GENERATOR

H. G. FISCHER & CO.
2335 WABANSIA AVE.
CHICAGO, ILL.

CAT. NO.

PART NO. S117

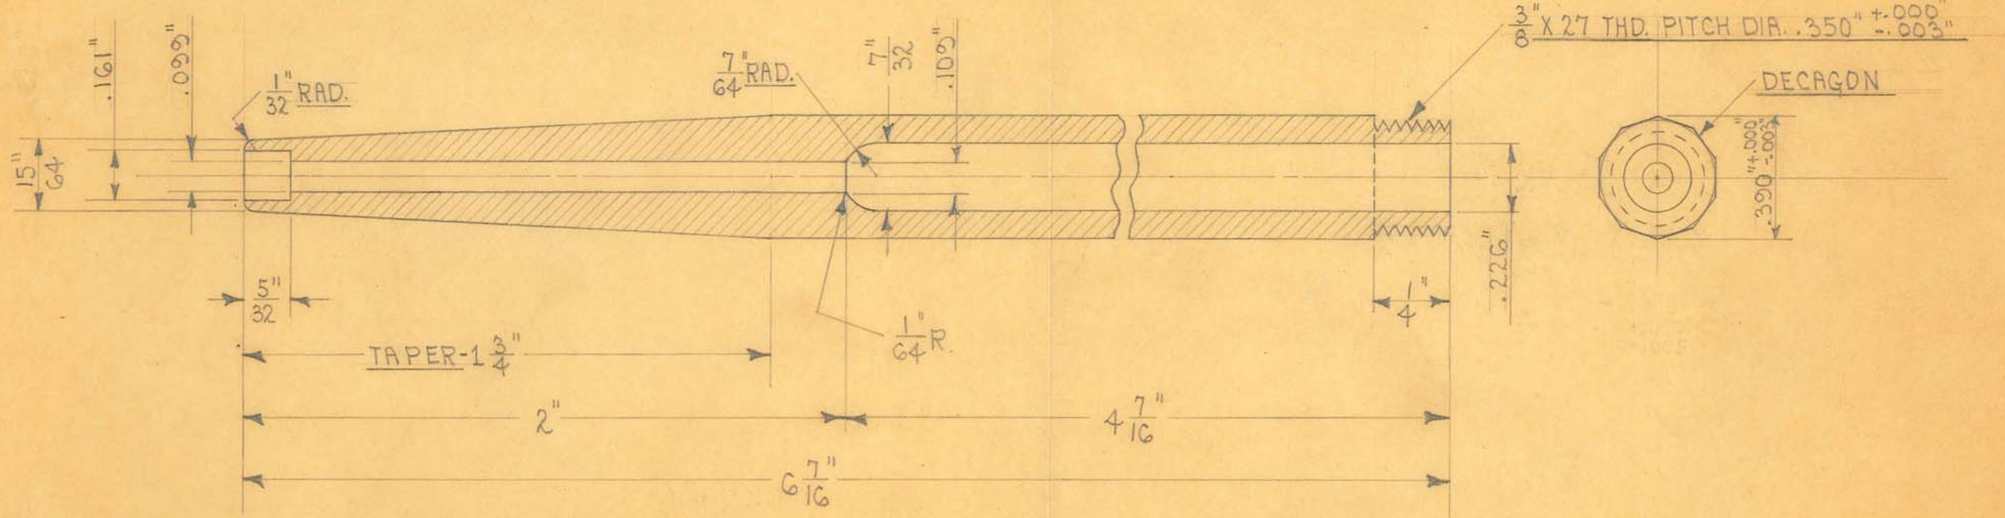

SCALE ~ 1" = 1/2"

C.M.P.C. MOLD # 1788

SIZE		ISSUE 12-18-35	A/E
KIND	MOLDED BAKELITE	CHANGED	
SHAPE	MOLD #1781	" "	
FINISH		" "	
TEMP.		" "	
PATT.		" "	

TITLE: DILLINGER HANDLE-BODY

H. G. FISCHER & CO.
2335 WABANSIA AVE.
CHICAGO, ILL.

CAT. NO.

PART NO. 2963C

DEPT

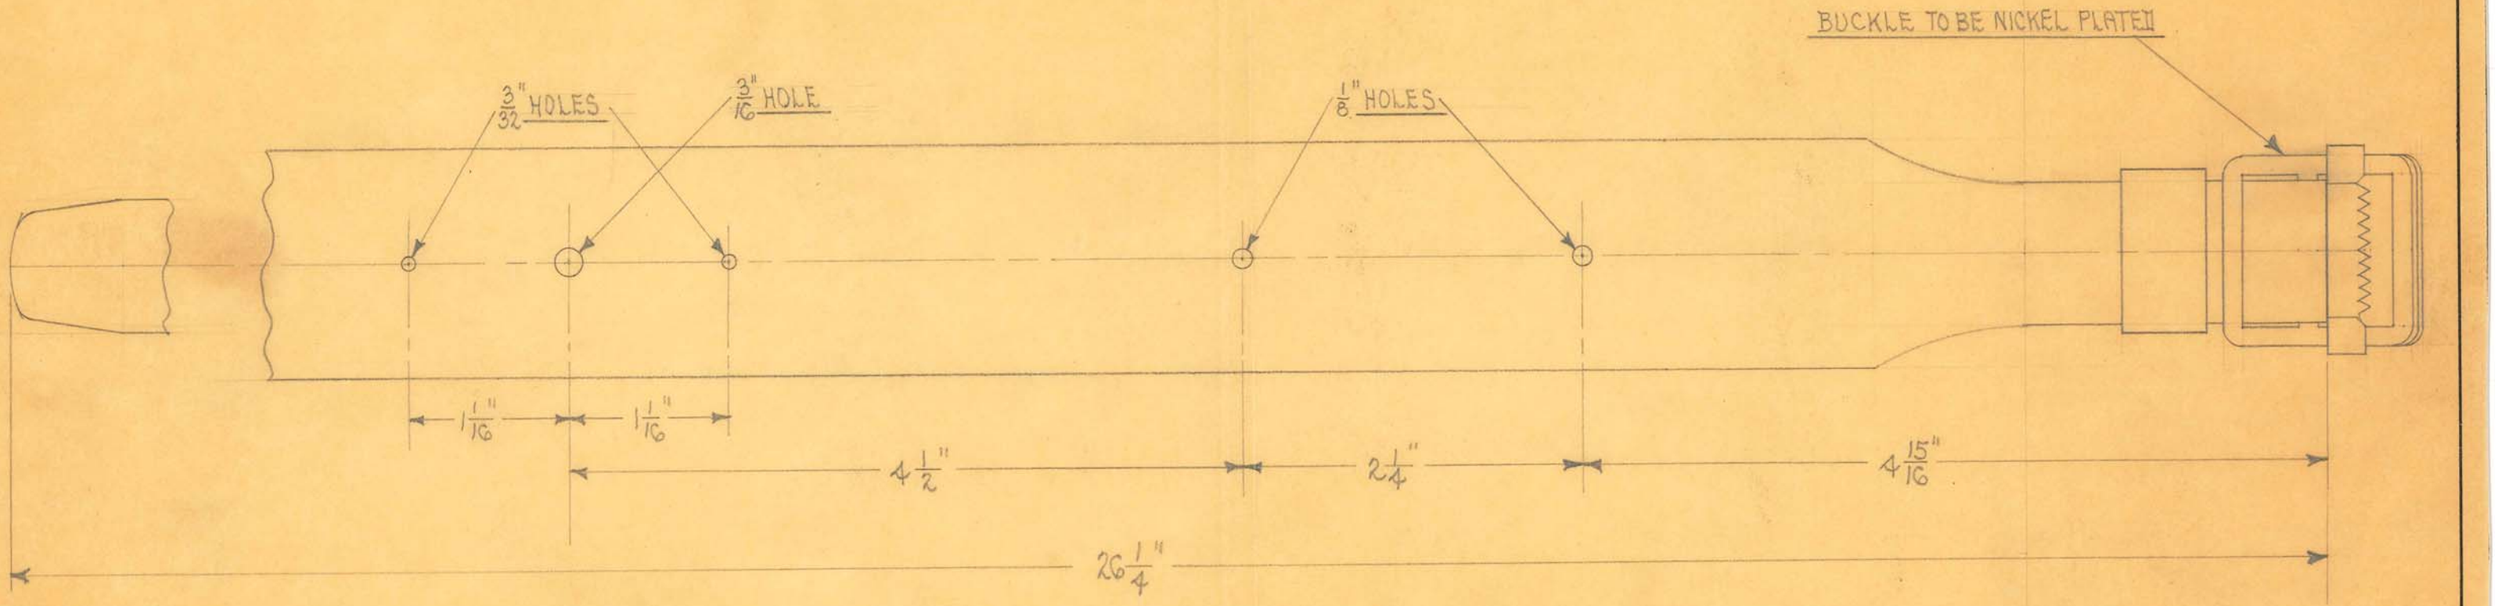

OBSOLETE

SIZE		ISSUE 4-13-32	H.E.	TITLE: HOLLANDER & COTTLE IONIZATION EL. HEAD BAND
KIND		CHANGED		
SHAPE		" "		
FINISH		" "		
TEMP.		" "		H. G. FISCHER & CO. 2335 WABANSIA AVE. CHICAGO, ILL. — CAT. NO. — PART NO. 3890
PATT.		" "		

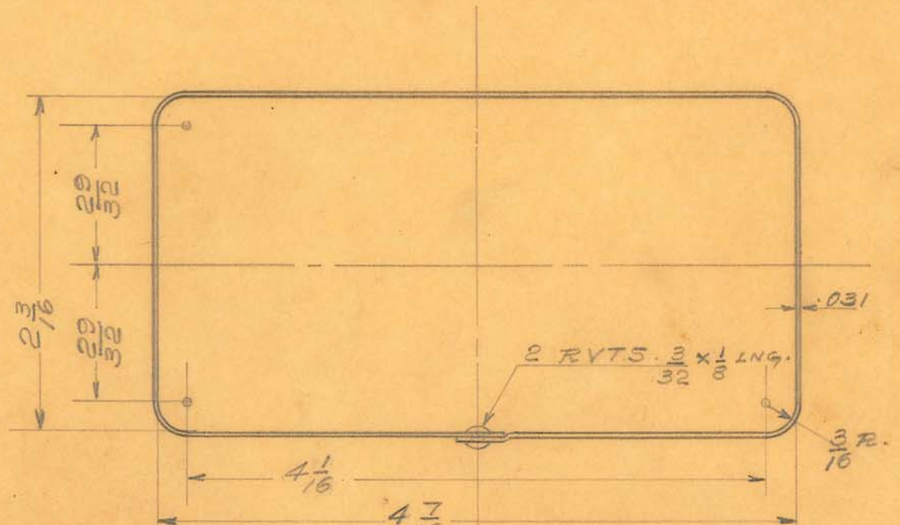

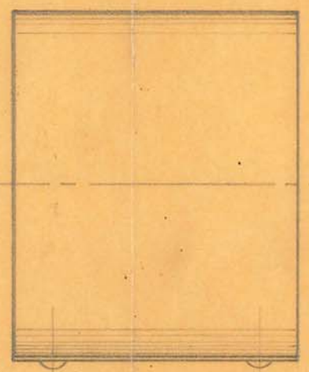

DEVELOPED BLANK

1 REQ.

SCALE FULL SIZE

OBSOLETE

SIZE		ISSUE 1-22-31	FHL.
KIND		CHANGED	
SHAPE		" "	
FINISH		" "	
TEMP.		" "	
PATT.		" "	

TITLE: SPECIAL CALV. GENERATOR POLARITY SWITCH COVER

H. G. FISCHER & CO.
2335 WABANSIA AVE.
CHICAGO, ILL.

CAT. NO.

PART NO. 5117

PCE. #6751

PCE. #6752

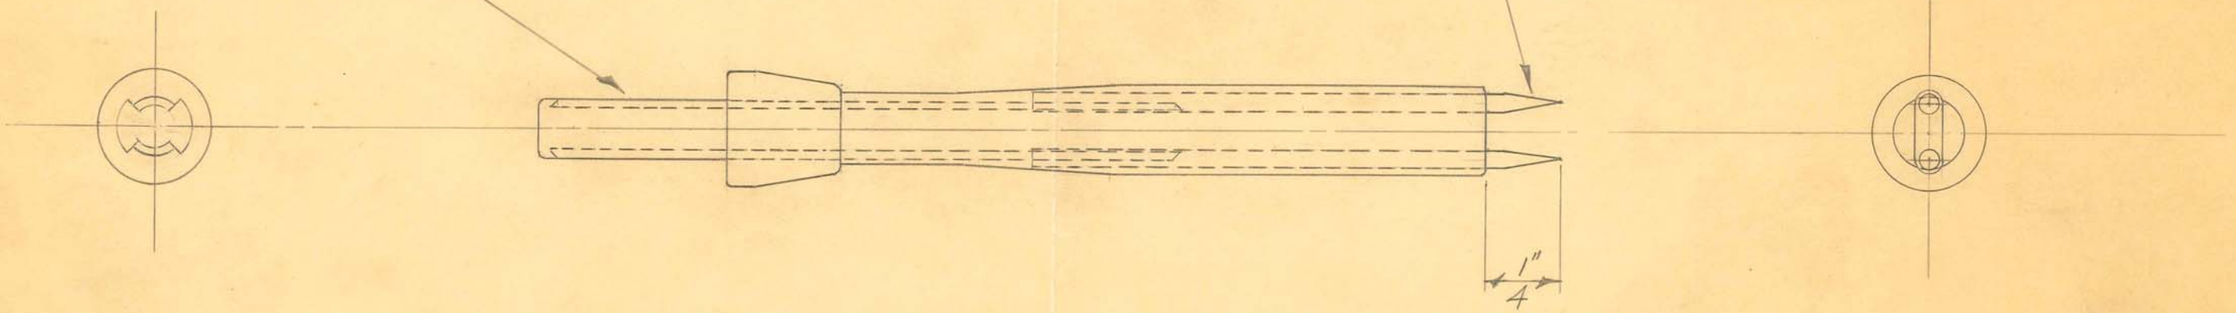

1-REQUIRED

SCALE 2 X SIZE

OBSOLETE

SIZE		ISSUE 9-18-47	J.M.F	TITLE: FISCHER BIPOLAR PUNCTURE ELECTRODE TIP
KIND		CHANGED		
SHAPE		"		
FINISH		"		
TEMP.		"		
PATT.		"		

H. G. FISCHER & CO.
2335 WABANSIA AVE.
CHICAGO, ILL.

CAT. NO.

PART NO. 6760 GF

FULL SIZE SECTN.
ON LINE A-A

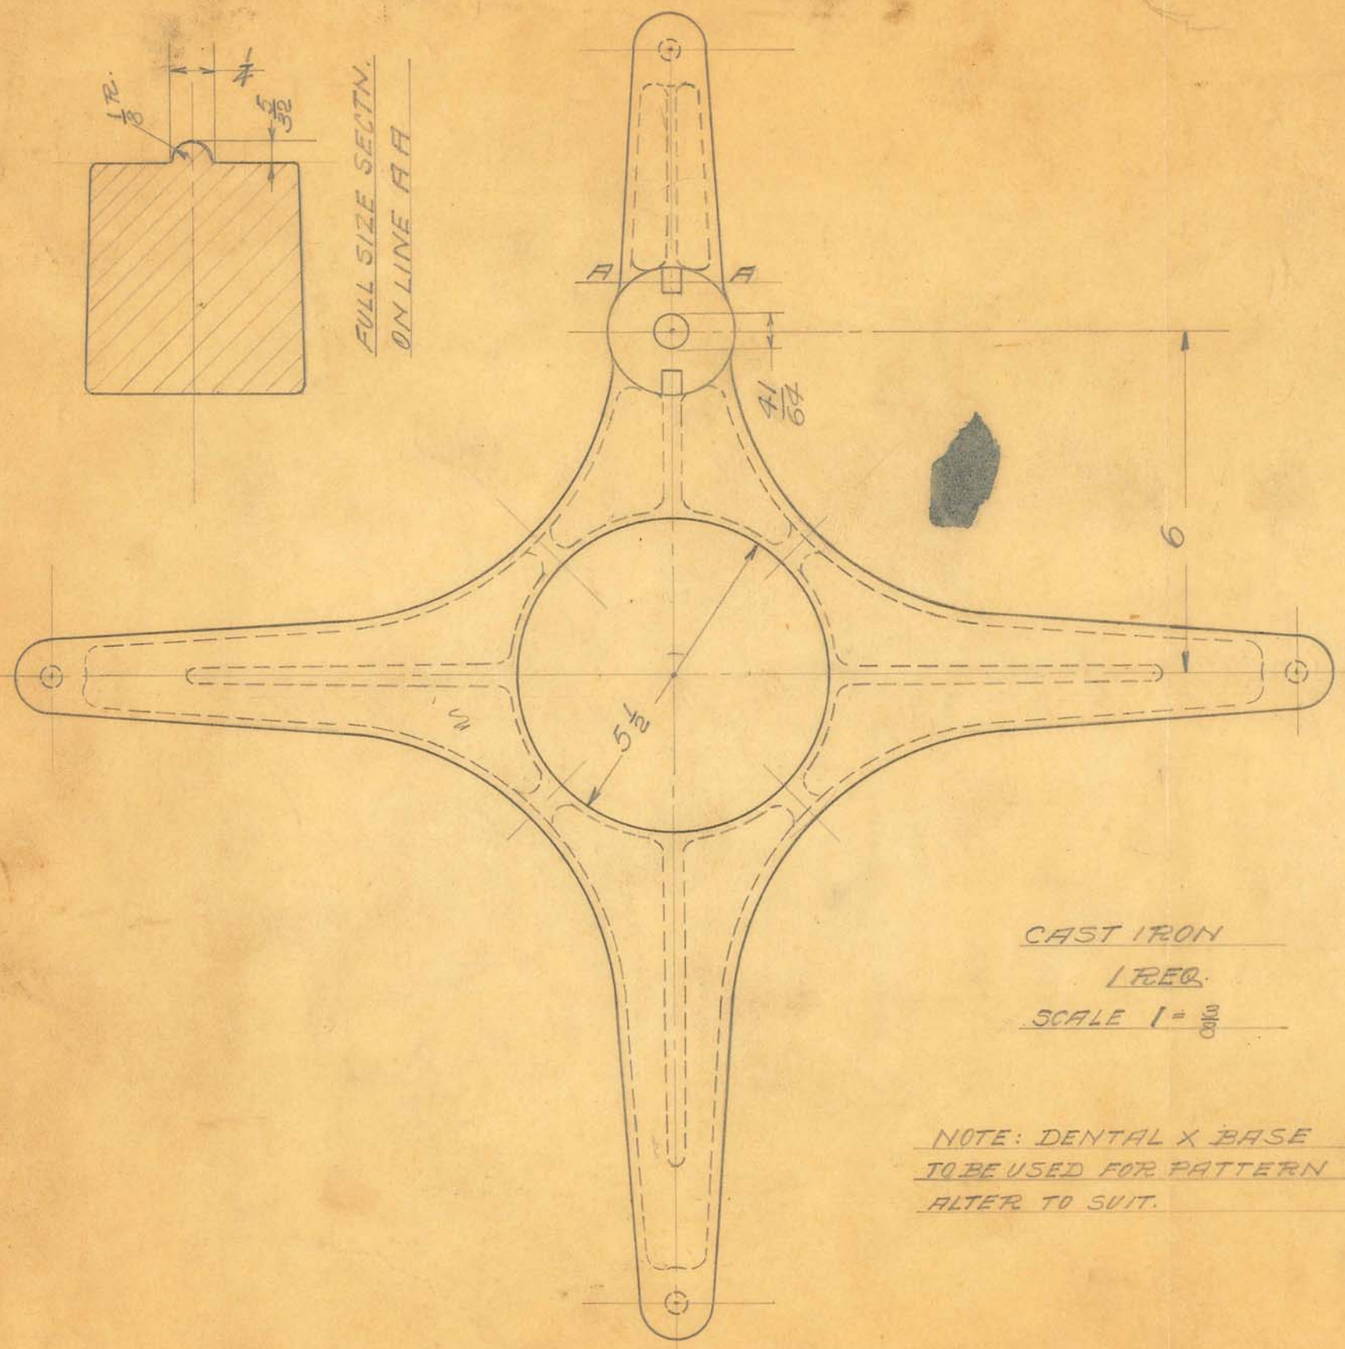

CAST IRON
1 REQ.
SCALE 1 = 3/8

NOTE: DENTAL X BASE
TO BE USED FOR PATTERN
ALTER TO SUIT.

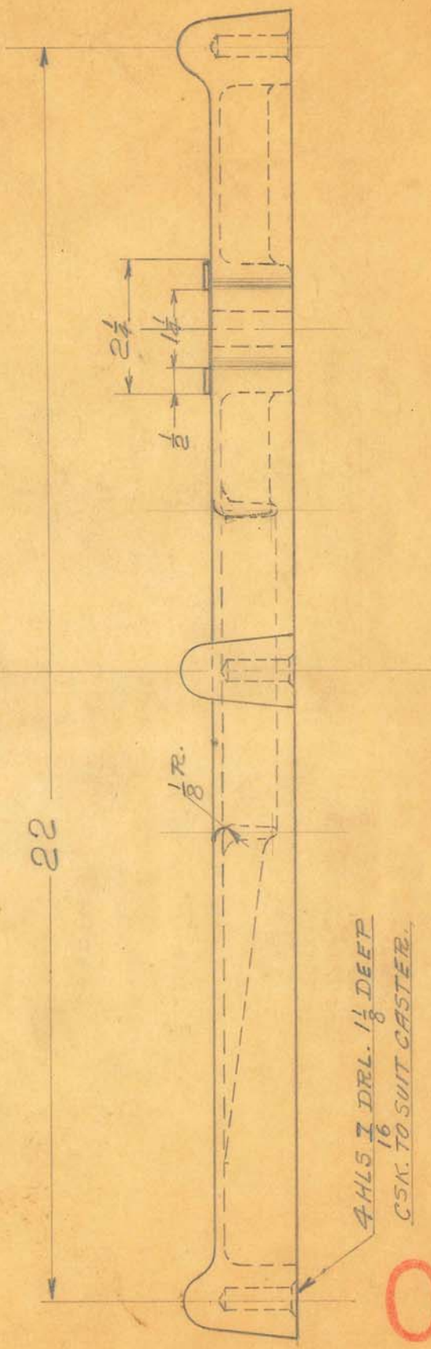

OBSOLETE

SIZE		ISSUE 10-13-30	C.H.L.
KIND		CHANGED	
SHAPE		" "	
FINISH	W. ENL. V.	" "	
TEMP.		" "	
PATT.		" "	

TITLE: COLONIC IRRIGATOR. BASE

H. G. FISCHER & CO.
2335 WABANSIA AVE.
CHICAGO, ILL.

CAT. NO.

PART NO. G551F

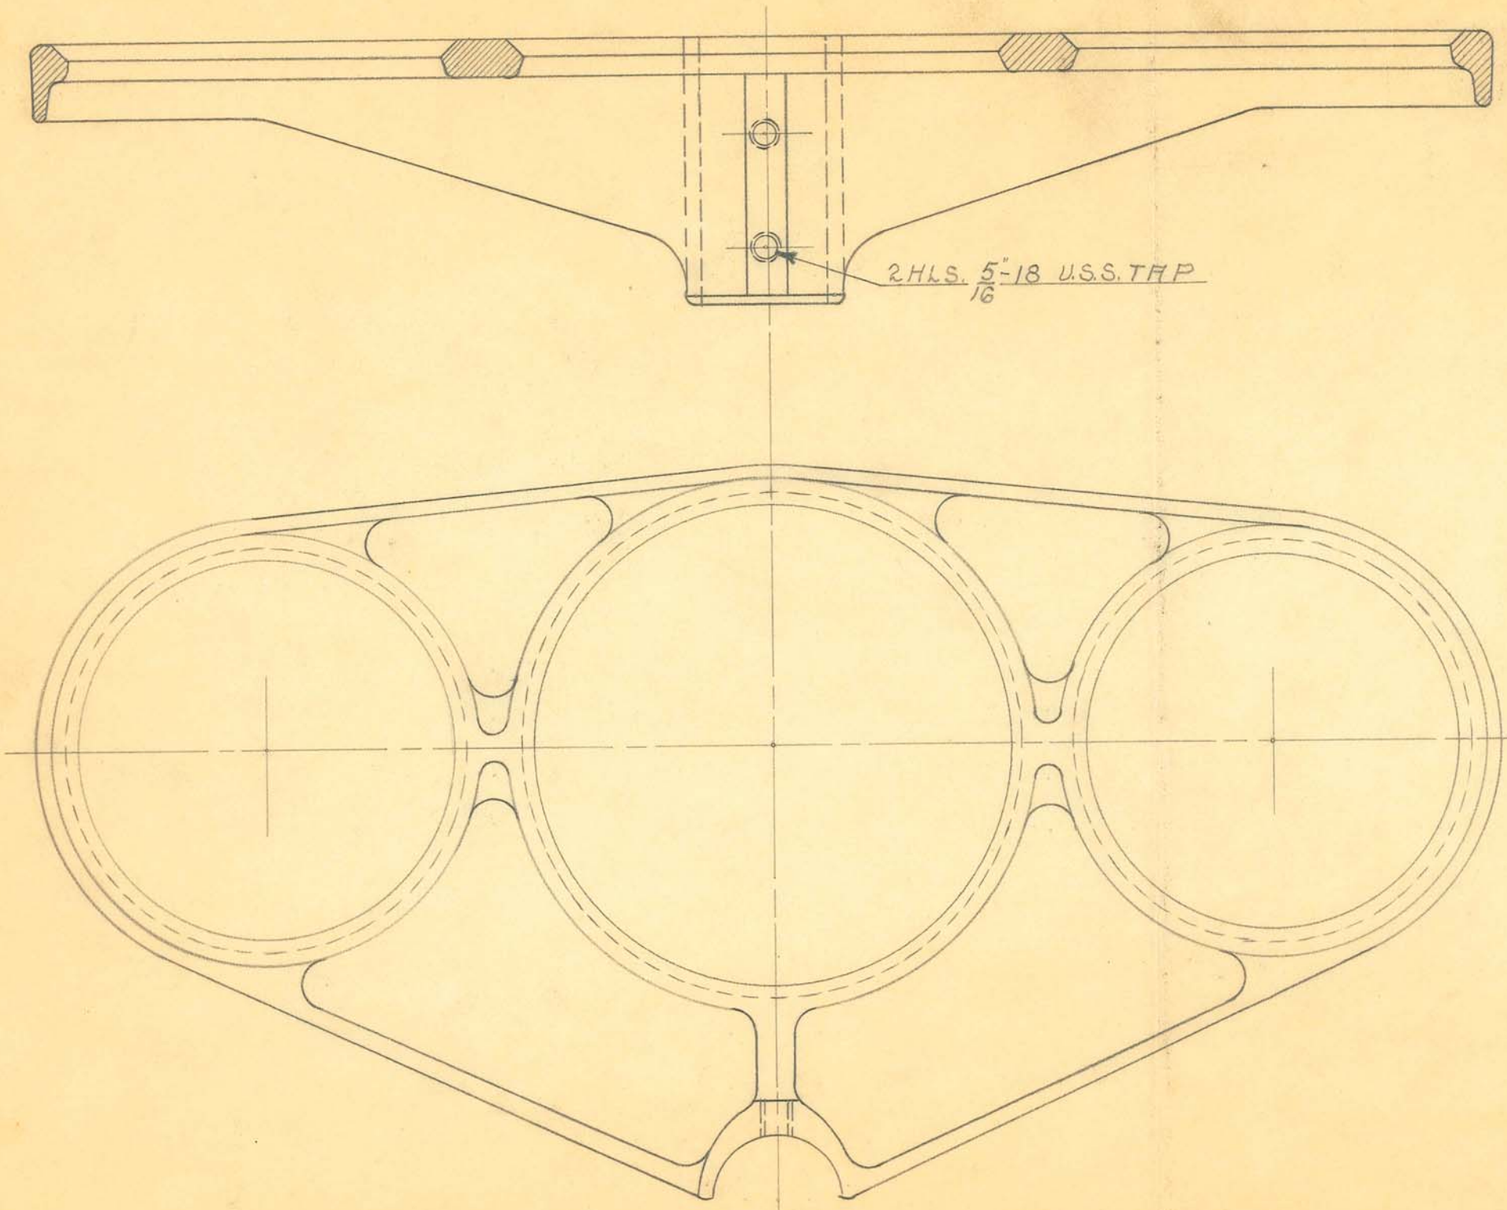

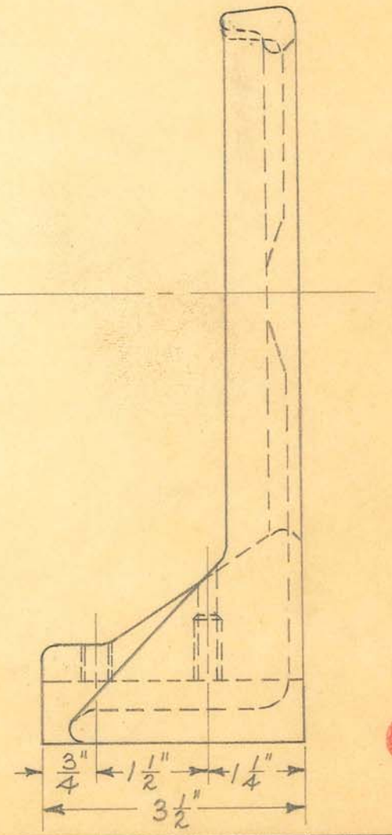

OBSOLETE

CAST IRON
1 REQ.
SCALE HALF SIZE

SIZE		ISSUE 10-10-30	C.M.
KIND		CHANGED	
SHAPE		" "	
FINISH	W. ENAMEL	" "	
TEMP.		" "	
PATT.		" "	

TITLE: COLONIC IRRIGATOR
PERCOLATOR SUPPORT

H. G. FISCHER & CO.
2335 WABANSIA AVE.
CHICAGO, ILL.

CAT. NO.

PART NO. G552F

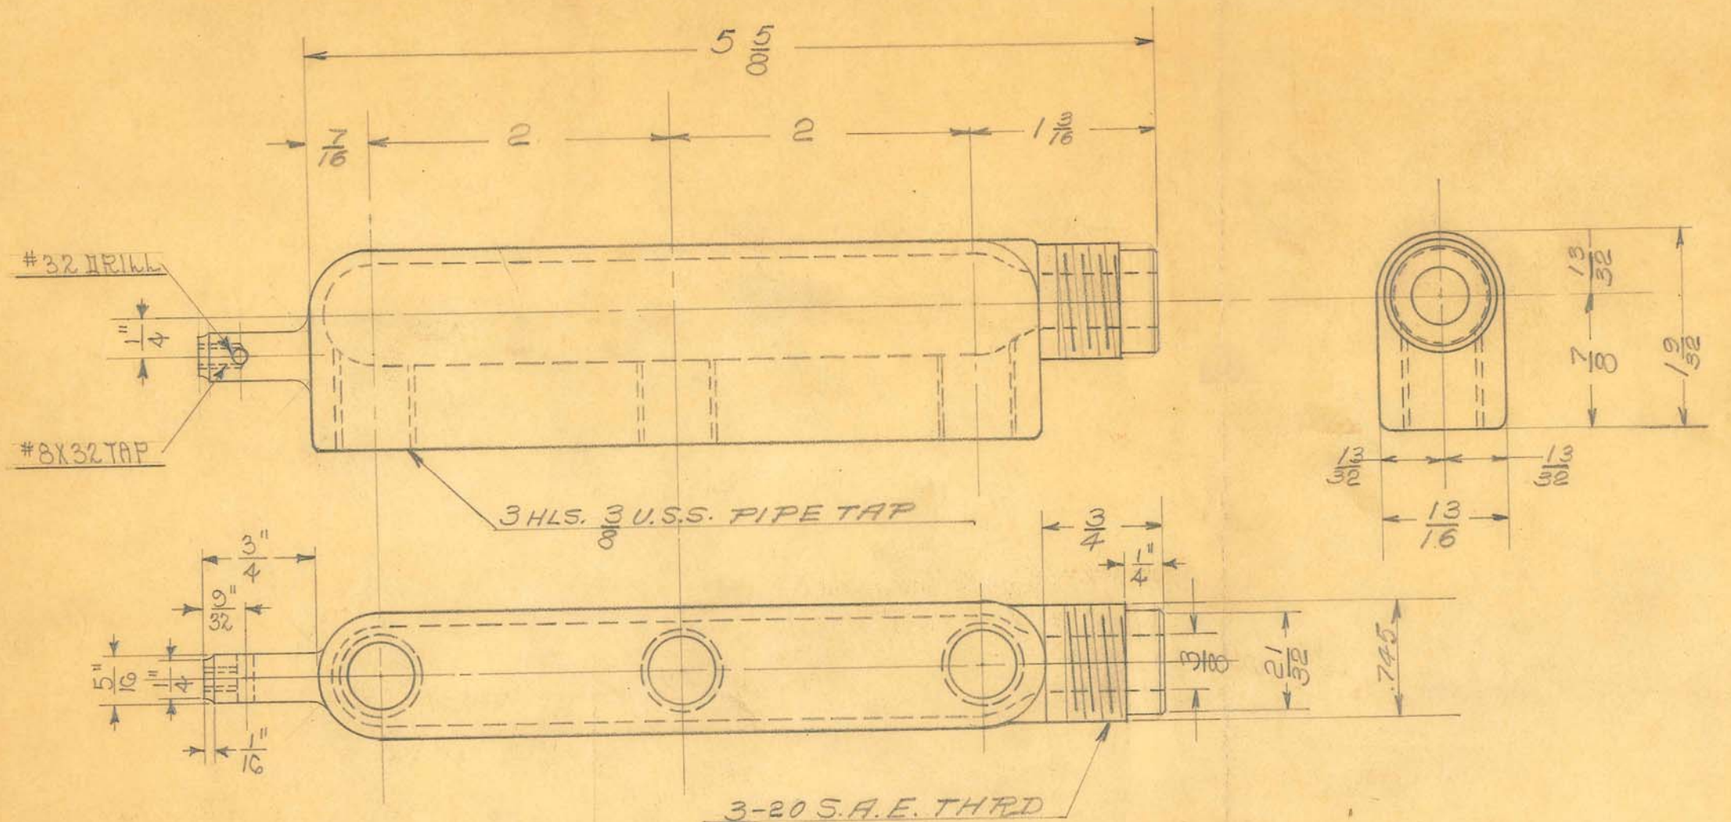

BRASS CASTING
1 REQ.
SCALE FULL SIZE

OBSOLETE

SIZE		ISSUE 12-9-30	C.H.
KIND		CHANGED 11-5-32	H.G.
SHAPE		" "	
FINISH	CHROM. PLATE	" "	
TEMP.		" "	

TITLE: COLONIC IRRIGATOR
VALVE HOUSING

H. G. FISCHER & CO.
2335 WABANSIA AVE.

CAT. NO.

PART NO. 6568AF

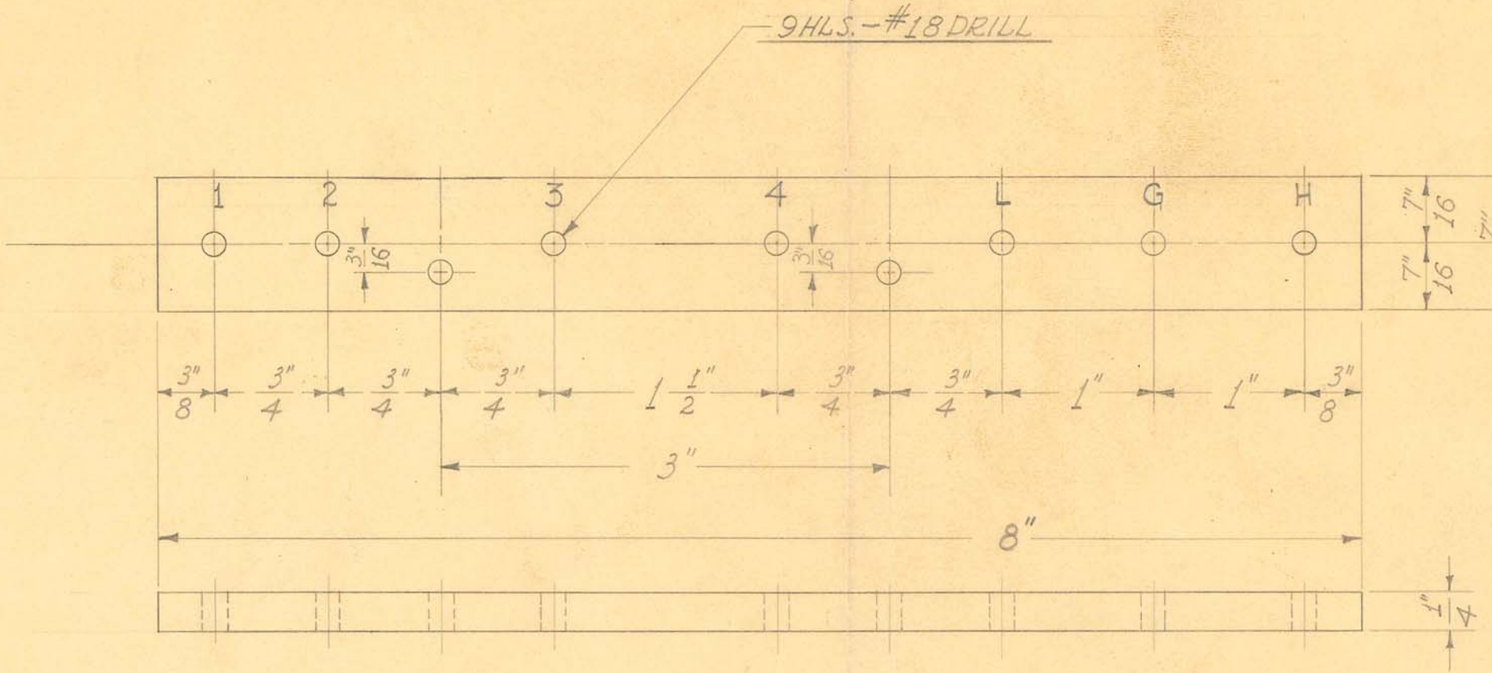

1 REQUIRED

OBSOLETE

SIZE	1/4" SHEET	ISSUE 7-19-38	J.W.	TITLE: FISCHER MOD. "K" COLD QUARTZ ULTRA VIOLET LAMP TRANSFORMER TERMINAL STRIP
KIND	BAKELITE	CHANGED 1-28-41	J.V.W.	
SHAPE		"		
FINISH		"		
TEMP.		"		
PATT.		"		

H. G. FISCHER & CO.
2335 WABANSIA AVE.
CHICAGO, ILL.

CAT. NO.

PART NO. 11872CF

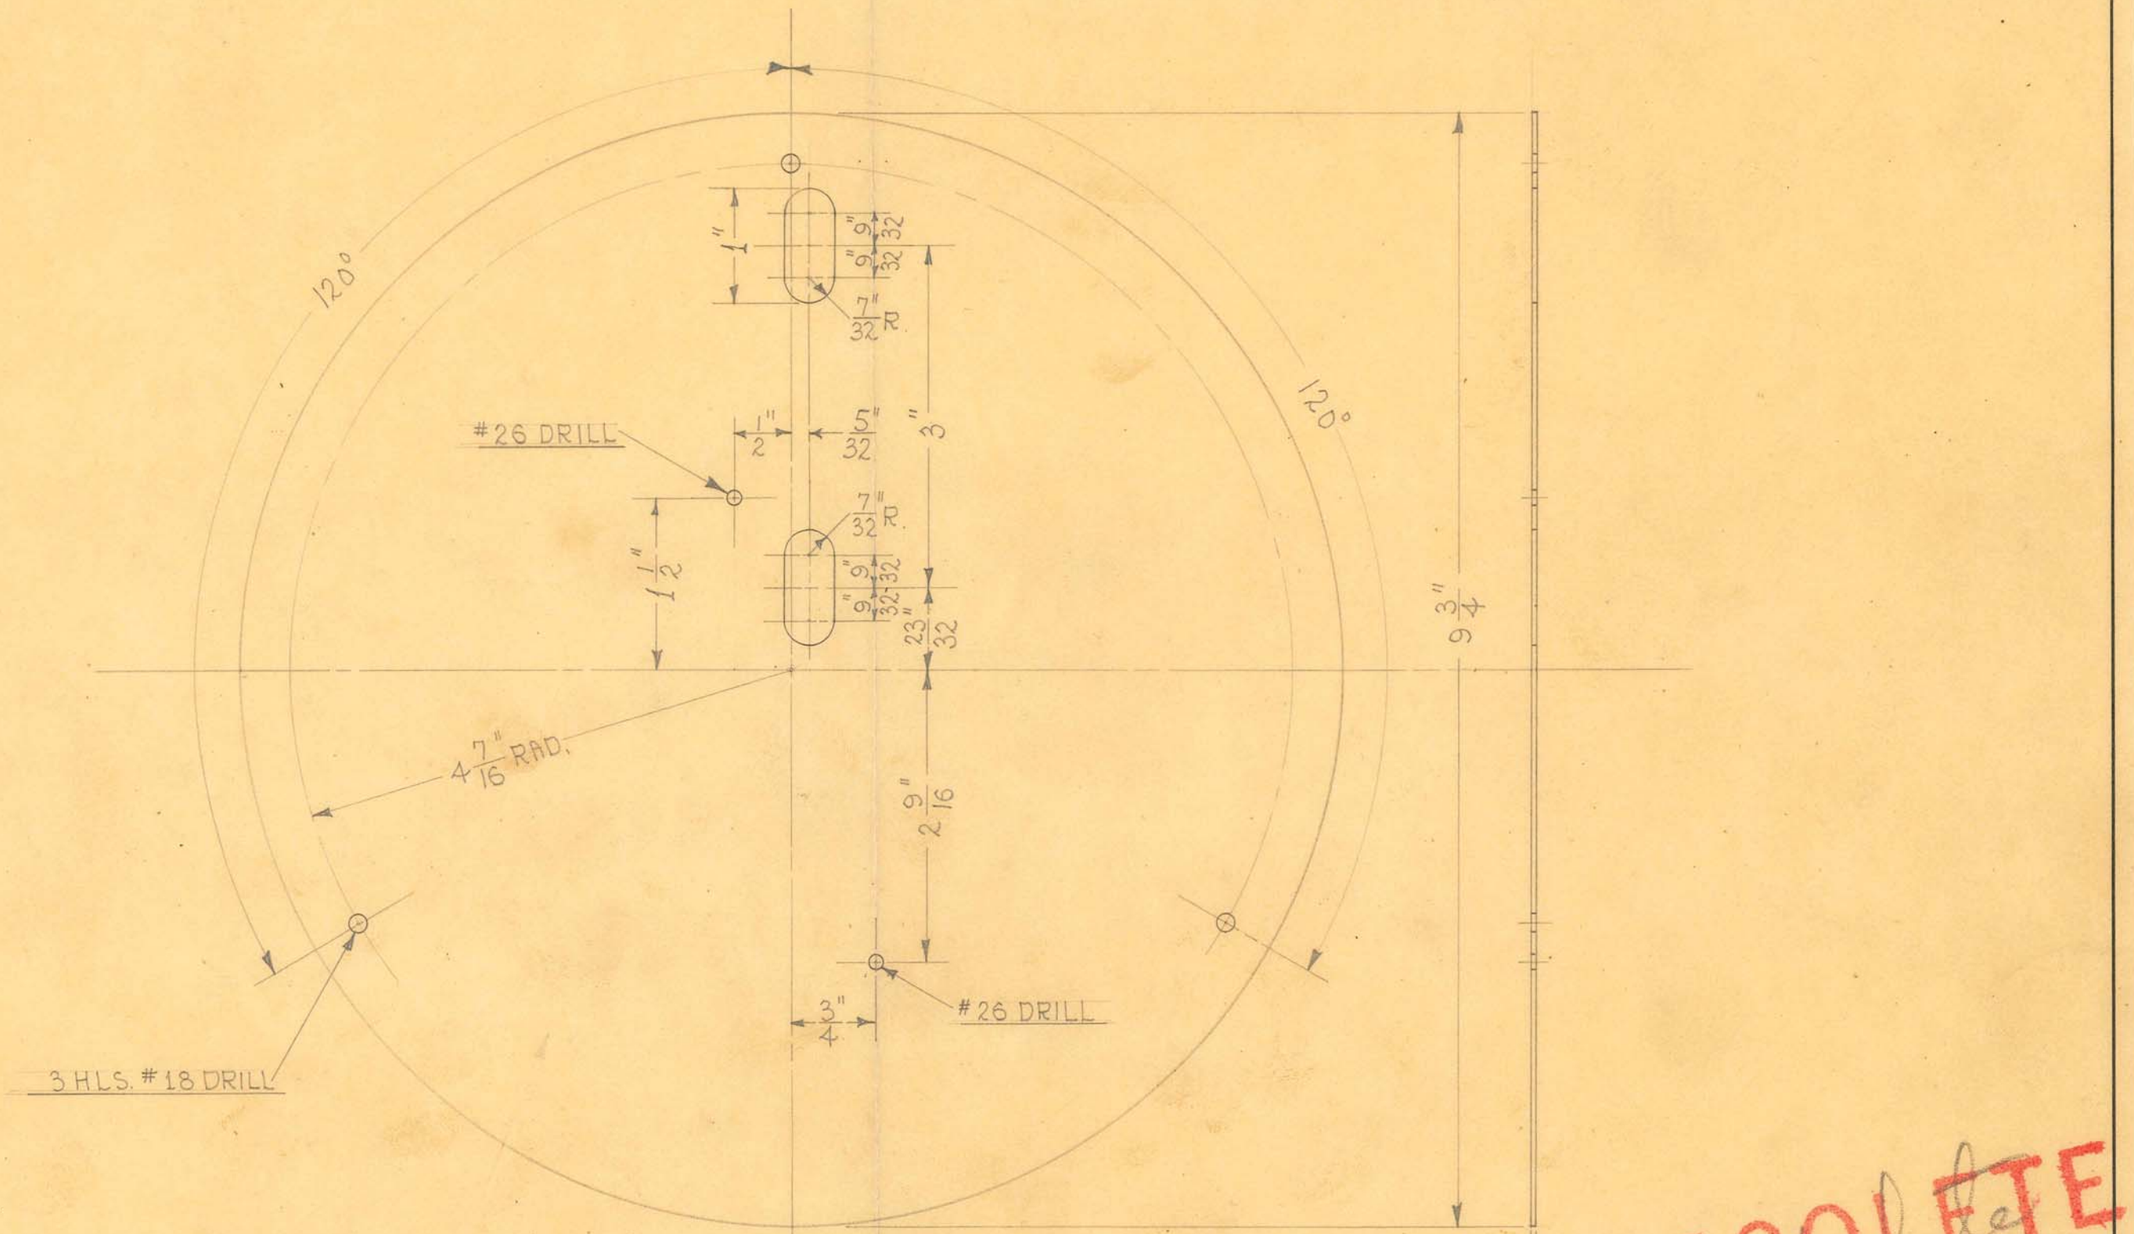

OBSOLETE

SCALE ÷ 3/4 = 1"

1 REQUIRED

SIZE	FROM	ISSUE 6-3-38	J.E.
KIND	11863	CHANGED	
SHAPE		"	
FINISH	SAL SODA	"	
~~TEMP.~~	DIP #40	"	

TITLE: FISCHER COLD QUARTZ ULTRA VIOLET LAMP-GRID BURNER MOUNTING PLATE (DRILLED)

H. G. FISCHER & CO.
2335 WABANSIA AVE.

CAT. NO.

PART NO. 11863F

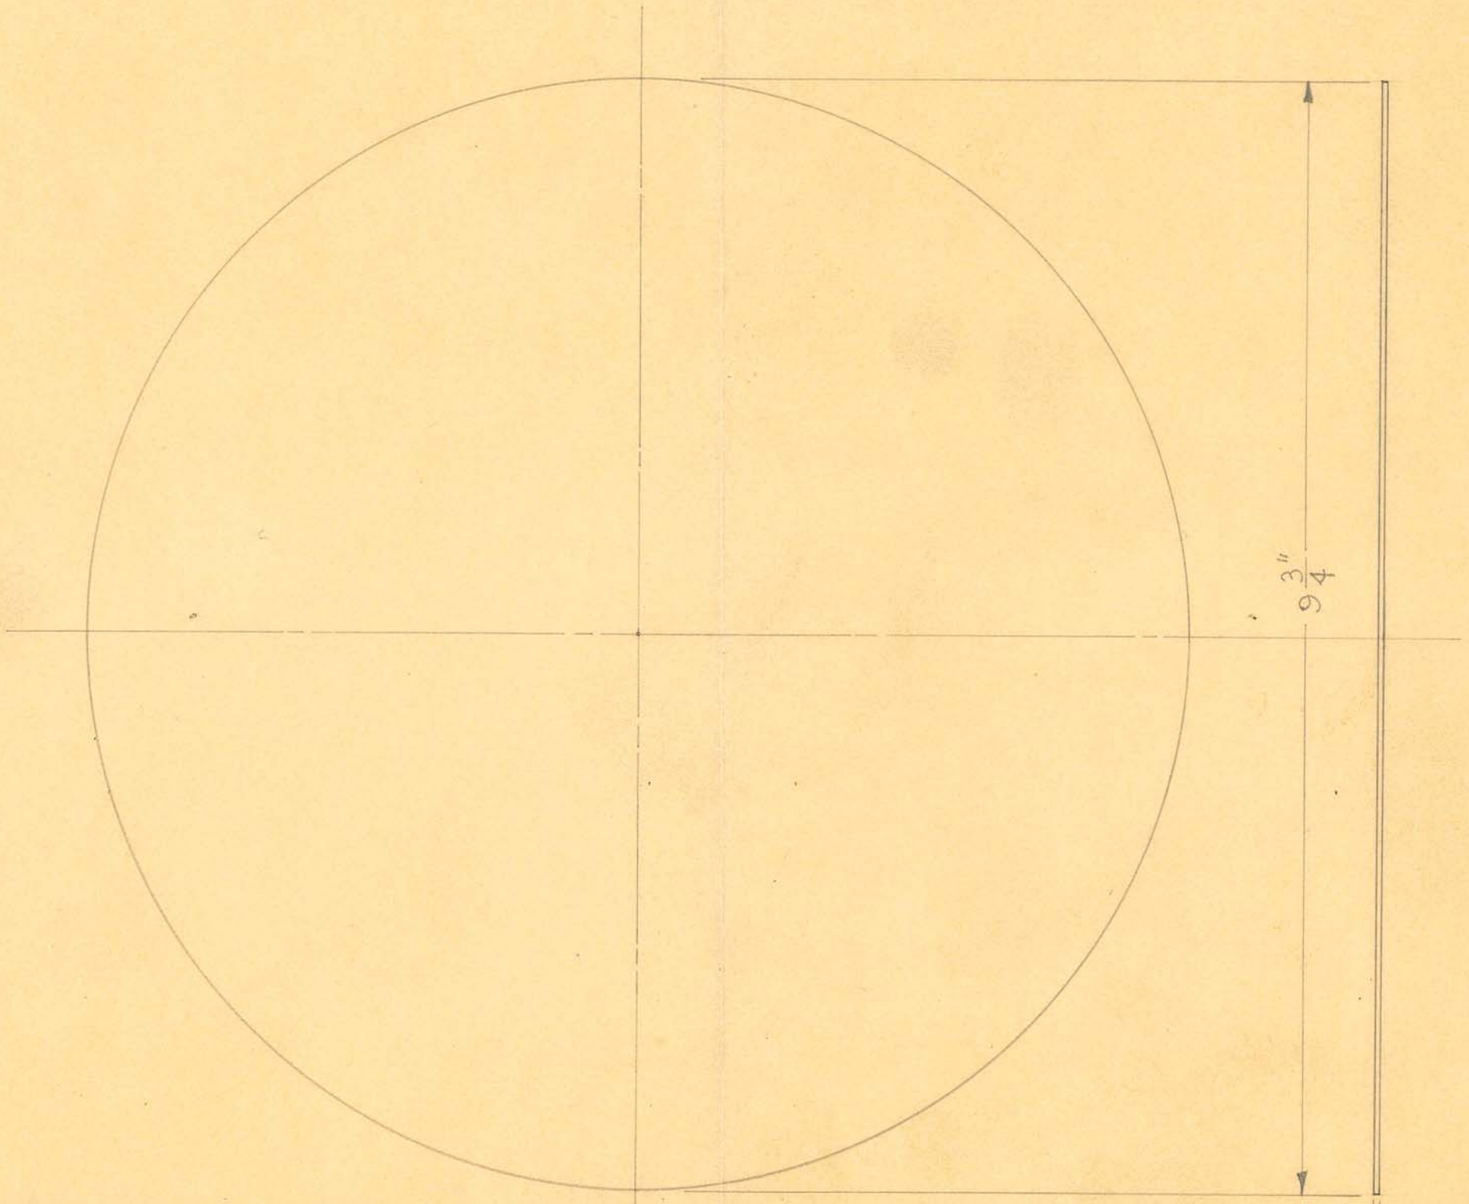

SCALE ≈ 3"/4 = 1"

1 REQUIRED

OBSOLETE

SIZE	.050"	ISSUE 7-8-38	HE.
KIND	ALUMINUM	CHANGED	
SHAPE	SHEET	"	
FINISH		"	
TEMP.		"	
PATT.		"	

TITLE:
FISCHER COLD QUARTZ ULTRA VIOLET LAMP-
GRID BURNER MOUNTING PLATE

H. G. FISCHER & CO.
2335 WABANSIA AVE.
CHICAGO, ILL.

CAT. NO.

PART NO. 11863

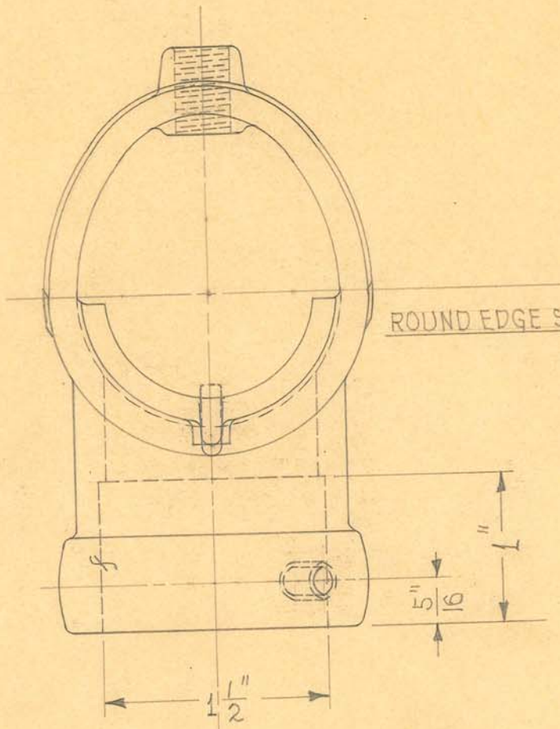

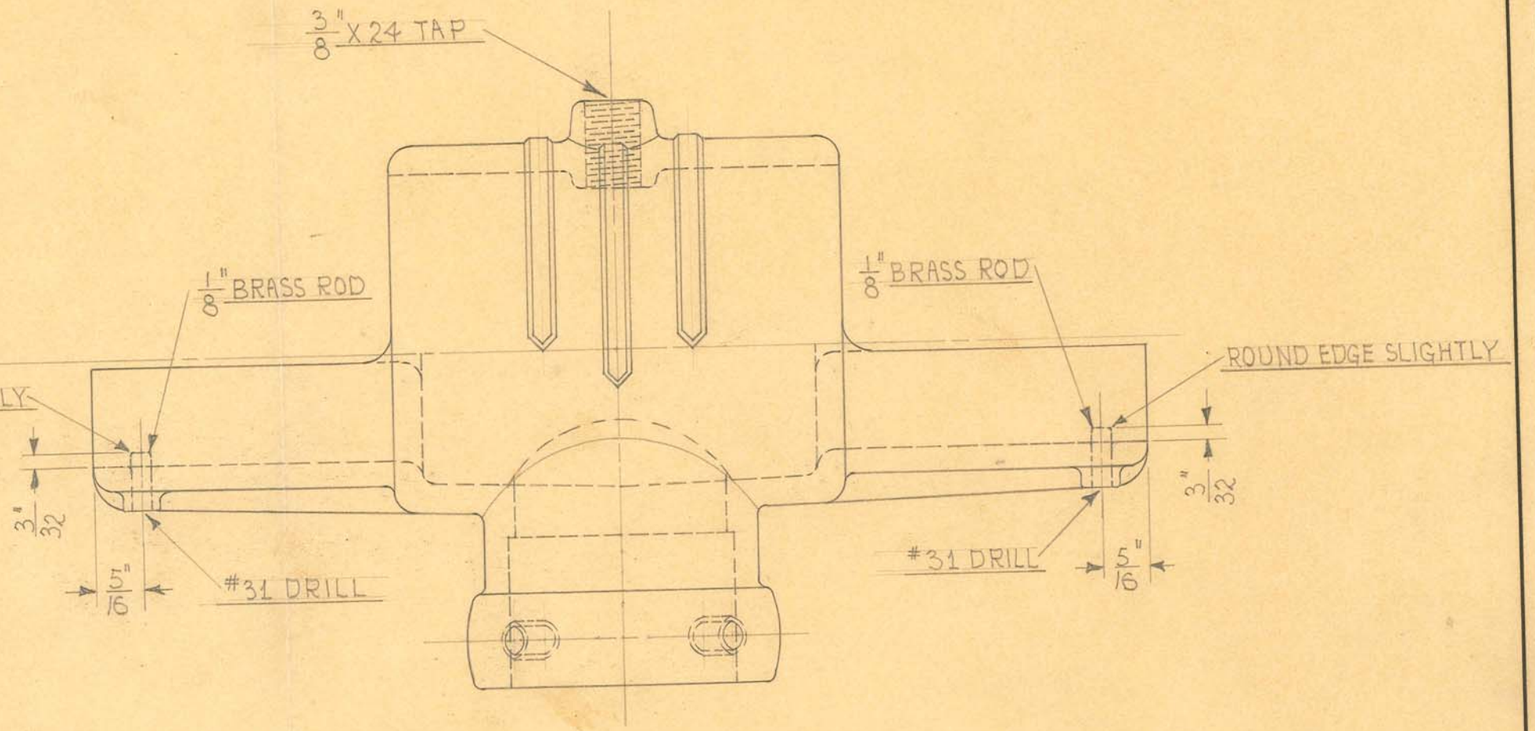

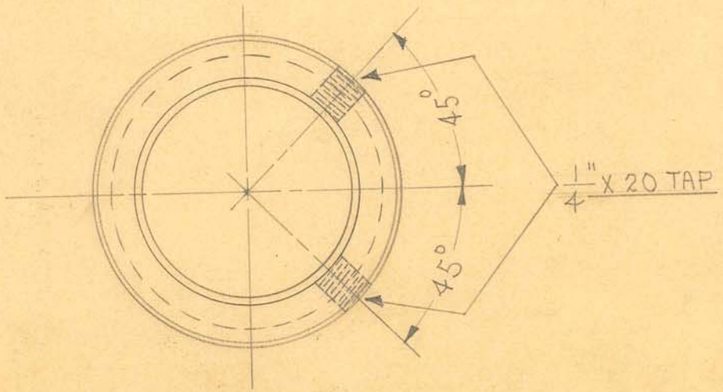

1 REQUIRED

OBSOLETE

SIZE		ISSUE 6-7-38	JE
KIND	IRON CASTING	CHANGED	
SHAPE		"	
FINISH	PAINTED	"	
TEMP.		"	
PATT.	1237	"	

TITLE: FISCHER COLD QUARTZ ULTRA VIOLET LAMP-
HORIZONTAL TUBE SUPPORT

H. G. FISCHER & CO.
2335 WABANSIA AVE.
CHICAGO, ILL.

CAT. NO.

PART NO. 11855G

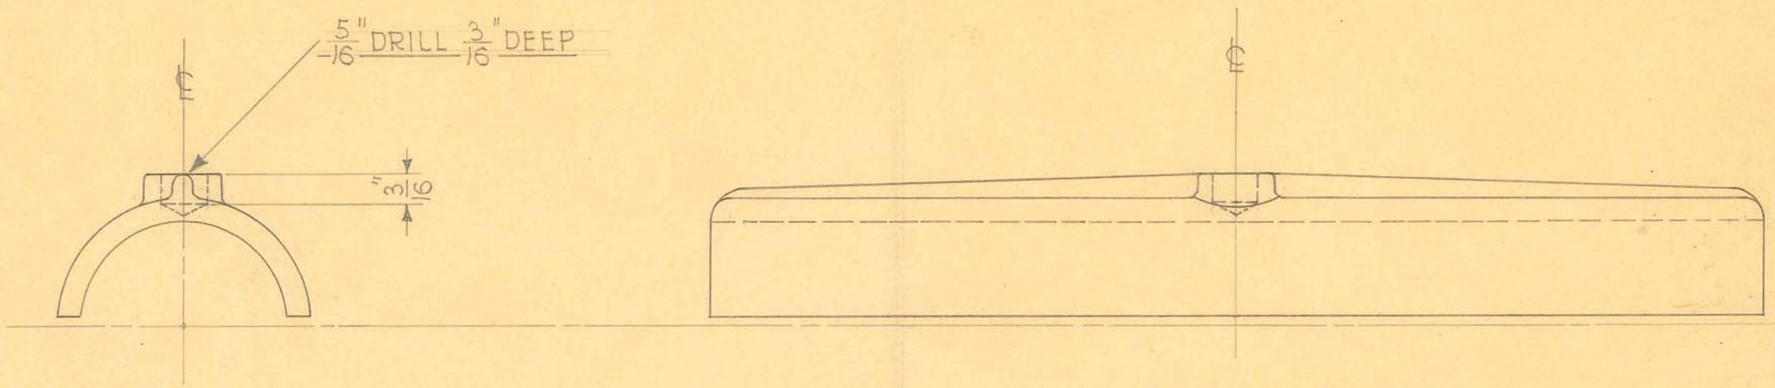

1 REQUIRED

OBSOLETE

SIZE		ISSUE 6-6-38	H.E.
KIND	IRON CASTING	CHANGED	
SHAPE		"	
FINISH	PAINTED	"	
TEMP.		"	
PATT.	1236	"	

TITLE: FISCHER COLD QUARTZ ULTRA VIOLET LAMP-
HORIZONTAL TUBE SUPPORT CLAMP

H. G. FISCHER & CO.
2335 WABANSIA AVE.
CHICAGO, ILL.

CAT. NO.

PART NO. 11854F

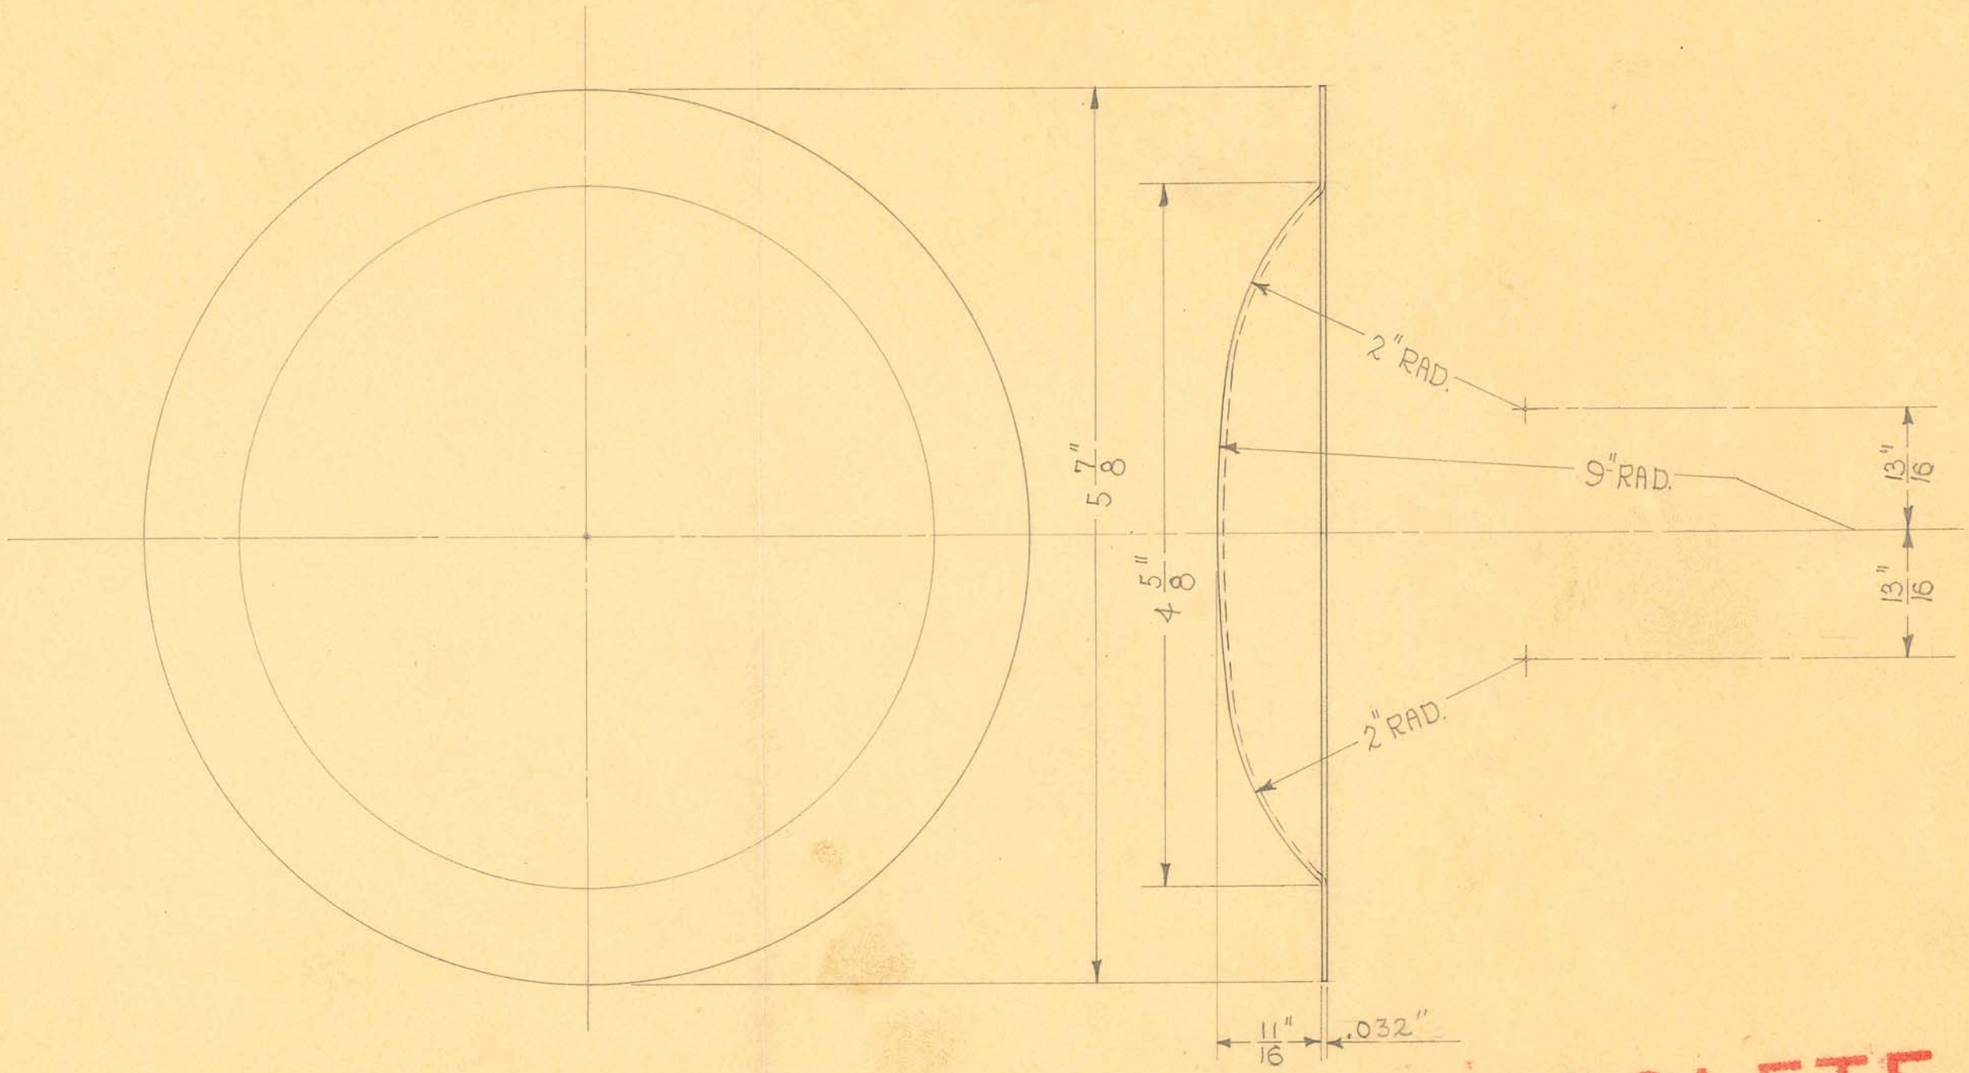

1 REQUIRED

OBSOLETE

SIZE	.032"	ISSUE 6-6-38	A.E.
KIND	ALUMINUM	CHANGED	
SHAPE	SHEET	"	
FINISH		"	
TEMP.		"	

TITLE: FISCHER COLD QUARTZ ULTRA VIOLET LAMP-
HOOD BAFFLE PLATE

H. G. FISCHER & CO.
2335 WABANSIA AVE.

CAT. NO.

PART NO. 11885

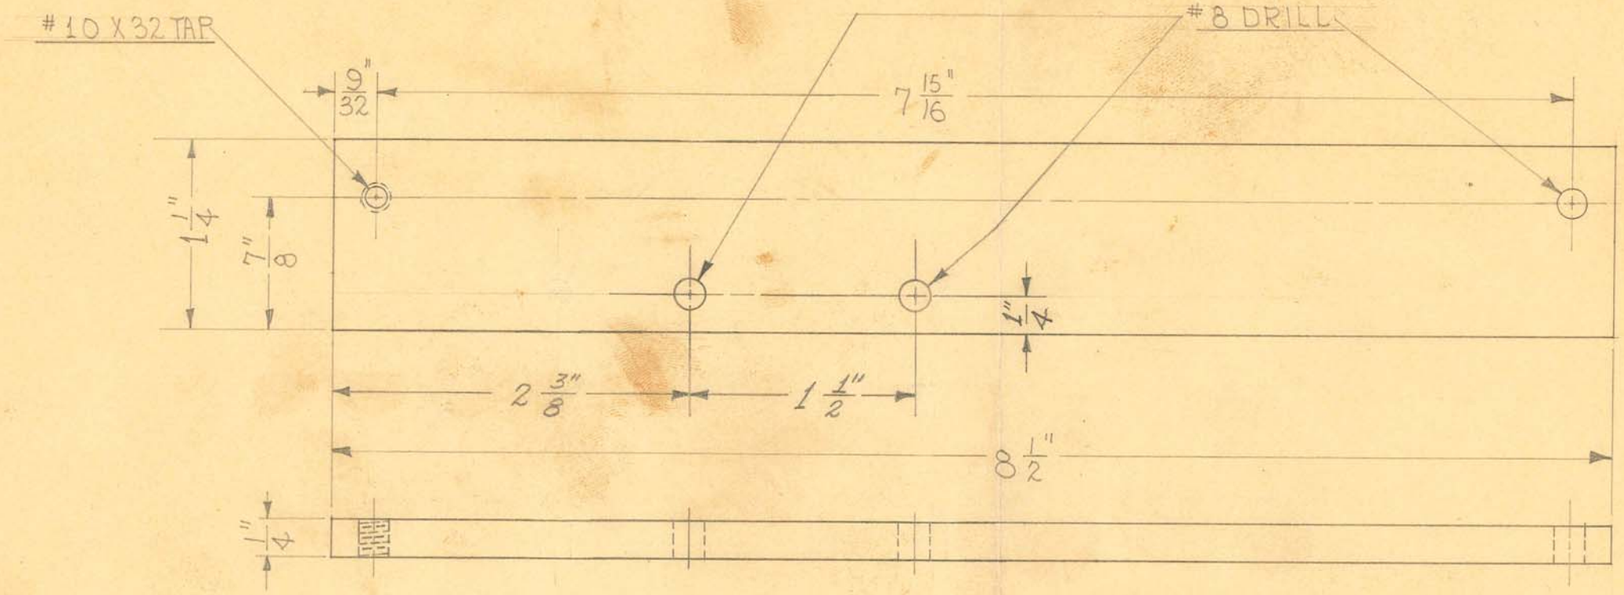

2 REQUIRED

OBSOLETE

SIZE	1¼" X ¼"	ISSUE 6-10-38	W.E.	TITLE: FISCHER COLD QUARTZ ULTRA VIOLET LAMP-TRANSFORMER MOUNTING STRIP
KIND	C.R. STEEL	CHANGED 4-24-40	J.W.	
SHAPE		"		
FINISH	BLACK #80	"		
TEMP.		"		
PATT.		"		

H. G. FISCHER & CO.
2335 WABANSIA AVE.
CHICAGO, ILL.

CAT. NO.

PART NO. 11902A

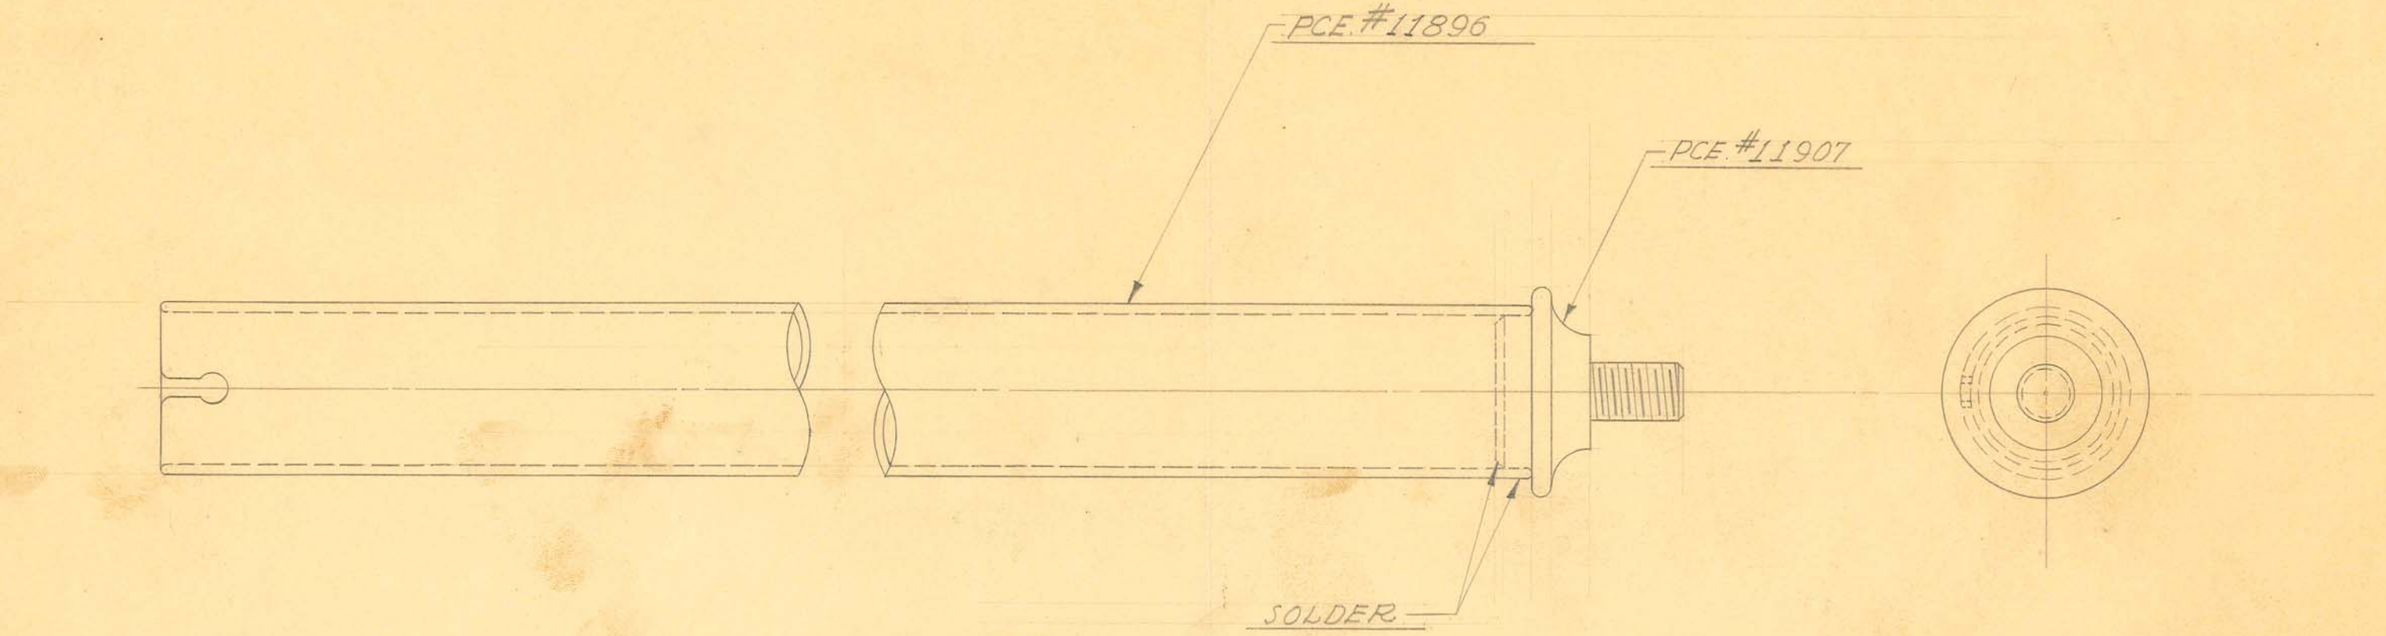

1 REQUIRED

OBSOLETE

SIZE		ISSUE 6-22-38	J.W.	TITLE: FISCHER MOD. "K" COLD QUARTZ ULTRA VIOLET LAMP-HOOD-HORIZ. SLIDE TUBE ASSEM.
KIND		CHANGED		
SHAPE		"		
FINISH		"		
TEMP.		"		
PATT.		"		

H. G. FISCHER & CO.
2335 WABANSIA AVE.
CHICAGO, ILL.

CAT. NO.

PART NO. 11906G

SMEAR STUD & TAPPED HOLE IN BALL WELL WITH PCE. #11916 DUPONT CEMENT. SCREW BALL DOWN TIGHT ONTO STUD

GROUP #11906G

PCE. #8214 1/2

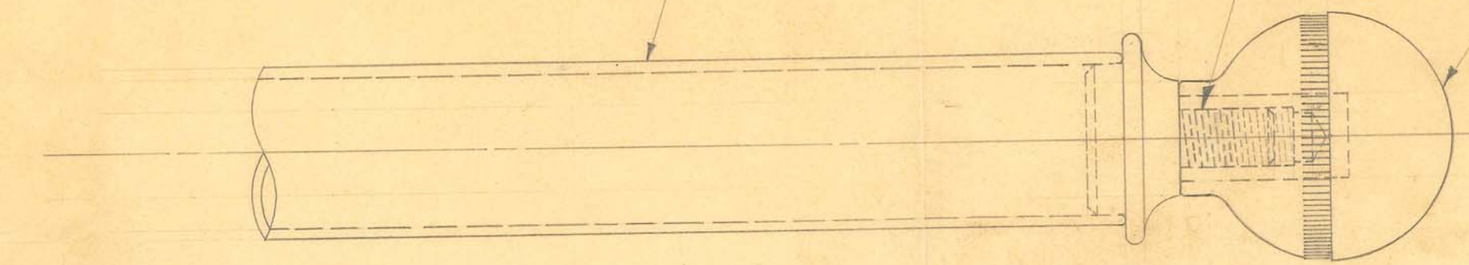

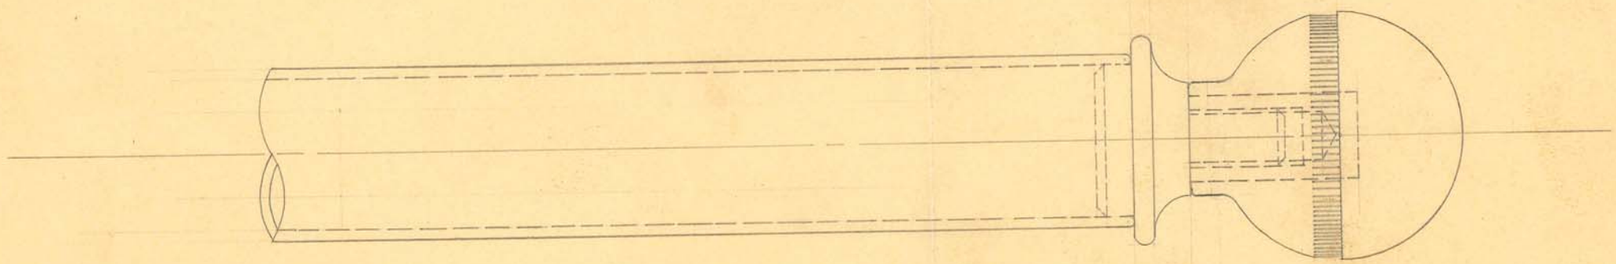

1 REQUIRED

OBSOLETE

SIZE		ISSUE 6-22-38	J.W.
KIND		CHANGED 4-17-42	J.W.W.
SHAPE		"	
FINISH		"	
TEMP.		"	

TITLE: FISCHER MOD. "K" COLD QUARTZ ULTRA VIOLET LAMP HOOD – HORIZ. SLIDE TUBE & HANDLE ASSEM.

H. G. FISCHER & CO.
2335 WABANSIA AVE.
CHICAGO, ILL.

CAT. NO.

PART NO. 11905GA

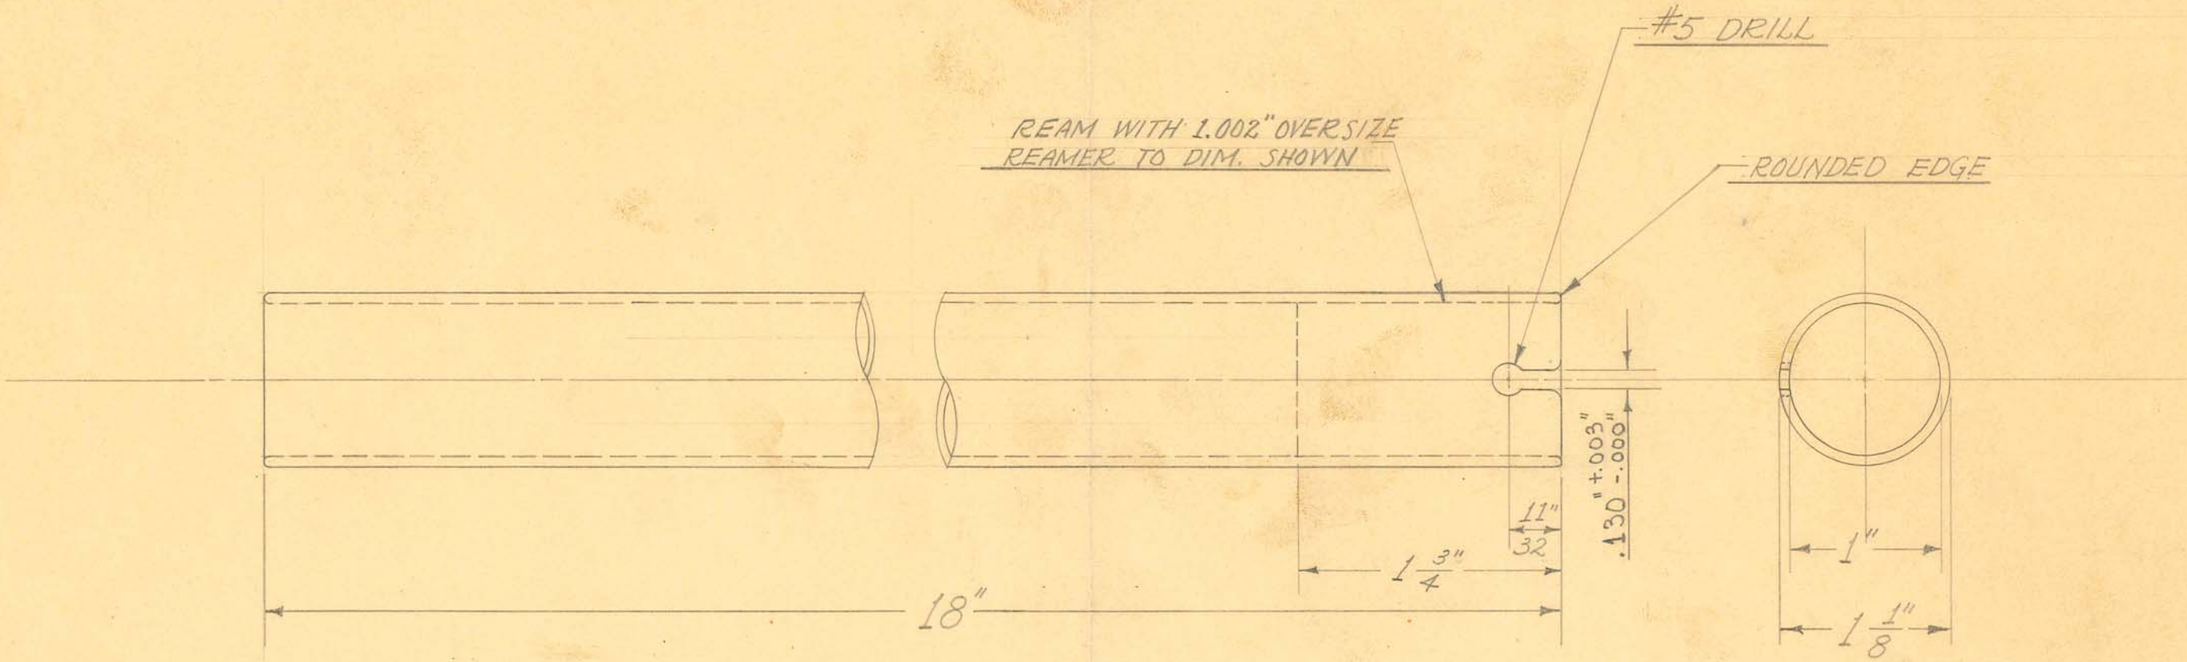

1 REQUIRED

OBSOLETE

SIZE	1⅛" O.D. X 1" I.D.	ISSUE 6-2-38	J.W.	TITLE: FISCHER COLD QUARTZ ULTRA VIOLET LAMP HOOD - HORIZONTAL SLIDE TUBE
KIND	BRASS TUBING	CHANGED		
SHAPE		"		
FINISH	CHROME #2	"		
TEMP.		"		
PATT.		"		

H. G. FISCHER & CO.
2335 WABANSIA AVE.
CHICAGO, ILL.

CAT. NO.

PART NO. 11896

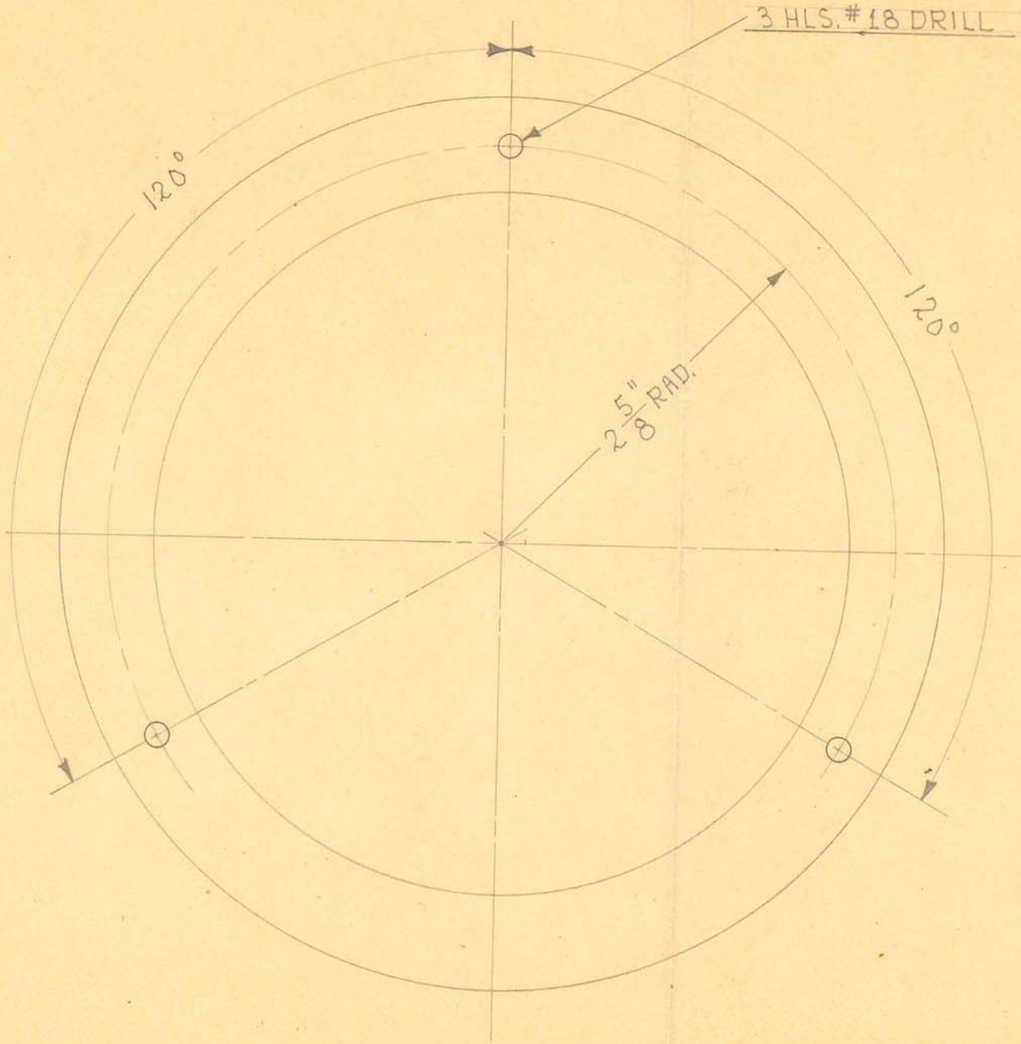

1 REQUIRED

OBSOLETE
Obsolete

SIZE		ISSUE 6-3-38	A.E.
KIND		CHANGED	
SHAPE		"	
FINISH	SATIN FINISH #27	"	
TEMP.	OUTSIDE ONLY	"	
PATT.		"	

TITLE: FISCHER COLD QUARTZ ULTRA VIOLET LAMP HOOD BAFFLE PLATE (DRILLED)

H. G. FISCHER & CO.
2335 WABANSIA AVE.
CHICAGO, ILL.

CAT. NO.

PART NO. 11885F

CUT THESE LINES LIGHTLY
FOR PURPOSE OF LOCATING CONE ON HOUSING.

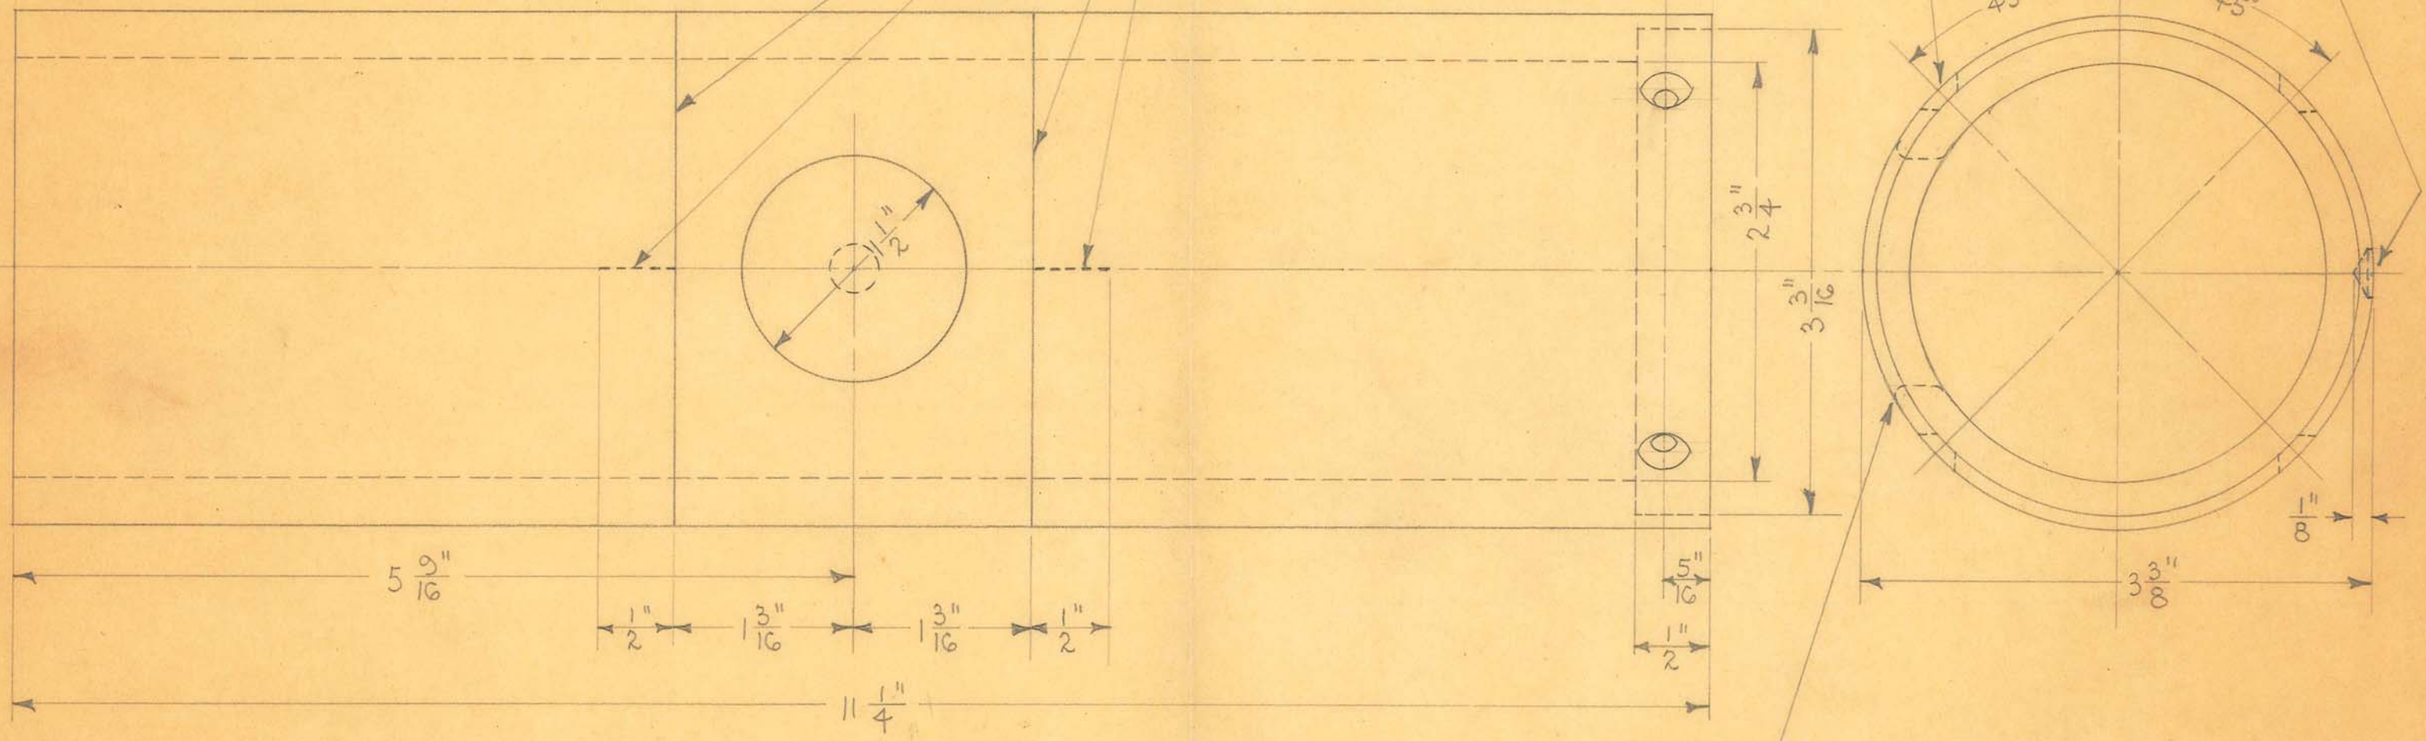

ROUND EDGE OF HOLE
INSIDE & OUTSIDE.

1 REQUIRED

OBSOLETE

SIZE	2 3/4" I.D. X 3 3/8" O.D.	ISSUE 2-17-36	H.E.
KIND	LITH. IMPREG.	CHANGED	
SHAPE	BAKELITE TUBING	" "	
FINISH		" "	
TEMP.		" "	
PATT.		" "	

TITLE: "15-88" WALL MODEL FLUOROSCOPE TUBE HOUSING

H. G. FISCHER & CO.
2335 WABANSIA AVE.
CHICAGO, ILL.

CAT. NO.

PART NO. 10016

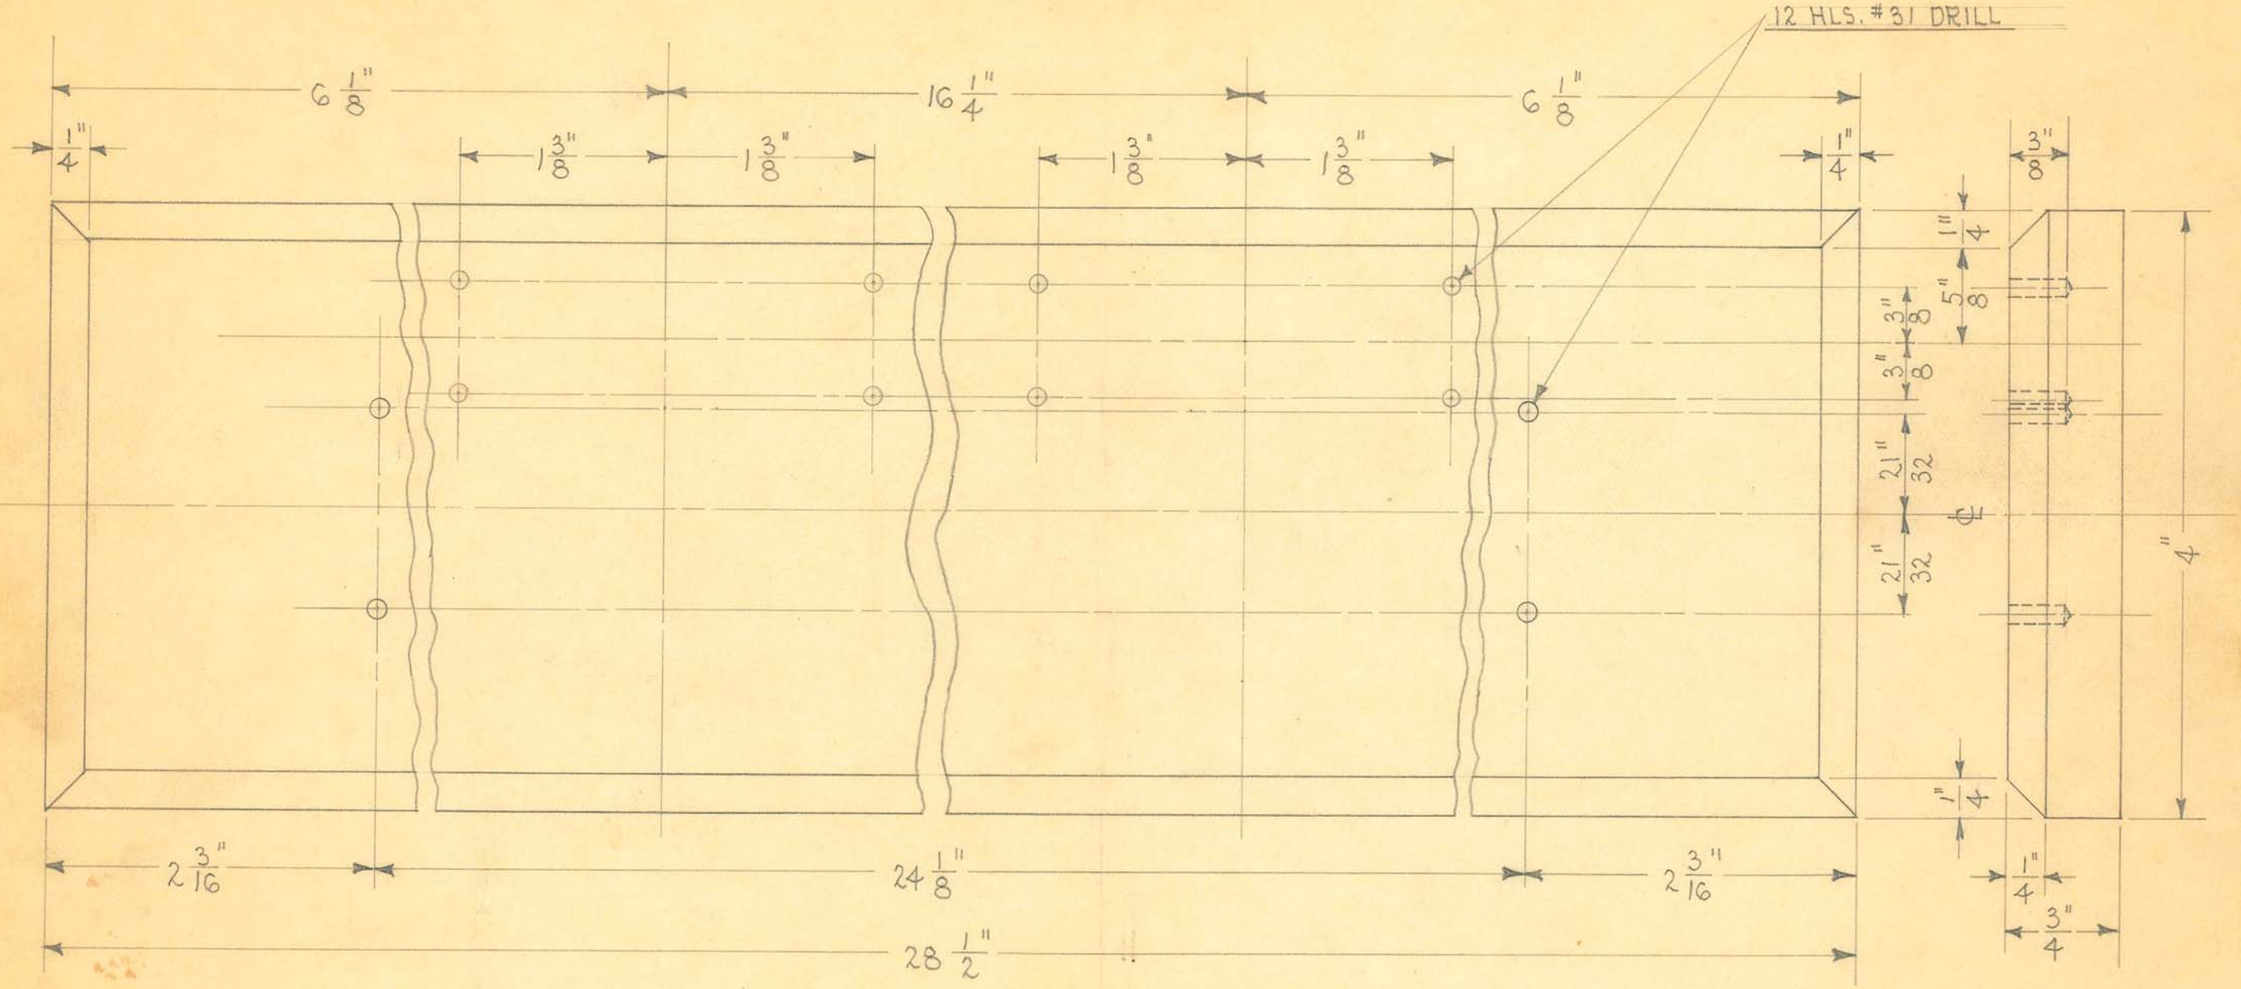

1 REQUIRED
FROM 10013

OBSOLETE

SIZE		ISSUE 5-29-36	J.E.	TITLE: FISCHER FLUOROSCOPE - WALL MODEL - HEART TRACING HORIZ. SUPP. MTG. BOARD
KIND		CHANGED		
SHAPE		" "		
FINISH		" "		
TEMP.		" "		
PATT.		" "		

H. G. FISCHER & CO.
2335 WABANSIA AVE.
CHICAGO, ILL.

CAT. NO.

PART NO. 10013 1/2

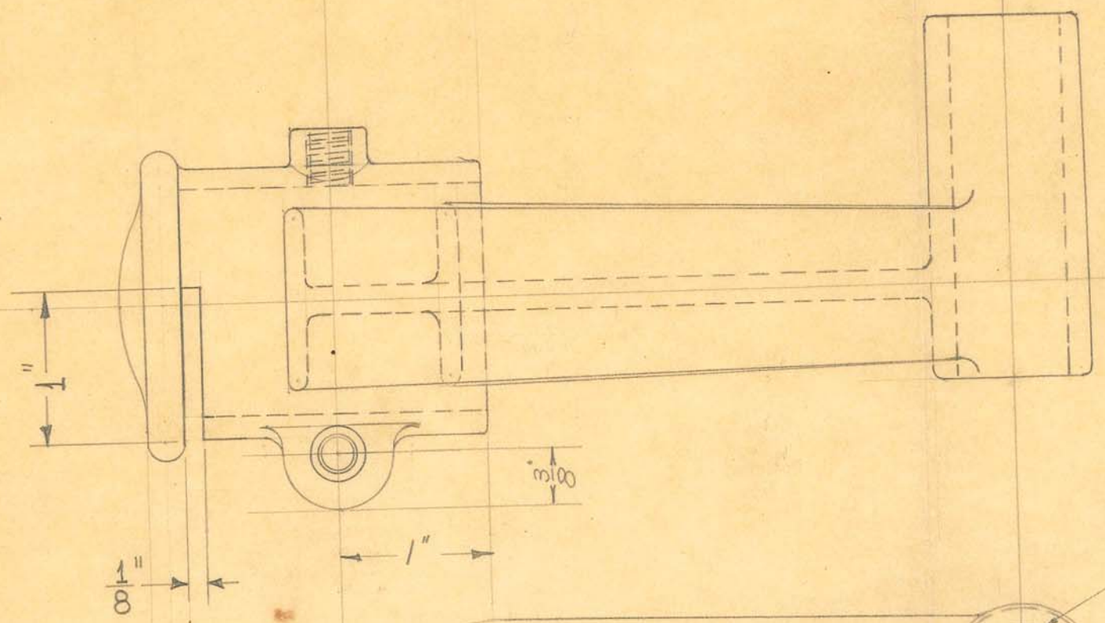

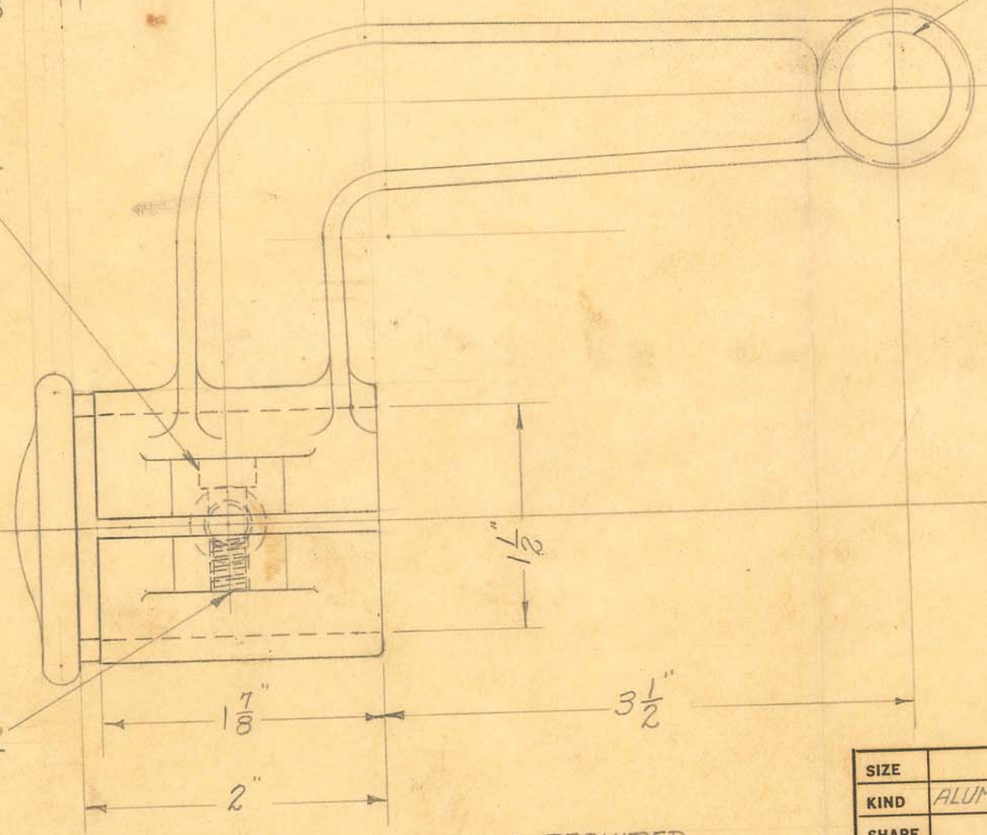

1 REQUIRED

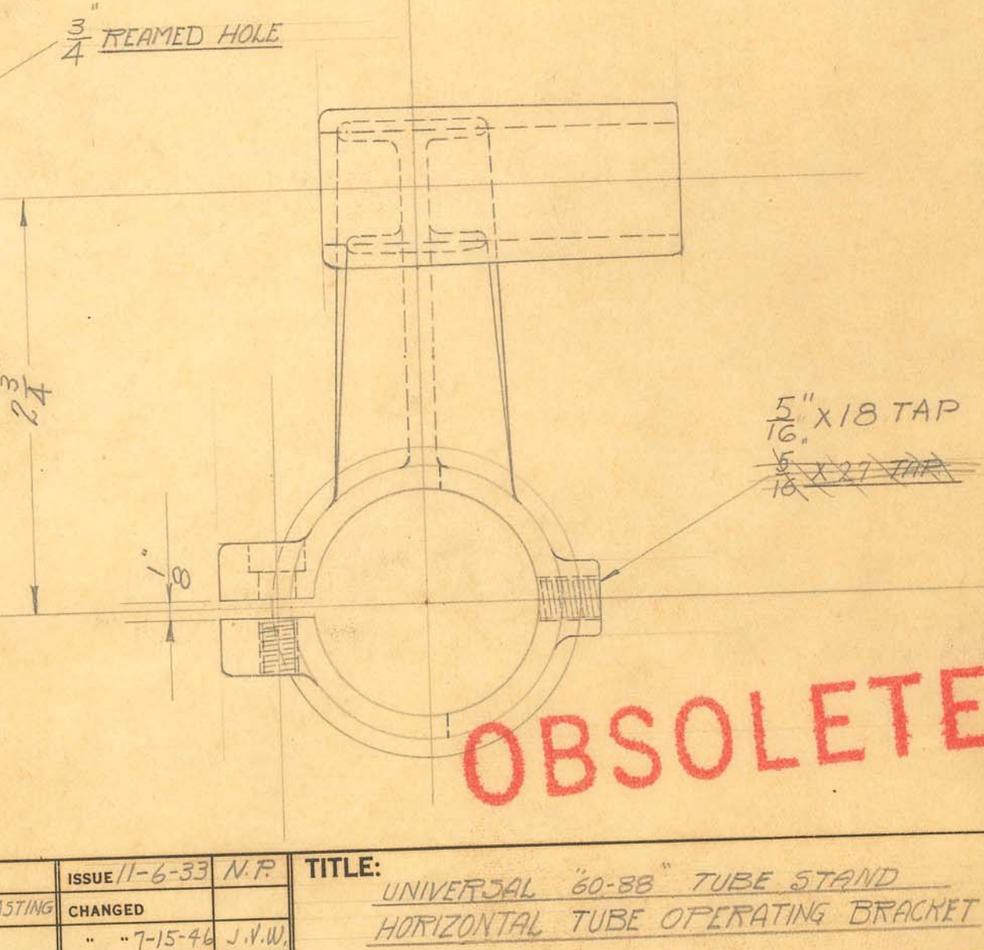

OBSOLETE

SIZE		ISSUE 11-6-33	N.F.
KIND	ALUM. CASTING	CHANGED	
SHAPE		" " 7-15-46	J.V.W.
FINISH	BLK. LACQ.	" "	
TEMP.		" "	
DATE	2955-631	" "	

TITLE: UNIVERSAL "60-88" TUBE STAND
HORIZONTAL TUBE OPERATING BRACKET

H. G. FISCHER & CO.
2335 WABANSIA AVE.
CHICAGO, ILL.

CAT. NO.

PART NO. 8282 AF

NOTE:-
WELDING MUST BE OIL TIGHT.
TEST FOR LEAKS WITH KEROSENE.
GIVE OUTSIDE OF TANK KEROSENE
BATH TO KEEP FROM RUSTING.

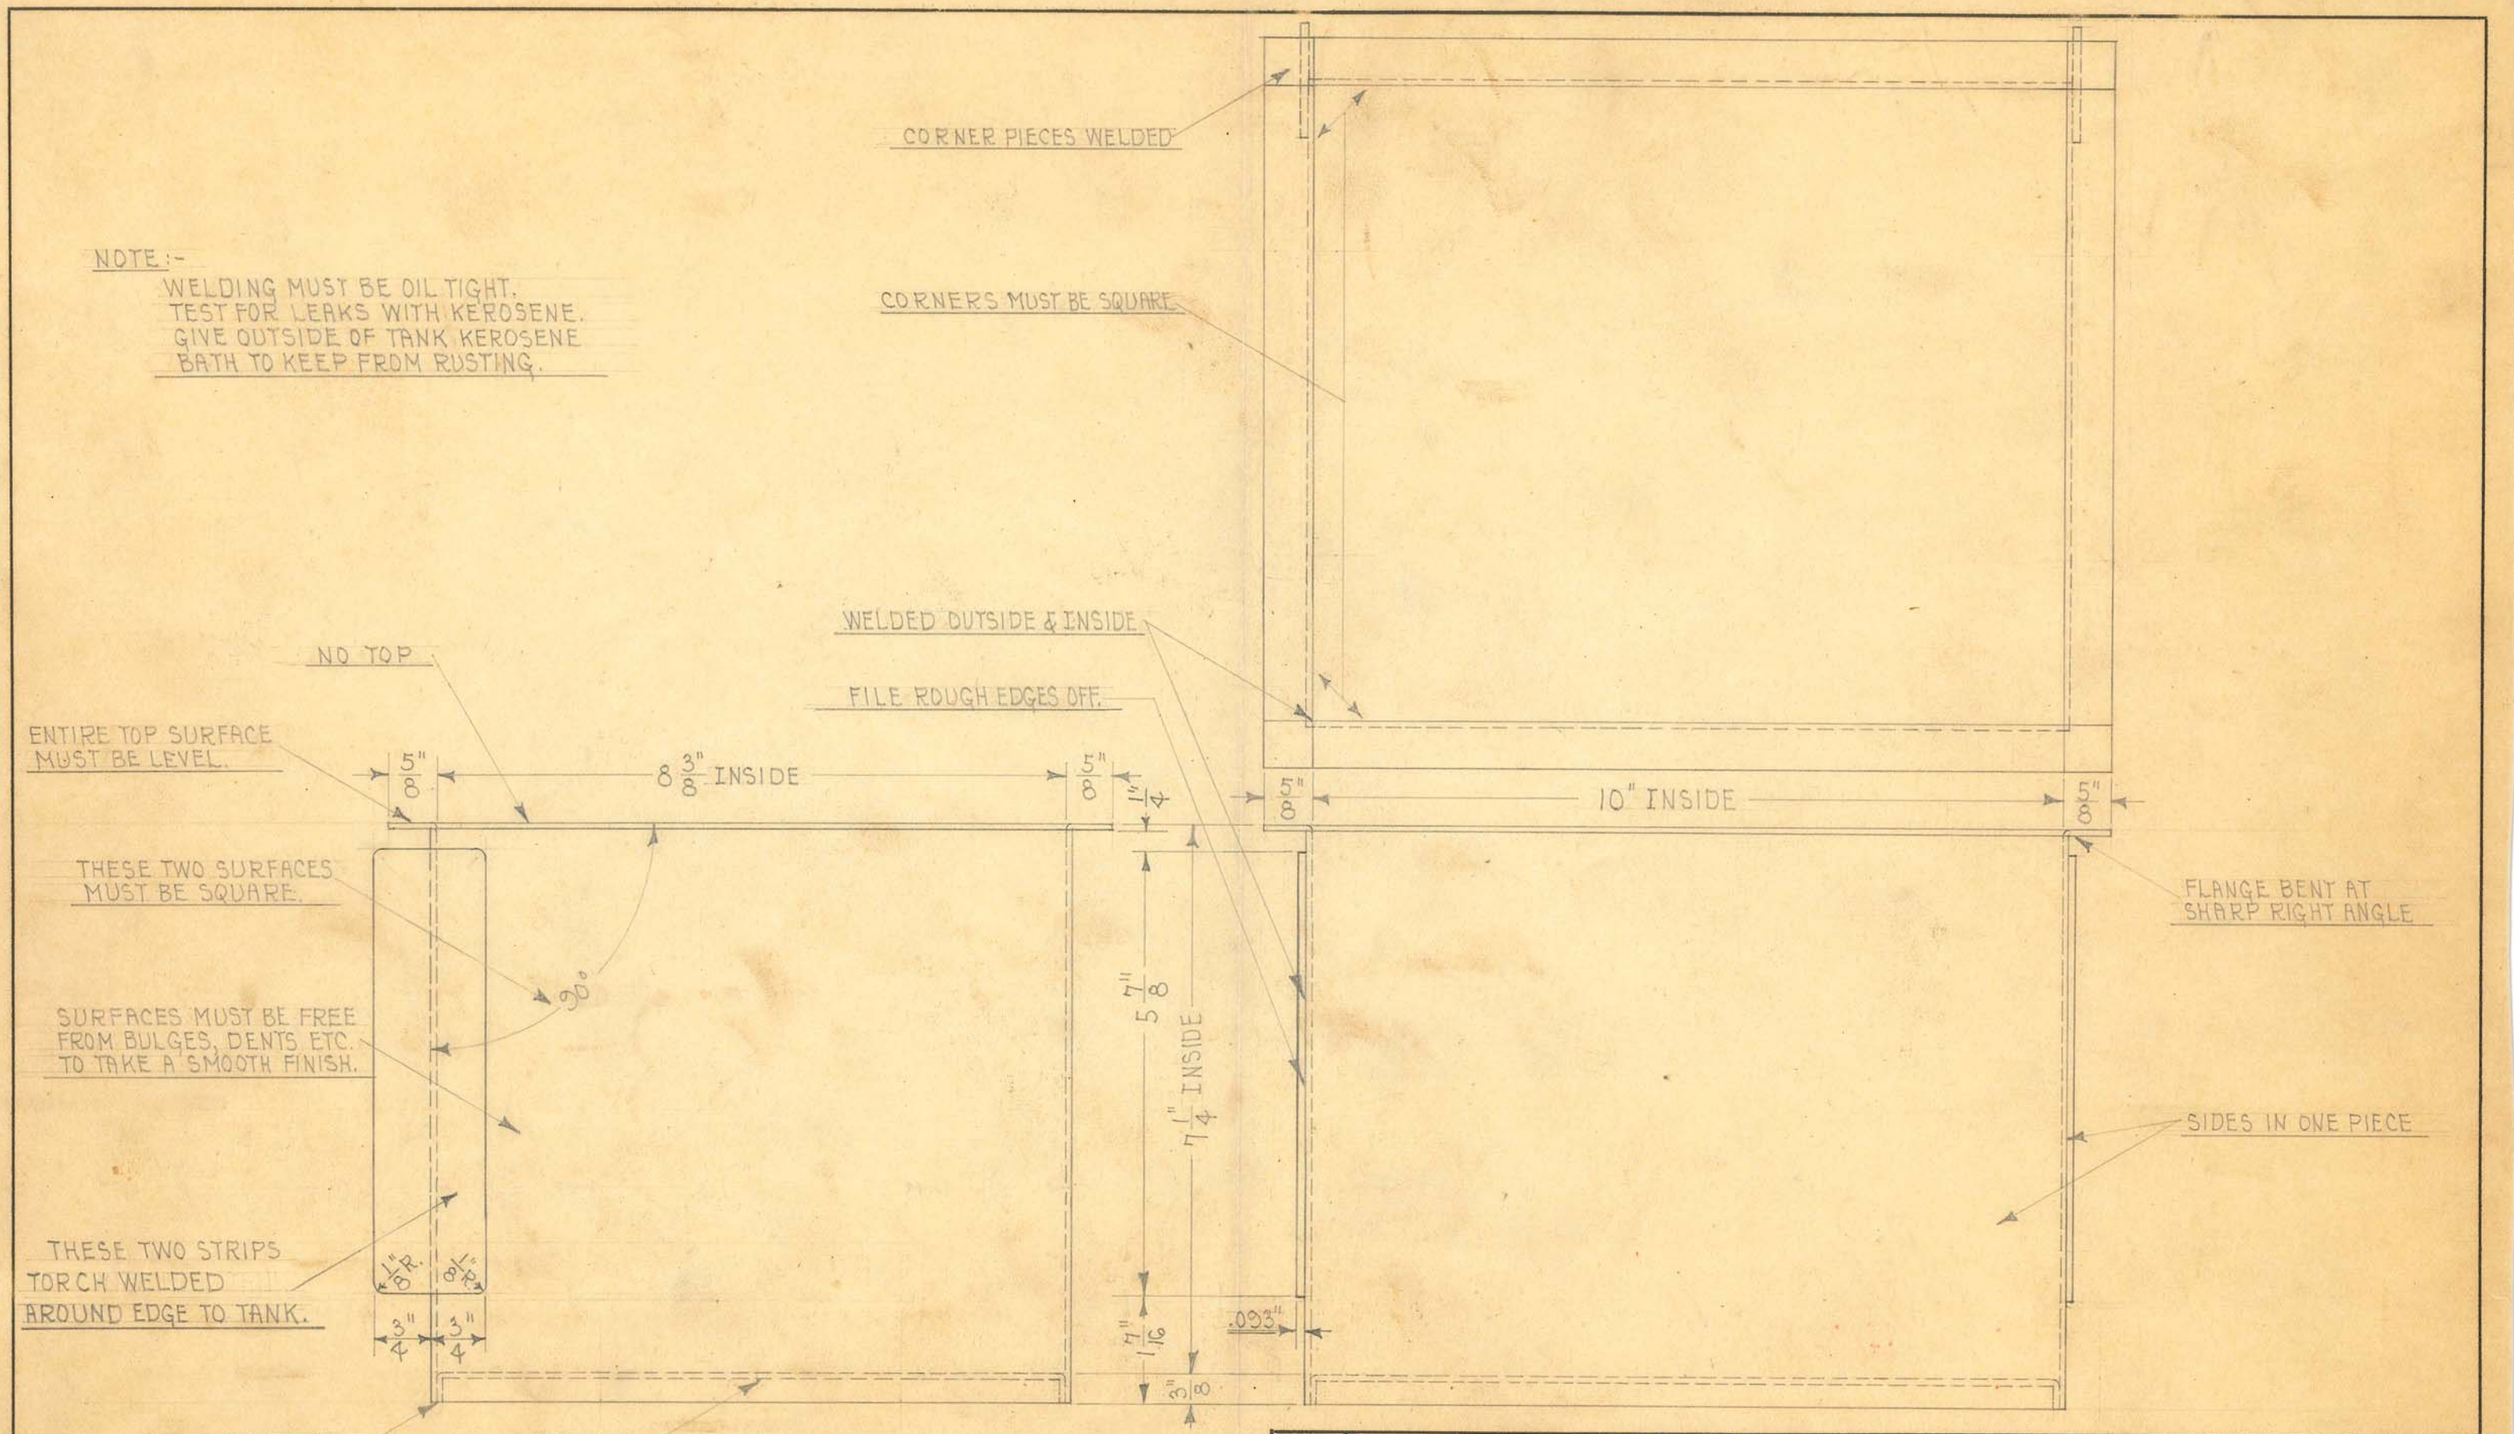

SCALE:- 1/2" = 1"

SIZE	#16 U.S.S. GA. (.064")	ISSUE 8-16-34	W.E.	
KIND	FURNITURE STEEL	CHANGED		
SHAPE		" "		
FINISH		" "		
TEMP.		" "		
PATT.		" "		

TITLE: FISCHER "DSP-20" TRANSFORMER TANK

OBSOLETE

H. G. FISCHER & CO.
2335 WABANSIA AVE.
CHICAGO, ILL.

CAT. NO.

PART NO. 9239

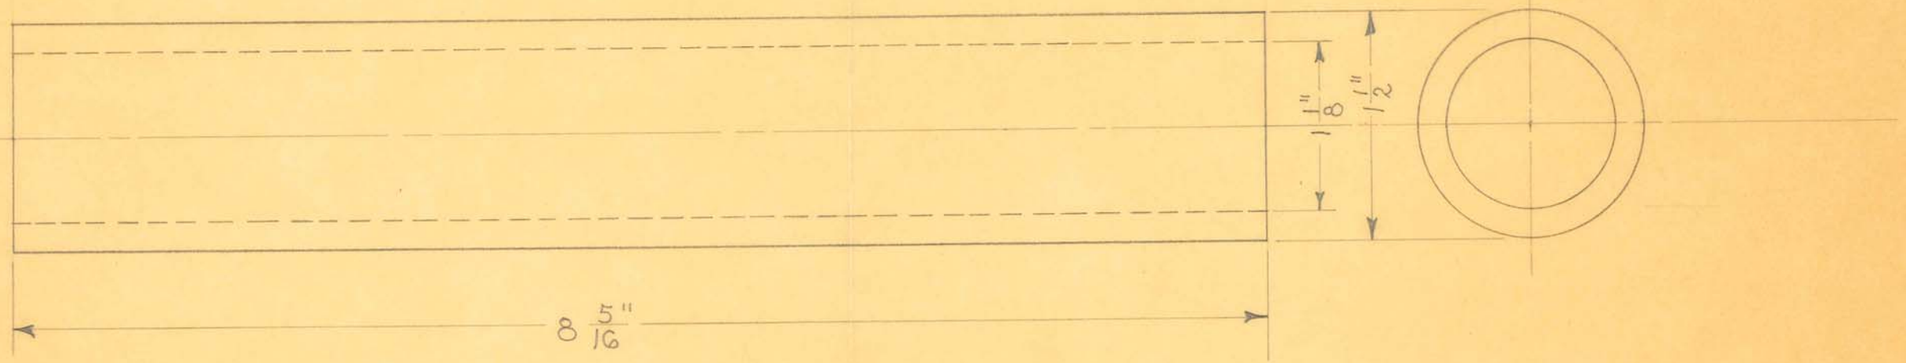

1 REQUIRED

OBSOLETE

SIZE	1⅛" I.D. X 1½" O.D.	ISSUE 11-6-35	A.E.
KIND	HARD RUBBER	CHANGED	
SHAPE	TUBING	" "	
FINISH		" "	
TEMP.		" "	
PATT.		" "	

TITLE: FISCHER "DSP-20" FILAMENT TRANSFORMER SECONDARY RUBBER TUBE

H. G. FISCHER & CO.
2335 WABANSIA AVE.
CHICAGO, ILL.

CAT. NO.

PART NO. 9237

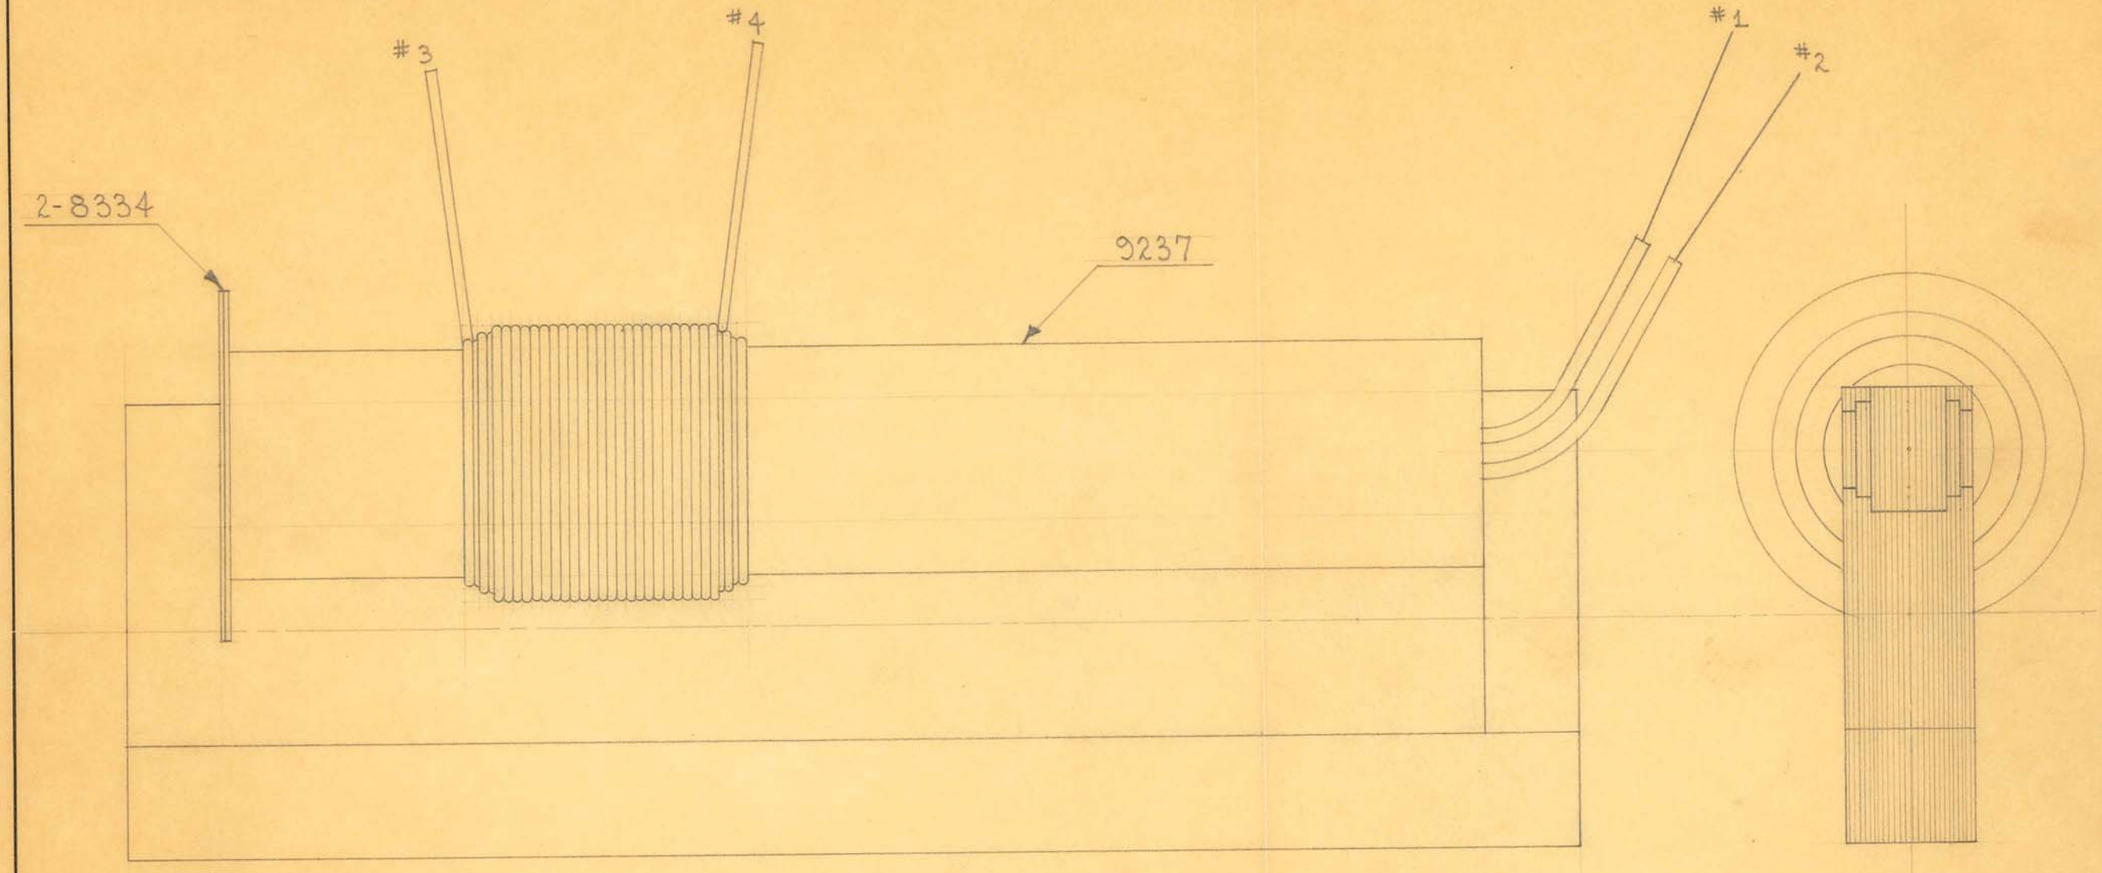

STEEL SIZES
PC. NO. 5043

1 - O CORE LAMS. CUT
9" X 13/16" BUILT UP TO 1/2".
9" X 5/8" BUILT UP TO 3/16".
9" X 1/2" BUILT UP TO 5/32".
} 27/32"

1 - □ CORE LAMS. CUT
9" X 3/4" BUILT UP TO 27/32".

END PIECES CUT 2 1/4" X 5/8".

BIND CORES WITH 1" LINEN TAPE.

WINDING DATA

COVER "O" CORE WITH 1 LAYER OF 5024 1/2 FIBROID PAPER AND 1 LAYER OF 5026 3/4 OILED CLOTH. USE #28 ENAMEL WIRE. ANCHOR LEAD #1 WITH FRICTION TAPE & WIND PRI. 1000 TURNS. ANCHOR END WITH FRICTION TAPE-LEAD #2. COVER WITH SHELLAC. COVER LEADS #1 & 2 WITH 5032 TUBING. SLIDE SEC. TUBE 9237 OVER PRI. WINDING. USE #16 COTENAMEL WIRE. ANCHOR LEAD #3, WITH FRICTION TAPE, 1 5/8" FROM END OF TUBE AND WIND 1 LAYER OF 30 TURNS, 1 LAYER OF 27 TURNS & 1 LAYER OF 25 TURNS. TOTAL 82 TURNS. ANCHOR END WITH FRICTION TAPE-LEAD #2. COVER SEC. WINDING WITH SHELLAC.

OBSOLETE

SIZE		ISSUE 12-17-35	A.E.	TITLE: FISCHER "DSP-20" FILAMENT TRANSFORMER
KIND		CHANGED		
SHAPE		" "		
FINISH		" "		
TEMP.		" "		
PATT.		" "		

H. G. FISCHER & CO.
2335 WABANSIA AVE.
CHICAGO, ILL.

CAT. NO.

PART NO. 9236G

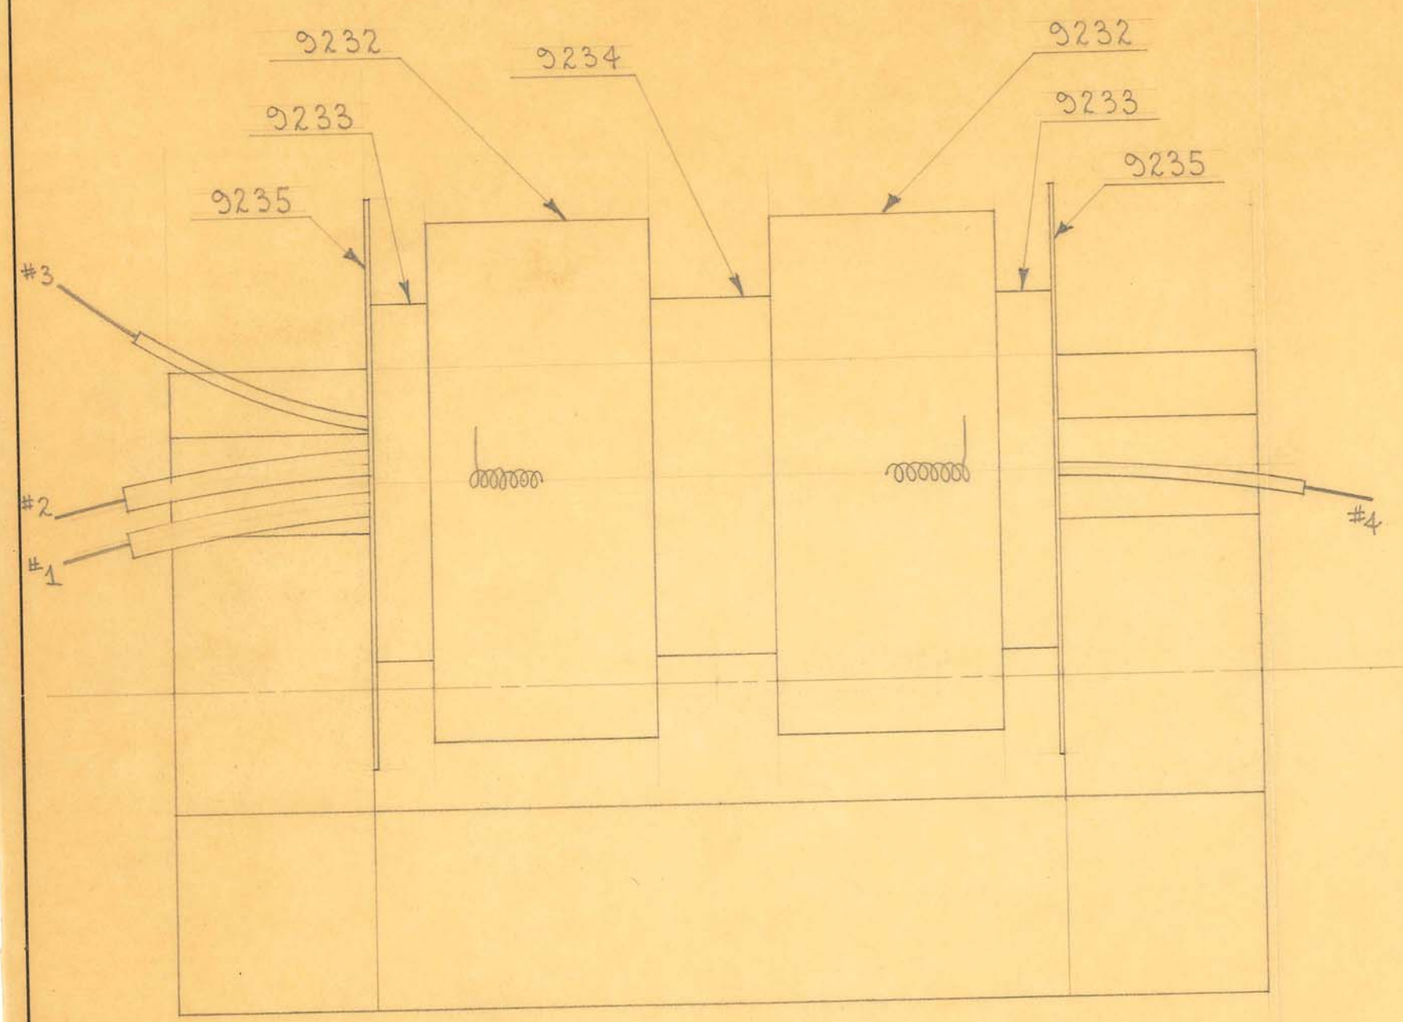

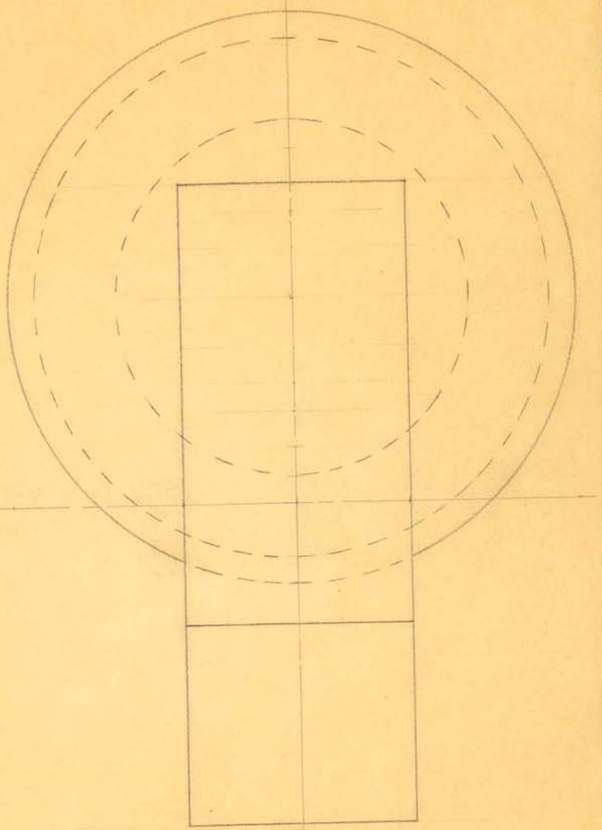

STEEL SIZES

PC. NO. 5043

1-O CORE LAMS. CUT:
46 PCS.- $7\frac{7}{8}$" X 2"
34 PCS.- $7\frac{7}{8}$" X $1\frac{1}{2}$"
24 PCS.- $7\frac{7}{8}$" X $\frac{7}{8}$"
} BUILT UP APPROX. 2".

1-□ CORE LAMS. CUT: $7\frac{7}{8}$" X $1\frac{3}{4}$" BUILT UP APPROX. 2".

END PIECES CUT: $4\frac{1}{8}$" X $1\frac{3}{4}$"
$3\frac{7}{8}$" X $1\frac{3}{4}$"
$3\frac{5}{8}$" X $1\frac{3}{4}$"

BIND CORES WITH $\frac{3}{4}$" FRICTION TAPE AND 1" LINEN TAPE.

WINDING DATA

COVER "O" CORE WITH 3 LAYERS OF $5024\frac{1}{2}$ FIBROID PAPER & 3 LAYERS OF $5026\frac{3}{4}$ OILED CLOTH. USE #14 COTENAMEL WIRE. ANCHOR LEAD #1 WITH FRICTION TAPE & WIND 150 TURNS (2 LAYERS WITH 1 LAYER OF OILED CLOTH IN BETWEEN). ANCHOR END WITH FRICTION TAPE - LEAD #2. COVER LEADS #1 & 2 WITH 5016 TUBING. SLIDE SEC. COILS OVER PRI. WITH SEPARATORS & WASHERS AS SHOWN. COVER SEC. LEADS #3 & 4 WITH 5032 TUBING.

SCALE ≈ $\frac{3}{4}$" = 1"

OBSOLETE

SIZE		ISSUE 12-17-35	A.E.
KIND		CHANGED	
SHAPE		" "	
FINISH		" "	
TEMP.		" "	

TITLE: FISCHER "DSP-20" HIGH TENSION TRANSFORMER

H. G. FISCHER & CO.
2335 WABANSIA AVE.
CHICAGO, ILL.

CAT. NO.

PART NO. 9231G

4 HLS. #9 DRILL

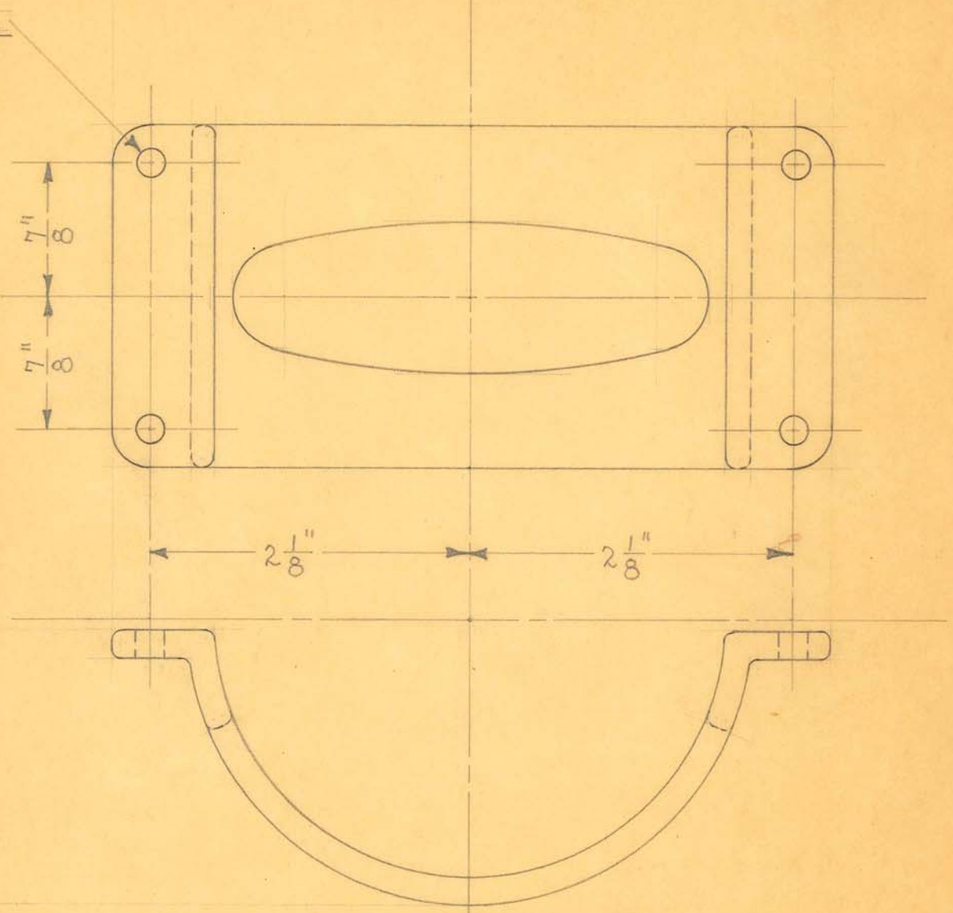

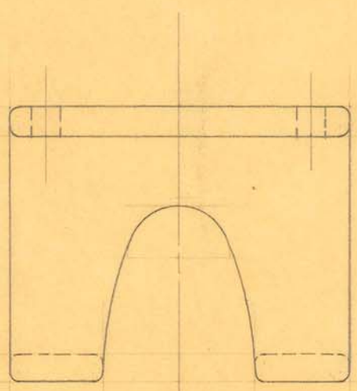

1 REQUIRED

OBSOLETE

SIZE		ISSUE 2-17-36	H.E.
KIND	ALUM. CASTING	CHANGED	
SHAPE		" "	
FINISH	BLACK #60	" "	
TEMP.		" "	
PATT.	6782-935	" "	

TITLE:
"15-88" WALL MODEL FLUOROSCOPE
TUBE HOUSING CONE CLAMP
OBSOLETE

H. G. FISCHER & CO.
2335 WABANSIA AVE.
CHICAGO, ILL.

CAT. NO.

PART NO. 10022F

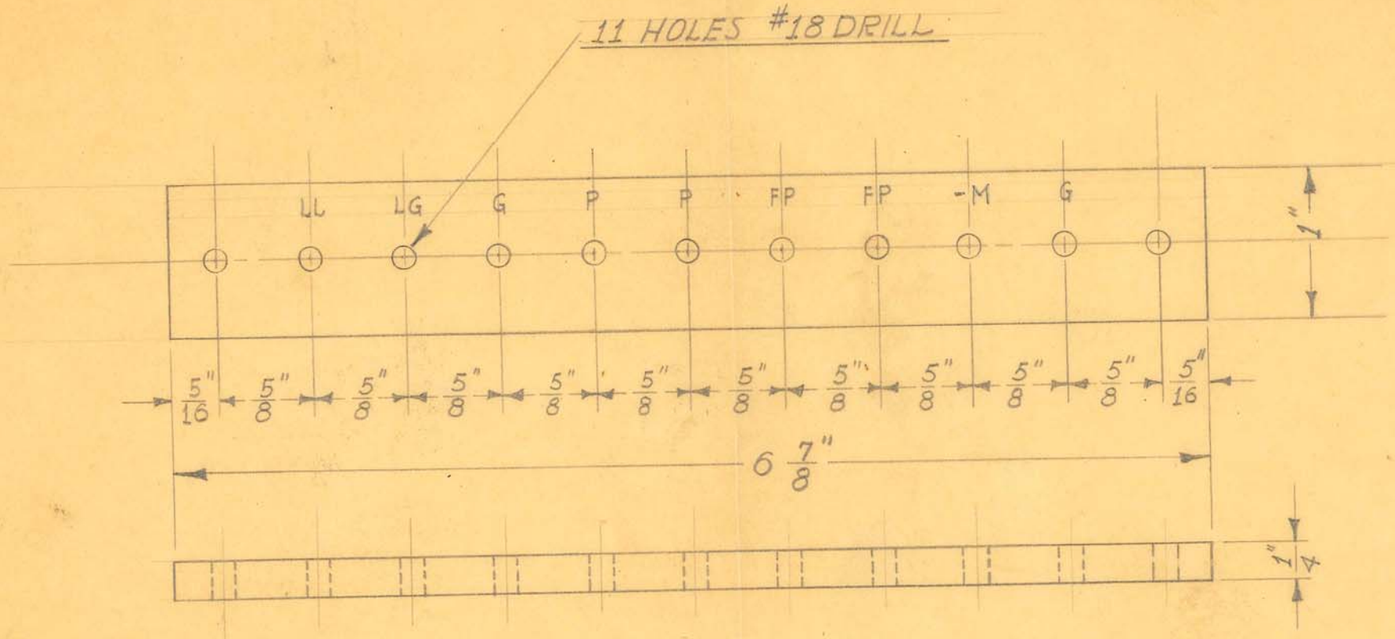

1 REQUIRED

OBSOLETE

SIZE	1/4" SHEET	ISSUE 2-18-36	J.W.	TITLE: FISCHER FLUOROSCOPE - WALL MOD. - CONTROL BOX TERM. BOARD
KIND	BAKELITE	CHANGED		
SHAPE		" "		
FINISH		" "		
TEMP.		" "		

H. G. FISCHER & CO.
2335 WABANSIA AVE.
CHICAGO, ILL.

CAT. NO.

PART NO. 10027

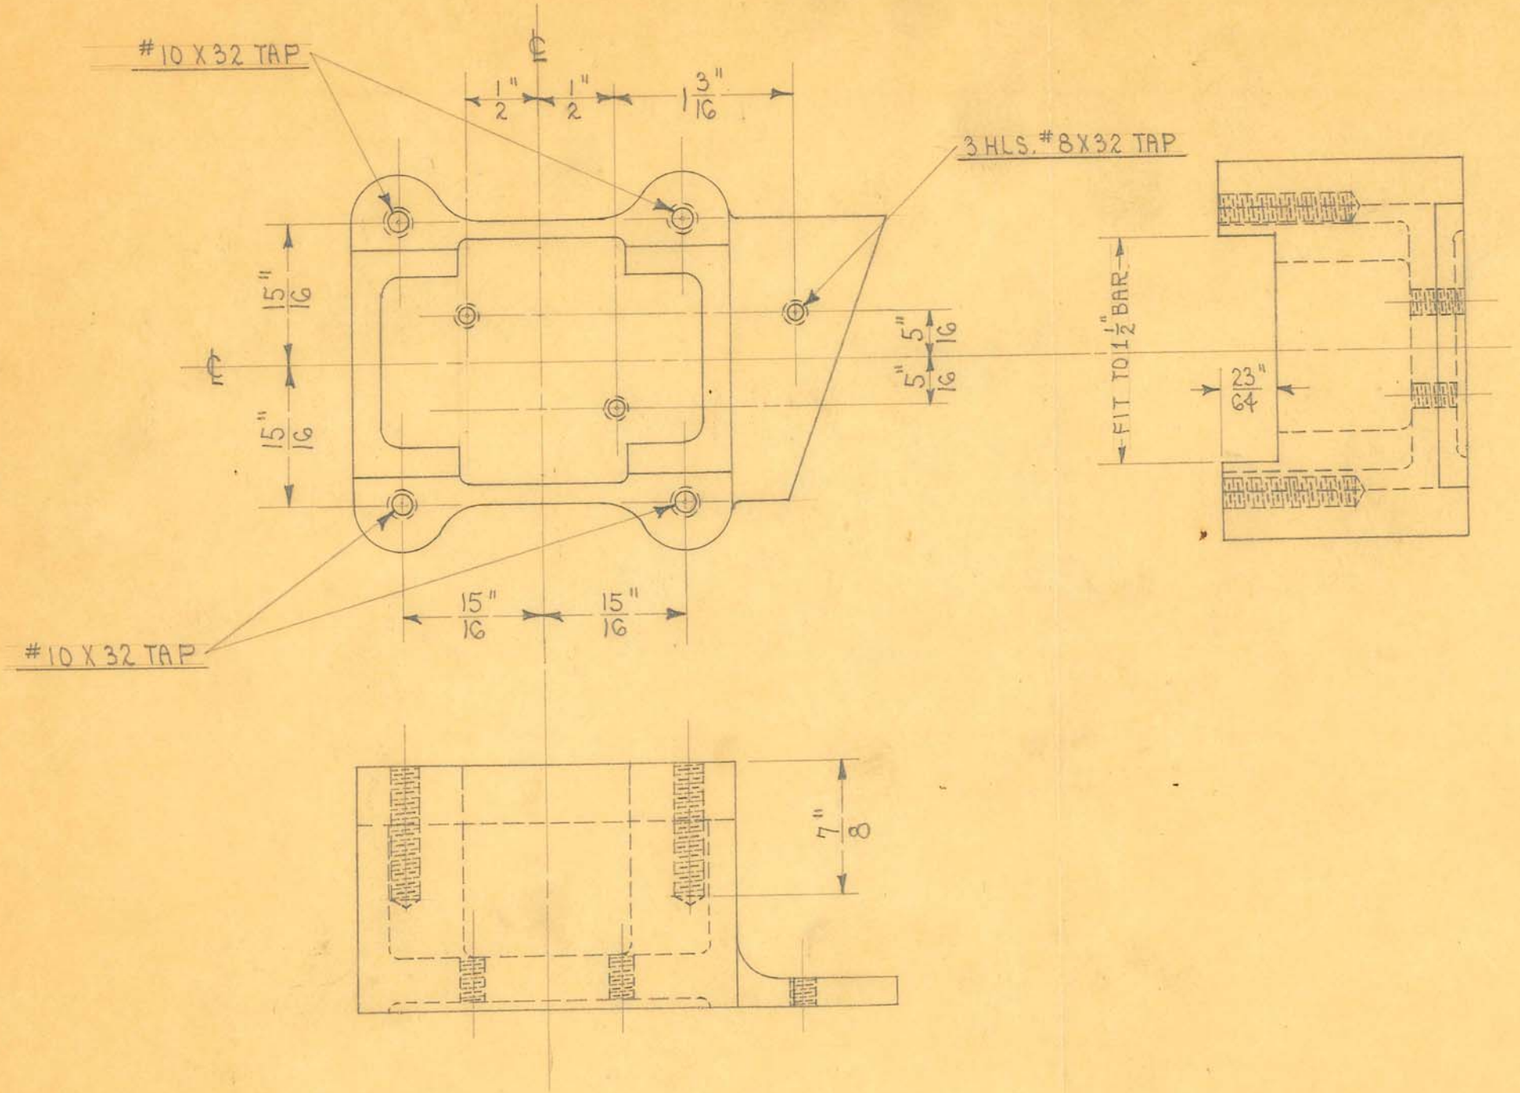

1 REQUIRED

OBSOLETE

SIZE		ISSUE 12-27-35	7-E
KIND	ALUM. CASTING	CHANGED	
SHAPE		" "	
FINISH		" "	
TEMP.		" "	

TITLE: "15-88" WALL MOD. FLUOROSCOPE CONTROX BOX CLAMP-UPPER

H. G. FISCHER & CO.
2335 WABANSIA AVE.

CAT. NO.

PART NO. 9998F

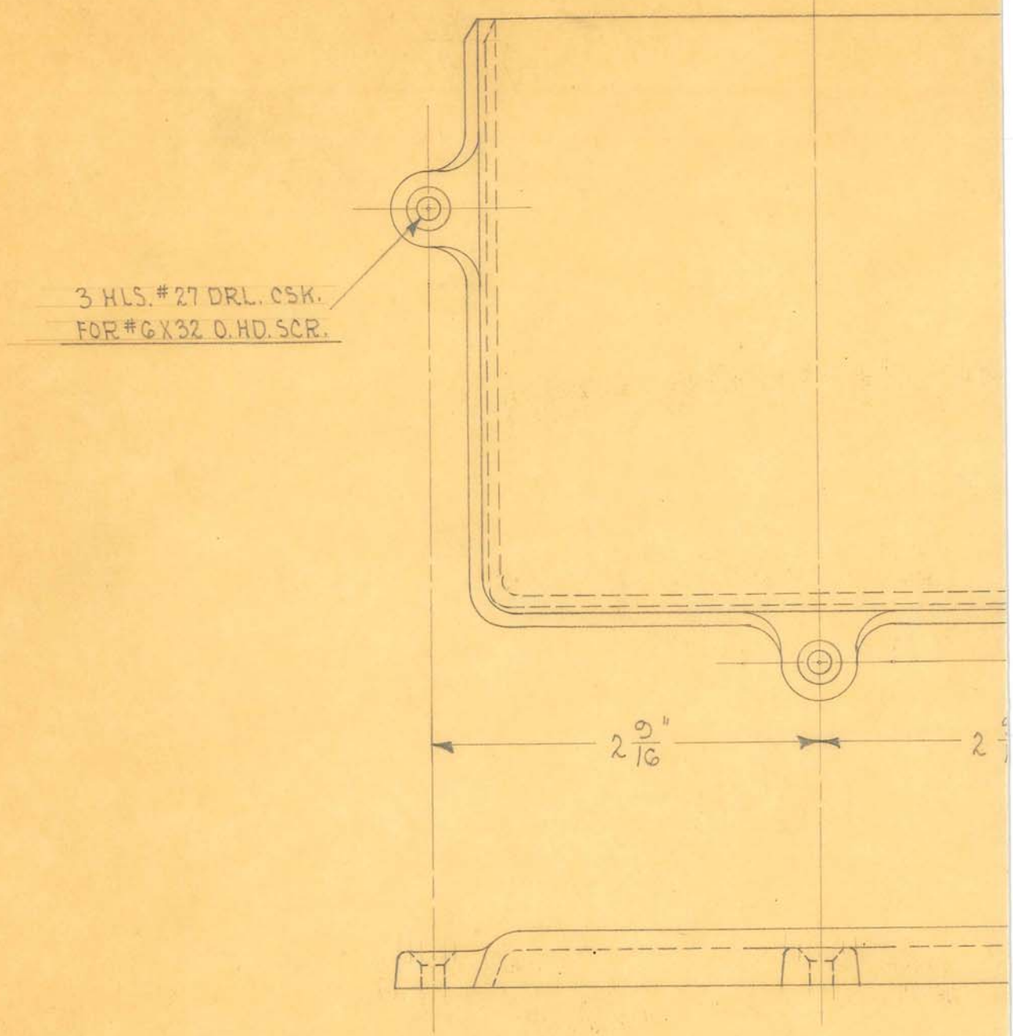
3 HLS. #27 DRL. CSK.
FOR #6 X 32 O. HD. SCR.
2 9/16"

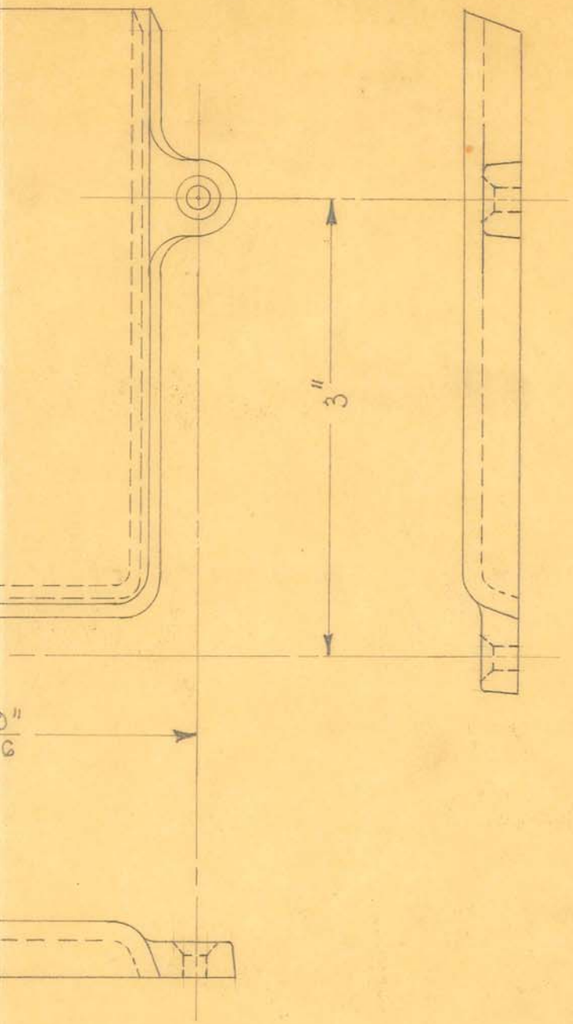

1 REQUIRED

OBSOLETE

SIZE		ISSUE 1-22-36	J.E.
KIND	ALUM. CASTING	CHANGED	
SHAPE		" "	
FINISH	BLACK # 60	" "	
TEMP.		" "	

TITLE: "15-88" WALL MODEL FLUOROSCOPE CONTROL BOX FUSE COVER

H. G. FISCHER & CO.
2335 WABANSIA AVE.

CAT. NO.

PART NO. 100045

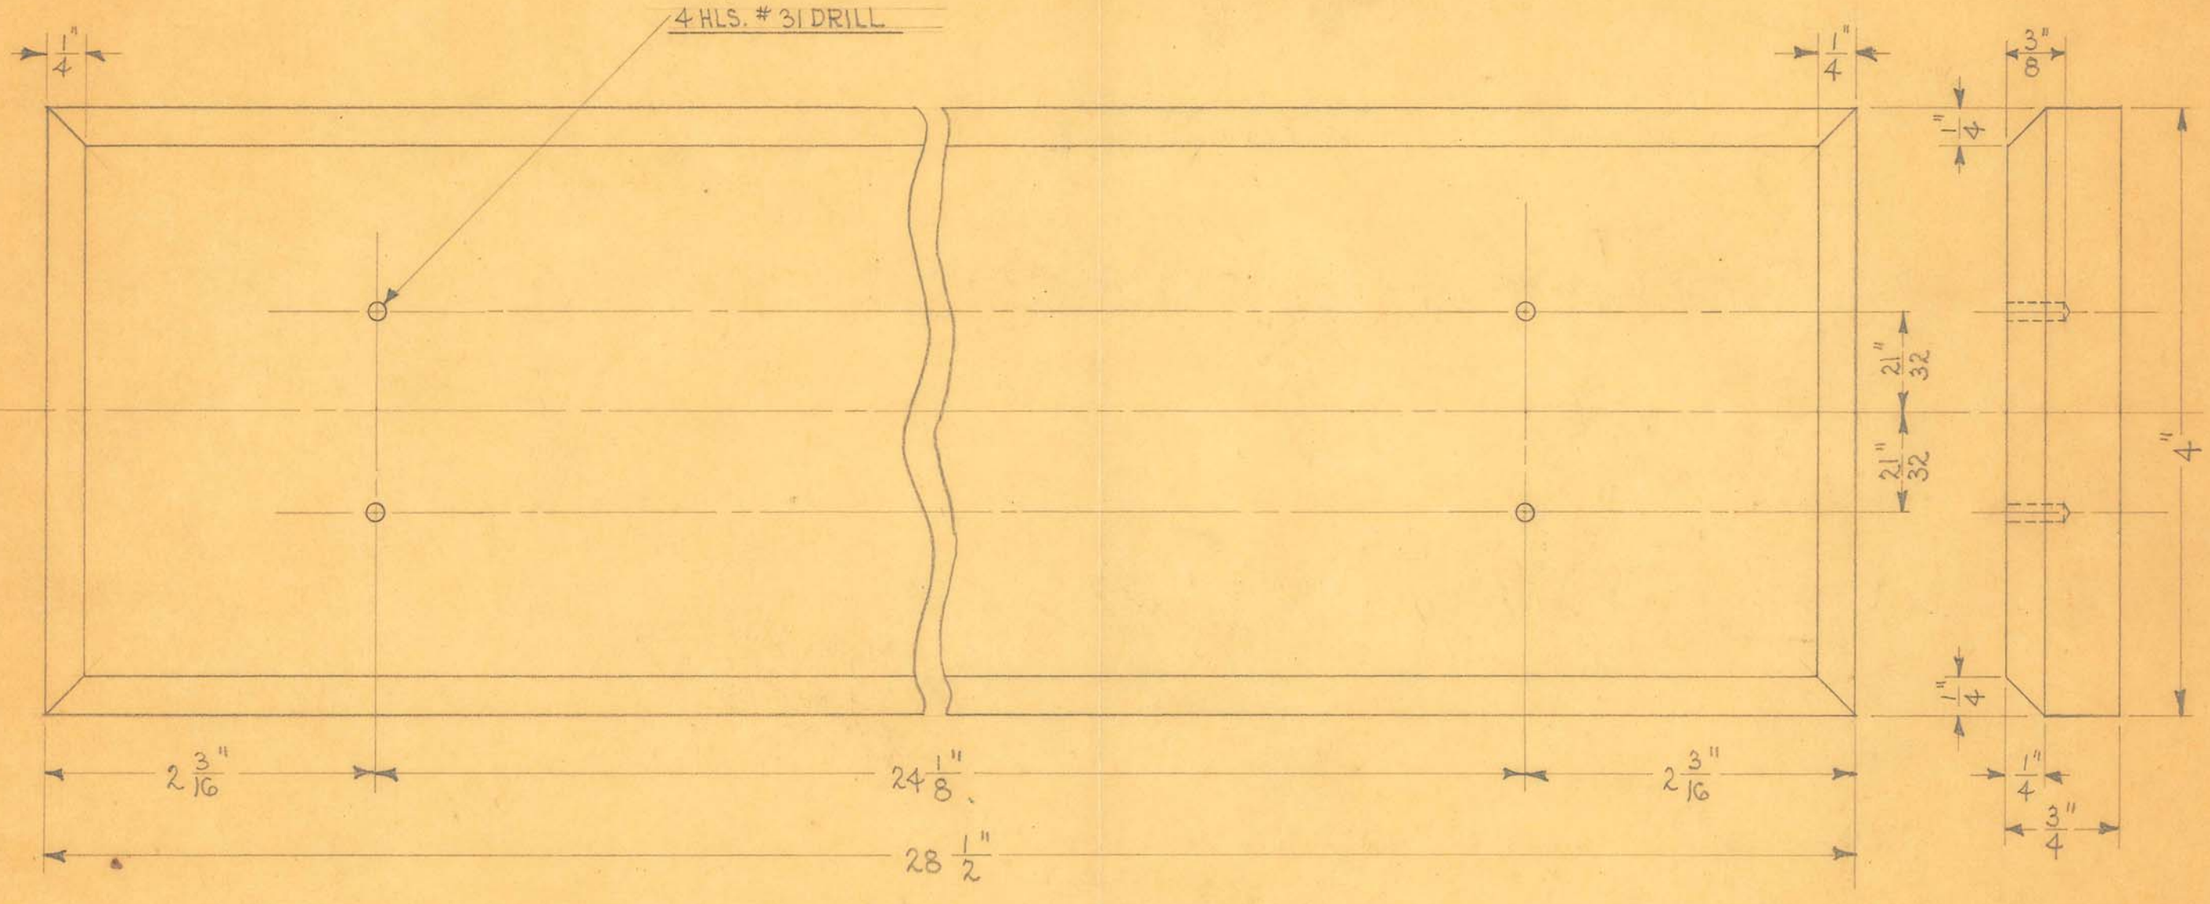

1 REQUIRED

OBSOLETE

SIZE	28½" X 4" X ¾"	ISSUE 2-10-36	A.E.	TITLE: "15-88" WALL MODEL FLUOROSCOPE HORIZ. SUPP. MOUNTING BOARD (DRILLED)
KIND	HARD WOOD	CHANGED		
SHAPE		" "		
FINISH		" "		
TEMP.		" "		
PATT.		" "		

H. G. FISCHER & CO.
2335 WABANSIA AVE.
CHICAGO, ILL.

CAT. NO.

PART NO. 10013F

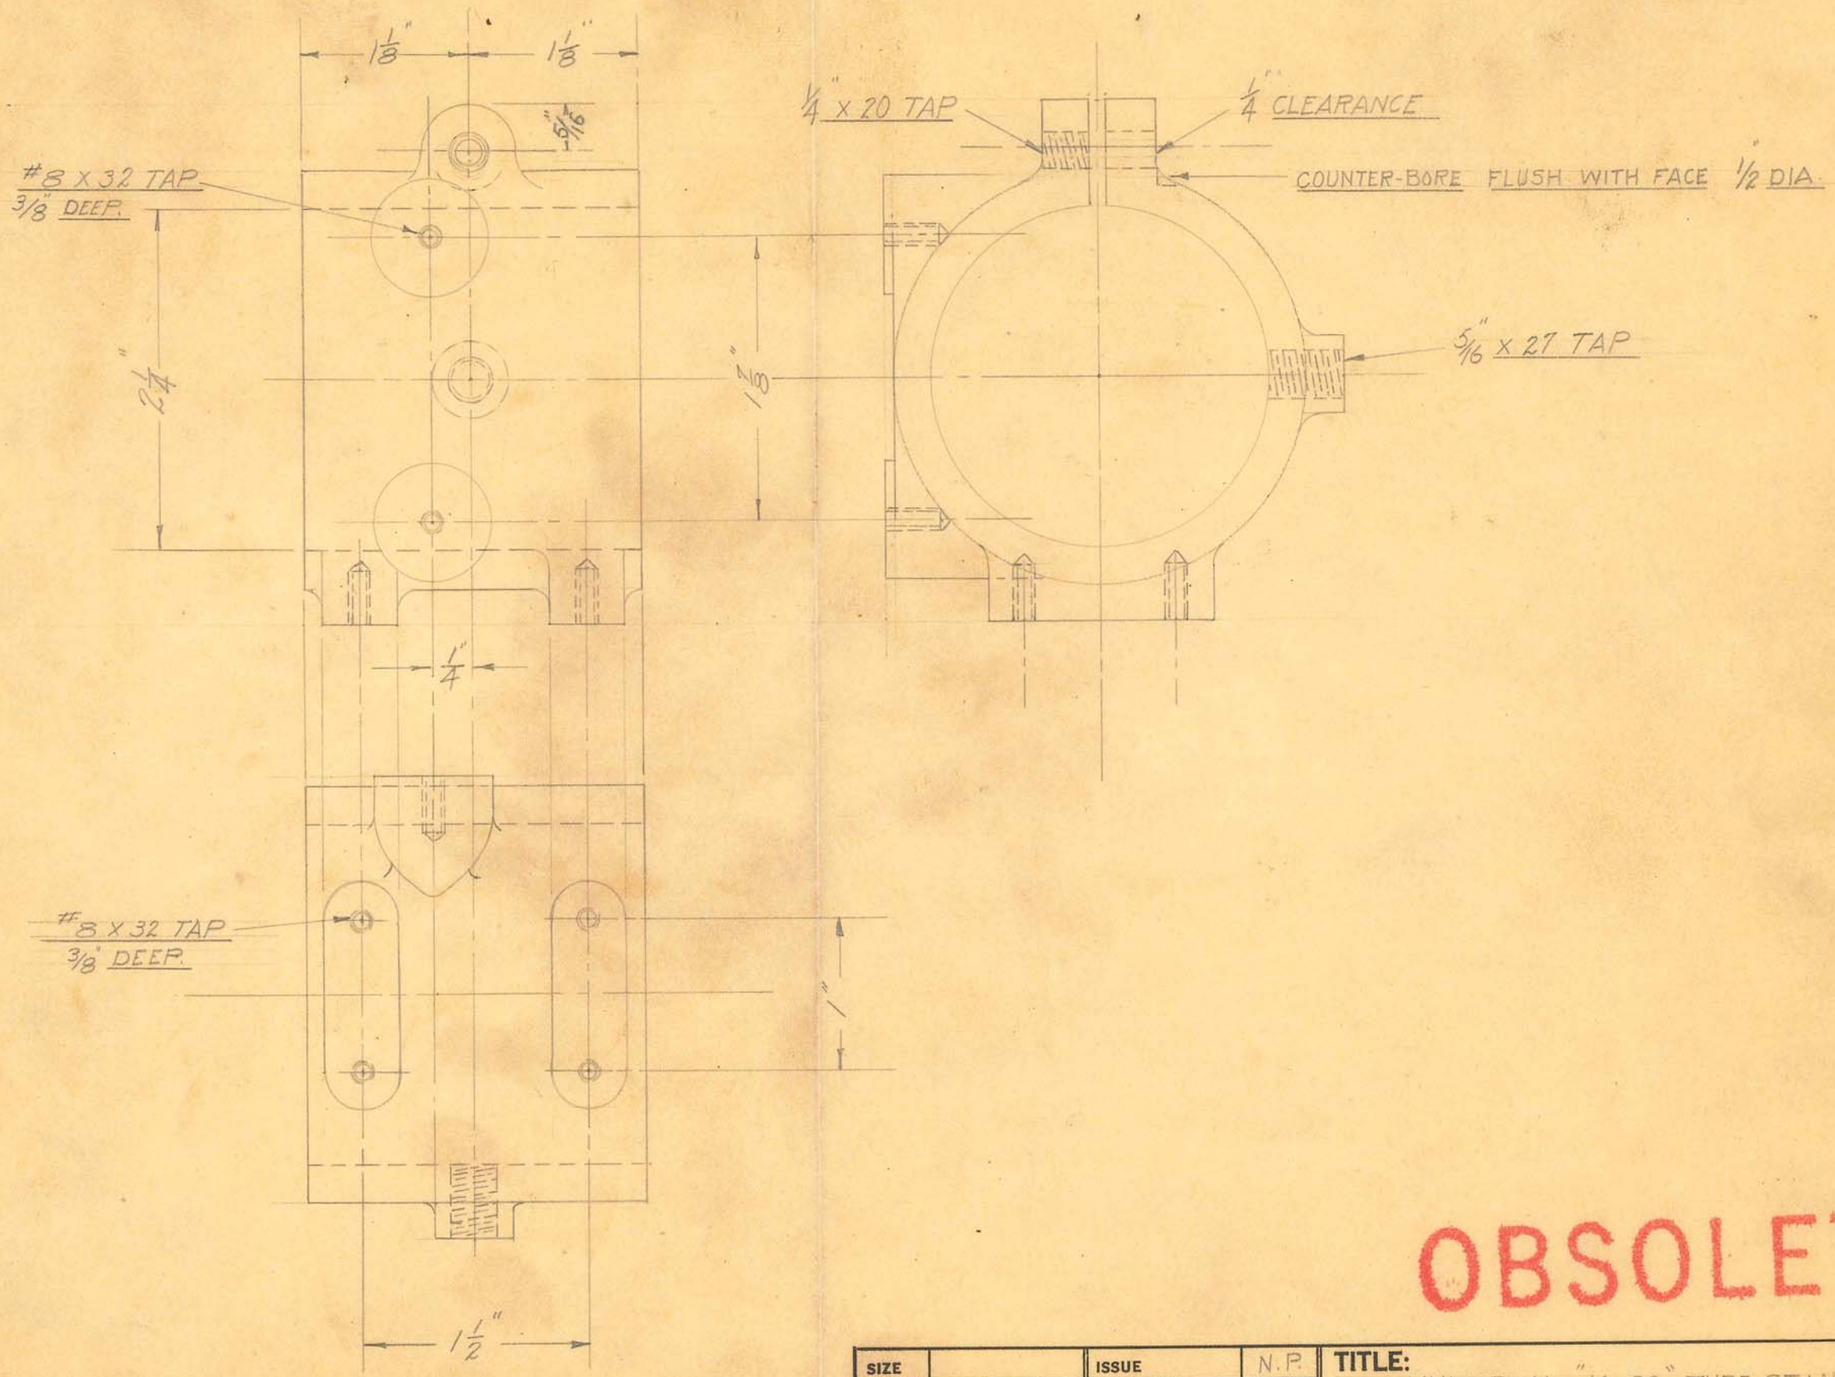

OBSOLETE

SIZE		ISSUE	N.P.
KIND	AL. CASTING	CHANGED	
SHAPE		" "	
FINISH	BLACK LACQUER	" "	
TEMP.		" "	
PATT.	#4274-652	" "	

TITLE: UNIVERSAL "60-88" TUBE STAND CABLE BRACKET SUPPORT CASTING

H. G. FISCHER & CO.
2335 WABANSIA AVE.
CHICAGO, ILL.

CAT. NO.

PART NO. 8266F

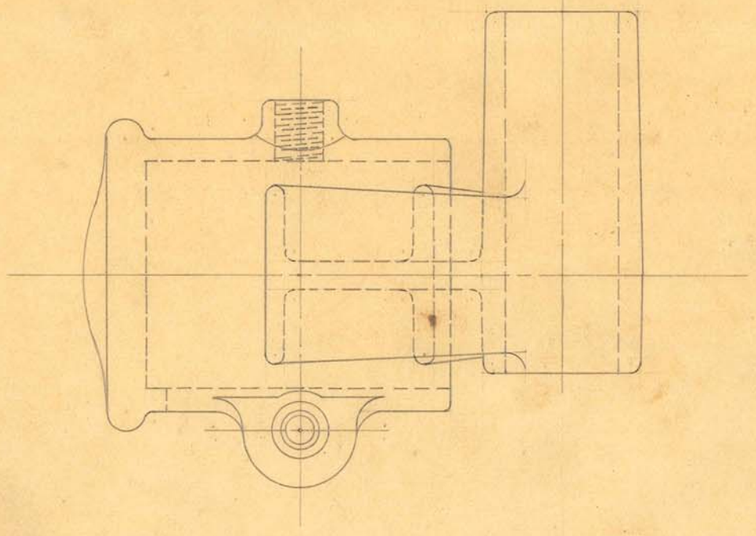

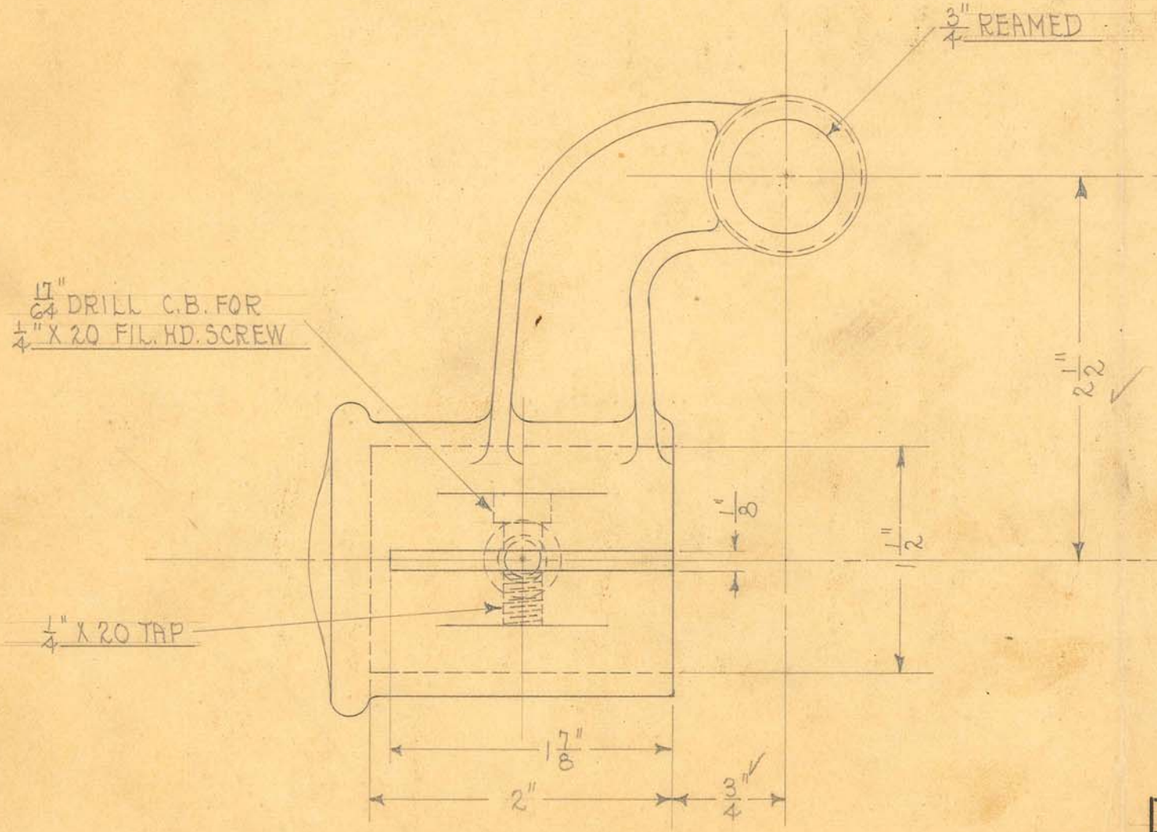

1 REQUIRED

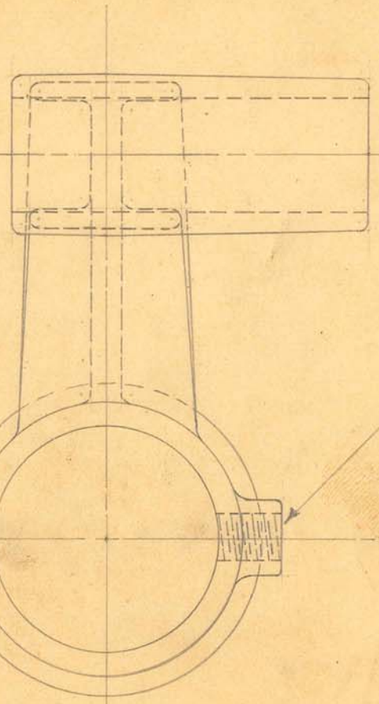

OBSOLETE

SIZE		ISSUE 7-11-33	A.E.G.
KIND	ALUM. CASTING	CHANGED	
SHAPE		" "	
FINISH	BLK. LACQUER	" "	
TEMP.		" "	
PATT.	2955-G31	" "	

TITLE:
UNIVERSAL "CO-88" TUBE STAND
HORIZONTAL TUBE OPERATING BRACKET

H. G. FISCHER & CO.
2335 WABANSIA AVE.
CHICAGO, ILL.

CAT. NO.

PART NO. 8282F

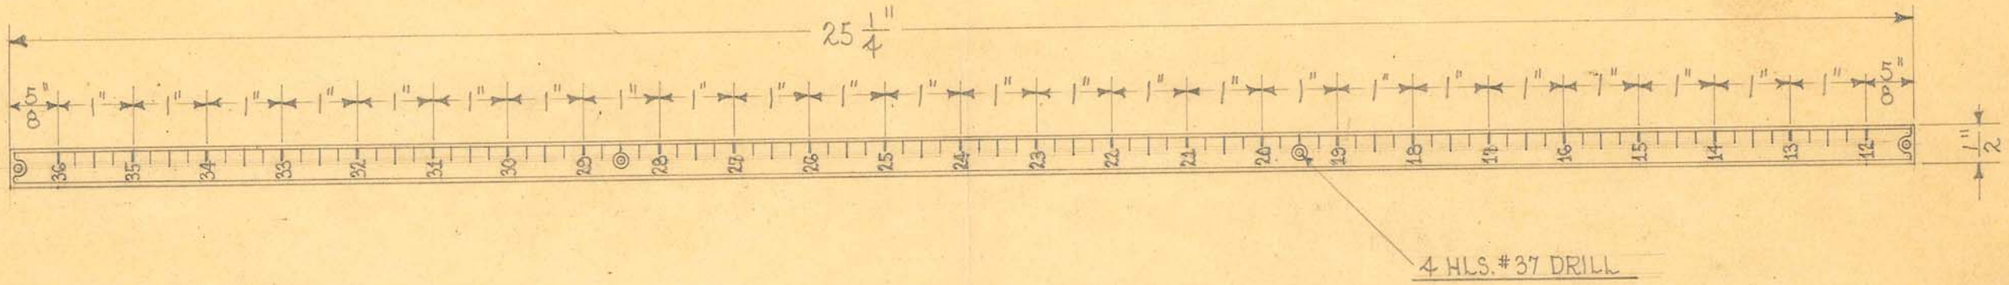

SCALE ~ 1/2" = 1"

OBSOLETE

SIZE		ISSUE 4-29-33	A.E.
KIND		CHANGED	
SHAPE		" "	
FINISH		" "	
TEMP.		" "	
CAST		" "	

TITLE: UNIVERSAL "CO-88" TUBE STAND VERTICAL SCALE

H. G. FISCHER & CO.
2335 WABANSIA AVE.
CHICAGO, ILL.

CAT. NO.

PART NO. 8289

SIZE	2"x 1/8"	ISSUE 4-10-45	L.V.W.	H. G. FISCHER & CO. 3338 MADRID AVE. CHICAGO, ILL.	NO. 13438 5/1
KIND	C.R. STEEL	CHANGED		CAT.	PART
SHAPE		"			
FINISH		"		TITLE: FISCHER MOD. "FT-100" CONTROL BOX RESISTOR SUPPORT STRAP	
TEMP.		"			
PAT.		"			

OBSOLETE

REVISED

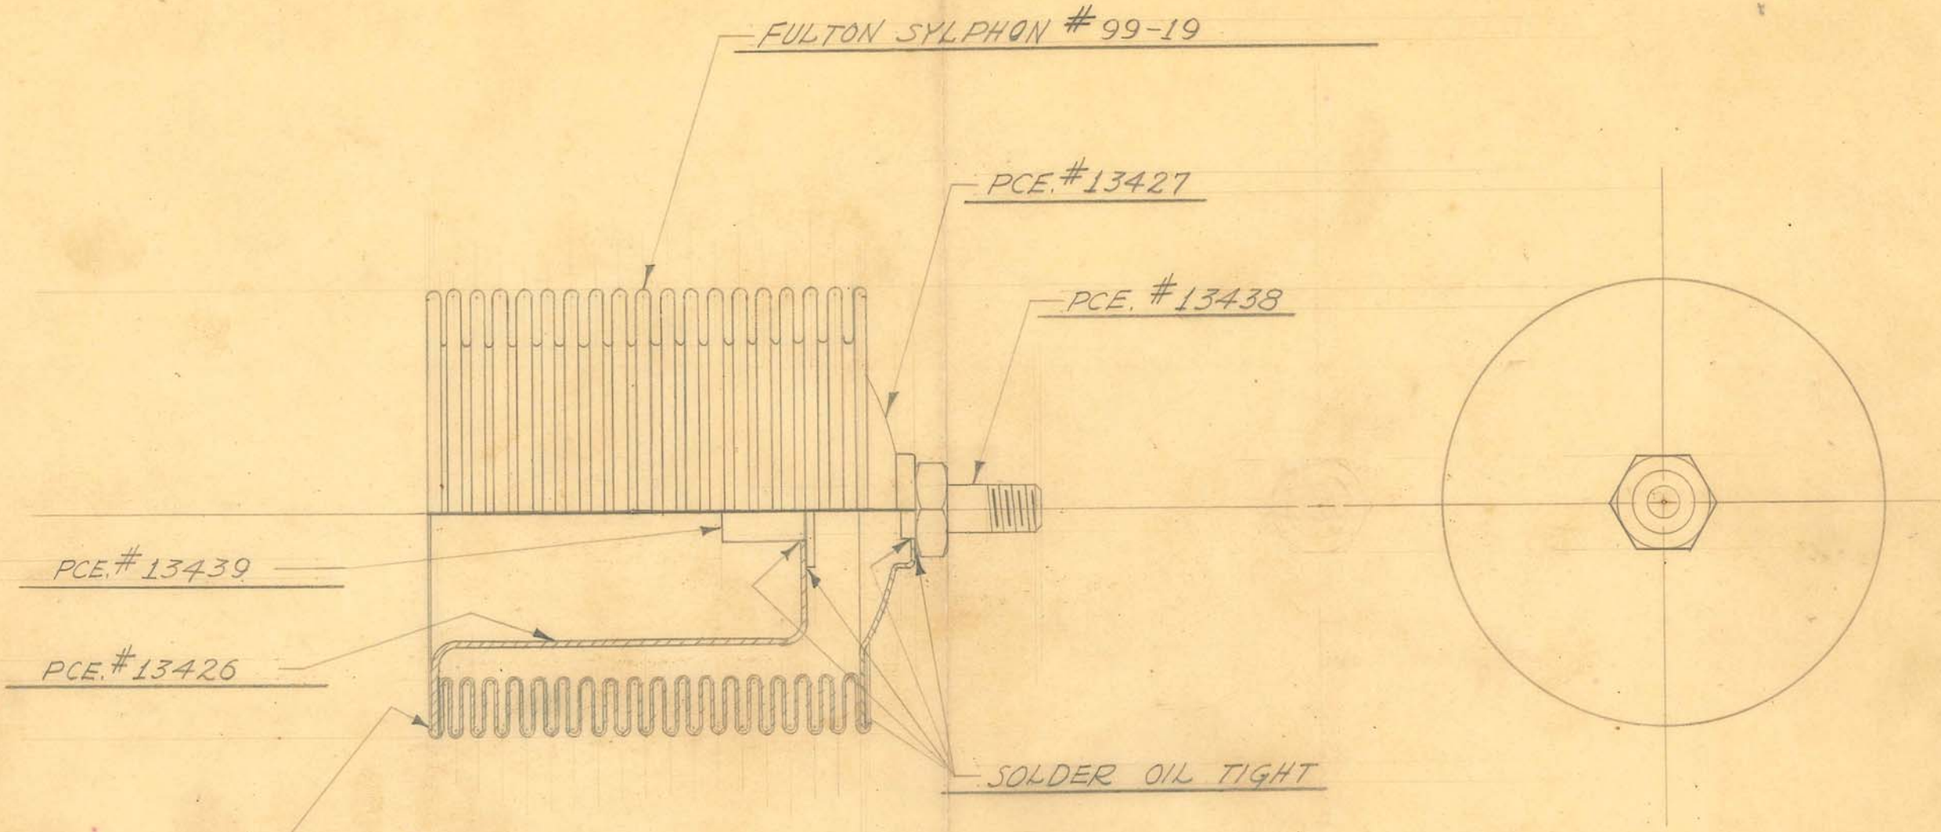

1 REQUIRED

OBSOLETE

Obsolete

SIZE		ISSUE 9-24-40	J.V.W.
KIND		CHANGED	
SHAPE		"	
FINISH		"	
TEMP.		"	
PATT.		"	

TITLE: FISCHER MOD. "100-96" DIAGNOSTIC S.P.X-RAY TUBE HEAD BELLOWS ASSEMBLY

H. G. FISCHER & CO.
2335 WABANSIA AVE.
CHICAGO, ILL.

CAT. NO.

PART NO. 13407G

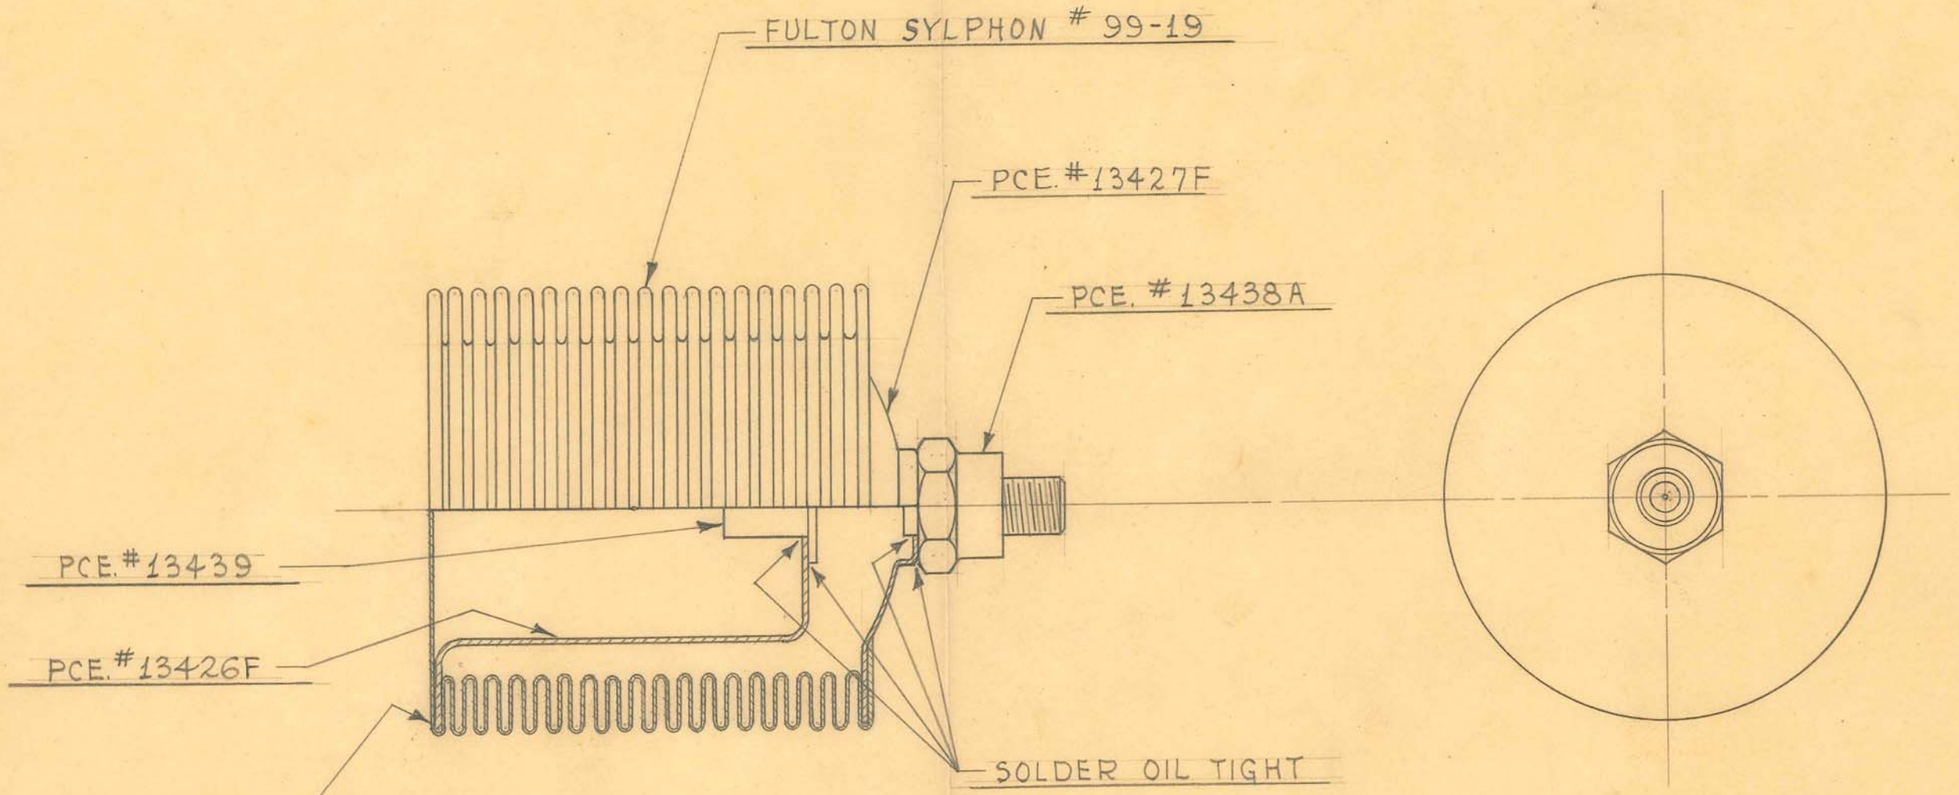

1 REQUIRED

OBSOLETE
8-27-68 CRS

SIZE		ISSUE 7-3-45	HE.
KIND		CHANGED	
SHAPE		"	
FINISH		"	
TEMP.		"	
PATT.		"	

TITLE: FISCHER MOD. "100-96" DIAG. S.P. X-RAY TUBE HEAD BELLOWS ASSEMBLY

H. G. FISCHER & CO.
2335 WABANSIA AVE.
CHICAGO, ILL.

CAT. NO.

PART NO. 13407GA

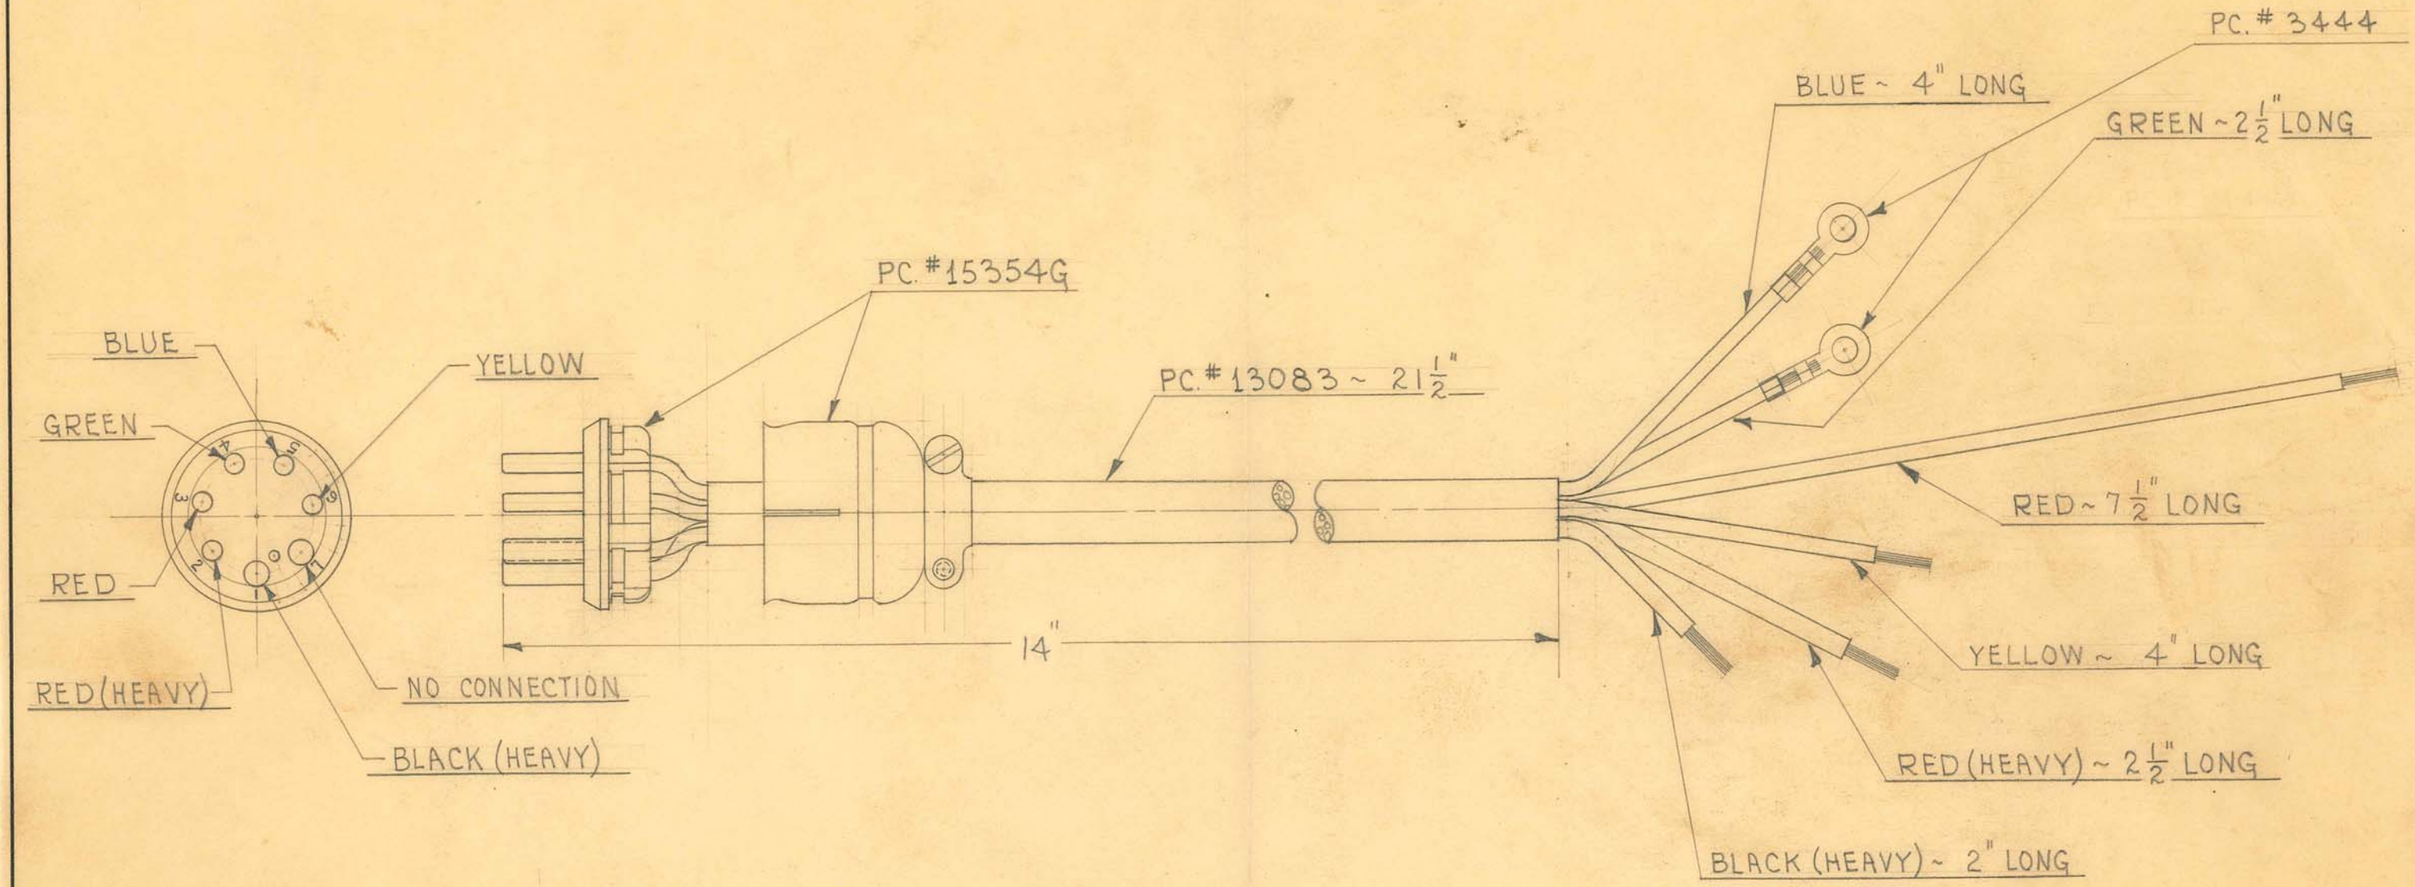

1 REQUIRED

NOTE:
CUT OFF 3 WIRES WHICH ARE NOT USED.

OBSOLETE

SIZE		ISSUE 3-27-44	HE.	TITLE: FISCHER "VC" SHORT WAVE APPARATUS ~ BUFFER COMP. ~ CORD ASSEM.
KIND		CHANGED		
SHAPE		"		
FINISH		"		
TEMP.		"		
PATT.		"		

H. G. FISCHER & CO.
2335 WABANSIA AVE.
CHICAGO, ILL.

CAT. NO.

PART NO. 15355G

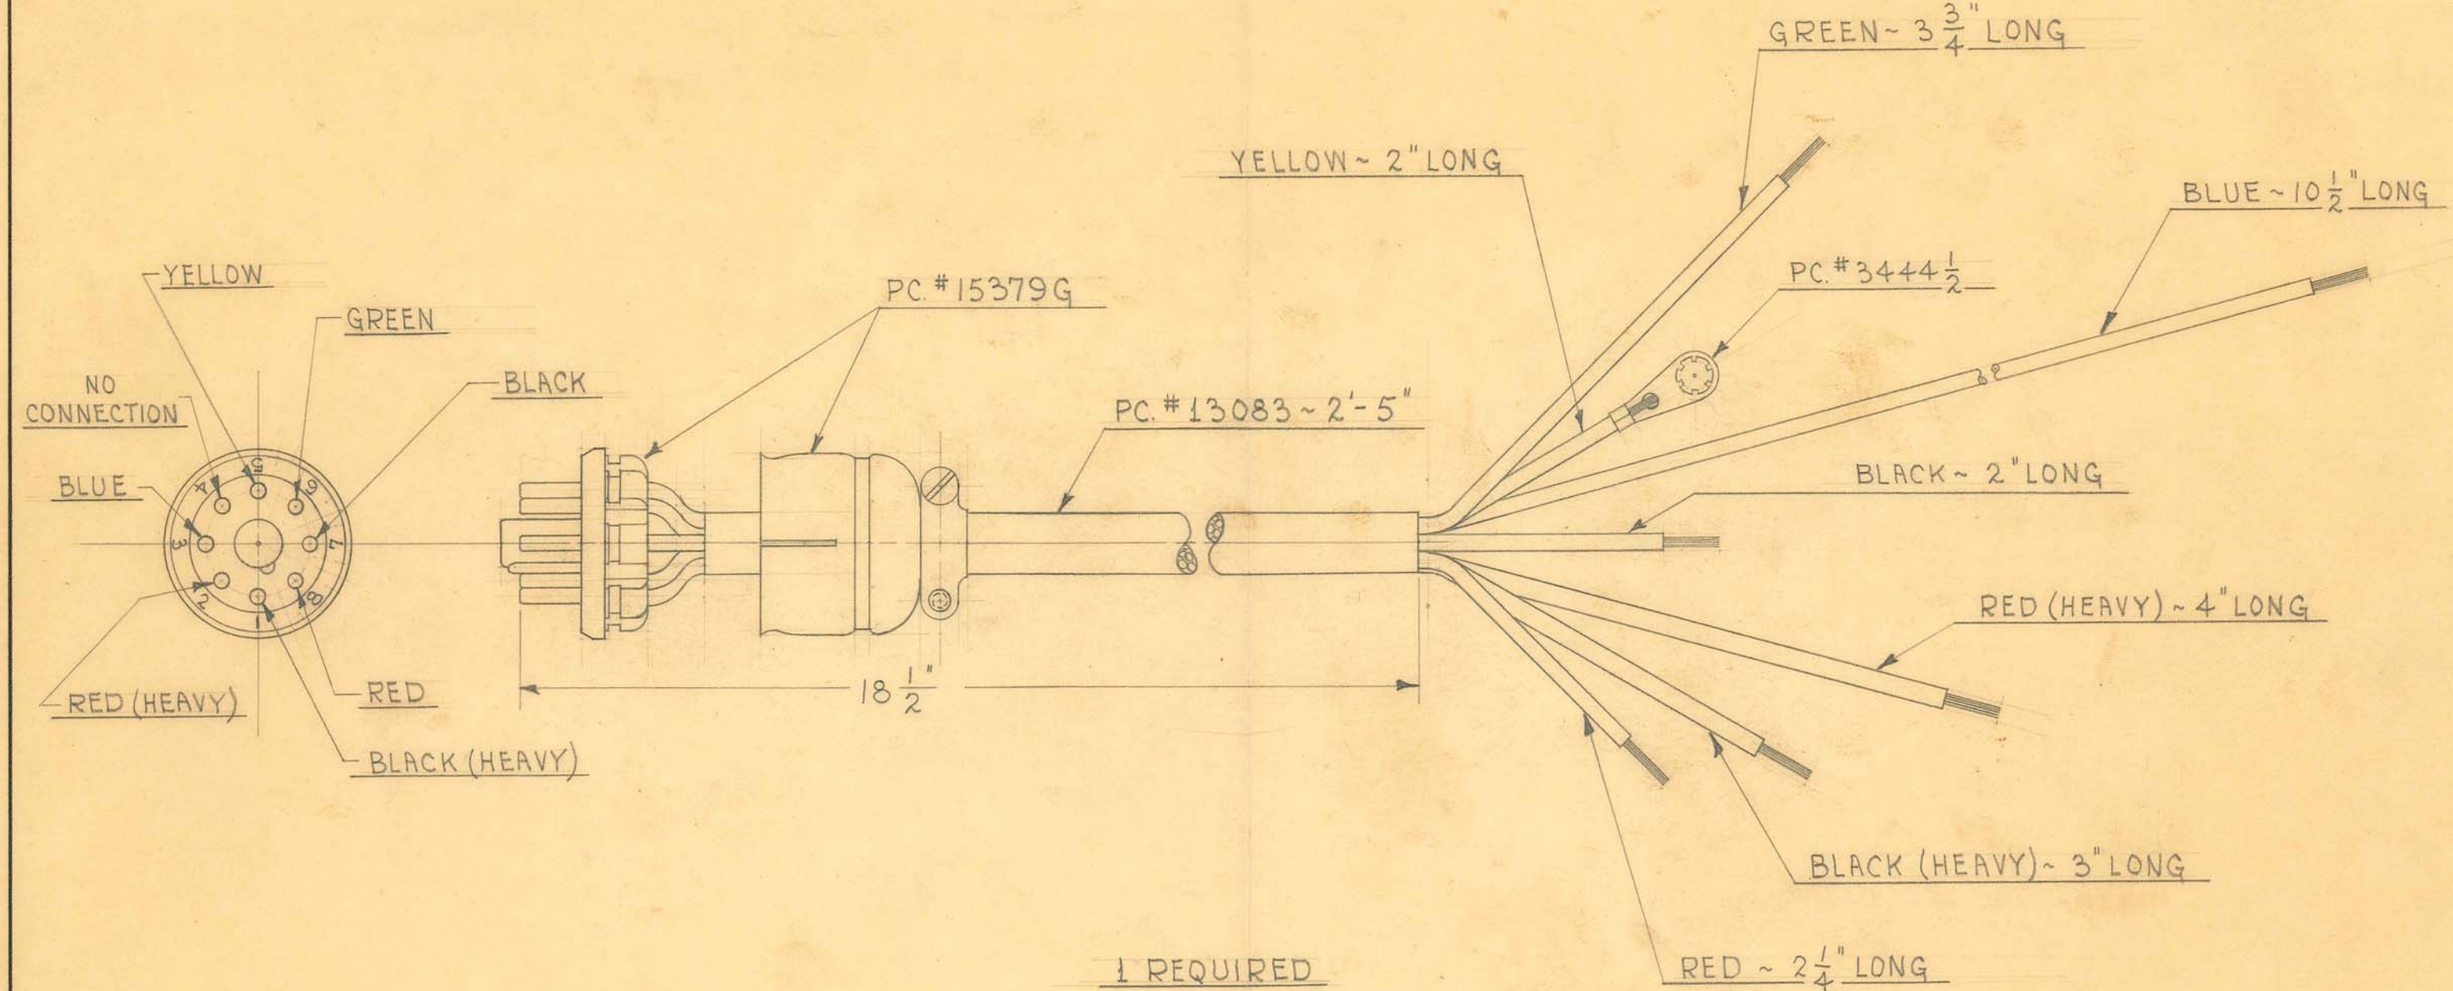

1 REQUIRED

NOTE:
CUT OF 2 WIRES WHICH ARE NOT USED.

OBSOLETE

SIZE		ISSUE 3-29-44	HE.	TITLE: FISCHER "VC" SHORT WAVE APPARATUS ~ CRYSTAL COMP. ~ CORD ASSEM.
KIND		CHANGED		
SHAPE		"		
FINISH		"		
TEMP.		"		
PATT.		"		

H. G. FISCHER & CO.
2338 WABANSIA AVE.
CHICAGO, ILL.

CAT. NO.

PART NO. 15385G

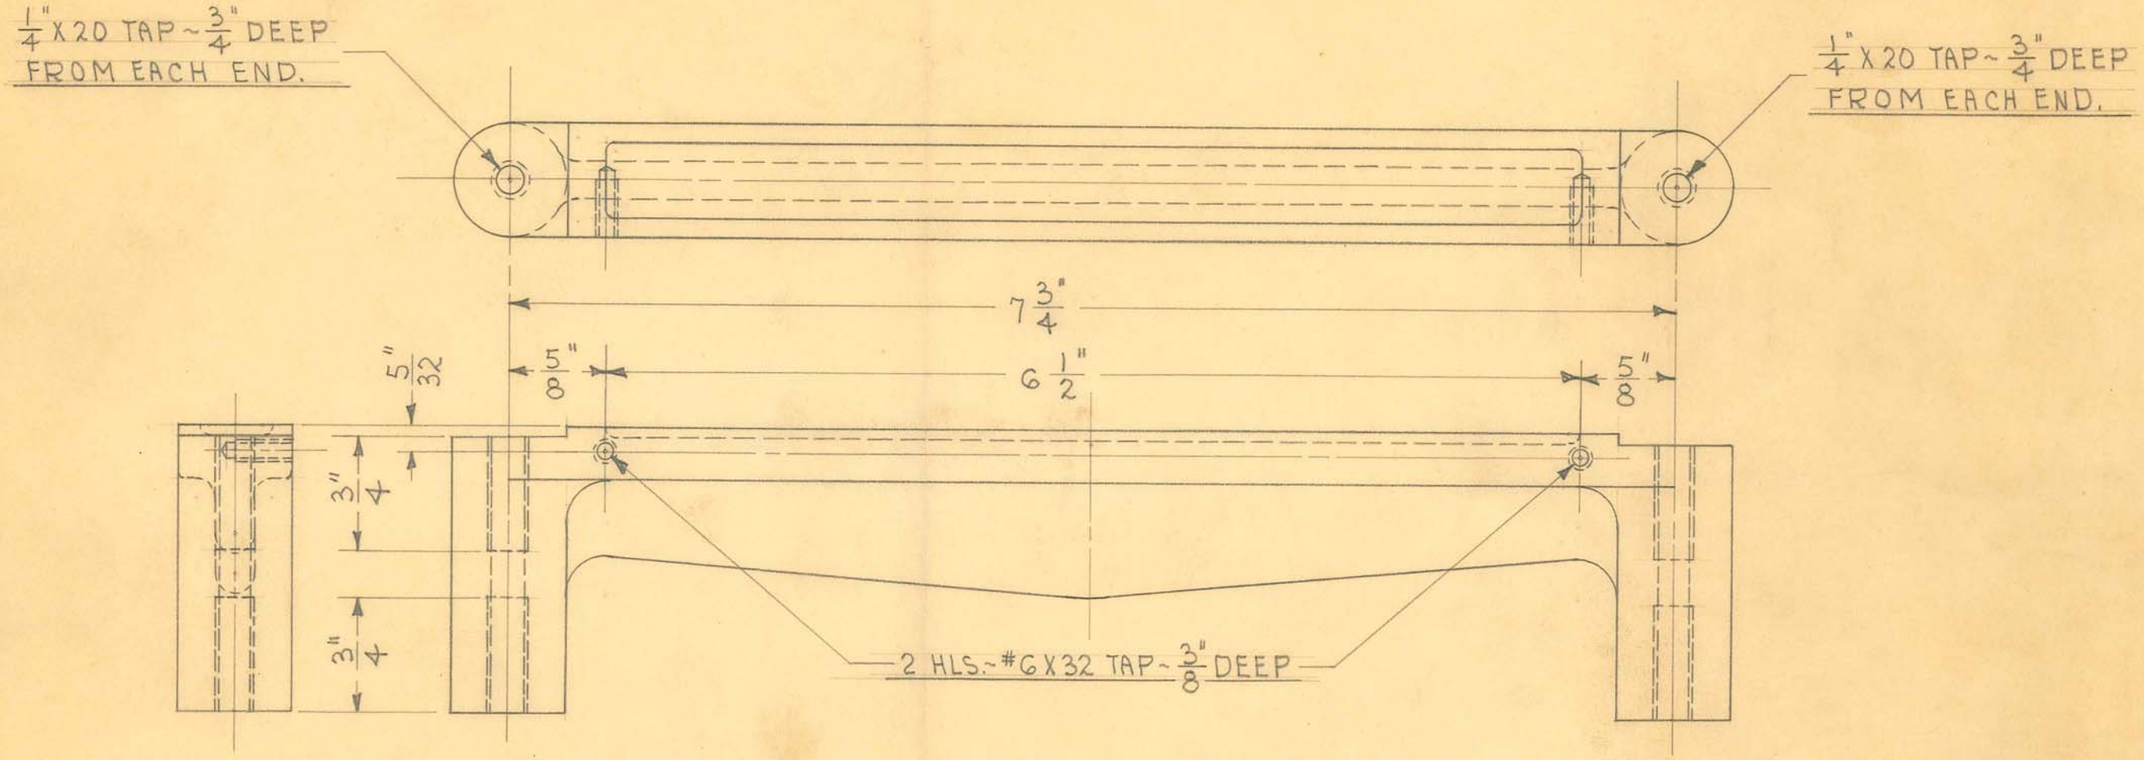

1 REQUIRED

OBSOLETE

SIZE		ISSUE 3-2-44	HE.
KIND	IRON CASTING	CHANGED	
SHAPE		"	
FINISH	BLACK #81	"	
TEMP.		"	
PATT.	739	"	

TITLE: FISCHER "VC" SHORT WAVE APPARATUS - POWER TRANSFORMER SUPPORT ~ TAPPED

H. G. FISCHER & CO.
2335 WABANSIA AVE.
CHICAGO, ILL.

CAT. NO.

PART NO. 15421

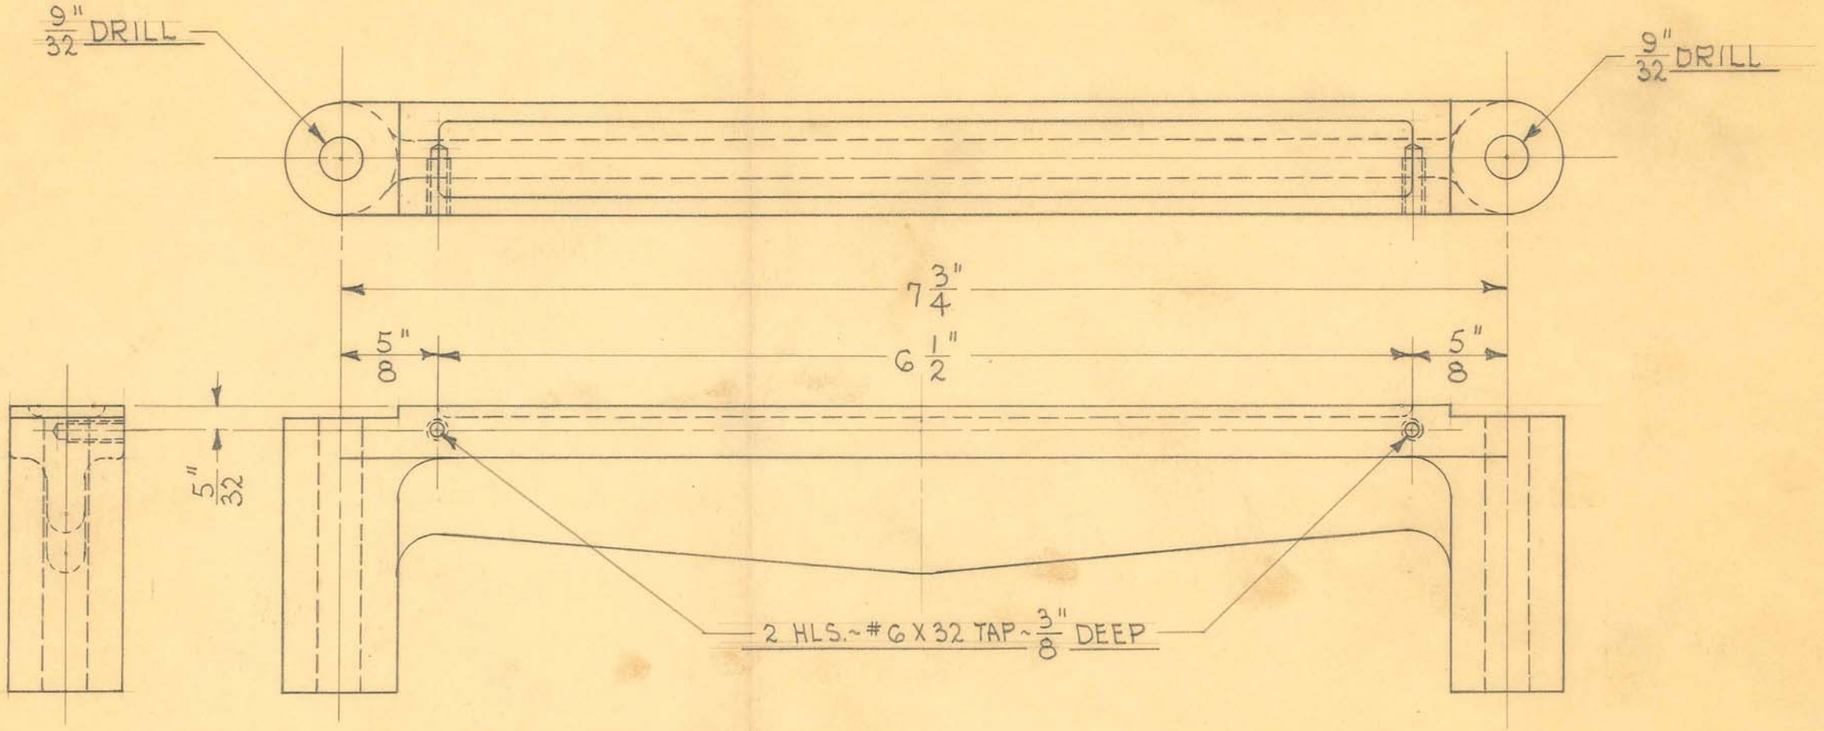

1 REQUIRED

OBSOLETE

SIZE		ISSUE 3-2-44	HE.
KIND	IRON CASTING	CHANGED	
SHAPE		"	
FINISH	BLACK #81	"	
TEMP.		"	
PATT.	739	"	

TITLE: FISCHER "VC" SHORT WAVE APPARATUS~ POWER TRANSFORMER SUPPORT~CLEARANCE

H. G. FISCHER & CO.
2335 WABANSIA AVE.
CHICAGO, ILL.

CAT. NO.

PART NO. 15422

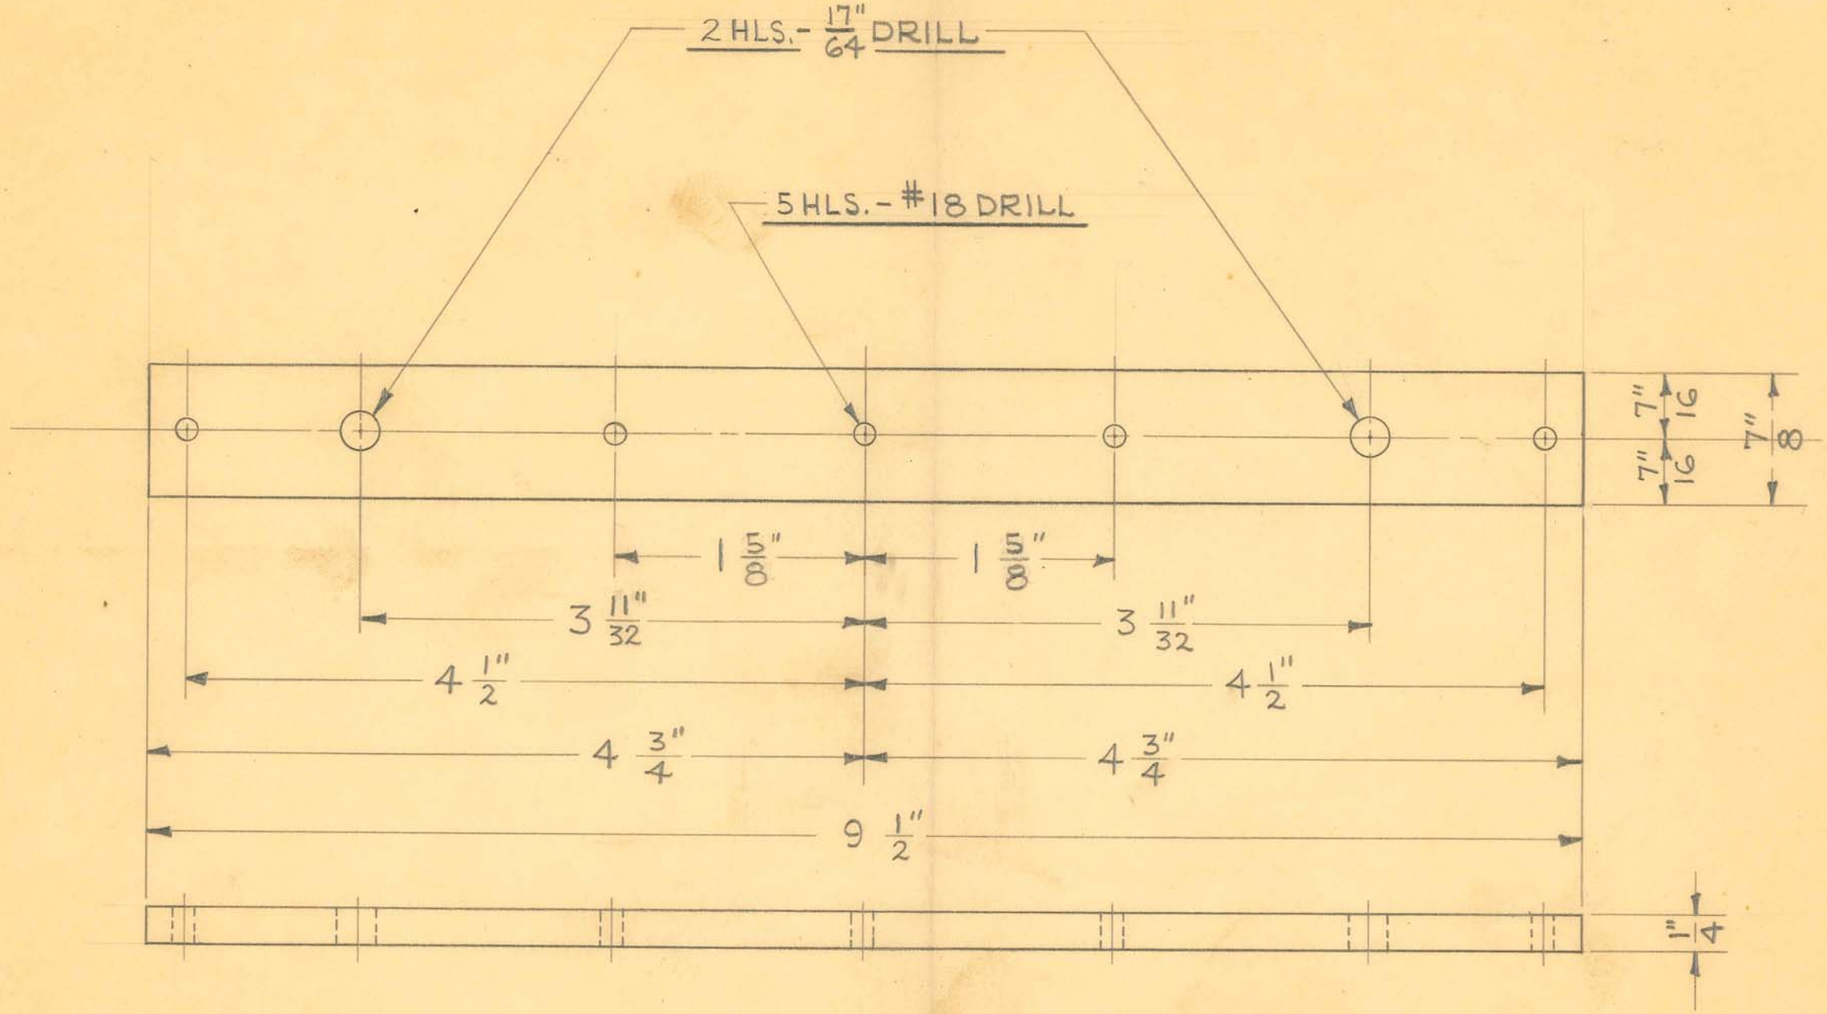

1 REQUIRED

OBSOLETE

SIZE	1/4" SHEET	ISSUE 2-21-44	J.V.W.
KIND	BAKELITE	CHANGED	
SHAPE		"	
FINISH		"	
TEMP.		"	
PATT.		"	

TITLE: FISCHER "VC" SHORT WAVE APP. POWER UNIT - SECONDARY TERMINAL STRIP

H. G. FISCHER & CO.
2335 WABANSIA AVE.
CHICAGO. ILL.

CAT. NO.

PART NO. 15424F

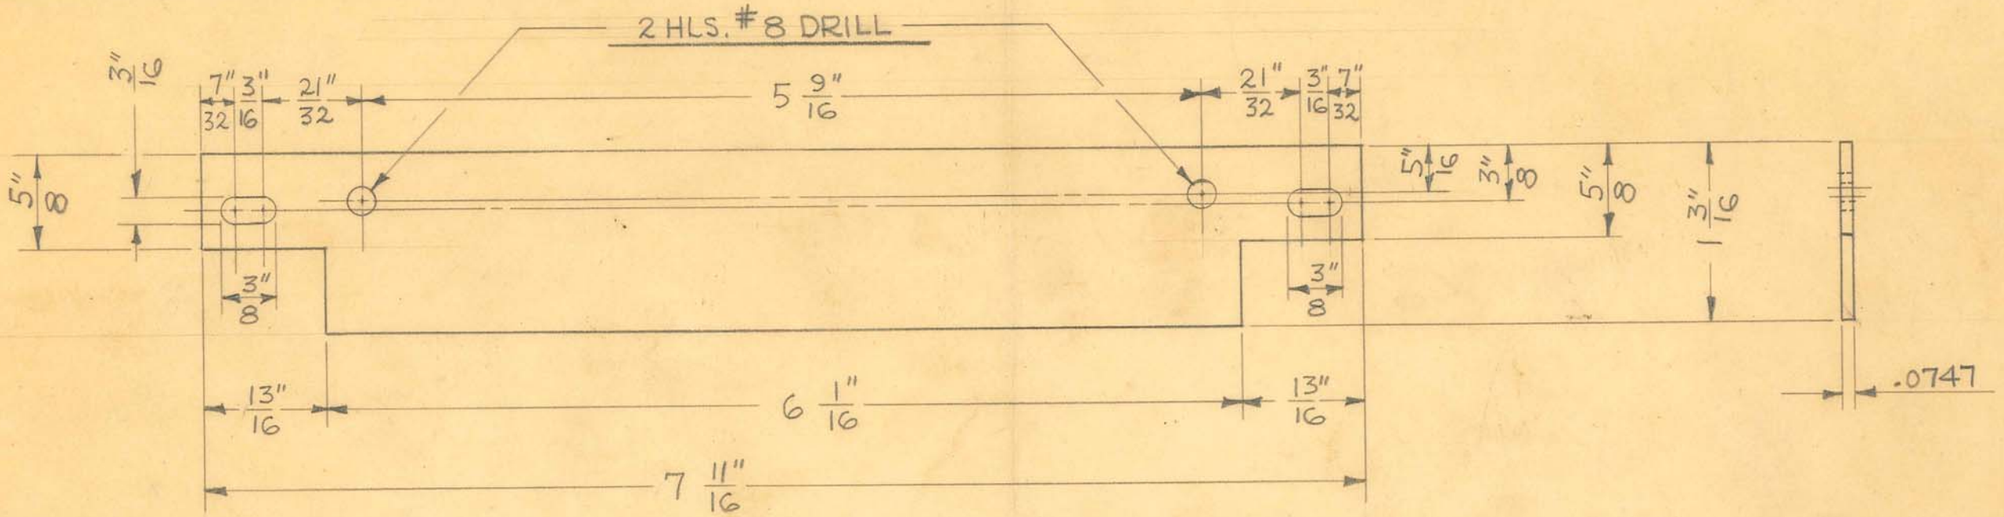

BLANK — #14 GA. (.0747") SHEET C.R. STEEL

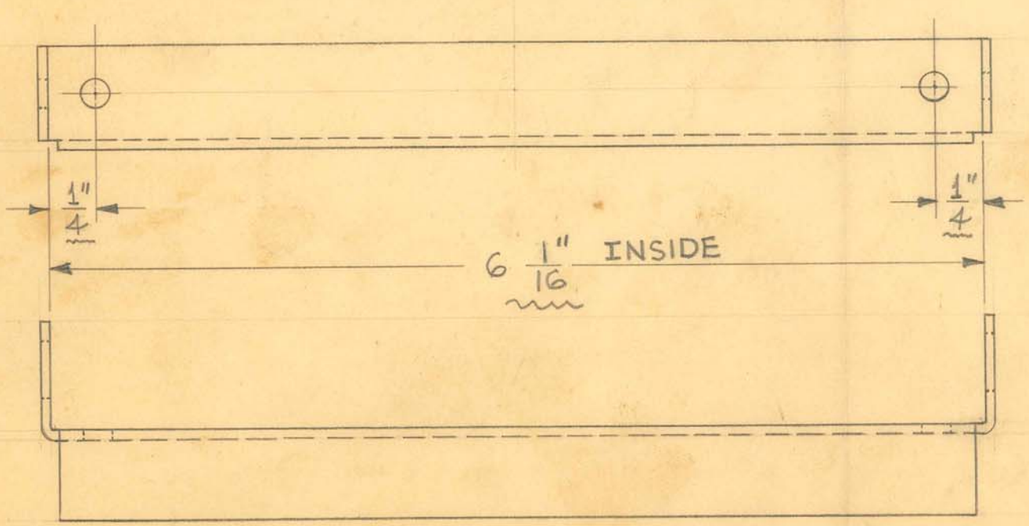

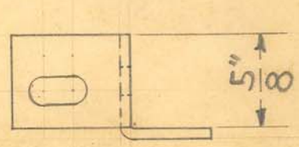

OBSOLETE

4 REQUIRED

SIZE		ISSUE 2-23-44	J.V.W.	TITLE: FISCHER "VC" SHORT WAVE APP. POWER UNIT RECT. FILAMENT TRANSF. SUPPORT
KIND		CHANGED		
SHAPE		"		
FINISH		"		
TEMP.		"		
PATT.		"		

H. G. FISCHER & CO.
2335 WABANSIA AVE.
CHICAGO, ILL.

CAT. NO.

PART NO. 15431

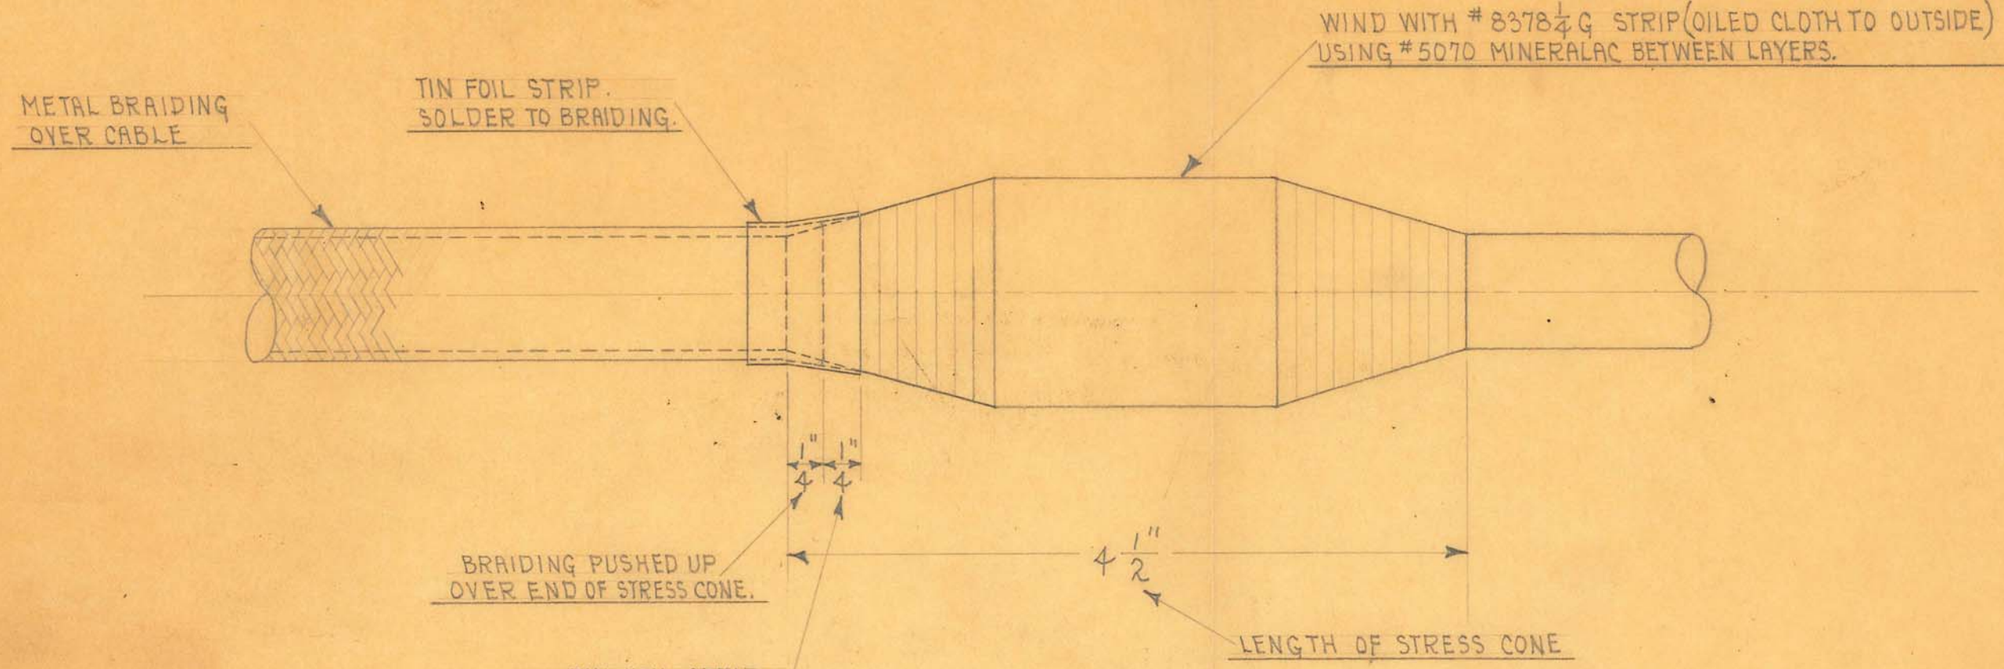

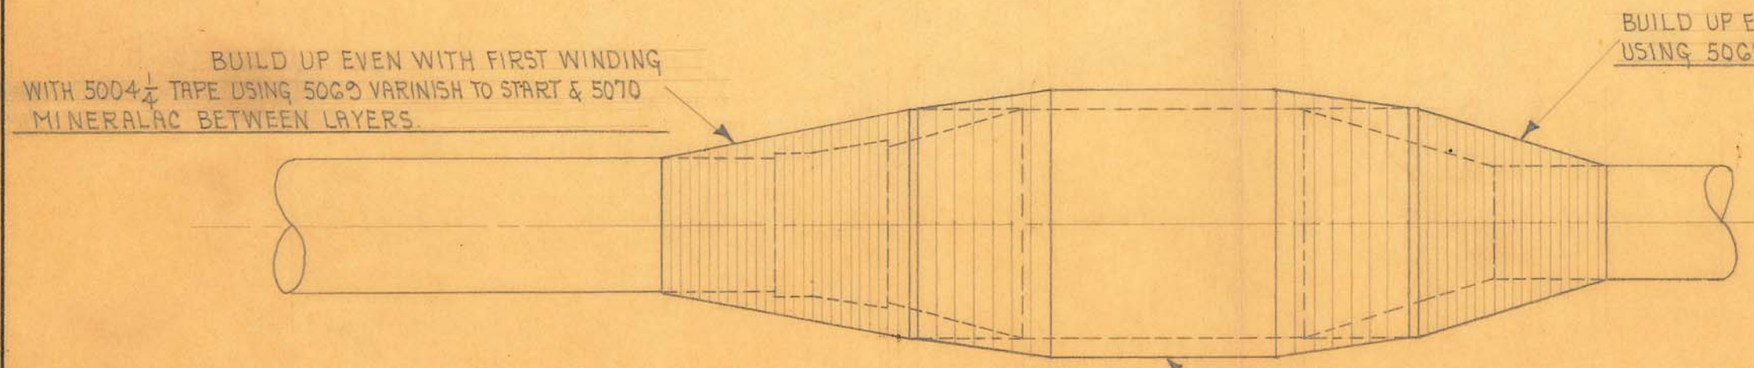

OBSOLETE

SIZE		ISSUE 5-24-35	A.E.	TITLE: UNIVERSAL "60-88" HIGH TENSION CABLE TUBE END STRESS CONE
KIND		CHANGED		
SHAPE		" "		
FINISH		" "		
TEMP.		" "		H. G. FISCHER & CO. 2335 WABANSIA AVE. CHICAGO, ILL. — CAT. NO. — PART NO. 8378G
PATT.		" "		

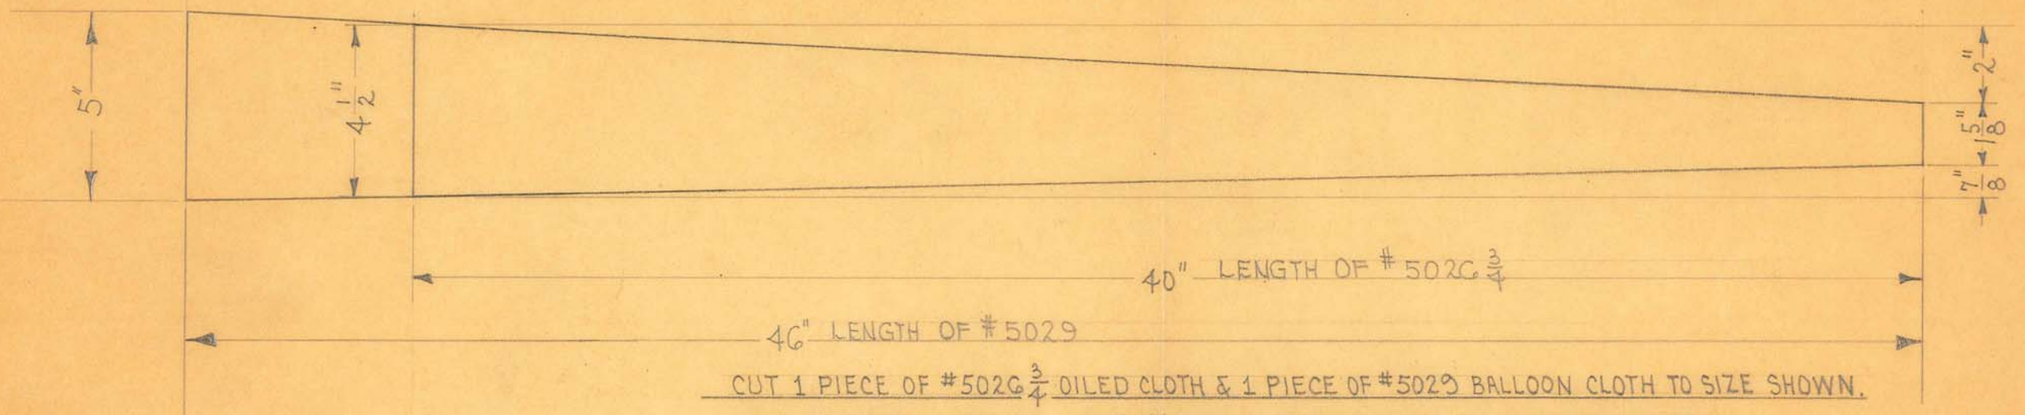

CUT 1 PIECE OF #502C $\frac{3}{4}$ OILED CLOTH & 1 PIECE OF #5029 BALLOON CLOTH TO SIZE SHOWN.
SEW BALLOON CLOTH ON OPPOSITE SIDE TO THAT SHOWN. DO NOT SEW ENDS.

1 REQUIRED

SCALE ≈ $\frac{1}{4}$" = 1"

OBSOLETE

Obsolete

SIZE		ISSUE 5-24-35	A.E.	TITLE: UNIVERSAL "GO-88" TUBE STAND H.T. CABLE TUBE END STRESS CONE STRIP ASSEM.
KIND		CHANGED		
SHAPE		" "		
FINISH		" "		
TEMP.		" "		H. G. FISCHER & CO. 2335 WABANSIA AVE. CHICAGO, ILL. — CAT. NO. — PART NO. 8378 1/4 GA
PATT.		" "		

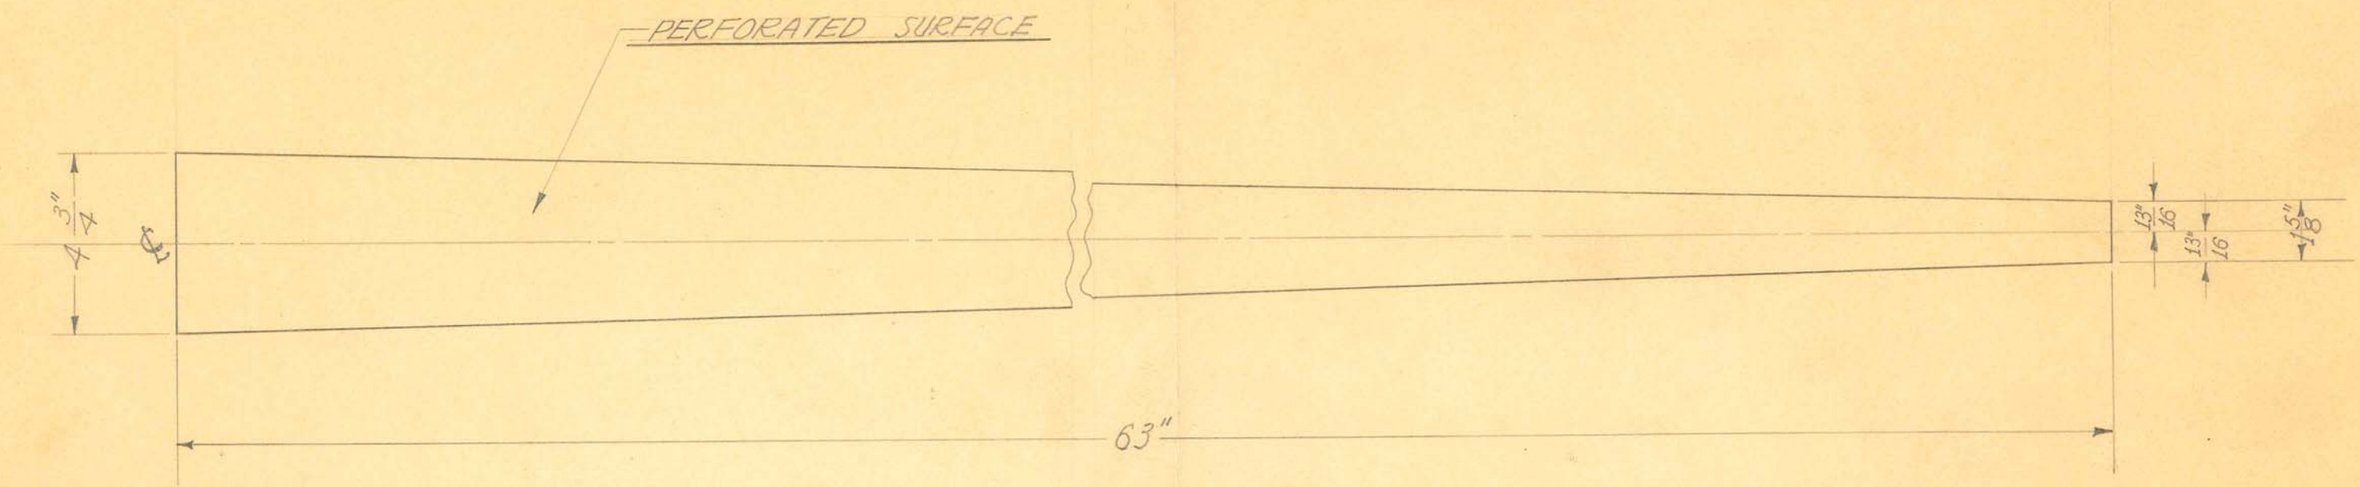

FROM #5026 3/4 OILED CLOTH

SCALE ÷ 1/4" = 1"

1 REQUIRED

OBSOLETE

SIZE		ISSUE 5-23-38	J.W.
KIND		CHANGED	
SHAPE		"	
FINISH		"	
TEMP.		"	

TITLE:
UNIVERSAL "60-88" TUBE STAND H.T. CABLE
TUBE END STRESS CONE STRIP

H. G. FISCHER & CO.
2335 WABANSIA AVE.

CAT. NO.

PART NO. 8378-1/4B

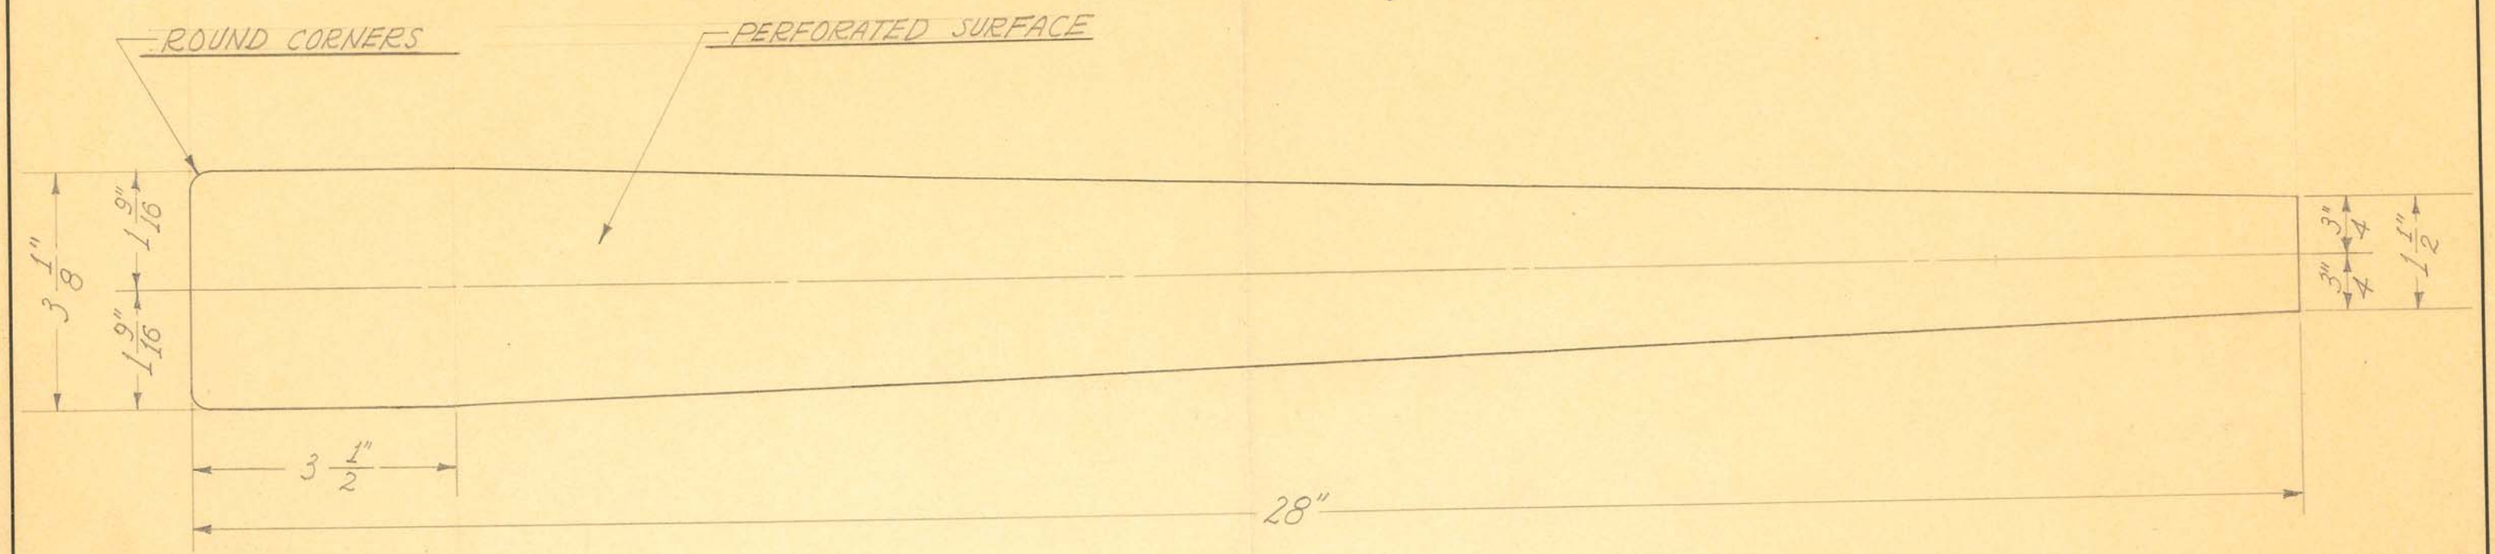

FROM #5026 3/4 OILED CLOTH

SCALE ~ 1/2" = 1"

1 REQUIRED

OBSOLETE

SIZE		ISSUE 5-23-38	J.W.	TITLE: UNIVERSAL "60-88" TUBE STAND H.T. CABLE TUBE END STRESS CONE FINISHING STRIP
KIND		CHANGED		
SHAPE		"		
FINISH		"		
TEMP.		"		
PATT.		"		

H. G. FISCHER & CO.
2335 WABANSIA AVE.
CHICAGO, ILL.

CAT. NO.

PART NO. 8378 1/2 A

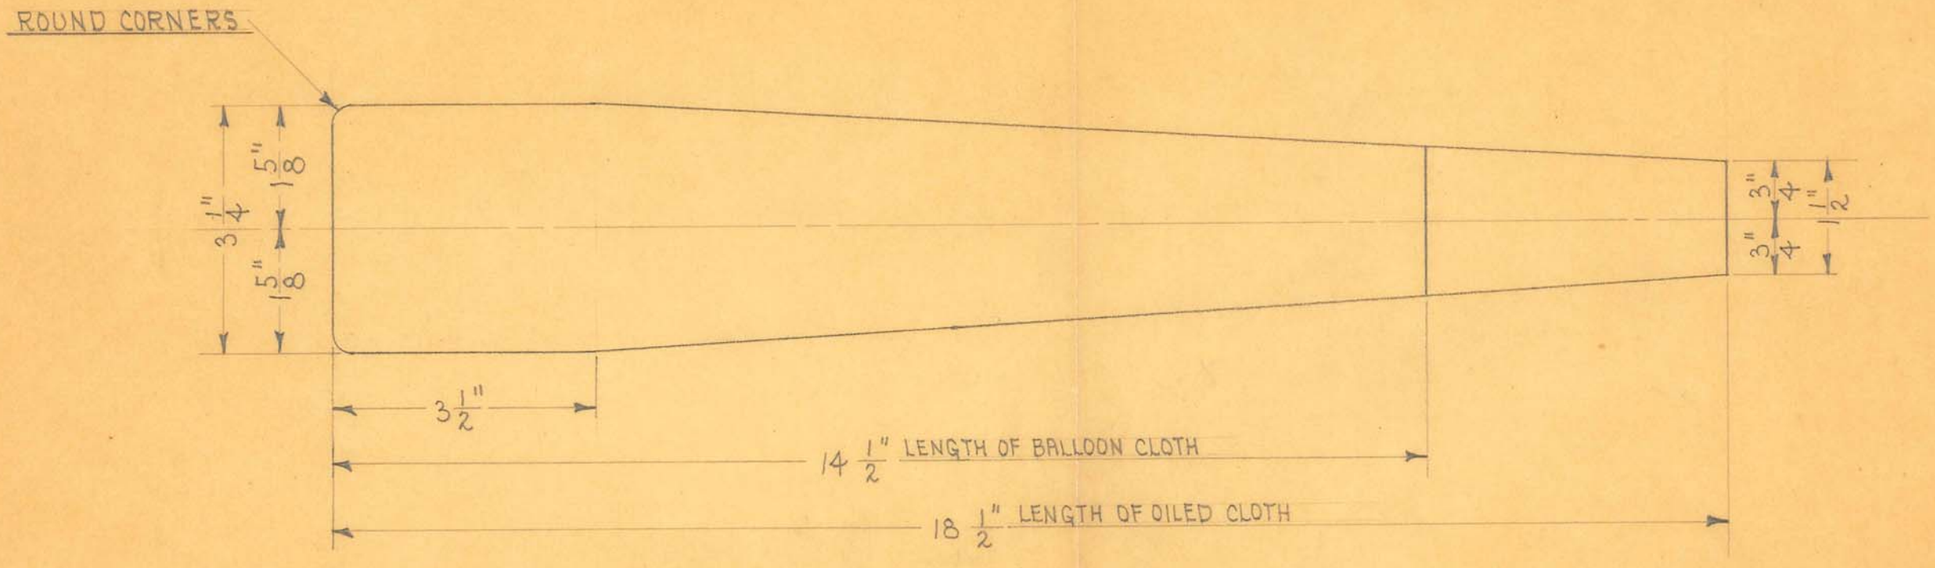

CUT 1 PIECE OF #502G $\frac{3}{4}$ OILED CLOTH & 1 PIECE OF #5029 BALLOON CLOTH TO SIZES SHOWN.
SEW TOGETHER ON SIDES ONLY. DO NOT SEW ENDS.

1 REQUIRED
SCALE ~ $\frac{1}{2}$" = 1"

OBSOLETE

SIZE		ISSUE 5-24-35	J.E.
KIND		CHANGED	
SHAPE		" "	
FINISH		" "	
TEMP.		" "	
PATT.		" "	

TITLE: UNIVERSAL "60-88" TUBE STAND H.T. CABLE TUBE END STRESS CONE FINISHING STRIP ASSEM.

H. G. FISCHER & CO.
2335 WABANSIA AVE.
CHICAGO, ILL.

CAT. NO.

PART NO. 8378 $\frac{1}{2}$G

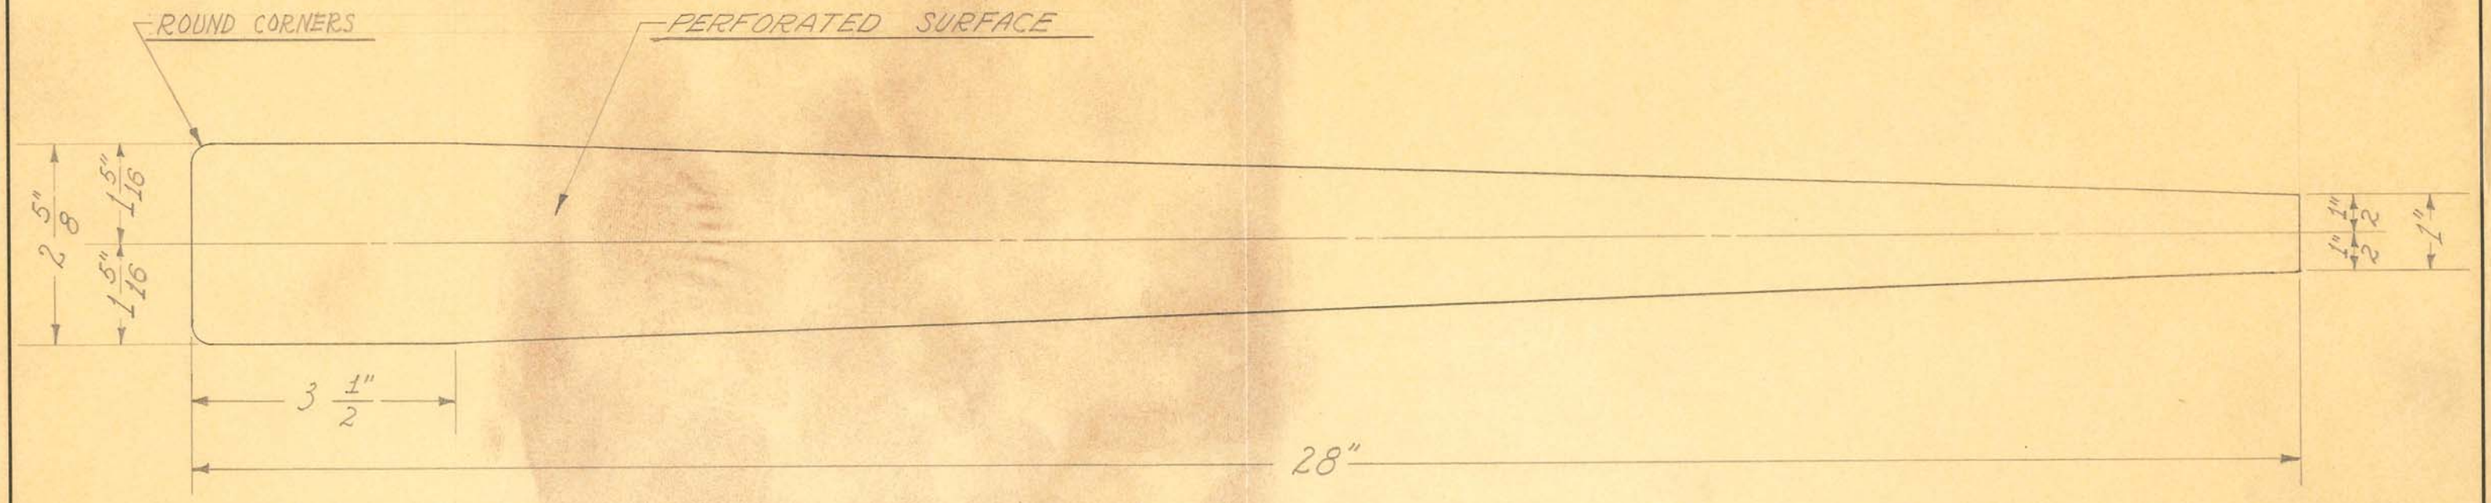

FROM #5026 3/4" OILED CLOTH

SCALE ÷ 1/2" = 1"

1 REQUIRED

OBSOLETE

SIZE		ISSUE 5-23-38	J.W.
KIND		CHANGED	
SHAPE		"	
FINISH		"	
TEMP.		"	
PATT.		"	

TITLE: UNIVERSAL "60-88" TUBE STAND H.T. CABLE TRANSF. END STRESS CONE FINISHING STRIP

H. G. FISCHER & CO.
2335 WABANSIA AVE.
CHICAGO, ILL.

CAT. NO.

PART NO. 8379 1/2 A

METAL BRAIDING OVER CABLE

TIN FOIL STRIP. SOLDER TO BRAIDING.

WIND WITH # 8379 1/4 G STRIP (OILED CLOTH TO OUTSIDE) USING # 5070 MINERALAC BETWEEN LAYERS.

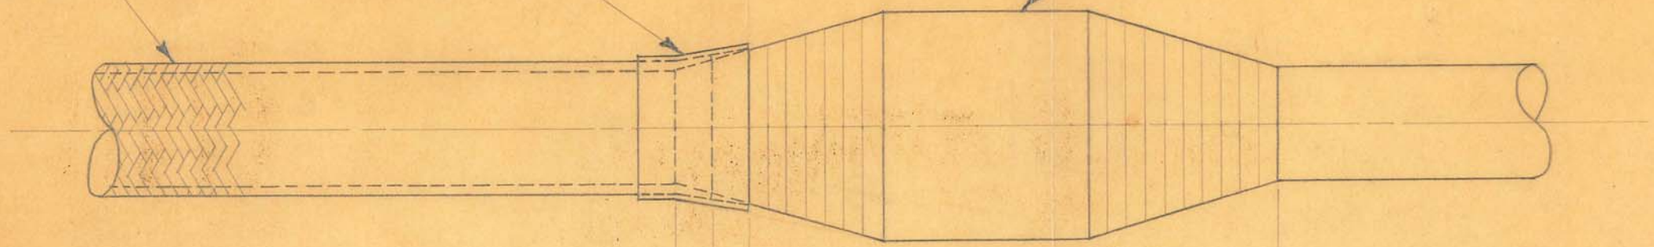

BRAIDING PUSHED UP OVER END OF STRESS CONE.

TIN FOIL STRIP OVERLAPS BRAIDING

LENGTH OF STRESS CONE

BUILD UP EVEN WITH FIRST WINDING WITH 5004 1/2 TAPE USING 5069 VARNISH TO START & 5070 MINERALAC BETWEEN LAYERS.

BUILD UP EVEN WITH FIRST WINDING WITH 5004 1/2 TAPE USING 5069 VARNISH TO START & 5070 MINERALAC BETWEEN LAYERS.

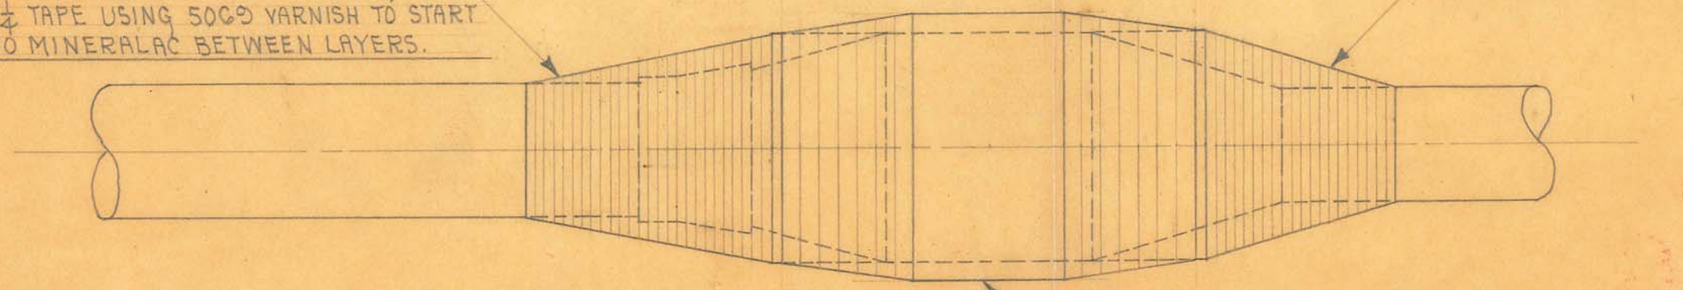

FINISH BY WINDING # 8379 1/2 G STRIP OVER PREVIOUS WINDINGS (OILED CLOTH TO OUTSIDE) USING 5070 MINERALAC BETWEEN LAYERS.

OBSOLETE

SIZE		ISSUE 5-27-35	A.E.
KIND		CHANGED	
SHAPE		" "	
FINISH		" "	
TEMP.		" "	
PATT.		" "	

TITLE: UNIVERSAL "CO-88" TUBE STAND H.T. CABLE TRANS. STRESS CONE

H. G. FISCHER & CO.
2335 WABANSIA AVE.
CHICAGO, ILL.

CAT. NO.

PART NO. 8379G

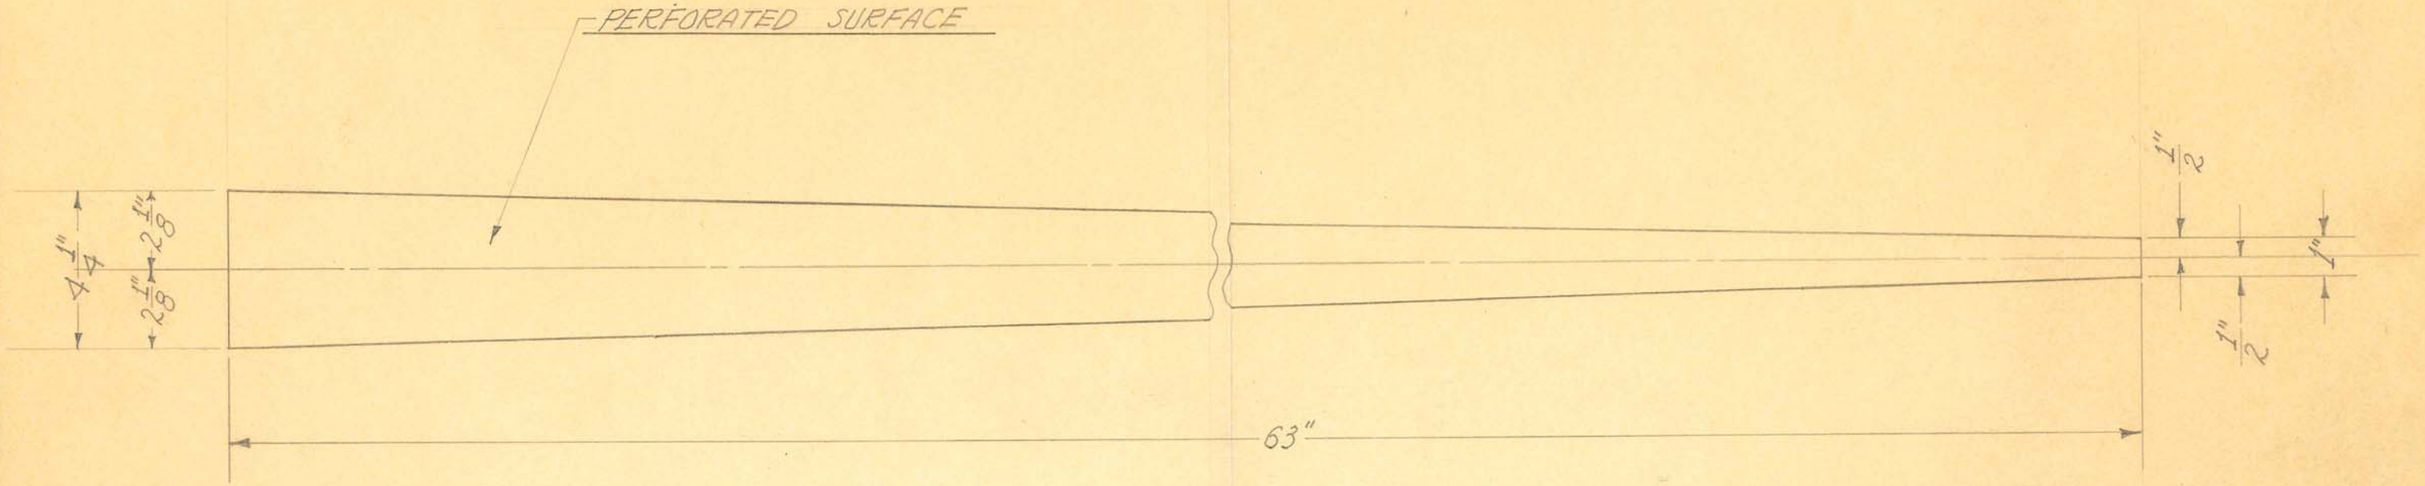

FROM #5026 3/4 OILED CLOTH

SCALE ÷ 1/4" = 1"

1 REQUIRED

OBSOLETE

SIZE		ISSUE 5-23-38	J.W.	TITLE: UNIVERSAL "60-88" TUBE STAND H.T. CABLE TRANSF. END STRESS CONE STRIP
KIND		CHANGED		
SHAPE		"		
FINISH		"		
TEMP.		"		
PATT.		"		

H. G. FISCHER & CO.
2335 WABANSIA AVE.
CHICAGO, ILL.

CAT. NO.

PART NO. 8370 1/4 B

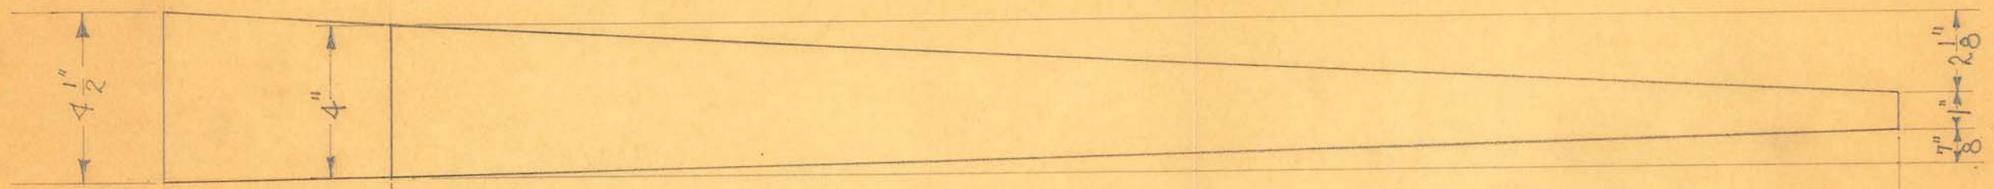

40" LENGTH OF #5026 3/4

46" LENGTH OF #5029

CUT 1 PIECE OF #5026 3/4 OILED CLOTH & 1 PIECE OF #5029 BALLOON CLOTH TO SIZE SHOWN.
SEW BALLOON CLOTH ON OPPOSITE SIDE TO THAT SHOWN. DO NOT SEW ENDS.

1 REQUIRED
SCALE ≈ 1/4" = 1"

OBSOLETE

SIZE		ISSUE 5-27-35	A.E.	TITLE: UNIVERSAL "C0-88" TUBE STAND H.T. CABLE TRANS. END STRESS CONE STRIP ASSEM.
KIND		CHANGED		
SHAPE		" "		
FINISH		" "		
TEMP.		" "		H. G. FISCHER & CO. 2335 WABANSIA AVE. CHICAGO, ILL. — CAT. NO. — PART NO. 8379 1/4 GR
PATT.		" "		

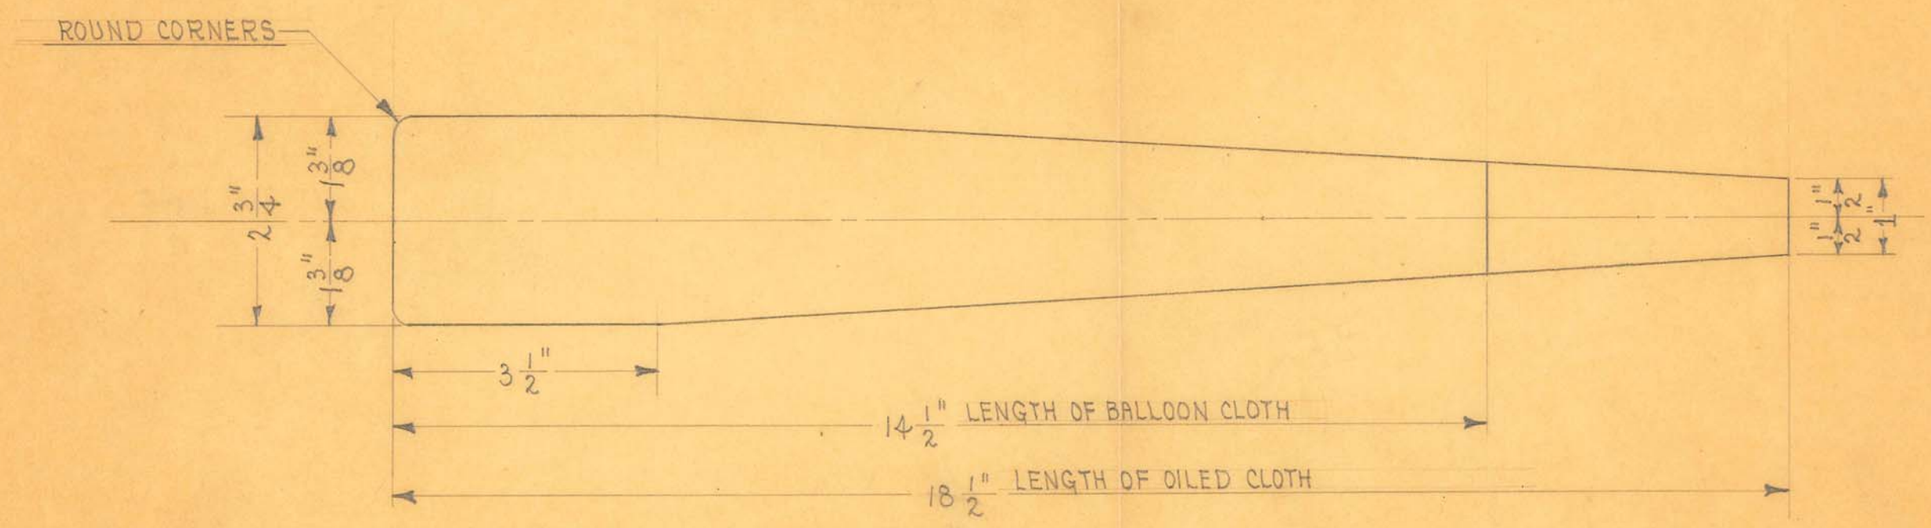

CUT 1 PIECE OF #5026 3/4 OILED CLOTH & 1 PIECE OF #5029 BALLOON CLOTH TO SIZES SHOWN.
SEW TOGETHER ON SIDES ONLY. DO NOT SEW ENDS.

1 REQUIRED
SCALE ~ 1/2" = 1"

OBSOLETE

SIZE		ISSUE 5-27-35	H.E.	TITLE: UNIVERSAL "GO-88" TUBE STAND H.T. CABLE TRANS. END STRESS CONE FINISHING STRIP ASS'EM.
KIND		CHANGED		
SHAPE		" "		
FINISH		" "		
TEMP.		" "		
PATT.		" "		

H. G. FISCHER & CO.
2335 WABANSIA AVE.
CHICAGO, ILL.

CAT. NO.

PART NO. 8379 1/2 G

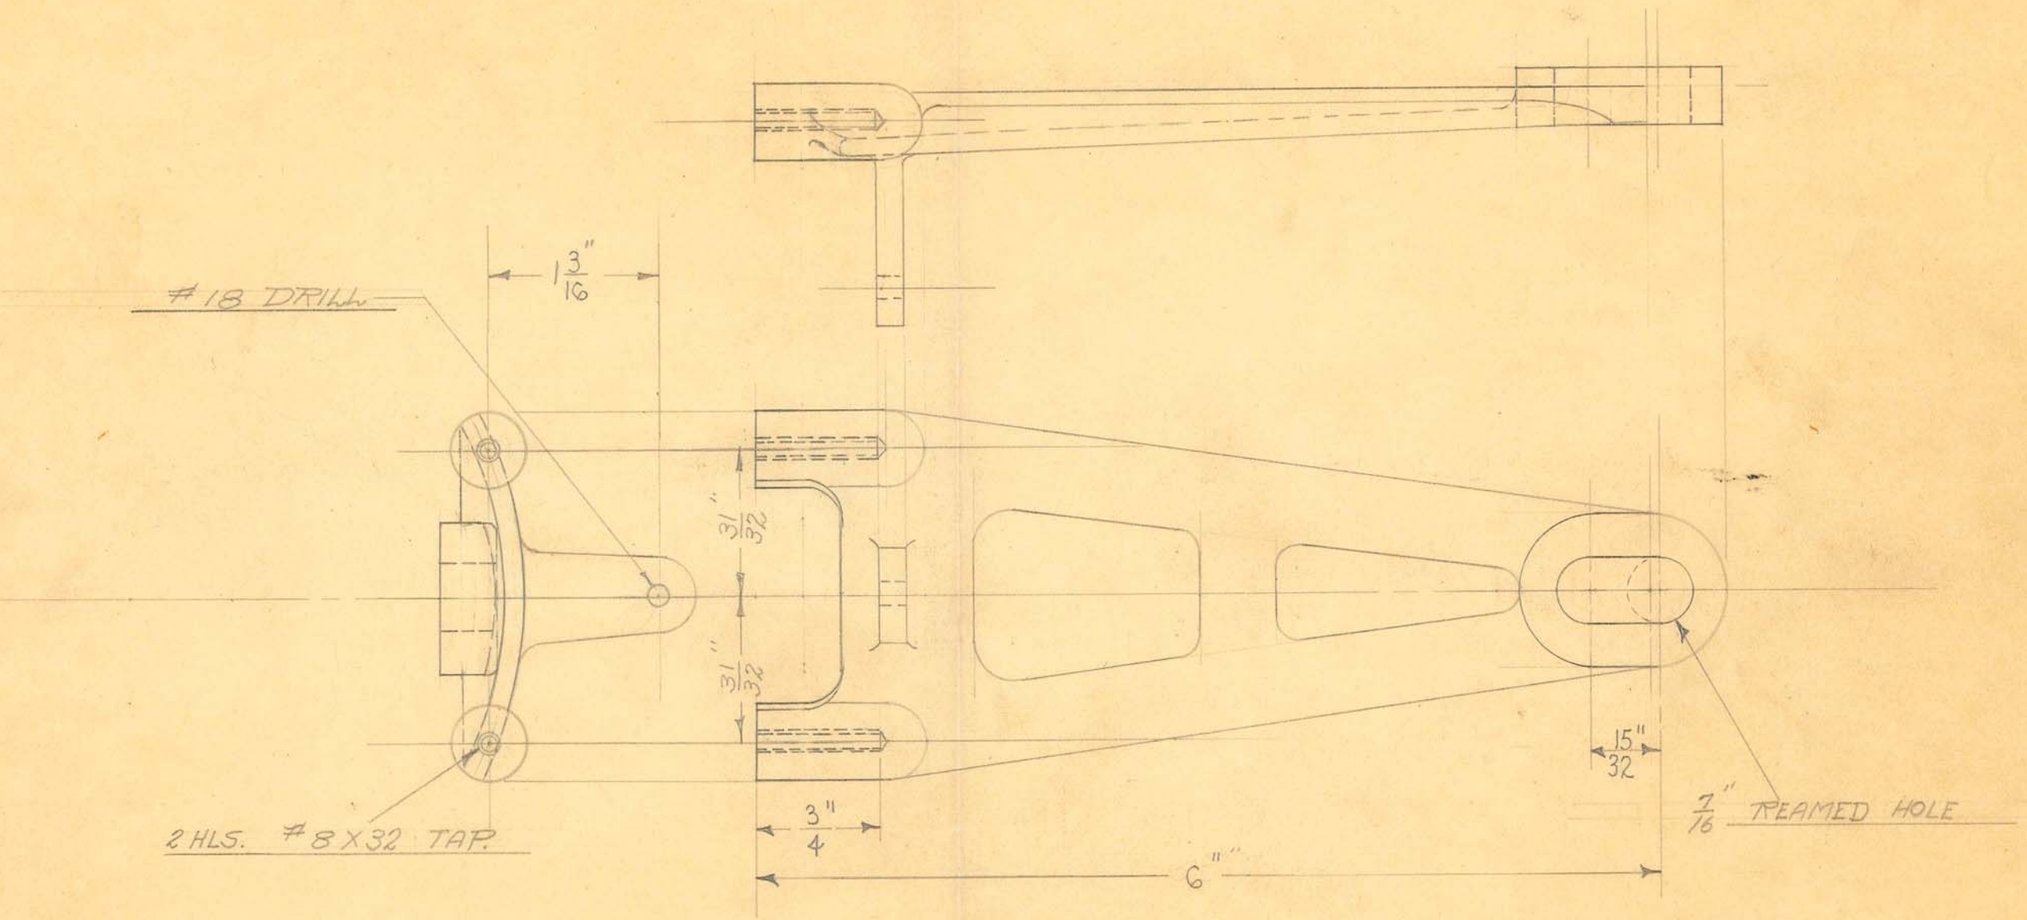

1 REQUIRED

OBSOLETE

SIZE		ISSUE 9-25-33	N.P.
KIND	ALUM. CASTING	CHANGED	
SHAPE		" "	
FINISH	BLK. LACQUER	" "	
TEMP.		" "	
PATT.	5492-663	" "	

TITLE: UNIVERSAL "60-88" SHUTTER FRAME SUPPORT

H. G. FISCHER & CO.
2335 WABANSIA AVE.
CHICAGO, ILL.

CAT. NO.

PART NO. 8397AF

ASSEMBLY

HORIZONTAL SHUTTER

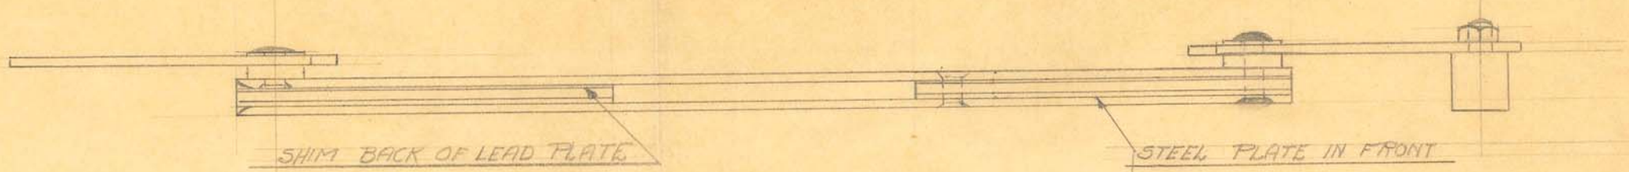

TOP

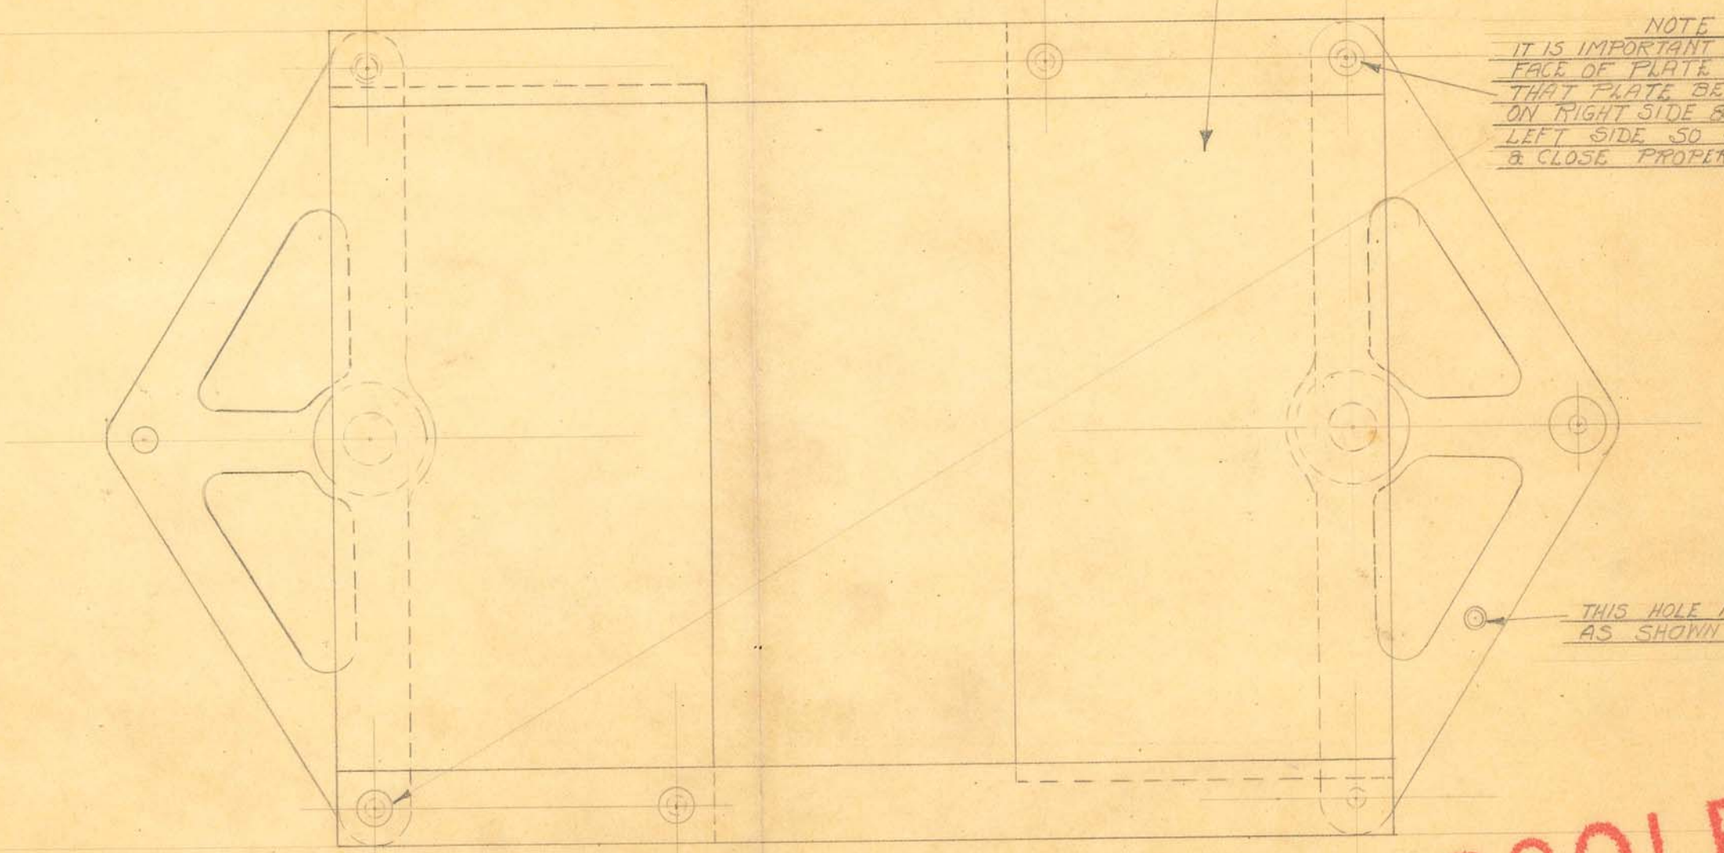

NOTE
IT IS IMPORTANT THAT THE STEEL FACE OF PLATE BE IN FRONT & THAT PLATE BE RIVETED AT TOP ON RIGHT SIDE & AT BOTTOM ON LEFT SIDE SO SHUTTER WILL OPEN & CLOSE PROPERLY.

OBSOLETE

SIZE		ISSUE 10-11-33	N.P.	TITLE: UNIVERSAL "CO-88" SHUTTER-HORIZ. SHUTTER ASSEM.
KIND		CHANGED		
SHAPE		" "		
FINISH		" "		
TEMP.		" "		H. G. FISCHER & CO. 2335 WABANSIA AVE. CHICAGO, ILL. — CAT. NO. — PART NO. 8411G
PATT.		" "		

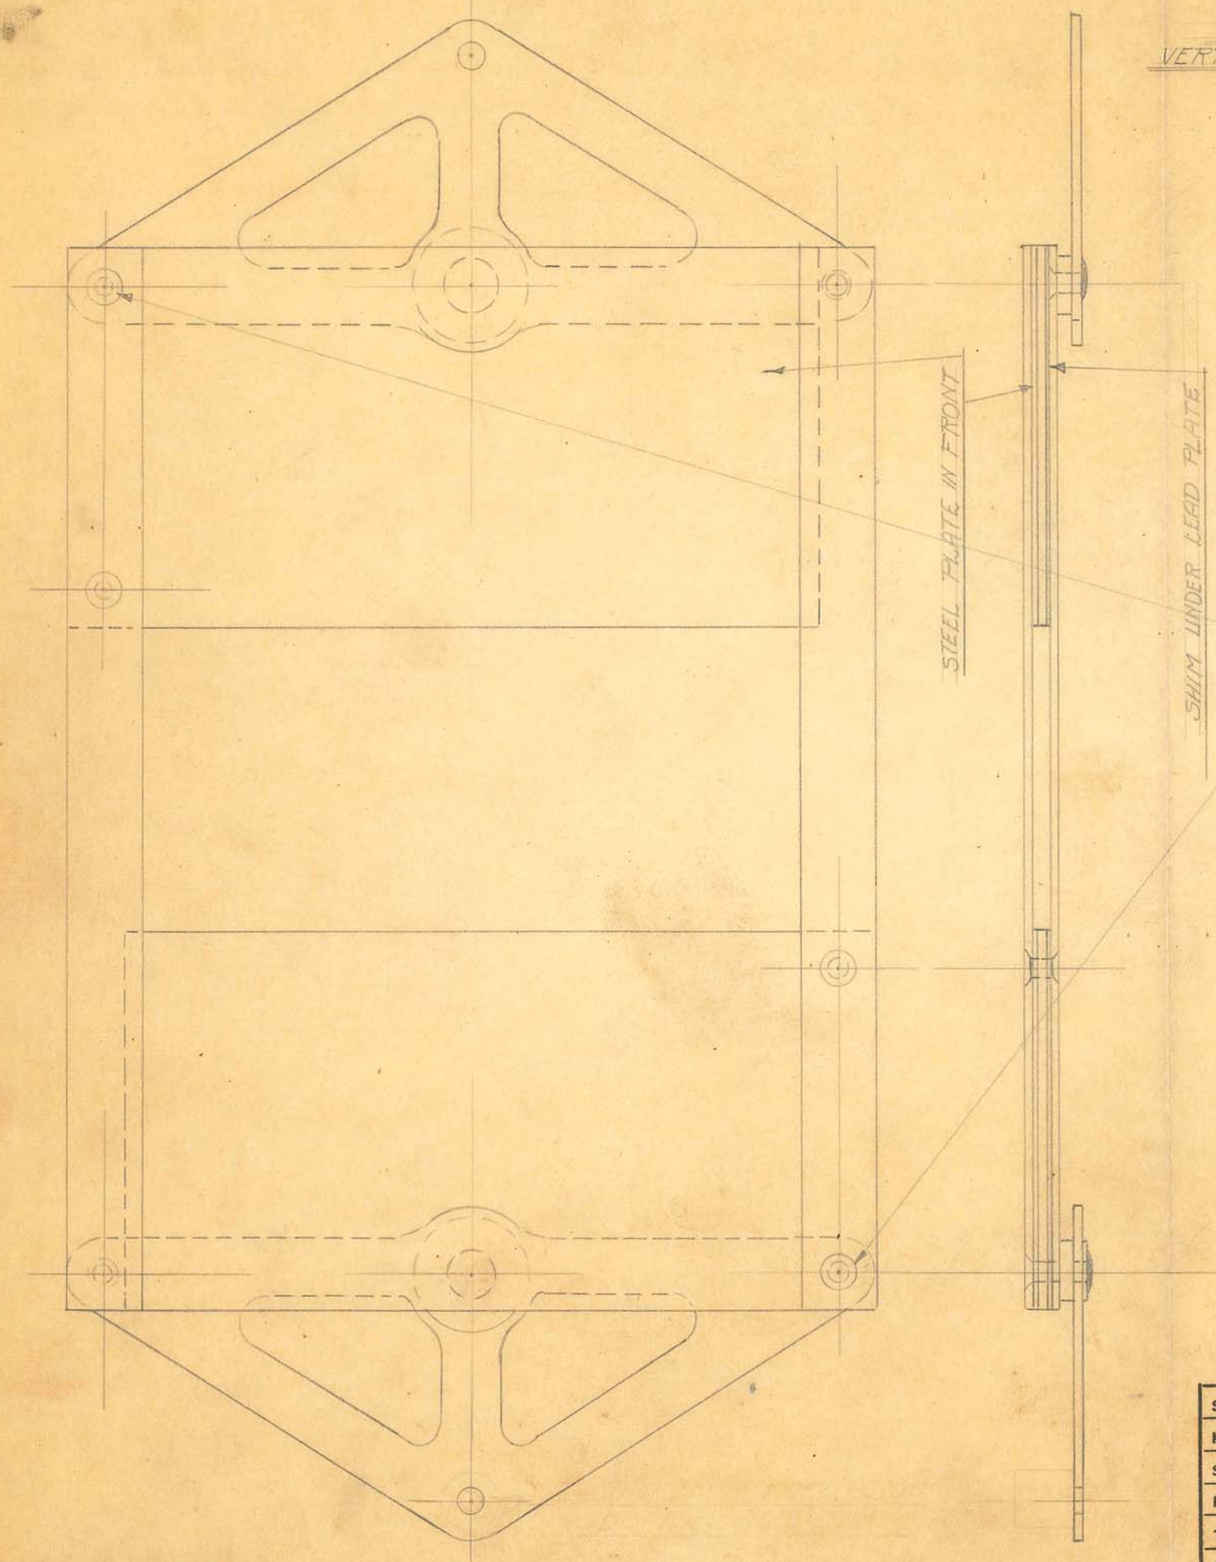

ASSEMBLY
VERTICAL SHUTTER

NOTE
IT IS IMPORTANT THAT THE STEEL FACE OF PLATE BE IN FRONT & THAT PLATE BE RIVETED ON LEFT SIDE AT THE TOP & ON right SIDE AT THE BOTTOM SO SHUTTER WILL OPEN & CLOSE PROPERLY

OBSOLETE

SIZE		ISSUE 10-11-33	N.P.
KIND		CHANGED	
SHAPE		" "	
FINISH		" "	
TEMP.		" "	
PATT.		" "	

TITLE: UNIVERSAL "60-88" SHUTTER-VERT. SHUTTER ASSEM.

H. G. FISCHER & CO.
2335 WABANSIA AVE.
CHICAGO, ILL.

CAT. NO.

PART NO. 8412G

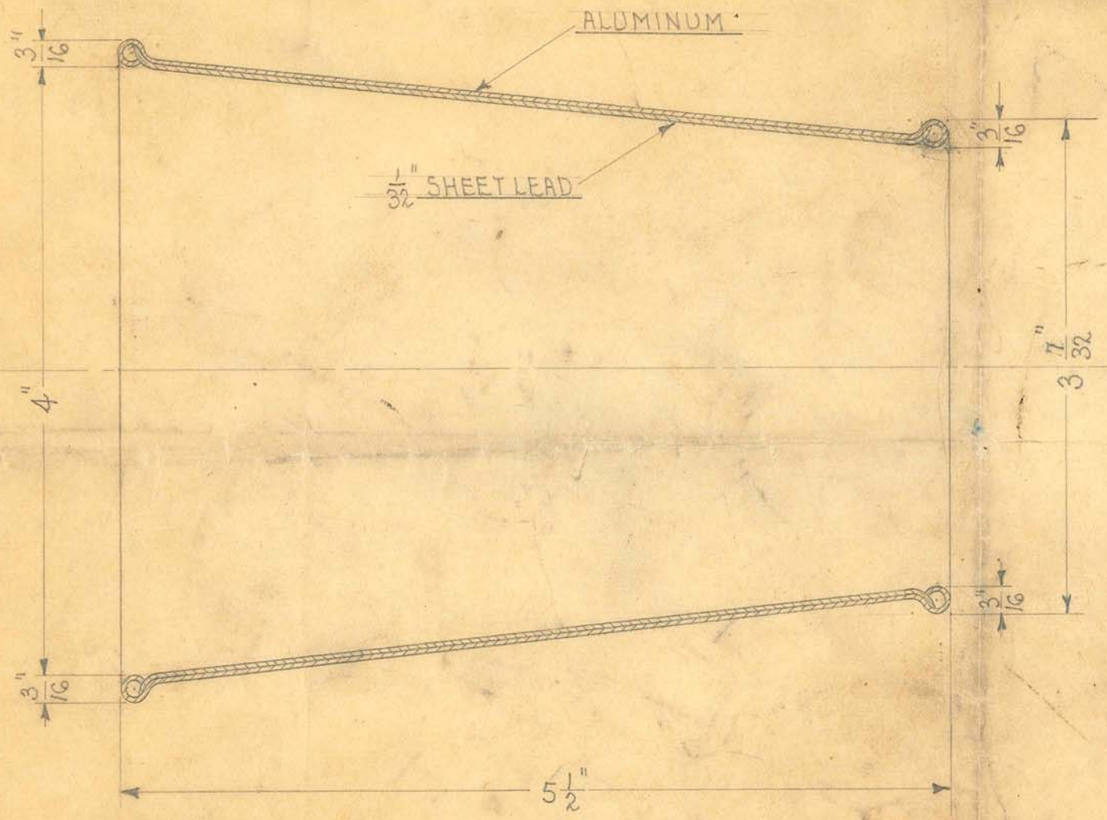

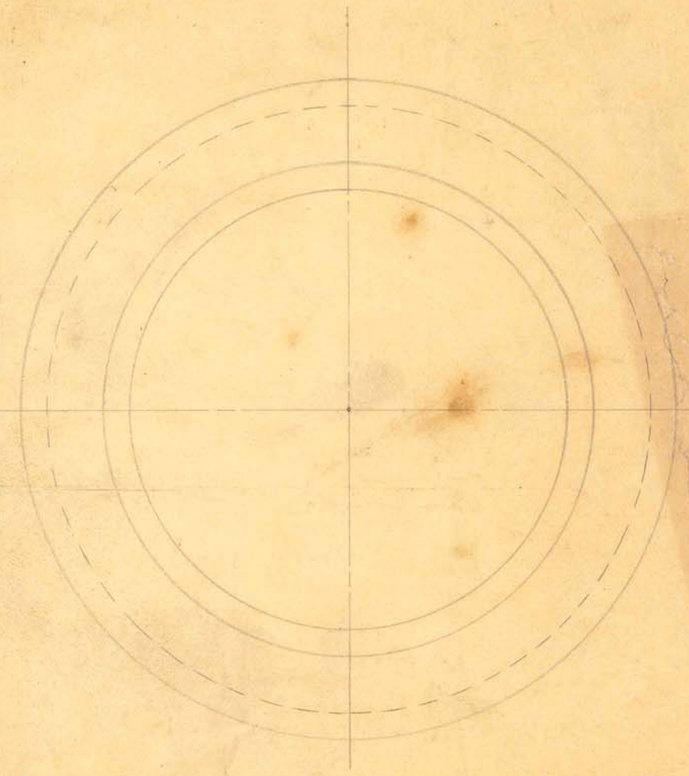

OBSOLETE

9 1/4" @ 25"

SIZE		ISSUE 11-3-33	A.B.
KIND		CHANGED	
SHAPE		" "	
FINISH		" "	
TEMP.		" "	
PATT.		" "	

TITLE: UNIVERSAL "60-88" LEAD LINED CONE 4"

H. G. FISCHER & CO.
2335 WABANSIA AVE.
CHICAGO, ILL.

CAT. NO. 2417

PART NO. 8425 G

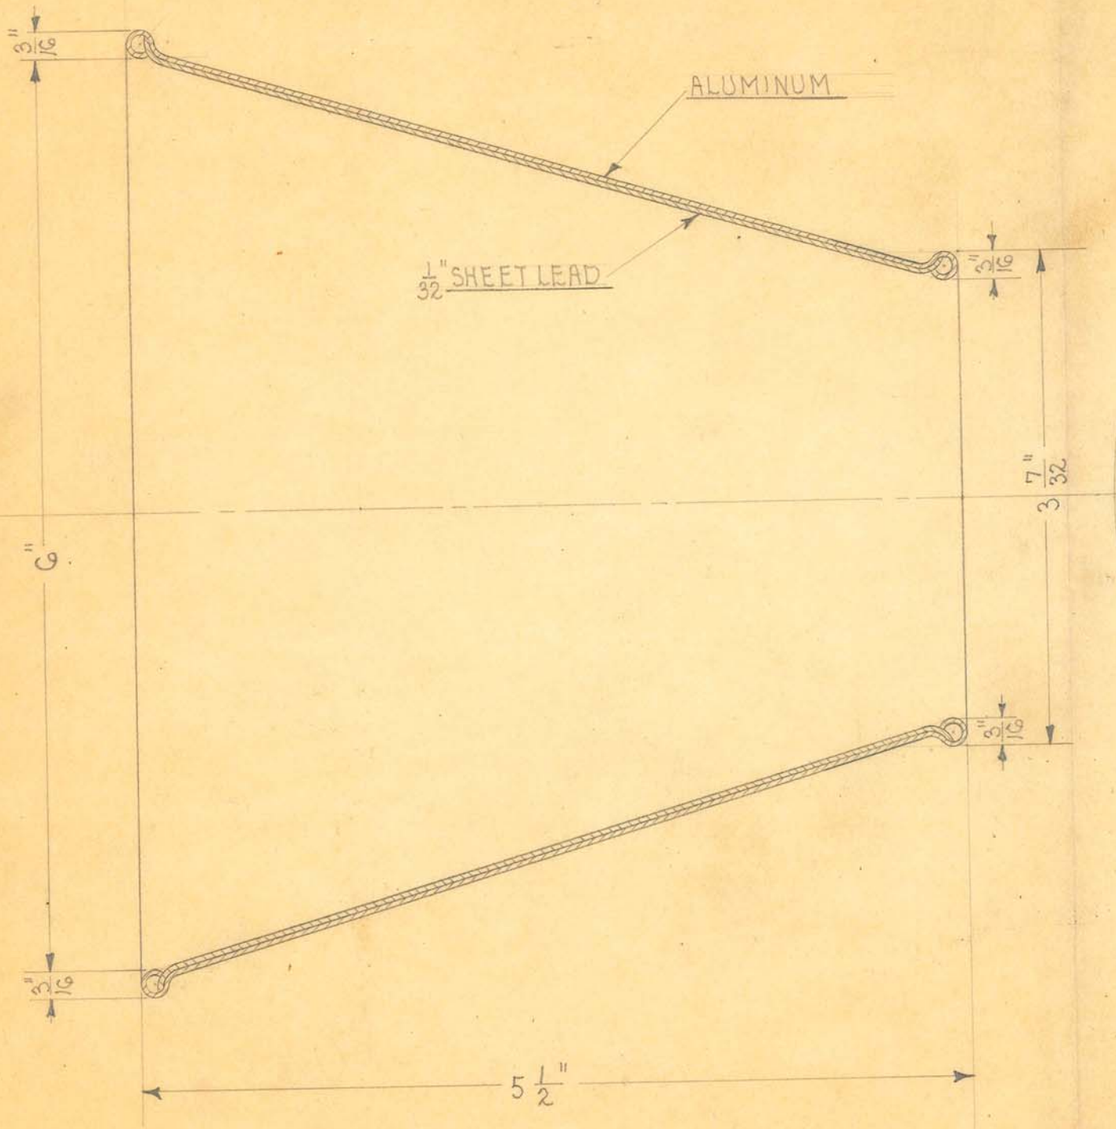

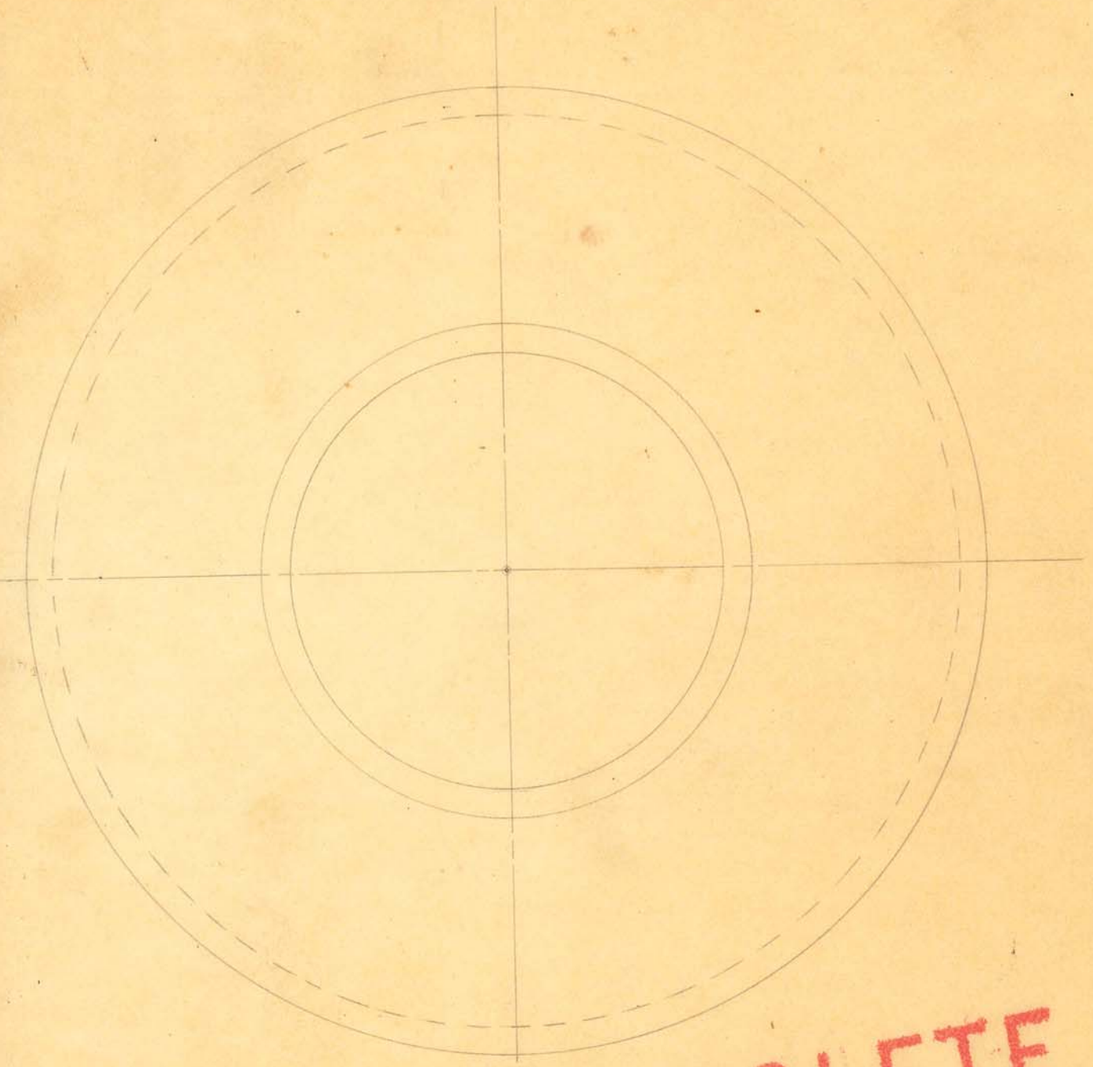

13 3/8" @ 25"

OBSOLETE

SIZE		ISSUE 11-21-33	A.E.	TITLE: UNIVERSAL "CO-88" LEAD LINED CONE 6"
KIND		CHANGED		
SHAPE		" "		
FINISH		" "		
TEMP.		" "		H. G. FISCHER & CO. 2335 WABANSIA AVE. CHICAGO, ILL. — CAT. NO. 2416 — PART NO. 8426G
PATT.		" "		

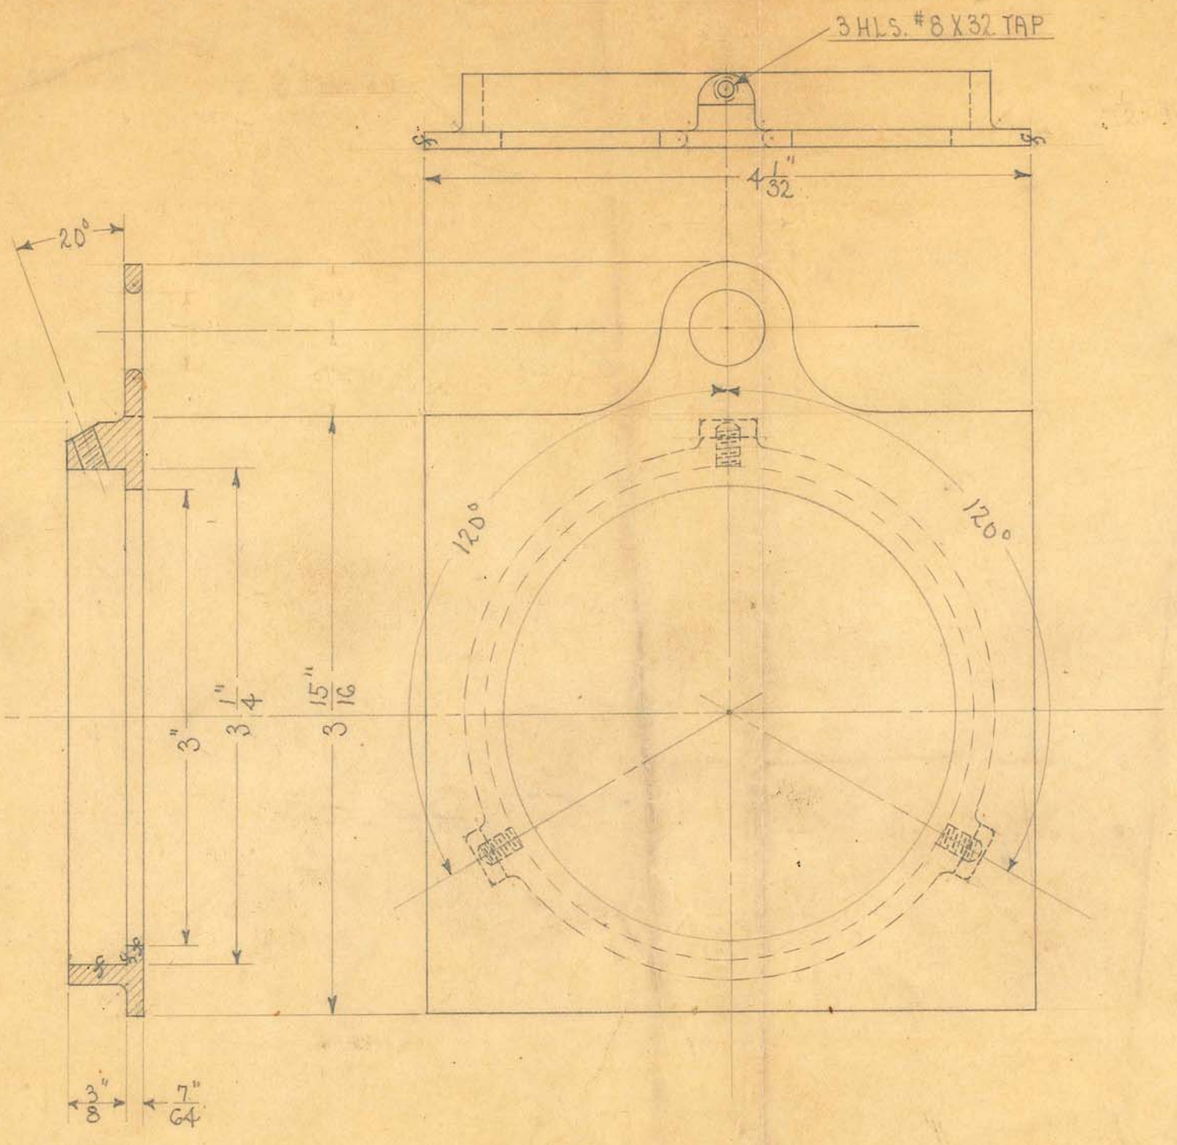

OBSOLETE

Obsolete

SIZE		ISSUE 11-6-33	H.E.	TITLE: UNIVERSAL "CO-88" LEAD LINED CONE HOLDER
KIND	ALUM. CASTING	CHANGED		
SHAPE		" "		
FINISH		" "		
TEMP.		" "		H. G. FISCHER & CO. 2335 WABANSIA AVE. CHICAGO, ILL. — CAT. NO. 2411 — PART NO. 8427F
PATT.	6858-670	" "		

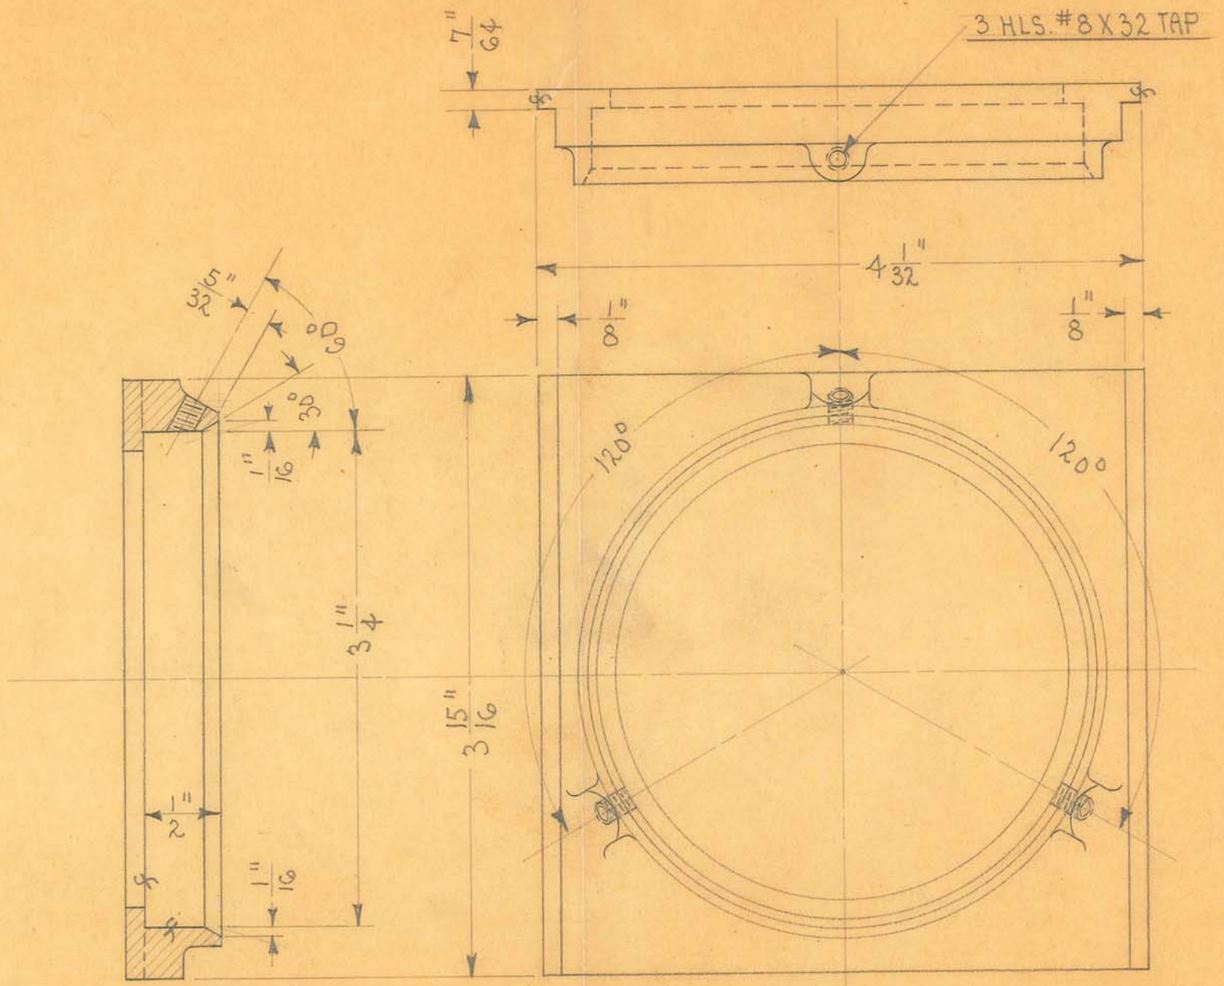

OBSOLETE

CAD. #23 & BLACK #50

SIZE		ISSUE 4-12-35	A.E.	TITLE: UNIVERSAL "60-88" LEAD LINED CONE HOLDER
KIND	IRON CASTING	CHANGED		
SHAPE		" "		
FINISH	SEE NOTE	" "		
TEMP.		" "		
PATT.	8243-833	" "		

H. G. FISCHER & CO.
2335 WABANSIA AVE.
CHICAGO, ILL.

CAT. NO. 2411A

PART NO. 8427AF

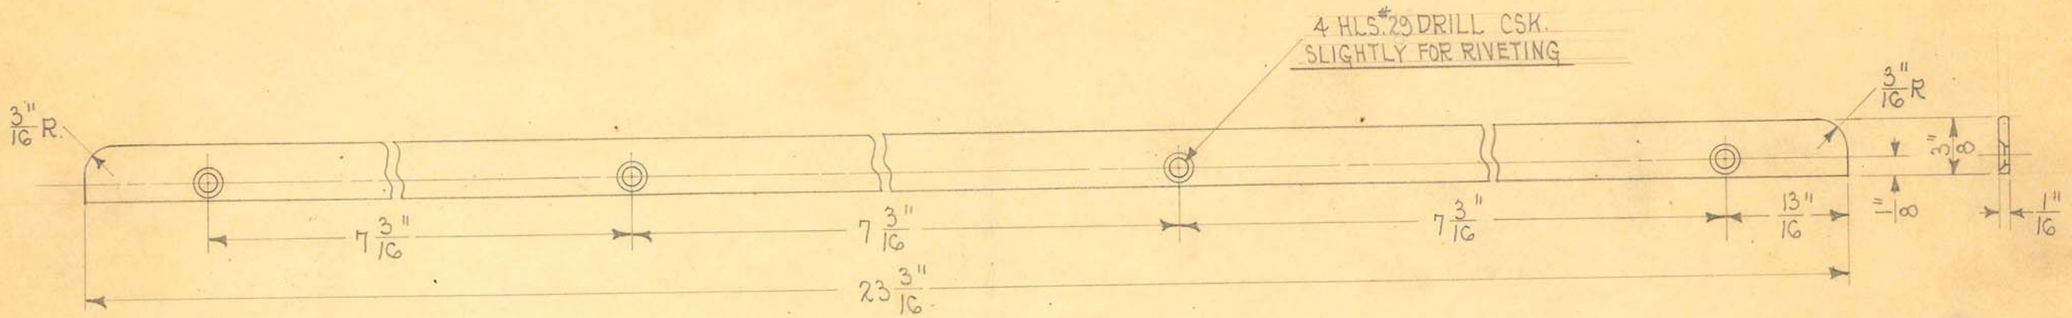

2 REQUIRED

OBSOLETE

SIZE	1/16" X 3/8"	ISSUE 1-24-35	A.E.
KIND	FLAT WIRE	CHANGED	
SHAPE		" "	
FINISH	CAD. #23	" "	
TEMP.		" "	
PATT.		" "	

TITLE: FISCHER FLAT BUCKY CASE BRACING STRIP
GUIDE STRIP

H. G. FISCHER & CO.
2335 WABANSIA AVE.
CHICAGO, ILL.

CAT. NO.

PART NO. 8452 1/2

SCALE ÷ 6" = 1'

2 REQUIRED

OBSOLETE

SIZE	#16 GA.	ISSUE 11-23-33	A.E.	TITLE: FISCHER FLAT BUCKY CASSETTE HOLDER CHANNEL
KIND	C.R. STEEL	CHANGED		
SHAPE		" "		
FINISH		" "		
TEMP.		" "		H. G. FISCHER & CO. 2335 WABANSIA AVE. CHICAGO, ILL. — CAT. NO. — PART NO. 8453
PATT.		" "		

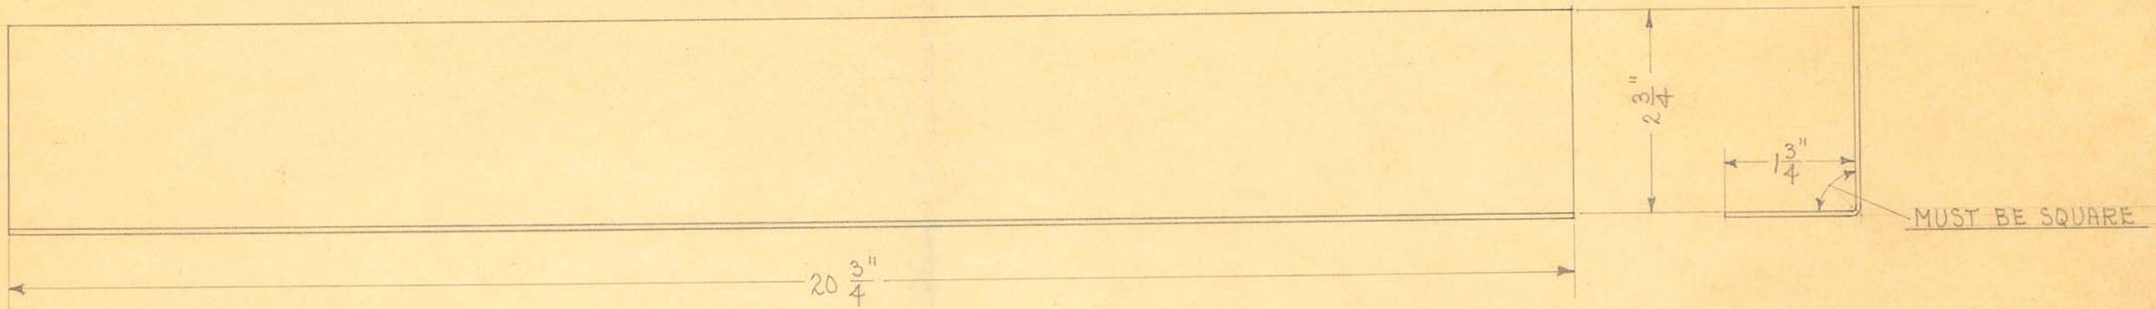

SCALE÷ 6" = 1'

1 REQUIRED

OBSOLETE

SIZE	#16 GA.	ISSUE 11-23-33	A.E.
KIND	SHEET STEEL	CHANGED	
SHAPE		" "	
FINISH		" "	
TEMP.		" "	
PATT.		" "	

TITLE: FISCHER FLAT BUCKY OPERATING UNIT MOUNTING ANGLE

H. G. FISCHER & CO.
2335 WABANSIA AVE.
CHICAGO, ILL.

CAT. NO.

PART NO. 8459

"NOTE"

ASSEMBLE & SOLDER 8481A & 8482B. THEN DRILL $\frac{21}{64}$" HOLE IN ONE SIDE OF 8481A, $\frac{5}{16}$" FROM LEFT END (MUST BE IN SAME RELATION TO HOLE IN 8482B AS SHOWN). PLACE 8479 INTO 8478AF AND DRILL $\frac{21}{64}$ HOLE THRU TOP SIDE. CLEAN OUT CHIPS. ASSEMBLE ALL PARTS & SOLDER IN FIXTURE #4081.

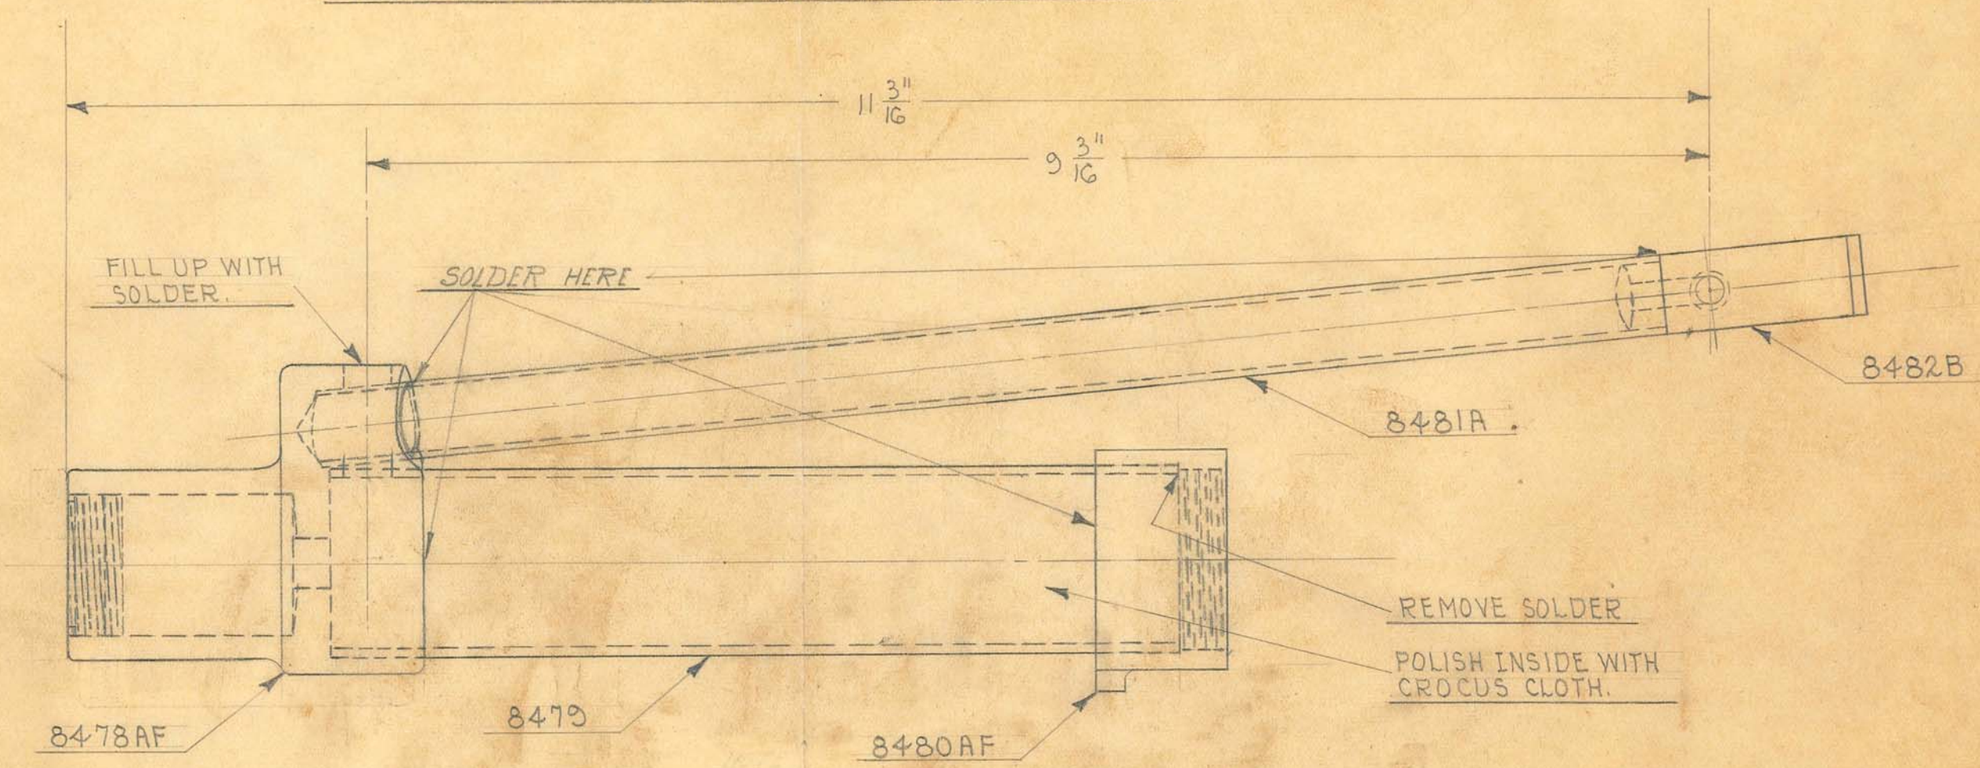

OBSOLETE

SIZE		ISSUE 11-29-33	N.P
KIND		CHANGED 10-11-34	A.E
SHAPE		" "	
FINISH		" "	
TEMP.		" "	
PATT.		" "	

TITLE: FISCHER FLAT BUCKY OIL CYLINDER ASSEM.

H. G. FISCHER & CO.
2335 WABANSIA AVE.
CHICAGO, ILL.

CAT. NO.

PART NO. 8478GB

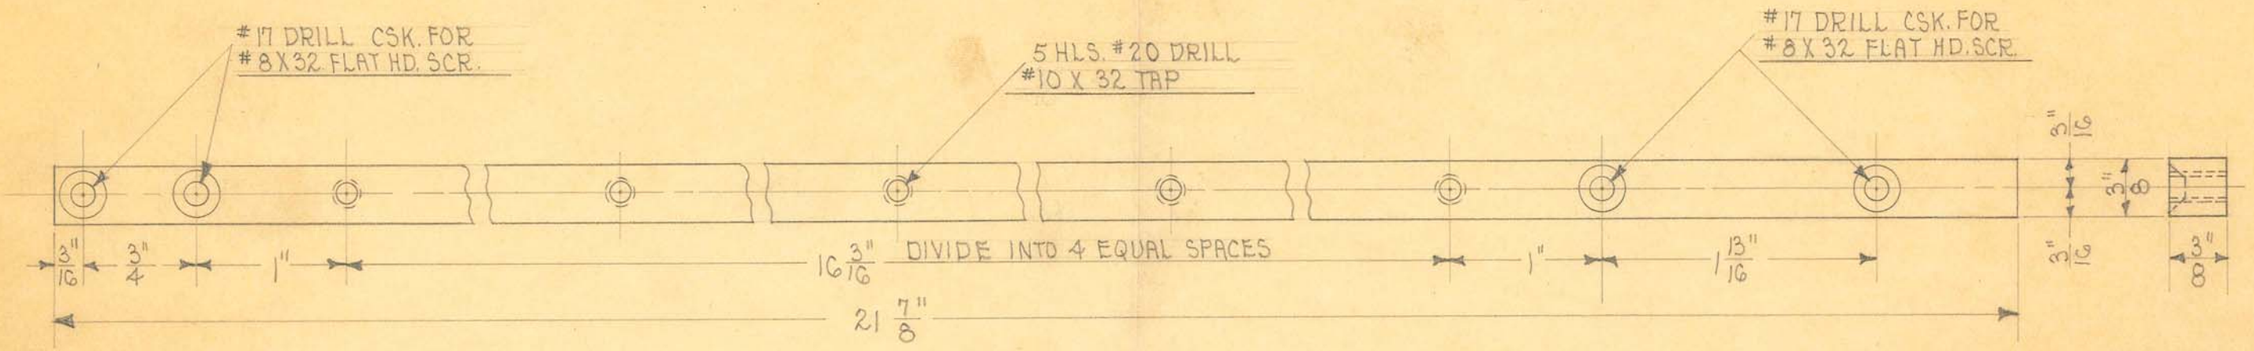

2 REQUIRED

NOTE:-
STRAIGHTEN BEFORE MACHINING.

OBSOLETE

SIZE	3/8" SQ.	ISSUE 12-20-33	A.E.	TITLE: FISCHER FLAT BUCKY GRID FRAME TIE ROD
KIND	C.R. STEEL	CHANGED		
SHAPE		" "		
FINISH	CAD. PLATE	" "		
TEMP.		" "		H. G. FISCHER & CO. 2335 WABANSIA AVE. CHICAGO, ILL. — CAT. NO. — PART NO. 8514
PATT.		" "		

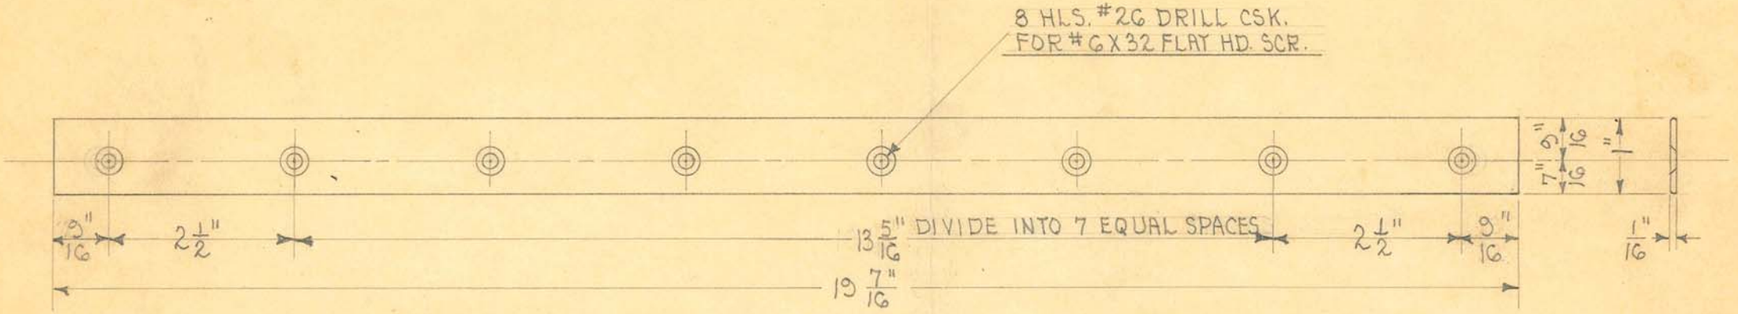

2 REQUIRED

SCALE: 6" = 1'

OBSOLETE

SIZE	1/16" X 1" R.E.	ISSUE 11-24-33	A.E.
KIND	FLAT WIRE #2	CHANGED	
SHAPE		" "	
FINISH	CAD. PLATE	" "	
TEMP.		" "	
PATT.		" "	

TITLE: FISCHER FLAT BUCKY GRID TOP CLAMPING STRIP

H. G. FISCHER & CO.
2335 WABANSIA AVE.
CHICAGO, ILL.

CAT. NO.

PART NO. 8516

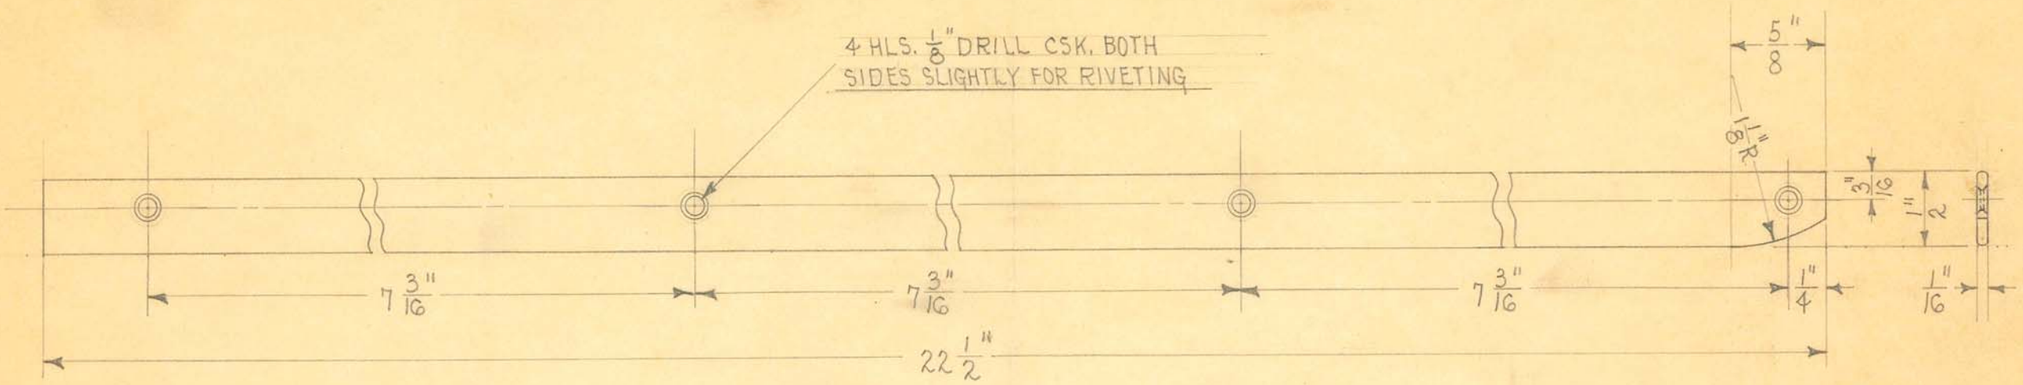

2 REQUIRED

OBSOLETE

SIZE	1/16" X 1/2"	ISSUE 1-24-35	A.E.	TITLE: FISCHER FLAT BUCKY CASSETTE HOLDER GUIDE STRIP
KIND	FLAT WIRE	CHANGED		
SHAPE		" "		
FINISH	CAD. #23	" "		
TEMP.		" "		H. G. FISCHER & CO. 2335 WABANSIA AVE. CHICAGO, ILL. — CAT. NO. — PART NO. 8534 1/4
PATT.		" "		

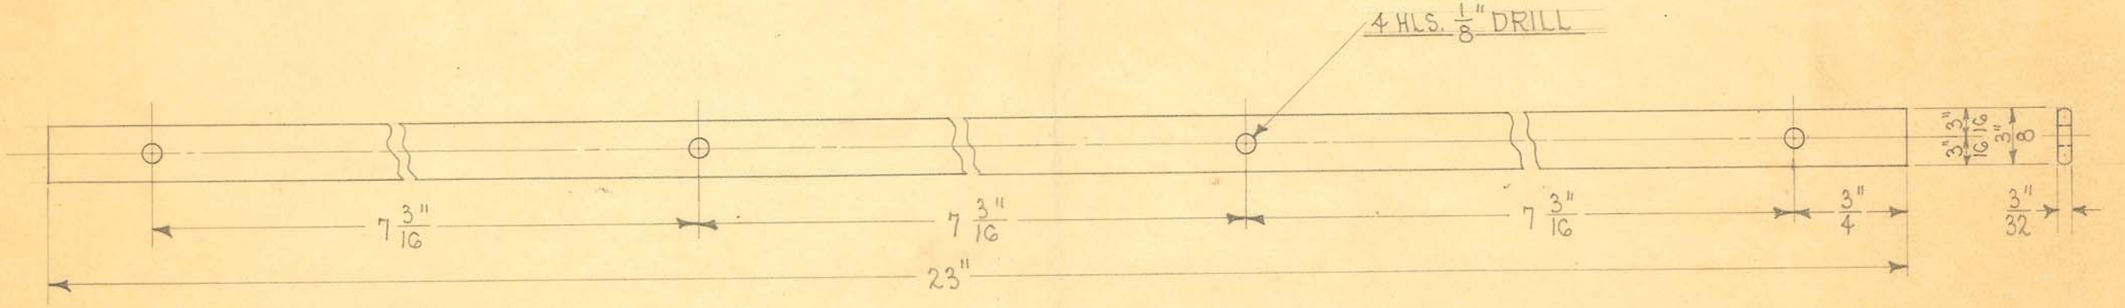

2 REQUIRED

OBSOLETE

SIZE	3/32" X 3/8"	ISSUE 1-22-35	A.E.	TITLE: FISCHER FLAT BUCKY CASSETTE HOLDER GUIDE STRIP SPACING STRIP
KIND	FLAT WIRE	CHANGED		
SHAPE		" "		
FINISH	CAD. #23	" "		
TEMP.		" "		
PATT.		" "		

H. G. FISCHER & CO.
2335 WABANSIA AVE.
CHICAGO, ILL.

CAT. NO.

PART NO. 8534 1/2

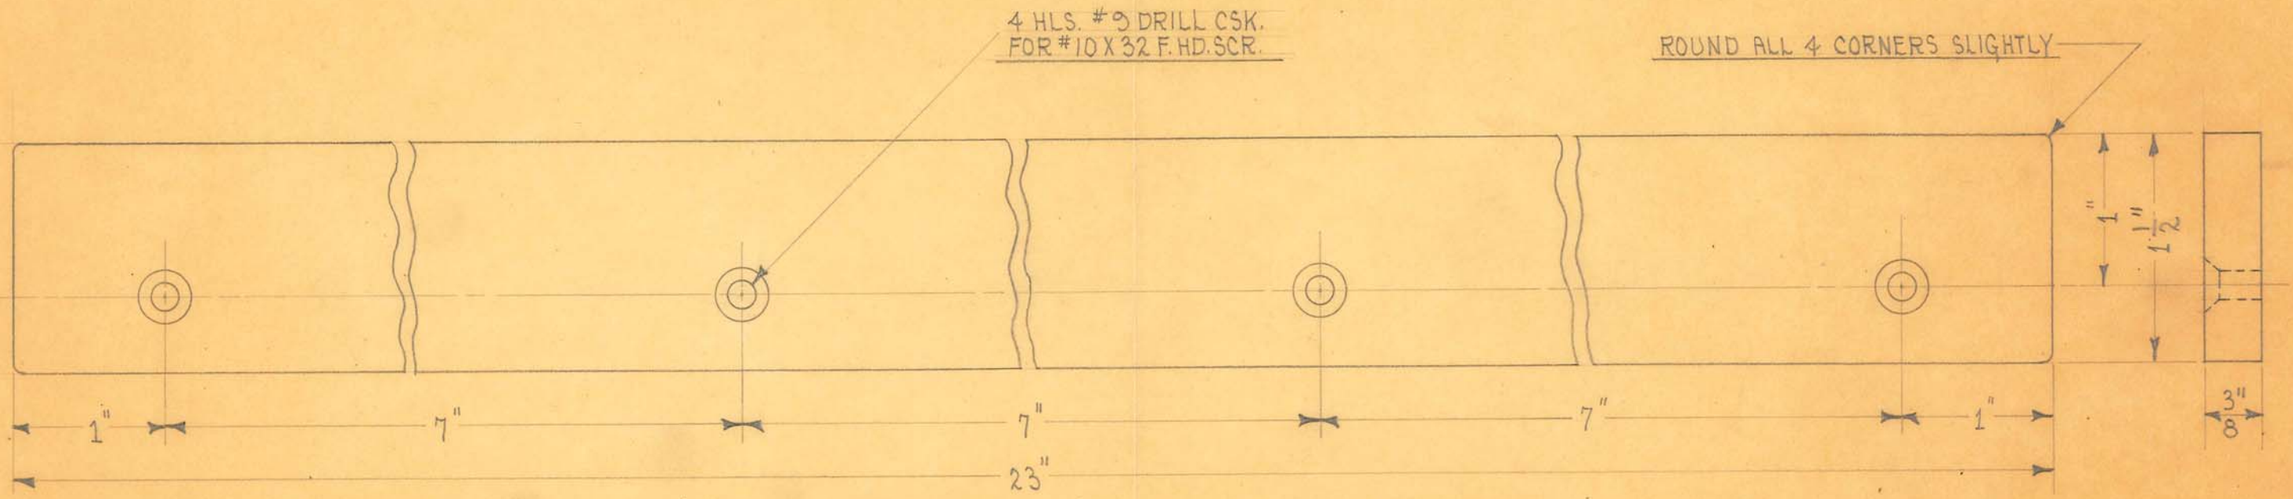

1 REQUIRED

OBSOLETE

SIZE	3/8" X 1 1/2"	ISSUE 3-11-35	A.E.	TITLE: FISCHER FLAT BUCKY MTG. STRIP FOR COMPRESSION ATTACHMENT - ROLLER END
KIND	C. DRAWN STEEL	CHANGED		
SHAPE		" "		
FINISH	CAD. #23	" "		
TEMP.		" "		H. G. FISCHER & CO. 2335 WABANSIA AVE. CHICAGO, ILL. — CAT. NO. — PART NO. 8548
PATT.		" "		

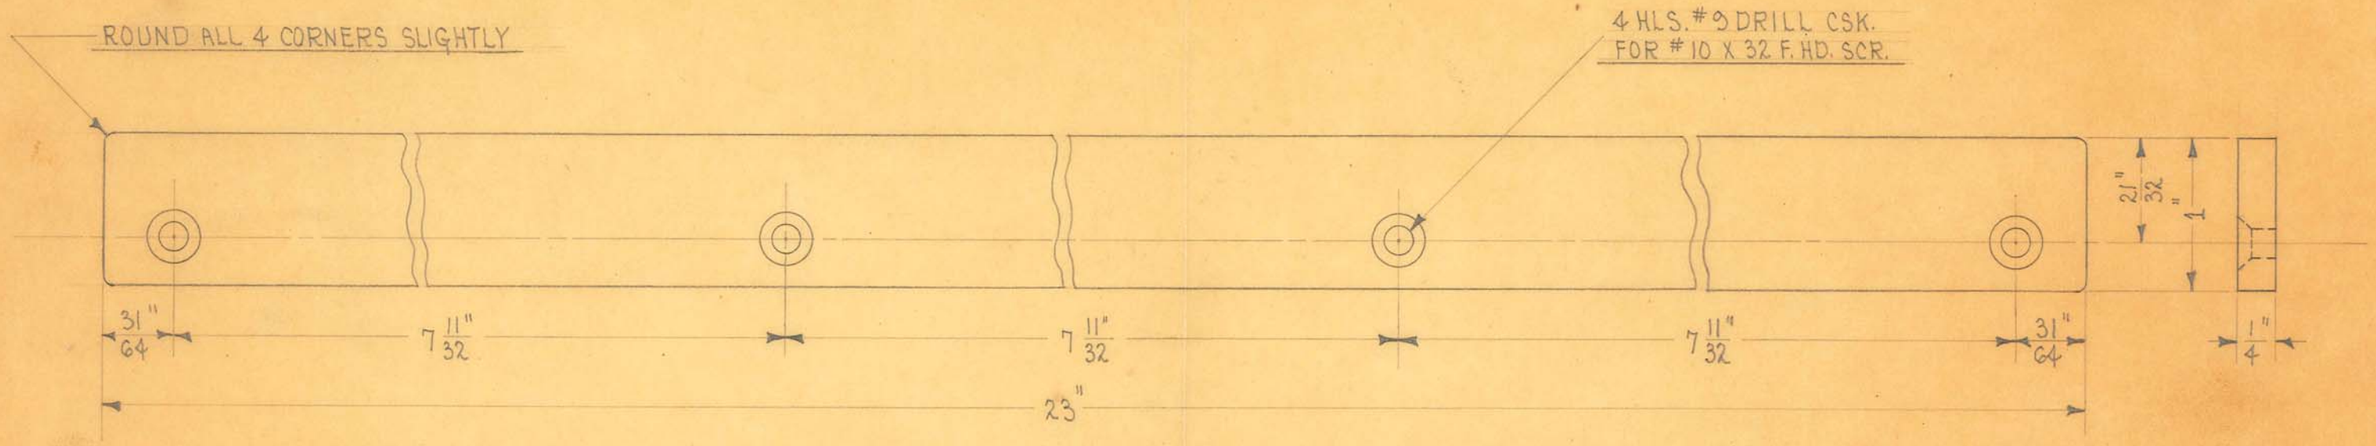

1 REQUIRED

OBSOLETE

SIZE	¼" X 1"	ISSUE 3-11-35	H.E.
KIND	C.DRAWN STEEL	CHANGED	
SHAPE		" "	
FINISH	CAD. #23	" "	
TEMP.		" "	
PATT.		" "	

TITLE: FISCHER FLAT BUCKY, MTG. STRIP FOR COMPRESSION ATTACHMENT - HOOK END

H. G. FISCHER & CO.
2335 WABANSIA AVE.
CHICAGO, ILL.

CAT. NO.

PART NO. 8548½

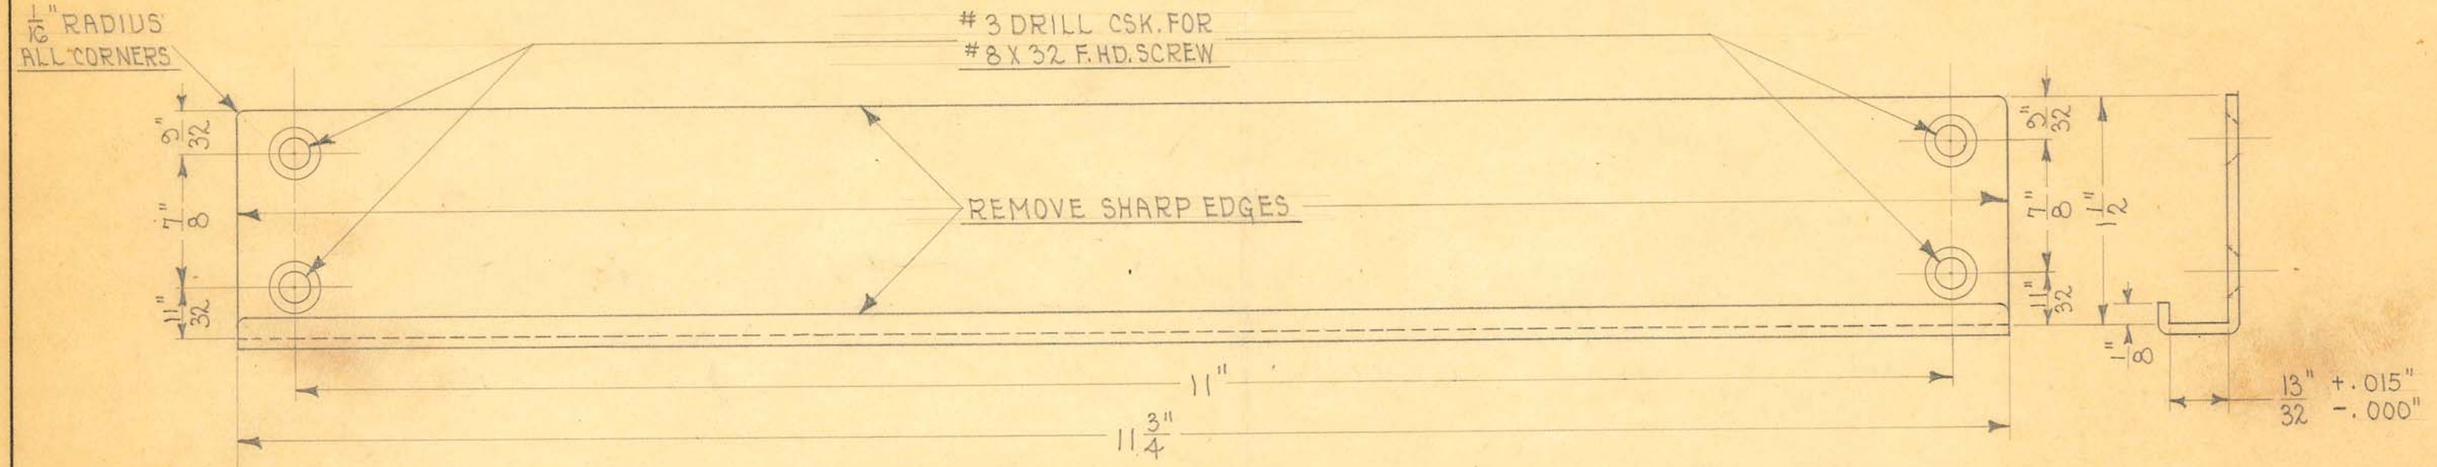

1 REQUIRED
FROM 855GA

OBSOLETE

SIZE	#16GA.(.0625)	ISSUE 6-20-34	J.E.	TITLE: FISCHER IMMOBILIZING & COMPRESSION ATTACHMENT MOUNTING STRIP (DRILLED)
KIND	C.R. STEEL	CHANGED		
SHAPE		" "		
FINISH	CADMIUM #23	" "		
TEMP.		" "		
PATT.		" "		

H. G. FISCHER & CO.
2335 WABANSIA AVE.
CHICAGO, ILL.

CAT. NO.

PART NO. 855GAF

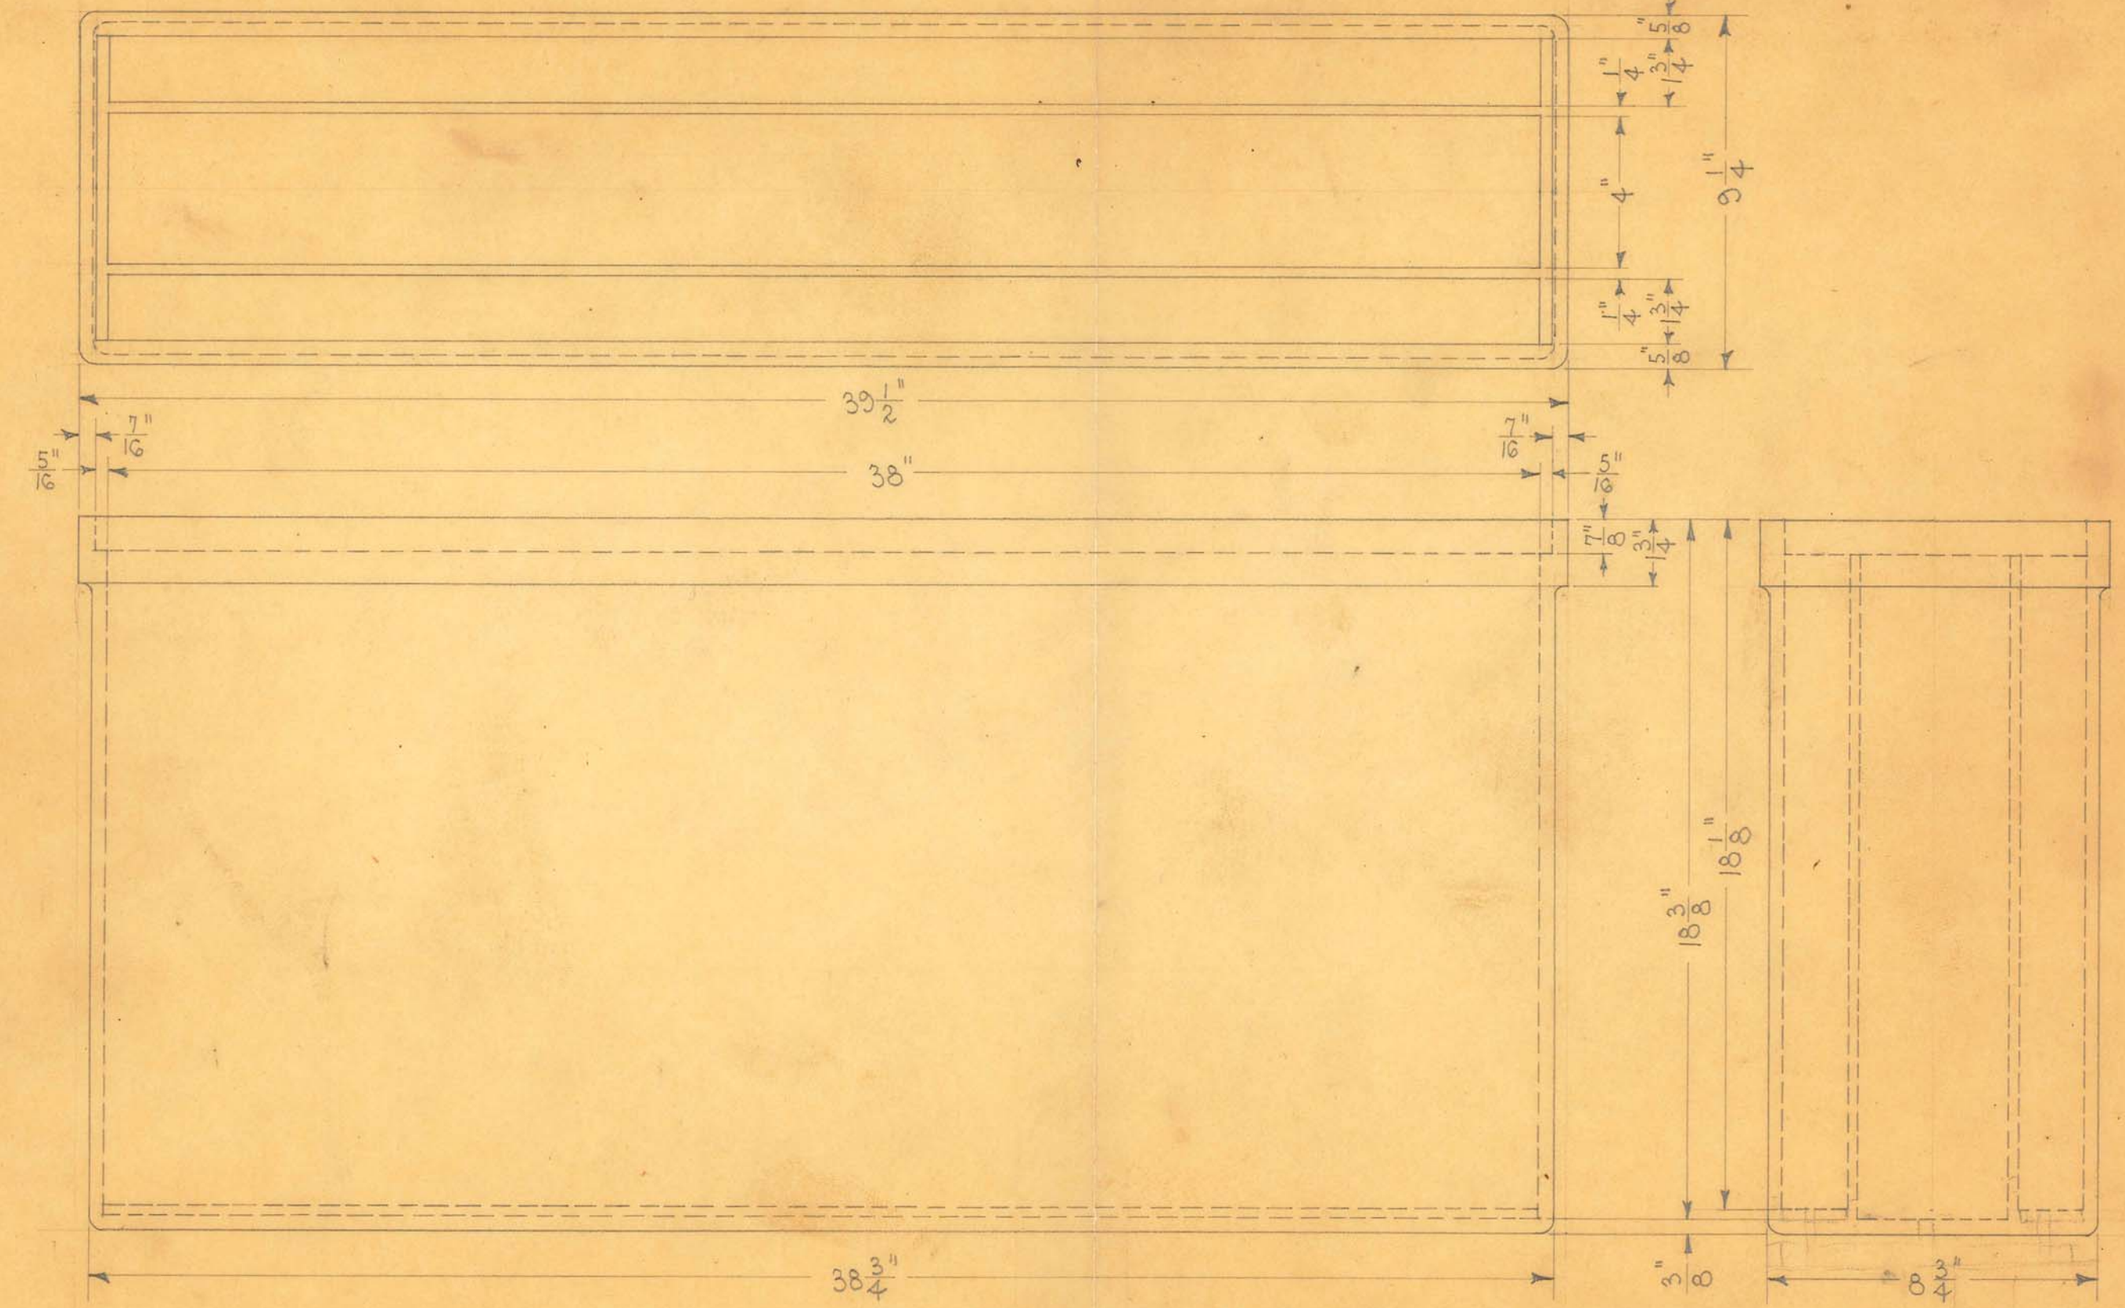

SCALE ≈ 1/4" = 1"

SIZE		ISSUE 11-27-35	W.E.	TITLE: FISCHER 14"X36" THREE COMPARTMENT TANK OBSOLETE
KIND	MOLDED	CHANGED		
~~SHAPE~~	HARD RUBBER	" "		
FINISH		" "		
TEMP.		" "		
PATT.		" "		

H. G. FISCHER & CO.
2335 WABANSIA AVE.
CHICAGO, ILL.

CAT. NO.

PART NO. 8581

1828

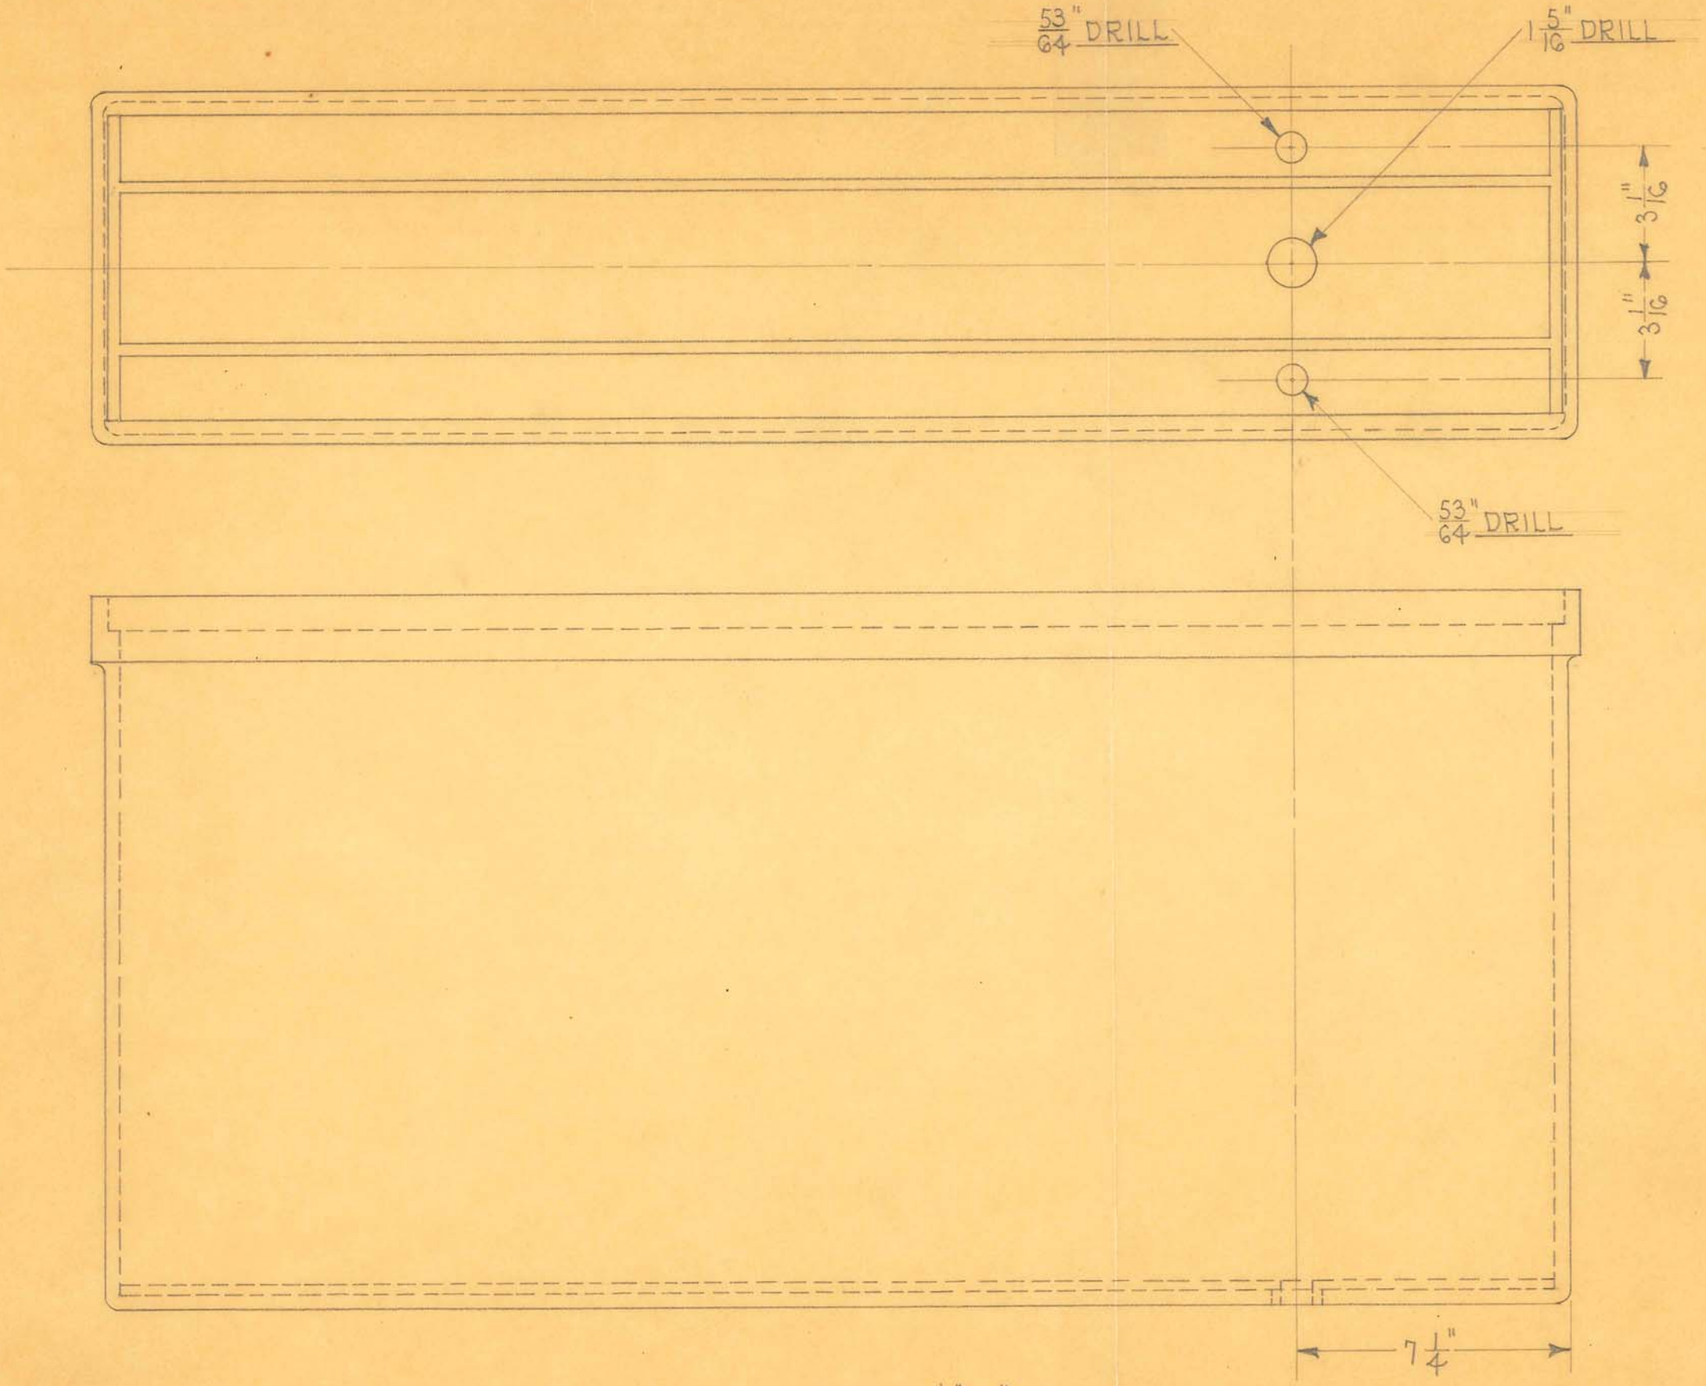

SCALE ~ 1/4" = 1"

OBSOLETE

SIZE		ISSUE 11-30-35	J.F.E.	TITLE: FISCHER 14" X 36" THREE COMPARTMENT TANK (DRILLED)
KIND		CHANGED		
SHAPE		" "		
FINISH		" "		
TEMP.		" "		H. G. FISCHER & CO. 2335 WABANSIA AVE. CHICAGO, ILL. — CAT. NO. — PART NO. 8581F
PATT.		" "		

71828

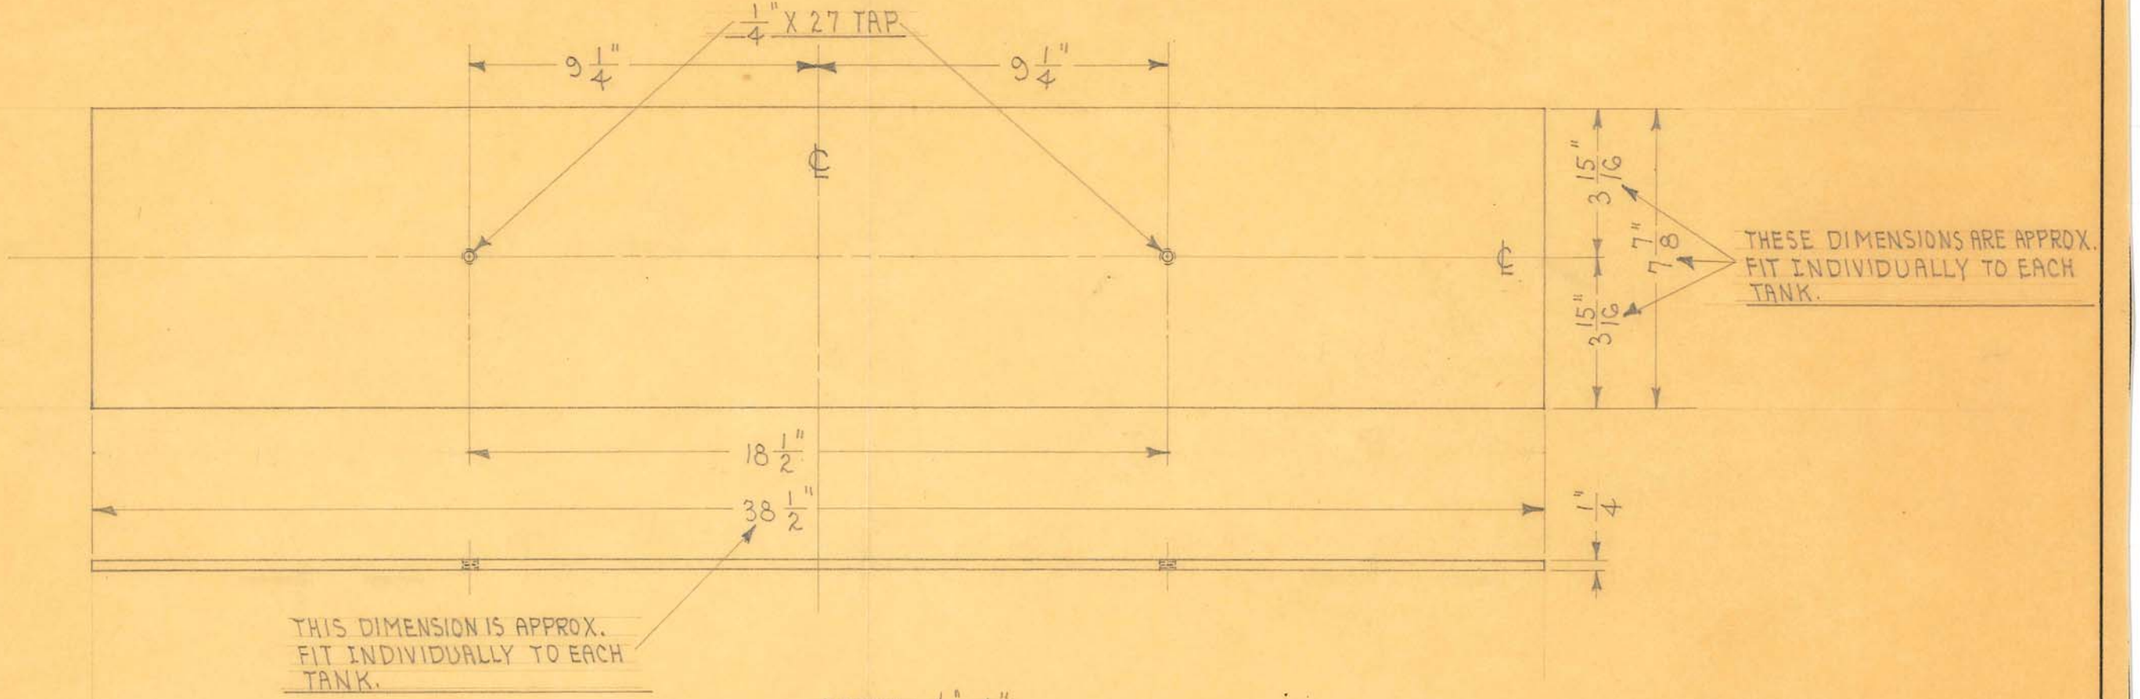

SCALE ÷ 1/4" = 1"

OBSOLETE

SIZE	1/4" SHEET	ISSUE 11-27-35	H.E.
KIND	XP RICHELAIN	CHANGED	
~~SHAPE~~	BAKELITE	" "	
FINISH		" "	
TEMP.		" "	
PATT.		" "	

TITLE: FISCHER 14"X 36" THREE COMPARTMENT TANK COVER

H. G. FISCHER & CO.
2335 WABANSIA AVE.
CHICAGO, ILL.

CAT. NO.

PART NO. 8583

8868

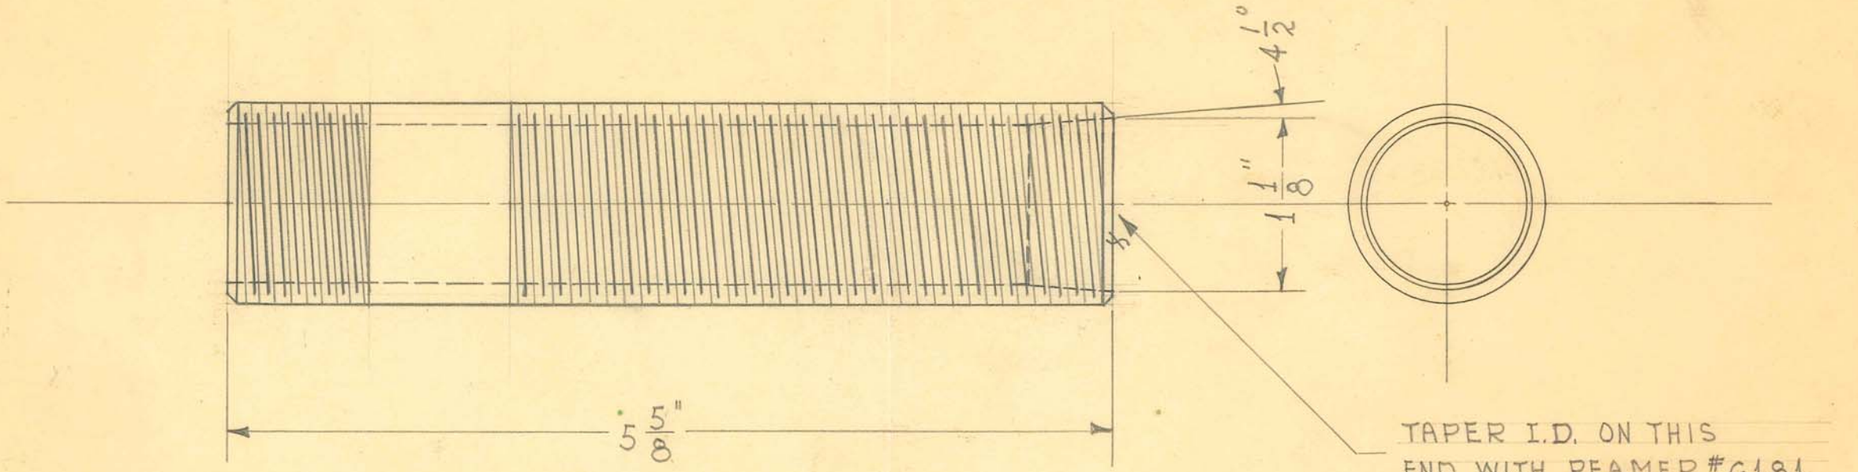

1 REQUIRED

OBSOLETE

SIZE	FROM #8585	ISSUE 8-6-45	HE.
KIND		CHANGED	
SHAPE		"	
FINISH		"	
TEMP.		"	
PATT.		"	

TITLE: FISCHER 14"X36" 3-COMPARTMENT TANK-
TANK NIPPLE 1"X6" (FINISHED)

H. G. FISCHER & CO.
2338 WABANSIA AVE.
CHICAGO, ILL.

CAT. NO.

PART NO. 8585F

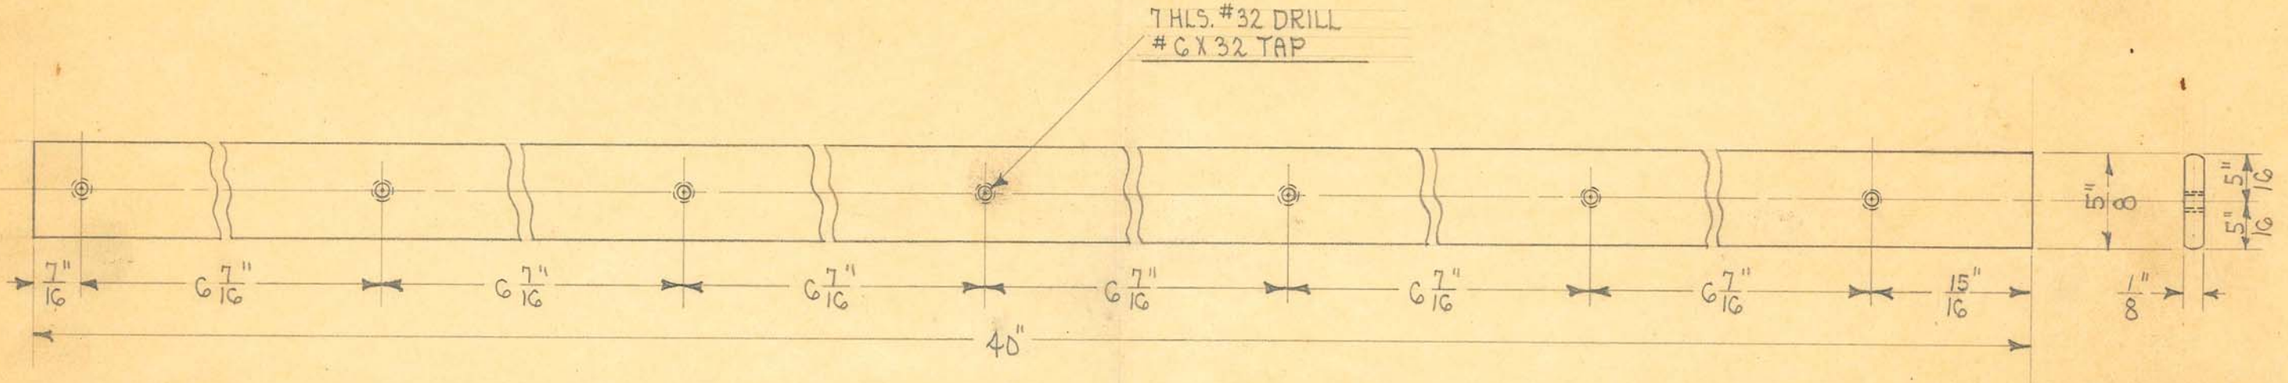

1 REQUIRED

NOTE ~ CASE & STRIP SHOULD BE DRILLED TOGETHER.

OBSOLETE

SIZE	1/8" X 5/8"	ISSUE 4-10-34	H.E.
KIND	FLAT WIRE	CHANGED	
SHAPE		" "	
FINISH		" "	
TEMP.		" "	
PATT.		" "	

TITLE: FISCHER 36" FLAT BUCKY CASE REINFORCING STRIP - FRONT

H. G. FISCHER & CO.
2335 WABANSIA AVE.
CHICAGO, ILL.

CAT. NO.

PART NO. 8602

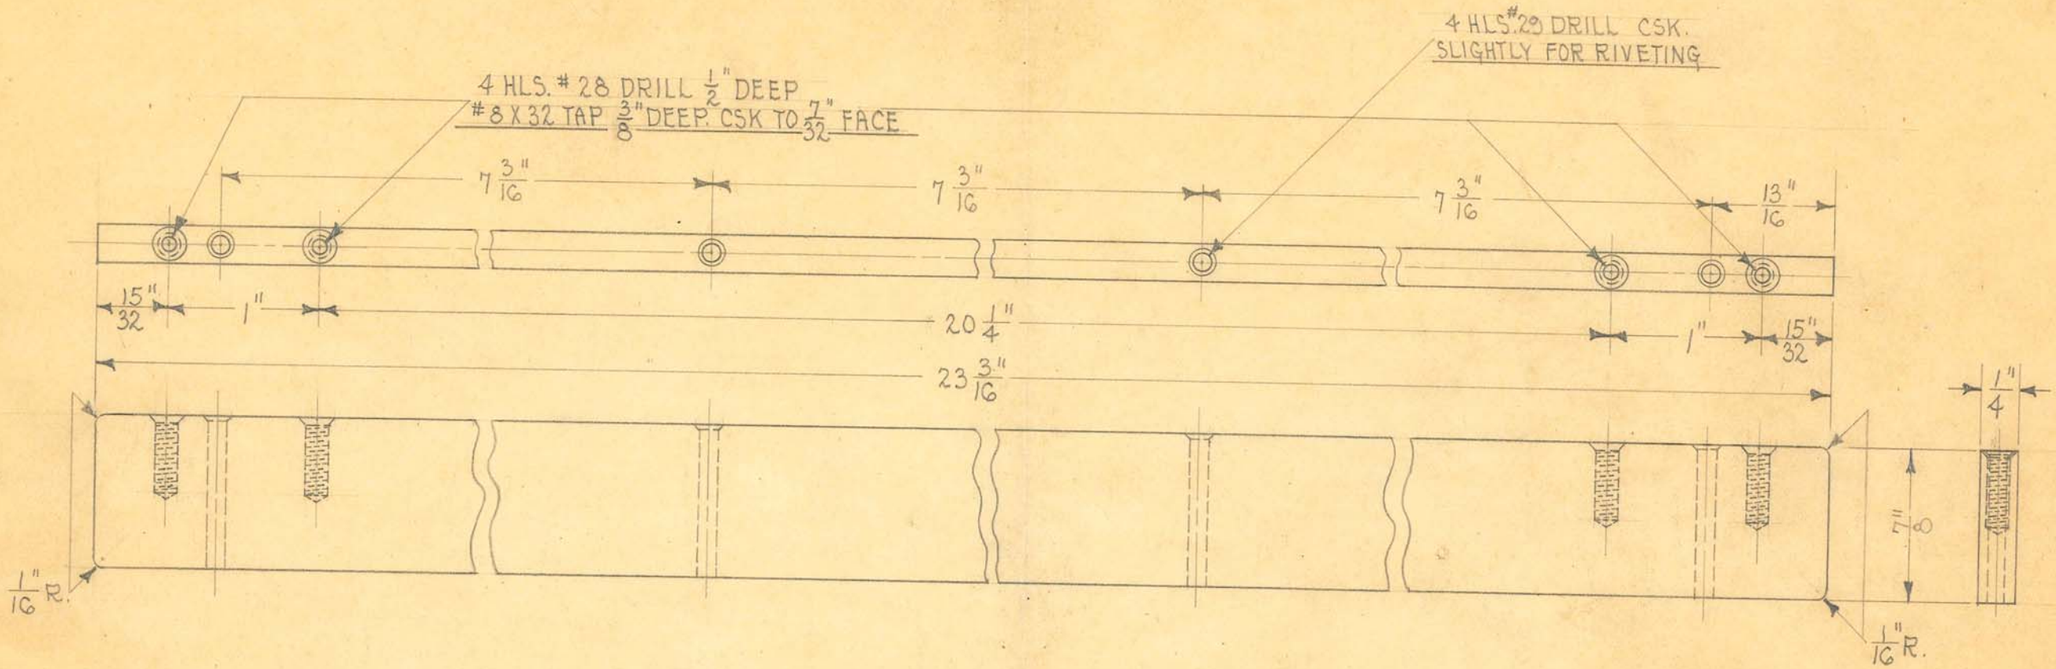

2 REQUIRED

OBSOLETE

SIZE	1/4" X 7/8"	ISSUE 4-11-34	H.E.	TITLE: FISCHER 36" FLAT BUCKY CASE BRACING STRIP
KIND	C.R. STEEL	CHANGED 1-25-35	H.E.	
SHAPE		" "		
FINISH	CAD. PLATE	" "		
TEMP.		" "		
PATT.		" "		

H. G. FISCHER & CO.
2335 WABANSIA AVE.

CAT. NO.

PART NO. 8C036

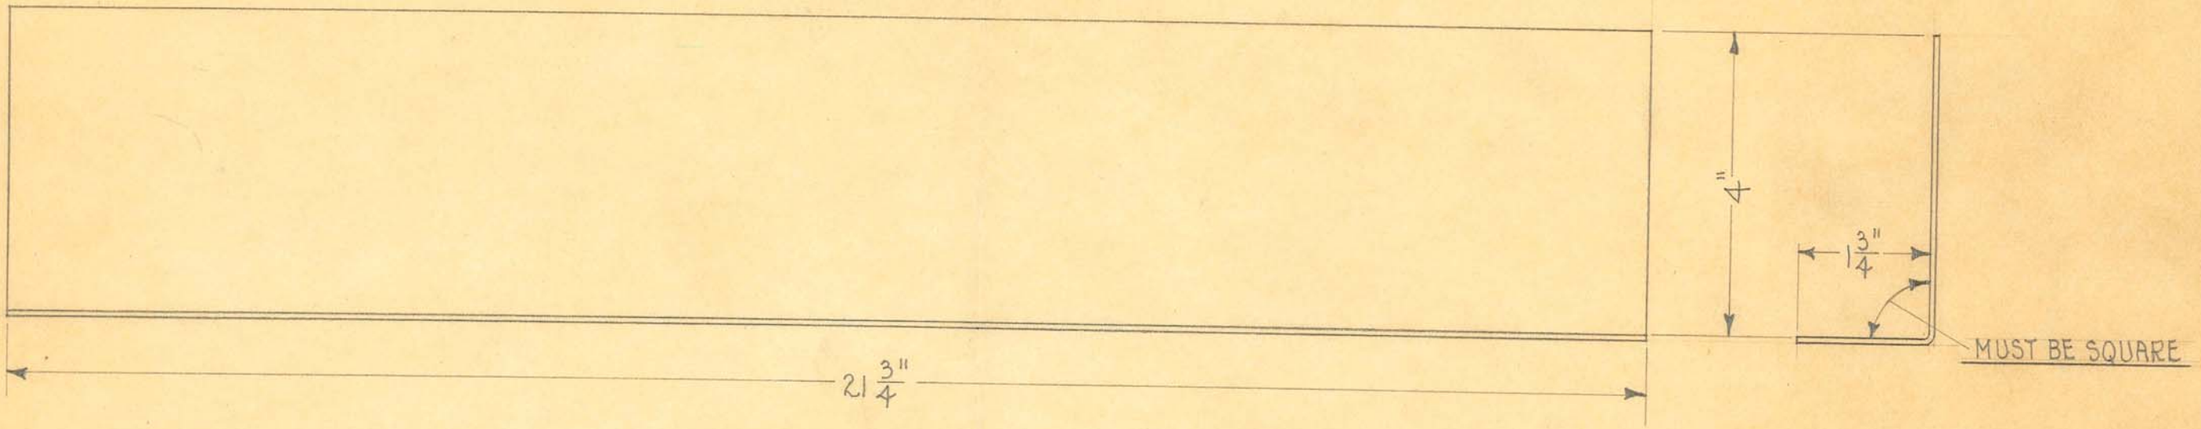

SCALE ~ 6" = 1'

1 REQUIRED

OBSOLETE

SIZE	#16 GA.	ISSUE 4-5-34	A.E.	TITLE: FISCHER 36" FLAT BUCKY OPERATING UNIT MOUNTING ANGLE
KIND	SHEET STEEL	CHANGED		
SHAPE		" "		
FINISH		" "		
TEMP.		" "		
PATT.		" "		

H. G. FISCHER & CO.
2335 WABANSIA AVE.
CHICAGO, ILL.

CAT. NO.

PART NO. 8605

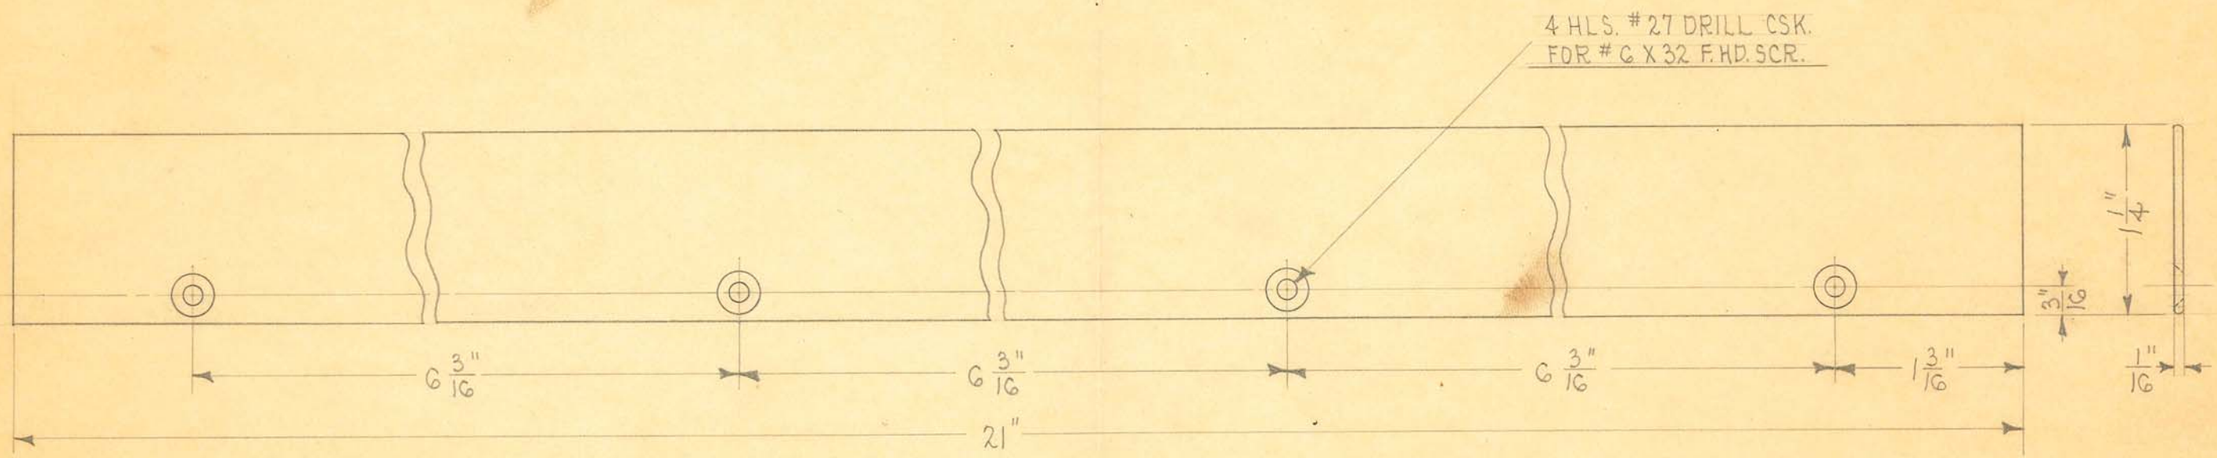

1 REQUIRED

OBSOLETE

SIZE	1/16" X 1 1/4"	ISSUE 1-23-35	A.E.
KIND	FLAT WIRE	CHANGED	
SHAPE		" "	
FINISH	CAD. #23	" "	
TEMP.		" "	
PATT.		" "	

TITLE: FISCHER 36" FLAT BUCKY GRID ROLLER PLATE

H. G. FISCHER & CO.
2335 WABANSIA AVE.
CHICAGO, ILL.

CAT. NO.

PART NO. 8620

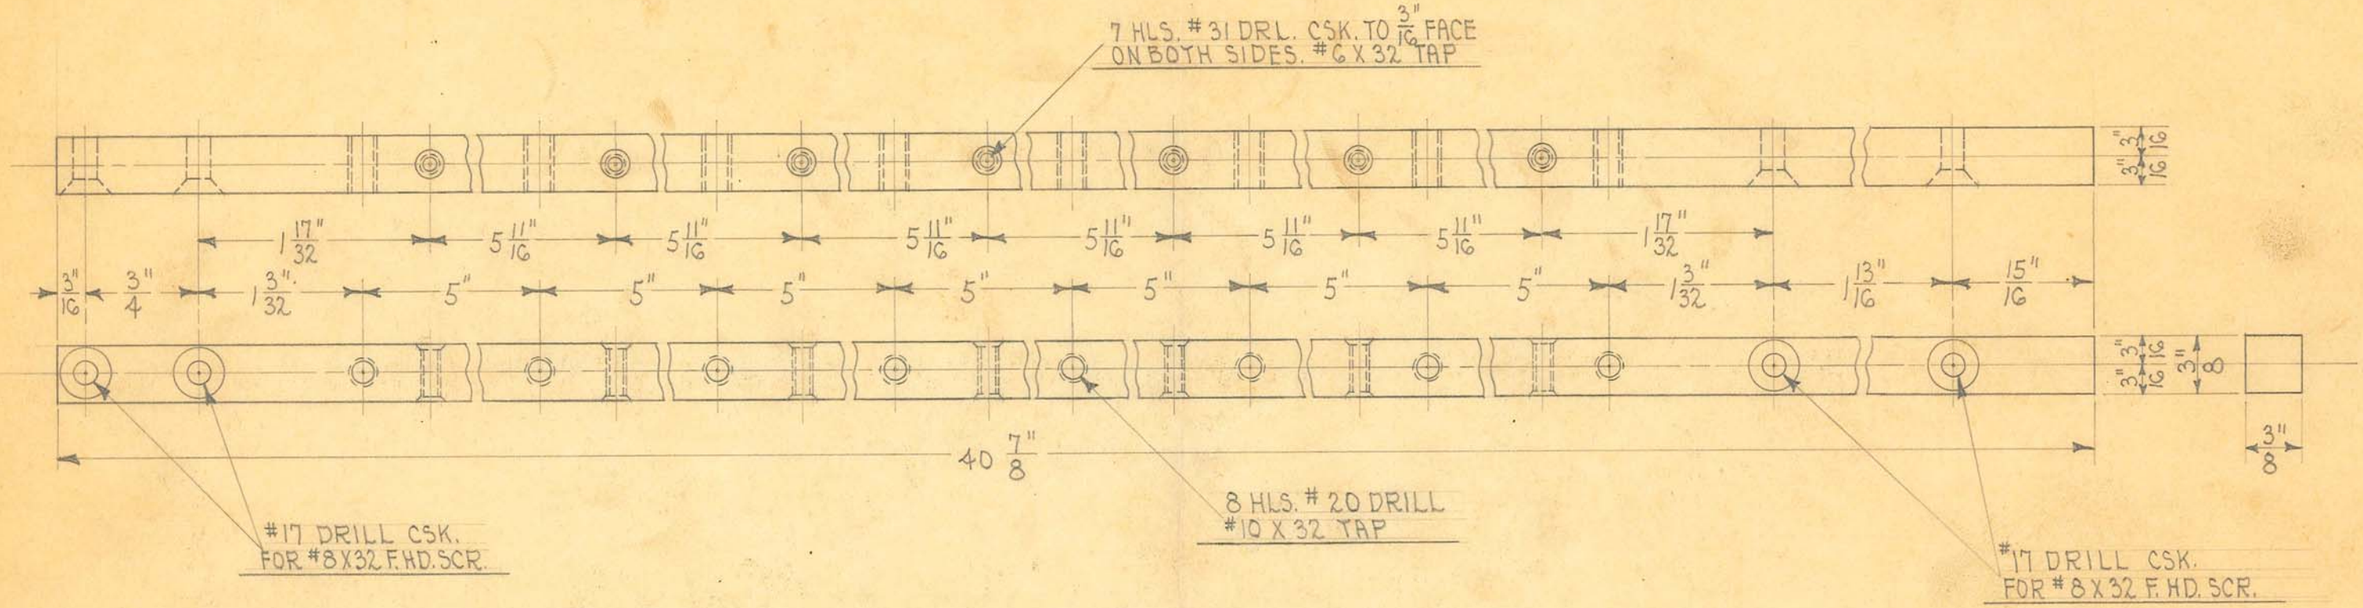

2 REQUIRED

DRILLED IN JIG

OBSOLETE

SIZE	3/8" SQ.	ISSUE 4-10-34	A.E.
KIND	C.R. STEEL	CHANGED	
SHAPE		" "	
FINISH	CAD. # 23	" "	
TEMP.		" "	
PATT.		" "	

TITLE: FISCHER 36" FLAT BUCKY GRID FRAME TIE ROD

H. G. FISCHER & CO.
2335 WABANSIA AVE.
CHICAGO, ILL.

CAT. NO.

PART NO. 8621

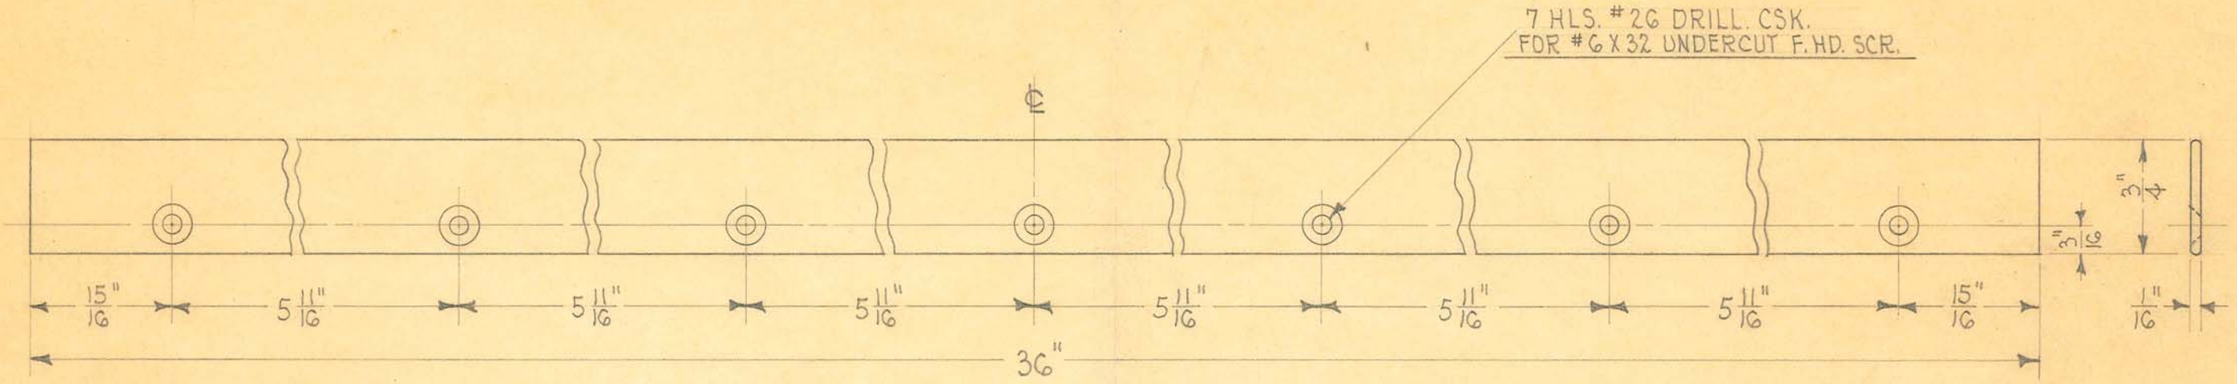

4 REQUIRED

OBSOLETE

SIZE	1/16" X 3/4"	ISSUE 4-11-34	D.E.
KIND	FLAT WIRE	CHANGED	
SHAPE		" "	
FINISH	CAD. #23	" "	
TEMP.		" "	
PATT.		" "	

TITLE: FISCHER 36" FLAT BUCKY GRID FRAME TIE ROD REINFORCING STRIP

H. G. FISCHER & CO.
2335 WABANSIA AVE.
CHICAGO, ILL.

CAT. NO.

PART NO. 8622

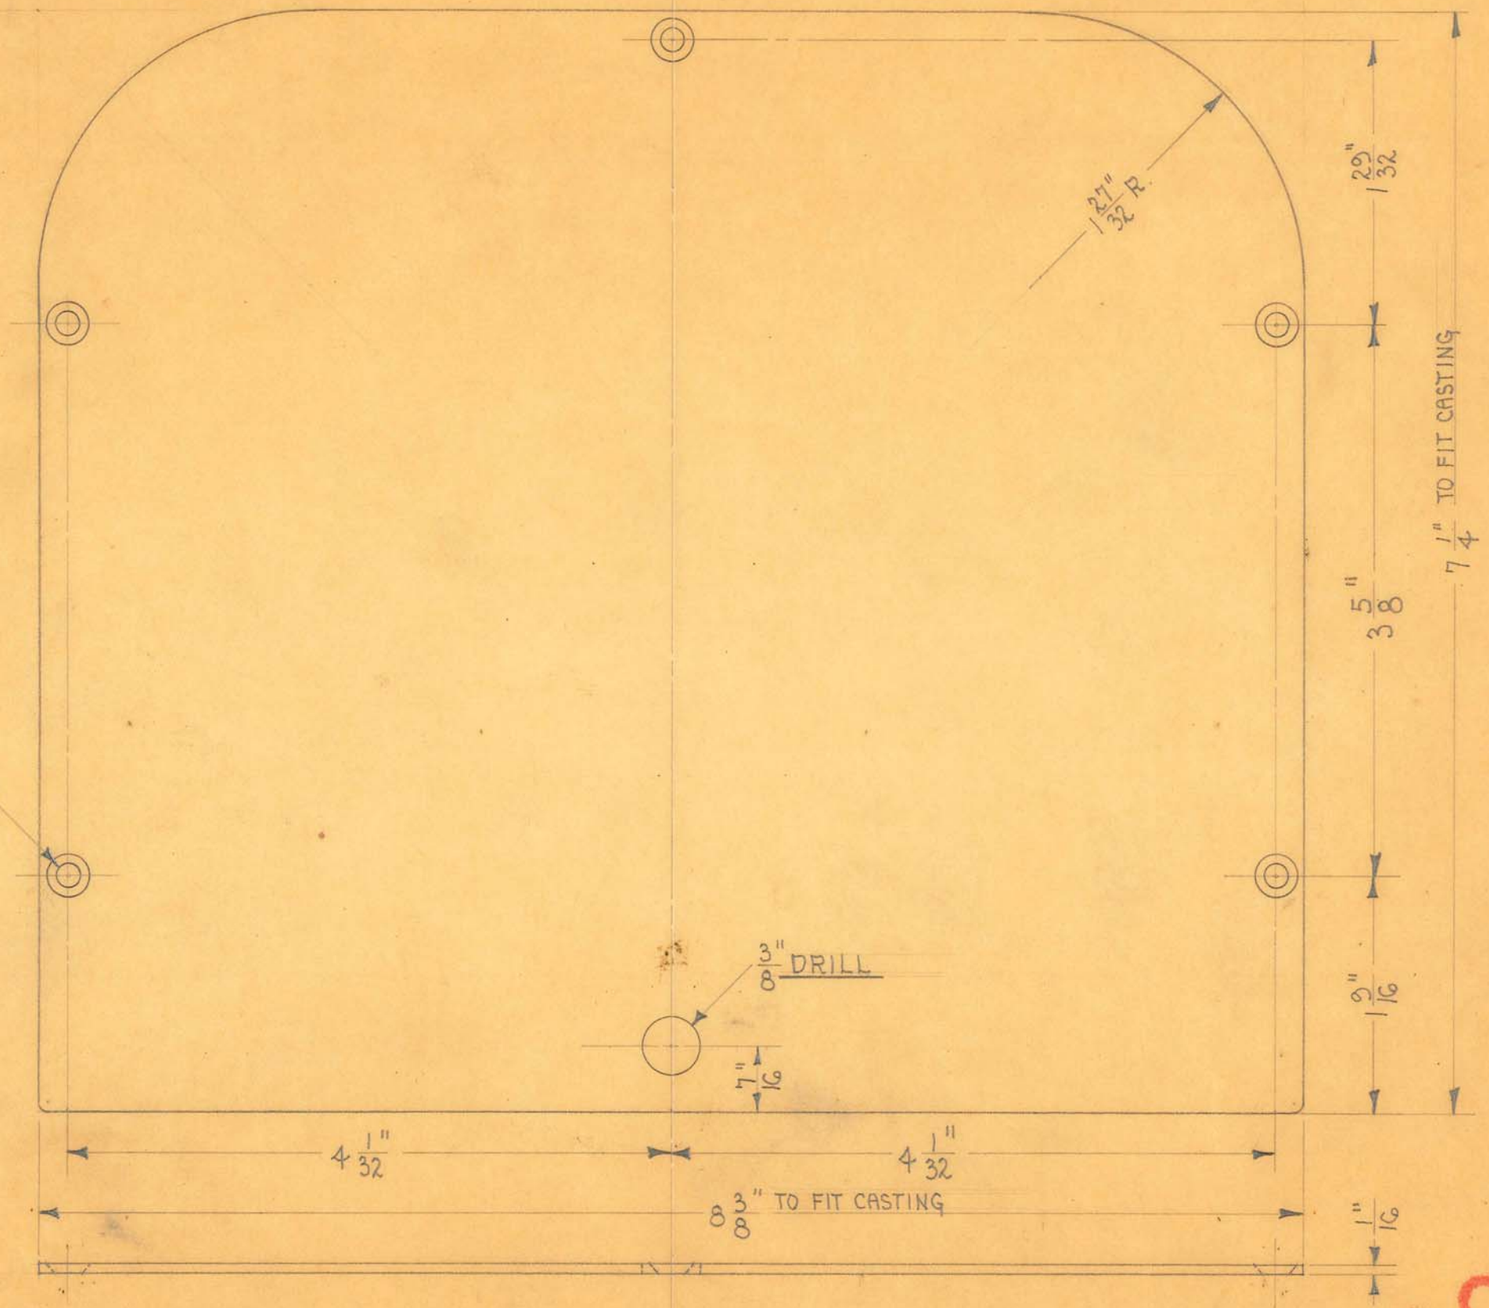

1 REQUIRED

OBSOLETE

SIZE	1/16" SHEET	ISSUE 4-9-35	A.E.
KIND	C.R. STEEL	CHANGED	
SHAPE		" "	
FINISH	BLACK # 70	" "	
TEMP.		" "	
PATT.		" "	

TITLE: FISCHER 36" FLAT BUCKY COUNTERBALANCE HOUSING COVER

H. G. FISCHER & CO.
2335 WABANSIA AVE.

CAT. NO.

PART NO. 8628

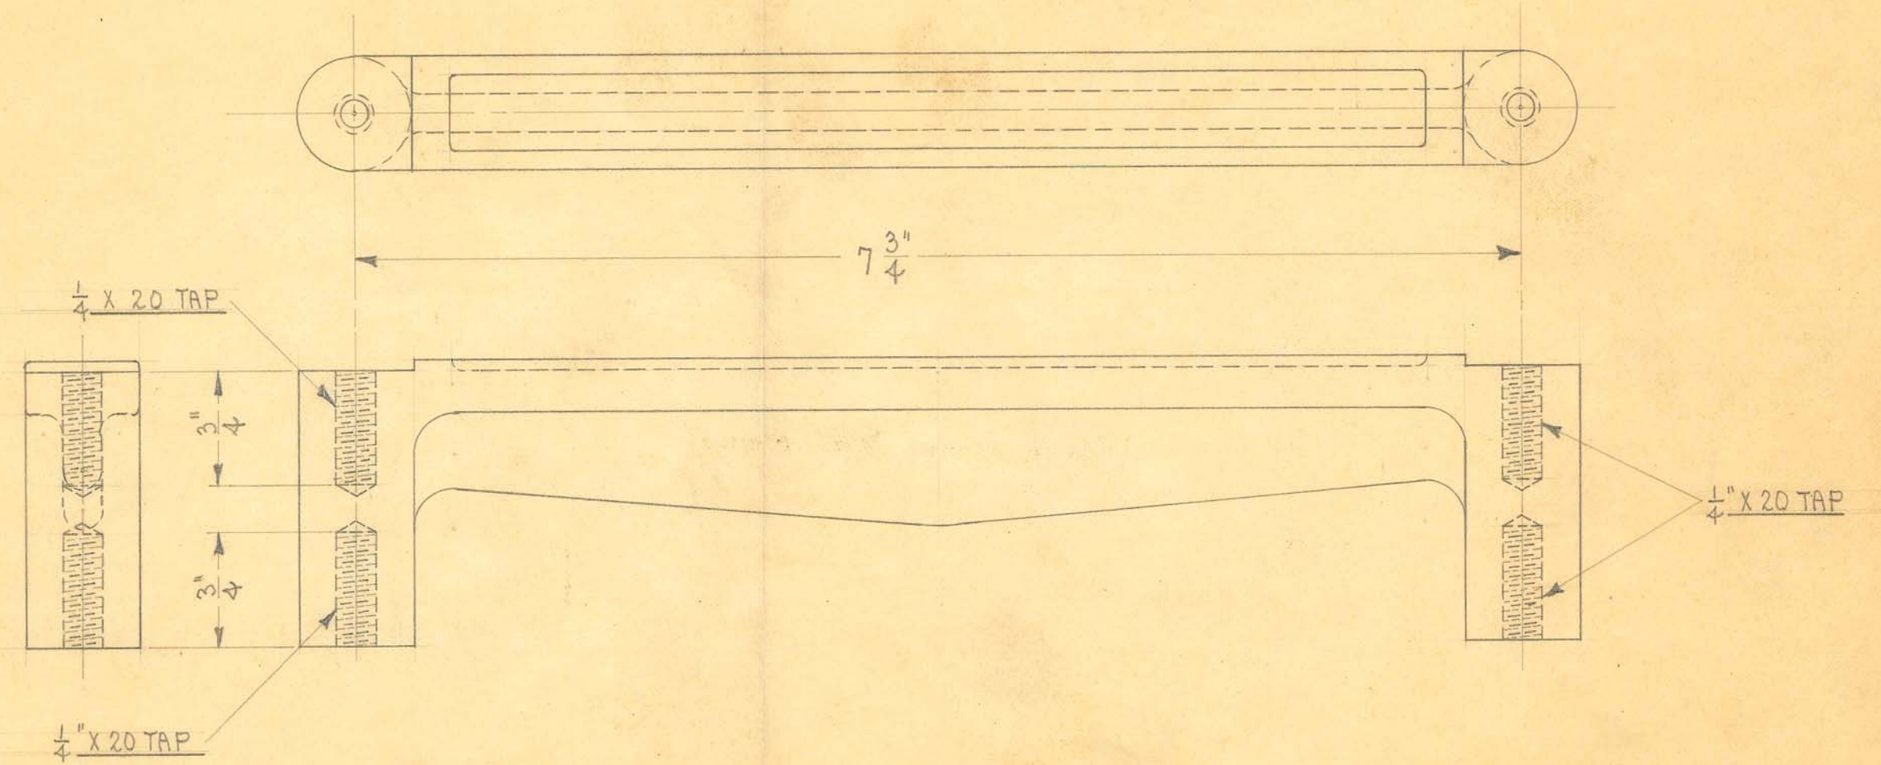

1 REQUIRED

OBSOLETE

SIZE		ISSUE 7-2-34	J.E.
KIND	IRON CASTING	CHANGED	
SHAPE		" "	
FINISH	BLACK #50	" "	
TEMP.		" "	
PATT.	136-739	" "	

TITLE: SHORT WAVE HIGH FREQ. OUTFIT TRANSFORMER SUPPORT-LOWER

H. G. FISCHER & CO.
2335 WABANSIA AVE.
CHICAGO, ILL.

CAT. NO.

PART NO. 8756 1/2 F

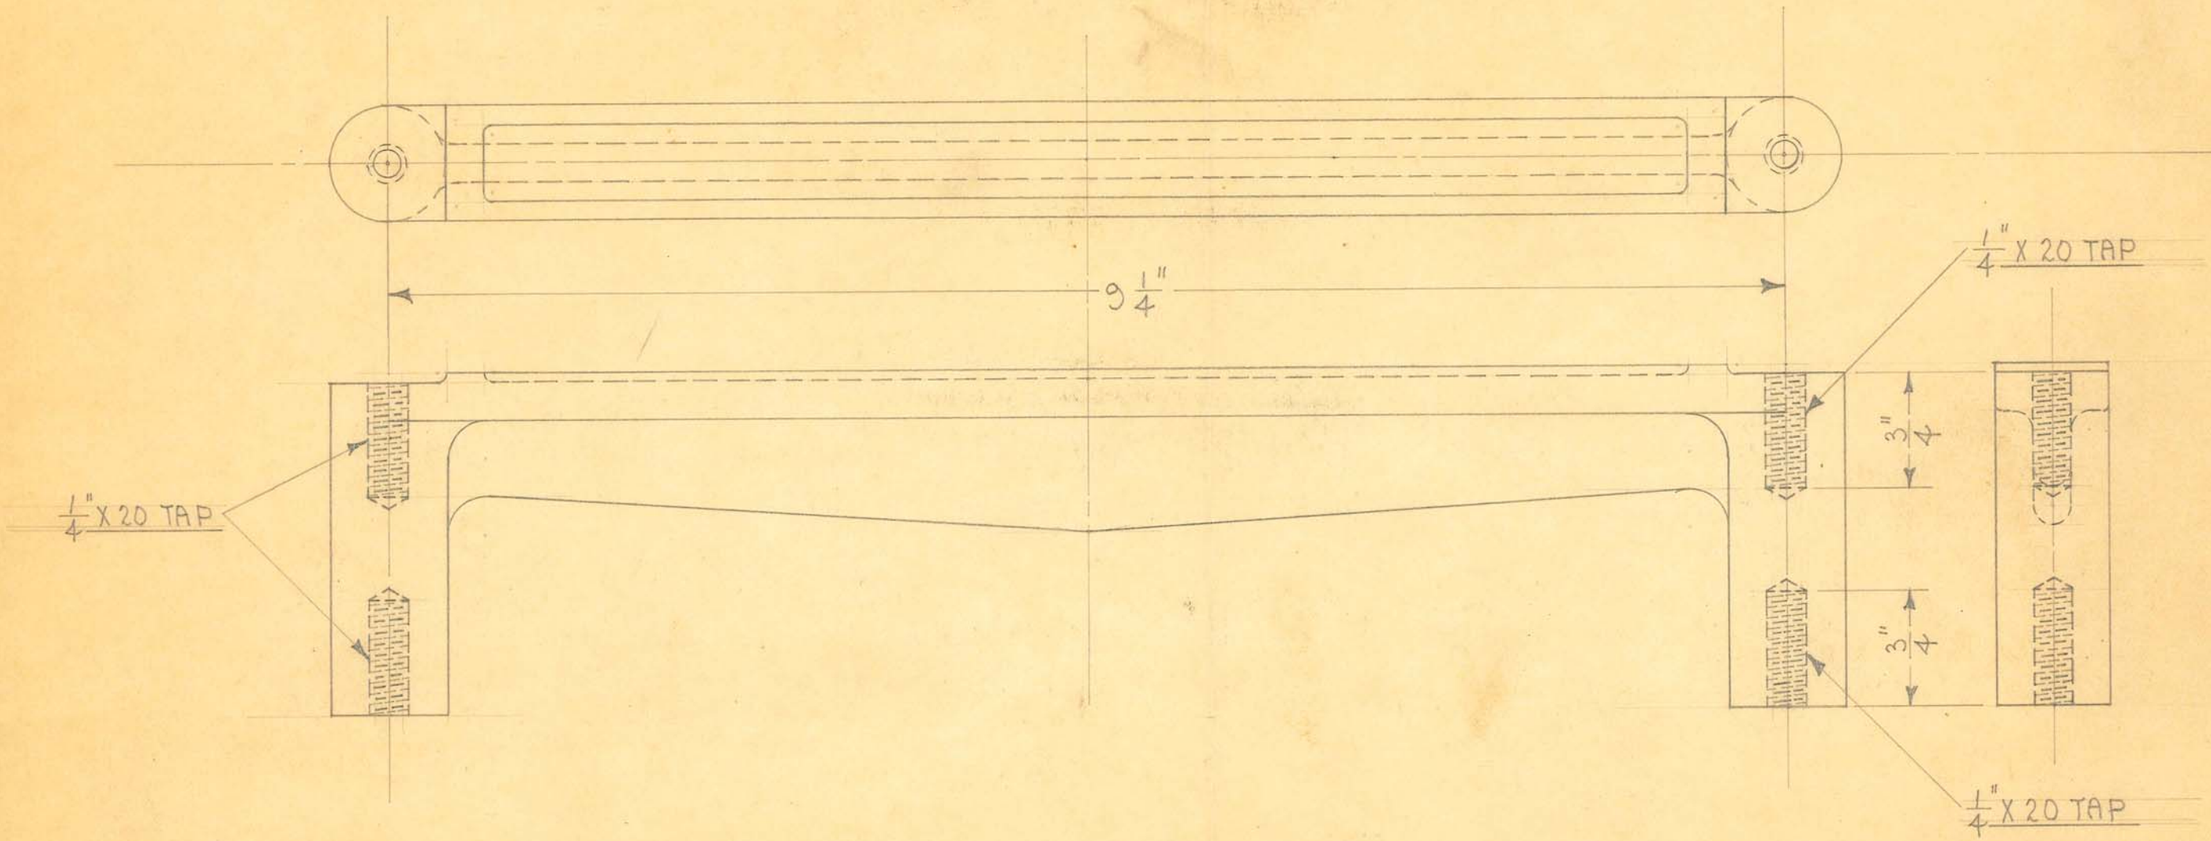

1 REQUIRED

OBSOLETE

SIZE		ISSUE 6-1-36	AE
KIND	IRON CASTING	CHANGED	
SHAPE		" "	
FINISH	BLACK #80	" "	
TEMP.		" "	
PATT.	8619-836	" "	

TITLE:
SHORT WAVE - 25 CYCLE - H. F. OUTFIT
TRANSFORMER SUPPORT - LOWER

H. G. FISCHER & CO.
2335 WABANSIA AVE.
CHICAGO, ILL.

CAT. NO.

PART NO. 8756 3/4

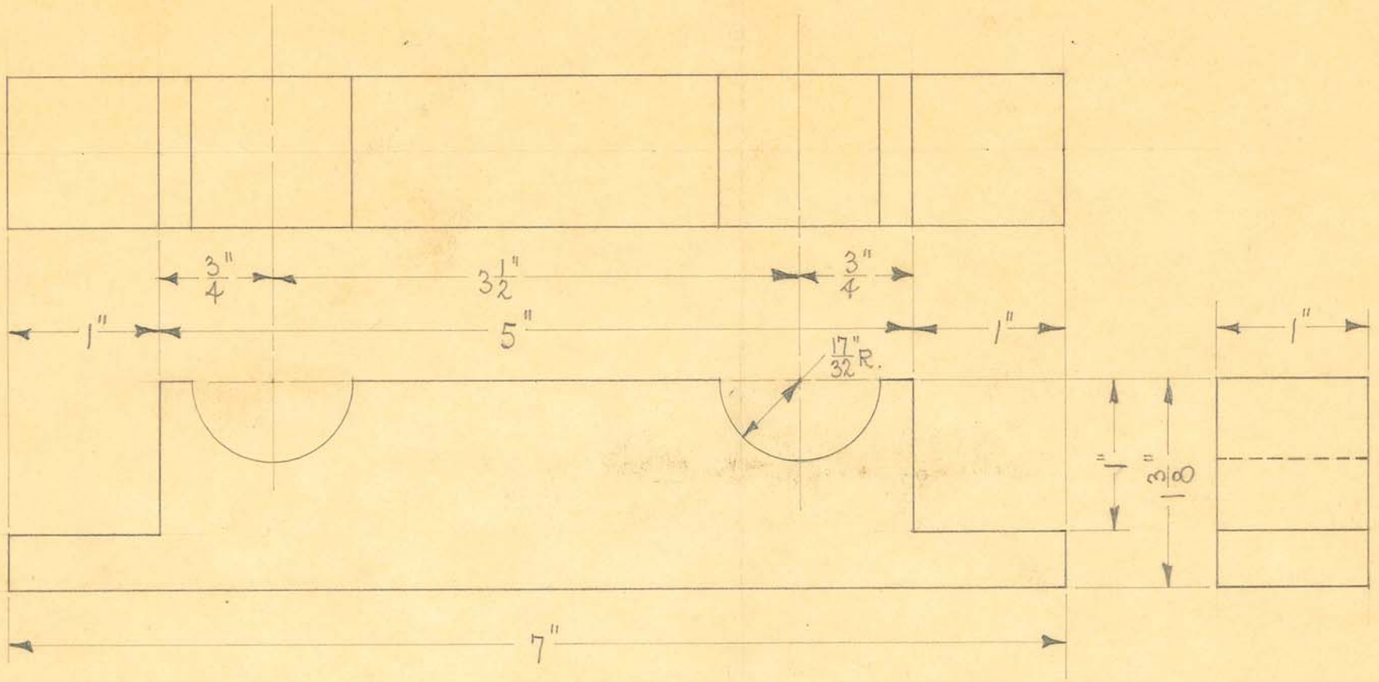

2 REQUIRED

OBSOLETE

SIZE		ISSUE 7-16-34	A.E.
KIND		CHANGED	
SHAPE		" "	
FINISH		" "	
TEMP.		" "	
PATT.		" "	

TITLE: SHORT WAVE HIGH FREQUENCY OUTFIT
HIGH FREQ. CHOKE COIL SUPPORT BLOCK

H. G. FISCHER & CO.
2335 WABANSIA AVE.
CHICAGO, ILL.

CAT. NO.

PART NO. 8768

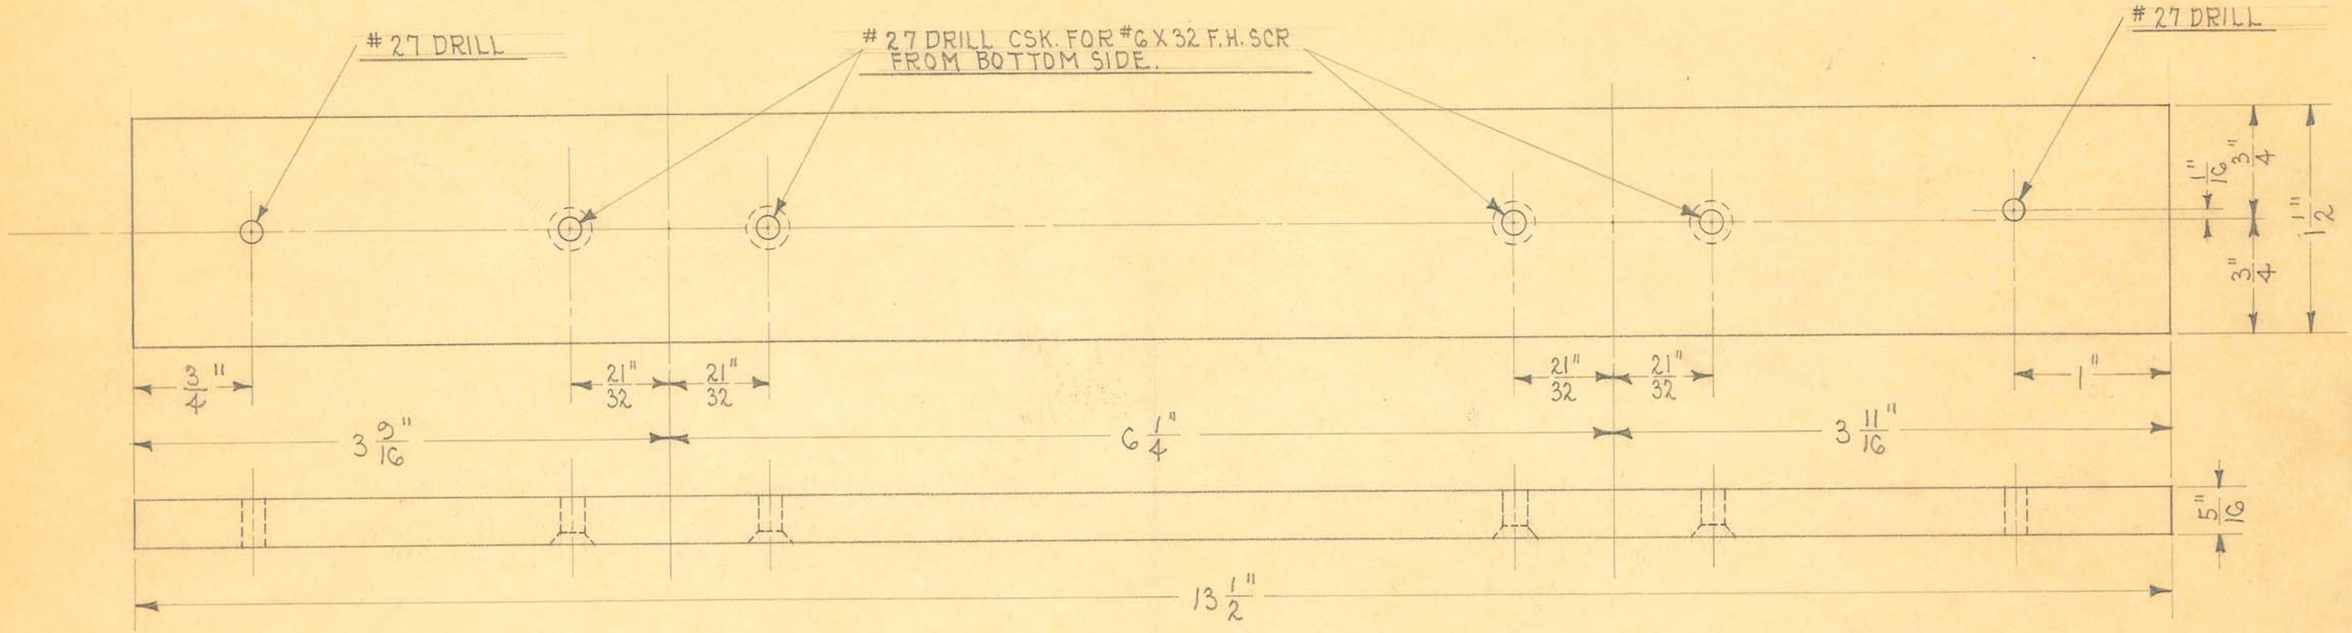

1 REQUIRED

OBSOLETE

SIZE		ISSUE 2-22-35	A.E.
KIND		CHANGED	
SHAPE		" "	
FINISH		" "	
TEMP.		" "	
PATT.		" "	

TITLE: MODEL "SW 24" SHORT WAVE HIGH FREQ. OUTFIT
AUXILLIARY TUNING COIL MTG. BOARD

H. G. FISCHER & CO.
2335 WABANSIA AVE.
CHICAGO, ILL.

CAT. NO.

PART NO. 8793F

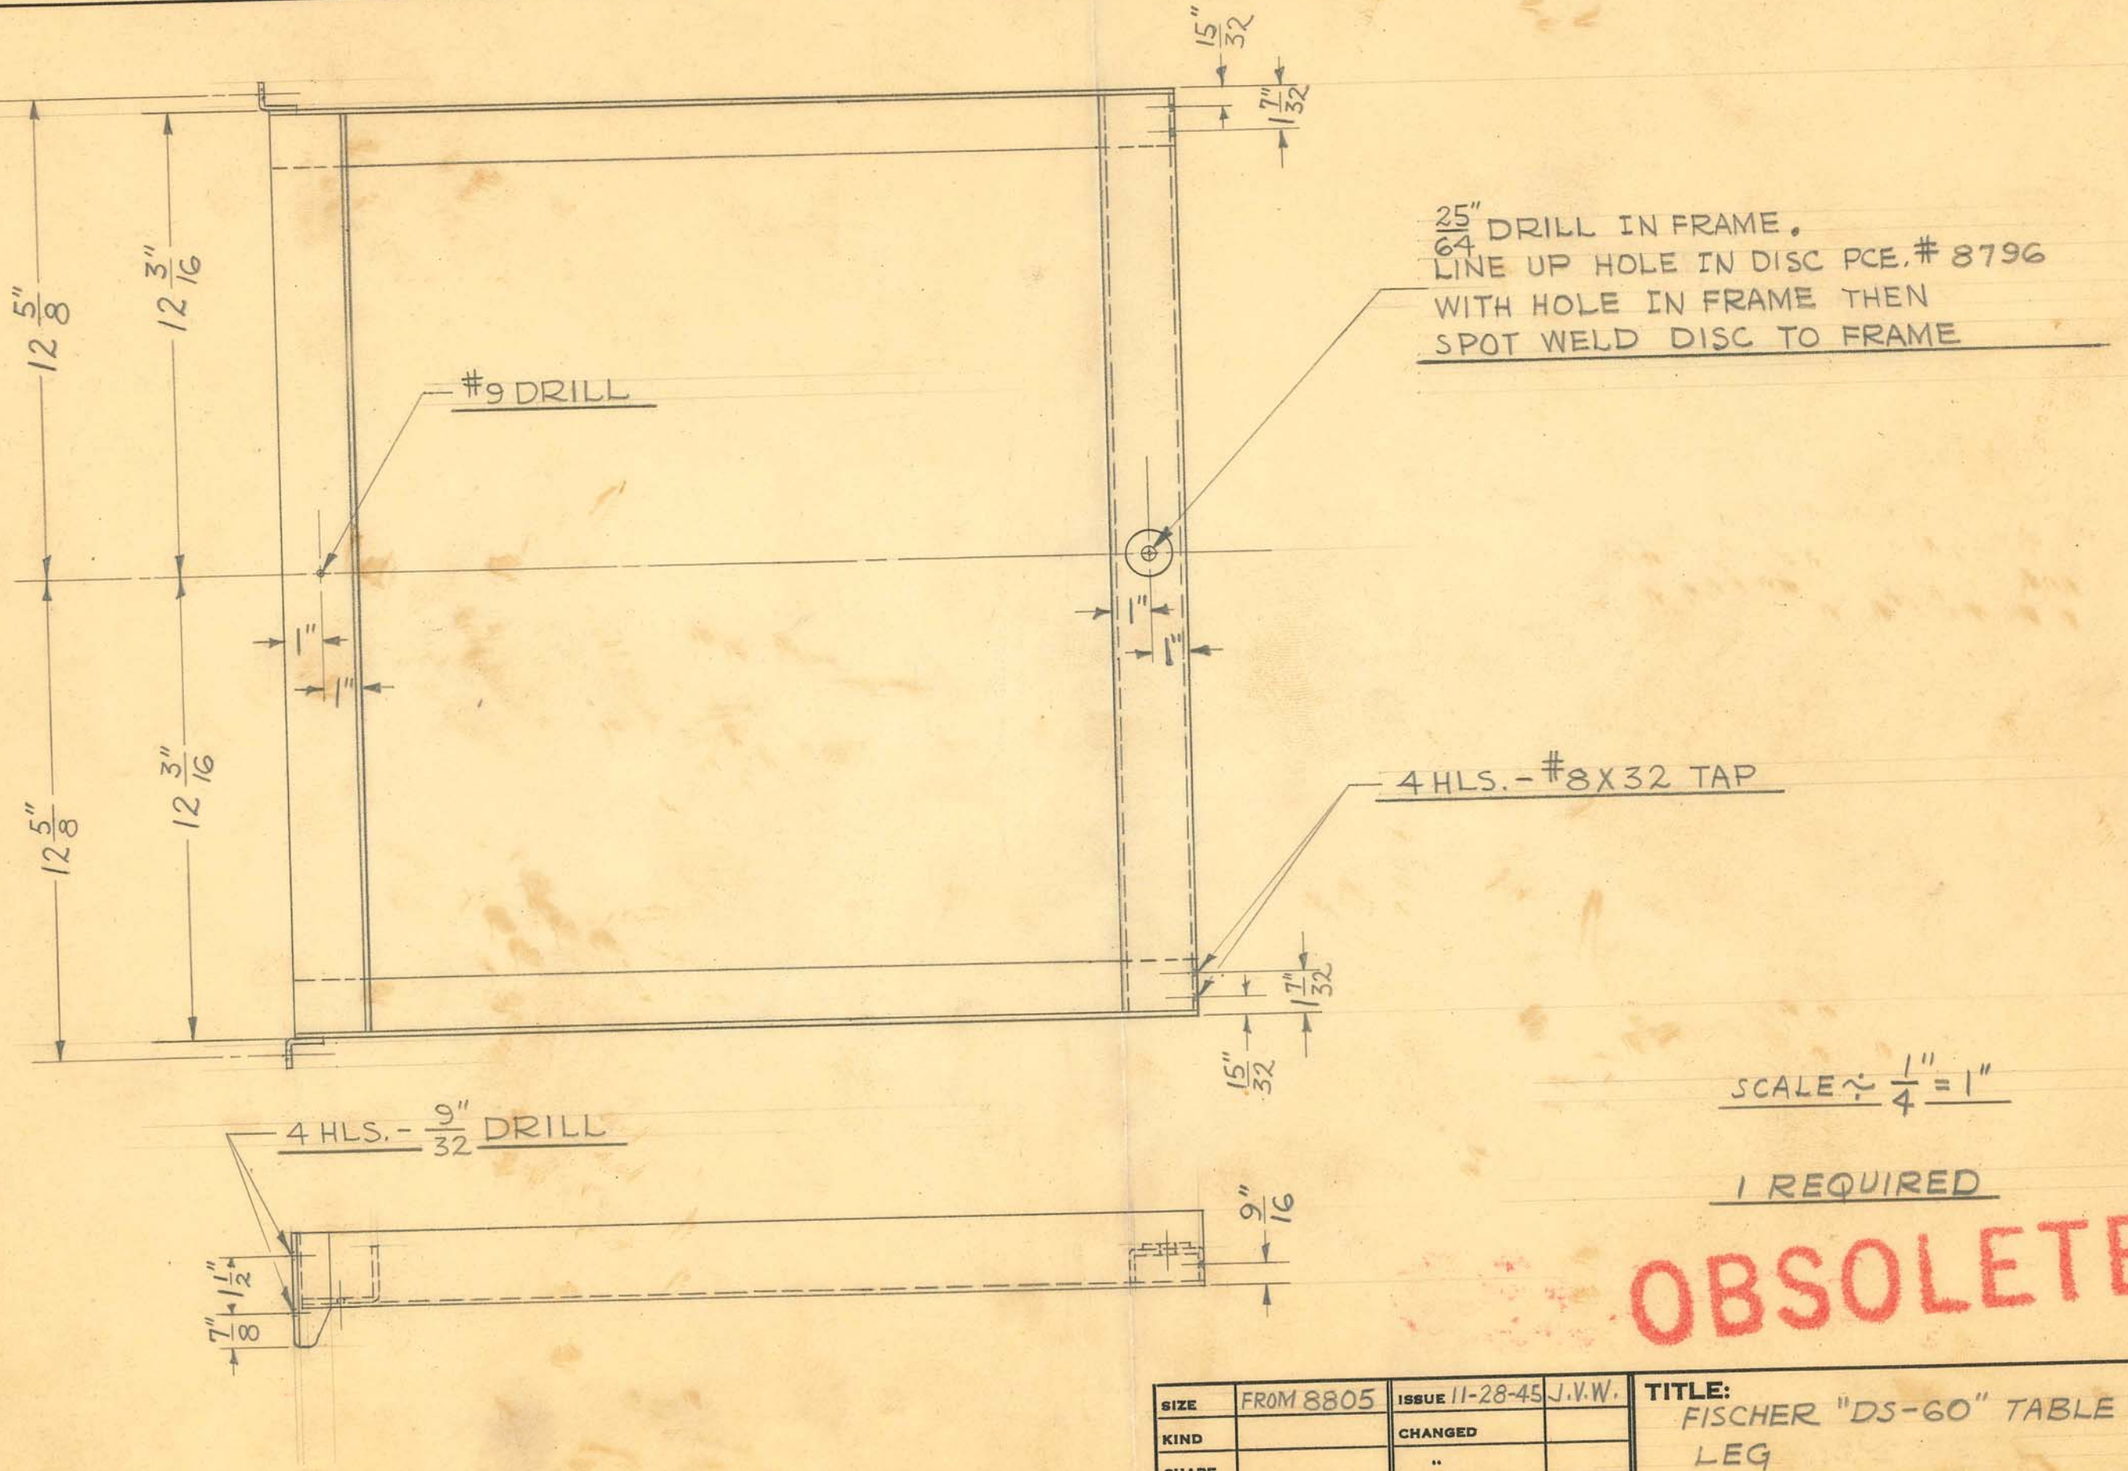

SCALE ≈ 1/4" = 1"

1 REQUIRED

OBSOLETE

SIZE	FROM 8805	ISSUE 11-28-45	J.V.W.
KIND		CHANGED	
SHAPE		"	
FINISH		"	
TEMP.		"	
PATT.		"	

TITLE: FISCHER "DS-60" TABLE LEG

H. G. FISCHER & CO.
2335 WABANSIA AVE.
CHICAGO, ILL.

CAT. NO.

PART NO. 8797G

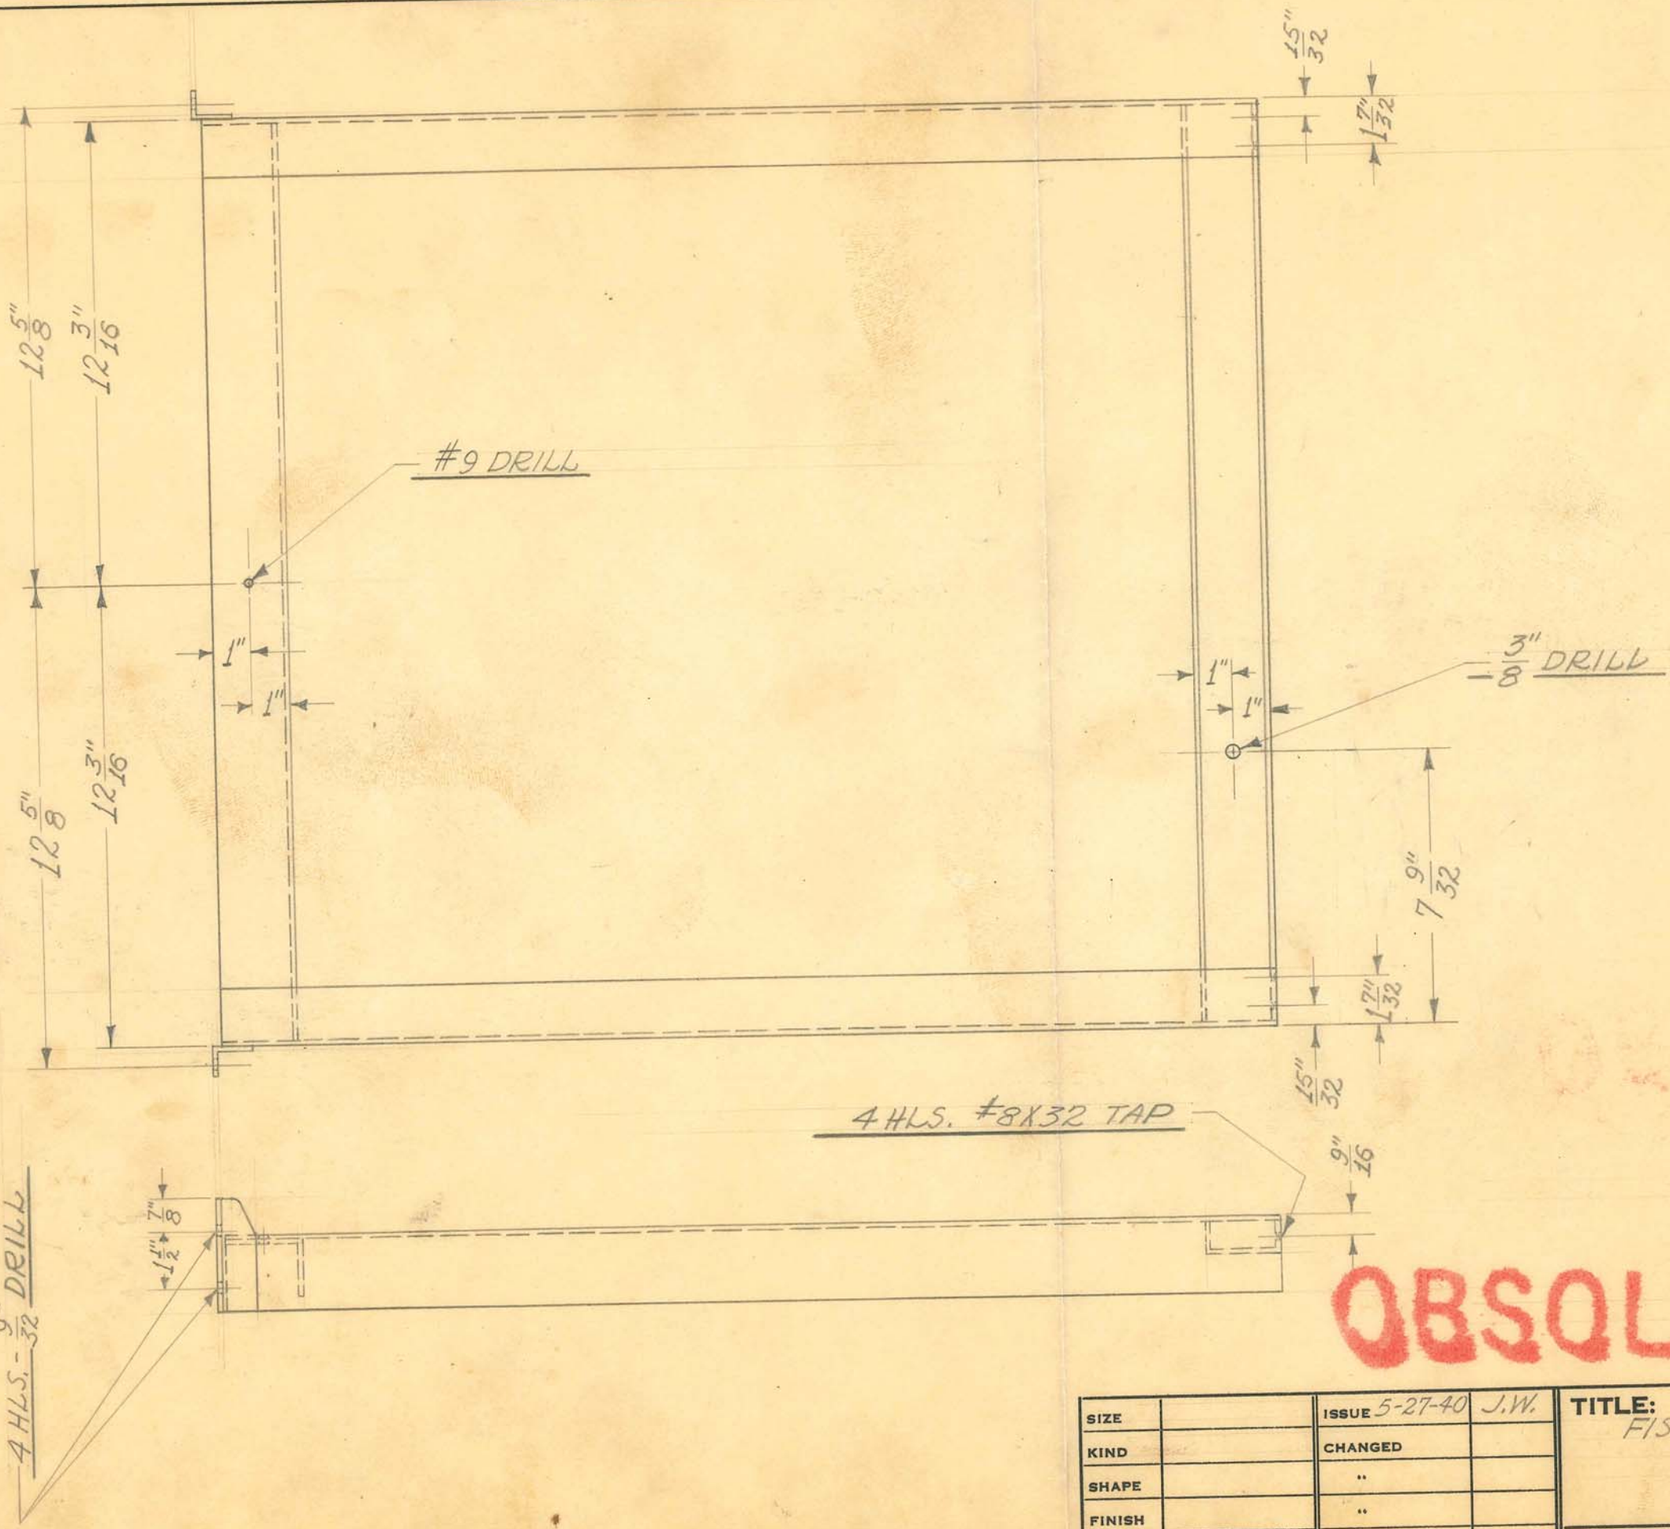

Obsolete

SCALE ÷ 1/4" = 1"

OBSOLETE FROM 8805

SIZE		ISSUE 5-27-40	J.W.	TITLE: FISCHER "DS-60" TABLE LEG -HEAD END
KIND		CHANGED		
SHAPE		"		
FINISH		"		
TEMP.		"		
PATT.		"		

H. G. FISCHER & CO.
2335 WABANSIA AVE.
CHICAGO, ILL.

CAT. NO.

PART NO. 8799

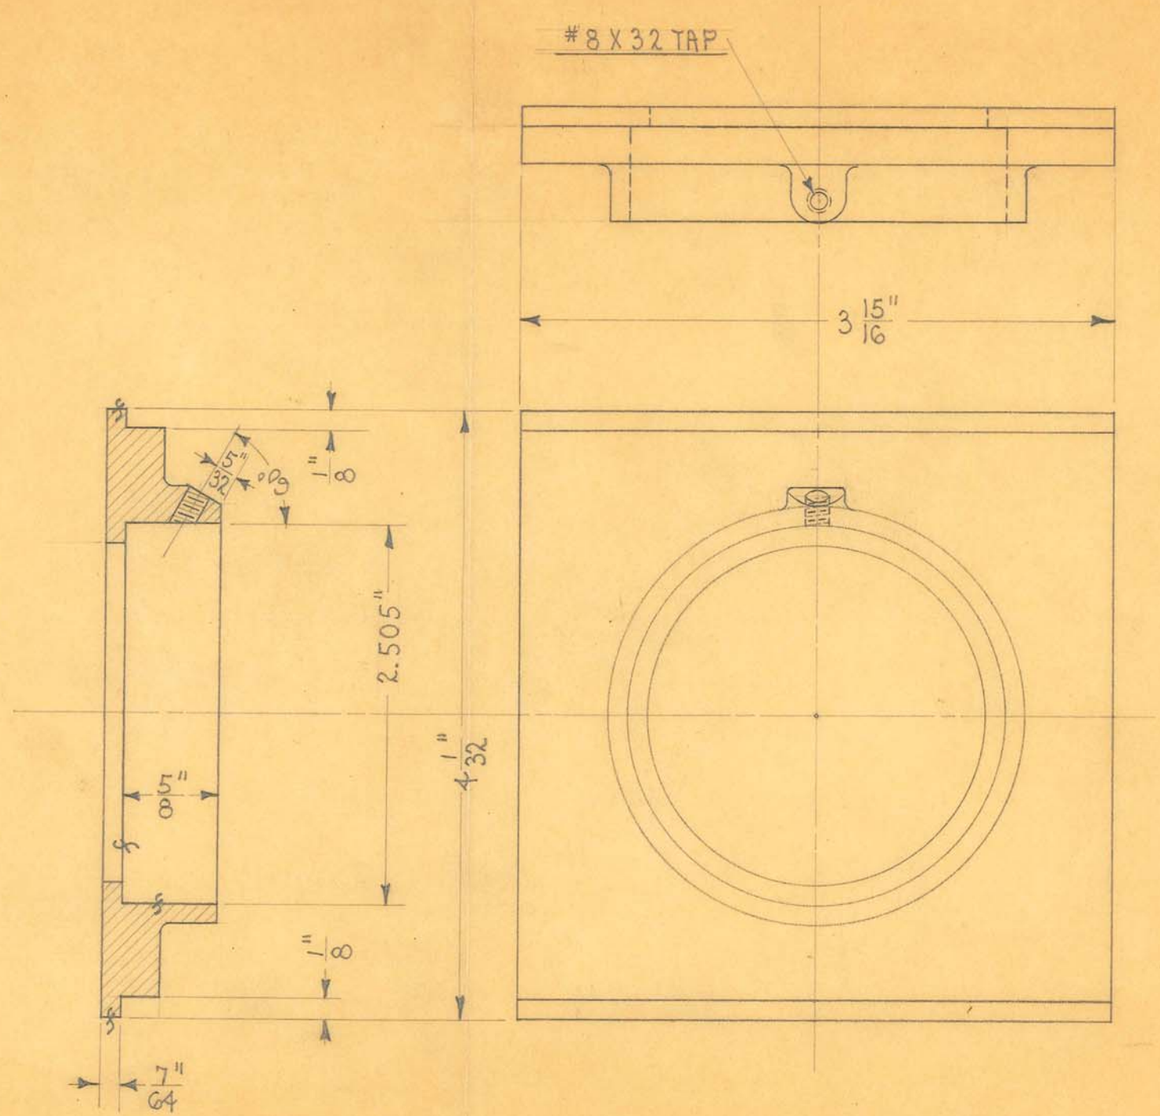

OBSOLETE

SIZE		ISSUE 4-9-35	H.E.	TITLE: "60-88" & "D-S-60" DENTAL CONE HOLDER
KIND	IRON CASTING	CHANGED		
SHAPE		" "		
FINISH	BLACK #50	" "		
TEMP.		" "		
PATT.	8244-832	" "		

H. G. FISCHER & CO.
2335 WABANSIA AVE.
CHICAGO, ILL.

CAT. NO. 3586A

PART NO. G40G½AF

OBSOLETE

SIZE	1/32"	ISSUE 6-11-31	H.E.
KIND	BL. SHEET FIBRE	CHANGED	
SHAPE		" "	
FINISH		" "	
TEMP.		" "	
PATT.		" "	

TITLE: FLUORDSCOPE CONE LIGHT SHIELD

H. G. FISCHER & CO.
2335 WABANSIA AVE.
CHICAGO, ILL.

CAT. NO.

PART NO. 6419

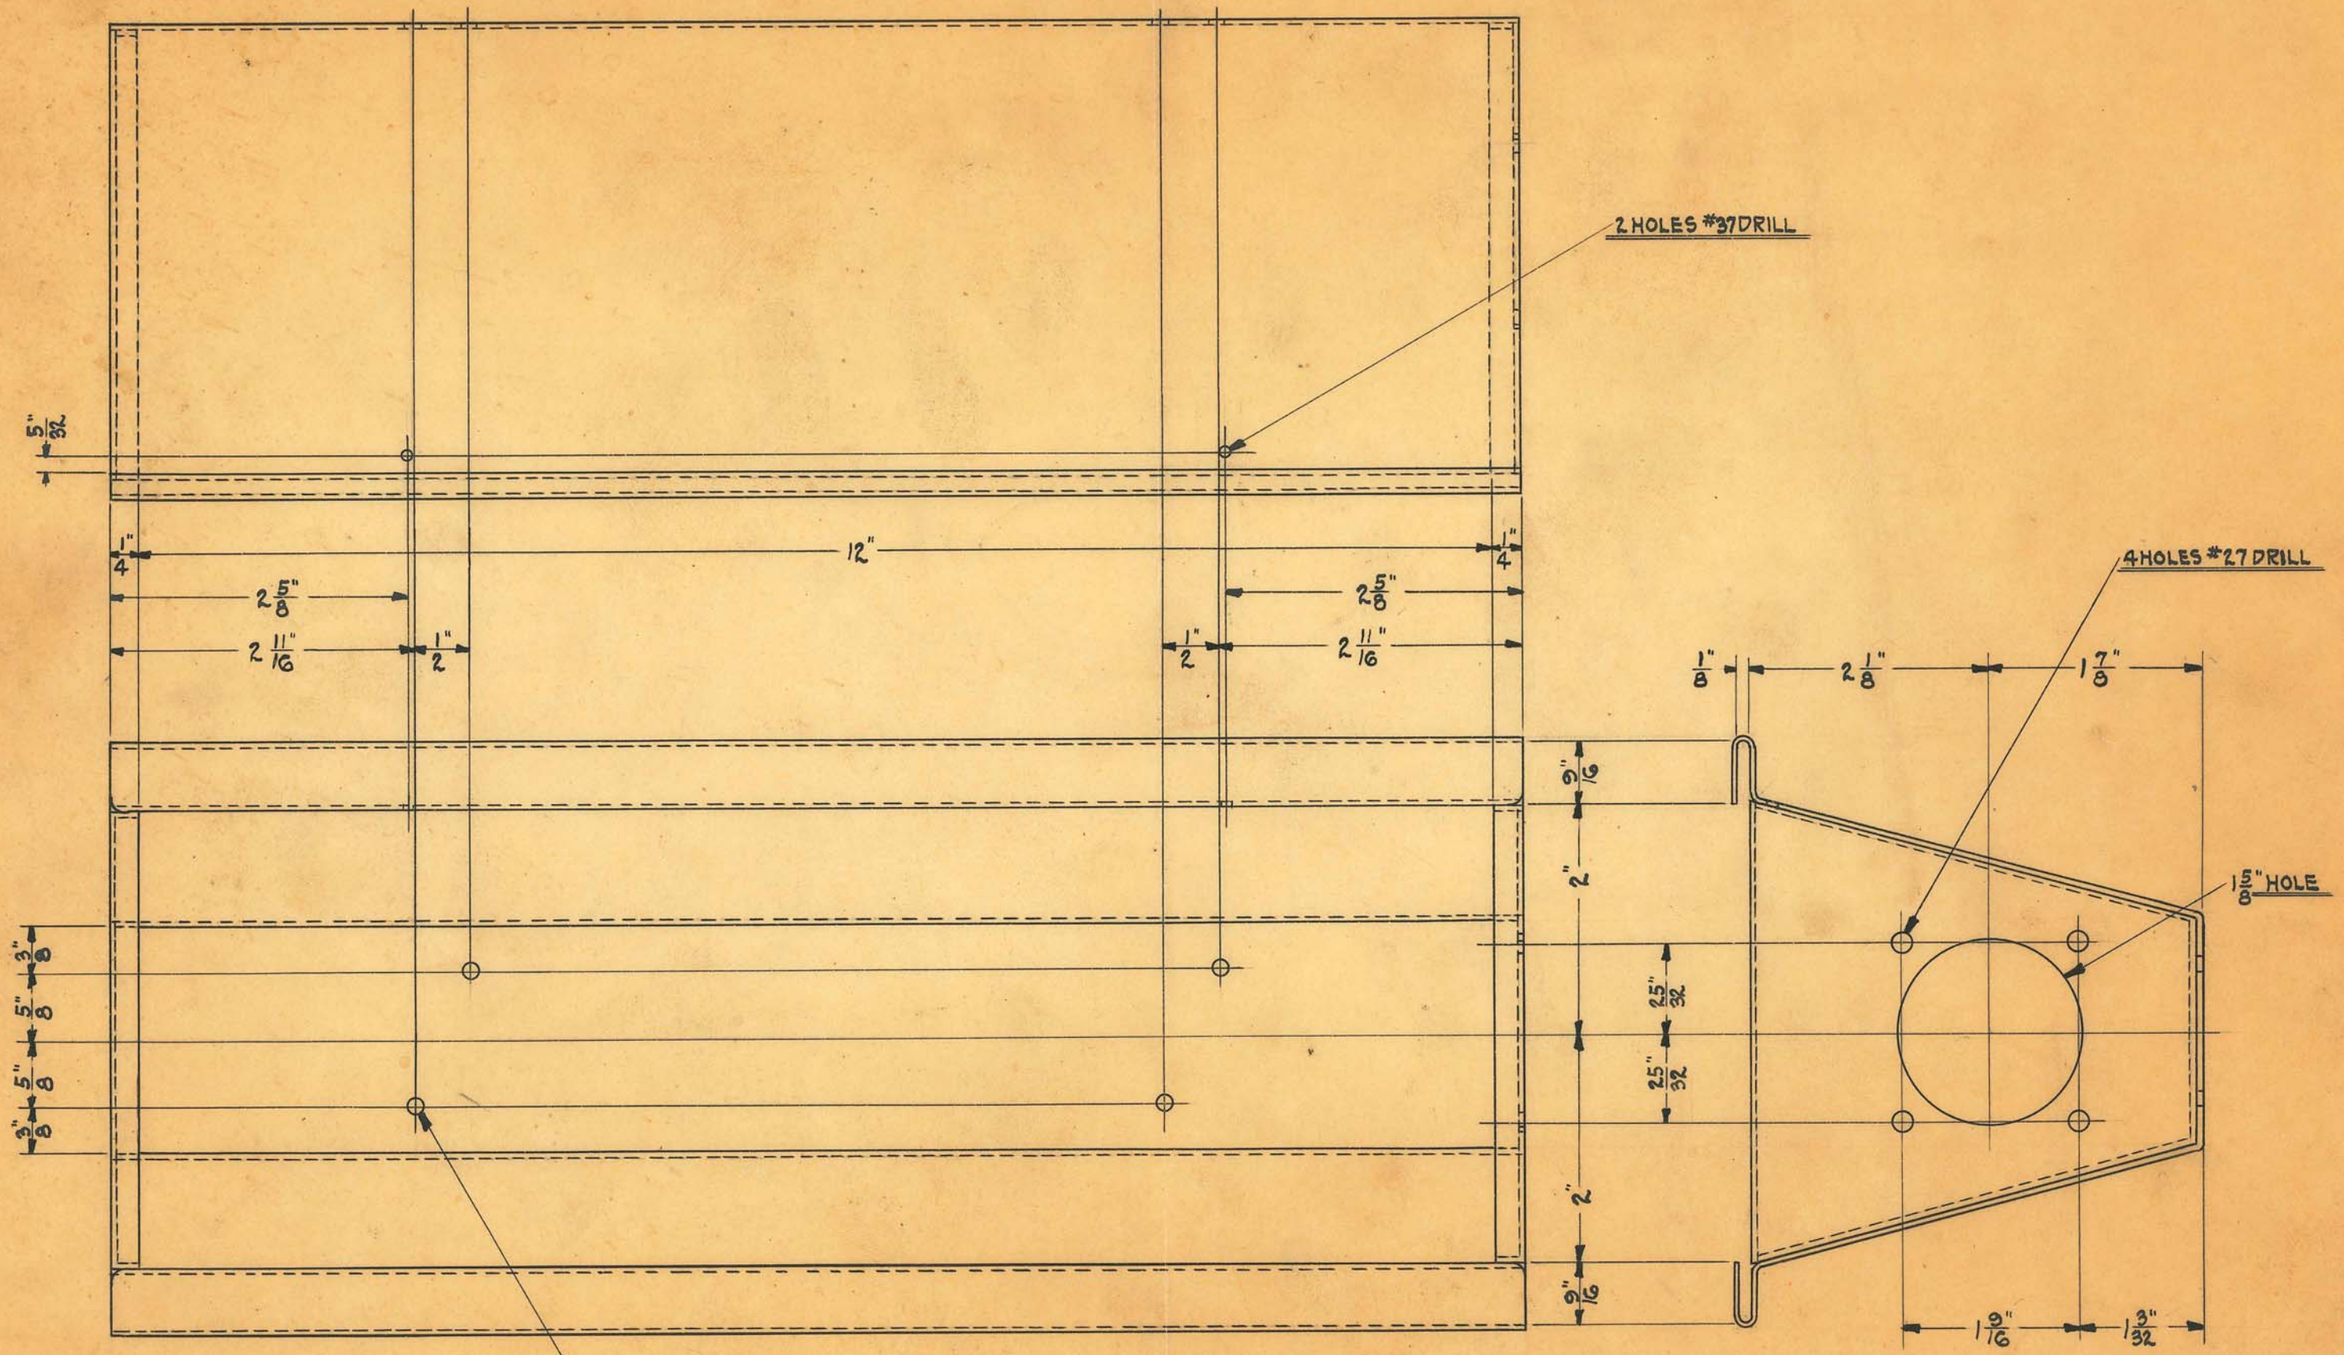

SCALE ÷ 3/4 = 1"

SIZE	1X	ISSUE H.E.	2-24-30
KIND	CHAR. PRIME	CHANGED	
SHAPE		" "	
FINISH		" "	
TEMP.		" "	
PATT.		" "	

TITLE: ILLUMINATOR BOX FOR DENTAL FILMS

OBSOLETE

H. G. FISCHER & CO.
2335 WABANSIA AVE.
CHICAGO, ILL.

CAT. NO.

PART NO. 6450F

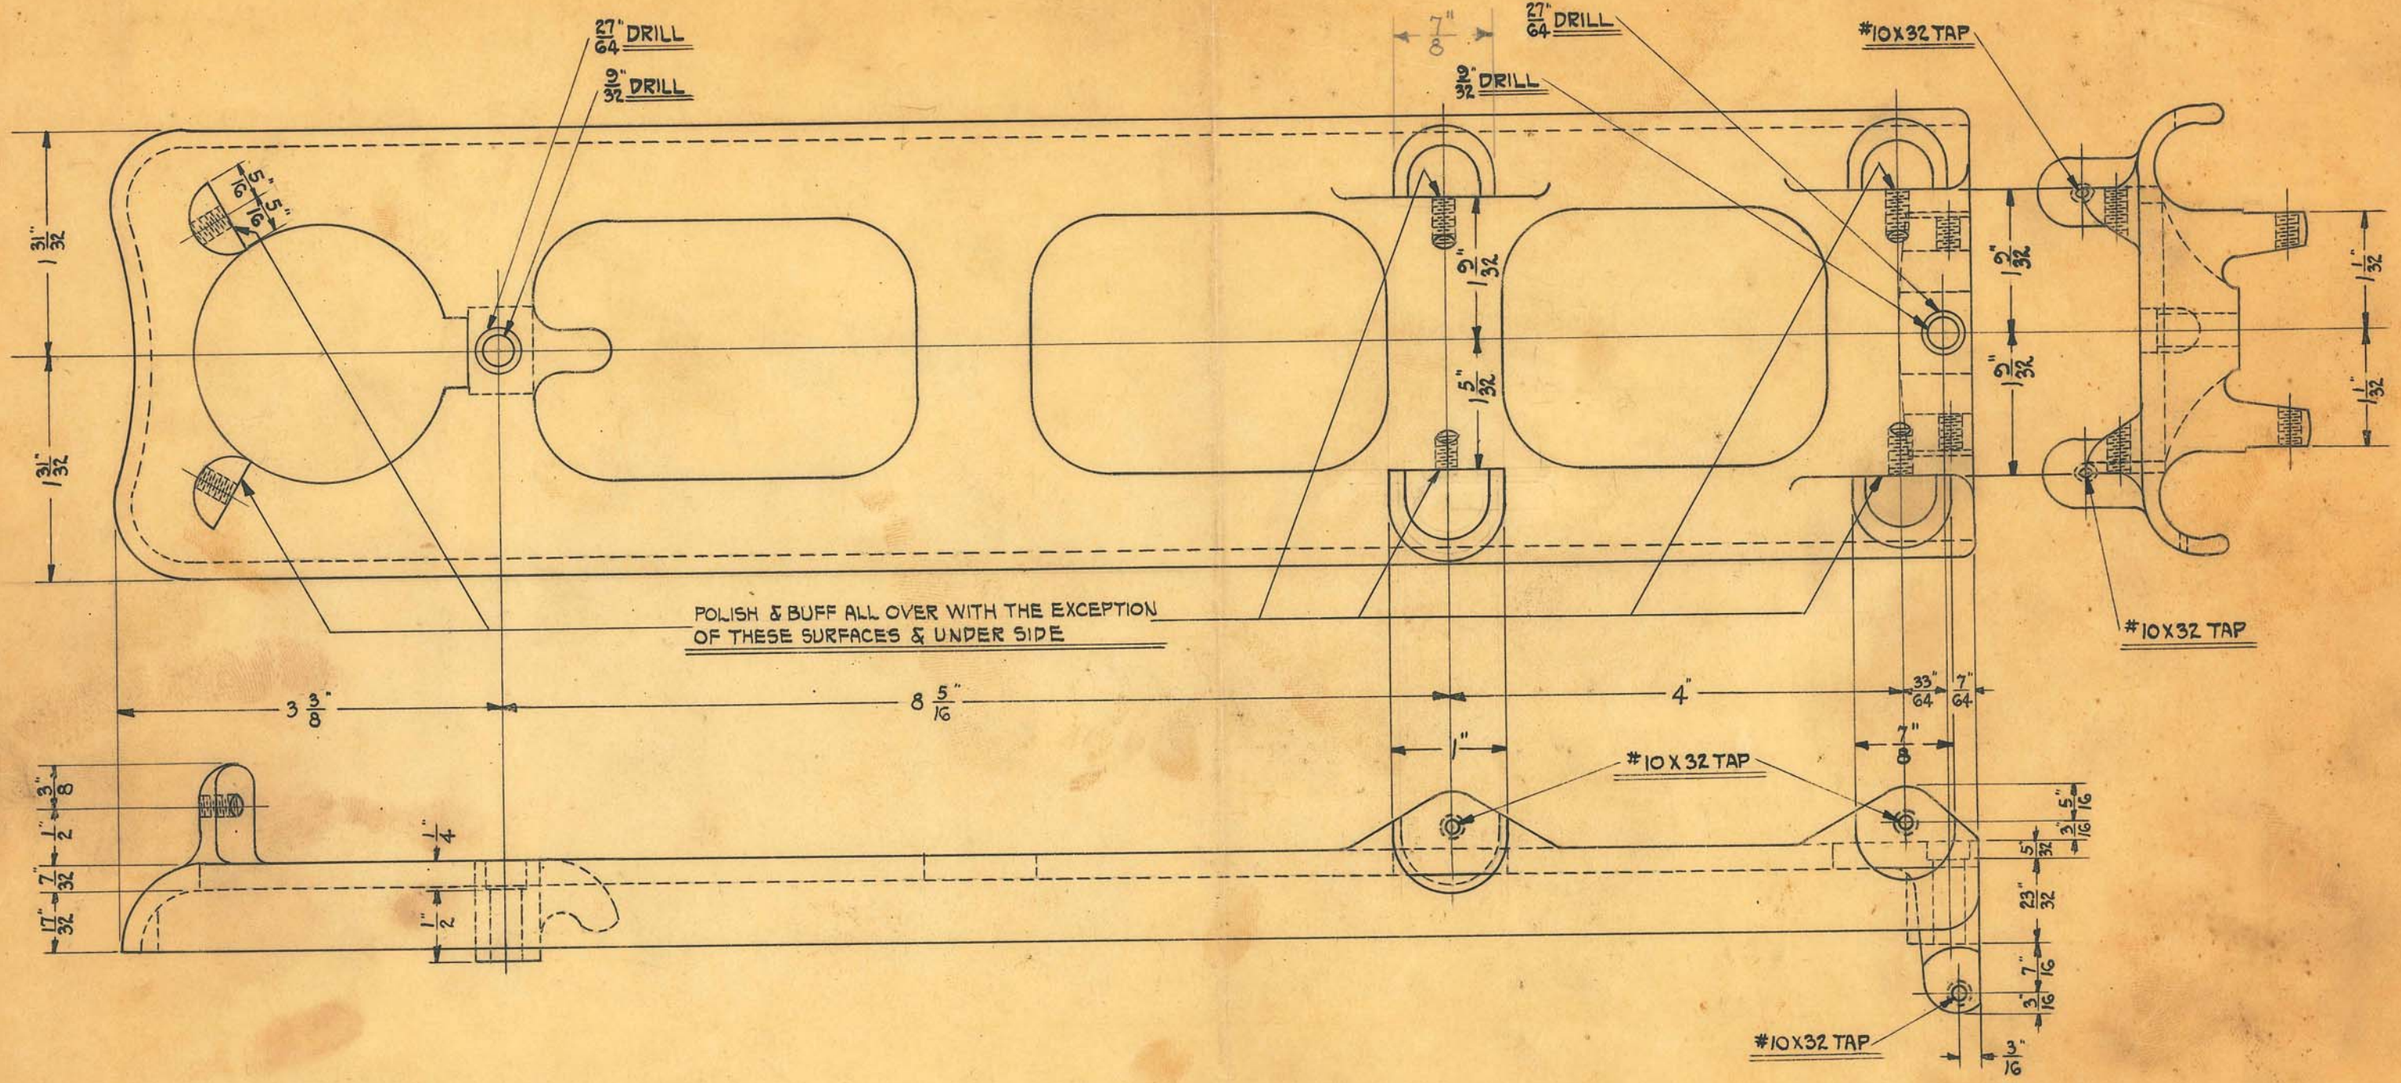

SCALE = 3/4" = 1"

OBSOLETE

SIZE		ISSUE H.E.	11-16-29	TITLE: "DENTAL X" SLIDE ROD CARRIAGE
KIND	ALUM. CASTING	CHANGED H.E.	9-12-30	
SHAPE		" " 3-8-32	H.E.	
FINISH	MAHOGANY GRAIN	" "		H. G. FISCHER & CO. 2335 WABANSIA AVE. CHICAGO, ILL.
TEMP.		" "		CAT. NO.
PATT.		" "		PART NO. 6101FA

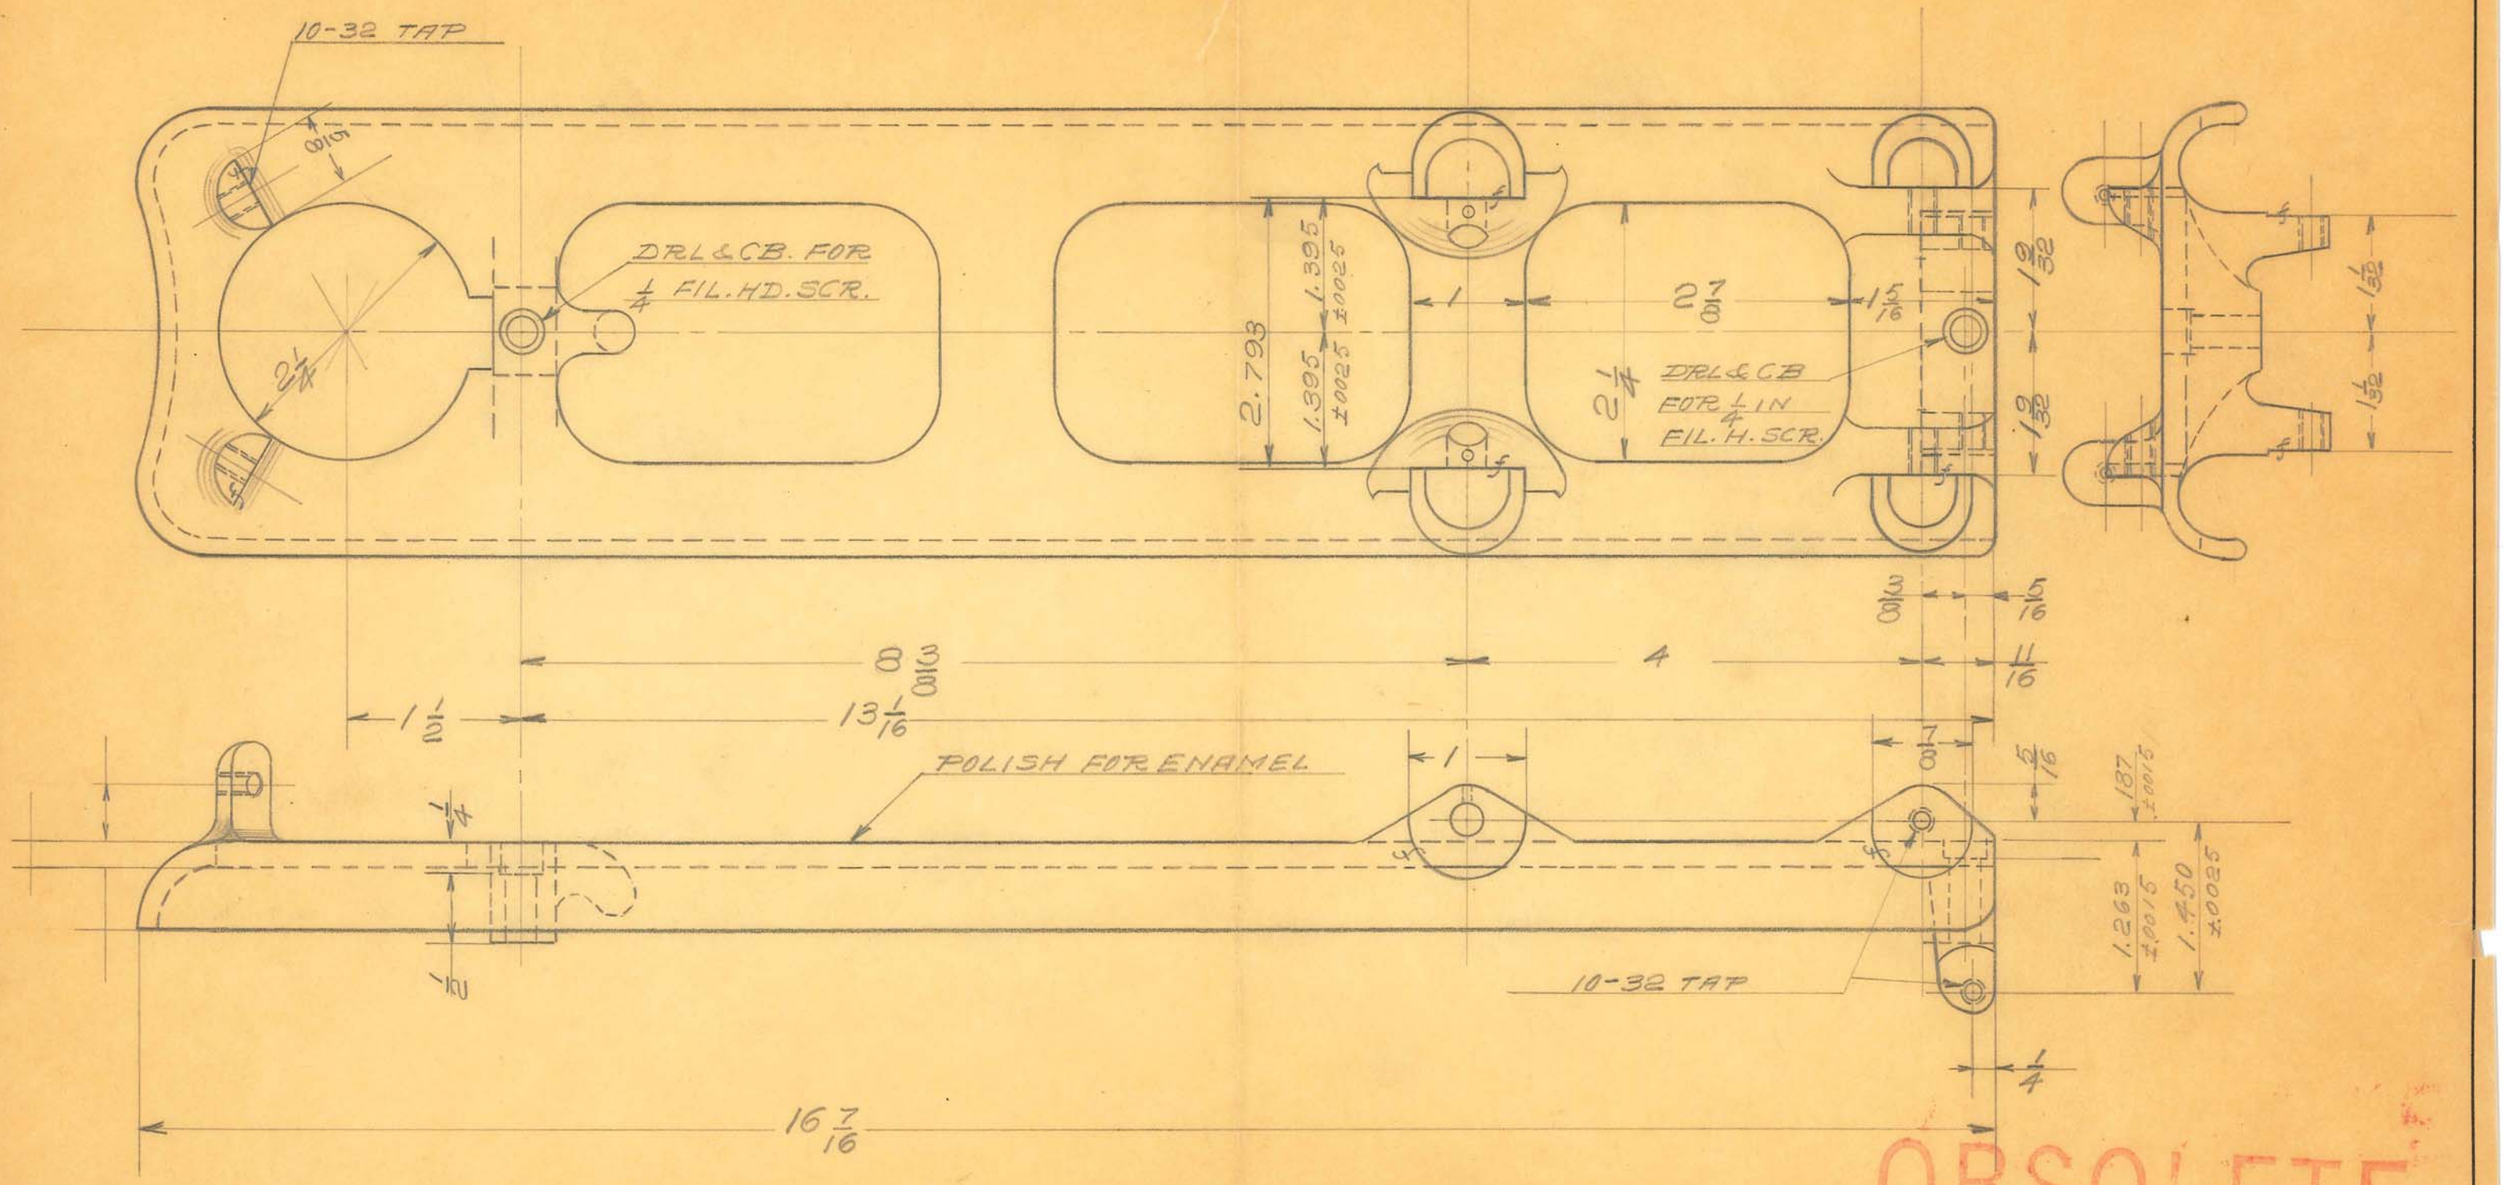

ALUM. CASTING

1 REQ.

SCALE 3/4 IN = 1 IN

OBSOLETE

SIZE		ISSUE 4-18-31	C.M.
KIND		CHANGED	
SHAPE		" "	
FINISH		" "	
TEMP.		" "	
PATT.		" "	

TITLE: DENTAL X SLIDE ROD CARRIAGE

H. G. FISCHER & CO.
2335 WABANSIA AVE.
CHICAGO, ILL.

CAT. NO.

PART NO. 6101 FAB.

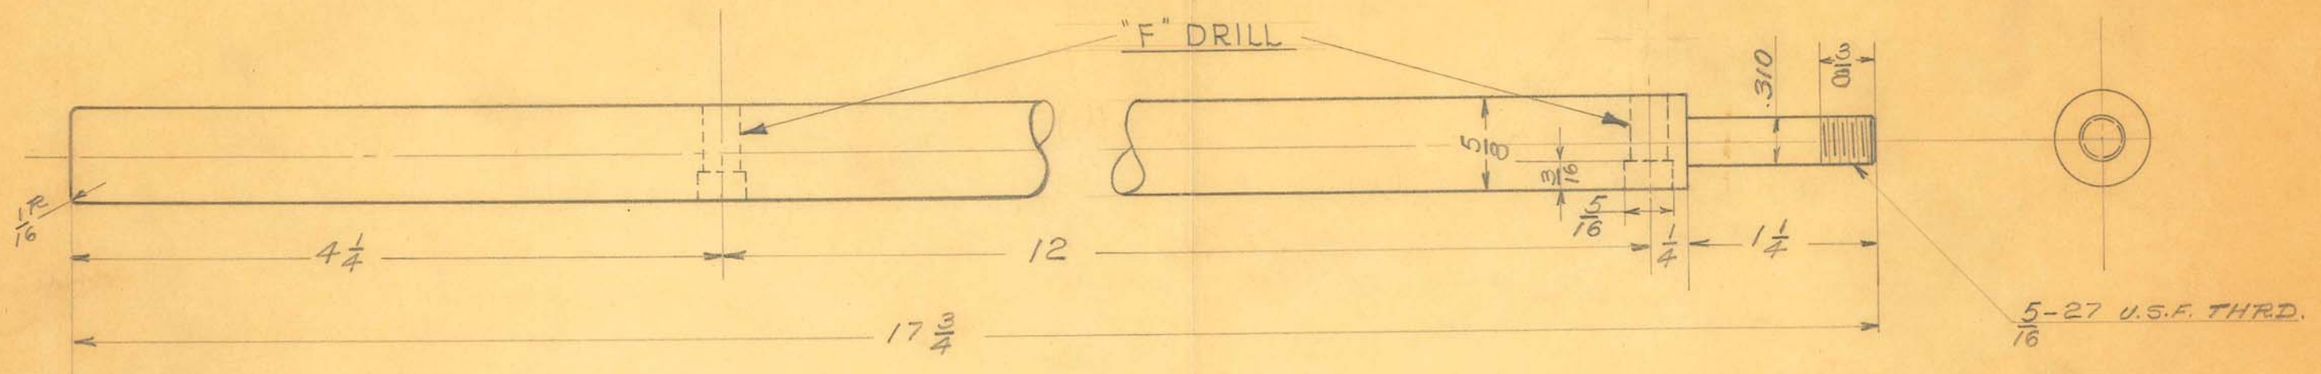

C. R. STEEL

2 REQ.

SCALE FULL SIZE

OBSOLETE

SIZE		ISSUE 2-13-31	A.M.
KIND		CHANGED	
SHAPE		" "	
FINISH	CHROME #2	" "	
TEMP.		" "	
PATT.		" "	

TITLE: DENTAL X TUBE SLIDE ROD

H. G. FISCHER & CO.
2335 WABANSIA AVE.
CHICAGO, ILL.

CAT. NO.

PART NO. 6102B

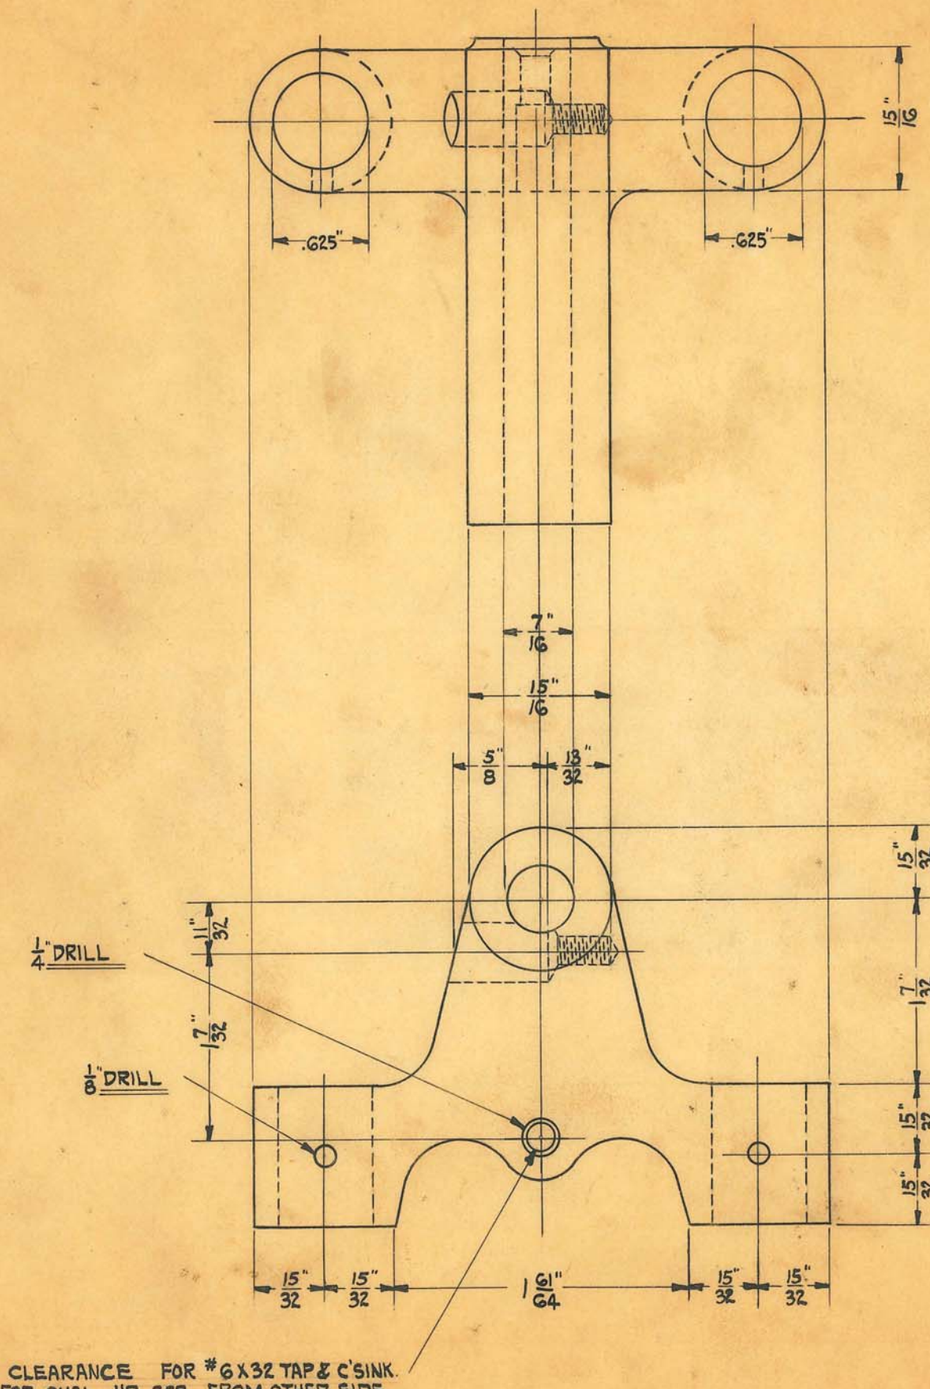

CLEARANCE FOR #6 X 32 TAP & C'SINK. FOR OVAL HD. SCR. FROM OTHER SIDE.

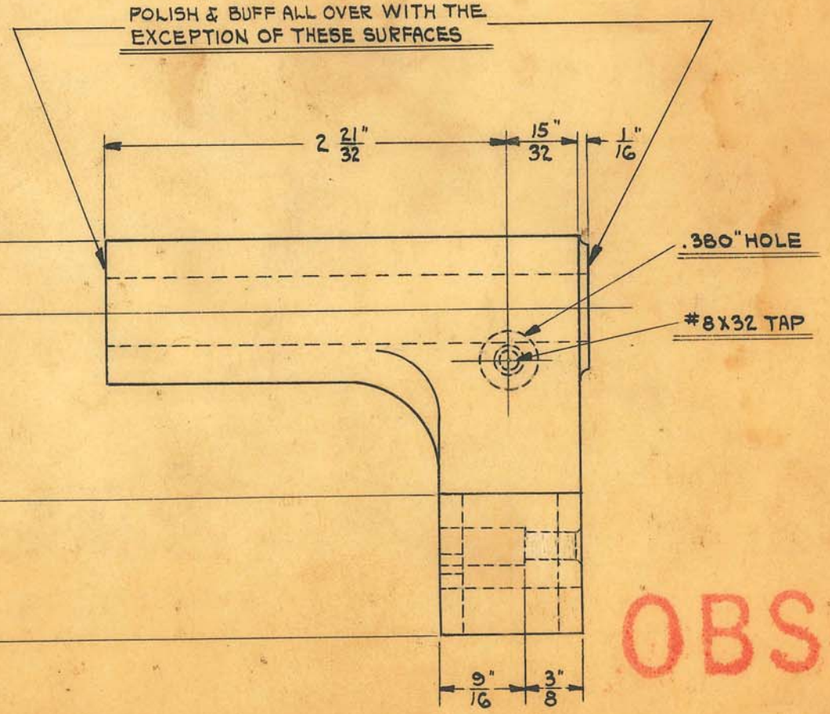

OBSOLETE

SIZE		ISSUE	H.E.	12-13-29
KIND	ALUM. CASTING	CHANGED		
SHAPE		" "		
FINISH	BUFFED	" "		
TEMP.	DRILL JIG #2949	" "		
PATT.		" "		

TITLE: "DENTAL X" PIVOT BEARING

H. G. FISCHER & CO.
2335 WABANSIA AVE.
CHICAGO, ILL.

CAT. NO.

PART NO. 6103F

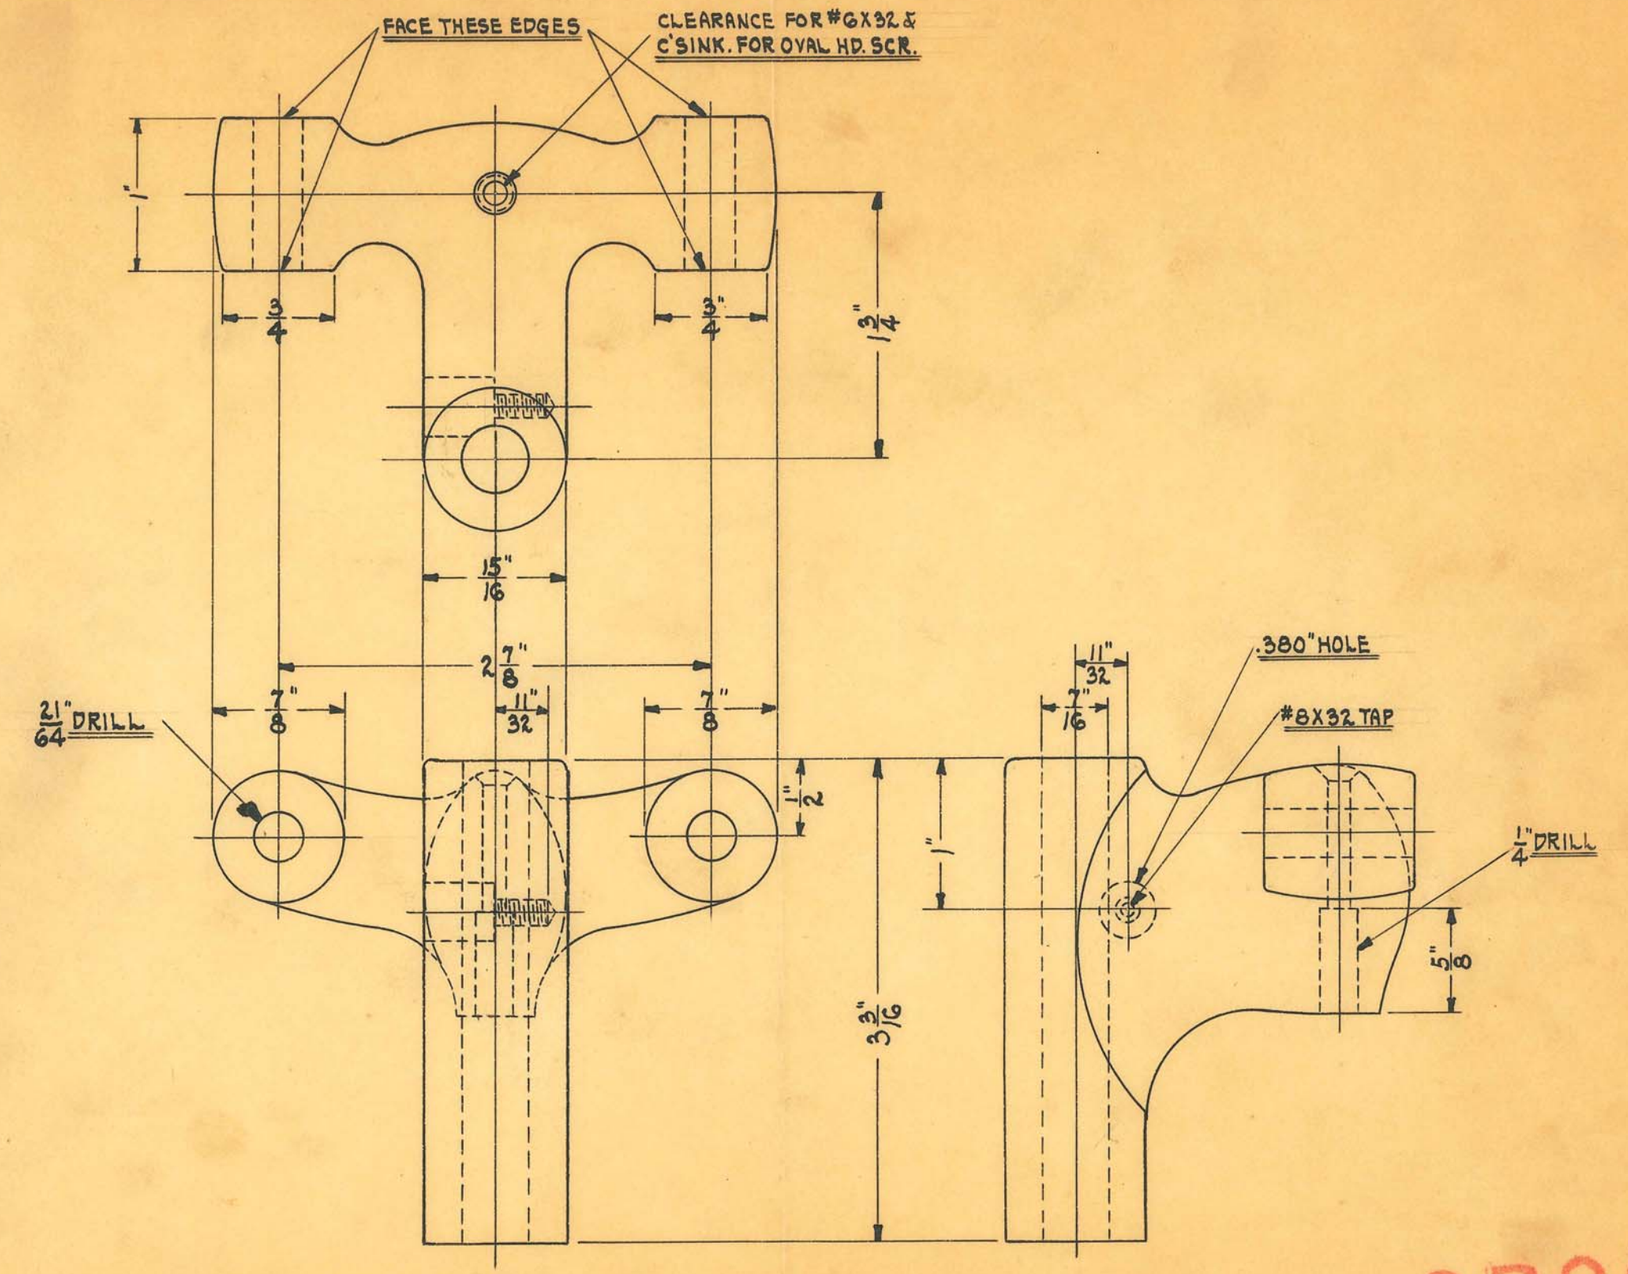

OBSOLETE

SIZE		ISSUE 9-15-30	A.E.	TITLE: DENTAL X PIVOT BEARING
KIND	ALUM. CASTING	CHANGED		
SHAPE		" "		
FINISH	BUFFED	" "		H. G. FISCHER & CO. 2335 WABANSIA AVE. CHICAGO, ILL. — CAT. NO. — PART NO. 6103 FA
TEMP.		" "		
PATT.		" "		

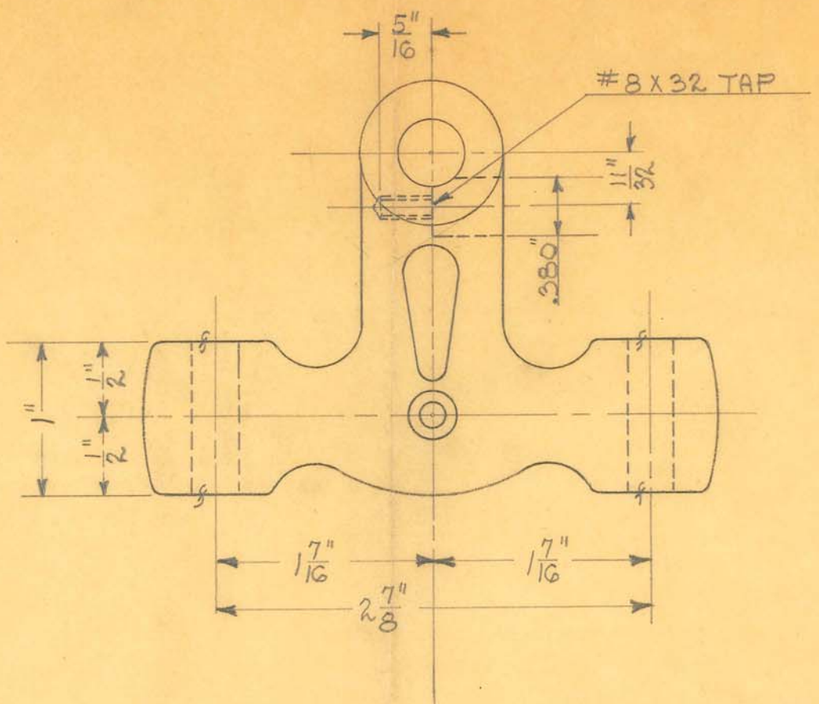

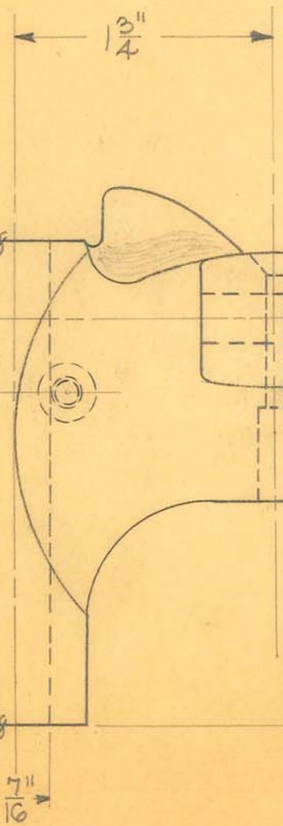

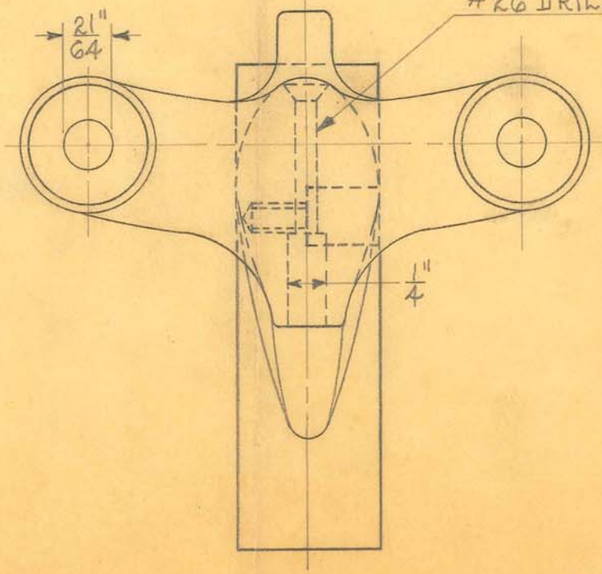

OBSOLETE

SIZE		ISSUE 2-6-31	A.E.
KIND	ALUM. CASTING	CHANGED	
SHAPE		" "	
FINISH	BUFFED	" "	
TEMP.		" "	
PATT.		" "	

TITLE: DENTAL X PIVOT BEARING

H. G. FISCHER & CO.
2335 WABANSIA AVE.
CHICAGO, ILL.

CAT. NO.

PART NO. G103FB

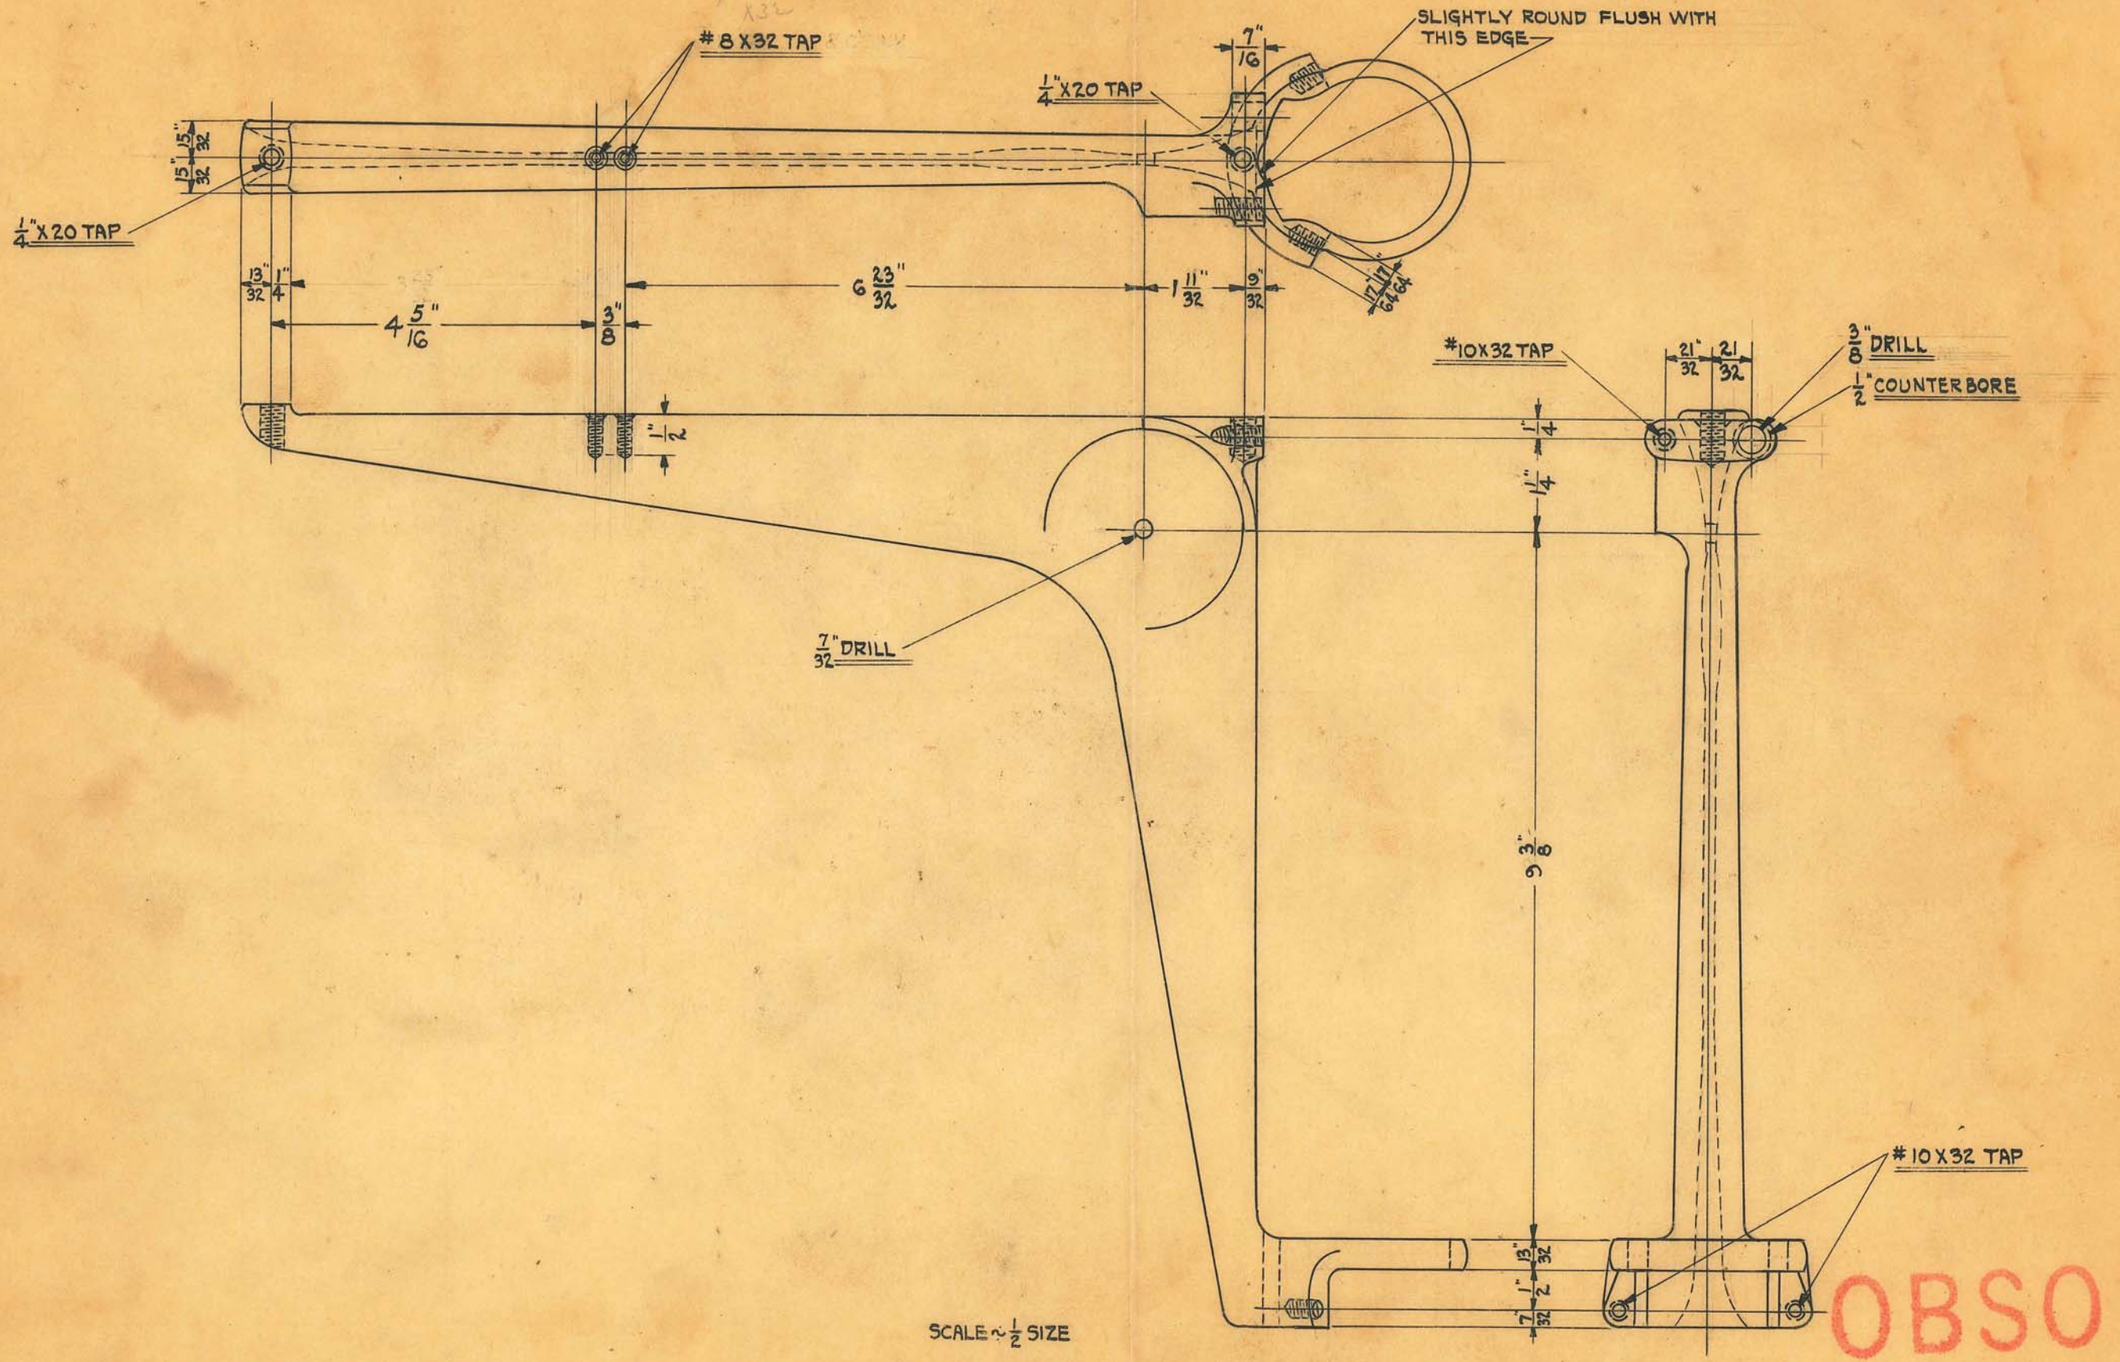

SCALE ~ 1/2 SIZE

OBSOLETE

SIZE		ISSUE H.E.	11-20-29	TITLE: "DENTAL X" CARRIAGE SUPPORT BRACKET
KIND	ALUM. CASTING	CHANGED H.E.	9-13-30	
SHAPE		" " 3-8-32	H.E.	
FINISH	MAHOGANY	" "		
[illegible]	GRAIN	" "		H. G. FISCHER & CO. 2335 WABANSIA AVE. CHICAGO, ILL.
PATT.	435	" "		CAT. NO.
				PART NO. 6104FA

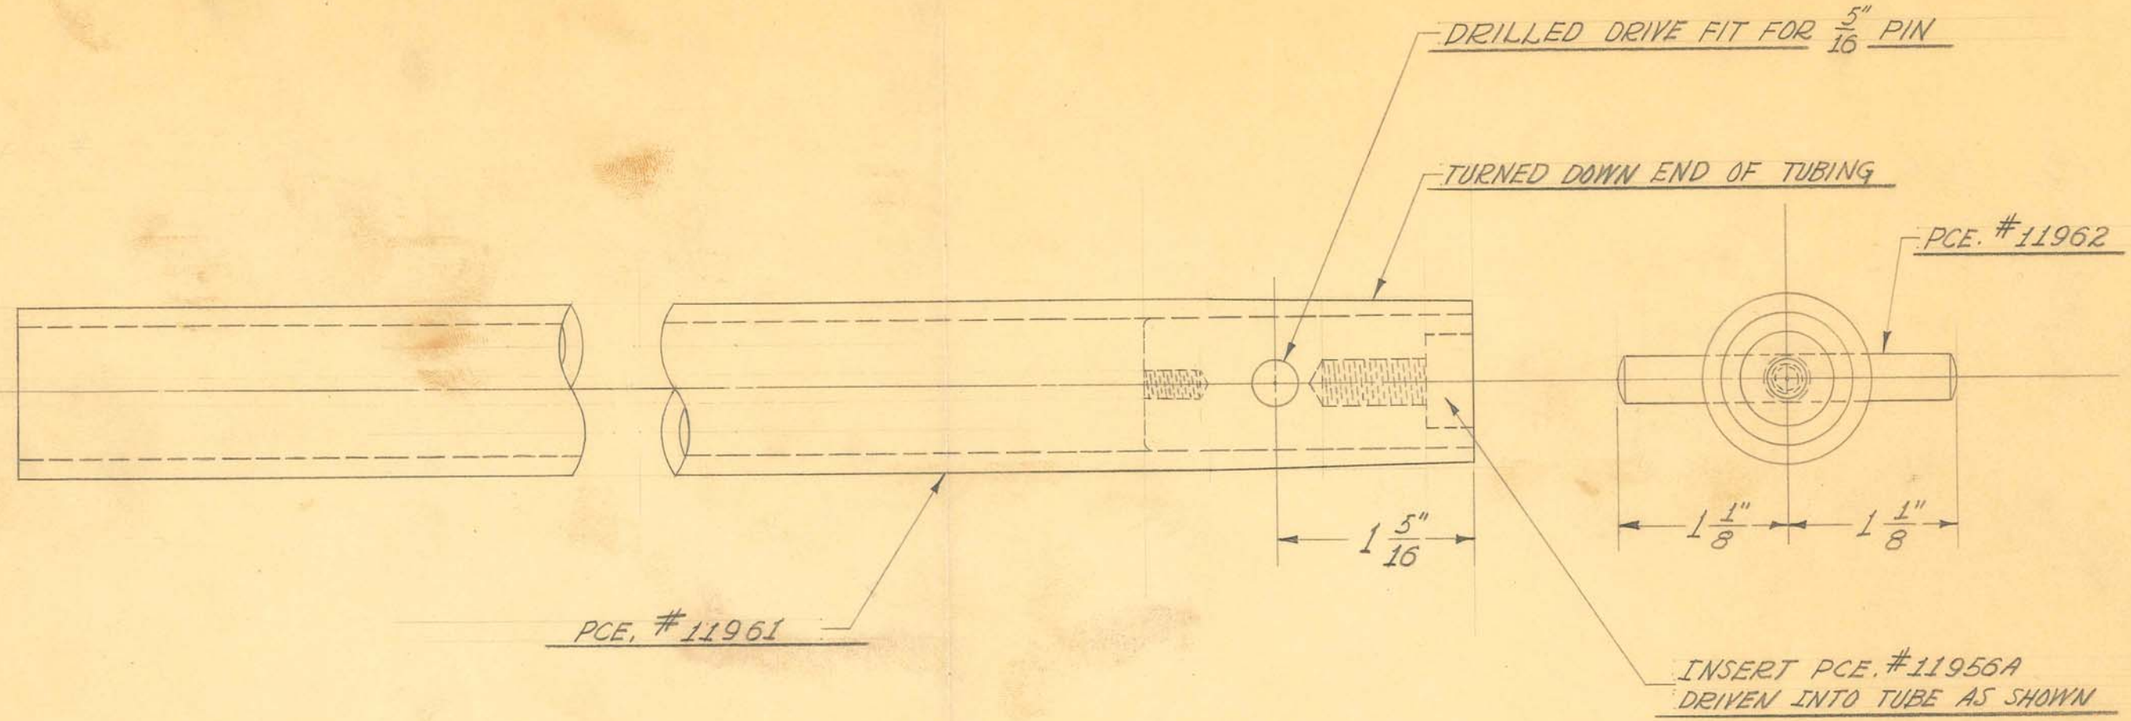

1 REQUIRED

OBSOLETE
Obsolete

SIZE		ISSUE 2-25-39	J.W.
KIND		CHANGED	
SHAPE		"	
FINISH	CAD. #23	"	
TEMP.		"	
PATT.		"	

TITLE: AUXILIARY TABLE STAND FOR MOD. "G" X-RAY HEAD
HORIZONTAL SLIDE TUBE ASSEMBLY

H. G. FISCHER & CO. 2335 WABANSIA AVE. CHICAGO, ILL.	CAT. NO.	PART NO. 11960GA

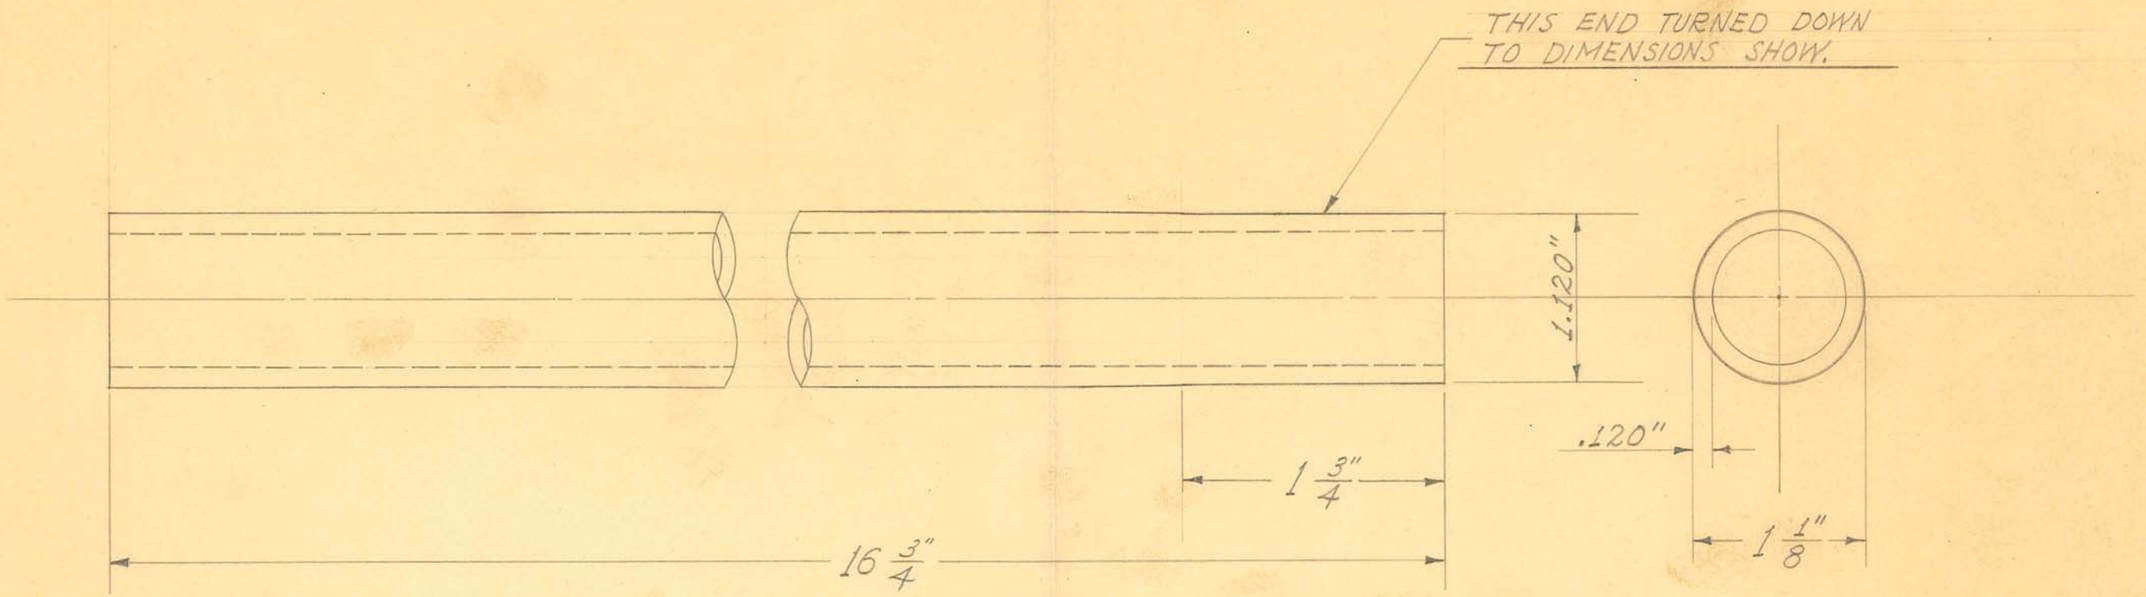

1 1/8" O.D. X #11 GA. (.120") WALL – SHELBY SEAMLESS STEEL TUBING

1 REQUIRED

OBSOLETE

SIZE		ISSUE 6-21-38	J.W.
KIND		CHANGED	
SHAPE		"	
FINISH		"	
TEMP.		"	
PATT.		"	

TITLE:
AUXILIARY TABLE STAND FOR MOD. "G" X-RAY HEAD
– HORIZONTAL SLIDE TUBE

H. G. FISCHER & CO.
2335 WABANSIA AVE.
CHICAGO, ILL.

CAT. NO.

PART NO. 11961

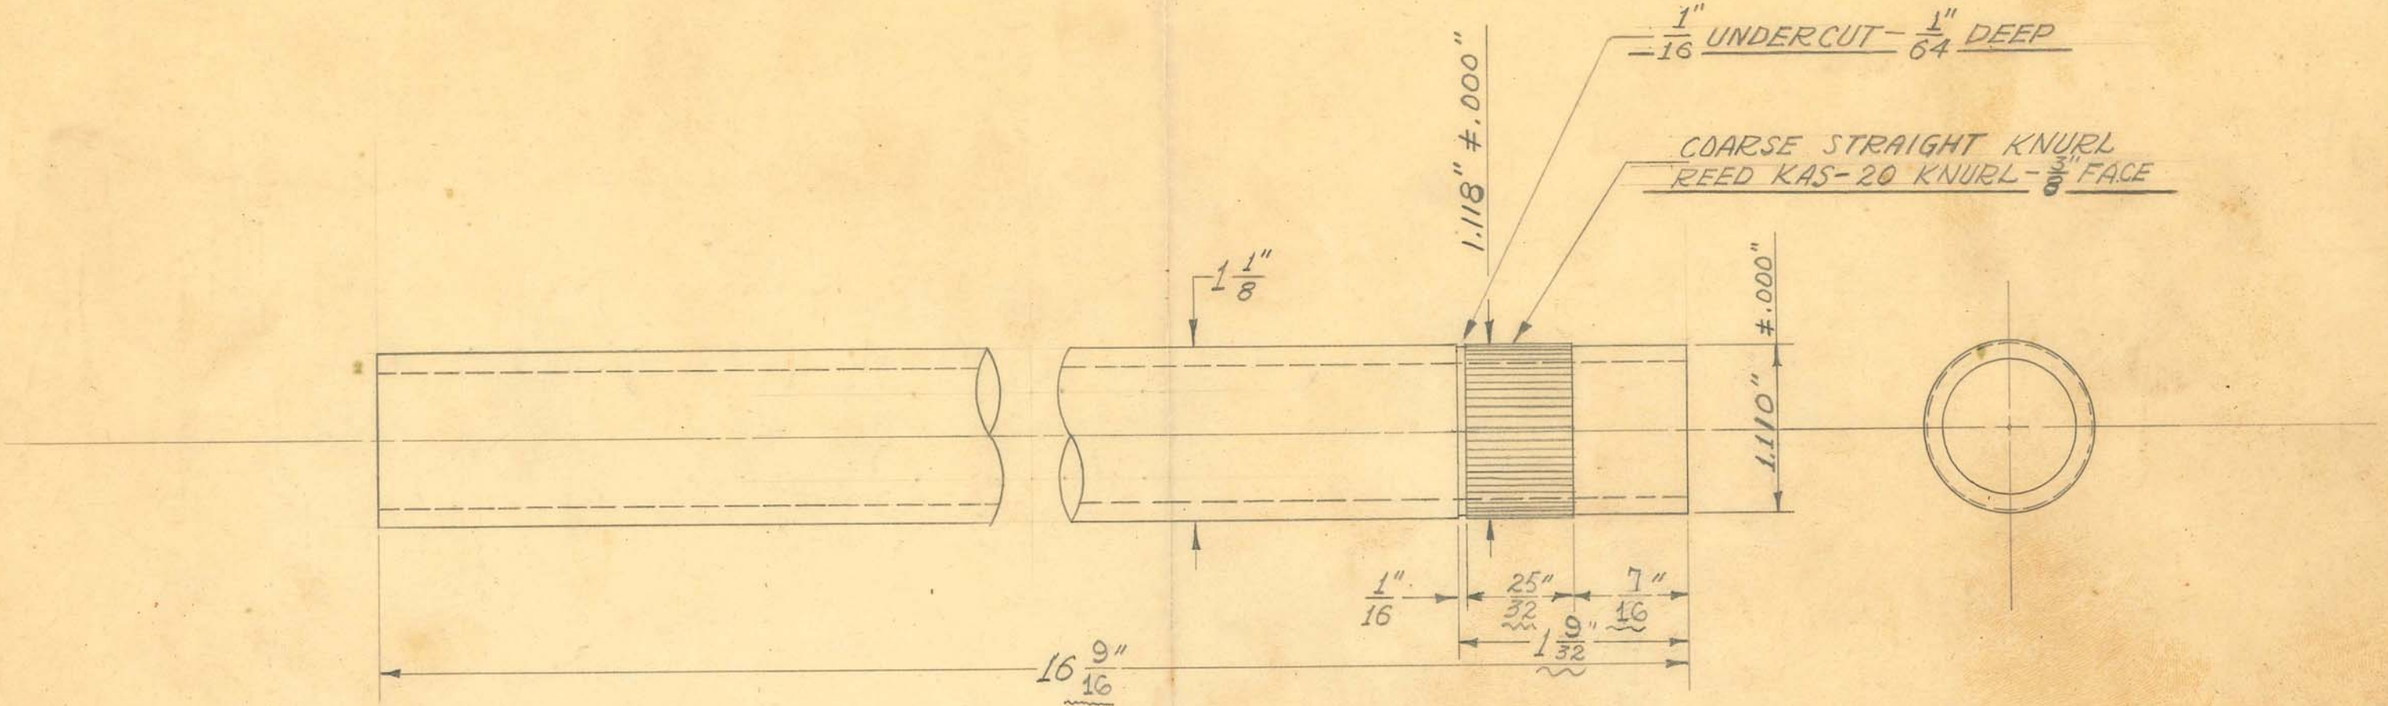

1 1/8" O.D. X #11 GA. (.120") WALL – SHELBY SEAMLESS STEEL TUBING

1 REQUIRED

OBSOLETE

SIZE		ISSUE 5-25-39	J.W.
KIND		CHANGED 4-10-44	H.E.
SHAPE		PER J.B. 5-16-46	J.V.W.
FINISH	CHR. #2 POL. UP TO KNURL	"	
TEMP.		"	
		"	

TITLE: AUXILIARY TABLE STAND FOR MOD "G" X-RAY HEAD – HORIZONTAL SLIDE TUBE

H. G. FISCHER & CO.
2335 WABANSIA AVE.
CHICAGO, ILL.

CAT. NO.

PART NO. 11961B

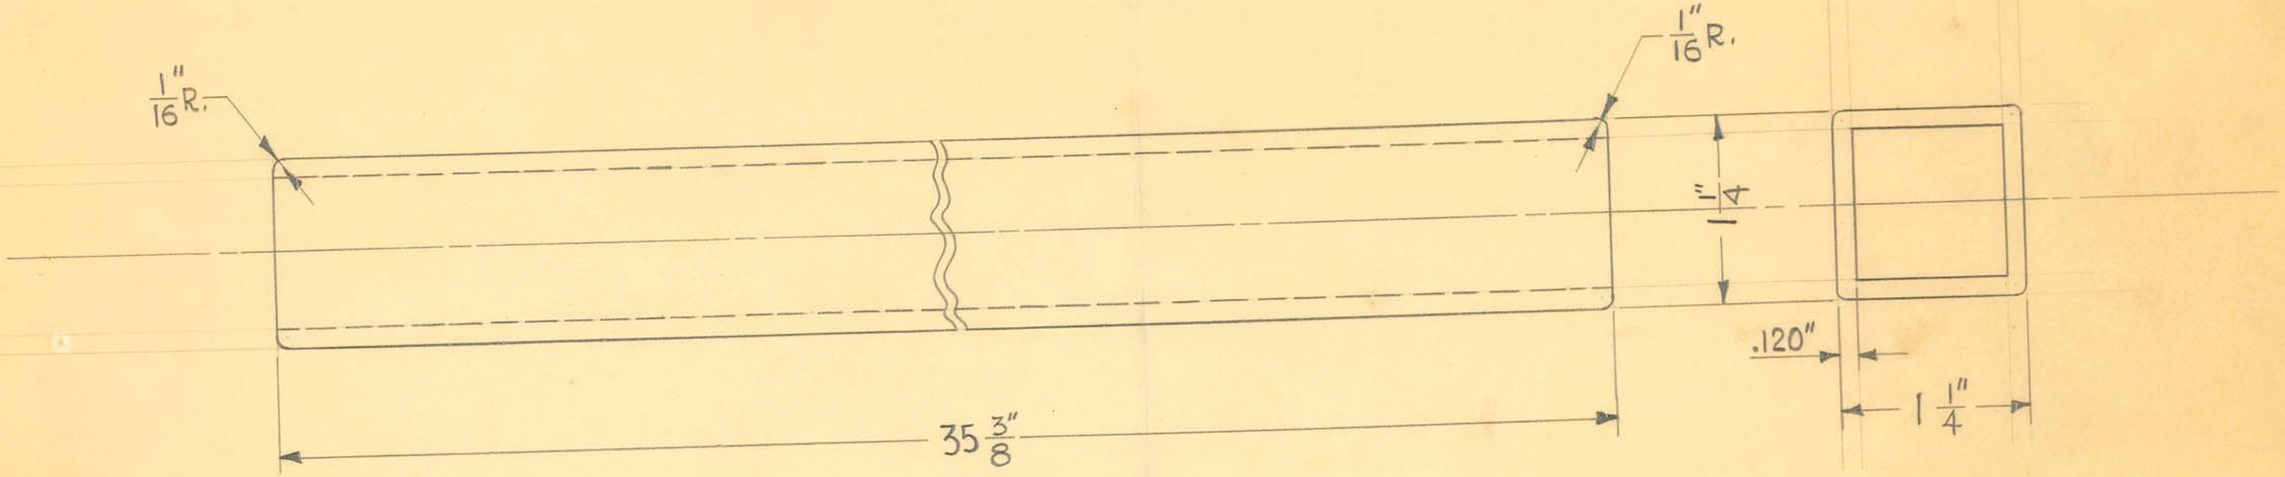

1 1/4" SQUARE X #11 GAUGE (.120") WALL - SHELBY SEAMLESS STEEL TUBING

OBSOLETE

SIZE		ISSUE 2-25-42	J.Y.W.	TITLE: AUXILIARY TABLE STAND FOR MOD. "G" HEAD UPRIGHT TUBE
KIND		CHANGED		
SHAPE		"		
FINISH		"		
TEMP.		"		
PATT.		"		

H. G. FISCHER & CO.
2338 WABANSIA AVE.
CHICAGO, ILL.

CAT. NO.

PART NO. 11965

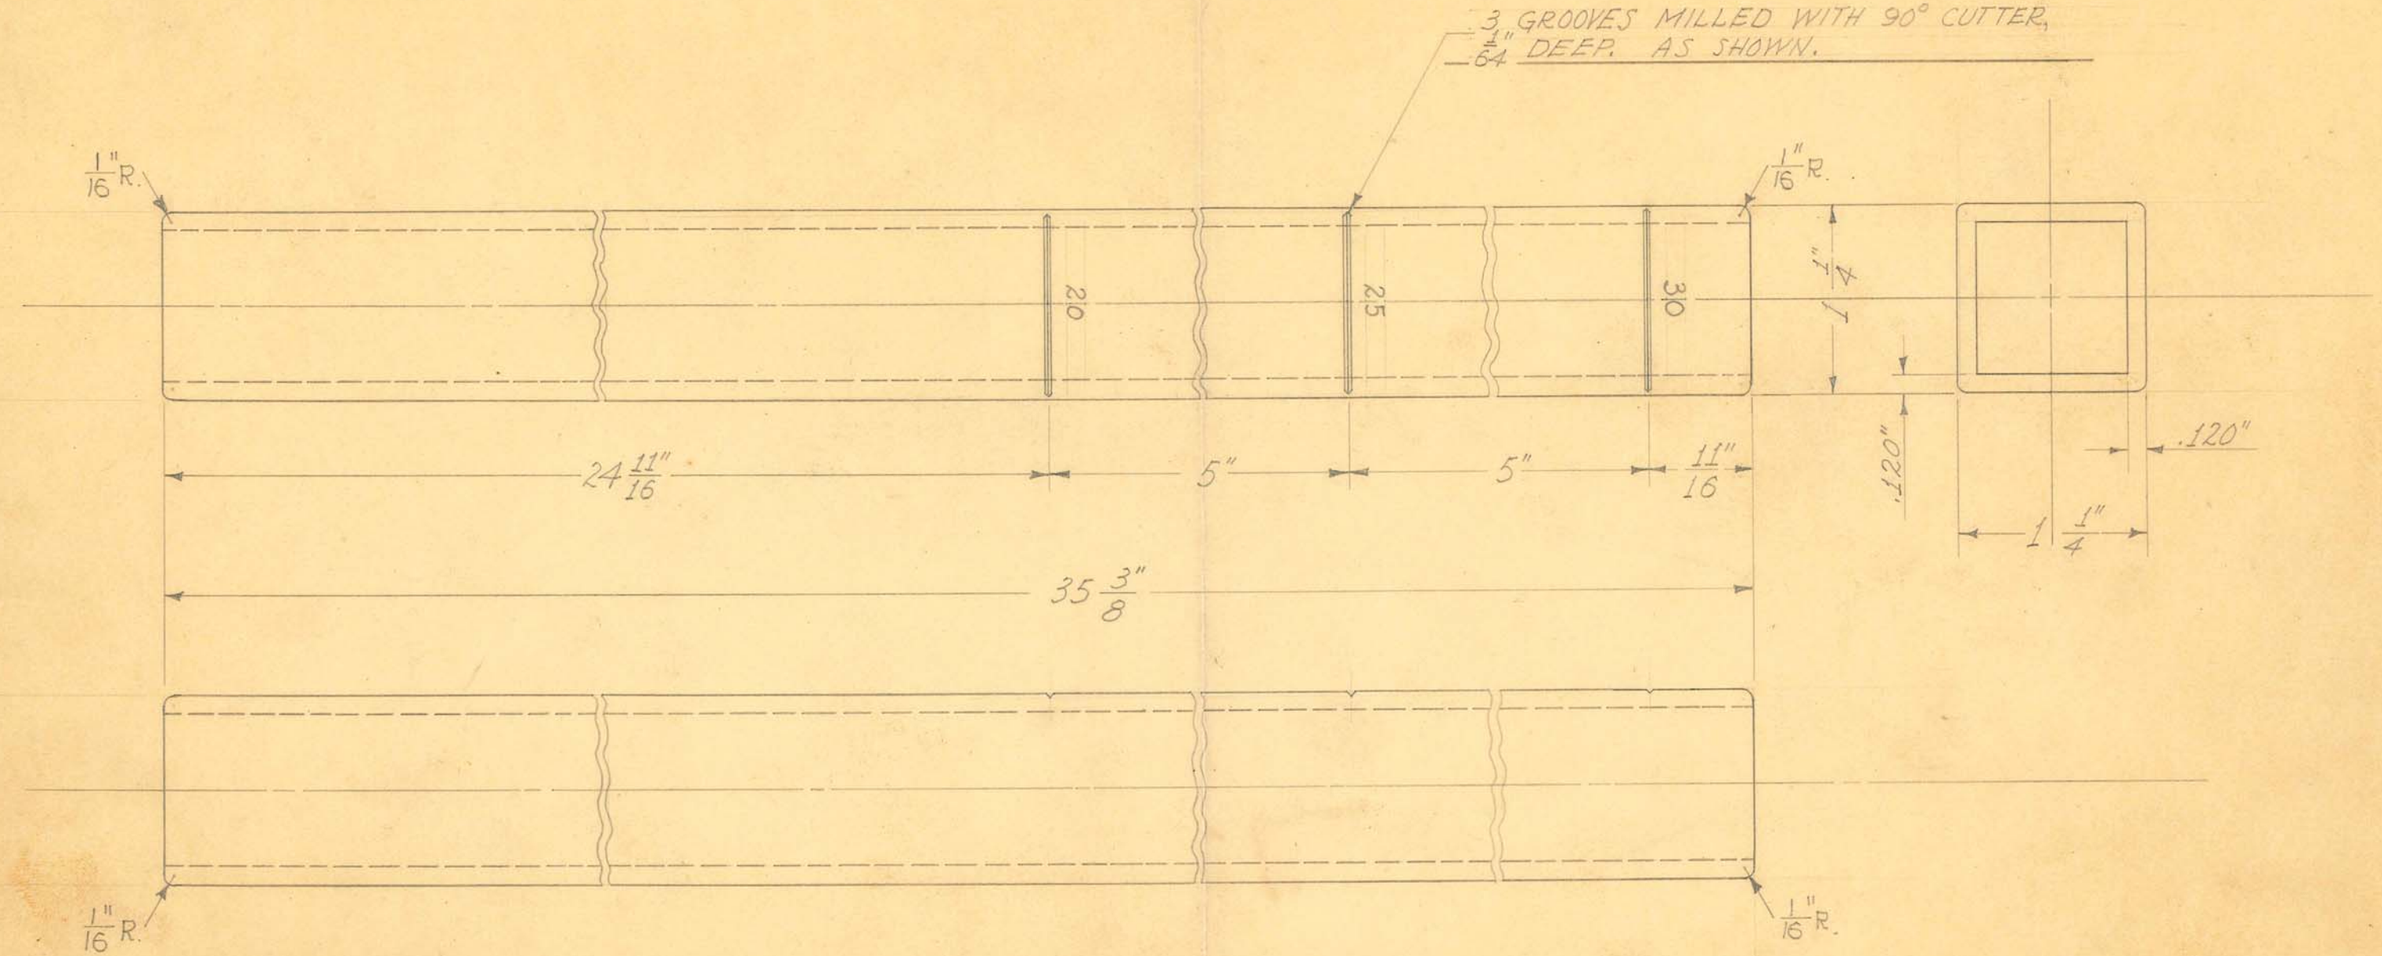

1 1/4" SQUARE X #11 GAUGE WALL - SHELBY SEAMLESS STEEL TUBING

1 REQUIRED

OBSOLETE

SIZE		ISSUE 6-24-38	J.W.
KIND		CHANGED	
SHAPE		"	
FINISH	CAD. #24	"	
TEMP.		"	
PATT.		"	

TITLE: AUXILIARY TABLE STAND FOR MOD. "G" X-RAY HEAD UPRIGHT TUBE (MARKED)

H. G. FISCHER & CO.
2335 WABANSIA AVE.
CHICAGO, ILL.

CAT. NO.

PART NO. 11965F

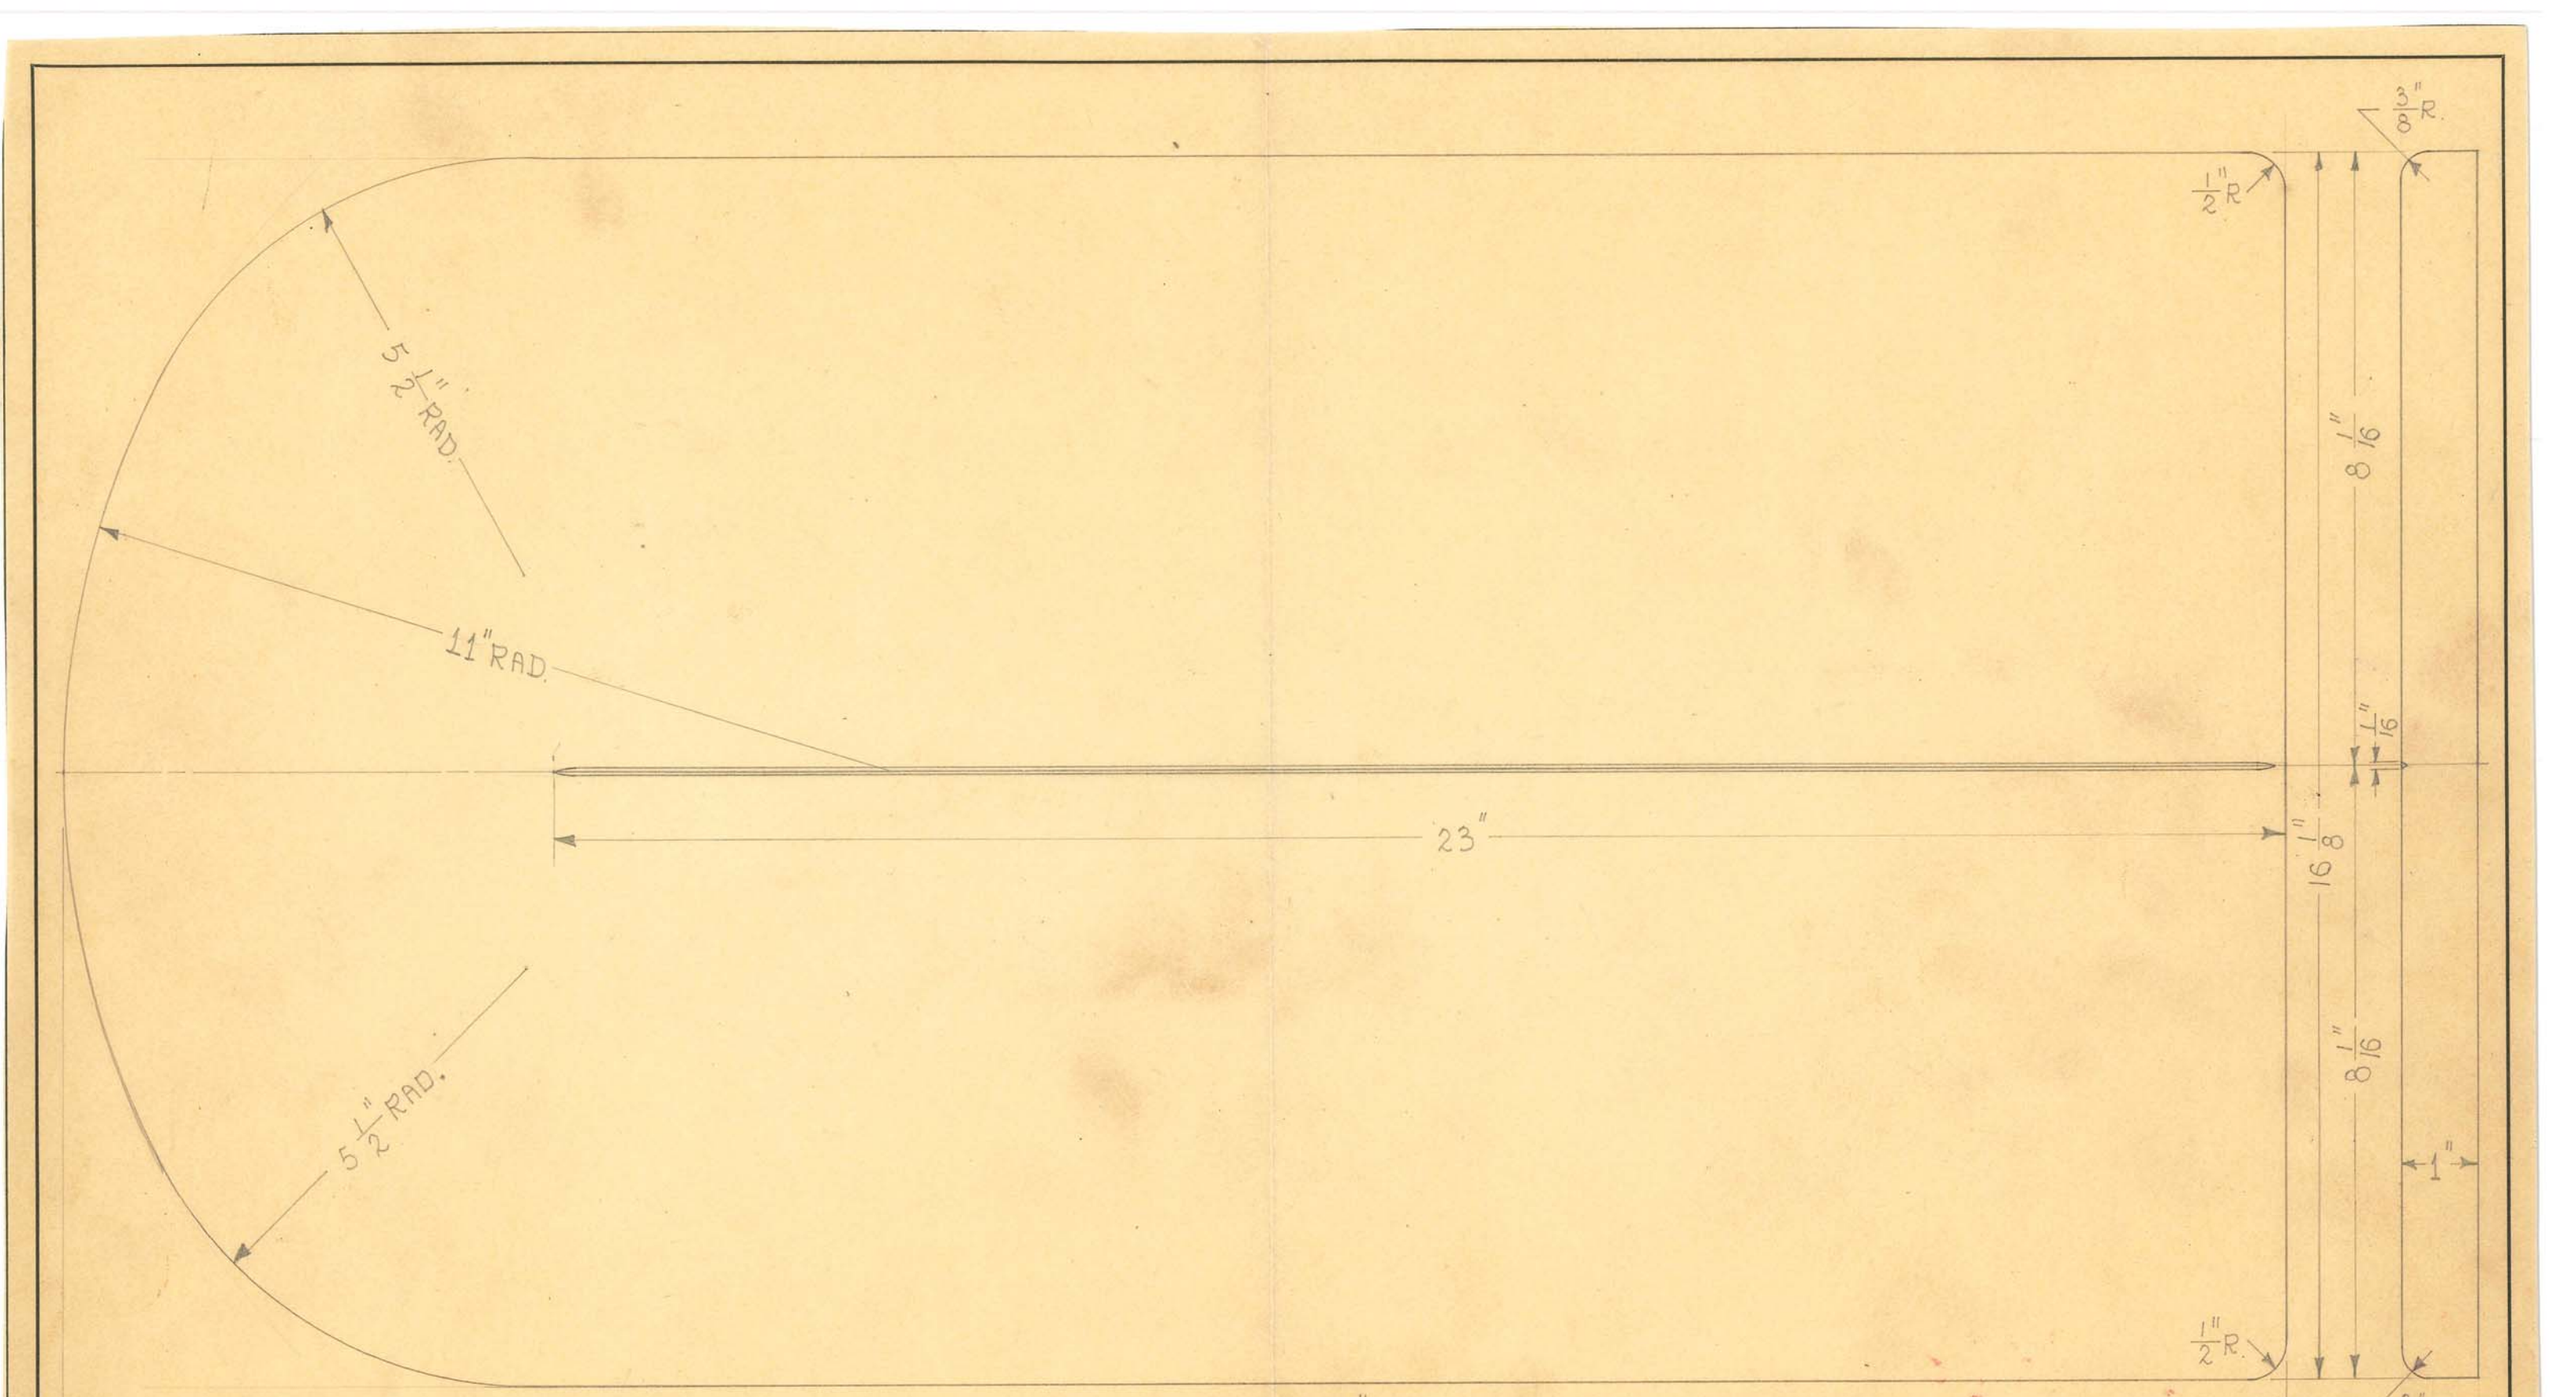

SCALE ~ 1/2" = 1"

SIZE	1"	ISSUE 5-31-38	A.B.	
KIND		CHANGED		
SHAPE		"		
FINISH		"		
TEMP.		"		
PATT.		"		

TITLE: TABLE MODEL PORT. "G" X-RAY UNIT BASE-BOARD

OBSOLETE

H. G. FISCHER & CO.
2335 WABANSIA AVE.
CHICAGO, ILL.

CAT. NO.

PART NO. 11966

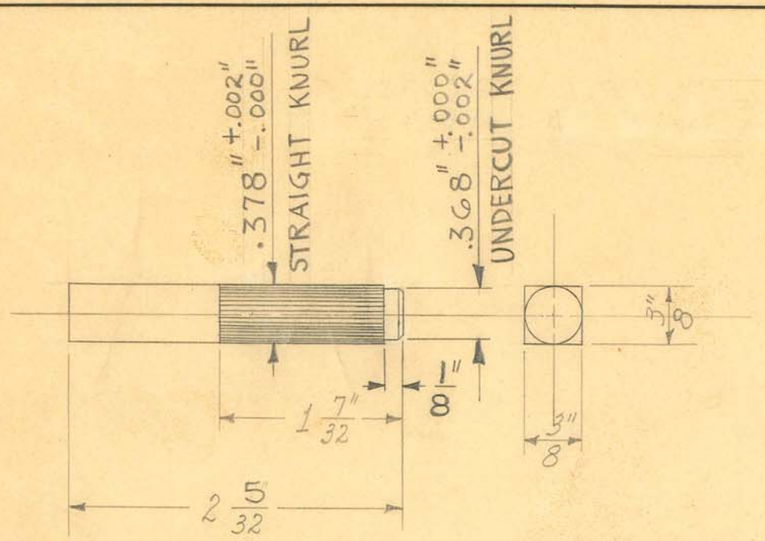

3/8" SQUARE BRASS ROD

LETTER "U" (.368") DRILL

ROUND CORNERS

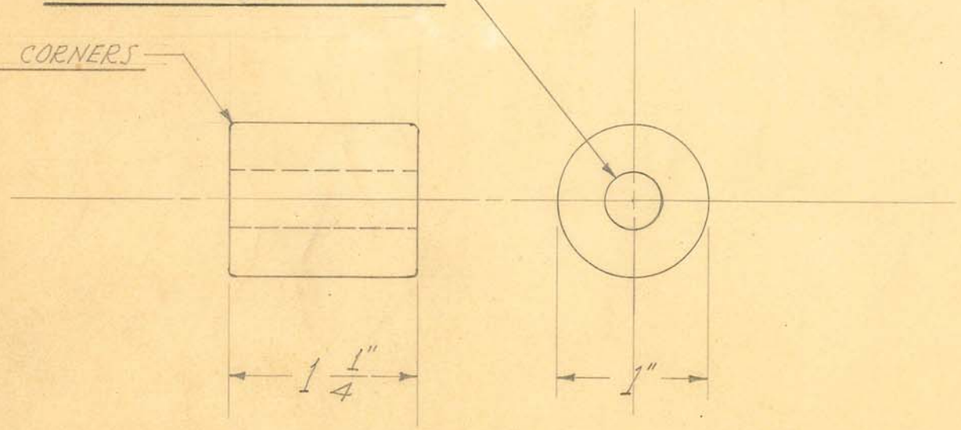

1" DIAM. BRASS ROD

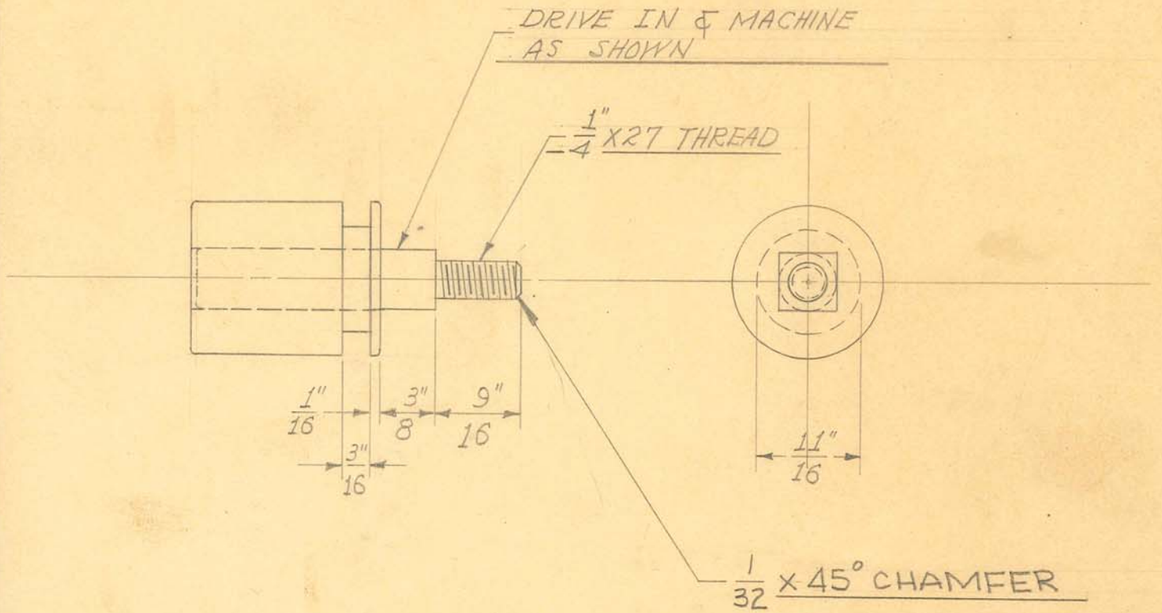

1 REQUIRED

OBSOLETE
See "A" size drawing

SIZE		ISSUE 7-20-38	J.W.
KIND		CHANGED	
SHAPE		"	
FINISH		"	
TEMP.		"	
PATT.		"	

TITLE: SHORT WAVE INDUCTION COIL ELECT. ARM - ROTATING SWIVEL FRICTION BODY ASSEM.

H. G. FISCHER & CO.
2335 WABANSIA AVE.
CHICAGO, ILL.

CAT. NO.

PART NO. 11996G

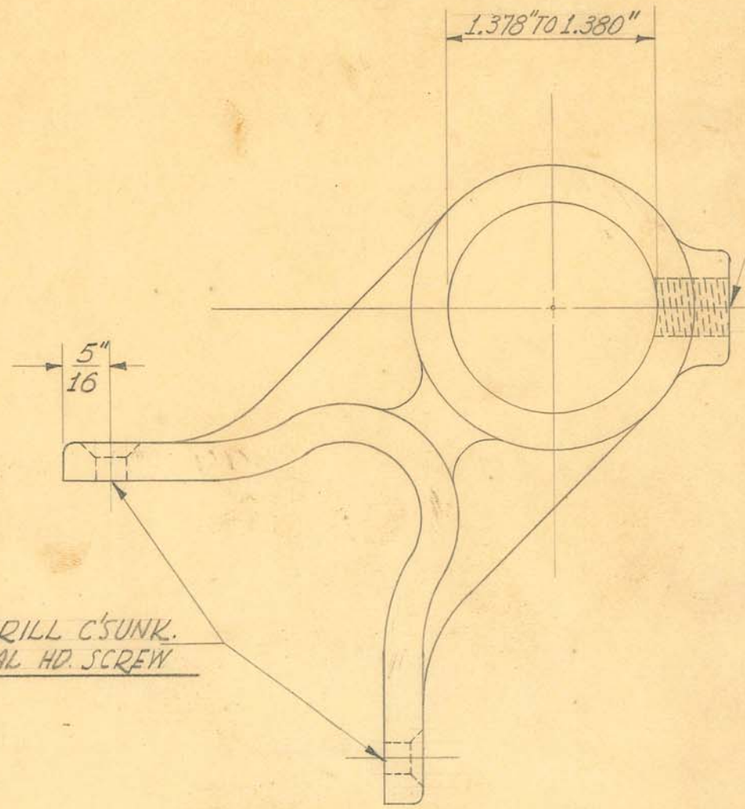

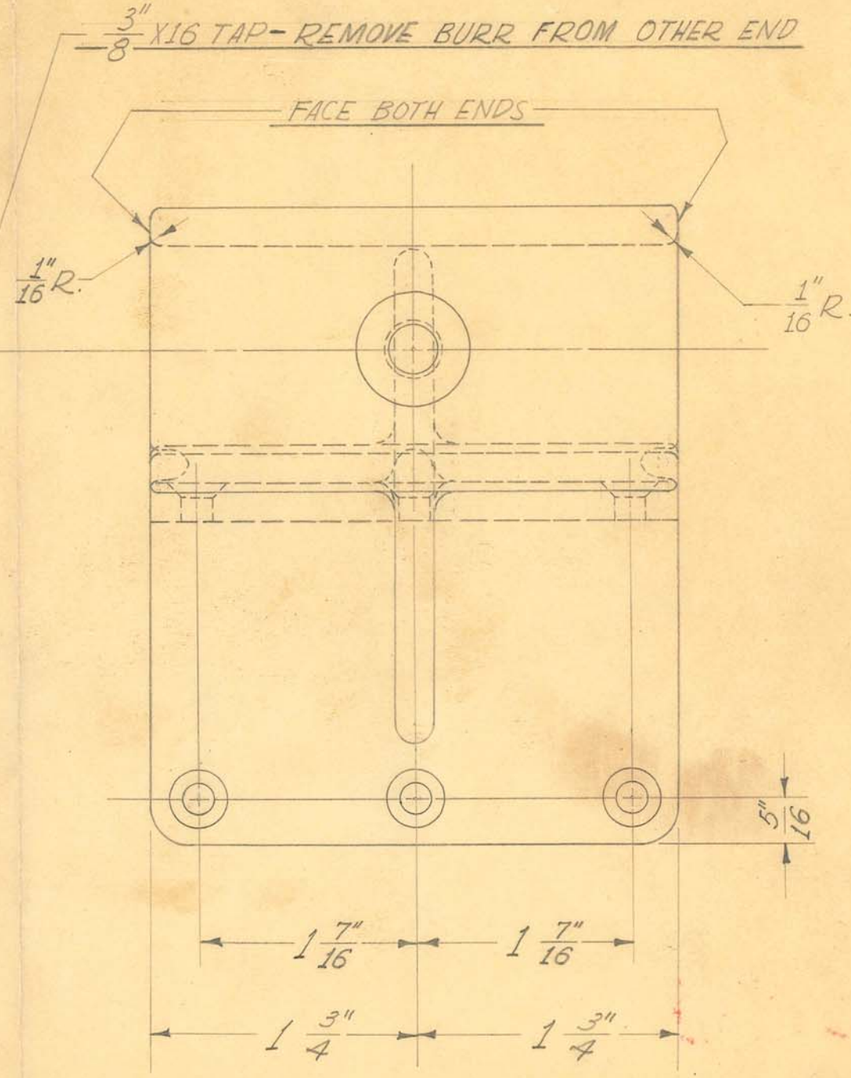

1 REQUIRED

OBSOLETE

SIZE	#214	ISSUE 9-21-38	J.W.	TITLE: SHORT WAVE INDUCTION COIL ELECTRODE ARM SUPPORT BRACKET
KIND	ALUM. CASTING	CHANGED		
SHAPE		"		
FINISH		"		
TEMP.		"		
PATT.	1264	"		

H. G. FISCHER & CO.
2335 WABANSIA AVE.
CHICAGO, ILL.

CAT. NO.

PART NO. 12031F

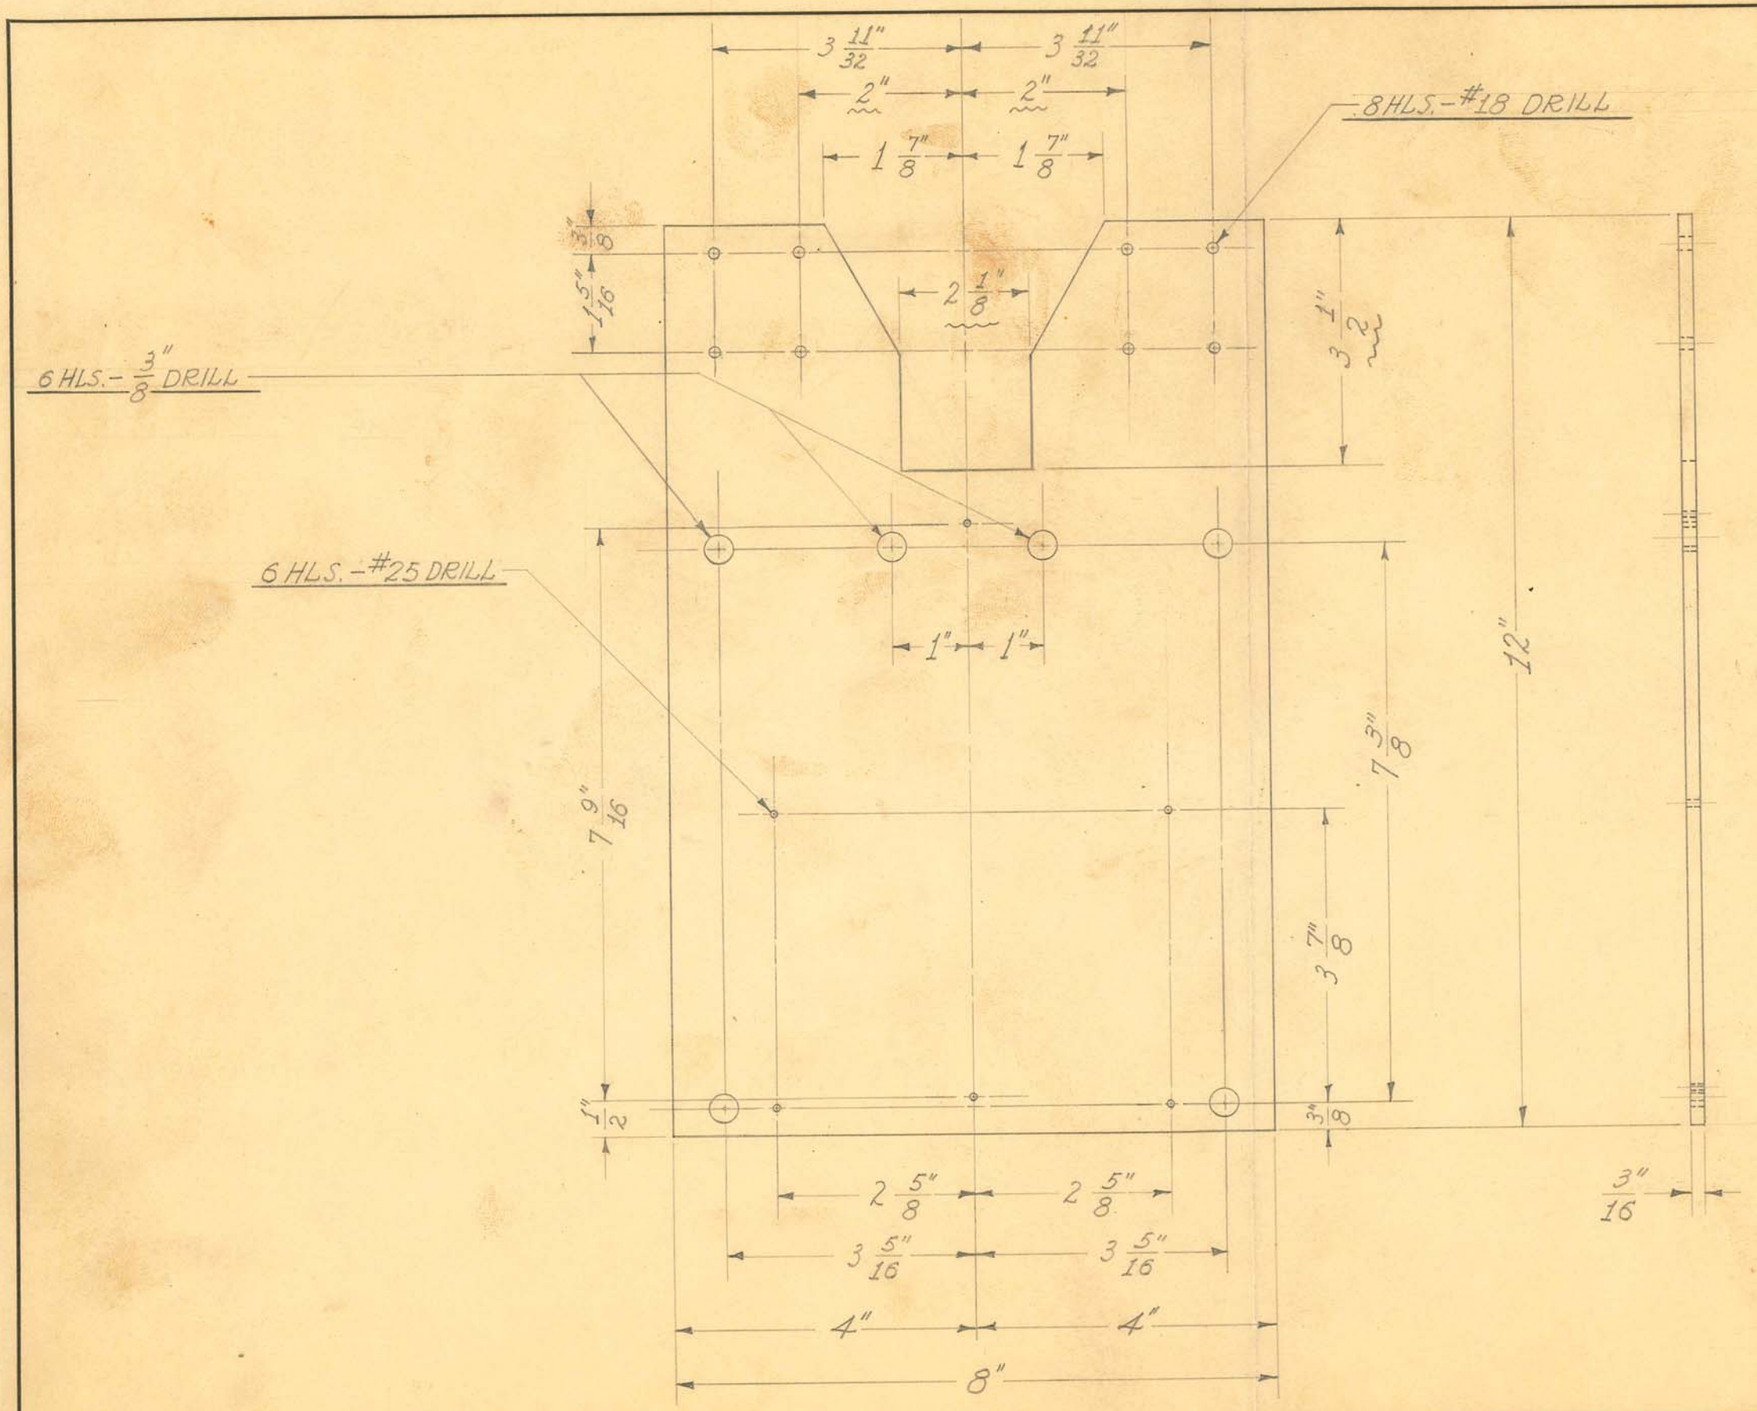

OBSOLETE

SCALE ~ 1/2" = 1"

1 REQUIRED

obsolete

SIZE	12"X8"X 3/16"	ISSUE 9-12-38	J.W.
KIND	SHEET TRANSITE	CHANGED 12-8-38	J.W.
SHAPE		"	
FINISH		"	
TEMP.		"	
DATE		"	

TITLE: FISCHER MOD. "M" SHORT WAVE TRANSFORMER HEAT BARRIER

H. G. FISCHER & CO.
2335 WABANSIA AVE.
CHICAGO, ILL.

CAT. NO.

PART NO. 12053F

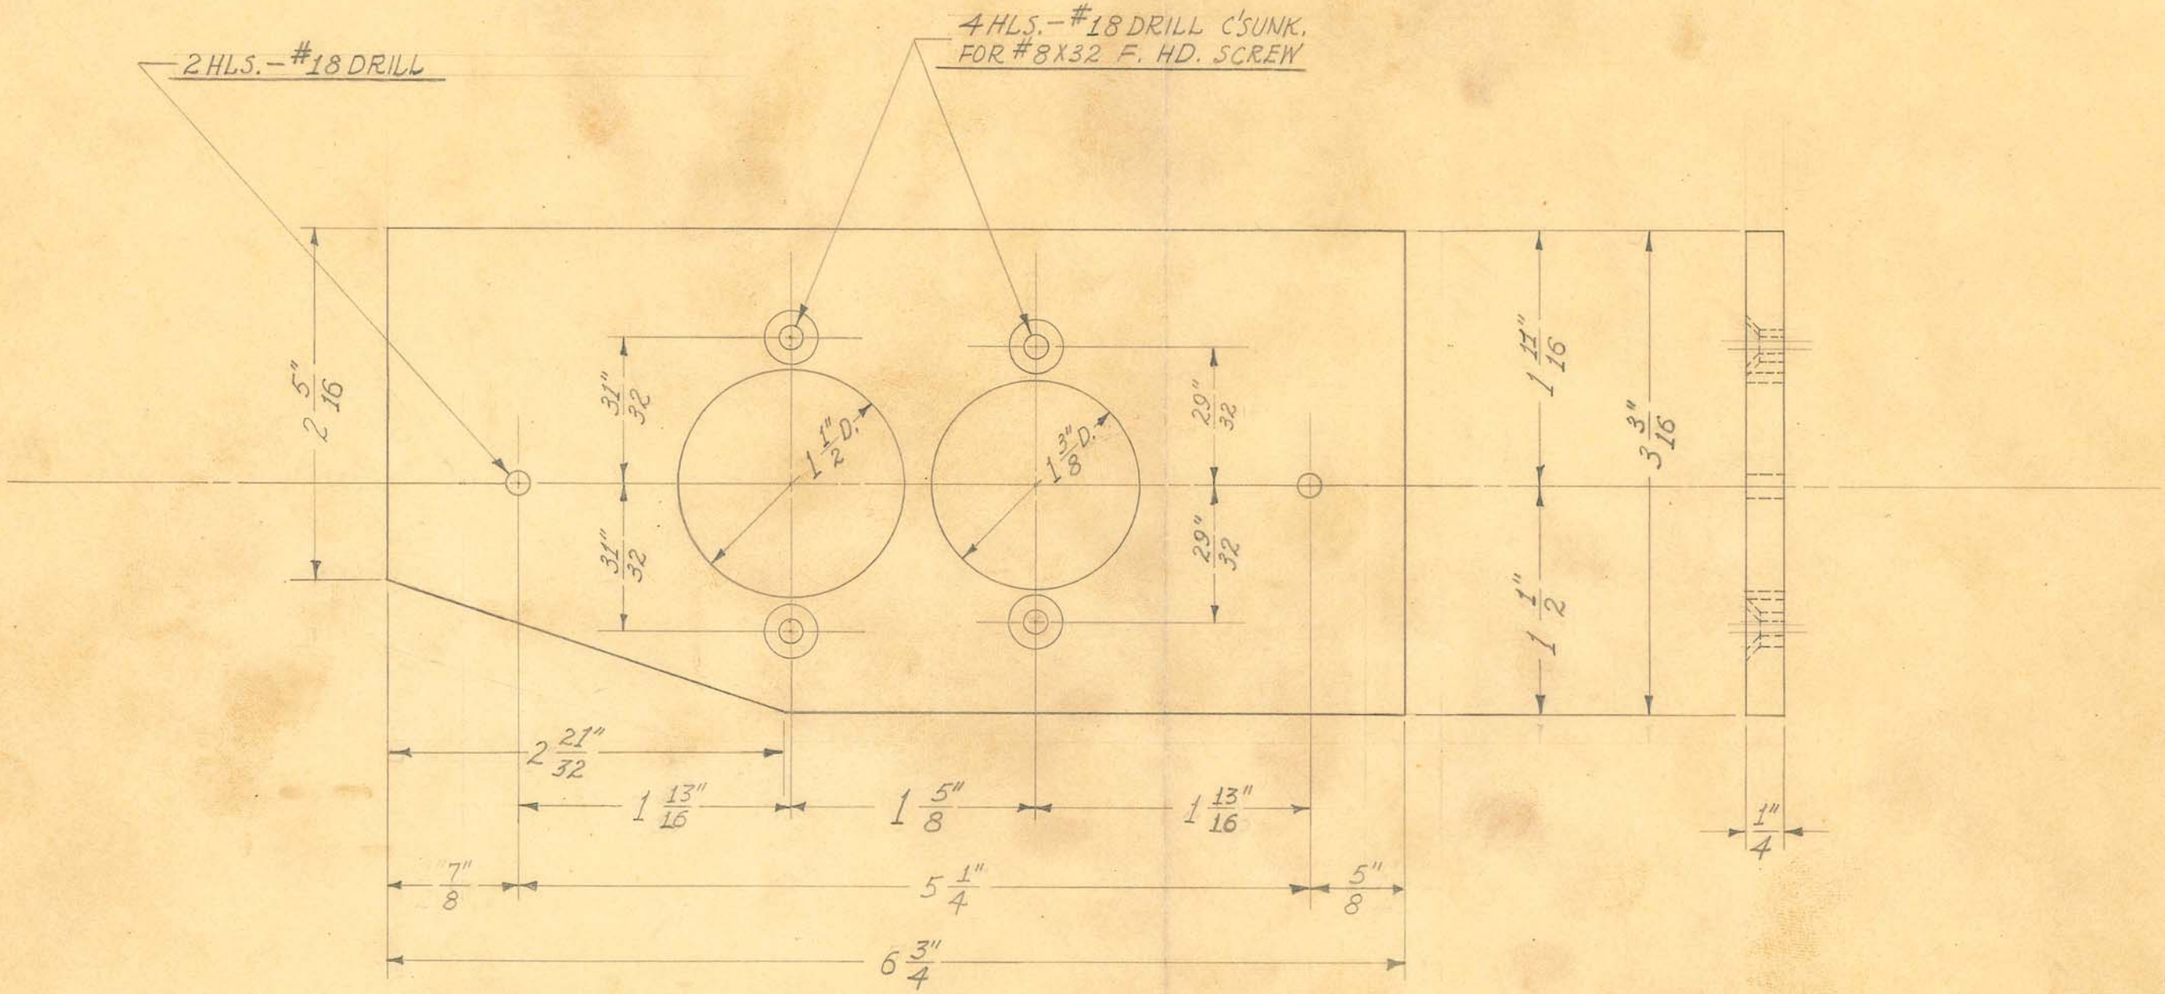

1 REQUIRED

OBSOLETE

SIZE	1/4" SHEET	ISSUE 9-20-38	J.W.
KIND	PLY-WOOD	CHANGED 4-15-40	J.W.
SHAPE		" 12-19-40	J.W.
FINISH		"	
TEMP.		"	
PATT.		"	

TITLE:
FISCHER MOD. "M" SHORT WAVE
LINE & FOOT SWITCH RECEPTACLE MTG. BOARD

H. G. FISCHER & CO.
2335 WABANSIA AVE.
CHICAGO, ILL.

CAT. NO.

PART NO. 12054BFA

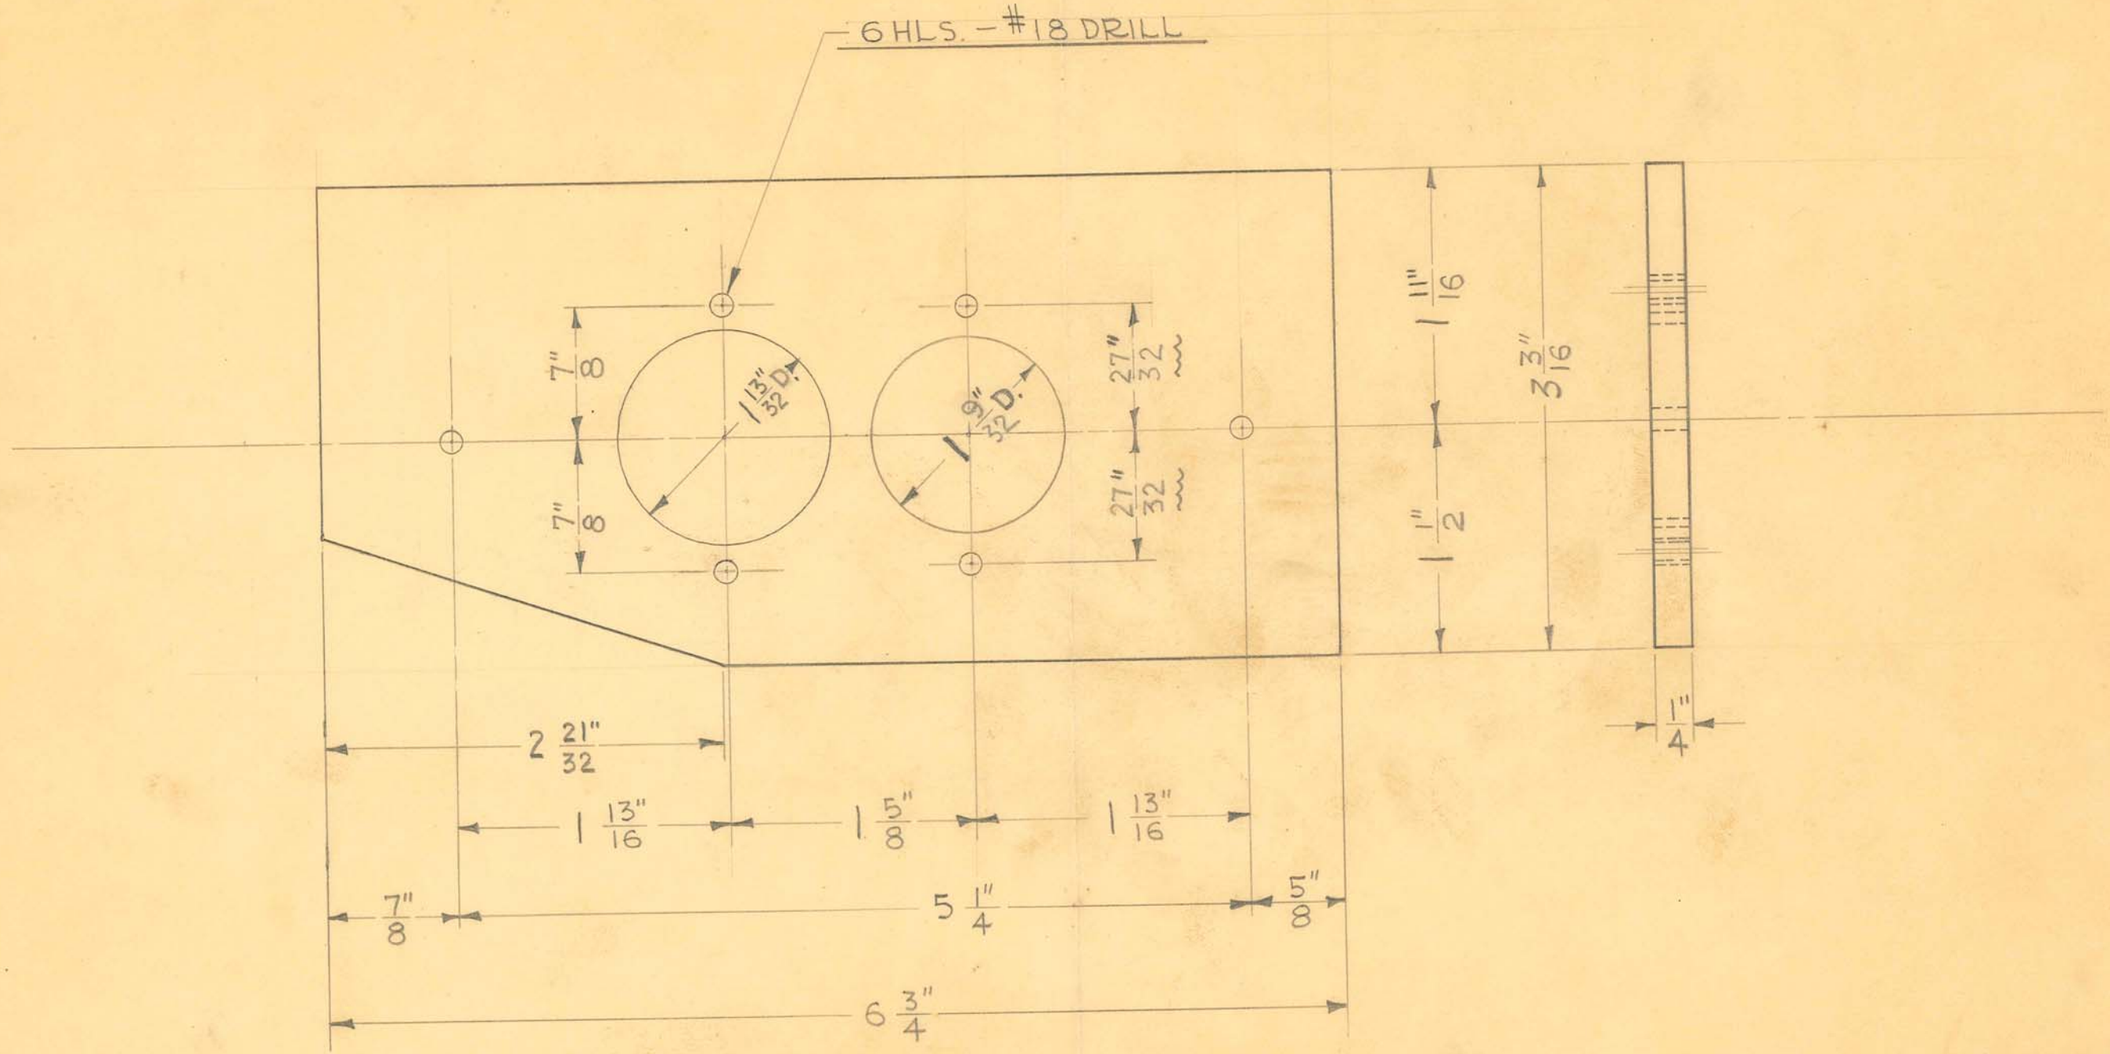

1 REQUIRED

OBSOLETE

SIZE	1/4" SHEET	ISSUE 8-6-41	J.V.W.
KIND	PLYWOOD	CHANGED	
SHAPE		"	
FINISH		"	
TEMP.		"	
PATT.		"	

TITLE: FISCHER MOD. "M" SHORT WAVE LINE & FOOT SWITCH RECEPTACLE MTG. BOARD

H. G. FISCHER & CO.
2338 WABANSIA AVE.
CHICAGO, ILL.

CAT. NO.

PART NO. 12054BFB

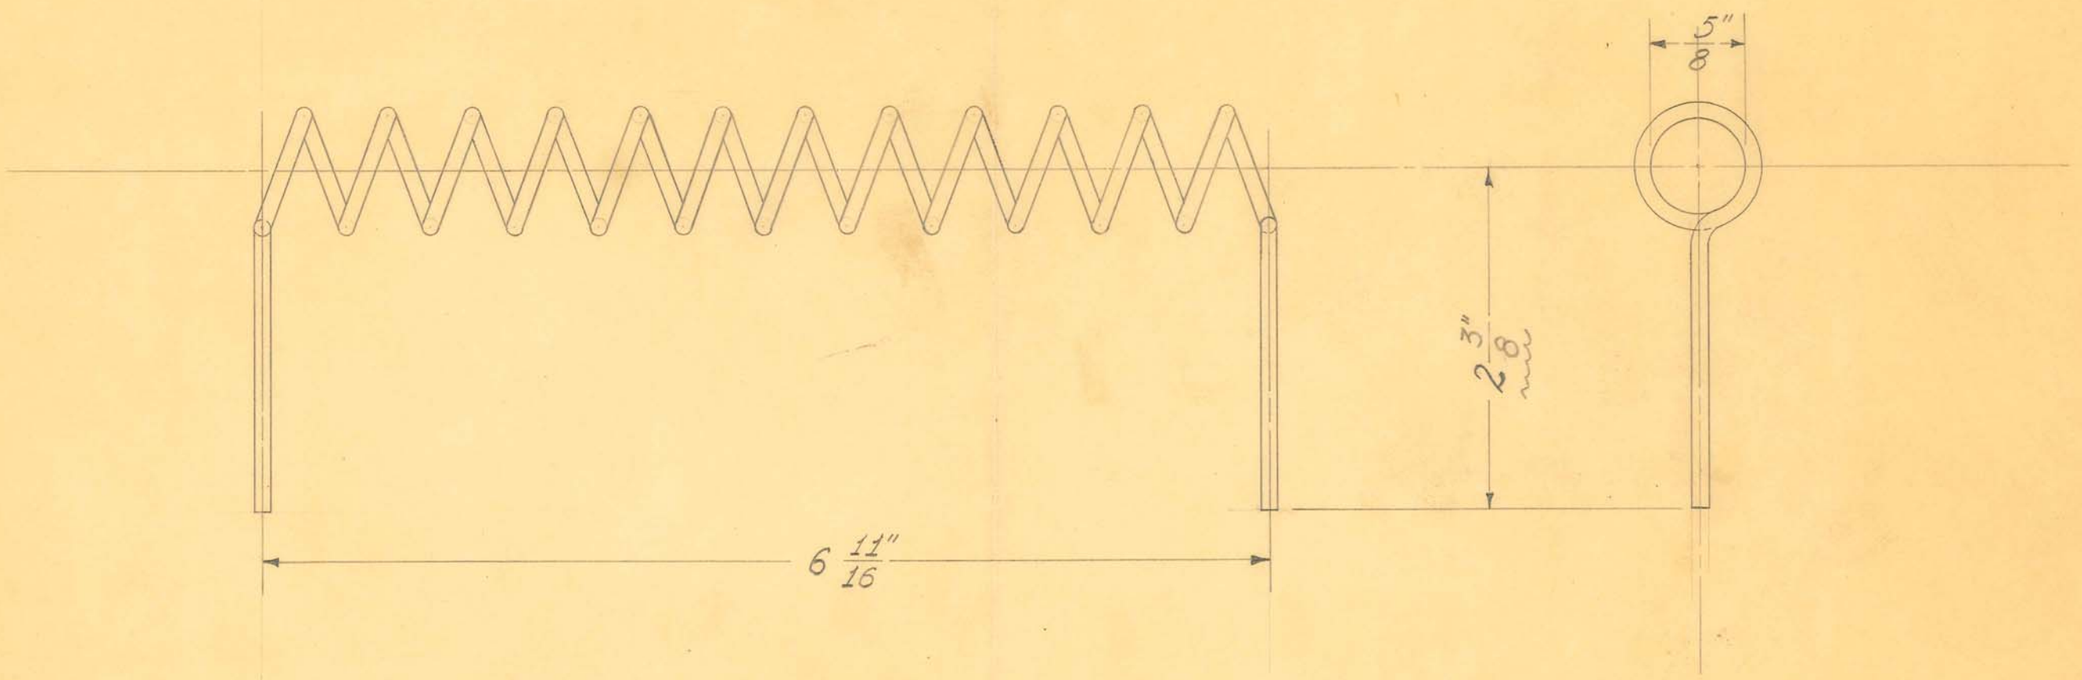

12 TURNS

1 REQUIRED

OBSOLETE

SIZE	#10 TINNED	ISSUE 9-15-38	J.W.
KIND	COPPER WIRE	CHANGED	
SHAPE		"	
FINISH		"	
TEMP.		"	
PATT.		"	

TITLE: FISCHER MOD. "M" SHORT WAVE GRID COIL

H. G. FISCHER & CO.
2335 WABANSIA AVE.
CHICAGO, ILL.

CAT. NO.

PART NO. 12055

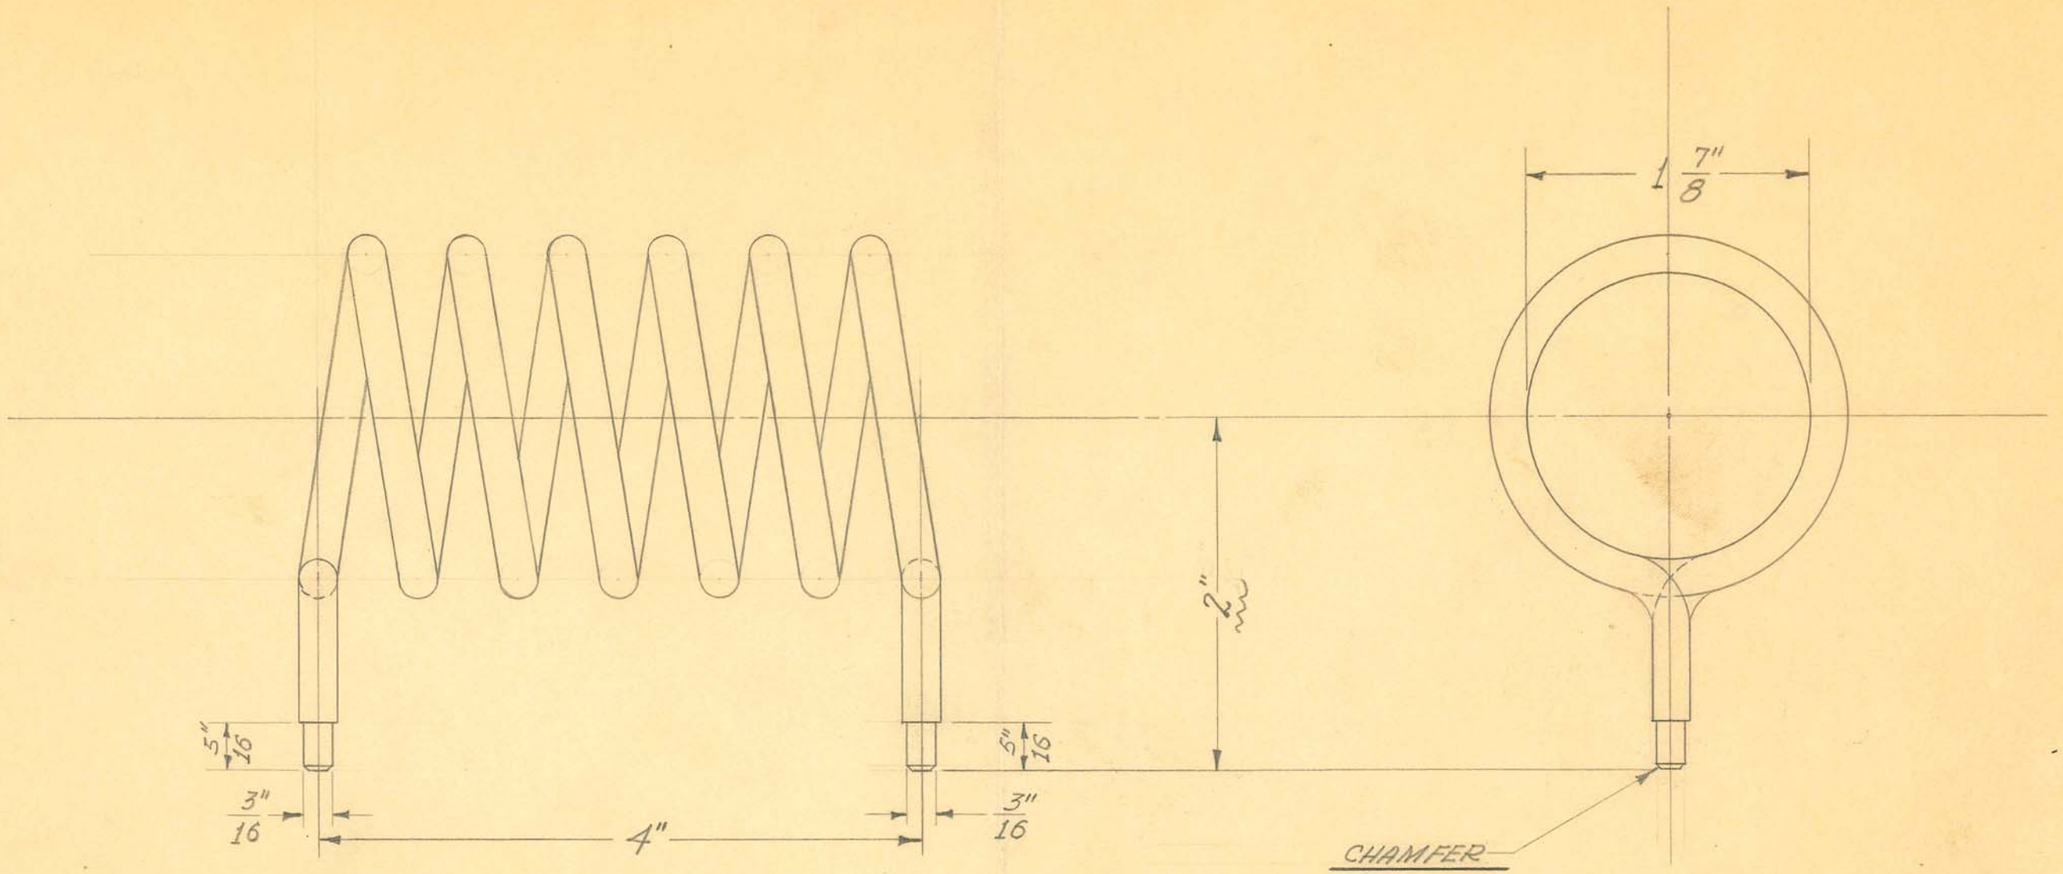

6 TURNS

1 REQUIRED

DEVELOPED LENGTH = 40 3/4"

OBSOLETE

SIZE	1/4" DIAM.	ISSUE 3-21-38	J.W.
KIND	COPPER	C.H. CHANGED 4-24-39	J.W.
SHAPE	ROD	"	
FINISH	ACID DIP	"	
TEMP.		"	

TITLE: FISCHER MOD. "M" SHORT WAVE OSCILLATING COIL

H. G. FISCHER & CO. 2335 WABANSIA AVE.

CAT. NO.

PART NO. 12056

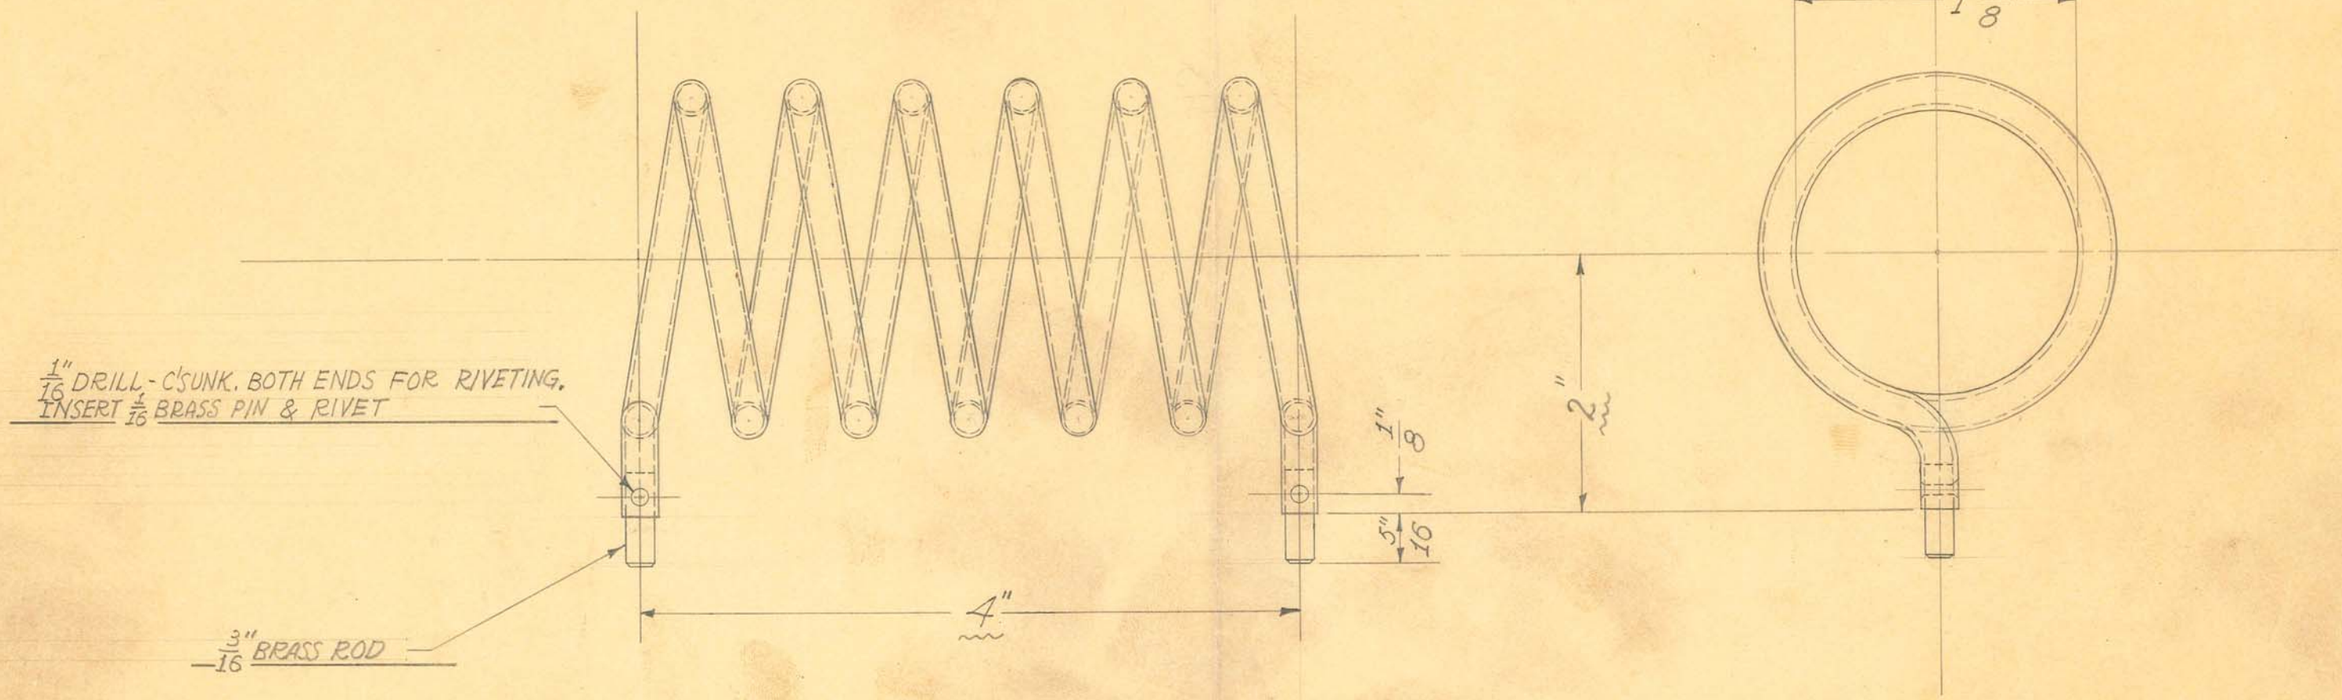

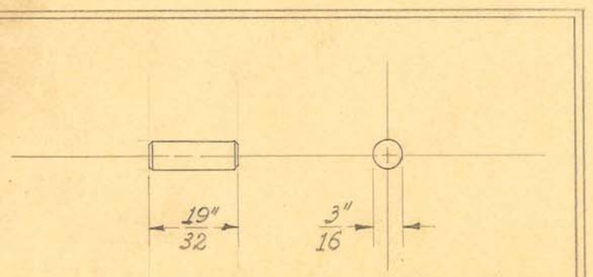

2 REQUIRED

6 TURNS

1 REQUIRED

OBSOLETE

SIZE	1/4" O.D. X 3/16" I.D.	ISSUE 9-16-38	J.W.	
KIND	SOFT COPPER	CHANGED		
SHAPE	TUBING	"		
FINISH	ACID DIP	"		
TEMP.		"		
PATT.		"		

TITLE: FISCHER MOD. "M" SHORT WAVE OSCILLATING COIL

H. G. FISCHER & CO.
2335 WABANSIA AVE.
CHICAGO, ILL.

CAT. NO.

PART NO. 12056G

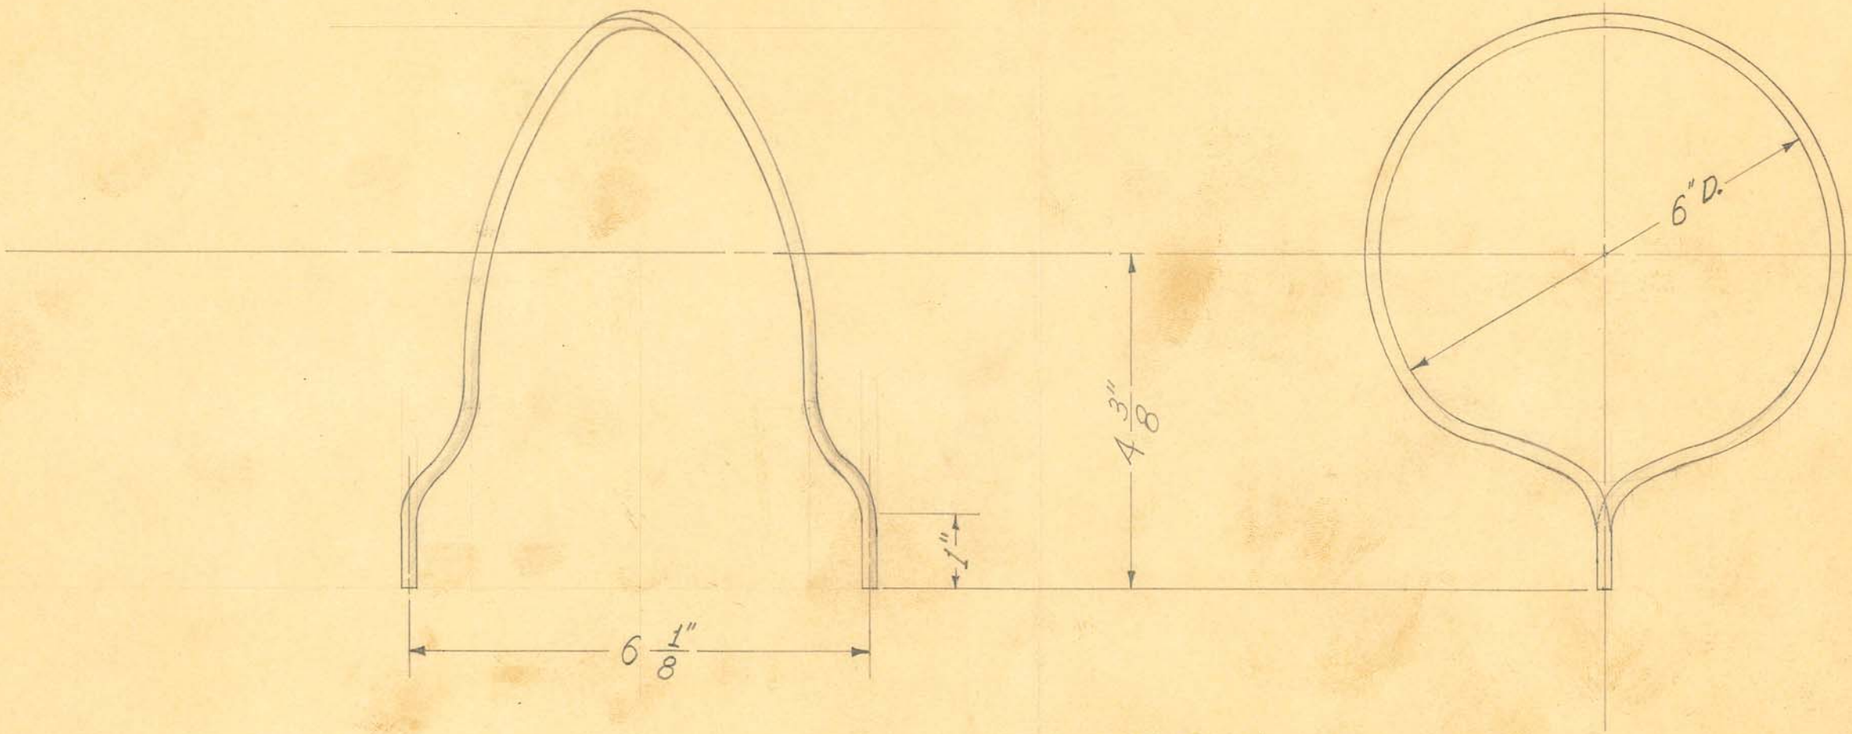

ONE TURN

SCALE ÷ HALF SIZE

1 REQUIRED

OBSOLETE Obsolete

SIZE	#6 BARE	ISSUE 9-16-38	J.W.
KIND	COPPER WIRE	CHANGED	
SHAPE		"	
FINISH	ACID DIP	"	
TEMP.		"	
PATT.		"	

TITLE: FISCHER MOD. "M" SHORT WAVE PICKUP COIL

H. G. FISCHER & CO.
2335 WABANSIA AVE.
CHICAGO, ILL.

CAT. NO.

PART NO. 12057

TITLE	H. G. FISCHER & CO.	PART NO.
FISCHER WALL FRAME TILTING BUCKY STAND ANGLE FOR BANTAM BUCKY	FRANKLIN PARK, ILLINOIS	17768
	DATE 9-16-48 DR. BY W.J. CH'K'D. J.V.W.	REVISION / DATE / BY
PATTERN / FINISH / SCALE HALF	DIMENSIONS: FRACTIONAL ±.015; DECIMAL ±.005; ANGULAR ±½°; UNLESS OTHERWISE SPECIFIED	
TOOLS / MATERIAL 13 GA. (.089") C.R. STEEL		

XX
Obsolete

OBSOLETE

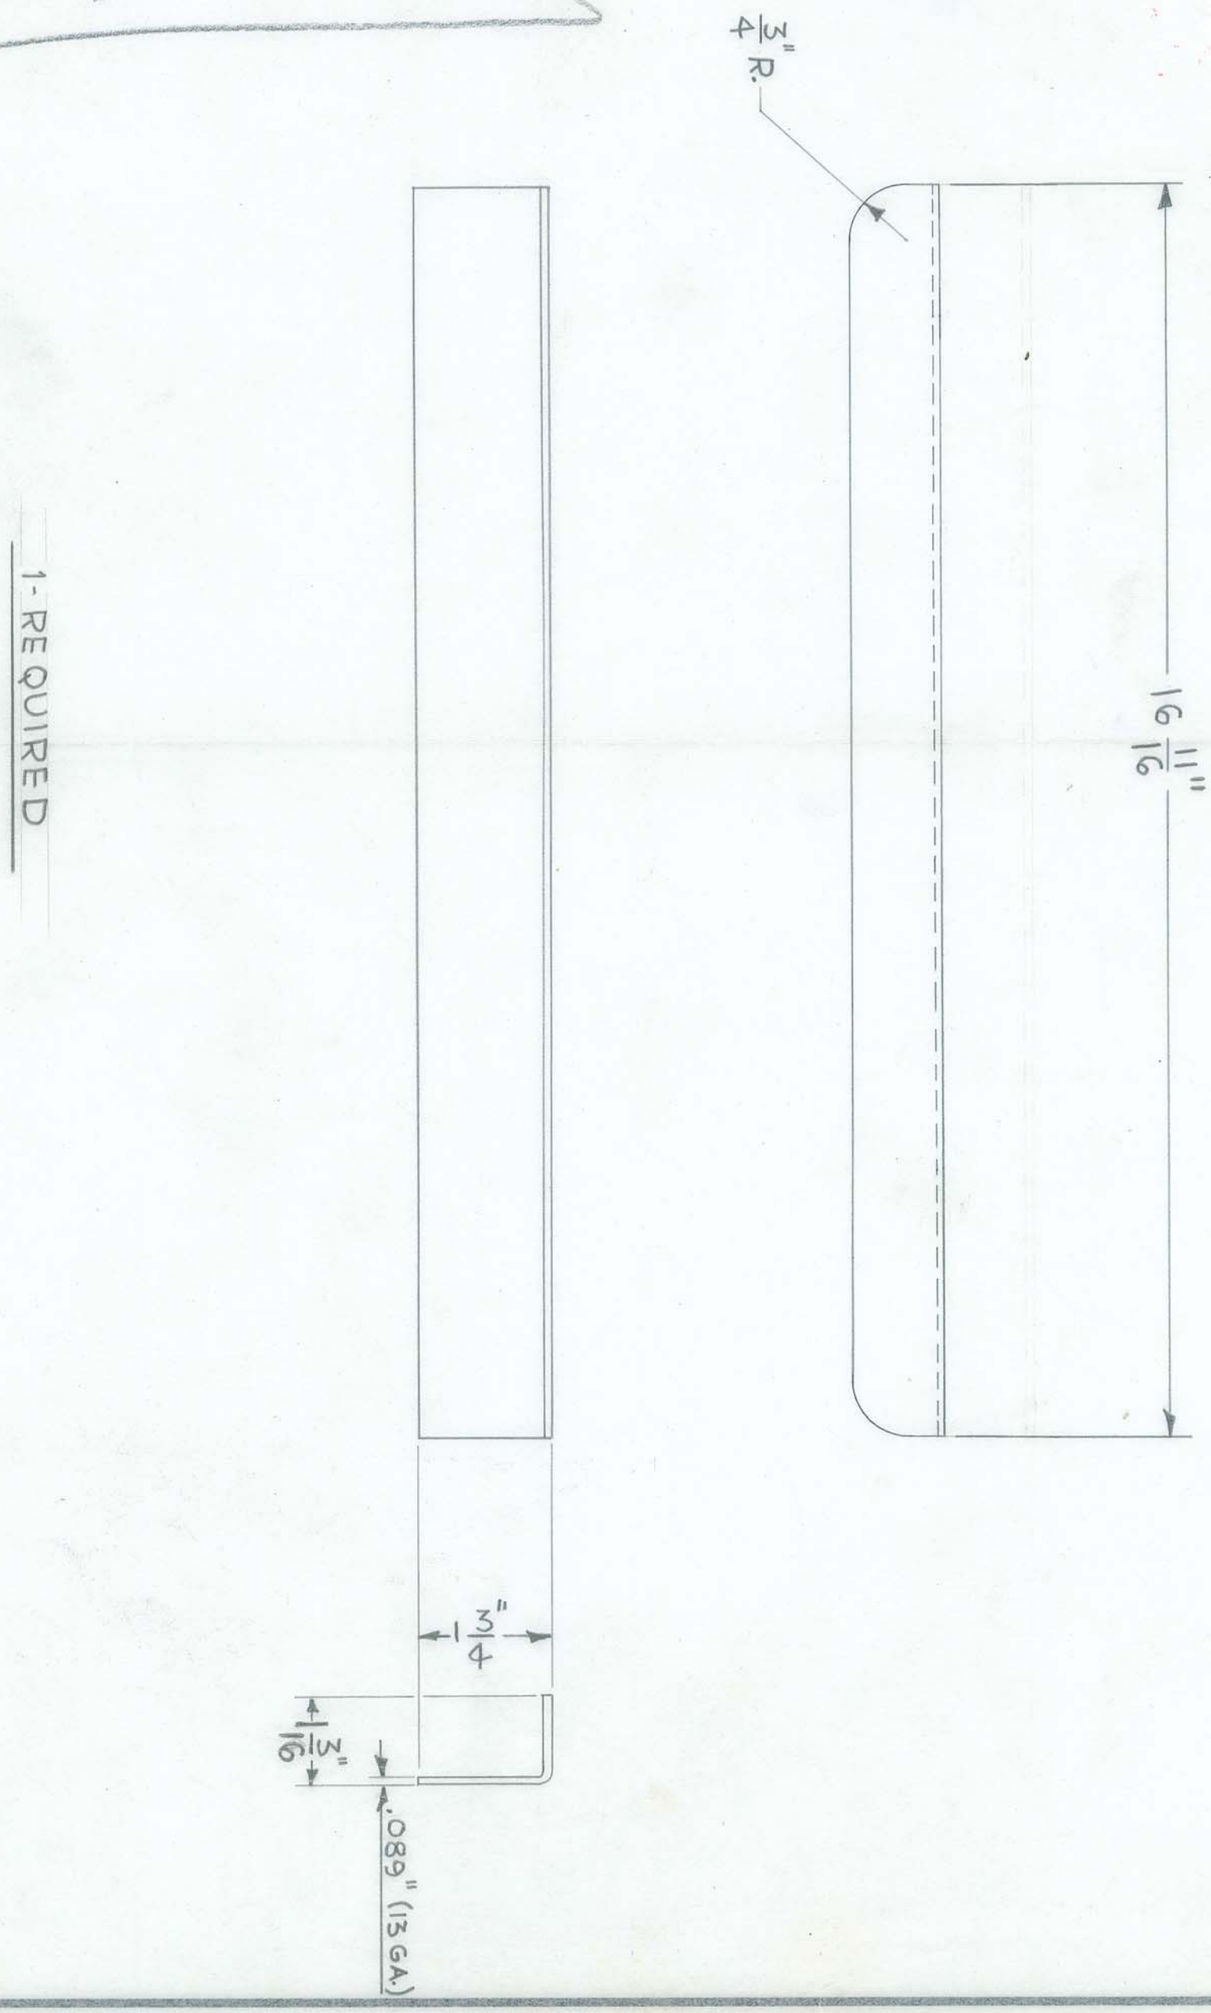

1 - REQUIRED

FOLDER #134

TITLE
FISCHER WALL FRAME TILTING BUCKY STAND
ANGLE FOR BANTAM BUCKY

H. G. FISCHER & CO.
FRANKLIN PARK, ILLINOIS

PART NO. 17768F

DATE 9-16-48 | DR. BY W.J. | CH'K'D. J.V.W.

REVISION	DATE	BY

PATTERN | FINISH PAINTED | SCALE HALF

TOOLS: DRILL JIG TOOL #9872 | MATERIAL: FROM 17768

DIMENSIONS UNLESS OTHERWISE SPECIFIED
FRACTIONAL ± .015
DECIMAL ± .005
ANGULAR ± ½°

OBSOLETE

XX Obsolete

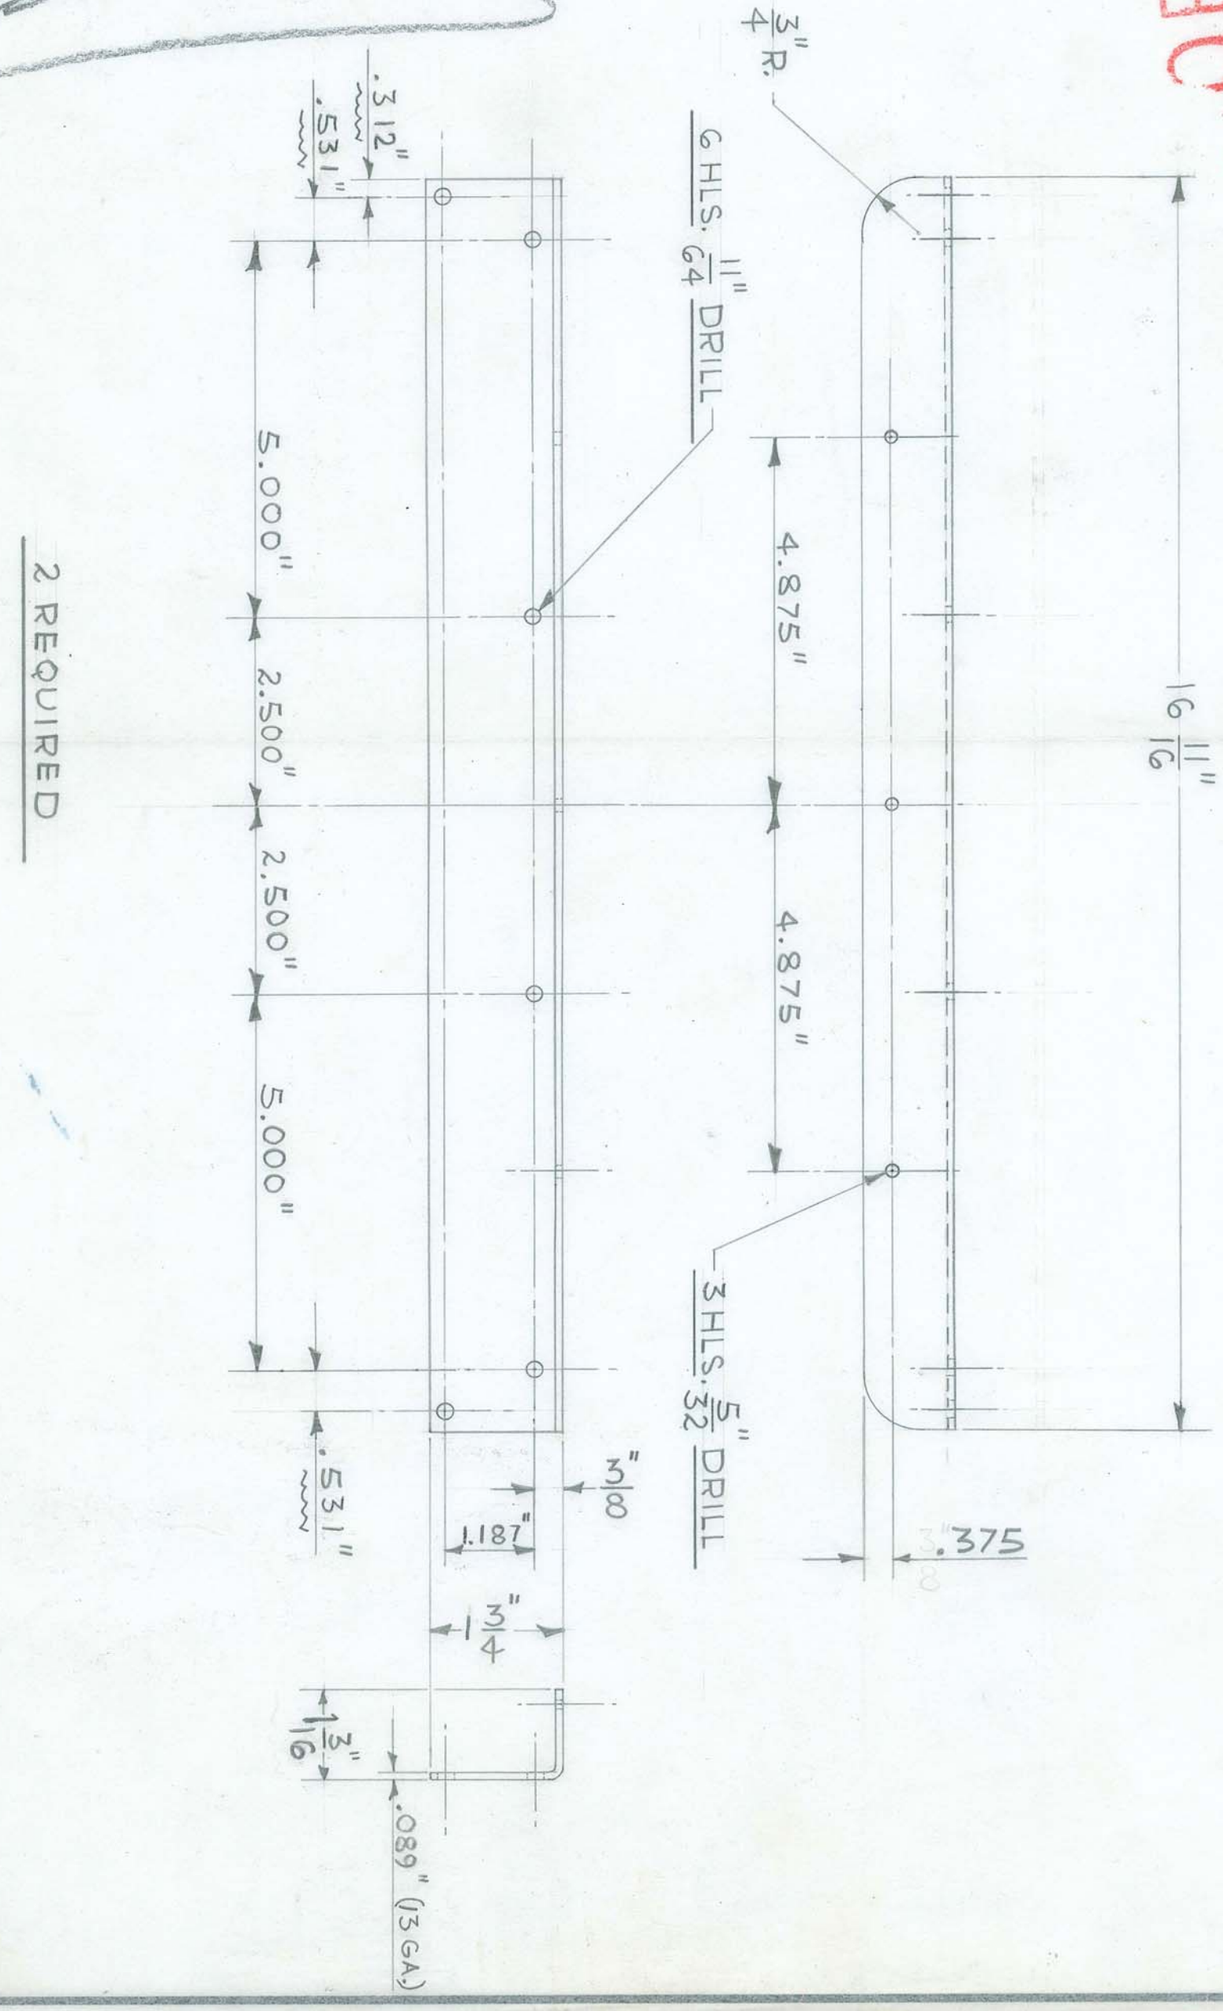

2 REQUIRED

FOLDER #134

TITLE
FICSHER WALL-FRAME TILTING BUCKY STAND
FRICTION BAR ASSEMBLY

H. G. FISCHER & CO.
FRANKLIN PARK, ILLINOIS

DATE 9-22-48 DR. BY W. J. CH'K'D. J.V.W.

PART NO. 17779G

REVISION	DATE	BY

PATTERN | FINISH CAD. # 23 | SCALE FULL

TOOLS | MATERIAL

DIMENSIONS
FRACTIONAL ± .015
DECIMAL ± .005
ANGULAR ± ½°
UNLESS OTHERWISE SPECIFIED

OBSOLETE

X X Obsolete

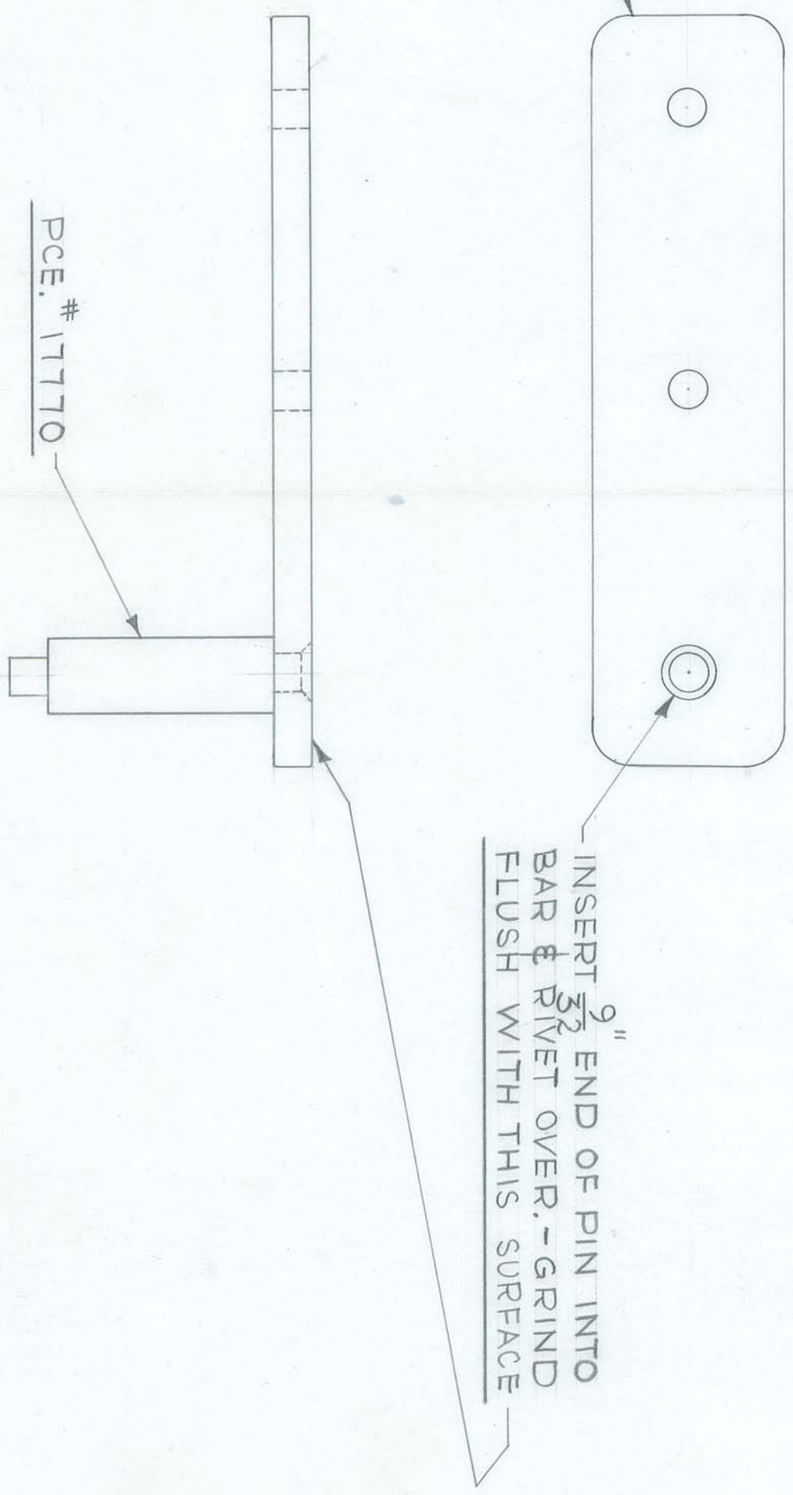

FOLDER # 134

OBSOLETE

INSERT PINS PCE.# 17003
& RIVET BOTH ENDS
FILE TO CONTOUR OF TUBE

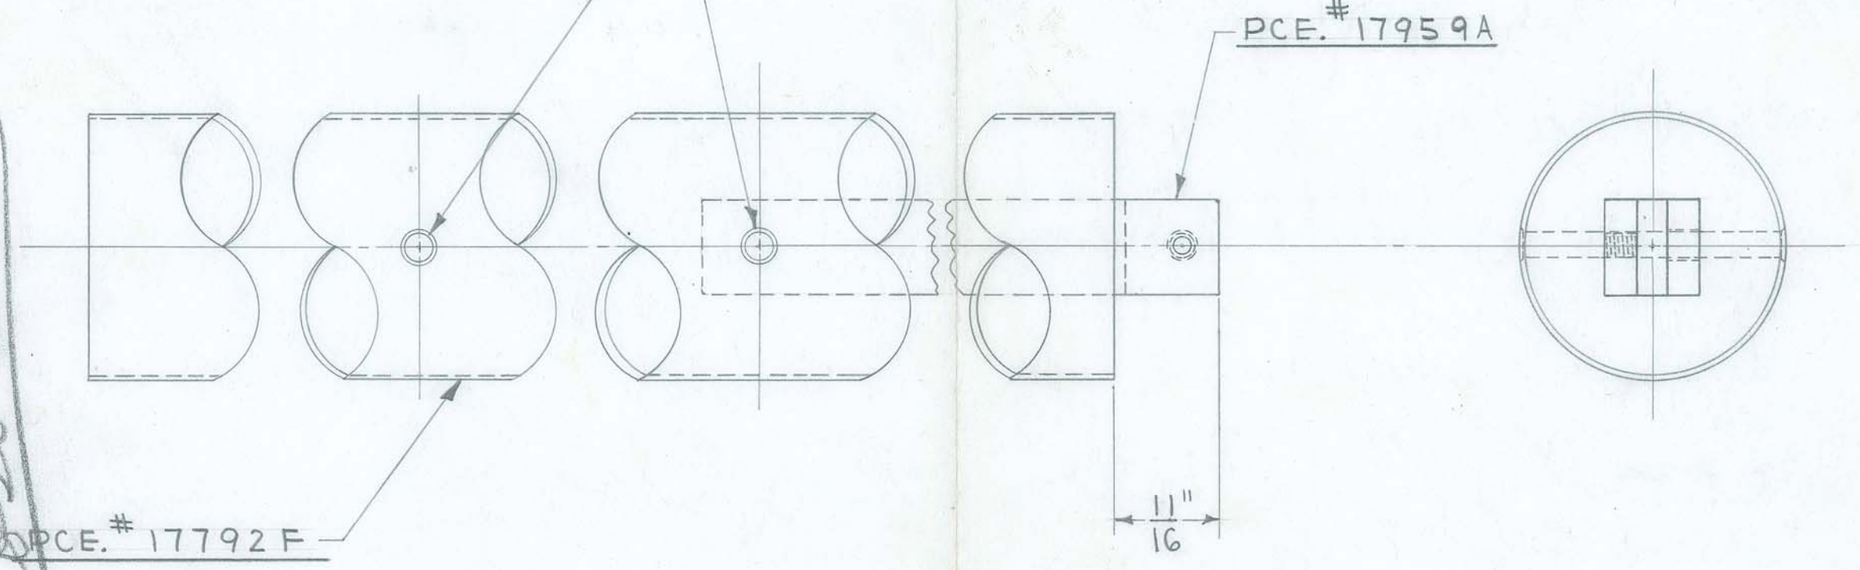

FILL TUBE WITH LEAD TO BRING TOTAL WEIGHT UP TO 31 1/2 LBS. ± 1/2 LB.

2 REQUIRED

TITLE FISCHER WALL FRAME TILTING BUCKY STAND
CWT. TUBE ASSEMBLY - 14"X17" BUCKY

H. G. FISCHER & CO.
FRANKLIN PARK, ILLINOIS

PART NO. 1779

REVISION

DATE 11-10-48 DR. BY W.J. CH'K'D. J.W.W.

SCALE FULL

DIMENSIONS
FRACTIONAL ±.015
DECIMAL ±.005
ANGULAR ±½°
UNLESS OTHERWISE SPECIFIED

PATTERN

FINISH

TOOLS FILLING CAP #9975

MATERIAL

FOLDER #134

TITLE
FISCHER WALL FRAME TILTING BUCK STAND
SUPPORT FOR 14"X17" & 14"X36" BUCKY (ANGLE)

H. G. FISCHER & CO.
FRANKLIN PARK, ILLINOIS

DATE 10-28-48 DR. BY W. J. CH'K'D.

PART NO. 17796

REVISION	DATE	BY

PATTERN | FINISH | SCALE HALF

TOOLS | MATERIAL 13 GA.(.089") C.R. STEEL

DIMENSIONS
FRACTIONAL ± .015
DECIMAL ± .005
ANGULAR ± ½°
UNLESS OTHERWISE SPECIFIED

16 GA.(.060") C.R. STEEL ON PAD ONLY

obsolete

OBSOLETE

1 REQUIRED

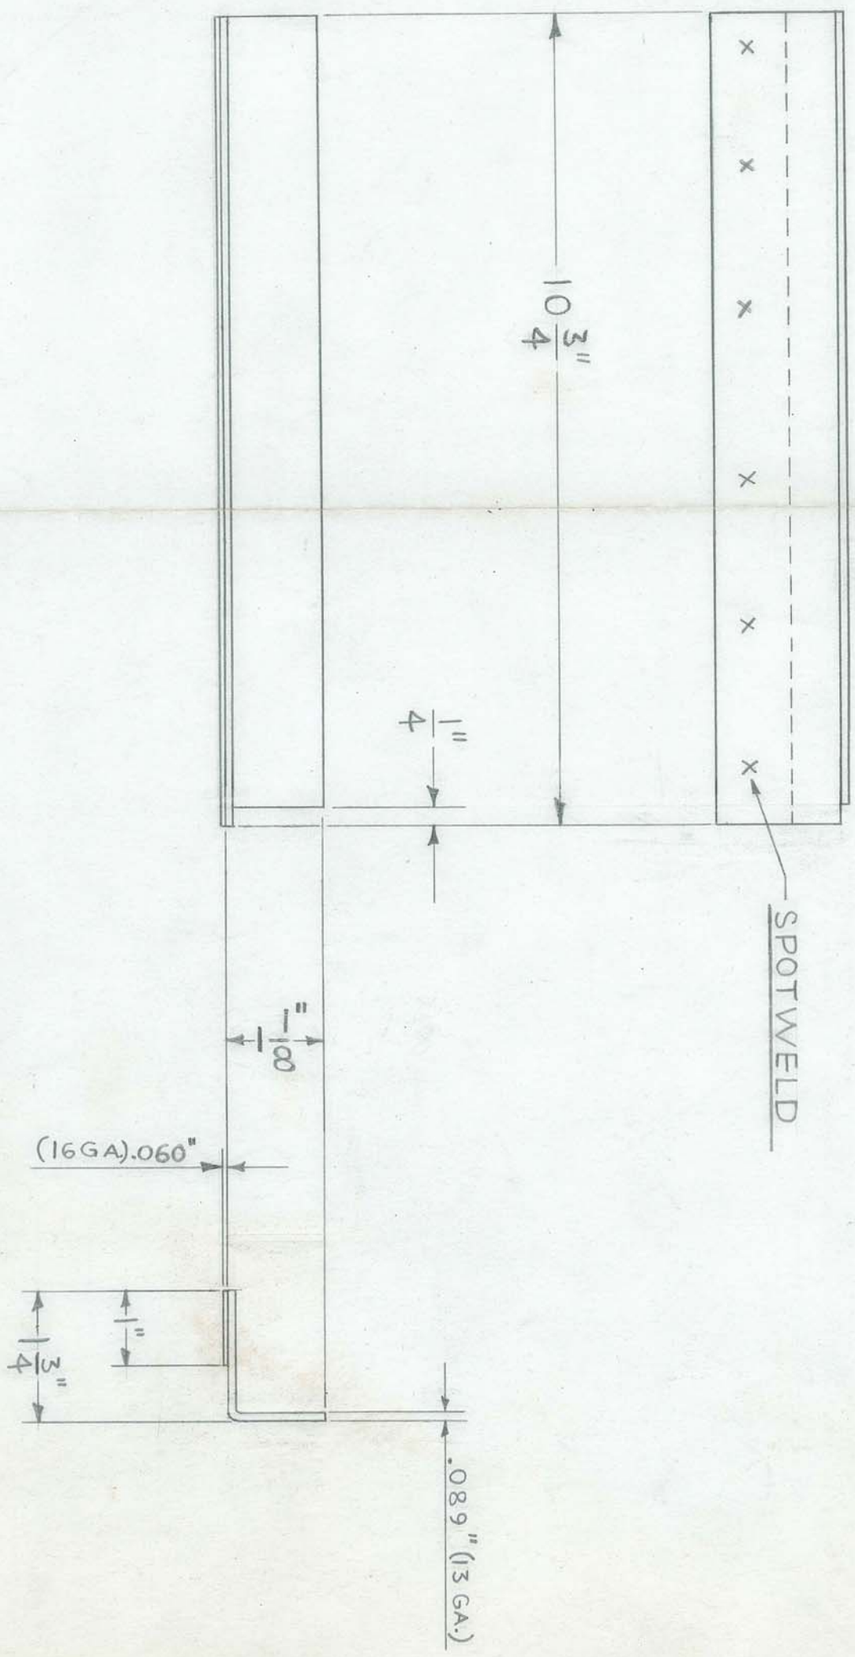

FOLDER # 134

TITLE: FISCHER TILTING BUCKY STAND
BUCKY SUPPORTS

H. G. FISCHER & CO.
FRANKLIN PARK, ILLINOIS

DATE 5-23-57 DR BY J.V.W. CH'K'D.

PART NO. 17796A

REVISION	DATE	BY
A SPECIFIC FINISH GIVEN	7/30/64	JF

OBSOLETE
SEE
17796GA
8/14/64
RCT

PATTERN | FINISH BLACK #269 (A) | SCALE HALF

TOOLS | MATERIAL

DIMENSIONS UNLESS OTHERWISE SPECIFIED
FRACTIONAL ± .015
DECIMAL ± .005
ANGULAR ± ½°

(2)

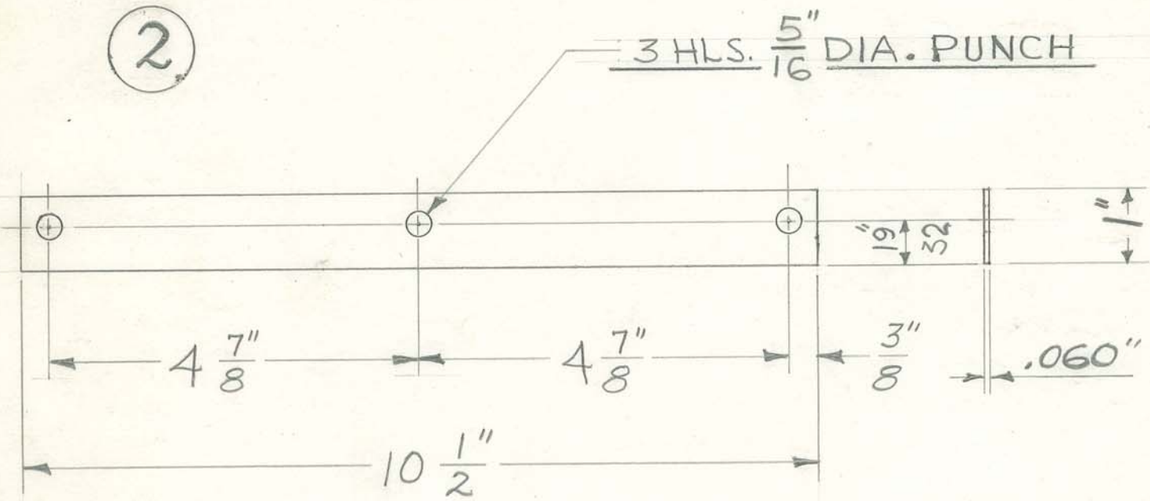

OBSOLETE

DEPT.	ITEM NO.	AMT.	NAME	PART NO. OR MATERIAL
S.M.	2	1	PAD	#16GA. (.060") SHEET C.R. STEEL
S.M.	1	1	SUPPORT	#17814A

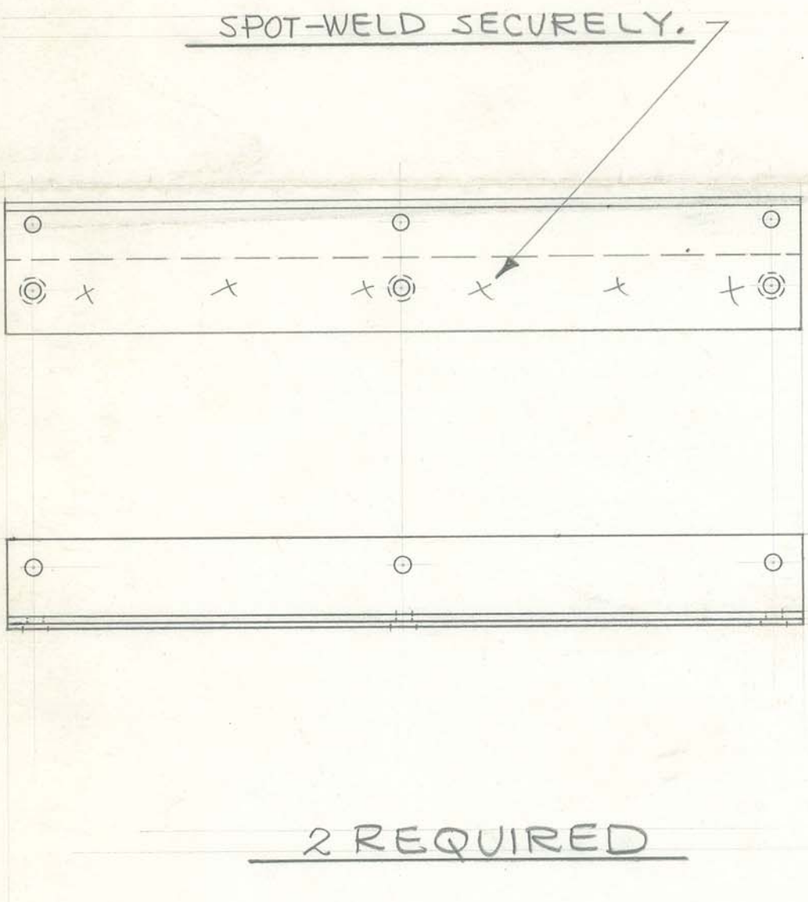

2 REQUIRED

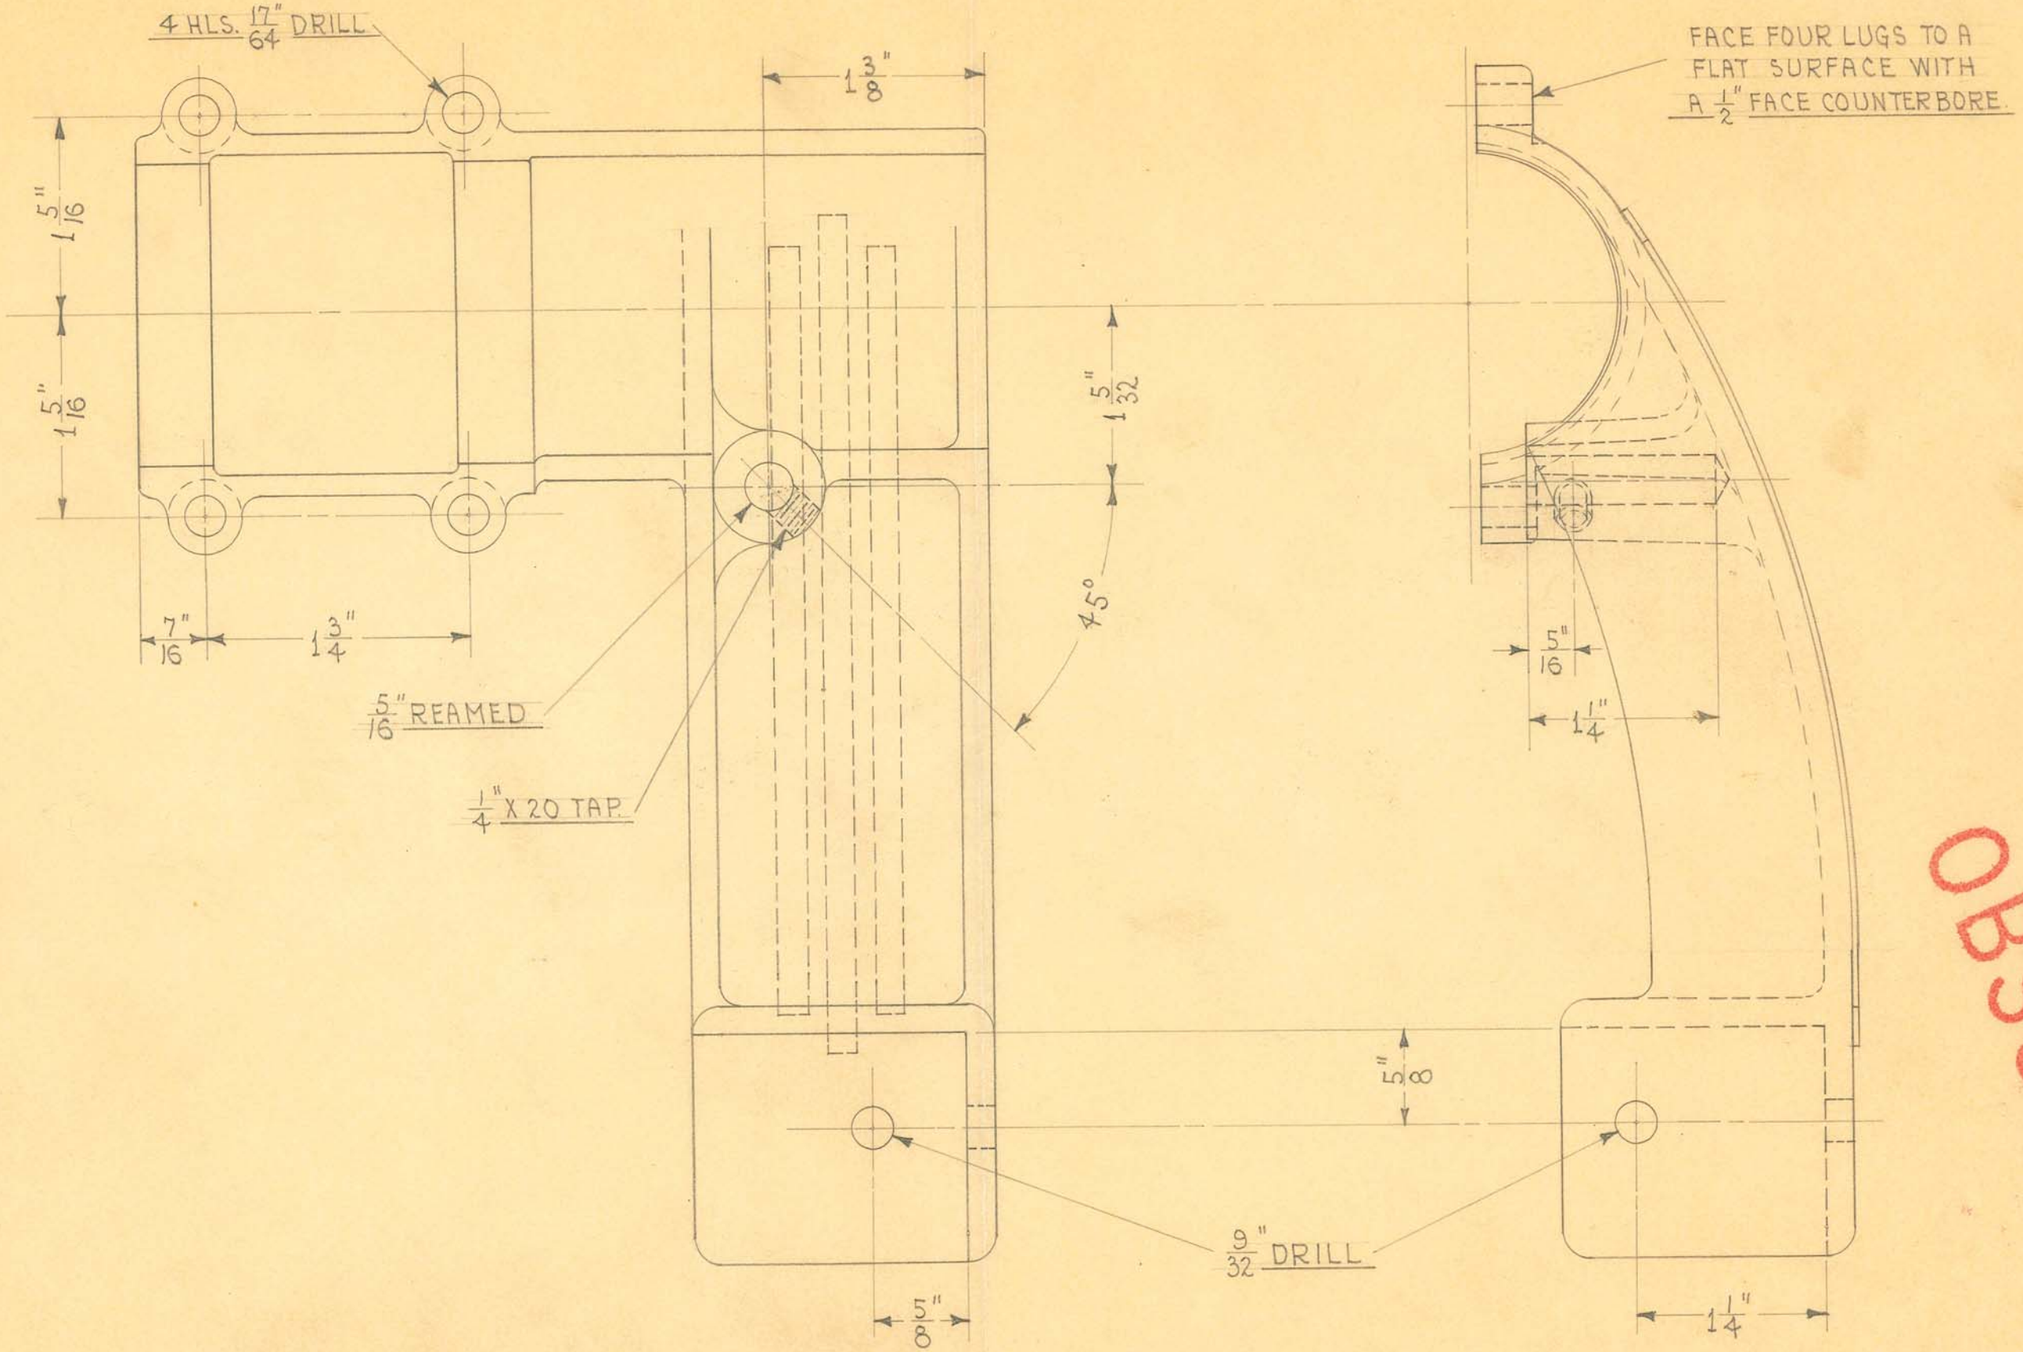

1 REQUIRED

OBSOLETE

SIZE		ISSUE 10-29-37	A.E.
KIND	IRON CASTING	CHANGED	
SHAPE		"	
FINISH	KRIST. #55	"	
TEMP.		"	
PATT.	7060-1163	"	

TITLE: VERTICAL WALL FRAME
PANEL FRAME UPPER SUPPORT - RIGHT

H. G. FISCHER & CO.
2335 WABANSIA AVE.
CHICAGO, ILL.

CAT. NO.

PART NO. 11071F

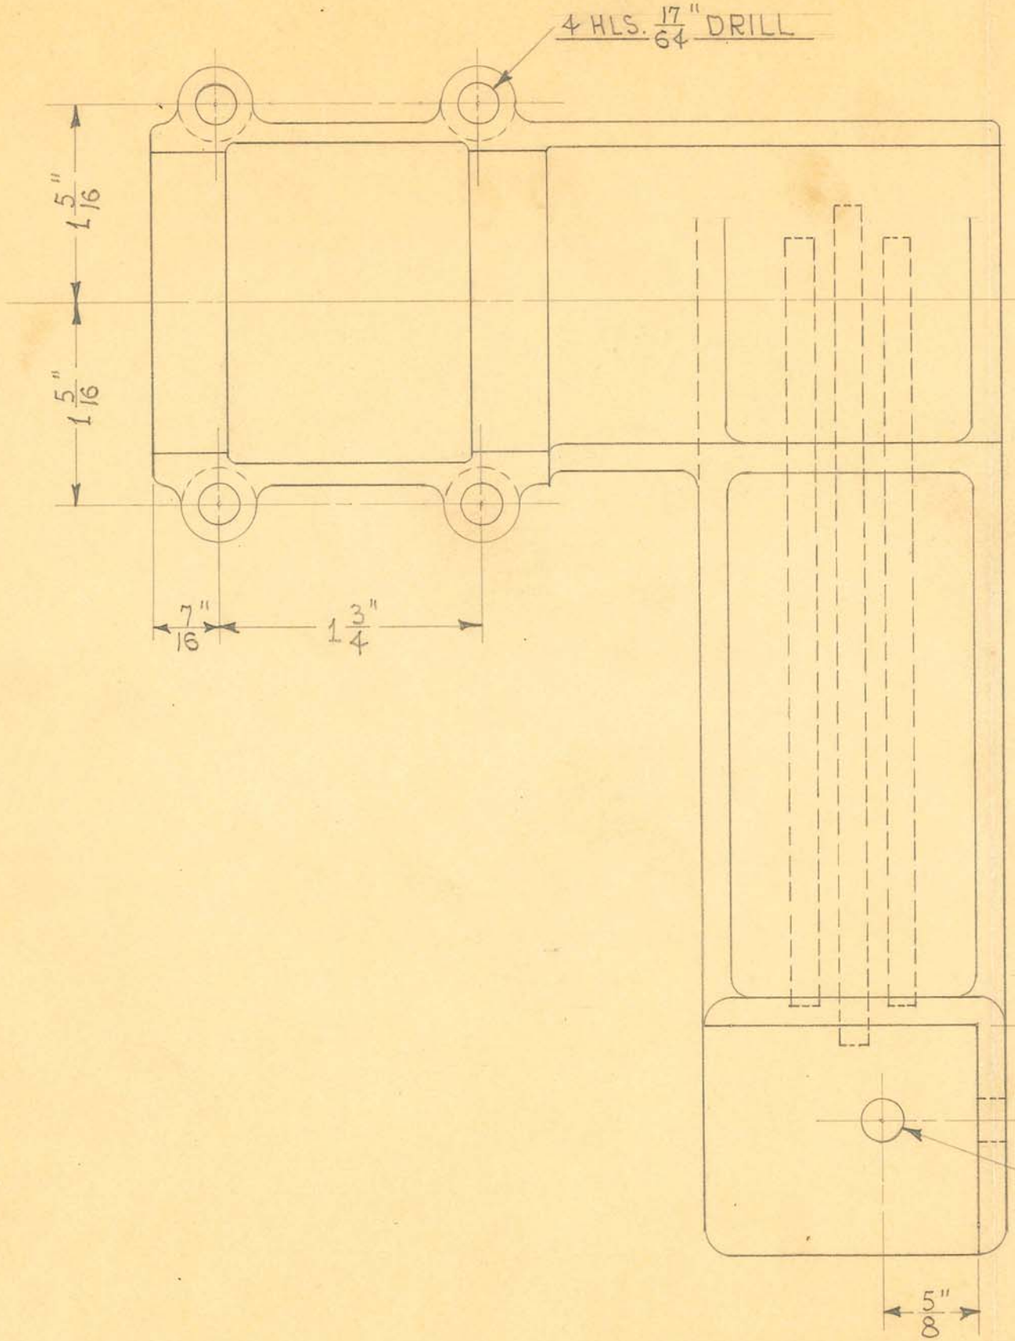

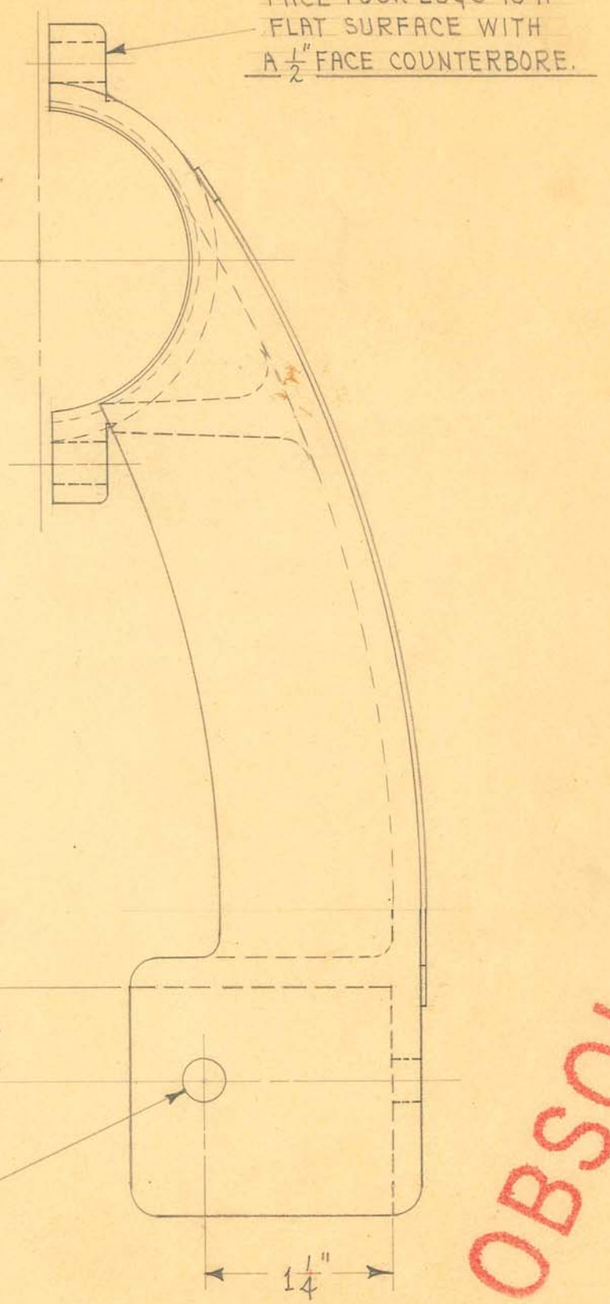

OBSOLETE

1 REQUIRED

SIZE		ISSUE 10-29-37	A.S.
KIND	IRON CASTING	CHANGED	
SHAPE		"	
FINISH	KRIST. # 55	"	
TEMP.		"	
PATT.	7503-1172	"	

TITLE:
VERTICAL WALL FRAME
PANEL FRAME LOWER SUPPORT - LEFT

H. G. FISCHER & CO. 2335 WABANSIA AVE. CHICAGO, ILL.	CAT. NO.	PART NO. 11072F

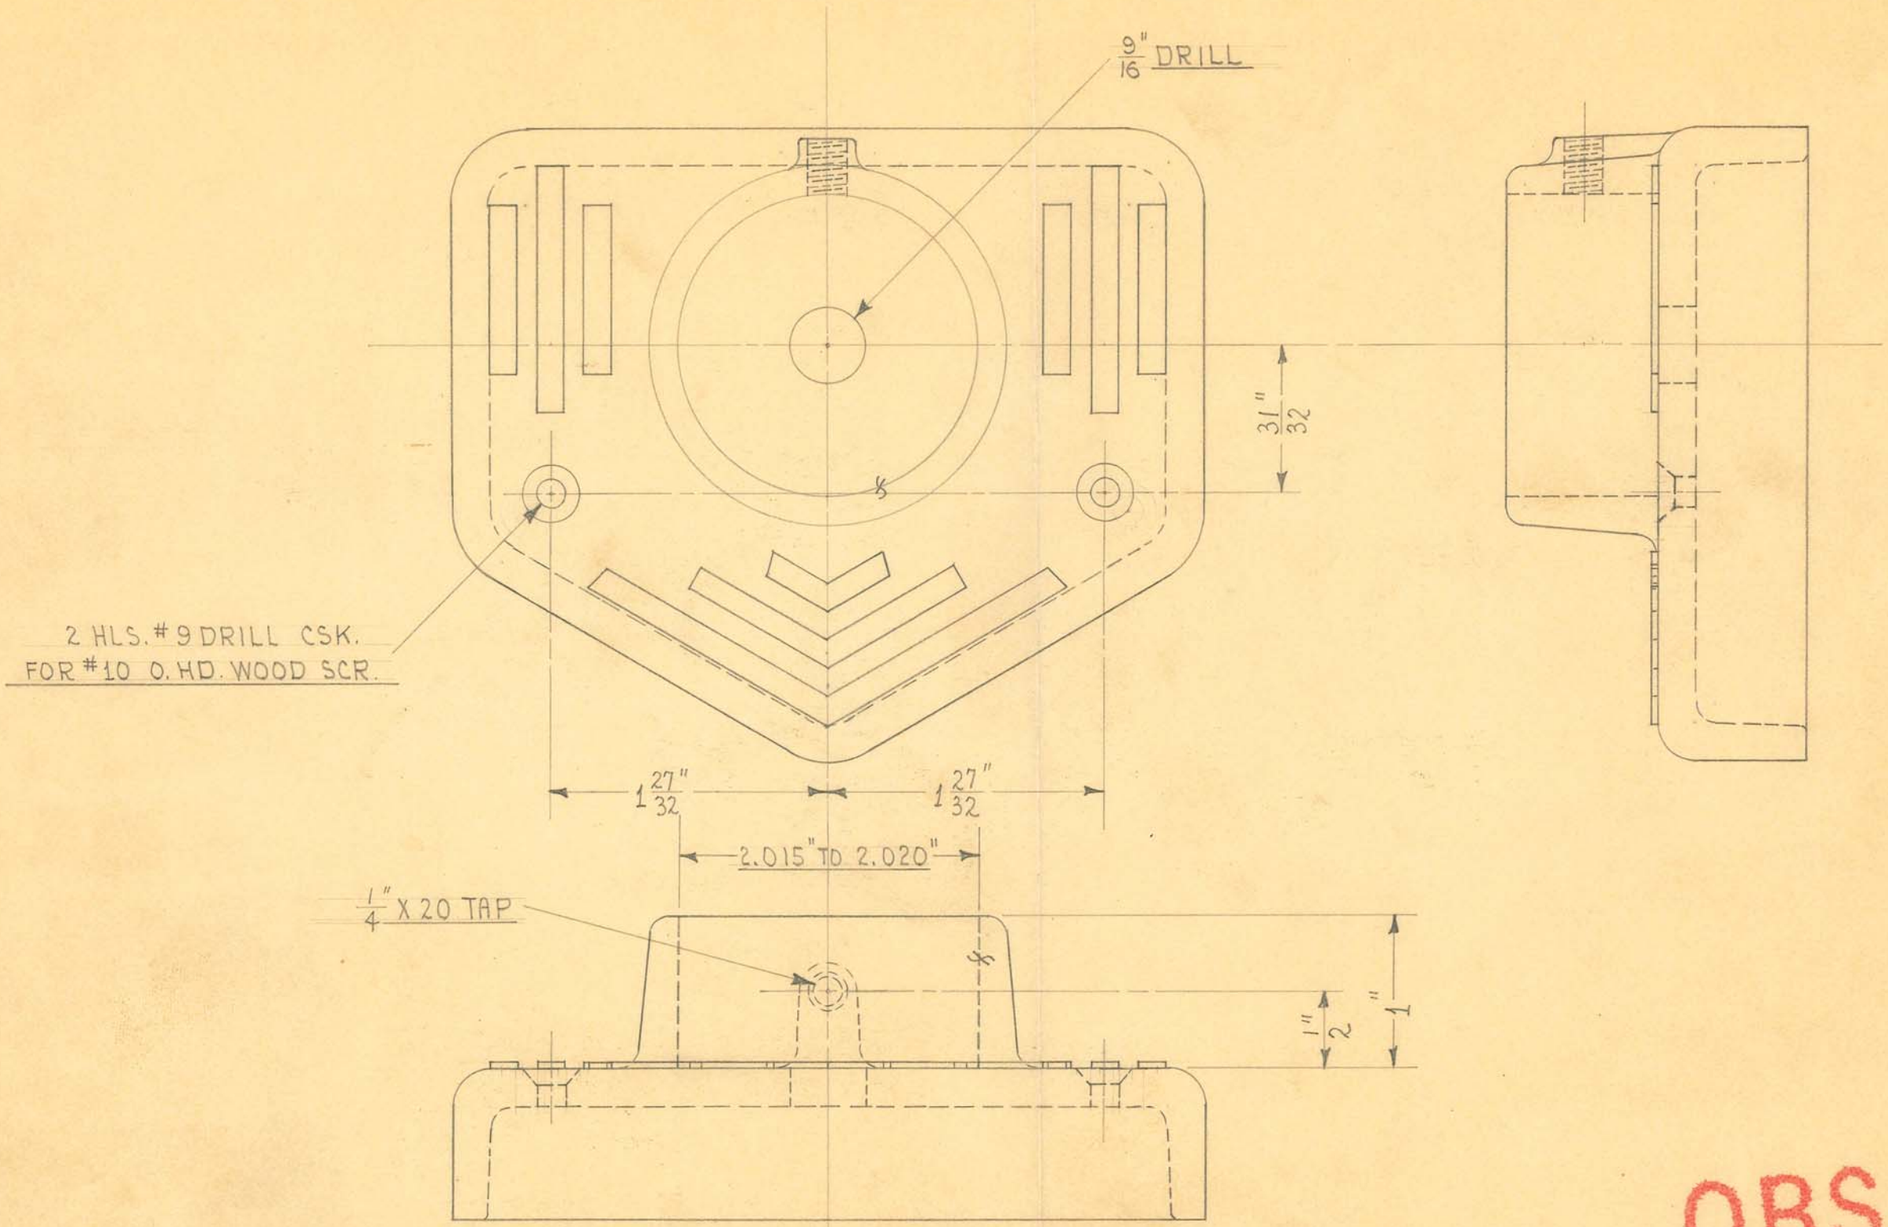

2 REQUIRED

OBSOLETE

SIZE		ISSUE 10-27-37	J.E.	TITLE: VERTICAL WALL FRAME BUCKY COUNTERWEIGHT TUBE BASE
KIND	IRON CASTING	CHANGED		
SHAPE		"		
FINISH	KRIST. #55	"		
TEMP.		"		
PATT.	7125-1166	"		

H. G. FISCHER & CO.
2335 WABANSIA AVE.
CHICAGO, ILL.

CAT. NO.

PART NO. 11078F

FACE FOUR LUGS TO A FLAT SURFACE WITH A $\frac{1}{2}$" FACE COUNTERBORE.

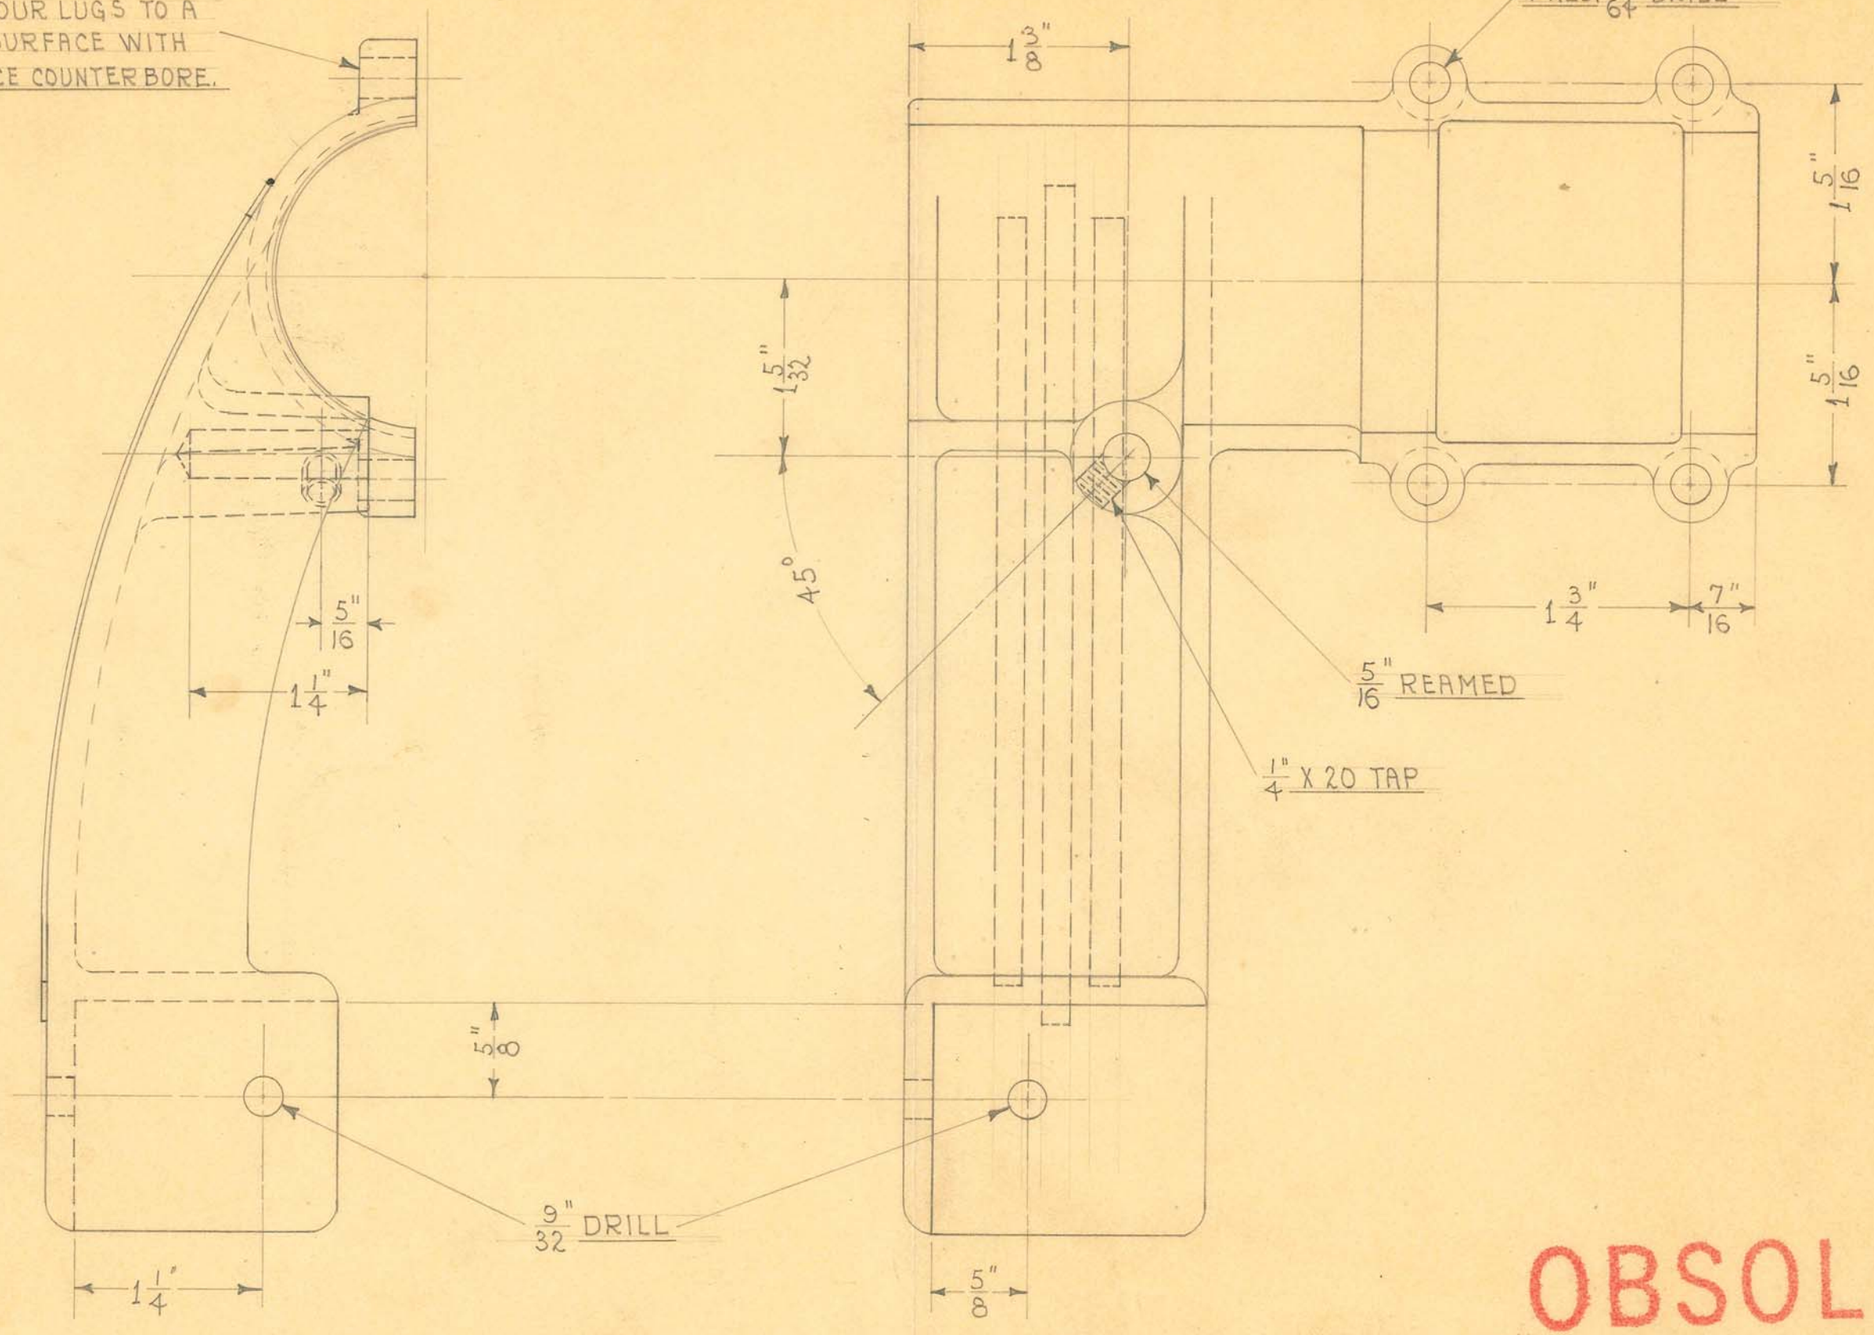

1 REQUIRED

OBSOLETE

SIZE		ISSUE 10-28-37	A.E.
KIND	IRON CASTING	CHANGED	
SHAPE		"	
FINISH	KRIST. #55	"	
TEMP.		"	
PATT.	7059-1162	"	

TITLE:
VERTICAL WALL FRAME
PANEL FRAME UPPER SUPPORT - LEFT

H. G. FISCHER & CO. 2338 WABANSIA AVE. CHICAGO, ILL.	CAT. NO.	PART NO. 11088F

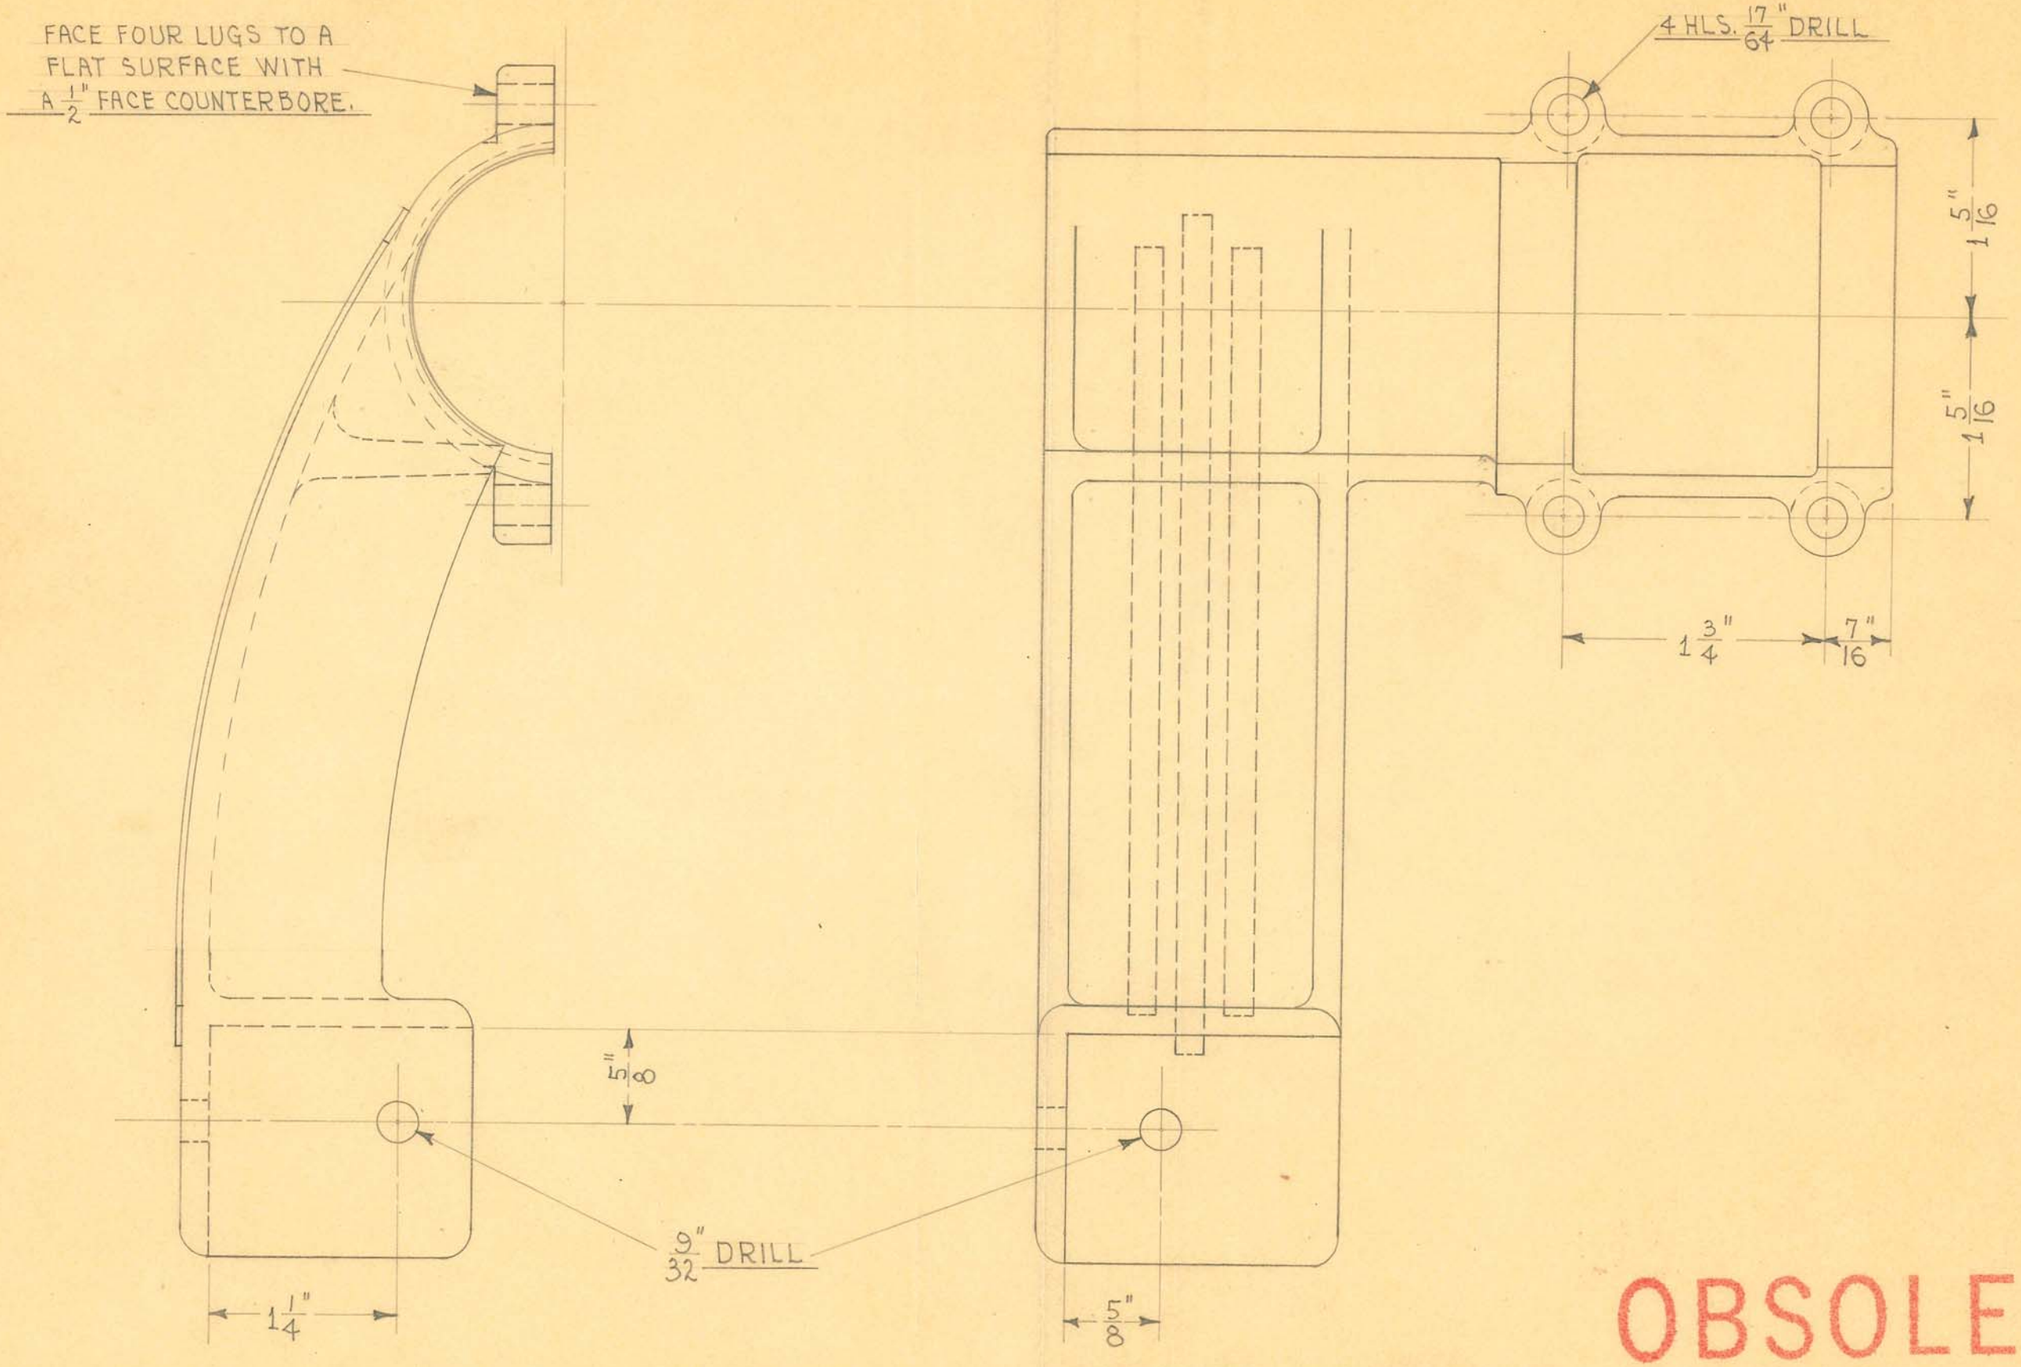

1 REQUIRED

OBSOLETE

SIZE		ISSUE 10-28-37	A.E.
KIND	IRON CASTING	CHANGED	
SHAPE		"	
FINISH	KRIST. #55	"	
TEMP.		"	
PATT.	7504-1173	"	

TITLE: VERTICAL WALL FRAME
PANEL FRAME LOWER SUPPORT-RIGHT

H. G. FISCHER & CO.
2335 WABANSIA AVE.
CHICAGO, ILL.

CAT. NO.

PART NO. 11089F

OBSOLETE

SCALE: 2"=1'

SIZE		ISSUED 5-27-40	J.W.
KIND		CHANGED	
SHAPE		"	
FINISH		"	
TEMP.		"	
PATT.		"	

TITLE:
FISCHER "DS-50" TABLE TOP

H. G. FISCHER & CO.
2333 WABANSIA AVE.
CHICAGO, ILL.

CAT. NO.

PART NO. 11093

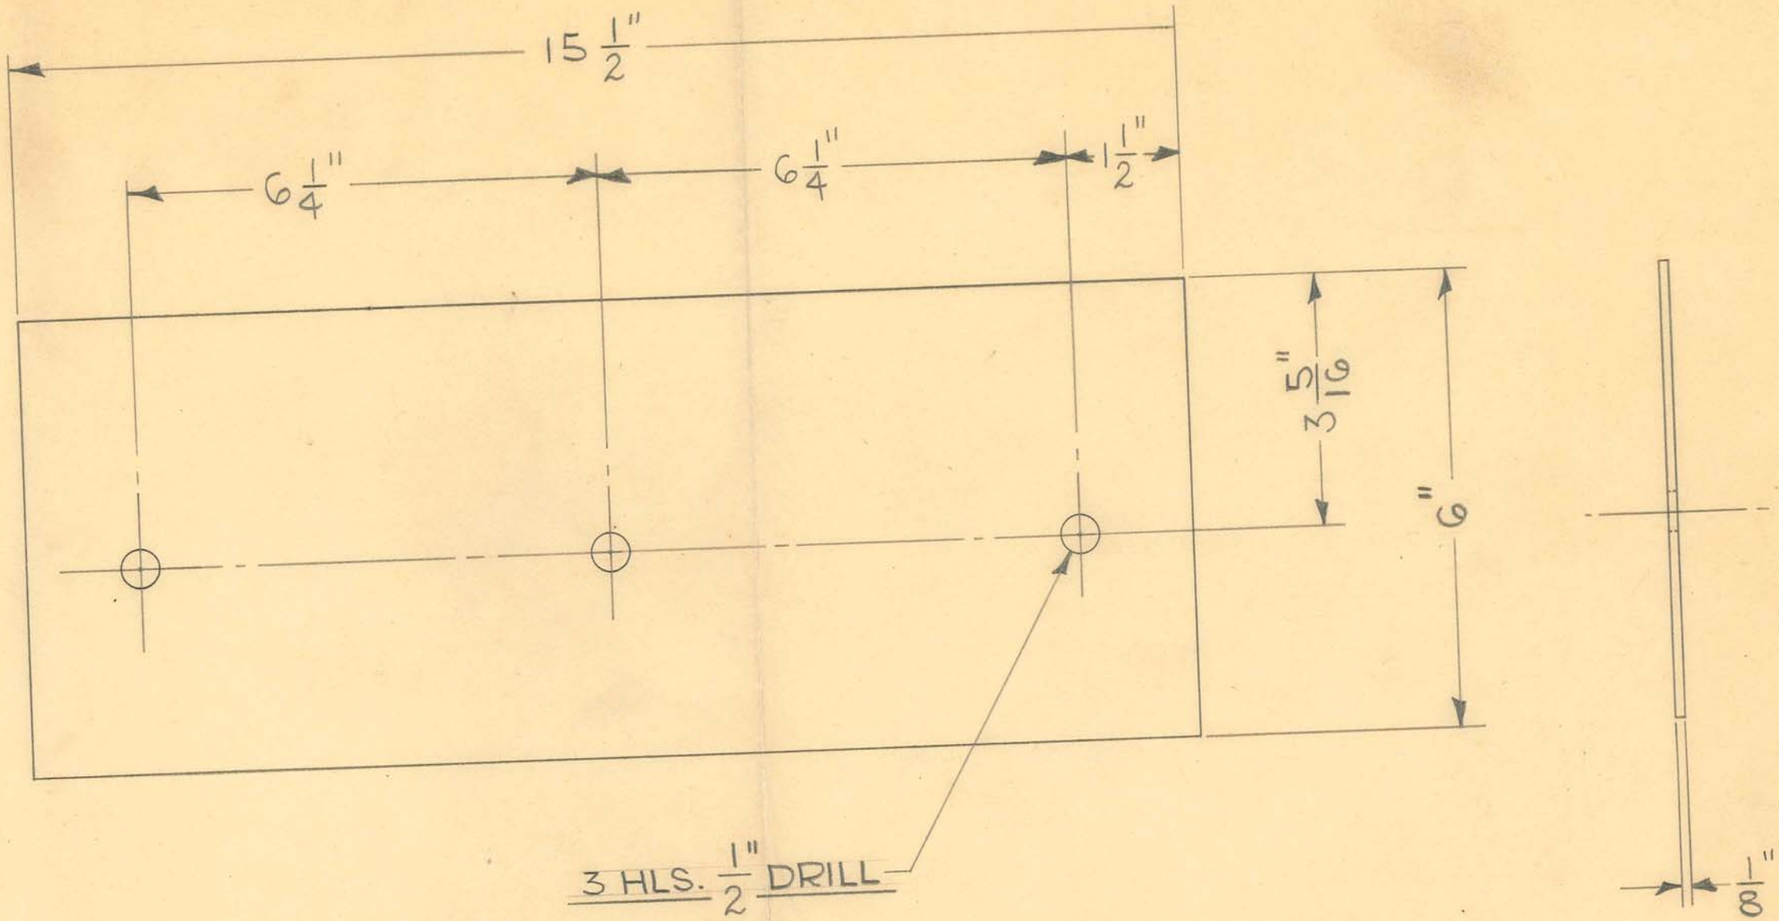

1 REQUIRED FOR 17" BUCKY
2 REQUIRED FOR 36" BUCKY

SCALE - HALF SIZE
WEIGHT - 5 1/4 LB.

OBSOLETE

DRILL JIG TOOL # 9836

SIZE	1/8" SHEET	ISSUE 6-8-48	W.J.
KIND	LEAD	CHANGED	
SHAPE		"	
FINISH		"	
TEMP.		"	
PATT.		"	

DIMENSIONS
FRACTIONAL ± .015
DECIMAL ± .005
ANGULAR ± 1/2°
UNLESS OTHERWISE SPECIFIED

TITLE:
FISCHER RADIOGRAPHIC TILT TABLE
C'WEIGHT - TOP

H. G. FISCHER & CO.
2338 WABANSIA AVE.
CHICAGO, ILL.

CAT. NO.

PART NO. 10187

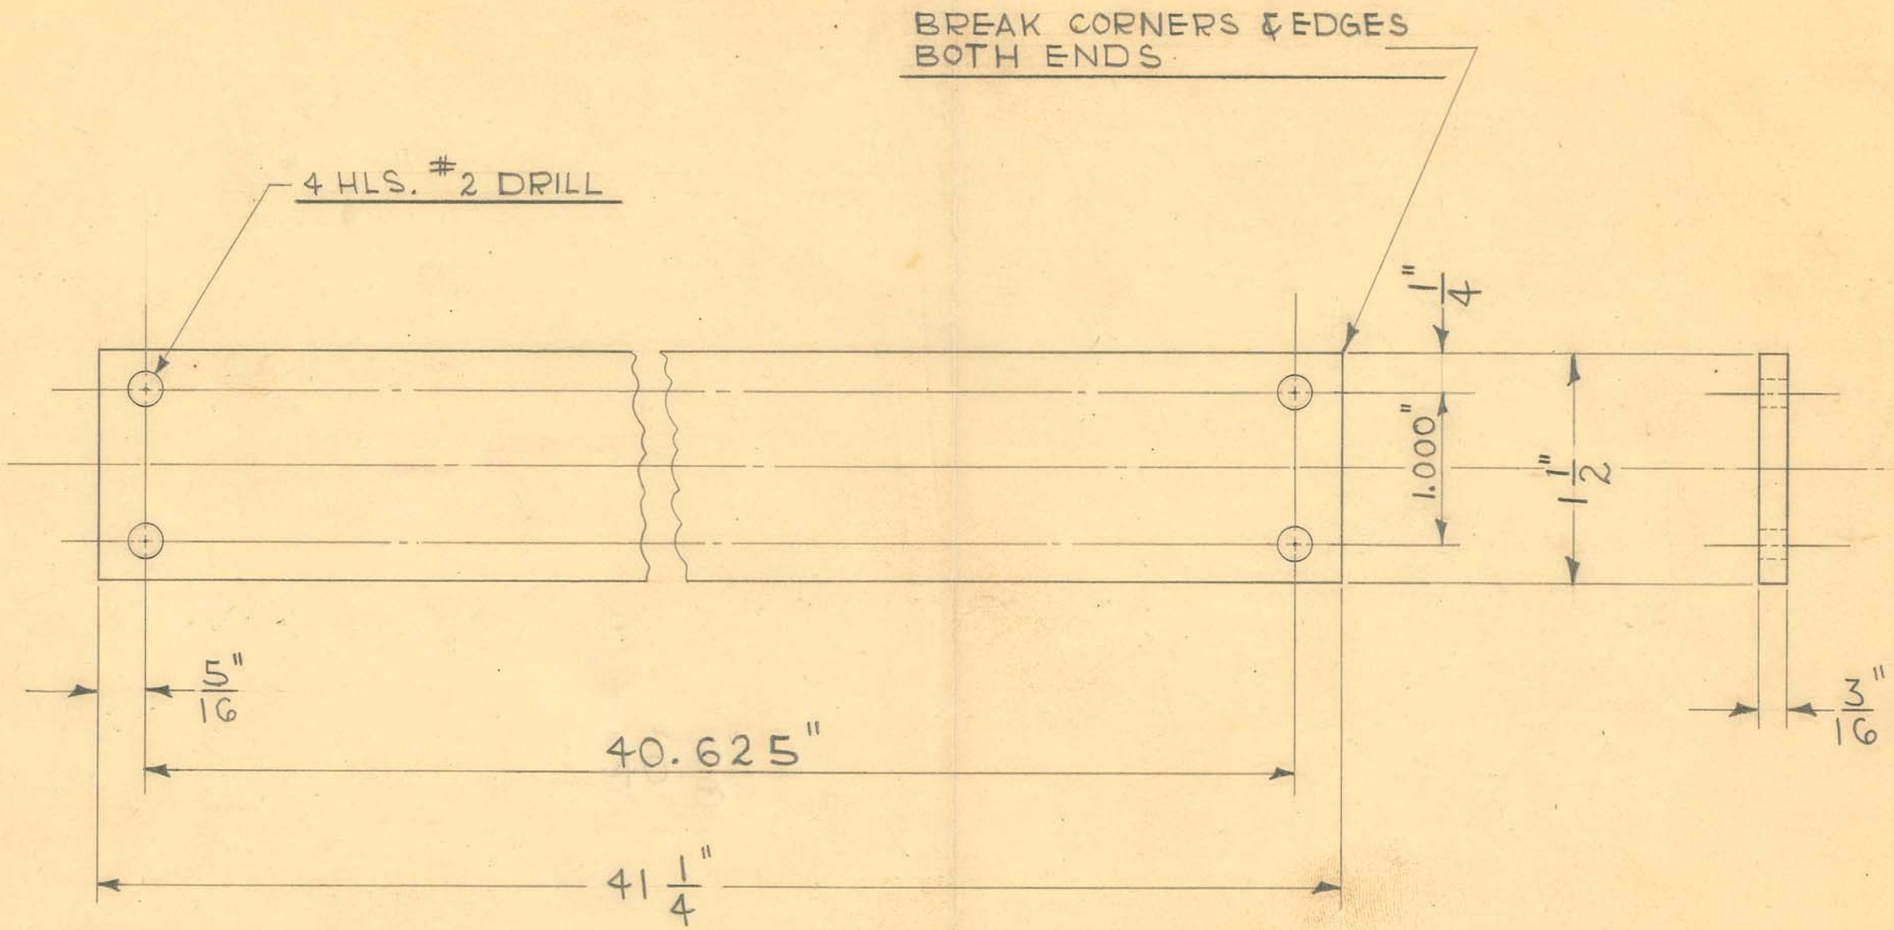

OBSOLETE

Obsolete

2 REQUIRED

DRILL JIG TOOL #9837

SIZE	3/16" X 1 1/2"	ISSUE 6-10-48	W.J.
KIND	ALUM.	CHANGED	
SHAPE	BAR	"	
FINISH		"	
TEMP.		"	
PATT.		"	

DIMENSIONS
FRACTIONAL ± .015
DECIMAL ± .005
ANGULAR ± 1/2°
UNLESS OTHERWISE SPECIFIED

TITLE:
FISCHER RADIOGAPHIC TILT TABLE
BUCKY C'WEIGHT CHAIN SUPP. TIE ROD

H. G. FISCHER & CO.
2338 WABANSIA AVE.
CHICAGO, ILL.

CAT. NO.

PART NO. 10188

#1620 MAHOGANY
POLISHED FINISH

$\frac{3}{64}$" STRIPE — ENGRAVED LINE
FILLED WITH WHITE NON METALIC
FILLER

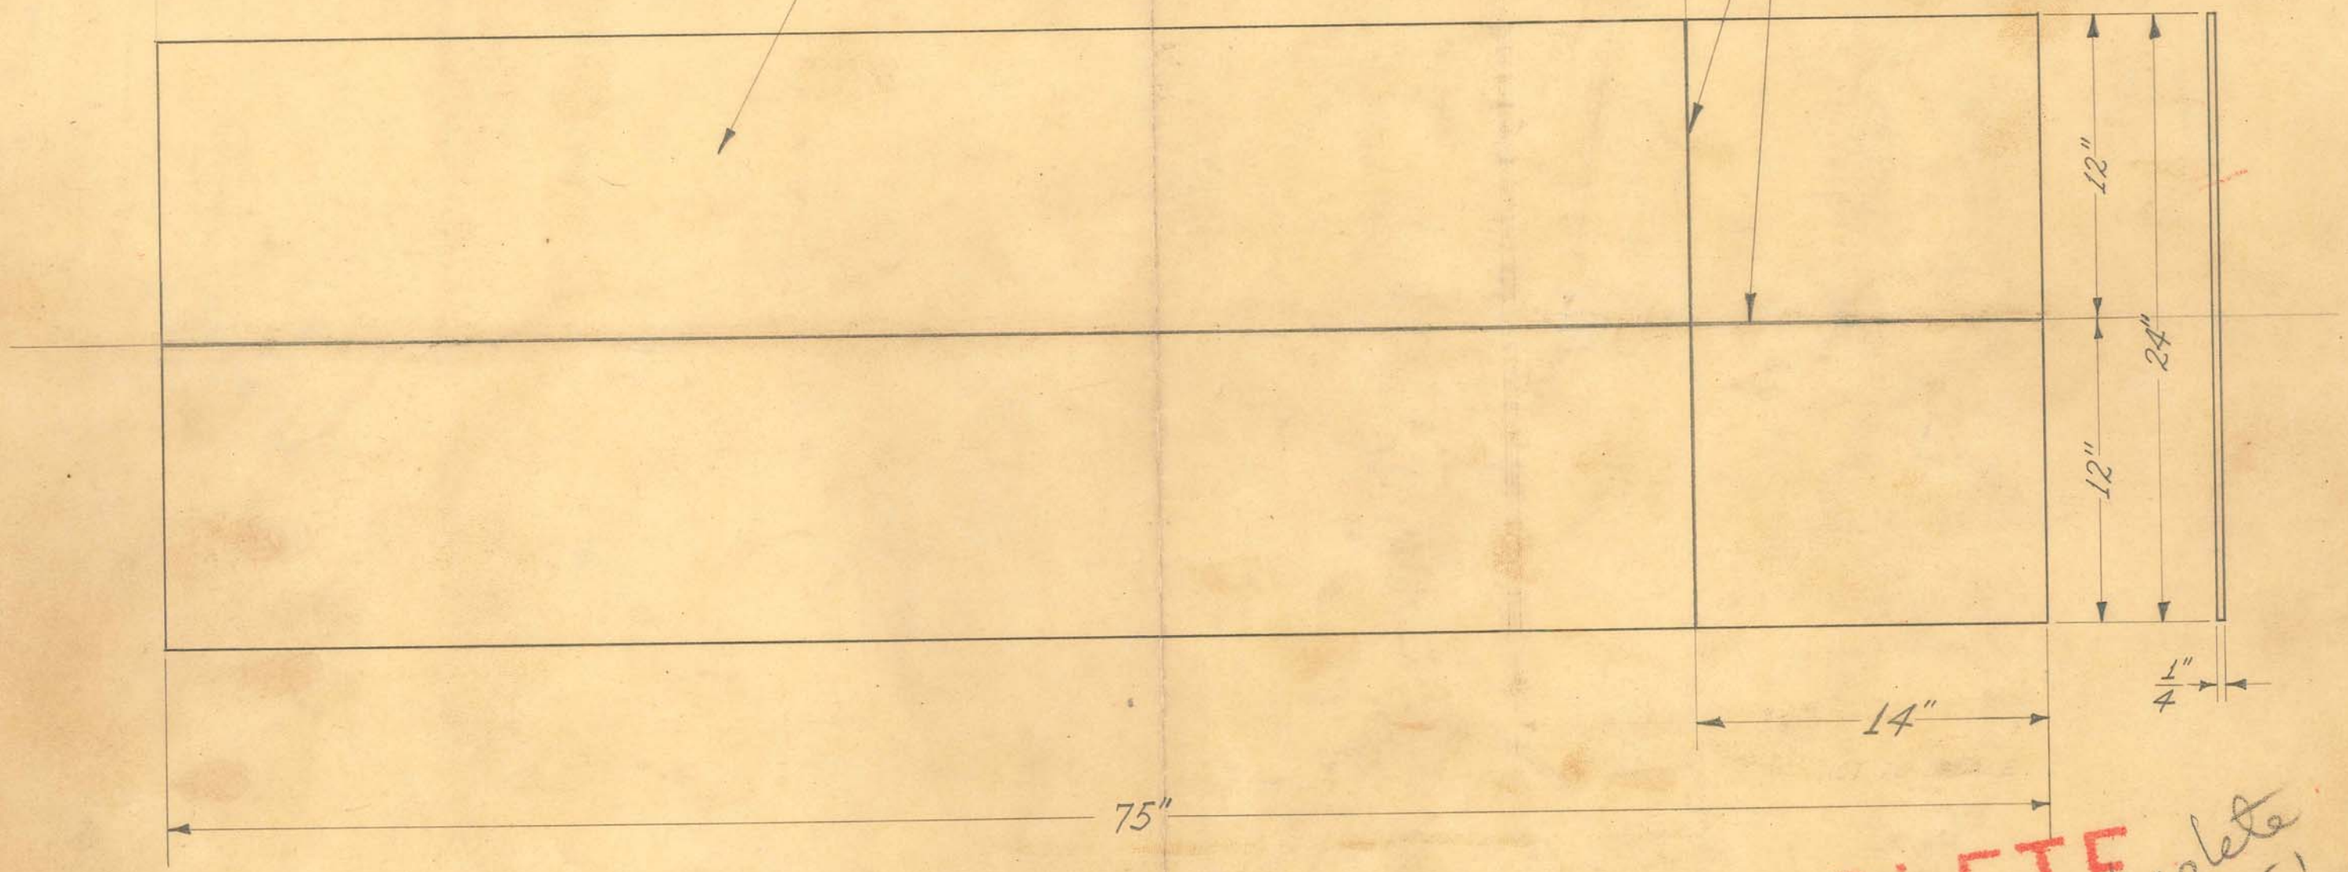

XX BLACK BAKELITE

OBSOLETE

Obsolete
1-24-51

SCALE ~ 2" = 1'-0"

SIZE		ISSUE 5-7-40	J.W.
KIND		CHANGED	
SHAPE		"	
FINISH		"	
TEMP.		"	
PATT.		"	

TITLE: FISCHER RAD. & FLUO. TILT TABLE TOP

H. G. FISCHER & CO.
2335 WABANSIA AVE.
CHICAGO, ILL.

CAT. NO.

PART NO. 10224B

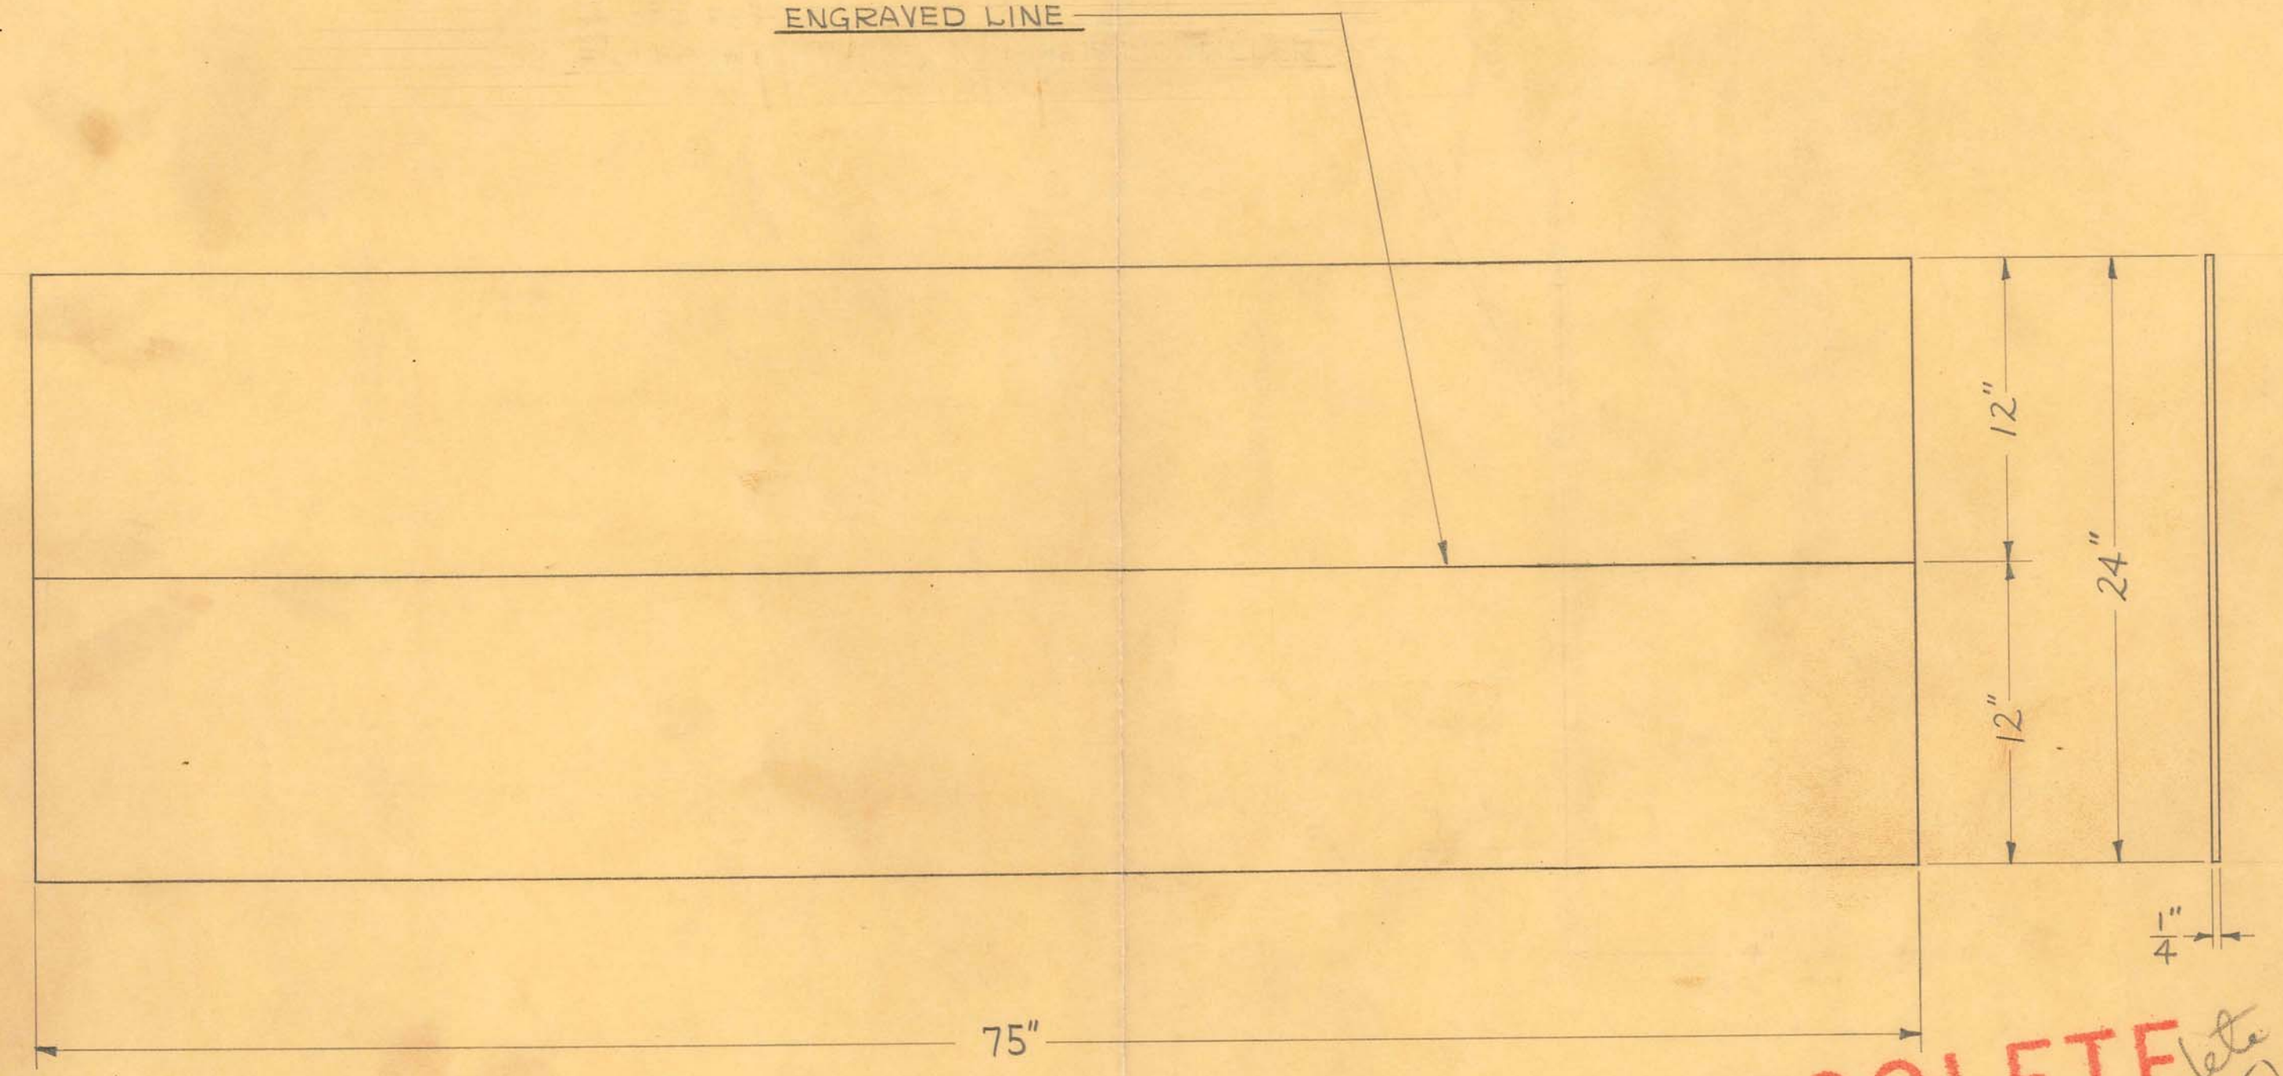

OBSOLETE
Obsolete
1-24-51

XX BLACK BAKELITE

SATIN FINISH - BOTH SIDES

SCALE ÷ 2" = 1'-0"

SIZE		ISSUE 3-18-46	J.V.W.	TITLE: FISCHER RAD. & FLUO. TILT TABLE TOP
KIND		CHANGED		
SHAPE		" 5-13-46	J.V.W.	
FINISH		"		
TEMP.		"		
PATT.		"		

H. G. FISCHER & CO.
2335 WABANSIA AVE.
CHICAGO, ILL.

CAT. NO.

PART NO. 10224 1/2

10224 1/2

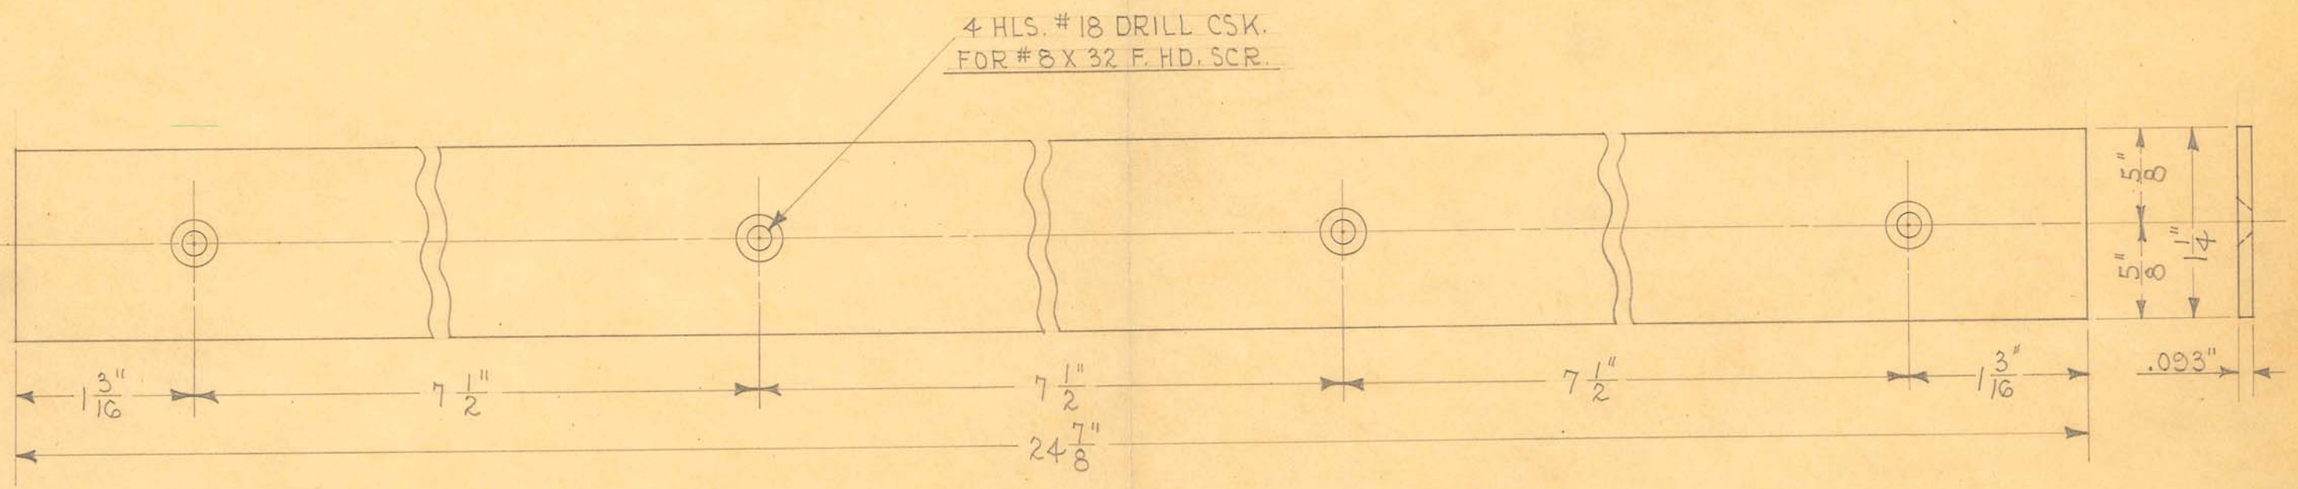

2 REQUIRED

obsolete
1-24-51

DRILL JIG # 5293
MILLING GAGE # 5342
GAUGE # 3337

SIZE	.093" X 1 1/4"	ISSUE 11-4-36	A.E.
KIND	C.R. STEEL	CHANGED	
SHAPE		"	
FINISH	PAINTED	"	
TEMP.		"	
		"	

TITLE: TILT TABLE END STRIP

OBSOLETE

H. G. FISCHER & CO.
2335 WABANSIA AVE.
CHICAGO, ILL.

CAT. NO.

PART NO. 10245

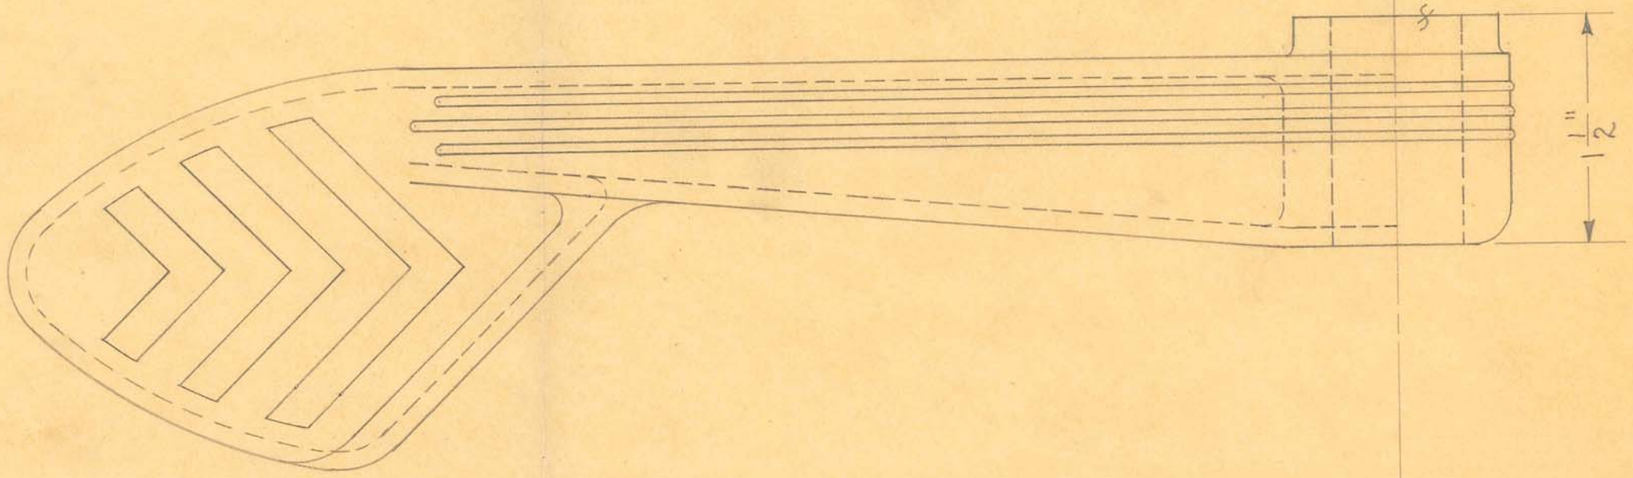

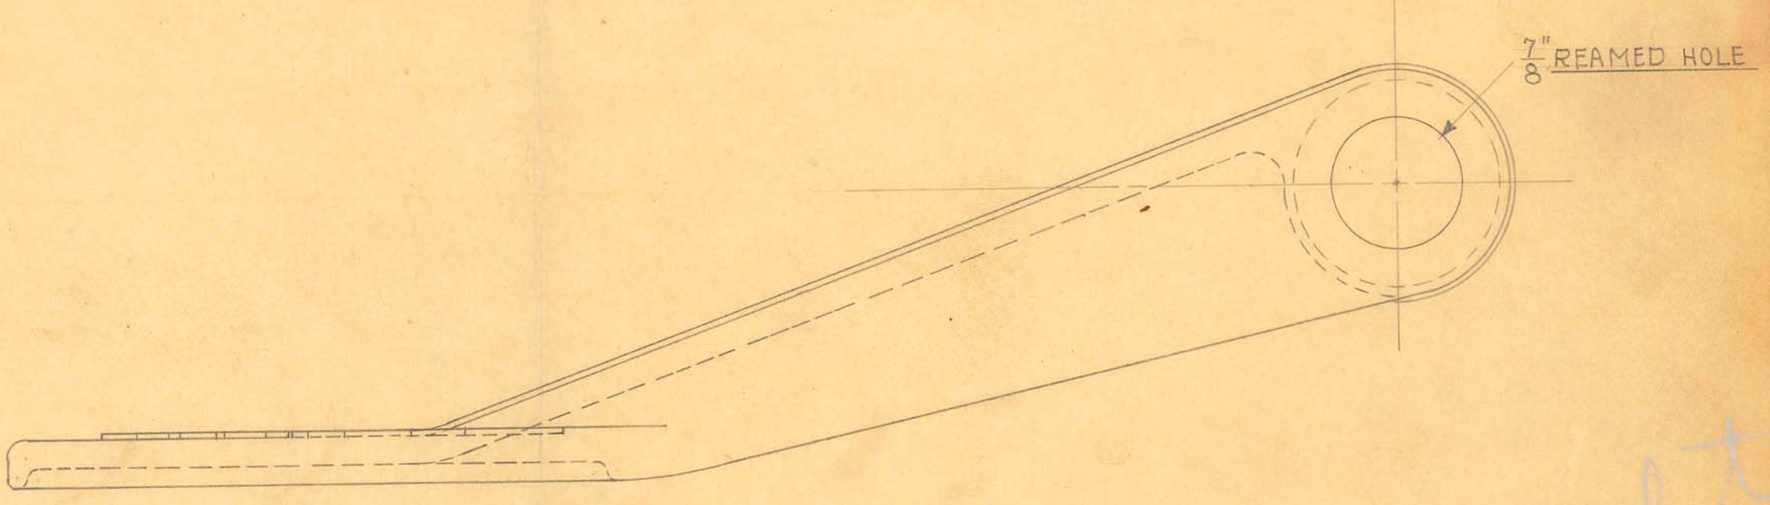

1 REQUIRED

SIZE		ISSUE 11-17-36	A.E.
KIND	IRON CASTING	CHANGED	
SHAPE		"	
FINISH	CHROME #2 KRIST. #55	"	
TEMP.		"	
PATT.	5517-1009	"	

TITLE: TILT TABLE QUADRANT LOCK LEVER PEDAL

OBSOLETE

H. G. FISCHER & CO.
2335 WABANSIA AVE.
CHICAGO, ILL.

CAT. NO.

PART NO. 10262F

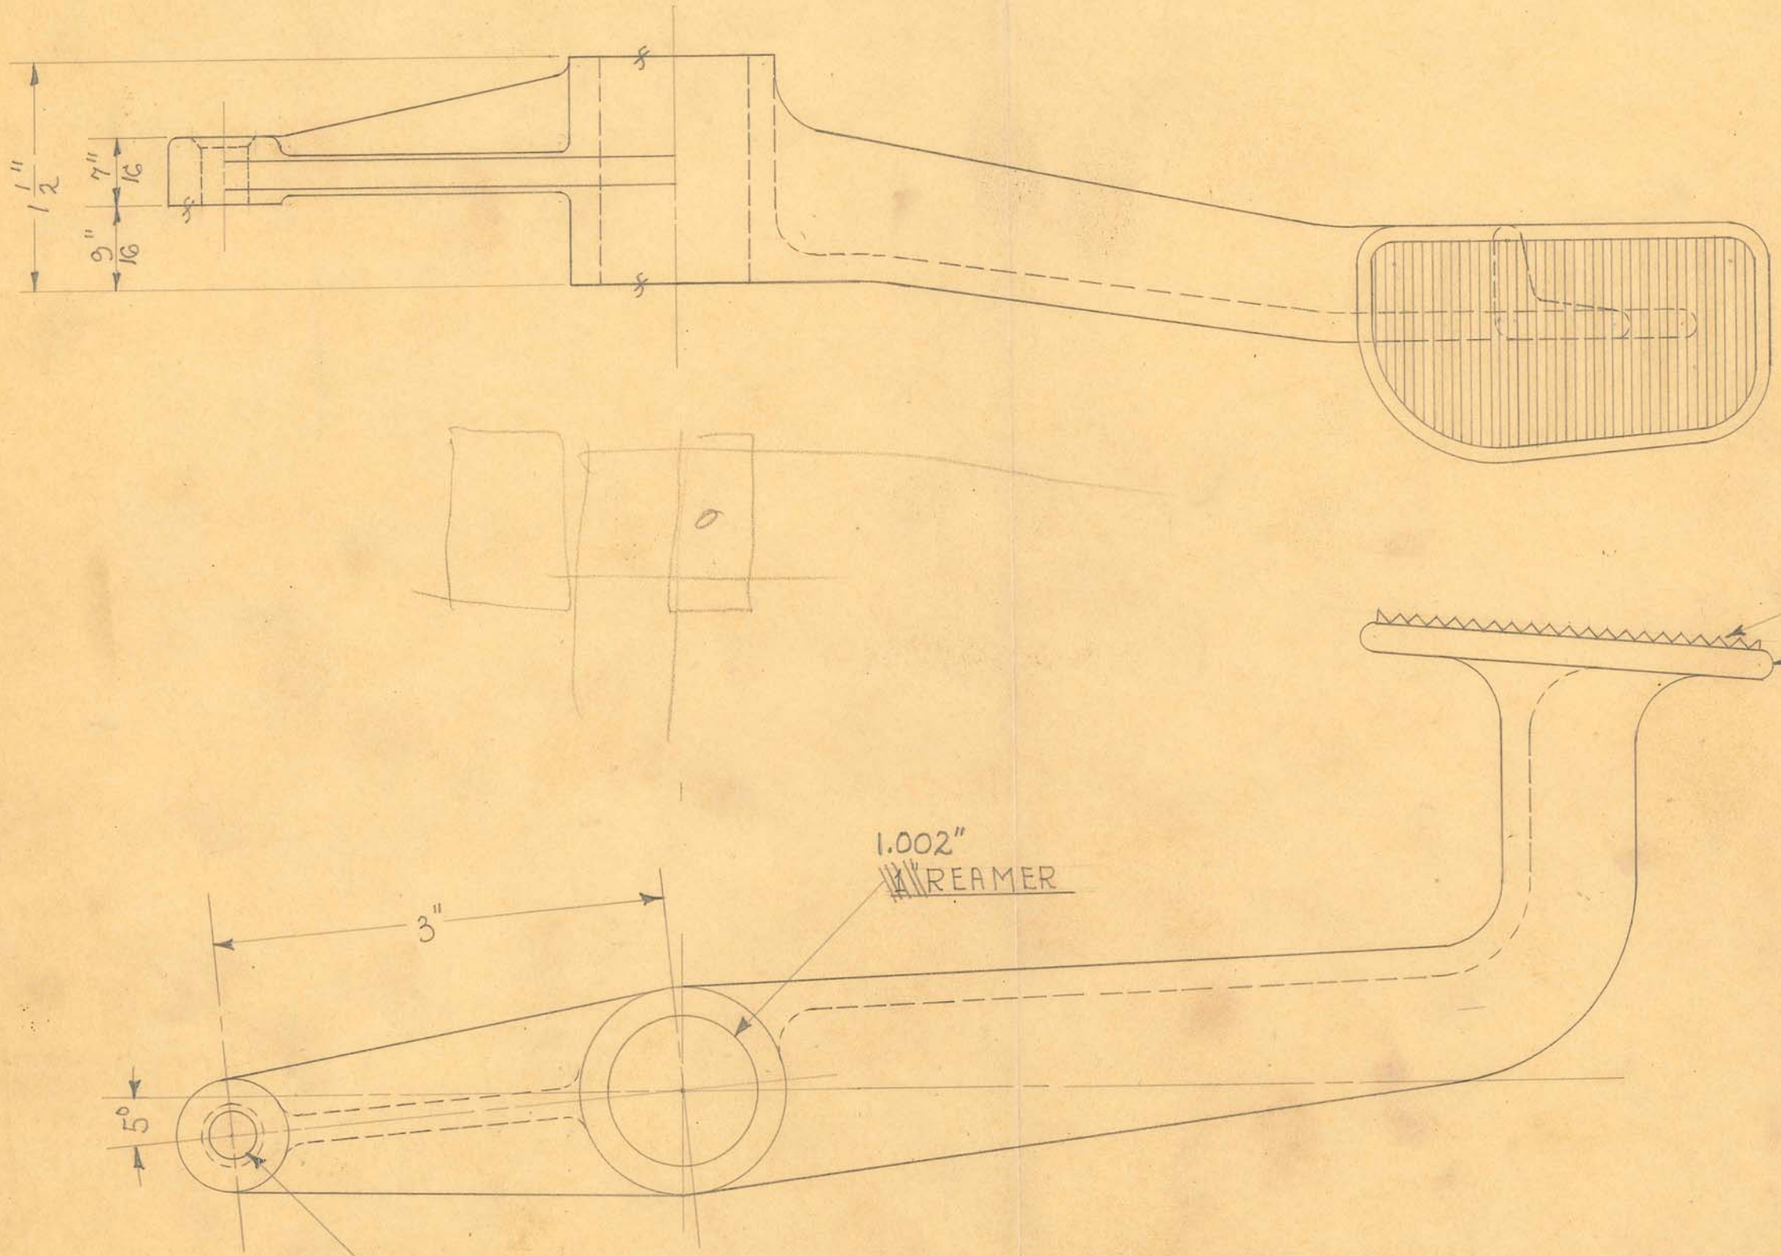

1 REQUIRED

SIZE		ISSUE 6-17-37	A.E.
KIND	IRON CASTING	CHANGED	
SHAPE		"	
FINISH	CHROME #4 KRIST. #55	"	
TEMP.		"	
PATT.	2594-1115	"	

TITLE: TILT TABLE QUADRANT LOCK LEVER PEDAL

OBSOLETE

H. G. FISCHER & CO.
2335 WABANSIA AVE.
CHICAGO, ILL.

CAT. NO.

PART NO. 10262AF

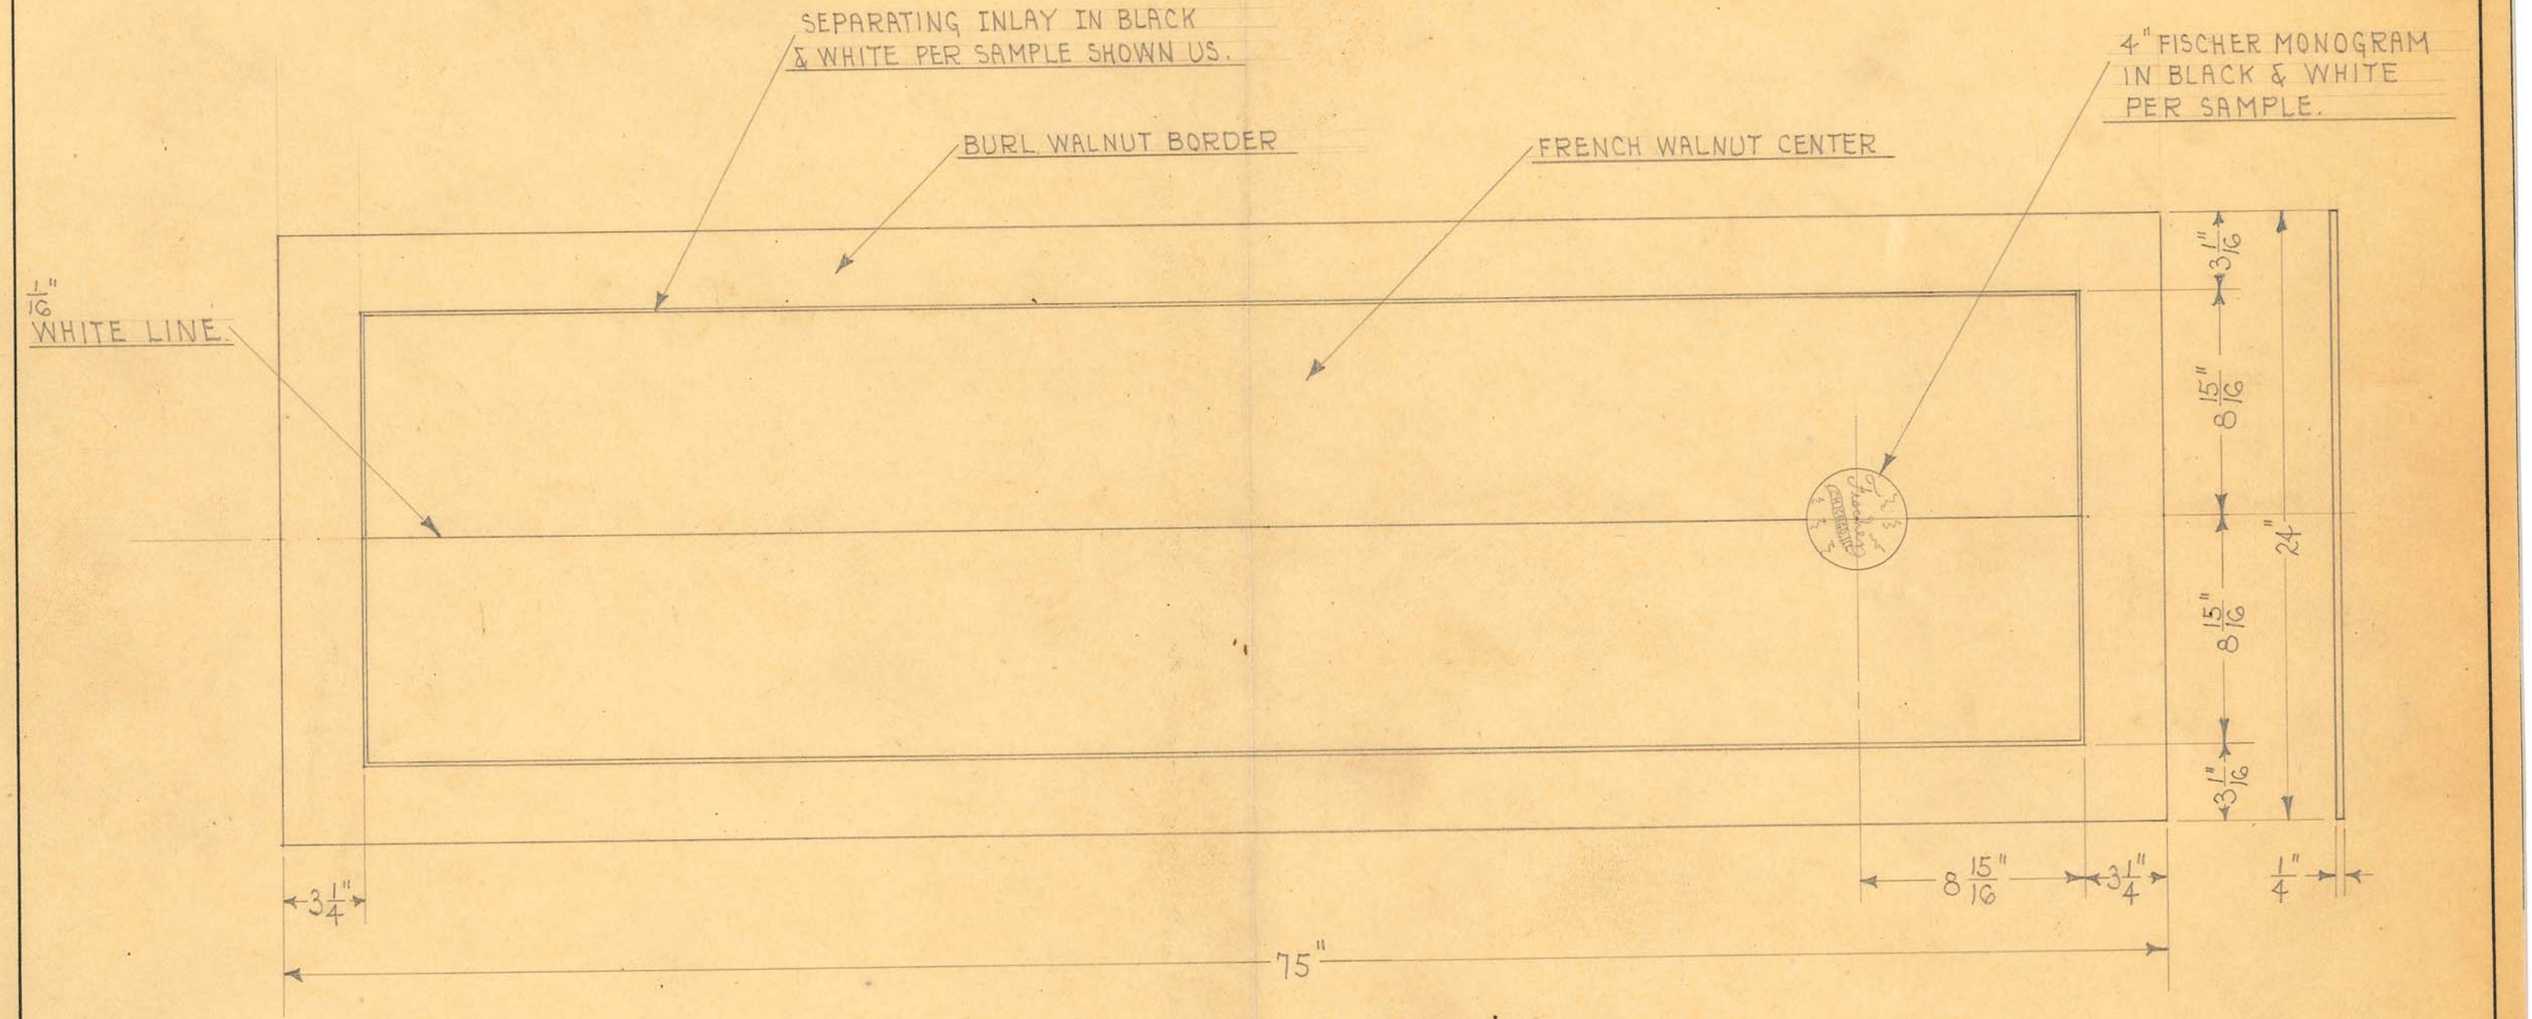

SCALE ÷ 2" = 1'-0"

SIZE	24"X75"X1/4"	ISSUE 10-19-36	A.E.
KIND	TEMPERED	CHANGED	
KIND SHAPE	PRESDWOOD	"	
FINISH		"	
TEMP.		"	
PATT.		"	

TITLE:

TILT TABLE TOP

OBSOLETE

H. G. FISCHER & CO.
2335 WABANSIA AVE.
CHICAGO, ILL.

CAT. NO.

PART NO. 10303

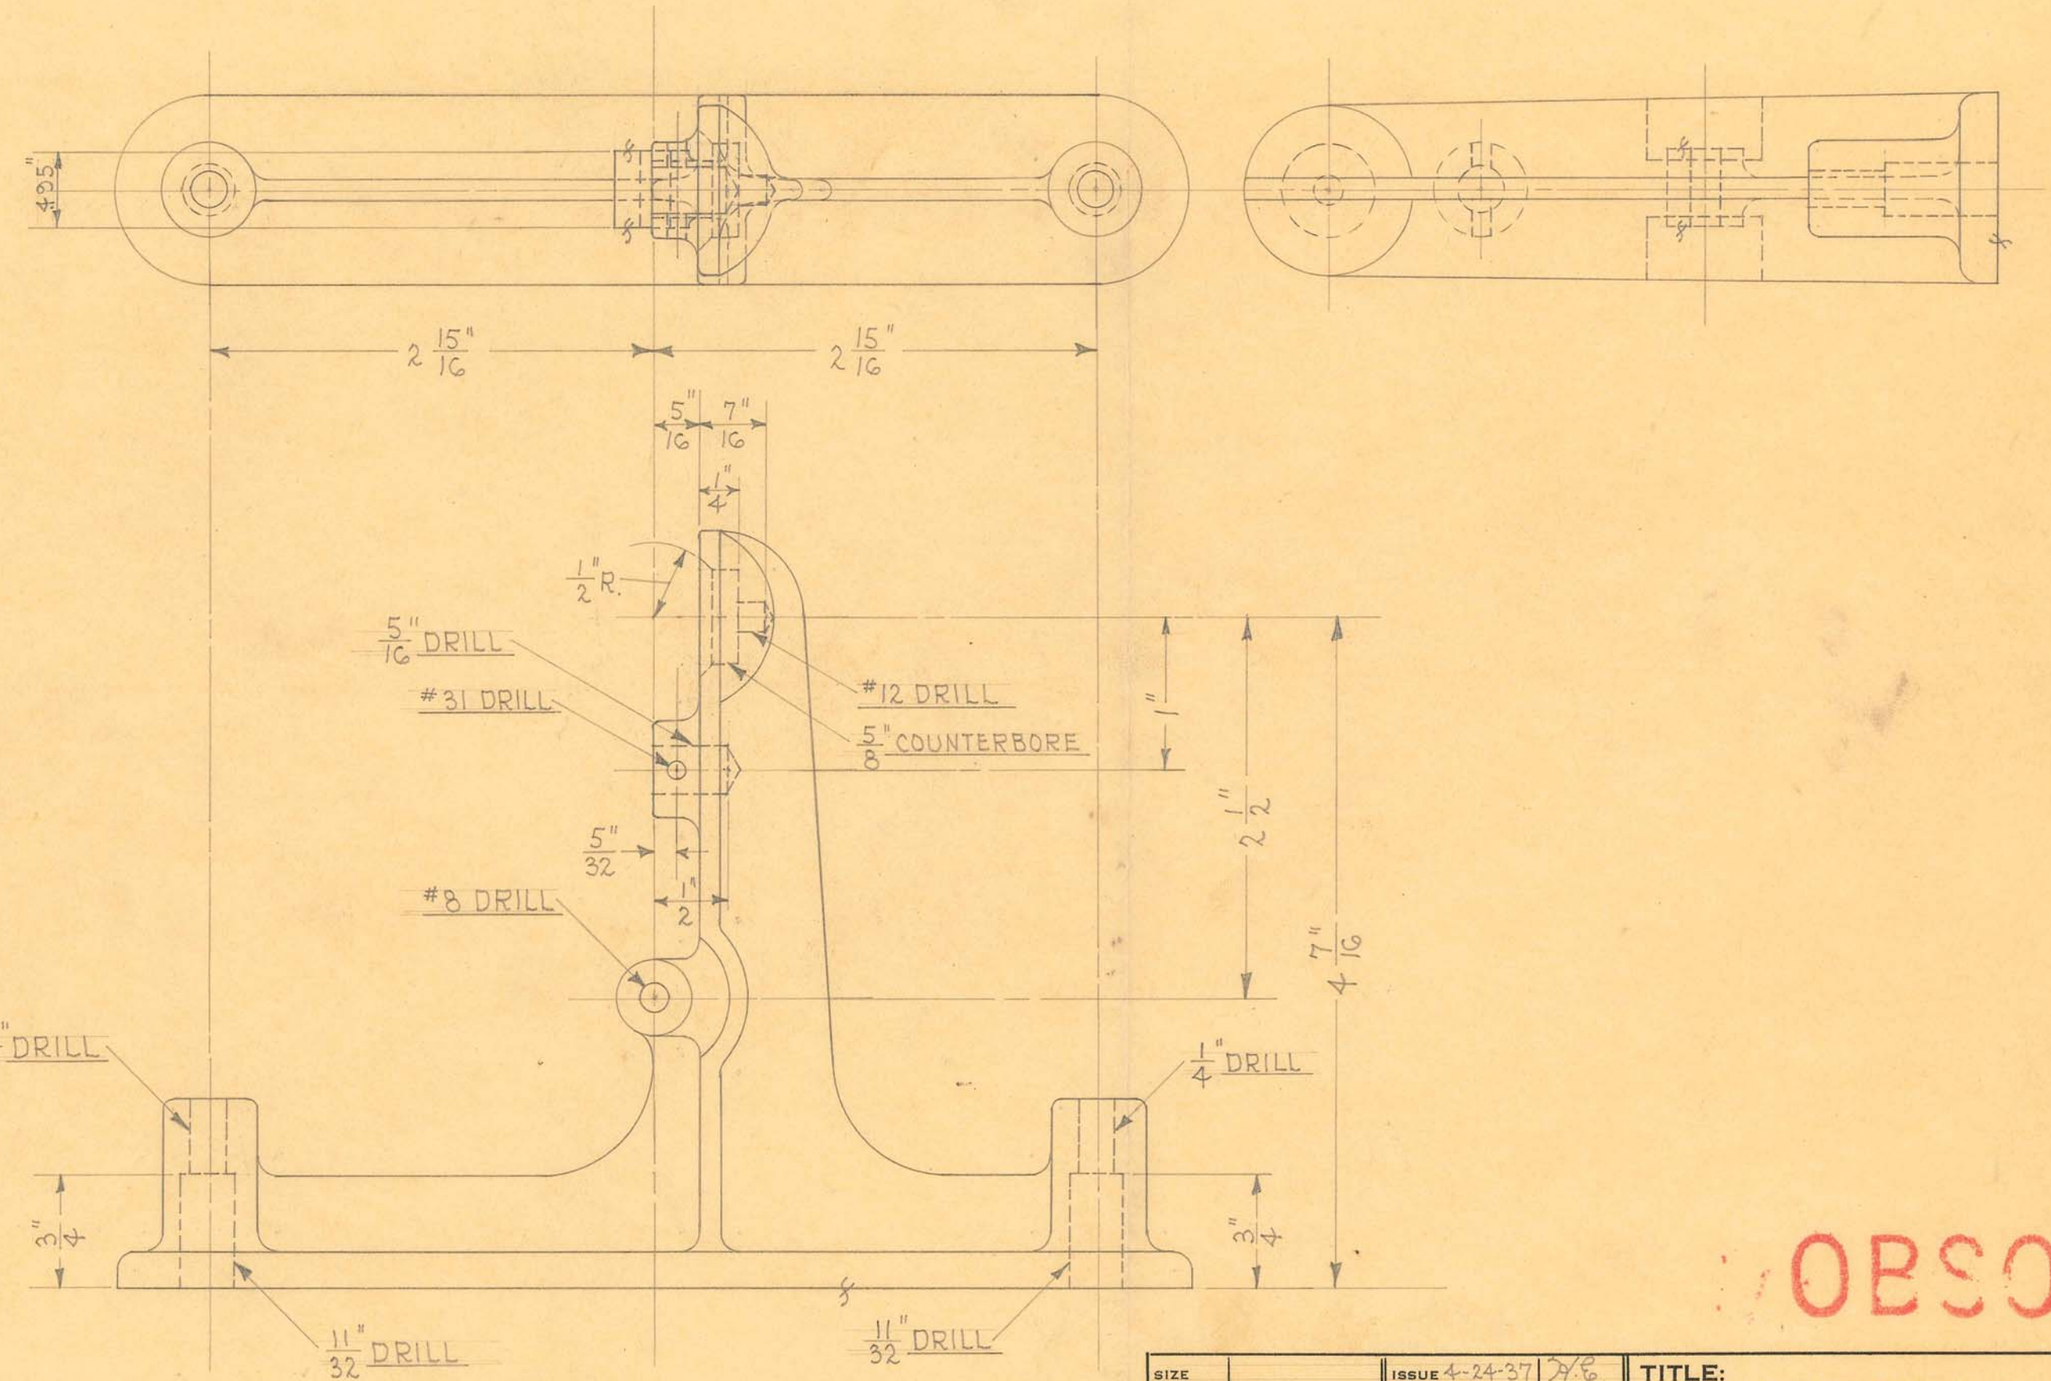

2 REQUIRED

OBSOLETE

SIZE		ISSUE 4-24-37	A.E.
KIND	ALUM. CASTING	CHANGED	
SHAPE		"	
FINISH	KRISTO #55	"	
TEMP.		"	
PATT.	7228-1039	"	

TITLE: FISCHER RAD. & FLUOROSCOPIC TILT TABLE HEAD & HIP SUPPORT

H. G. FISCHER & CO.
2335 WABANSIA AVE.
CHICAGO, ILL.

CAT. NO.

PART NO. 10309F

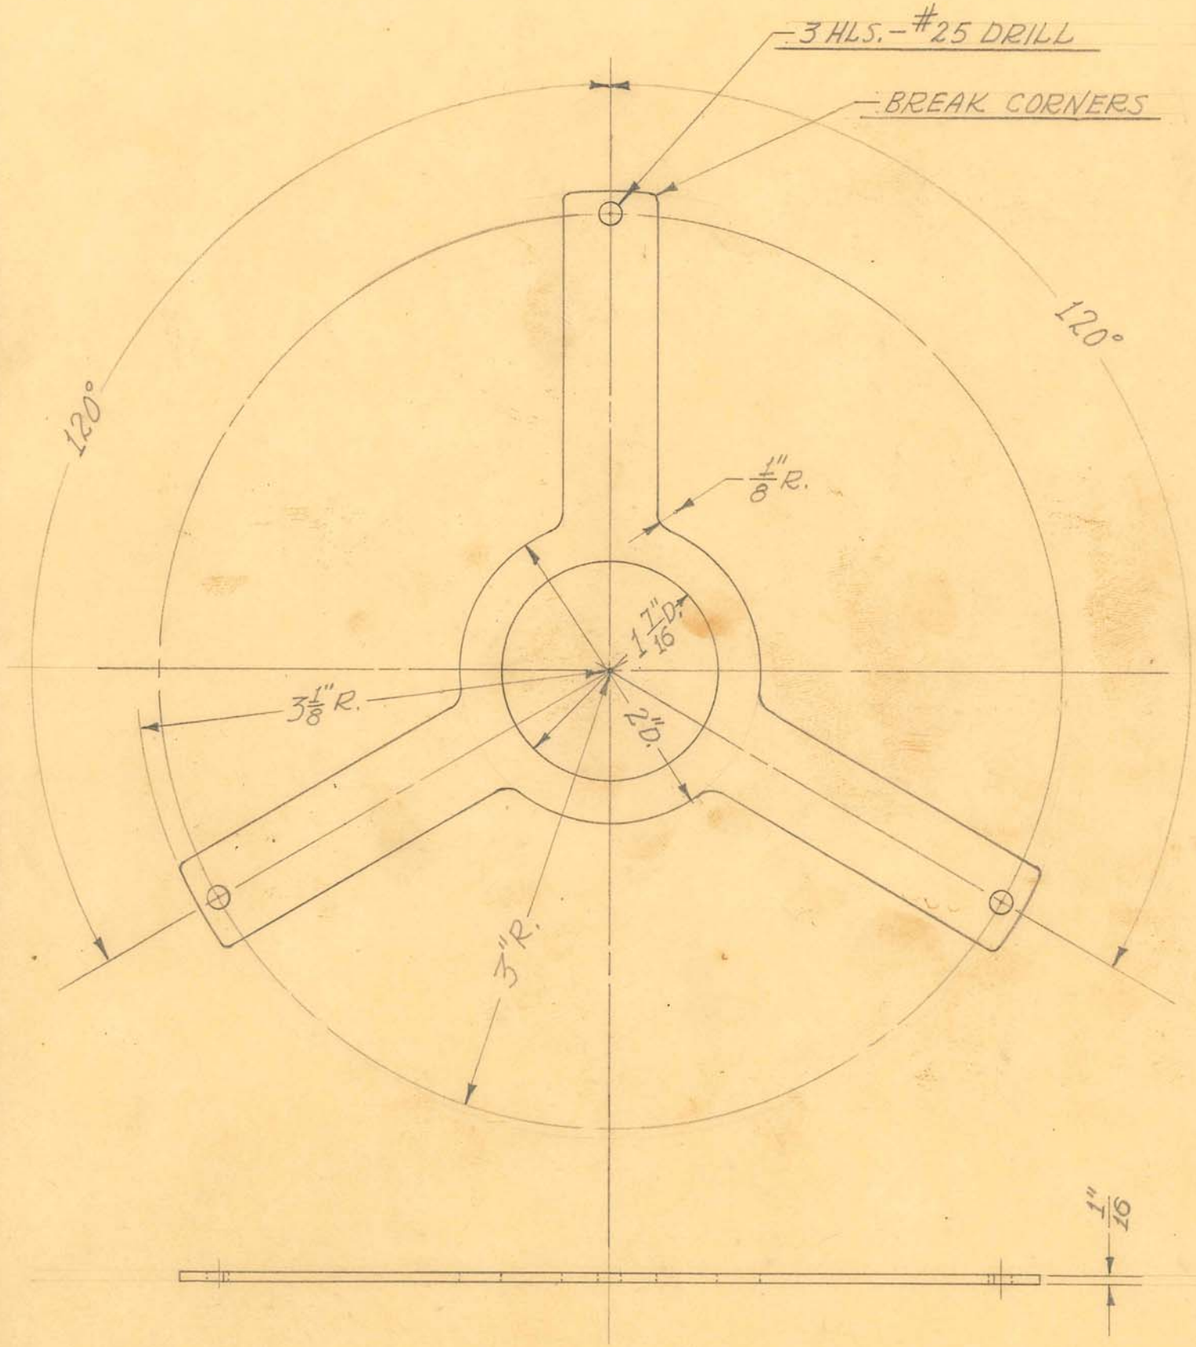

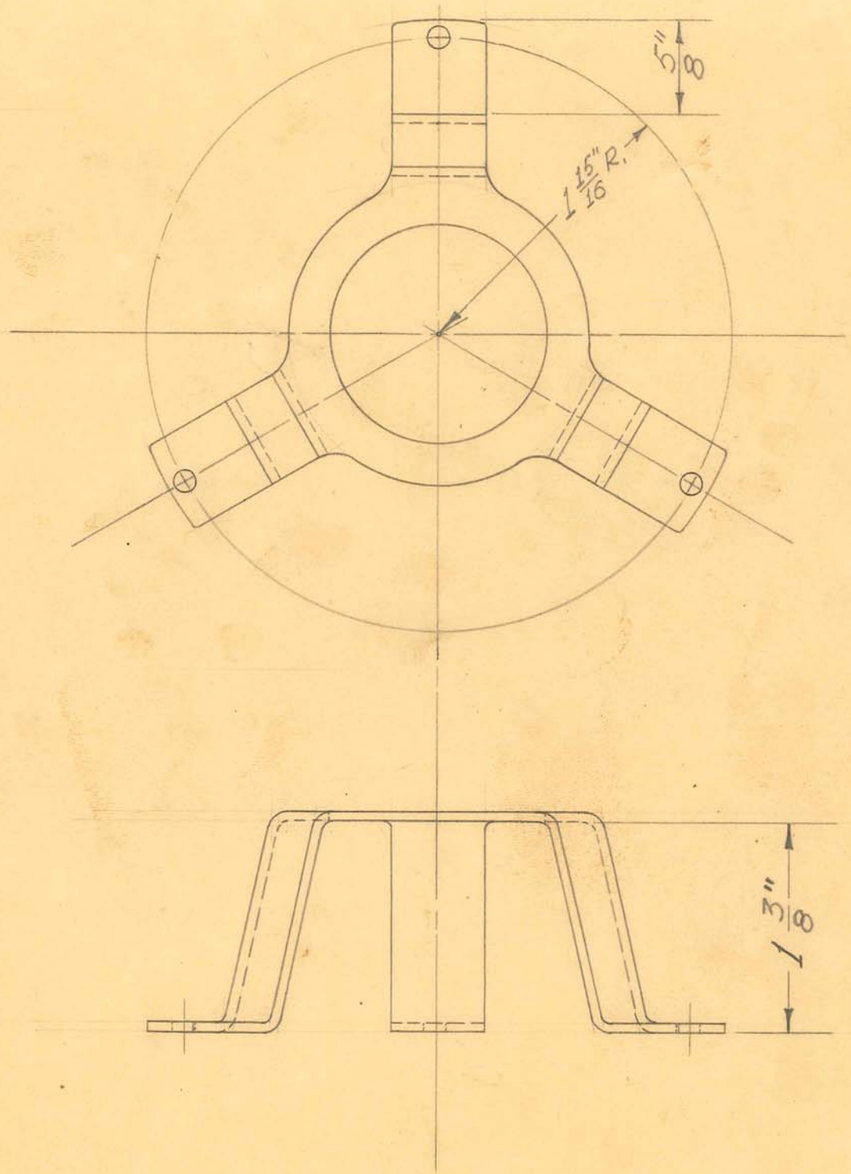

1 REQUIRED

OBSOLETE

SIZE	1/16" SHEET	ISSUE 4-26-39	J.W.
KIND	C.R. STEEL	CHANGED	
SHAPE		"	
FINISH	CAD. #23	"	
TEMP.		"	
PATT.		"	

TITLE: FISCHER INFRA RED LAMP SOCKET MOUNTING

H. G. FISCHER & CO.
2335 WABANSIA AVE.
CHICAGO, ILL.

CAT. NO.

PART NO. 10319

10319

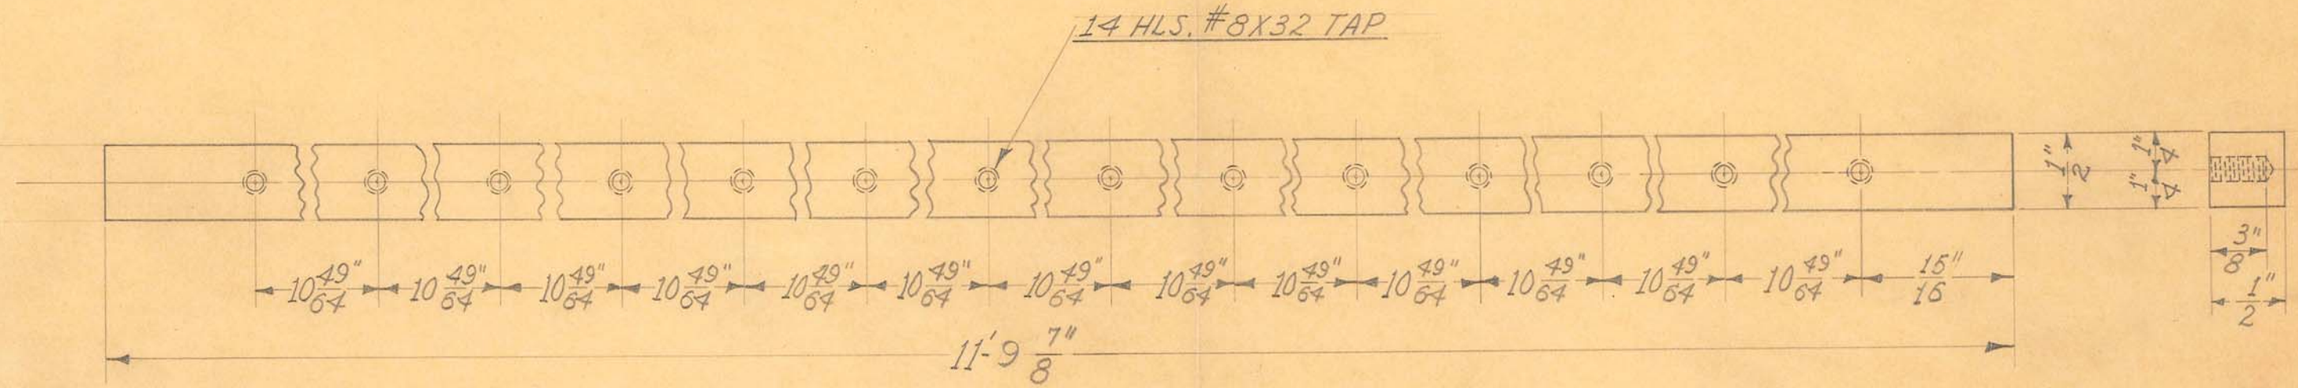

1 REQUIRED

OBSOLETE

SIZE	½" SQ.	ISSUE	1-11-37	J.W.
KIND	C.R. STEEL	CHANGED		
SHAPE		"		
FINISH	CAD. #23	"		
TEMP.		"		
PATT.		"		

TITLE:
FISCHER RAD. & FLUO. TILT TABLE
12 FT. RAIL – TUBE STAND RAIL

H. G. FISCHER & CO.
2335 WABANSIA AVE.
CHICAGO, ILL.

CAT. NO.

PART NO. 10322

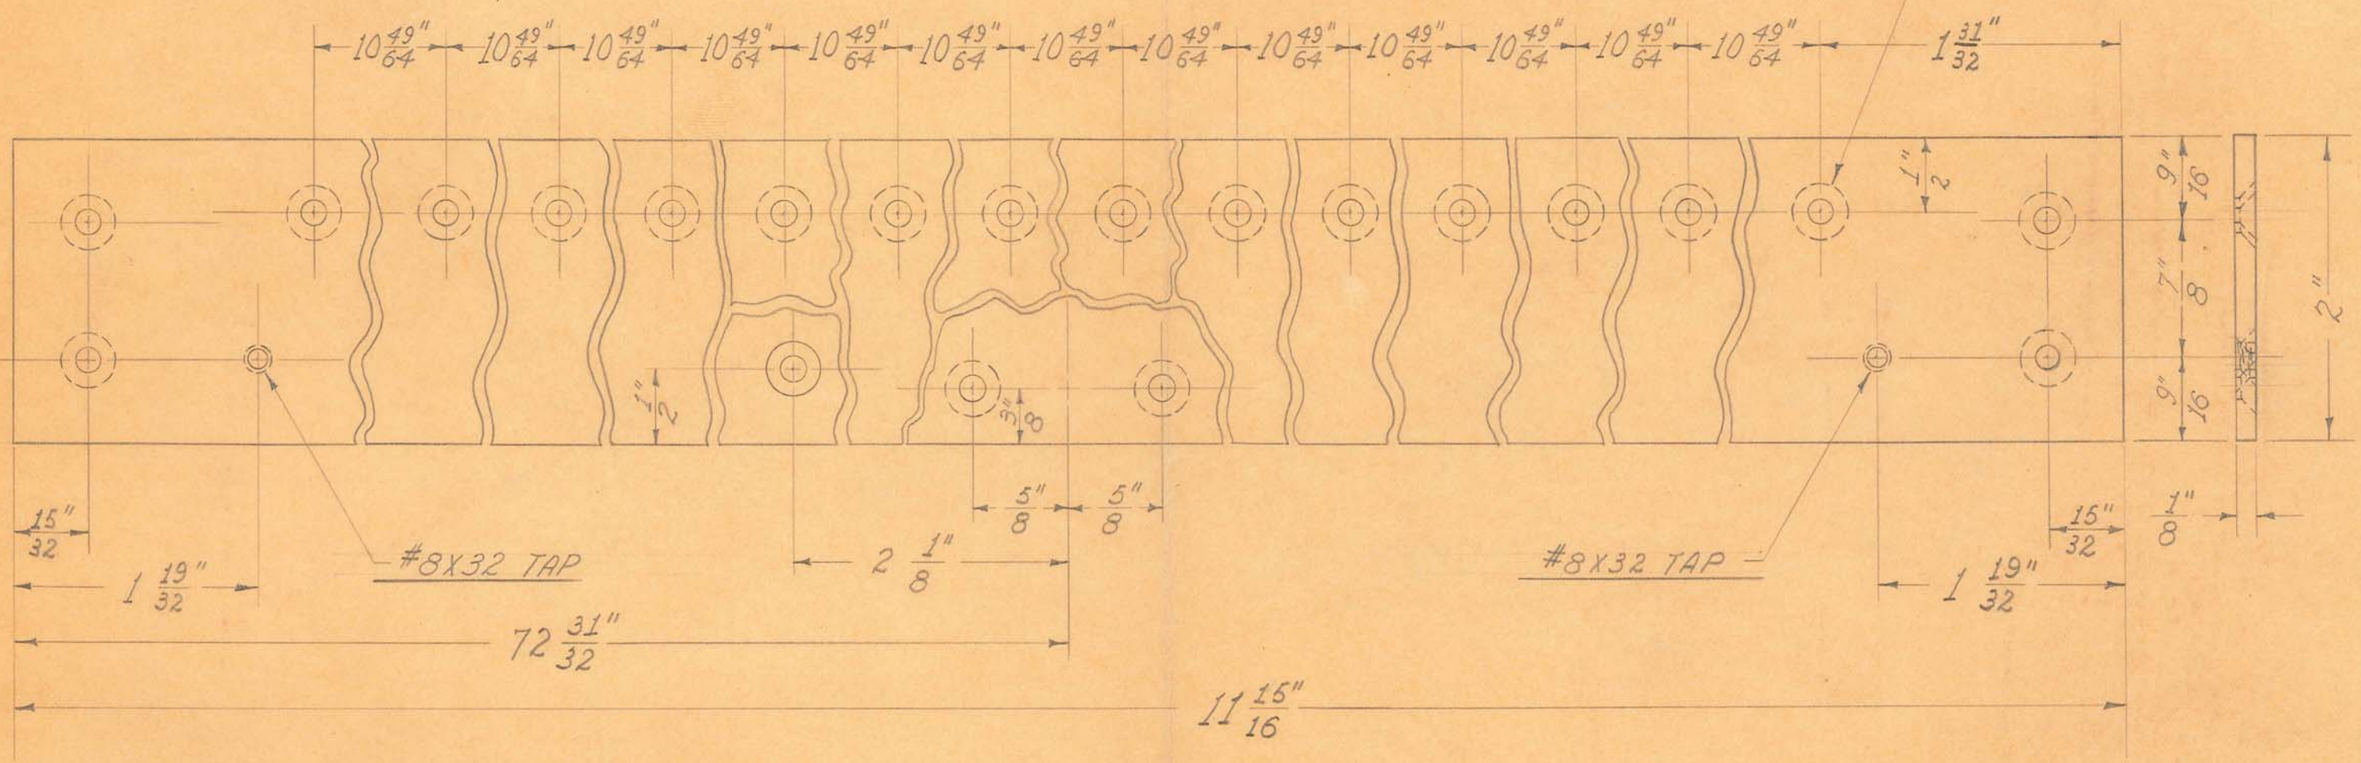

1 REQUIRED

OBSOLETE

SIZE	1/8" X 2"	ISSUE 3-20-37	J.W.
KIND	C.R. STEEL	CHANGED	
SHAPE		"	
FINISH	CAD. & LAC.	"	
[redacted]	#26	"	
PATT.		"	

TITLE: "60-88" & TILT TABLE - 12' RAIL
RAIL PLATE

H. G. FISCHER & CO.
2335 WABANSIA AVE.
CHICAGO, ILL.

CAT. NO.

PART NO. 10323A

595-220

TITLE	H. G. FISCHER & CO.	PART NO.
METER, KILOVOLT	FRANKLIN PARK, ILLINOIS	103-277

PATTERN	FINISH	SCALE FULL
MATERIAL PURCHASED SIMPSON ELECTRIC CO.		
TOOLS		

DATE 6/17/71 | DR. BY AHP | CH'K'D. JMG

DIMENSIONS—UNLESS OTHERWISE SPECIFIED:
FRACTIONAL ± .015 | DECIMAL ± .005 | ANGULAR ± 1/2°
THREAD CHAMFER UP TO 5/16 D. - 1/32 X 45° 3/8 D. & OVER - 1/16 X 45°
REMOVE ALL BURRS & SHARP CORNERS

USED ON	QTY.	USED ON	QTY.
208-408	1		

REVISION	DATE	BY

OBSOLETE
DATE 12-4-71
REFER TO REV. A
FOR DETAILS SEE E. C. O. # 1404
ENGINEER
DRAFTSMAN RS

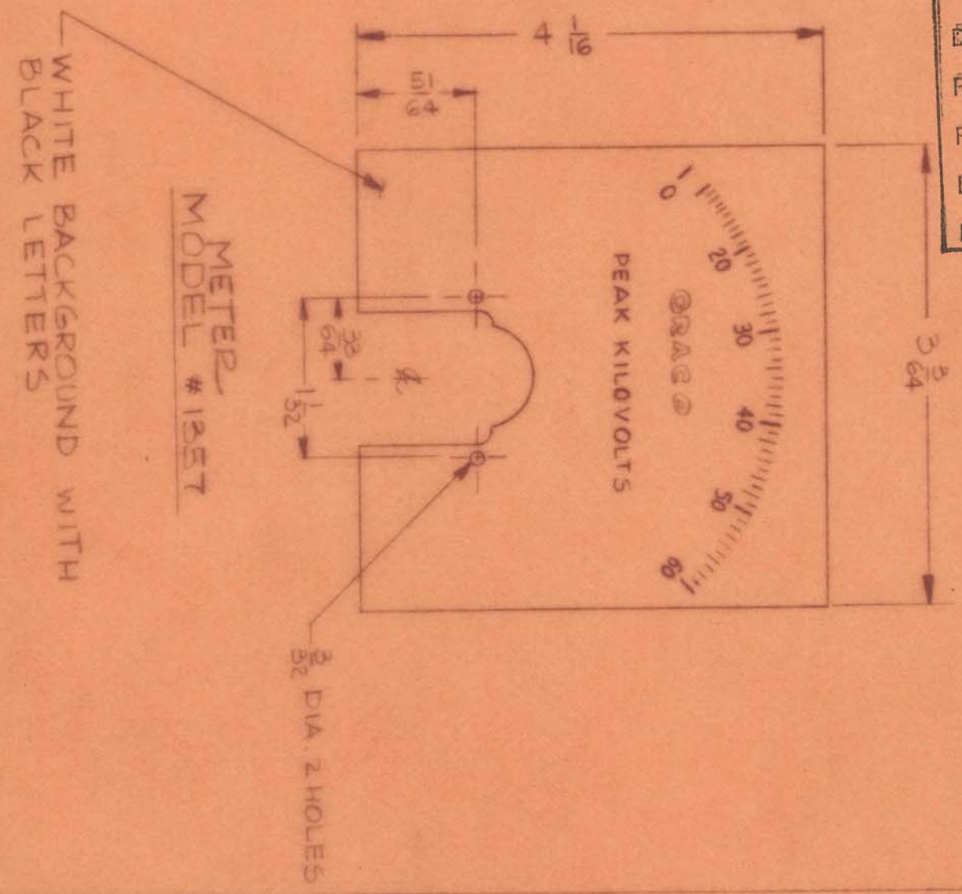

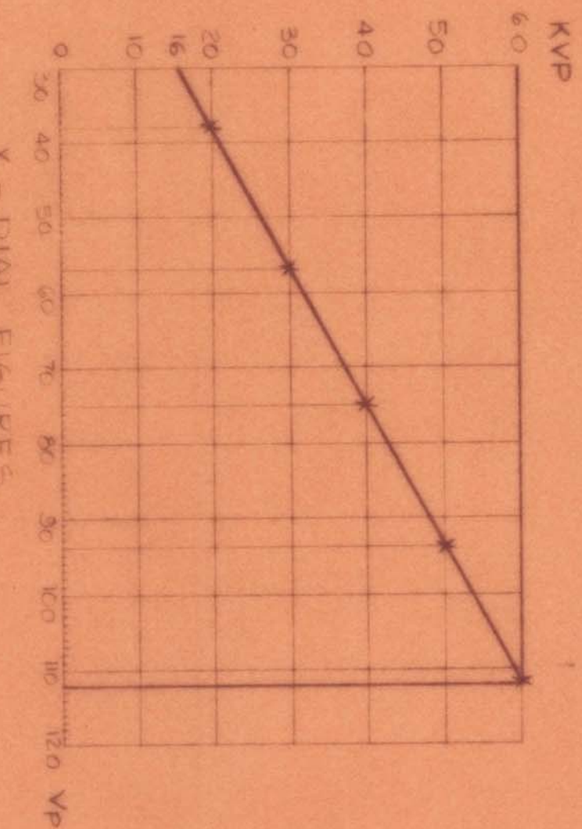

DO NOT SCALE DRAWING.

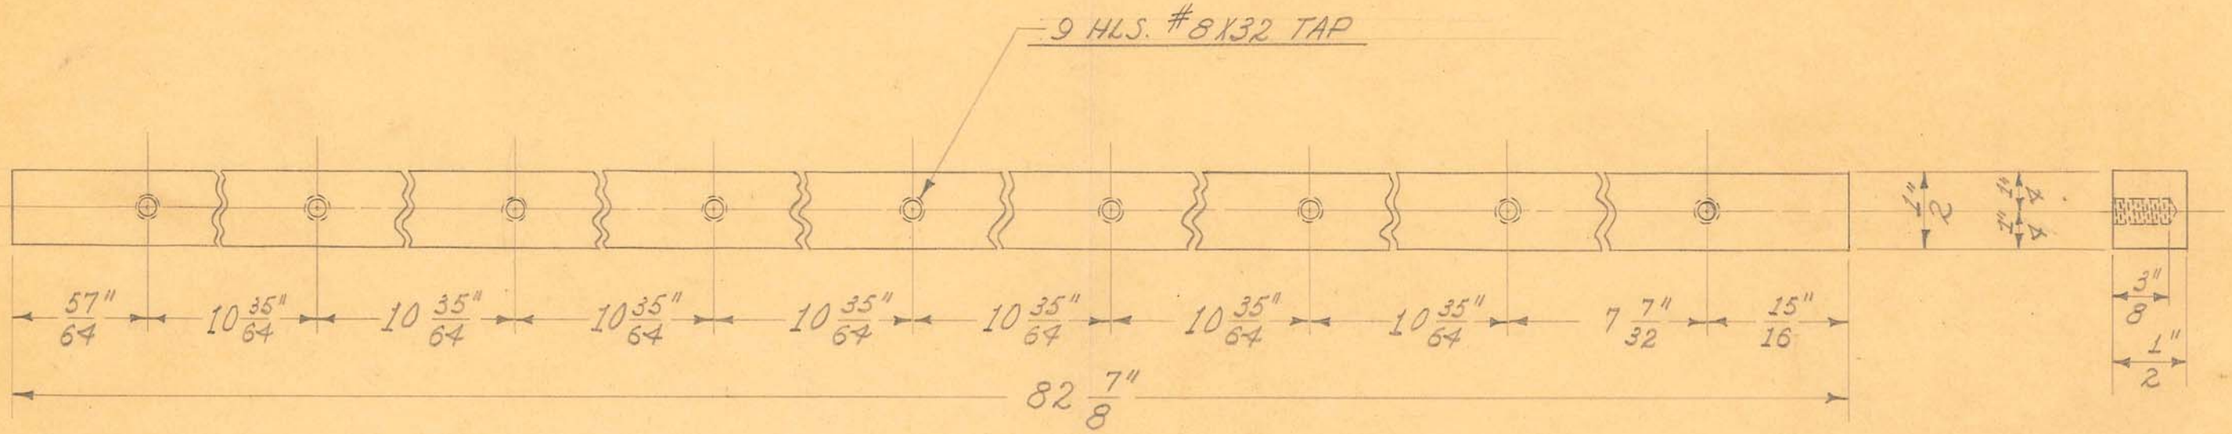

1 REQUIRED

OBSOLETE

SIZE	1/2" SQUARE	ISSUE 8-27-31	J.W.
KIND	C.R. STEEL	CHANGED	
SHAPE		"	
FINISH	CAD. #23	"	
TEMP.		"	
PATT.		"	

TITLE: "60-88" & TILT TABLE - 15' RAIL EXTENSION - RAIL

H. G. FISCHER & CO.
2335 WABANSIA AVE.
CHICAGO, ILL.

CAT. NO.

PART NO. 10328 1/2

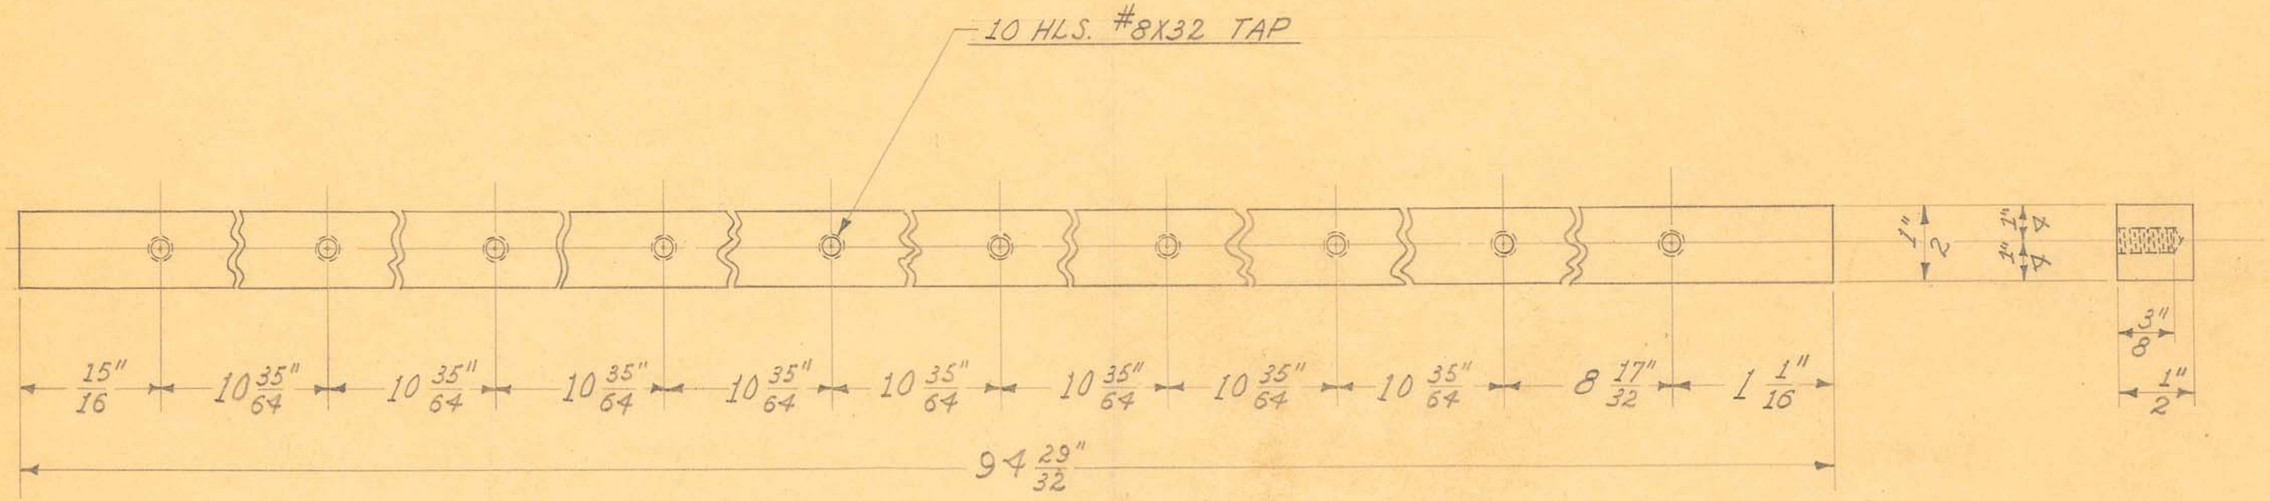

1 REQUIRED

OBSOLETE

SIZE	1/2" SQUARE	ISSUE 8-27-37	J.W.	TITLE: "60-88" & TILT TABLE - 15' RAIL RAIL
KIND	C.R. STEEL	CHANGED		
SHAPE		"		
FINISH	CAD. #23	"		
TEMP.		"		

H. G. FISCHER & CO.
2335 WABANSIA AVE.
CHICAGO, ILL.

CAT. NO.

PART NO. 10329 1/2

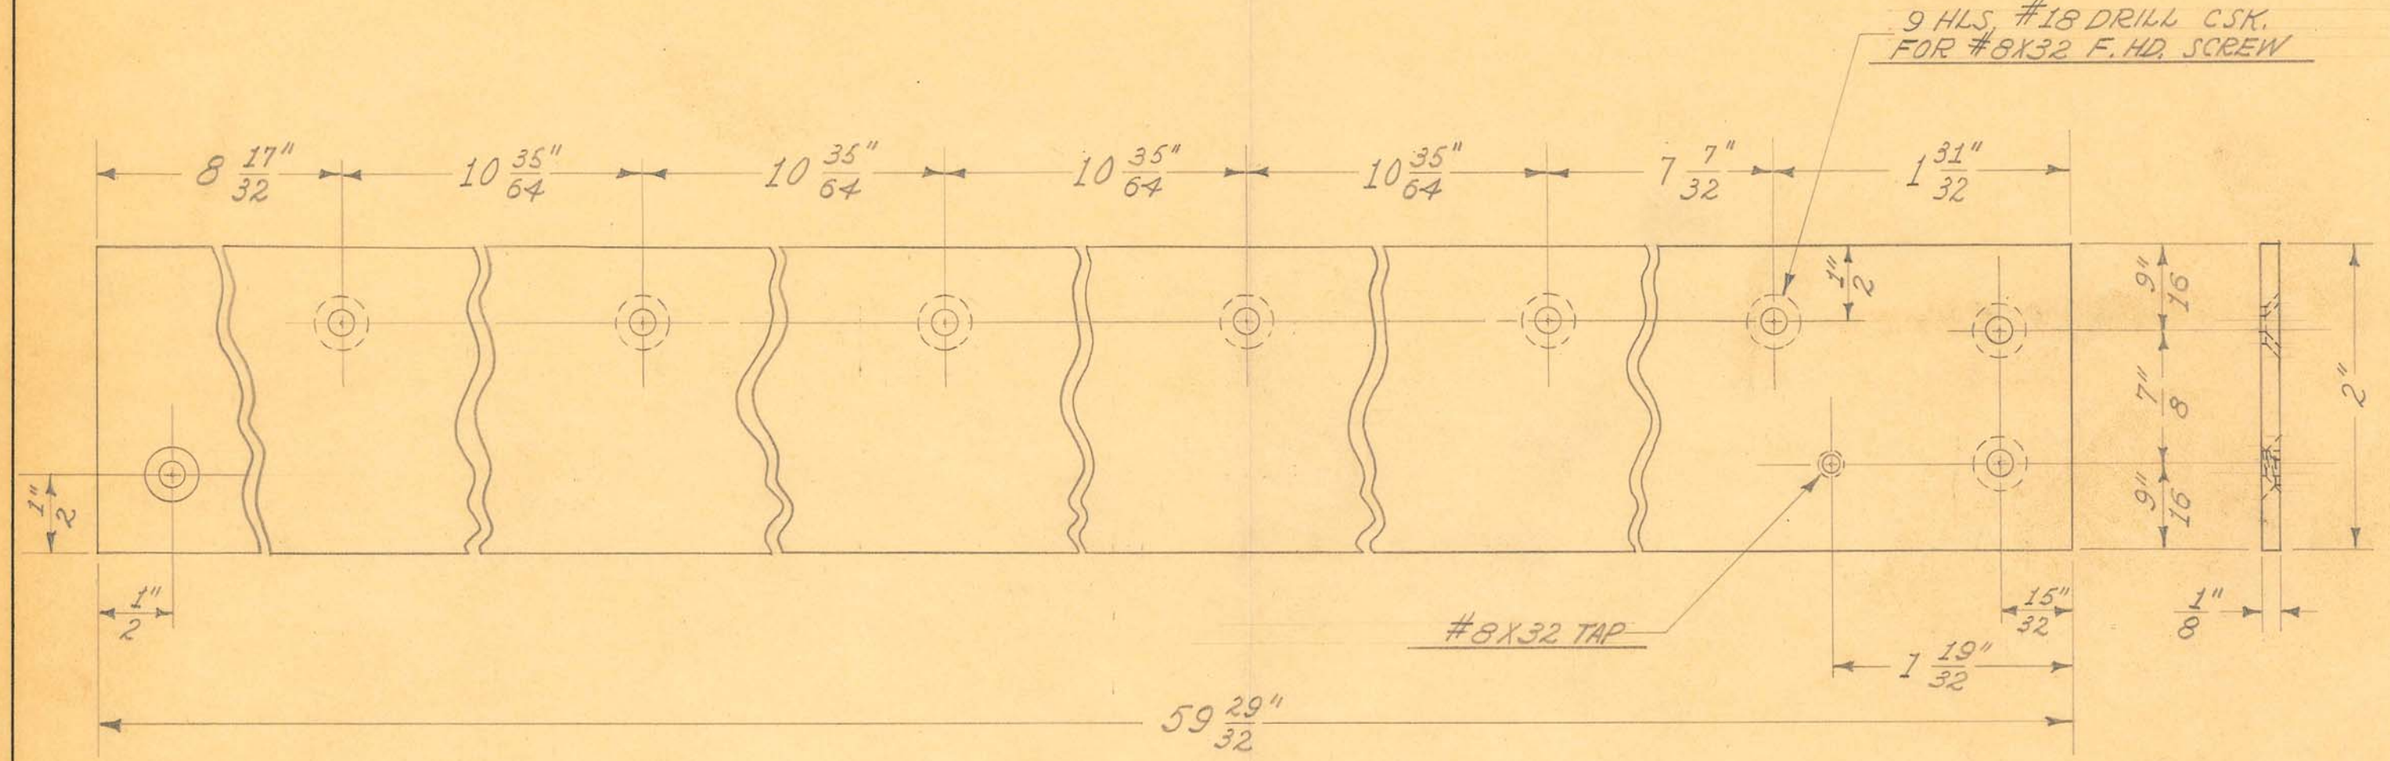

1 REQUIRED

OBSOLETE

SIZE	1/8" X 2"	ISSUE 8-26-37	J.W.	TITLE: "60-88" & TILT TABLE - 15' RAIL EXTENSION - RAIL PLATE
KIND	C. R. STEEL	CHANGED		
SHAPE	STRIP	"		
FINISH	CAD. & LAC.	"		
TEMP.	#26	"		
PATT.		"		

H. G. FISCHER & CO.
2335 WABANSIA AVE.
CHICAGO, ILL.

CAT. NO.

PART NO. 10331 1/2

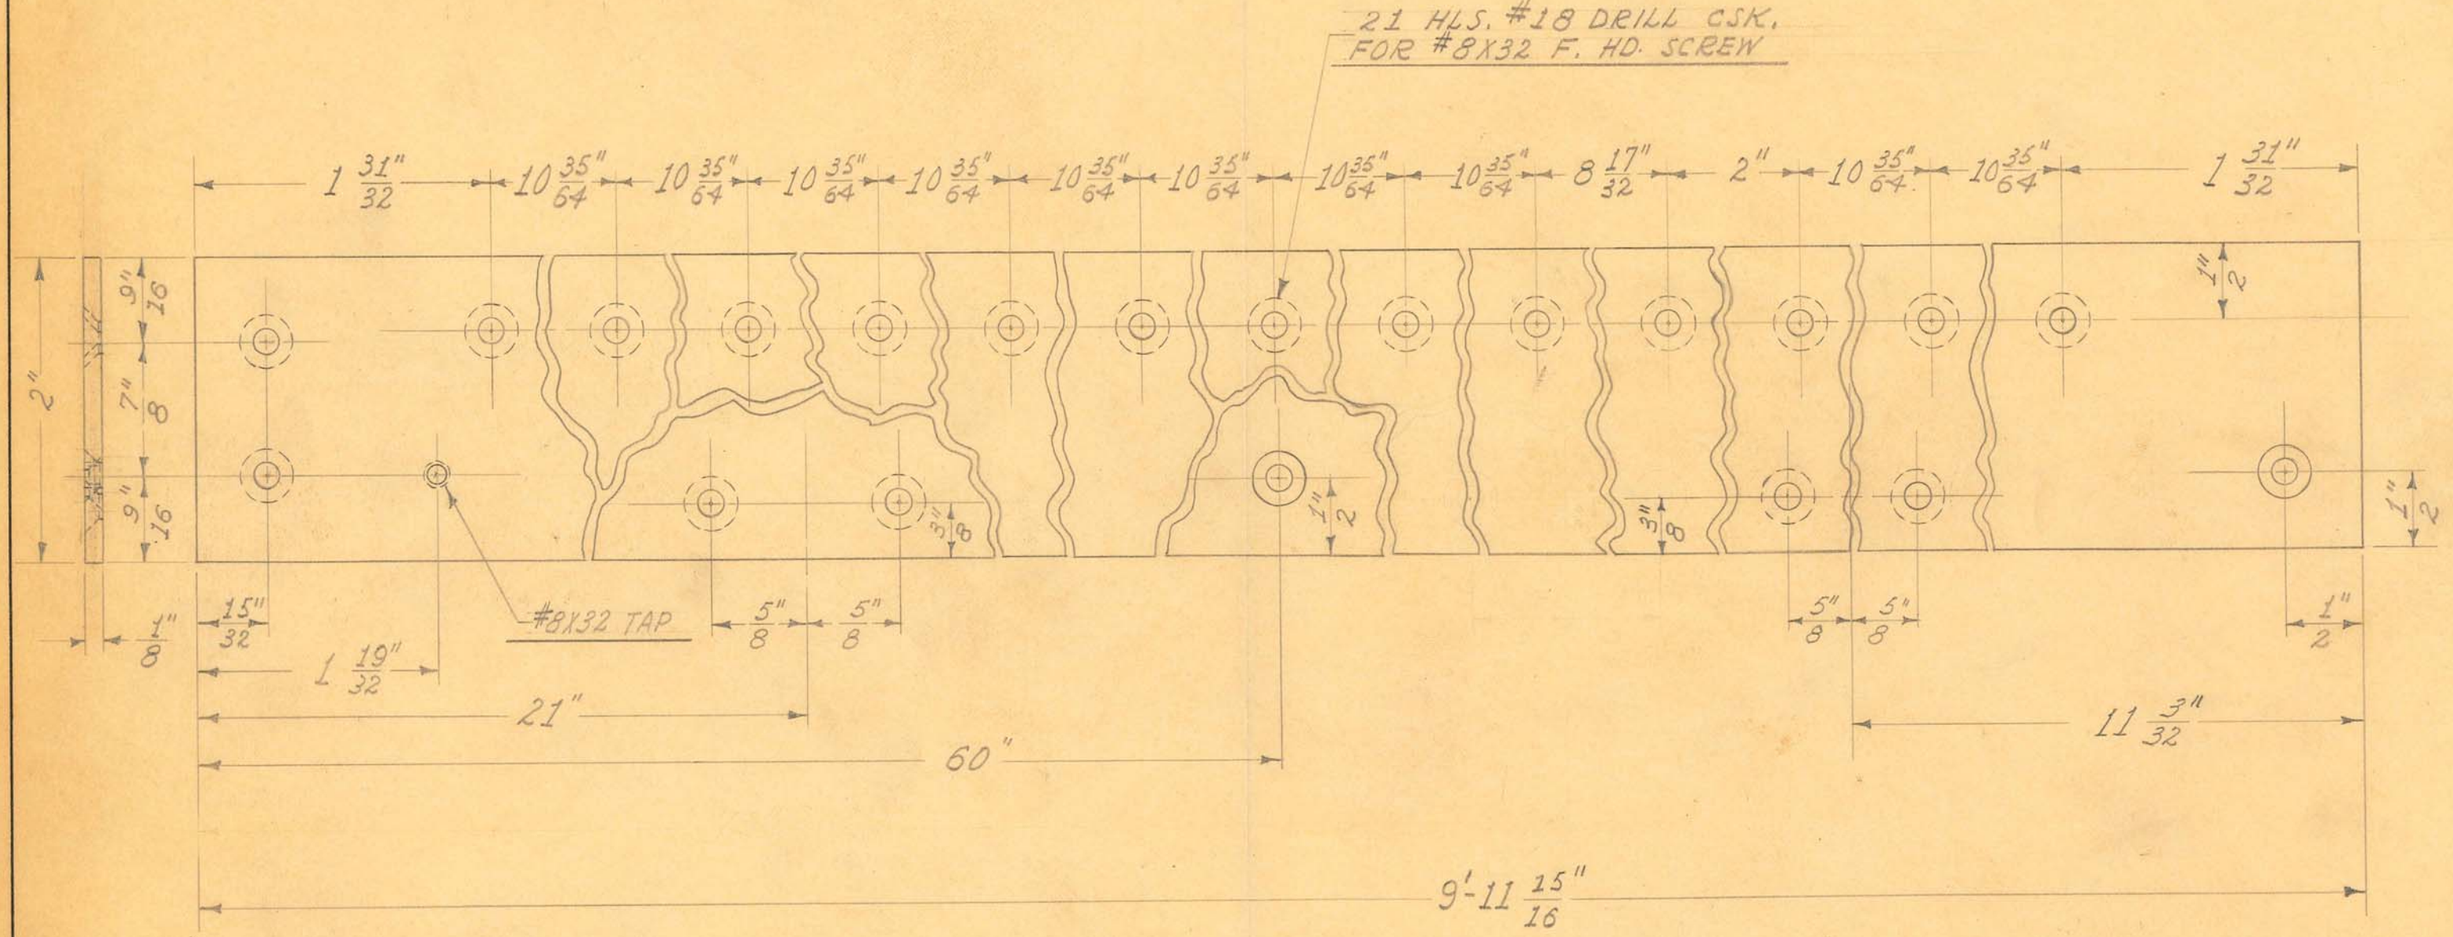

1 REQUIRED

OBSOLETE

SIZE	1/8" X 2"	ISSUE	8-27-37	J.W.
KIND	C.R. STEEL	CHANGED		
SHAPE	STRIP	"		
FINISH	CAD. & LAC.	"		
TEMP.	#26	"		
PATT.		"		

TITLE: "60-88" & TILT TABLE - 15' RAIL RAIL PLATE

H. G. FISCHER & CO.
2335 WABANSIA AVE.
CHICAGO, ILL.

CAT. NO.

PART NO. 10332 1/2

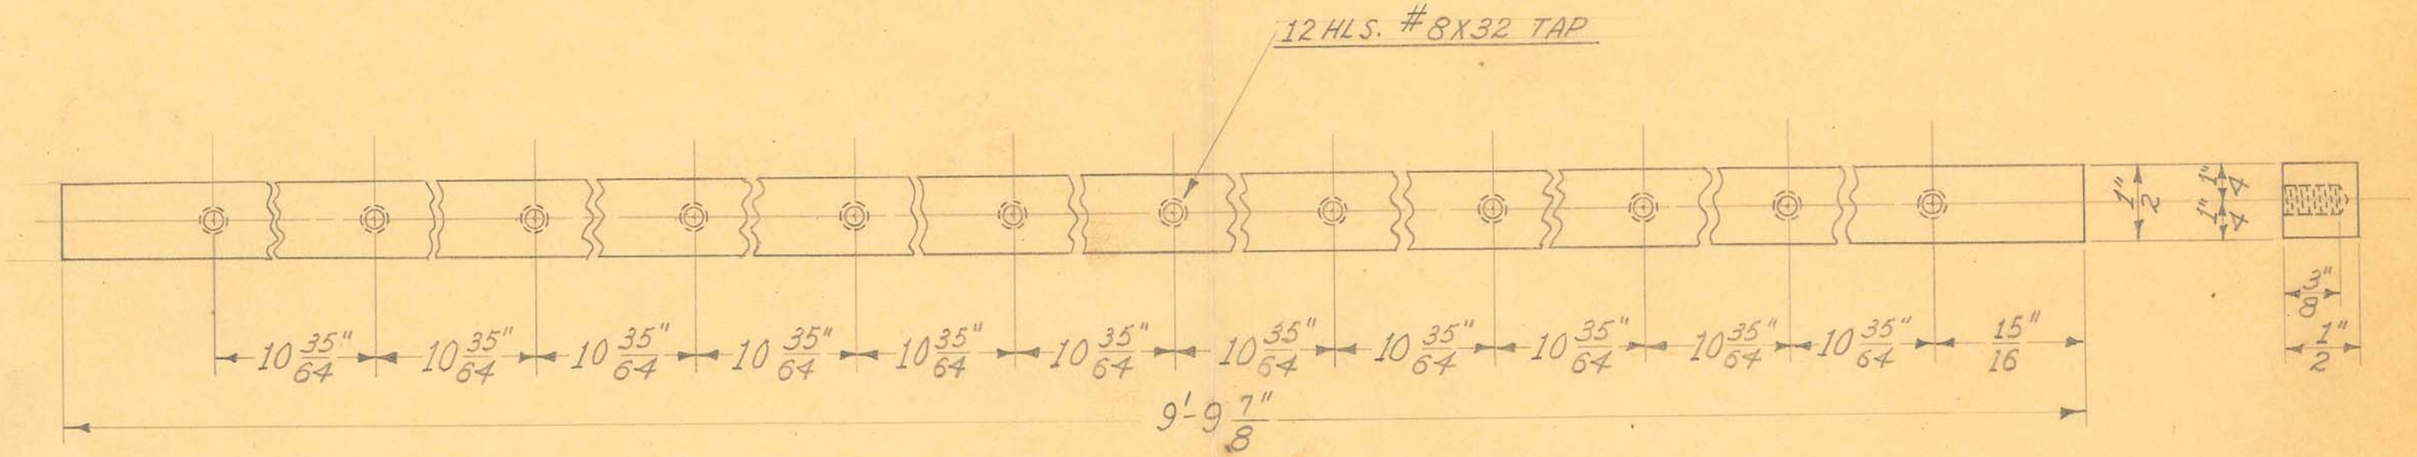

1 REQUIRED

OBSOLETE

SIZE	1/2" SQUARE	ISSUE 1-16-37	J. W.	
KIND	C.R. STEEL	CHANGED		
SHAPE		"		
FINISH	CAD. #23	"		
TEMP.		"		
PATT.		"		

TITLE:
FISCHER RAD. & FLUO. TILT TABLE
10' RAIL - TUBE STAND RAIL

H. G. FISCHER & CO.
2335 WABANSIA AVE.
CHICAGO, ILL.

CAT. NO.

PART NO. 10333

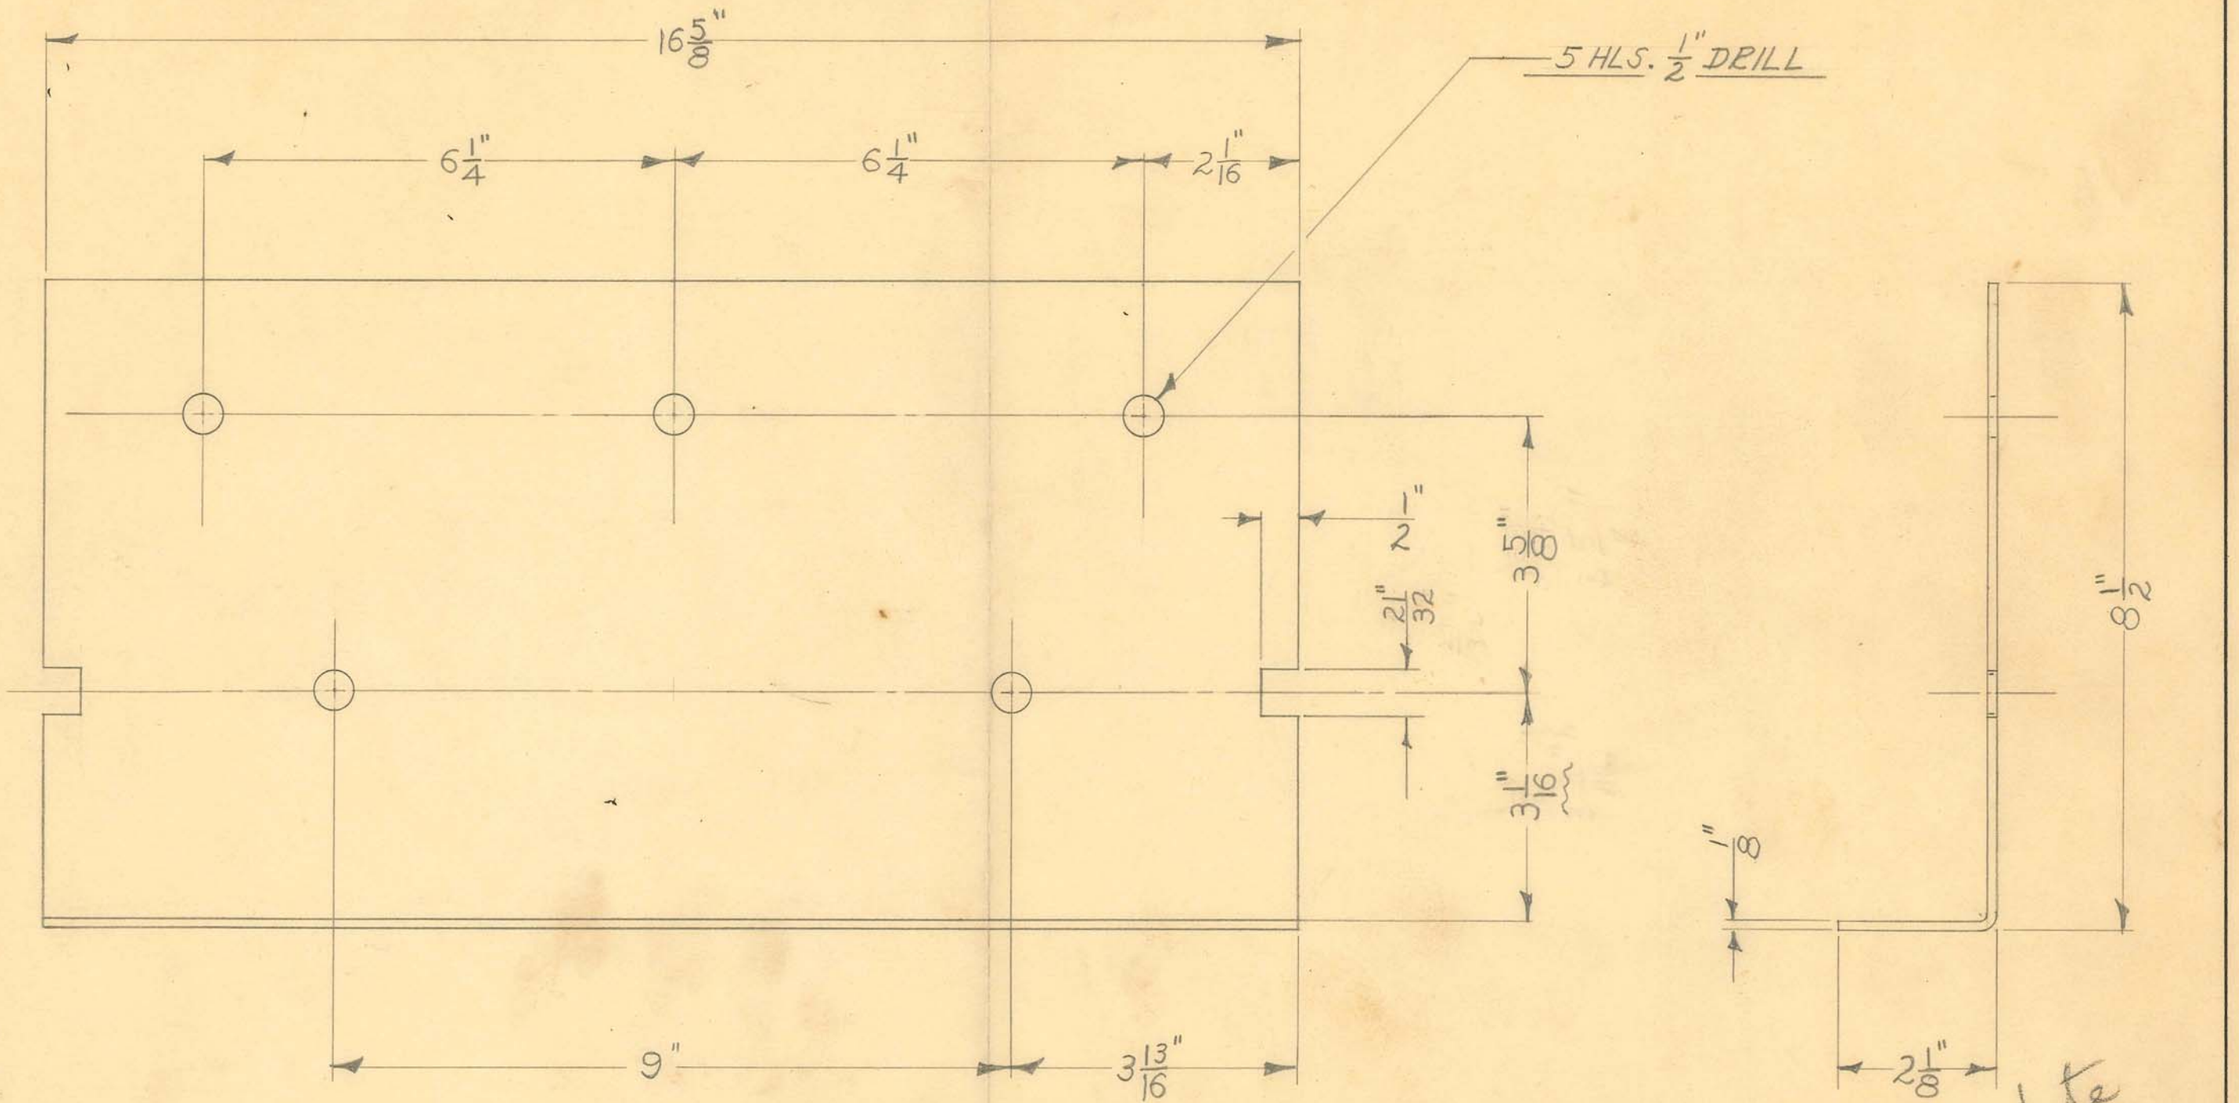

SCALE ÷ HALF SIZE

1-REQUIRED

obsolete
1-26-51
Jan

DIMENSIONS	
FRACTIONAL	± .015
DECIMAL	± .005
ANGULAR	± 1/2°
UNLESS OTHERWISE SPECIFIED	

SIZE	1/8" OR 11GA.	ISSUE 11-26-47	J.M.F
KIND	C.R. STEEL	CHANGED	
SHAPE		"	
FINISH	PAINTED	"	
TEMP.		"	
PATT.		"	

TITLE: FISCHER DELUXE "RF-100" X-RAY REMOVEABLE C'WEIGHT SUPPORT

OBSOLETE

H. G. FISCHER & CO.
2333 WABANSIA AVE.
CHICAGO, ILL.

CAT. NO.

PART NO. 17397

2 HLS. $\frac{1}{4}$" X 20 TAP - $\frac{1}{2}$" DEEP

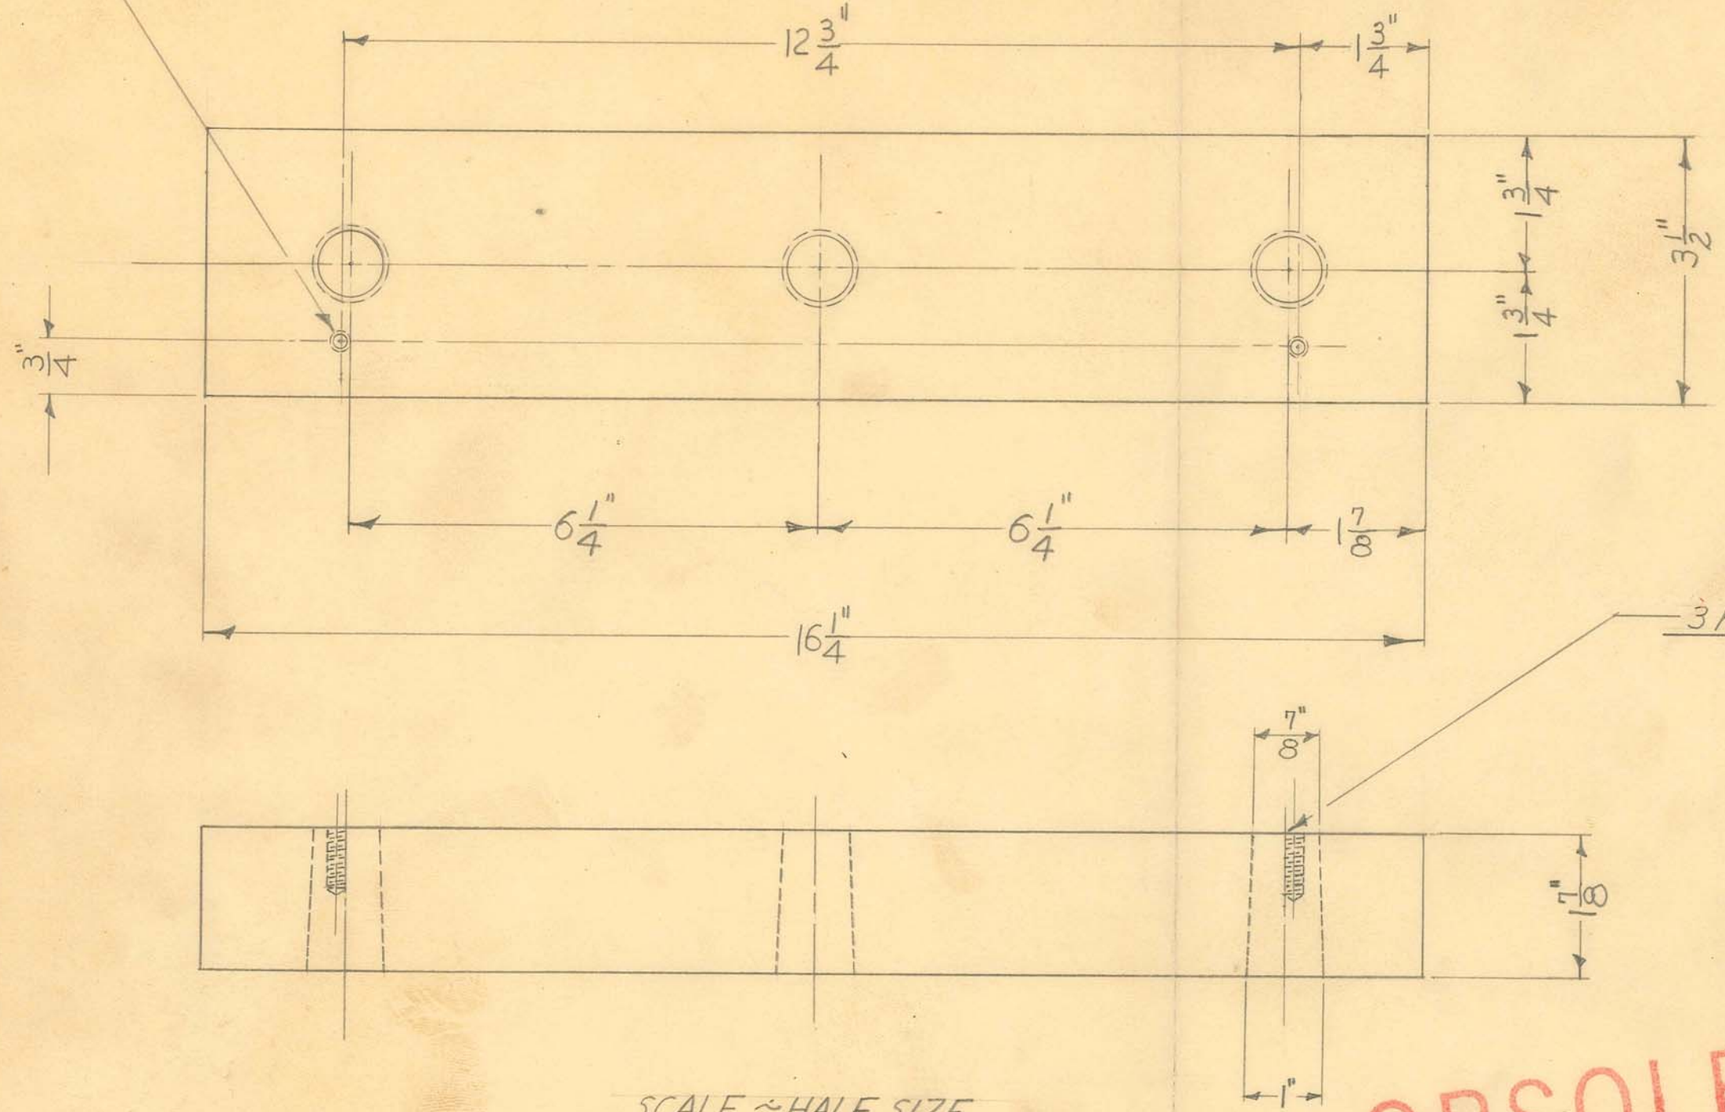

3 HLS. TAPERED TO DIMENSIONS SHOWN

SCALE ≈ HALF SIZE

WEIGHT ~40 $\frac{3}{4}$ LBS.

OBSOLETE

obsolete 1-26-51

1-REQUIRED

DRILL JIG TOOL #9803

MOLD TOOL # 1830

DIMENSIONS	
FRACTIONAL	± .015
DECIMAL	± .005
ANGULAR	± 1/2°
UNLESS OTHERWISE SPECIFIED	

SIZE		ISSUE 11-26-47	JMF
KIND	PIG LEAD	CHANGED	
SHAPE		"	
FINISH		"	
TEMP.		"	
PATT.		"	

TITLE: FISCHER DELUXE "RF-100" X-RAY TILT TABLE HEAD COVER C'WEIGHT

H. G. FISCHER & CO.
2335 WABANSIA AVE.
CHICAGO, ILL.

CAT. NO.

PART NO. 17399

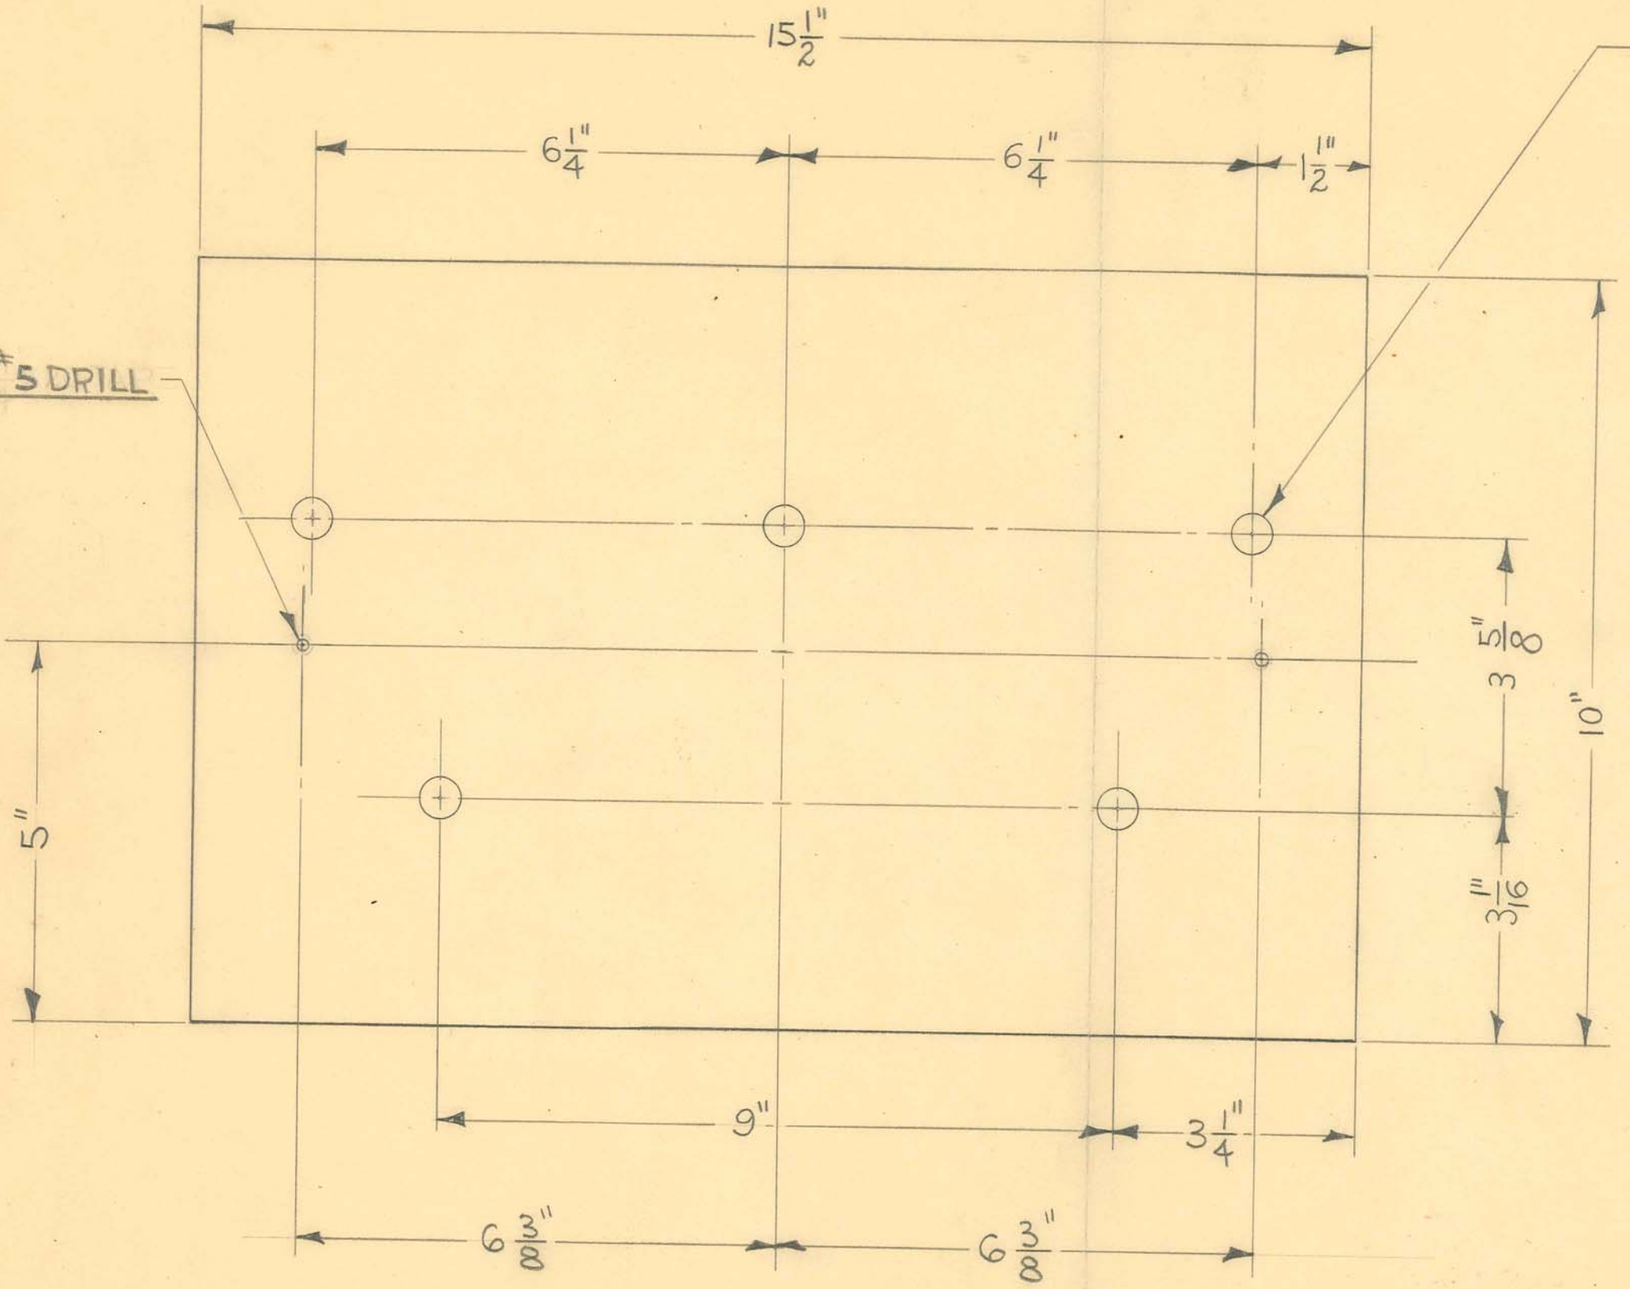

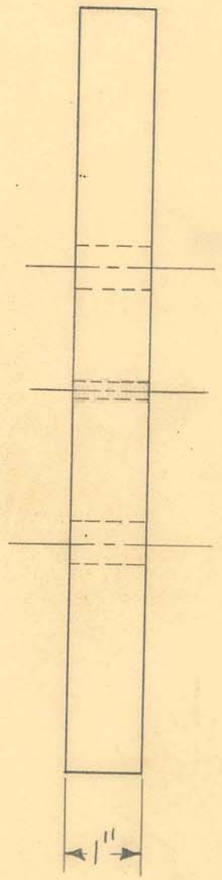

OBSOLETE

obsolete
1-26-51
Jer.

SCALE ≈ HALF SIZE

WEIGHT ≈ 63 LBS.

3 REQUIRED DRILL JIG TOOL # 9804

SIZE		ISSUE 4-29-48	W.J.
KIND	LEAD	CHANGED	
SHAPE		"	
FINISH		"	
TEMP.		"	
PATT.		"	

DIMENSIONS
FRACTIONAL ± .015
DECIMAL ± .005
ANGULAR ± 1/2°
UNLESS OTHERWISE SPECIFIED

TITLE:
FISCHER DELUXE "RF-100" X-RAY UNIT
TILT TABLE C'WEIGHT - OUTER

H. G. FISCHER & CO.
2335 WABANSIA AVE.
CHICAGO, ILL.

CAT. NO.

PART NO. 17401F

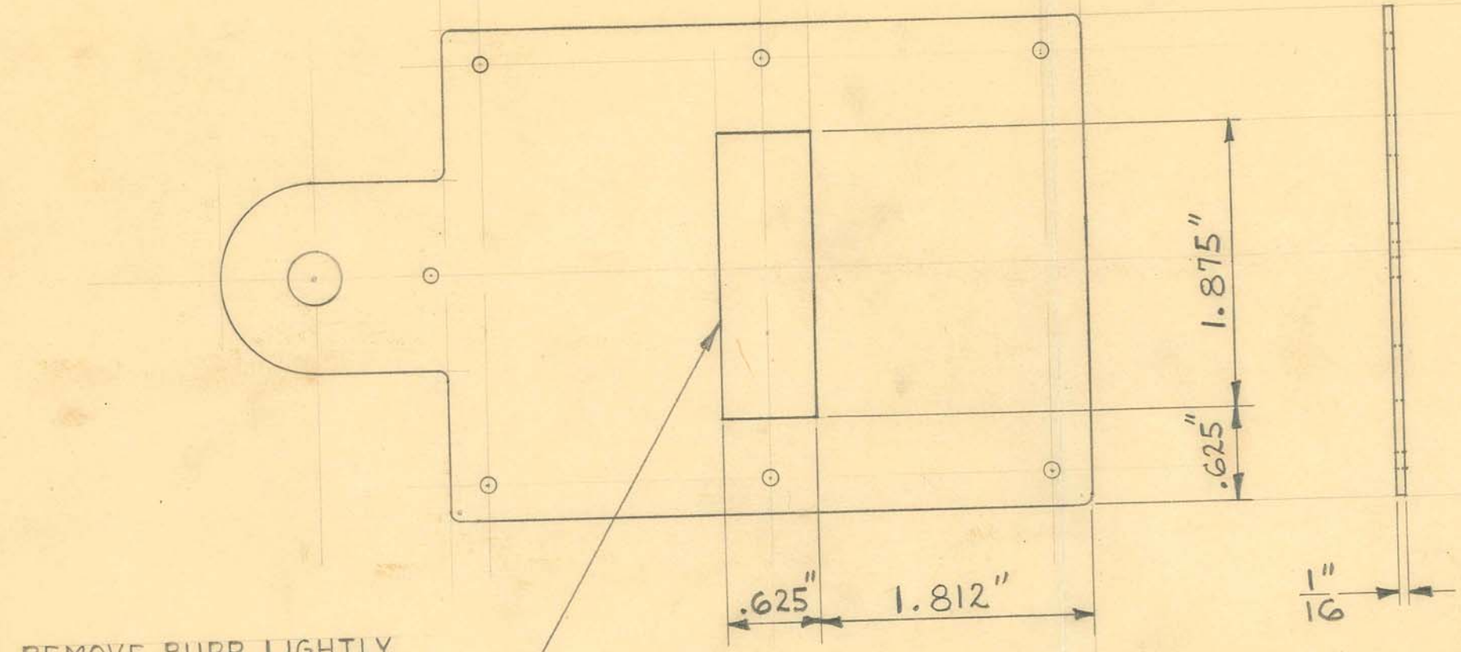

REMOVE BURR LIGHTLY
ALL AROUND BOTTOM
SIDE OF OPENING

BLANK & PIERCE DIMENSIONS SEE DRAWING #17477

BLANKING DIE TOOL # 9768

PIERCING DIE TOOL # 9769

SLOTTING DIE TOOL # 9770

OBSOLETE

1 REQUIRED

Obsolete

SIZE	1/16" SHEET	ISSUE 4-1-48	J.V.W.
KIND	LEAD	CHANGED	
SHAPE		"	
FINISH		"	
TEMP.		"	
PATT.		"	

DIMENSIONS
FRACTIONAL ± .015
DECIMAL ± .005
ANGULAR ± 1/2°
UNLESS OTHERWISE SPECIFIED

TITLE:
FISCHER "L-200" & "RF-100" X-RAY
FULL SPINE BLOCKER & FILTER
LEAD PLATE

H. G. FISCHER & CO.
2335 WABANSIA AVE.
CHICAGO, ILL.

CAT. NO.

PART NO. 17479

TITLE FISCHER "L-200" & "RF-100" X-RAY UNIT
TUBE ADAPTER BLOCKER SLIDE & SPRING RETAINER ASSEMBLY

H. G. FISCHER & CO.
FRANKLIN PARK, ILLINOIS

DATE 3-21-49 | DR. BY W.J. | CH'K'D. J.V.W.

PART NO. 17488GA

REVISION	DATE	BY

PATTERN | FINISH | SCALE FULL

TOOLS: DRILL JIG # 11012 | MATERIAL

DIMENSIONS UNLESS OTHERWISE SPECIFIED
FRACTIONAL ± .015
DECIMAL ± .005
ANGULAR ± ½°

Obsolete

1 REQUIRED

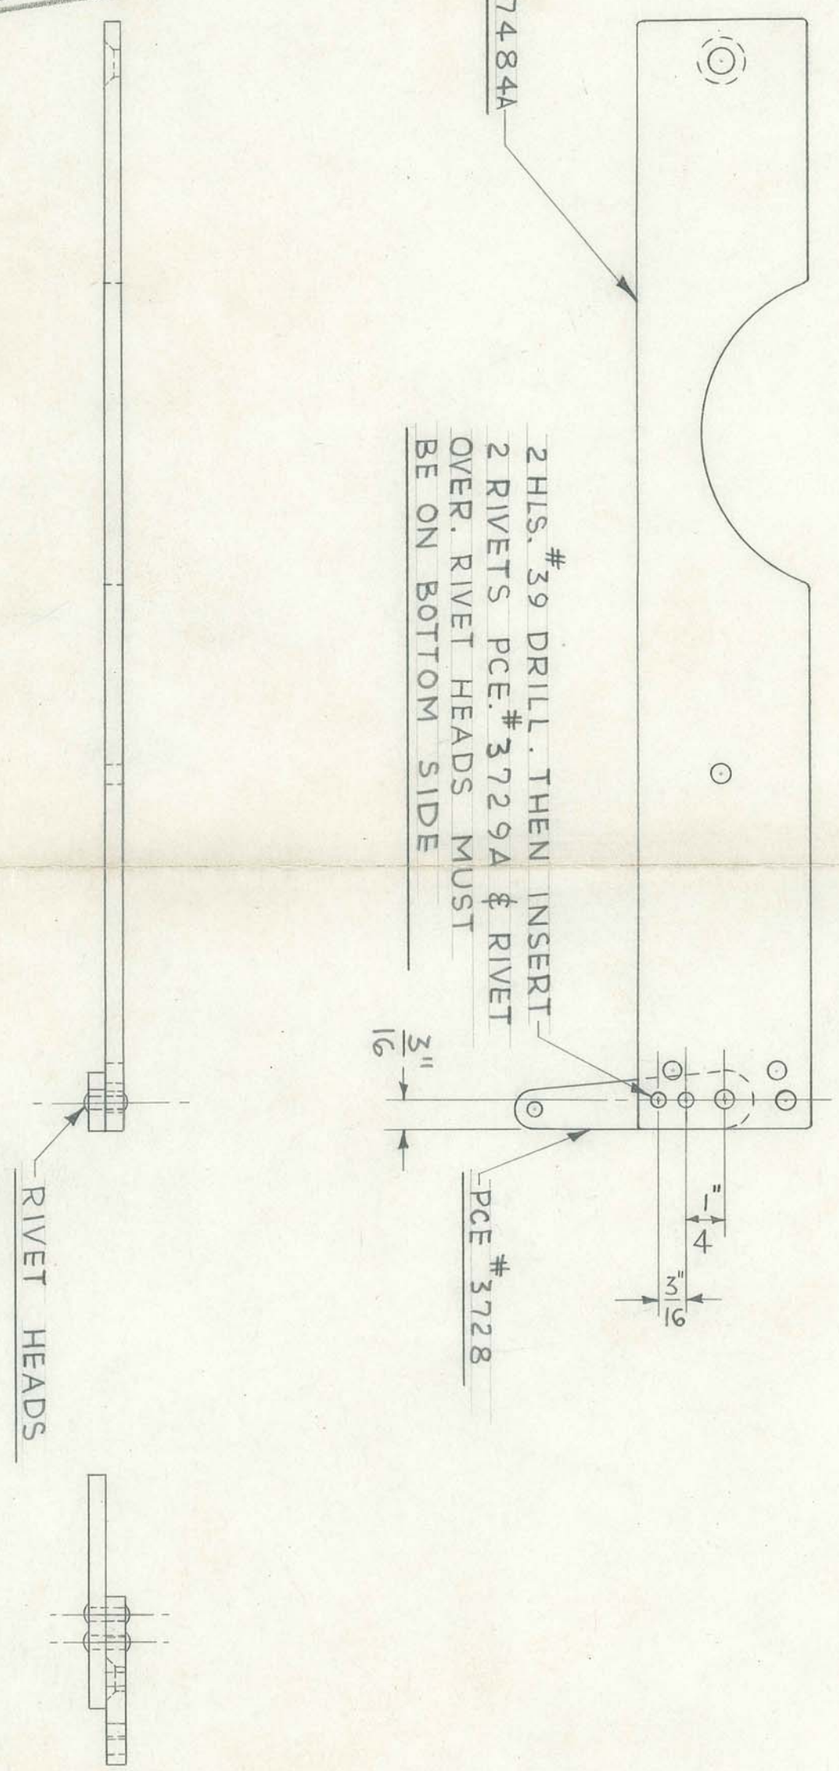

OBSOLETE

FOLDER #130

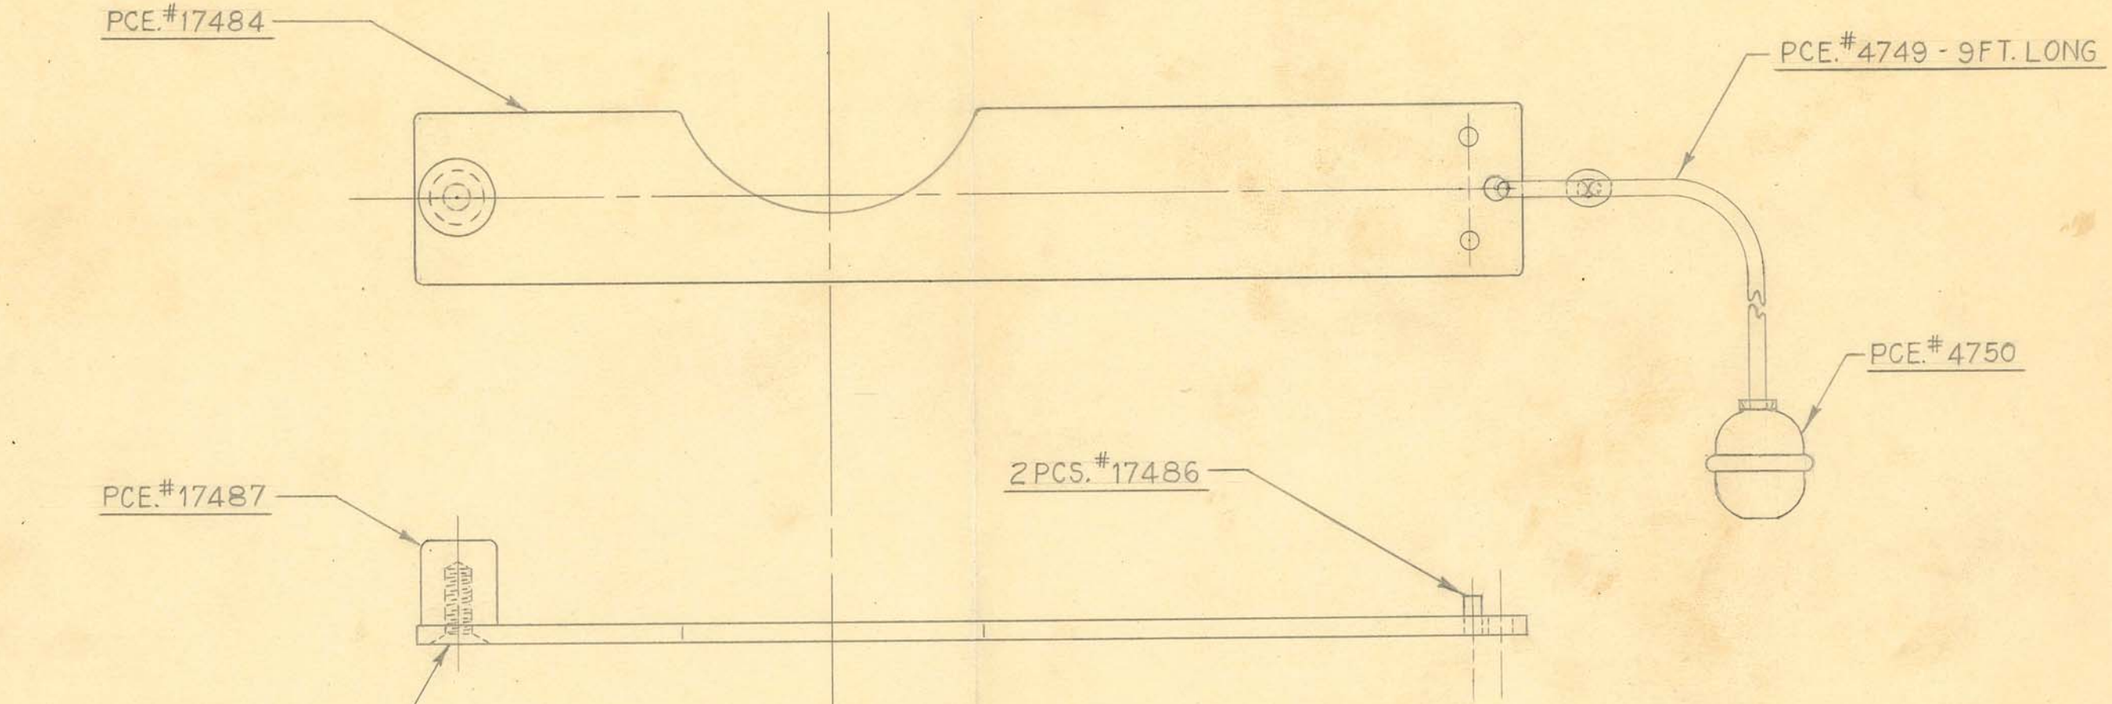

LA

Obsolete 3-17-49

OBSOLETE

SIZE		ISSUE 4-8-48	J.B.G.
KIND		CHANGED	
SHAPE		"	
FINISH		"	
TEMP.		"	
PATT.		"	

DIMENSIONS
FRACTIONAL ± .015
DECIMAL ± .005
ANGULAR ± 1/2°
UNLESS OTHERWISE SPECIFIED

TITLE:
FISCHER "L-200" & "RF-100" X-RAY UNIT
TUBE ADAPTER BLOCKER SLIDE ASSEMBLY

H. G. FISCHER & CO.
2335 WABANSIA AVE.
CHICAGO, ILL.

CAT. NO.

PART NO. 17489G

TITLE
FISCHER "L-200" & "RF-100" X-RAY UNIT
TUBE ADAPTER BLOCKER SLIDE ASSEM.

H. G. FISCHER & CO.
FRANKLIN PARK, ILLINOIS

PART NO. 17489GC

DATE 3-22-49 DR. BY W.J. CH'K'D. J.V.W.

REVISION	DATE	BY

PATTERN | FINISH | SCALE FULL

TOOLS | MATERIAL

DIMENSIONS
FRACTIONAL ±.015
DECIMAL ±.005
ANGULAR ± ½°
UNLESS OTHERWISE SPECIFIED

OBSOLETE

1 REQUIRED

M838-23 F.H.I

PCE. # 17487

2 PIECES PCE. # 17488GA

PCE. # 17488GA

RUBBER TUBING 7/16" LONG
PCE. # 5585

2 PIECES RUBBER TUBING 1/4"
LONG EACH - PCE. # 2974

PCE. # 4749 - 9 FT. LONG

PCE. # 4750

FOLDER #130

OBSOLETE

3-24-53

PART NO. 17509G

REVISION	DATE	BY

H. G. FISCHER & CO.
FRANKLIN PARK, ILLINOIS

DATE 1-6-49 DR. BY W. J. CH'K'D J.V.W.

DIMENSIONS
FRACTIONAL ±.015
DECIMAL ±.005
ANGULAR ±½°
UNLESS OTHERWISE SPECIFIED

SCALE HALF

TITLE FISCHER DELUXE "RF-250" X-RAY
CWT. TUBE ASSEM. FOR R. A. TUBE HEAD

PATTERN

FINISH

MATERIAL

TOOLS DRILL JIG #9541
FILLING CAP #9565

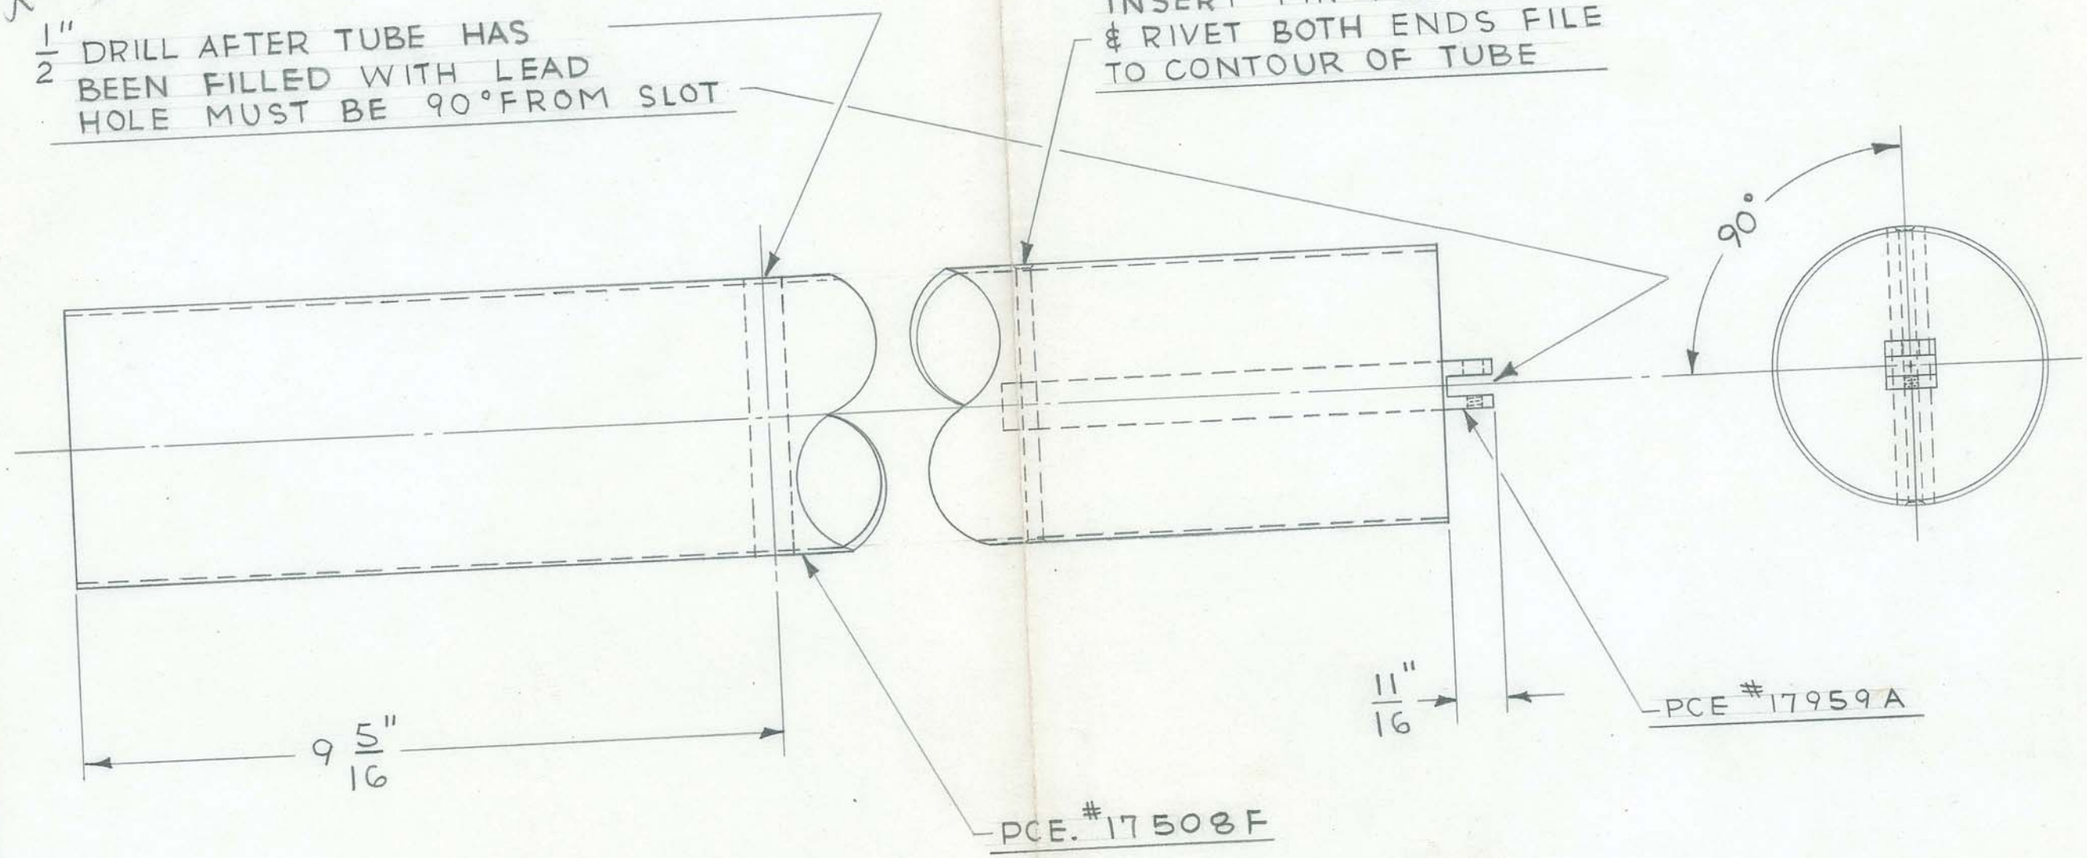

FILL TUBE WITH LEAD TO BRING TOTAL WEIGHT UP TO 85½ LBS. ± ½ LB.

1 REQUIRED

FOLDER #131

6

TITLE
FISCHER WALL FRAME TILTING BUCKY STAND
CWT TUBE ASSEM. - 10"X12" ANDERSON BUCKY

H. G. FISCHER & CO.
FRANKLIN PARK, ILLINOIS

PART NO. 17613G

REVISION	DATE	BY

DATE 2-22-50 | DR. BY W.J. | CH'K'D.

PATTERN | FINISH | SCALE FULL

TOOLS: FILLING CAP # 9975

MATERIAL

DIMENSIONS
FRACTIONAL ± .015
DECIMAL ± .005
ANGULAR ± ½°
UNLESS OTHERWISE SPECIFIED

XX Obsolete 3-26-53

OBSOLETE

INSERT PINS PCE. # 17003
& RIVET BOTH ENDS
FILE TO CONTOUR OF TUBE

PCE. # 17609F

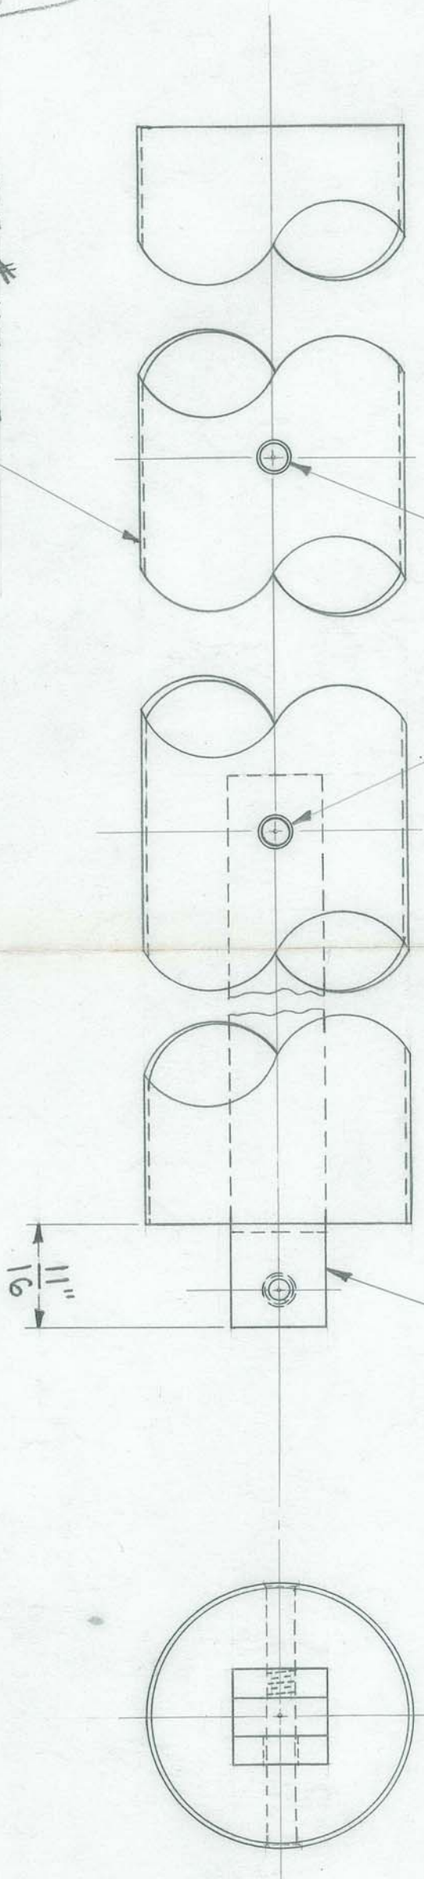

FILL TUBE WITH LEAD TO BRING TOTAL WEIGHT UP TO 26 1/2 LBS. + 1/4 LB.

2 REQUIRED

FOLDER #134

TITLE
FISCHER WALL FRAME TILTING BUCKY STAND - MOUNTING BOARD

H. G. FISCHER & CO.
FRANKLIN PARK, ILLINOIS

PART NO. 17615

DATE 10-12-49 DR. BY W.J. CH'K'D.

REVISION	DATE	BY

PATTERN | FINISH PAINTED | SCALE HALF

TOOLS | MATERIAL BIRCH

DIMENSIONS
FRACTIONAL ± .015
DECIMAL ± .005
ANGULAR ± ½°
UNLESS OTHERWISE SPECIFIED

1 REQUIRED

obsolete

OBSOLETE

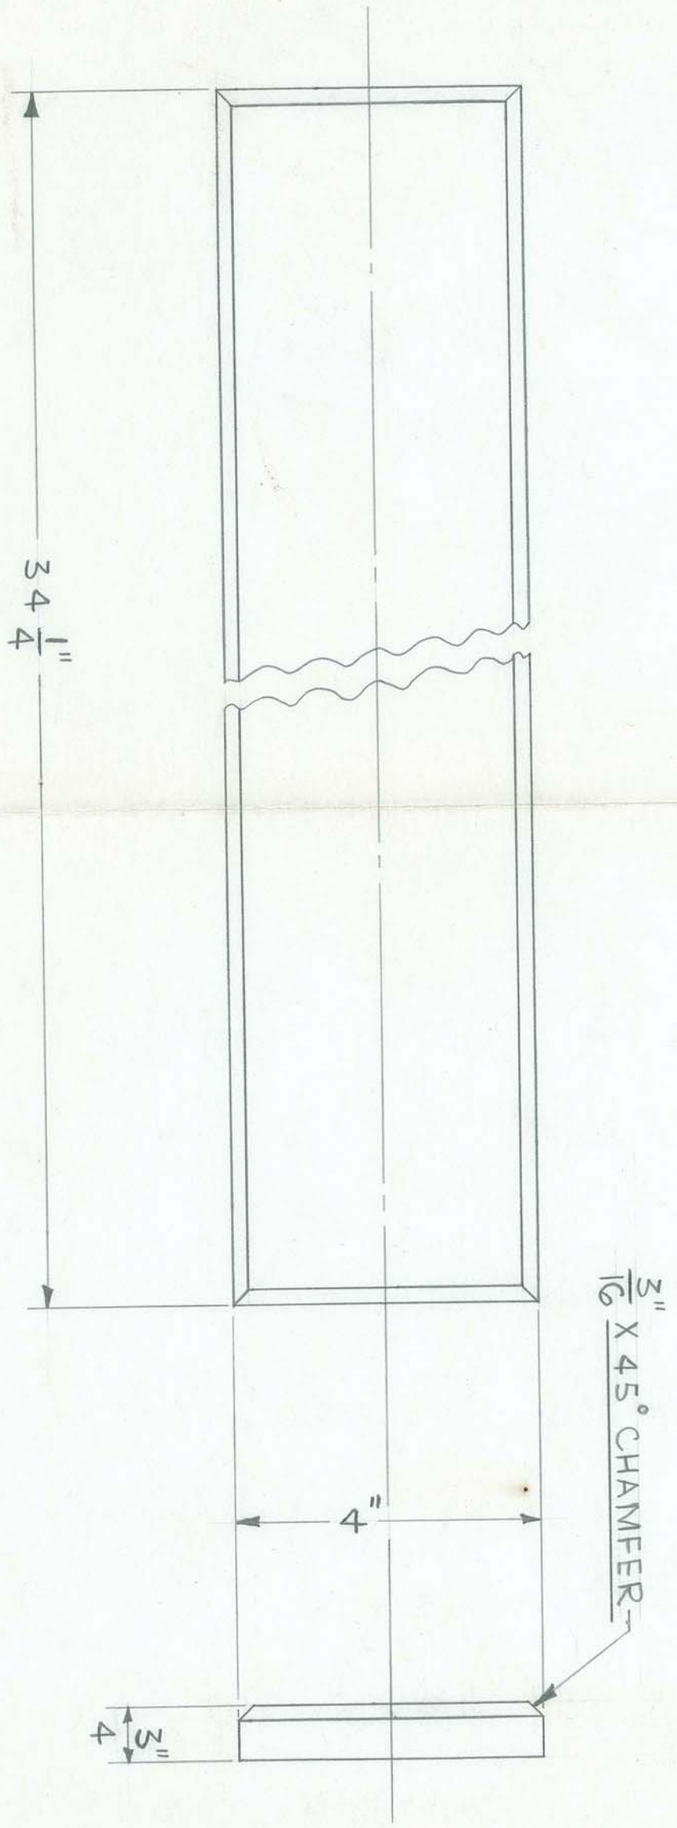

FOLDER #134

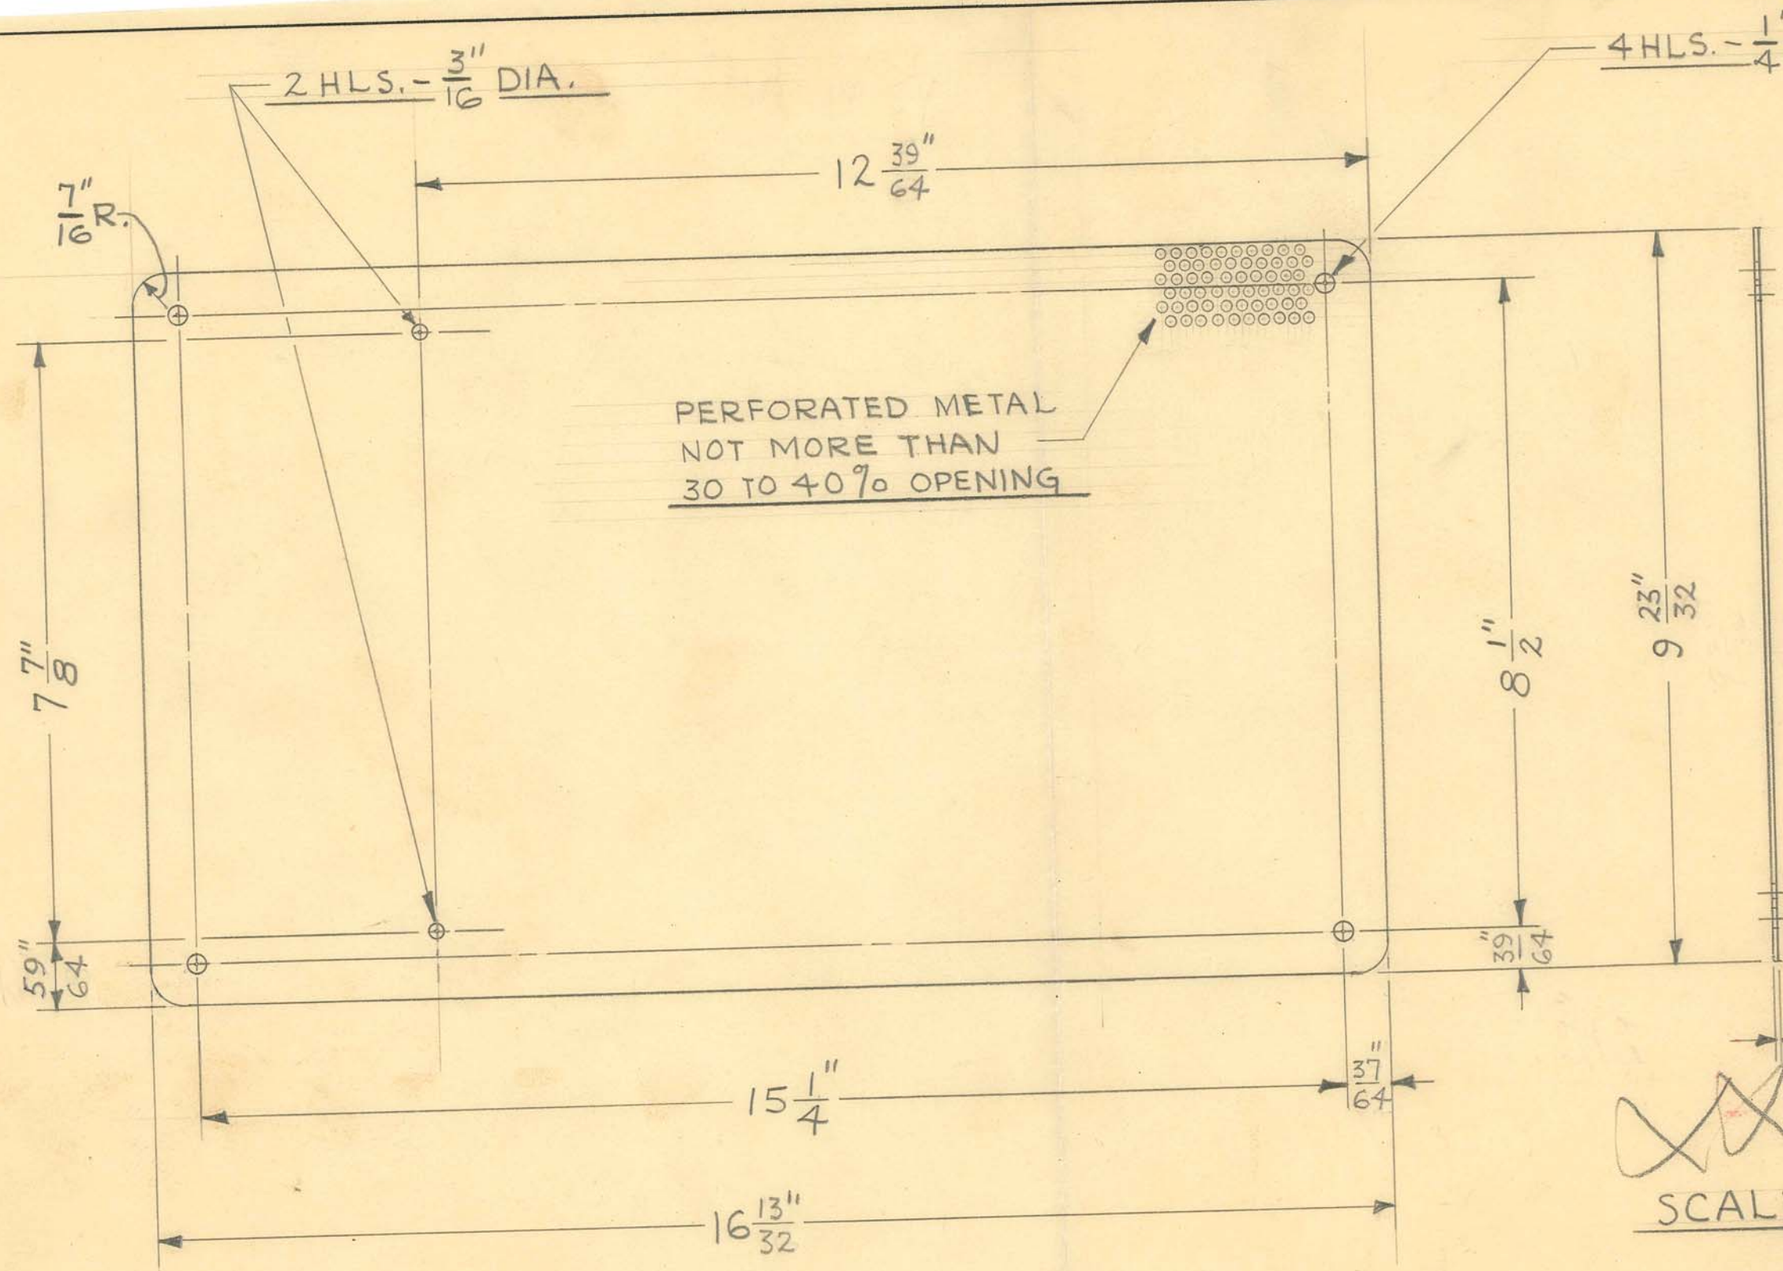

OBSOLETE

SEE NEW TRACING

SCALE ~ HALF SIZE

1 REQUIRED

#16GA. (.060") PERFORATED STEEL 30 TO 40% OPENING

SIZE		ISSUE 5-11-48	J.V.W.
KIND		CHANGED	
SHAPE		"	
FINISH	CAD. #23	"	
TEMP.		"	
PATT.		"	

DIMENSIONS	
FRACTIONAL	± .015
DECIMAL	± .005
ANGULAR	± 1/2°
UNLESS OTHERWISE SPECIFIED	

TITLE: FISCHER MODEL "10" PORTABLE DIA. MODEL "300" DIATHERMY CABINET - BASE COVER

H. G. FISCHER & CO.
2338 WABANSIA AVE.
CHICAGO, ILL.

CAT. NO.

PART NO. 17653

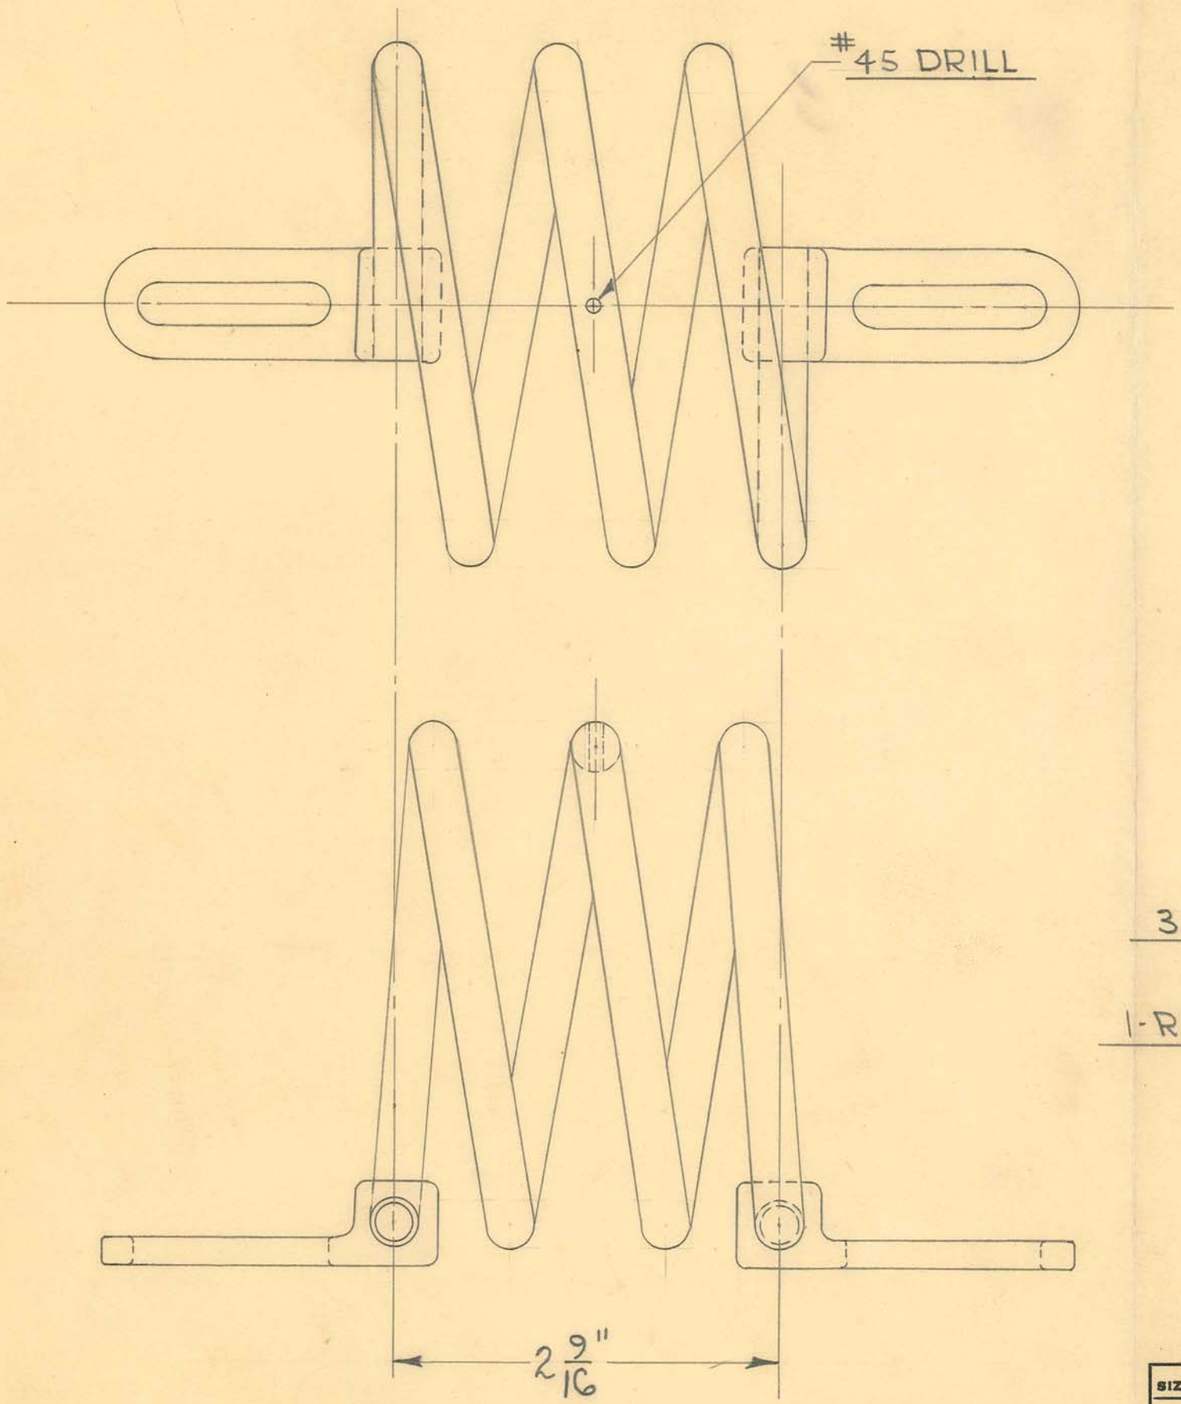

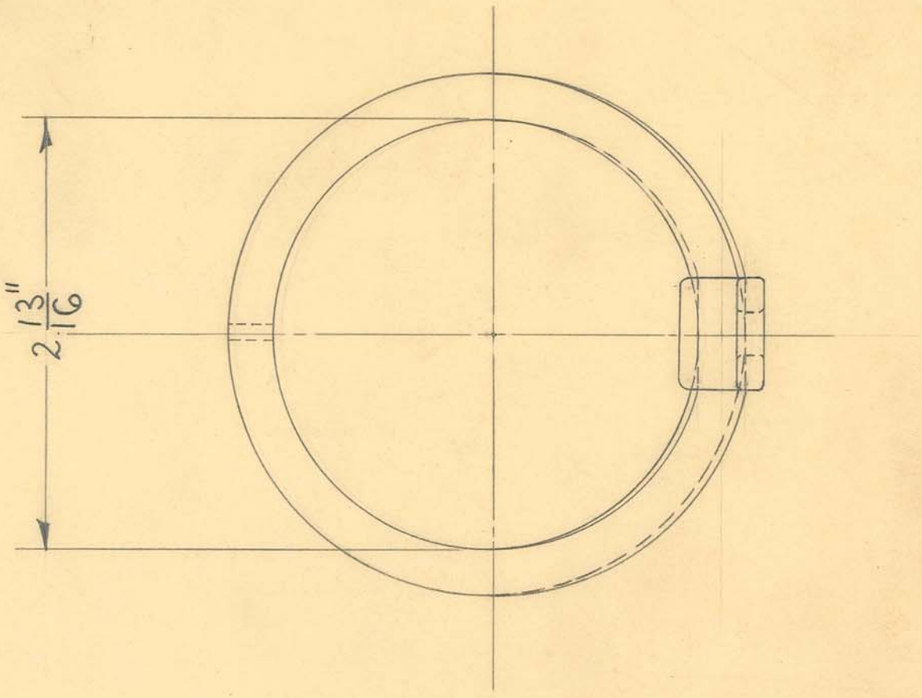

3 TURNS

1-REQUIRED

ACID DIP - NEUTRALIZE ACID &
BLOW OUT INSIDE OF COIL TUBING

OBSOLETE
Obsolete 6-16-52

DRILL JIG TOOL # 9815
STRETCHING MANDRELL TOOL # 9816

DIMENSIONS	
FRACTIONAL	± .015
DECIMAL	± .005
ANGULAR	± 1/2°
UNLESS OTHERWISE SPECIFIED	

SIZE	FROM	ISSUE 5-11-47	W.J.
KIND	162846A	CHANGED	
SHAPE		"	
FINISH		"	
TEMP.		"	
PATT.		"	

TITLE: FISCHER MOD. "10" DIATHERMY
MODEL "300" PORTABLE DIATHERMY
OSCILLATING COIL

H. G. FISCHER & CO.
2335 WABANSIA AVE.
CHICAGO, ILL.

CAT. NO.

PART NO. 17655

TITLE

FISCHER MOD. "10" DIATHERMY FARRADAY PICK UP LOOP

H. G. FISCHER & CO.
FRANKLIN PARK, ILLINOIS

DATE 3-3-49 | DR. BY W.J. | CH'K'D. J.V.W.

PART NO. 17654G

REVISION	DATE	BY

PATTERN | FINISH | SCALE FULL

TOOLS: BENDING FIX.# 10089
CRIMPING TOOL# 10088

MATERIAL: 84-#16234A 2-#17635 1-#16334
$16\ 28\frac{3}{4}$ #16 BARE COPPER WIRE-16" LONG

DIMENSIONS
FRACTIONAL ± .015
DECIMAL ± .005
ANGULAR ± ½°
UNLESS OTHERWISE SPECIFIED

obsolete

OBSOLETE

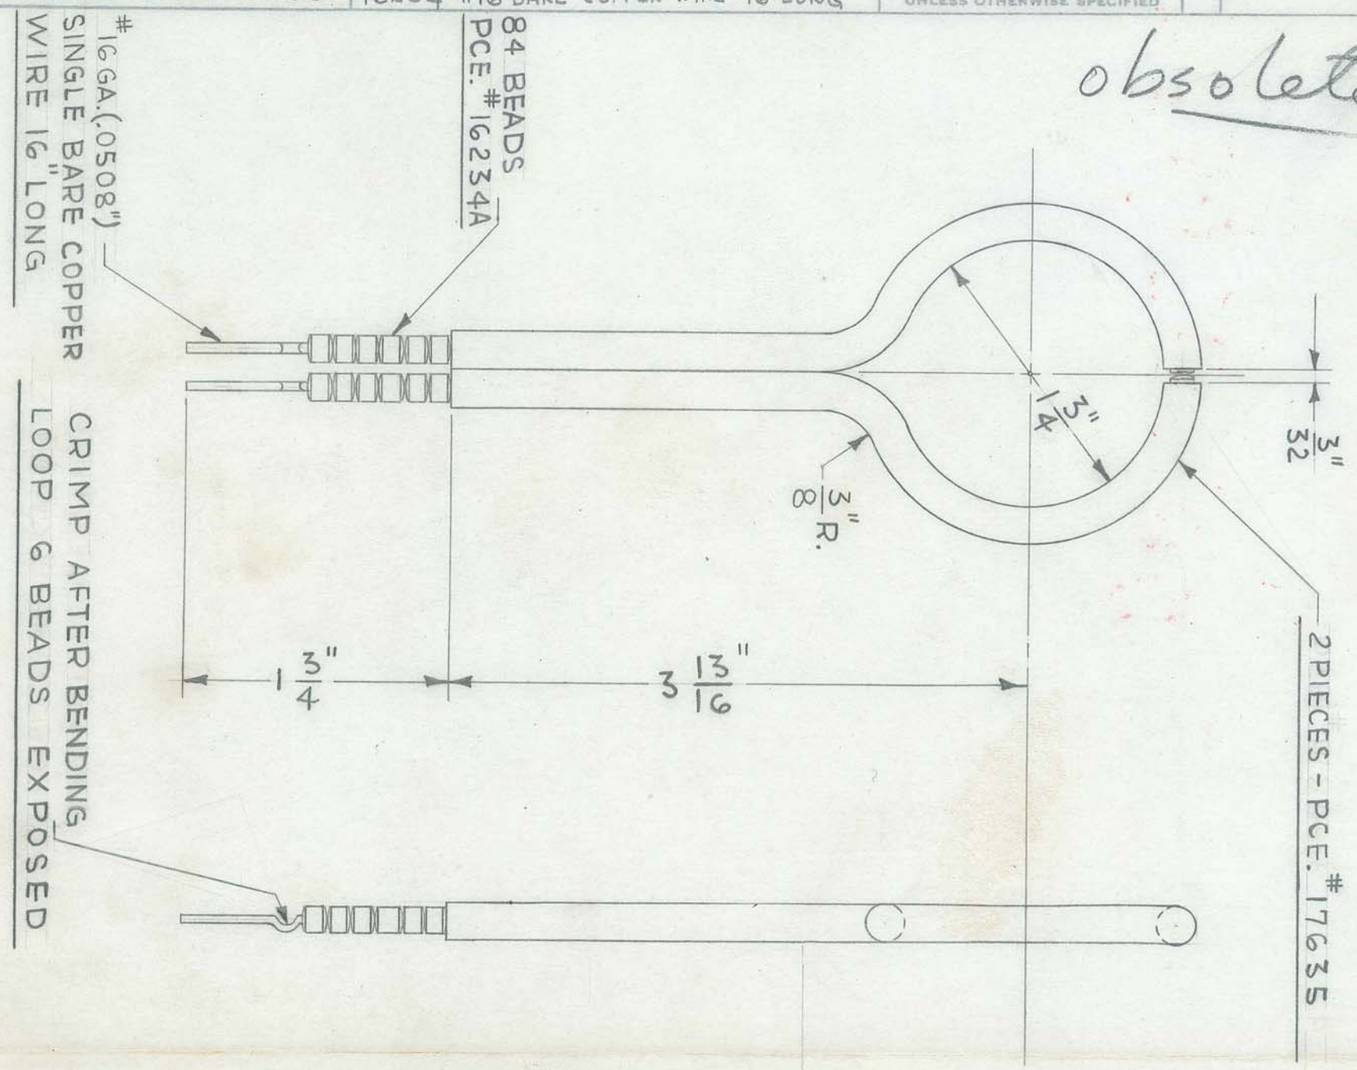

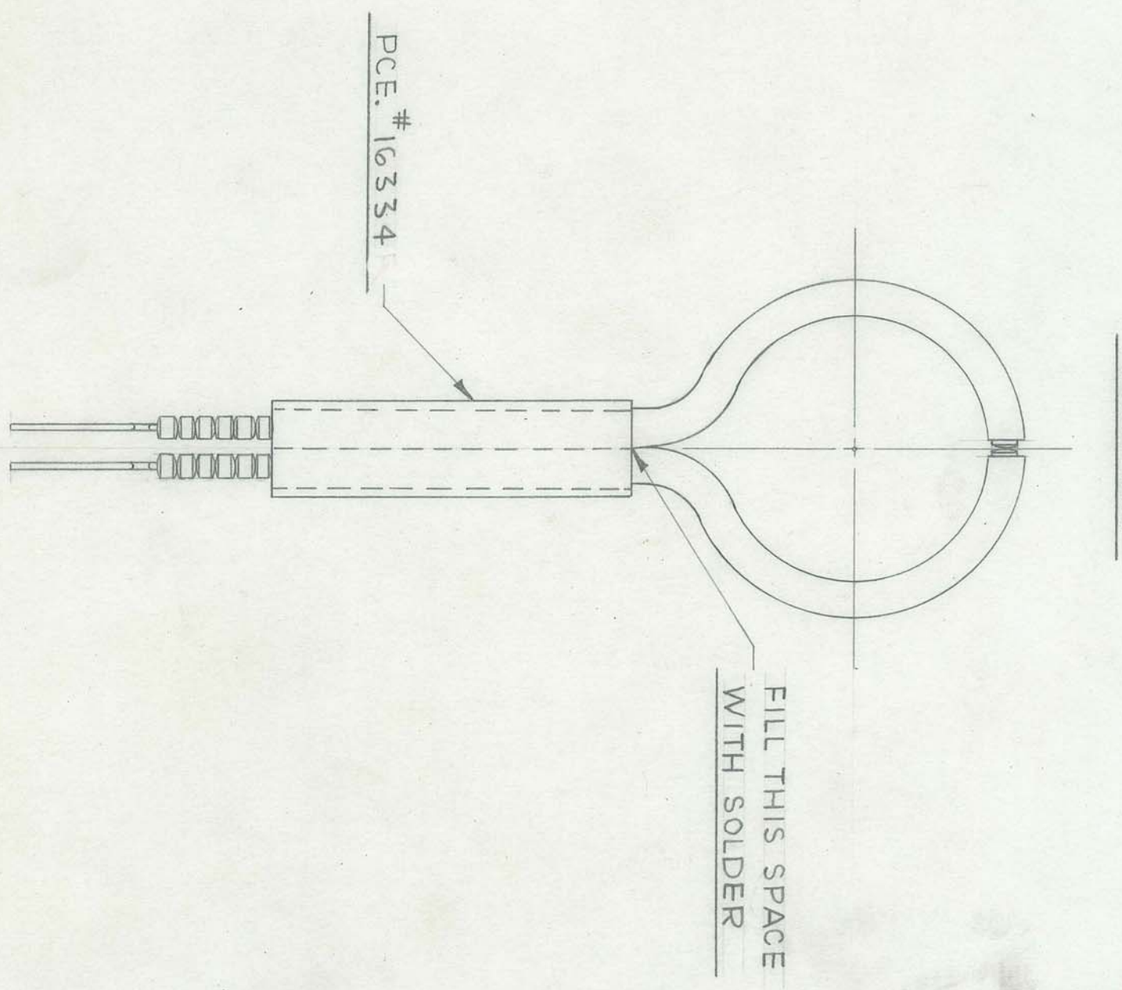

FOLDER #132

17635 — 2 pcs. 1/4" Tubing 5 11/16" long each

16234 Beads = 84"

— #16 GA (.0508) WIRE = 16"

SOFT bare copper wire

ASSEMBLY

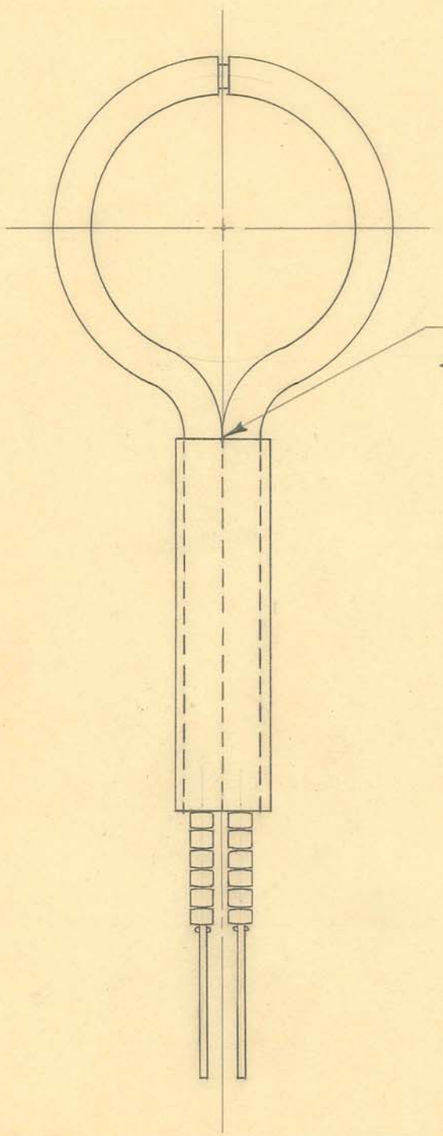

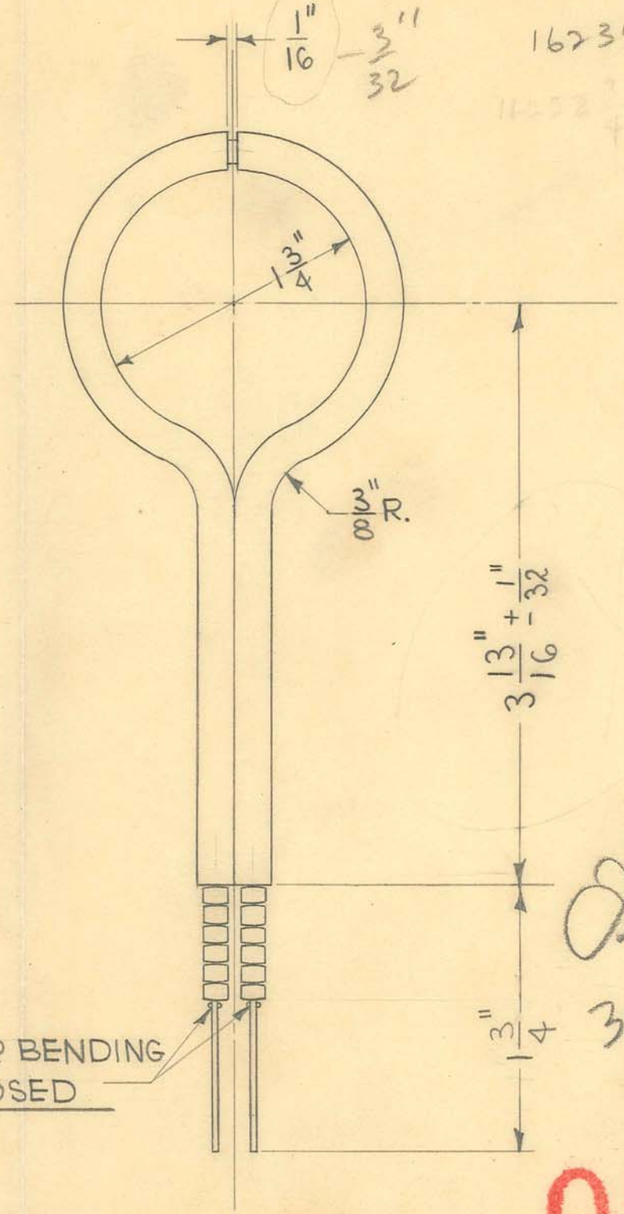

16334

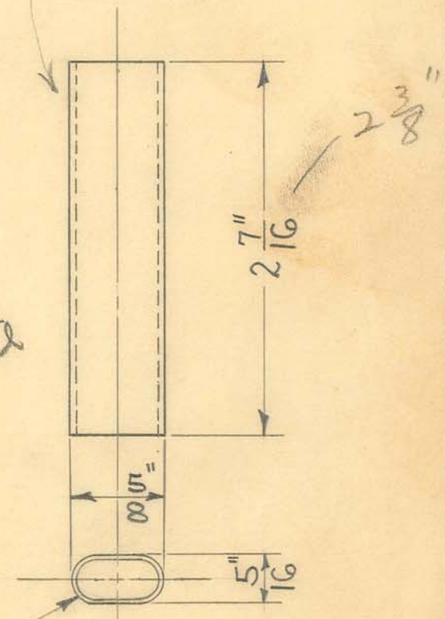

Obsolete 3-9-49

OBSOLETE

MATERIAL TO BE USED AS SPECIFIED ON YOUR DRAWING NO. L-11722

1 REQUIRED

DIMENSIONS	
FRACTIONAL	± .015
DECIMAL	± .005
ANGULAR	± 1/2°
UNLESS OTHERWISE SPECIFIED	

		ISSUE 5-10-48	W. J.
SIZE			
KIND		CHANGED	
SHAPE		"	
FINISH		"	
TEMP.		"	
PATT.		"	

TITLE: FISCHER MOD. "10" DIATHERMY
MODEL "300" PORTABLE DIATHERMY
FARRADAY PICK UP LOOP

H. G. FISCHER & CO.
2335 WABANSIA AVE.
CHICAGO, ILL.

CAT. NO.

PART NO. 17654

TITLE FISCHER MOD "10A" DIATHERMY OSCILLATING COIL ASSEM.

H. G. FISCHER & CO.
FRANKLIN PARK, ILLINOIS

DATE 6-16-52 DR. BY J.V.W. CH'K'D.

PART NO. 17655G

REVISION	DATE	BY

PATTERN | FINISH ACID DIP - SEE NOTE | SCALE FULL

TOOLS BRAZING FIX. #11777
DRILL JIG # 9815

MATERIAL 1-#16482 2-#16483

DIMENSIONS UNLESS OTHERWISE SPECIFIED
FRACTIONAL ± .015
DECIMAL ± .005
ANGULAR ± ½°

obsolete 2-26-57

OBSOLETE

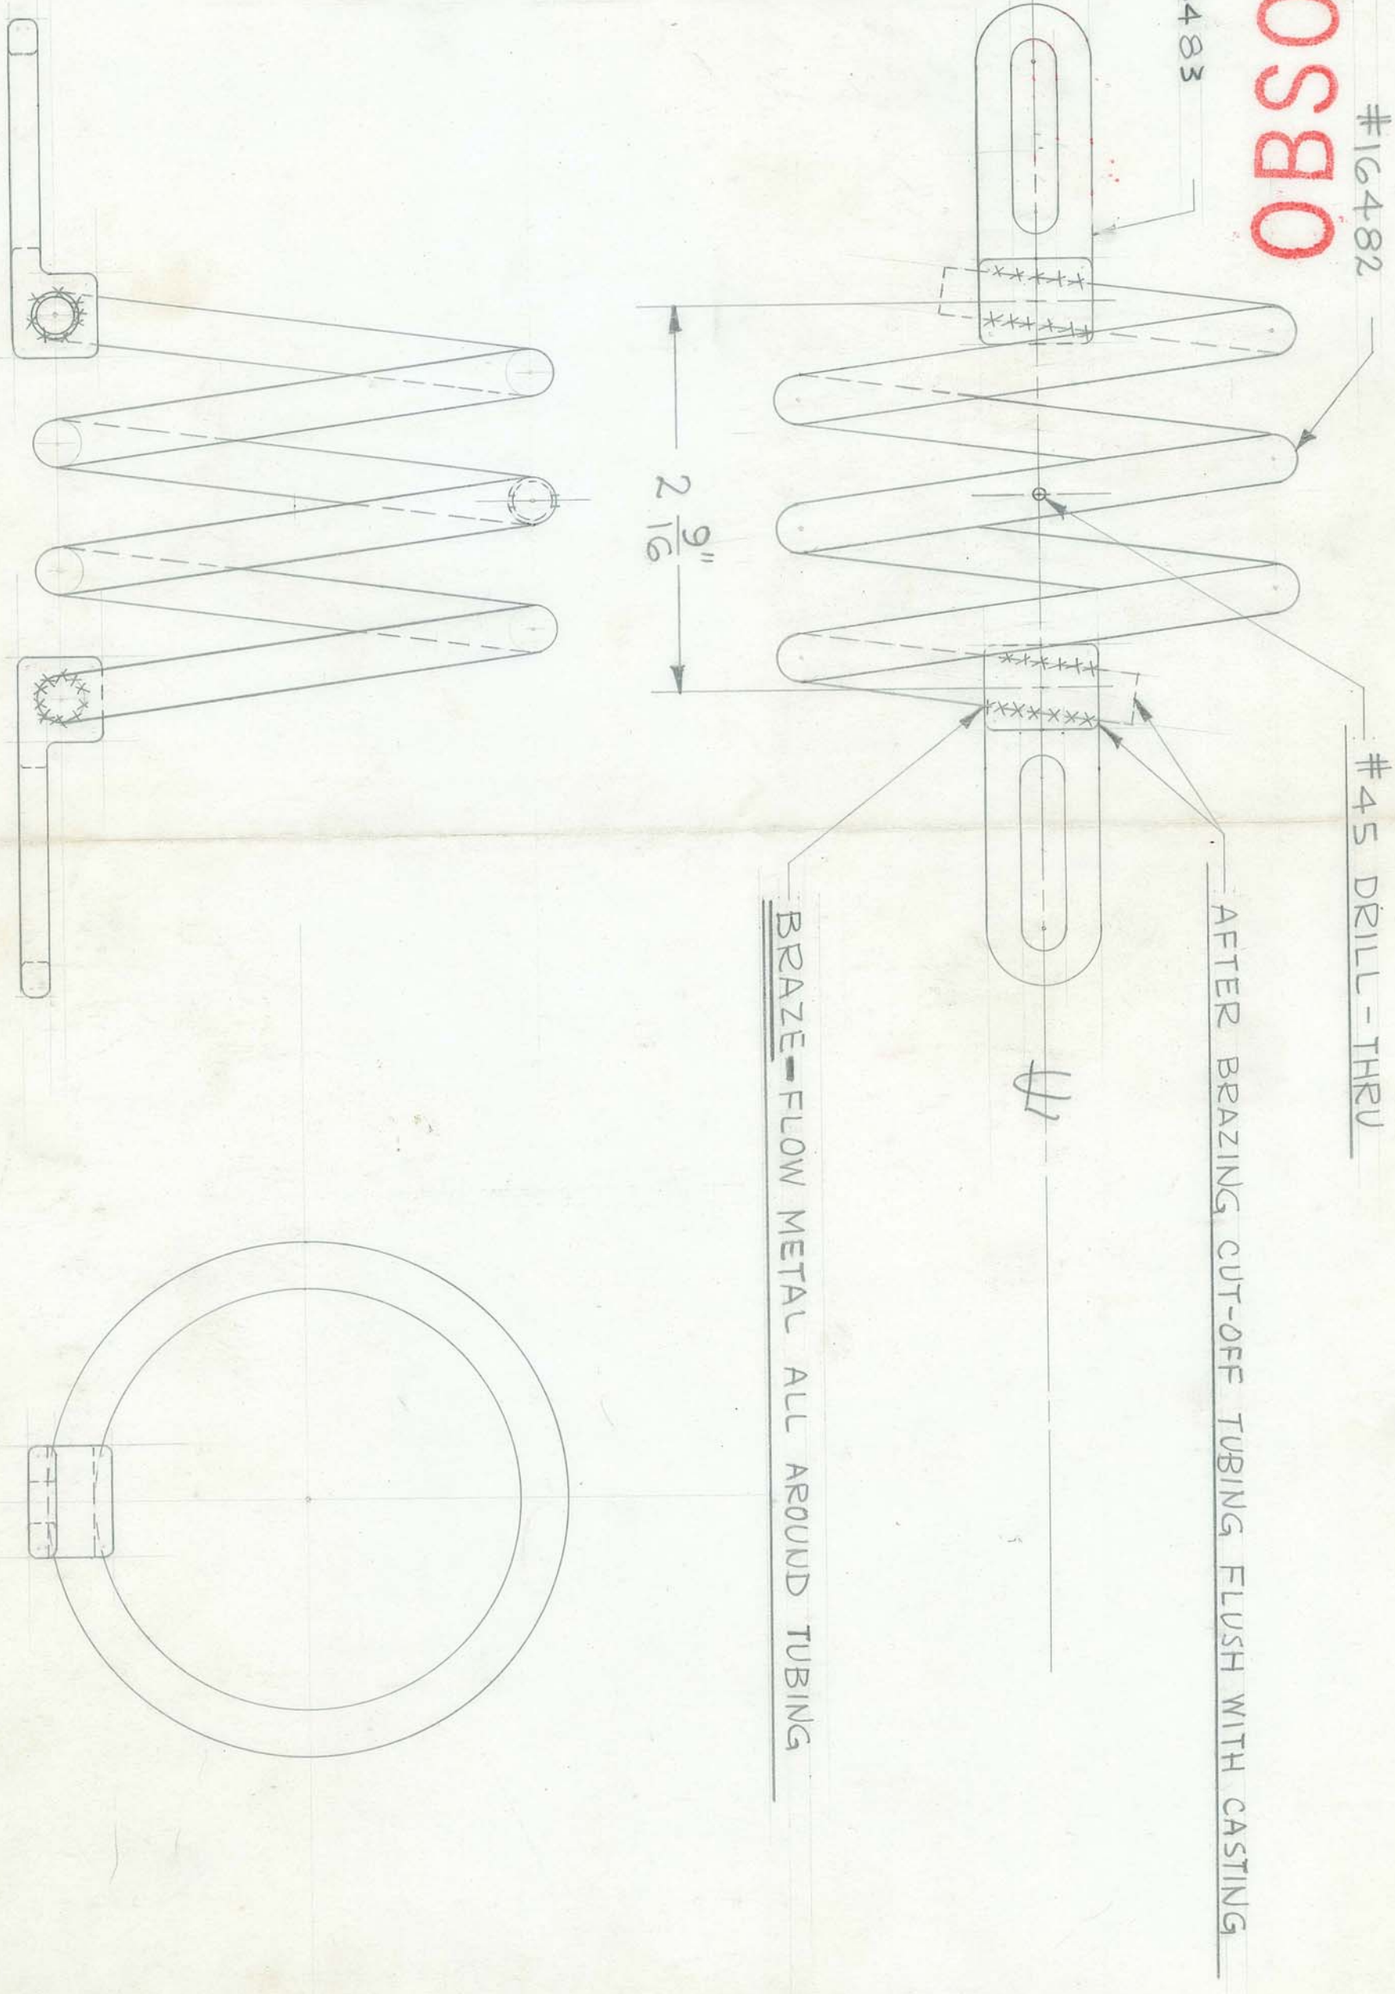

FOLDER #132

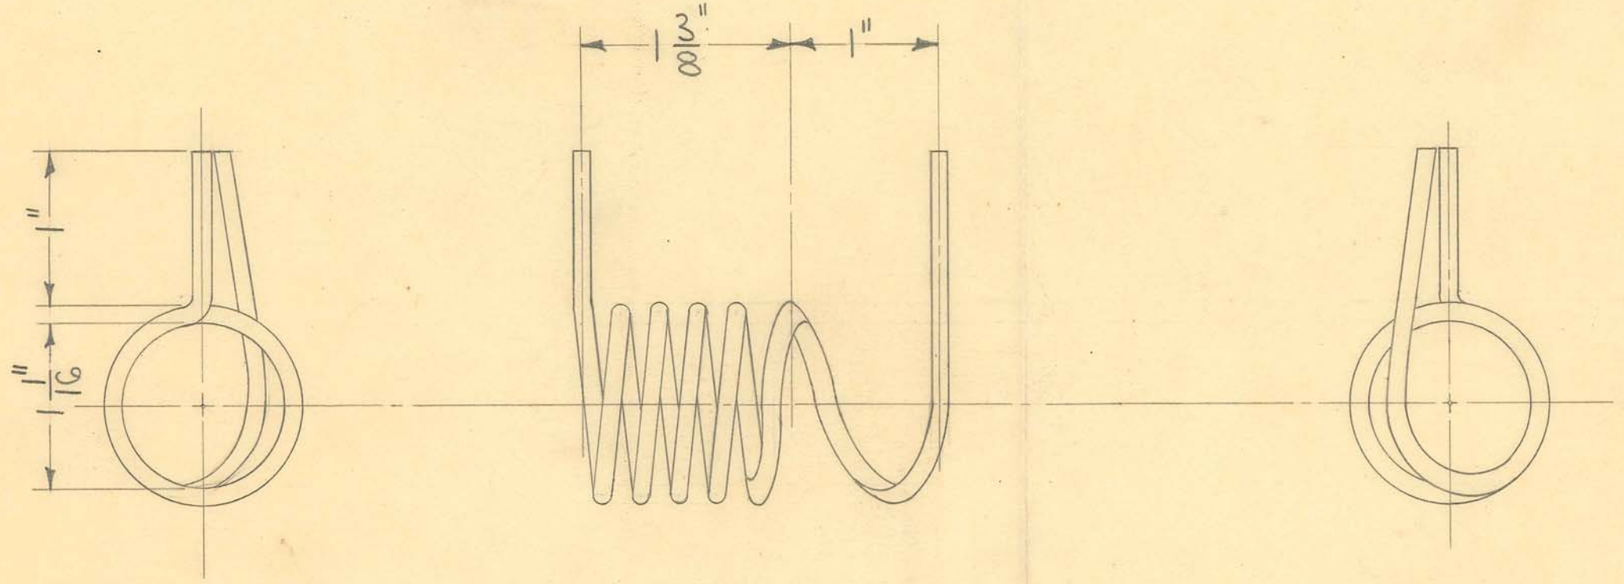

6 TURNS

FORMING MANDREL TOOL # 9009-9023.

XX Obsolete 6-21-49 W.J.

OBSOLETE

2 REQUIRED

SIZE	# 8 GA.	ISSUE 5-13-48	W. J.
KIND	BARE COPPER	CHANGED	
SHAPE	WIRE	"	
FINISH		"	
TEMP.		"	
PATT.		"	

DIMENSIONS
FRACTIONAL ± .015
DECIMAL ± .005
ANGULAR ± 1/2°
UNLESS OTHERWISE SPECIFIED

TITLE: FISCHER MOD. "10" DIATHERMY
MODEL "300" PORTABLE DIATHERMY
PARALLEL COIL

H. G. FISCHER & CO.
2335 WABANSIA AVE.
CHICAGO, ILL.

CAT. NO.

PART NO. 17658

OBSOLETE

PART NO.	REVISION	DATE	BY
17737 G			

H. G. FISCHER & CO.
FRANKLIN PARK, ILLINOIS

DATE 12-28-48 DR. BY W.J. CH'K'D. J.V.W.

DIMENSIONS
FRACTIONAL ±.015
DECIMAL ±.003
ANGULAR ±½°
UNLESS OTHERWISE SPECIFIED

TITLE
FISCHER WALL FRAME TILTING BUCKY STAND
CWT. TUBE ASSEMBLY - 14" X 36" BUCKY

SCALE FULL

PATTERN

FINISH

TOOLS FILLING CAP #9975

MATERIAL

3-26-53

INSERT PINS PCE. # 17003
& RIVET BOTH ENDS
FILE TO CONTOUR OF TUBE

PCE. # 17959A

PCE. # 17731

$\frac{11}{16}$"

FILL TUBE WITH LEAD TO BRING TOTAL WEIGHT UP TO 43 LBS. ± ½ LB.

2 REQUIRED

1/X

TITLE FISCHER TILTING BUCKY STAND FLOOR FLANGE

H. G. FISCHER & CO.
FRANKLIN PARK, ILLINOIS

PART NO. 17756 DF

DATE 10-7-53 DR. BY J.V.W. CH'K'D. RS

REVISION		DATE	BY
B	WAS ½" DRILL	3-29-67	[illegible]
C	WAS 3 HLS 17/64 DRILL	7-11-67	J.V.W.
D_1	3 HLS CAST	7-13-67	M.N.
D_2	¼ x 20 HLS. REPOSITIONED	7-15-67	M.N.

PATTERN 2352 FINISH PAINTED SCALE FULL

TOOLS DRILL JIG #5862 MATERIAL CAST IN #12 ALUMINUM FROM #17756B

DIMENSIONS
FRACTIONAL ± .015
DECIMAL ± .005
ANGULAR ± ½°
UNLESS OTHERWISE SPECIFIED

CINT. FIXT # 14391

OBSOLETE
DATE 10-29-71
REFER TO CHG. E
FOR DETAILS SEE E. C. O. # 1379
ENGINEER J.V.W.
DRAFTSMAN RS

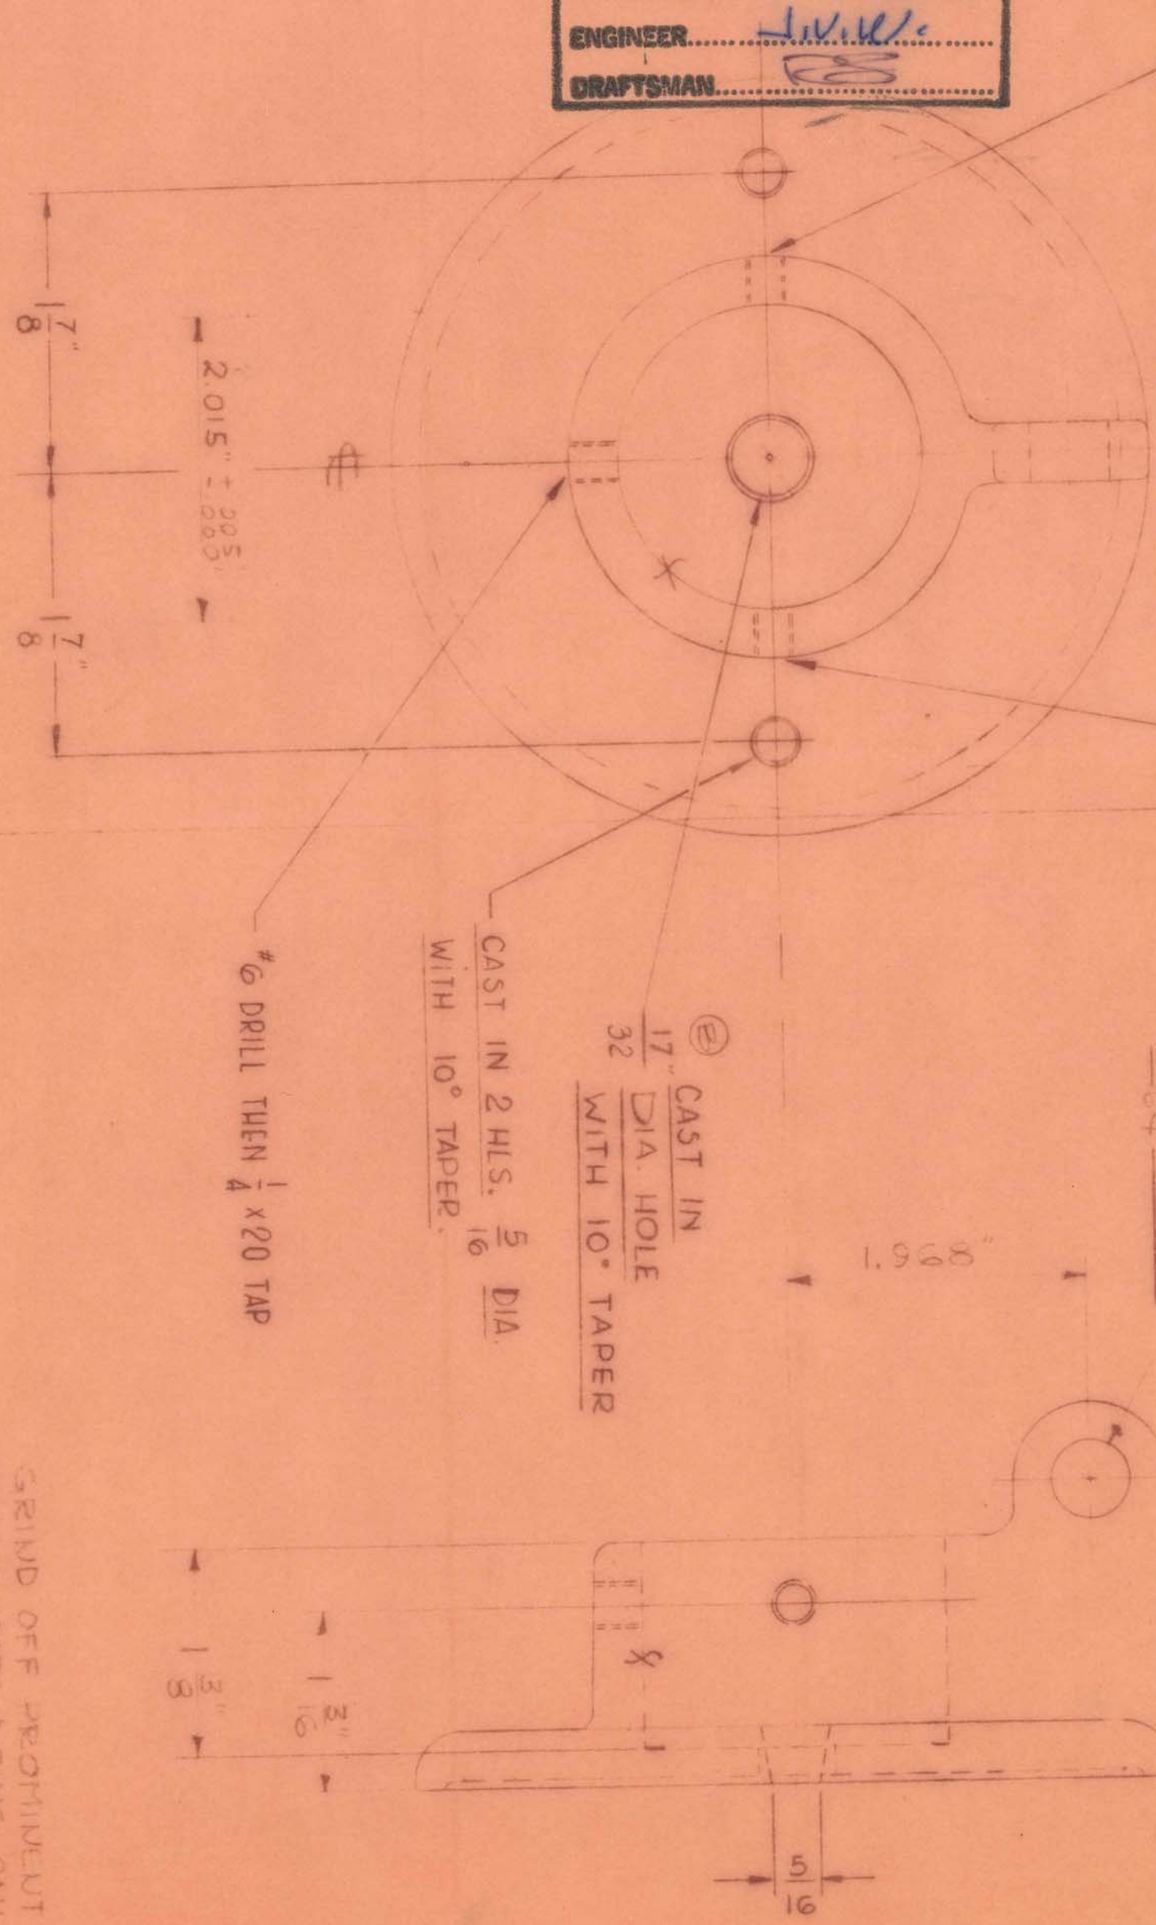

GRIND OFF PROMINENT ROUGH SPOTS & FINS ONLY

FOLDER # 134

FOLDER # 13H

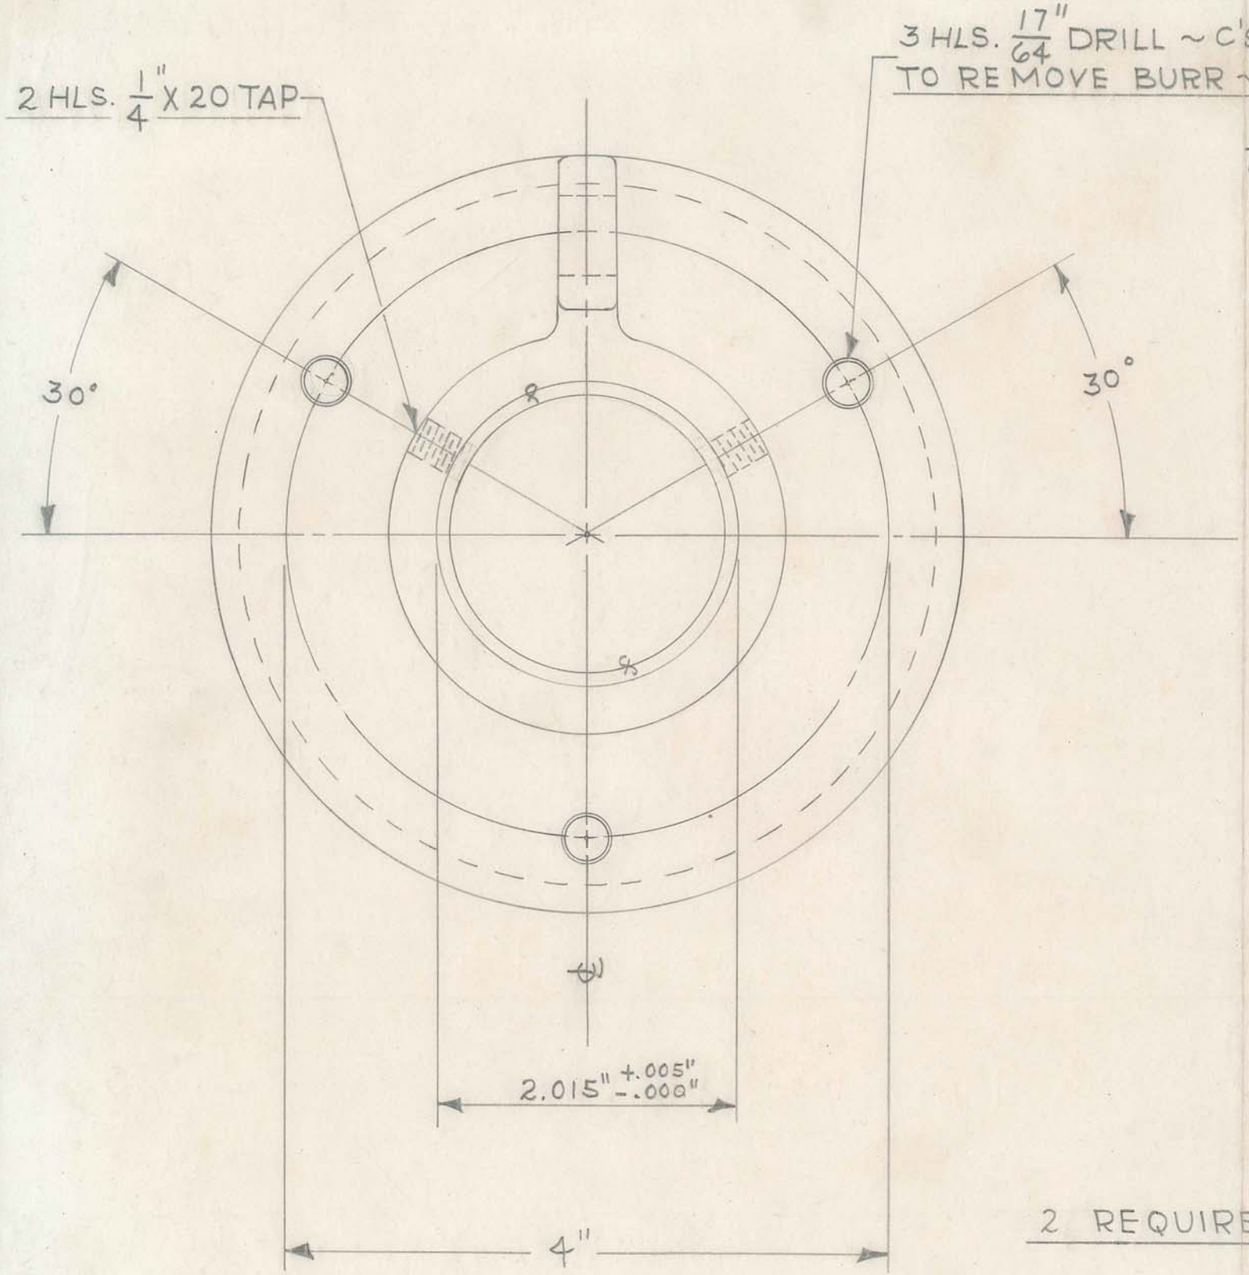

2 REQUIRED

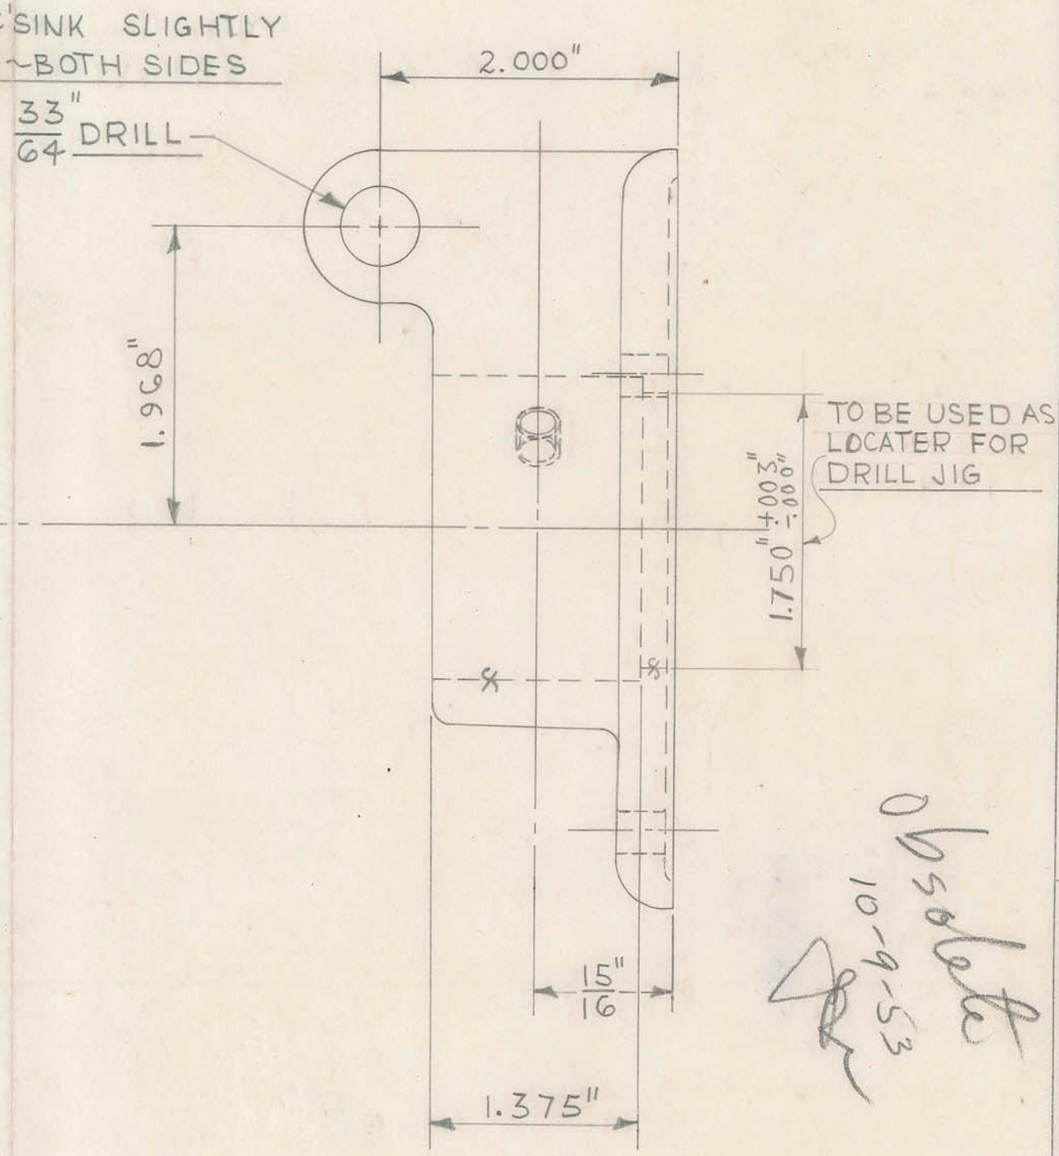

GRIND OFF PROMINENT ROUGH SPOTS & FINS ONLY

OBSOLETE

Obsolete
10-9-53

TITLE: FISCHER WALL-FRAME TILTING BUCKY STAND
FLOOR FLANGE

PATTERN 2352 | FINISH PAINTED | SCALE FULL

TOOLS DRILL JIG TOOL # 9862 | MATERIAL CAST IN #12 ALUM.

DIMENSIONS: FRACTIONAL ±.015 | DECIMAL ±.005 | ANGULAR ±½° | UNLESS OTHERWISE SPECIFIED

DATE 9-7-48 | DR. BY W.J. | CH'K'D. J.V.W.

H. G. FISCHER & CO.
FRANKLIN PARK, ILLINOIS

PART NO. 17756 F

REVISION	DATE	BY

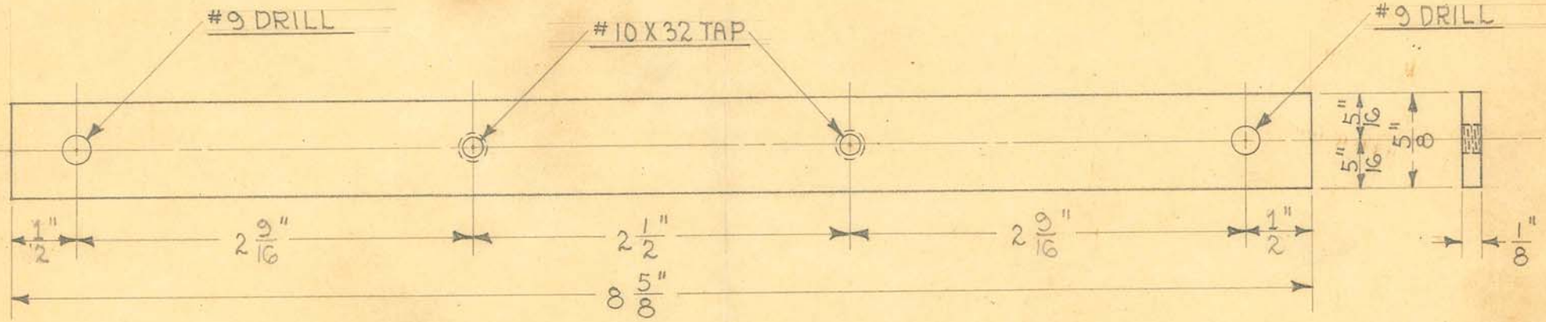

1 REQUIRED

OBSOLETE

SIZE	5/8" X 1/8"	ISSUE 4-4-36	A.B.	TITLE: MODEL "SP-GO" SHOCKPROOF RAD. UNIT CONTROL BOX RESISTOR SUPPORT STRAP
KIND	C.R. STEEL	CHANGED		
SHAPE		" "		
FINISH		" "		
TEMP.		" "		
PATT.		" "		

H. G. FISCHER & CO.
2335 WABANSIA AVE.
CHICAGO, ILL.

CAT. NO.

PART NO. 9725 1/2

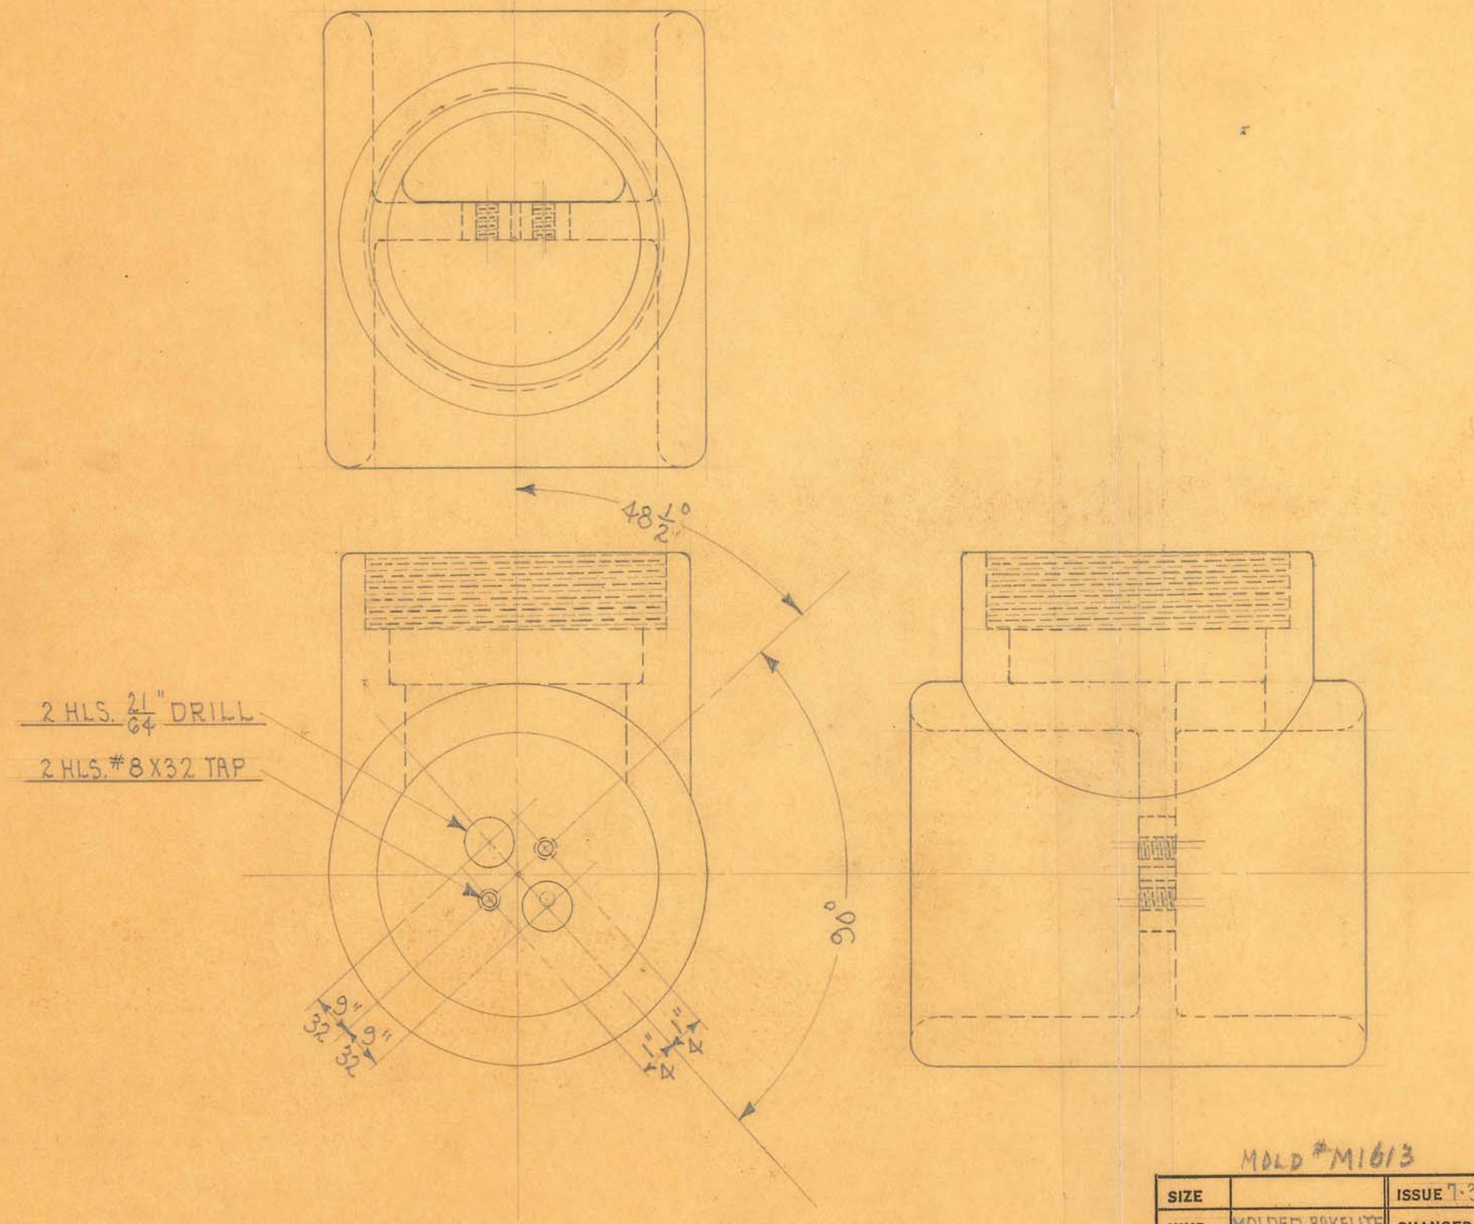

1 REQUIRED

OBSOLETE

MOLD #M1613

SIZE		ISSUE 7-30-35	26
KIND	MOLDED BAKELITE	CHANGED	
SHAPE		" "	
FINISH		" "	
TEMP.		" "	

TITLE: MODEL "SP-GO" SHOCKPROOF RAD. UNIT
HIGH TENSION CABLE TIP HOLDER-RIGHT

H. G. FISCHER & CO.
2335 WABANSIA AVE.

CAT. NO.

PART NO. 9739F

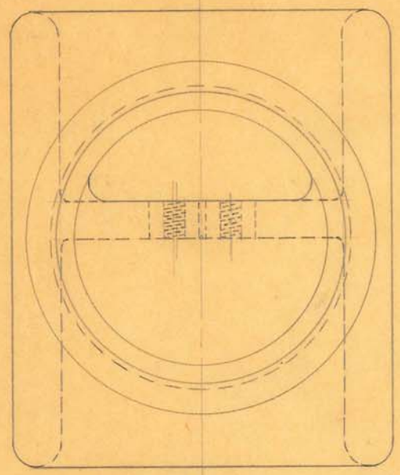

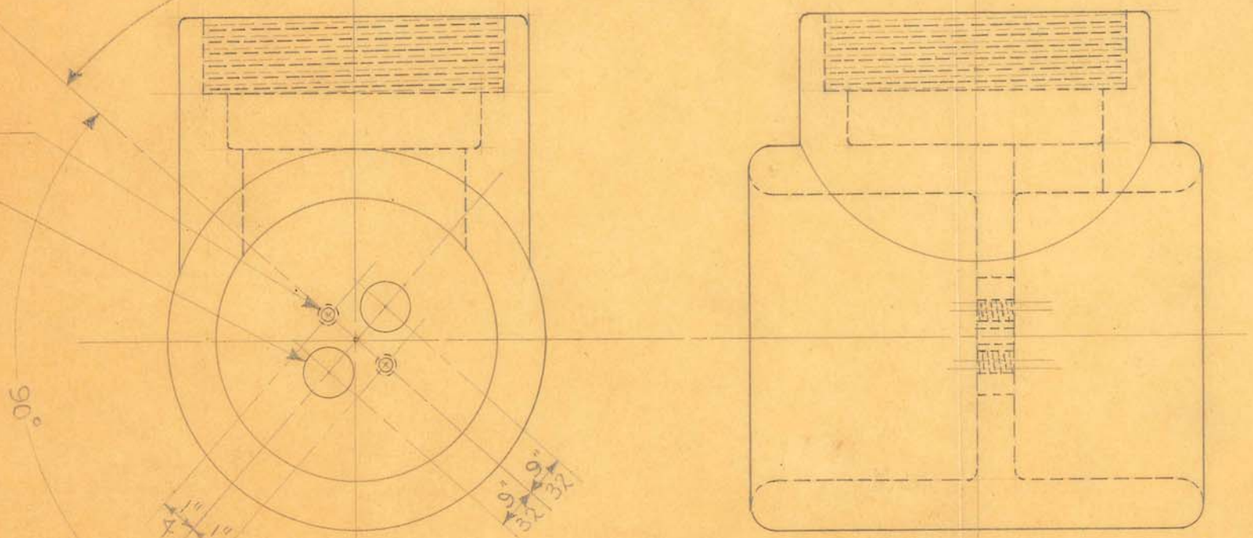

1 REQUIRED

OBSOLETE

SIZE		ISSUE 8-5-35	H.E.
KIND	MOLDED BAKELITE	CHANGED	
SHAPE		" "	
FINISH		" "	
TEMP.		" "	

TITLE: MODEL "SP-GO" SHOCKPROOF RAD. UNIT
HIGH TENSION CABLE TIP HOLDER - LEFT

H. G. FISCHER & CO.
2335 WABANSIA AVE.

CAT. NO.

PART NO. 9740

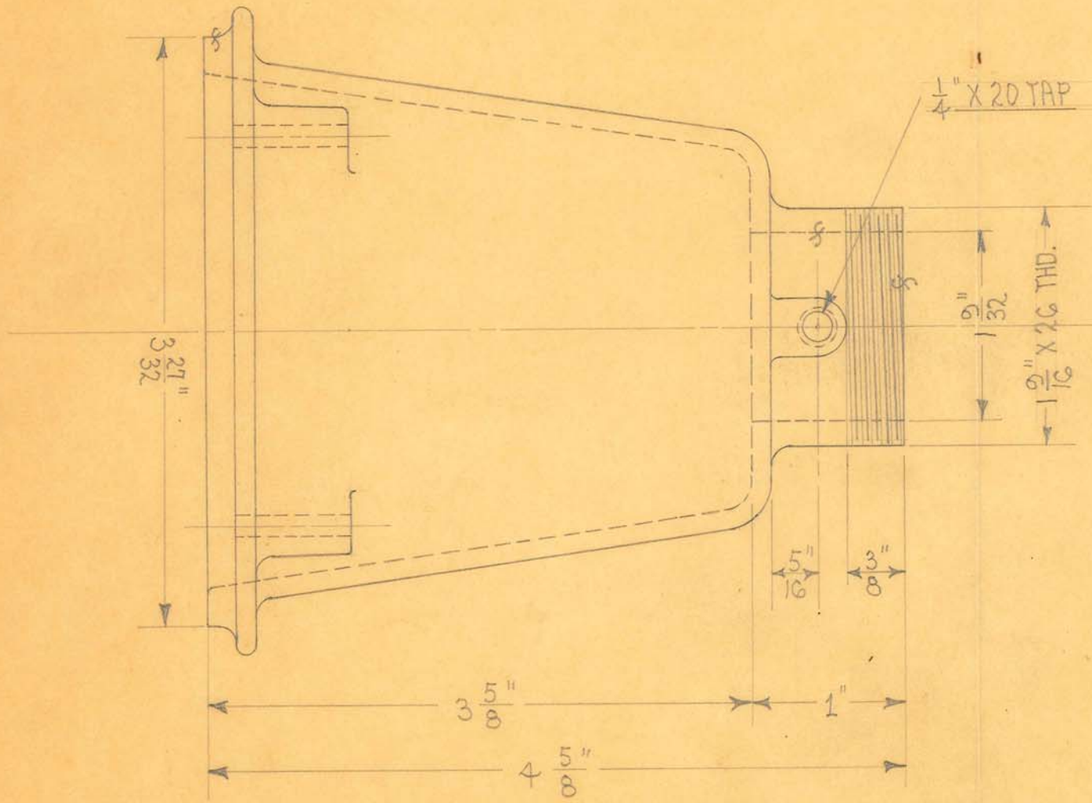

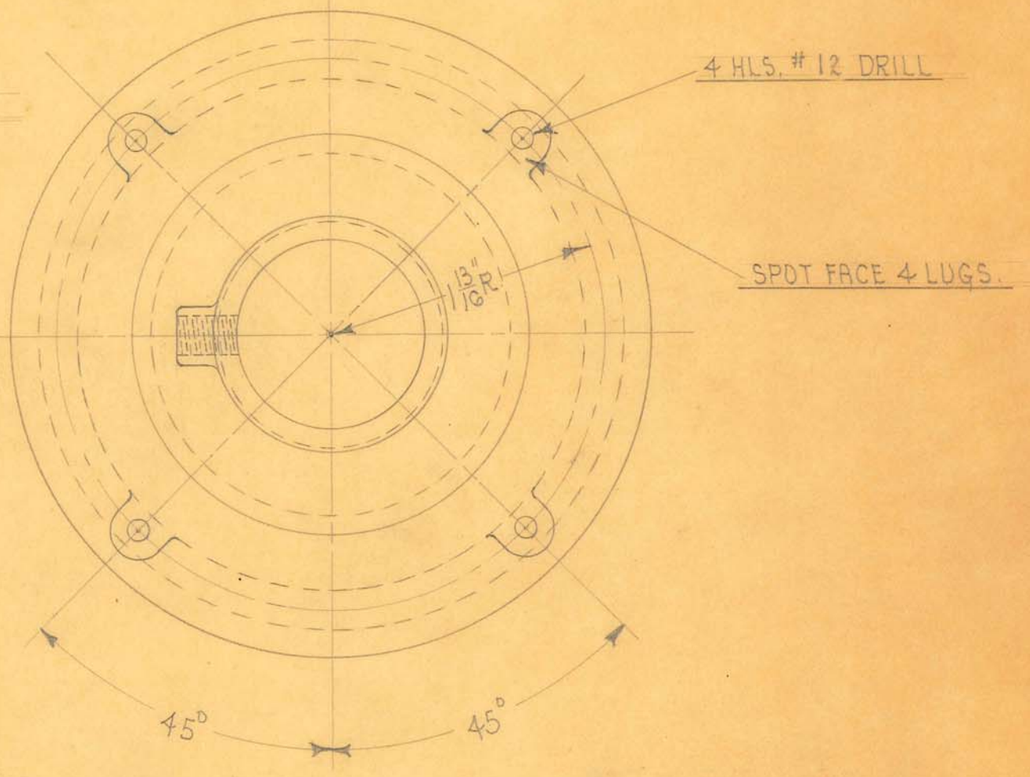

2 REQUIRED

OBSOLETE

SIZE		ISSUE 8-12-35	A.E.
KIND	ALUM. CASTING	CHANGED	
SHAPE		" "	
FINISH	IVORY #52	" "	
TEMP.		" "	

TITLE:
MODEL "SP-60" SHOCKPROOF RAD. UNIT
TRANS. STRESS CONE COVER

H. G. FISCHER & CO.
2335 WABANSIA AVE.

CAT. NO.

PART NO. 9745F

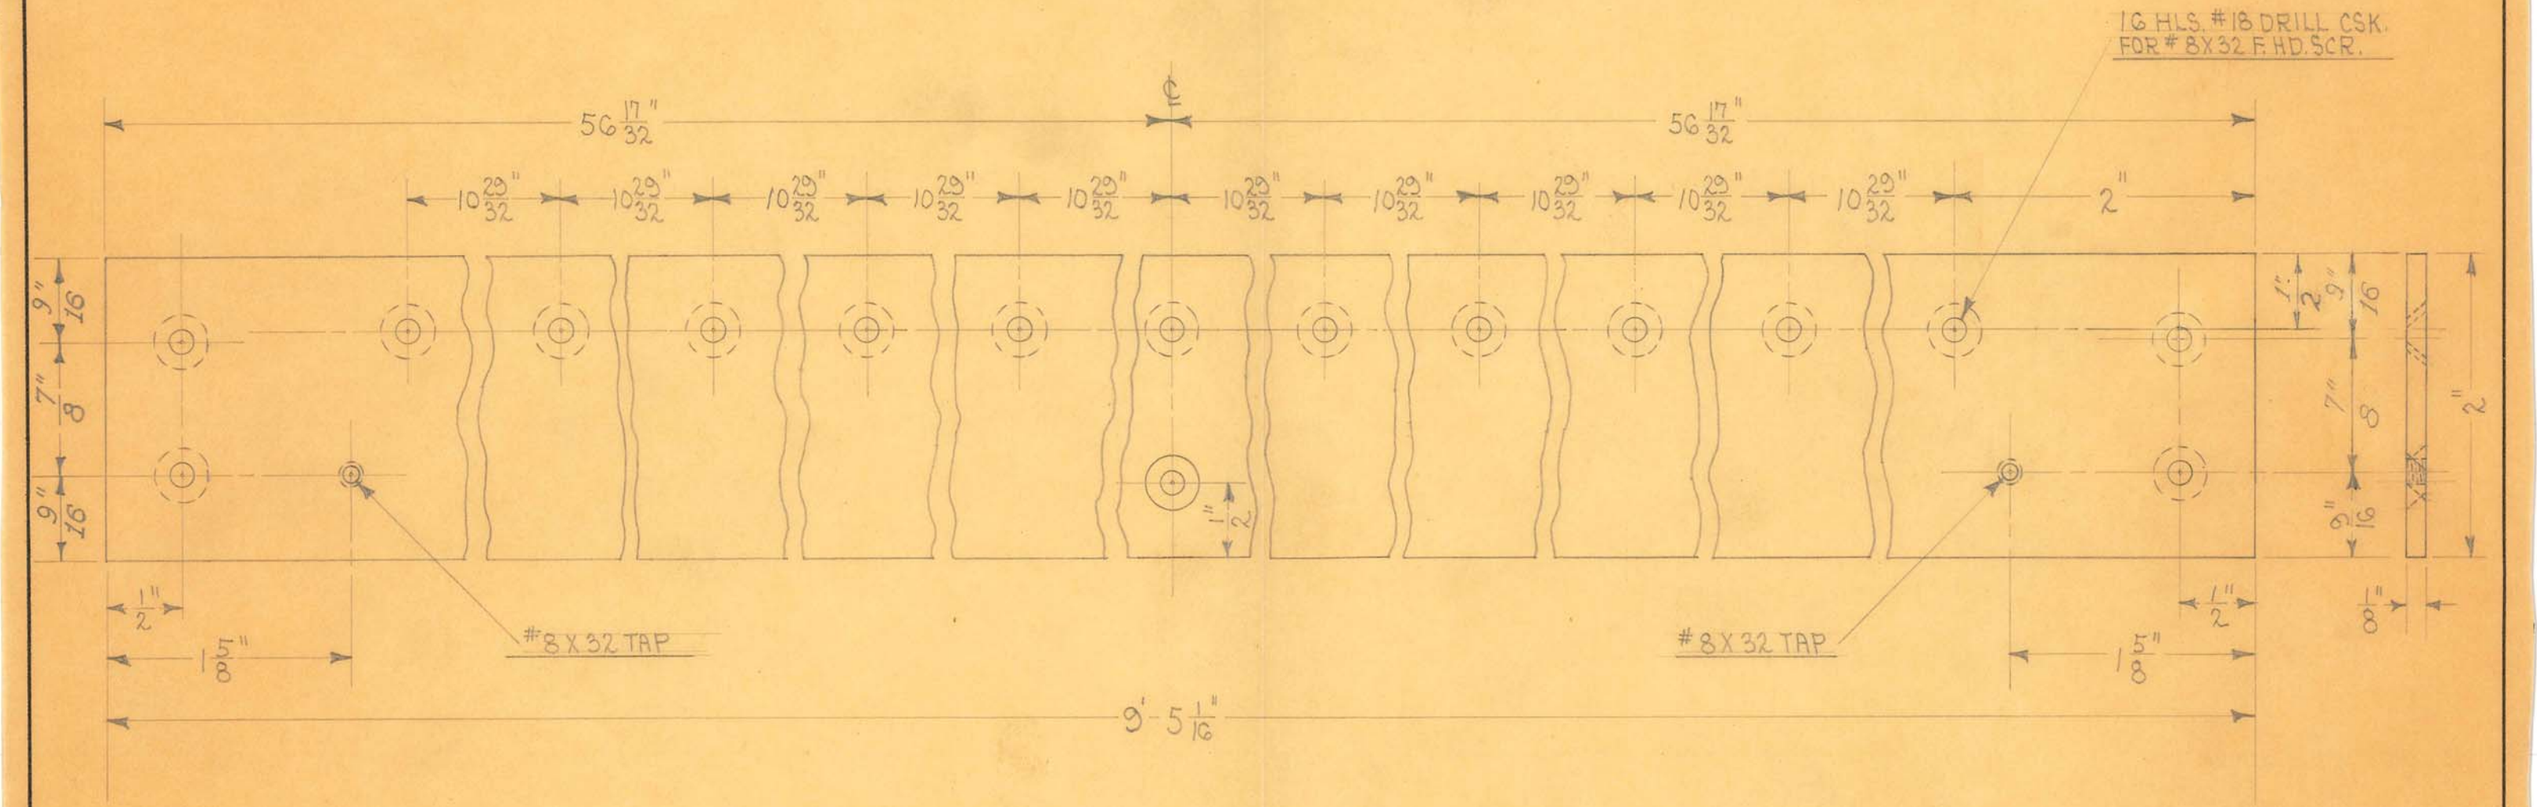

1 REQUIRED

OBSOLETE

SIZE	1/8" X 2"	ISSUE 9-4-35	A.E.
KIND	STRIP C.R. STEEL	CHANGED	
SHAPE		" "	
FINISH	CAD. # 23	" "	
TEMP.		" "	

TITLE: MOD. "SP-GO" SHOCKPROOF RAD. UNIT TUBE STAND RAIL PLATE

H. G. FISCHER & CO. 3335 WABANSIA AVE.

CAT.

PART 2750

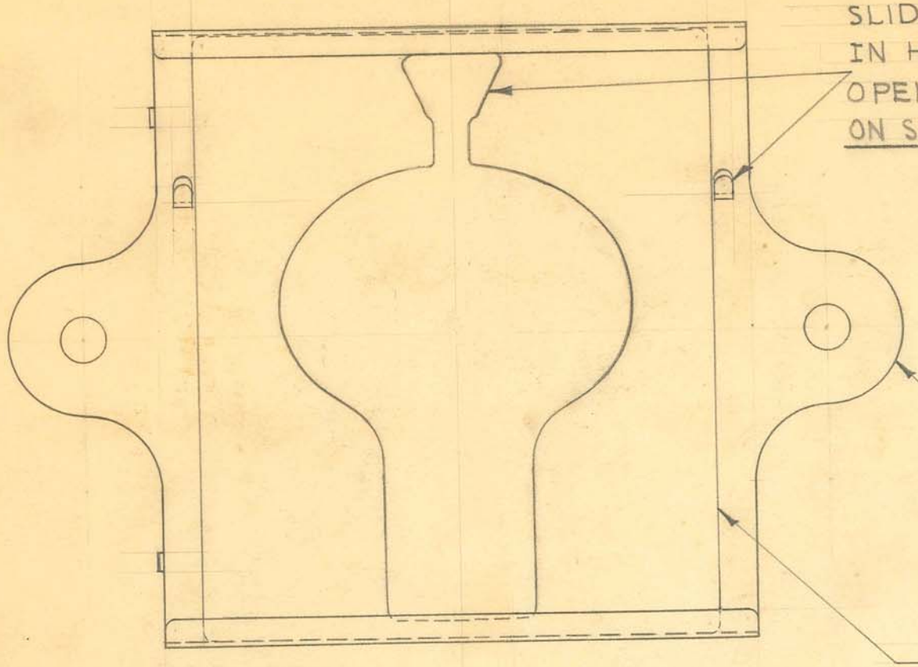

SLIDE 2 MAIN PLATES INTO PLACE IN HOUSING. TRIANGULAR SHAPED OPENING IN MAIN PLATES MUST BE ON SAME SIDE AS HOOKS IN HOUSING.

PCE. # 7966F - HOUSING

PCE. # 7968 1/2
2- MAIN PLATES

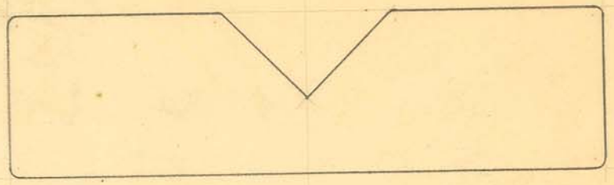

PCE. # 7972 1/2 — 1- PLATE MED. "V" SLOT

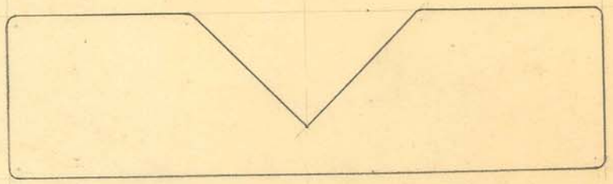

PCE. # 7973 1/2 - 1- PLATE - LARGE "V" SLOT - THIN

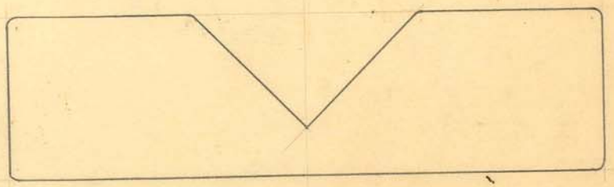

PCE. # 7974 1/2 - 1- PLATE - LARGE "V" SLOT - THICK

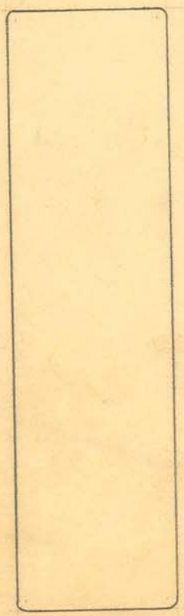

PCE. # 7969A - 2- PLATES - PLAIN

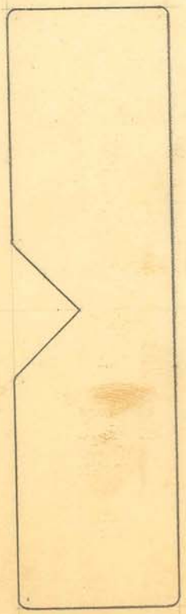

PCE. # 7971 1/2 - 1- PLATE SMALL "V" SLOT

OBSOLETE

SIZE		ISSUE 1-7-45	J.V.W.	TITLE: 36" SPINOGRAPH ADJUSTABLE FILTER-COMPLETE
KIND		CHANGED		
SHAPE		"		
FINISH		"		
TEMP.		"		
PATT.		"		

H. G. FISCHER & CO.
2335 WABANSIA AVE.
CHICAGO, ILL.

CAT. NO. 3553A

PART NO. 7965GA

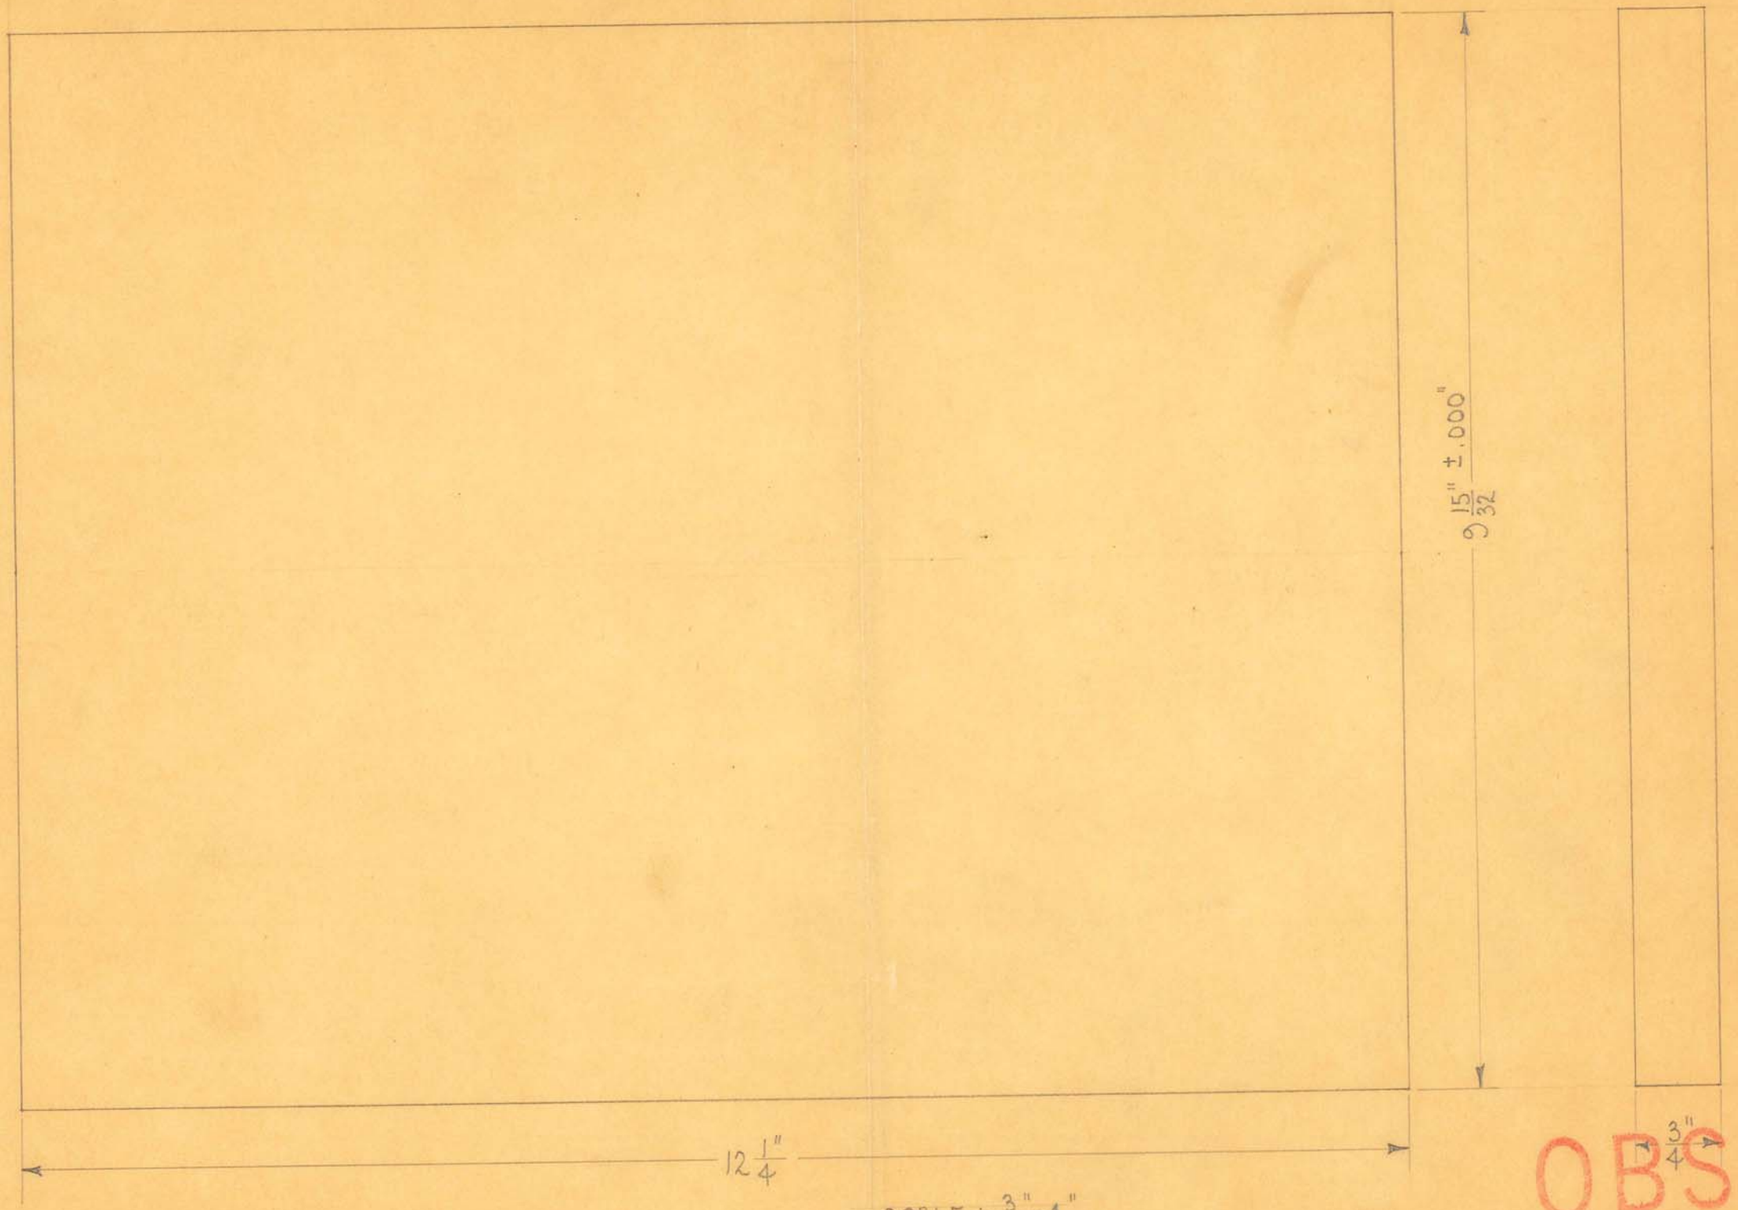

SCALE ÷ 3/4" = 1"

OBSOLETE

SIZE	3/4" X 3 7/16" X 12 1/4"	ISSUED 3-11-35	H.E.
KIND	BIRCH	CHANGED	
SHAPE		" "	
FINISH		" "	
TEMP.		" "	
PATT.		" "	

TITLE: FISCHER ADJ. HEADREST & CASSETTE HOLDER BASE

H. G. FISCHER & CO.
2335 WABANSIA AVE.
CHICAGO, ILL.

CAT. NO.

PART NO. 7981

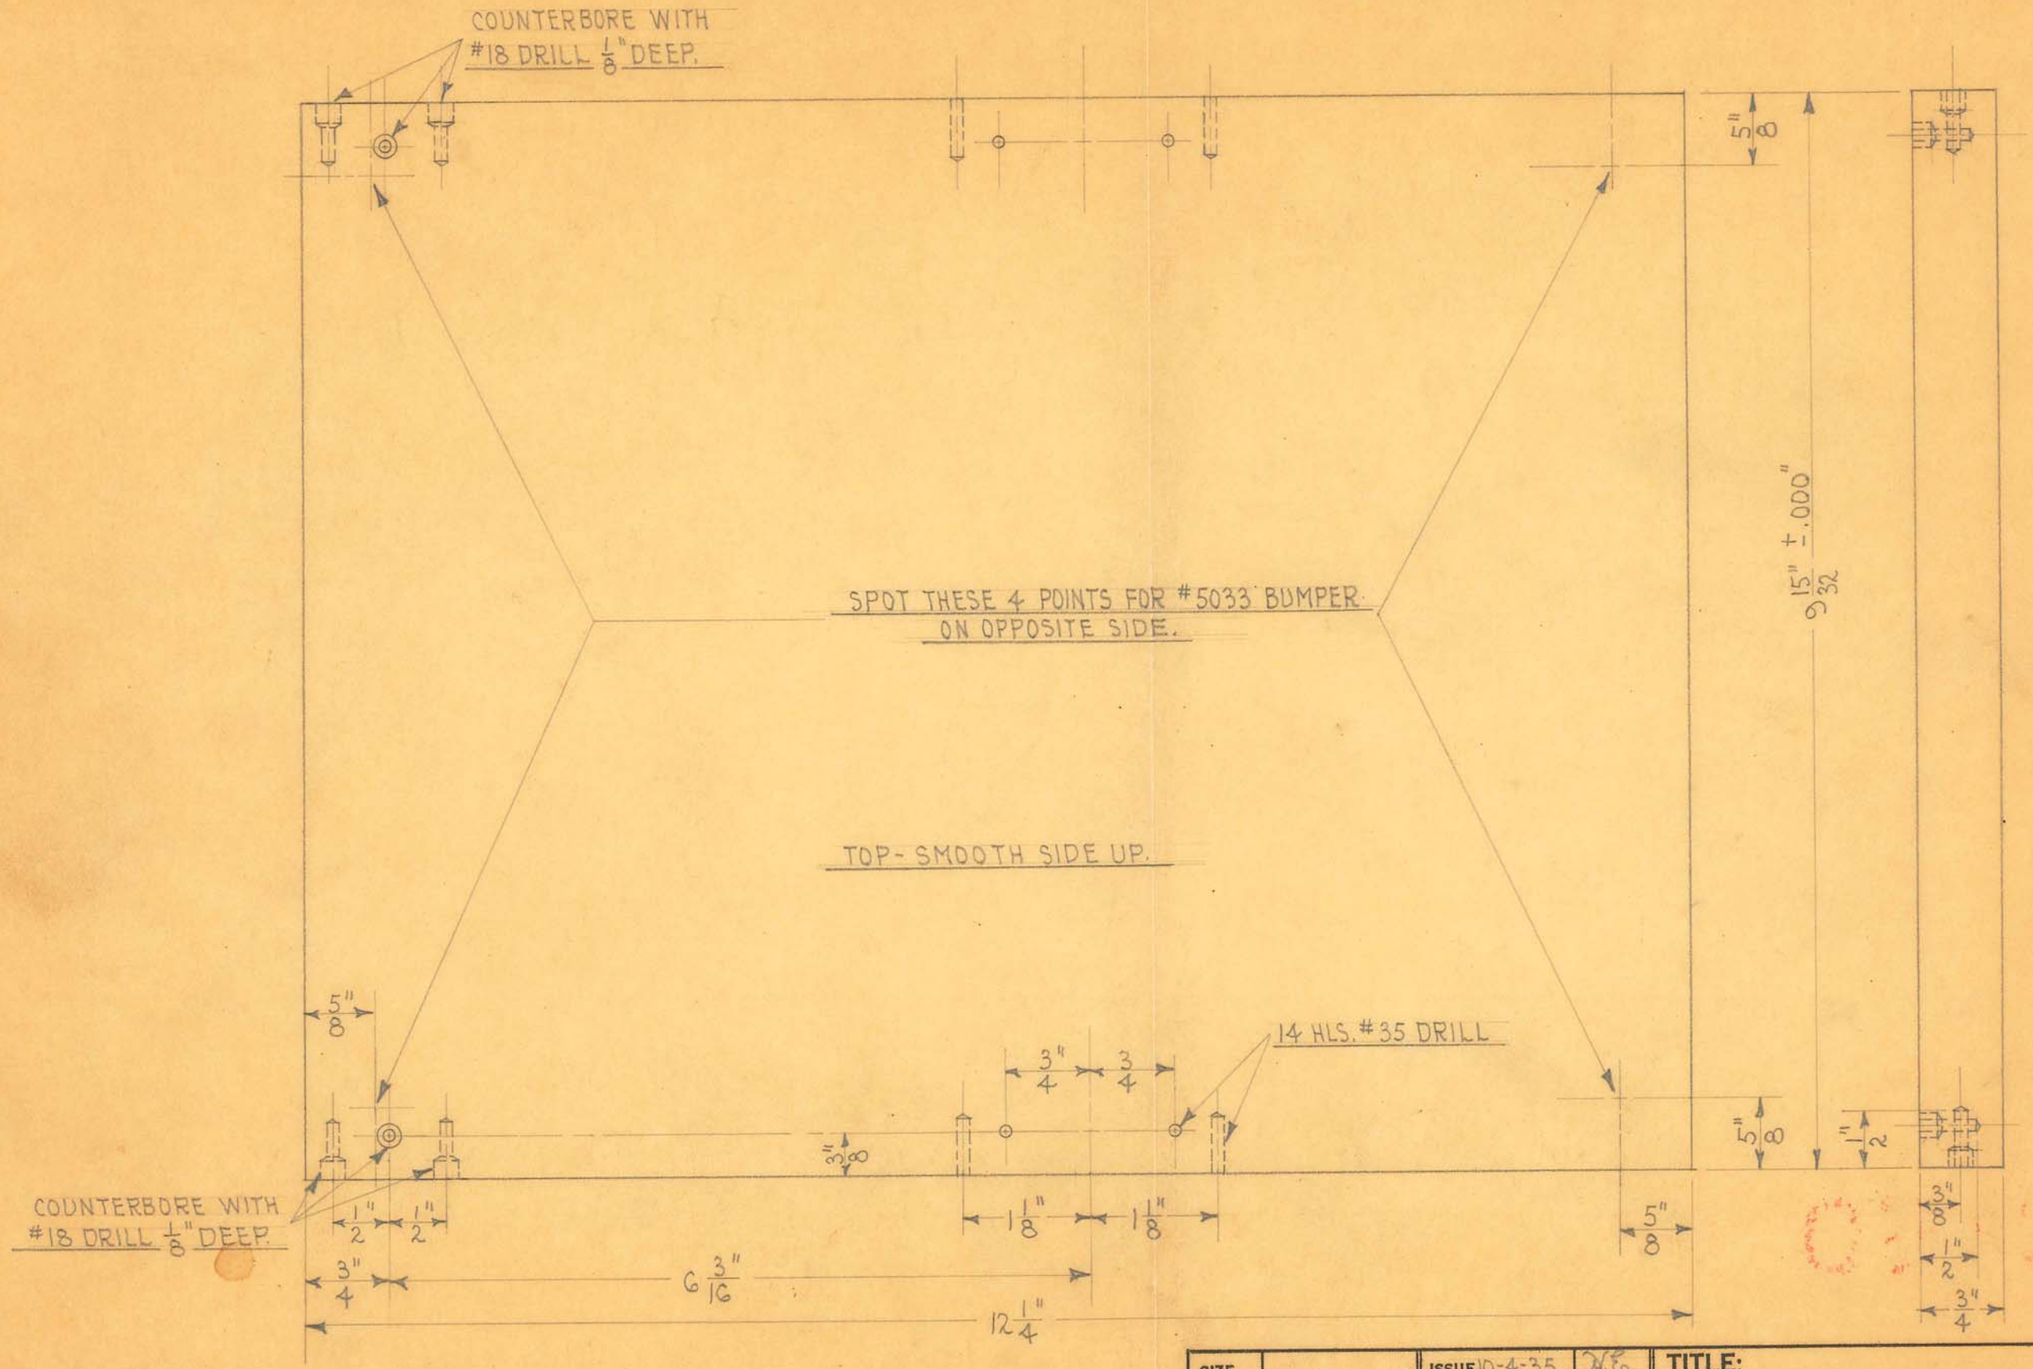

SCALE: 3/4" = 1"

OBSOLETE

SIZE		ISSUE 10-4-35	J.E.	TITLE: FISCHER ADJ. HEADREST & CASSETTE HOLDER BASE (DRILLED)
KIND		CHANGED		
SHAPE		" "		
FINISH	IVORY #91	" "		
TEMP.		" "		
PATT.		" "		

H. G. FISCHER & CO.
2335 WABANSIA AVE.
CHICAGO, ILL.

CAT. NO.

PART NO. 7981F

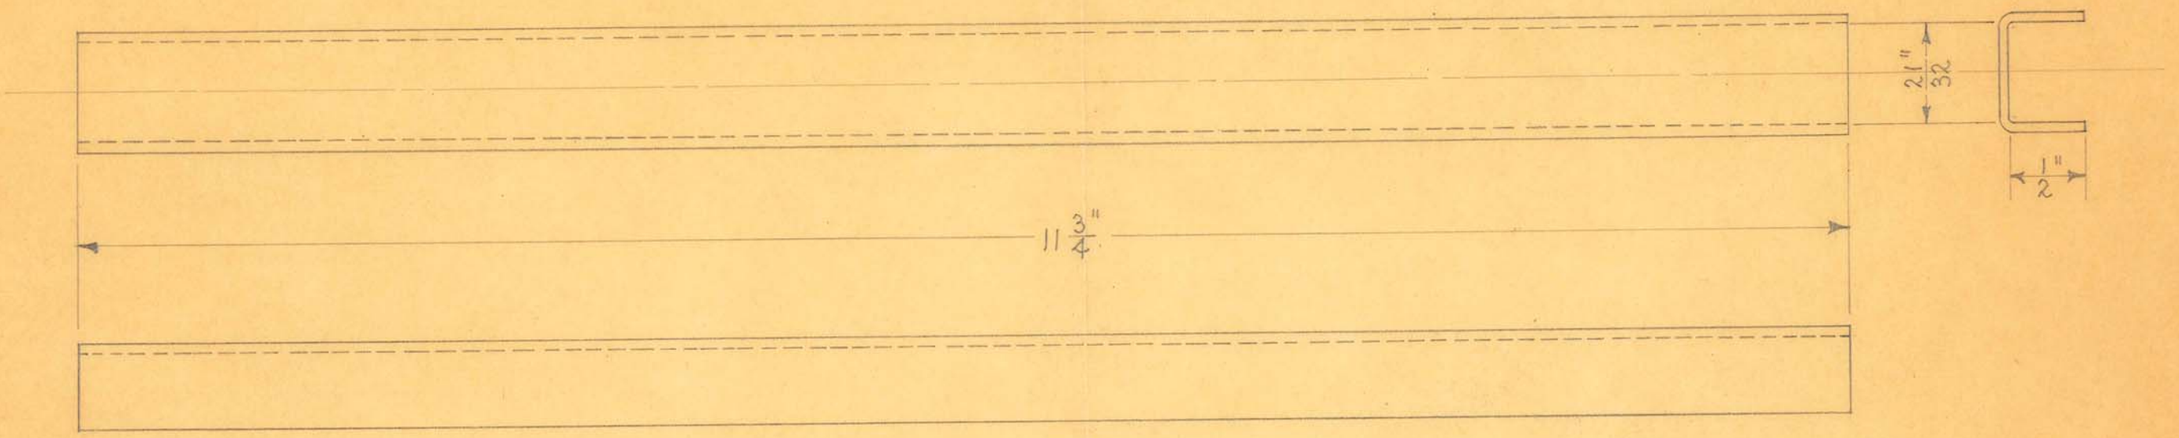

2 REQUIRED

OBSOLETE

SIZE	#16 GA. (.0625")	ISSUE 9-12-35	A.E.
KIND	C.R. STEEL	CHANGED	
SHAPE		" "	
FINISH		" "	
TEMP.		" "	
PATT.		" "	

TITLE: FISCHER ADJ. HEADREST & CASSETTE HOLDER
CASSETTE CHANNEL

H. G. FISCHER & CO.
2335 WABANSIA AVE.
CHICAGO, ILL.

CAT. NO.

PART NO. 7985

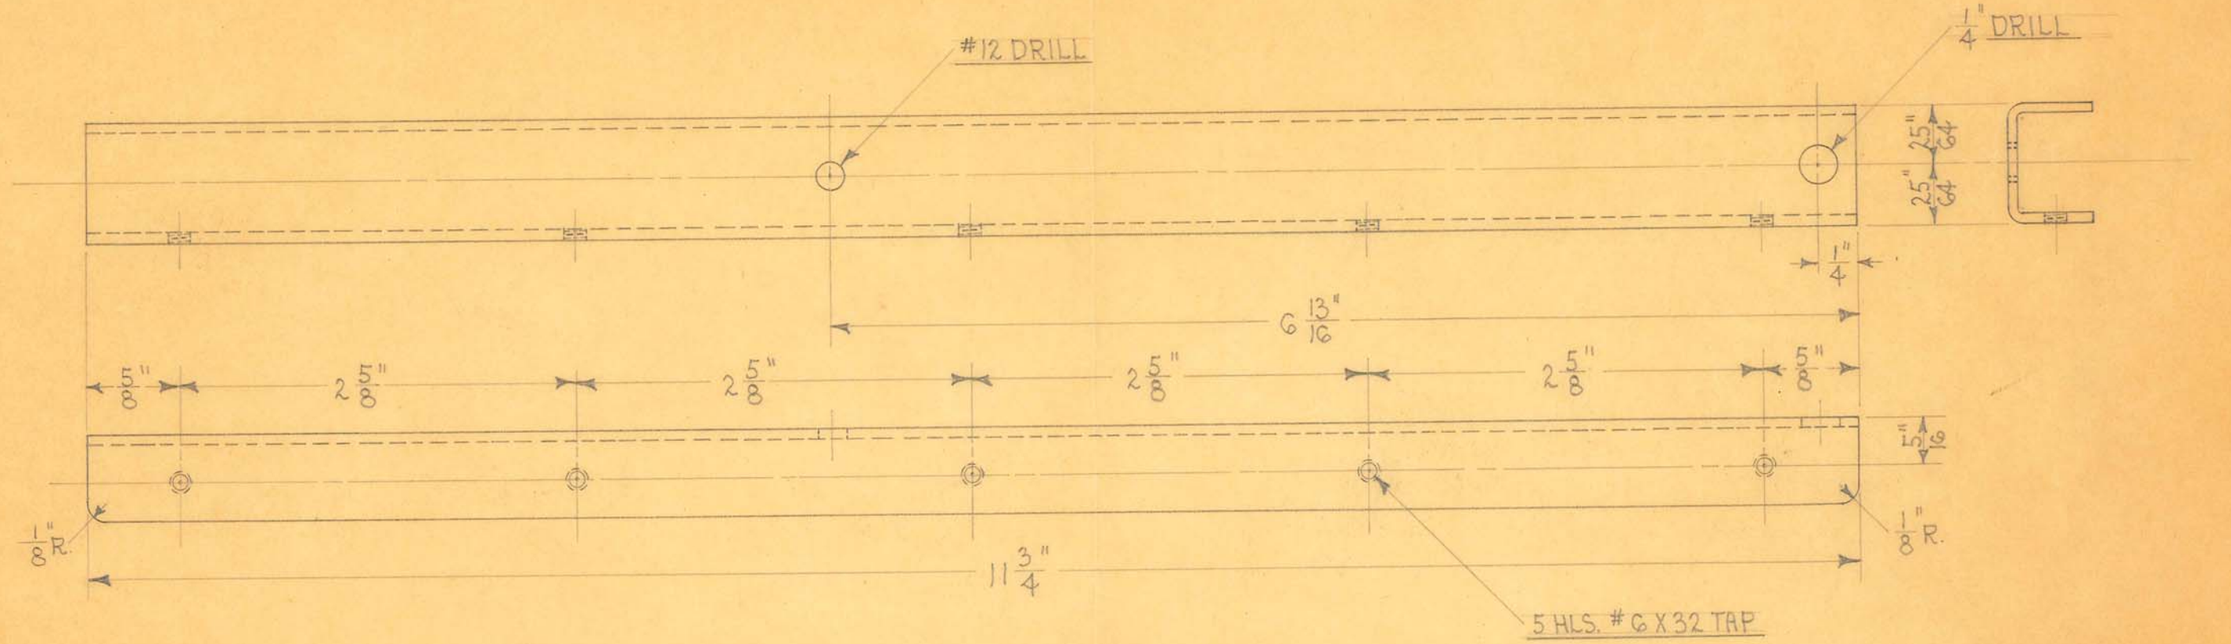

1 REQUIRED

OBSOLETE

SIZE		ISSUE 3-11-35	J.E.
KIND		CHANGED	
SHAPE		" "	
FINISH	CAD. # 23	" "	
TEMP.		" "	
PATT.		" "	

TITLE: FISCHER ADJ. HEADREST & CASSETTE HOLDER
CASSETTE CHANNEL - RIGHT

H. G. FISCHER & CO.
2335 WABANSIA AVE.
CHICAGO, ILL.

CAT. NO.

PART NO. 7985F

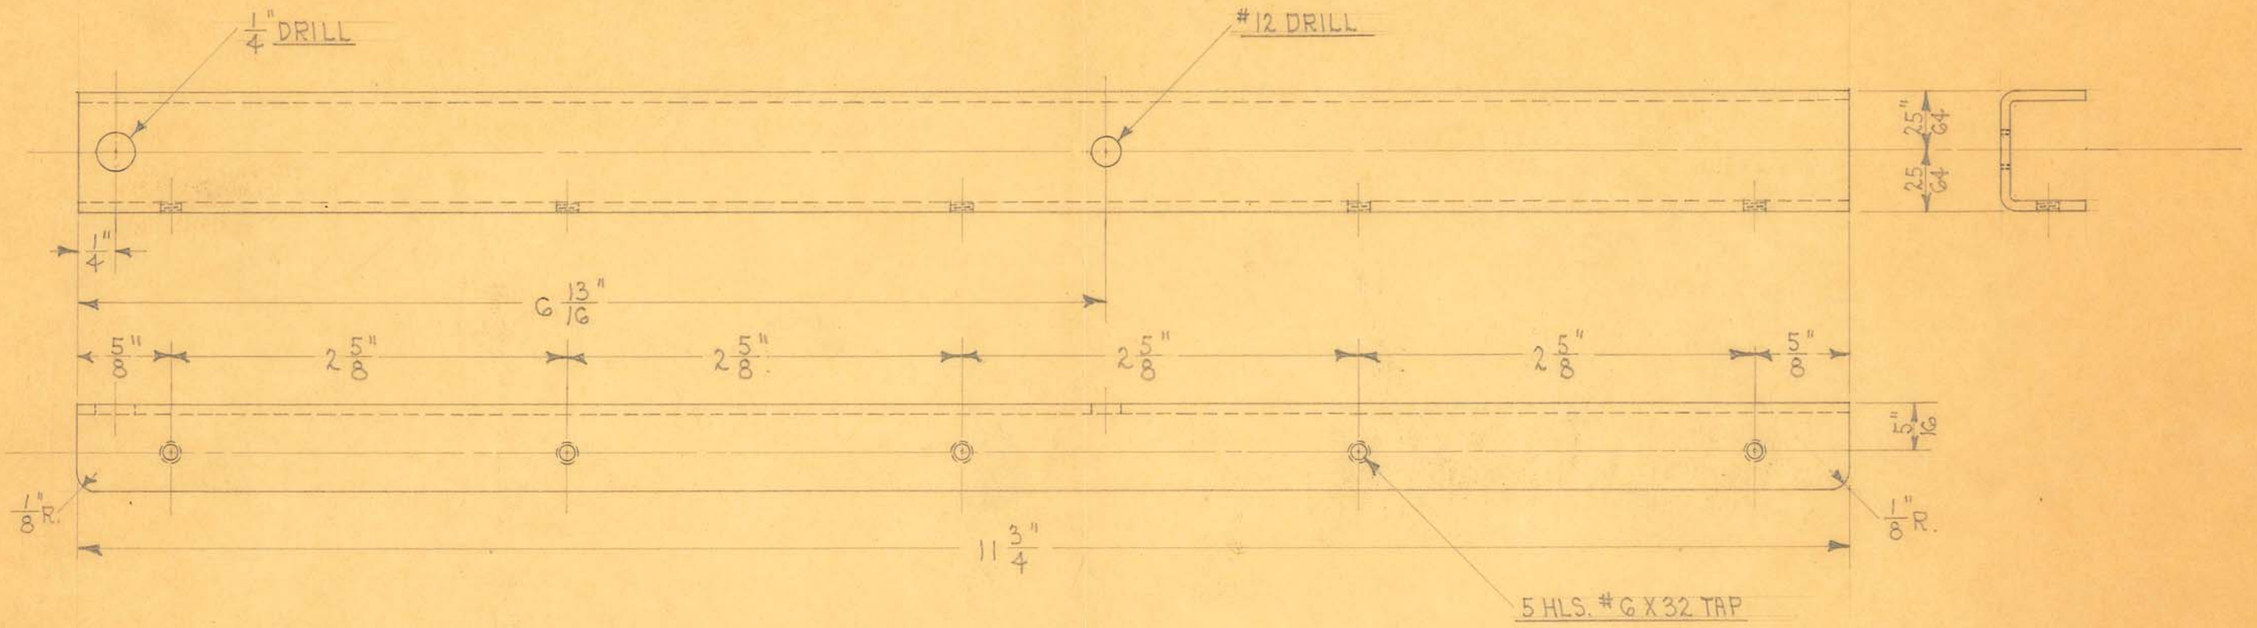

1 REQUIRED

OBSOLETE

SIZE		ISSUE 9-11-35	J.W.E.
KIND		CHANGED	
SHAPE		" "	
FINISH	CAD. #23	" "	
TEMP.		" "	
PATT.		" "	

TITLE: FISCHER ADJ. HEADREST & CASSETTE HOLDER
CASSETTE CHANNEL - LEFT

H. G. FISCHER & CO.
2335 WABANSIA AVE.
CHICAGO, ILL.

CAT. NO.

PART NO. 7986

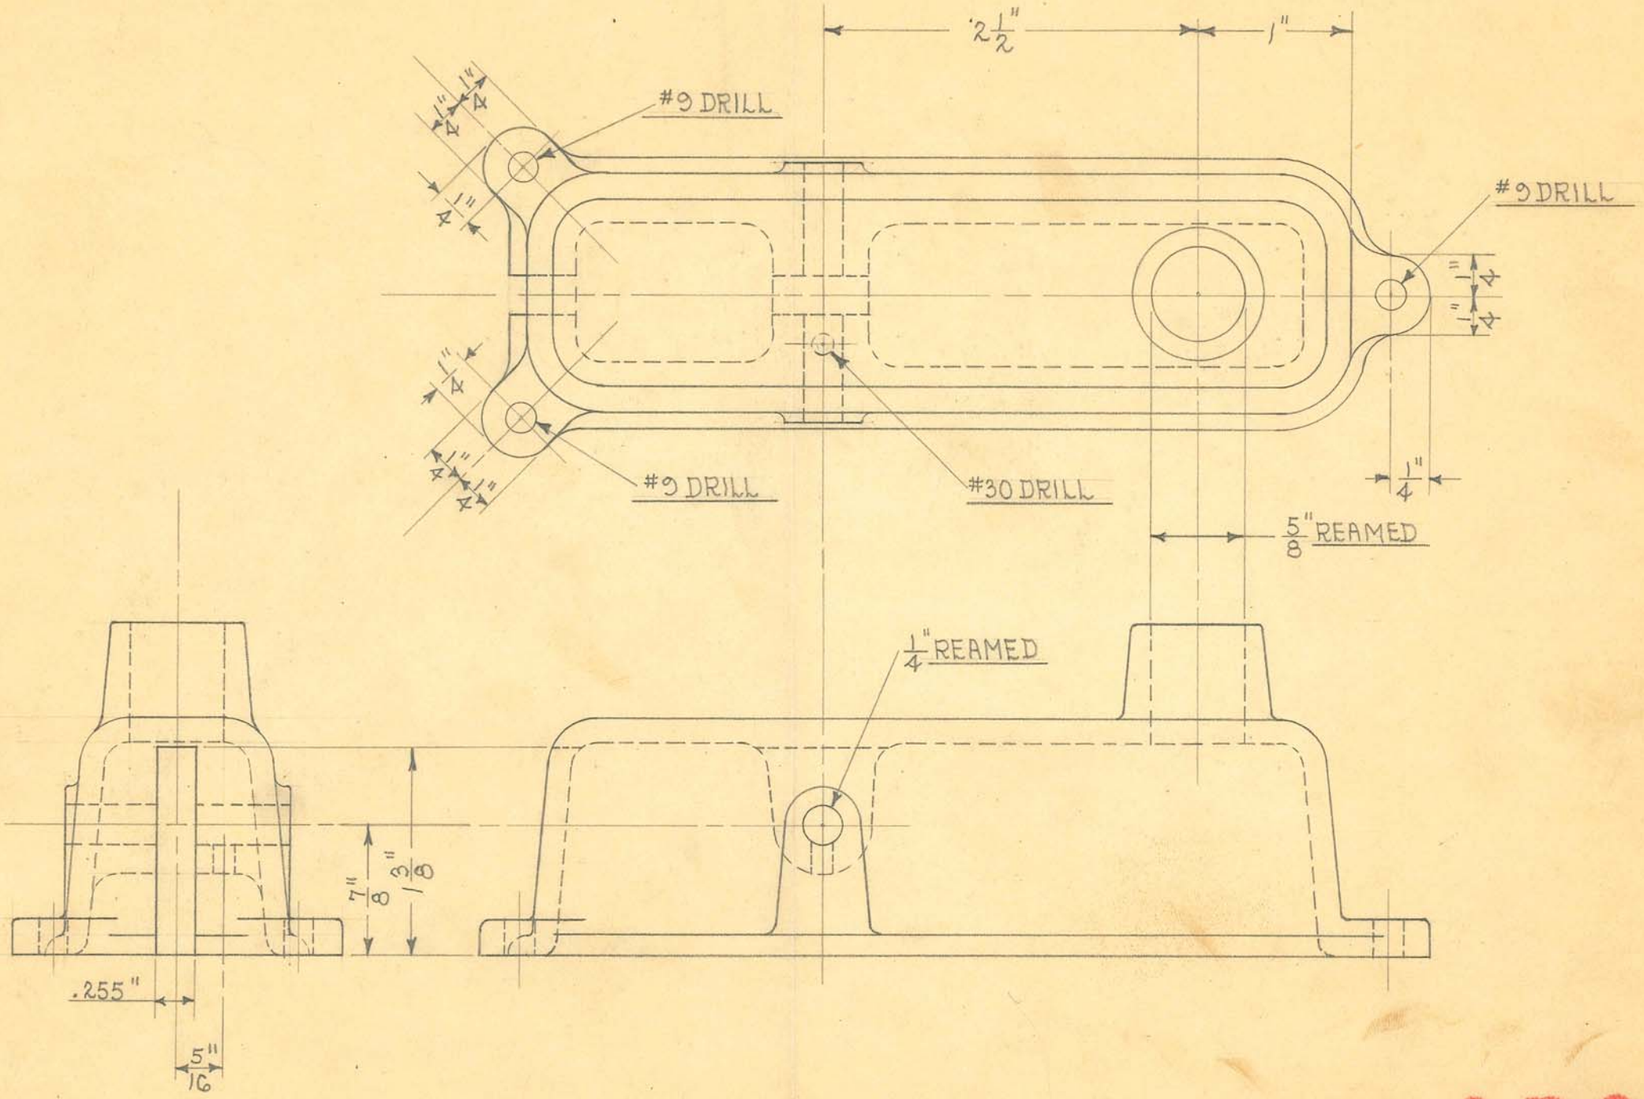

1 REQUIRED

OBSOLETE

SIZE		ISSUE 3-10-33	H.E.
KIND	ALUM. CASTING	CHANGED	
SHAPE		" "	
FINISH	BLK. LACQUER	" "	
TEMP.		" "	
PATT.	1663-503	" "	

TITLE:
UNIVERSAL "GO-88" TABLE UPRIGHT
LOCKING DEVICE HOUSING

H. G. FISCHER & CO.
2335 WABANSIA AVE.
CHICAGO, ILL.

CAT. NO.

PART NO. 8013F

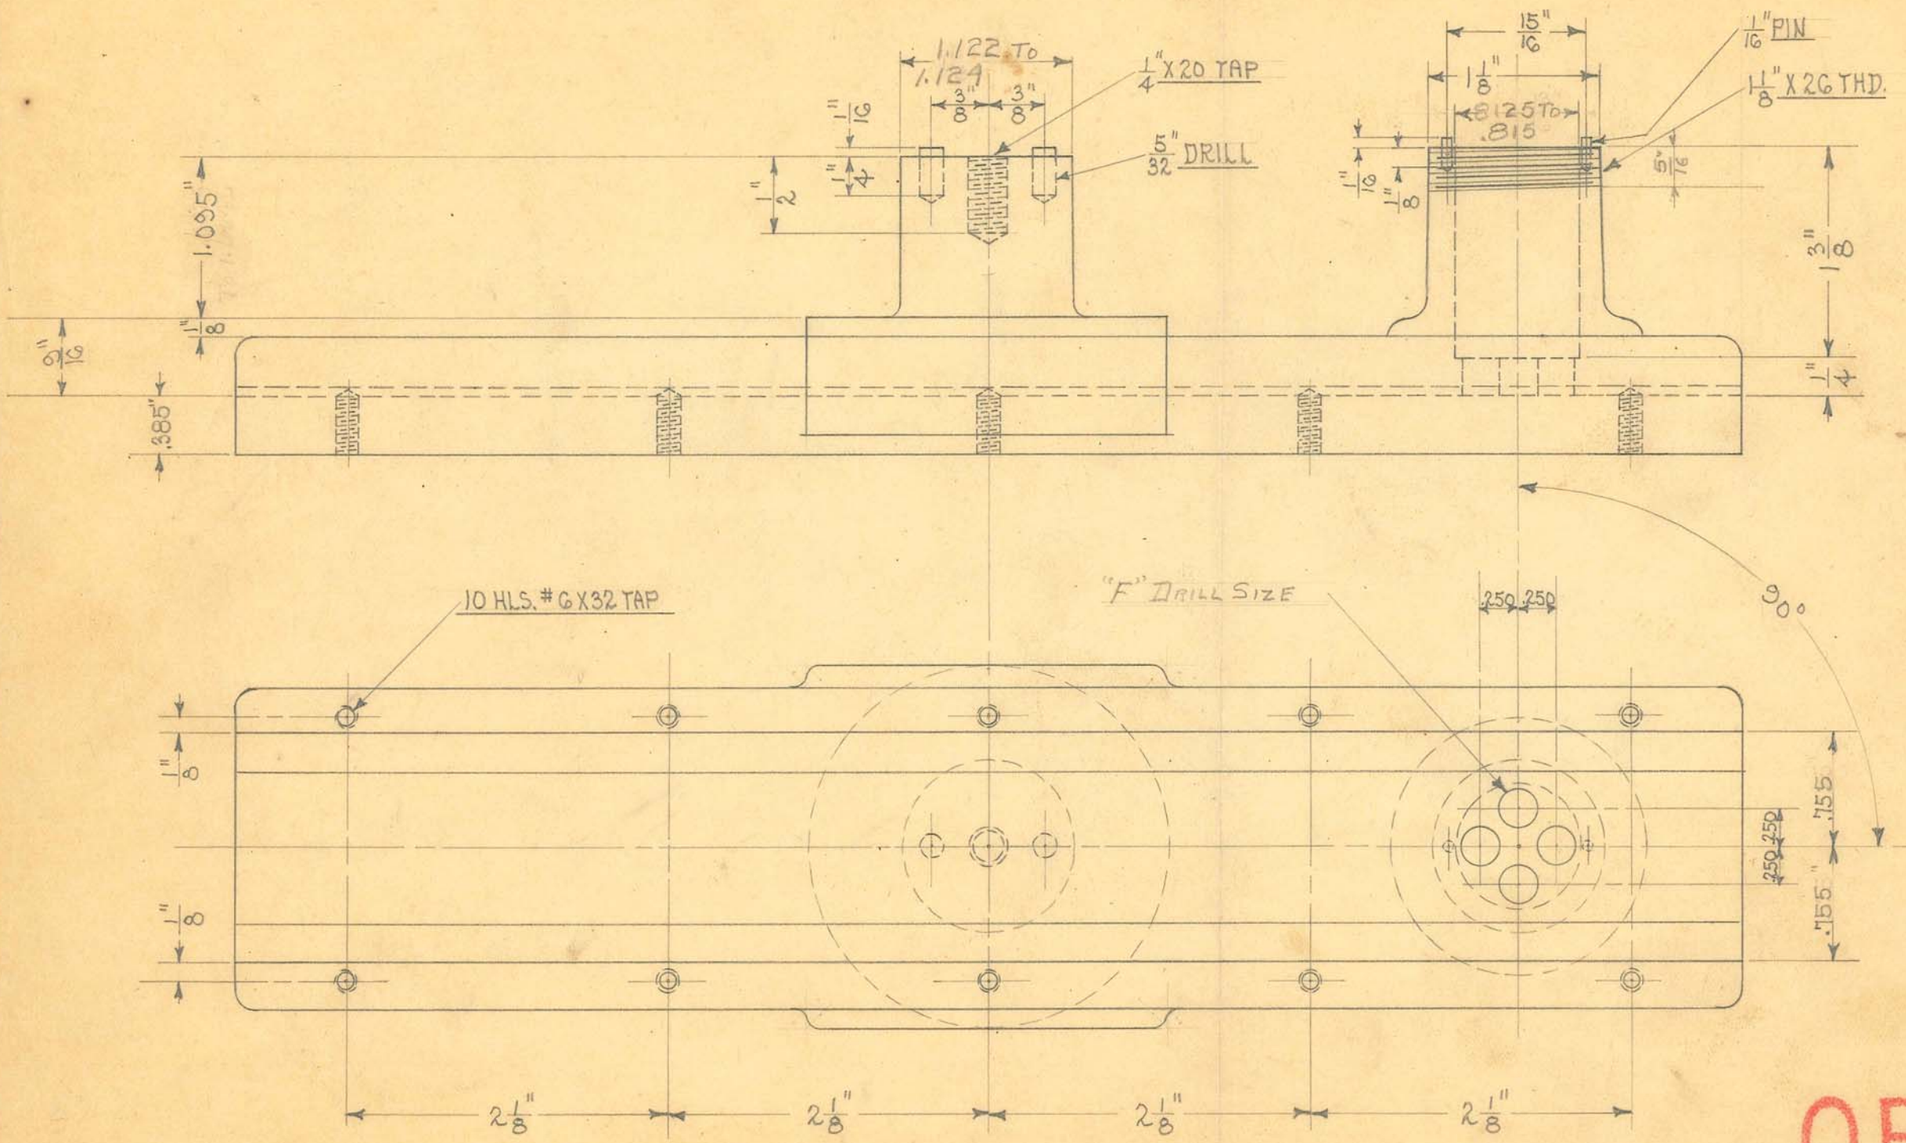

2 REQUIRED

OBSOLETE

SIZE		ISSUE 3-6-33	2/E.
KIND	CAST IRON	CHANGED	
SHAPE		" "	
FINISH		" "	
TEMP.		" "	

TITLE: UNIVERSAL "GO-88" TABLE SLIDE

H. G. FISCHER & CO.
2335 WABANSIA AVE.

CAT. NO.

PART NO. 8031F

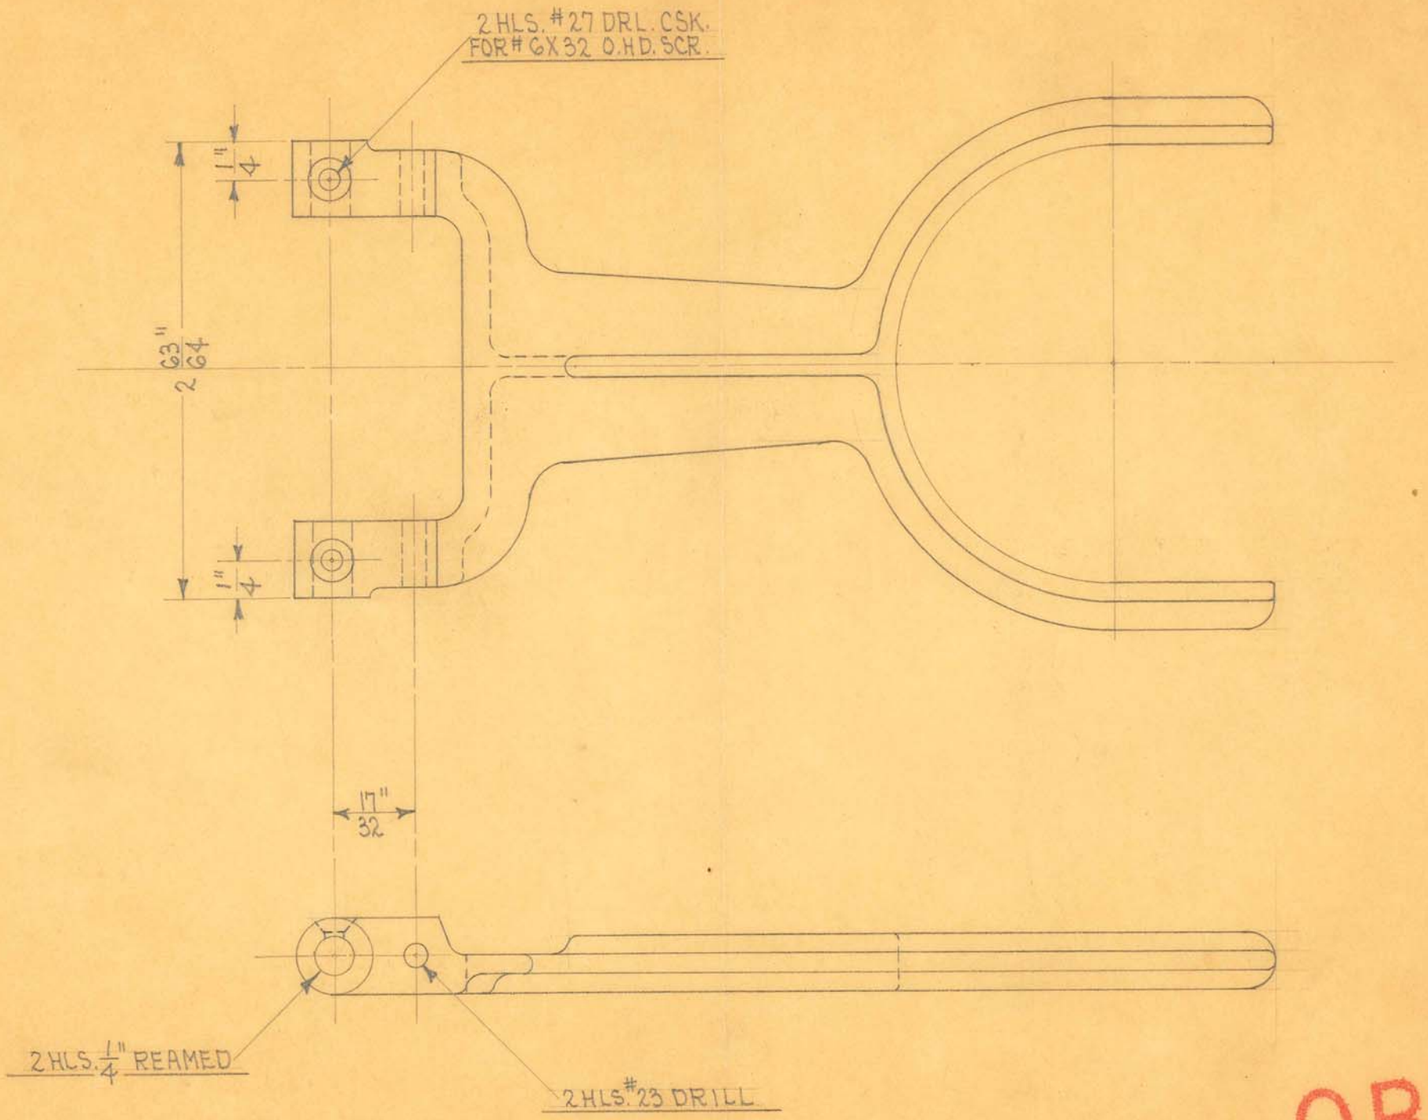

1 REQUIRED

OBSOLETE

SIZE		ISSUE 10-15-35	A.E.
KIND	ALUM. CASTING	CHANGED	
SHAPE		" "	
FINISH	BLACK #60	" "	
TEMP.		" "	
PATT.	3209-897	" "	

TITLE: FISCHER FLAT BUCKY OPERATING LEVER - FOR # 2400

H. G. FISCHER & CO.
2335 WABANSIA AVE.
CHICAGO, ILL.

CAT. NO.

PART NO. 7403 1/2 F

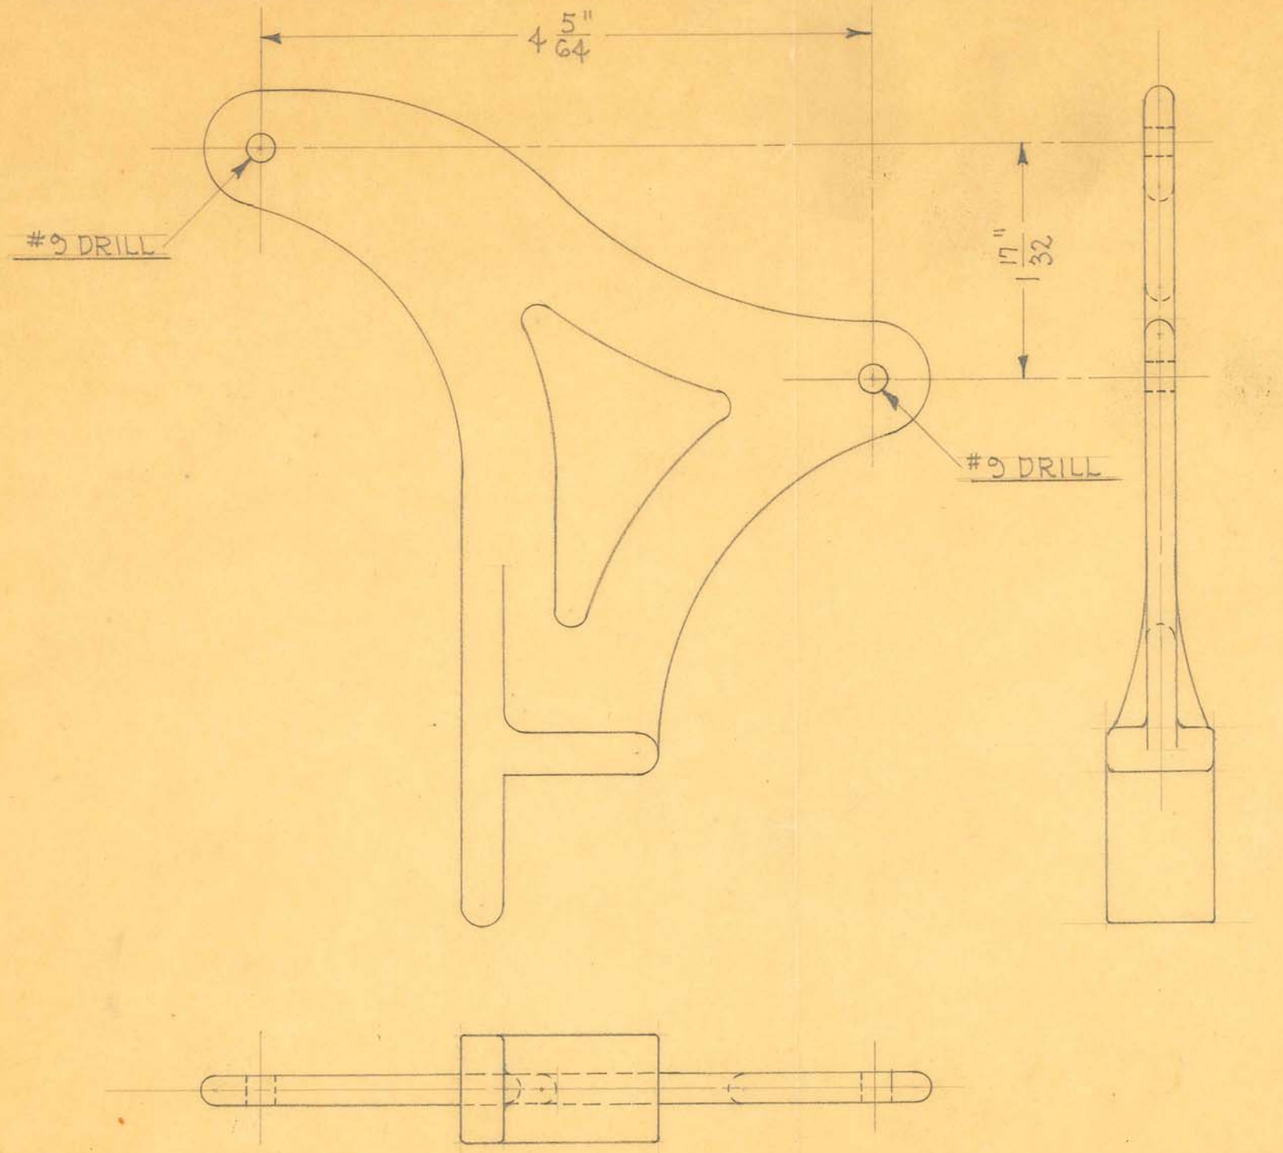

2 REQUIRED

OBSOLETE

SIZE		ISSUE 12-26-35	A.E
KIND	IRON CASTING	CHANGED	
SHAPE		" "	
FINISH	BLACK #50	" "	
TEMP.		" "	

TITLE: "15-88" WALL MOD. FLUOROSCOPE TRANSFORMER LOCATING PLATE

H. G. FISCHER & CO.
2335 WABANSIA AVE.

CAT. NO.

PART NO. 9953F

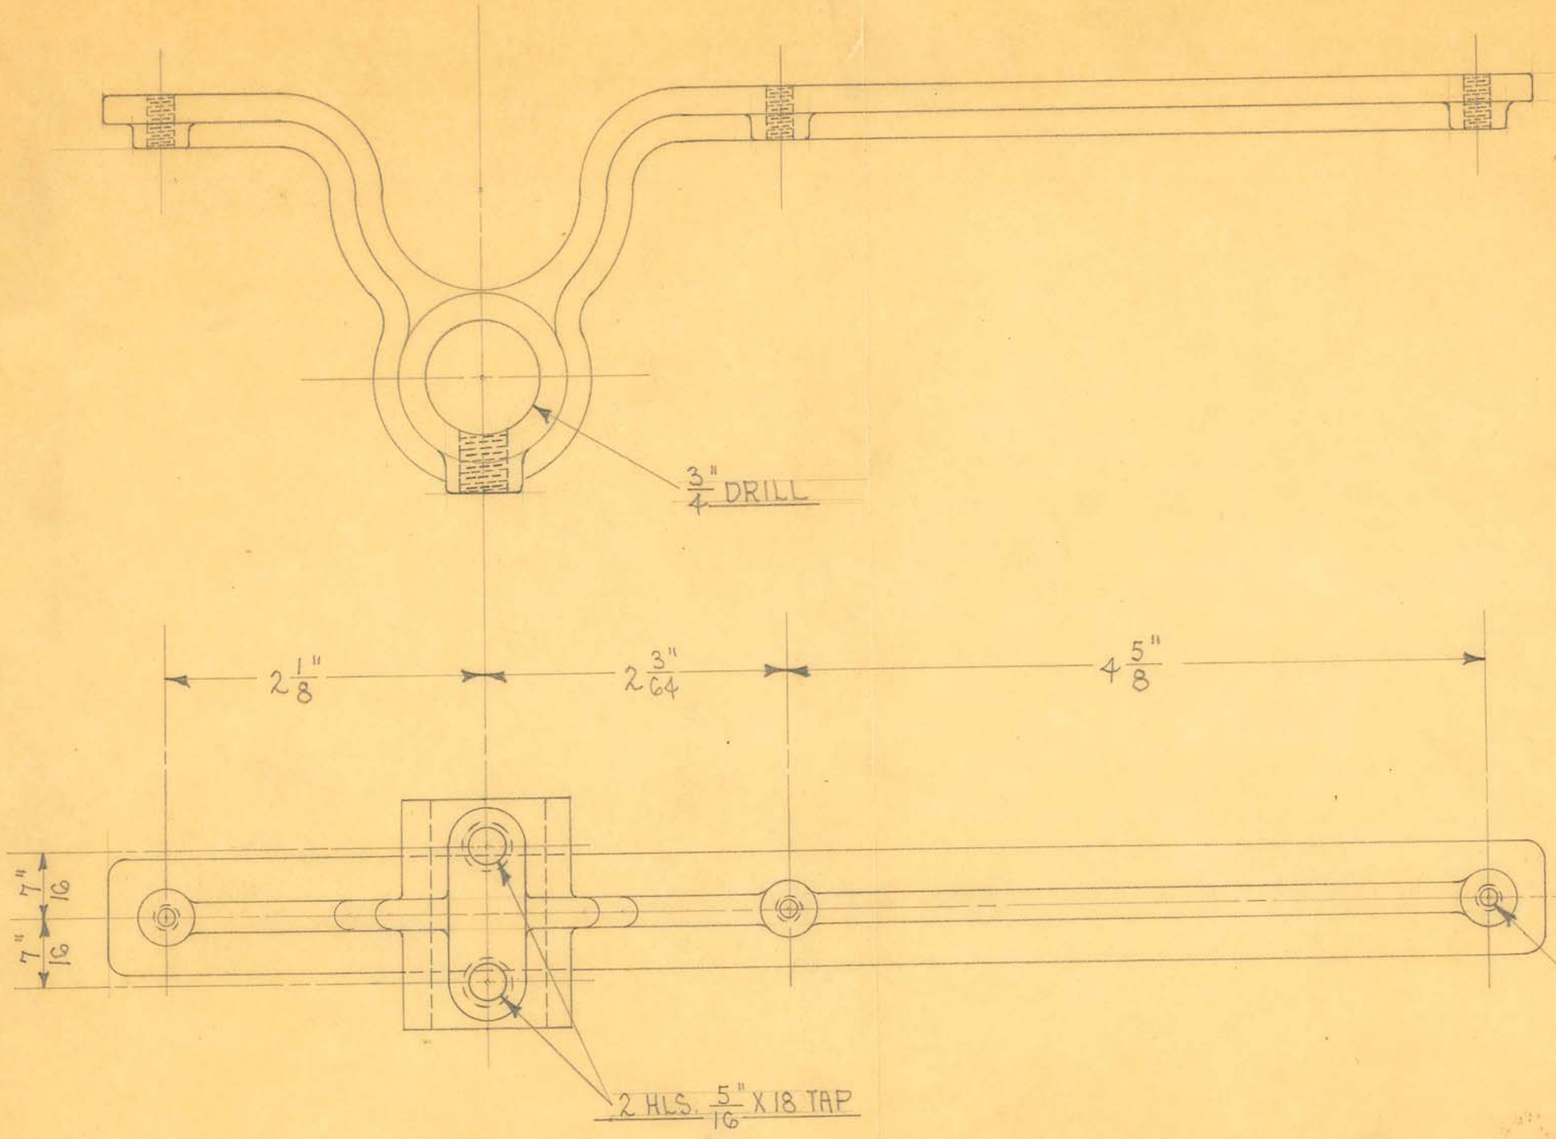

4 REQUIRED

OBSOLETE

SIZE		ISSUE 1-13-36	A.E.
KIND	IRON CASTING	CHANGED	
SHAPE		" "	
FINISH	BLACK #50	" "	
TEMP.		" "	
PATT. #	3903-909	" "	

TITLE: "15-88" WALL MOD. FLUOROSCOPE PROTECTION SCREEN SUPPORT

H. G. FISCHER & CO.
2335 WABANSIA AVE.
CHICAGO, ILL.

CAT. NO.

PART NO. 9956F

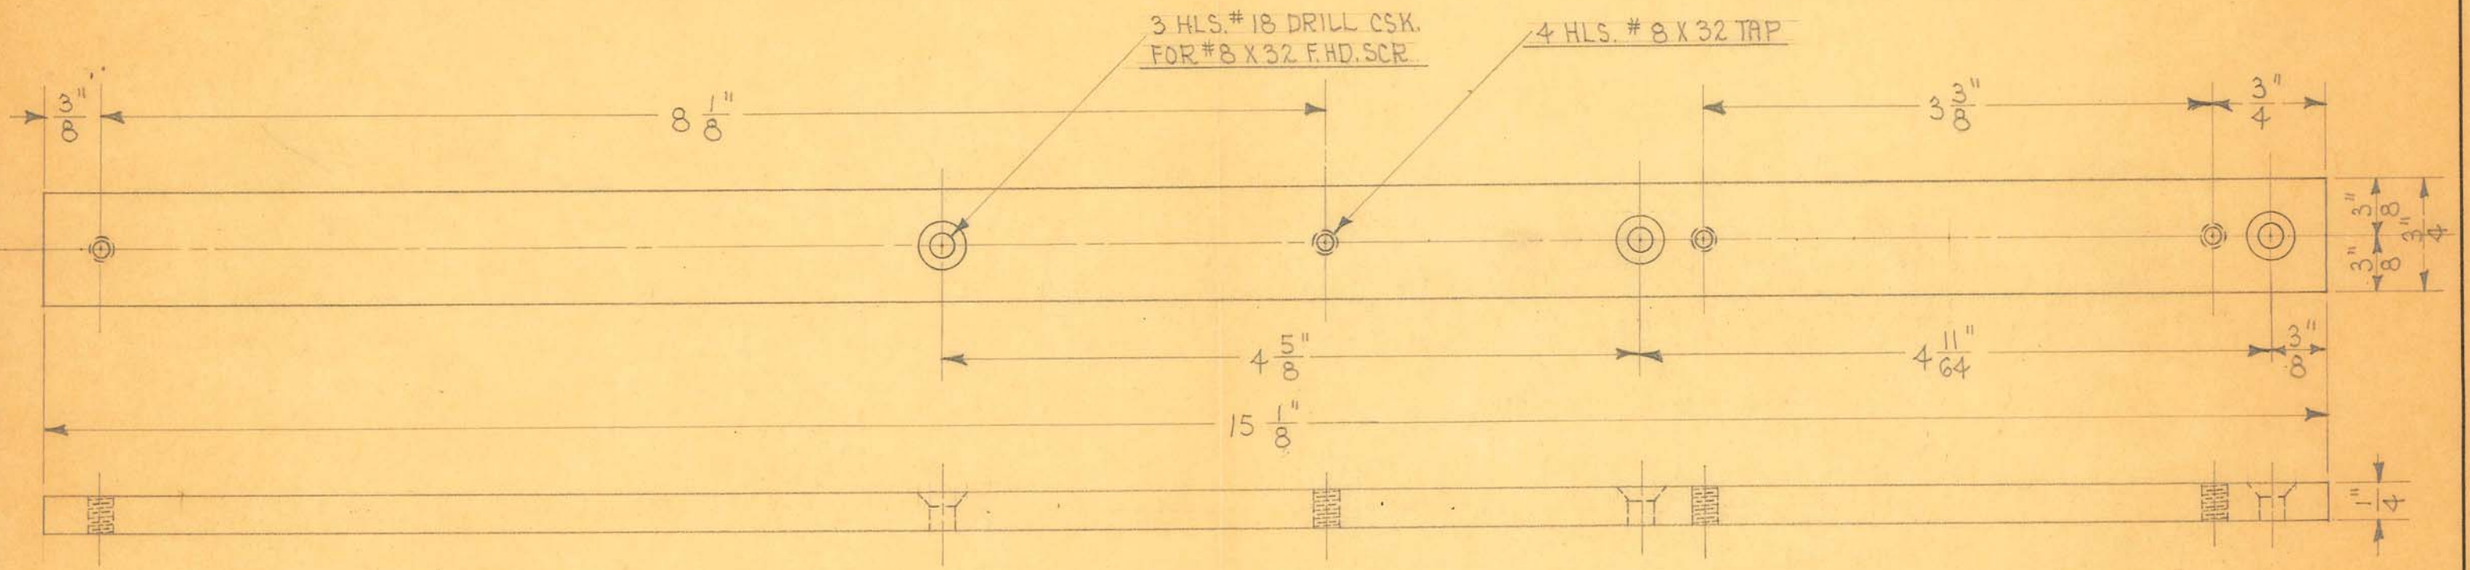

2 REQUIRED

OBSOLETE

SIZE	3/4" x 1/4"	ISSUE 1-30-36	A.E.	TITLE: 15-88" WALL MODEL FLUOROSCOPE PROTECTION SCREEN SUPP. EXTENSION - LEFT
KIND	C.R. STEEL	CHANGED		
SHAPE		" "		
FINISH	BLACK # 70	" "		
TEMP.		" "		
DATE		" "		

H. G. FISCHER & CO.
2335 WABANSIA AVE.
CHICAGO, ILL.

CAT. NO.

PART NO. 9957

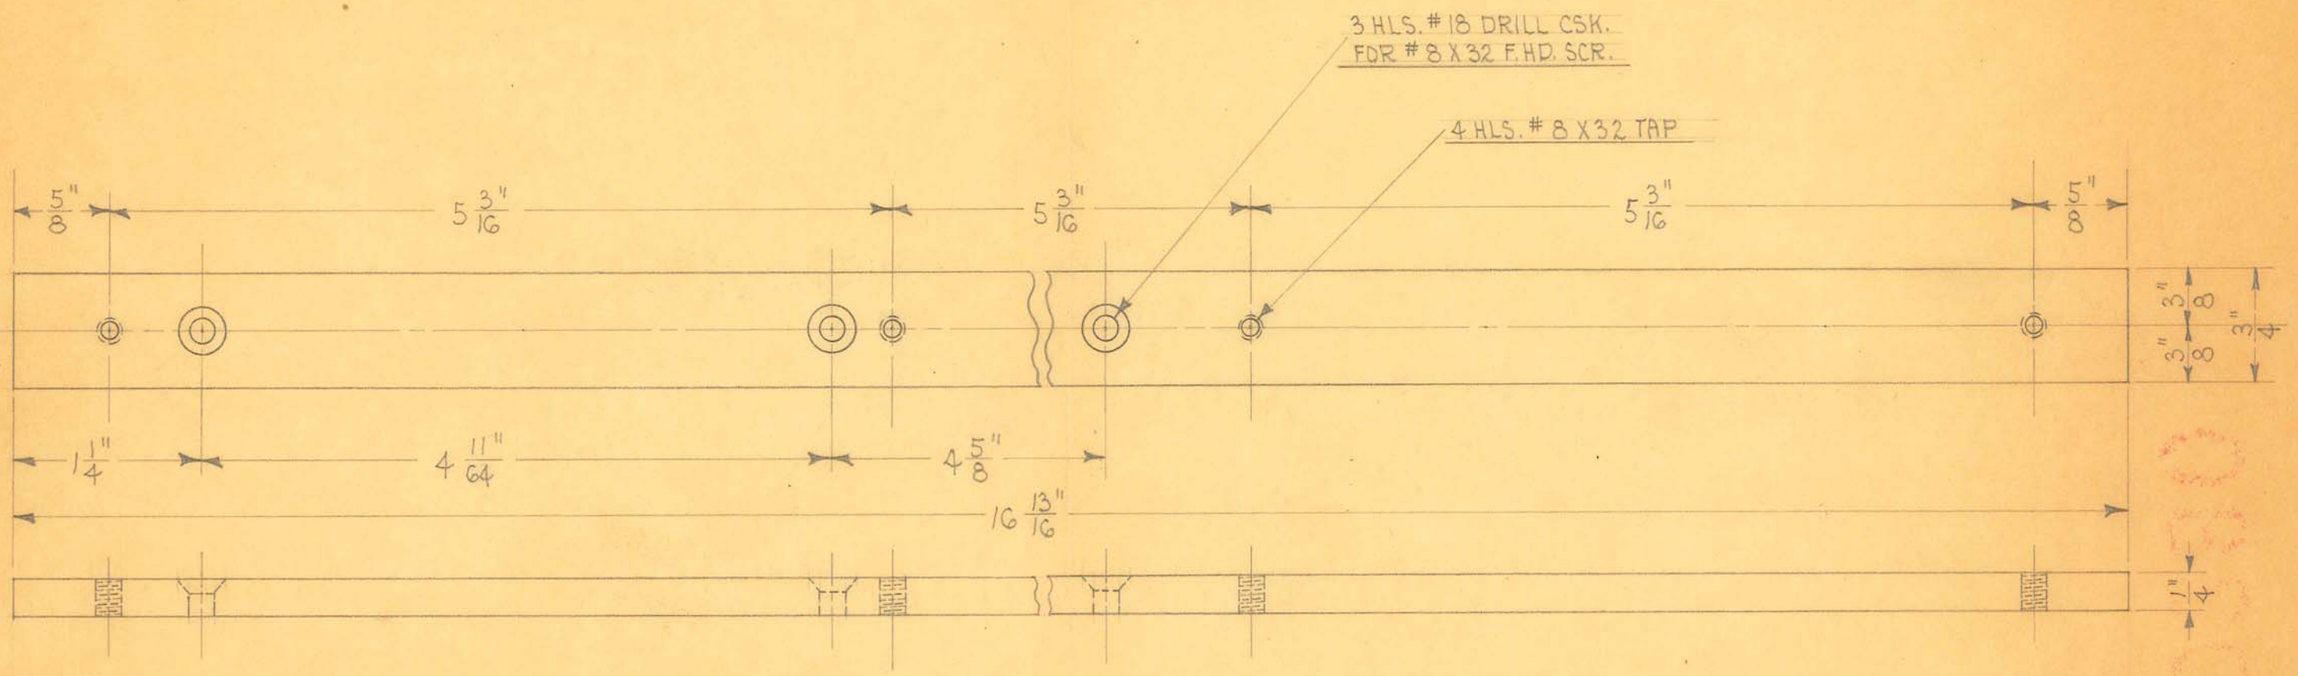

2 REQUIRED

OBSOLETE

SIZE	3/4" X 1/4"	ISSUE 1-30-36	2/E.
KIND	C.R. STEEL	CHANGED	
SHAPE		" "	
FINISH	BLACK #70	" "	
TEMP.		" "	
PATT.		" "	

TITLE: "15-88" WALL MODEL FLUOROSCOPE PROTECTION SCREEN SUPP. EXTENSION - RIGHT

H. G. FISCHER & CO.
2335 WABANSIA AVE.
CHICAGO, ILL.

CAT. NO.

PART NO. 9957 1/2

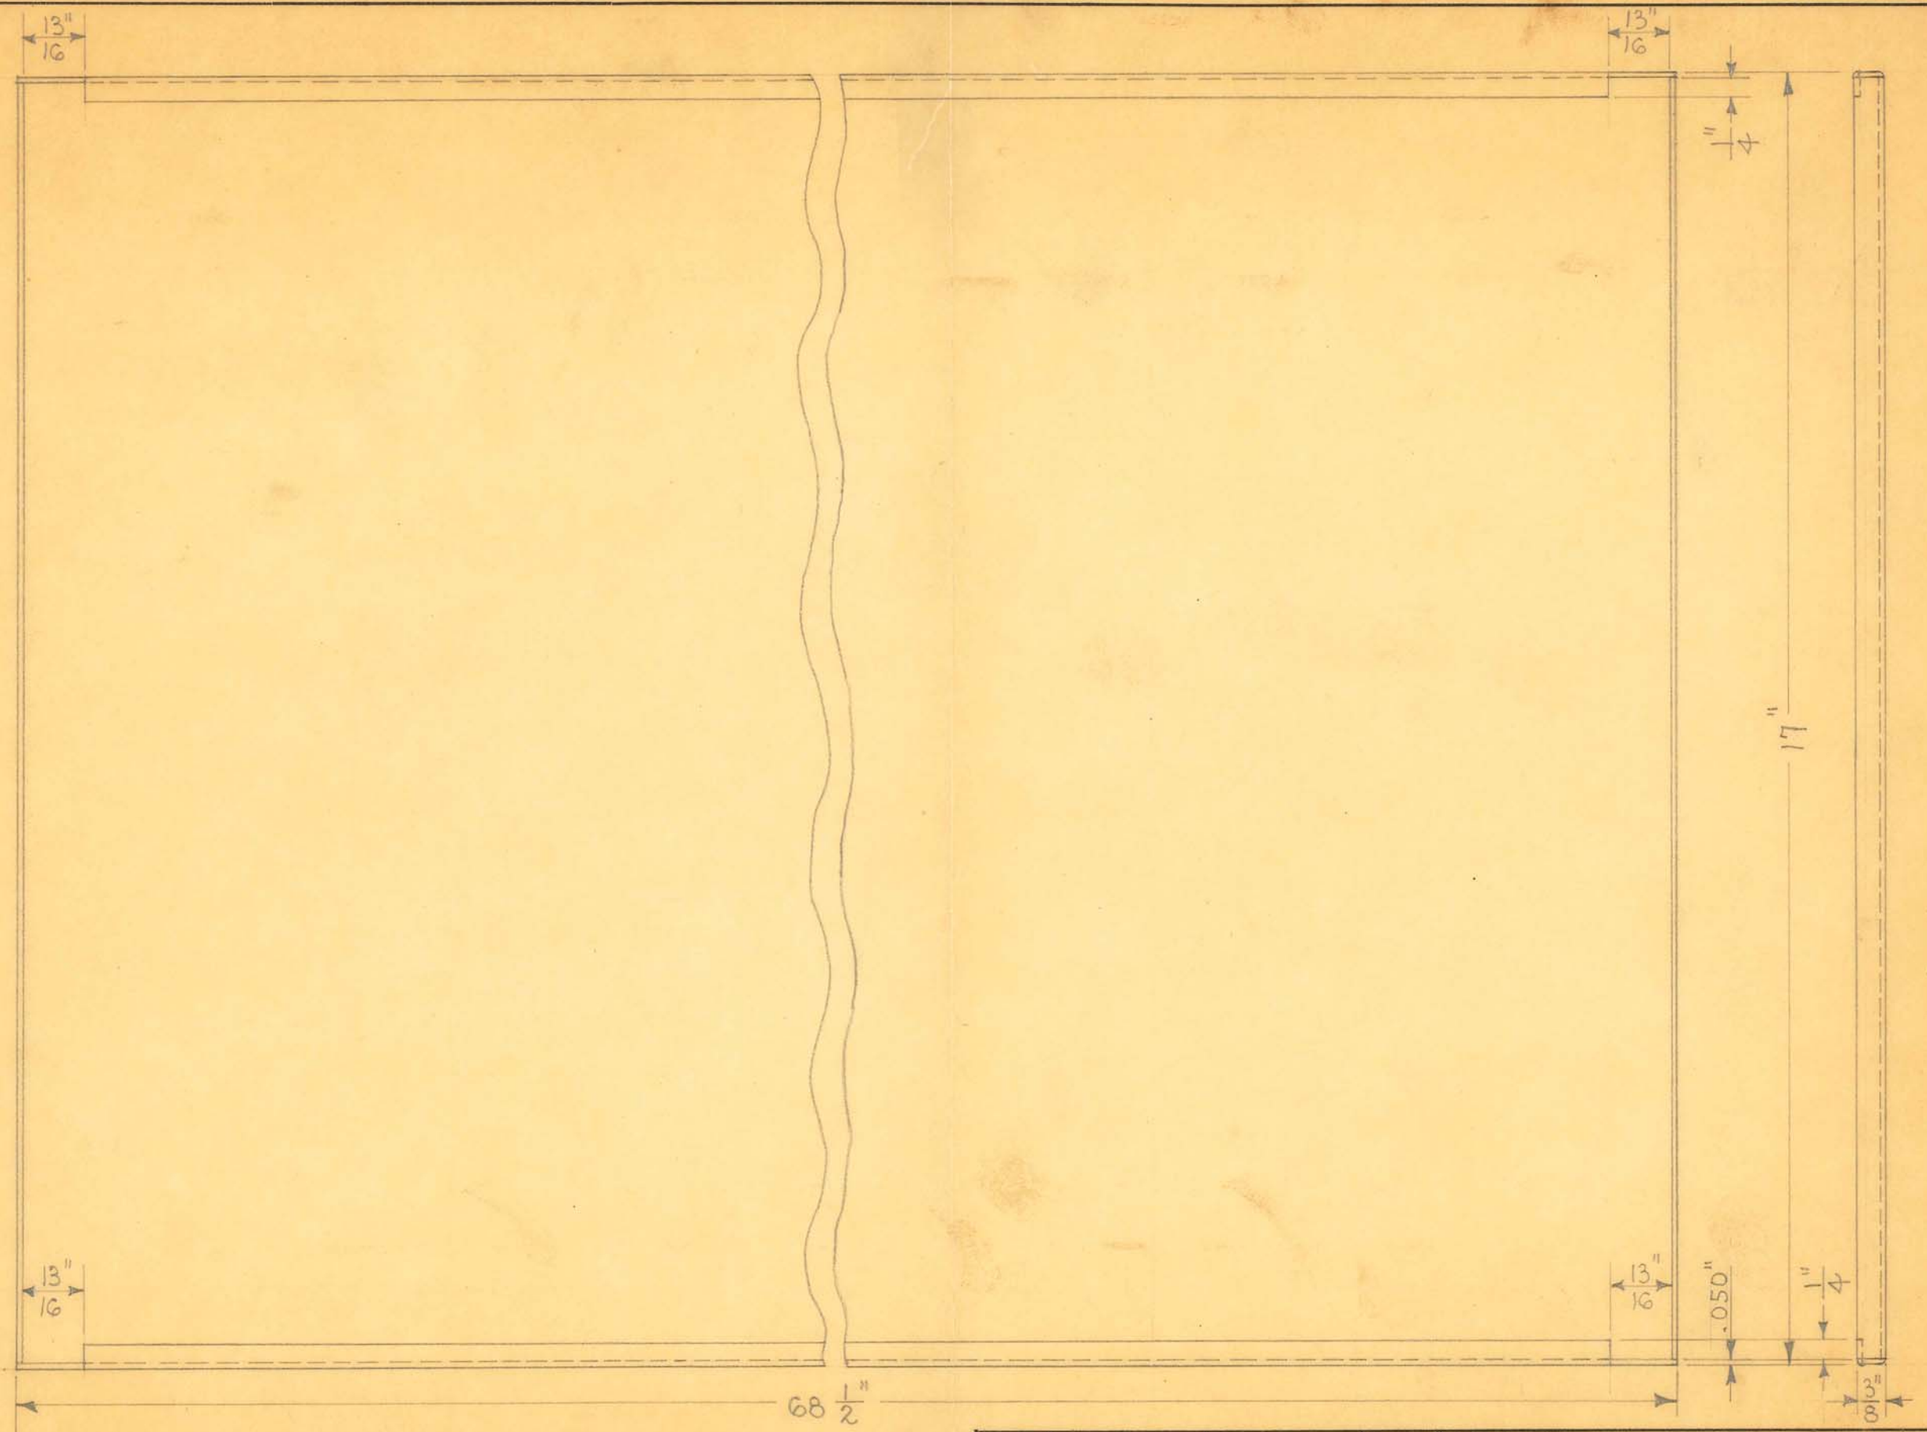

1 REQUIRED
SCALE ≈ 1/2" = 1"

SIZE	.050"	ISSUE 1-29-36	2/8.
KIND	FURNITURE STEEL	CHANGED	
SHAPE		" "	
FINISH		" "	
TEMP.		" "	

TITLE: "15-88" WALL MODEL FLUOROSCOPE PROTECTION SCREEN - RIGHT - BLANK

H. G. FISCHER & CO.
2335 WABANSIA AVE.

CAT. NO.

PART NO. 9958

OBSOLETE

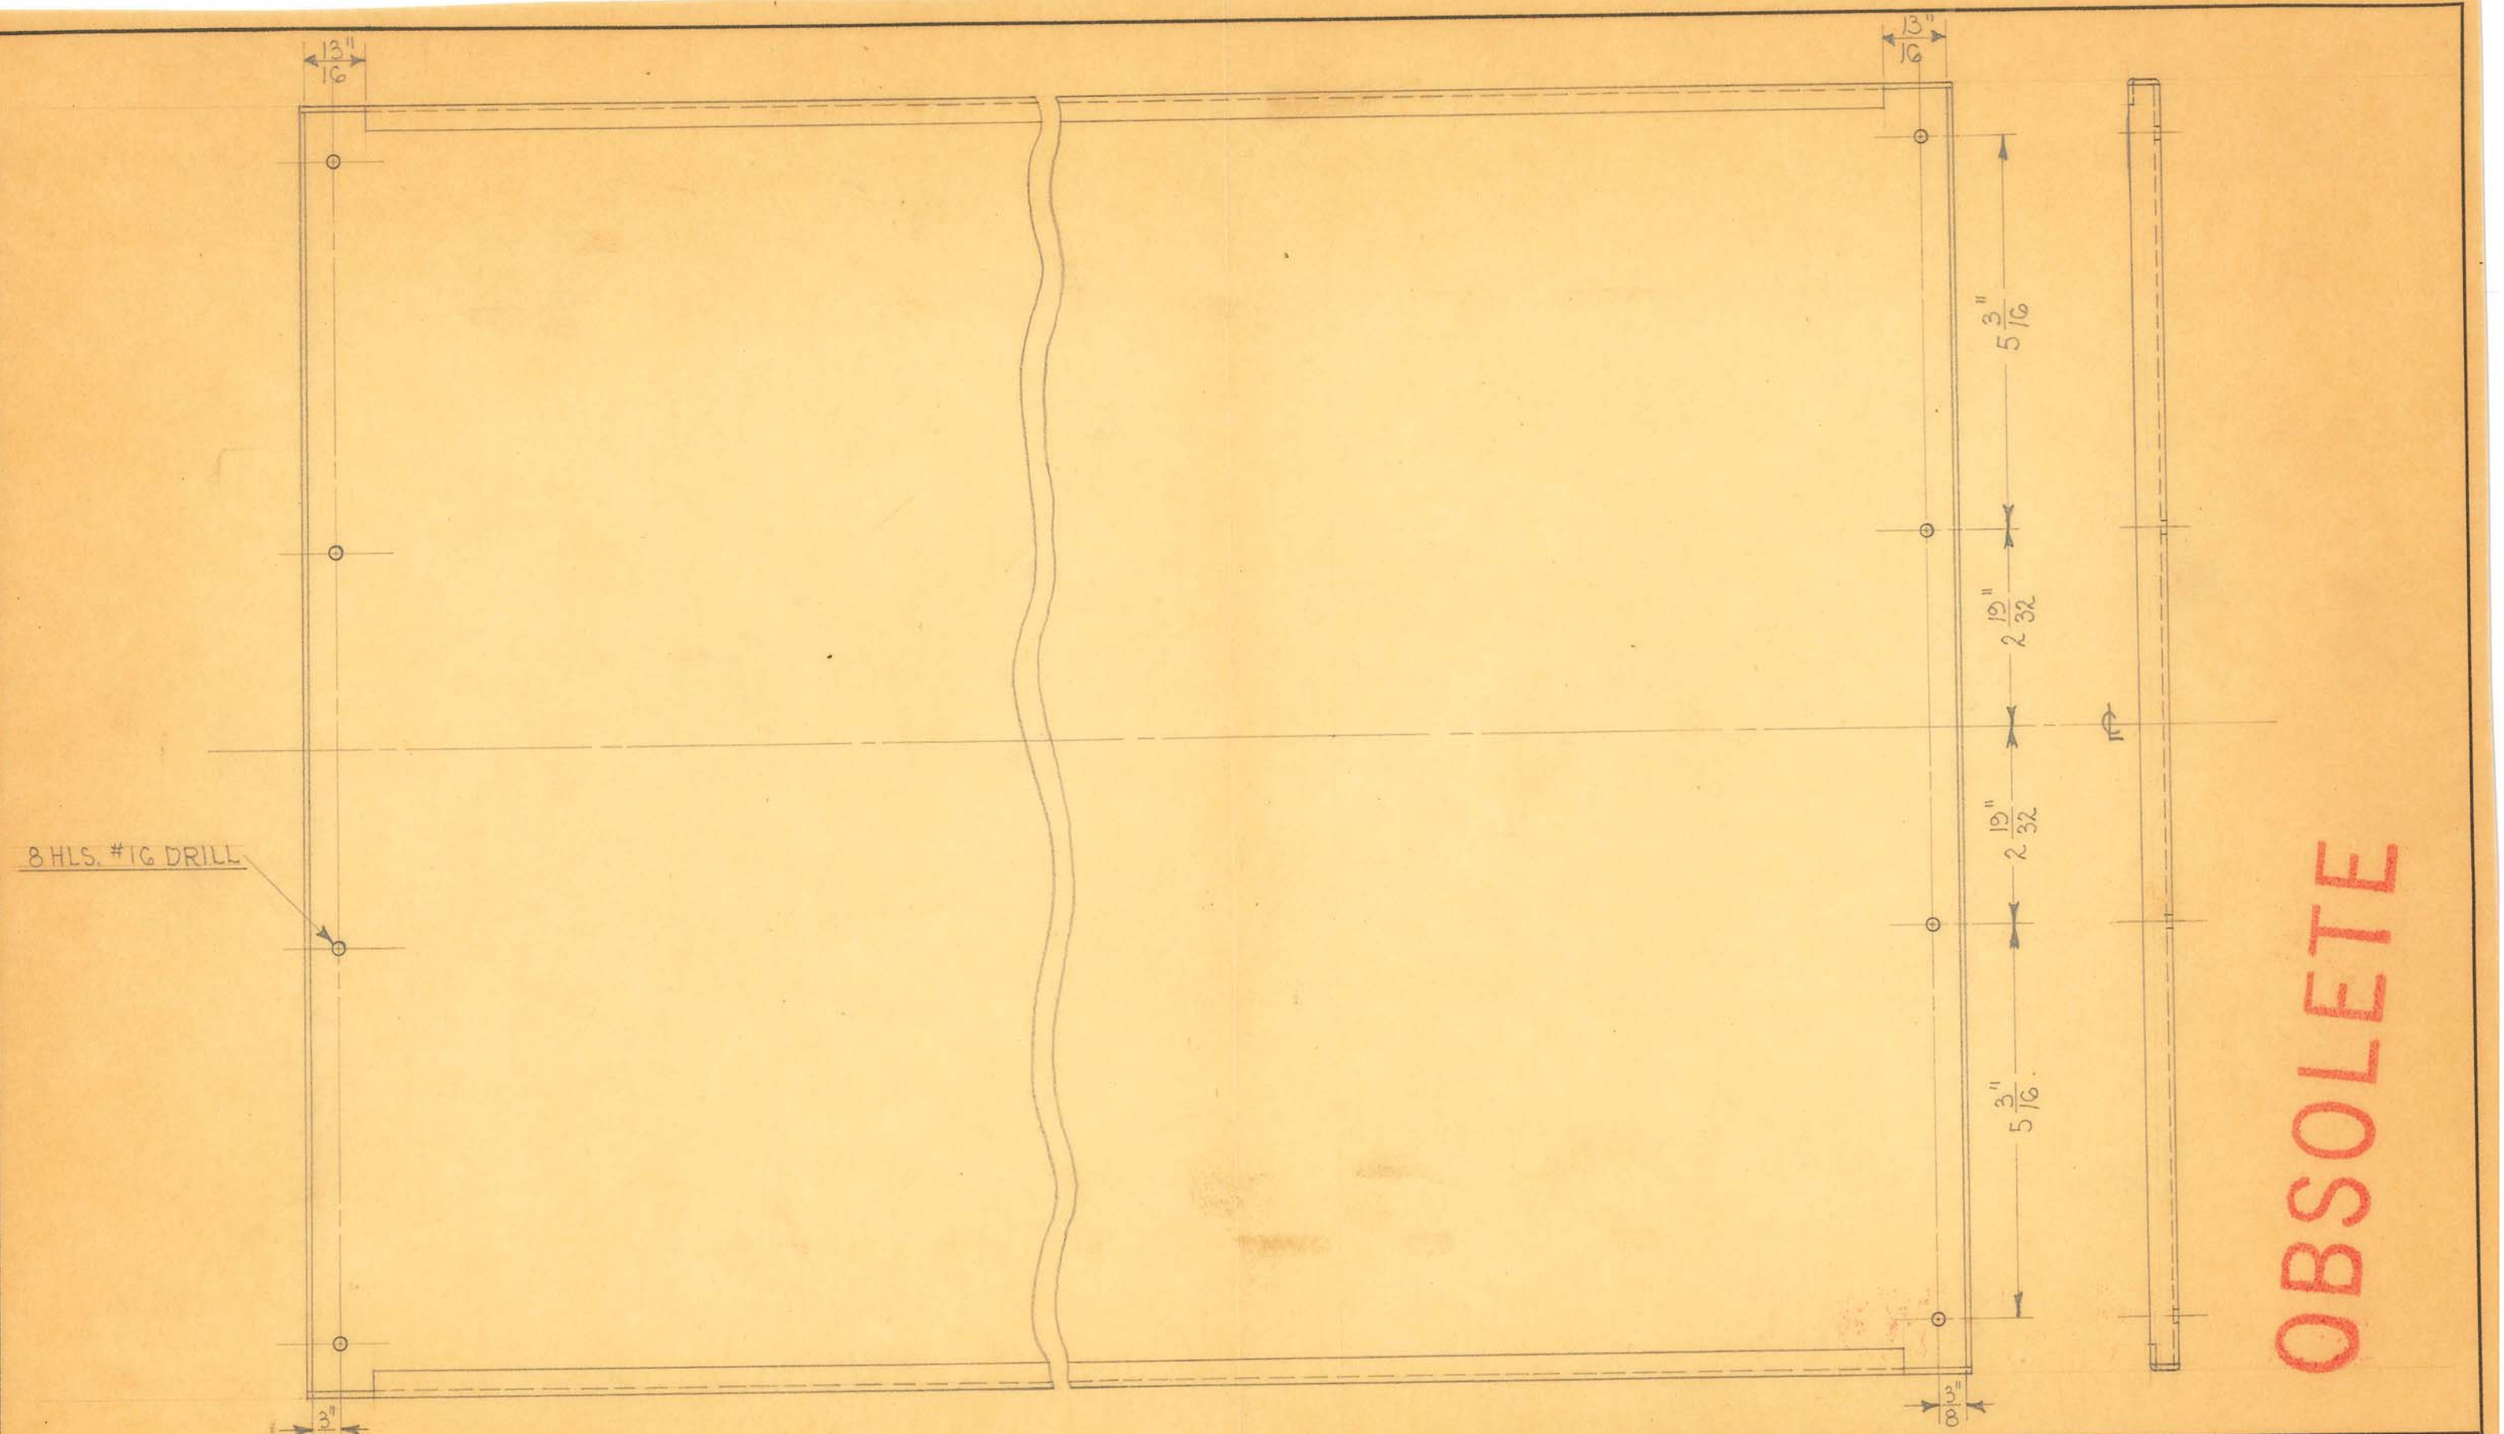

OBSOLETE

1 REQUIRED
SCALE ≈ 1/2" = 1"

SIZE		ISSUE 1-30-36	78.
KIND		CHANGED	
SHAPE		" "	
FINISH	BLACK #70	" "	
TEMP.		" "	
PATT.		" "	

TITLE:
"15-88" WALL MODEL FLUORDSCORE
PROTECTION SCREEN - RIGHT

H. G. FISCHER & CO.
2335 WABANSIA AVE.
CHICAGO, ILL.

CAT. NO.

PART NO. 9958F

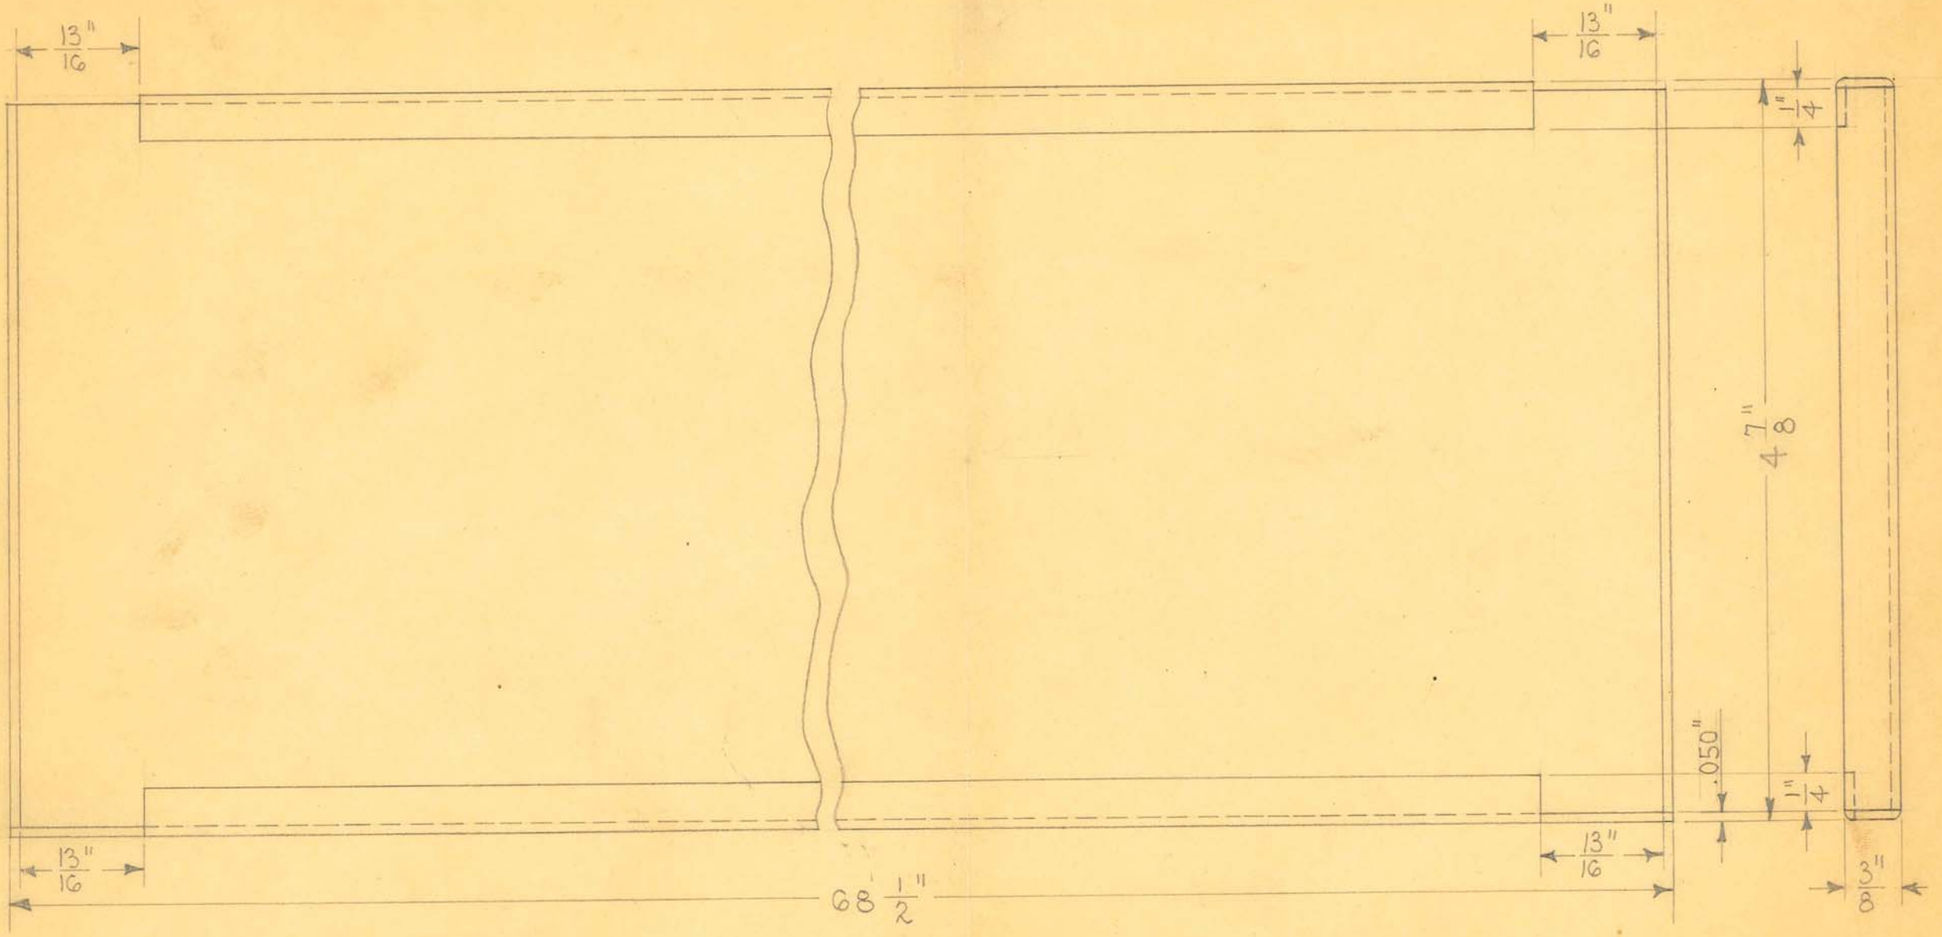

1 REQUIRED

SCALE ~ FULL SIZE

OBSOLETE

SIZE	.050"	ISSUE 1-29-36	A.E.
KIND	FURNITURE STEEL	CHANGED	
SHAPE		" "	
FINISH		" "	
TEMP.		" "	

TITLE: "15-88" WALL MODEL FLUOROSCOPE PROTECTION SCREEN-LEFT FRONT-BLANK

H. G. FISCHER & CO.
2335 WABANSIA AVE.
CHICAGO, ILL.

CAT. NO.

PART NO. 9959

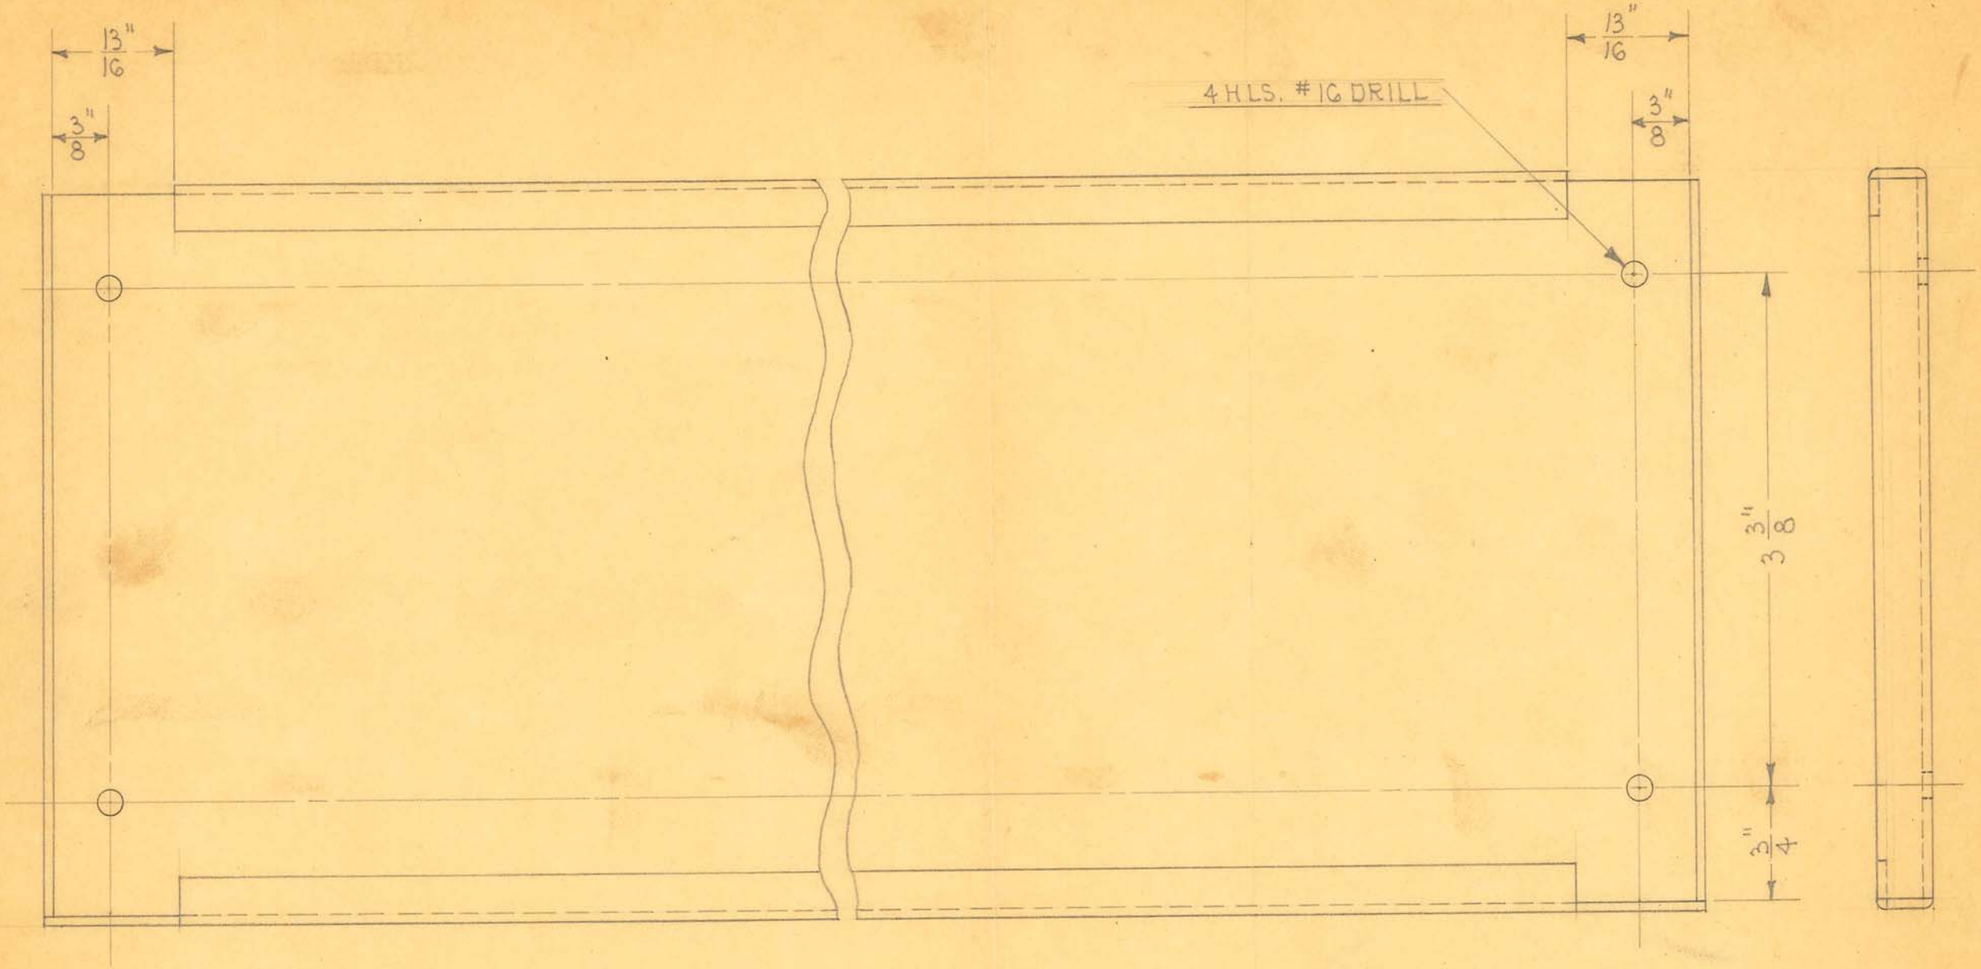

1 REQUIRED
SCALE ÷ FULL SIZE

OBSOLETE

SIZE		ISSUE 1-29-36	A.E.
KIND		CHANGED	
SHAPE		" "	
FINISH	BLACK #70	" "	
TEMP.		" "	
DATE		" "	

TITLE: "15-88" WALL MODEL FLUOROSCOPE PROTECTION SCREEN - LEFT FRONT

H. G. FISCHER & CO.
2335 WABANSIA AVE.
CHICAGO, ILL.

CAT. NO.

PART NO. 9959F

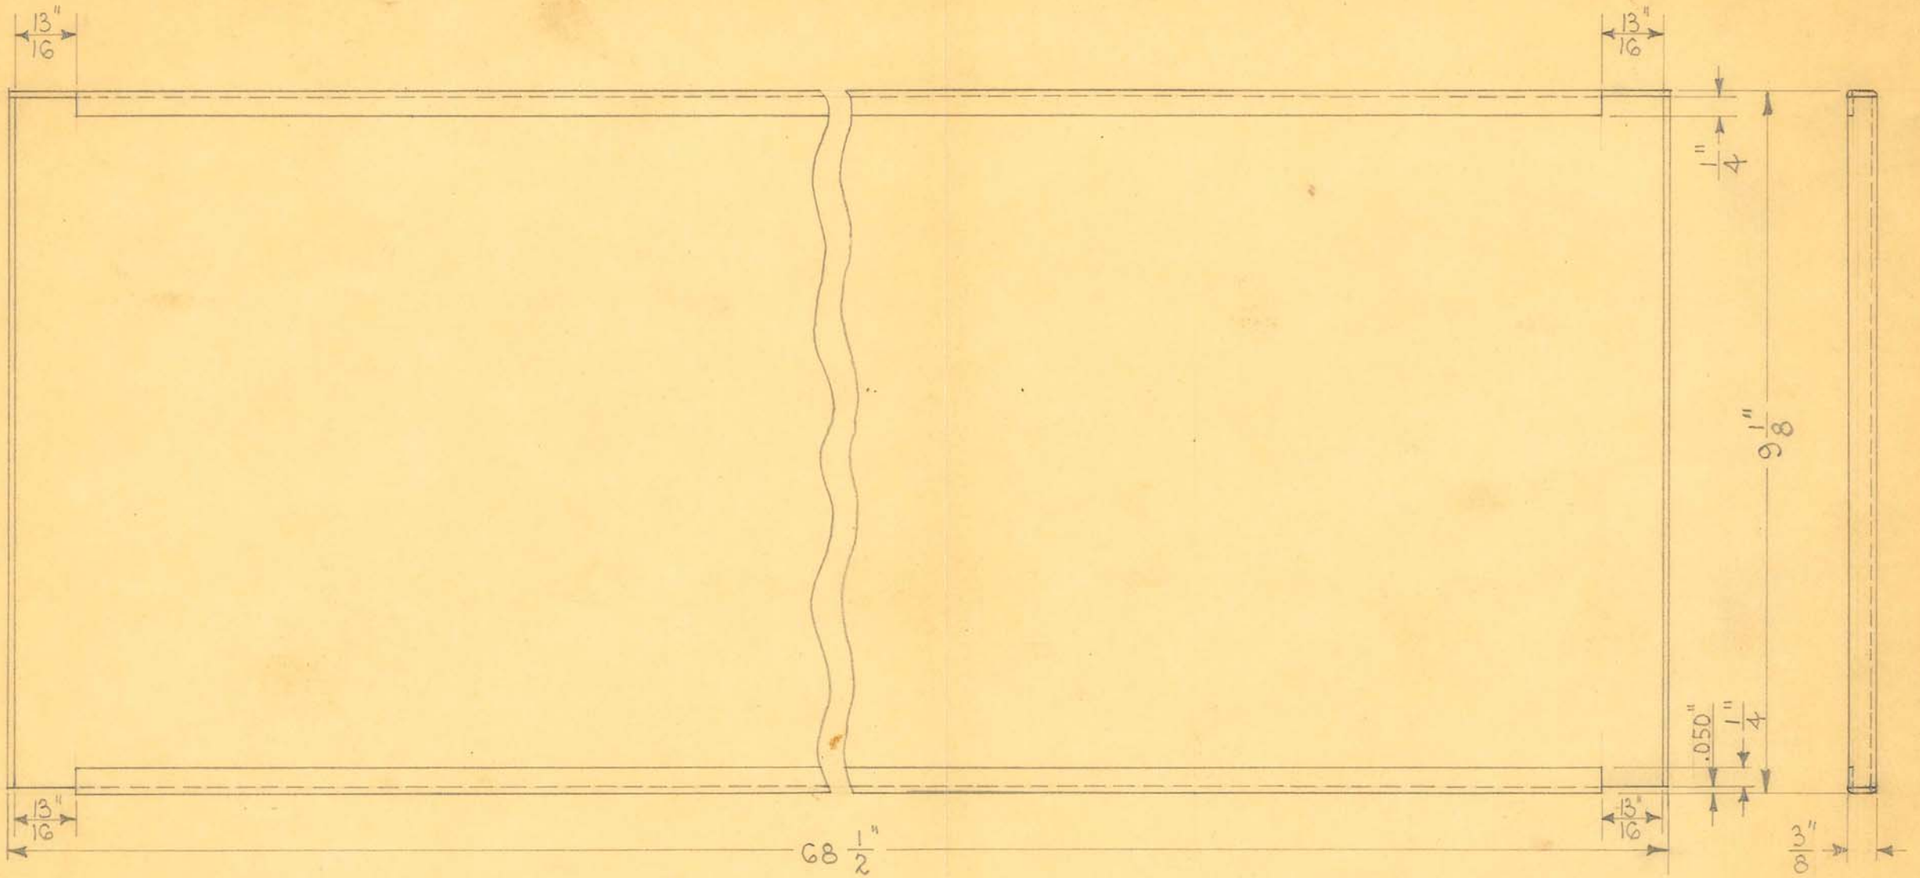

1 REQUIRED

SCALE ≈ 1/2" = 1"

OBSOLETE

SIZE	.050"	ISSUE 1-23-36	W.E.
KIND	FURNITURE STEEL	CHANGED	
SHAPE		" "	
FINISH		" "	
TEMP.		" "	

TITLE: "15-88" WALL MODEL FLUOROSCOPE PROTECTION SCREEN - LEFT REAR - BLANK

H. G. FISCHER & CO.
2335 WABANSIA AVE.

CAT.

PART NO. 9960

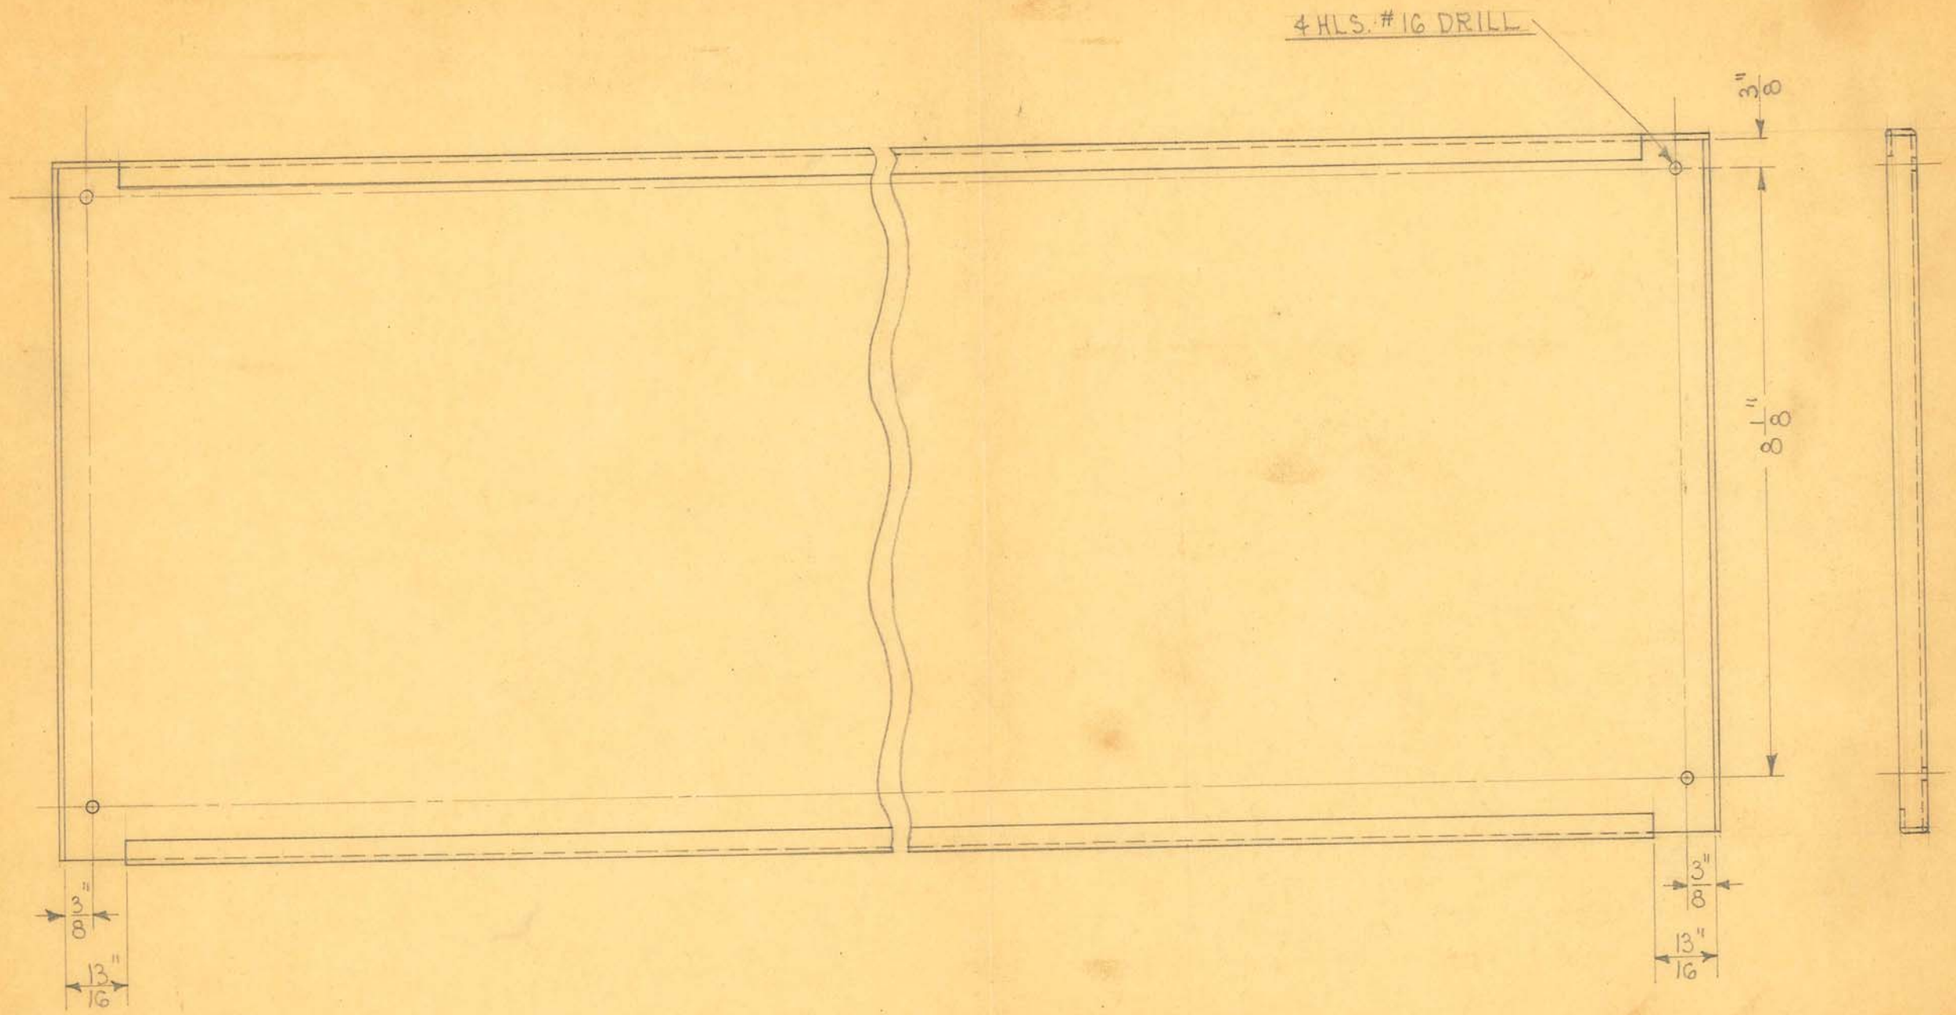

1 REQUIRED

SCALE ~ 1/2" = 1"

OBSOLETE

SIZE		ISSUE 1-29-36	A.E.
KIND		CHANGED	
SHAPE		" "	
FINISH	BLACK #70	" "	
TEMP.		" "	
PATT.		" "	

TITLE: "15-88" WALL MODEL FLUOROSCOPE PROTECTION SCREEN - LEFT REAR

H. G. FISCHER & CO.
2335 WABANSIA AVE.
CHICAGO, ILL.

CAT. NO.

PART NO. 9960F

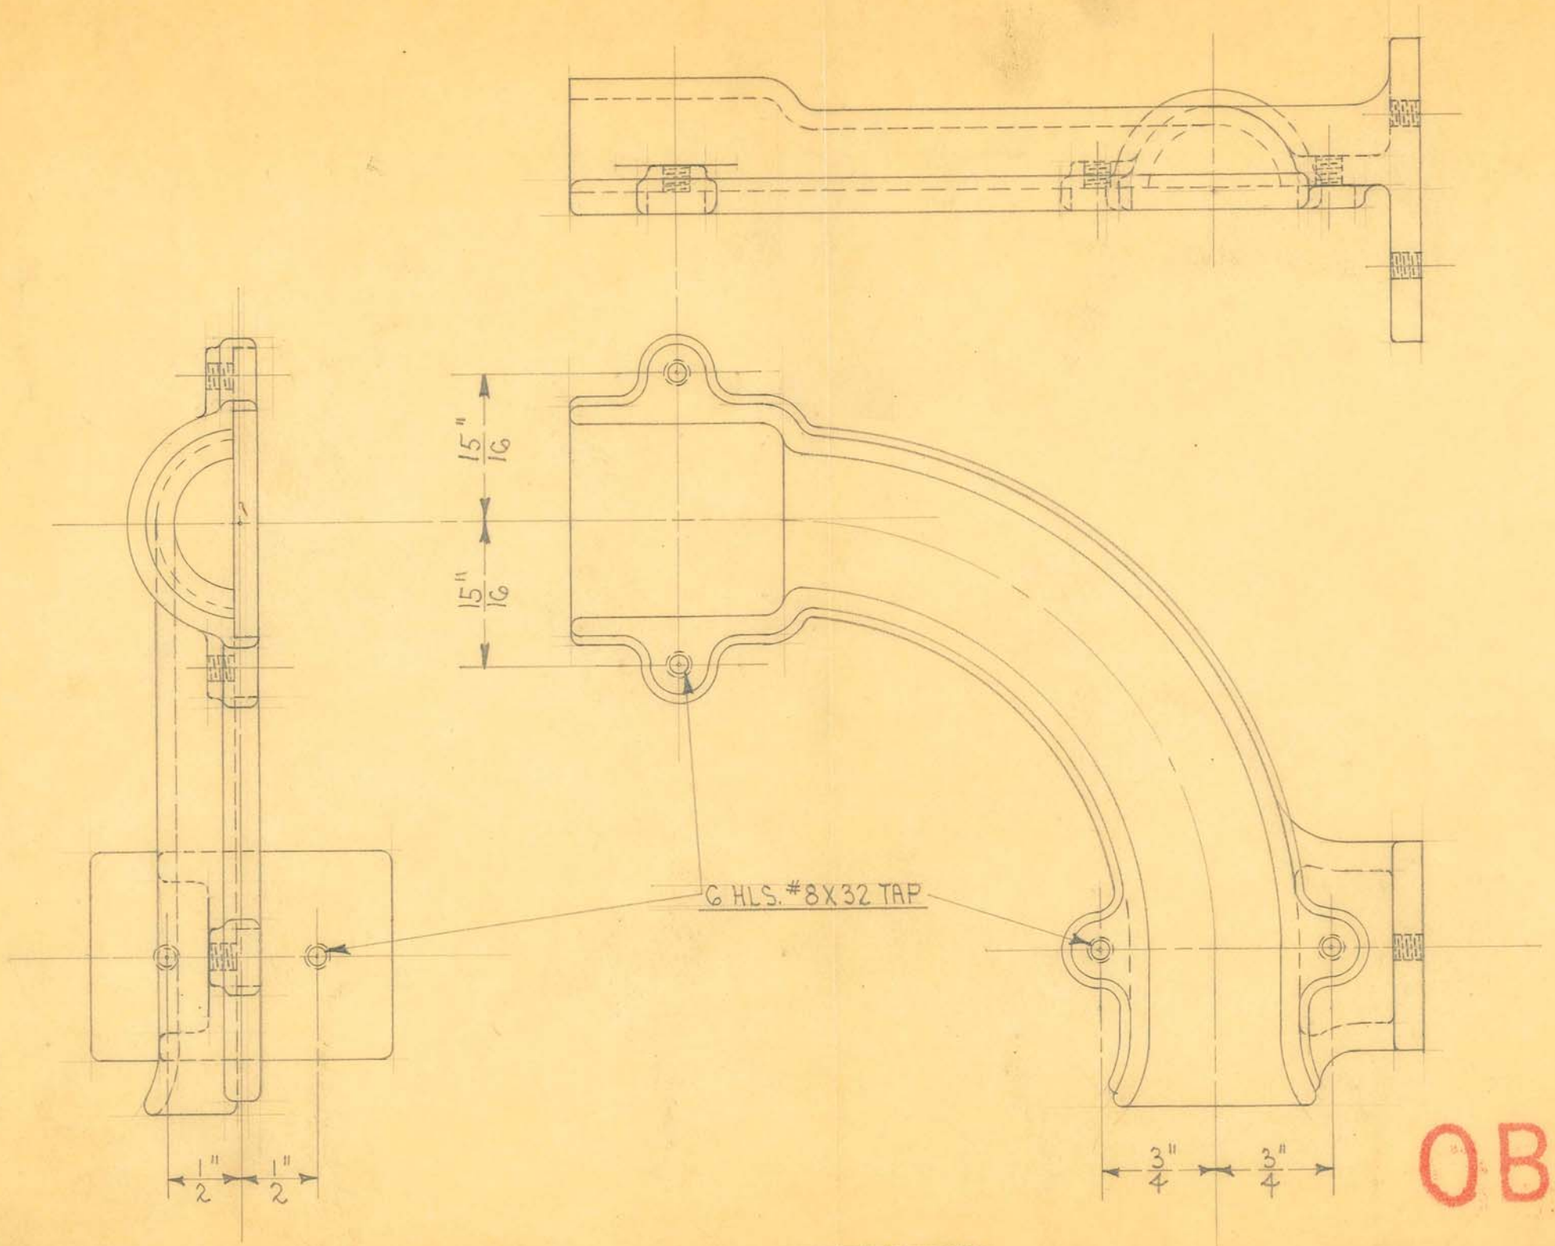

OBSOLETE

1 REQUIRED

SIZE		ISSUE 1-10-36	A.E.
KIND	ALUM. CASTING	CHANGED	
SHAPE		" "	
FINISH	BLACK #60	" "	
TEMP.		" "	
PATT.	4090-913	" "	

TITLE:
"15-88" WALL MOD. FLUOROSCOPE
CABLE SUPPORT

H. G. FISCHER & CO.
2335 WABANSIA AVE.
CHICAGO, ILL.

CAT. NO.

PART NO. 9962F

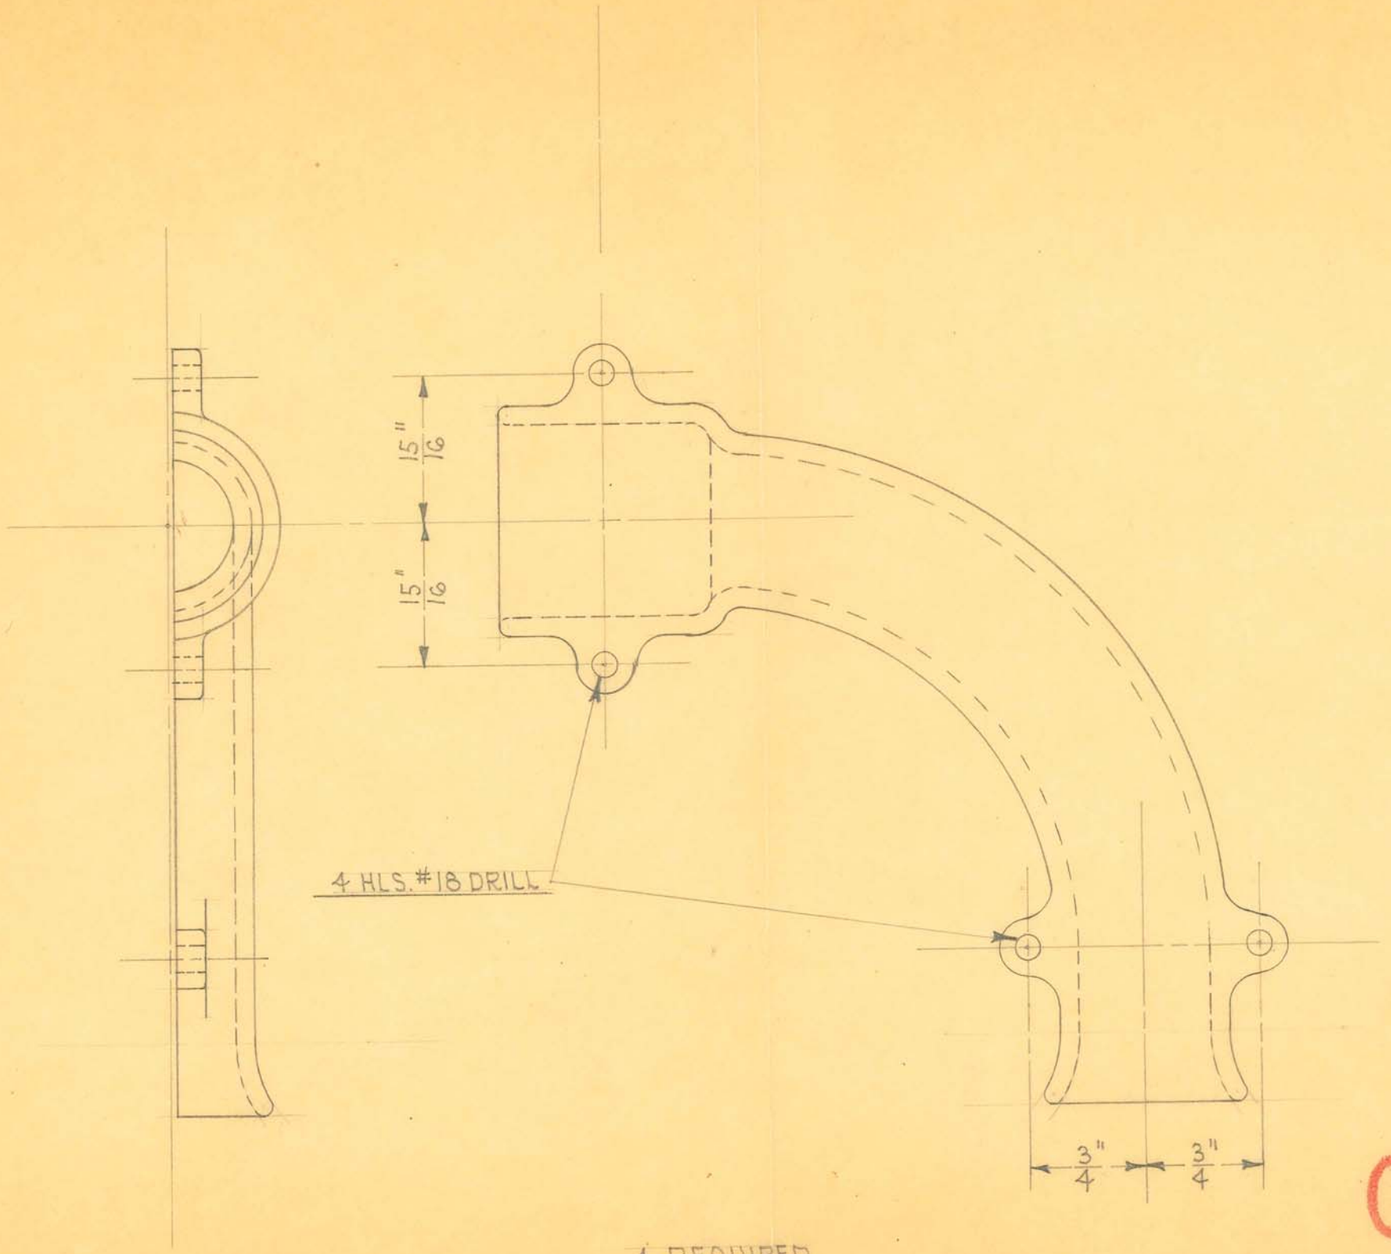

1 REQUIRED

OBSOLETE

SIZE		ISSUE 1-10-36	A.E.
KIND	ALUM. CASTING	CHANGED	
SHAPE		" "	
FINISH	BLACK #60	" "	
TEMP.		" "	
PATT. #	4091-914	" "	

TITLE: "15-88" WALL MOD. FLUOROSCOPE CABLE SUPPORT CAP

H. G. FISCHER & CO.
2335 WABANSIA AVE.
CHICAGO, ILL.

CAT. NO.

PART NO. 9963F

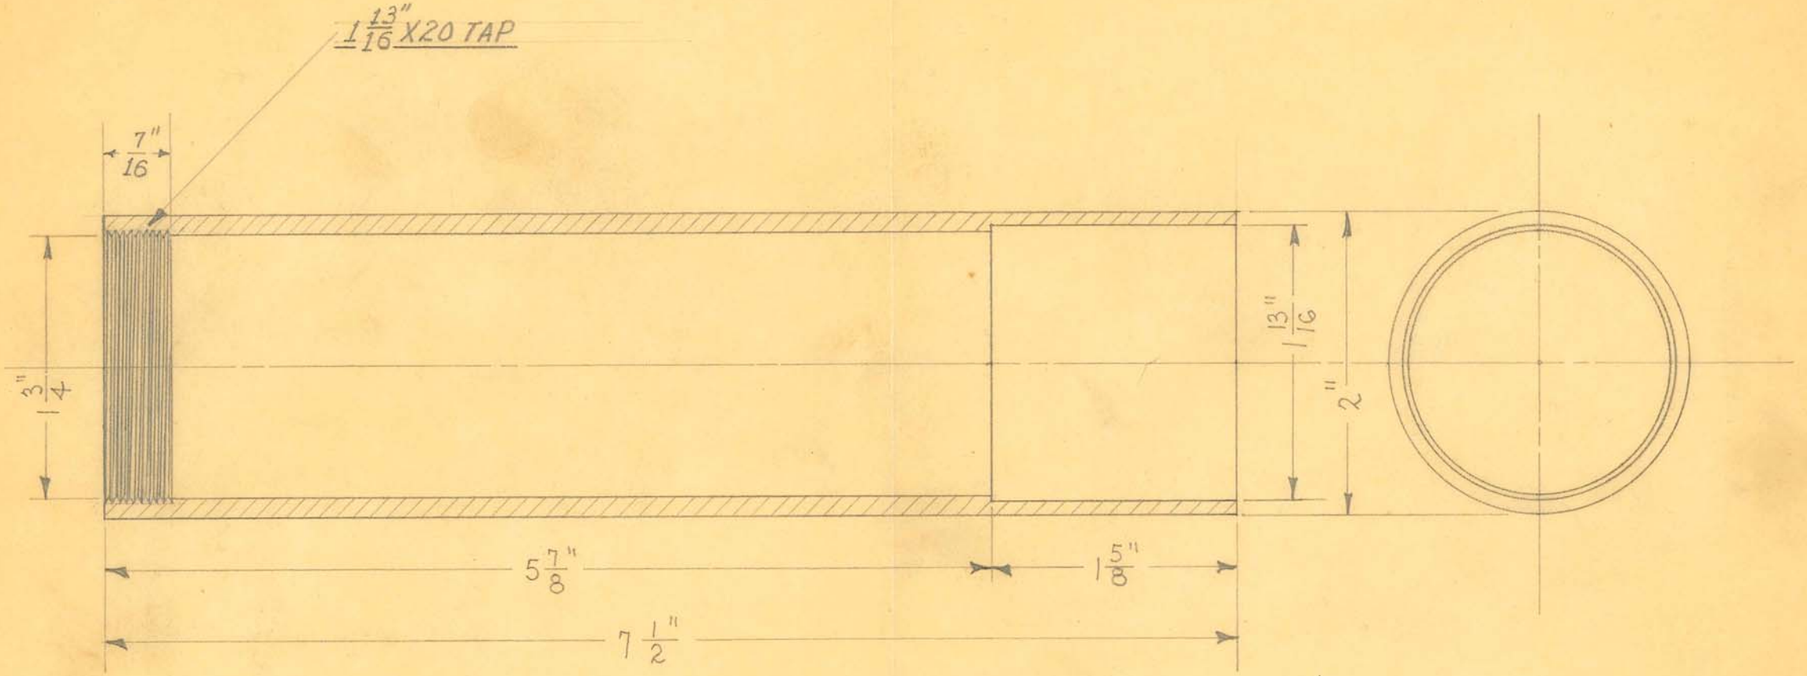

1 REQUIRED

OBSOLETE

SIZE	2" O.D. X 1 3/4" I.D.	ISSUE 1-28-36	2/8.	TITLE: "15-88" WALL MODEL FLUOROSCOPE TRANSF. HIGH TENSION CABLE INSULATOR
KIND	BAKELITE TUBING	CHANGED		
SHAPE		" "		
FINISH		" "		
TEMP.		" "		
PATT.		" "		

H. G. FISCHER & CO.
2335 WABANSIA AVE.
CHICAGO, ILL.

CAT. NO.

PART NO. 9972A

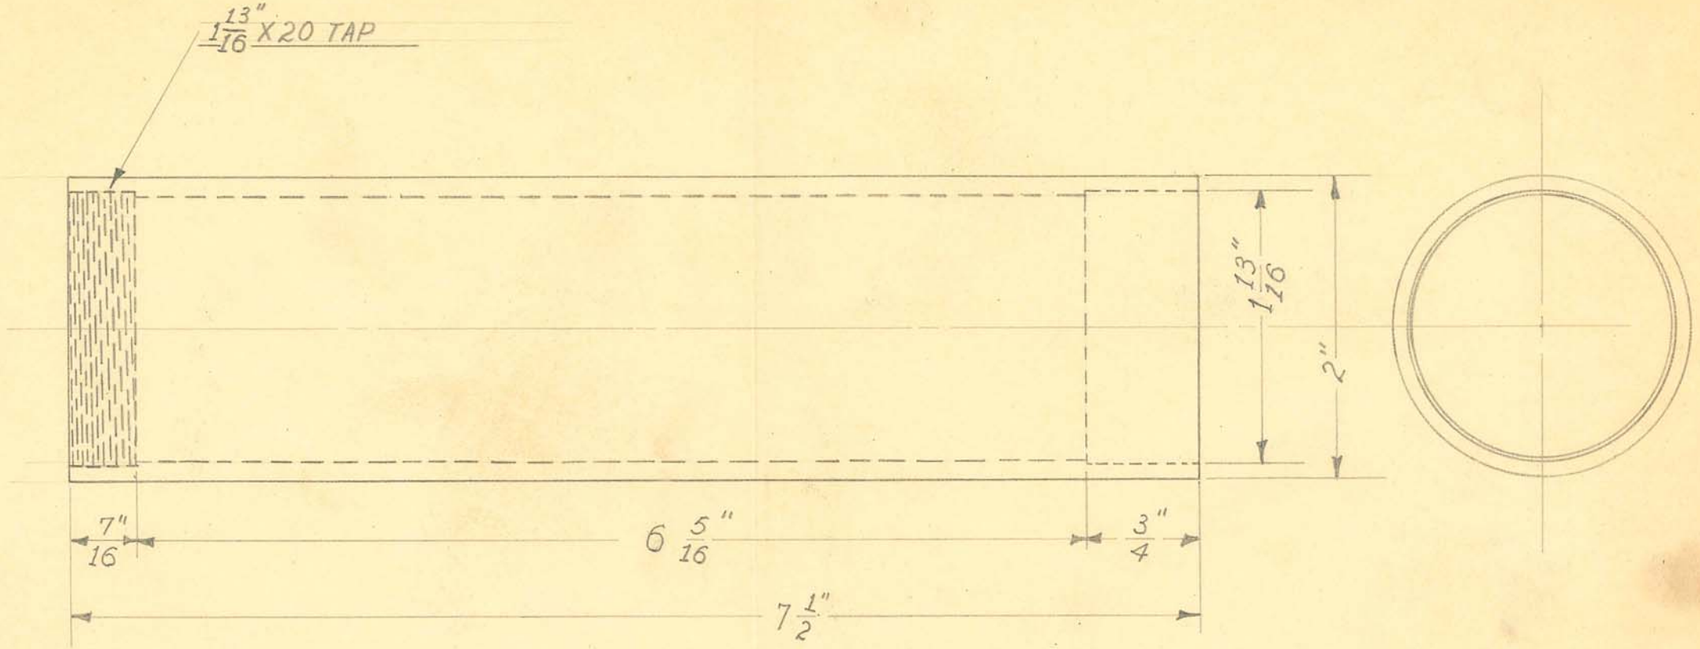

1 REQUIRED

OBSOLETE

SIZE	2"O.D.X1 3/4"I.D.	ISSUE 8-25-36	J.W.	
KIND	BAKELITE	CHANGED		
SHAPE	TUBING	"		
FINISH		"		
TEMP.		"		
PATT.		"		

TITLE:
FISCHER FLUOROSCOPE - WALL MOD.
CORD REEL CABLE INSULATOR

H. G. FISCHER & CO.
2335 WABANSIA AVE.
CHICAGO, ILL.

CAT. NO.

PART NO. 9973B

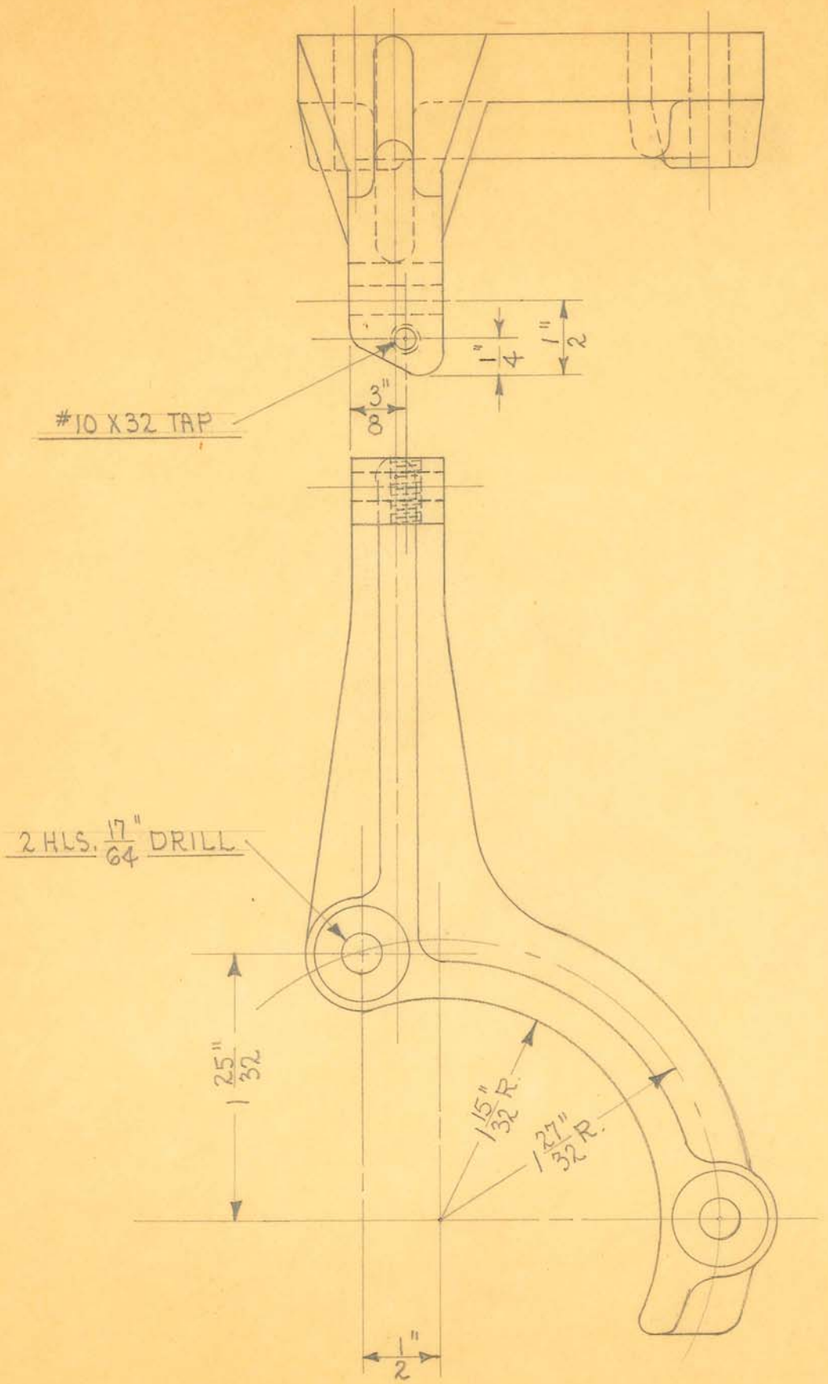

1 REQUIRED

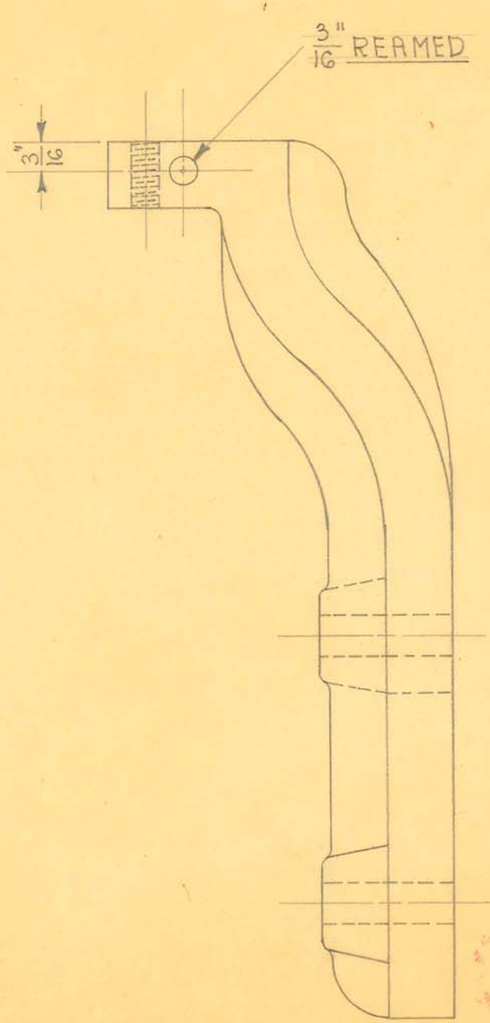

OBSOLETE

SIZE		ISSUE 1-11-36	3.6.
KIND	ALUM. CASTING	CHANGED	
SHAPE		" "	
FINISH	BLACK #60	" "	
TEMP.		" "	
PATT. #	2423-881	" "	

TITLE: "15-88" WALL MOD. FLUOROSCOPE
VERTICAL SLIDE GUIDE - LOWER

H. G. FISCHER & CO.
2335 WABANSIA AVE.
CHICAGO, ILL.

CAT. NO.

PART NO. 9977F

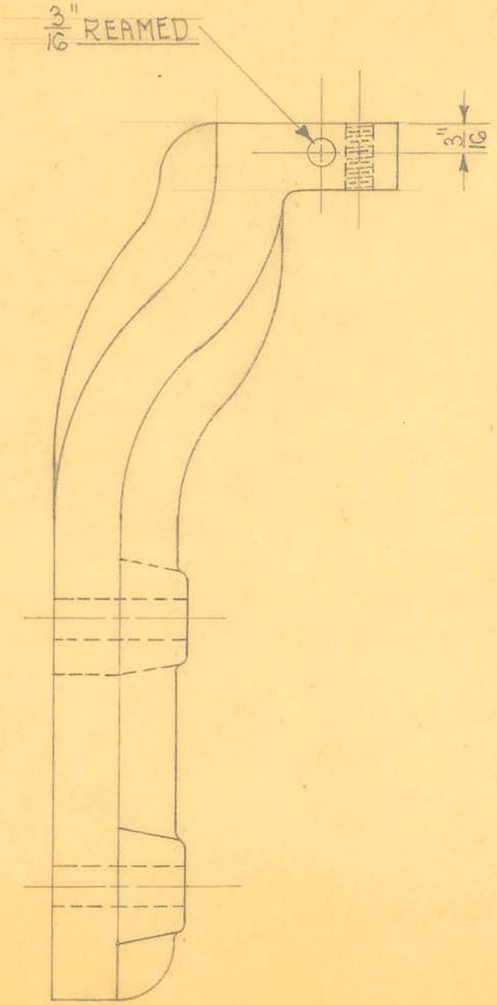

1 REQUIRED

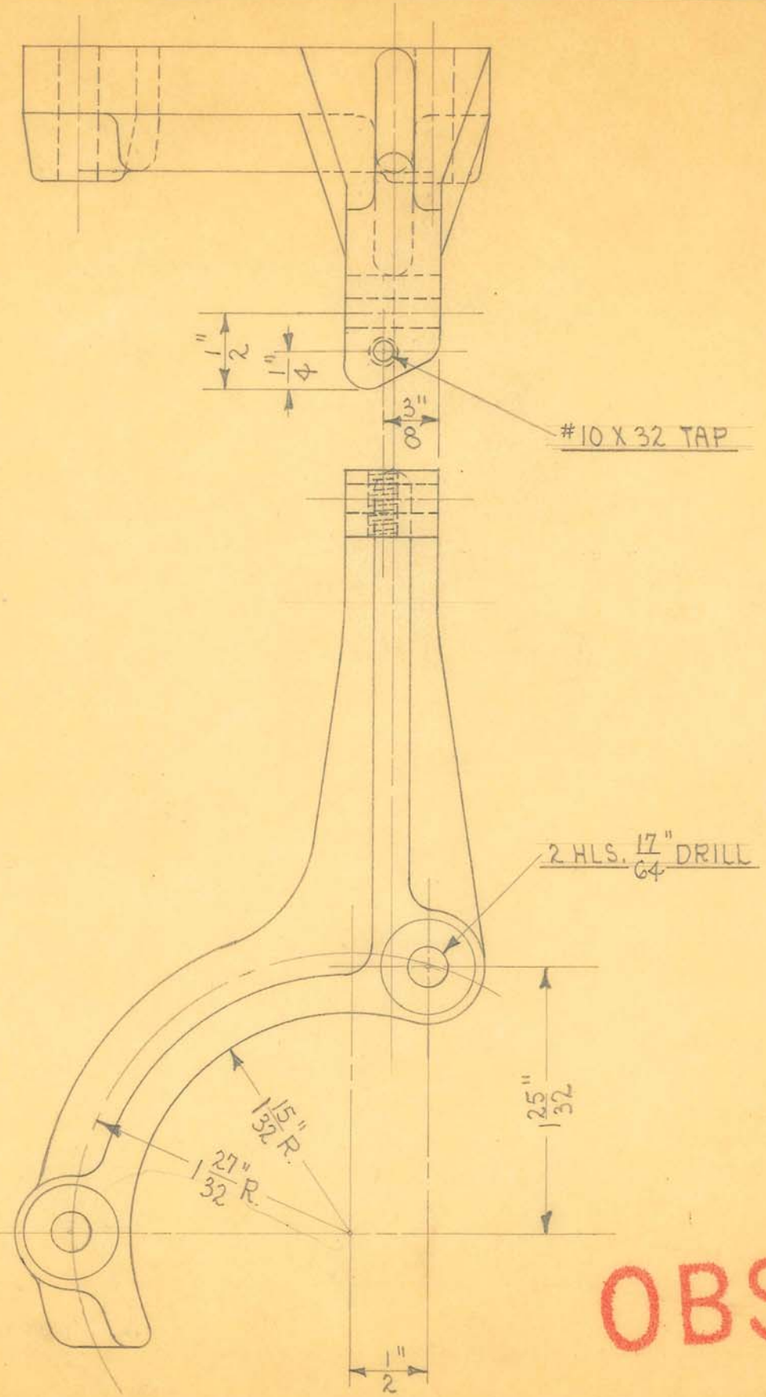

OBSOLETE

SIZE		ISSUE 1-11-36	A.E.
KIND	ALUM. CASTING	CHANGED	
SHAPE		" "	
FINISH	BLACK #60	" "	
TEMP.		" "	
PATT. #	2422-88D	" "	

TITLE: "15-88" WALL MOD. FLUOROSCOPE
VERTICAL SLIDE GUIDE - UPPER

H. G. FISCHER & CO.
2335 WABANSIA AVE.
CHICAGO, ILL.

CAT. NO.

PART NO. 9978F

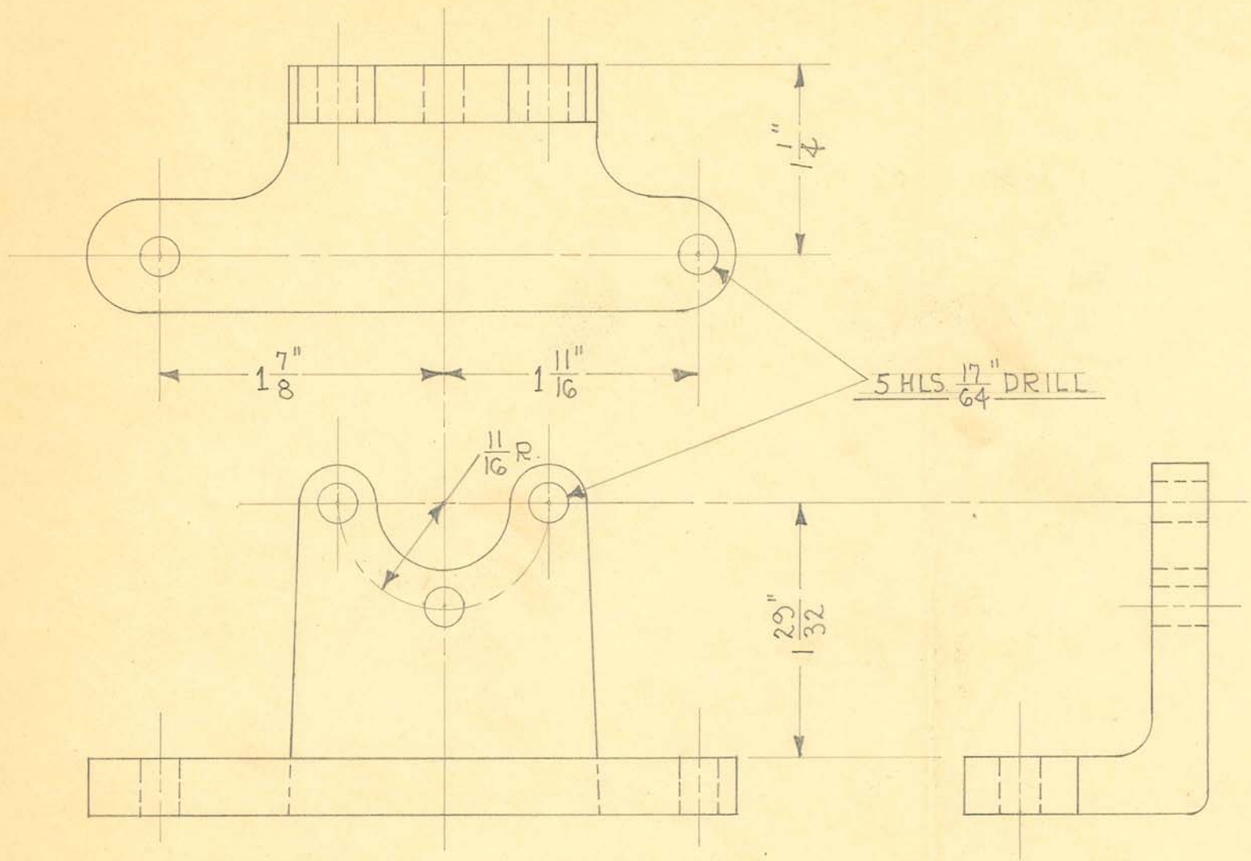

1 REQUIRED

OBSOLETE

SIZE		ISSUE 1-3-36	A.E.
KIND	ALUM. CASTING	CHANGED	
SHAPE		"	
FINISH	BLACK #60	"	
TEMP.		"	
PATT.	4583-922	"	

TITLE: "15-88" WALL MOD. FLUOROSCOPE TUBE HEAD & SCREEN BRACKET BEARING SUPPORT

H. G. FISCHER & CO. 2335 WABANSIA AVE. CHICAGO, ILL.	CAT. NO.	PART NO. 9979F

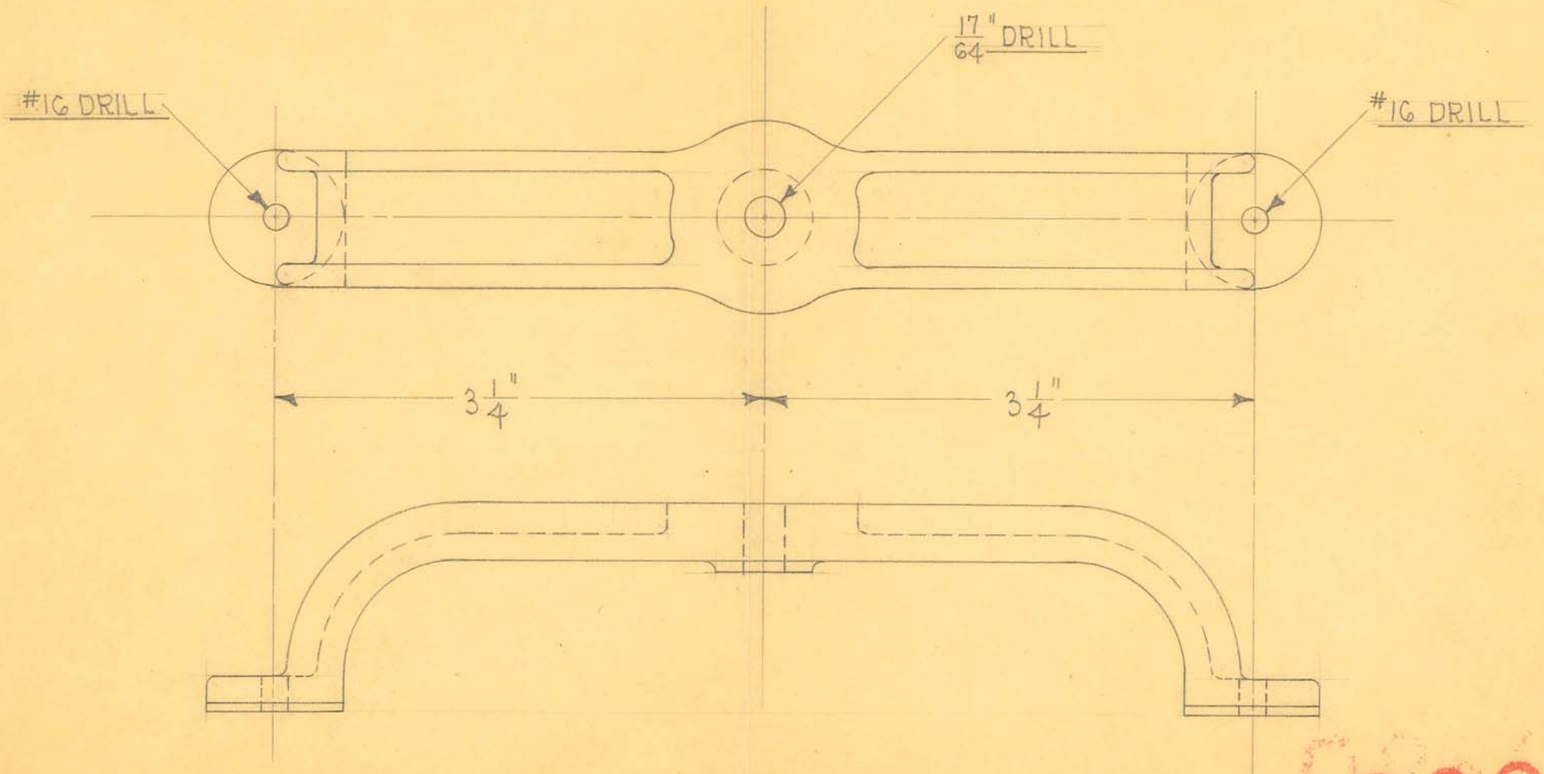

2 REQUIRED

OBSOLETE

SIZE		ISSUE 1-3-36	A.E.
KIND	ALUM. CASTING	CHANGED	
SHAPE		" "	
FINISH	BLACK #60	" "	
TEMP.		" "	
PATT. #	2991-894	" "	

TITLE: "15-88" WALL MOD. FLUOROSCOPE TUBE MOUNTING BRIDGE

H. G. FISCHER & CO.
2335 WABANSIA AVE.
CHICAGO, ILL.

CAT. NO.

PART NO. 9980F

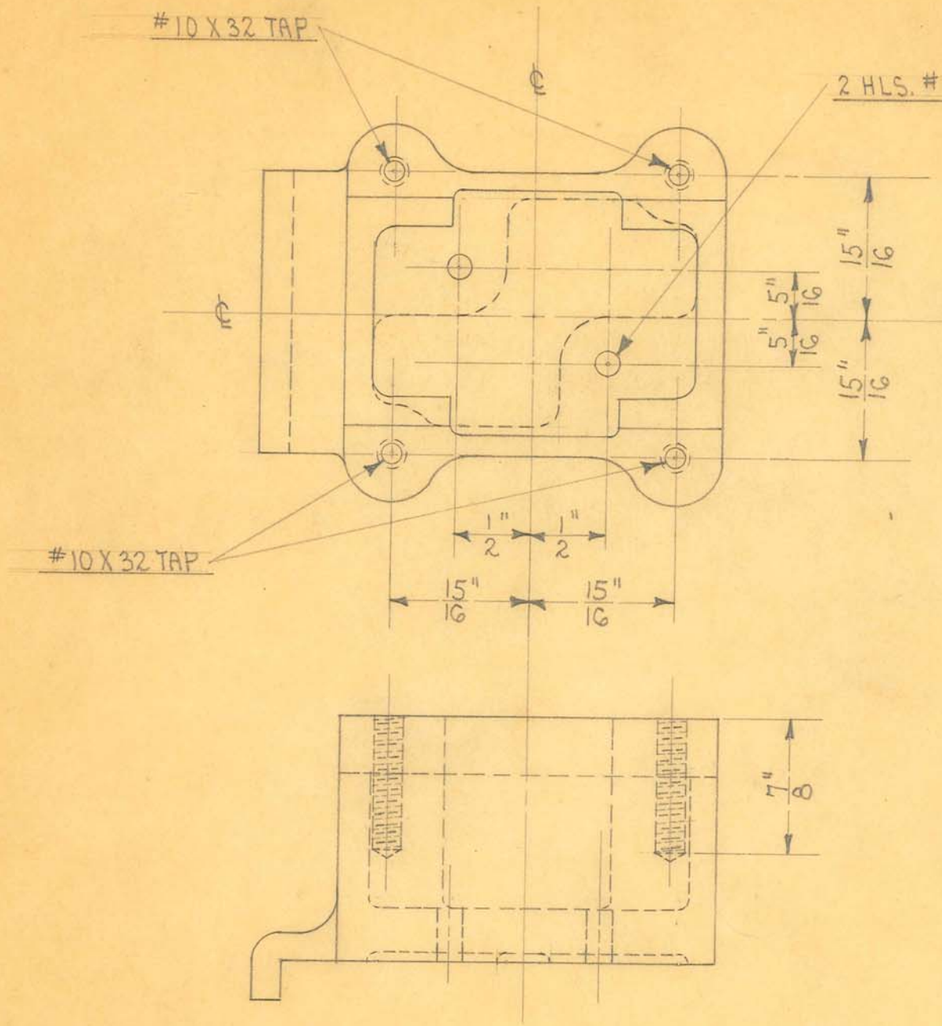

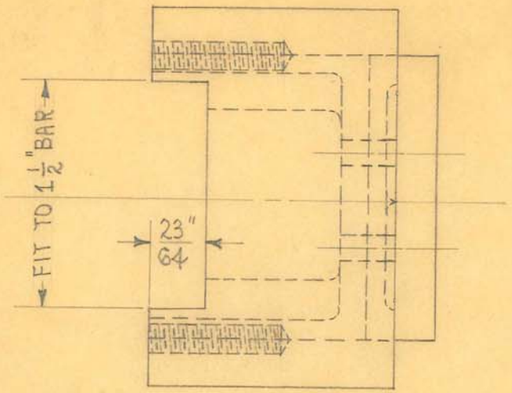

1 REQUIRED

OBSOLETE

SIZE		ISSUE 12-27-35	A.E.	TITLE: "15-88" WALL MOD. FLUOROSCOPE CONTROL BOX CLAMP-LOWER
KIND	ALUM. CASTING	CHANGED		
SHAPE		" "		
FINISH		" "		
TEMP.		" "		H. G. FISCHER & CO. 2335 WABANSIA AVE. CAT. NO. PART NO. 29875

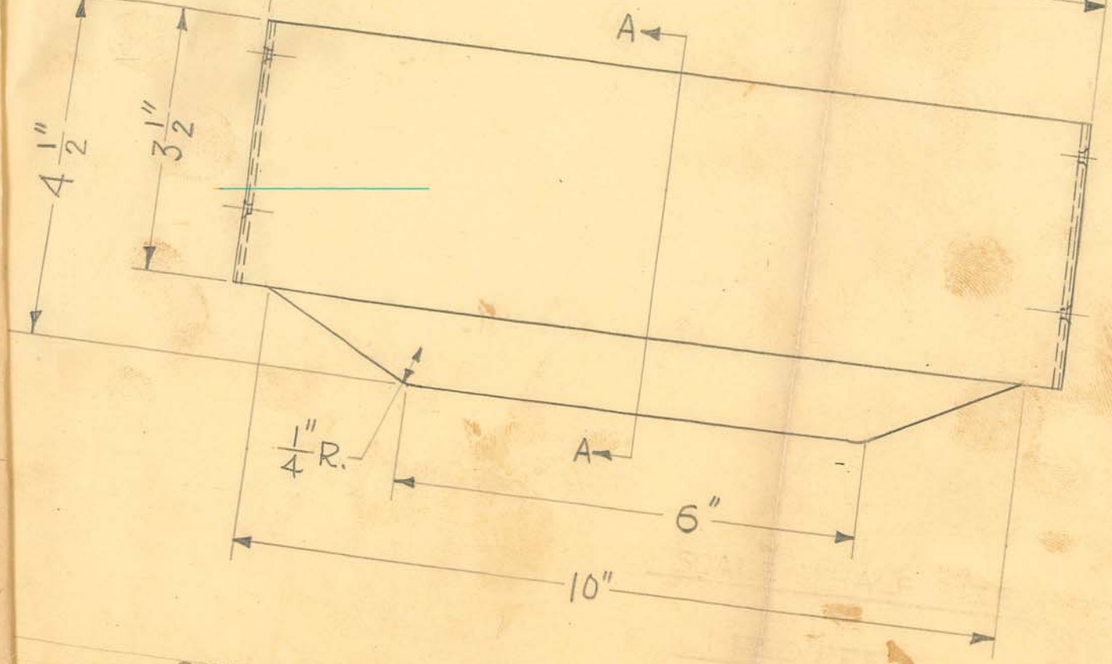

SCALE ~ HALF SIZE

DEVELOPED LENGTH = 17 15/16"

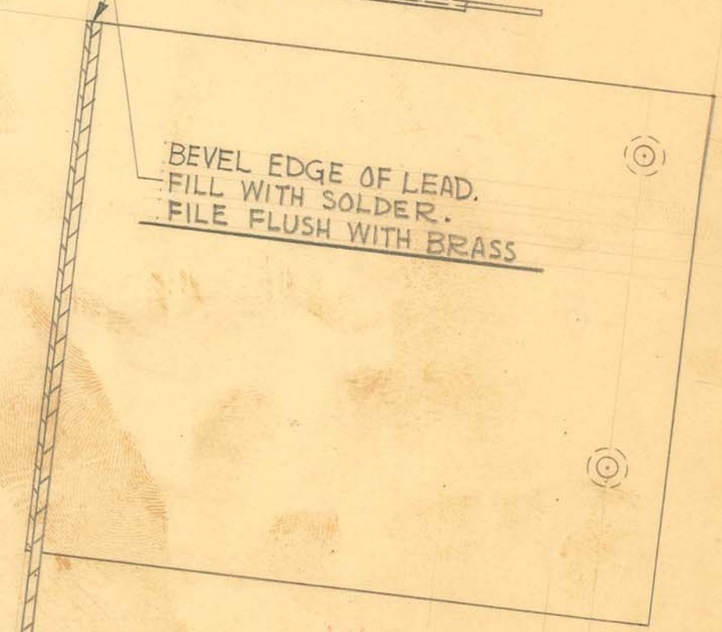

SECTION THRU "A-A"
SCALE ~ FULL SIZE

OBSOLETE

SIZE		ISSUE 2-4-41	J.V.W.	TITLE: FISCHER MOD. "G" X-RAY UNIT TANK — X-RAY SHIELD
KIND		CHANGED		
SHAPE		"		
FINISH		"		
TEMP.		"		
PATT.				

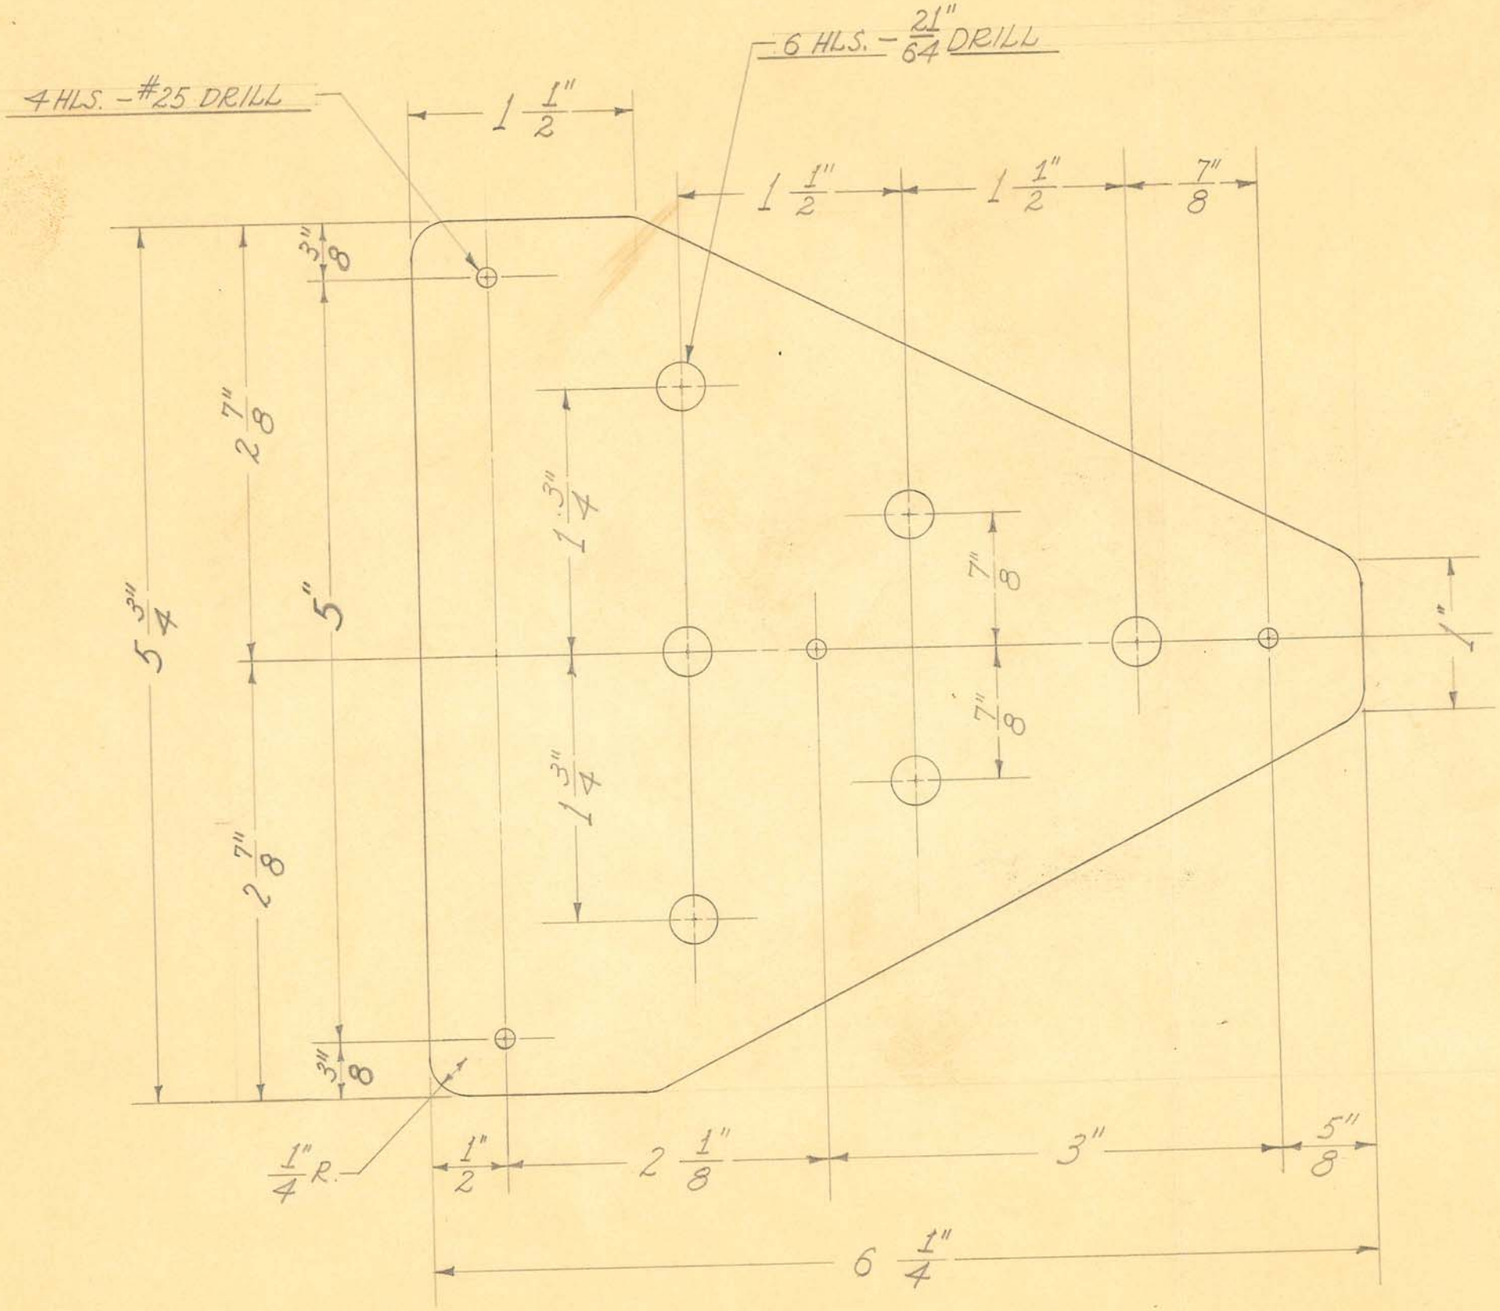

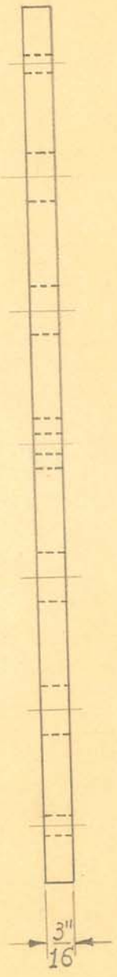

OBSOLETE

2 REQUIRED

SIZE	3/16" SHEET	ISSUE 5-9-38	J.W.	TITLE: FISCHER MOD. "6-24-72" SHORT WAVE CORD SOCKET MOUNTING BOARD
KIND	MICALEX	CHANGED		
SHAPE		"		
FINISH		"		
TEMP.		"		
PATT.		"		

H. G. FISCHER & CO.
2335 WABANSIA AVE.
CHICAGO, ILL.

CAT. NO.

PART NO. 11604

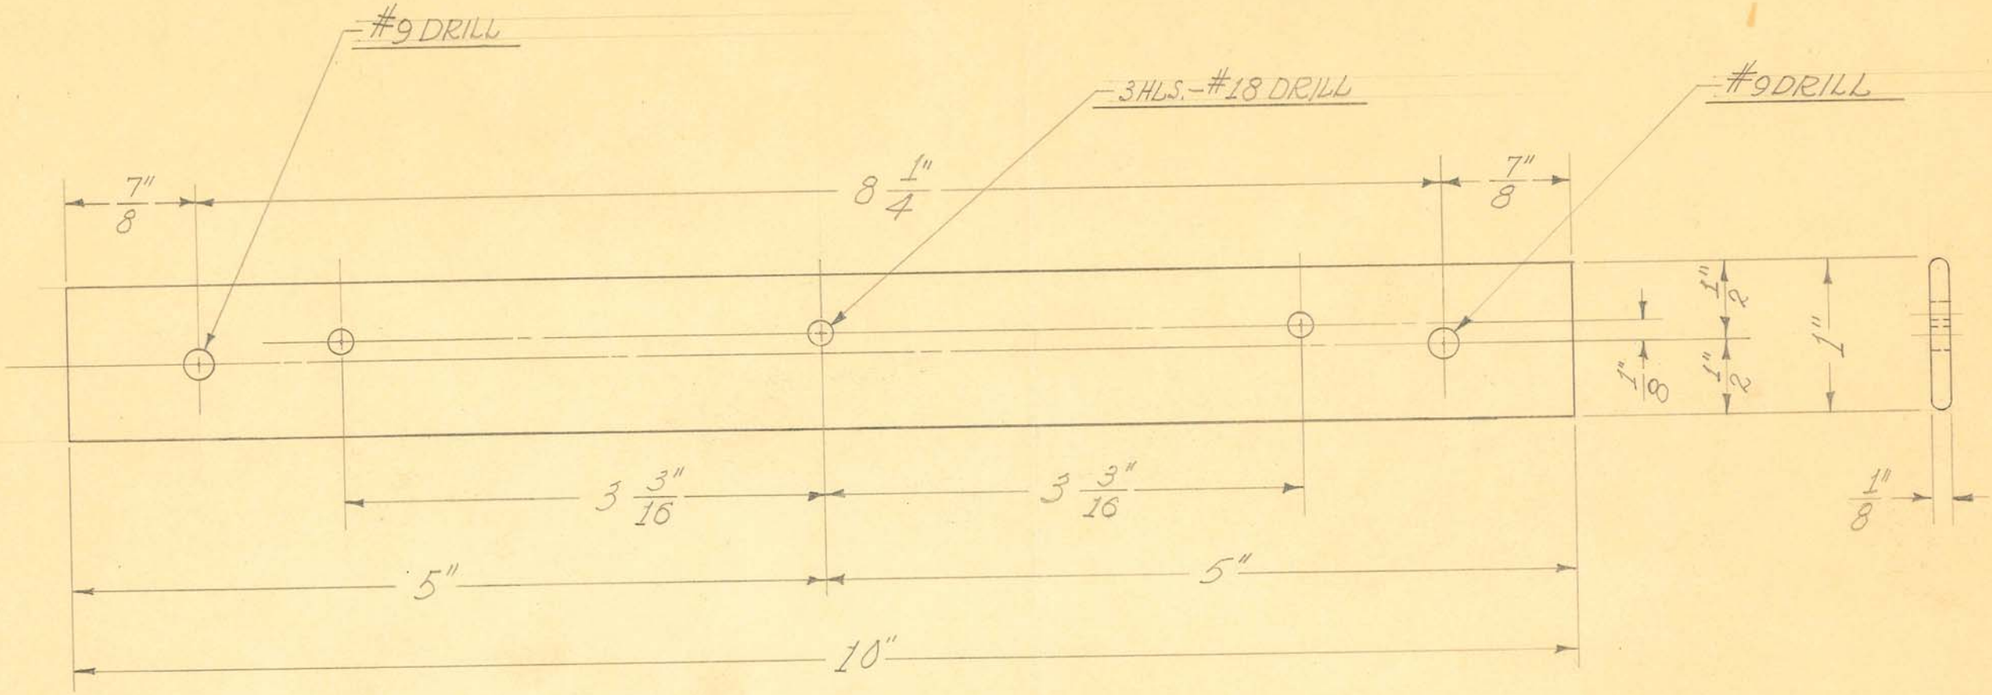

1 REQUIRED

OBSOLETE

SIZE	1"x 1/8"	ISSUE 5-3-38	J.W.	TITLE: FISCHER MOD. "6-24-72" SHORT WAVE FILAMENT CHOKE TIE STRIP—BOTTOM
KIND	FLAT WIRE	CHANGED		
SHAPE		"		
FINISH		"		
TEMP.		"		
PATT.		"		

H. G. FISCHER & CO.
2335 WABANSIA AVE.
CHICAGO, ILL.

CAT. NO.

PART NO. 11606

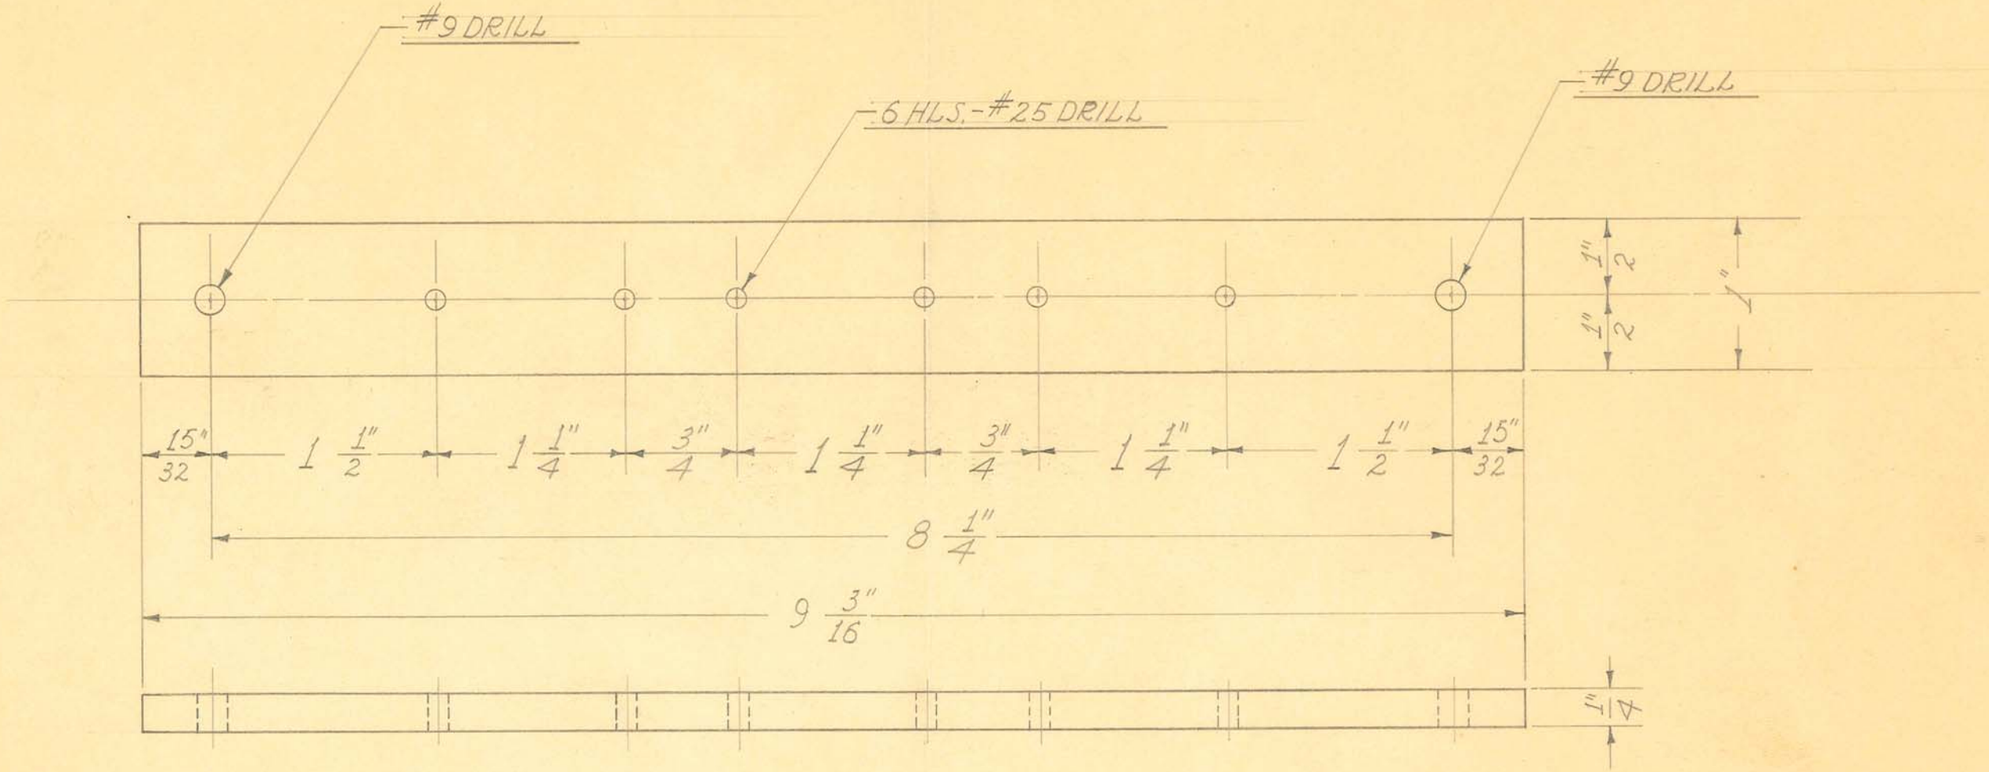

1 REQUIRED

OBSOLETE

SIZE	1/4" SHEET	ISSUE 5-3-38	J.W.
KIND	BAKELITE	CHANGED	
SHAPE		"	
FINISH		"	
TEMP.		"	
PATT.		"	

TITLE: FISCHER MOD. "6-24-72" SHORT WAVE FILAMENT CHOKE TIE STRIP—TOP

H. G. FISCHER & CO.
2335 WABANSIA AVE.
CHICAGO, ILL.

CAT. NO.

PART NO. 11607

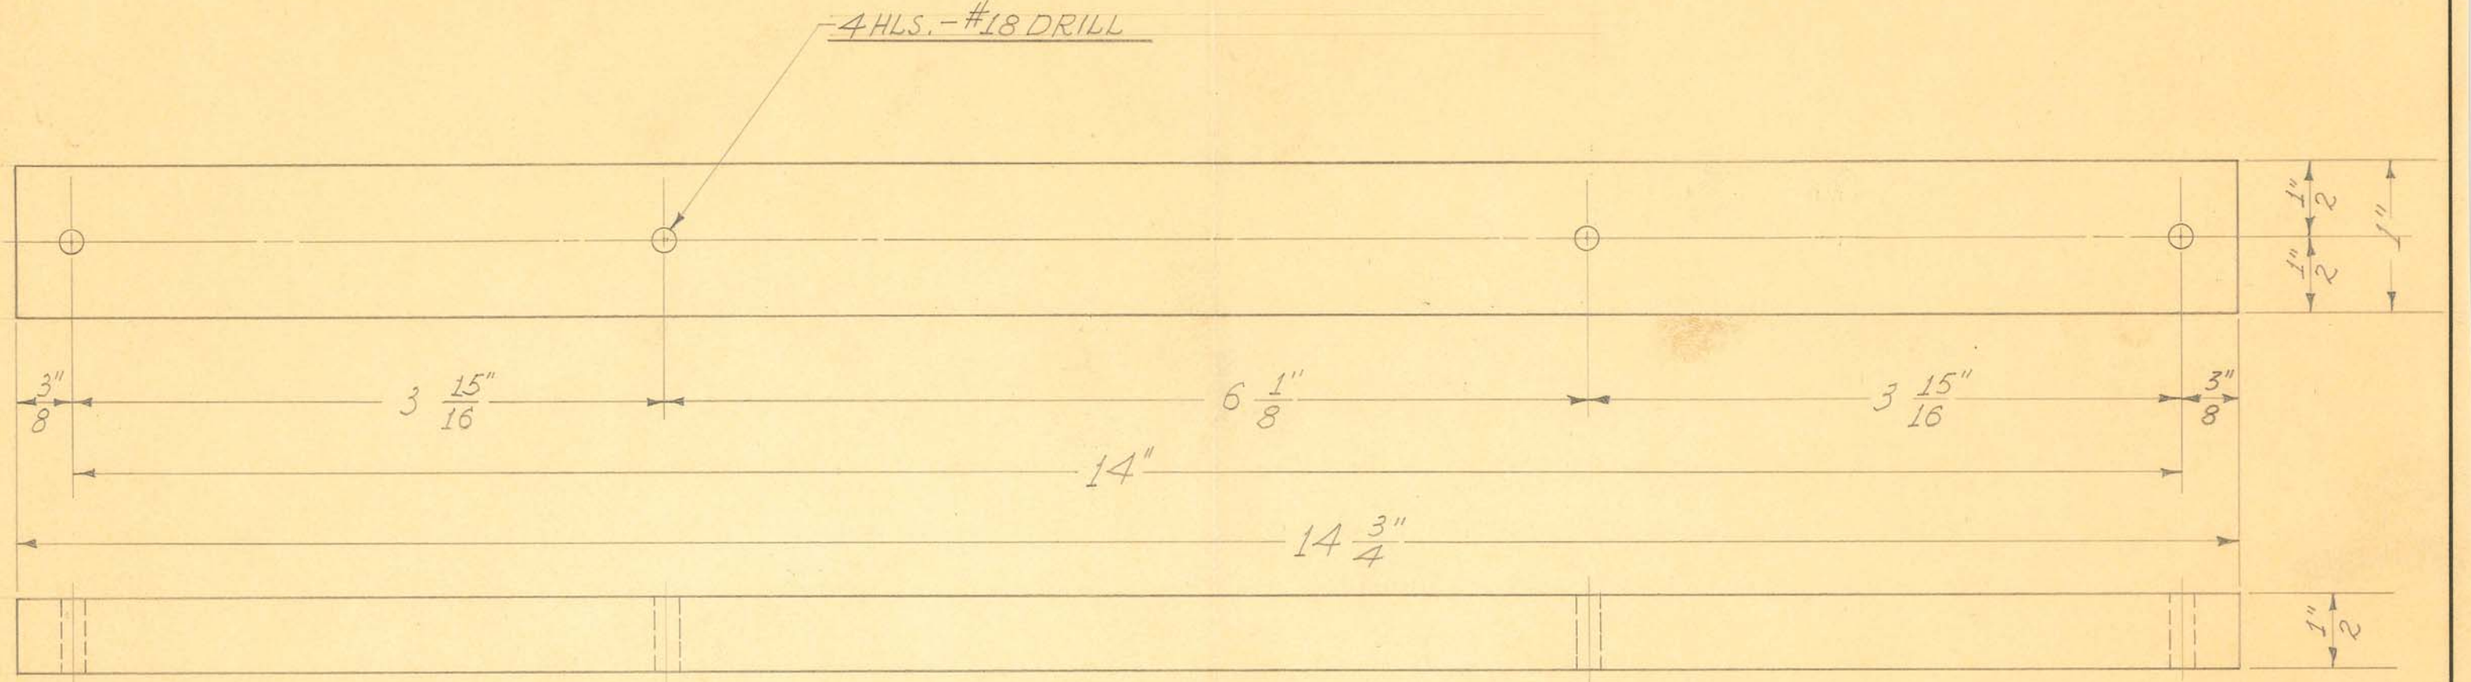

1 REQUIRED

OBSOLETE

SIZE	1/2" SHEET	ISSUE 5-3-38	J.W.
KIND	BAKELITE	CHANGED	
SHAPE		"	
FINISH		"	
TEMP.		"	

TITLE:
FISCHER MOD. "6-24-72" SHORT WAVE
PATIENT'S TUNING COND. MTG. STRIP-FRONT

H. G. FISCHER & CO.
2335 WABANSIA AVE.

CAT. NO.

PART NO. 11608

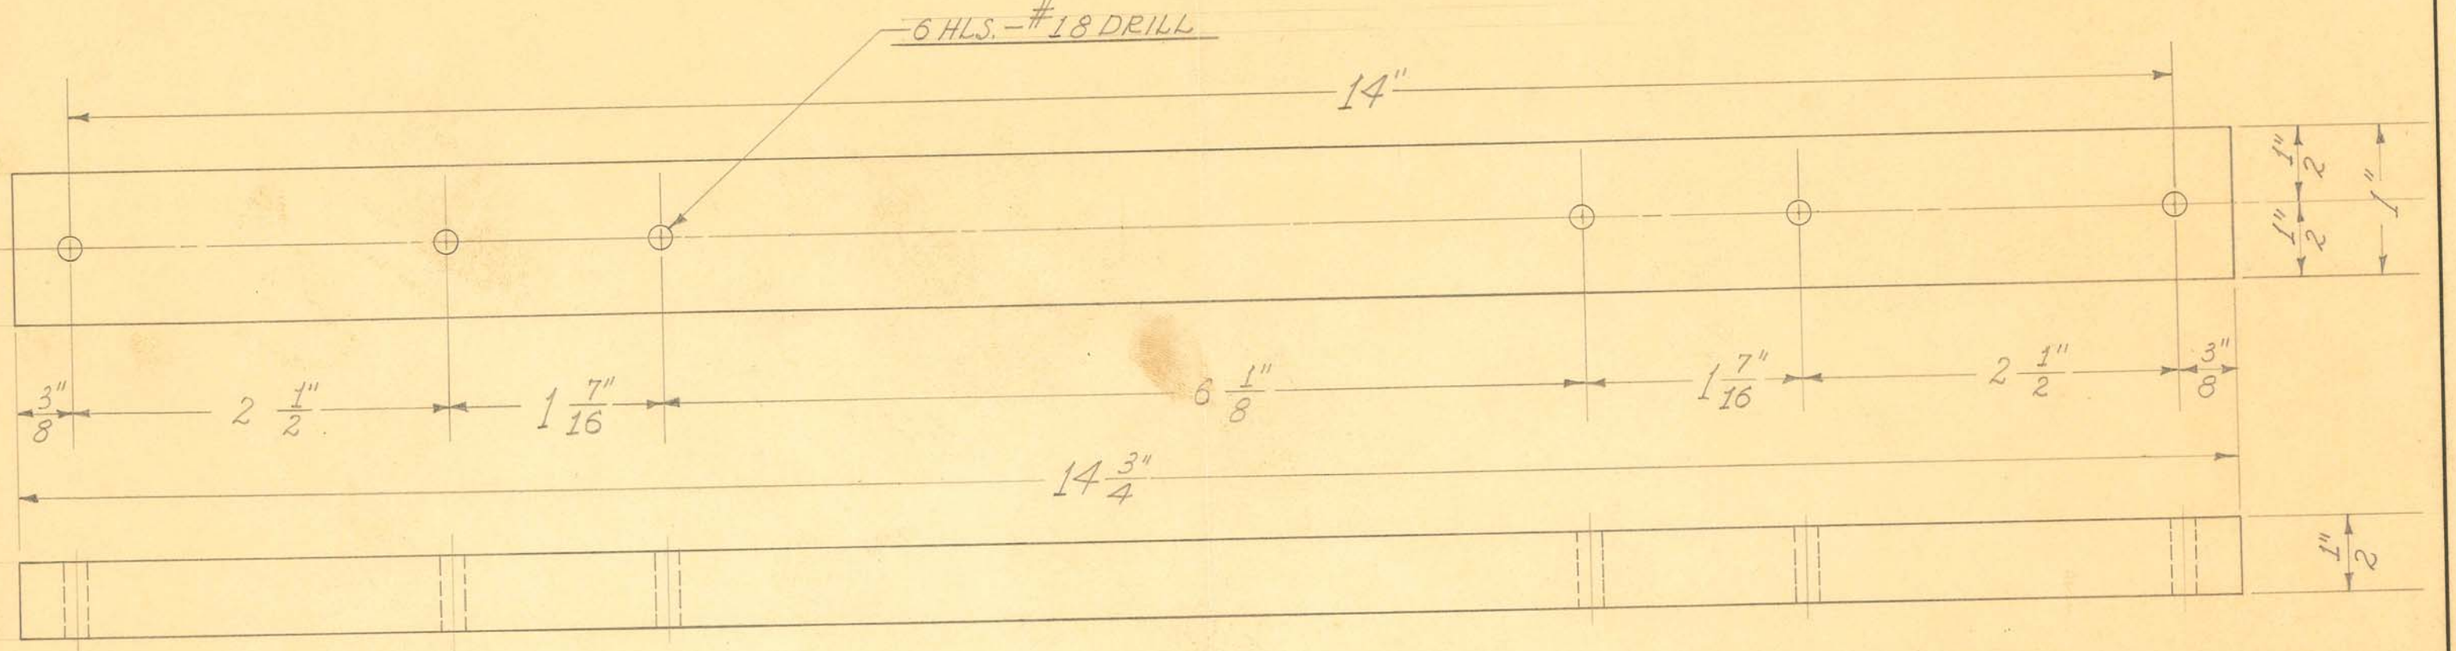

1 REQUIRED

OBSOLETE

SIZE	4½" SHEET	ISSUE 5-3-38	J.W.	TITLE: FISCHER MOD. "6-24-72" SHORT WAVE PATIENT'S TUNING COND. MTG. STRIP - REAR
KIND	BAKELITE	CHANGED		
SHAPE		"		
FINISH		"		
TEMP.		"		
PATT.		"		

H. G. FISCHER & CO.
2335 WABANSIA AVE.
CHICAGO, ILL.

CAT. NO.

PART NO. 11609

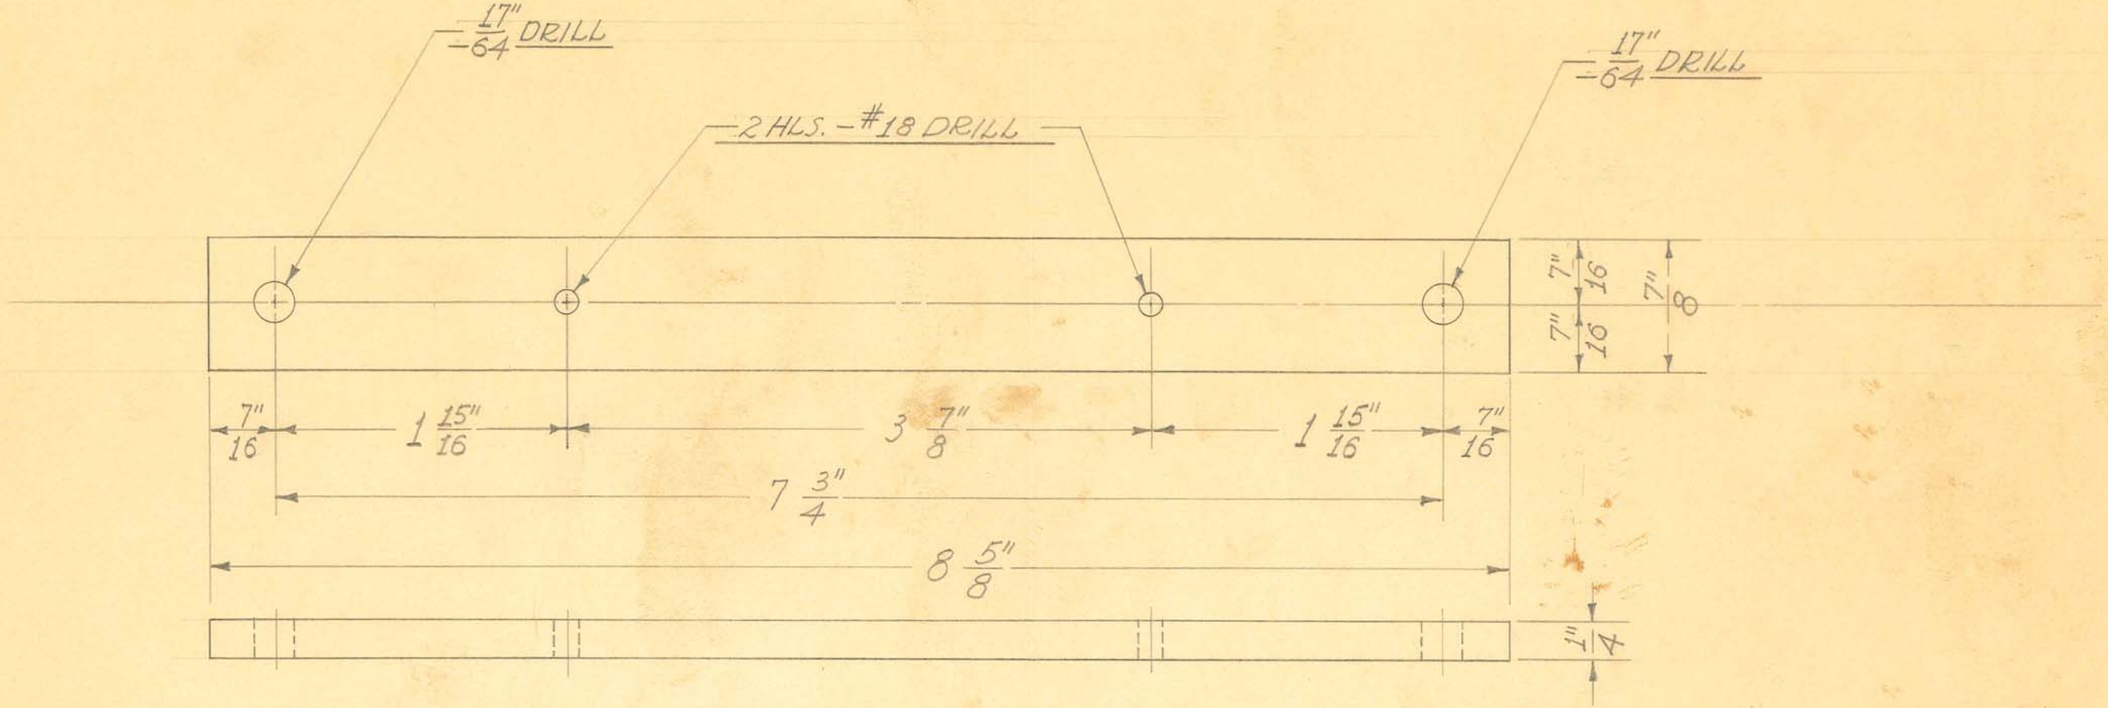

1 REQUIRED

OBSOLETE

USE DRILL JIG AS USED ON #9426

SIZE	1/4" SHEET	ISSUE 5-6-38	J.W.
KIND	BAKELITE	CHANGED	
SHAPE		"	
FINISH		"	
TEMP.		"	
PATT.		"	

TITLE: FISCHER MOD. "6-24-72" SHORT WAVE POWER TRANSF. TERM. SUPP. BOARD - FRONT

H. G. FISCHER & CO.
2335 WABANSIA AVE.
CHICAGO, ILL.

CAT. NO.

PART NO. 11624

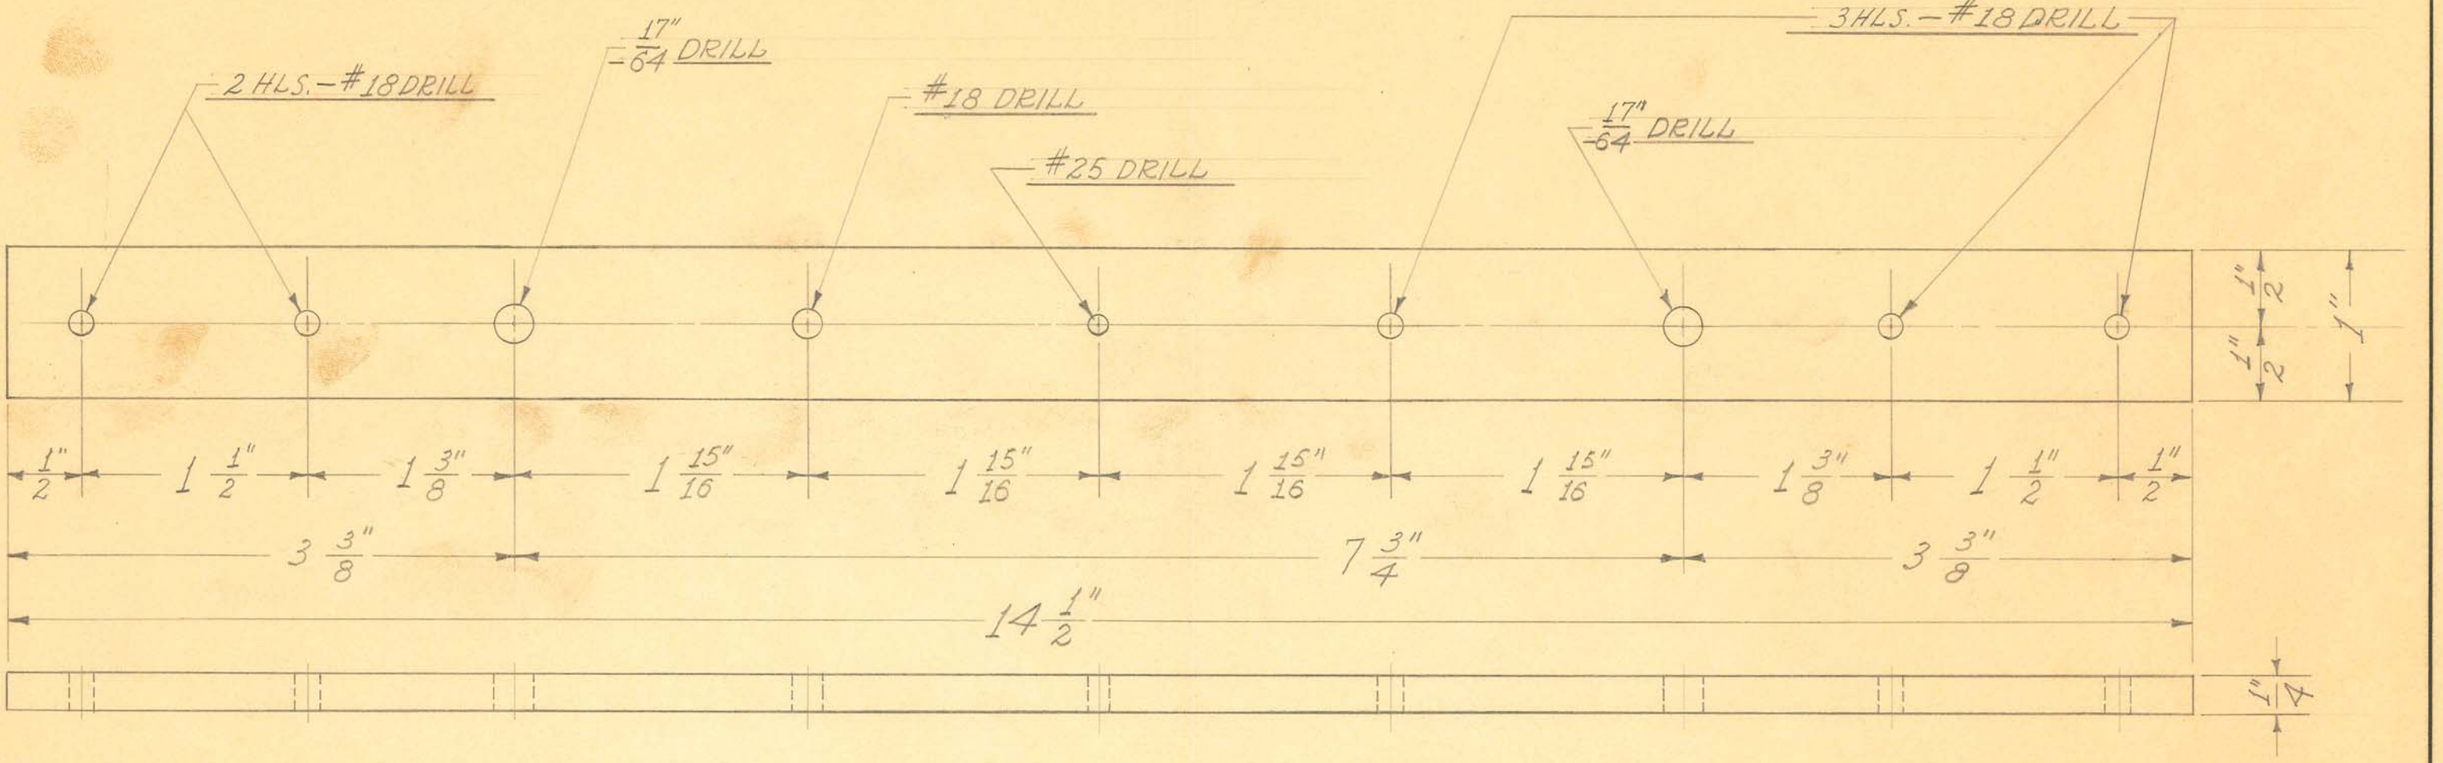

1 REQUIRED

OBSOLETE

SIZE	4/4" SHEET	ISSUE 5-5-38	J.W.
KIND	BAKELITE	CHANGED	
SHAPE		"	
FINISH		"	
TEMP.		"	

TITLE:
FISCHER MOD. "6-24-72" SHORT WAVE POWER TRANSF.-TERM. SUPP. BOARD-REAR

H. G. FISCHER & CO.
2335 WABANSIA AVE.

CAT. NO.

PART NO. 11627

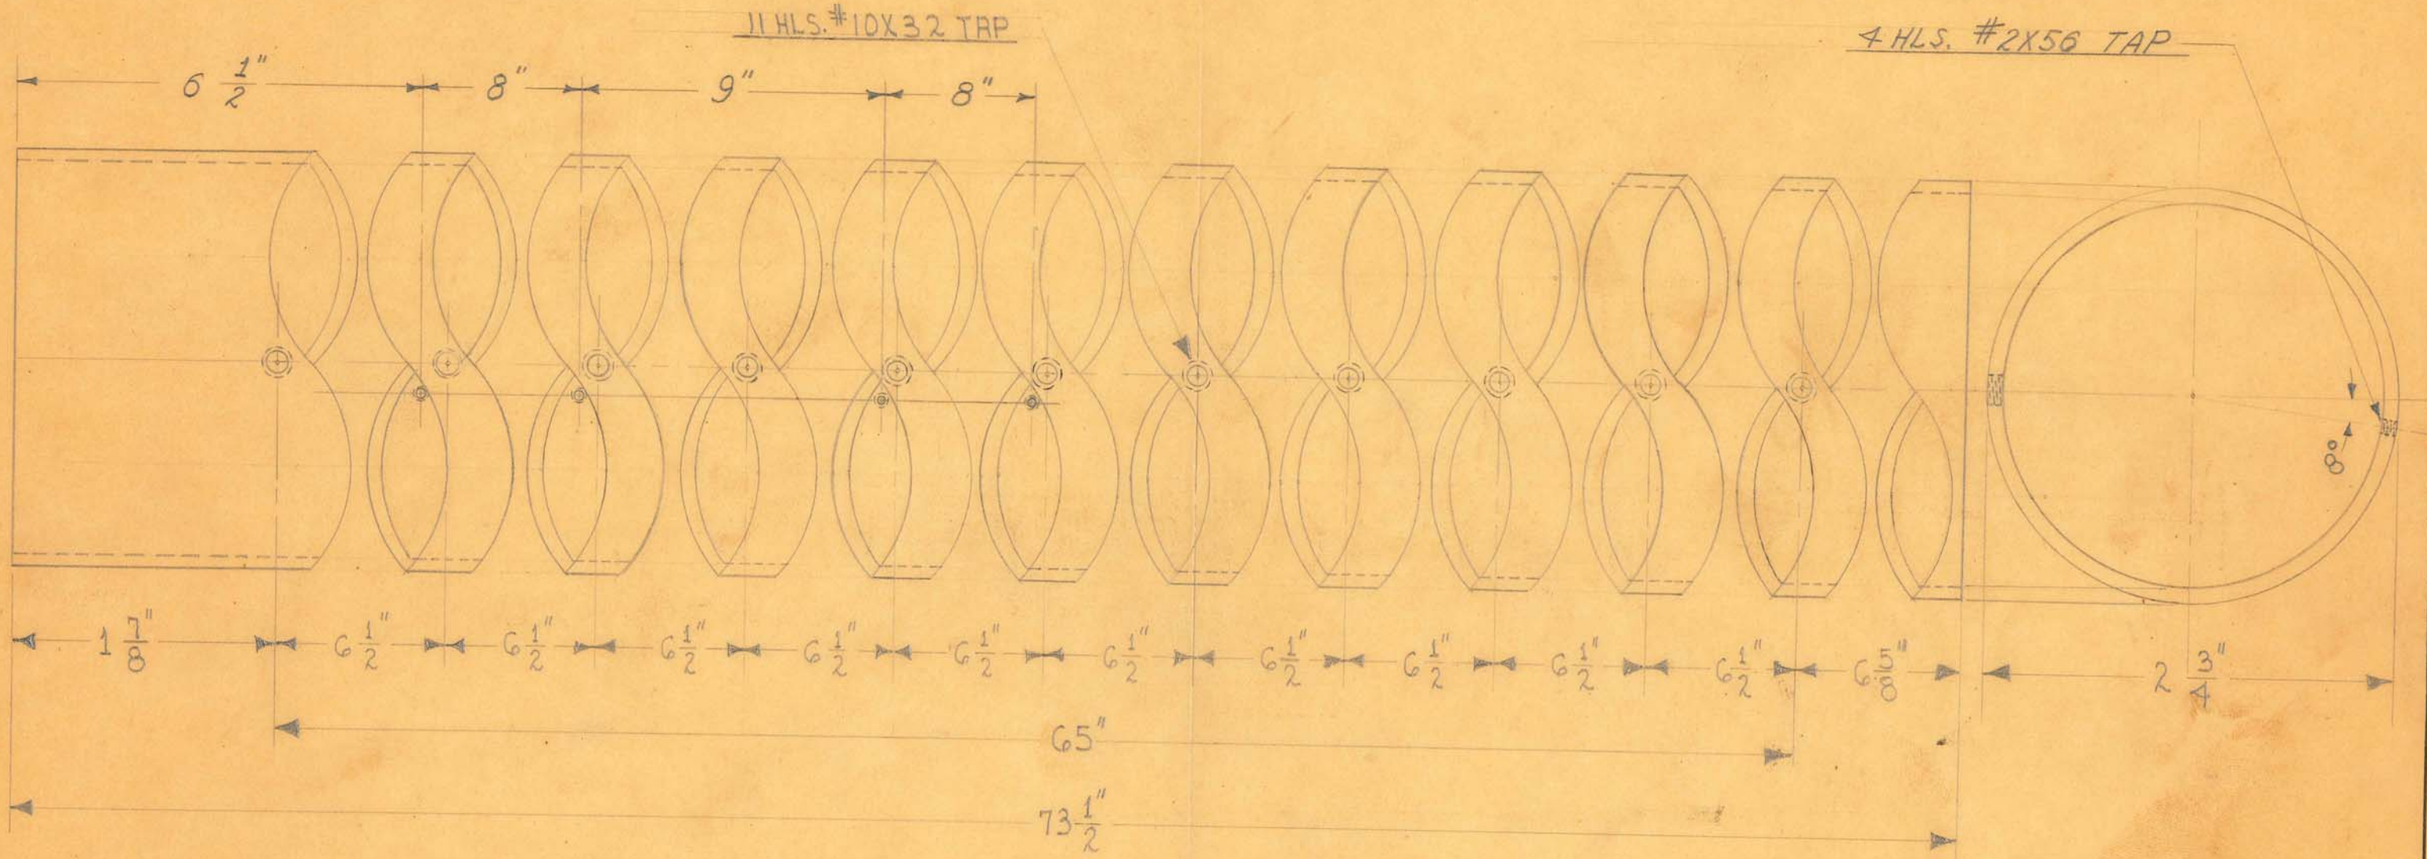

1 REQUIRED

OBSOLETE

SIZE	2¾"O.DX13GR.	ISSUE 8-9-35	J.W.	TITLE: MOD. "SP-60" SHOCKPROOF RAD. UNIT UPRIGHT TUBE
KIND	SEAMLESS	CHANGED 4-13-37	J.W.	
SHAPE	STEEL TUBING	" "		
FINISH	CHROME #2.	" "		
TEMP.		" "		
PATT.		" "		

H. G. FISCHER & CO.
2335 WABANSIA AVE.
CHICAGO, ILL.

CAT. NO.

PART NO. 9705A

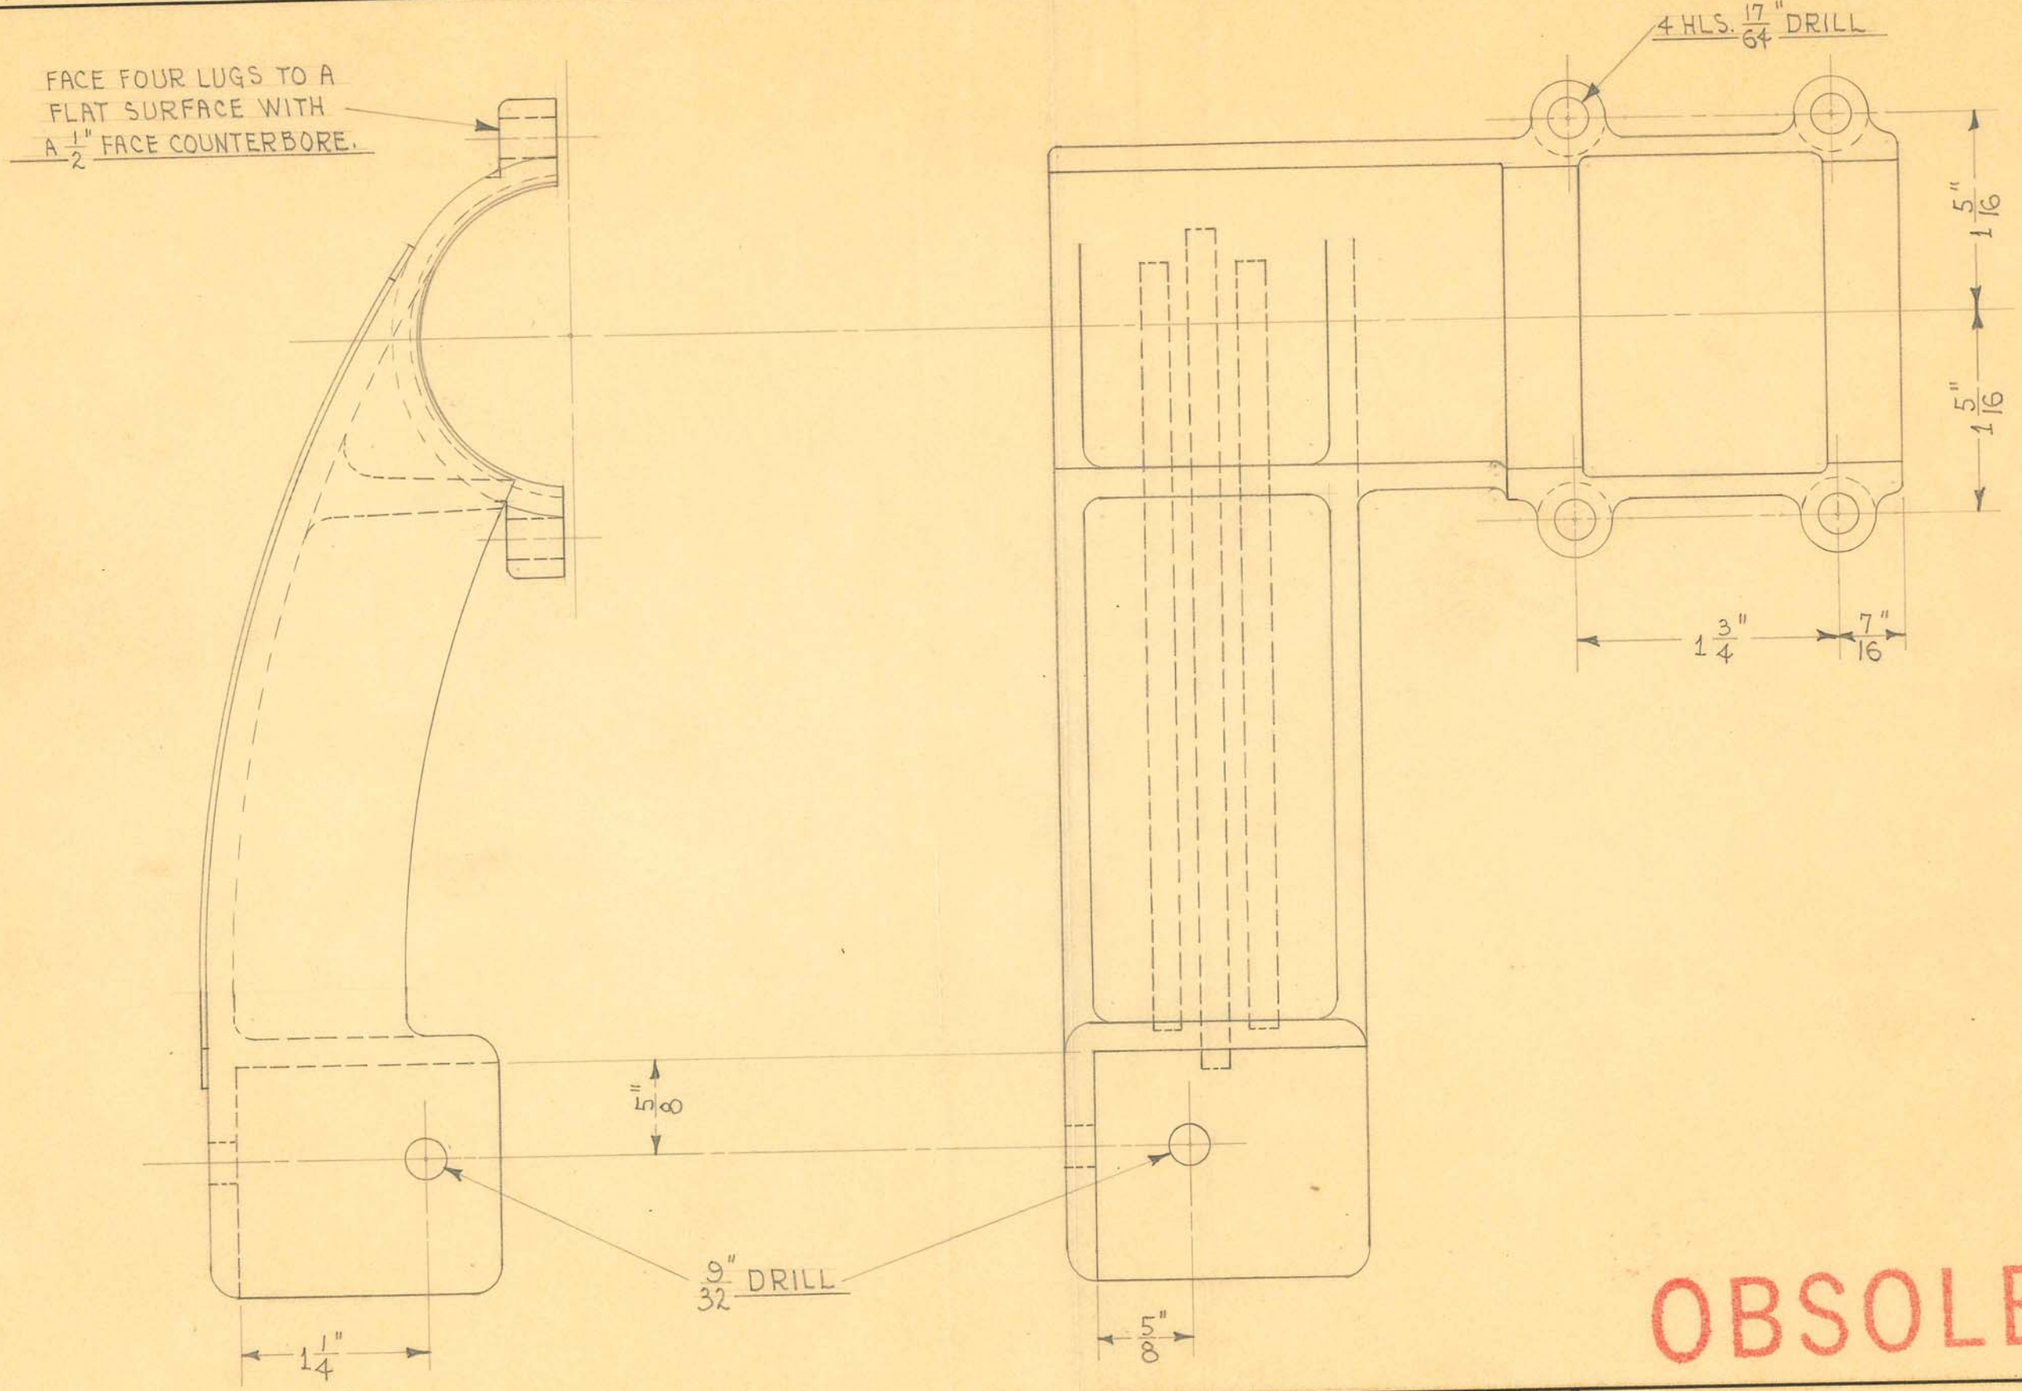

1 REQUIRED

OBSOLETE

SIZE		ISSUE 10-28-37	A.E.
KIND	IRON CASTING	CHANGED	
SHAPE		"	
FINISH	KRIST.#55	"	
TEMP.		"	
PAT.	7504-1173	"	

TITLE: VERTICAL WALL FRAME
PANEL FRAME LOWER SUPPORT-RIGHT

H. G. FISCHER & CO.
2335 WABANSIA AVE.
CHICAGO, ILL.

CAT. NO.

PART NO. 11089F

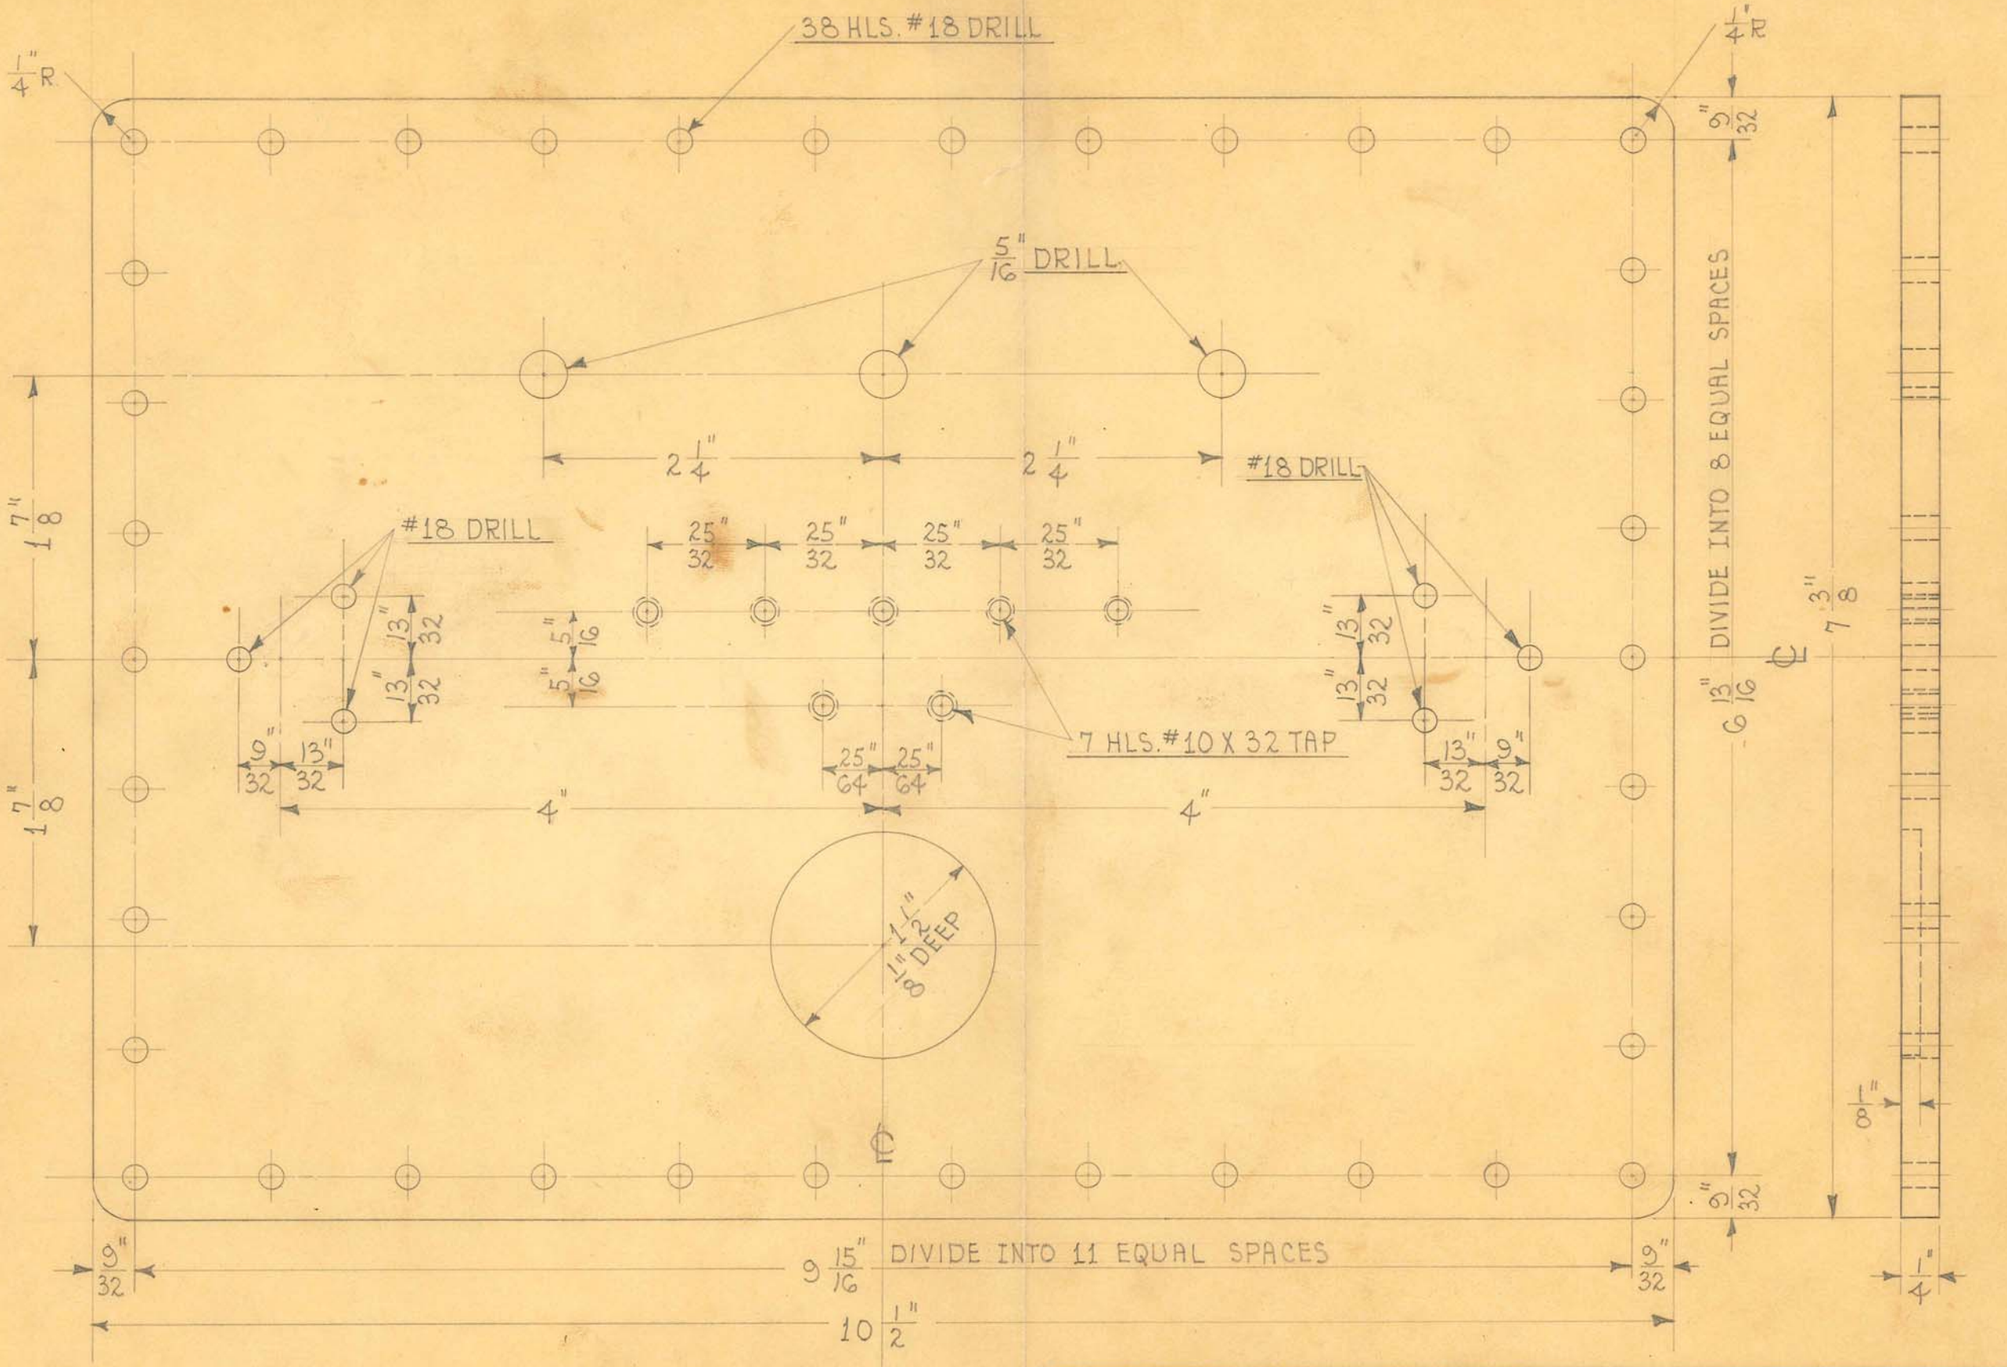

OBSOLETE

1 REQUIRED

SIZE	10½"X7⅜"X¼	ISSUED 9-10-37	H.E.
KIND	BAKELITE	CHANGED 2-21-38	H.E.
SHAPE		" 3-24-38	H.E.
FINISH		"	
TEMP.		"	
PATT.		"	

TITLE: "H" PORTABLE X-RAY UNIT TANK PANEL

H. G. FISCHER & CO.
2335 WABANSIA AVE.
CHICAGO, ILL.

CAT. NO.

PART NO. 10868B

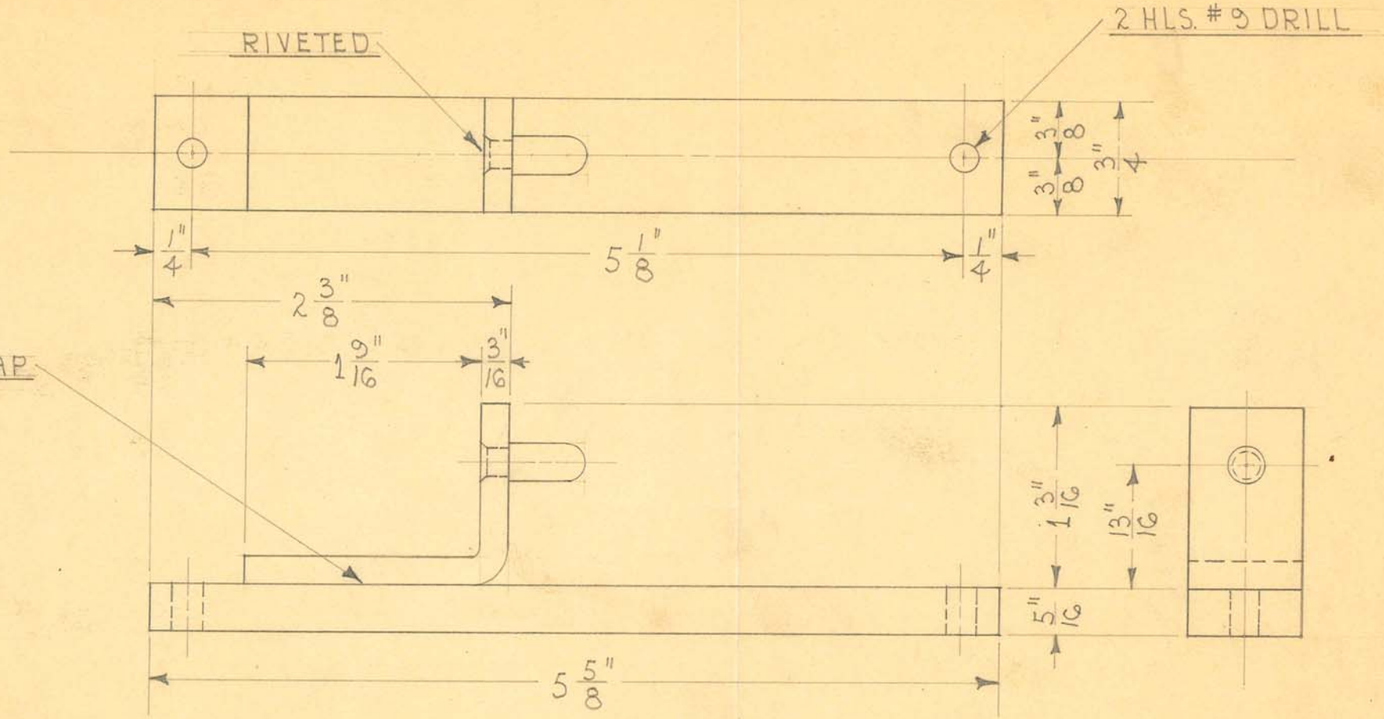

2 REQUIRED

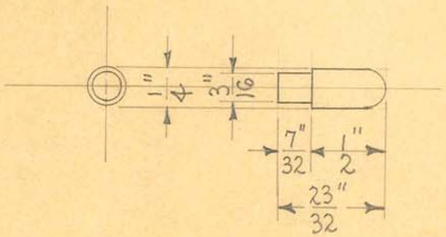

1/4" C.R. STEEL

MATERIAL

5/16" X 3/4" C. R. STEEL
3/16" X 3/4" C. R. STEEL
1/4" C. R. STEEL

OBSOLETE

OBSOLETE

SIZE		ISSUE 9-10-37	J.E.
KIND		CHANGED	
SHAPE		"	
FINISH		"	
TEMP.		"	
PATT.		"	

TITLE: PORTABLE X-RAY UNIT TRANSFORMER STRAP & LOCATING BRACKET ASSEM.

H. G. FISCHER & CO.
2335 WABANSIA AVE.
CHICAGO, ILL.

CAT. NO.

PART NO. 10883G

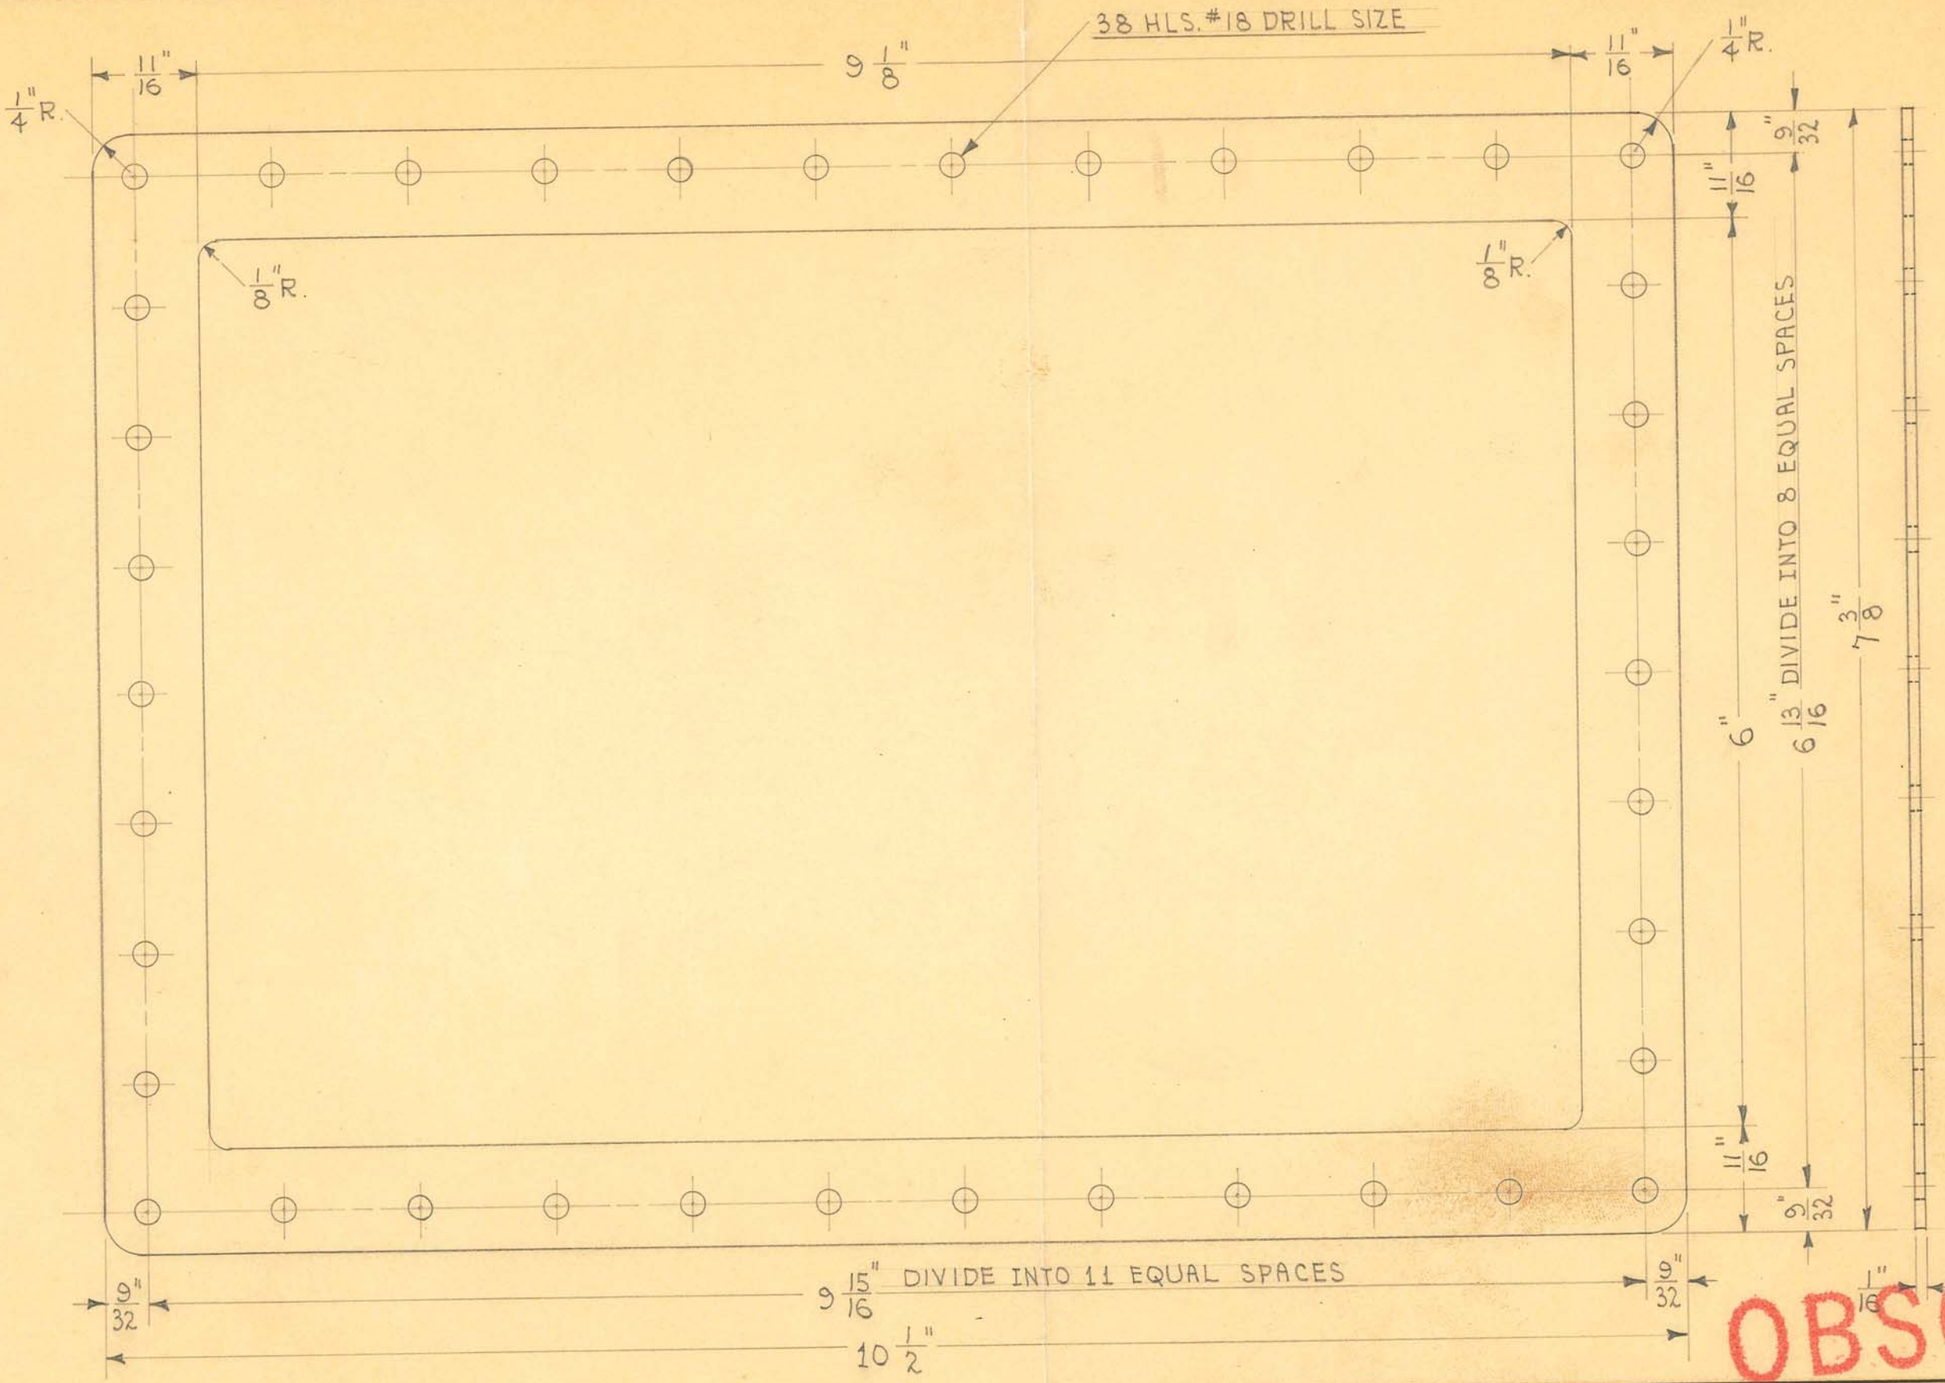

1 REQUIRED

OBSOLETE

SIZE	1/16" SHEET	ISSUE 10-15-37	A.E.
KIND	VELLUMOID	CHANGED	
SHAPE		"	
FINISH		"	
TEMP.		"	
PATT.		"	

TITLE: "H" PORTABLE X-RAY UNIT TANK PANEL GASKET

H. G. FISCHER & CO. 2335 WABANSIA AVE. CHICAGO, ILL.	CAT. NO.	PART NO. 10898

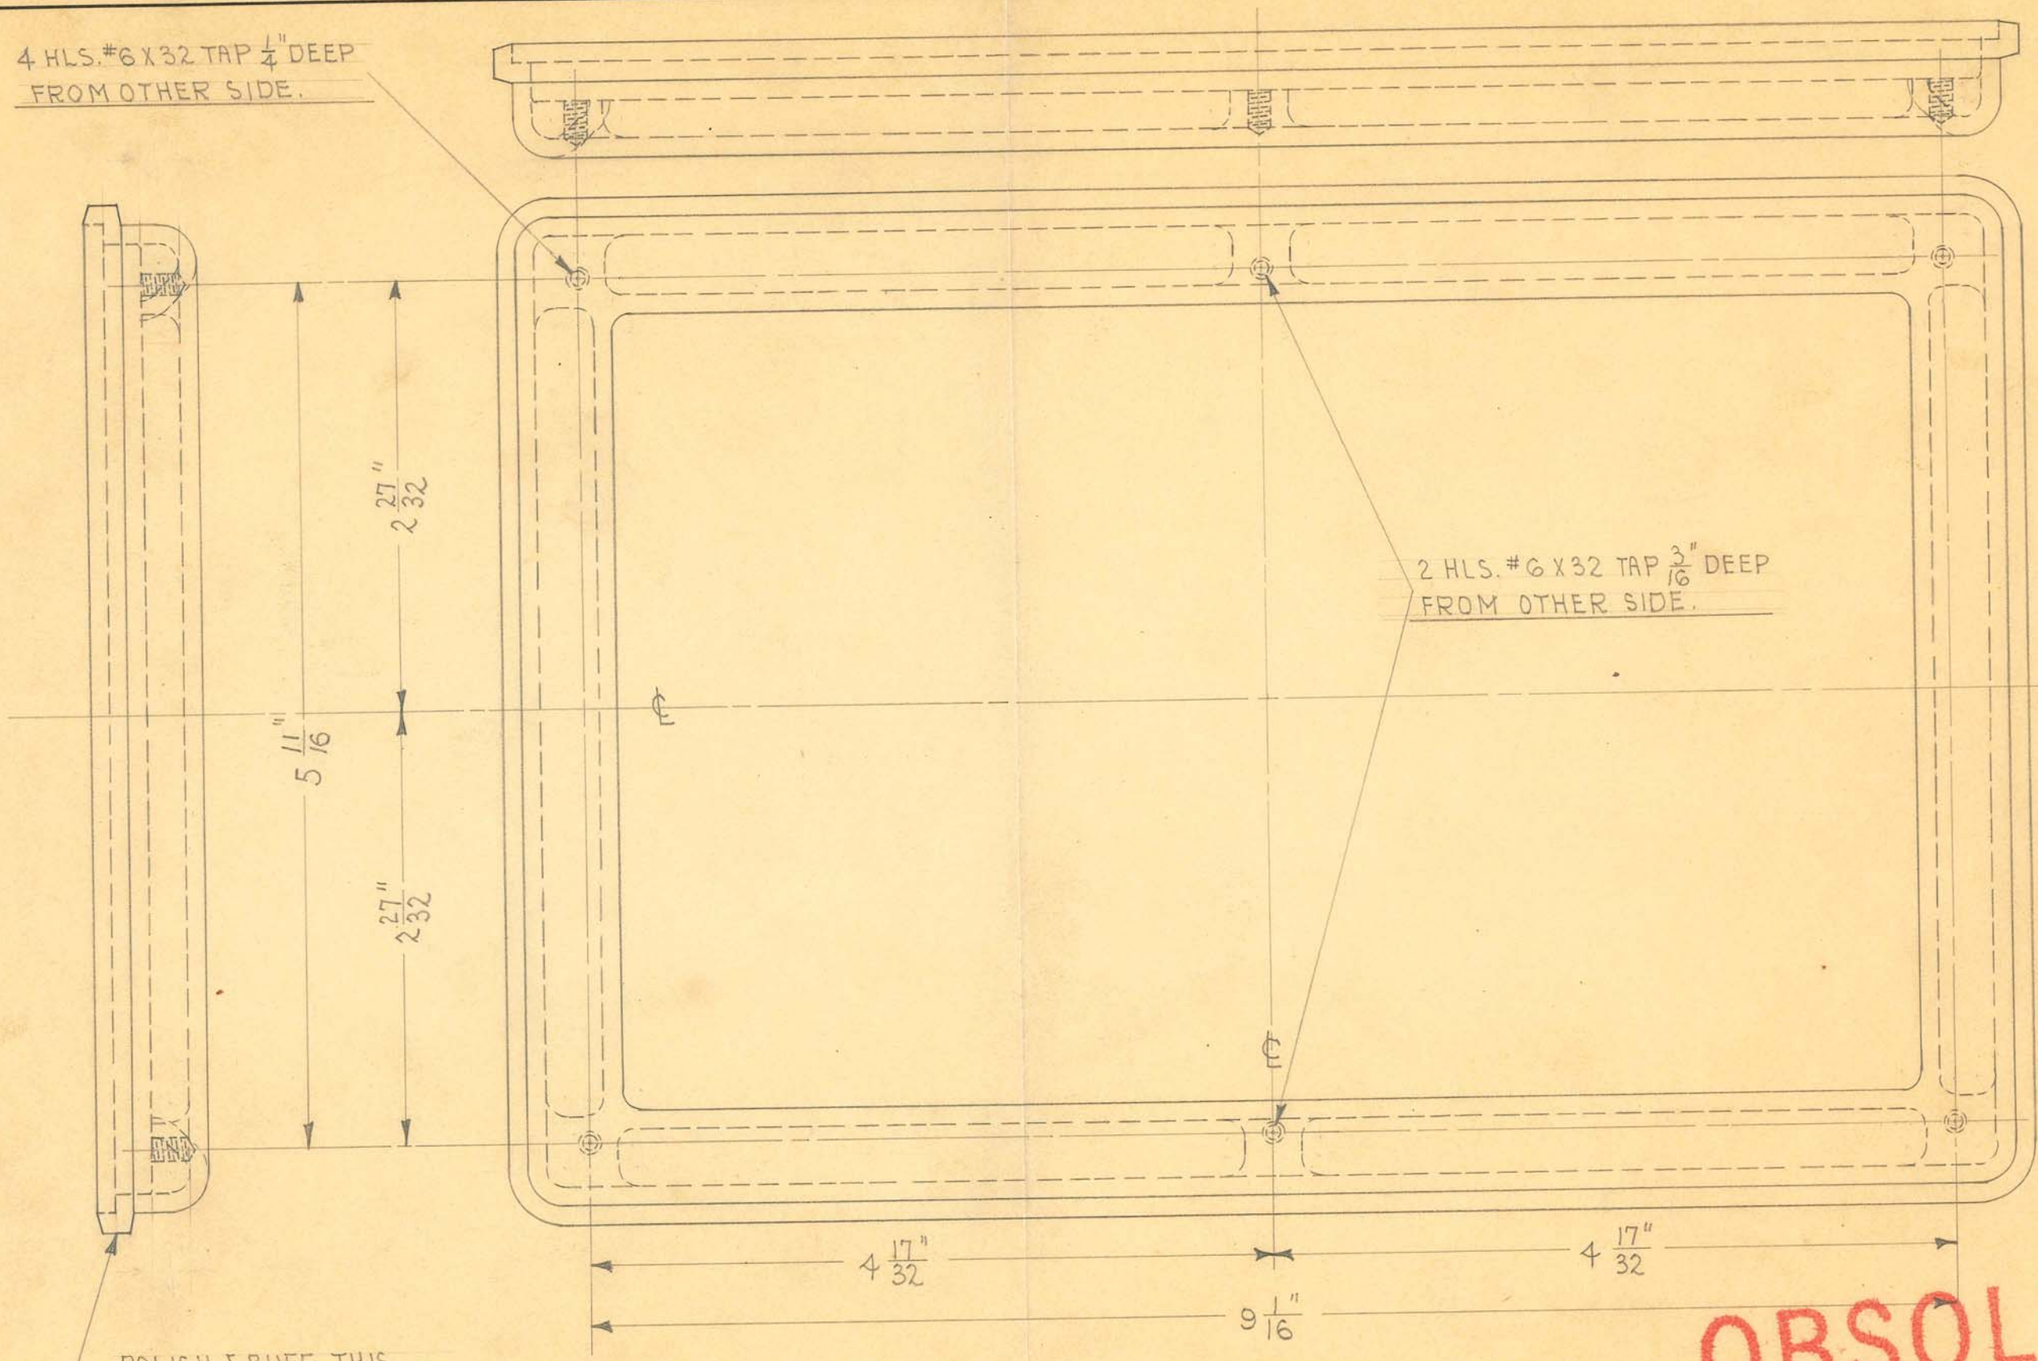

1 REQUIRED

OBSOLETE

SIZE		ISSUE 10-25-37	A.E.
KIND	ALUM. CASTING	CHANGED	
SHAPE		"	
FINISH	KRIST. #55	"	
TEMP.		"	
PATT.	6189-1159	"	

TITLE: MODEL "100-100" TIMER CASE COVER-FRONT

H. G. FISCHER & CO.
2338 WABANSIA AVE.
CHICAGO, ILL.

CAT. NO.

PART NO. 10995F

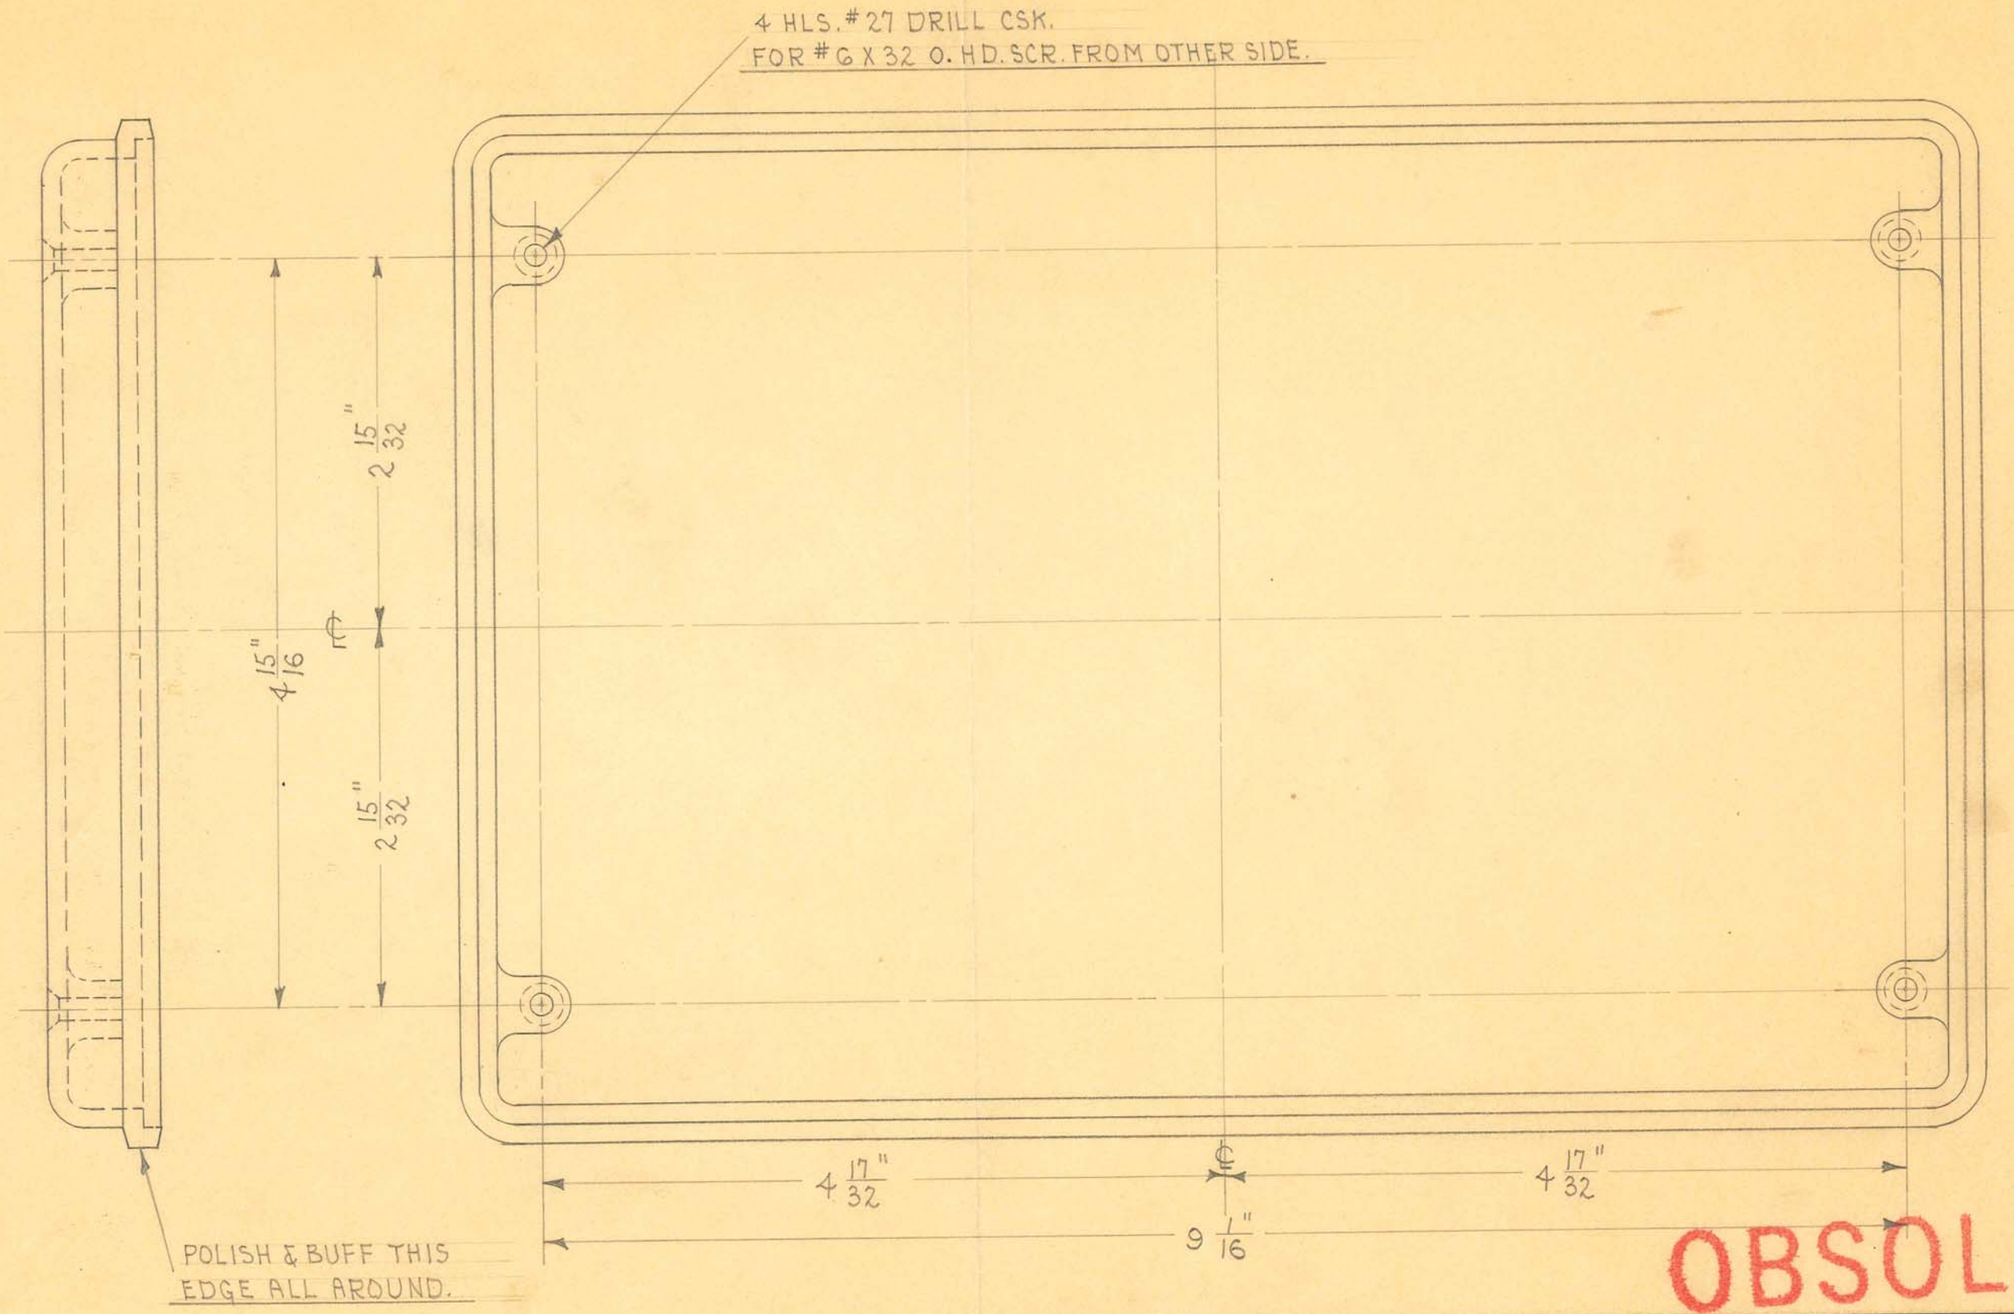

1 REQUIRED

OBSOLETE

SIZE		ISSUE 10-25-37	A.E.
KIND	ALUM. CASTING	CHANGED	
SHAPE		"	
FINISH	KRIST. #55	"	
TEMP.		"	
	CLOD-116D	"	

TITLE: MODEL "100-100" TIMER CASE COVER - REAR

H. G. FISCHER & CO.
2335 WABANSIA AVE.
CHICAGO, ILL.

CAT. NO.

PART NO. 10996F

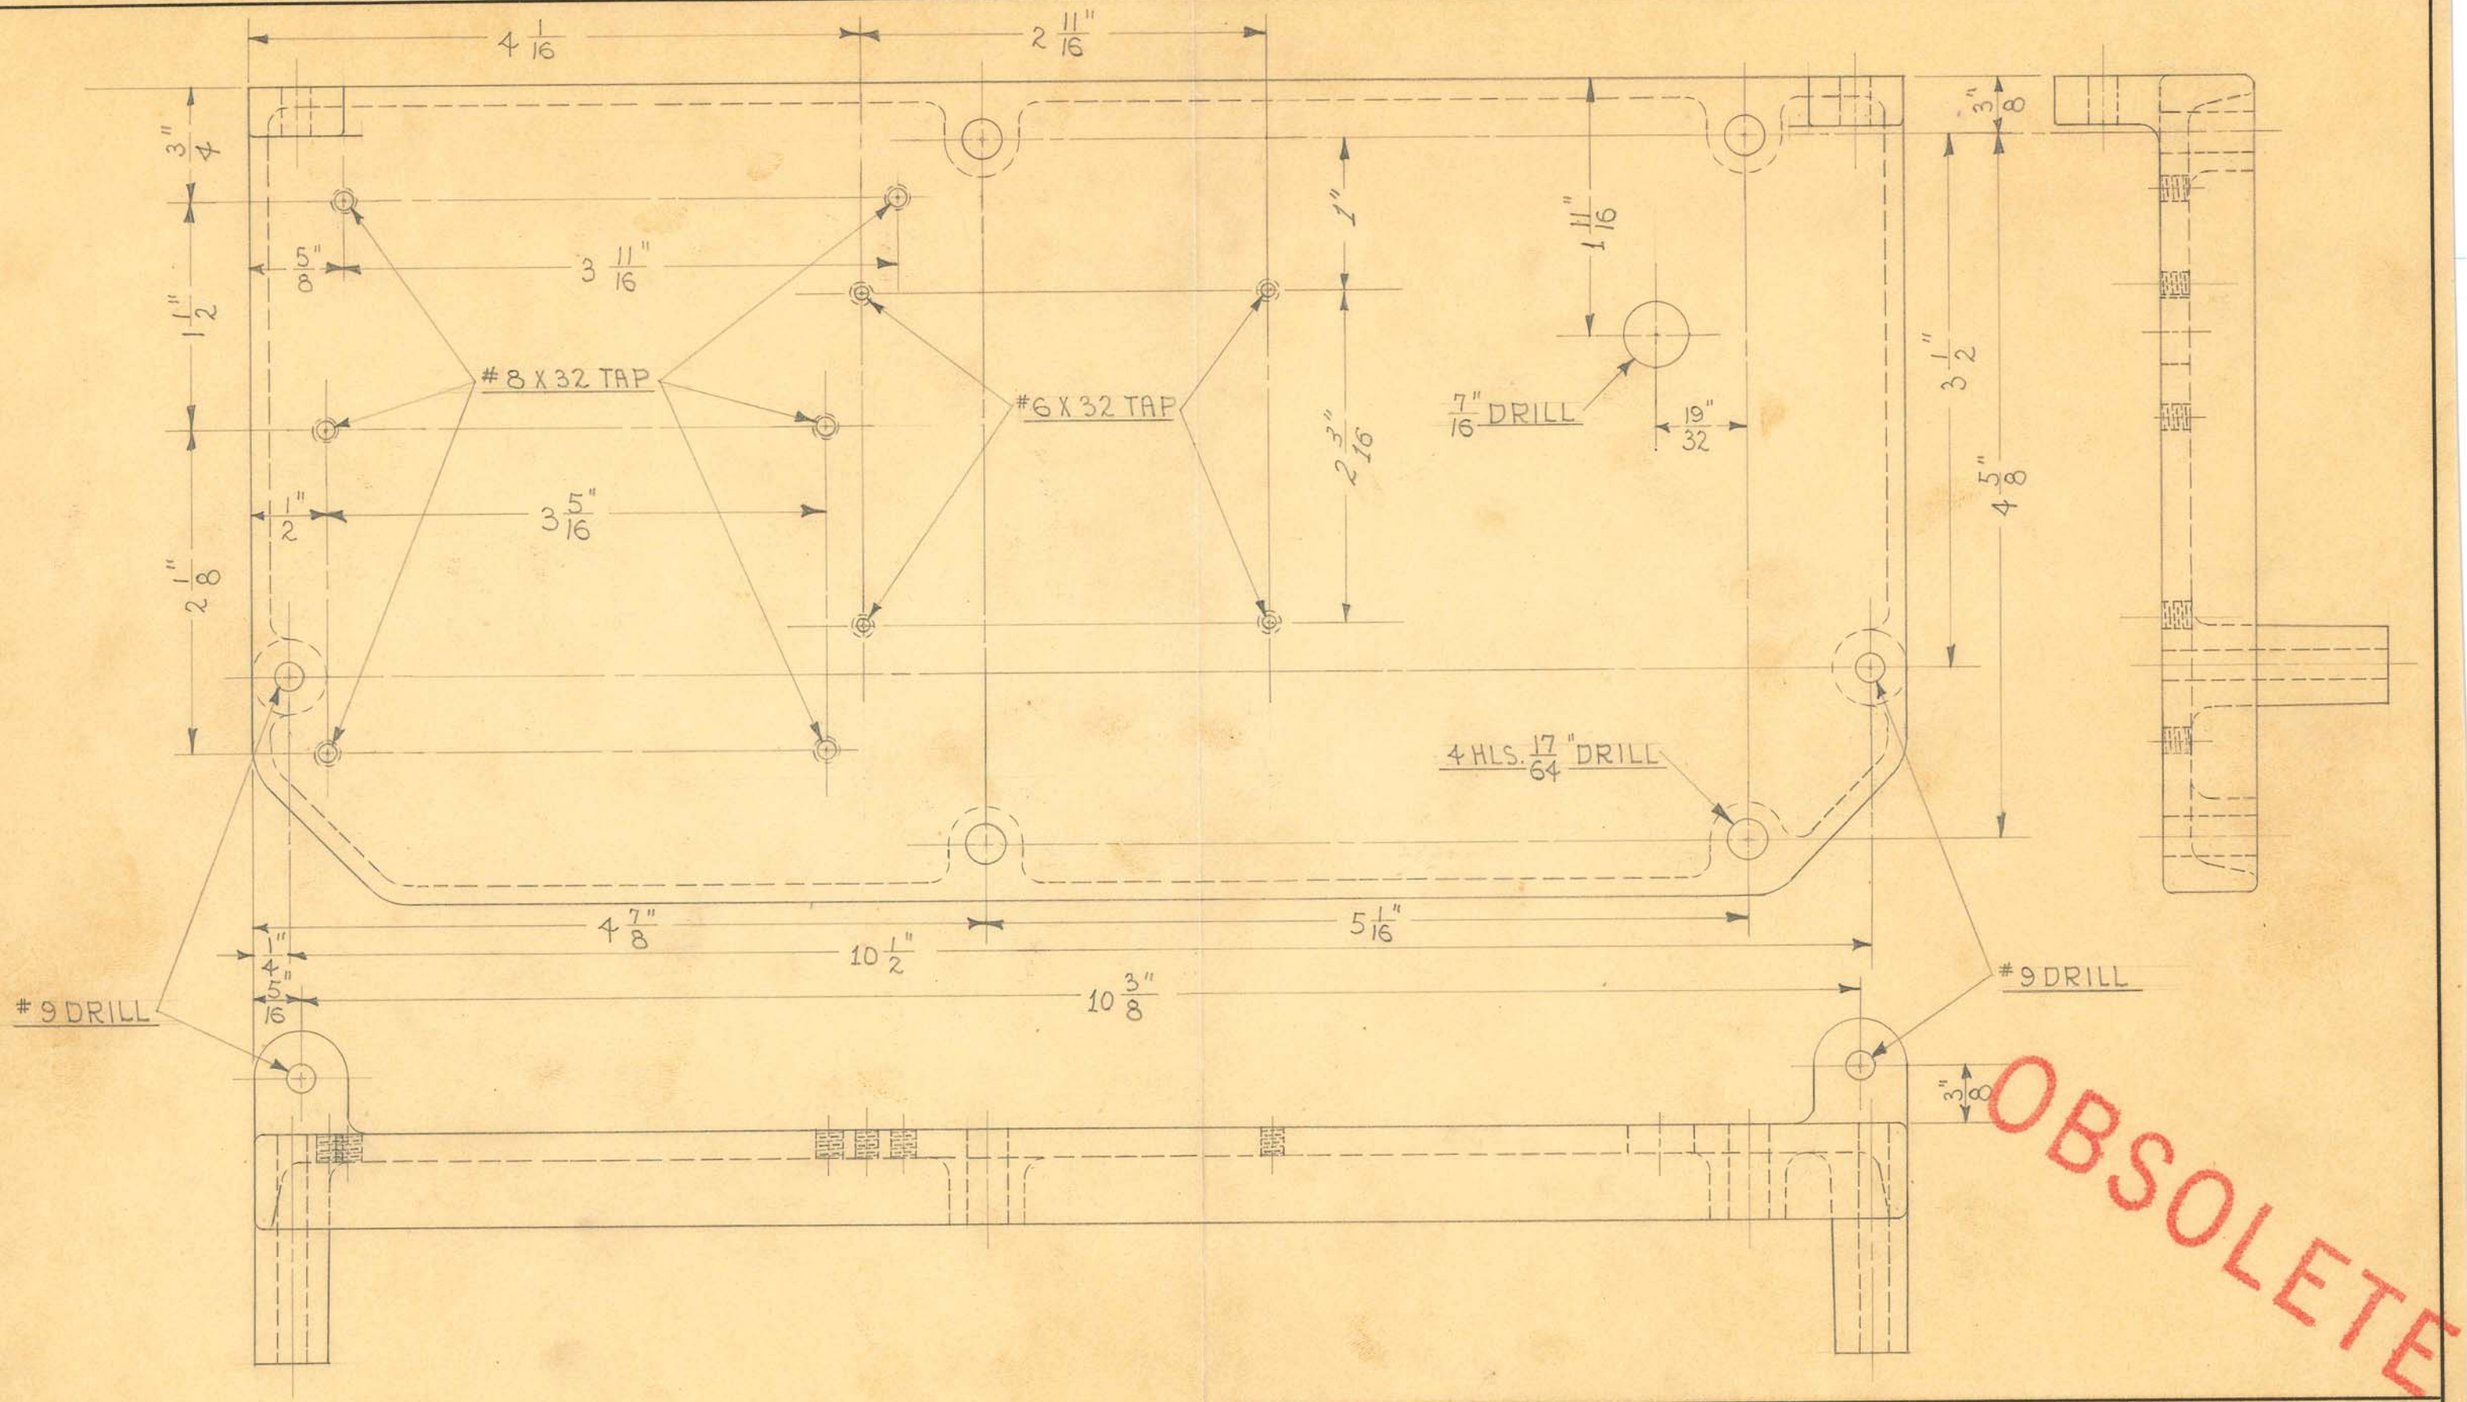

1 REQUIRED

OBSOLETE

SIZE		ISSUE 10-27-37	H.E.
KIND	ALUM. CASTING	CHANGED	
SHAPE		" 11-19-37	J.W.
FINISH		"	
TEMP.		"	
PATT.	G350-1161	"	

TITLE: MODEL "100-100" TIMER
ELECTRICAL UNIT MOUNTING BASE

H. G. FISCHER & CO.
2335 WABANSIA AVE.
CHICAGO, ILL.

CAT. NO.

PART NO. 10997FA

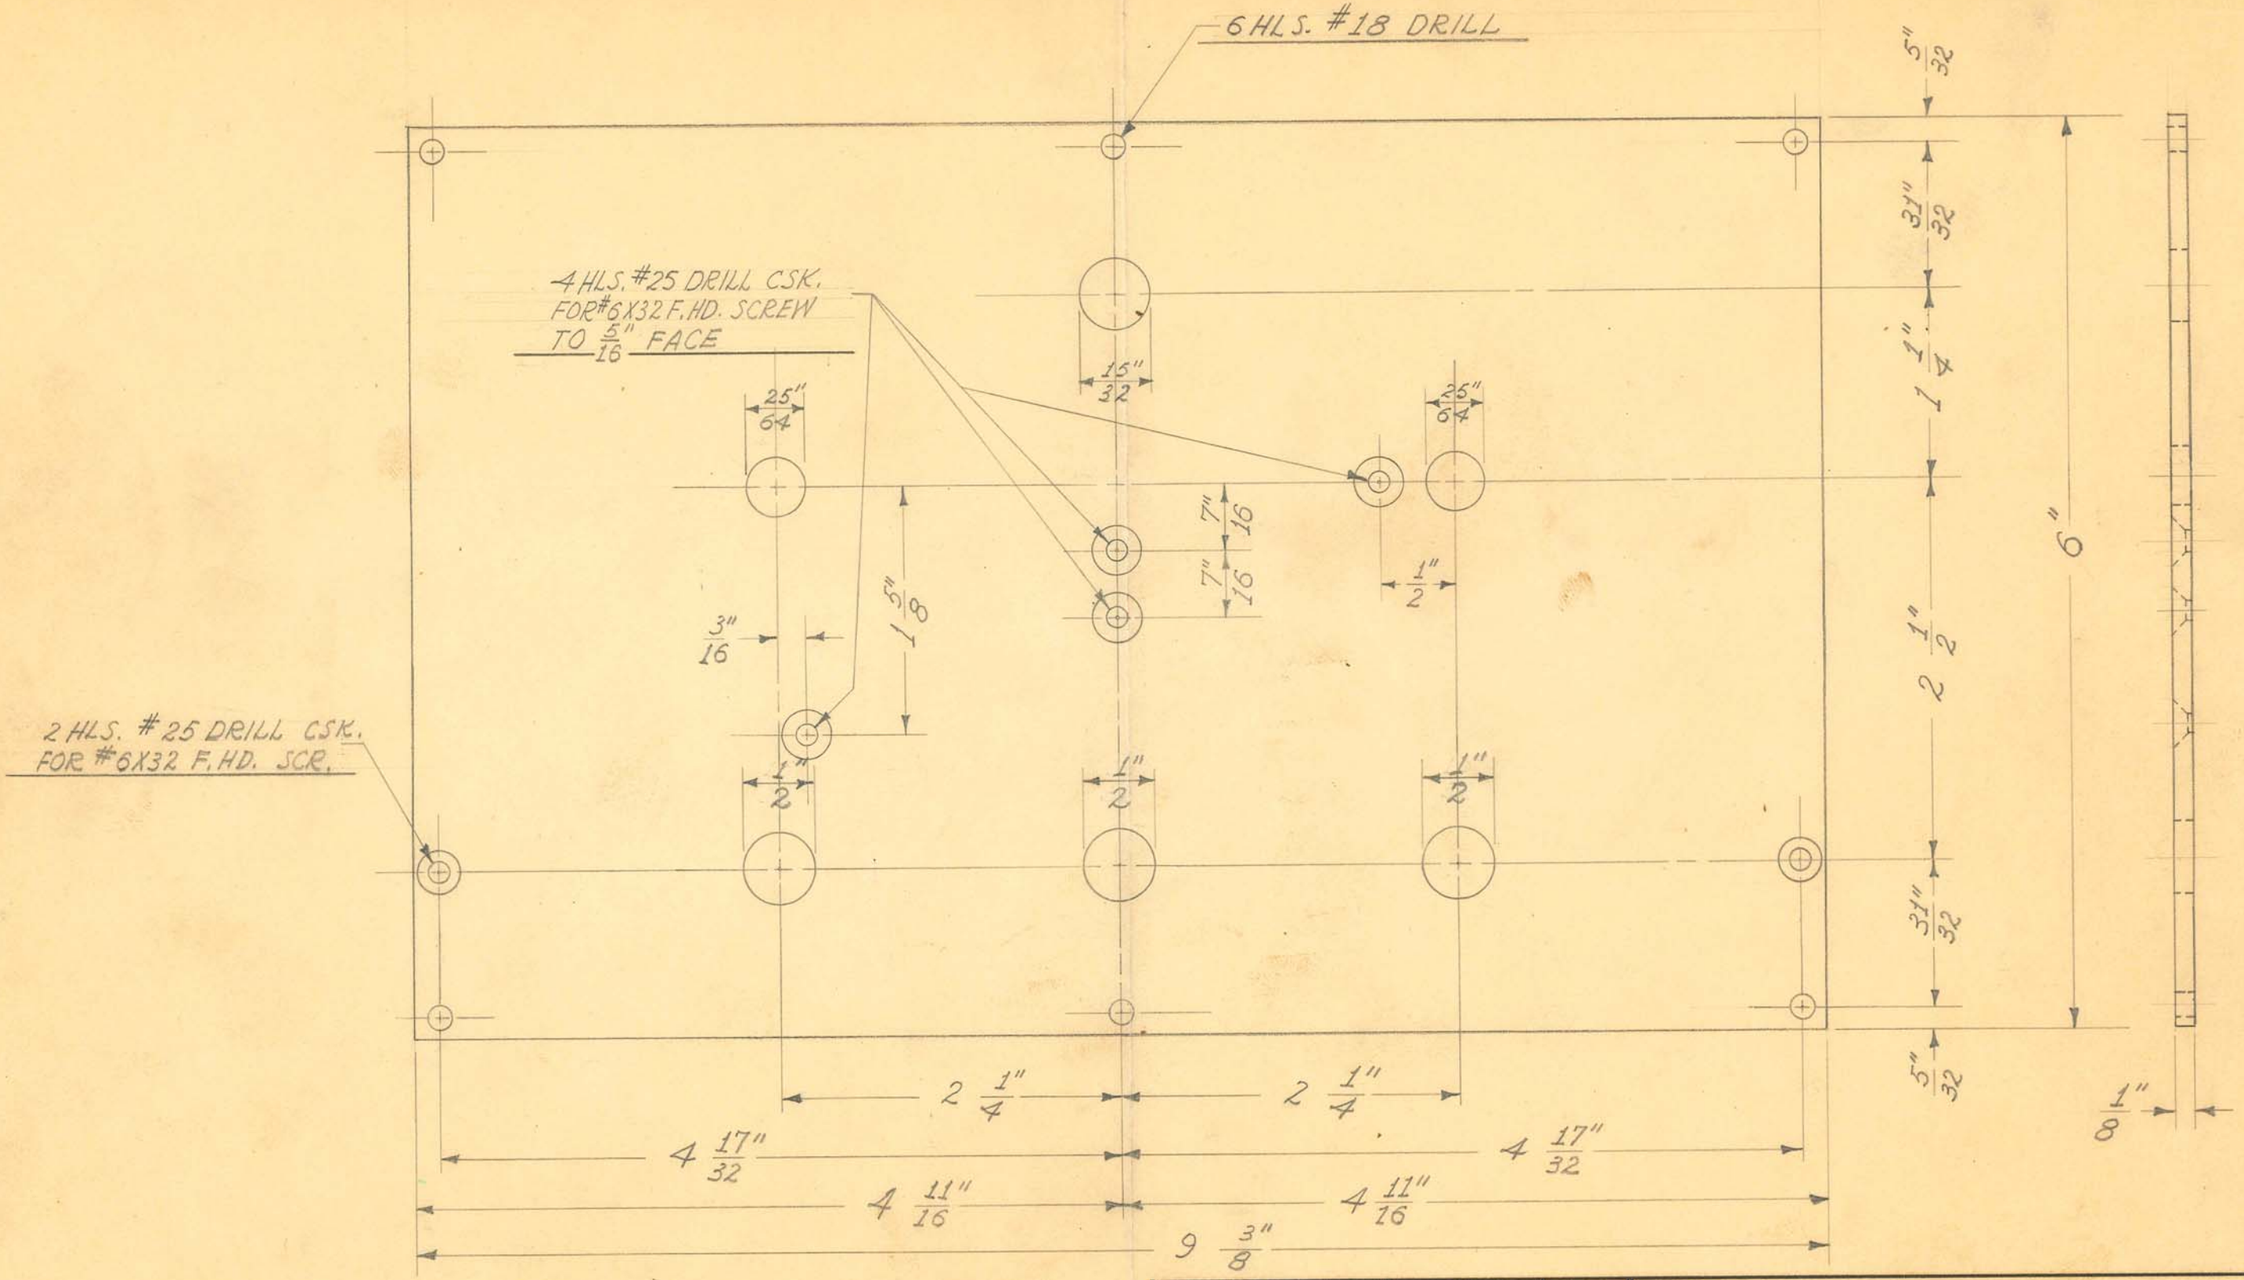

1 REQUIRED

SIZE	1/8" SHEET	ISSUE 11-2-37	J.W.
KIND	BAKELITE	CHANGED 12-22-37	J.W.
SHAPE		" 5-19-38	J.W.
FINISH		"	
TEMP.		"	
DATE		"	

TITLE:
FISCHER "100-100" REMOTE CONTROL TIMER – CONTROL CASE PANEL

H. G. FISCHER & CO.
2335 WABANSIA AVE.
CHICAGO, ILL.

CAT. NO.

PART NO. 10998B.

OBSOLETE

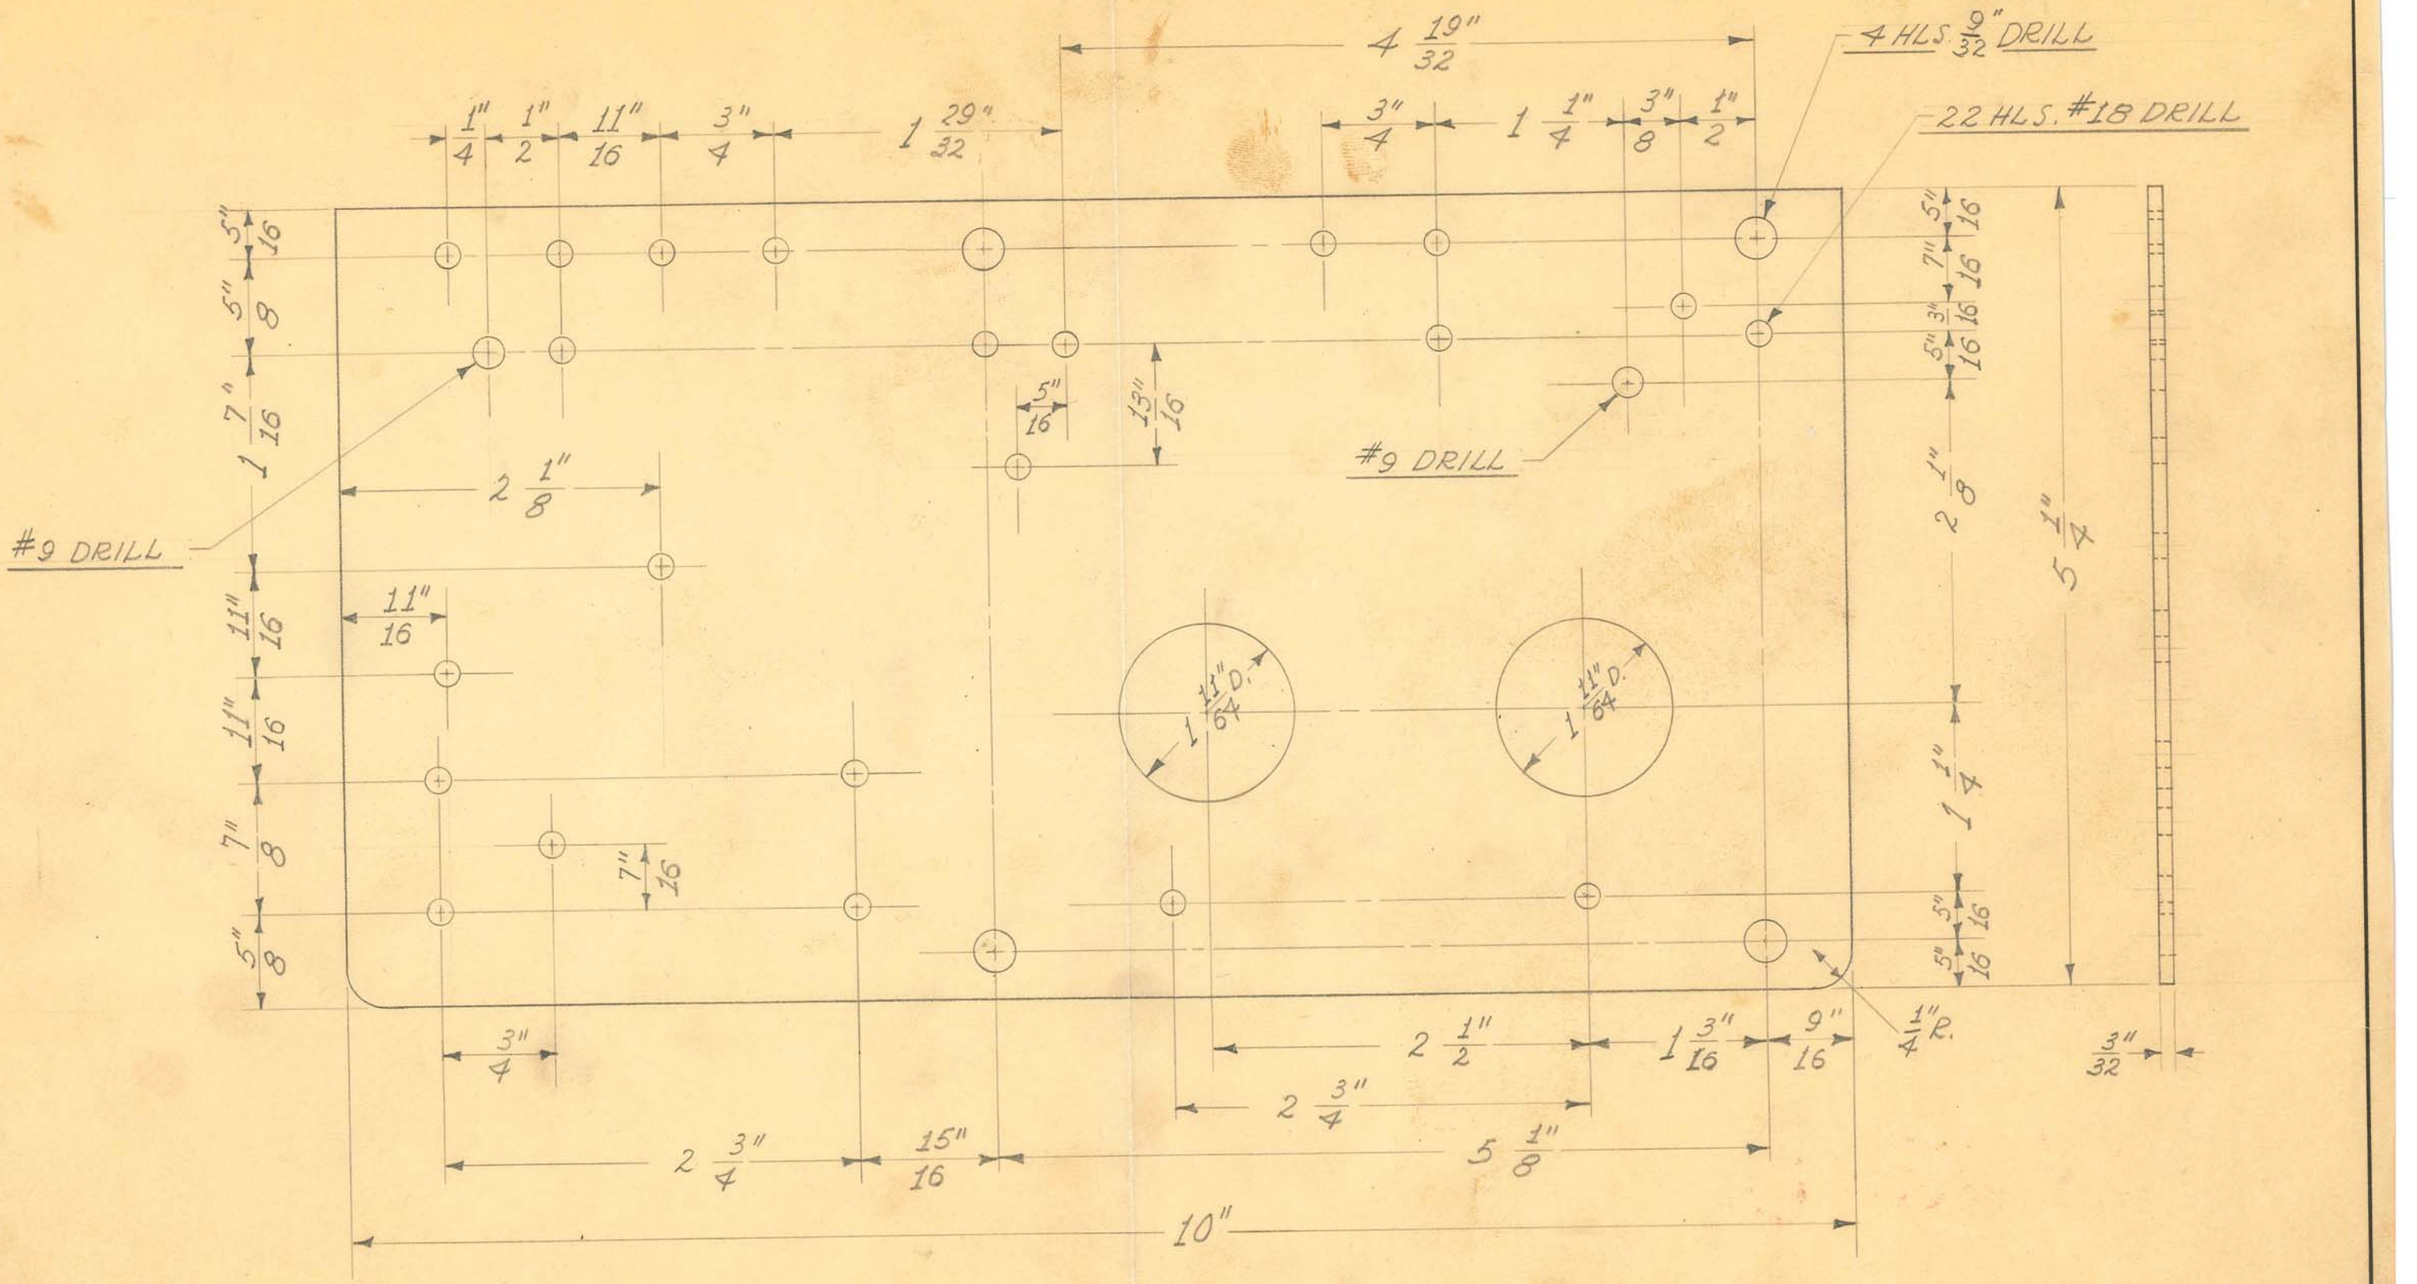

1 REQUIRED

SIZE	3/32" SHEET	ISSUE 11-1-37	J.W.
KIND	CANVAS BASE	CHANGED	
SHAPE	BAKELITE	"	
FINISH		"	
TEMP.		"	
PATT.		"	

TITLE: (TIMER) FISCHER MOD. "100-100" REMOTE CONTROL TUBE SOCKET & RESISTOR MTG. BOARD

OBSOLETE

H. G. FISCHER & CO.
2338 WABANSIA AVE.
CHICAGO, ILL.

CAT. NO.

PART NO. 10999

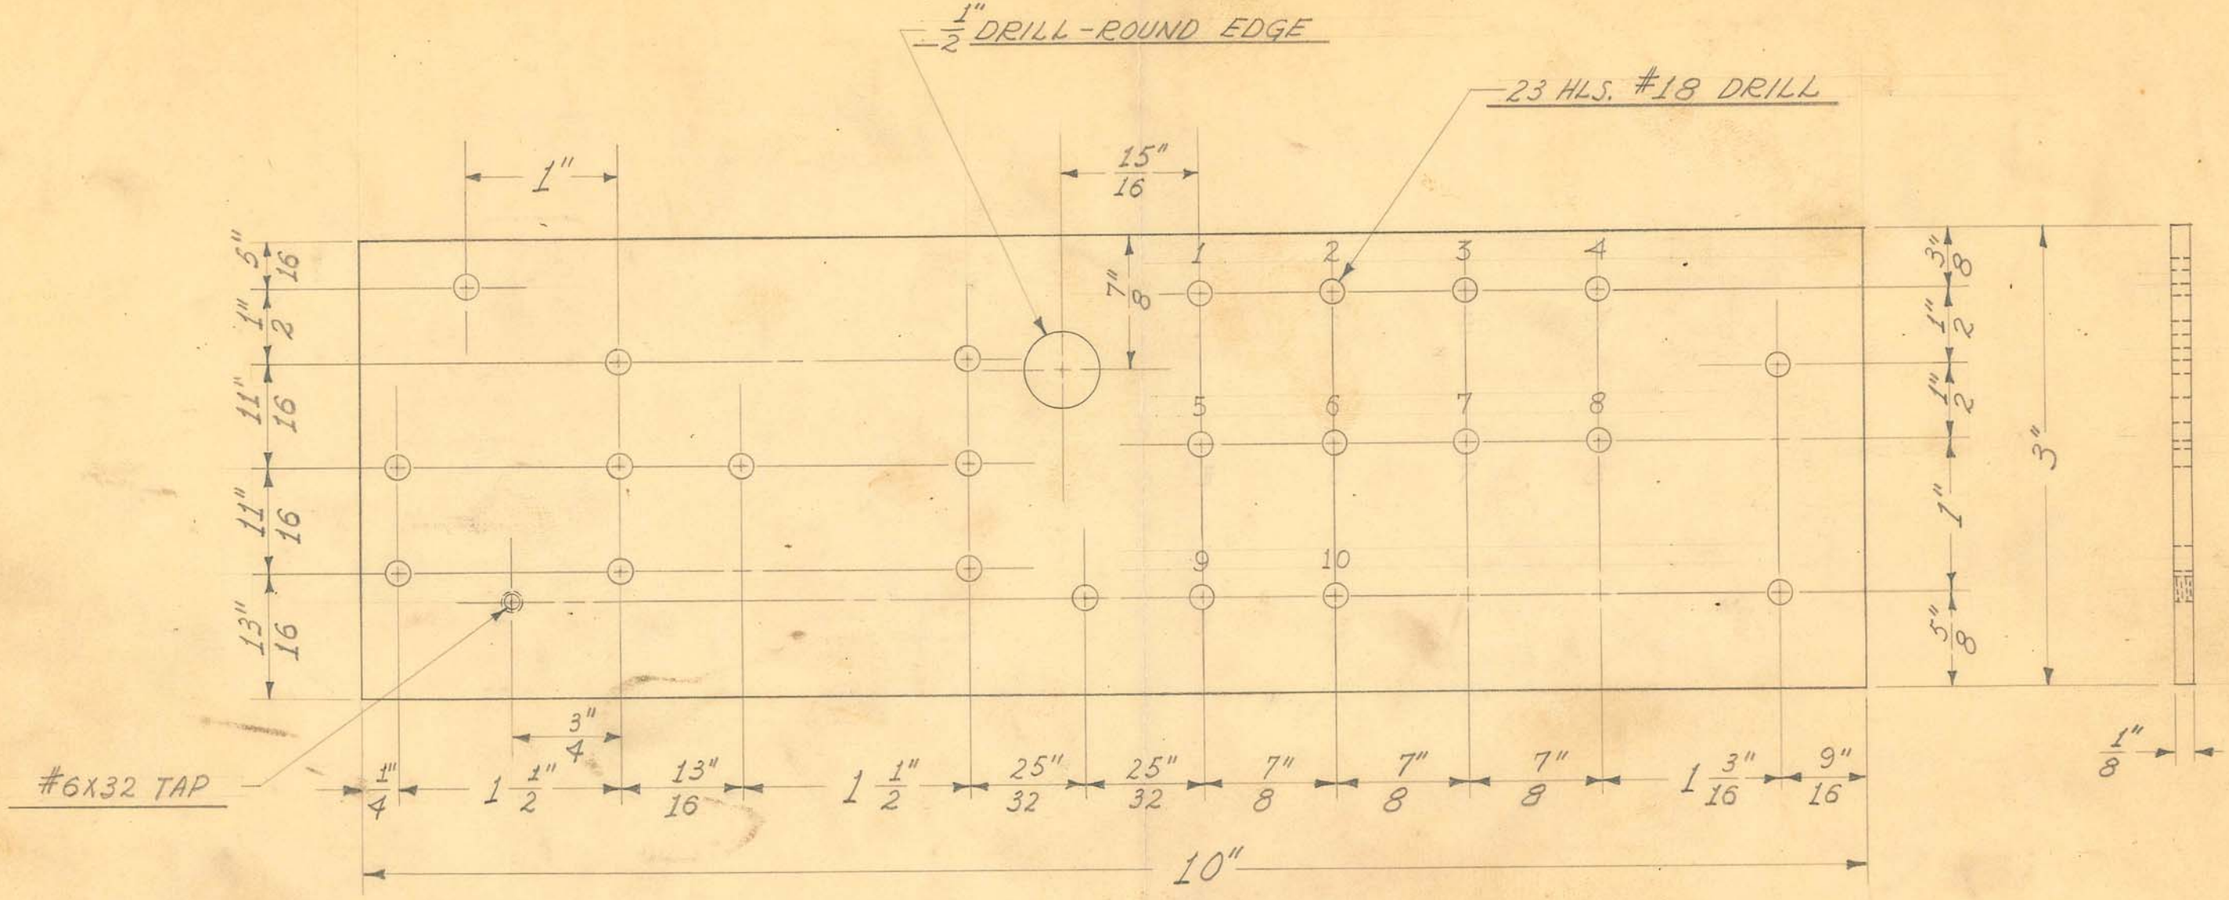

1 REQUIRED

OBSOLETE

SIZE	1/8" SHEET	ISSUE 11-1-37	J.W.	TITLE: FISCHER MOD. "100-100" REMOTE CONTROL - TERMINAL & RELAY MTG. BOARD
KIND	BAKELITE	CHANGED		
SHAPE		"		
FINISH		"		
TEMP.		"		
PATT.		"		

H. G. FISCHER & CO.
2335 WABANSIA AVE.
CHICAGO, ILL.

CAT. NO.

PART NO. 11001F

OBSOLETE

PART NO. 17152G

REVISION	DATE	BY

H. G. FISCHER & CO.
FRANKLIN PARK, ILLINOIS

DATE 10-12-48 DR. BY J.V.W. CH'K'D.

DIMENSIONS UNLESS OTHERWISE SPECIFIED
FRACTIONAL ± .015
DECIMAL ± .005
ANGULAR ± ½°

SCALE FULL

MATERIAL

FINISH

PATTERN

TOOLS

TITLE
FISCHER DELUXE "RF-250" X-RAY
THERMO COMPENSATOR ASSEM.

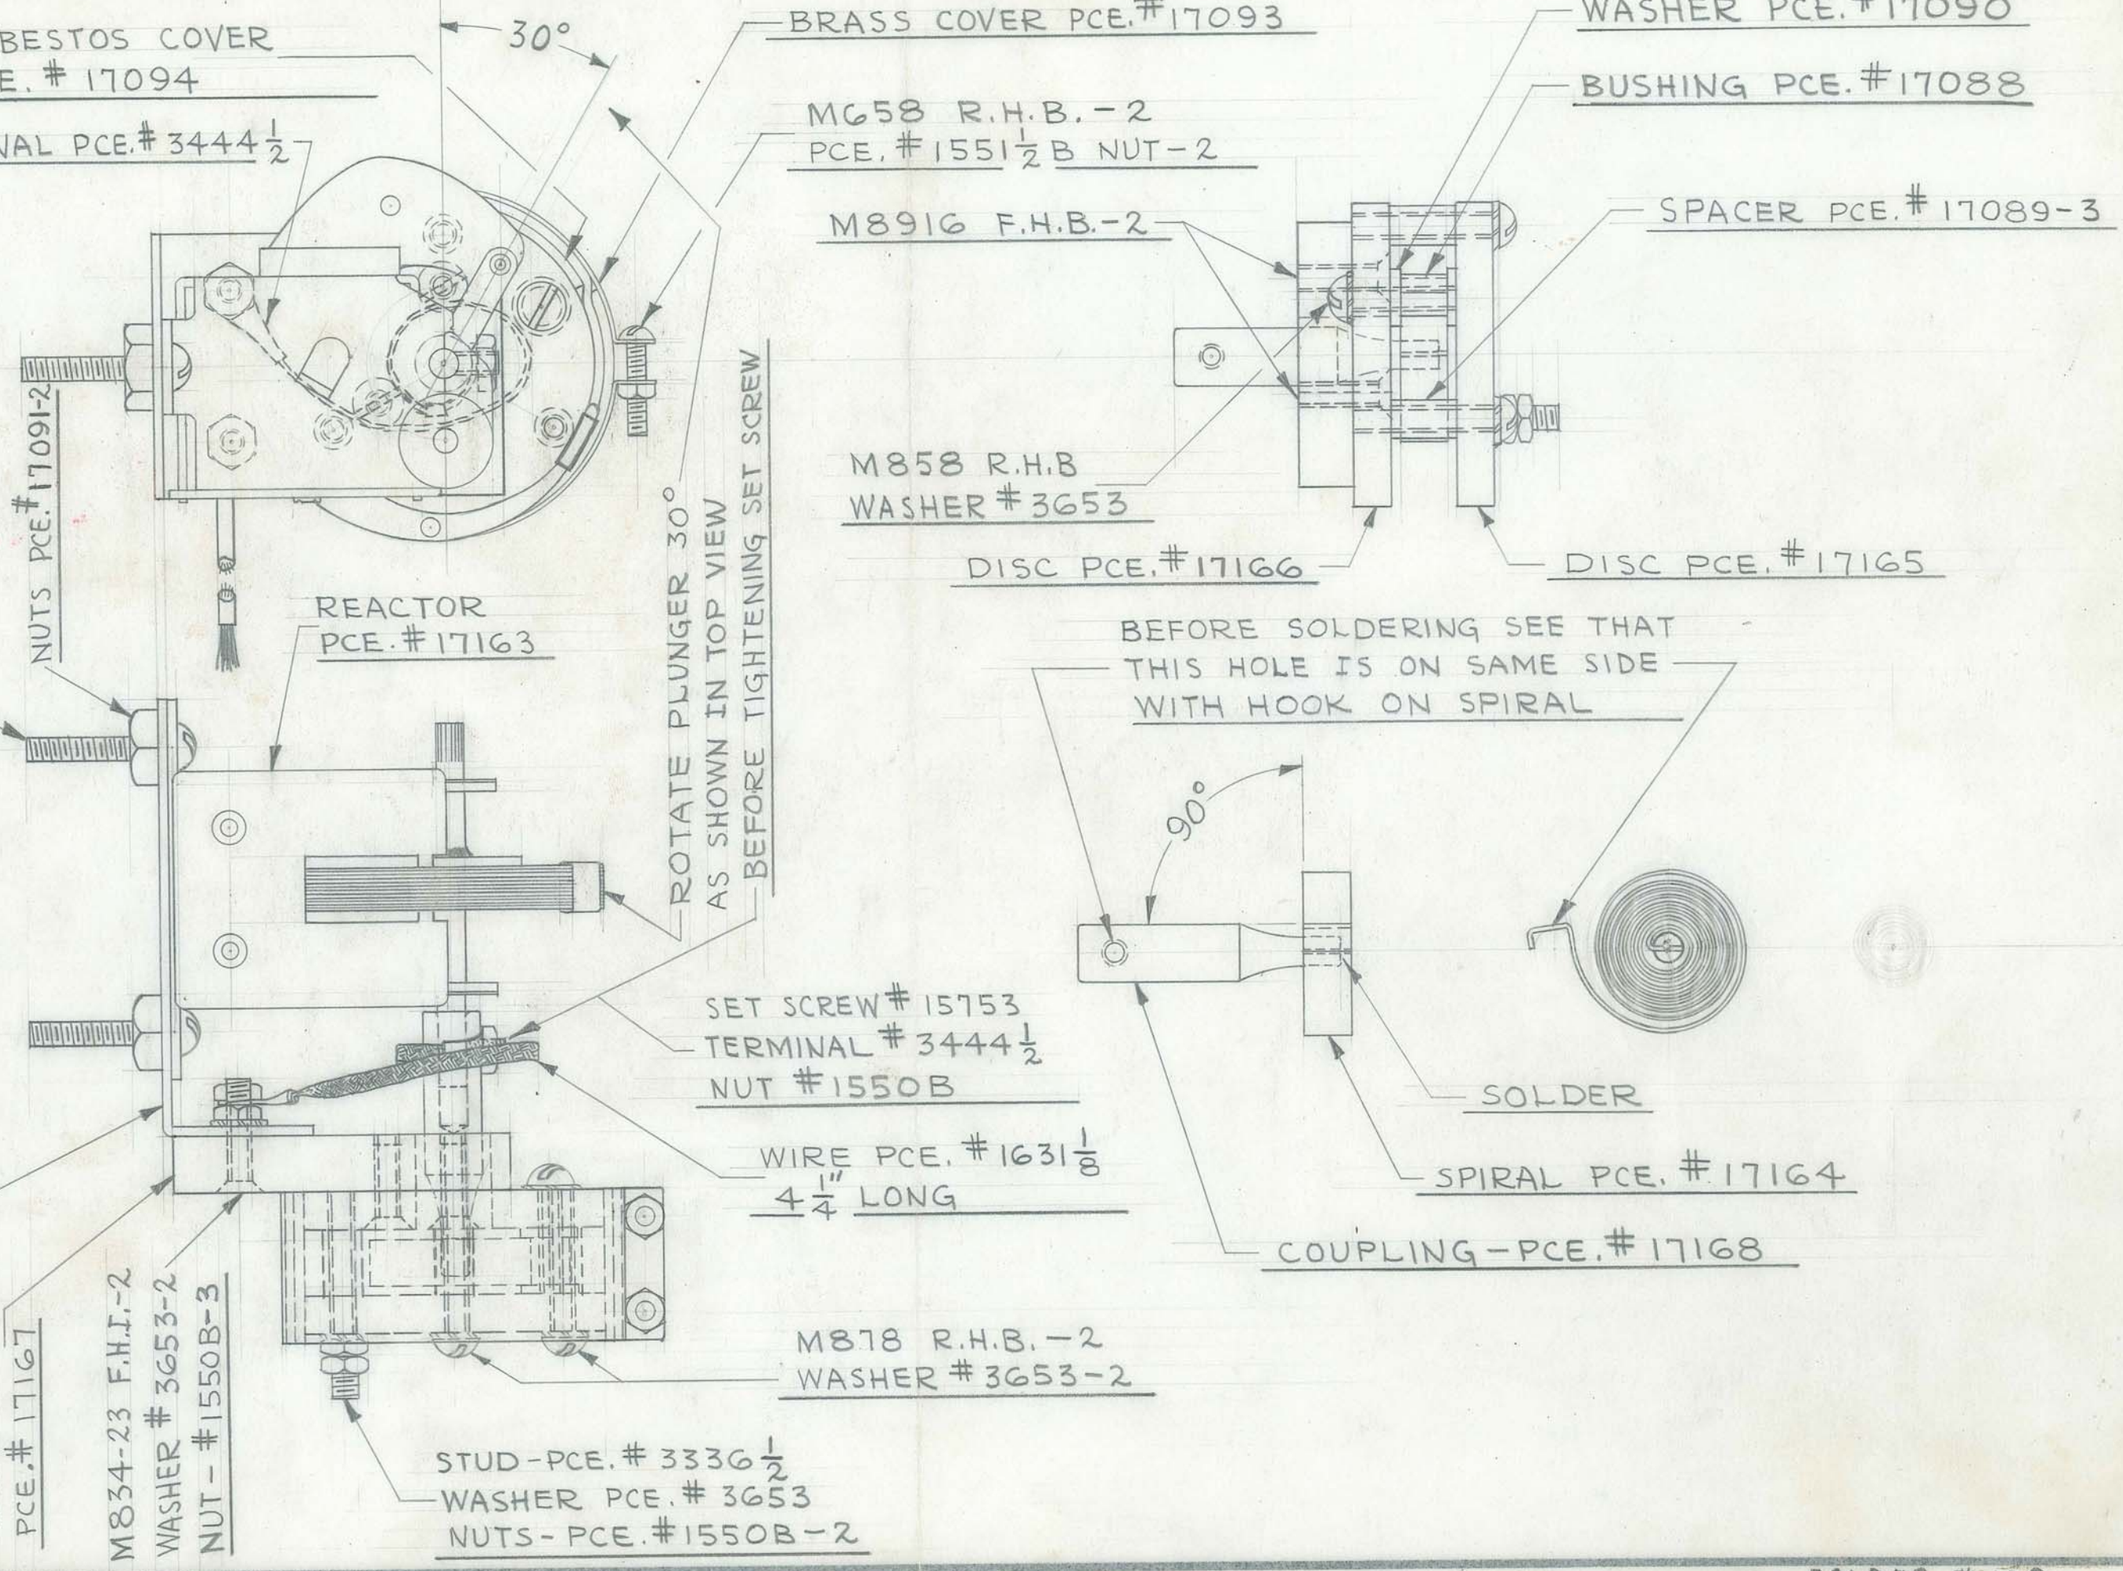

FOLDER # 138

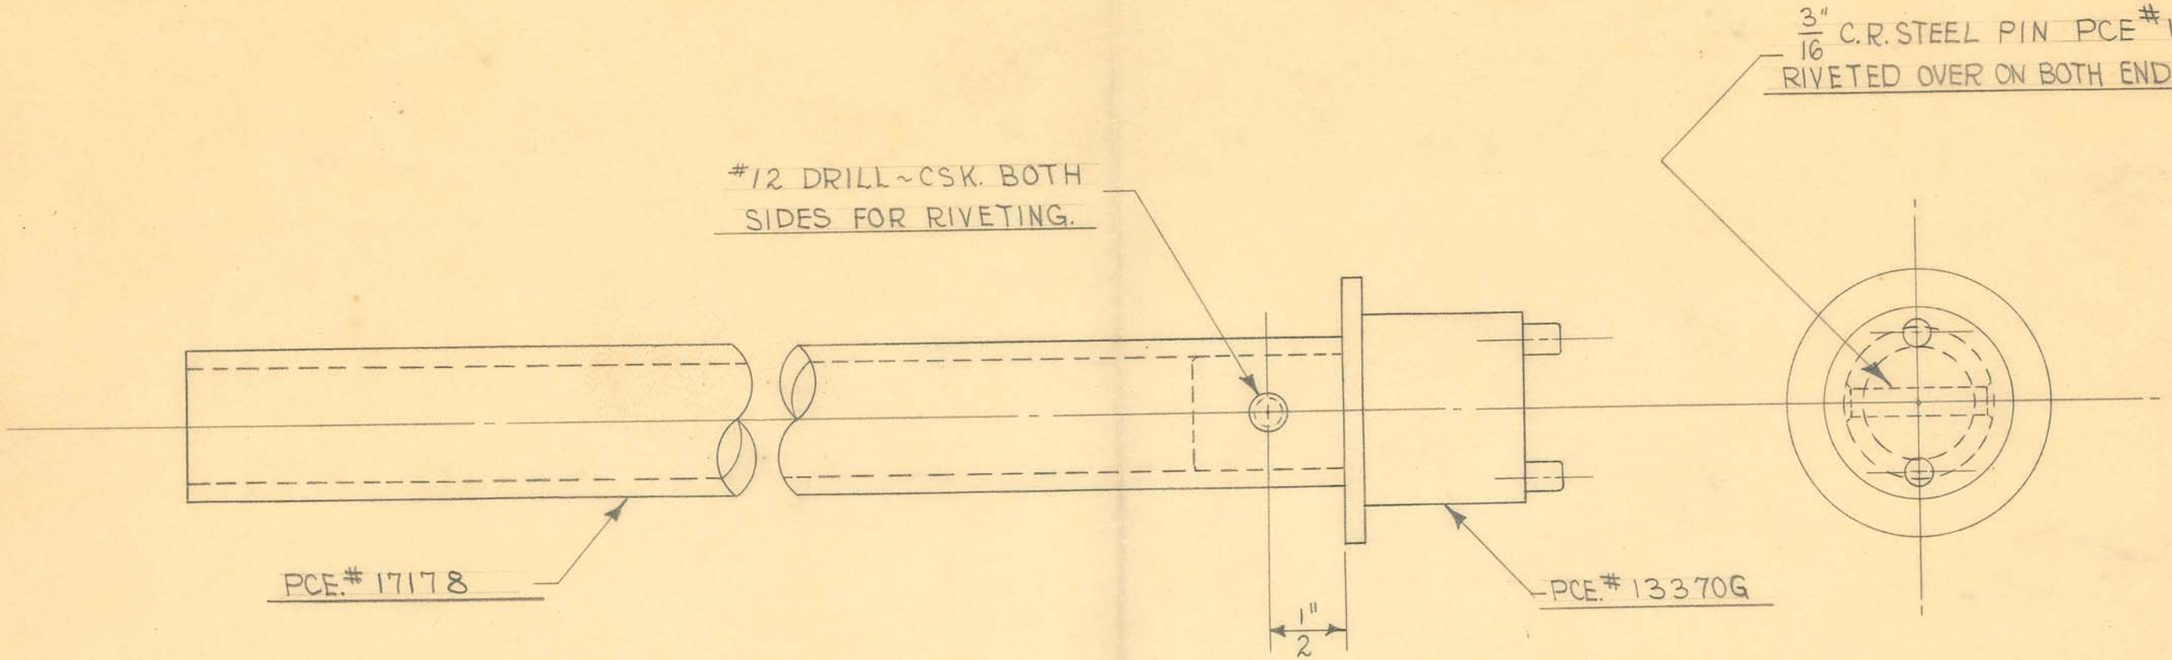

1 REQUIRED

OBSOLETE

Obsolete

SIZE		ISSUE 2-2-48	W.J.
KIND		CHANGED	
SHAPE		"	
FINISH	CAD. #23	"	
TEMP.		"	
PATT.		"	

DIMENSIONS
FRACTIONAL ± .015
DECIMAL ± .005
ANGULAR ± 1/2°
UNLESS OTHERWISE SPECIFIED

TITLE: FISCHER "DELUXE RF-100" X-RAY UNIT
INNER TUBE HEAD SUPP. HORIZ. TUBE ASSEM.

H. G. FISCHER & CO.
2335 WABANSIA AVE.
CHICAGO. ILL.

CAT. NO.

PART NO. 17179G

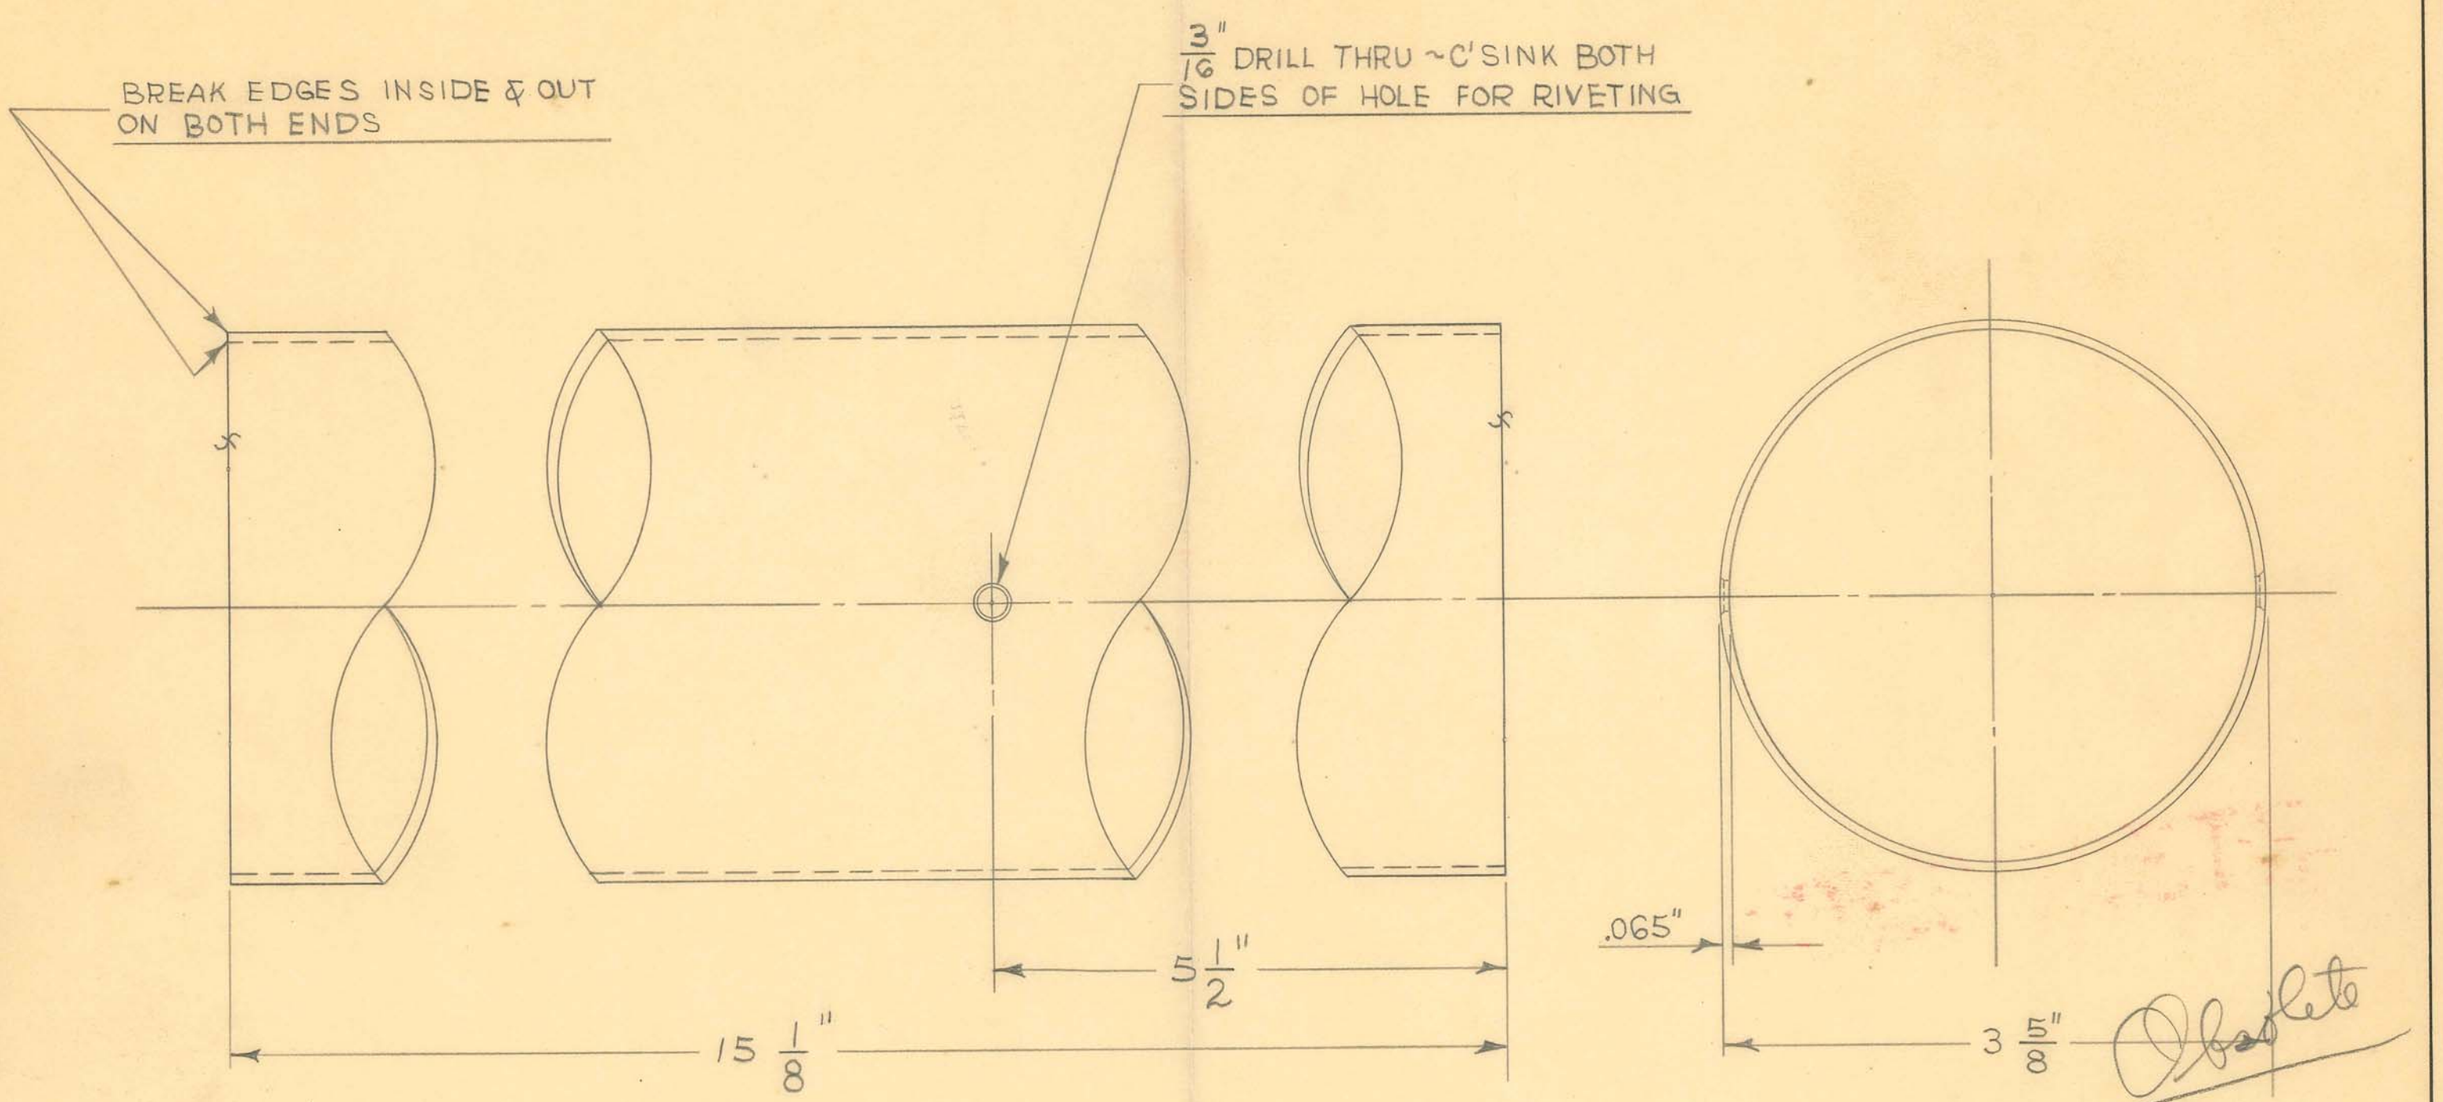

3 5/8" O.D. X #16 GA. (.065") WALL
SEAMLESS STEEL TUBING

1 REQUIRED

DRILL JIG TOOL #9541

Obsolete

DIMENSIONS	
FRACTIONAL	± .015
DECIMAL	± .005
ANGULAR	± 1/2°

		ISSUE 11-19-47	W. J.
SIZE			
KIND		CHANGED	
SHAPE		"	
FINISH		"	
TEMP.		"	
PATT.		"	

TITLE:
FISCHER "DELUXE RF-100" X-RAY UNIT
CWT. TUBE

OBSOLETE

H. G. FISCHER & CO.
2335 WABANSIA AVE.
CHICAGO, ILL.

CAT. NO.

PART NO. 17197F

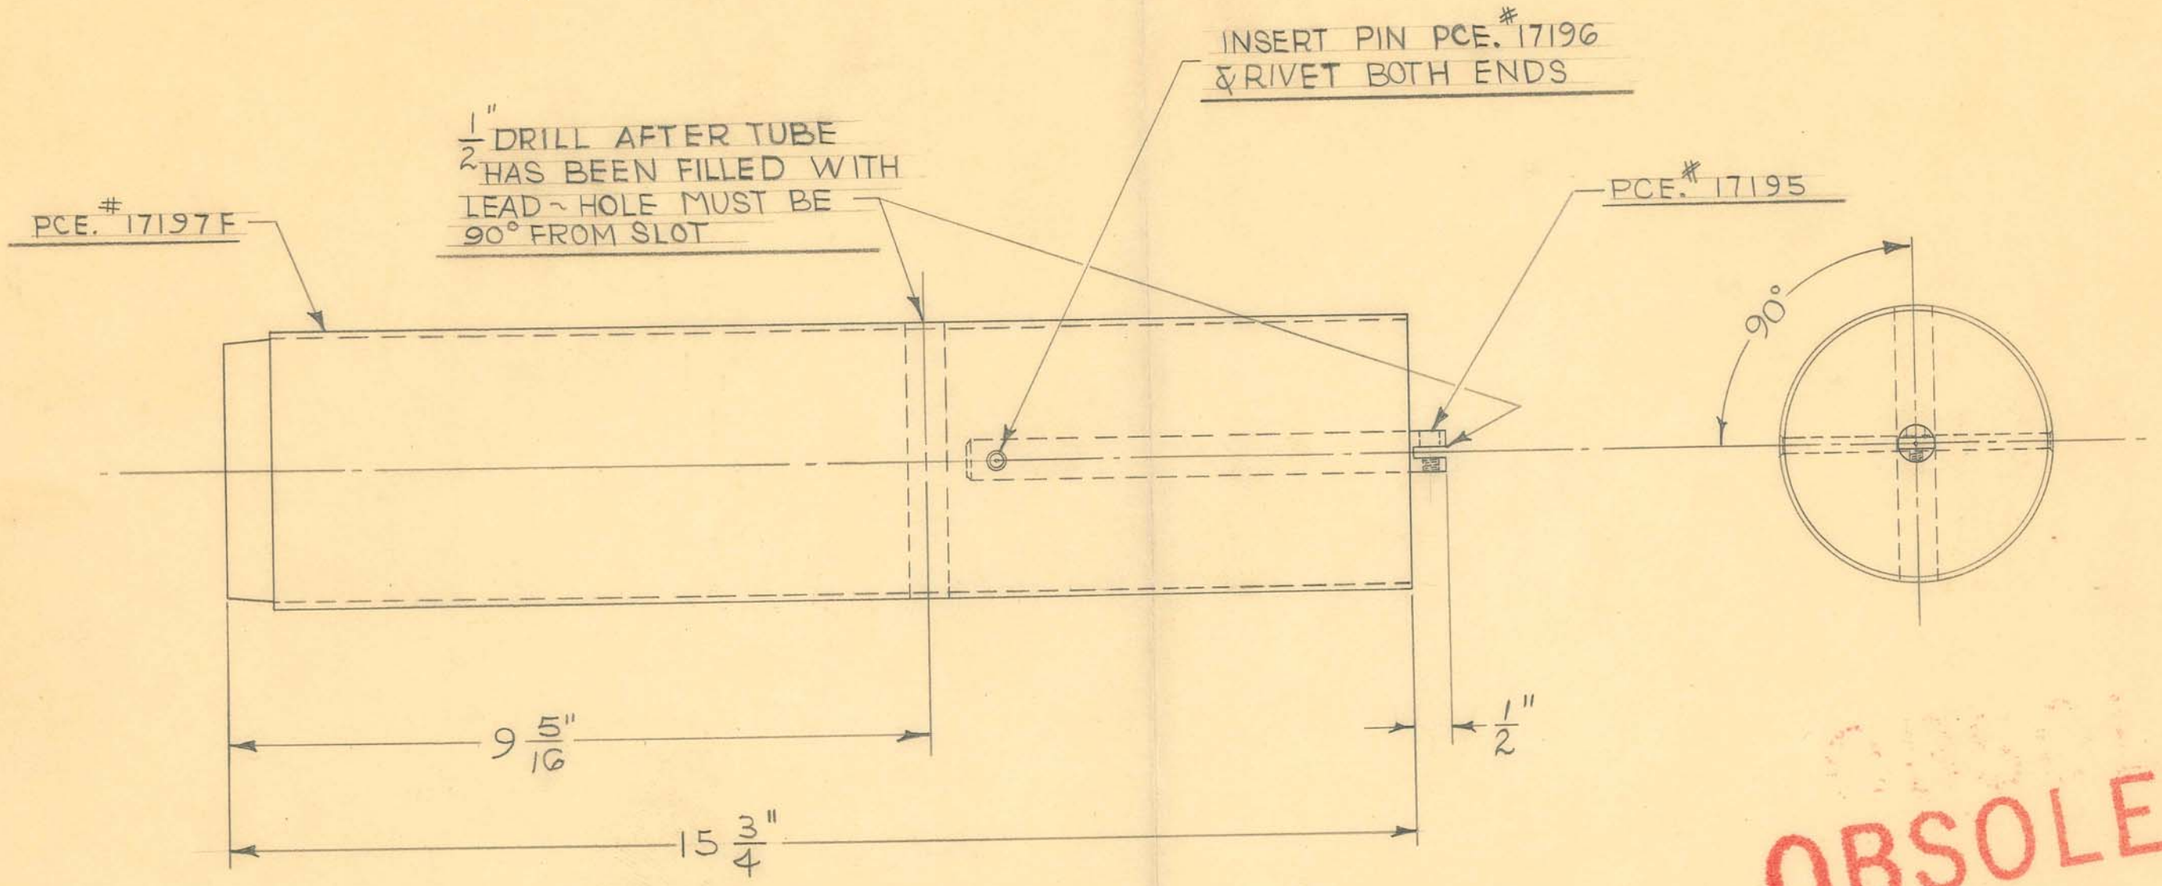

FILL TUBE WITH LEAD TO BRING TOTAL WEIGHT UP TO 63 1/2 LB. ± 1/2 LB.

OBSOLETE

Obsolete

1 REQUIRED

DRILL JIG TOOL #9541

SIZE		ISSUE 11-18 47	W.J.
KIND		CHANGED	
SHAPE		"	
FINISH		"	
TEMP.		"	
PATT.		"	

DIMENSIONS
FRACTIONAL ± .015
DECIMAL ± .005
ANGULAR ± 1/2°
UNLESS OTHERWISE SPECIFIED

TITLE:
FISCHER DELUXE RF-100 X-RAY UNIT
COUNTERWEIGHT TUBE ASSEMBLY

H. G. FISCHER & CO.
2335 WABANSIA AVE.
CHICAGO. ILL.

CAT. NO.

PART NO. 17198G

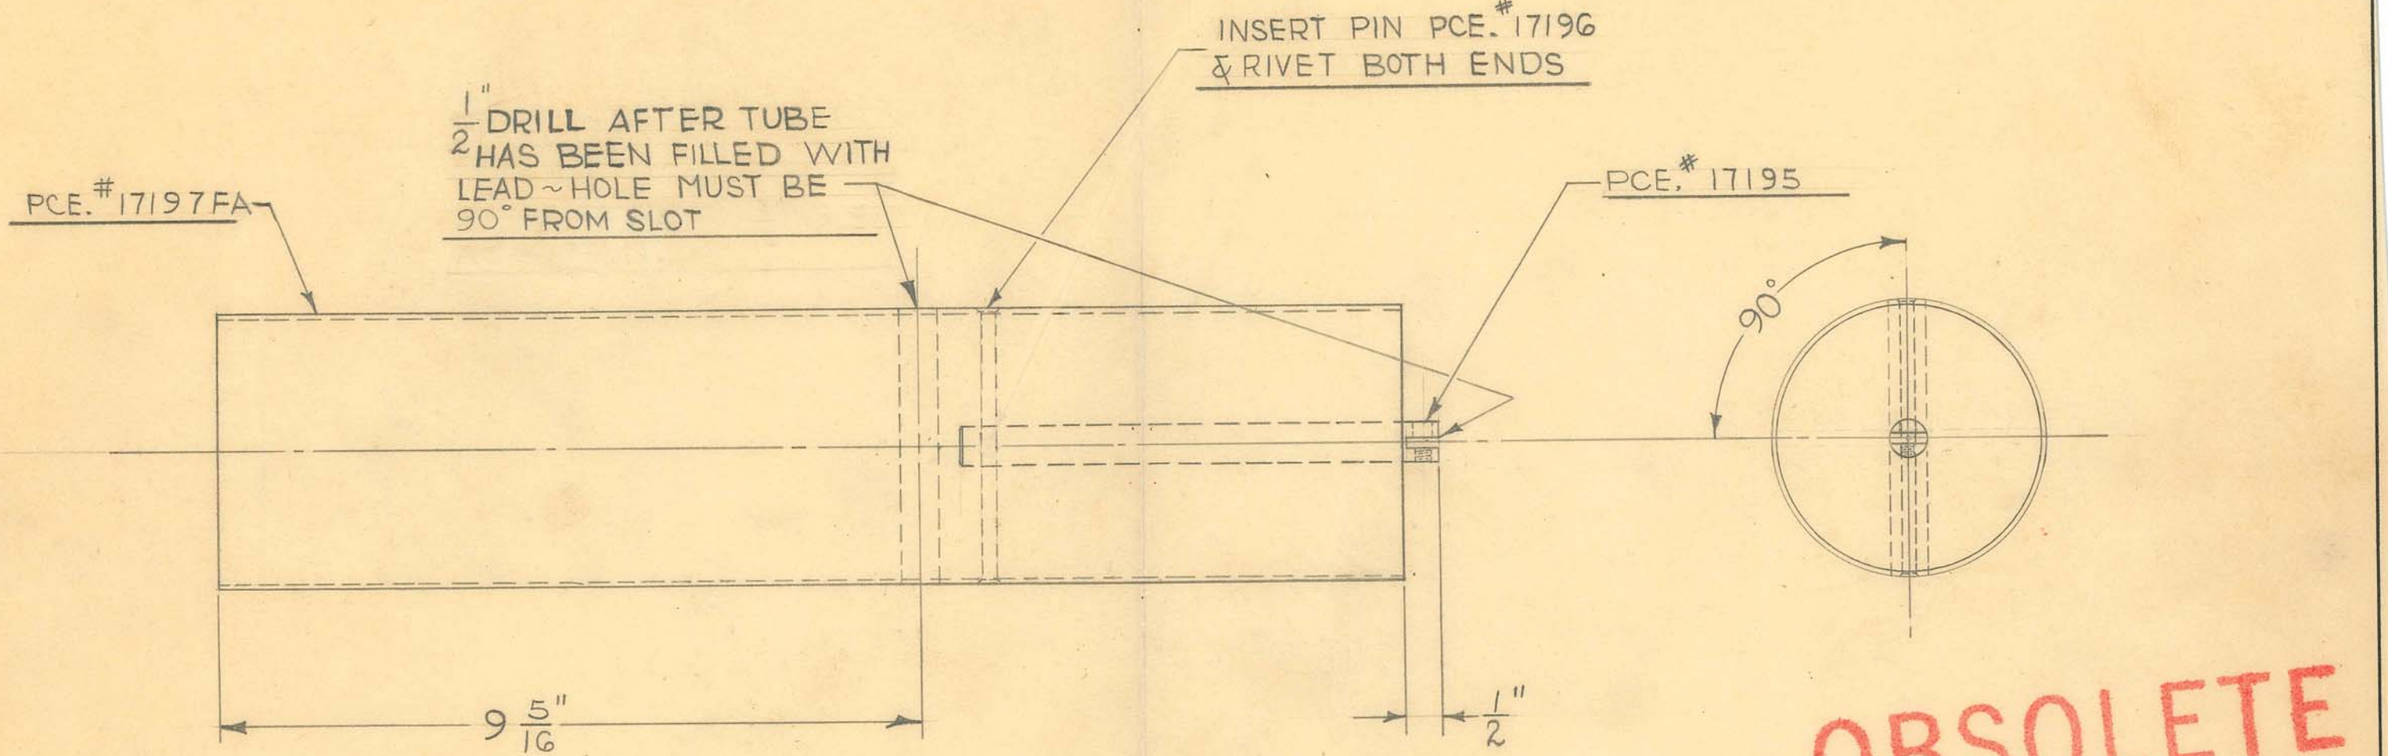

OBSOLETE

Obsolete

FILL TUBE WITH LEAD TO BRING TOTAL WEIGHT UP TO 63 1/2 LB. ± 1/2 LB.

WHEN PRESENT STOCK OF PCE.# 17195 IS USED UP USE PCE.# 17959. ALSO SEE NEW PRINT # 17198 GB

1 REQUIRED

DRILL JIG TOOL #9541

DIMENSIONS	
FRACTIONAL	± .015
DECIMAL	± .005
ANGULAR	± 1/2°
UNLESS OTHERWISE SPECIFIED	

SIZE		ISSUE 11-12-47	W.J.
KIND		CHANGED	
SHAPE		"	
FINISH		"	
TEMP.		"	
PATT.		"	

TITLE:
FISCHER DELUXE RF.-100 X-RAY UNIT
COUNTERWEIGHT TUBE ASSEMBLY

H. G. FISCHER & CO.
2335 WABANSIA AVE.
CHICAGO, ILL.

CAT. NO.

PART NO. 17198GA

TITLE
FISCHER DELUXE RF-100 X-RAY UNIT
COUNTERWEIGHT TUBE ASSEMBLY

H. G. FISCHER & CO.
FRANKLIN PARK, ILLINOIS

PART NO. 17198GB

DATE 10-5-48 | DR. BY W.J. | CH'K'D. J.Y.W.

REVISION	DATE	BY

PATTERN | FINISH | SCALE HALF

DIMENSIONS
FRACTIONAL ± .015
DECIMAL ± .005
ANGULAR ± ½°
UNLESS OTHERWISE SPECIFIED

TOOLS
DRILL JIG TOOL #9541
FILLING CAP TOOL #9565

MATERIAL

OBSOLETE

XX Obsolete
3-25-53

1 REQUIRED

FILL TUBE WITH LEAD TO BRING TOTAL WEIGHT UP TO 63 1/2 LBS. + 1/2 - 1/2 LB.

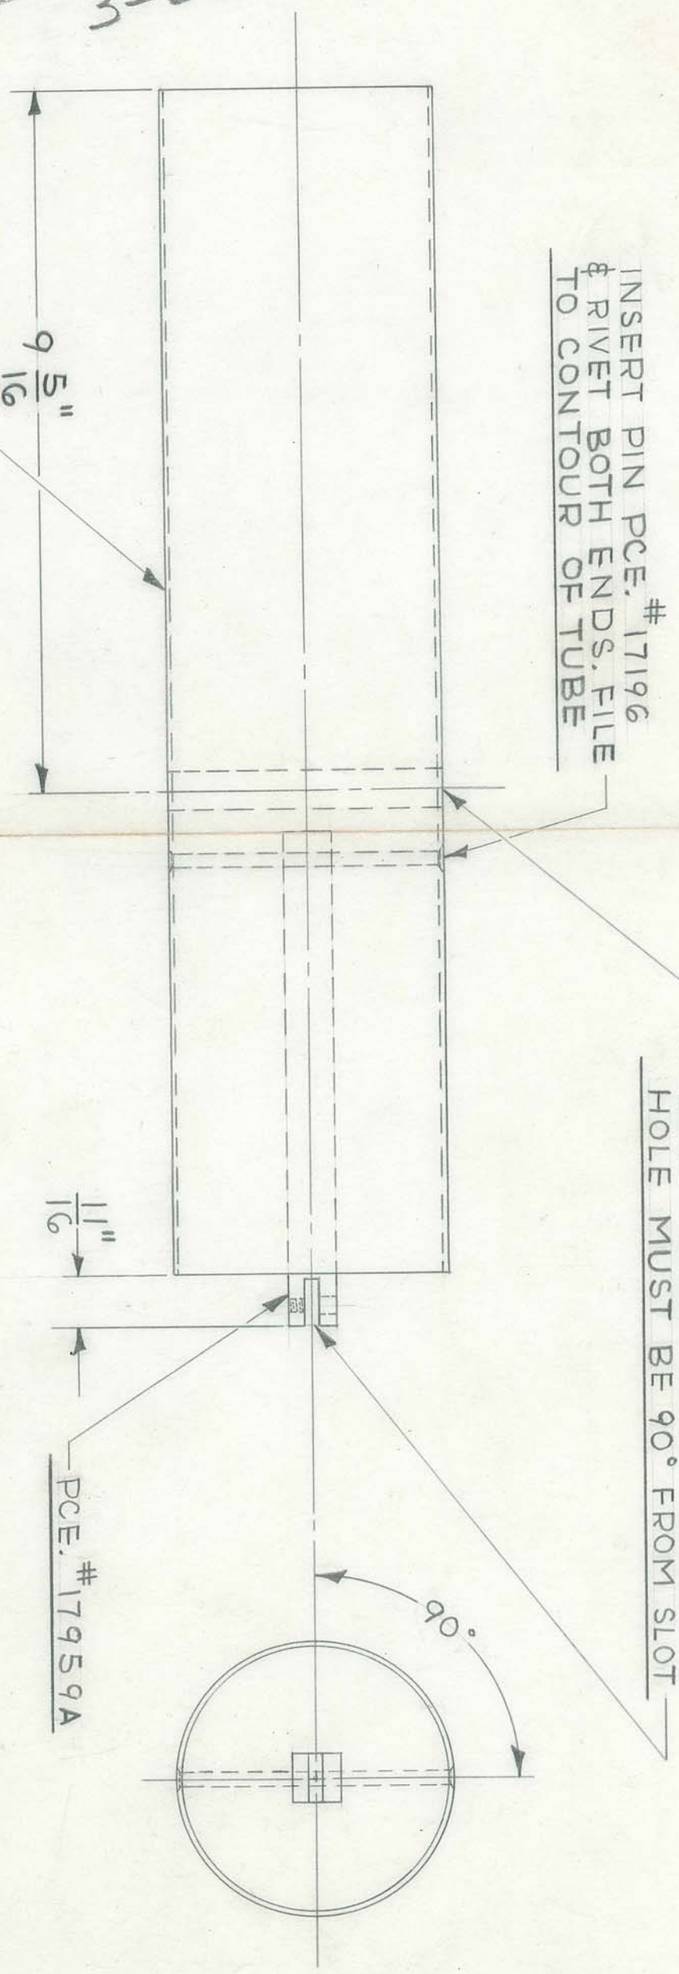

FOLDER #127

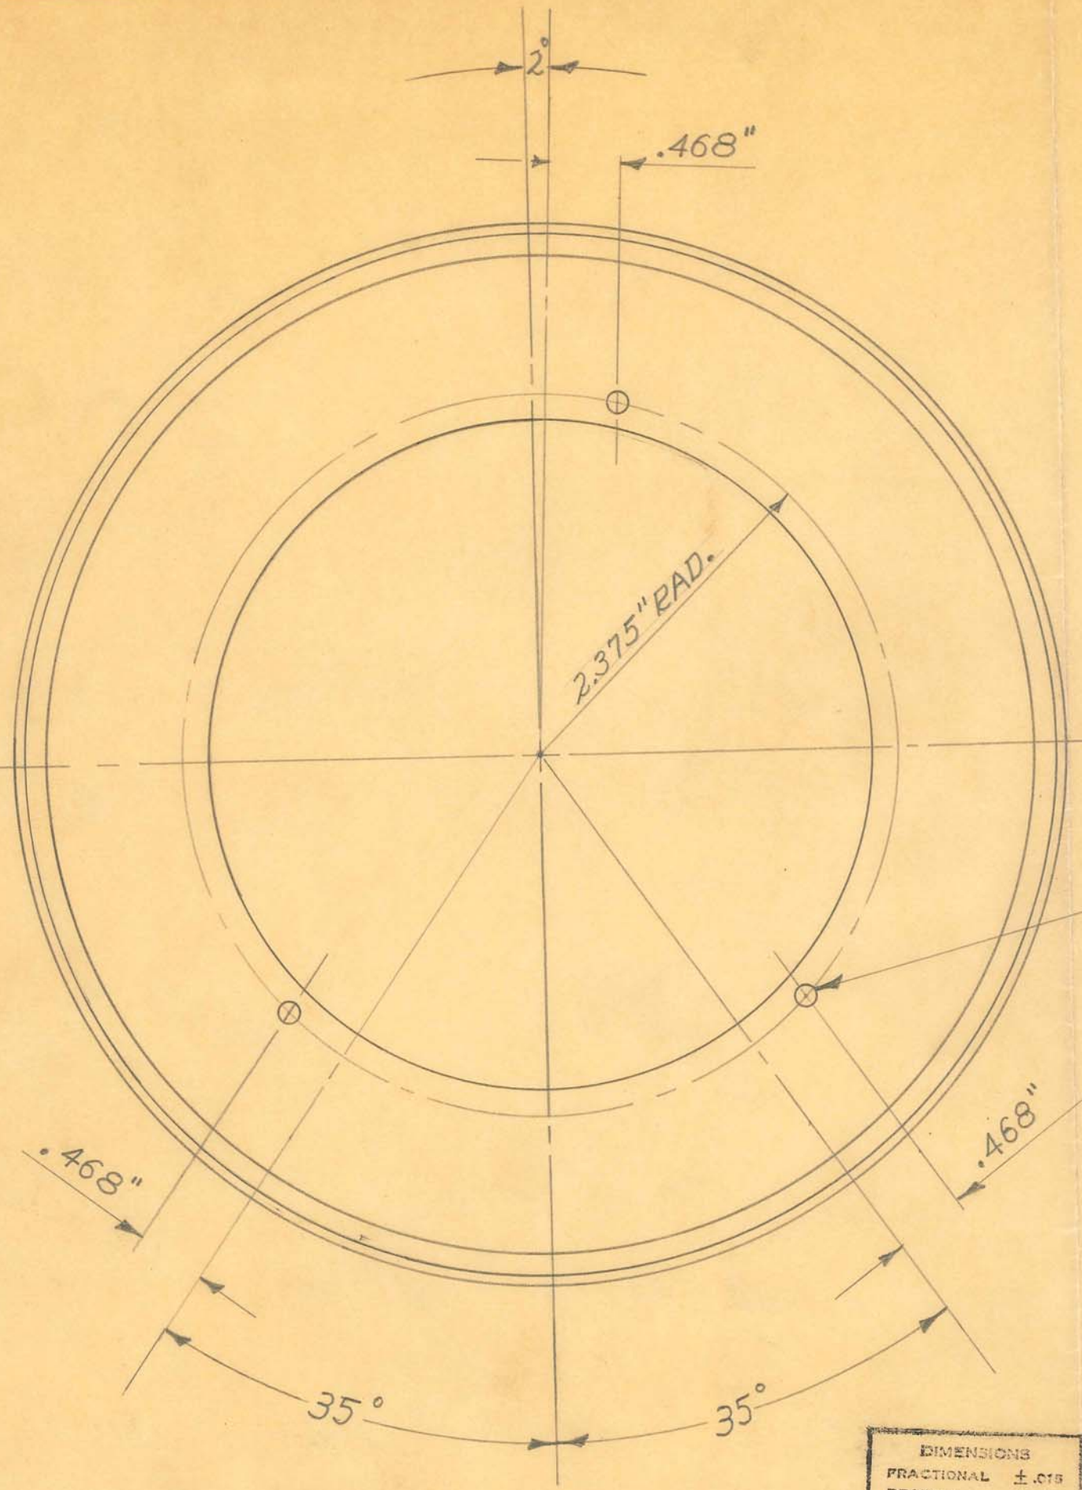

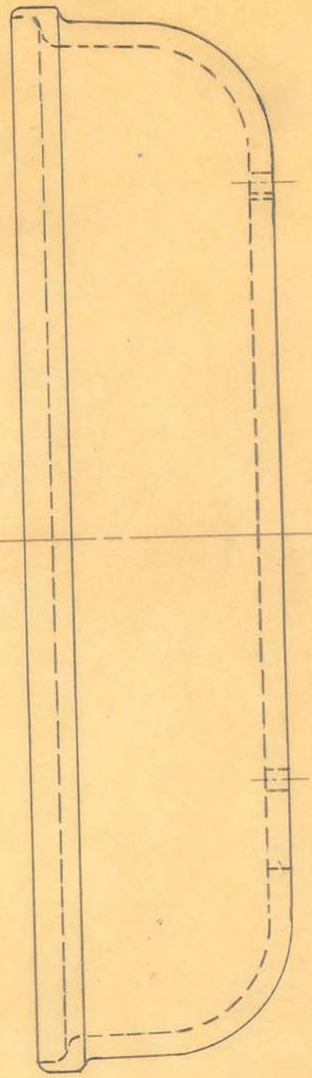

3 HLS. #25 DRILL

DIMENSIONS
FRACTIONAL ± .015
DECIMAL ± .005
ANGULAR ± ½°
UNLESS OTHERWISE SPECIFIED

GRIND PROMINET ROUGH SPOTS ONLY

1-REQUIRED

DRILL JIG TOOL #9537

OBSOLETE

obsolete
3-15-51
JF

SIZE	MAKE	ISSUE 11-7-47	J.M.F
KIND	FROM	CHANGED	
SHAPE	17251	"	
FINISH		"	
TEMP.		"	
PATT.	#2262	"	

TITLE: FISCHER DELUXE "RF-100" X-RAY VERTICAL SLIDE BEARING COVER-UPPER

H. G. FISCHER & CO.
2335 WABANSIA AVE.
CHICAGO, ILL.

CAT. NO.

PART NO. 17199

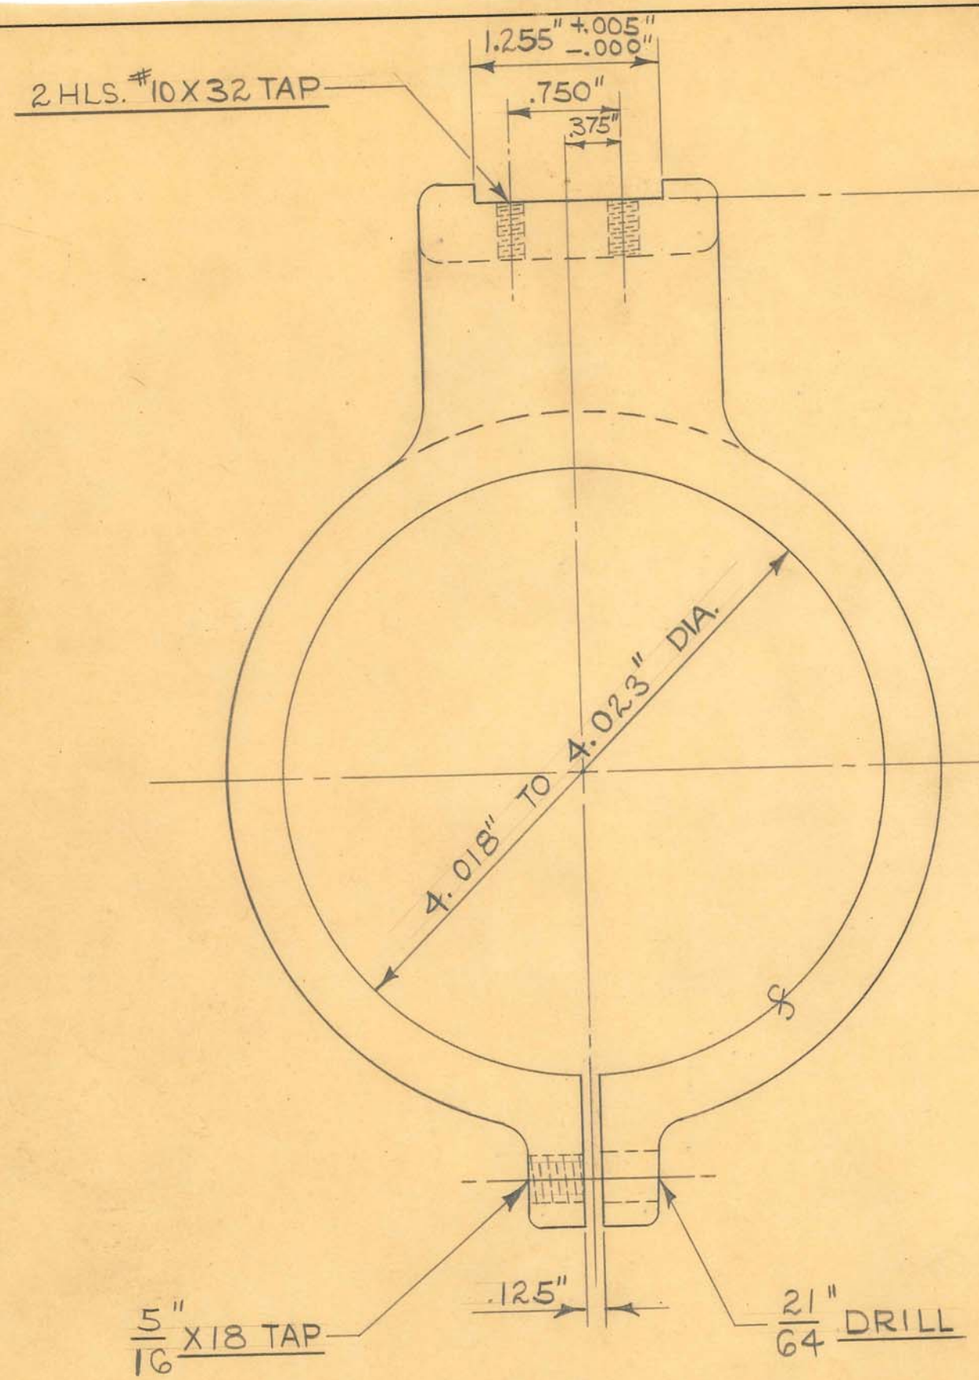

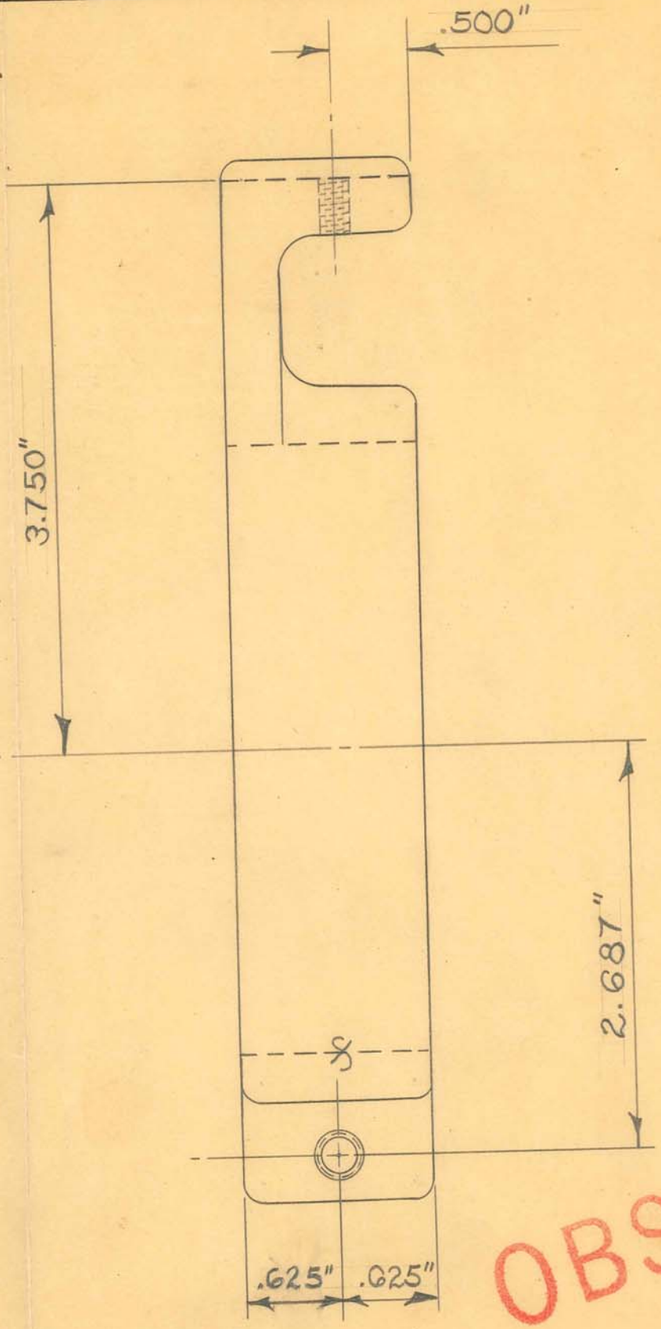

OBSOLETE

Obsolete 8-4-50

1 REQUIRED

4.017" GO - 4.023" NO GO GAUGE #11,146
DRILL JIG TOOL #9365
MILLING FIXTURE TOOL #9366

DIMENSIONS	
FRACTIONAL	± .015
DECIMAL	± .003
ANGULAR	± ½°
UNLESS OTHERWISE SPECIFIED	

SIZE	CAST IN	ISSUE 10-23-47	W. J.	TITLE: FISCHER DELUXE RF 100 X-RAY UNIT VERT. SLIDE GUIDE BAR SUPPORT
KIND	GRAY IRON	CHANGED		
SHAPE		"		
FINISH	PAINTED	"		
TEMP.		"		
PATT.	2247	"		

H. G. FISCHER & CO.
2338 WABANSIA AVE.
CHICAGO, ILL.

CAT. NO.

PART NO. 17214F

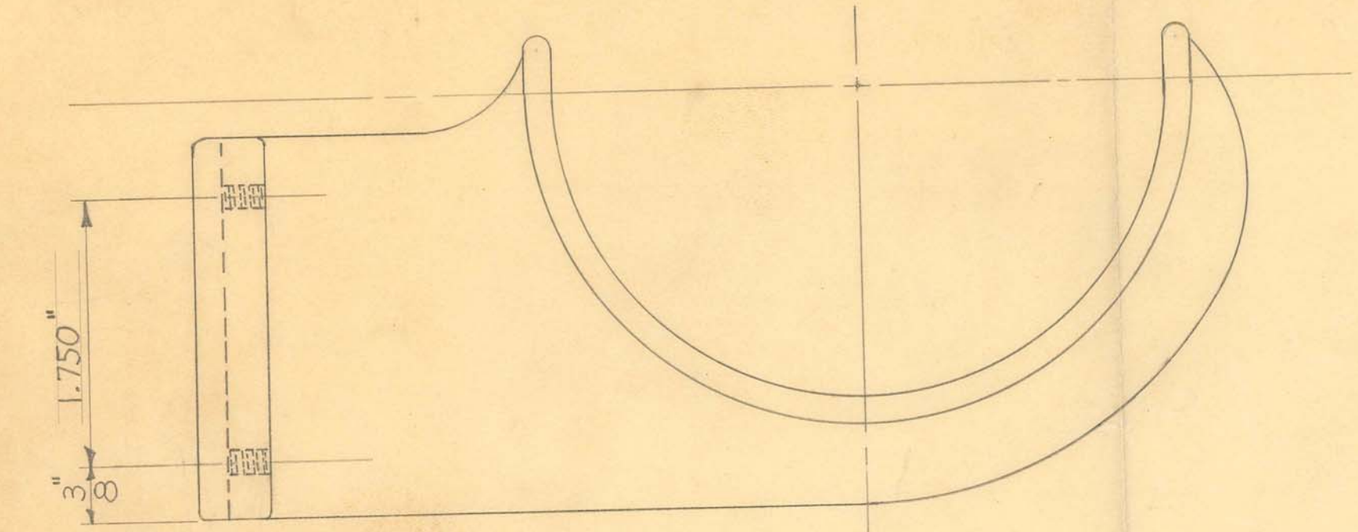

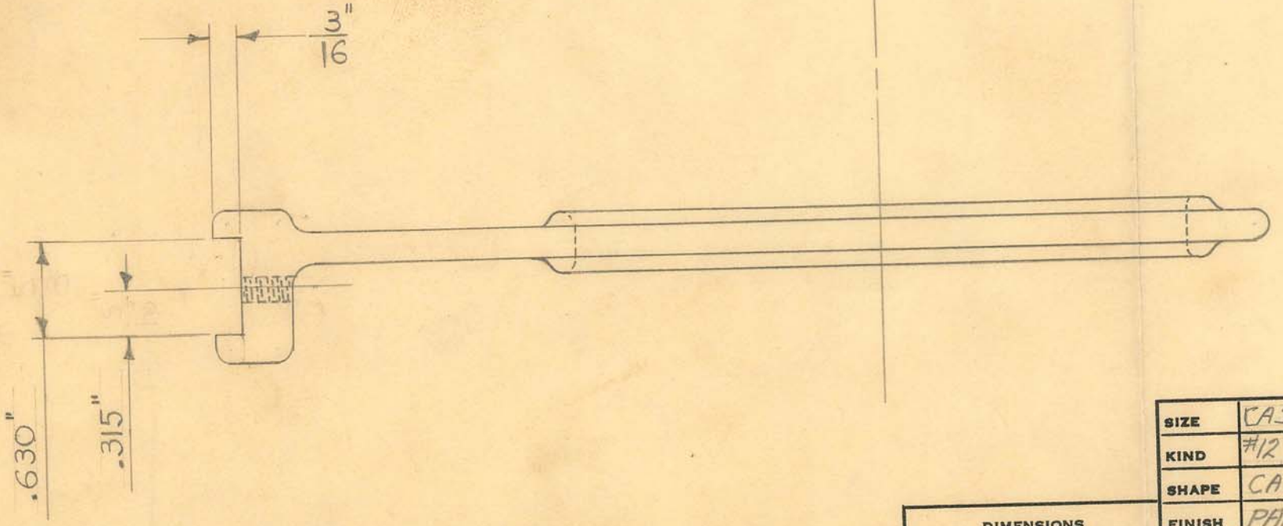

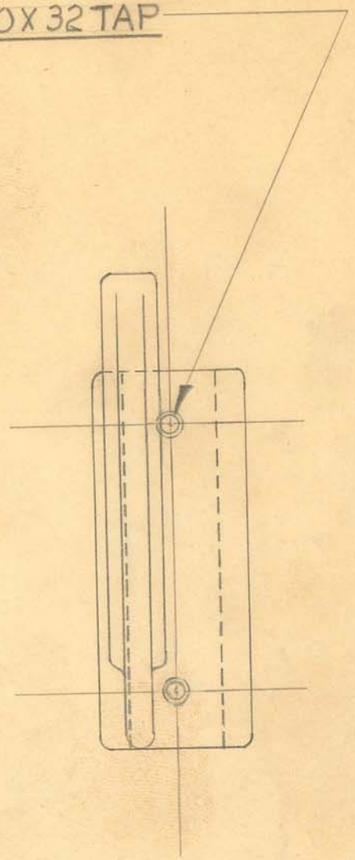

GRIND OFF PROMINENT FINS
AND ROUGH SPOTS ONLY

1-REQUIRED

OBSOLETE Obsolete

MILLING FIXTURE TOOL # 9624
DRILL JIG TOOL # 9623

DIMENSIONS	
FRACTIONAL	± .015
DECIMAL	± .005
ANGULAR	± 1/2°

UNLESS OTHERWISE SPECIFIED

SIZE	CAST IN	ISSUE 12-22-47	J.M.F
KIND	#12 ALUM.	CHANGED	
SHAPE	CASTING	"	
FINISH	PAINTED	"	
TEMP.		"	
PATT.	2289	"	

TITLE:
FISCHER DELUXE RF-100 X-RAY
BUCKY & TUBE STAND INTERLOCK

H. G. FISCHER & CO.
2335 WABANSIA AVE.
CHICAGO. ILL.

CAT. NO.

PART NO. 17262F

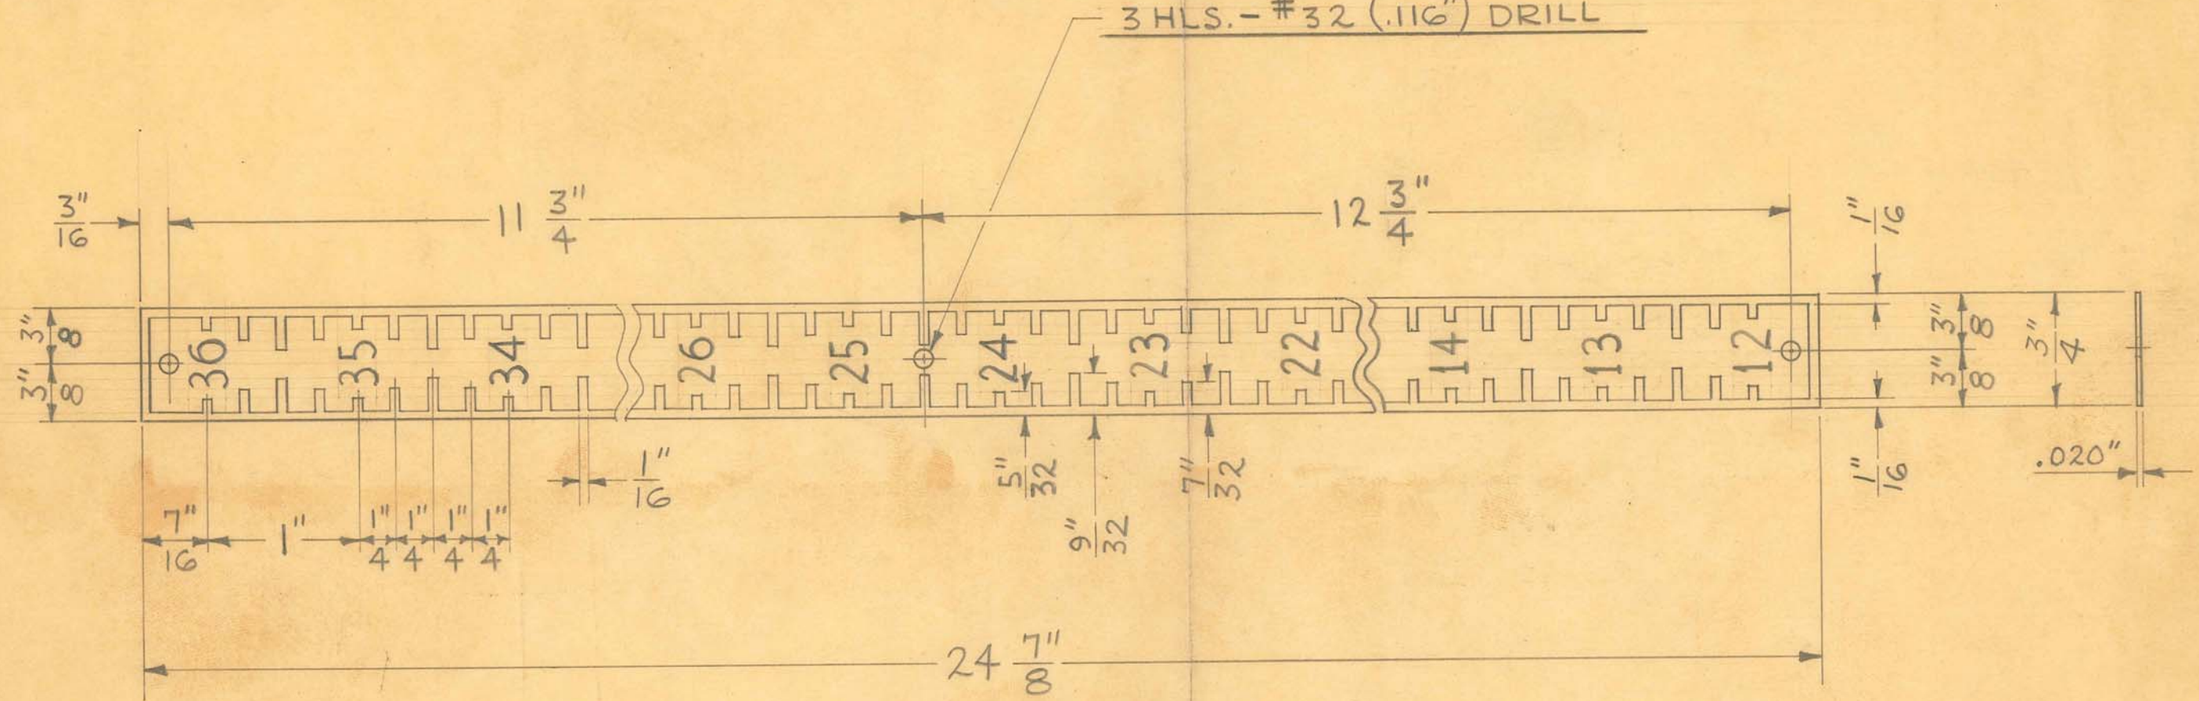

1 REQUIRED

obsolete
3-12-51

OBSOLETE

.020" SHEET ALUMINUM ANNODIZED BLACK BACKROUND

SIZE		ISSUE 10-10-47	J.V.W.	TITLE: FISCHER DELUXE "RF-100" X-RAY VERTICAL SCALE
KIND		CHANGED		
SHAPE		"		
FINISH		"		
TEMP.		"		
PATT.		"		

H. G. FISCHER & CO.
2335 WABANSIA AVE.
CHICAGO, ILL.

CAT. NO.

PART NO. 17282

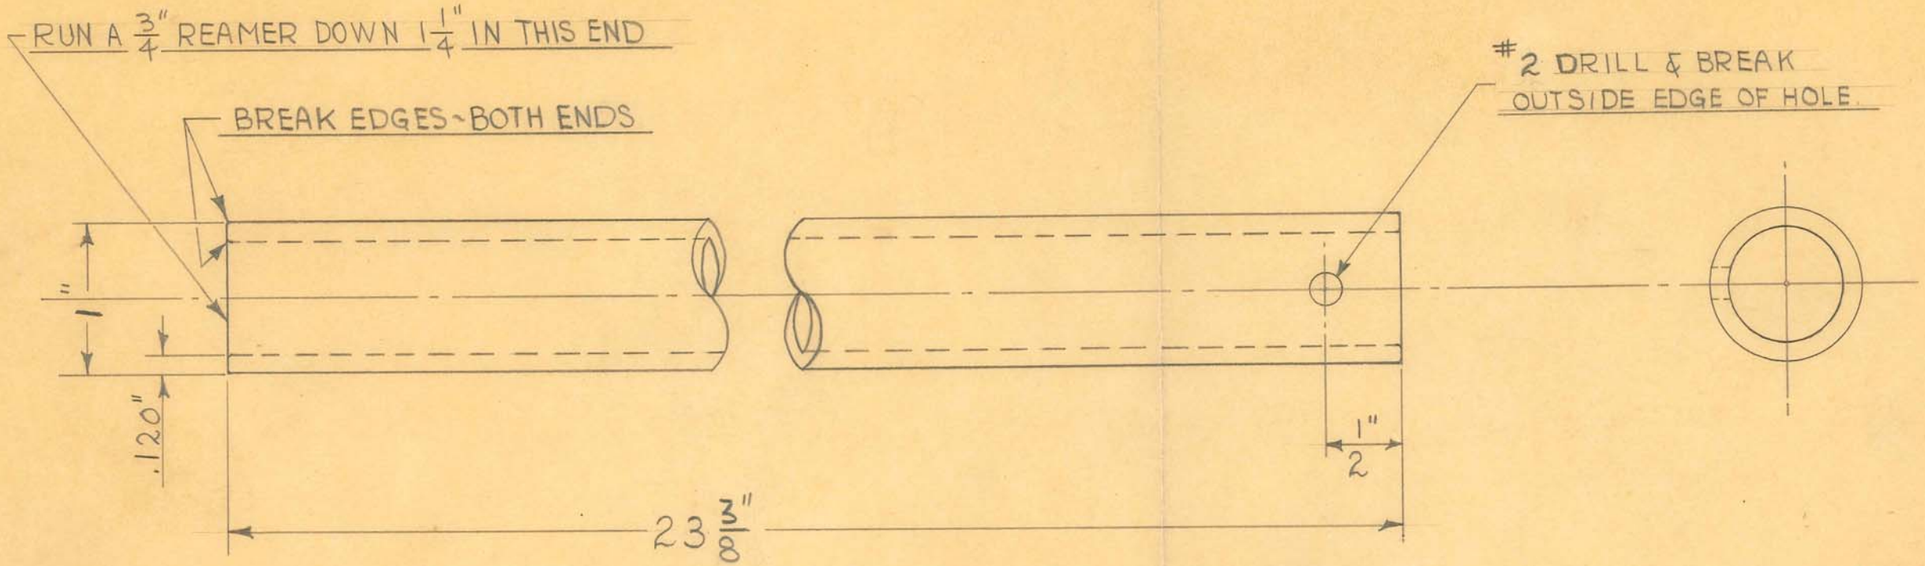

OBSOLETE

1" O.D. X # 11 GA. (.120") WALL SHELBY SEAMLESS STEEL TUBING

1 REQUIRED

Obsolete 8-10-51 W.J.

DRILL JIG TOOL # 9542

SIZE		ISSUE 11-4-47	W.J.
KIND		CHANGED	
SHAPE		"	
FINISH	PAINTED	"	
TEMP.		"	
PATT.		"	

TITLE: FISCHER "DELUXE RF-100" X-RAY UNIT
BASE STOP VERTICAL TUBE

H. G. FISCHER & CO.
2335 WABANSIA AVE.
CHICAGO, ILL.

CAT. NO.

PART NO. 17305

FOLDER #127

TITLE: FISCHER DELUXE "RF-100" X-RAY UNIT
VERTICAL TUBE

PATTERN	FINISH: CHROME #2	SCALE: HALF	PART NO. 17312F
TOOLS: DRILL JIG #9538	MATERIAL: 4" OD. X #11GA. (.120") WALL X 80 1/4" SEAMLESS STEEL TUBING	DATE: 1-27-49	REVISION / DATE / BY
		DR. BY: W.J.	
		CH'K'D. J.W.W.	

H. G. FISCHER & CO.
FRANKLIN PARK, ILLINOIS

DIMENSIONS
FRACTIONAL ± .015
DECIMAL ± .005
ANGULAR ± ½°
UNLESS OTHERWISE SPECIFIED

1 REQUIRED

NOTE:
#44 HLS. MUST BE 17/64" IN RELATION TO HOLE AS SHOWN

6 HLS. #44 DRILL

OBSOLETE
8-21-50
W.J.W.

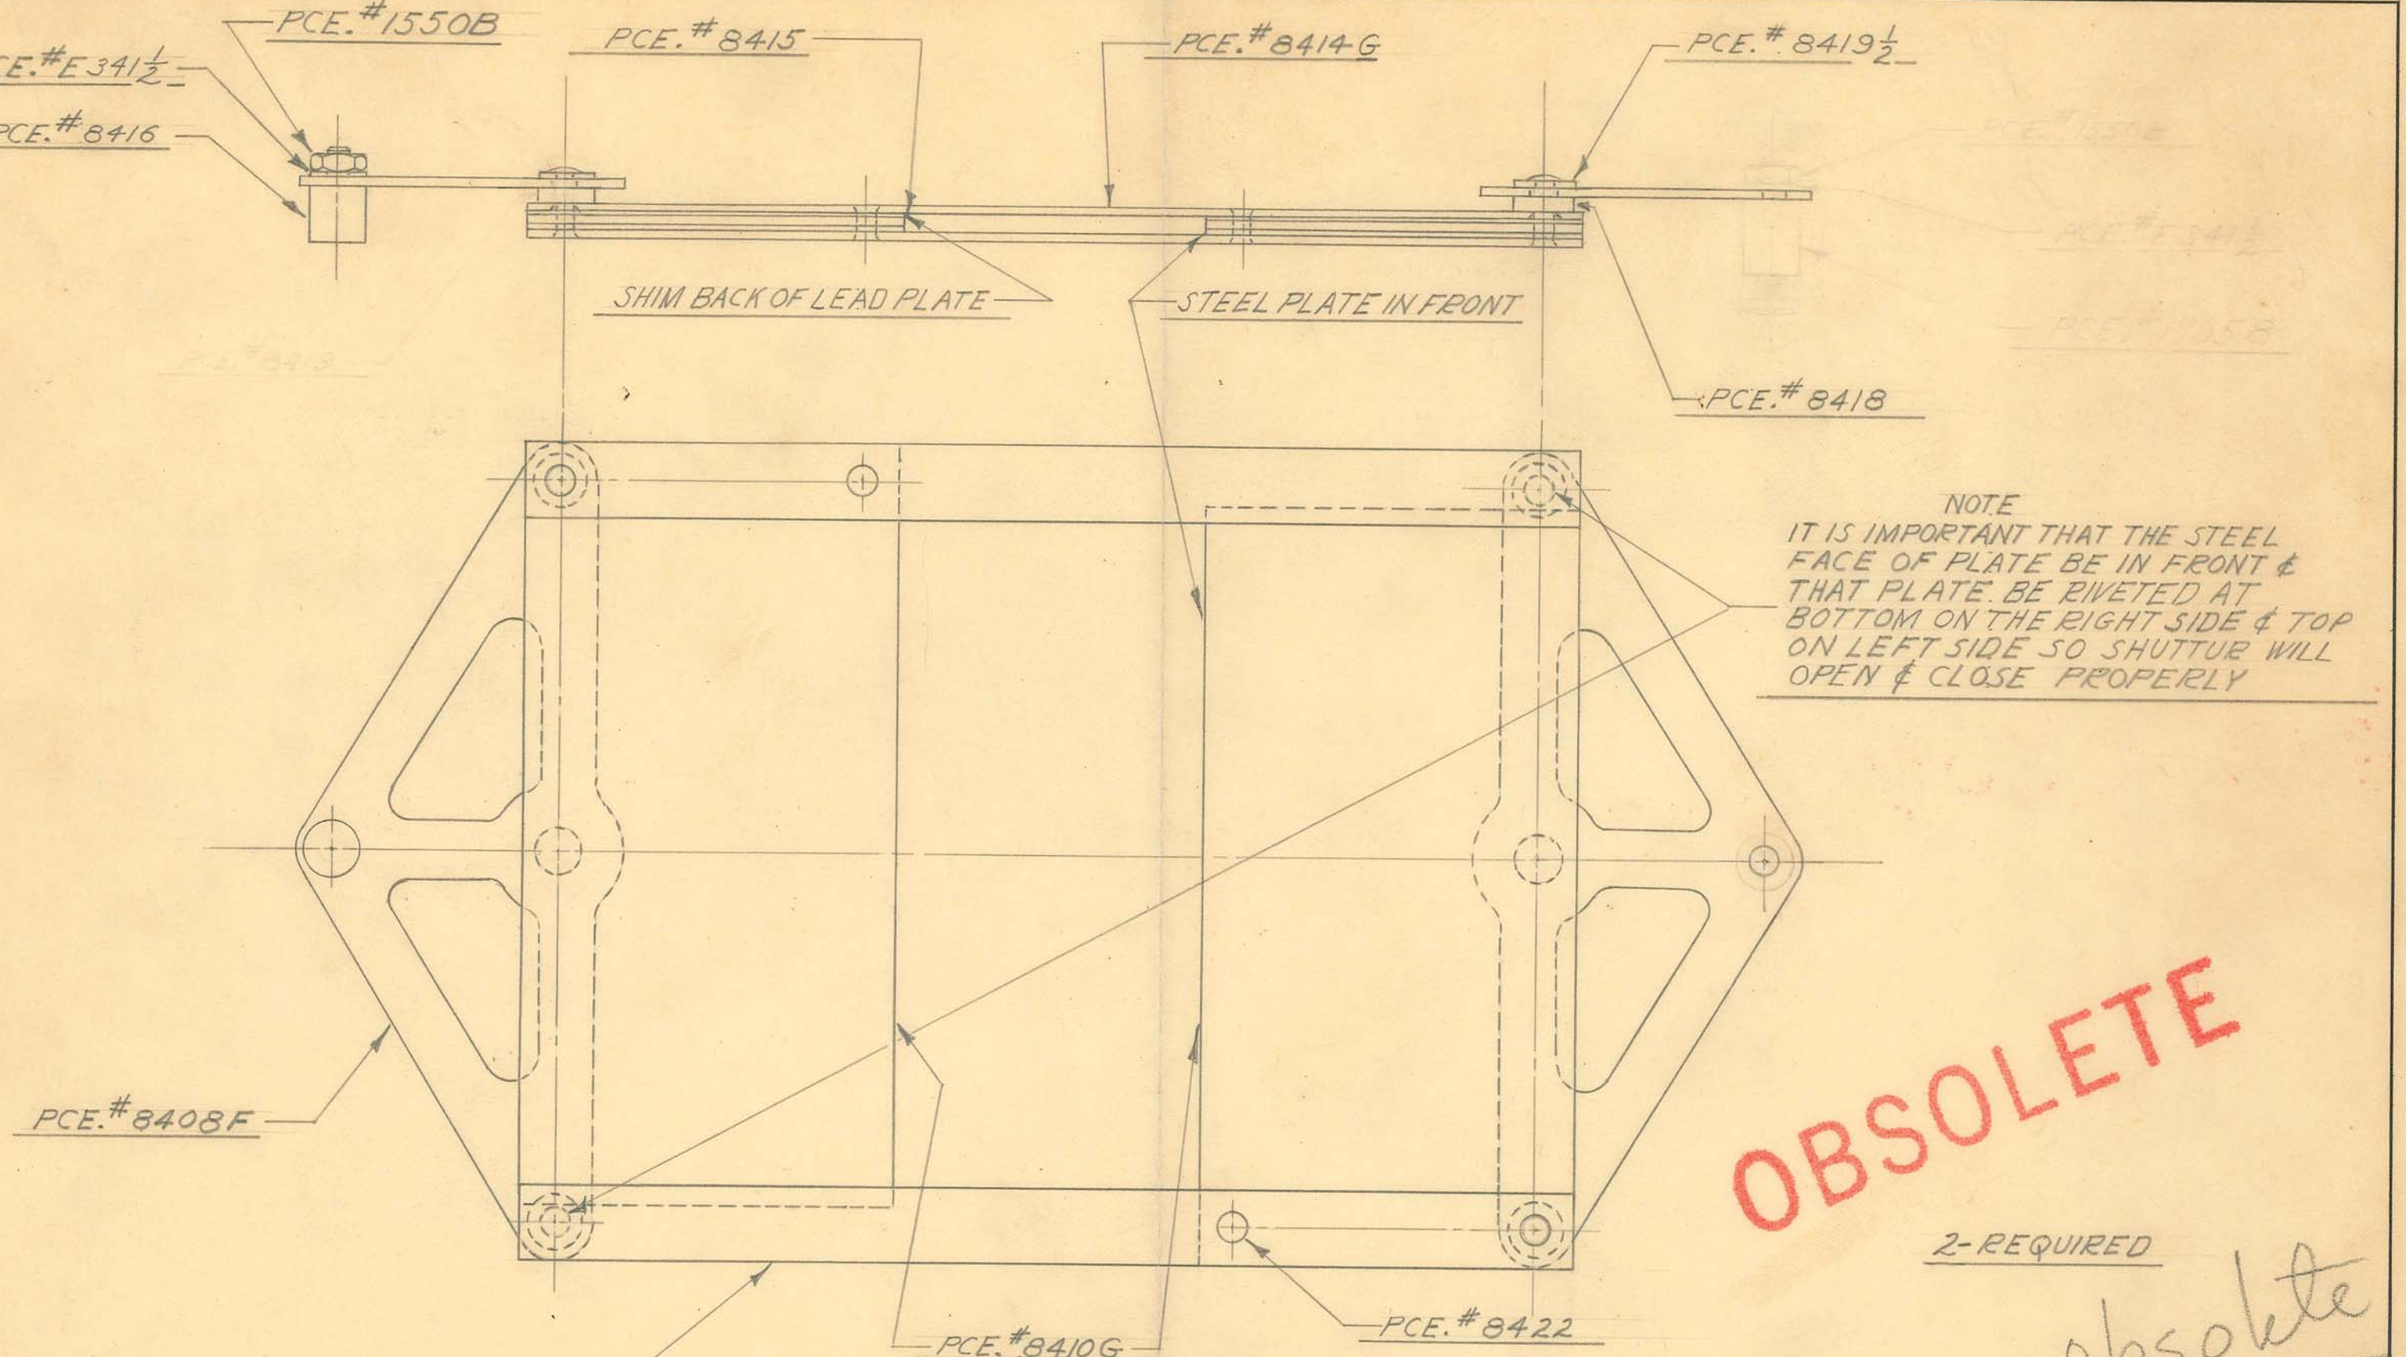

NOTE
IT IS IMPORTANT THAT THE STEEL FACE OF PLATE BE IN FRONT & THAT PLATE BE RIVETED AT BOTTOM ON THE RIGHT SIDE & TOP ON LEFT SIDE SO SHUTTUR WILL OPEN & CLOSE PROPERLY

OBSOLETE

2-REQUIRED

obsolete 5-9-50

DIMENSIONS	
FRACTIONAL	± .015
DECIMAL	± .005
ANGULAR	± 1/2°
UNLESS OTHERWISE SPECIFIED	

SIZE		ISSUE 11-12-47	J.M.F	
KIND		CHANGED		
SHAPE		"		
FINISH		"		
TEMP.		"		
PATT.		"		

TITLE: FISCHER DELUXE "RF-100" X-RAY VERTICAL SHUTTER ASSEMBLY

H. G. FISCHER & CO.
2335 WABANSIA AVE.
CHICAGO, ILL.

CAT. NO.

PART NO. 17355 G

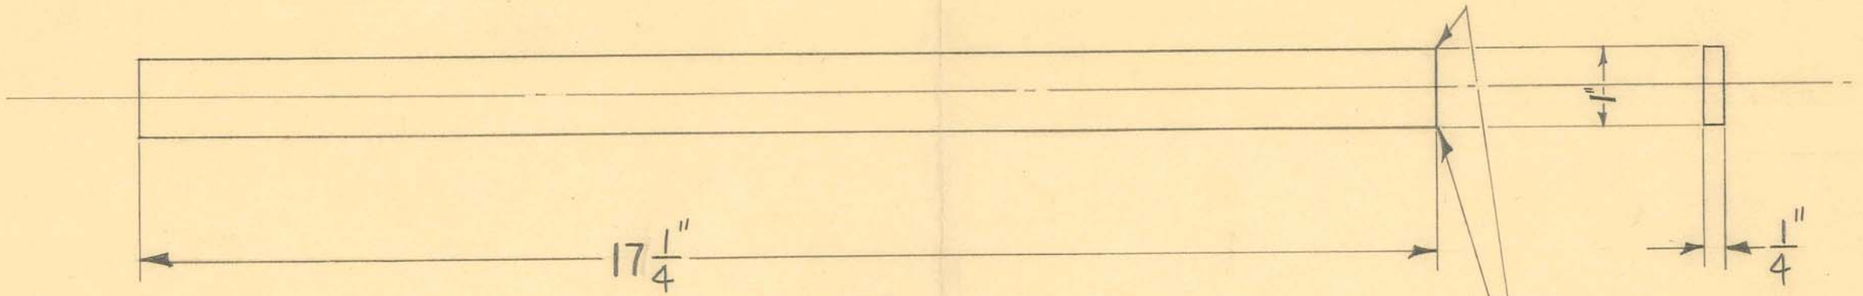

LENGTH OF DEVELOPMENT

REMOVE ALL SHARP CORNERS & EDGES - BOTH ENDS

OBSOLETE

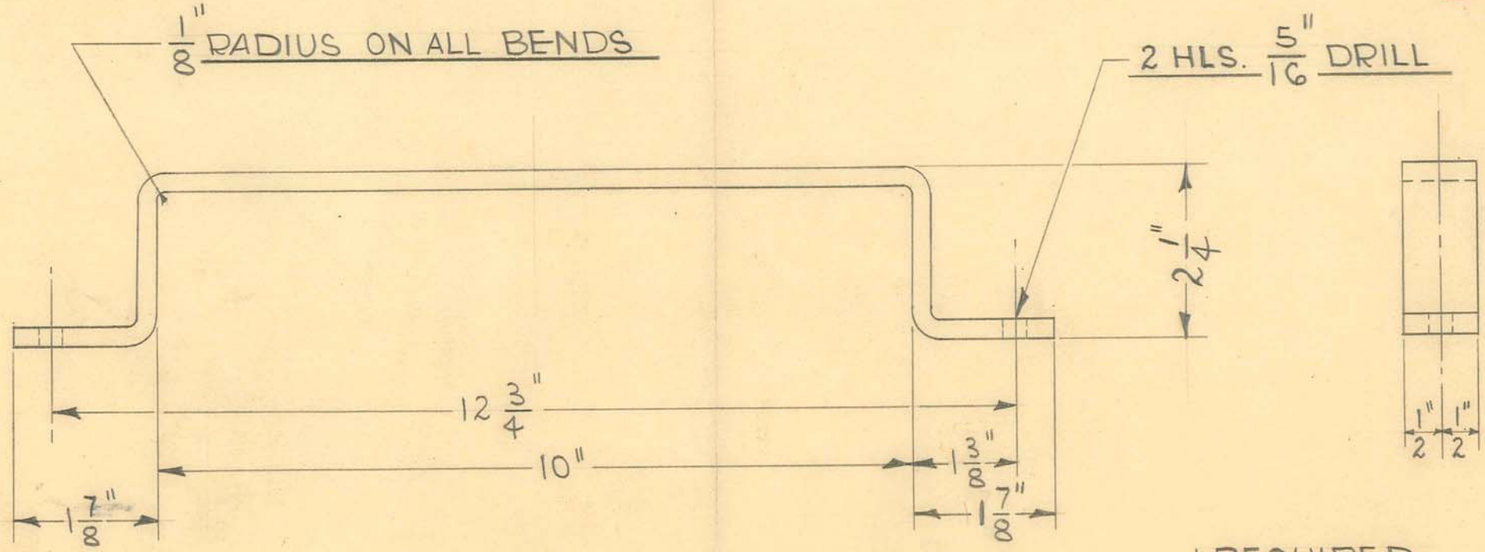

obsolete
1-29-51

1 REQUIRED

SCALE ≈ HALF SIZE

DIMENSIONS	
FRACTIONAL	± .015
DECIMAL	± .005
ANGULAR	± 1/2°

SIZE	1" X 1/4"	ISSUE 4-28-48	W.J.
KIND	C.R. STEEL	CHANGED	
SHAPE	BAR	"	
FINISH		"	
TEMP.		"	
PATT.		"	

TITLE:
FISCHER DELUXE RF-100 X RAY UNIT
C'WEIGHT LIFTING HANDLE

H. G. FISCHER & CO.
2335 WABANSIA AVE.
CHICAGO, ILL.

CAT. NO.

PART NO. 17395

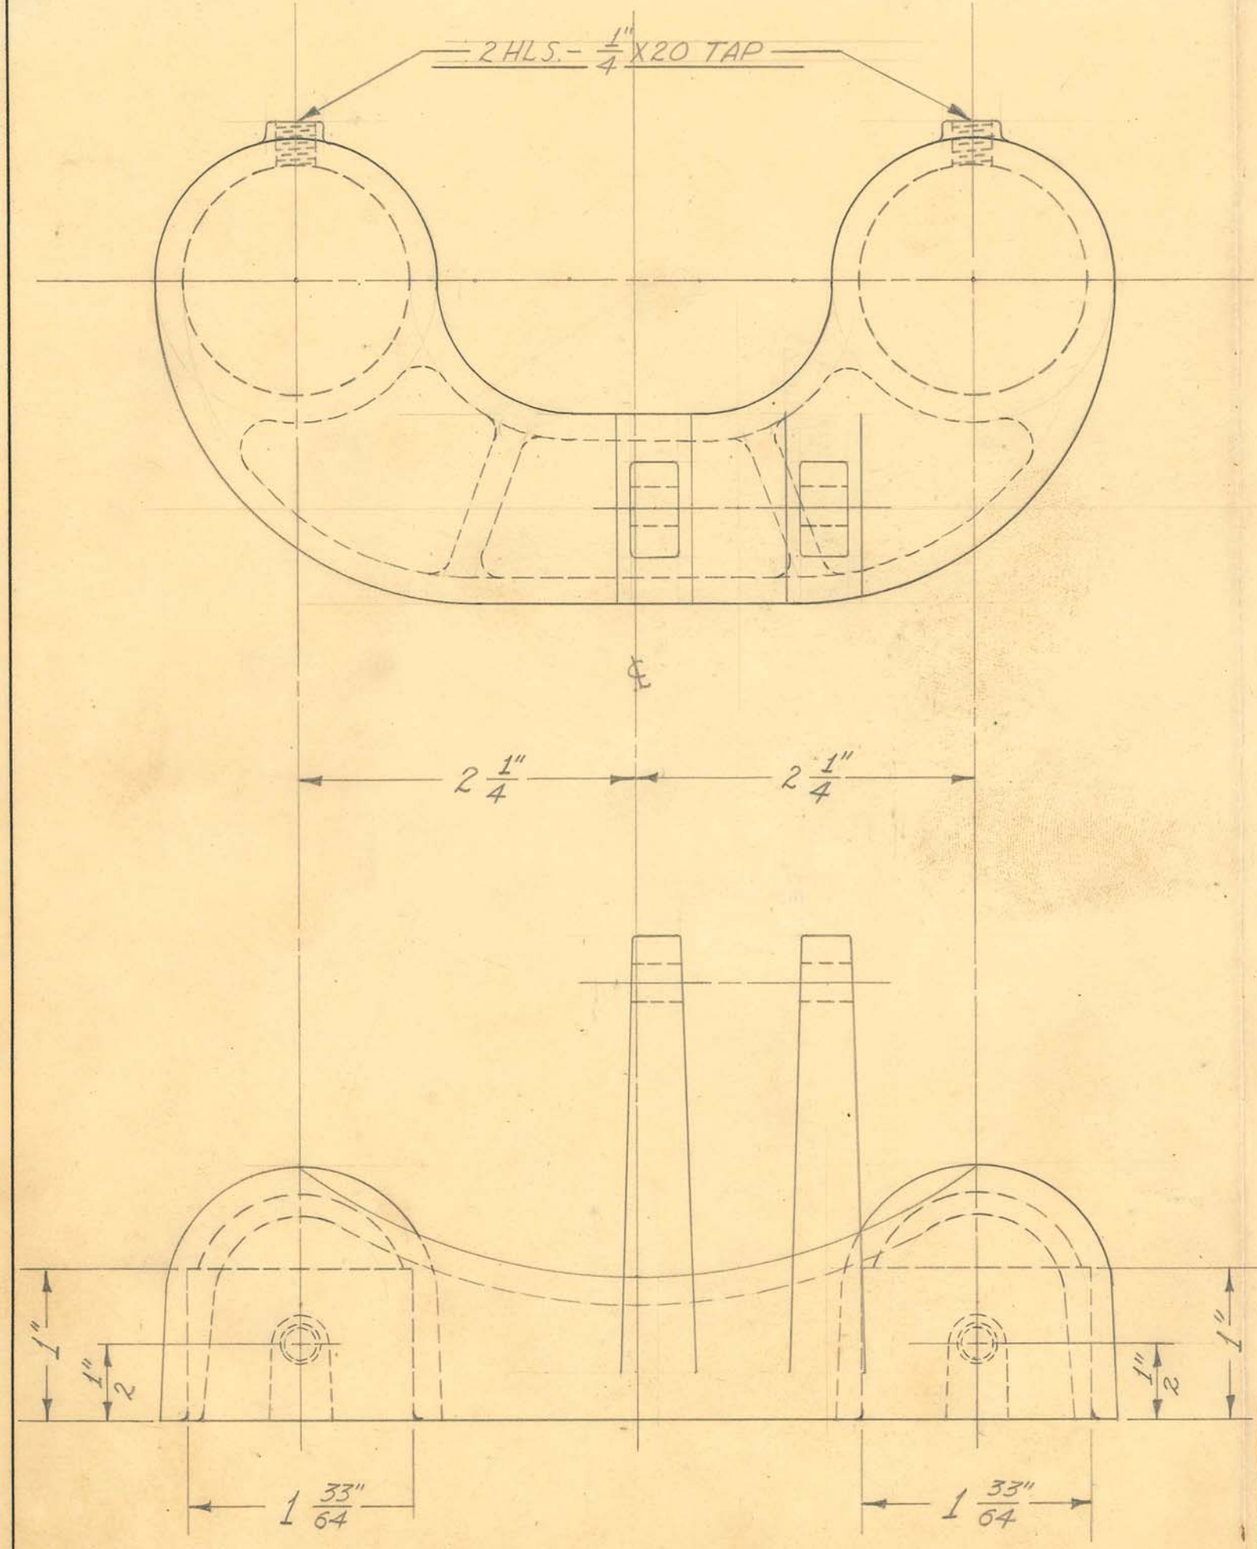

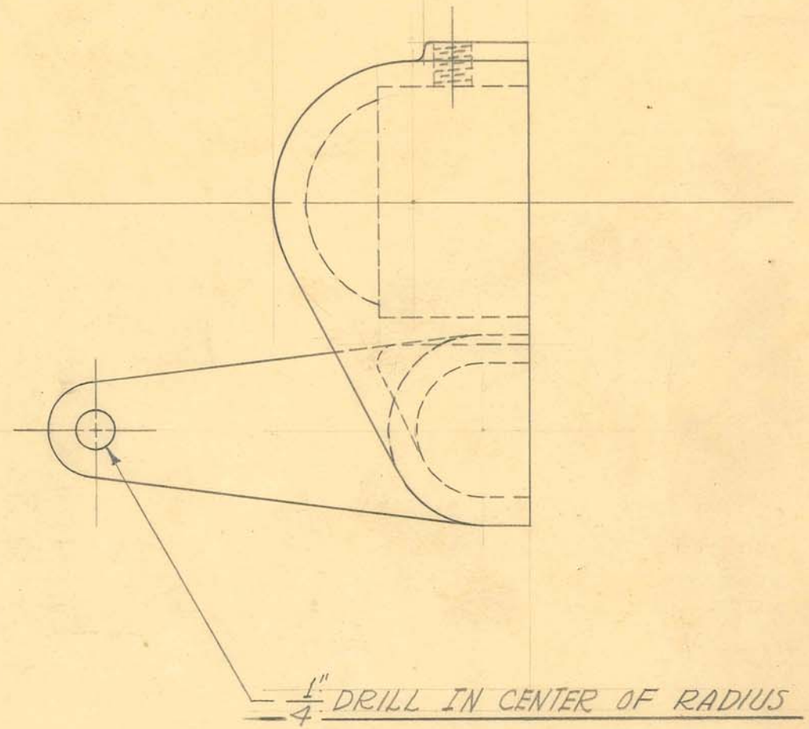

1 REQUIRED

OBSOLETE

SIZE	#214	ISSUE 8-16-39	J.W.	
KIND	ALUM. CASTING	CHANGED		
SHAPE		"		
FINISH		"		
TEMP.		"		
PATT.	1396	"		

TITLE: FISCHER LIGHT MOBILE STAND UPRIGHT TUBE CAP

H. G. FISCHER & CO.
2335 WABANSIA AVE.
CHICAGO, ILL.

CAT. NO.

PART NO. 12496BF

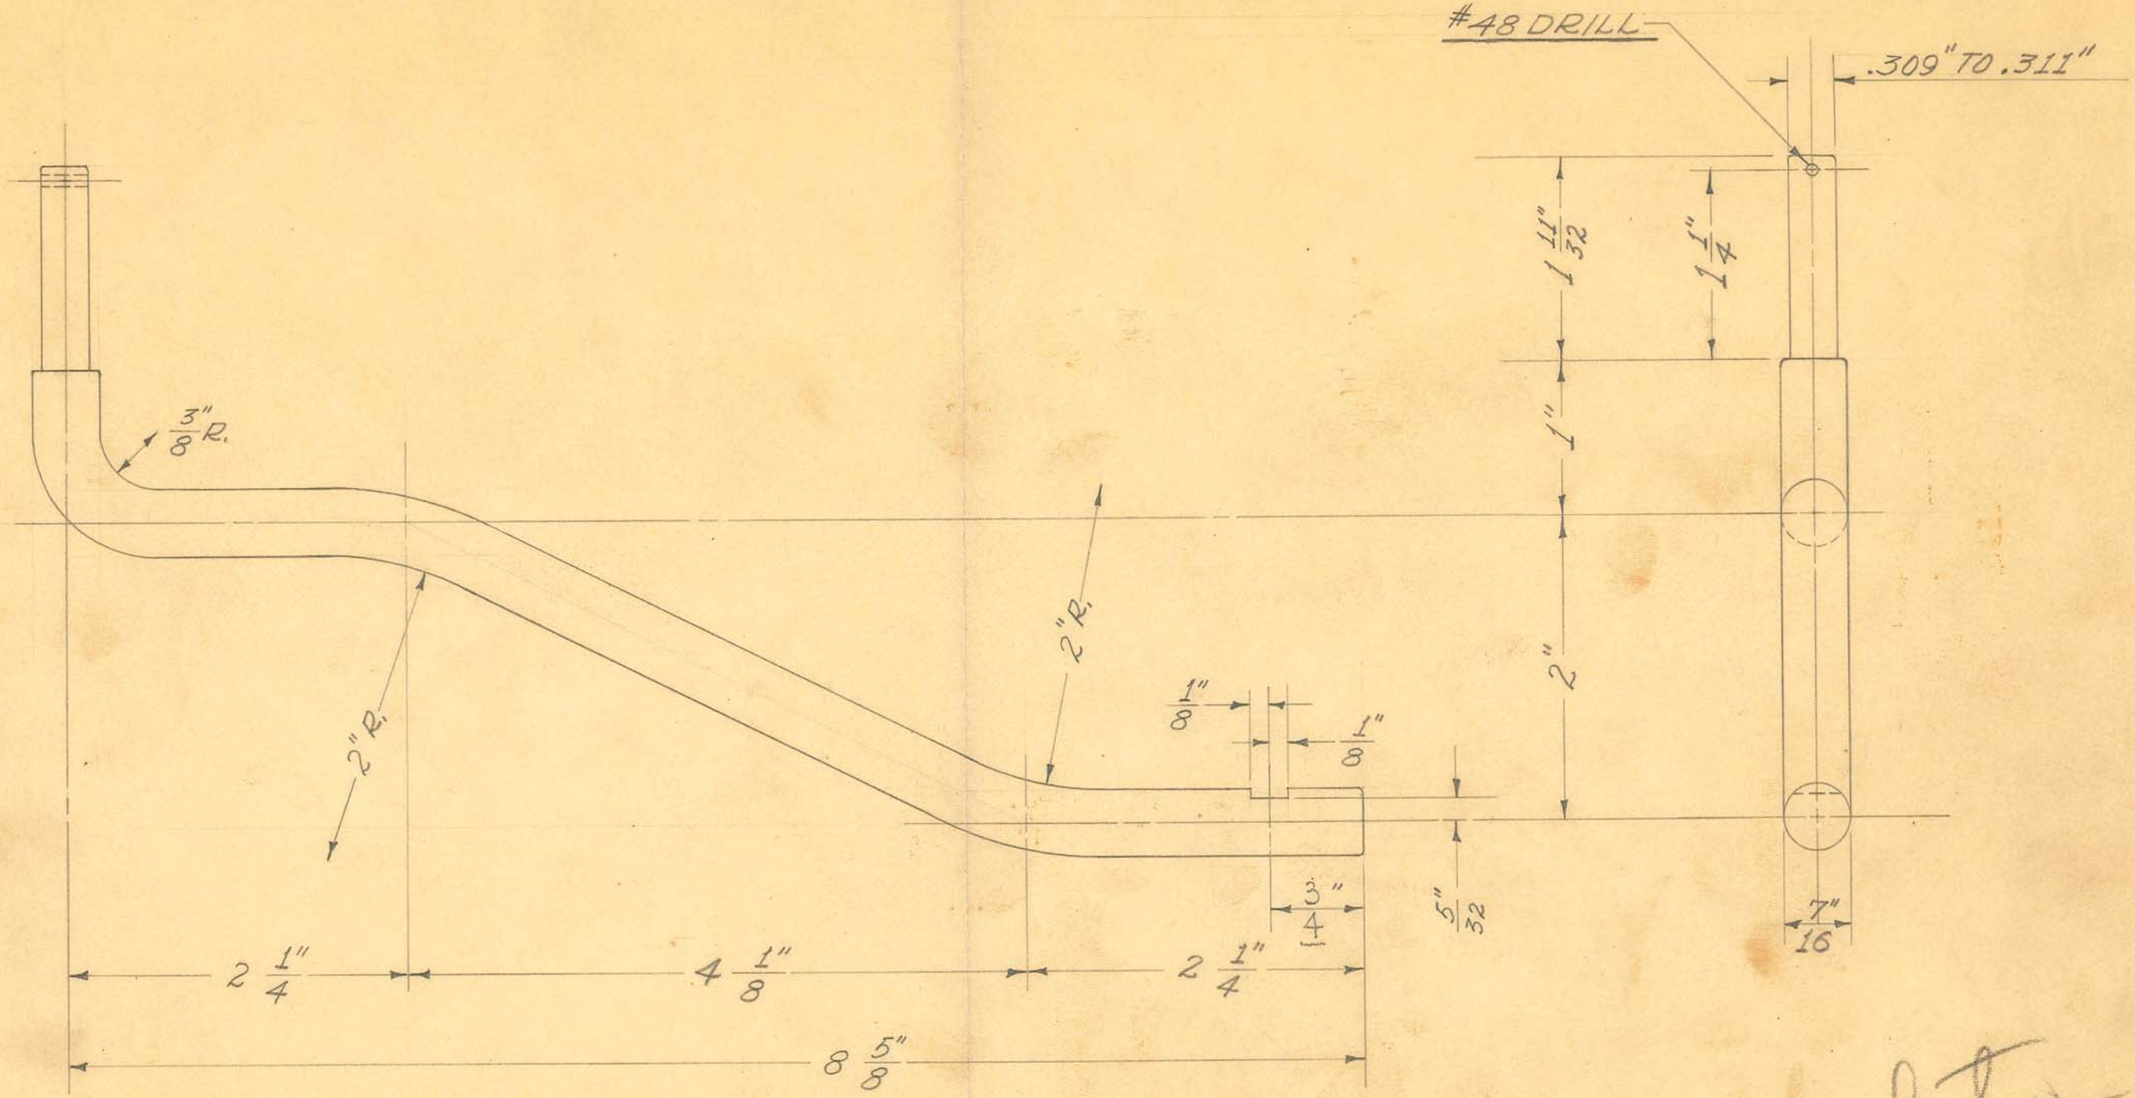

1 REQUIRED

DEVELOPED LENGTH = 11 1/4"

OBSOLETE

SIZE	7/16" DIAM.	ISSUE 2-6-39	J.W.	TITLE: LIGHT MOBILE STAND CRANK HANDLE
KIND	C.R. STEEL	CHANGED 8-2-39	H.E.	
SHAPE	ROD	"		
FINISH	CHROME #2	"		
TEMP.		"		
PATT.		"		

H. G. FISCHER & CO.
2335 WABANSIA AVE.
CHICAGO, ILL.

CAT. NO.

PART NO. 12507A

DRILL JIG TOOL # 6973
MILLING FIXTURE TOOL # 6974
FORMING FIXTURE TOOL # 6975

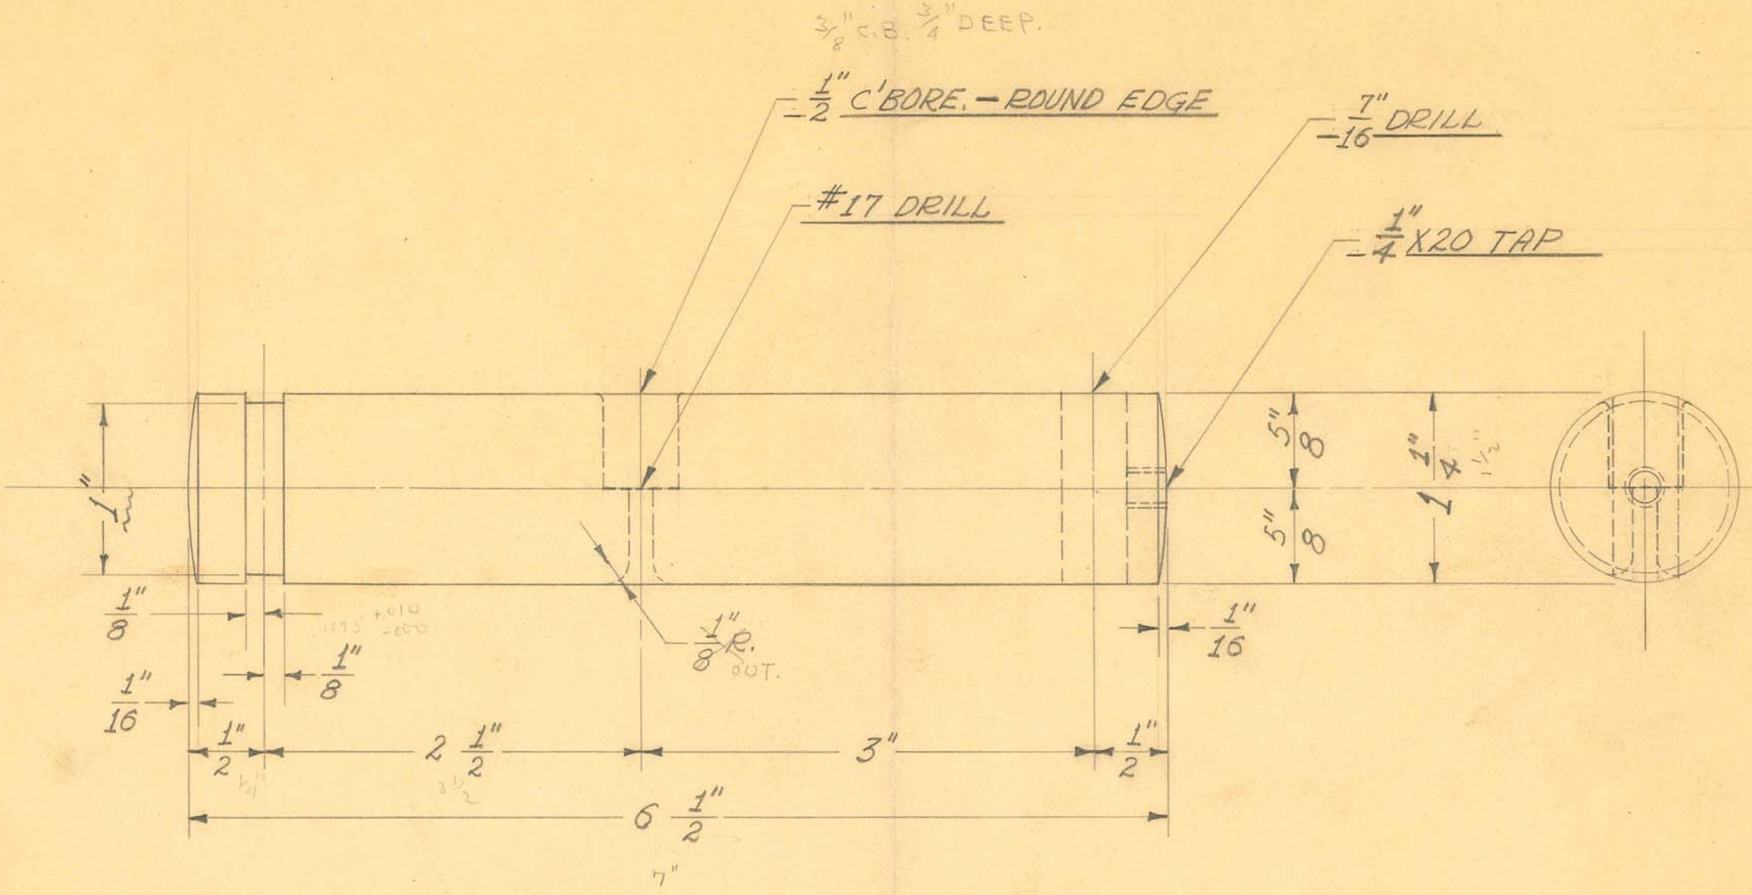

1 REQUIRED

OBSOLETE

OBSOLETE

SIZE	1 1/4" DIAM.	ISSUE 2-7-39	J.W.
KIND	C.R. STEEL	CHANGED	
SHAPE		"	
FINISH	CHR. #2 POL. ENDS ONLY	"	
TEMP.		"	
PATT.		"	

TITLE:
LIGHT MOBILE STAND
CRANK SHAFT

H. G. FISCHER & CO.
2335 WABANSIA AVE.
CHICAGO, ILL.

CAT. NO.

PART NO. 12508

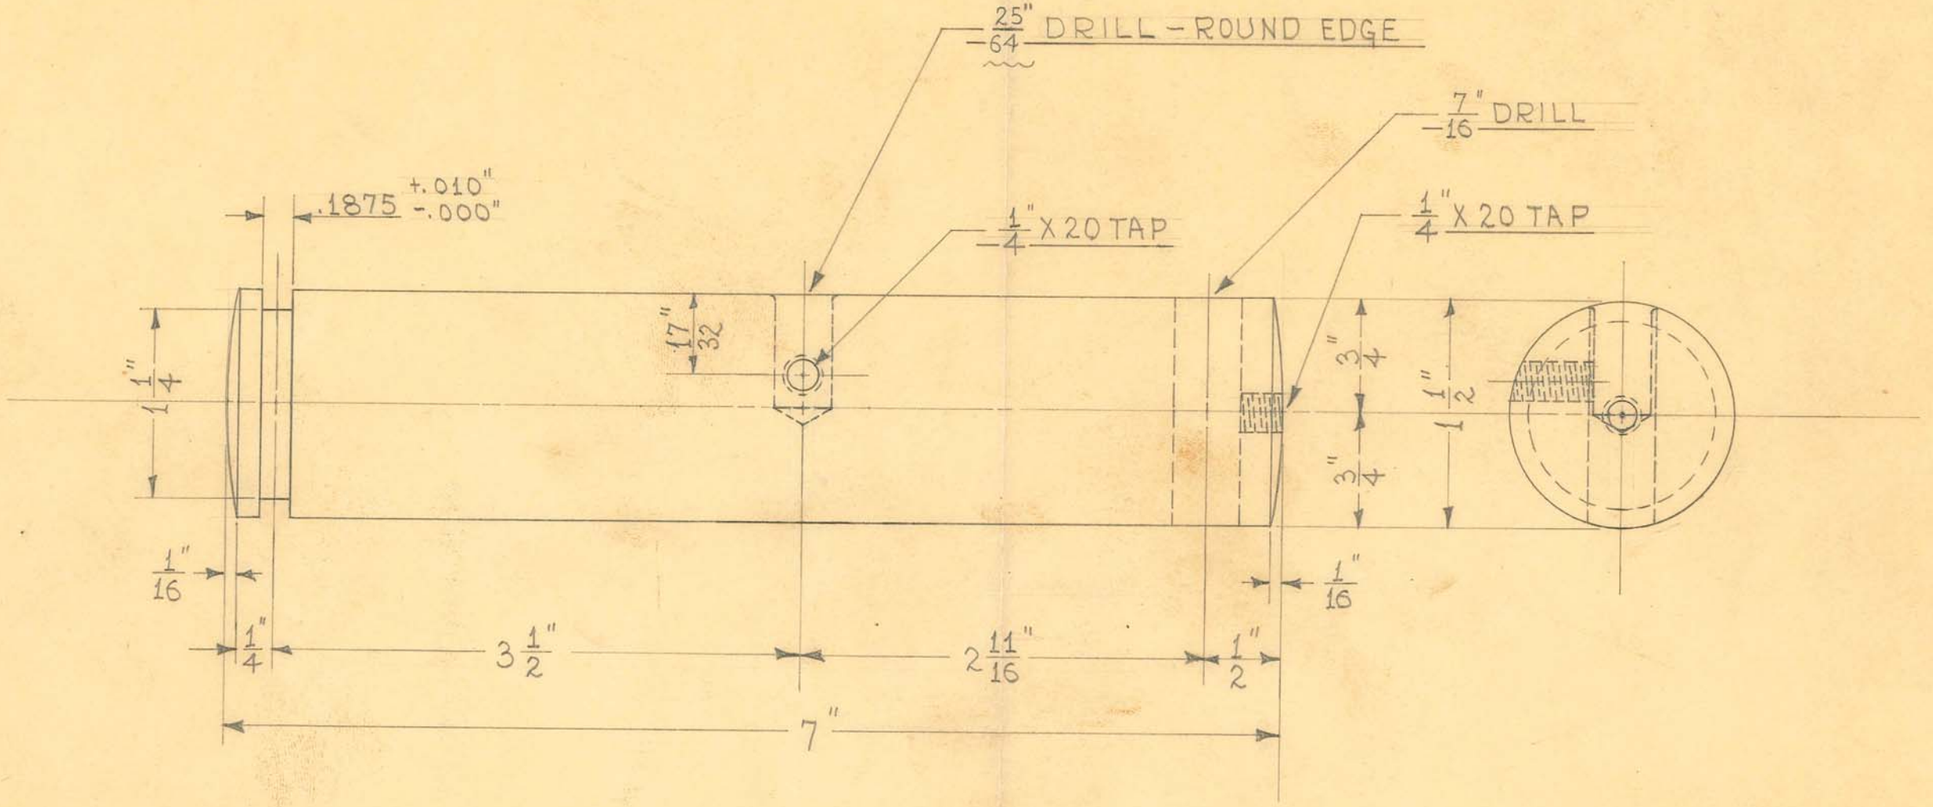

1 REQUIRED

OBSOLETE

SIZE	1½" DIAM.	ISSUE 8-2-39	HE.
KIND	C.R. STEEL	CHANGED 9-15-39	J.W.
SHAPE		"	
FINISH	CHR. #2 POL. ENDS ONLY	"	
TEMP.		"	
PATT.		"	

TITLE:
LIGHT MOBILE STAND
CRANK SHAFT

H. G. FISCHER & CO. 2335 WABANSIA AVE. CHICAGO, ILL.	CAT. NO.	PART NO. 12508A

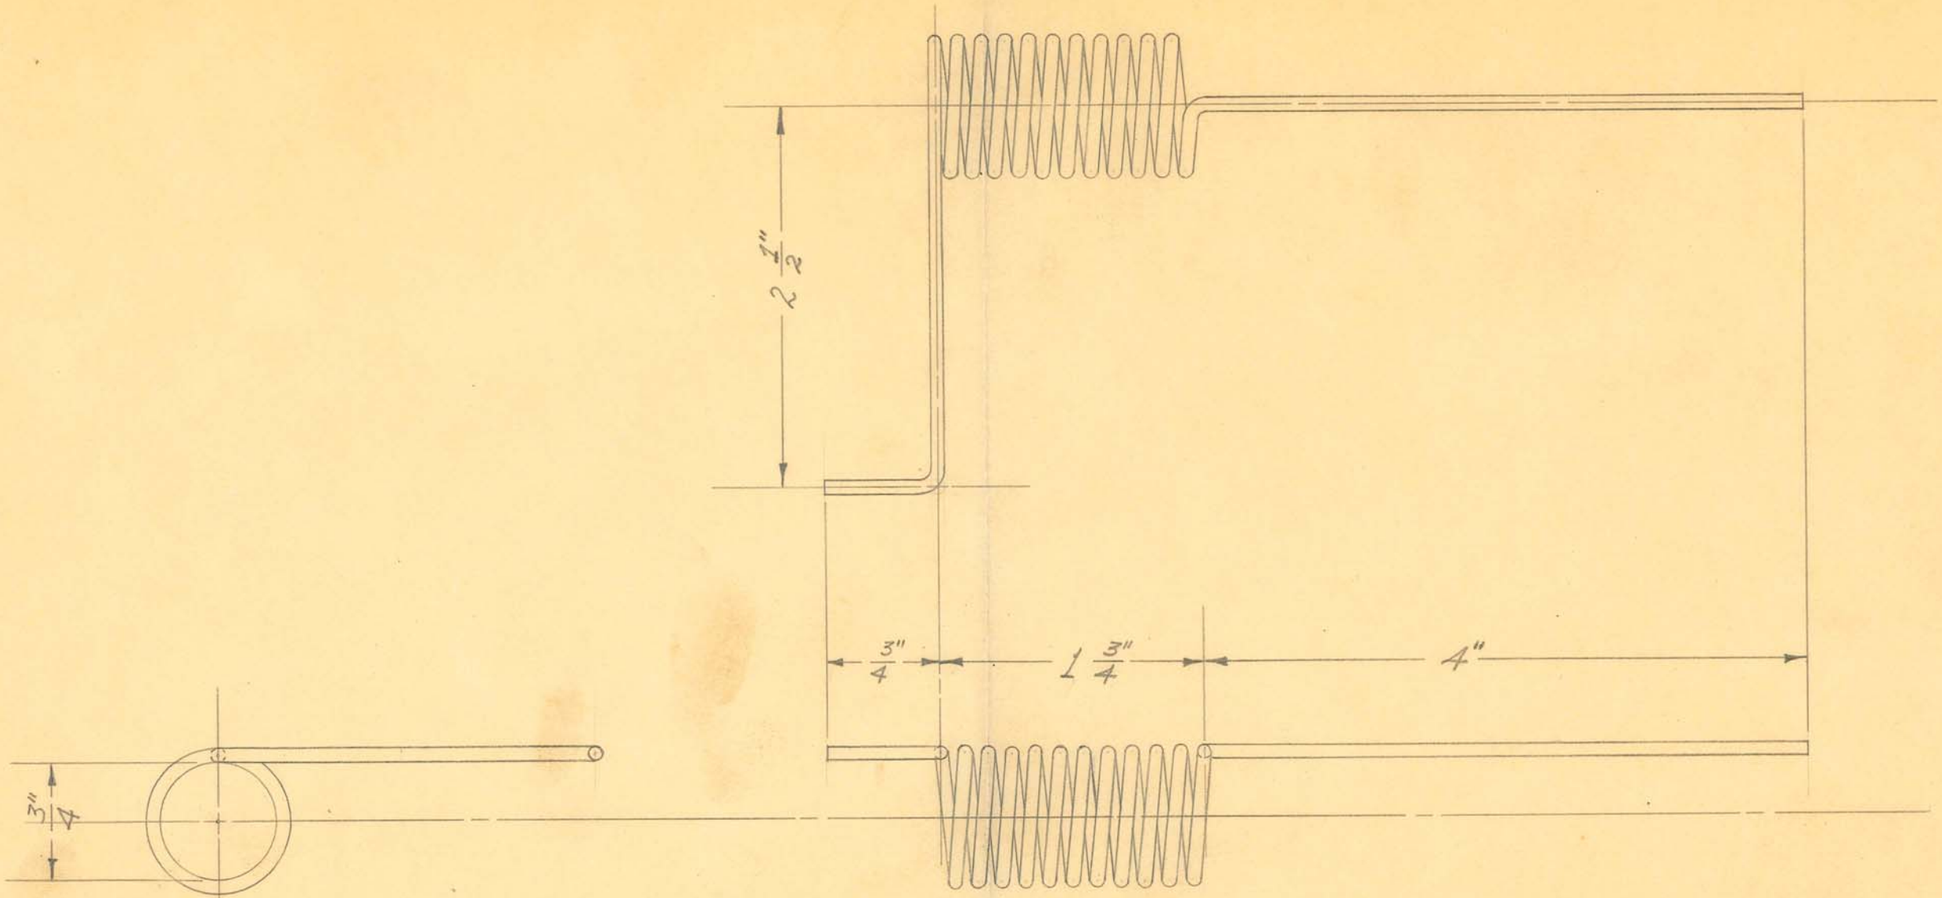

11 TURNS

1 REQUIRED

OBSOLETE

SIZE	#10 TINNED	ISSUE 3-15-39	J.W.
KIND	COPPER WIRE	CHANGED	
SHAPE		"	
FINISH		"	
TEMP.		"	

TITLE: FISCHER MOD. PORT. 3" 6 METER SHORT WAVE PATIENT'S TUNING COIL-LEFT

H. G. FISCHER & CO. 2335 WABANSIA AVE.

CAT. NO.

PART NO. 12557

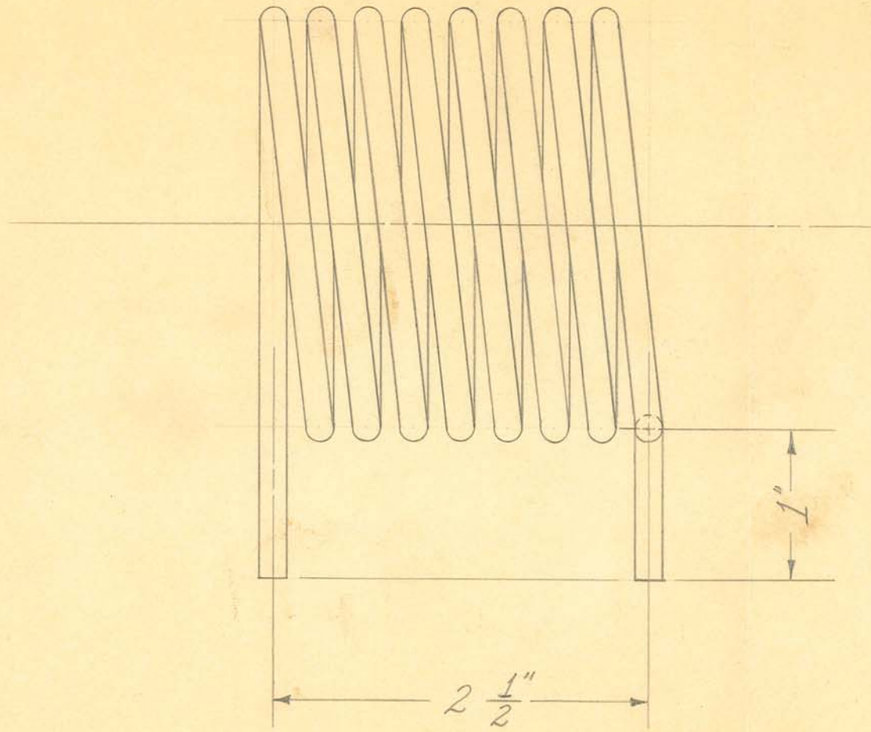

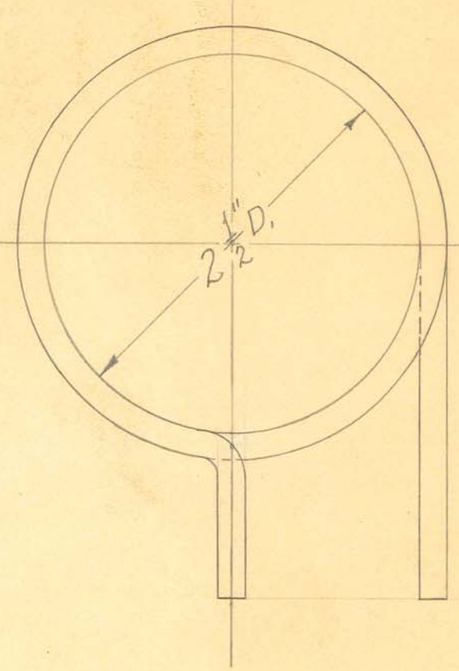

8 TURNS

1 REQUIRED

OBSOLETE

SIZE	#6 BARE	ISSUE 5-5-38	J.W.
KIND	COPPER WIRE	CHANGED	
SHAPE		"	
FINISH		"	
TEMP.		"	
PATT.		"	

TITLE: FISCHER MOD. "6-24-72" SHORT WAVE 24 METER PICKUP COIL - LEFT

H. G. FISCHER & CO.
2335 WABANSIA AVE.
CHICAGO, ILL.

CAT. NO.

PART NO. 11629

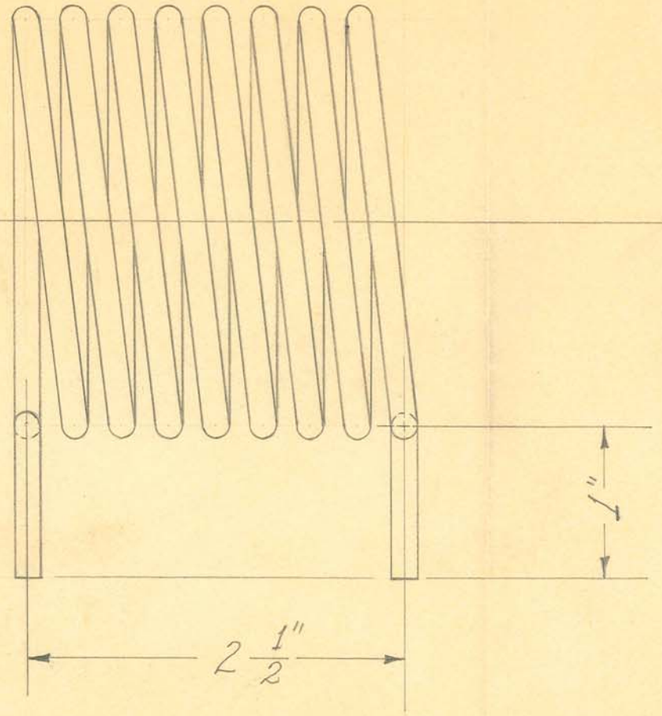

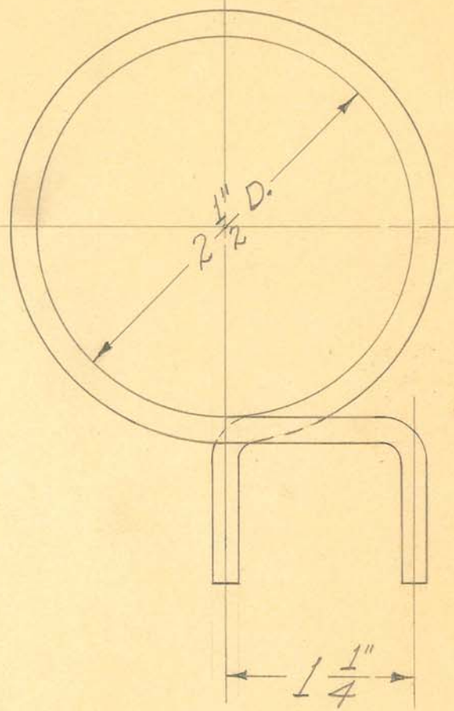

8 TURNS

1 REQUIRED

OBSOLETE

SIZE	#6 BARE	ISSUE	
KIND	COPPER WIRE	CHANGED	
SHAPE		"	
FINISH		"	
TEMP.		"	
PATT.		"	

TITLE: FISCHER MOD. "6-24-72" SHORT WAVE 24 METER PICKUP COIL - RIGHT

H. G. FISCHER & CO.
2335 WABANSIA AVE.
CHICAGO, ILL.

CAT. NO.

PART NO. 11630

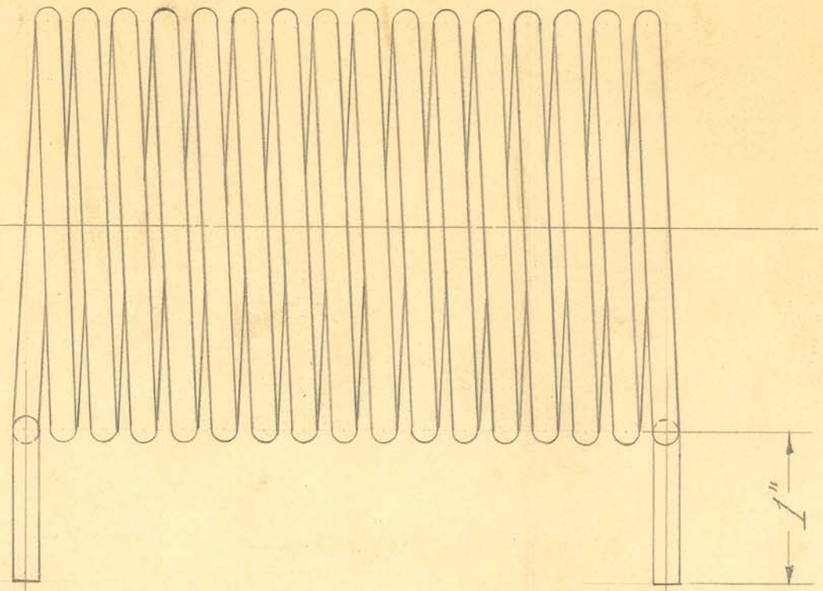

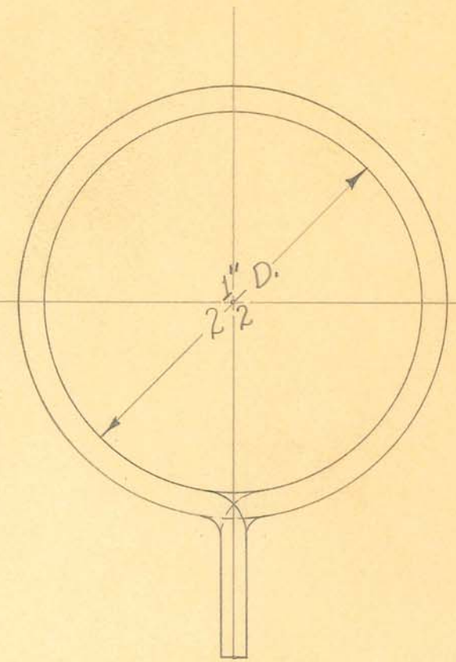

16 TURNS

1 REQUIRED

OBSOLETE

SIZE	#6 BARE	ISSUE 5-5-38	J.W.
KIND	COPPER WIRE	CHANGED	
SHAPE		"	
FINISH		"	
TEMP.		"	
PATT.		"	

TITLE: FISCHER MOD. "6-24-72" SHORT WAVE 24 METER OSCILLATING COIL

H. G. FISCHER & CO.
2335 WABANSIA AVE.
CHICAGO, ILL.

CAT. NO.

PART NO. 11631

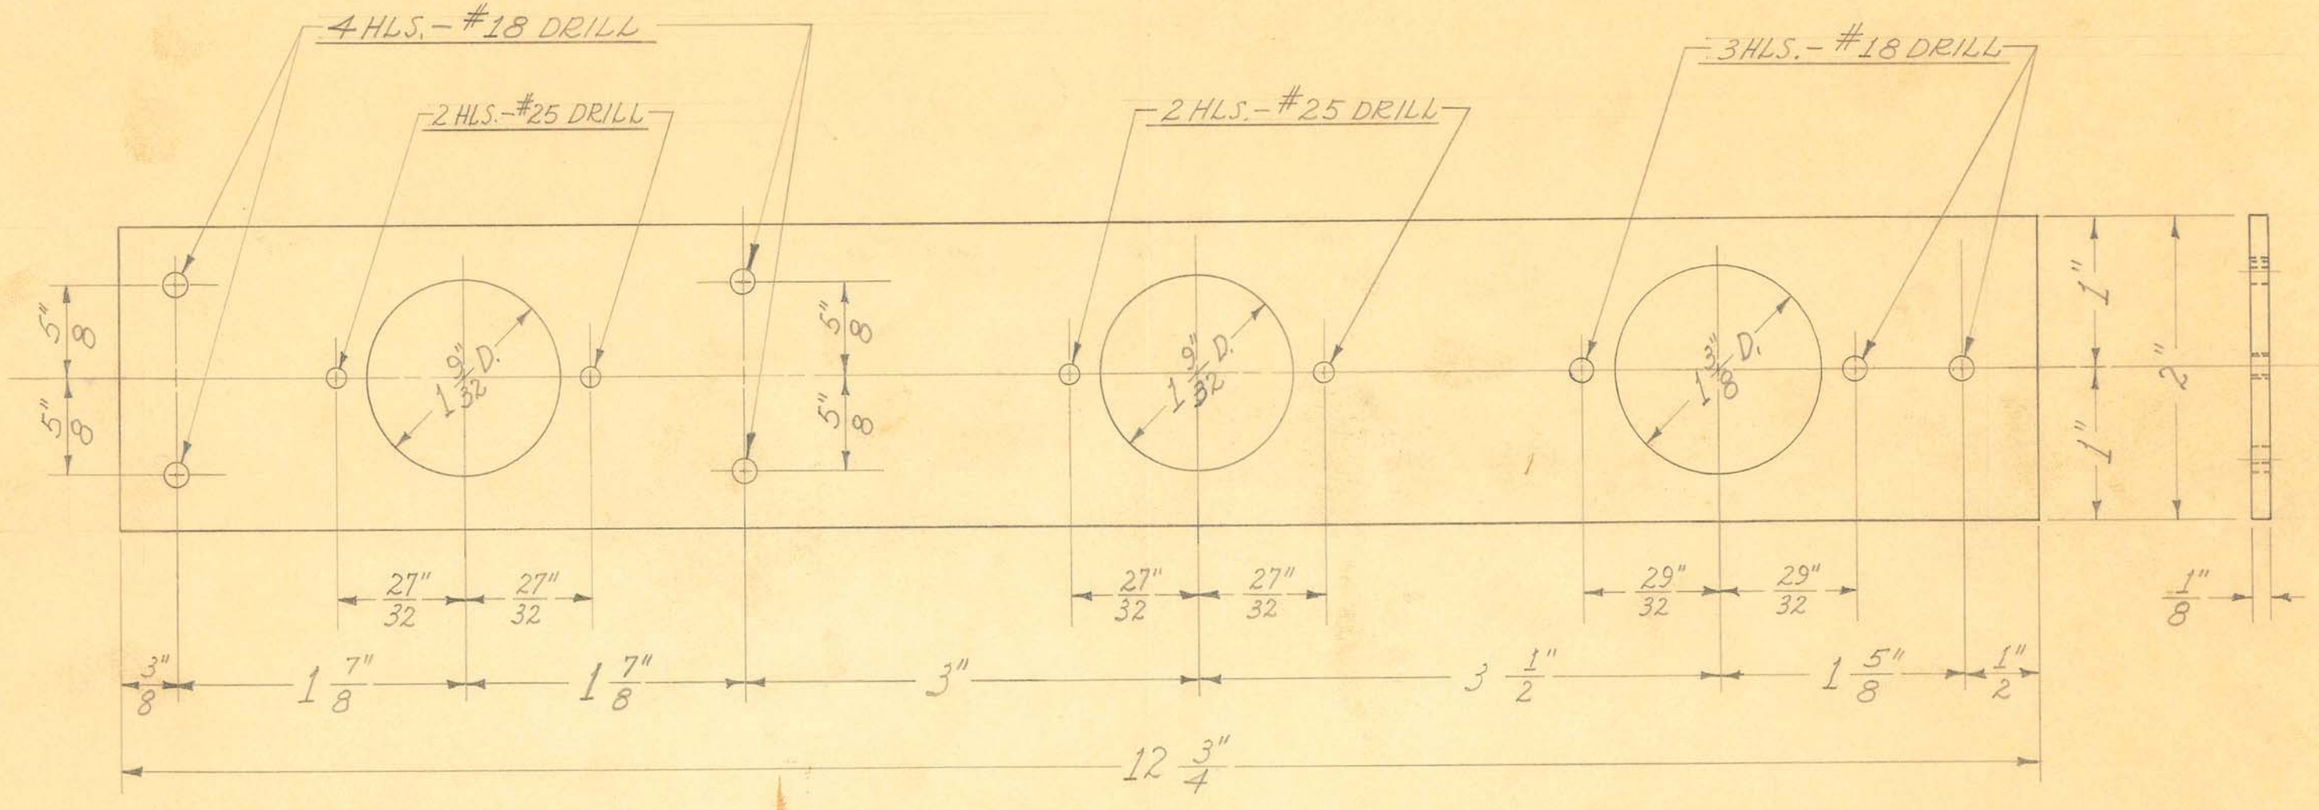

2 REQUIRED

OBSOLETE

SIZE	1/8" SHEET	ISSUE 5-9-38	J.W.
KIND	BAKELITE	CHANGED	
SHAPE		"	
FINISH		"	
TEMP.		"	
PATT.		"	

TITLE: FISCHER MOD. "6-24-72" SHORT WAVE RECTIFYING TUBE MOUNTING BOARD

H. G. FISCHER & CO. 2335 WABANSIA AVE. CHICAGO, ILL.	CAT. NO.	PART NO. 11641

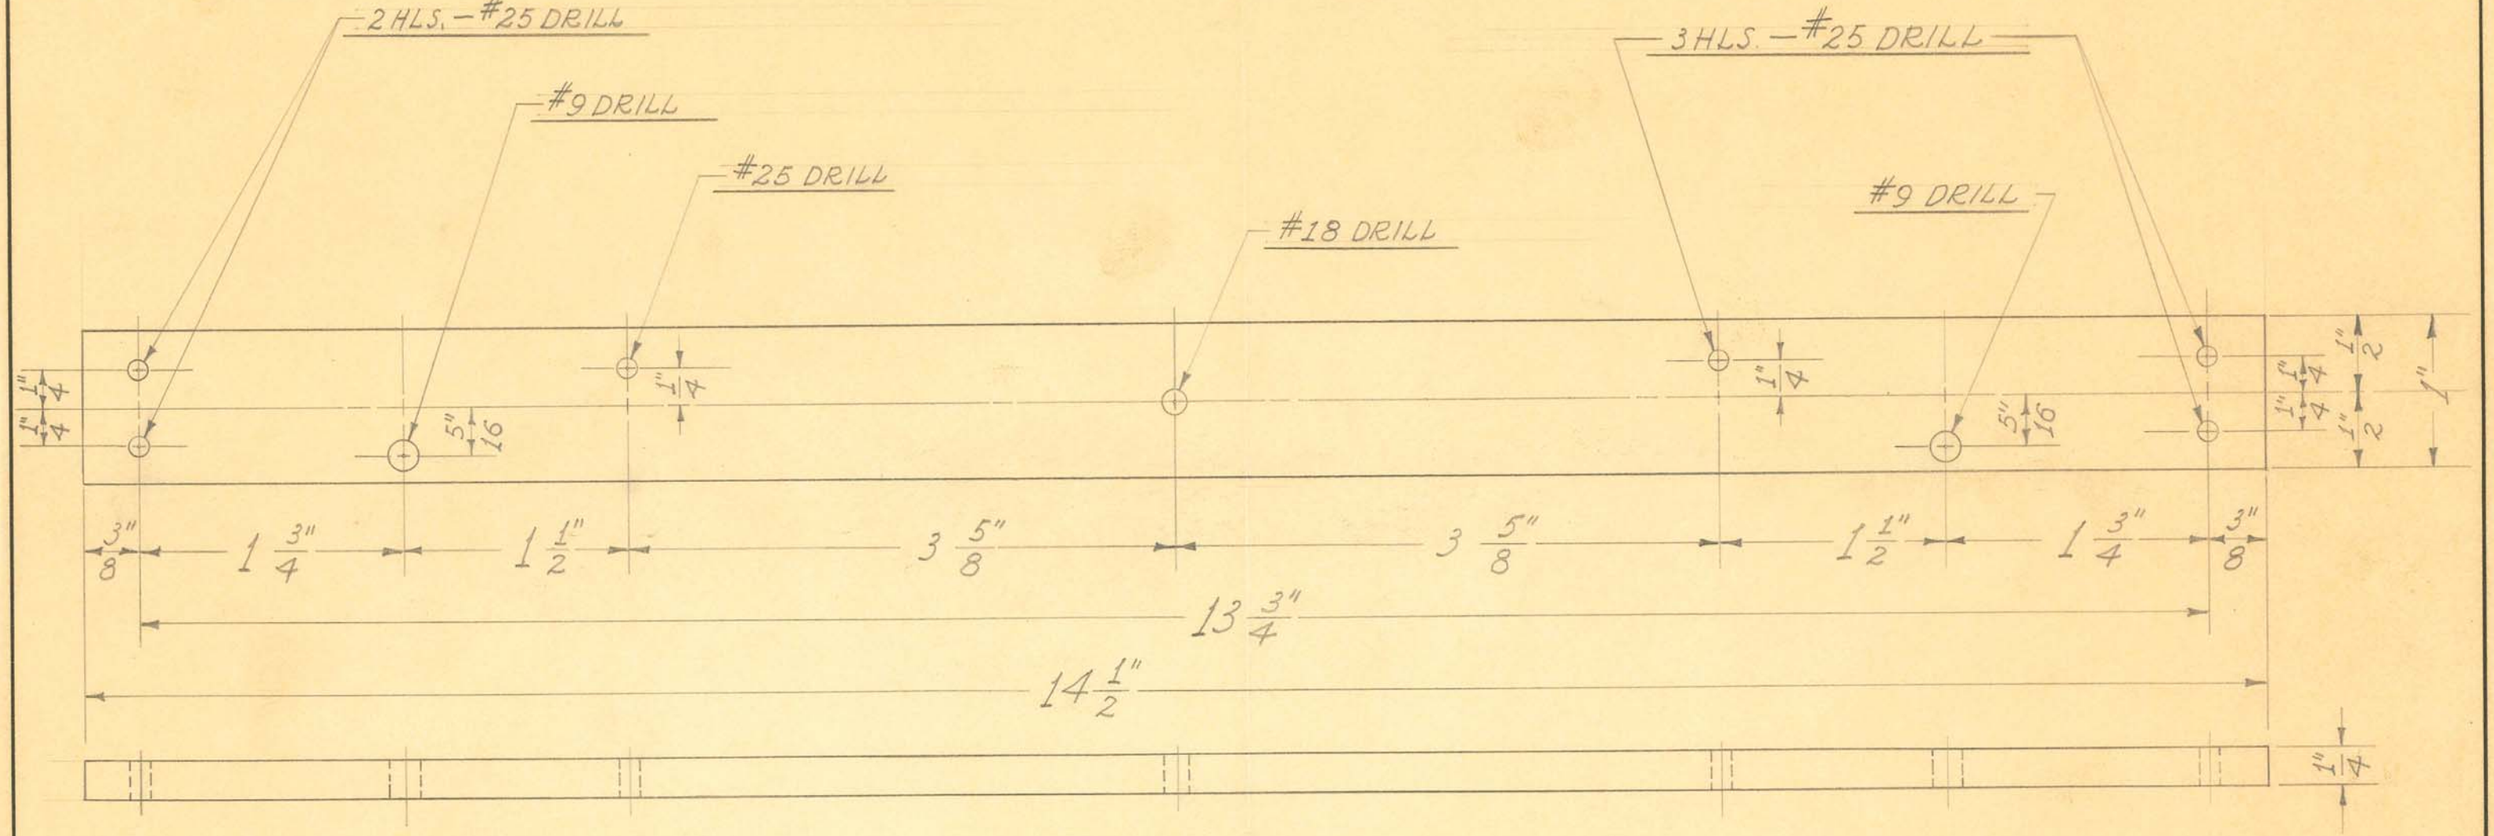

1 REQUIRED

OBSOLETE

SIZE	1/4" SHEET	ISSUE 5-6-38	J.W.	TITLE: FISCHER MOD. "6-24-72" SHORT WAVE 72 METER PLATE COIL MTG. BOARD – FRONT
KIND	BAKELITE	CHANGED		
SHAPE		"		
FINISH		"		
TEMP.		"		
PATT.		"		

H. G. FISCHER & CO.
2335 WABANSIA AVE.
CHICAGO, ILL.

CAT. NO.

PART NO. 11642

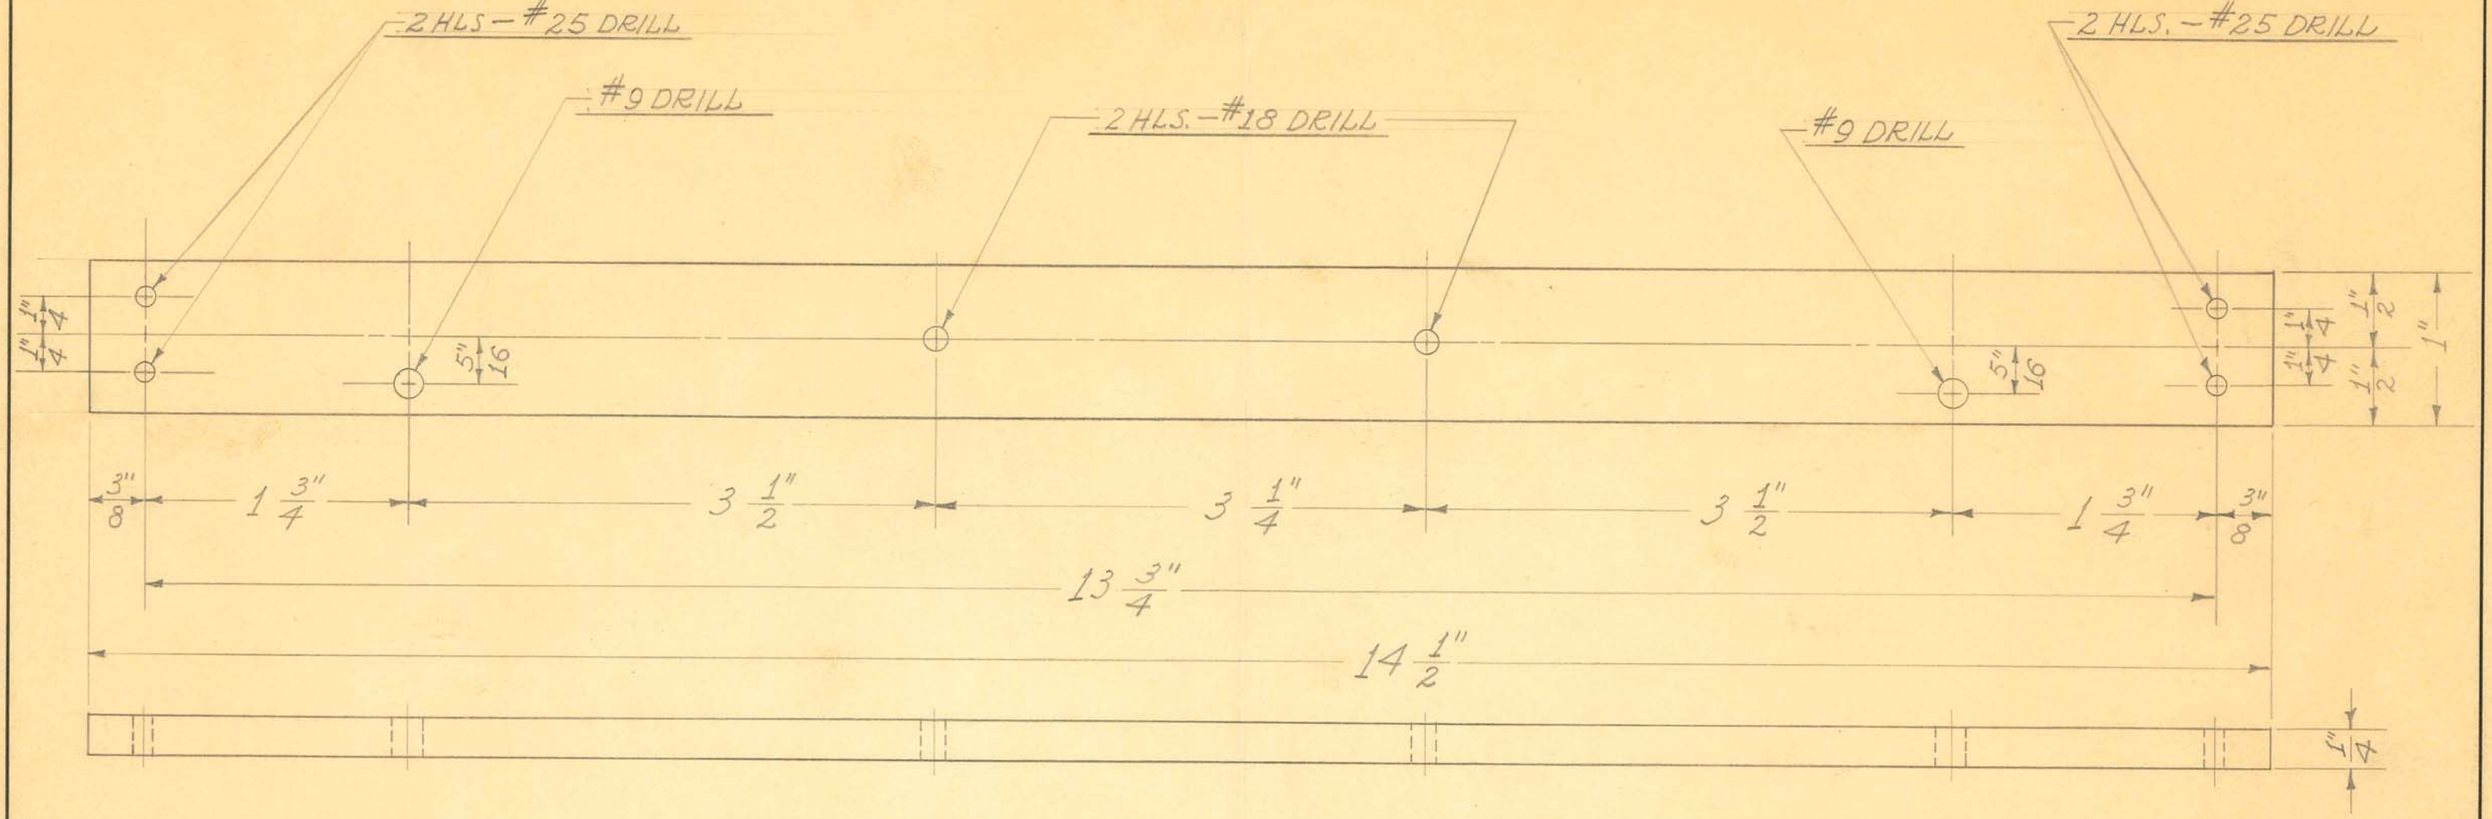

1 REQUIRED

OBSOLETE

SIZE	1/4" SHEET	ISSUE 5-6-38	J.W.	TITLE: FISCHER MOD. "6-24-72" SHORT WAVE 72 METER PLATE COIL MTG BOARD-REAR
KIND	BAKELITE	CHANGED		
SHAPE		"		
FINISH		"		
TEMP.		"		
PATT.		"		

H. G. FISCHER & CO.
2335 WABANSIA AVE.
CHICAGO, ILL.

CAT. NO.

PART NO. 11643

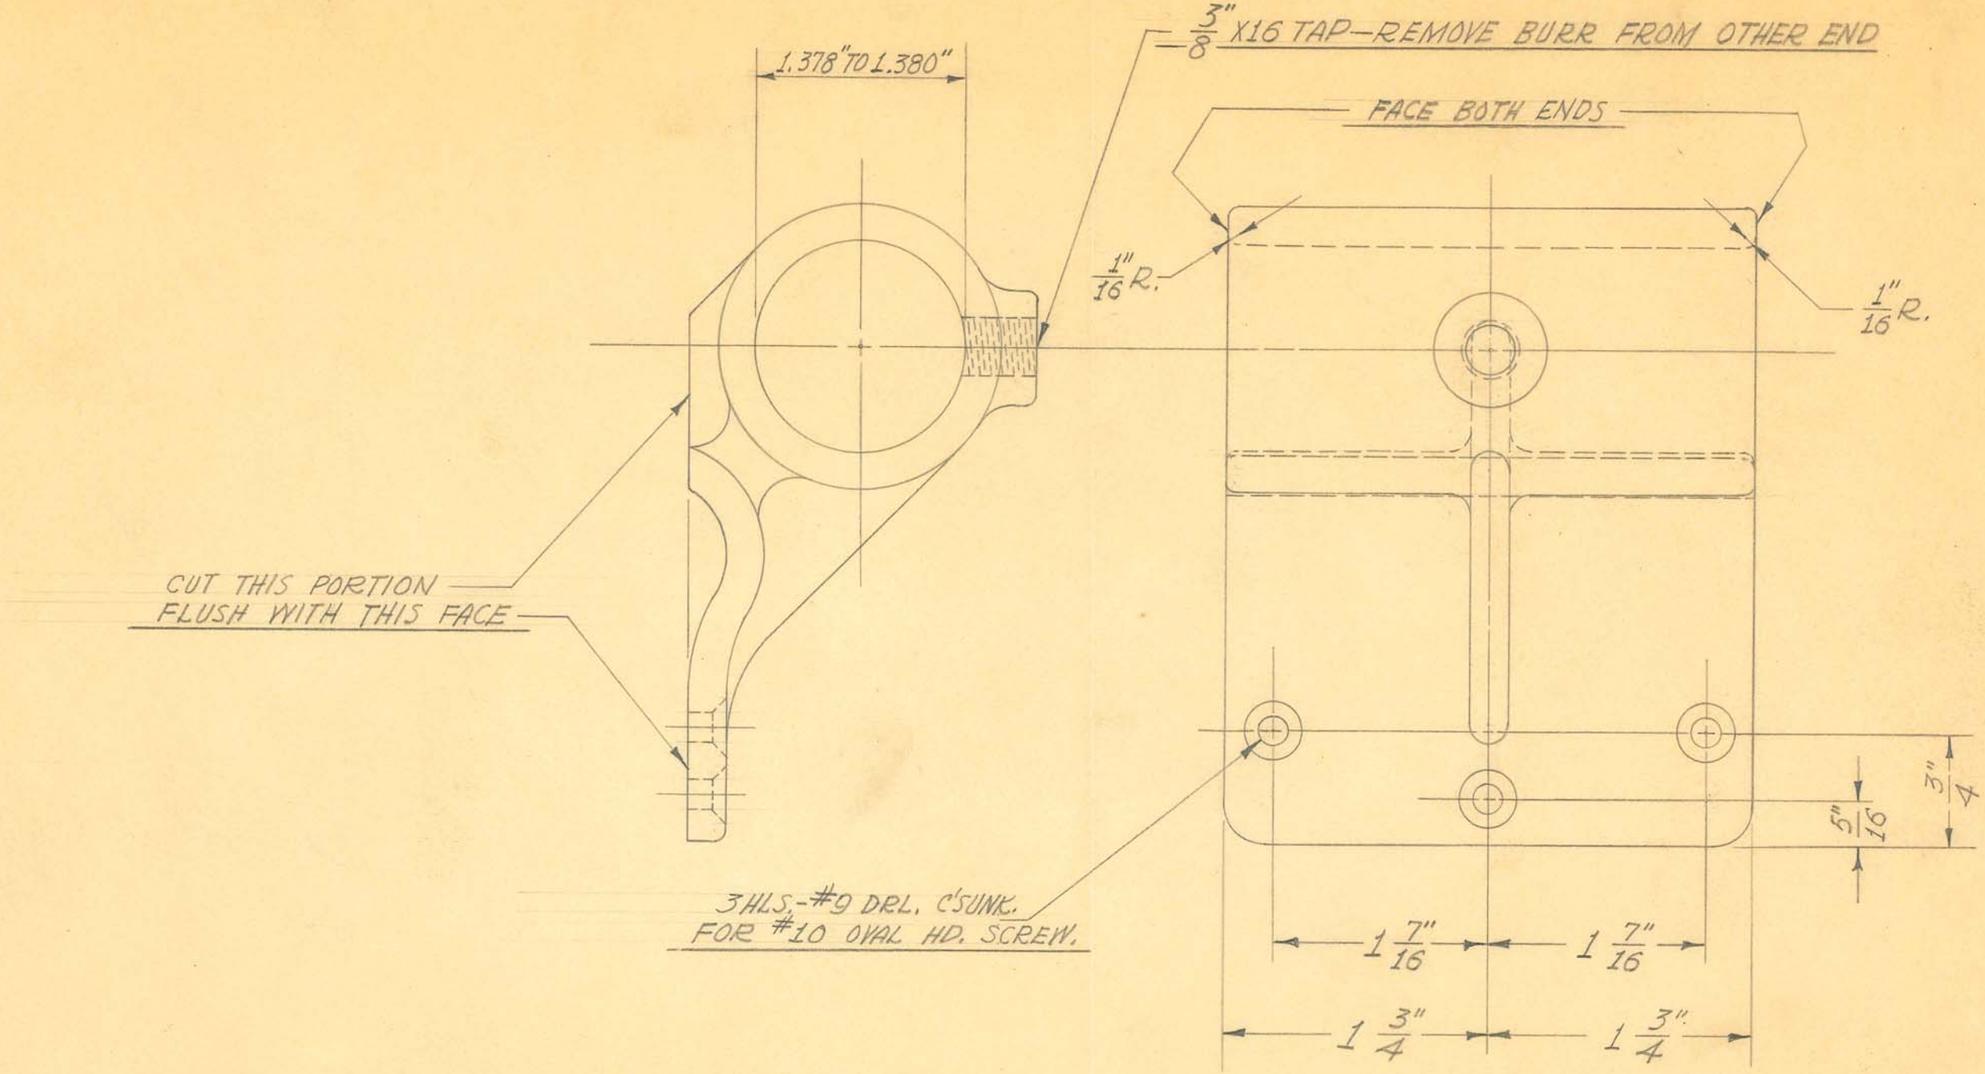

1 REQUIRED

OBSOLETE

SIZE	#214	ISSUE 3-14-39	J.W.
KIND	ALUM. CASTING	CHANGED	
SHAPE		"	
FINISH	PAINTED	"	
TEMP.		"	
PATT.	1264	"	

TITLE: SHORT WAVE INDUCTION COIL ELECT. ARM SUPPORT BRACKET FOR "DE-LUXE" 6-24-72"

H. G. FISCHER & CO.
2335 WABANSIA AVE.
CHICAGO, ILL.

CAT. NO.

PART NO. 11685

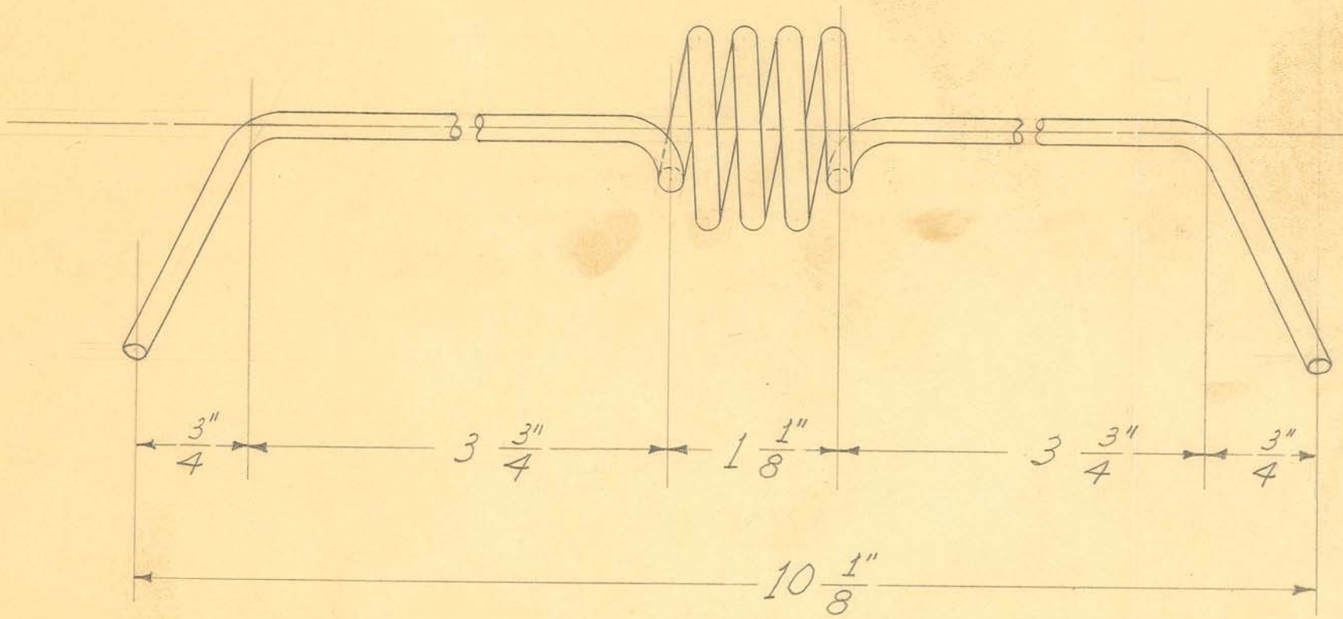

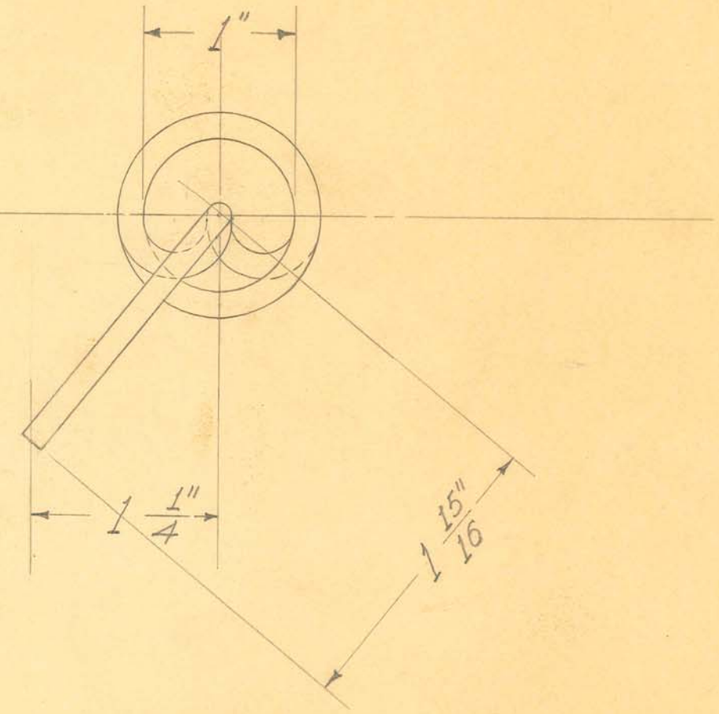

3 1/2 TURNS

1 REQUIRED

OBSOLETE

SIZE	#8 BARE	ISSUE 4-22-38	J.W.	TITLE: FISCHER MOD. "6-24-72" SHORT WAVE 6 METER PICKUP COIL
KIND	COPPER WIRE	CHANGED		
SHAPE		"		
FINISH	SILVER #5	"		
TEMP.		"		
PATT.		"		

H. G. FISCHER & CO.
2335 WABANSIA AVE.
CHICAGO, ILL.

CAT. NO.

PART NO. 11706

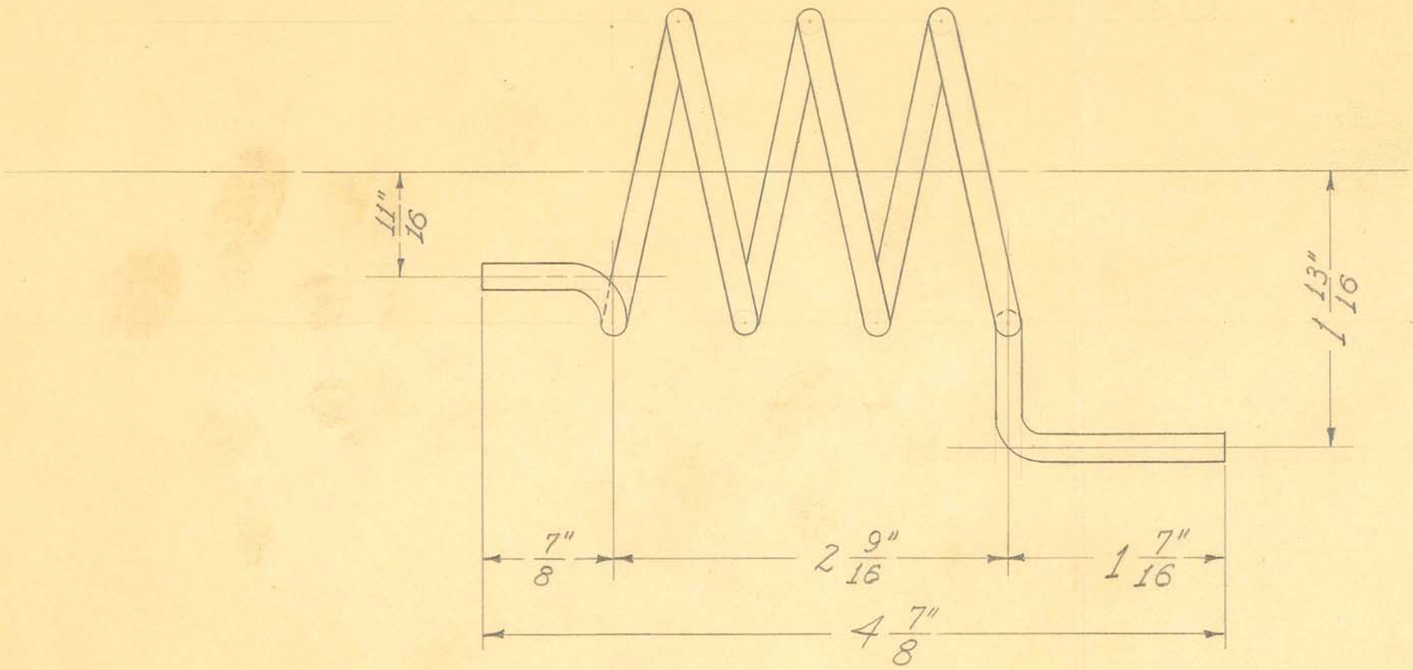

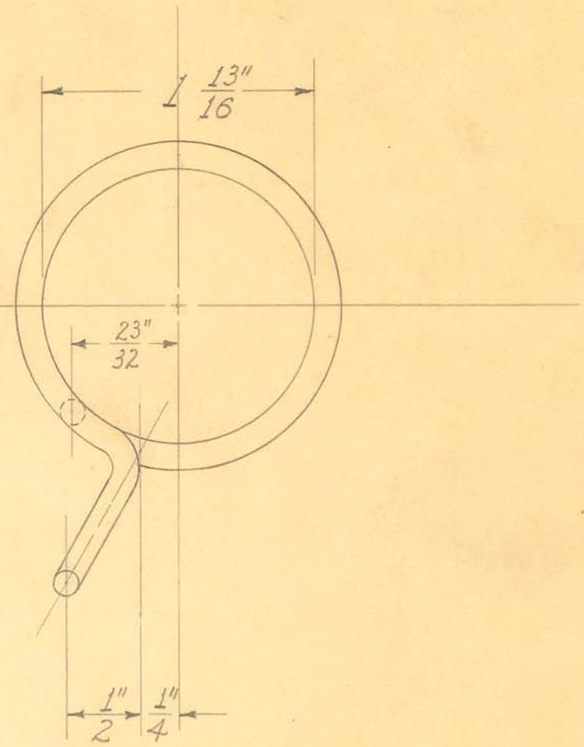

3 TURNS

1 REQUIRED

OBSOLETE

SIZE	#6 BARE	ISSUE 4-22-38	J.W.	TITLE: FISCHER MOD. "6-24-72" SHORT WAVE 6 METER OSCILLATING COIL-LEFT
KIND	COPPER WIRE	CHANGED		
SHAPE		"		
FINISH	SILVER #5	"		
TEMP.		"		
PATT.		"		

H. G. FISCHER & CO.
2335 WABANSIA AVE.
CHICAGO, ILL.

CAT. NO.

PART NO. 11710

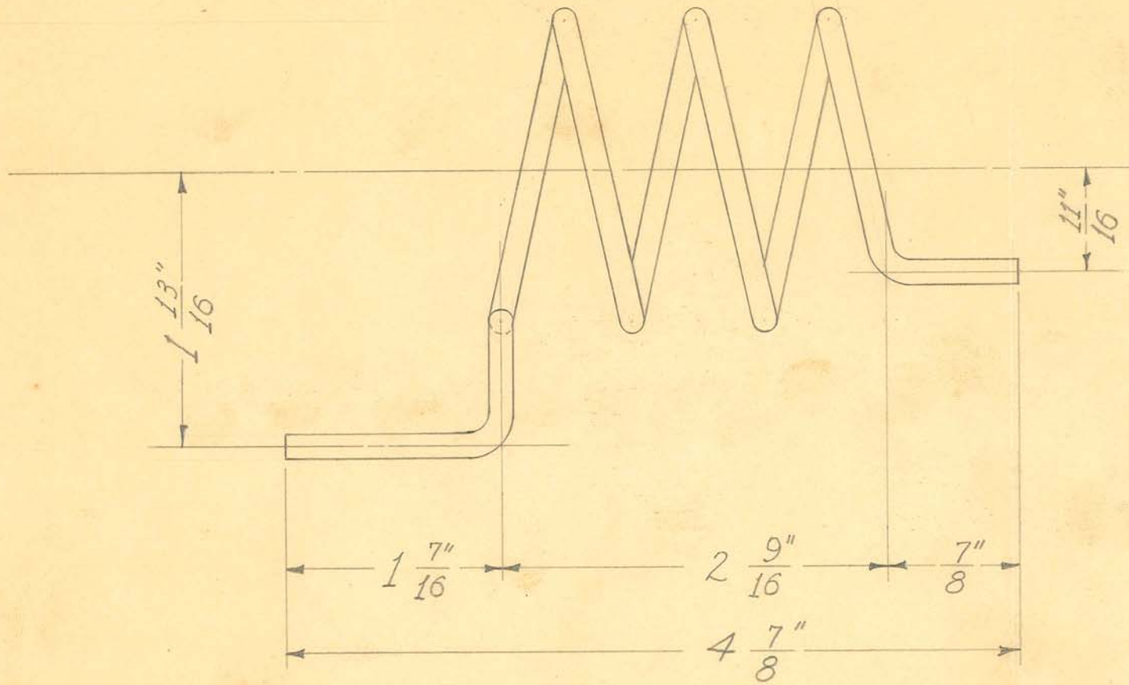

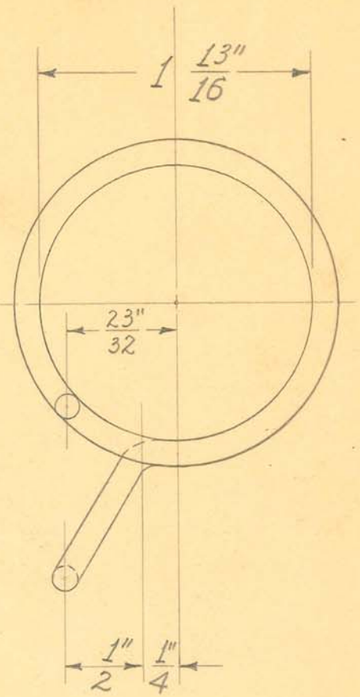

3 TURNS

1 REQUIRED

OBSOLETE

SIZE	#6 BARE	ISSUE 4-22-38	J.W.
KIND	COPPER WIRE	CHANGED	
SHAPE		"	
FINISH	SILVER #5	"	
TEMP.		"	
PATT.		"	

TITLE: FISCHER MOD. "6-24-72" SHORT WAVE 6 METER OSCILLATING COIL-RIGHT

H. G. FISCHER & CO.
2335 WABANSIA AVE.
CHICAGO, ILL.

CAT. NO.

PART NO. 11711

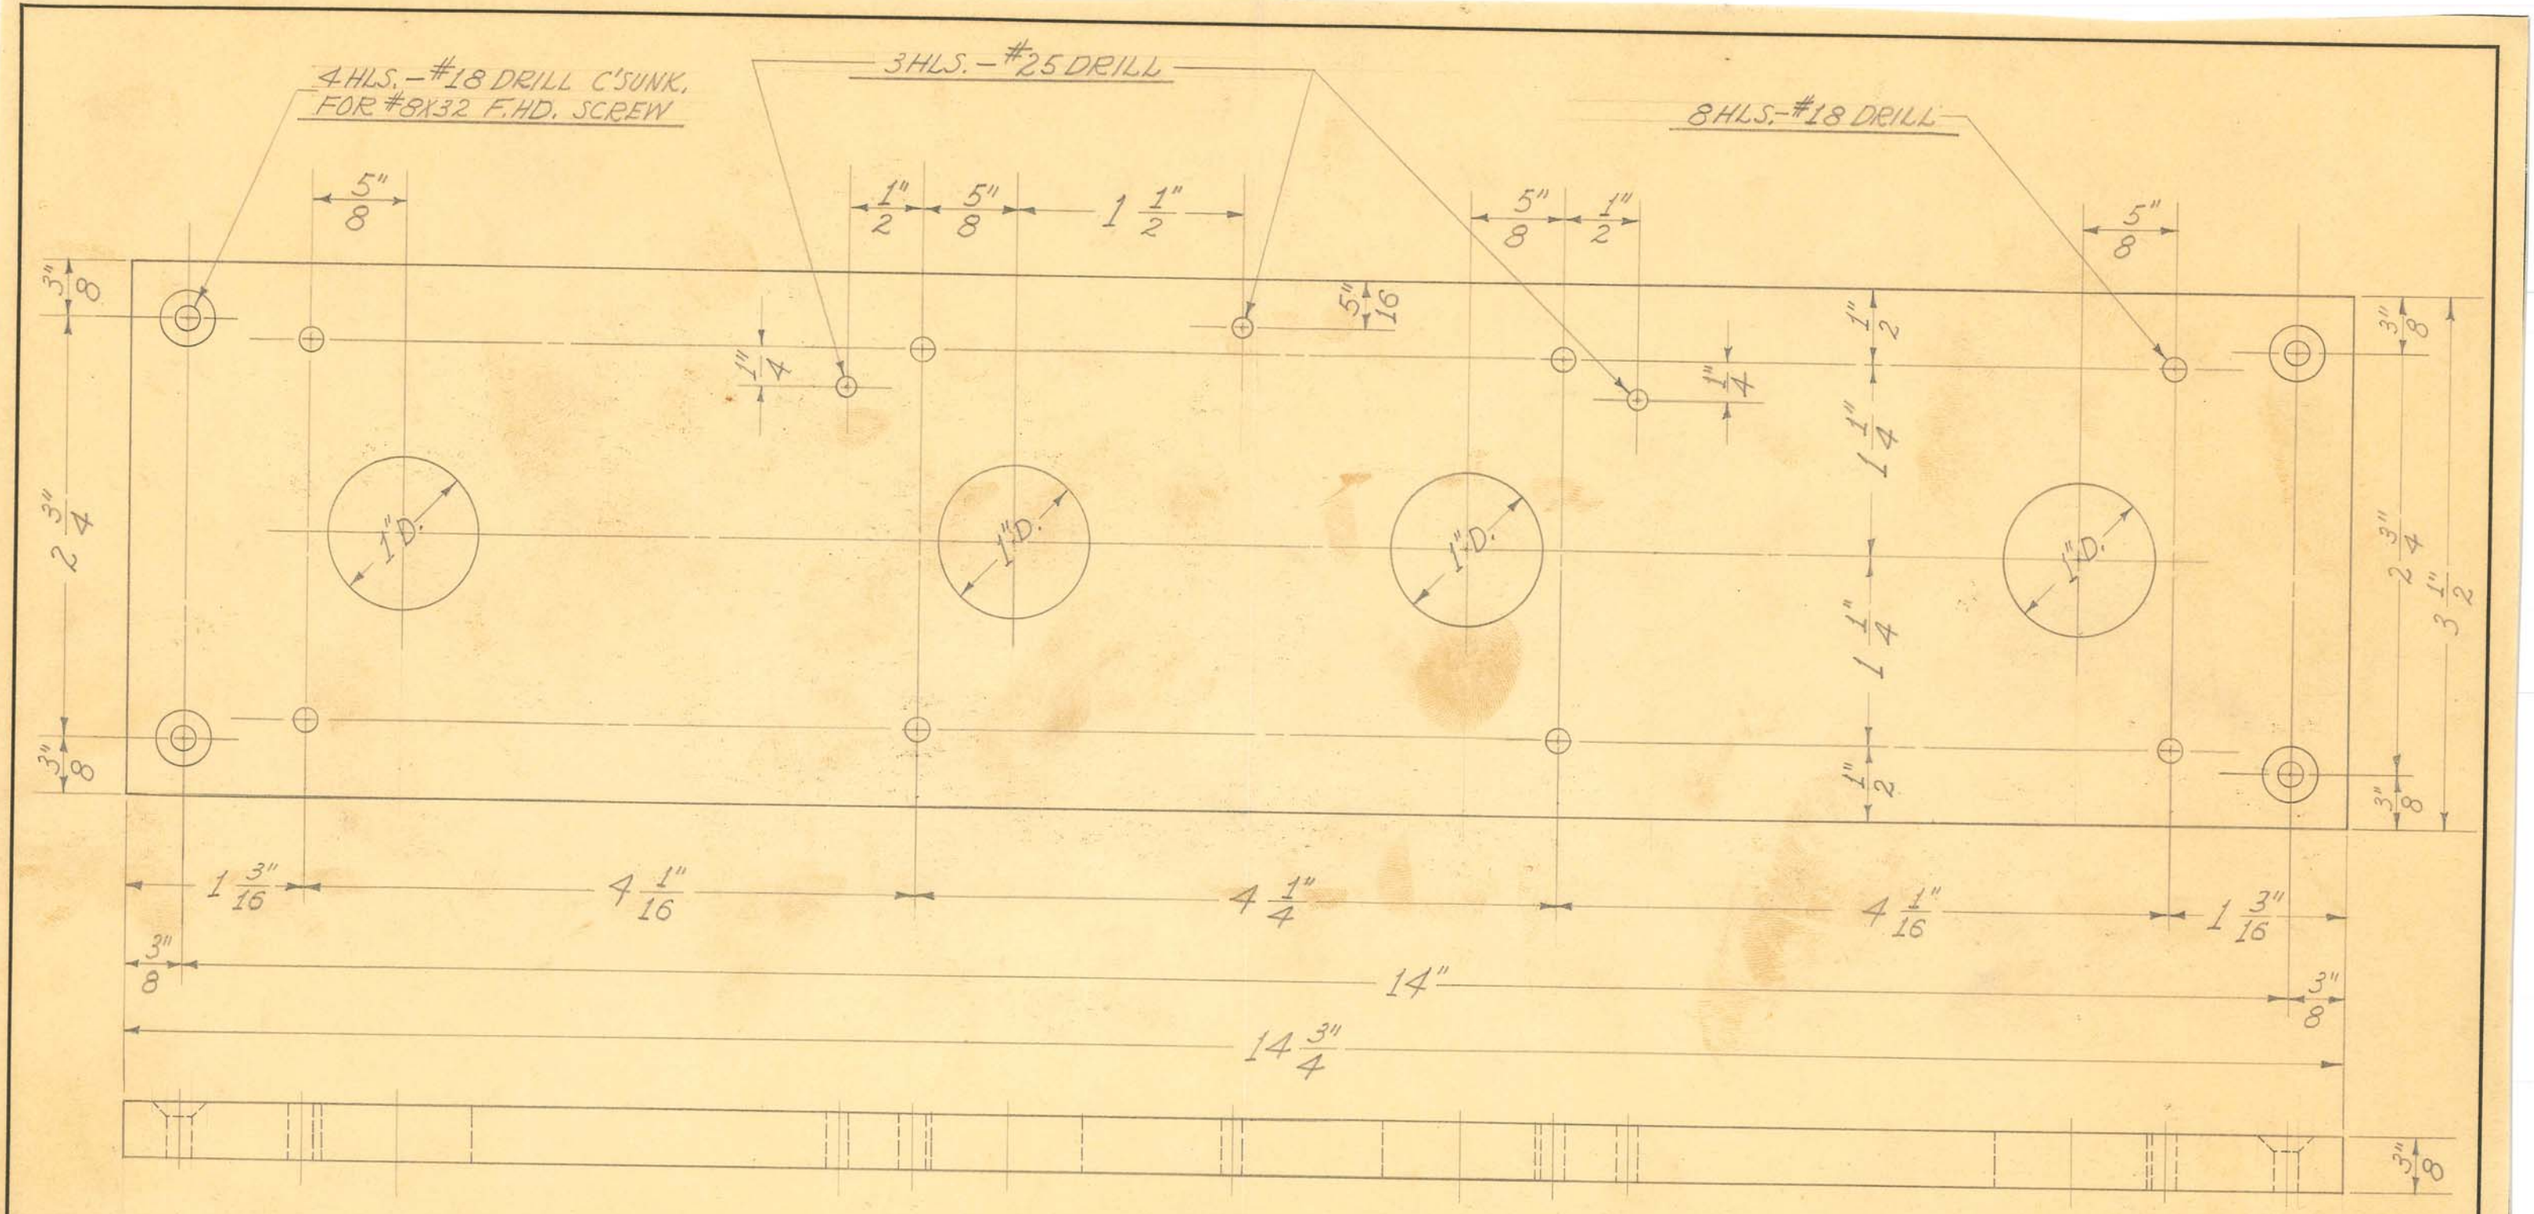

1 REQUIRED

OBSOLETE

SIZE	3/16" SHEET	ISSUE 4-27-38	J.W.	
KIND	BAKELITE	CHANGED		
SHAPE		"		
FINISH		"		
TEMP.		"		
PATT.		"		

TITLE:
FISCHER MOD. "6-24-72" SHORT WAVE METER CHANGING SWITCH MTG. BASE

H. G. FISCHER & CO.
2335 WABANSIA AVE.
CHICAGO, ILL.

CAT. NO.

PART NO. 11714

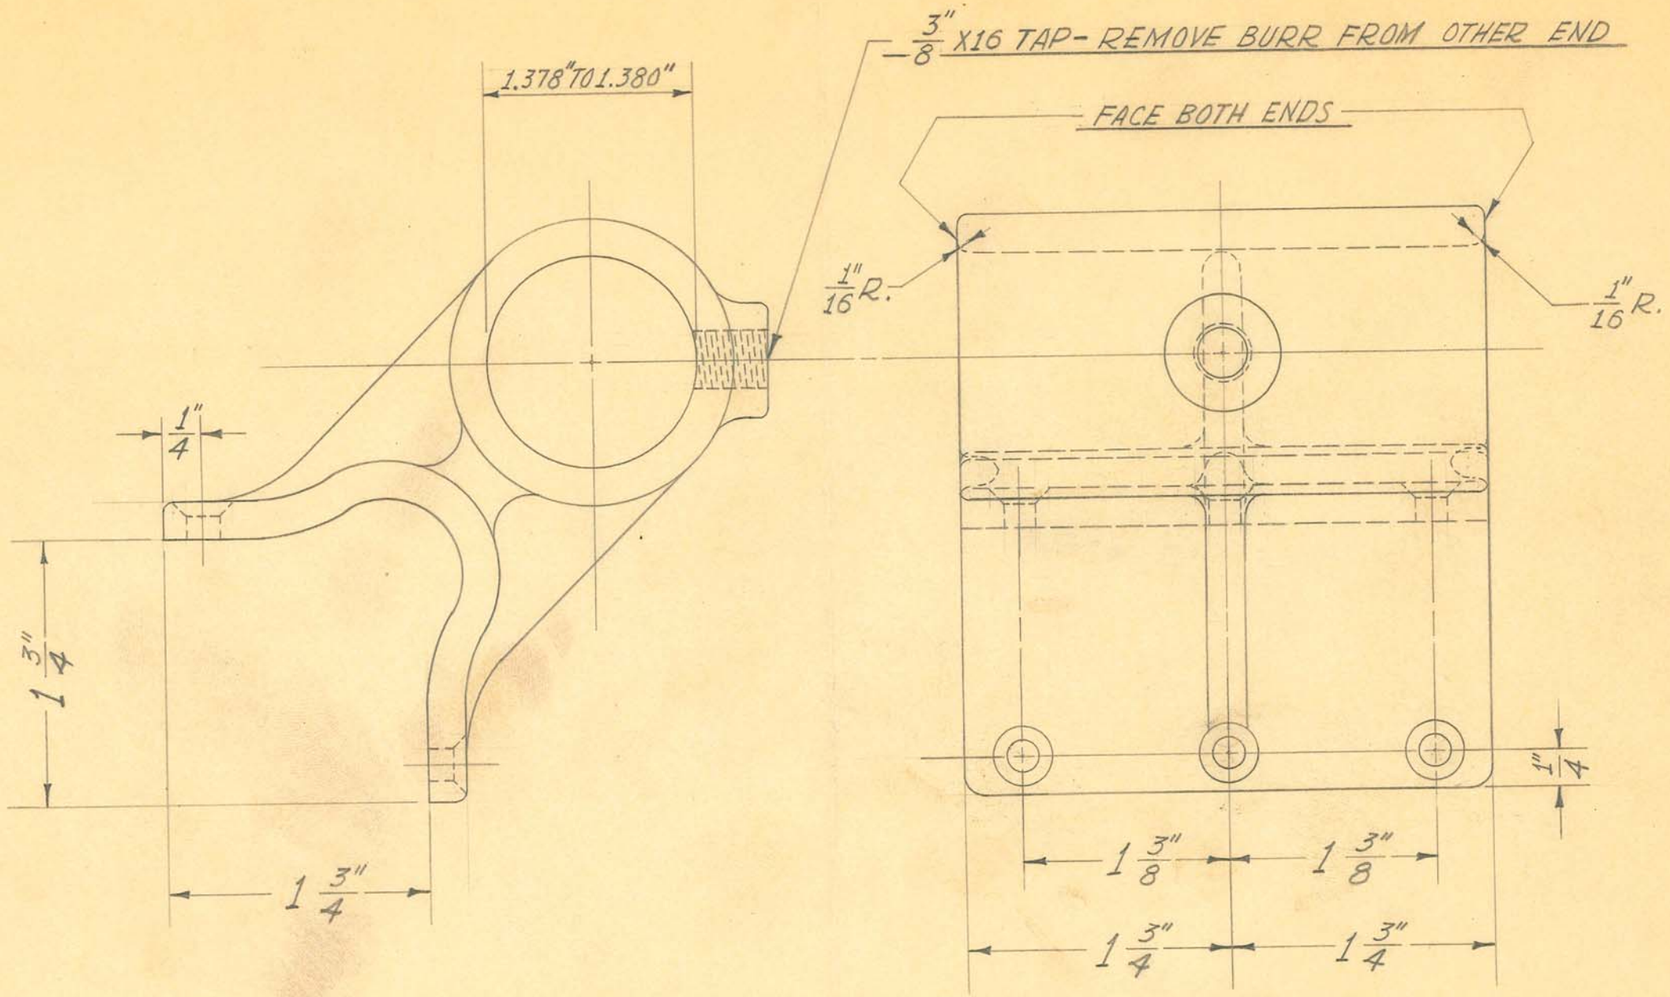

1 REQUIRED

OBSOLETE

SIZE	#214	ISSUE 1-26-39	J.W.
KIND	ALUM. CASTING	CHANGED	
SHAPE		"	
FINISH		"	
TEMP.		"	
PATT.	1264	"	

TITLE: FISCHER MOD. "6-24-72" SHORT WAVE INDUCTION COIL ELECT. ARM SUPP. BRACKET

H. G. FISCHER & CO.
2335 WABANSIA AVE.
CHICAGO, ILL.

CAT. NO.

PART NO. 11726

TITLE

FISCHER ADJUSTABLE INDUCTION ELECTRODE COIL ~ RIGHT

H. G. FISCHER & CO.
FRANKLIN PARK, ILLINOIS

DATE 10-22-48 | DR. BY J.B.G. | CH'K'D. J.V.W.

PART NO. 16205

REVISION	DATE	BY

PATTERN | FINISH | SCALE FULL

TOOLS BENDING FIXTURE TOOL #9881

MATERIAL #8 GA.(.1285") BARE COPPER WIRE

DIMENSIONS UNLESS OTHERWISE SPECIFIED
FRACTIONAL ±.015
DECIMAL ±.005
ANGULAR ±½°

1-27-50 OBSOLETE

OBSOLETE

DEVELOPED LENGTH ~ 14 3/8"

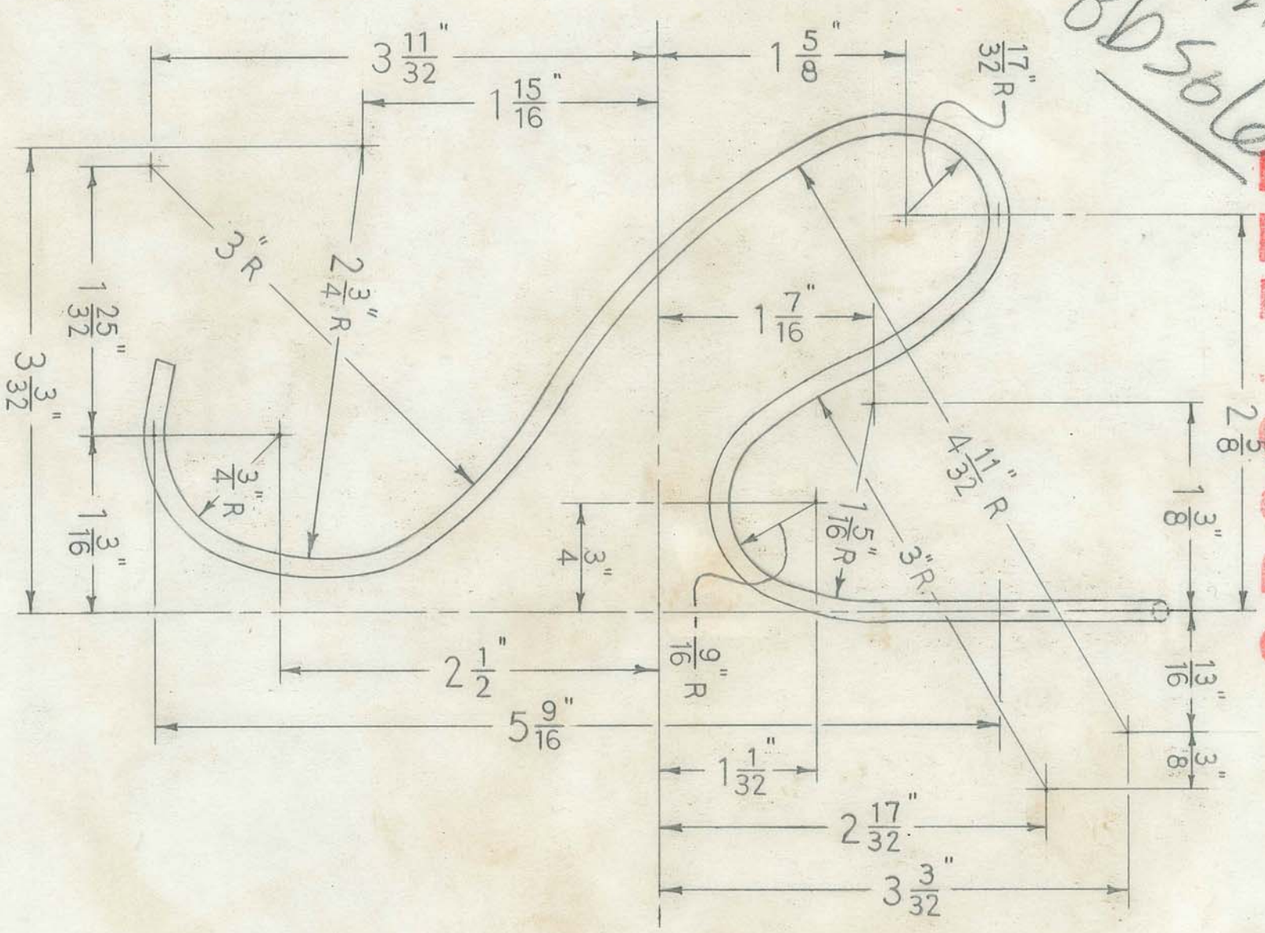

1-REQUIRED

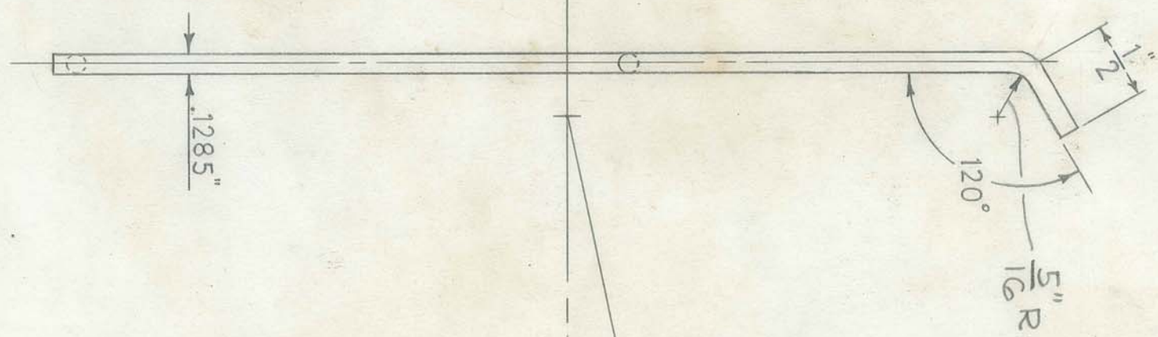

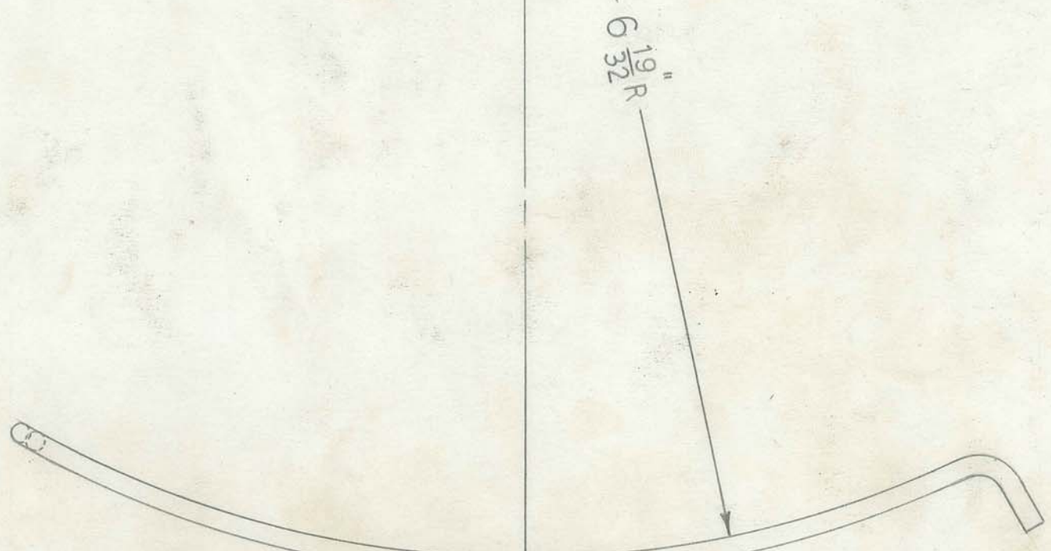

BENDING FIXTURE TOOL #9881

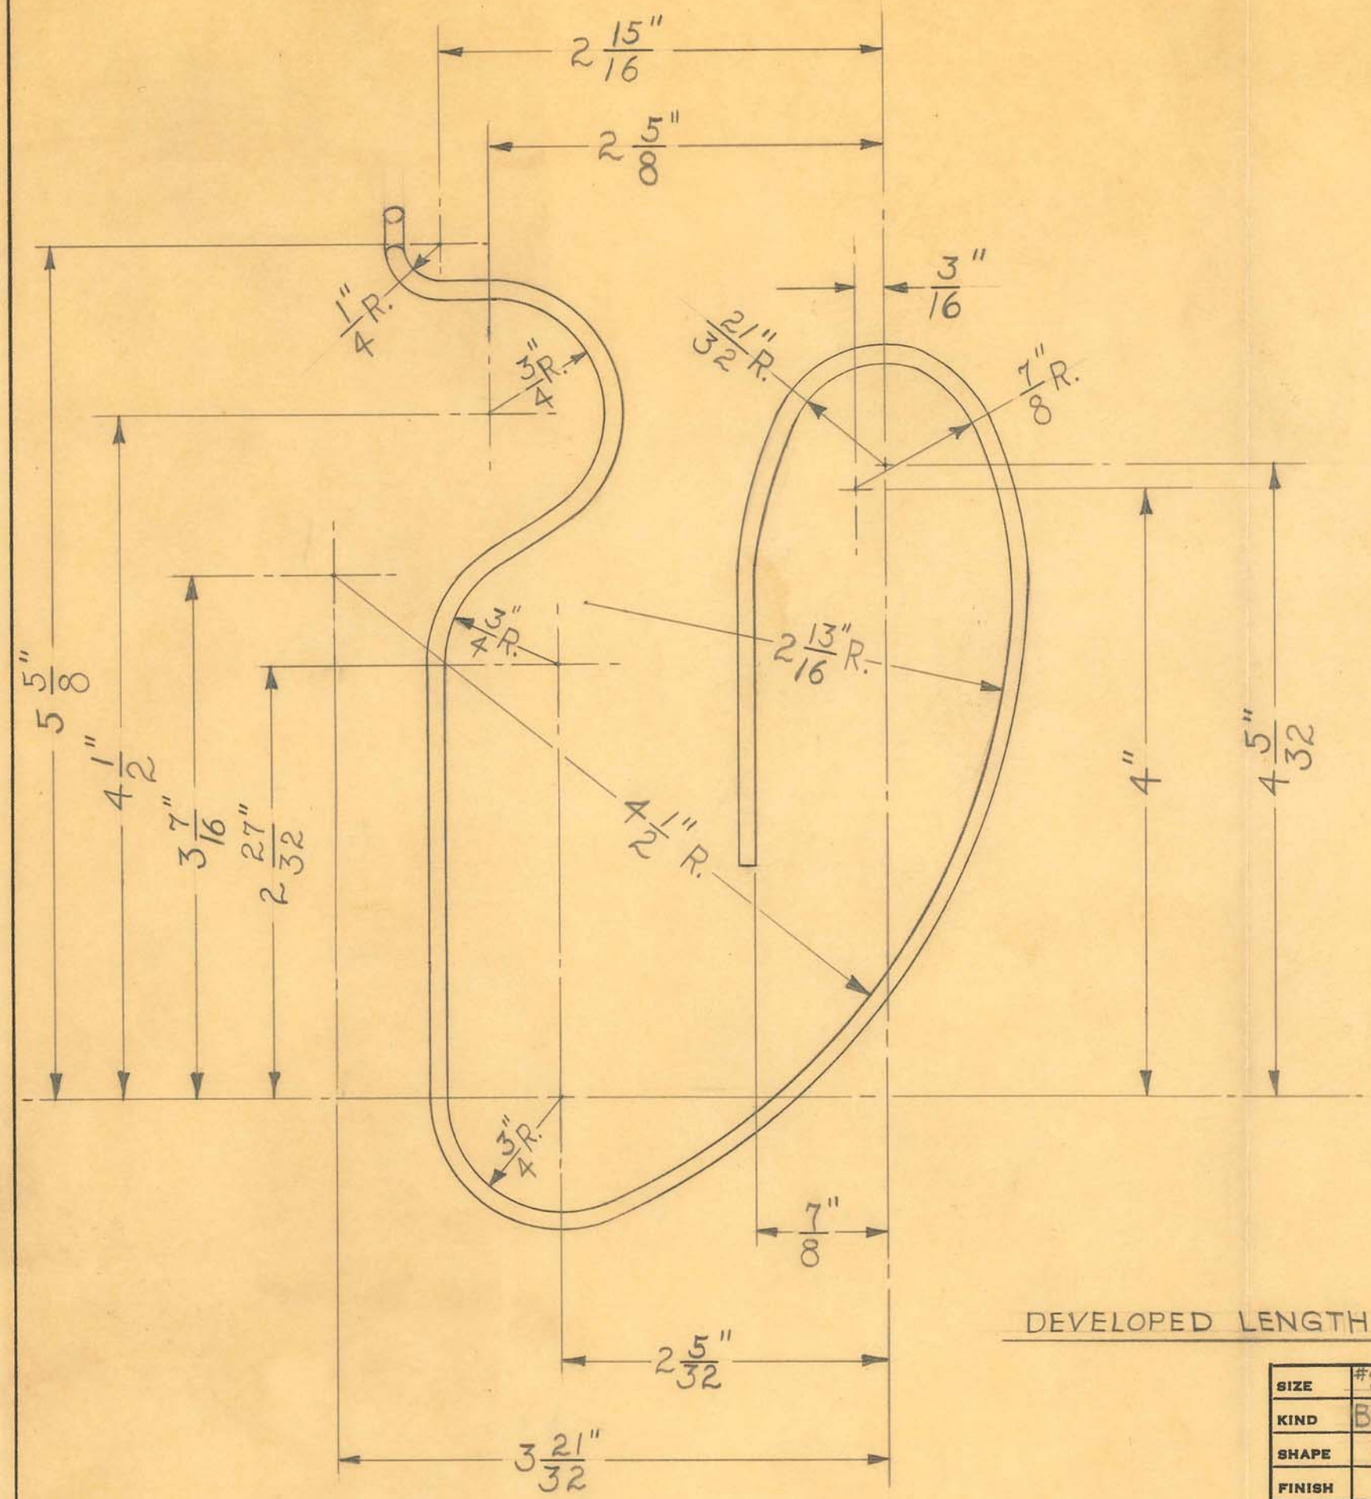

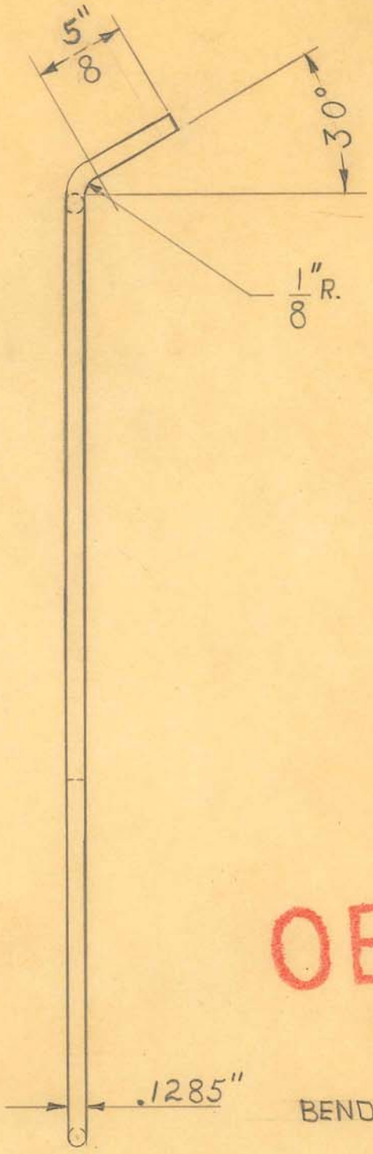

OBSOLETE

BENDING FIXTURE #9223

DEVELOPED LENGTH ~ 20 1/2"

1 REQUIRED

Obsolete

SIZE	#8GA.(.1285)	ISSUE 7-23-47	W.J.
KIND	BARE COPPER	CHANGED	
SHAPE	WIRE	"	
FINISH		"	
TEMP.		"	

TITLE: FISCHER ADJUSTABLE INDUCTION ELECTRODE COIL ~ RIGHT

H. G. FISCHER & CO. 2335 WABANSIA AVE.

CAT. NO.

PART NO. 16196 A

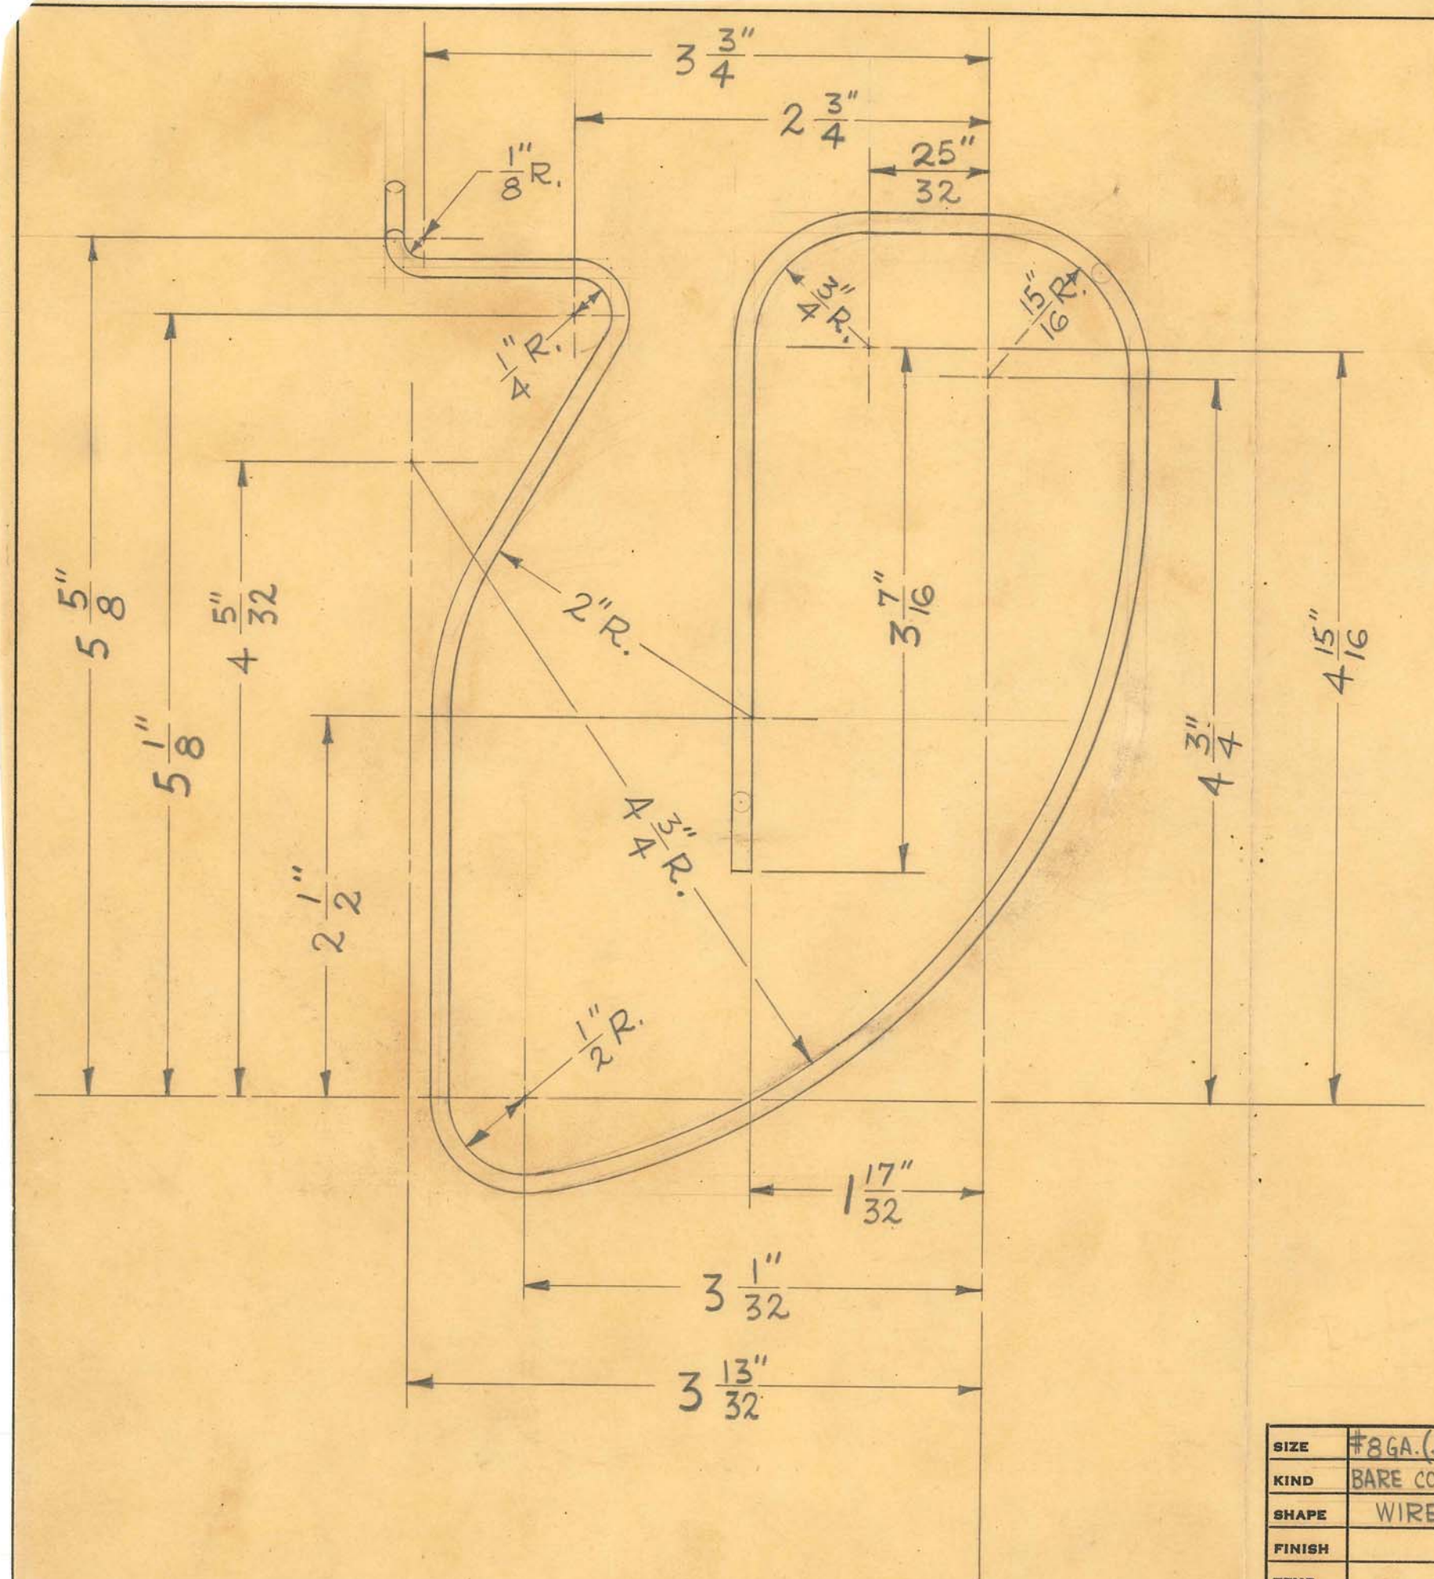

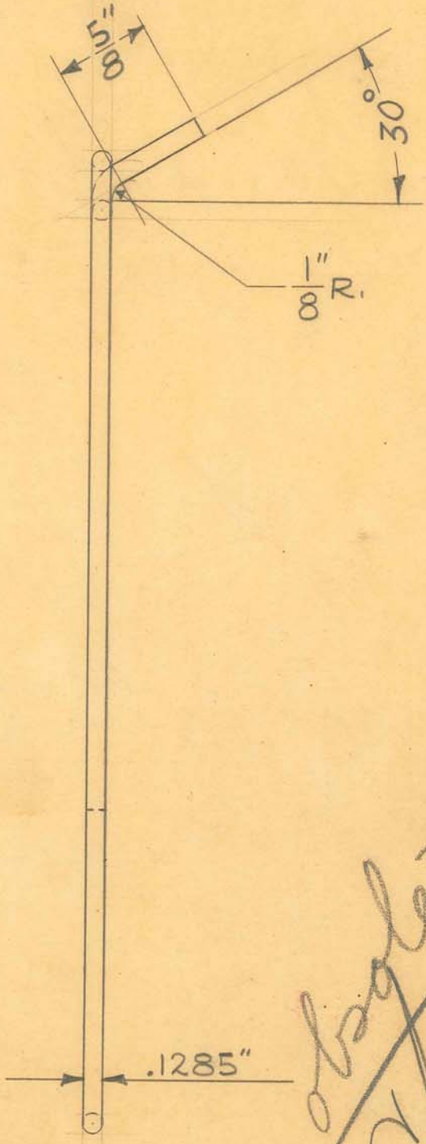

Obsolete Change

OBSOLETE

1 REQUIRED

SIZE	#8 GA. (.1285")	ISSUE 3-21-47	J.V.W.
KIND	BARE COPPER	CHANGED	
SHAPE	WIRE	"	
FINISH		"	
TEMP.		"	

TITLE: FISCHER ADJUSTABLE INDUCTION ELECTRODE COIL-RIGHT

H. G. FISCHER & CO. 2335 WABANSIA AVE. | CAT. NO. | PART NO. 16186

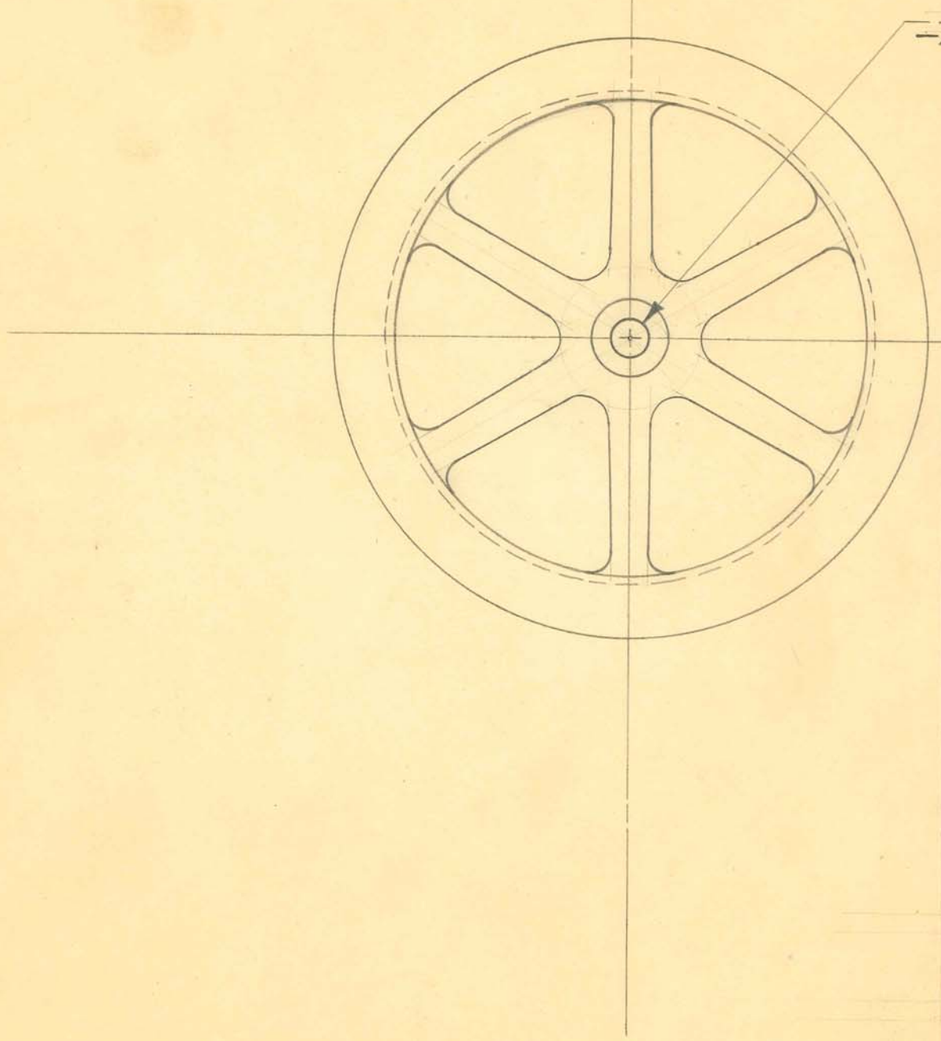

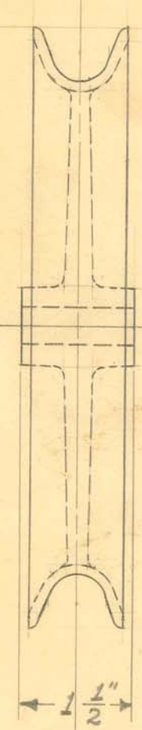

SCALE ~ 1" = 1"

2 REQUIRED

OBSOLETE

SIZE		ISSUE 5-10-40	J.W.	TITLE: FISCHER WALL BRACKET THERA. LAMP PULLEY
KIND	ALUM.	CHANGED		
SHAPE		"		
FINISH	PAINTED	"		
TEMP.		"		
PATT.	308	"		

H. G. FISCHER & CO.
2335 WABANSIA AVE.
CHICAGO, ILL.

CAT. NO.

PART NO. 3829F

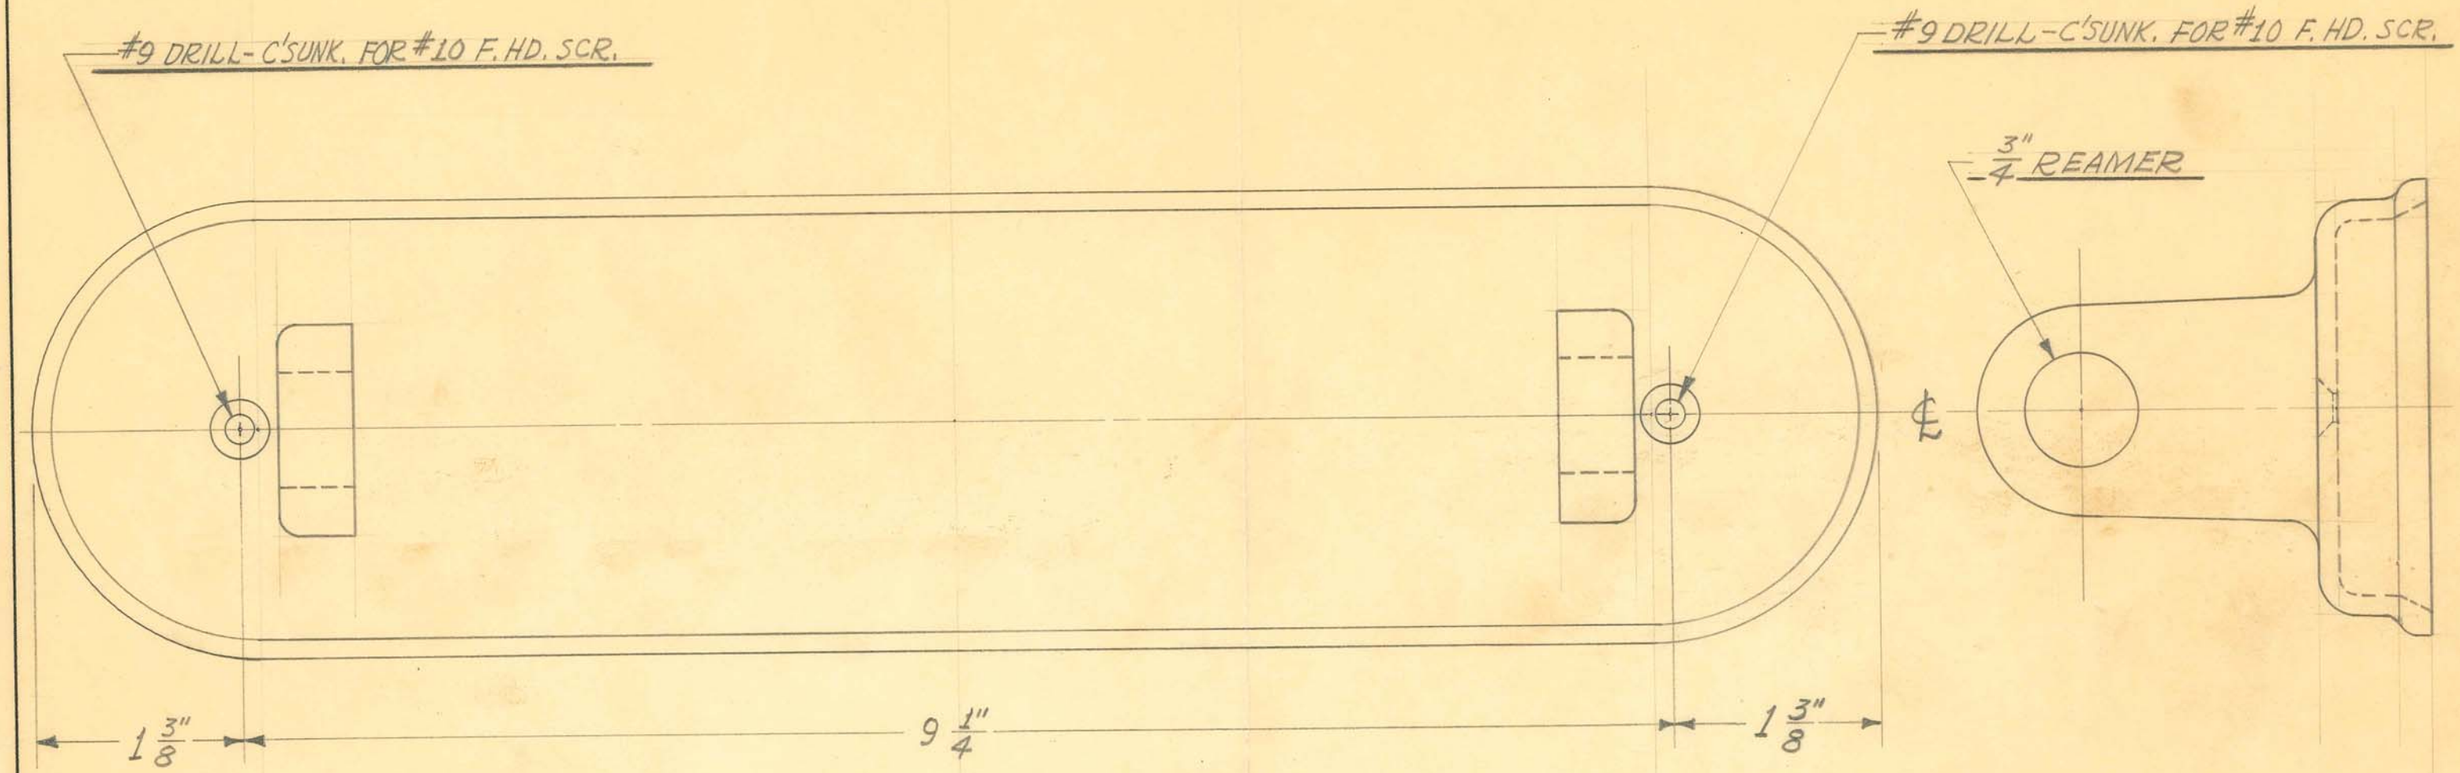

1 REQUIRED

OBSOLETE

SIZE		ISSUE 5-9-40	J.W.
KIND	ALUM.	CHANGED	
SHAPE		"	
FINISH	PAINTED	"	
TEMP.		"	
PATT.	311	"	

TITLE: FISCHER WALL BRACKET THERA. LAMP WALL BRACKET

H. G. FISCHER & CO.
2335 WABANSIA AVE.
CHICAGO, ILL.

CAT. NO.

PART NO. 3833F

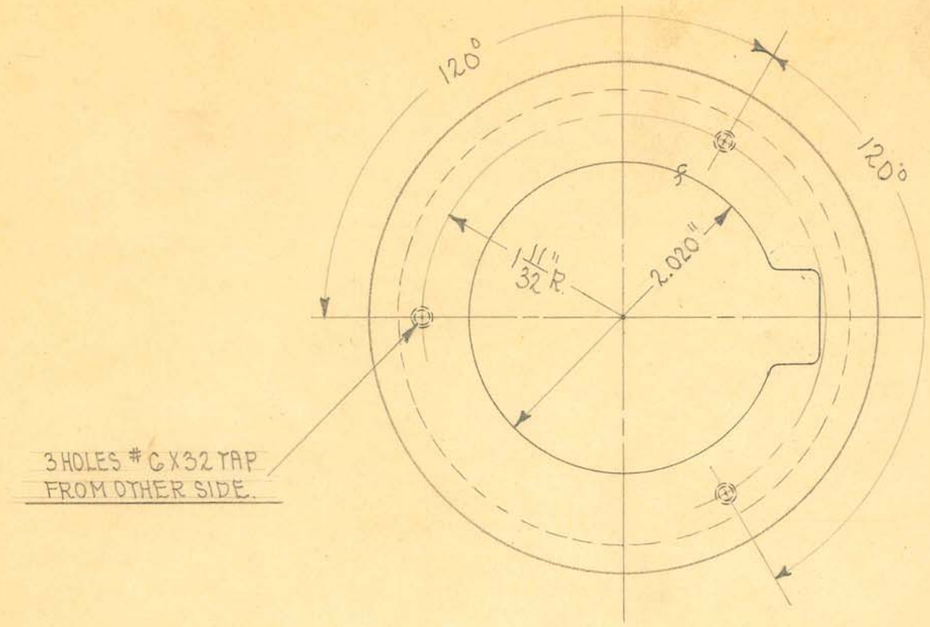

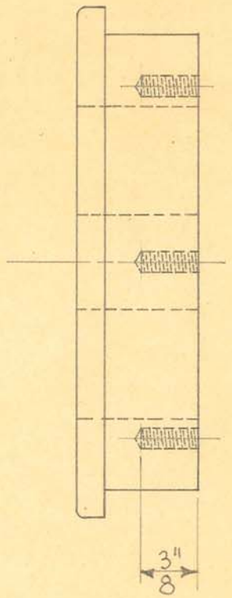

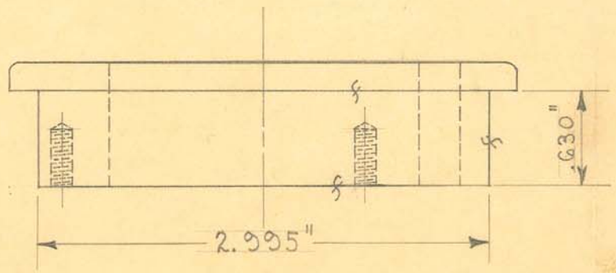

1 REQUIRED

OBSOLETE

SIZE		ISSUE 12-10-34	A.E.	TITLE: PORTABLE SHOCKPROOF X-RAY UPRIGHT TUBE SUPPORT BEARING
KIND	ALUM. CASTING	CHANGED		
SHAPE		" " per C.M. 1-11-38	J.W.	
FINISH	BUFF & POLISH	" "		
TEMP.		" "		H. G. FISCHER & CO. 2335 WABANSIA AVE. CHICAGO, ILL. — CAT. NO. — PART NO. 9228F
PATT.	4845-786	" "		

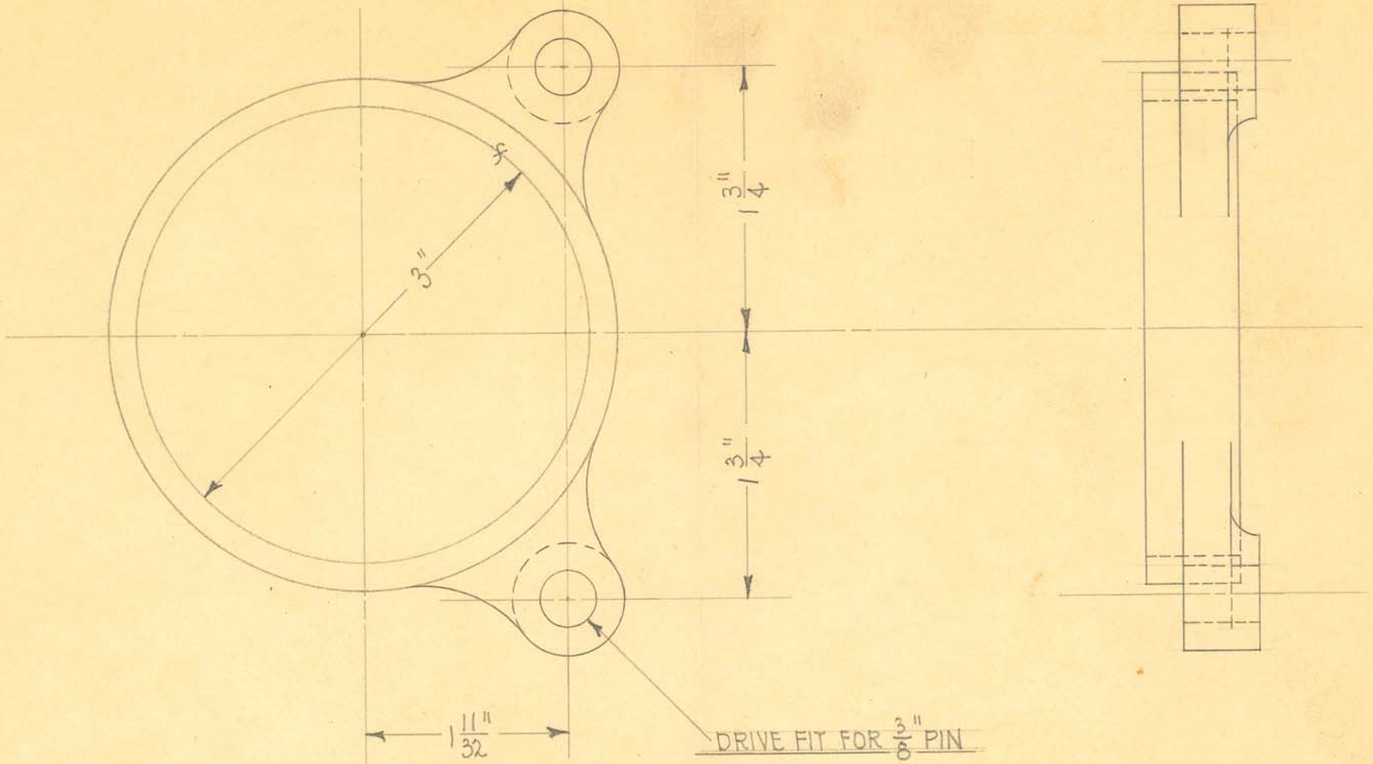

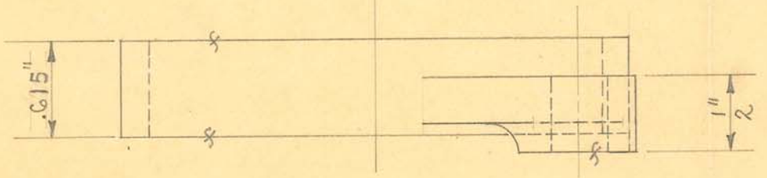

1 REQUIRED

OBSOLETE

SIZE		ISSUE 12-10-34	A.E.
KIND	BRASSCASTING	CHANGED	
SHAPE		" "	
FINISH	CAD. #23	" "	
TEMP.		" "	
PATT.	4844-785	" "	

TITLE: PORTABLE SHOCKPROOF X-RAY UPRIGHT TUBE SUPPORT

H. G. FISCHER & CO.
2335 WABANSIA AVE.
CHICAGO, ILL.

CAT. NO.

PART NO. 9225F

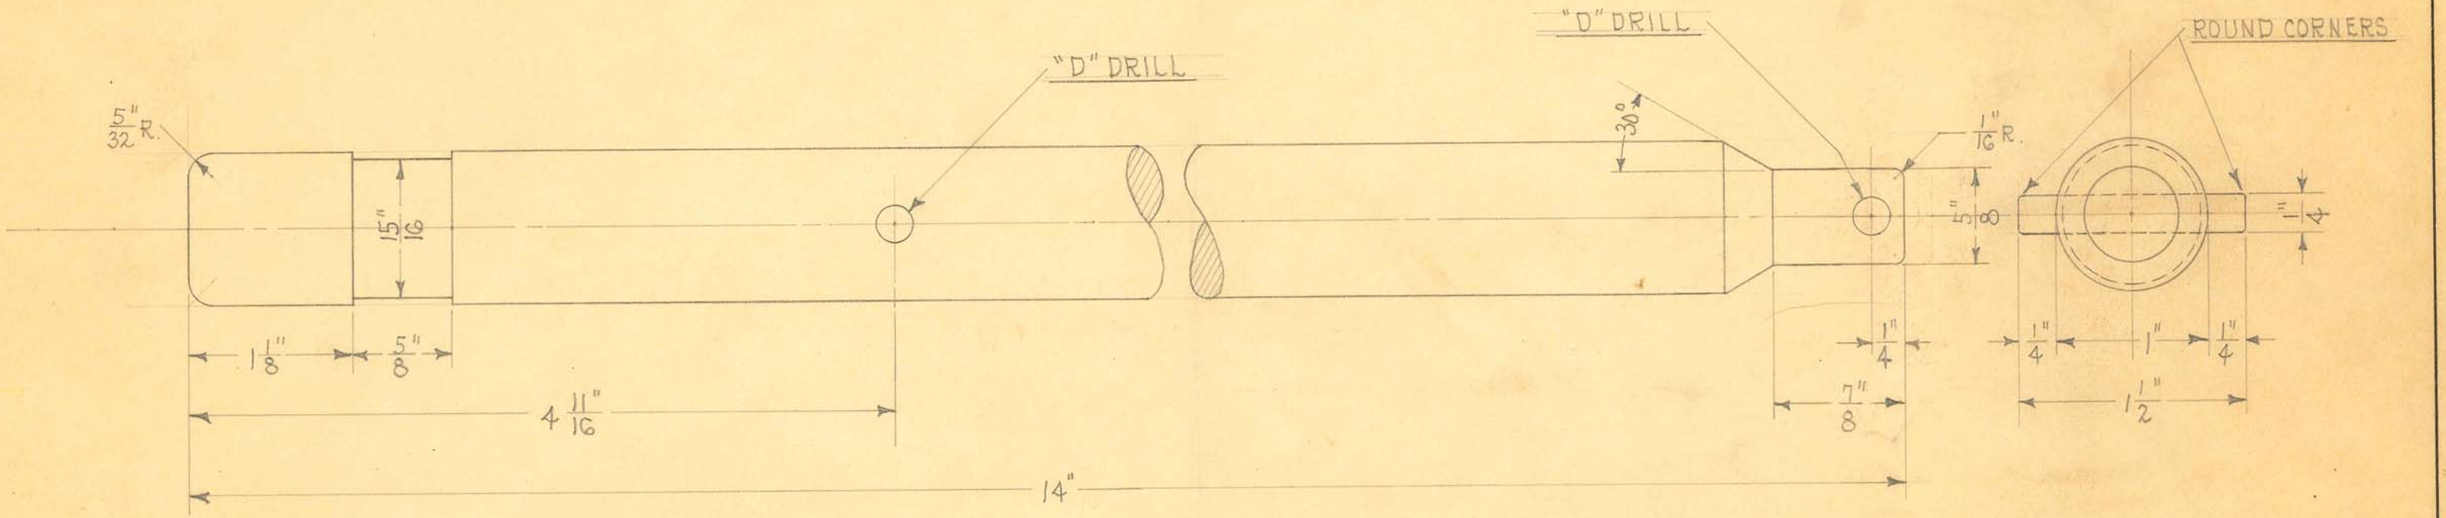

1 REQUIRED

OBSOLETE

SIZE	1" & 1/4"	ISSUE 12-6-34	H.E.
KIND	C.R. STEEL	CHANGED	
SHAPE		" "	
FINISH	CAD. #23	" "	
TEMP.		" "	
PATT.		" "	

TITLE: PORTABLE SHOCKPROOF X-RAY UPRIGHT TUBE BEARING SHAFT.

H. G. FISCHER & CO.
2335 WABANSIA AVE.
CHICAGO, ILL.

CAT. NO.

PART NO. 9223G

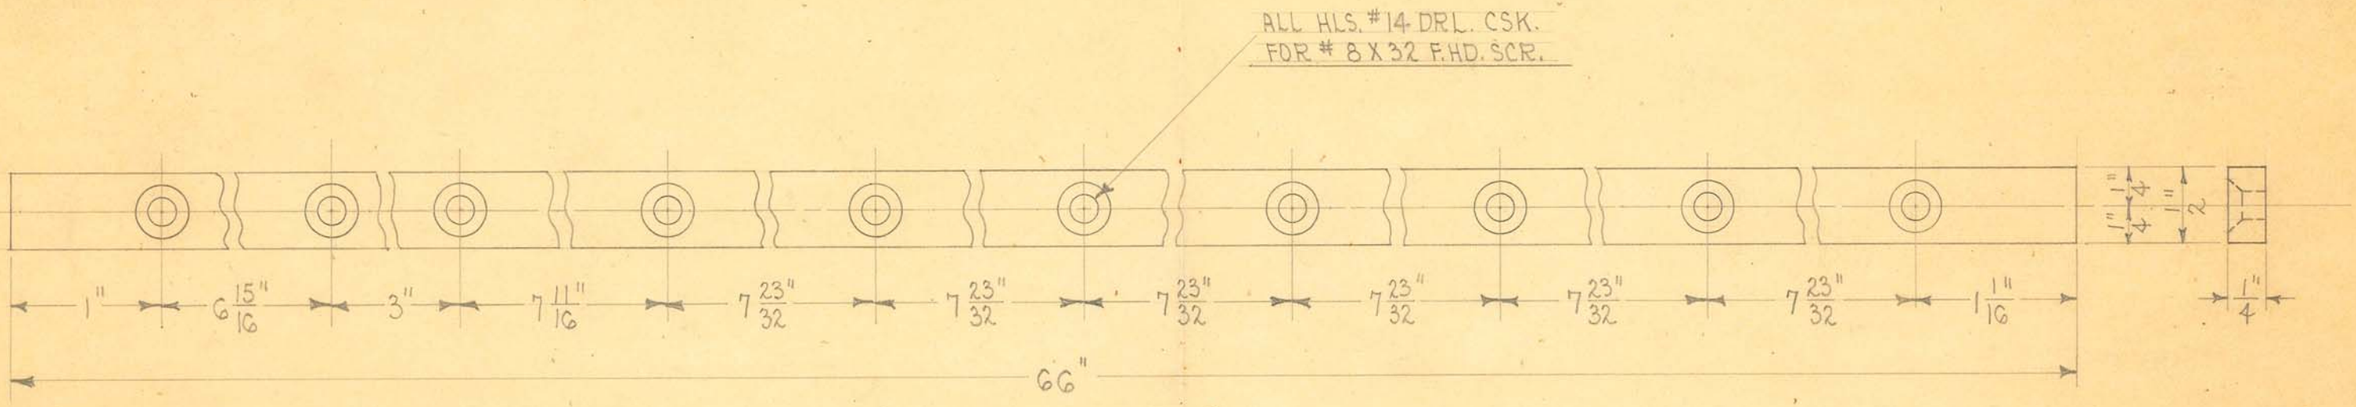

1 REQUIRED

OBSOLETE

SIZE	1/4" X 1/2"	ISSUE 1-9-35	A.E.	TITLE: PORTABLE SHOCKPROOF X-RAY LONG UPRIGHT GUIDE STRIP
KIND	C.R. STEEL	CHANGED		
SHAPE		" "		
FINISH	CAD. #23	" "		
TEMP.		" "		
PATT.		" "		

H. G. FISCHER & CO.
2335 WABANSIA AVE.
CHICAGO, ILL.

CAT. NO.

PART NO. 9220

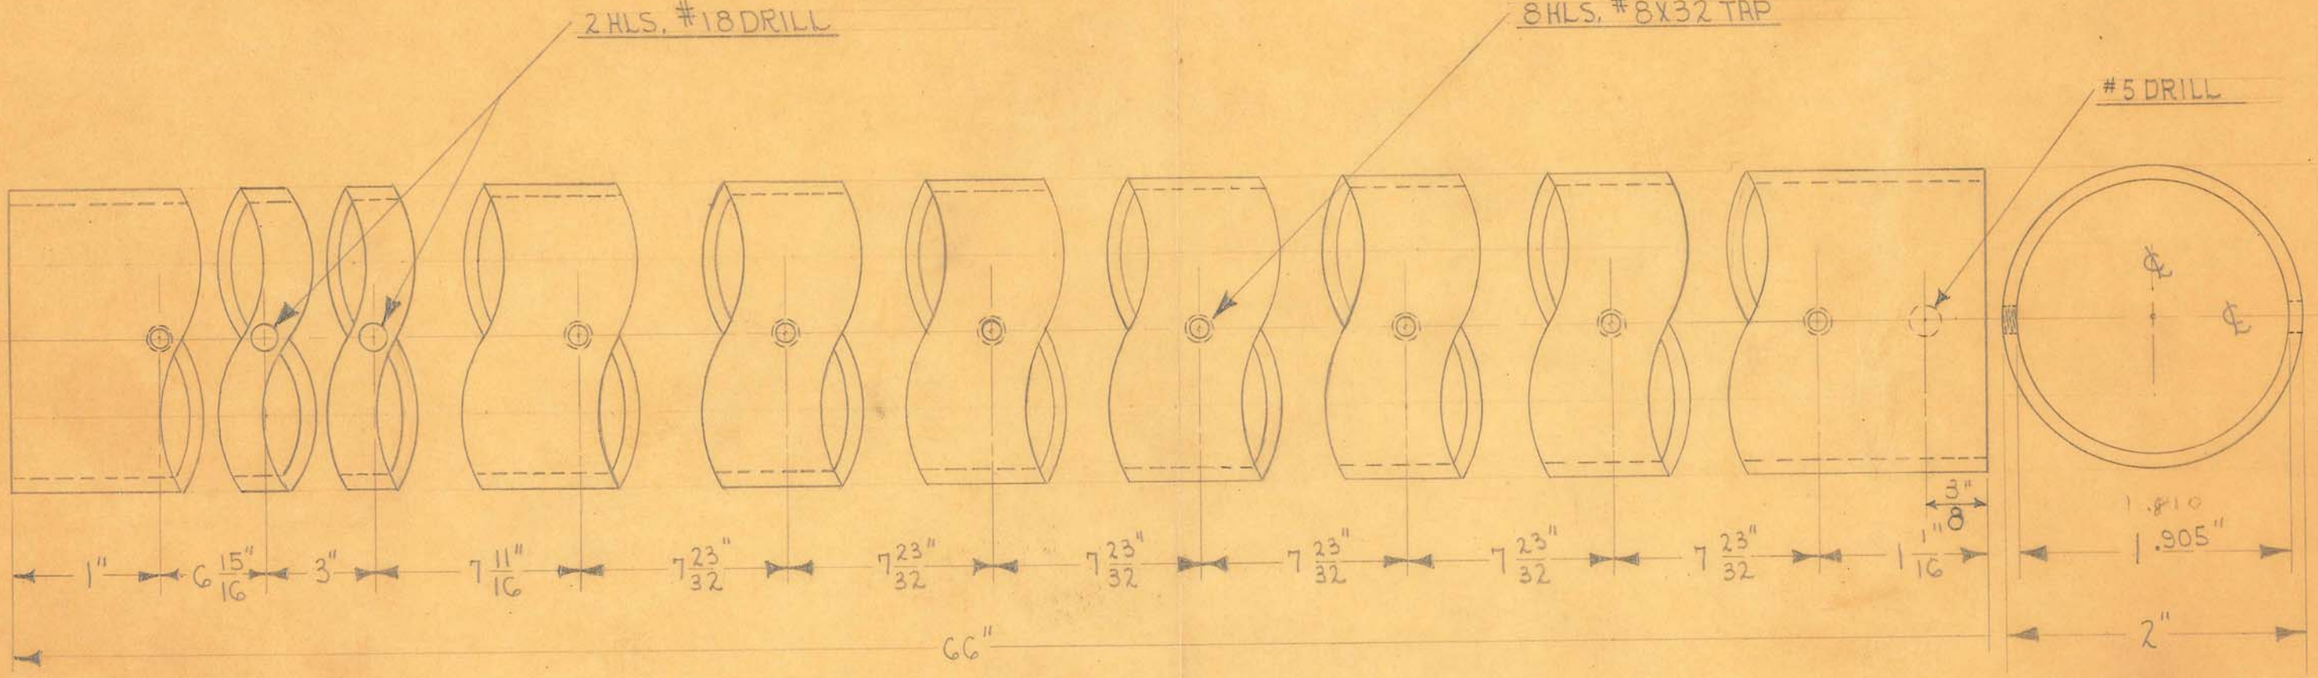

OBSOLETE

SIZE	2" O.D. X #13	ISSUE 8-27-35	J.W.	TITLE: FISCHER "DSP-20" LONG UPRIGHT (FINISHED)
KIND	BIRMINGHAM	CHANGED 5-20-36	J.W.	
SHAPE	GA. SEAMLESS S.T.	UBING "		
FINISH	CHROME #2	" "		
TEMP.		" "		H. G. FISCHER & CO. 2335 WABANSIA AVE. CHICAGO, ILL. — CAT. NO. — PART NO. 9219FB
PATT.		" "		

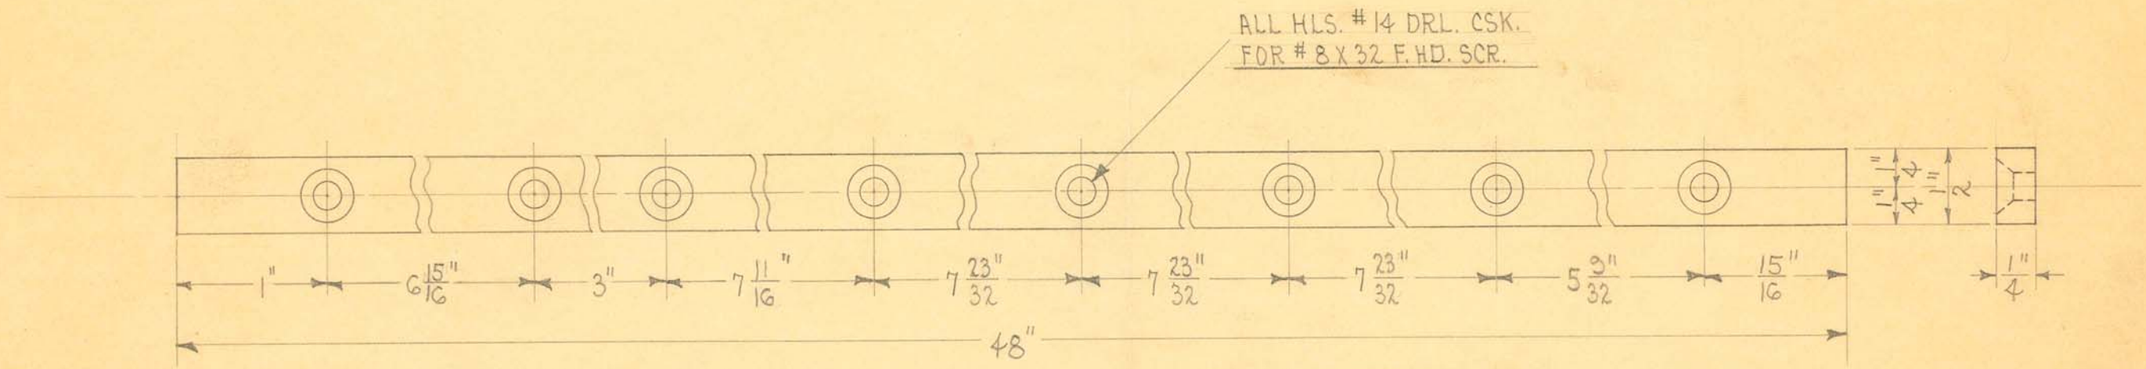

1 REQUIRED

OBSOLETE

SIZE	1/4" X 1/2"	ISSUE 1-11-35	A.E.
KIND	C.R. STEEL	CHANGED	
SHAPE		" "	
FINISH	CAD. # 23	" "	
TEMP.		" "	
PATT.		" "	

TITLE: PORTABLE SHOCKPROOF X-RAY SHORT UPRIGHT GUIDE STRIP

H. G. FISCHER & CO.
2335 WABANSIA AVE.
CHICAGO, ILL.

CAT. NO.

PART NO. 9218

16235 — 2 pcs. $\frac{1}{4}$" Tubing $3\frac{5}{8}$" LONG EACH
16234 — Beads = 52
#16 GA WIRE = 12"

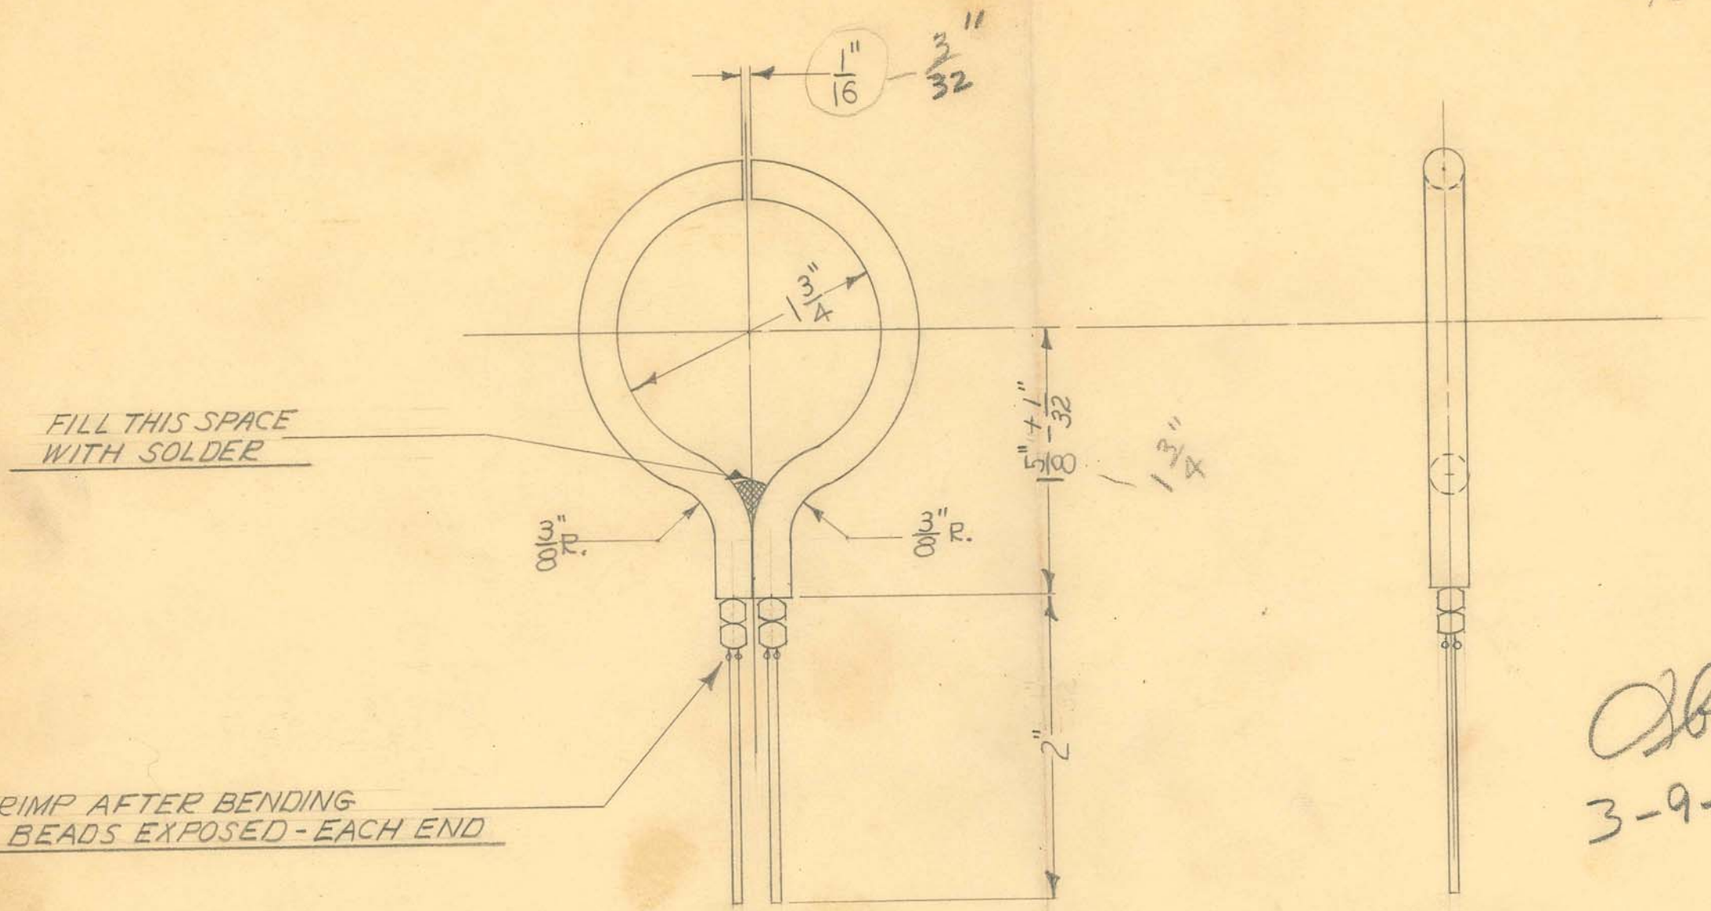

Obsolete
3-9-49

OBSOLETE

1-REQUIRED

MATERIALS TO BE USED AS SPECIFIED ON YOUR DRAWING NO. L-11722

SOLDERING FIXTURE TOOL# 9828

SIZE		ISSUE	12-4-47	J.MF	
KIND		CHANGED			
SHAPE		"			
FINISH		"			
TEMP.		"			
PATT.		"			

DIMENSIONS
FRACTIONAL ± .015
DECIMAL ± .005
ANGULAR ± 1/2°
UNLESS OTHERWISE SPECIFIED

TITLE: MODEL "400" FISCHER DELUXE DIATHERMY FARRADAY PICK-UP LOOP - SHORT

H. G. FISCHER & CO.
2335 WABANSIA AVE.
CHICAGO, ILL.

CAT. NO.

PART NO. 16237

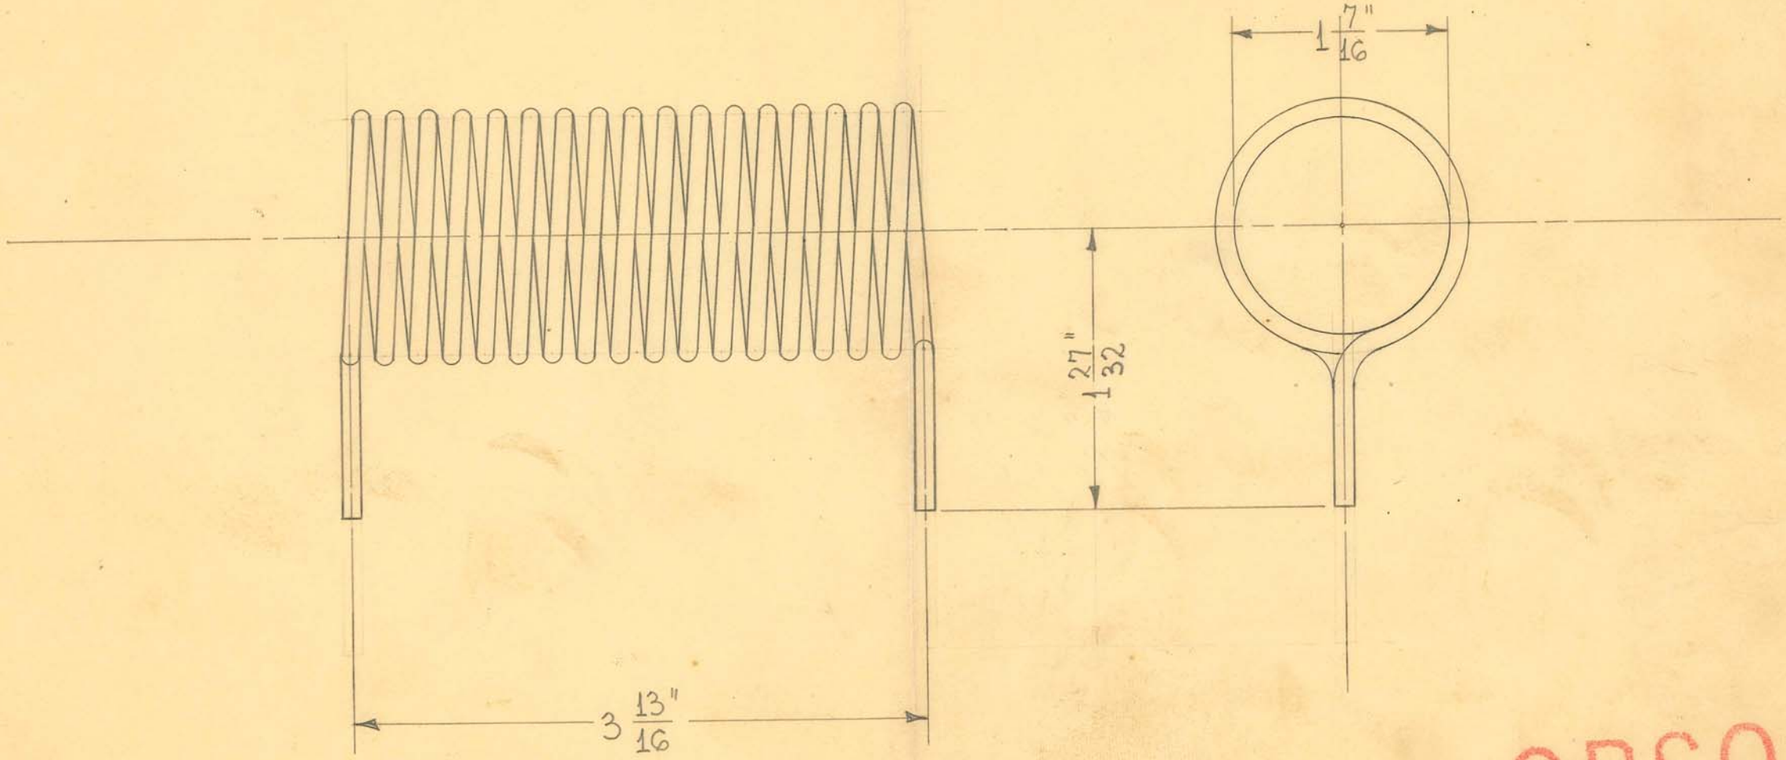

~~#7~~
19 TURNS
1 REQUIRED

OBSOLETE
Obsolete

SIZE	#8 BARE	ISSUE 9-19-45	HE.	
KIND	COPPER WIRE	CHANGED		
SHAPE		"		
FINISH		"		
TEMP.		"		
PATT.		"		

TITLE: FISCHER "FCW" SHORT WAVE OUTFIT~ PARALLEL TUNING COIL

H. G. FISCHER & CO.
2335 WABANSIA AVE.
CHICAGO, ILL.

CAT. NO.

PART NO. 16276

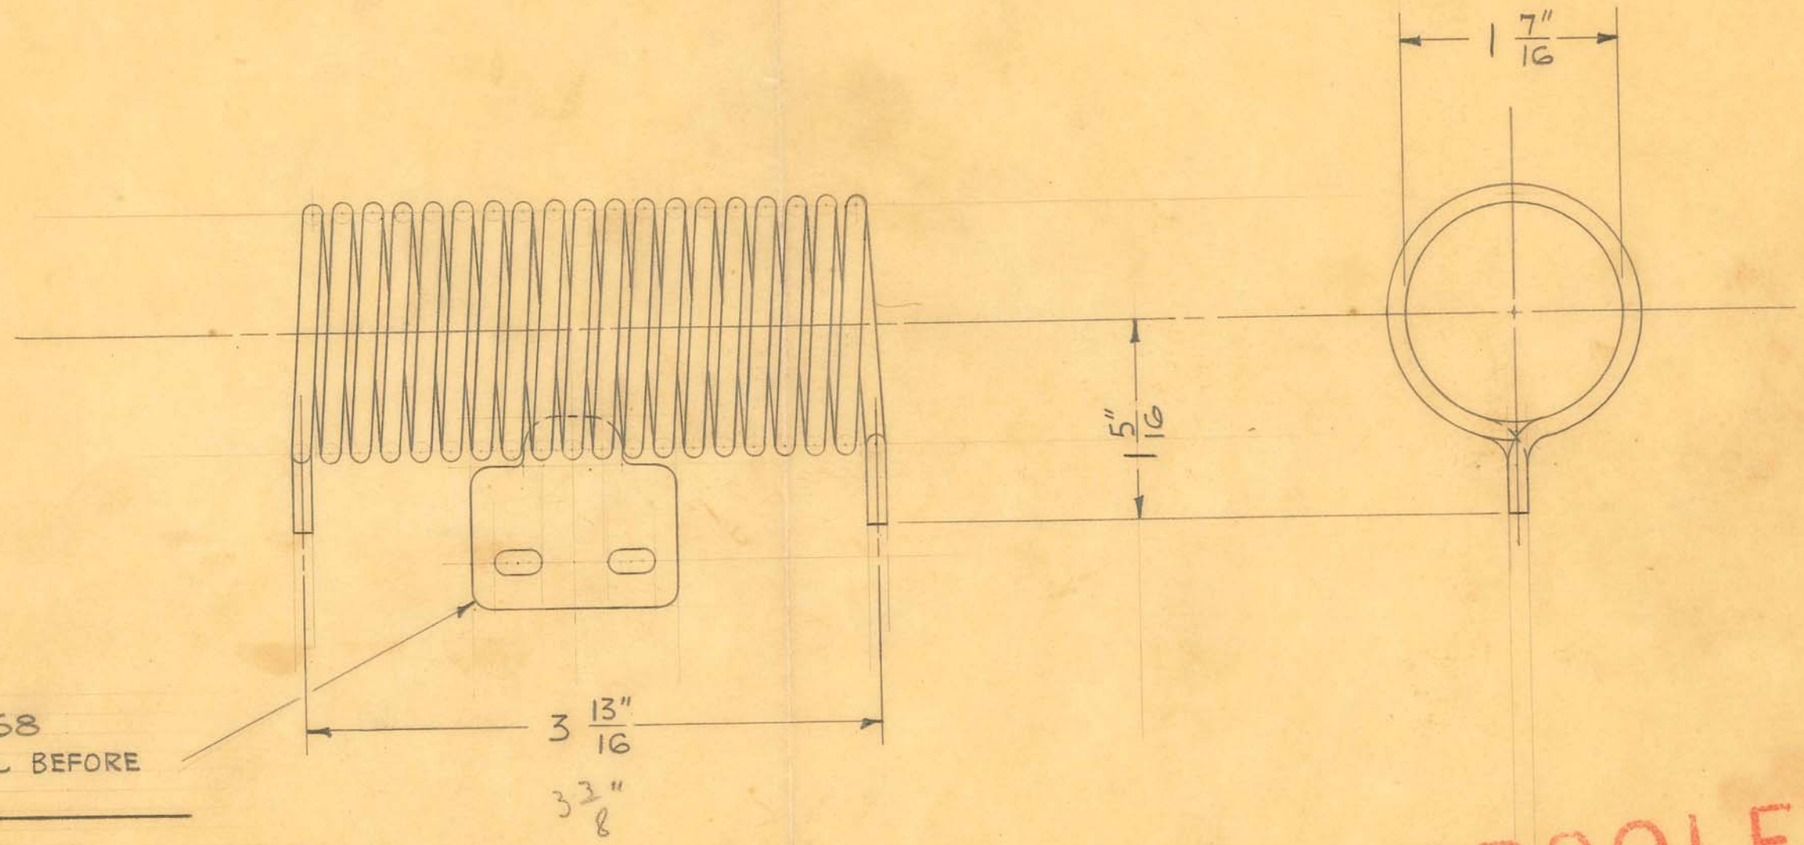

THREAD PCE.# 16258
SUPPORT ONTO COIL BEFORE
BENDING ENDS.

19 TURNS

1 REQUIRED

OBSOLETE

OBSOLETE

SIZE	#8 BARE	ISSUE 4-26-46	J.V.W.
KIND	COPPER WIRE	CHANGED	
SHAPE		"	
FINISH		"	
TEMP.		"	
PATT.		"	

TITLE:
FISCHER "FCW" SHORT WAVE OUTFIT
PARALLEL TUNING COIL

H. G. FISCHER & CO.
2335 WABANSIA AVE.
CHICAGO, ILL.

CAT. NO.

PART NO. 16276G

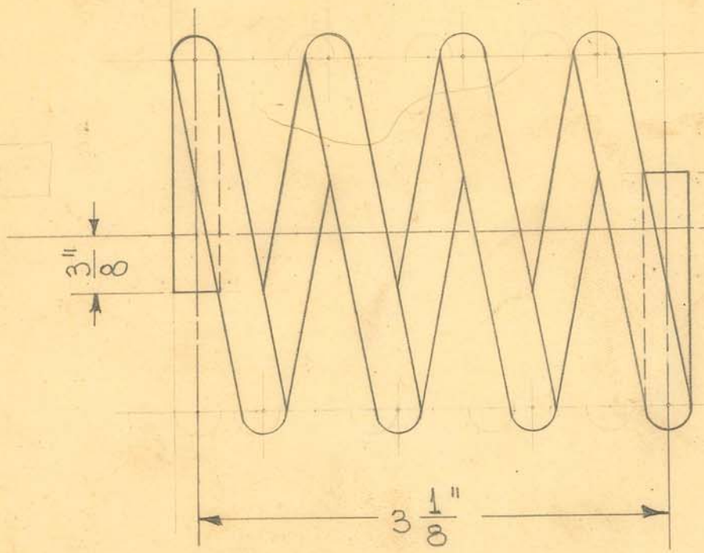

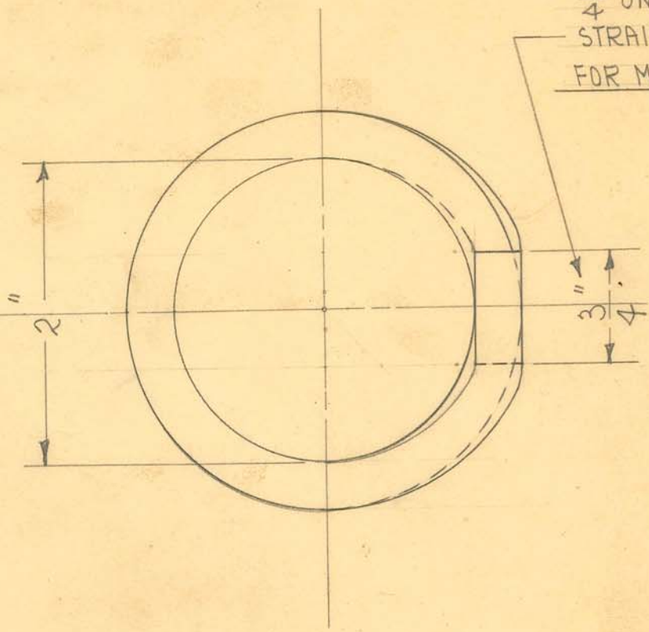

3/4" ON EACH END OF COIL TO BE STRAIGHT (WITHOUT ANY CURVATURE) FOR MOUNTING TO CASTINGS.

4 TURNS

1 REQUIRED

OBSOLETE

Obsolete

SIZE	5/16" O.D. X 1/4" I.D.	ISSUE 9-18-45	H.E.	TITLE: FISCHER "FCW" SHORT WAVE OUTFIT~ OSCILLATING COIL
KIND	COPPER	CHANGED		
SHAPE	TUBING	"		
FINISH		"		
TEMP.		"		
PATT.		"		

H. G. FISCHER & CO.
2335 WABANSIA AVE.
CHICAGO, ILL.

CAT. NO.

PART NO. 16283

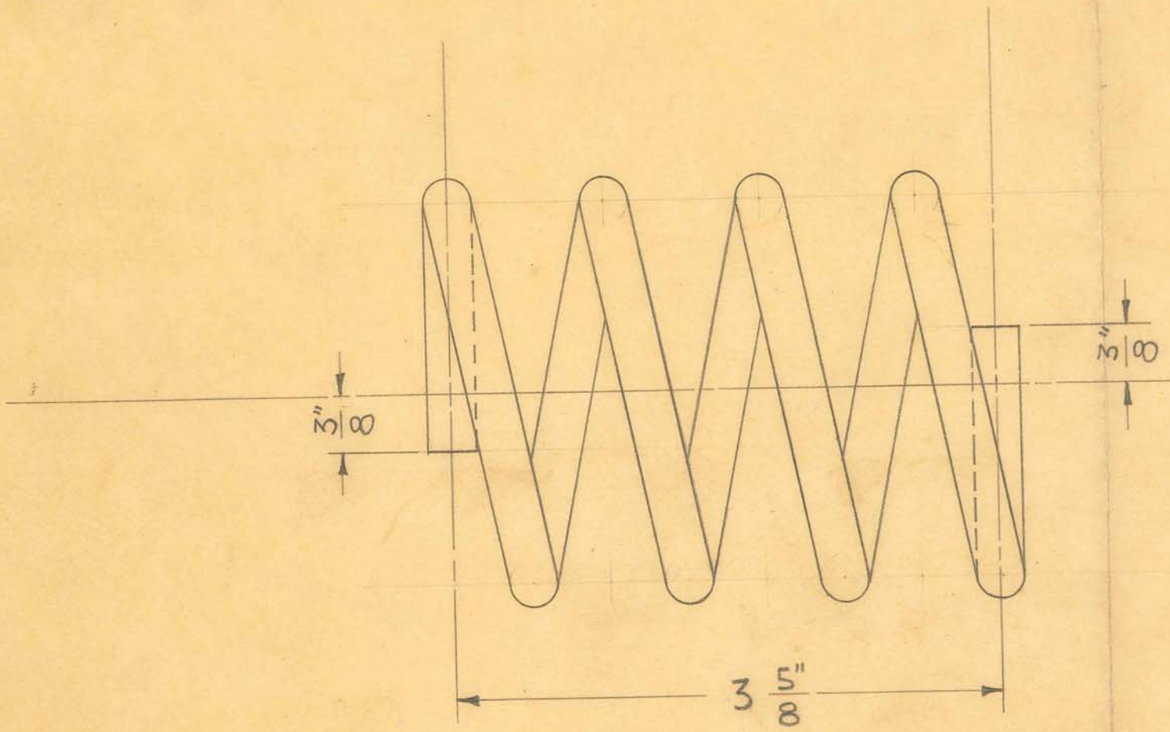

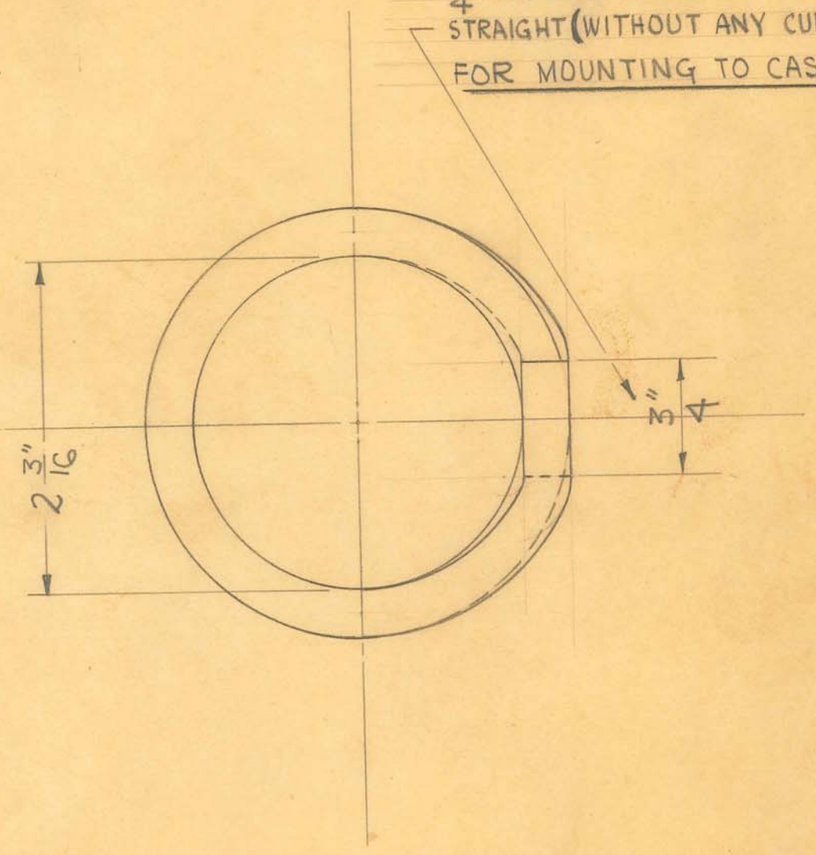

4 TURNS

1 REQUIRED

OBSOLETE

Obsolete

OR 5/8 27

SIZE	5/16" O.D. X 1/4" I.D.	ISSUE 2-11-46	J.V.W.	TITLE: FISCHER "FCW" SHORT WAVE OUTFIT OSCILLATING COIL
KIND	COPPER	CHANGED		
SHAPE	TUBING	"		
FINISH		"		
TEMP.		"		
PATT.		"		

H. G. FISCHER & CO.
2335 WABANSIA AVE.
CHICAGO, ILL.

CAT. NO.

PART NO. 16283A

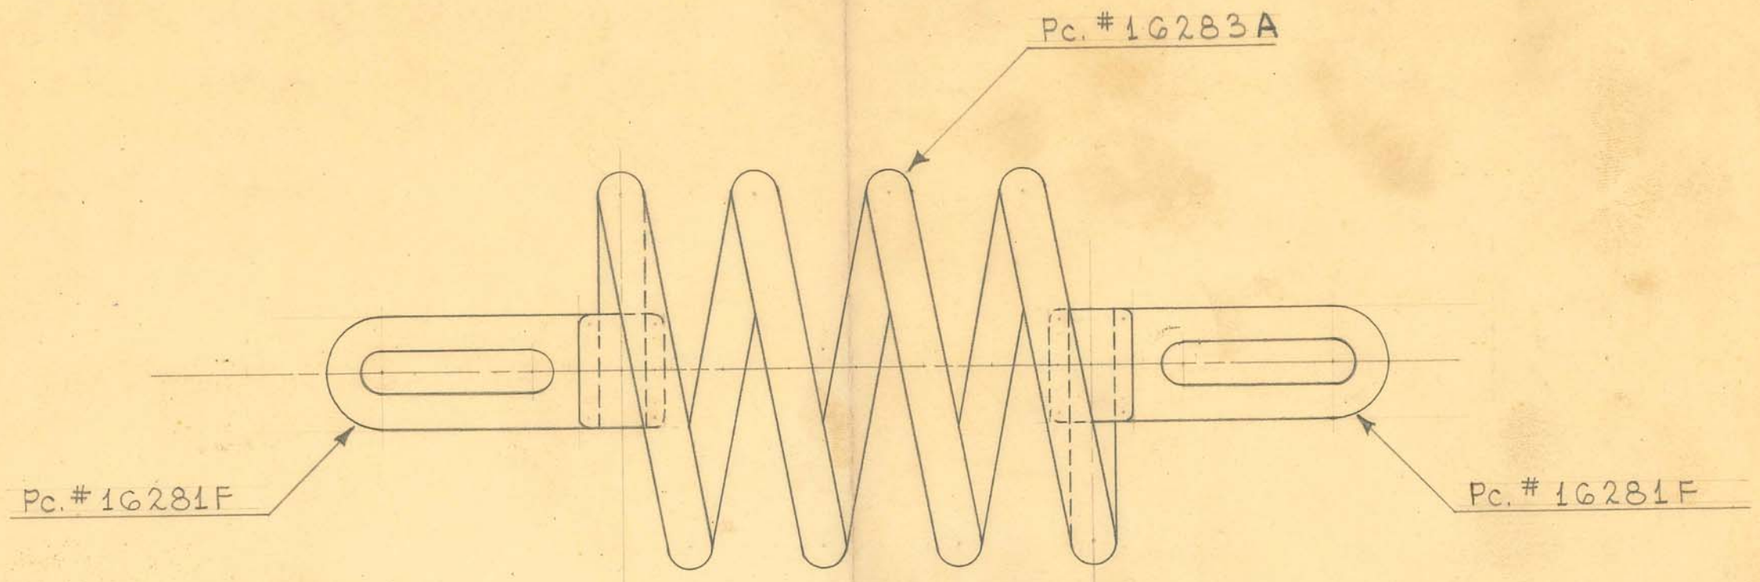

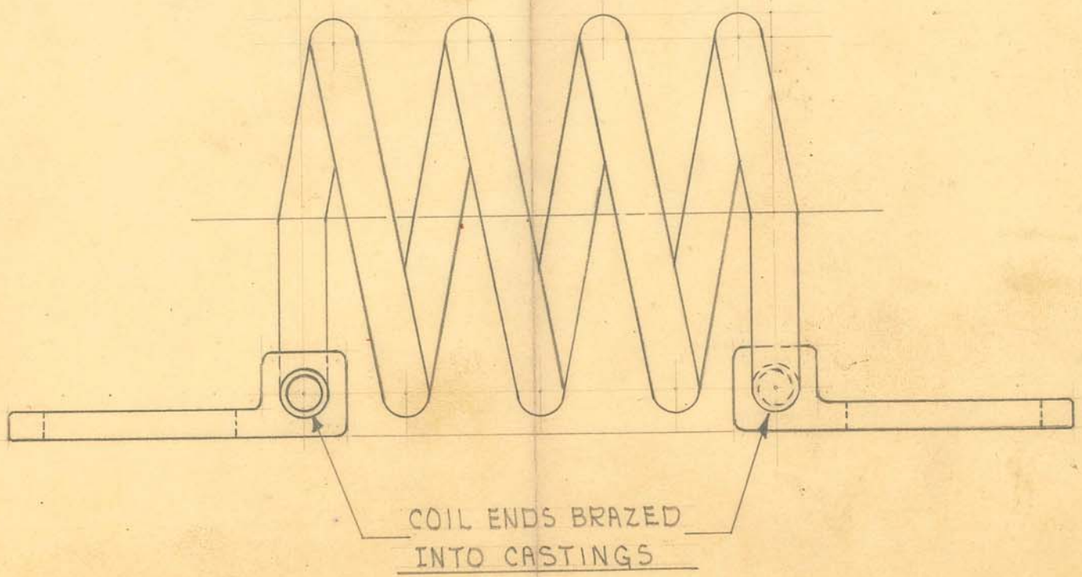

1 REQUIRED

OBSOLETE
obsolete

SIZE		ISSUE 9-18-45	HE.
KIND		CHANGED	
SHAPE		" 2-11-46	J.V.W.
FINISH		"	
TEMP.		"	
PATT.		"	

TITLE: FISCHER "FCW" SHORT WAVE OUTFIT~ OSCILLATING COIL ASSEMBLY

H. G. FISCHER & CO.
2335 WABANSIA AVE.
CHICAGO, ILL.

CAT. NO.

PART NO. 16284GA

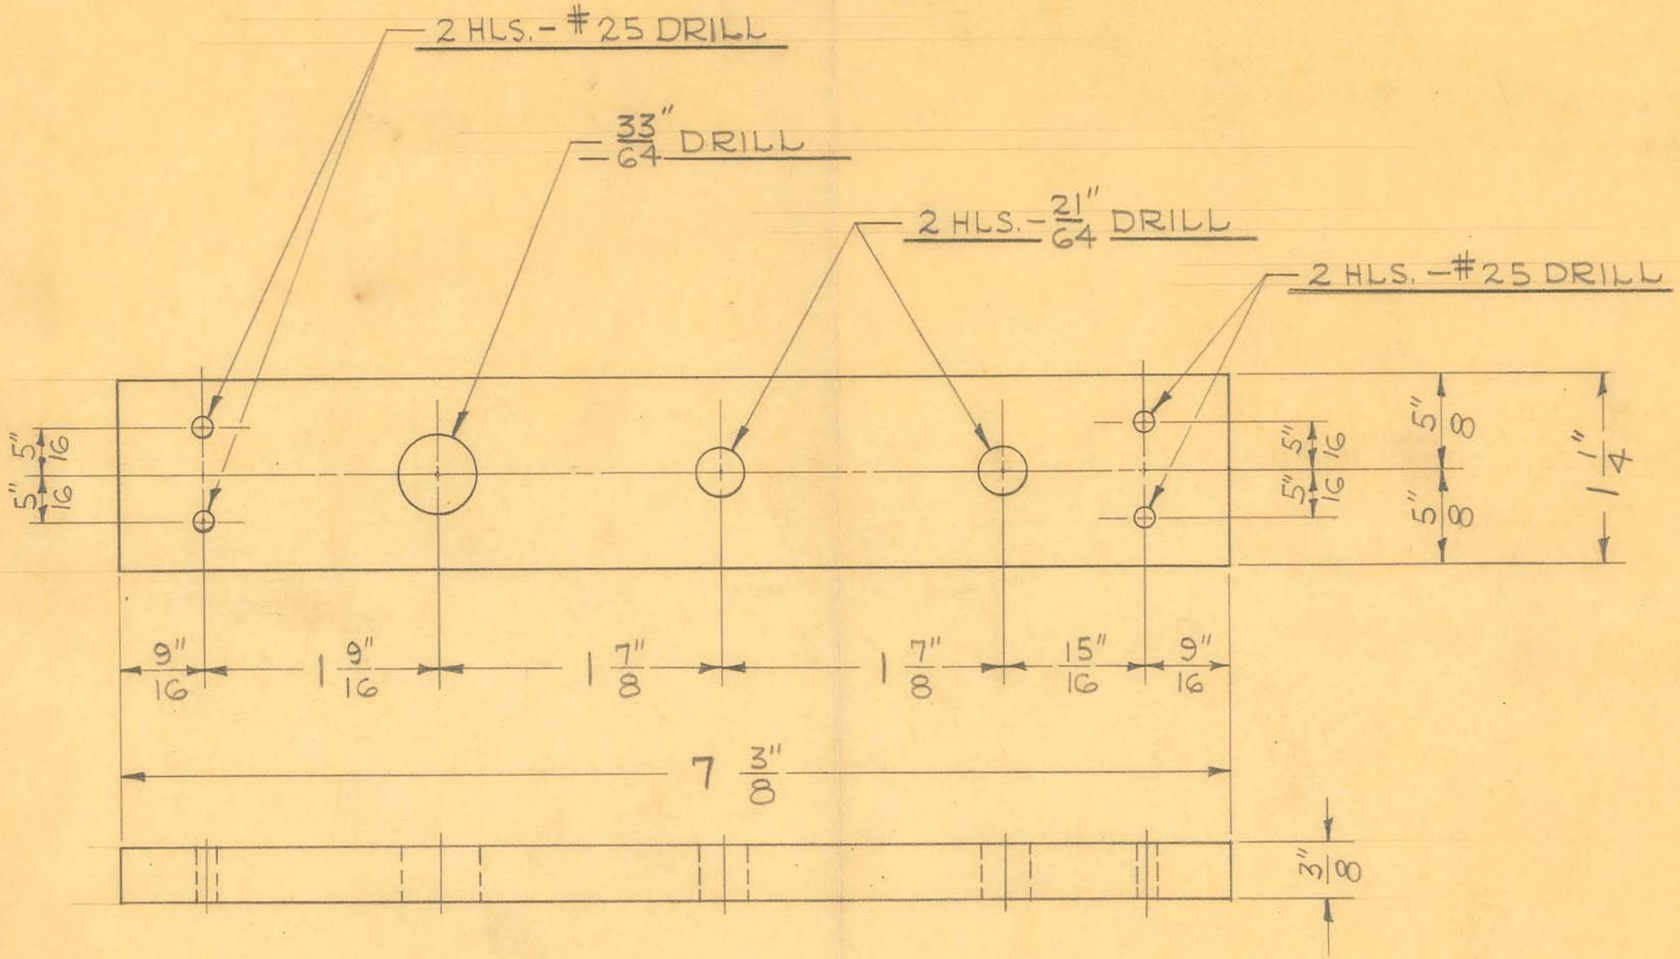

2 REQUIRED

OBSOLETE

Obsolete

X

SIZE	MYKROY	ISSUE 4-4-46	J.V.W.
KIND		CHANGED	
SHAPE		"	
FINISH		"	
TEMP.		"	
PATT.		"	

TITLE:
FISCHER "FCW" SHORT WAVE OUTFIT
CORD SOCKET MOUNTING BOARD

H. G. FISCHER & CO.
2335 WABANSIA AVE.
CHICAGO, ILL.

CAT. NO.

PART NO. 16286A

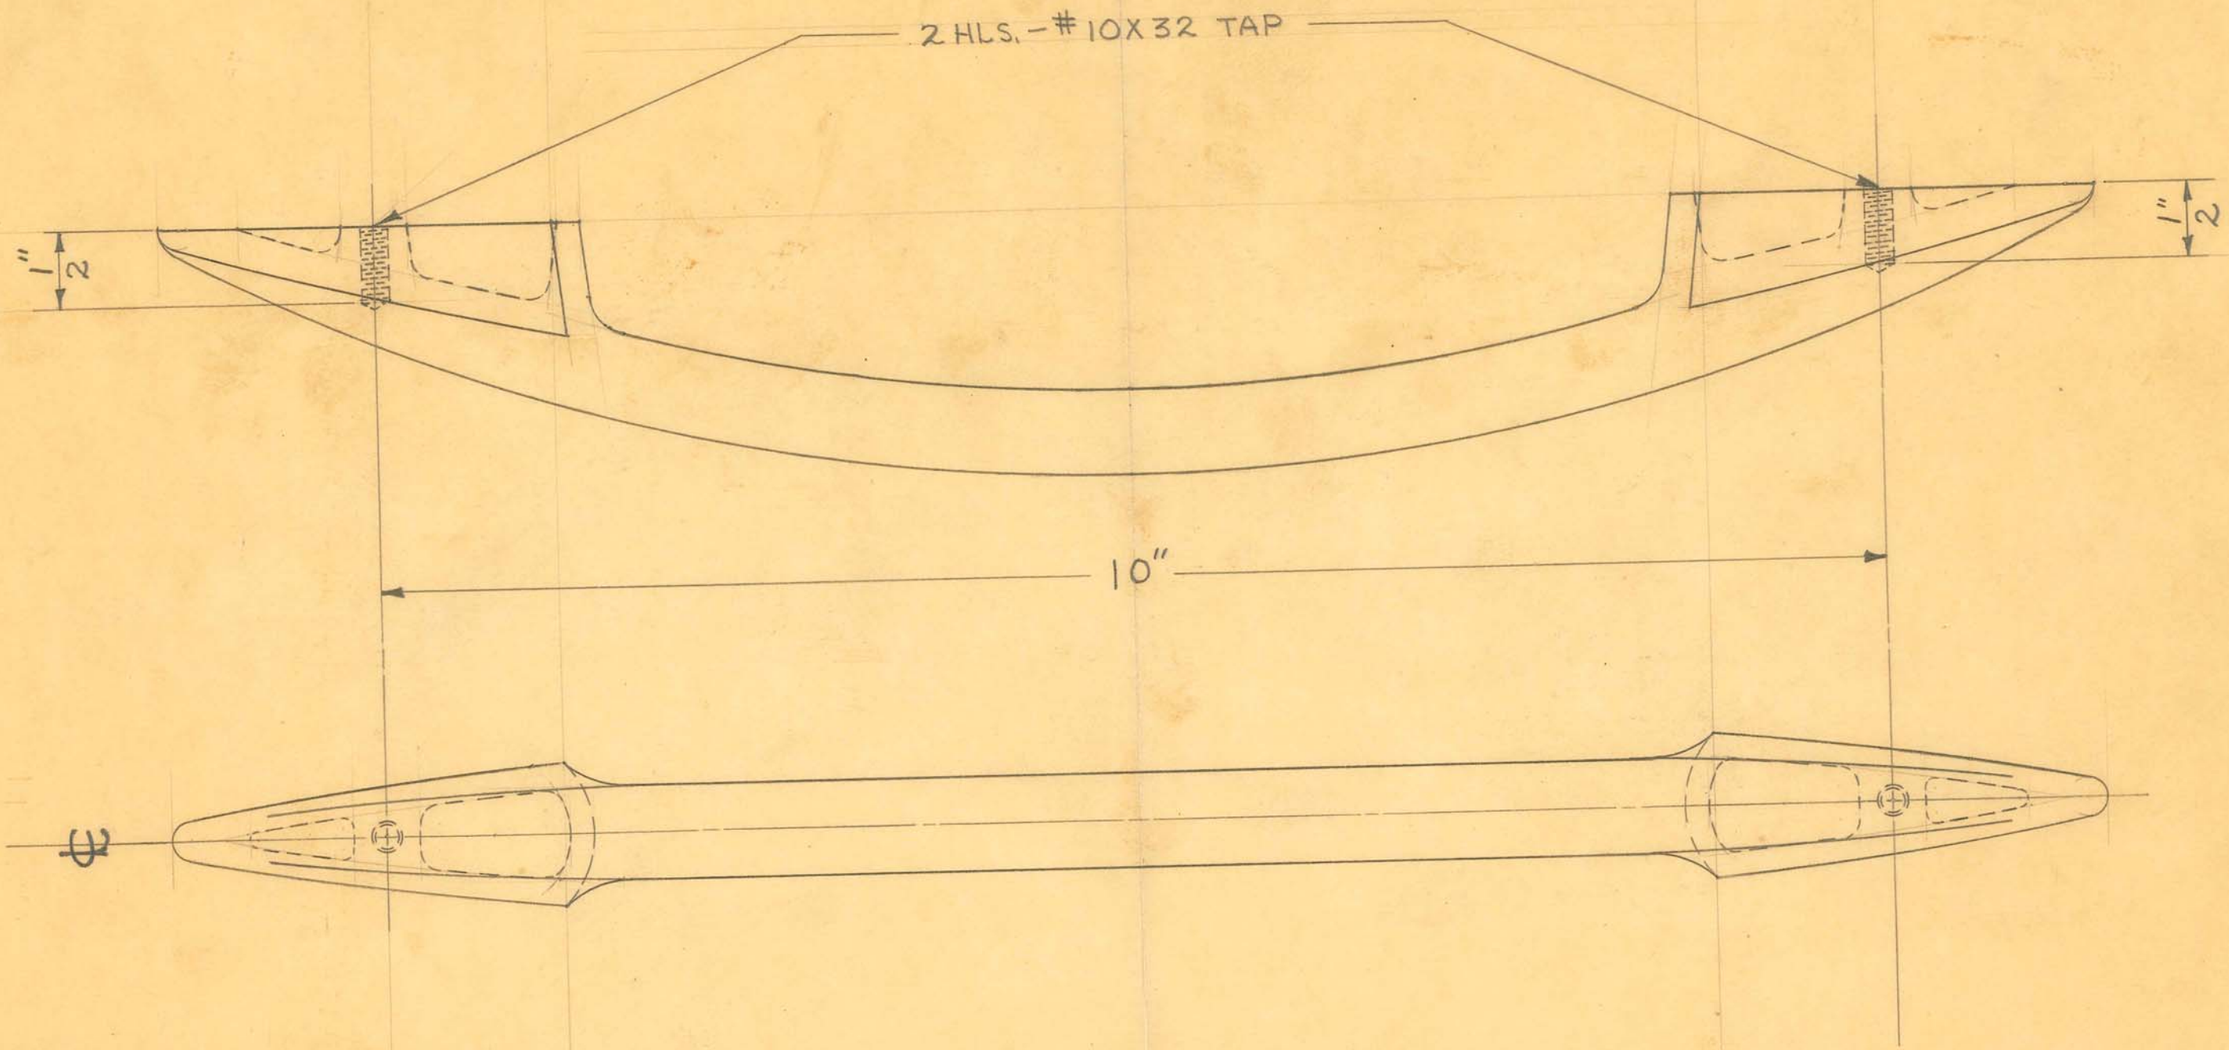

2 REQUIRED

OBSOLETE

SIZE	BRASS	ISSUE 1-24-47	J.V.W.	TITLE: FISCHER "FCW" SHORT WAVE OUTFIT HANDLE
KIND	CASTING	CHANGED		
SHAPE		"		
FINISH	CHROME #2	"		
TEMP.		"		H. G. FISCHER & CO. 2338 WABANSIA AVE. CHICAGO, ILL. — CAT. NO. — PART NO. 16298AF
PATT.	2128	"		

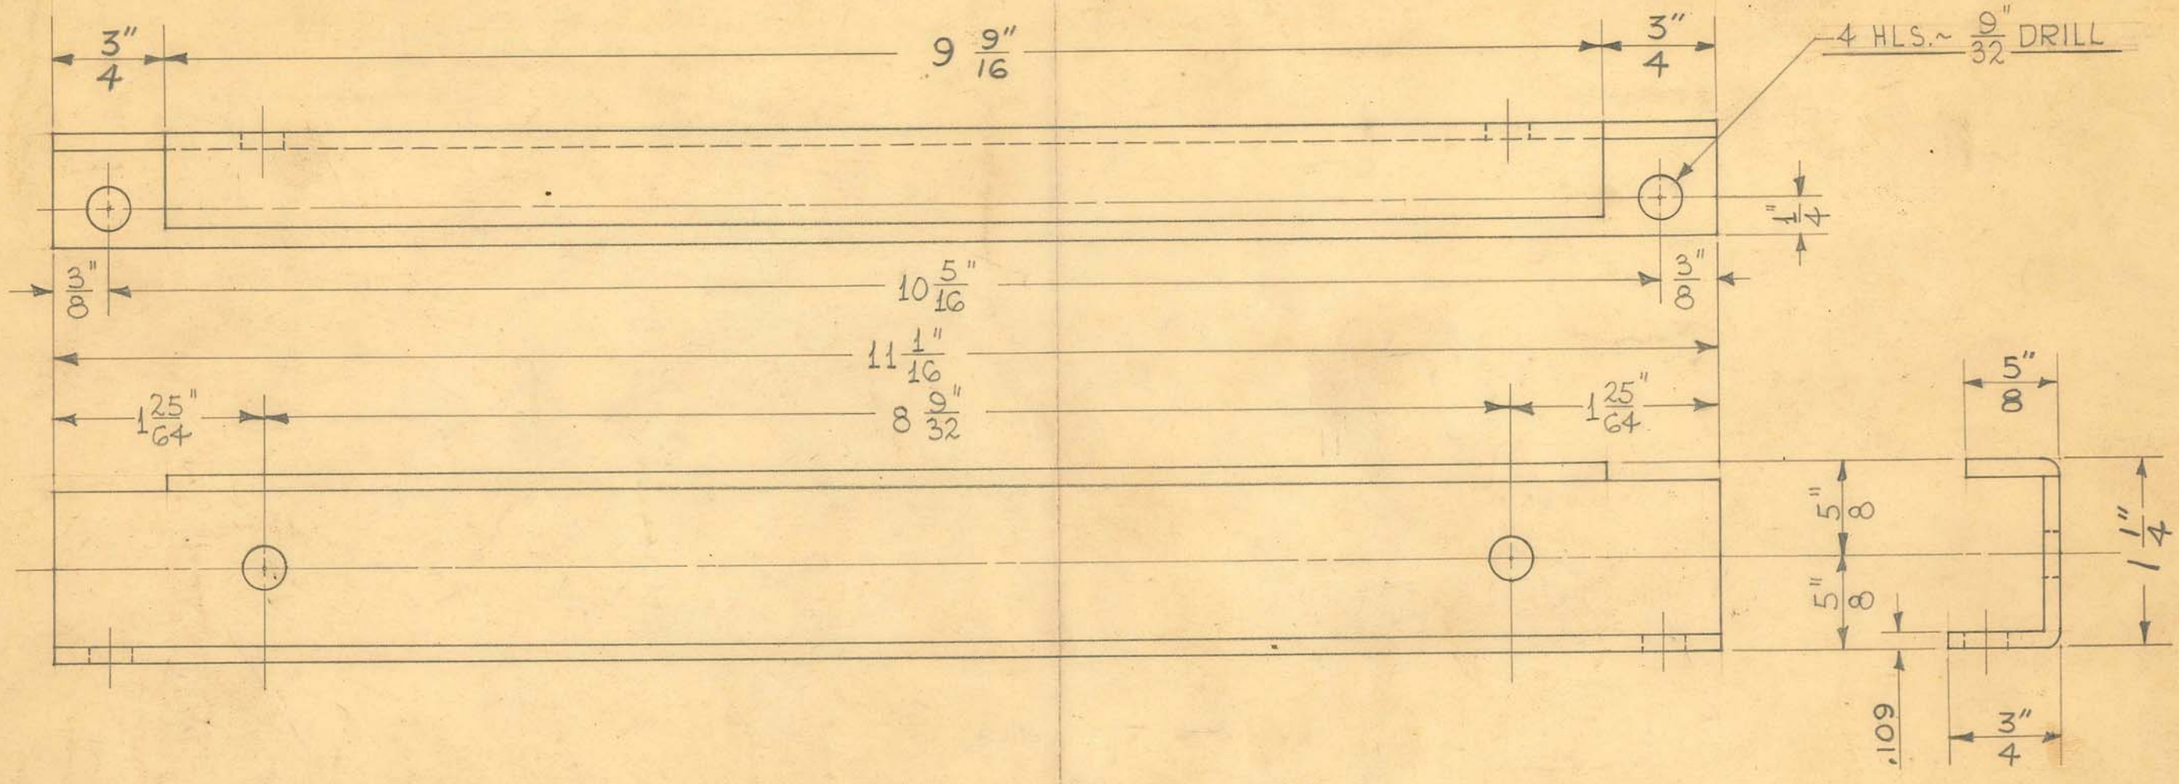

2 REQUIRED

OBSOLETE Absolete

SIZE	#12GA.(.109)	ISSUE 7-30-45	HE.
KIND	C.R. STEEL	CHANGED	
SHAPE	SHEET	"	
FINISH	BLACK #80	"	
TEMP.		"	
PATT.		"	

TITLE: FISCHER "FCW" SHORT WAVE OUTFIT- POWER TRANSF. CLAMP - BOTTOM (DRILLED)

H. G. FISCHER & CO.
2335 WABANSIA AVE.
CHICAGO, ILL.

CAT. NO.

PART NO. 16303

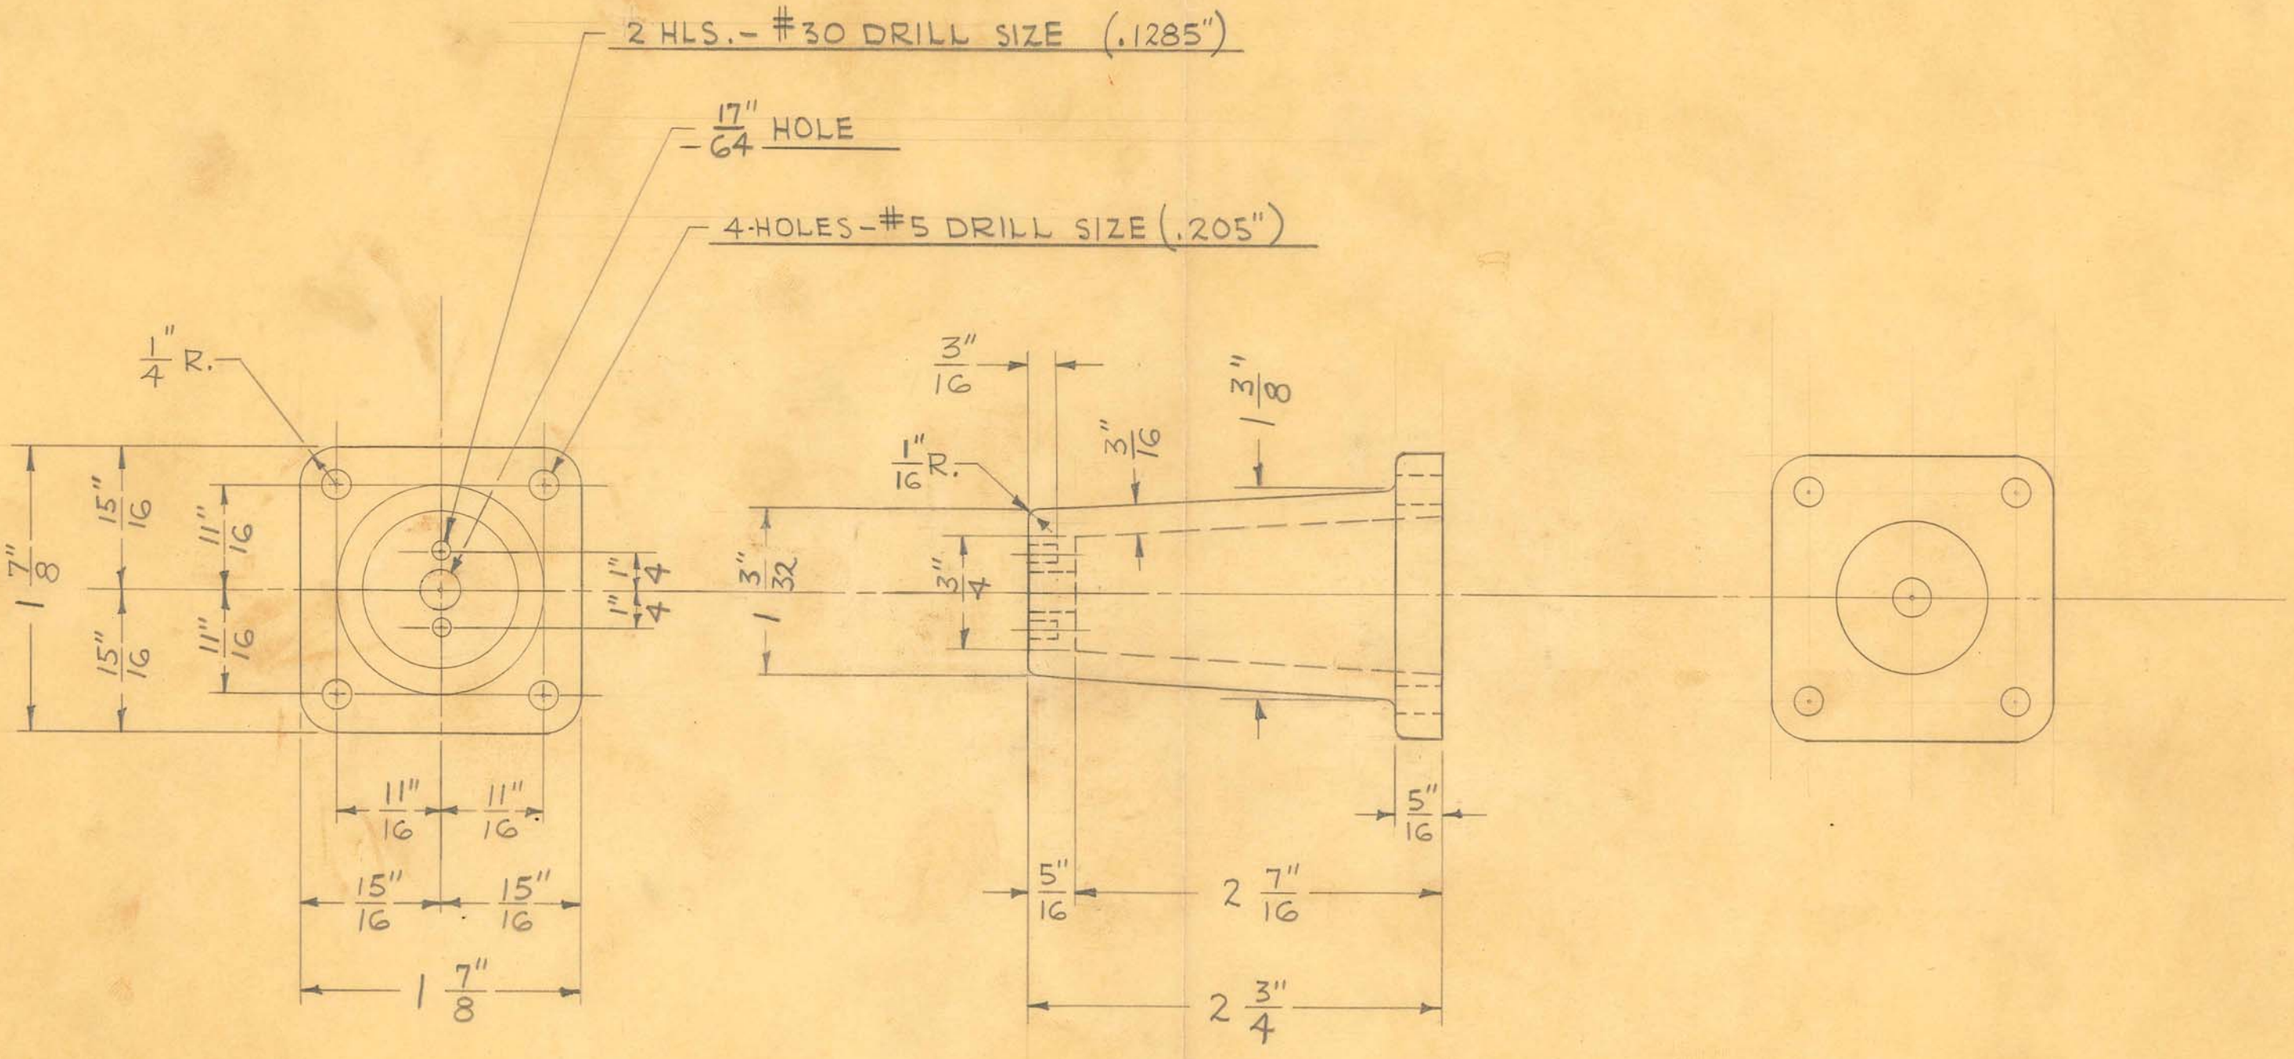

OBSOLETE

SIZE	MYKROY	ISSUE 4-22-47	J.V.W.
KIND		CHANGED	
SHAPE		"	
FINISH		"	
TEMP.		"	

TITLE:
FISCHER "FCW" SHORT WAVE OUTFIT
STAND-OFF INSULATOR

H. G. FISCHER & CO.
2335 WABANSIA AVE.

CAT. NO.

PART NO. LC 333

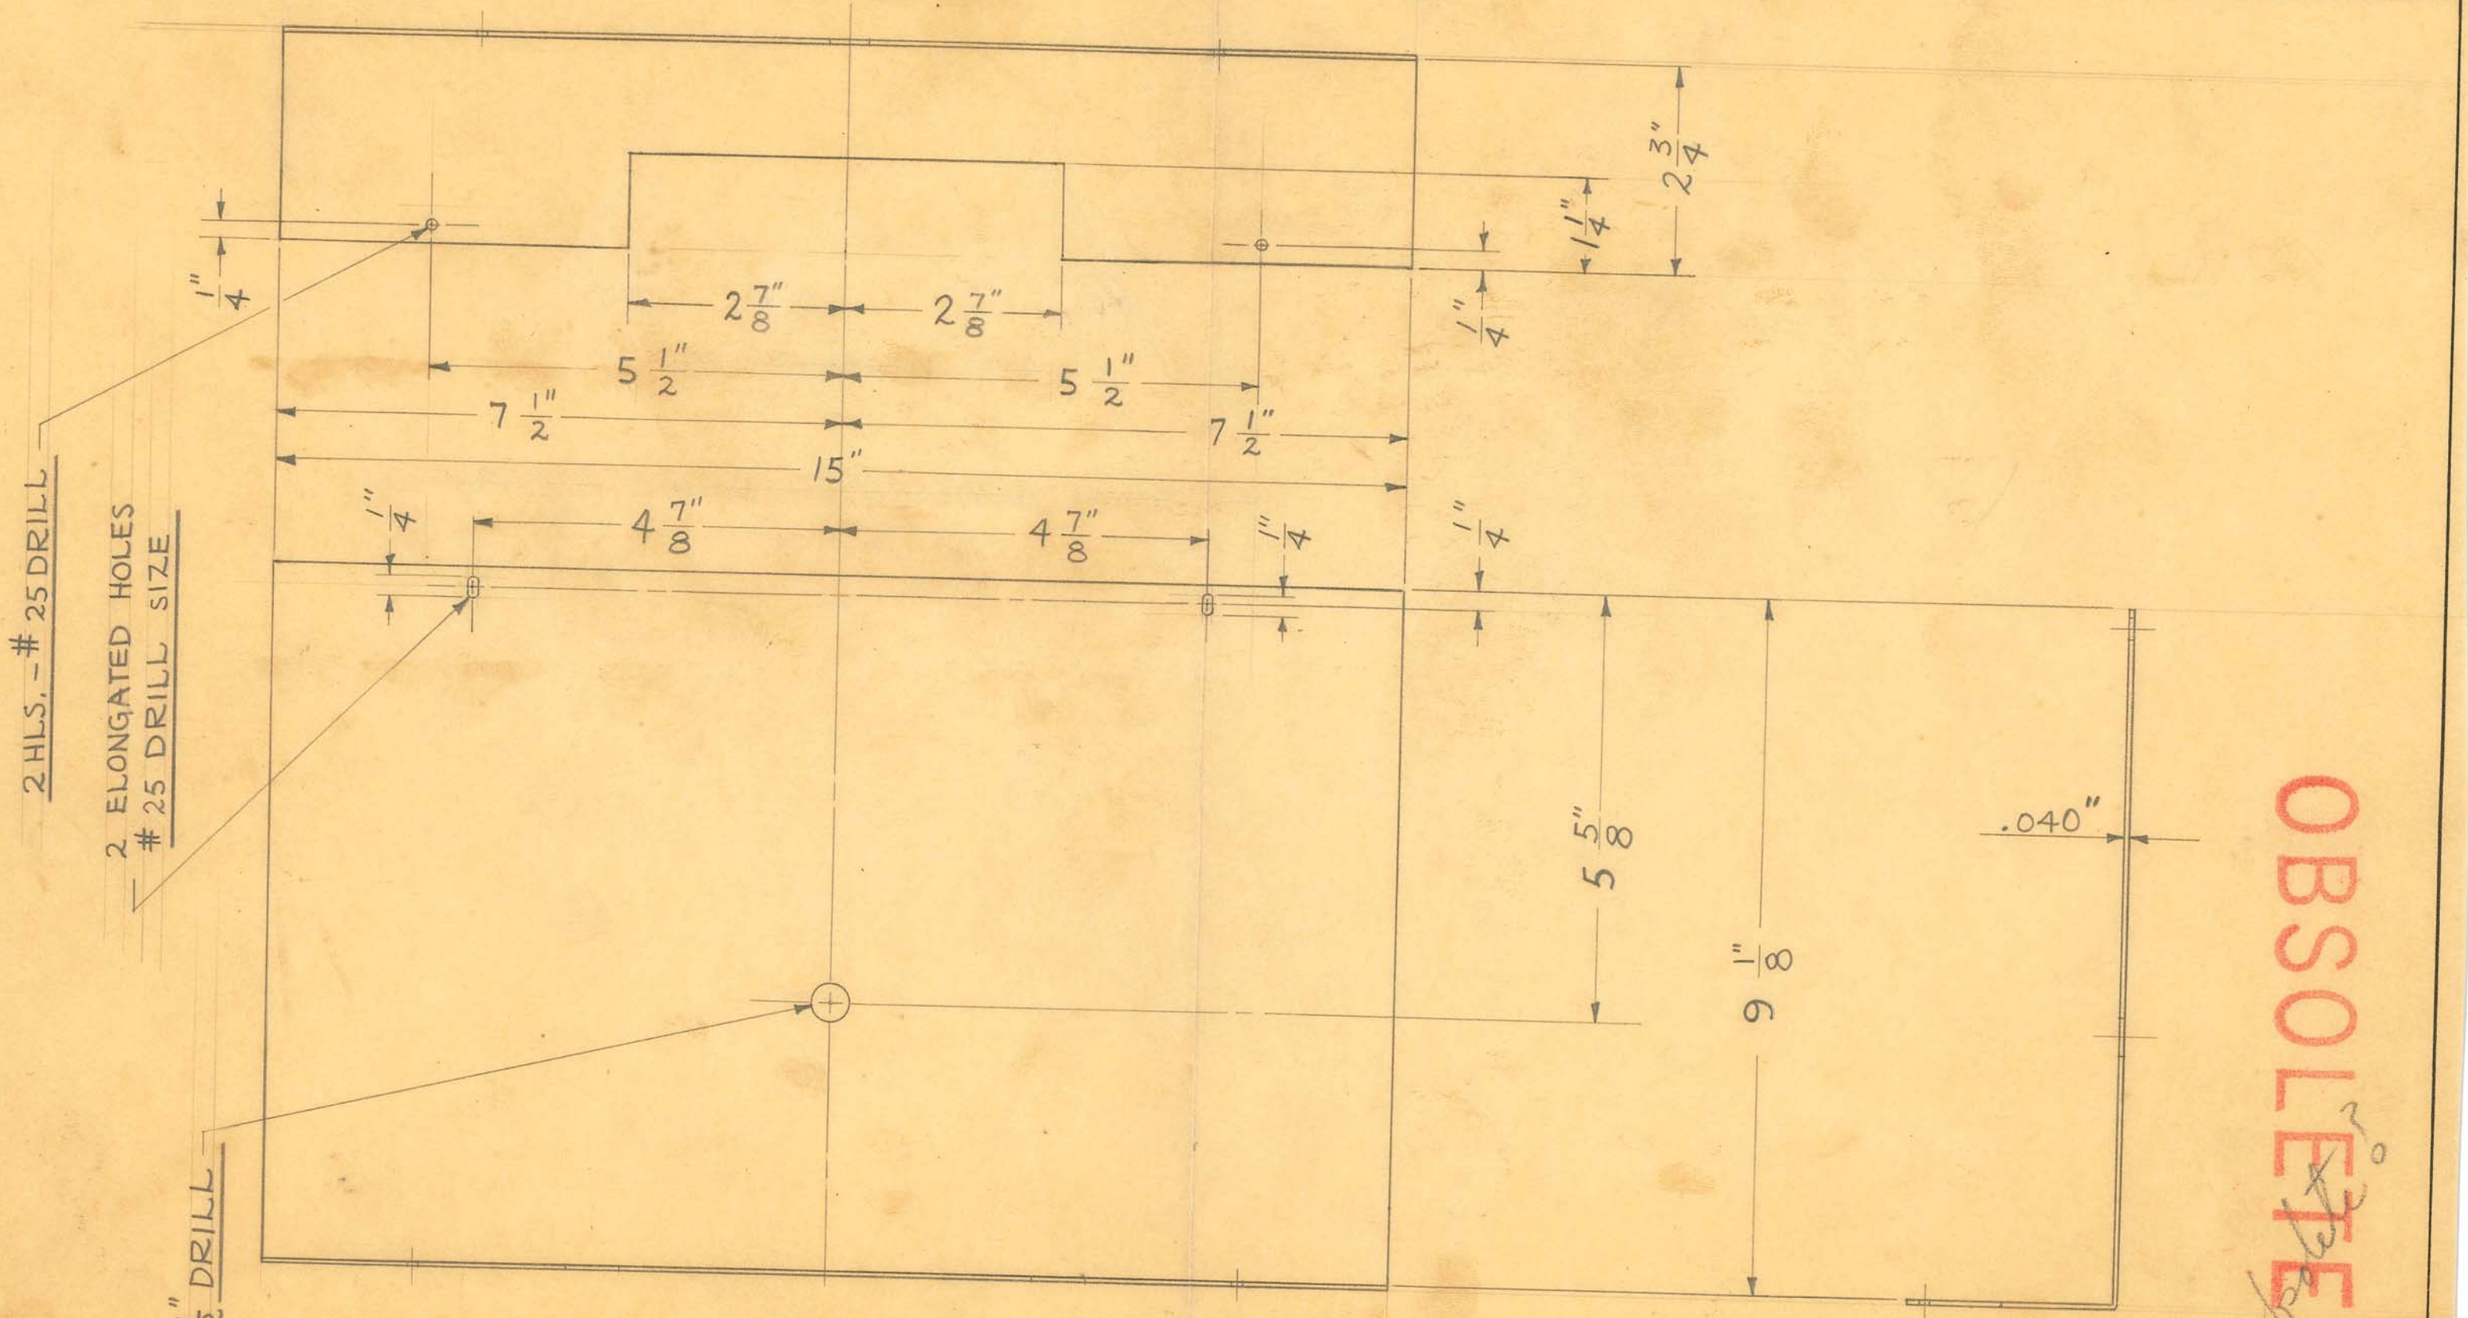

OBSOLETE

SCALE ÷ HALF SIZE

1 REQUIRED

SIZE	.040" SHEET	ISSUE 5-22-46	J.V.W.
KIND	ALUMINUM	CHANGED	
SHAPE		"	
FINISH		"	
TEMP.		"	
PATT.		"	

TITLE:
FISCHER "FCW" SHORT WAVE OUTFIT
OSCILLATING UNIT BAFFLE PLATE-TOP

H. G. FISCHER & CO.
2338 WABANSIA AVE.

CAT. NO.

PART NO. 16-346

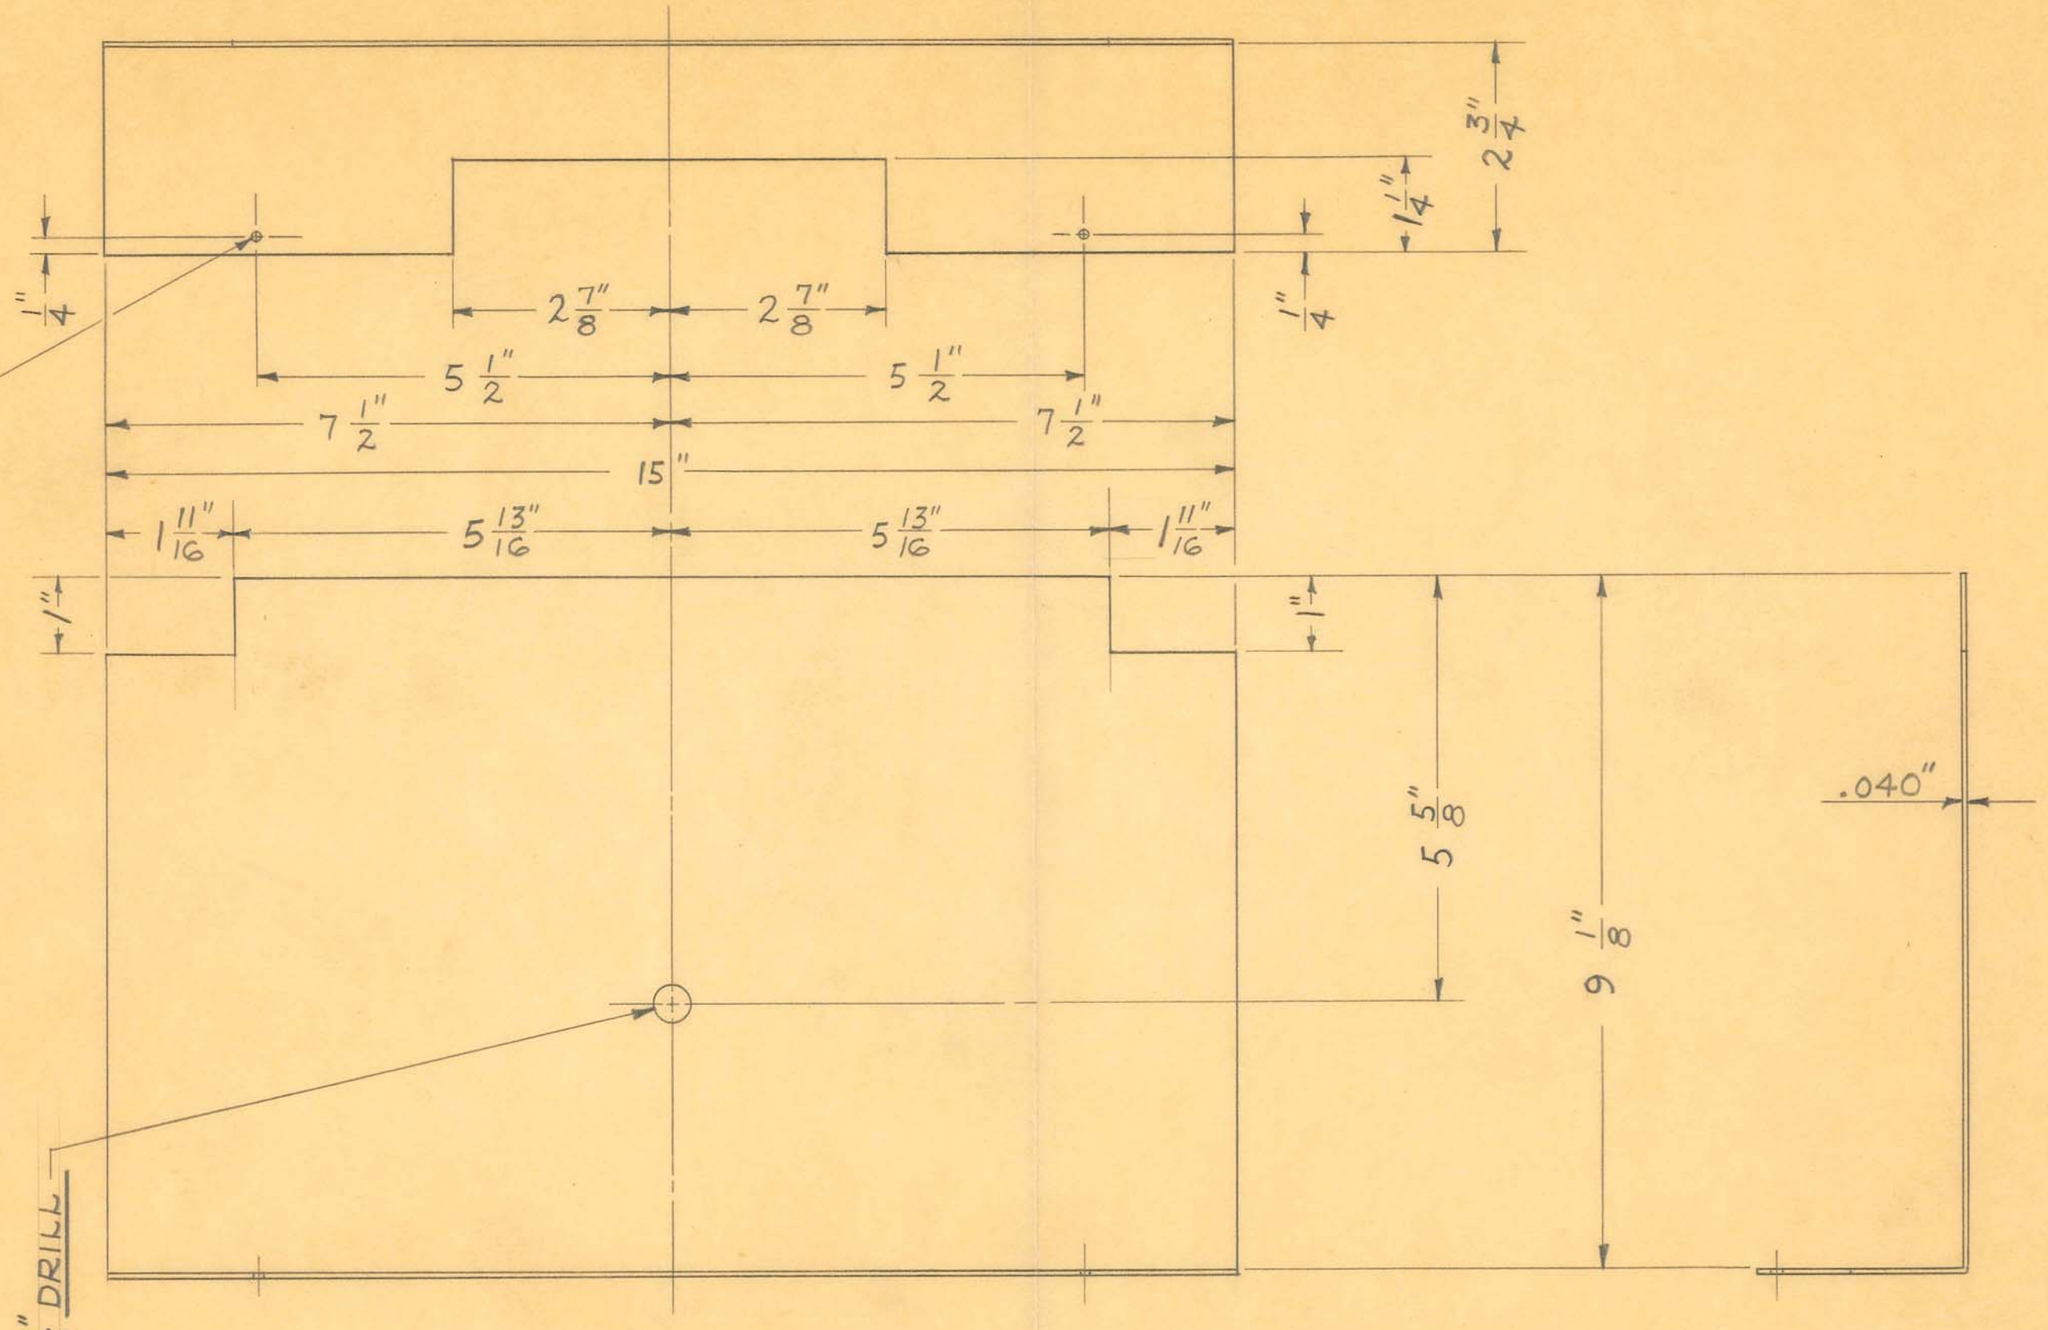

SCALE ~ HALF SIZE

1 REQUIRED

SIZE	.040" SHEET	ISSUE 9-13-46	J.V.W.
KIND	ALUMINUM	CHANGED	
SHAPE		"	
FINISH		"	
TEMP.		"	

TITLE:
FISCHER "FCW" SHORT WAVE OUTFIT
OSCILLATING UNIT BAFFLE PLATE - TOP

H. G. FISCHER & CO.
2335 WABANSIA AVE.

CAT. NO.

PART NO. 16346A

OBSOLETE

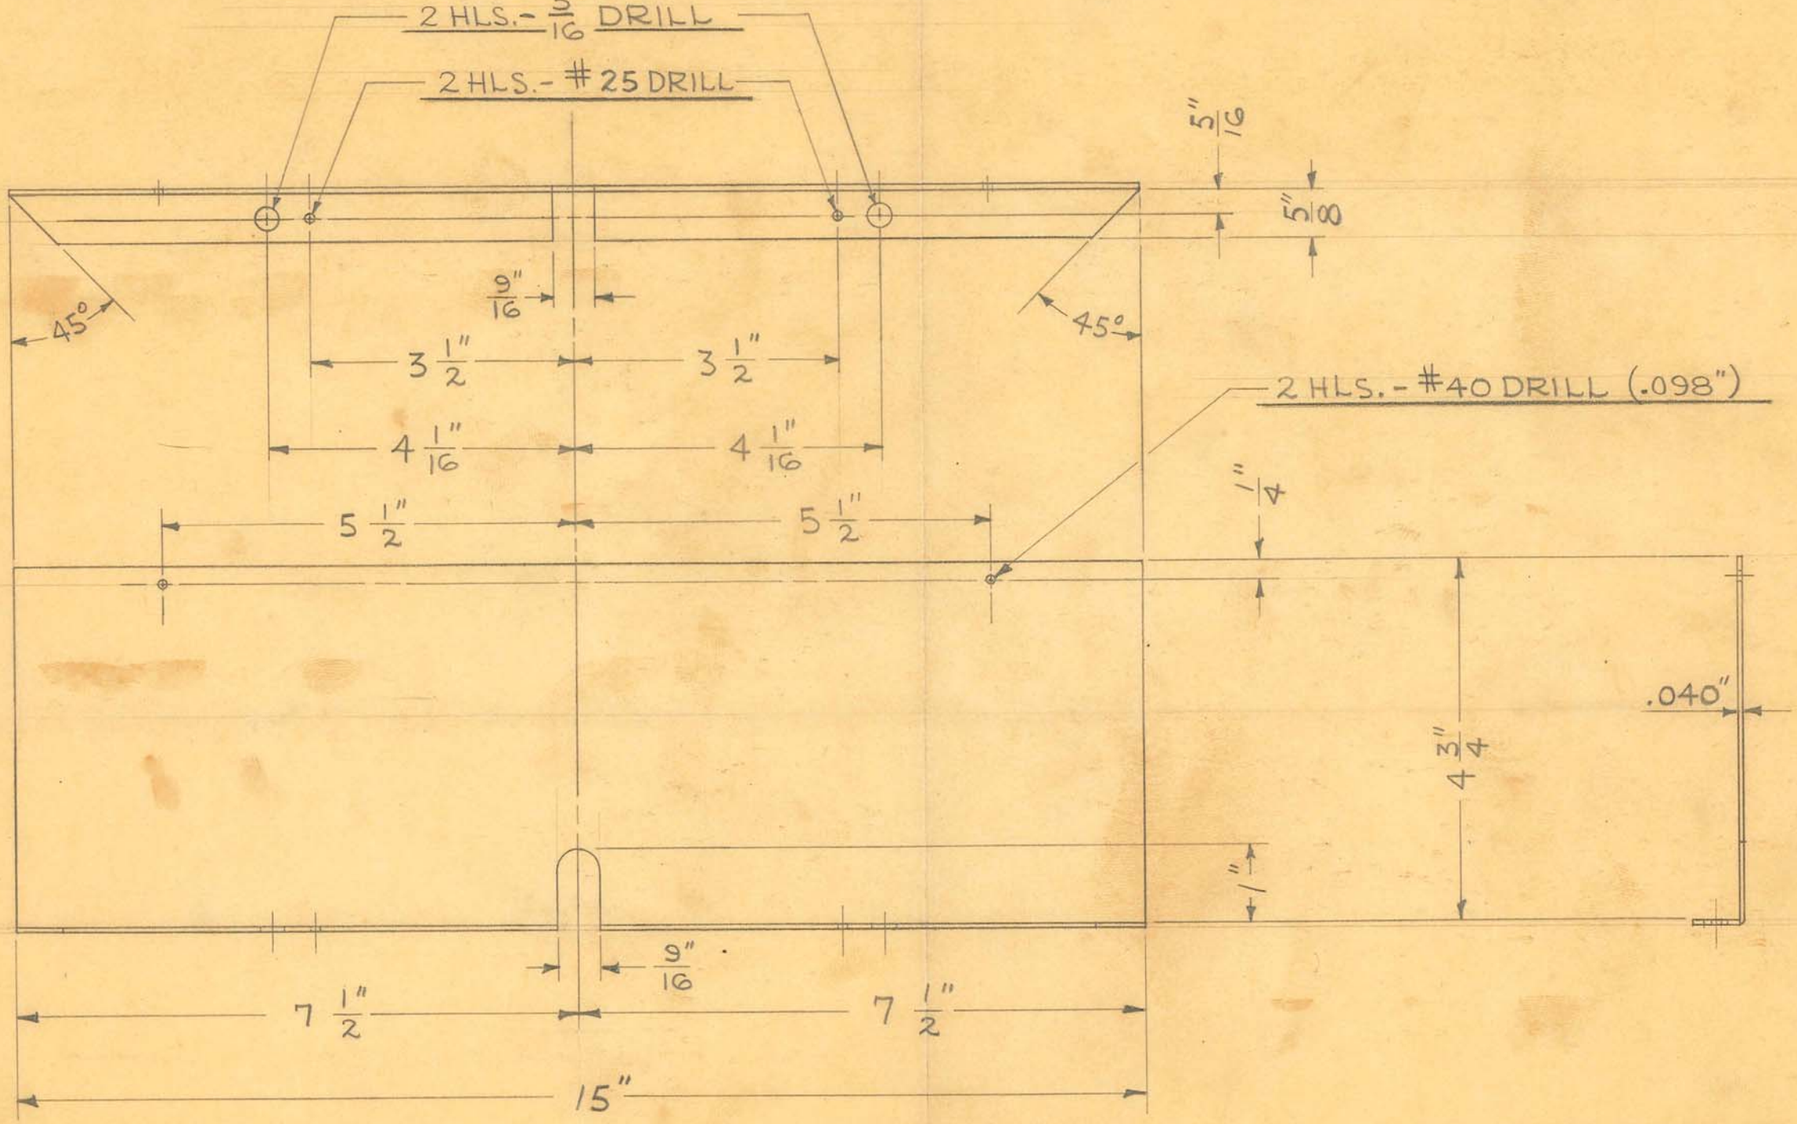

SCALE ÷ HALF SIZE

1 REQUIRED

OBSOLETE

Obsolete?

SIZE	.040" SHEET	ISSUE 5-22-46	J.V.W.	
KIND	ALUMINUM	CHANGED		
SHAPE		"		
FINISH		"		
TEMP.		"		

TITLE:
FISCHER "FCW" SHORT WAVE OUTFIT
OSCILLATING UNIT BAFFLE PLATE - REAR

H. G. FISCHER & CO.
2335 WABANSIA AVE.

CAT. NO.

PART NO. 16347

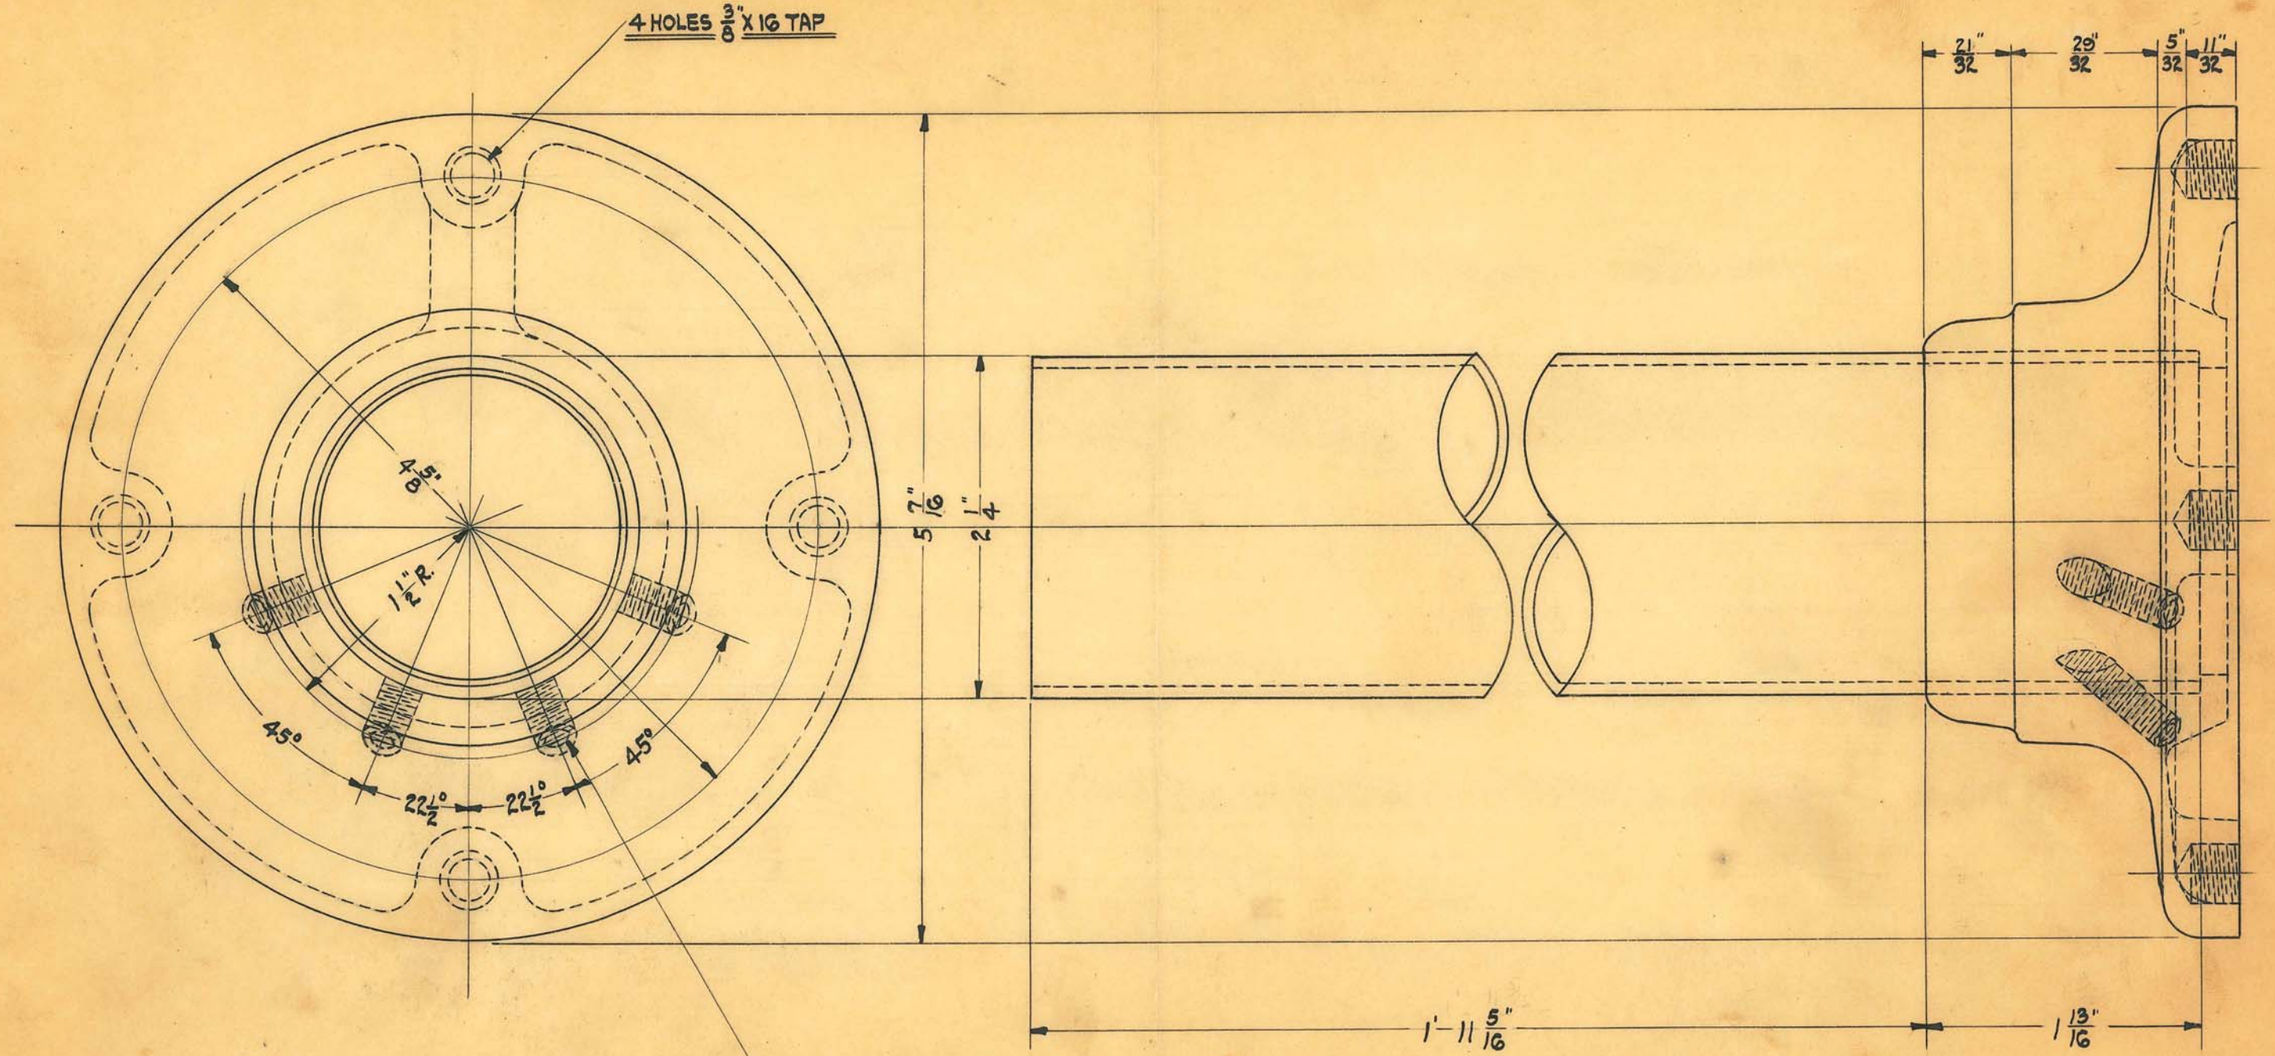

SIZE		ISSUE H.E.	1-16-30
KIND		CHANGED	
SHAPE		" "	
FINISH		" "	
TEMP.		" "	
PATT.		" "	

TITLE: "DENTAL X" UPRIGHT SLEEVE COMPLETE

OBSOLETE

H. G. FISCHER & CO.
2335 WABANSIA AVE.
CHICAGO, ILL.

CAT. NO.

PART NO. 6192G

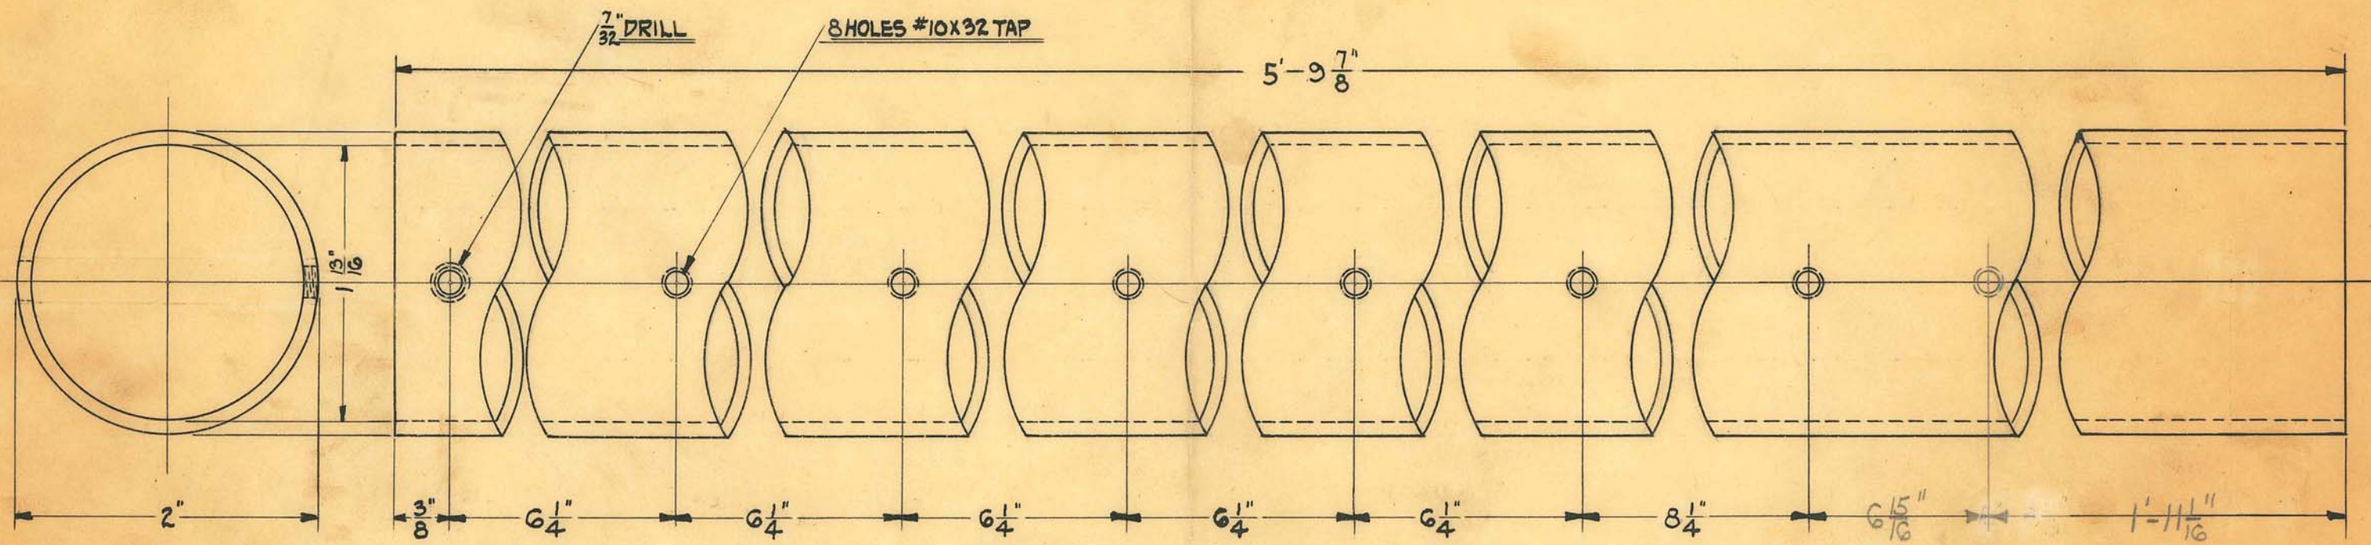

DRILL HOLES ON WELDED SEAM

SIZE	2" O.D. X 13 GA.	ISSUE	H.E.	1-13-30
KIND	SEAMLESS STEEL TUBING	CHANGED		
SHAPE	ROUND	"	"	
FINISH	~~POLISH & PLATE~~	"	"	
~~TEMP.~~	CHROME #2	"	"	
PATT.		"	"	

TITLE: "DENTAL X" COLUMN

OBSOLETE

H. G. FISCHER & CO.
2335 WABANSIA AVE.
CHICAGO, ILL.

CAT. NO.

PART NO. 6193F

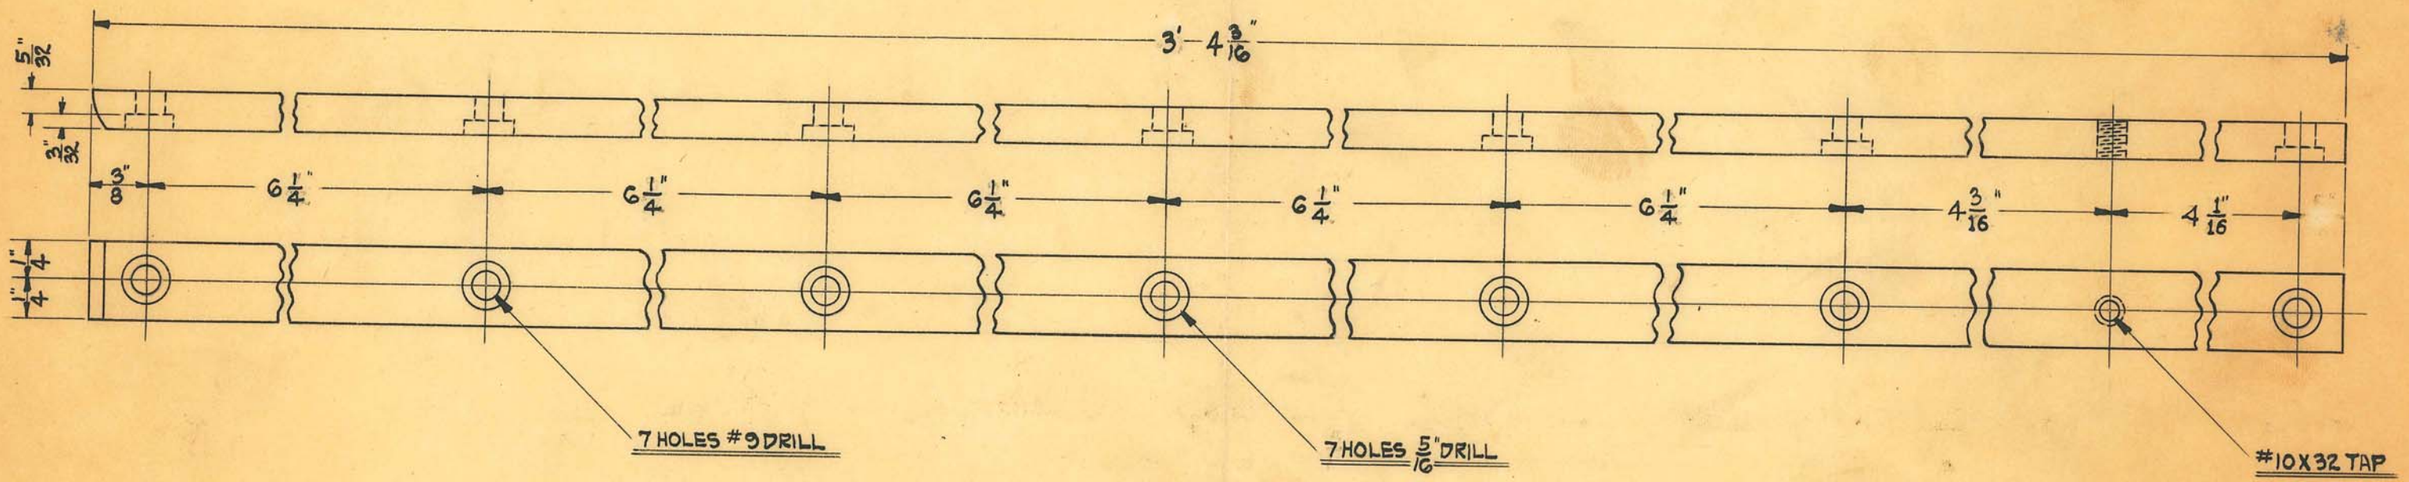

SIZE	1/4" X 1/2"	ISSUE	H.E.	1-17-30
KIND	COLD ROLL	CHANGED	10-10-38	J.W.
SHAPE	STRIP	"	"	
FINISH	W.P.	"	"	
TEMP.		"	"	

TITLE: "DENTAL X" VERTICAL GUIDE STRIP

OBSOLETE

H. G. FISCHER & CO.
2335 WABANSIA AVE.

CAT.

PART G21E0

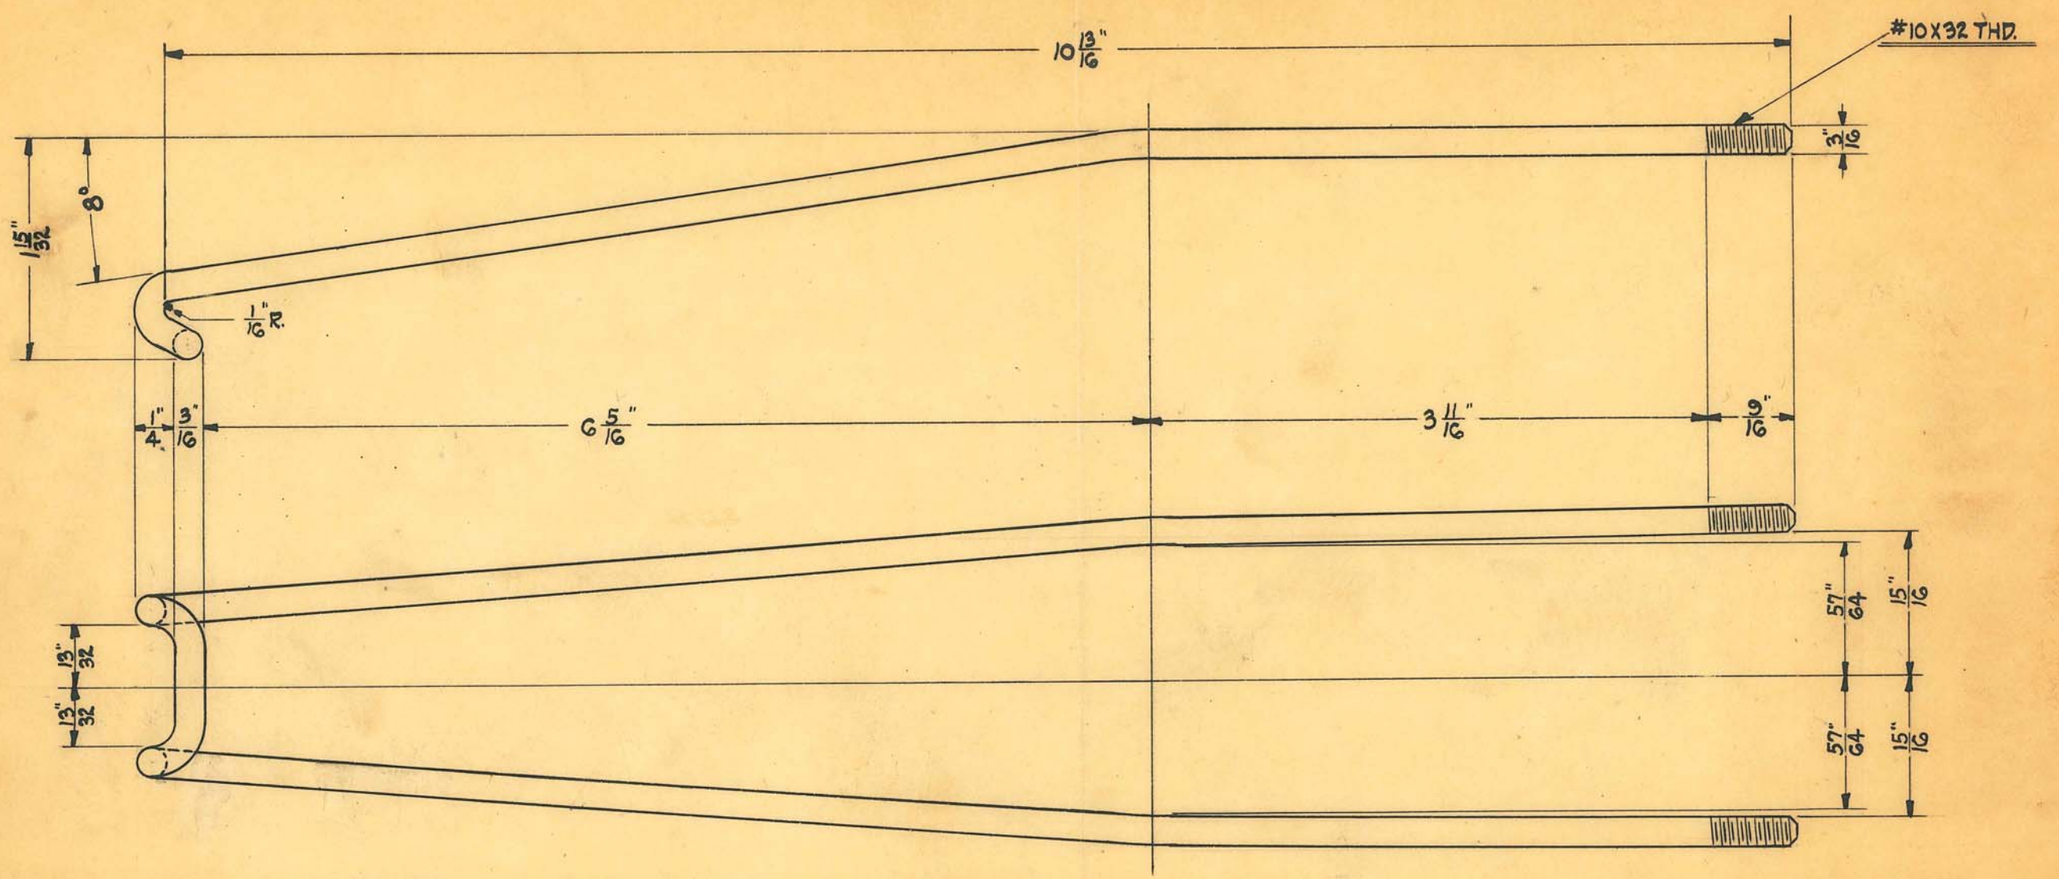

CUT ROD 23 3/16" LONG

SIZE	9/16"	ISSUE H.E.	1-27-30
KIND	BESMER ROD	CHANGED	
SHAPE	ROUND	" "	
FINISH	W.P.	" "	
TEMP.		" "	
PATT.		" "	

TITLE: "DENTAL X" TRANS. TANK SUPPORT BRACKET

OBSOLETE

H. G. FISCHER & CO.
2335 WABANSIA AVE.
CHICAGO, ILL.

CAT. NO.

PART NO. 6251

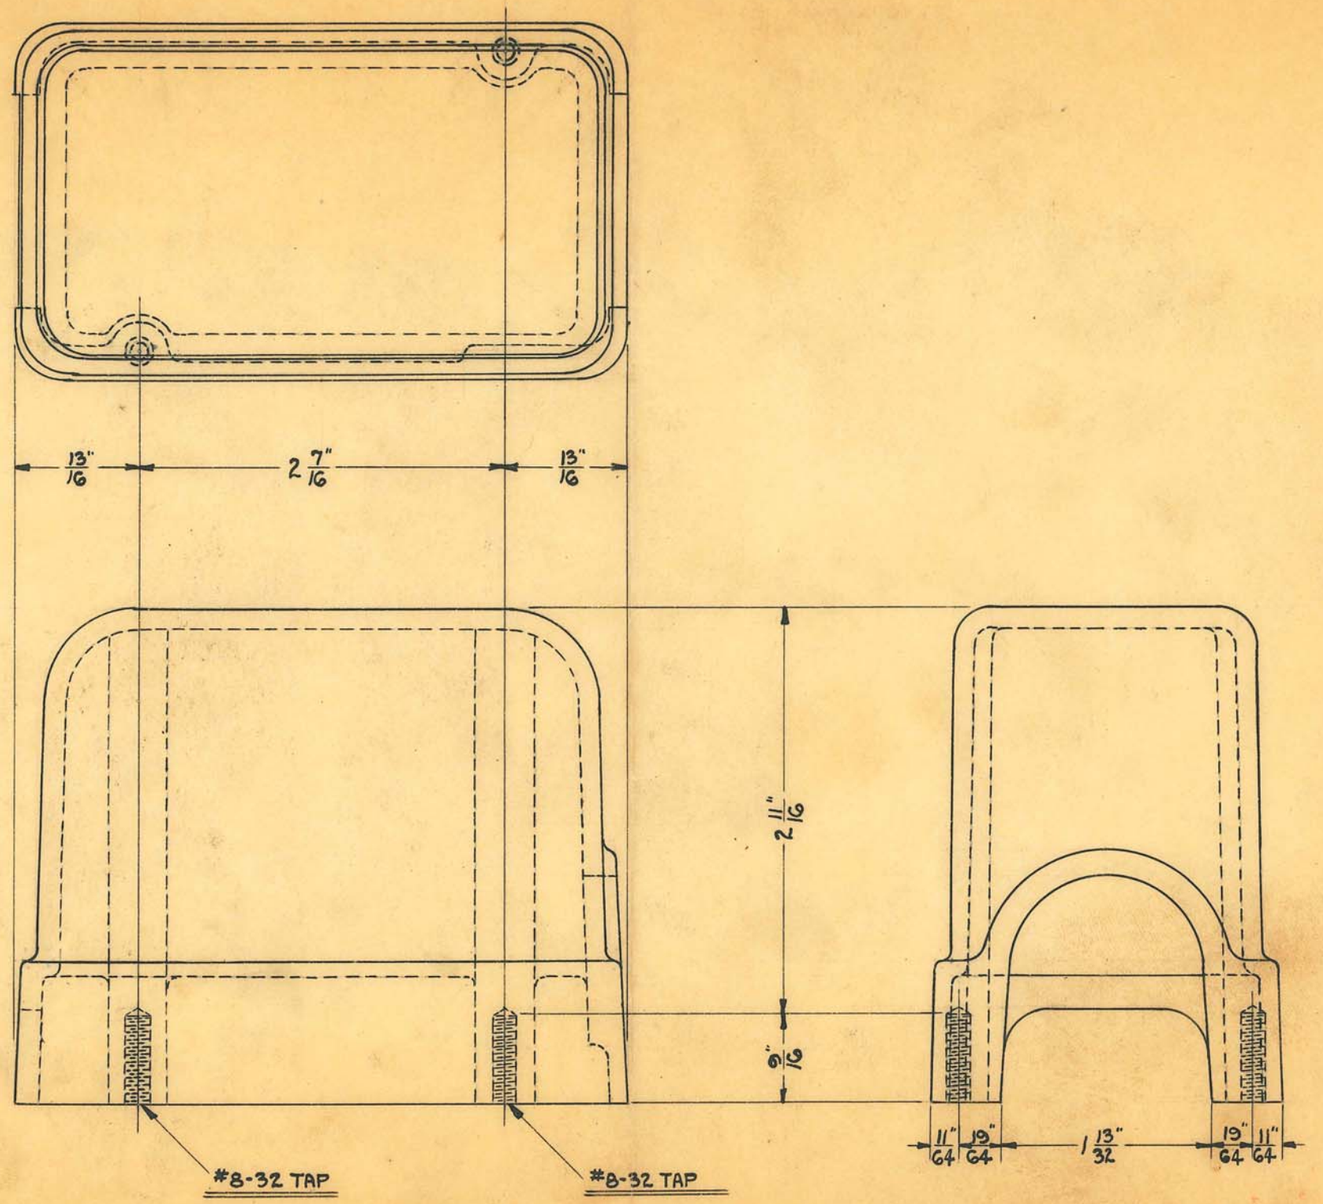

SIZE		ISSUE H.E.	12-18-29
KIND	ALUMINUM CASTING	CHANGED	
SHAPE		" "	
FINISH	MAH. GRAIN	" "	
TEMP.		" "	
PATT.		" "	

TITLE: "DENTAL X" LINE CORD COVER

OBSOLETE

H. G. FISCHER & CO.
2335 WABANSIA AVE.
CHICAGO, ILL.

CAT. NO.

PART NO. 6253F

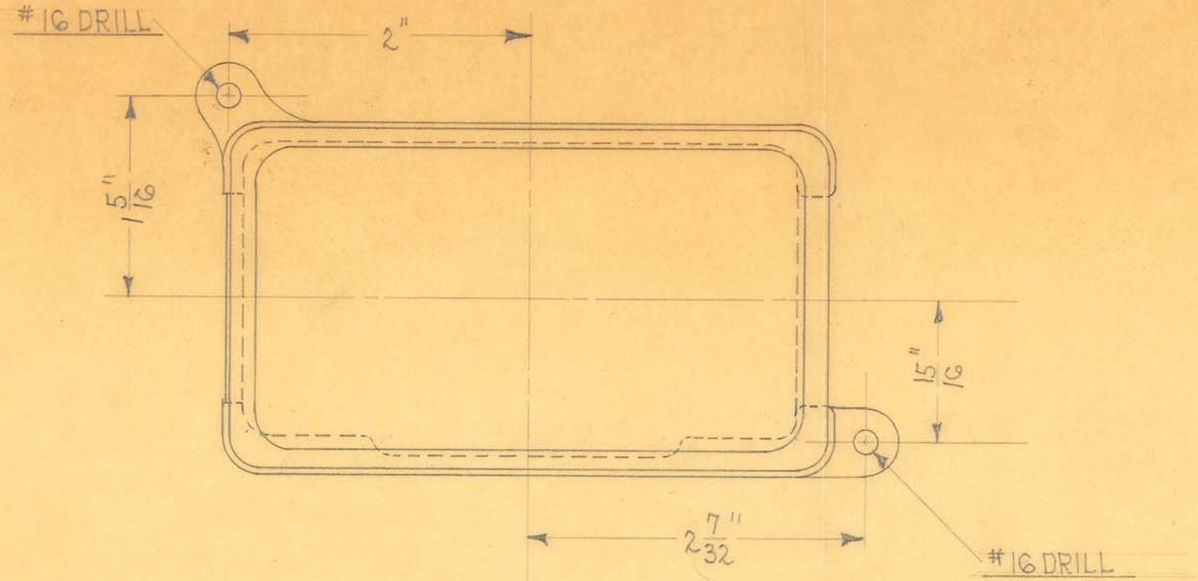

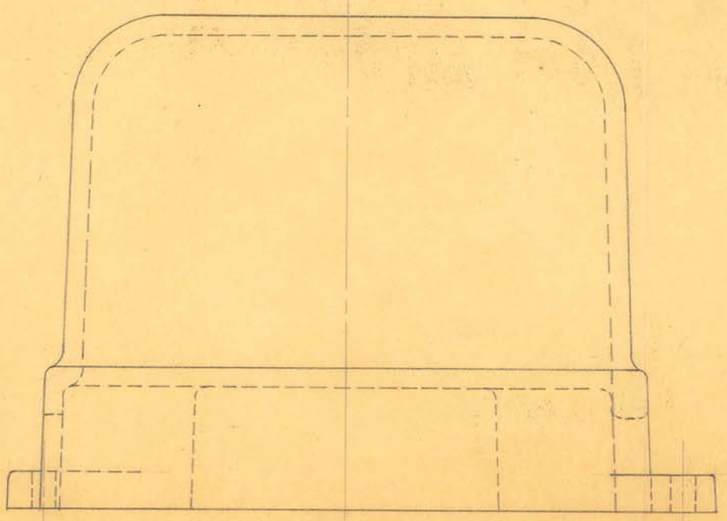

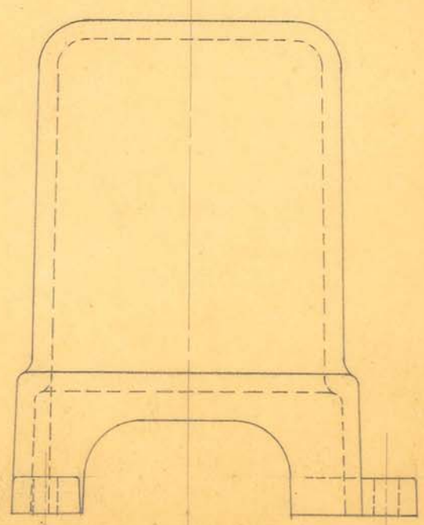

OBSOLETE

SIZE		ISSUE 8-26-35	J.E.
KIND	ALUM. CASTING	CHANGED	
SHAPE		" "	
FINISH	MAH. GRAIN	" "	
TEMP.		" "	

TITLE: DENTAL "X" LINE CORD COVER

H. G. FISCHER & CO.
2335 WABANSIA AVE.

CAT. NO.

PART NO. G253BE

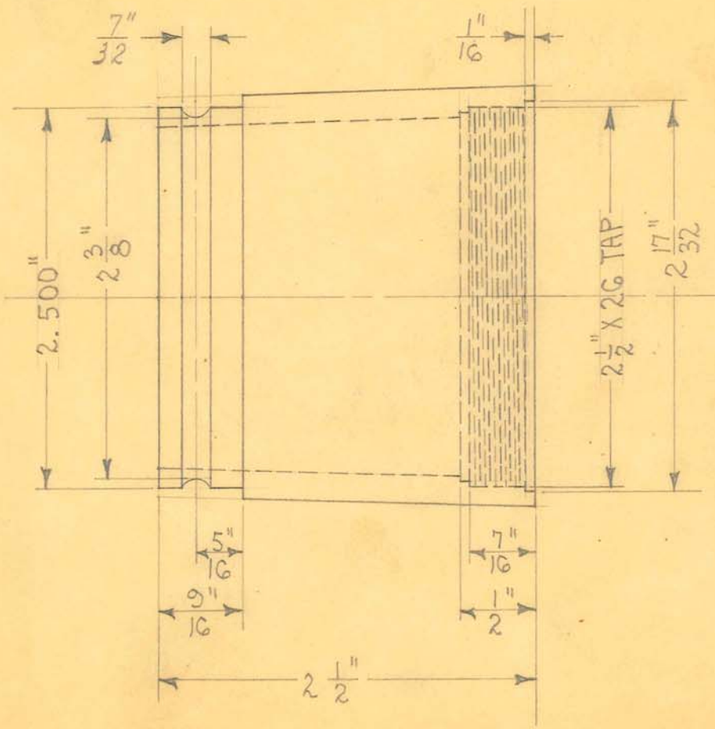

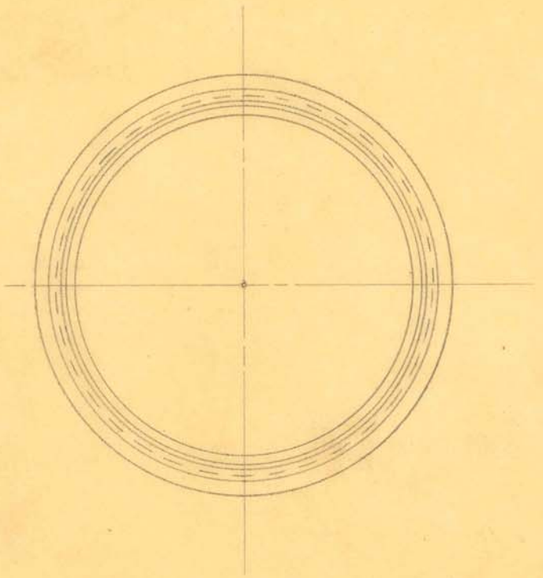

1 REQUIRED

OBSOLETE

SIZE		ISSUE 11-9-35	A.E.
KIND	ALUM. CASTING	CHANGED	
SHAPE		" "	
FINISH	POL. & BUFF	" "	
TEMP.		" "	
PATT.	2810-8931	" "	

TITLE: DENTAL "X" CONE ADAPTER

H. G. FISCHER & CO.
2335 WABANSIA AVE.
CHICAGO, ILL.

CAT. NO. 3921

PART NO. 6255 1/2 F

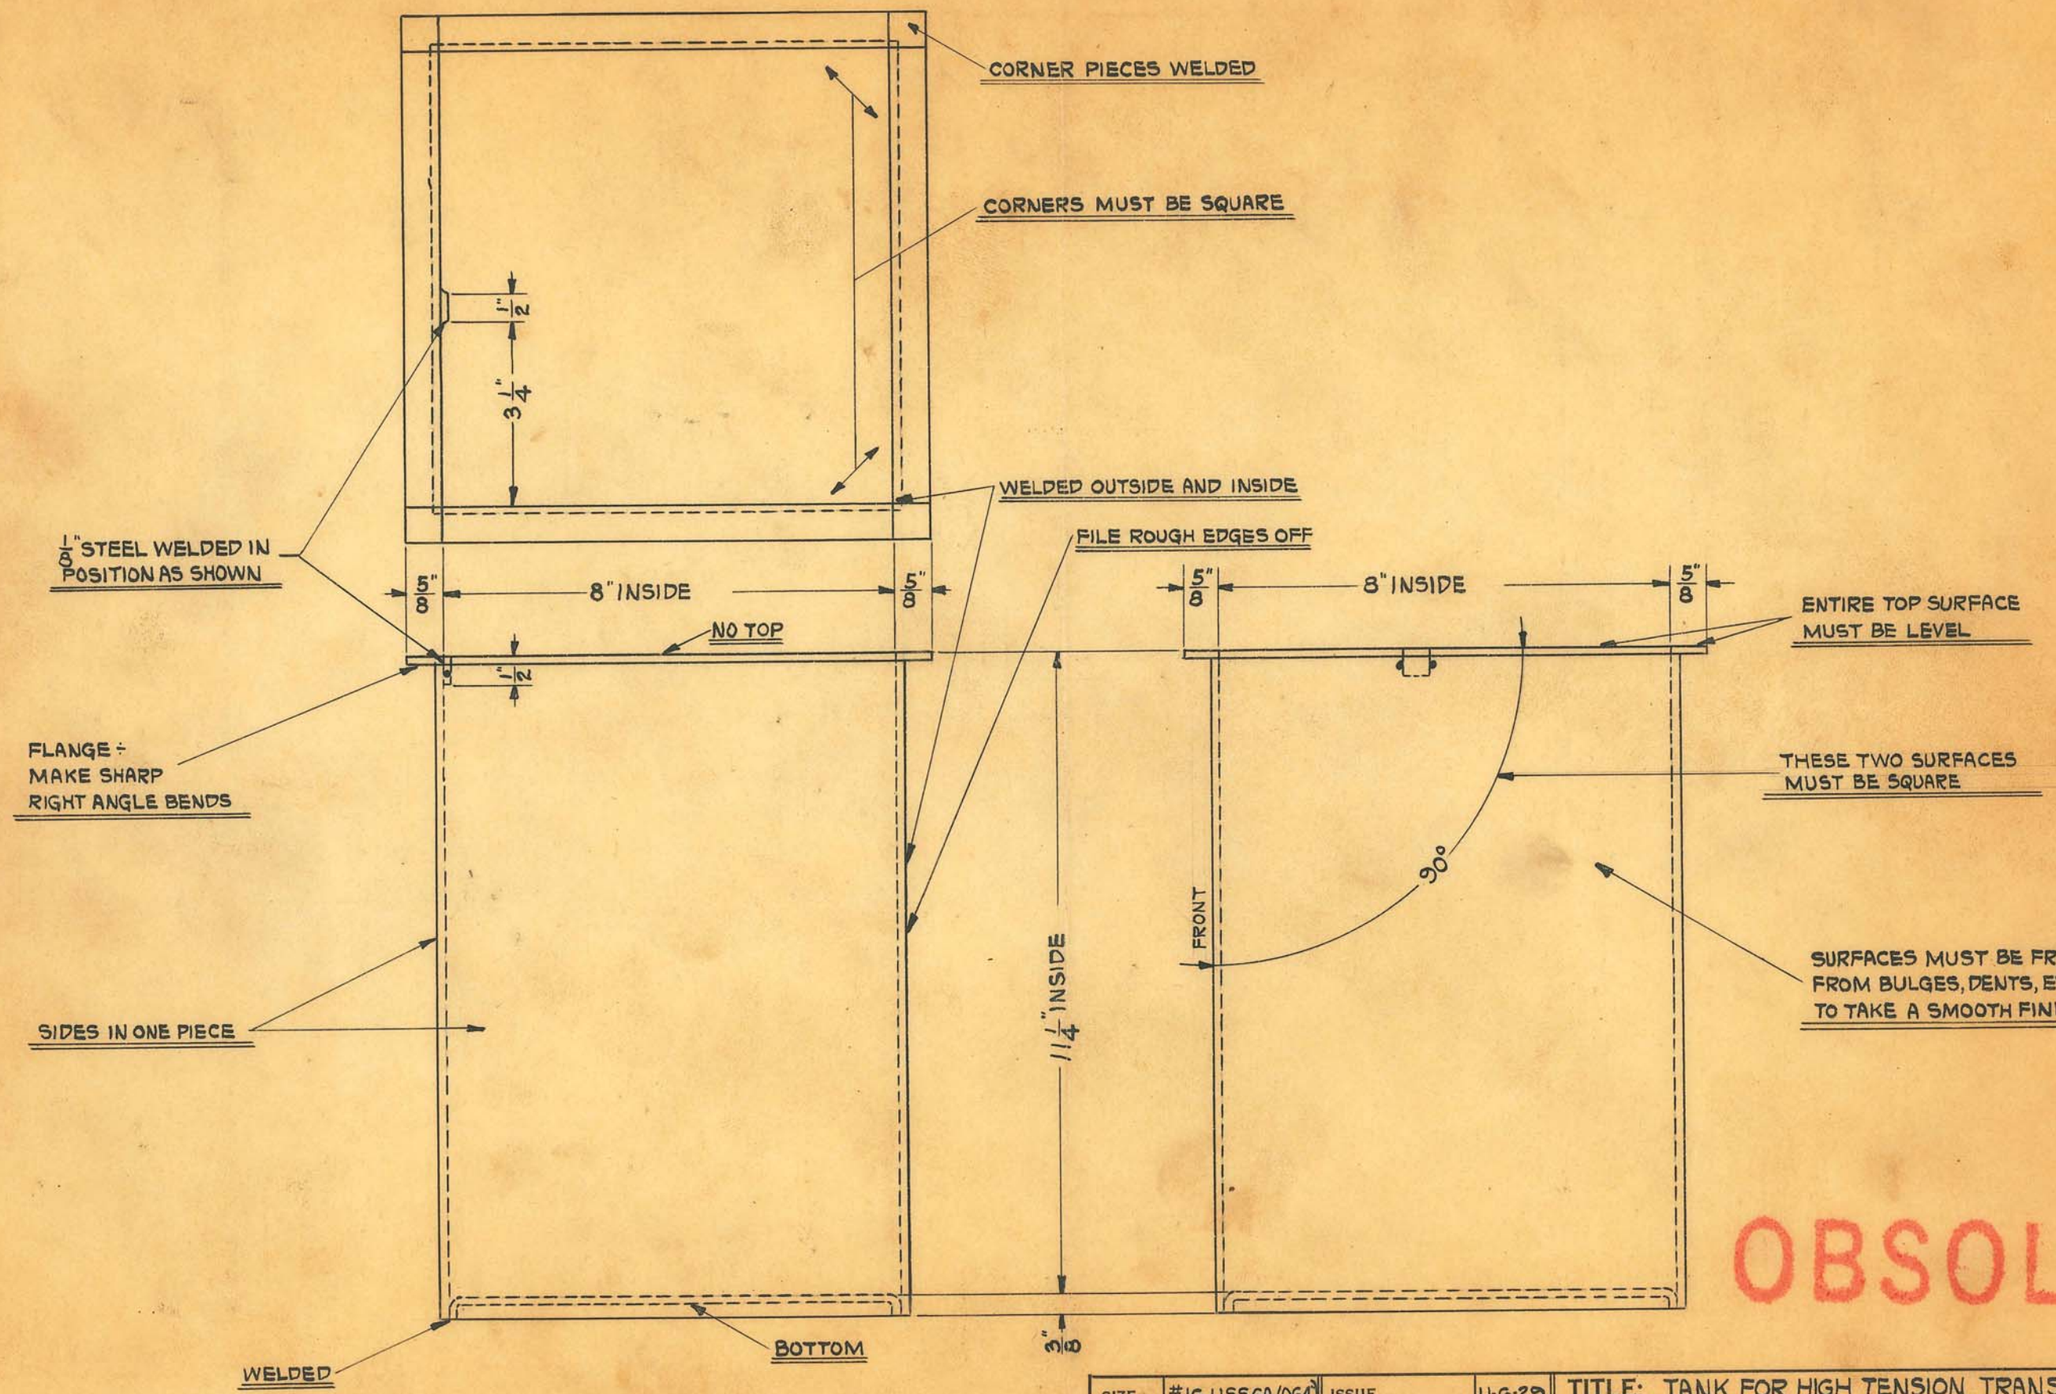

OBSOLETE

SCALE ÷ 3/8" = 1"

WELDED - MUST BE OIL TIGHT.
TEST FOR LEAKS WITH KEROSENE.
GIVE OUTSIDE OF TANK KEROSENE BATH

SIZE	#16 U.S.S.GA.(064)	ISSUE	11-6-29
KIND	FURNITURE STEEL	CHANGED	
SHAPE	STRIP	" "	
FINISH		" "	
TEMP.		" "	

TITLE: TANK FOR HIGH TENSION TRANSFORMER FOR "DENTAL X" - 25 CYCLE

H. G. FISCHER & CO.
2335 WABANSIA AVE.

CAT. NO.

PART NO. 6276F

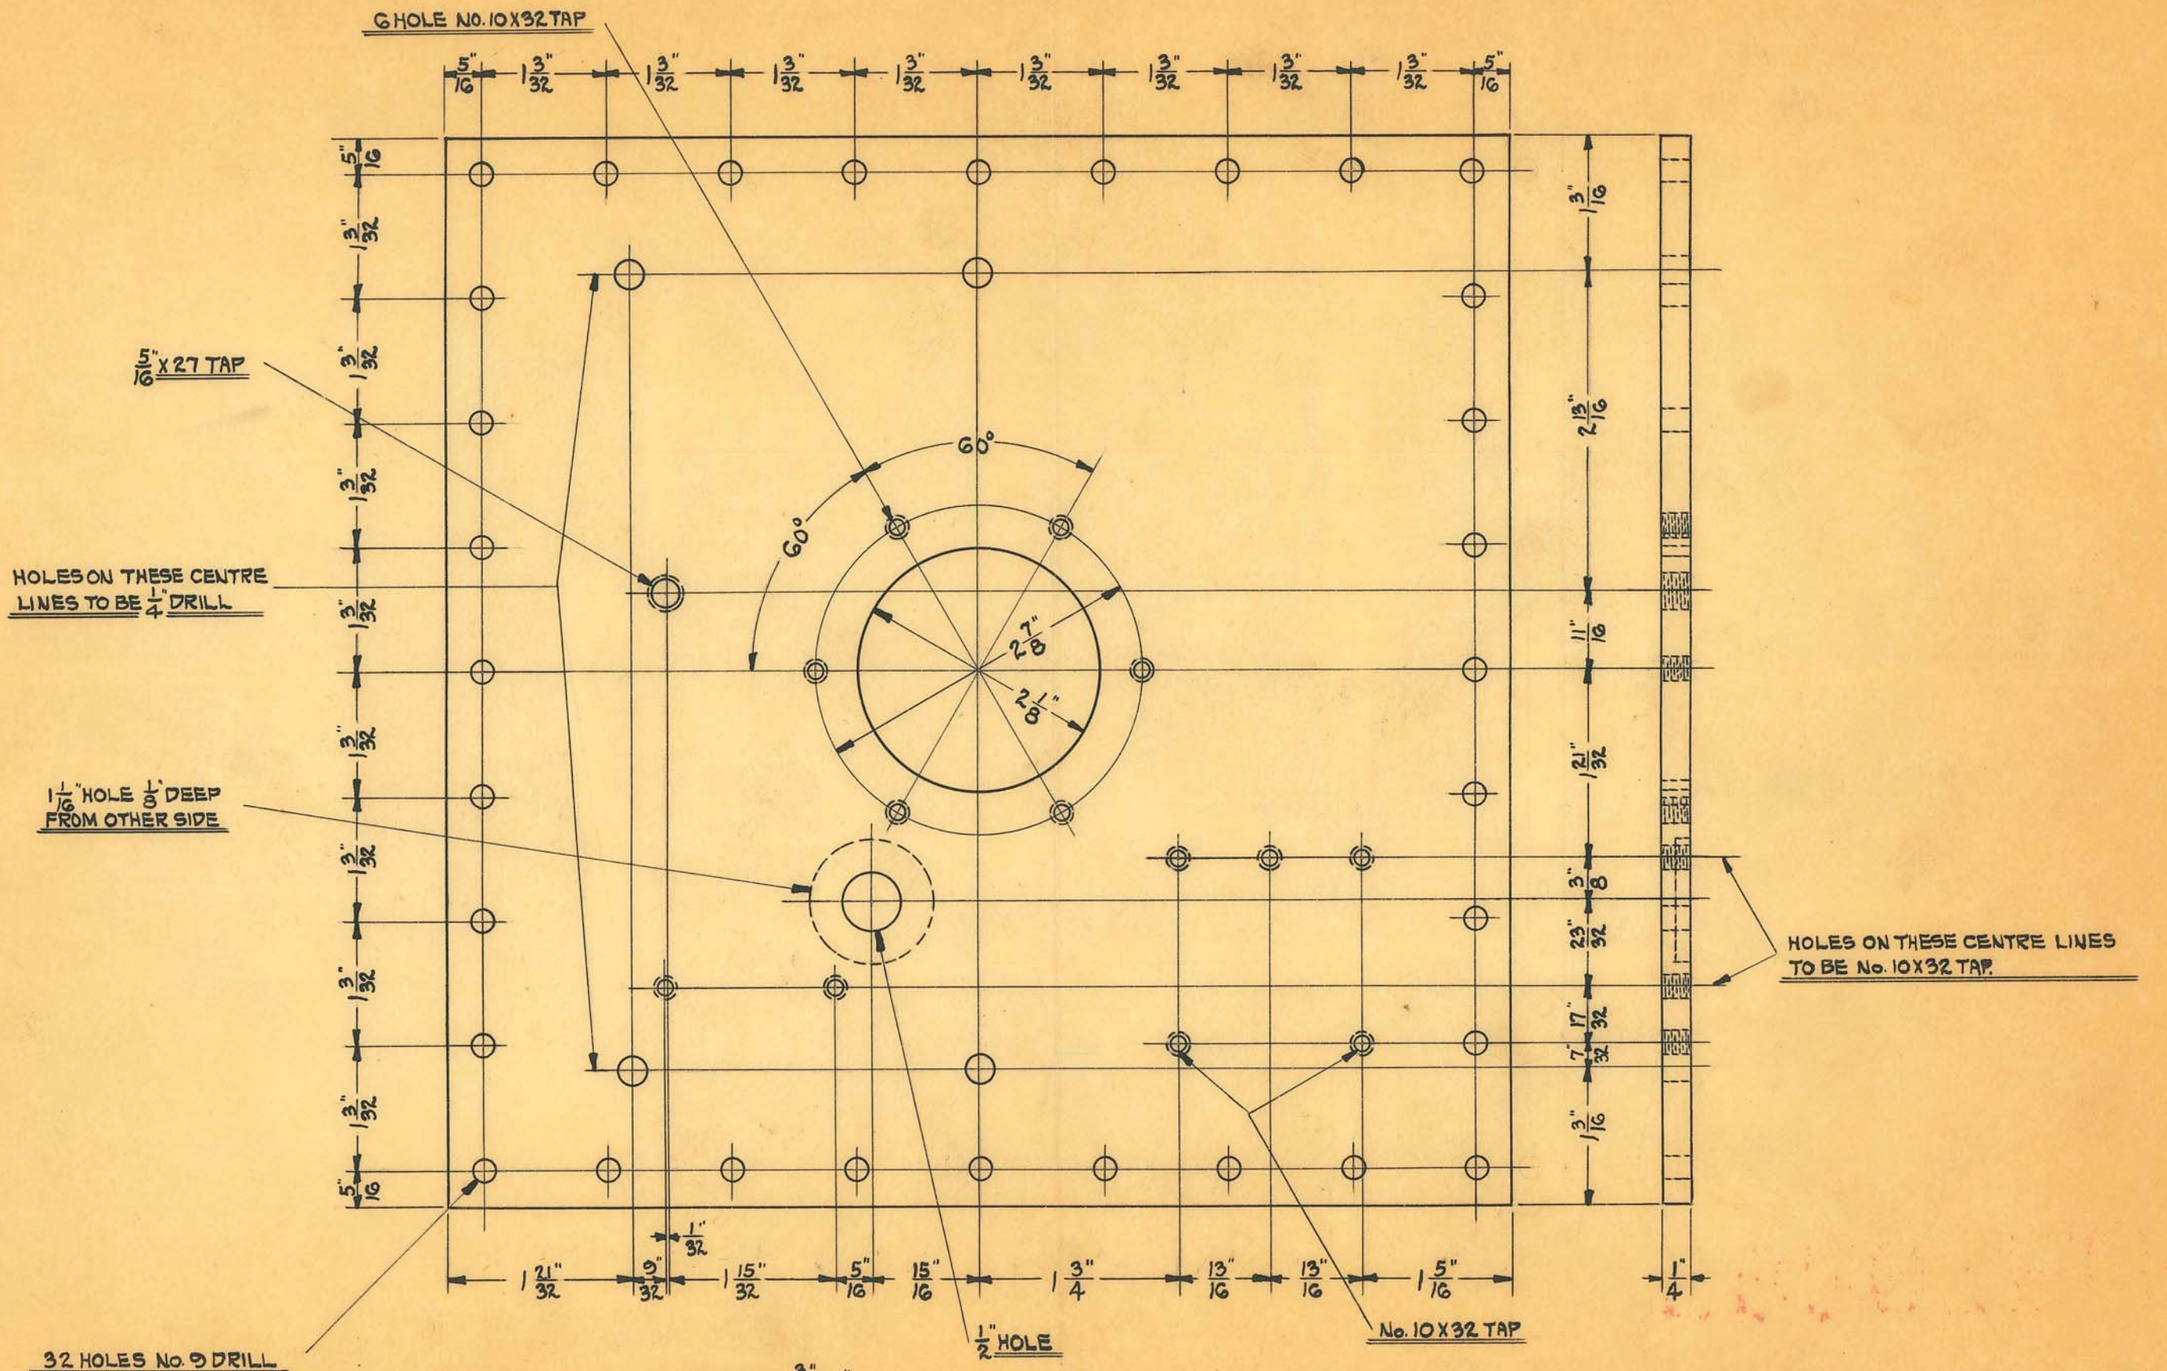

SCALE ~ 3/4" = 1"
BOUGHT OUTSIDE

SIZE		ISSUE	H.E.	2-6-30
KIND		CHANGED		
SHAPE		"	"	
FINISH		"	"	
TEMP.		"	"	
PATT. #		"	"	

TITLE: "25 CYCLE DENTAL X" TRANSFORMER TANK COVER

OBSOLETE

H. G. FISCHER & CO.
2335 WABANSIA AVE.
CHICAGO, ILL.

CAT. NO.

PART NO. G277F

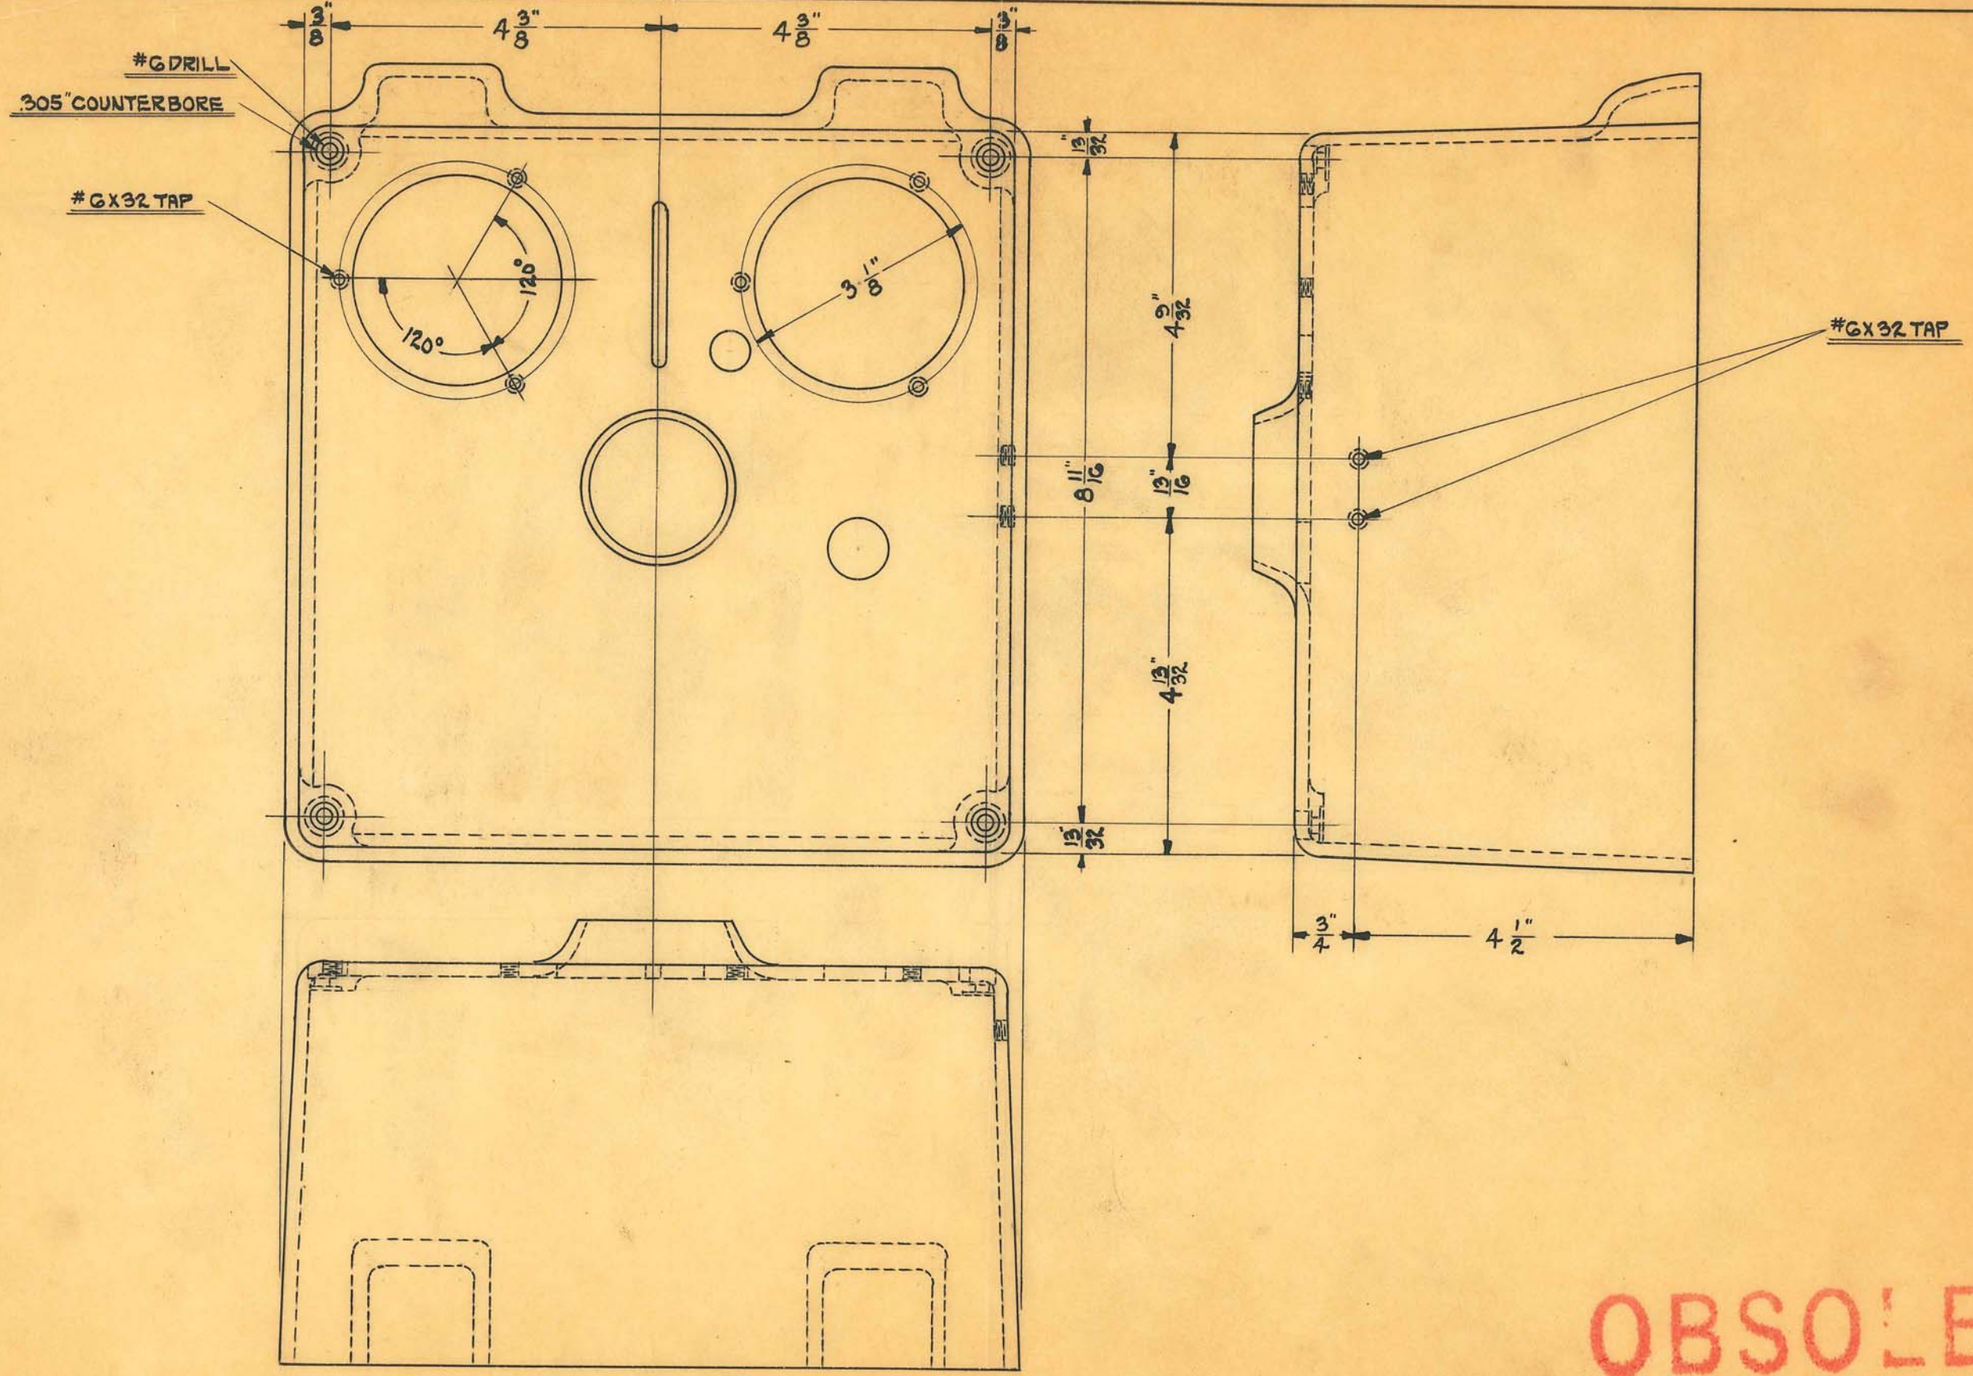

SCALE ~ 1/2 SIZE

OBSOLETE

SIZE		ISSUE H.E.	2-10-30	TITLE: "25 CYCLE DENTAL X" CONTROL HOUSING
KIND	ALUM. CASTING	CHANGED		
SHAPE		" "		
FINISH	MAH. GRAIN	" "		
TEMP.		" "		H. G. FISCHER & CO. 2335 WABANSIA AVE. CHICAGO, ILL. — CAT. NO. — PART NO. G278F
PATT.		" "		

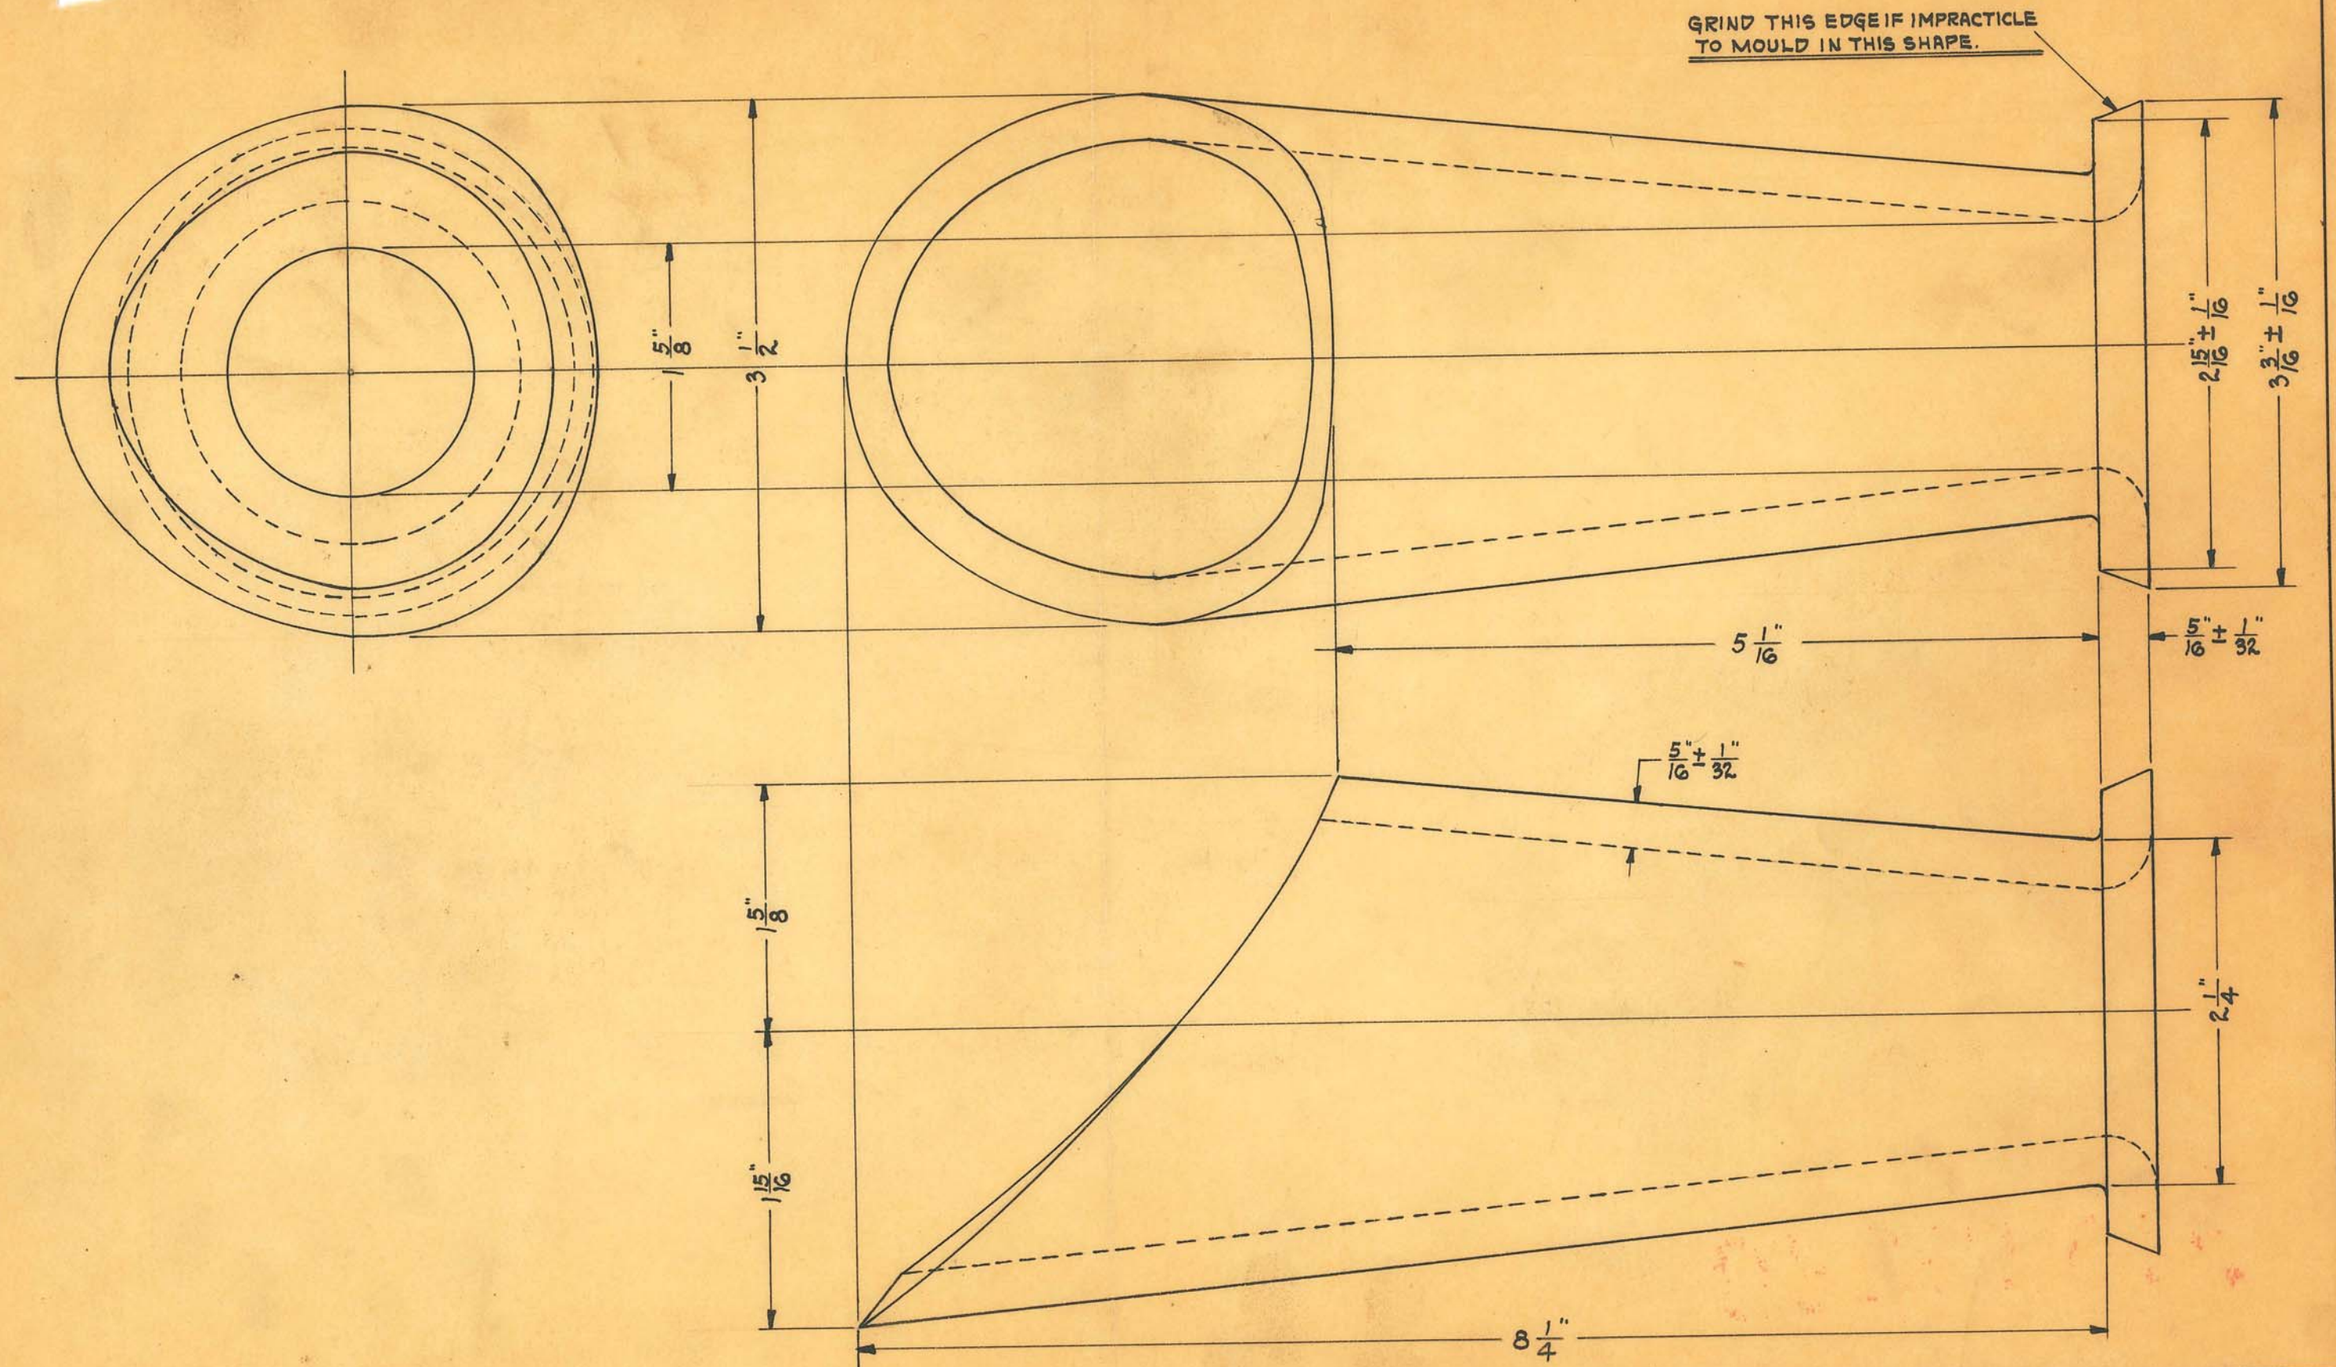

SIZE	MOULDED	ISSUE H.E.	3-24-30
KIND	LEAD GLASS	CHANGED	
SHAPE		" "	
FINISH		" "	
TEMP.		" "	

TITLE: LEAD GLASS DENTAL CONE FOR FLUOROSCOPIC UNIT

OBSOLETE

H. G. FISCHER & CO.
2335 WABANSIA AVE.
CHICAGO, ILL.

CAT. NO.

PART NO. 6402

2 HLS. - 5/16" DRILL - 1" DEEP.
3/8" X16 TAP - 3/4" DEEP

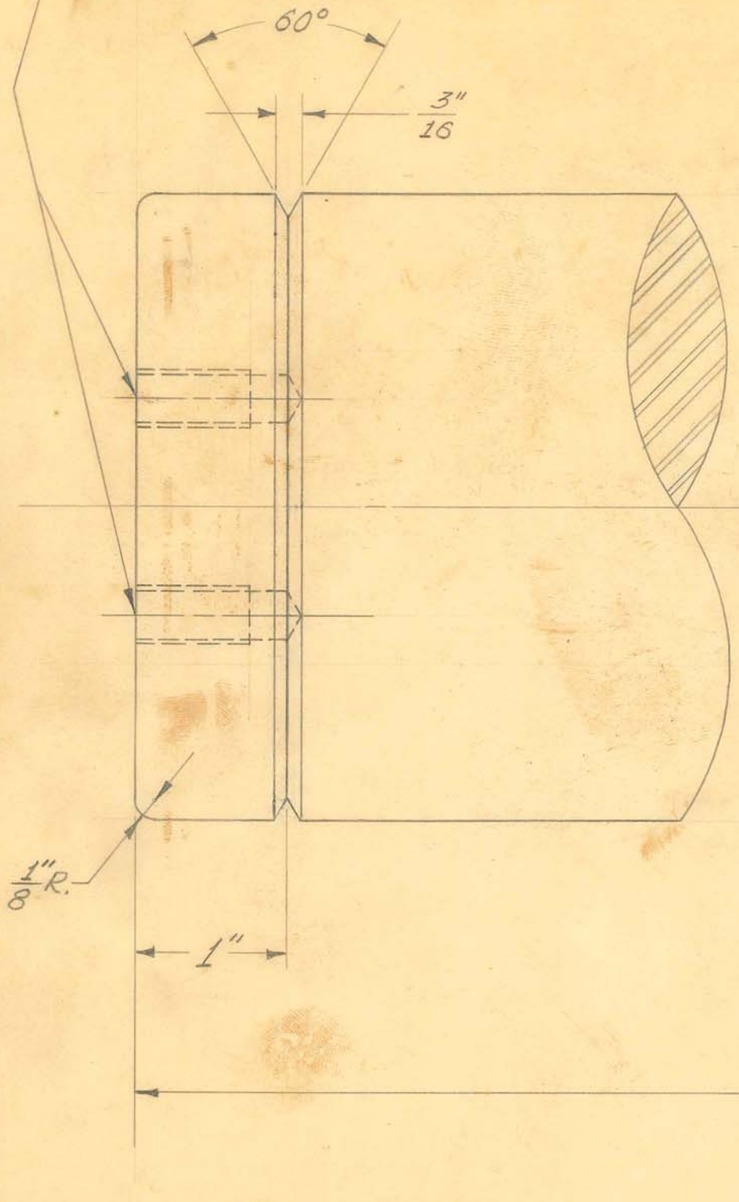

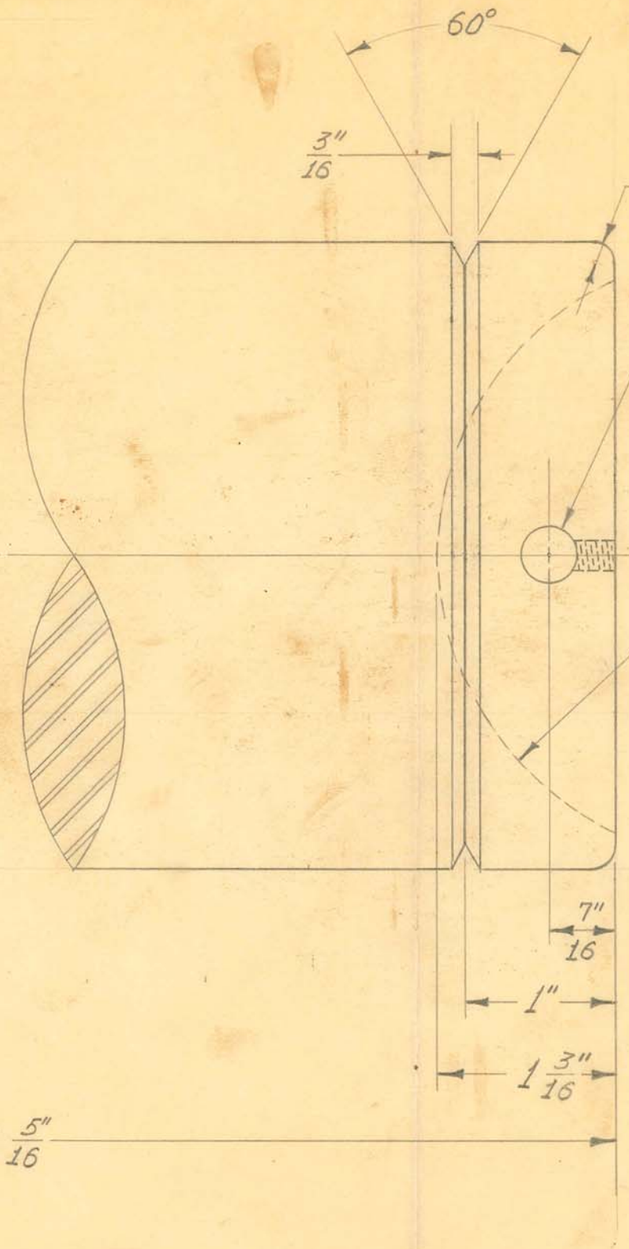

3/8" DRILL

2 HLS. - #10X32 TAP

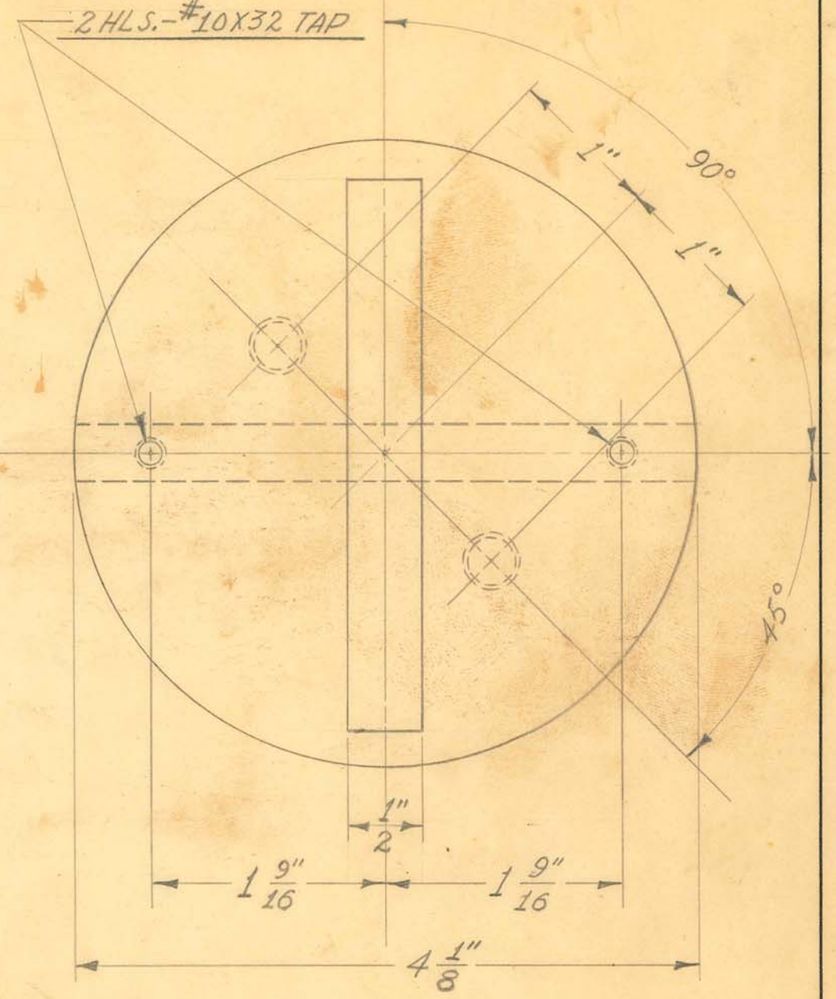

OBSOLETE

1 REQUIRED

SIZE	4 1/8" DIAM.	ISSUE 7-12-39	J.W.
KIND	C.R. STEEL	CHANGED	
SHAPE		"	
FINISH		"	
TEMP.		"	
PATT.		"	

TITLE: FISCHER MOD. "GM" MOBILE UNIT COUNTERWEIGHT

H. G. FISCHER & CO.
2335 WABANSIA AVE.
CHICAGO, ILL.

CAT. NO.

PART NO. 12275FA
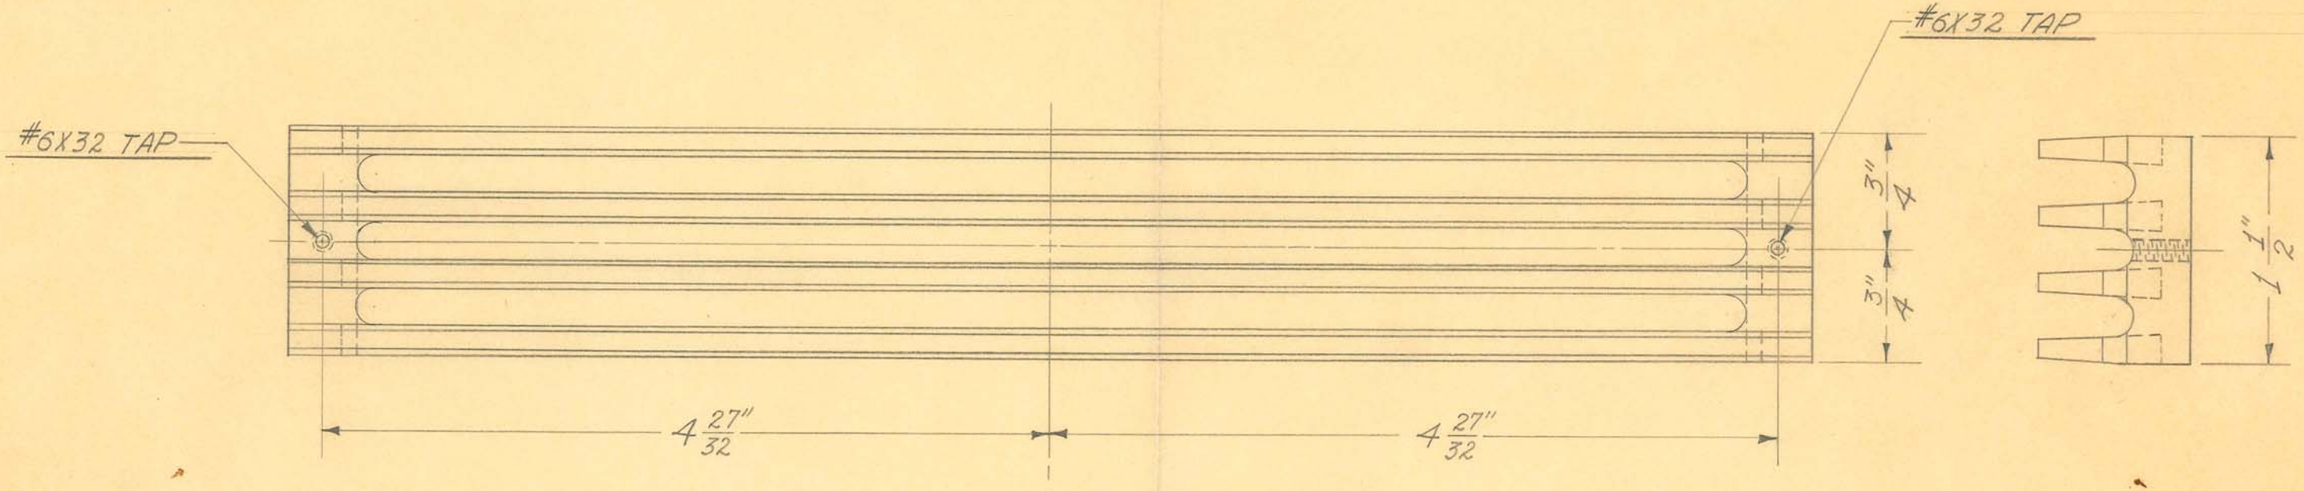
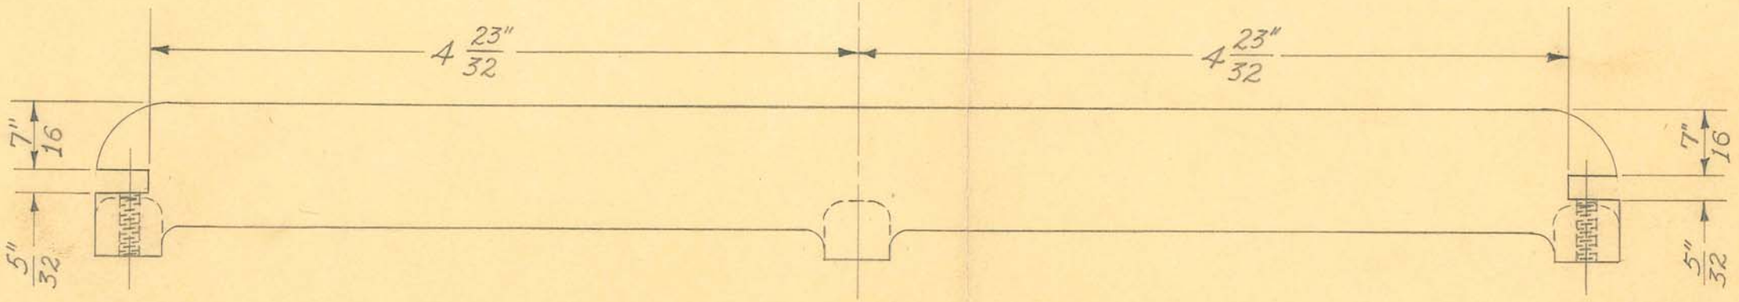

2 REQUIRED

OBSOLETE

SIZE		ISSUE 12-6-38	J.W.
KIND	ALUM. CASTING	CHANGED	
SHAPE		"	
FINISH		"	
TEMP.		"	
PATT.	8387-1181	"	

TITLE: FISCHER MOD. "GM"
MOBILE UNIT - CABINET LOUVRE - SHORT

H. G. FISCHER & CO.
2335 WABANSIA AVE.
CHICAGO, ILL.

CAT. NO.

PART NO. 12283F

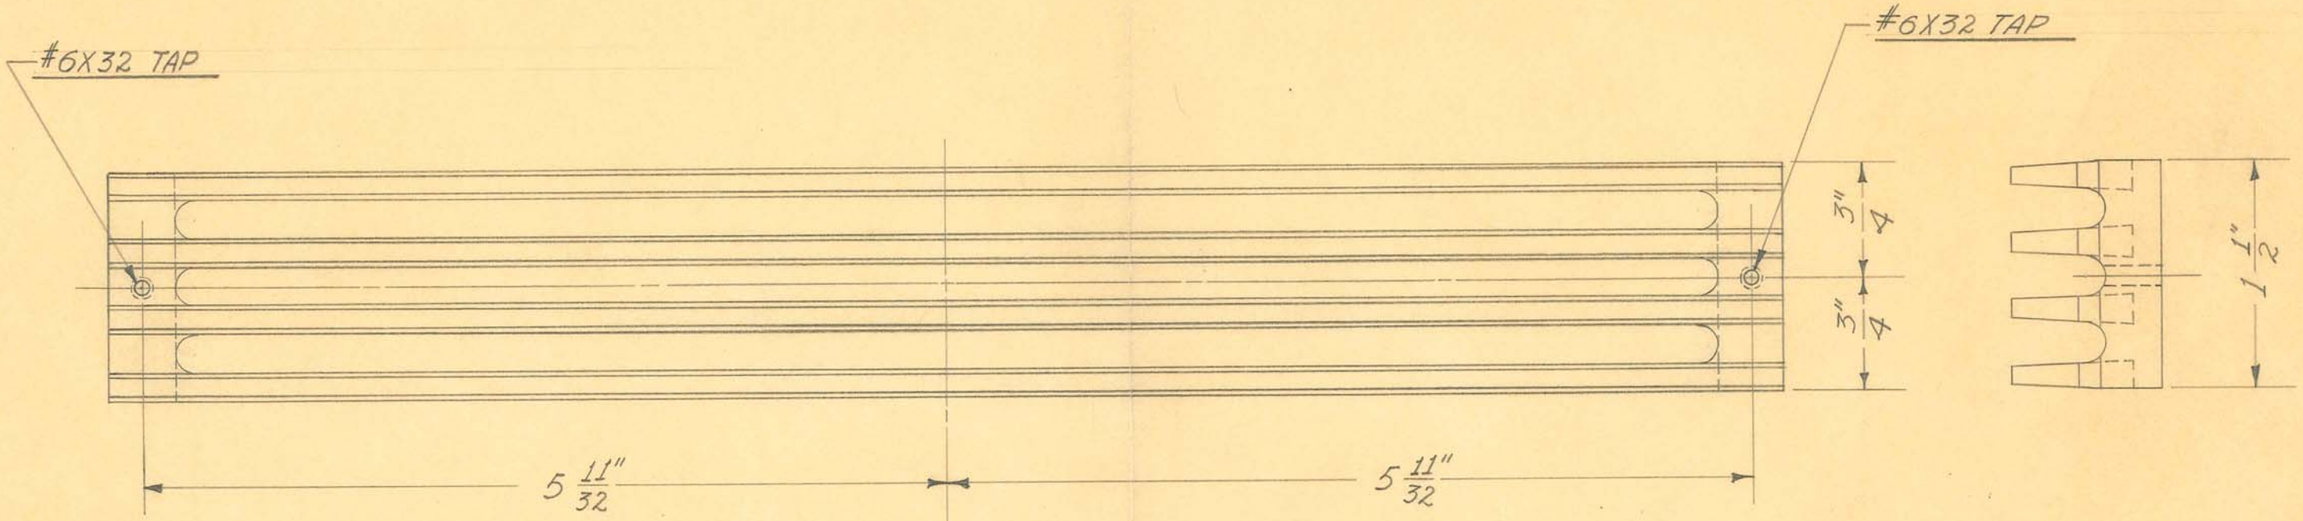

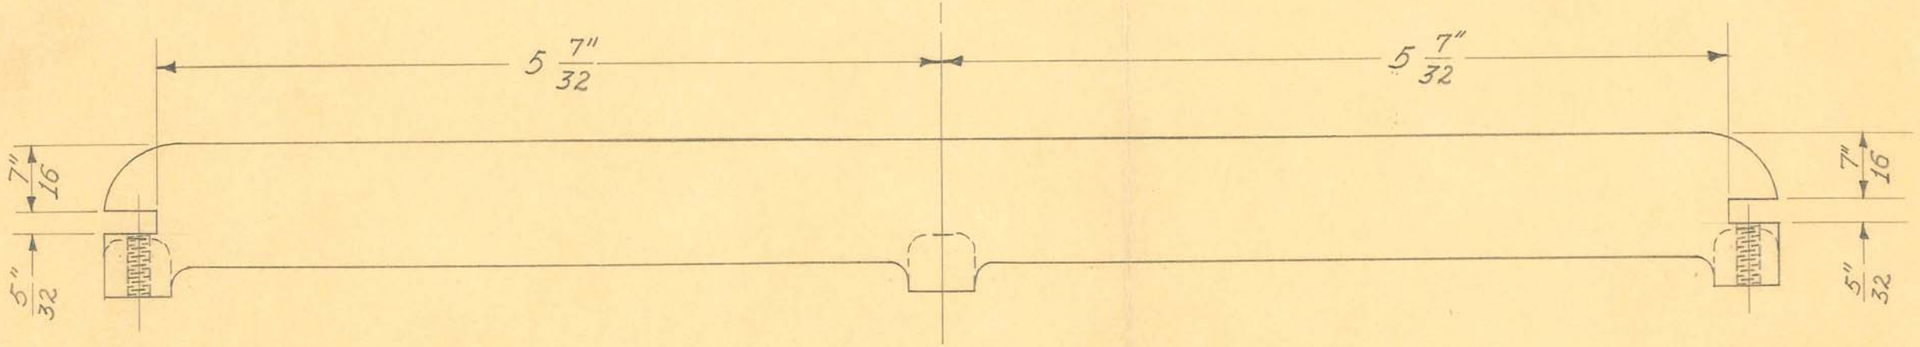

2 REQUIRED

OBSOLETE

SIZE		ISSUE 12-6-38	J.W.	TITLE: FISCHER MOD. "GM" MOBILE UNIT - CABINET LOUVRE - LONG
KIND	ALUM. CASTING	CHANGED		
SHAPE		"		
FINISH		"		
TEMP.		"		H. G. FISCHER & CO. 2335 WABANSIA AVE. CHICAGO, ILL. — CAT. NO. — PART NO. 12284F
PATT.	8386-1180	"		

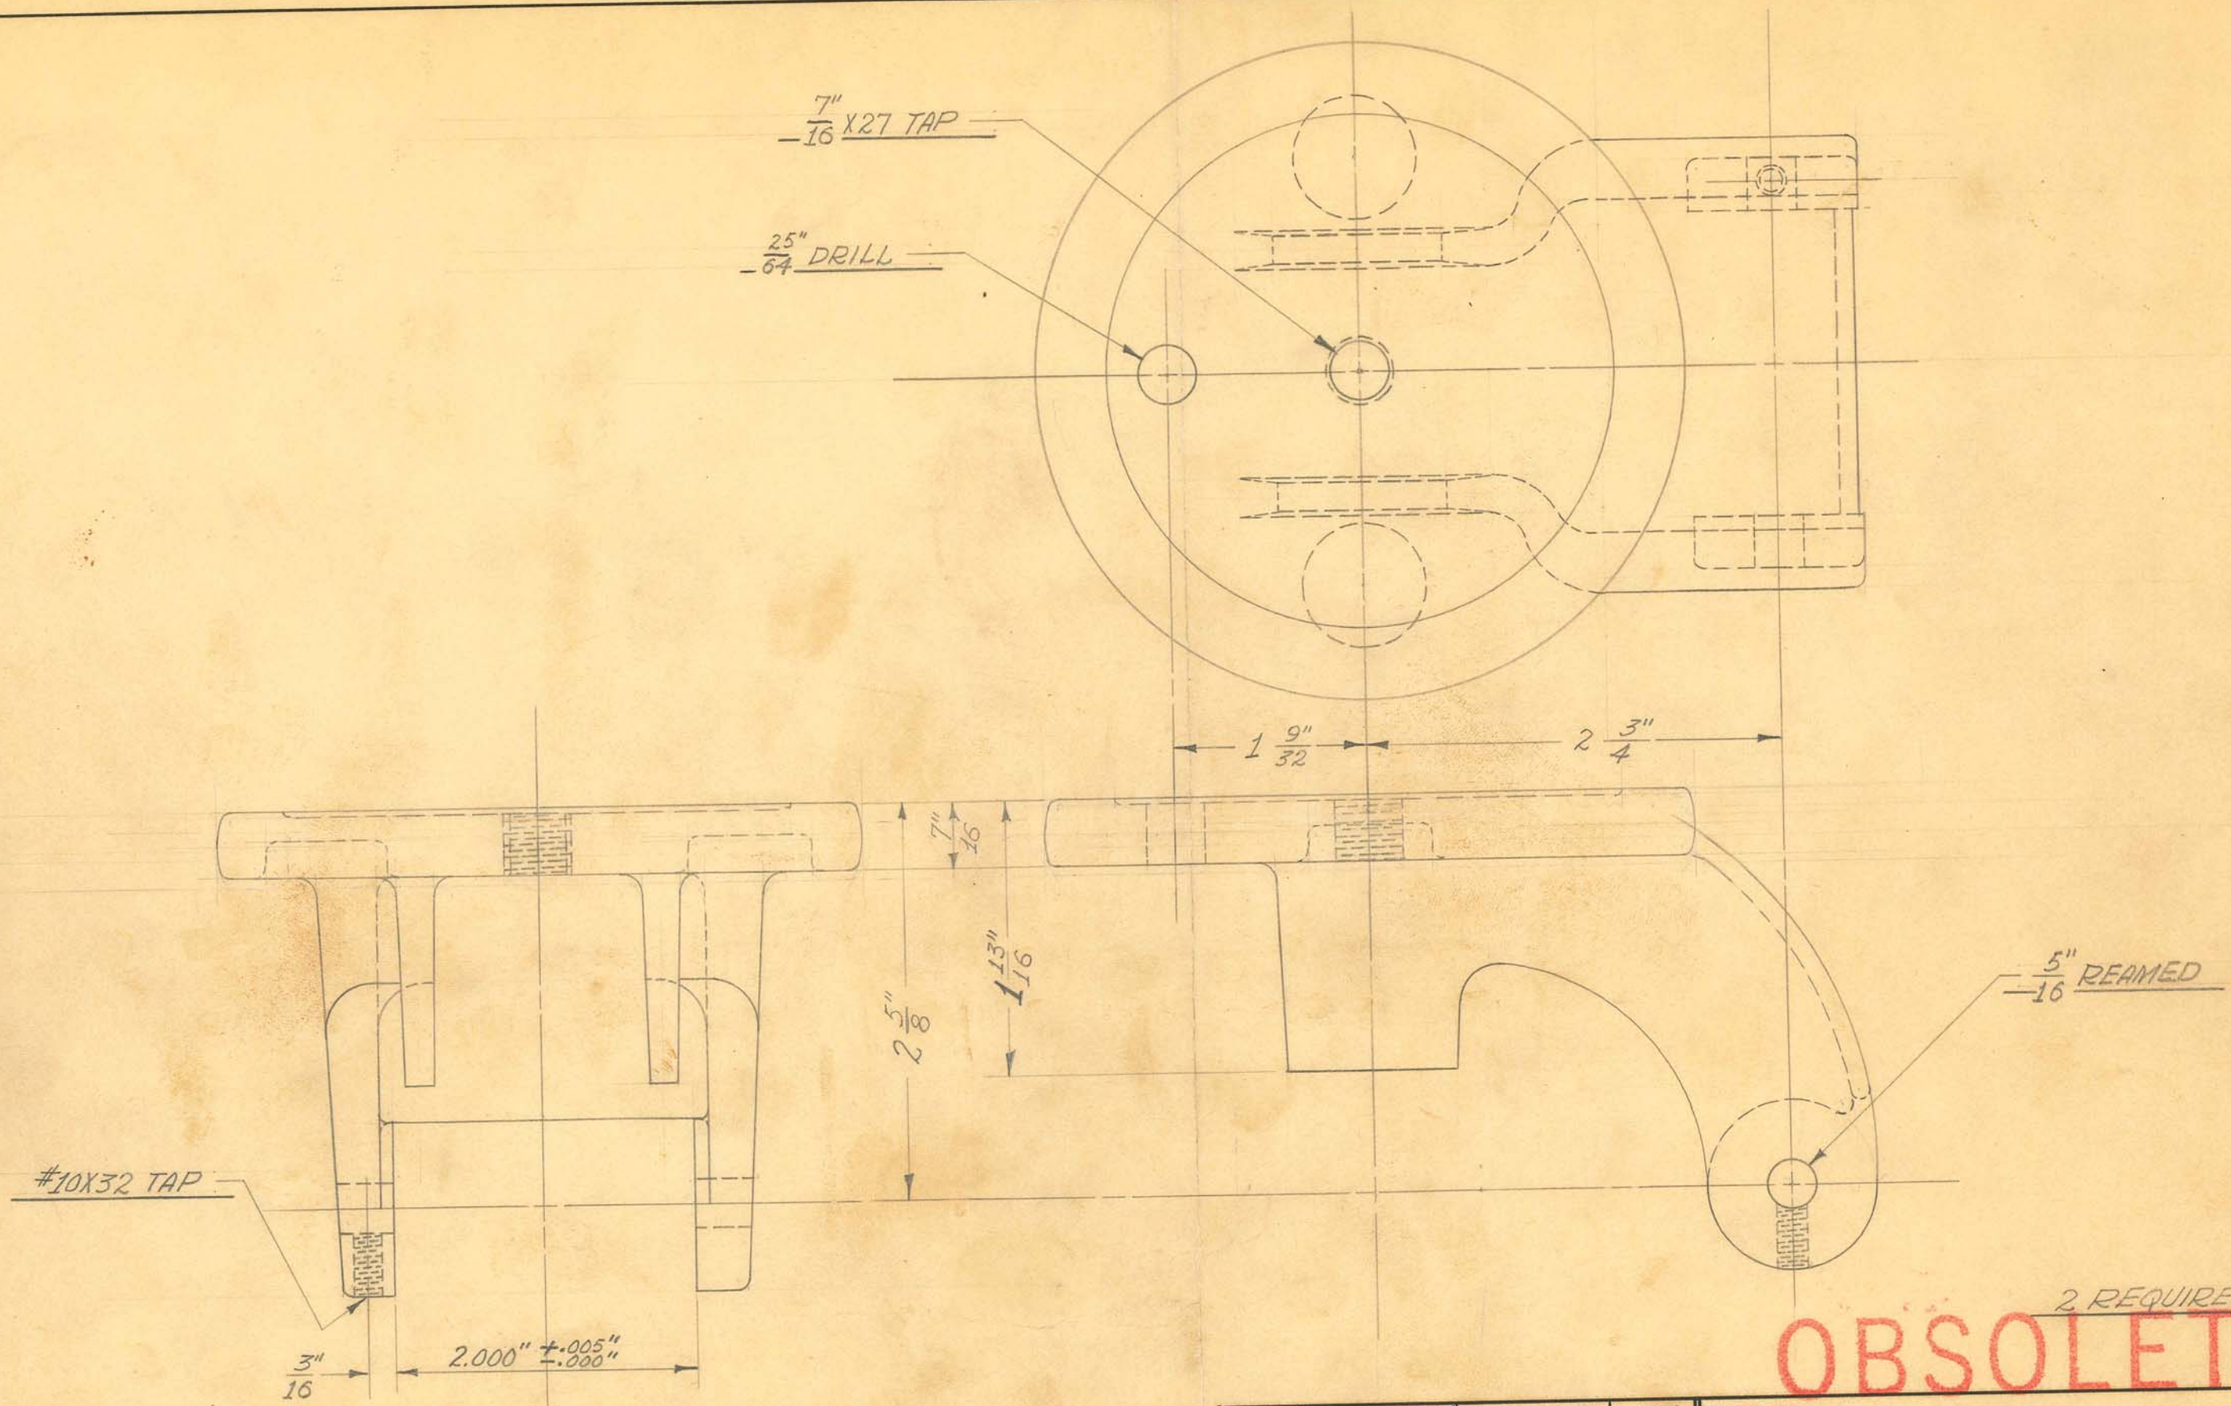

2 REQUIRED

OBSOLETE

SIZE		ISSUE 4-7-39	J.W.
KIND	IRON CASTING	CHANGED 10-28-40	J.V.W.
SHAPE		"	
FINISH	PAINTED	"	
TEMP.		"	
PATT.	1346	"	

TITLE: FISCHER MOD. "GM." MOBILE UNIT
ROLLER SUPPORT BRACKET

H. G. FISCHER & CO.
2335 WABANSIA AVE.
CHICAGO, ILL.

CAT. NO.

PART NO. 12291AF

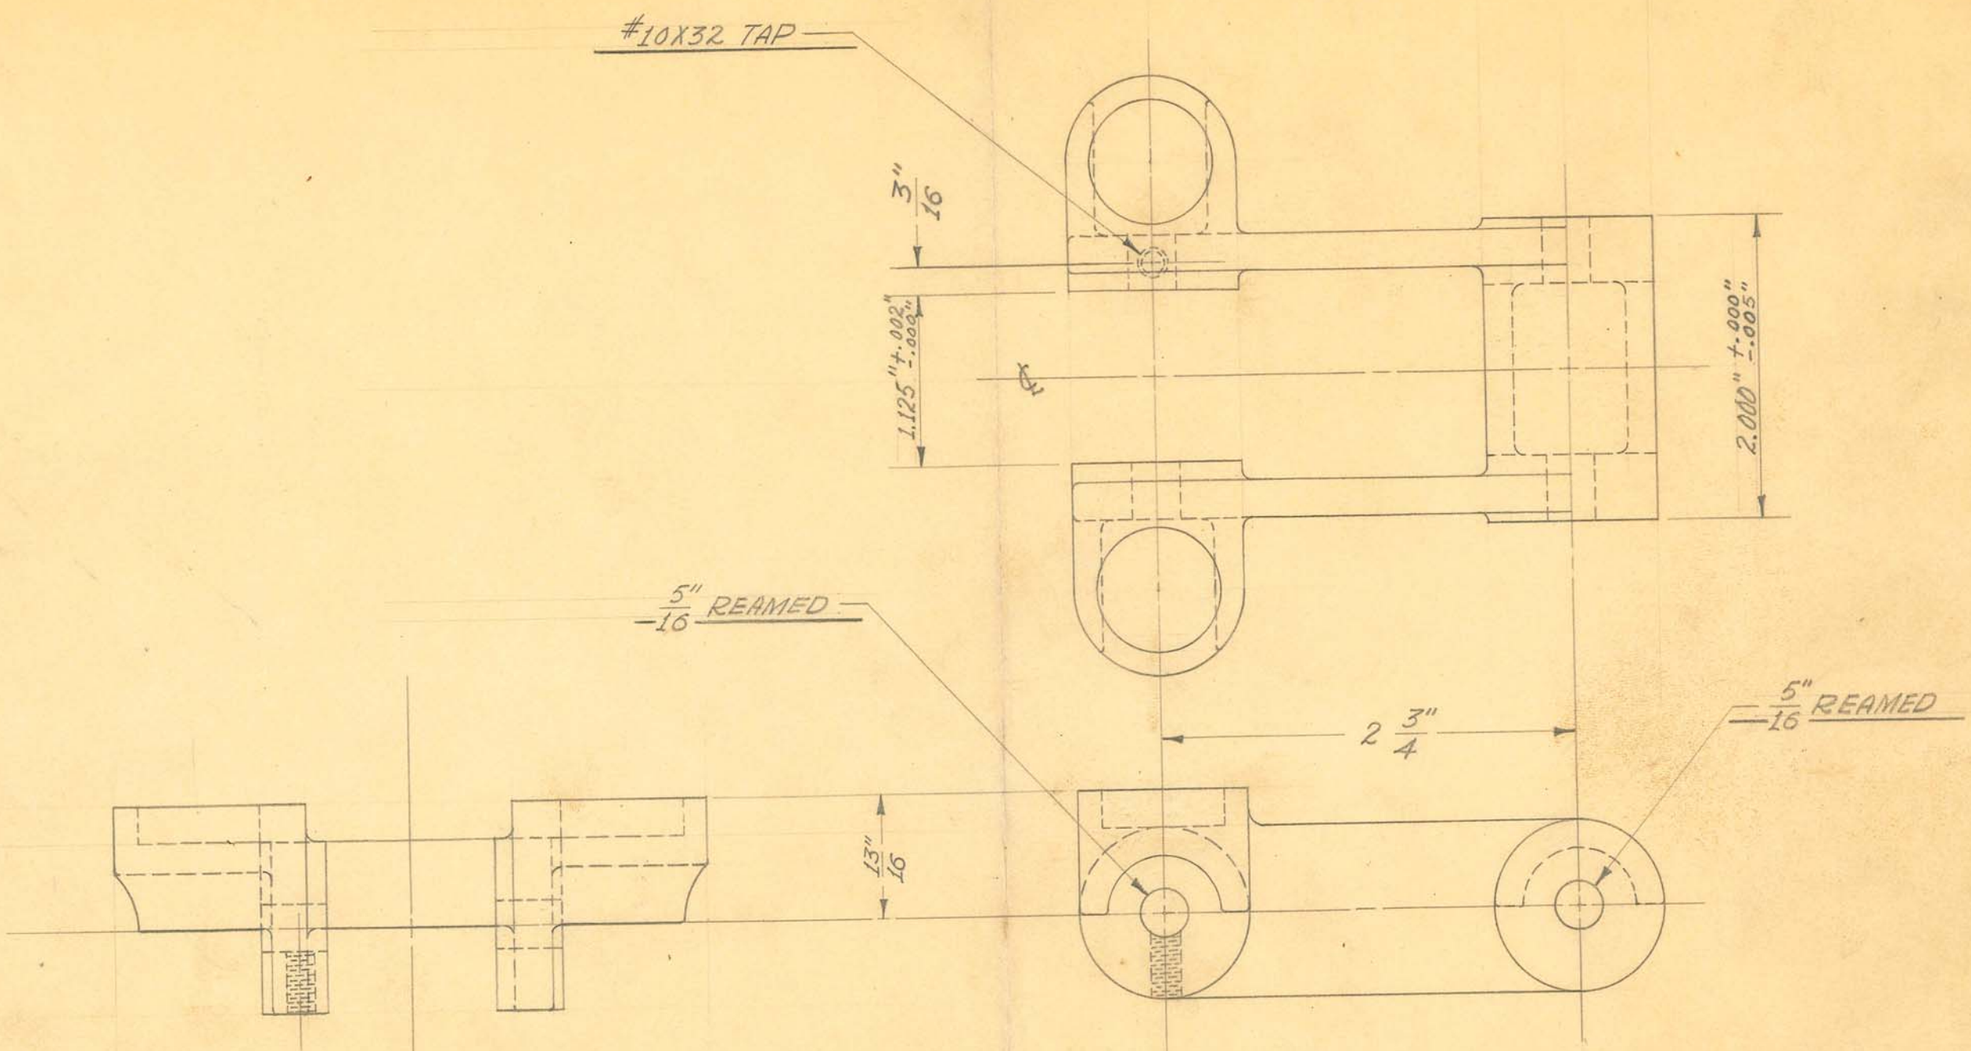

2 REQUIRED

OBSOLETE

SIZE		ISSUE 4-10-39	J.W.	TITLE: FISCHER MOD. "GM" MOBILE UNIT ROLLER SUPPORT
KIND	IRON CASTING	CHANGED		
SHAPE		"		
FINISH	PAINTED	"		
TEMP.		"		
PATT.	1345	"		

H. G. FISCHER & CO.
2335 WABANSIA AVE.
CHICAGO, ILL.

CAT. NO.

PART NO. 12292F

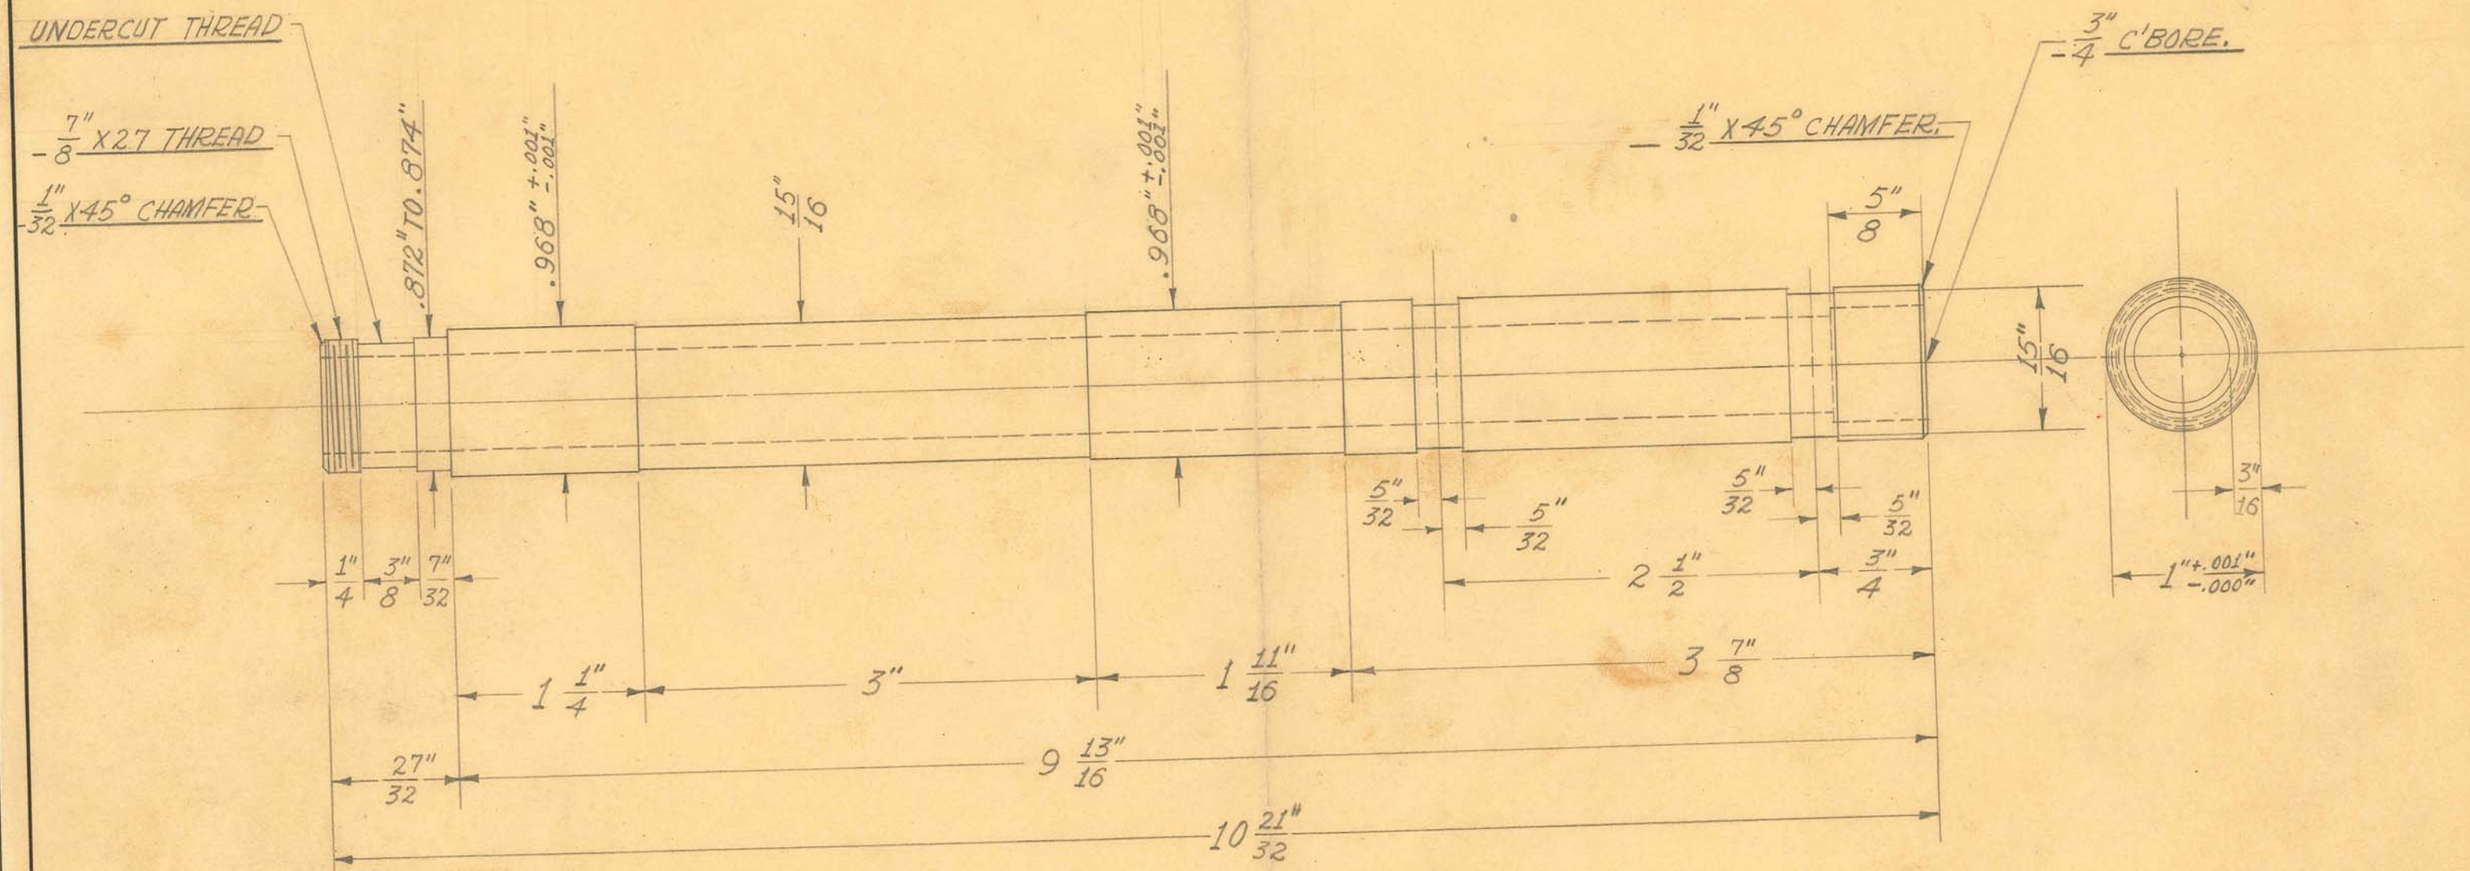

1 REQUIRED

1" O.D. X 3/16" WALL SHELBY SEAMLESS STEEL TUBING

OBSOLETE

SIZE		ISSUE 3-7-39	J.W.	TITLE: WALL MODEL DENTAL "X-RAY" UNIT SWIVEL ARM SUPPORT SHAFT
KIND		CHANGED		
SHAPE		"		
FINISH		"		
TEMP.		"		
PATT.		"		

H. G. FISCHER & CO.
2338 WABANSIA AVE.
CHICAGO, ILL.

CAT. NO.

PART NO. 12308

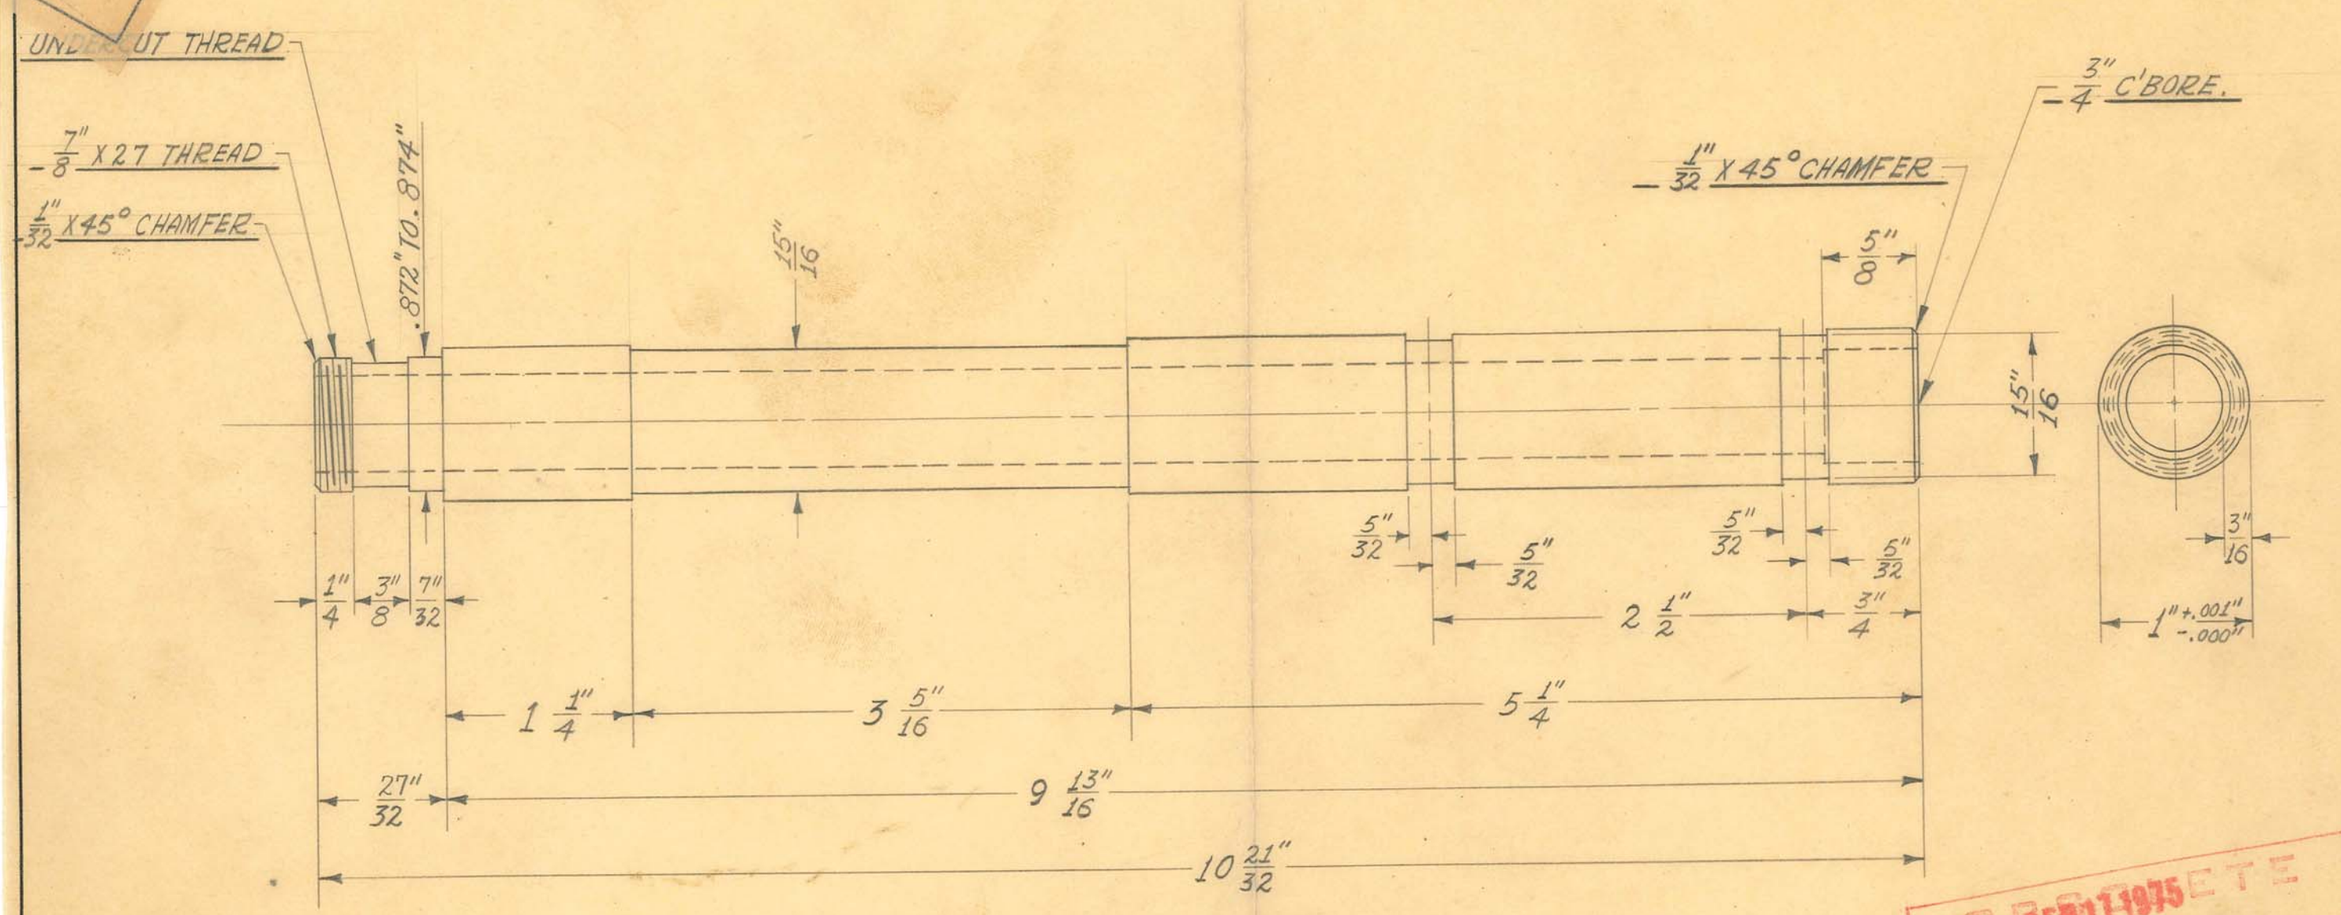

NOTE:-

BREAK ALL SHARP EDGES.

O.D. MUST BE CONCENTRIC WITH HOLE.

1 REQUIRED

1" O.D. X 3/16" WALL SHELBY SEAMLESS STEEL TUBING

SEP 17 1975
DATE
REFER TO
FOR DETAILS SEE E. C. O. #
ENGINEER
DRAFTSMAN

SIZE		ISSUE 4-17-40	J.W.
KIND		CHANGED	
SHAPE		"	
FINISH		"	
TEMP.		"	

TITLE: FISCHER WALL MODEL DENTAL X-RAY UNIT
SWIVEL ARM SUPPORT SHAFT

H. G. FISCHER & CO.
2335 WABANSIA AVE.
CHICAGO, ILL.

CAT. NO.

PART NO. 12308A

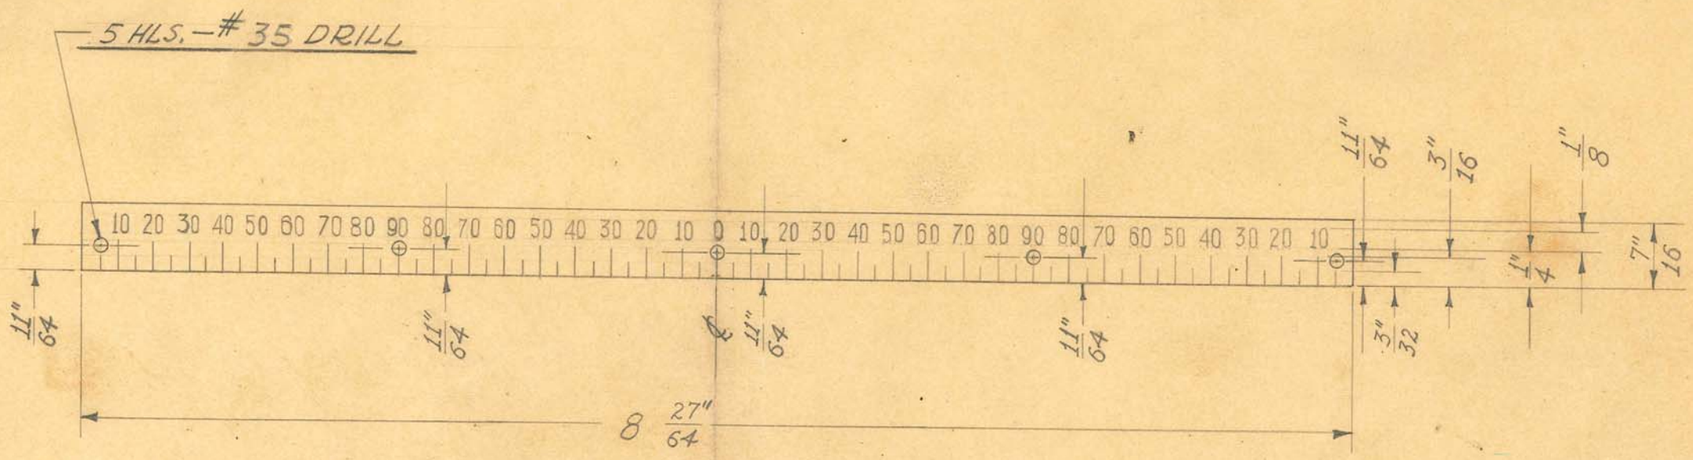

ROLL PLATE TO FIT $2\frac{11}{16}$" DIAMETER

$\frac{1}{32}$" STOCK

OBSOLETE
DATE SEP 17 1975
REFER TO
FOR DETAILS SEE E. C. O. #
ENGINEER
DRAFTSMAN

SIZE		ISSUE 2-22-39	J.W.	TITLE: WALL MODEL DENTAL X-RAY HORIZONTAL ANGLE PLATE
KIND		CHANGED		
SHAPE		" 7-10-46	J.W.	
FINISH		"		
TEMP.		"		
PATT.		"		

H. G. FISCHER & CO.
2335 WABANSIA AVE.
CHICAGO, ILL.

CAT. NO.

PART NO. 12322

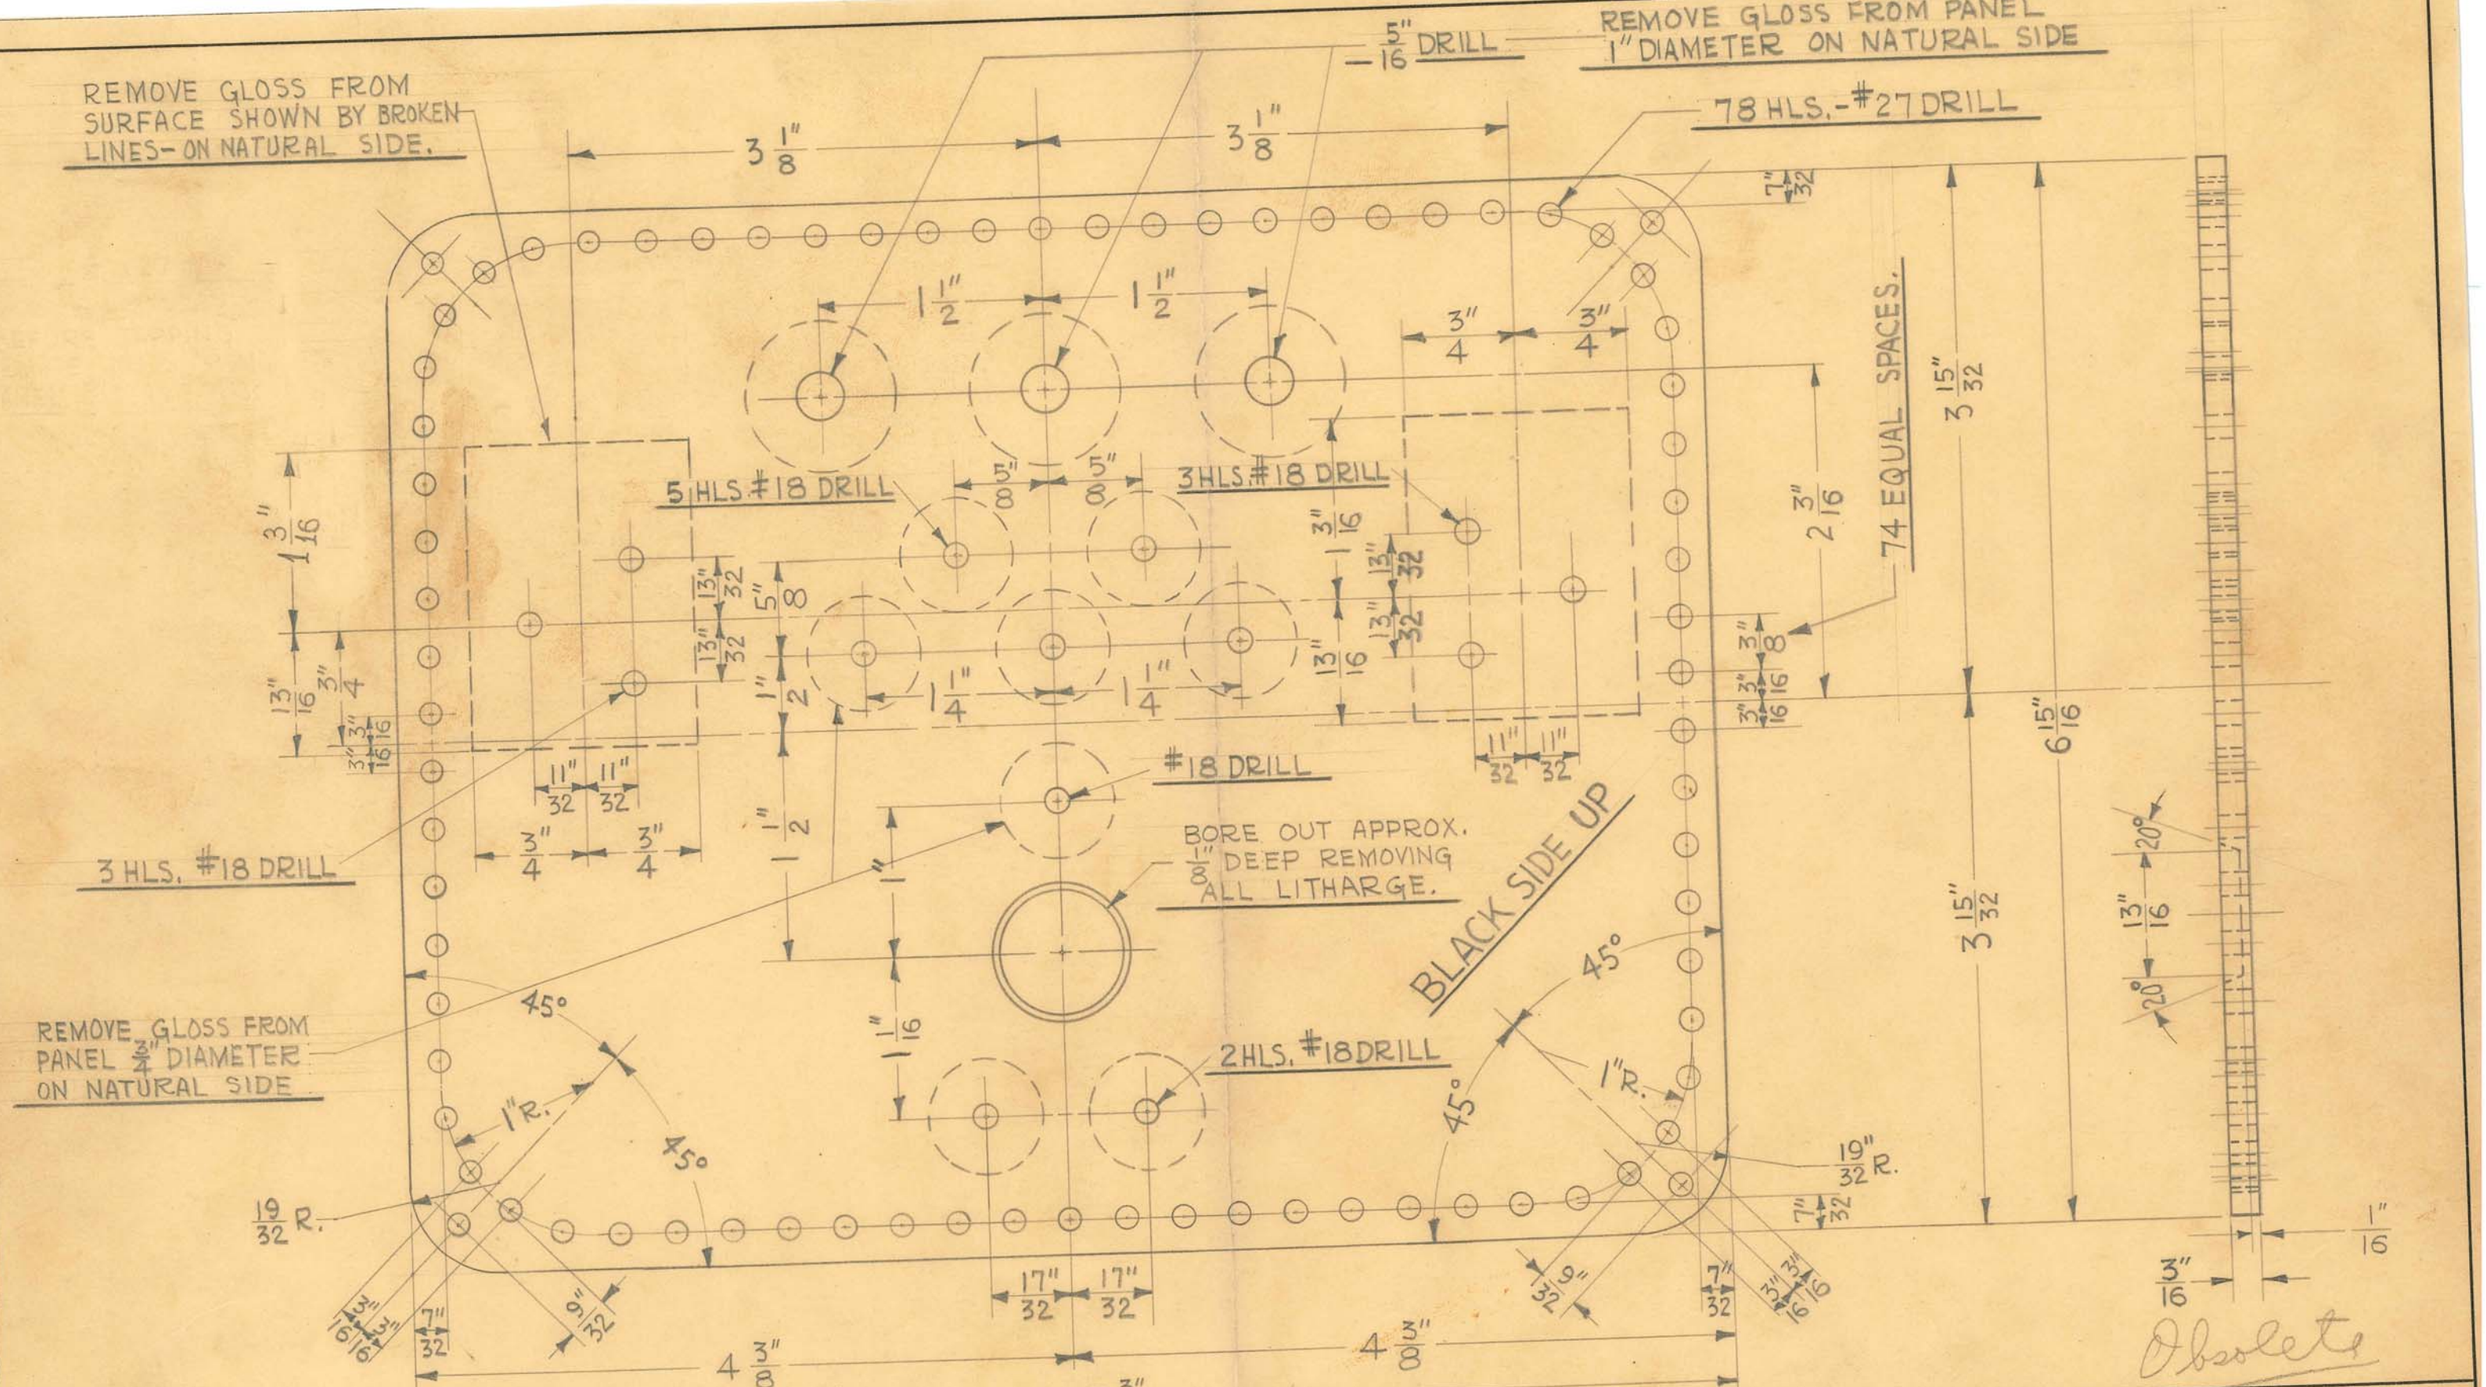

SIZE	8 3/4" X 6 15/16" X 3/16"	ISSUE 10-17-41	J.V.W.	TITLE: WALL MODEL DENTAL X-RAY UNIT TRANSFORMER TANK PANEL (DRILLED)
KIND	LITHARGE	CHANGED 4-29-43	HE.	
SHAPE	IMP. BAKELITE	"		
FINISH		"		
TEMP.		"		
PATT.		"		

OBSOLETE

H. G. FISCHER & CO.
2338 WABANSIA AVE.
CHICAGO, ILL.

CAT. NO.

PART NO. 12326AFB

STAMP THESE LETTERS ON TOP SIDE OF PANEL.

78 HLS.~#27 DRILL

5 HLS.~# 9 DRILL & 9/16" C'BORE. .031"±.003" DEEP FROM UNDER SIDE

2 HLS.~# 9 DRILL & 9/16" C'BORE. ~ .031"±.003" DEEP FROM UNDER SIDE

3 HLS.~ 5/16" DRILL & 5/8" C'BORE. .031"±.003" DEEP FROM UNDER SIDE

2 HLS.~# 9 DRILL & 9/16" C'BORE. .031"±.003" DEEP FROM UNDER SIDE

BORE OUT 1/8" DEEP

4 HLS.~ 1/4" DRILL & 9/16" C'BORE. .031"±.003" DEEP FROM TOP SIDE.

74 EQUAL SPACES

1 REQUIRED

OBSOLETE CES 8-16-68

DRILL JIG #7007 - 2 PARTS

SIZE	8 3/4" X 6 15/16" X 3/16"	ISSUE 8-1-44	HE.
KIND	NATURAL	CHANGED 1-8-45	HE.
SHAPE	BAKELITE	"	
FINISH		"	
TEMP.		"	
PATT.		"	

TITLE: WALL MODEL DENTAL X-RAY UNIT~ TRANSFORMER TANK PANEL (DRILLED)

H. G. FISCHER & CO. 2335 WABANSIA AVE. CHICAGO. ILL.

CAT. NO.

PART NO. 12326BF

B

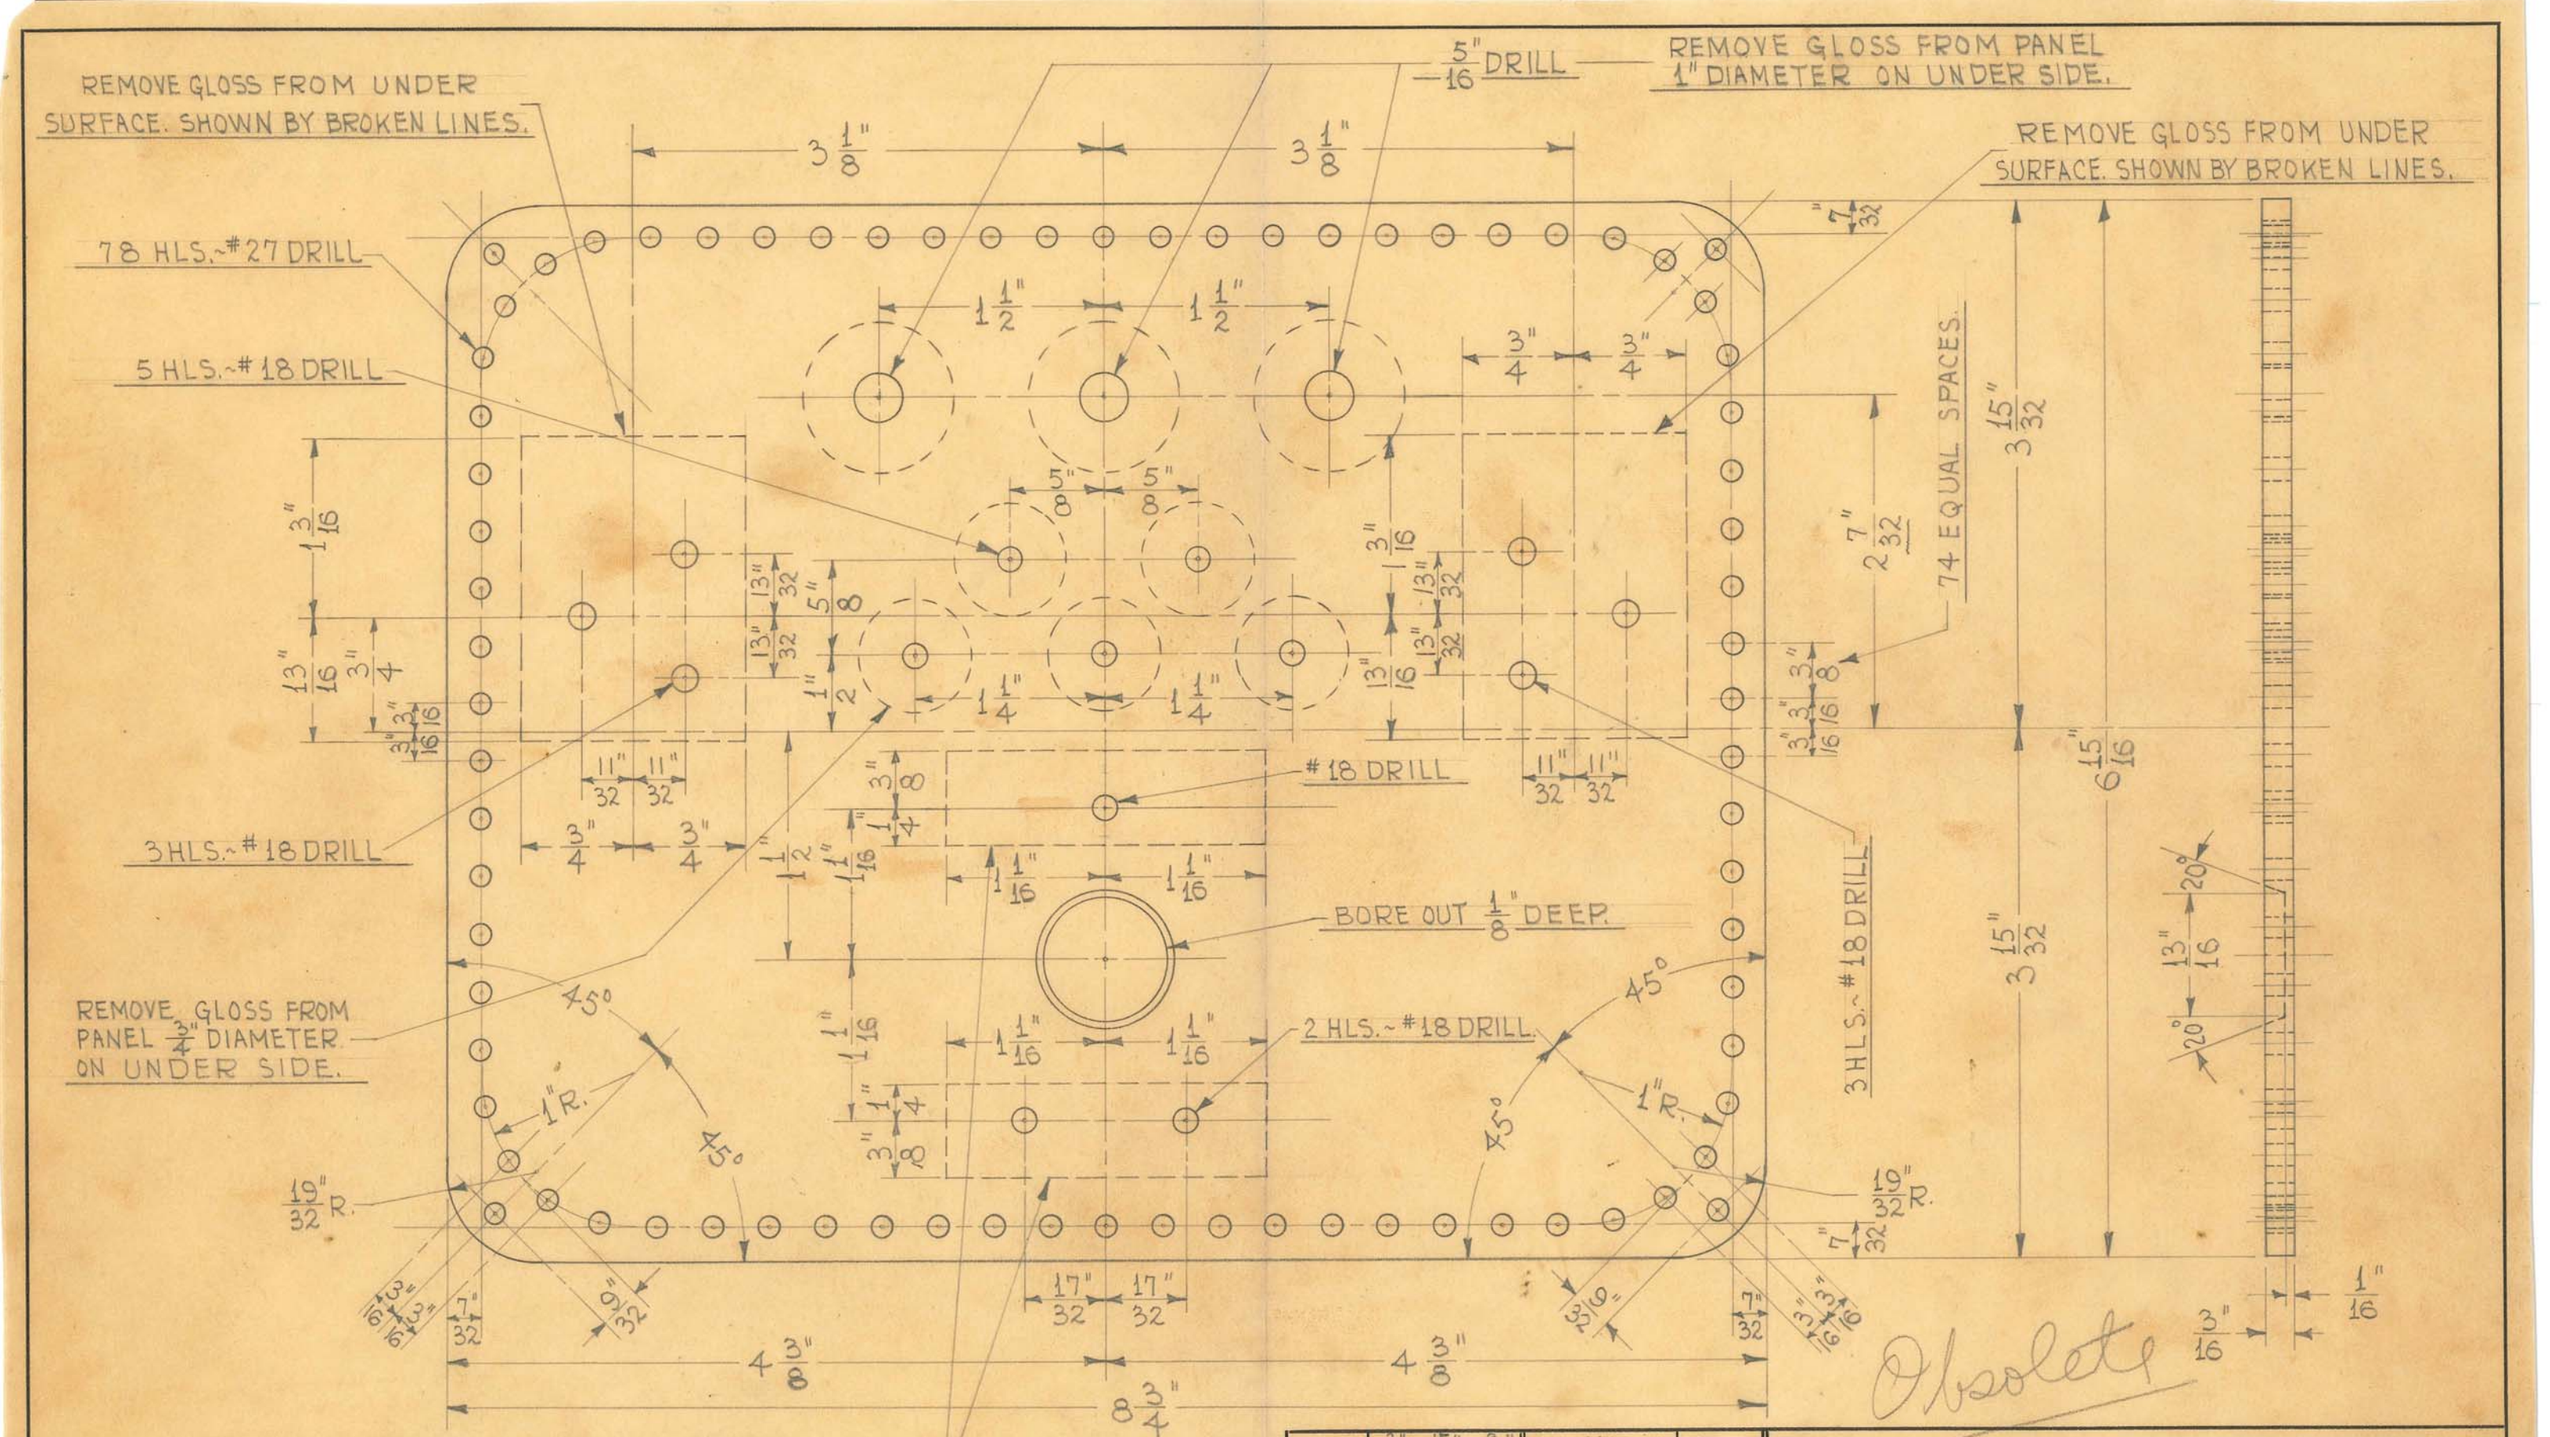

SIZE	8 3/4" X 6 15/16" X 3/16"	ISSUE 11-3-43	H. E.	
KIND	NATURAL	CHANGED		
SHAPE	BAKELITE	"		
FINISH		"		
TEMP.		"		
PATT.		"		

TITLE: WALL MODEL DENTAL X-RAY UNIT- TRANSFORMER TANK PANEL (DRILLED)

OBSOLETE

H. G. FISCHER & CO. 2335 WABANSIA AVE. CHICAGO, ILL. | CAT. NO. | PART NO. 12326BF

REMOVE GLOSS FROM SURFACE SHOWN BY BROKEN LINES - ON NATURAL SIDE

$\frac{5}{16}$" DRILL

REMOVE GLOSS FROM PANEL 1" DIAMETER ON NATURAL SIDE

78 HLS. # 27 DRILL

$3\frac{1}{8}$" $3\frac{1}{8}$"

$\frac{3}{8}$" X 27 TAP

BEFORE TAPPING REMOVE GLOSS FROM PANEL $\frac{3}{4}$" DIAMETER.

$1\frac{1}{2}$" $1\frac{1}{2}$"

$\frac{3}{4}$" $\frac{3}{4}$"

$7\frac{7}{32}$"

$2\frac{1}{4}$"

$1\frac{11}{32}$"

5 HLS. # 18 DRILL

5" 8 5" 8

3 HLS. # 18 DRILL

$3\frac{15}{32}$"

$2\frac{3}{16}$"

74 EQUAL SPACES $\frac{3}{8}$" CENTERS

$\frac{13}{16}$" $\frac{3}{4}$" $\frac{3}{16}$" $\frac{3}{16}$"

$\frac{13}{32}$" $\frac{13}{32}$"

$\frac{5}{8}$" $\frac{1}{2}$"

$1\frac{1}{4}$" $1\frac{1}{4}$"

$1\frac{3}{16}$" $\frac{13}{32}$" $\frac{13}{32}$"

$\frac{3}{8}$" $\frac{3}{16}$" $\frac{3}{16}$"

$\frac{11}{32}$" $\frac{11}{32}$" $\frac{11}{32}$" $\frac{11}{32}$"

$6\frac{15}{16}$"

#18 DRILL

3 HLS. # 18 DRILL

$\frac{3}{4}$" $\frac{3}{4}$"

$1\frac{1}{2}$"

1" 1"

BLACK SIDE UP

BLACK SIDE UP

BORE OUT $\frac{1}{8}$" DEEP

45° 45° 45° 45°

REMOVE GLOSS FROM PANEL $\frac{3}{4}$" DIAMETER ON NATURAL SIDE

$1\frac{1}{16}$"

$\frac{3}{4}$"

2 HLS. #18 DRILL

1"R. 1"R.

$\frac{17}{32}$" $\frac{17}{32}$"

$\frac{19}{32}$"R. $\frac{19}{32}$"R.

$\frac{7}{32}$" $\frac{9}{32}$" $\frac{7}{32}$" $\frac{3}{16}$" $\frac{3}{16}$" $\frac{3}{16}$"

$4\frac{3}{8}$" $4\frac{3}{8}$"

$8\frac{3}{4}$"

Obsolete

SIZE	$8\frac{3}{4}$" X $6\frac{15}{16}$" X $\frac{3}{16}$"	ISSUE 2-20-39	HE.
KIND	LITHARGE	CHANGED 3-18-41	J.V.W.
SHAPE	IMP. BAKELITE	"	
FINISH		"	
TEMP.		"	
PATT.		"	

TITLE: WALL MODEL DENTAL X-RAY UNIT - TRANSFORMER TANK PANEL (DRILLED)

OBSOLETE

H. G. FISCHER & CO. 2335 WABANSIA AVE. CHICAGO, ILL.

CAT. NO.

PART NO. 12326AF

STAMP THESE LETTERS ON TOP SIDE OF PANEL.

78 HLS.~#27 DRILL

5 HLS.~# 9 DRILL & 9/16 C'BORE. .031"±.003" DEEP FROM UNDER SIDE.

2 HLS.~#9 DRILL & 9/16 C'BORE. .031"±.003" DEEP FROM UNDER SIDE.

4 HLS.~1/4 DRILL & 9/16 C'BORE. .031"±.003" DEEP FROM TOP SIDE.

1 REQUIRED

2 HLS.~LETTER "O" DRILL~BREAK EDGE ON C'BORED. SIDE. C'BORE CIRCULAR GROOVE AS SHOWN~.015" +.000" -.002" DEEP FROM UNDER SIDE

2 HLS.~#9 DRILL & 9/16 C'BORE. 1/32 DEEP FROM UNDER SIDE.

74 EQUAL SPACES

BORE OUT 1/8 DEEP

CIRCULAR GROOVE C'BORE #11168

REVISION		DATE	BY
A	WAS 1/16"	10-10-49	W.J.
B	" 1 1/32"		

SIZE	8 3/4" X 6 15/16" X 3/16"	ISSUE 5-29-45	HE.
KIND	NATURAL	CHANGED	
SHAPE	BAKELITE	"	
FINISH		"	
TEMP.		"	
PATT.		"	

TITLE: WALL MODEL DENTAL X-RAY UNIT~ TRANSFORMER TANK PANEL (DRILLED)

OBSOLETE

H. G. FISCHER & CO. 2335 WABANSIA AVE. CHICAGO, ILL.

CAT. NO.

PART NO. 12326BFC

Obsolete 1-23-51

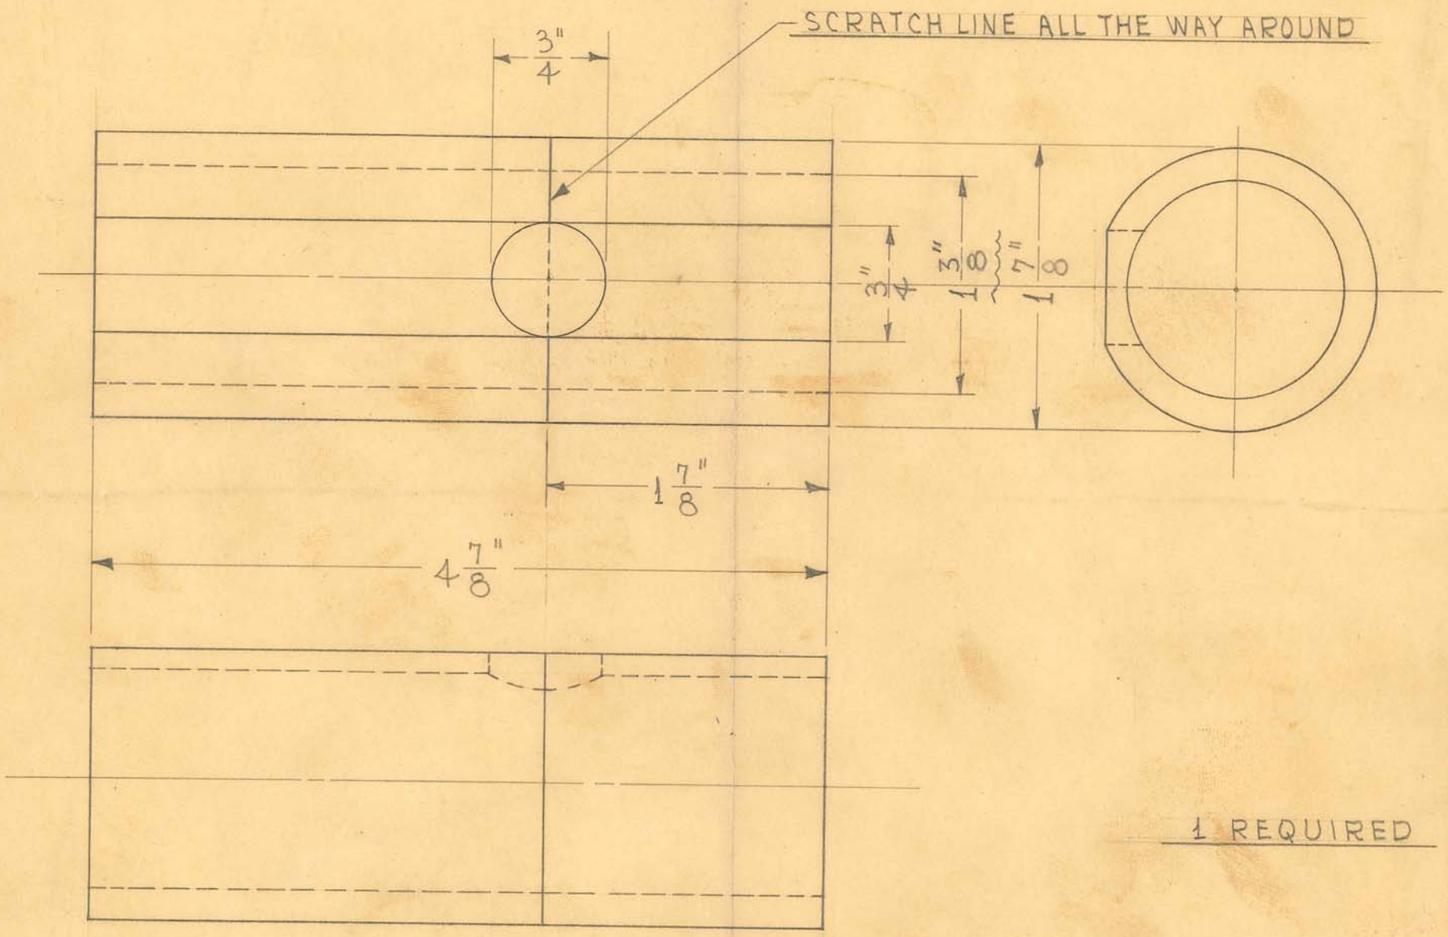

1 REQUIRED

OBSOLETE
DATE SEP 17 1975
REFER TO
FOR DETAILS SEE E. C. O. #
ENGINEER
DRAFTSMAN

SIZE	1 7/8" O.D. X 1 3/8" I.D.	ISSUE 11-1-43	HE
KIND	X-OPAKE	CHANGED	
SHAPE	TUBING	"	
FINISH		"	
TEMP.		"	
PATT.		"	

TITLE: WALL MODEL DENTAL X-RAY UNIT- TUBE SHIELD

H. G. FISCHER & CO.
2335 WABANSIA AVE.
CHICAGO, ILL.

CAT. NO.

PART NO. 12338 1/2 A

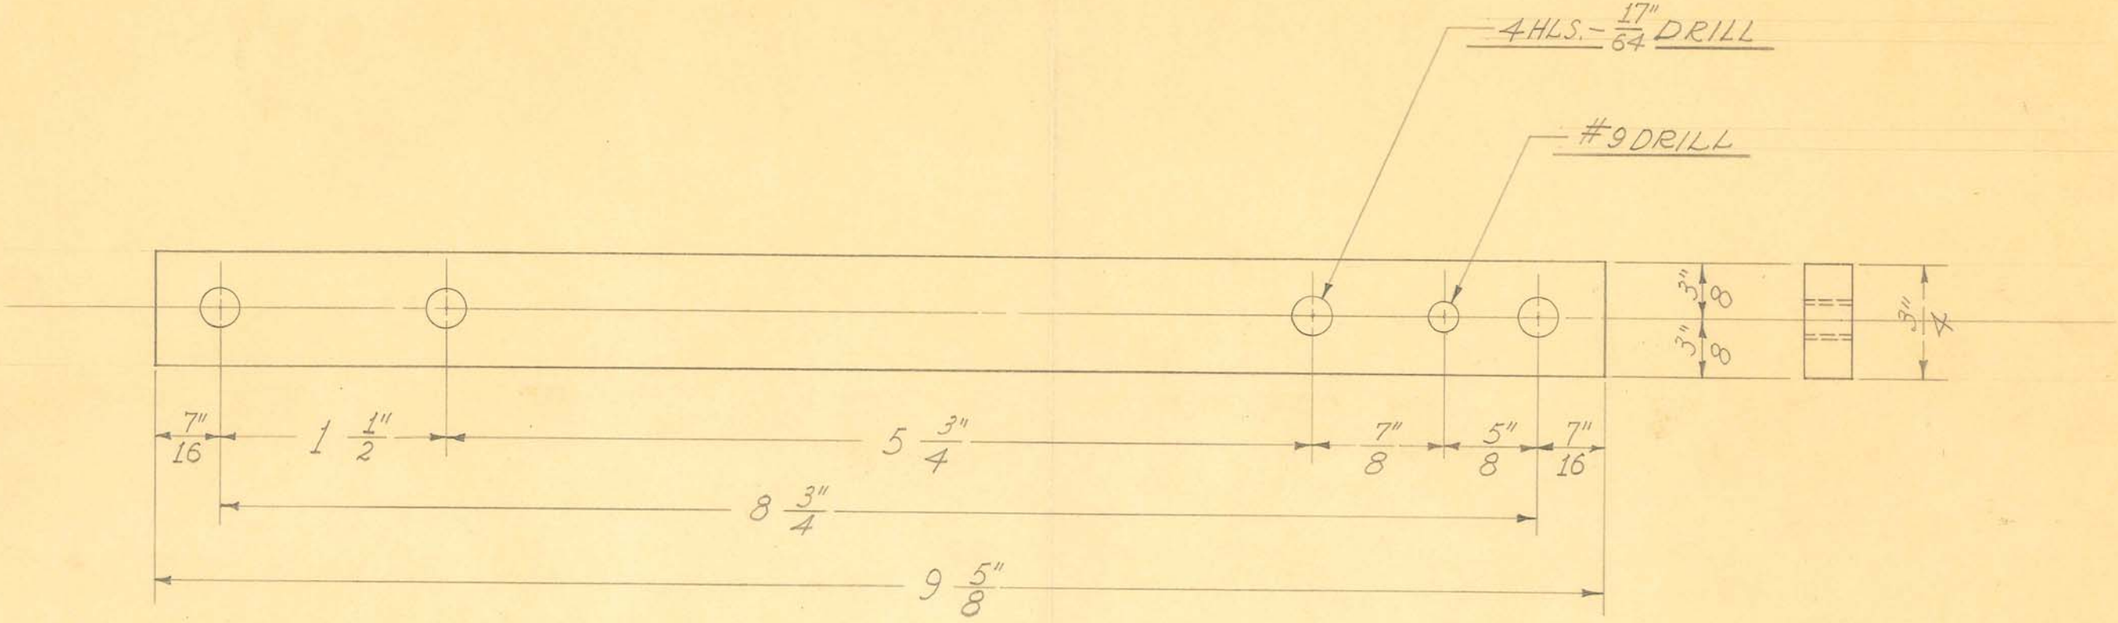

1 REQUIRED

OBSOLETE

SIZE	3/4" X 5/16"	ISSUE 4-28-38	J.W.	TITLE: FISCHER MOD. "G" SHOCKPROOF FLUOROSCOPE TRANSF. & TERMINAL BOARD SUPPORT -REAR
KIND	C.R. STEEL	CHANGED		
SHAPE	ROD	"		
FINISH		"		
TEMP.		"		
PATT.		"		

H. G. FISCHER & CO.
2335 WABANSIA AVE.
CHICAGO, ILL.

CAT. NO.

PART NO. 11460

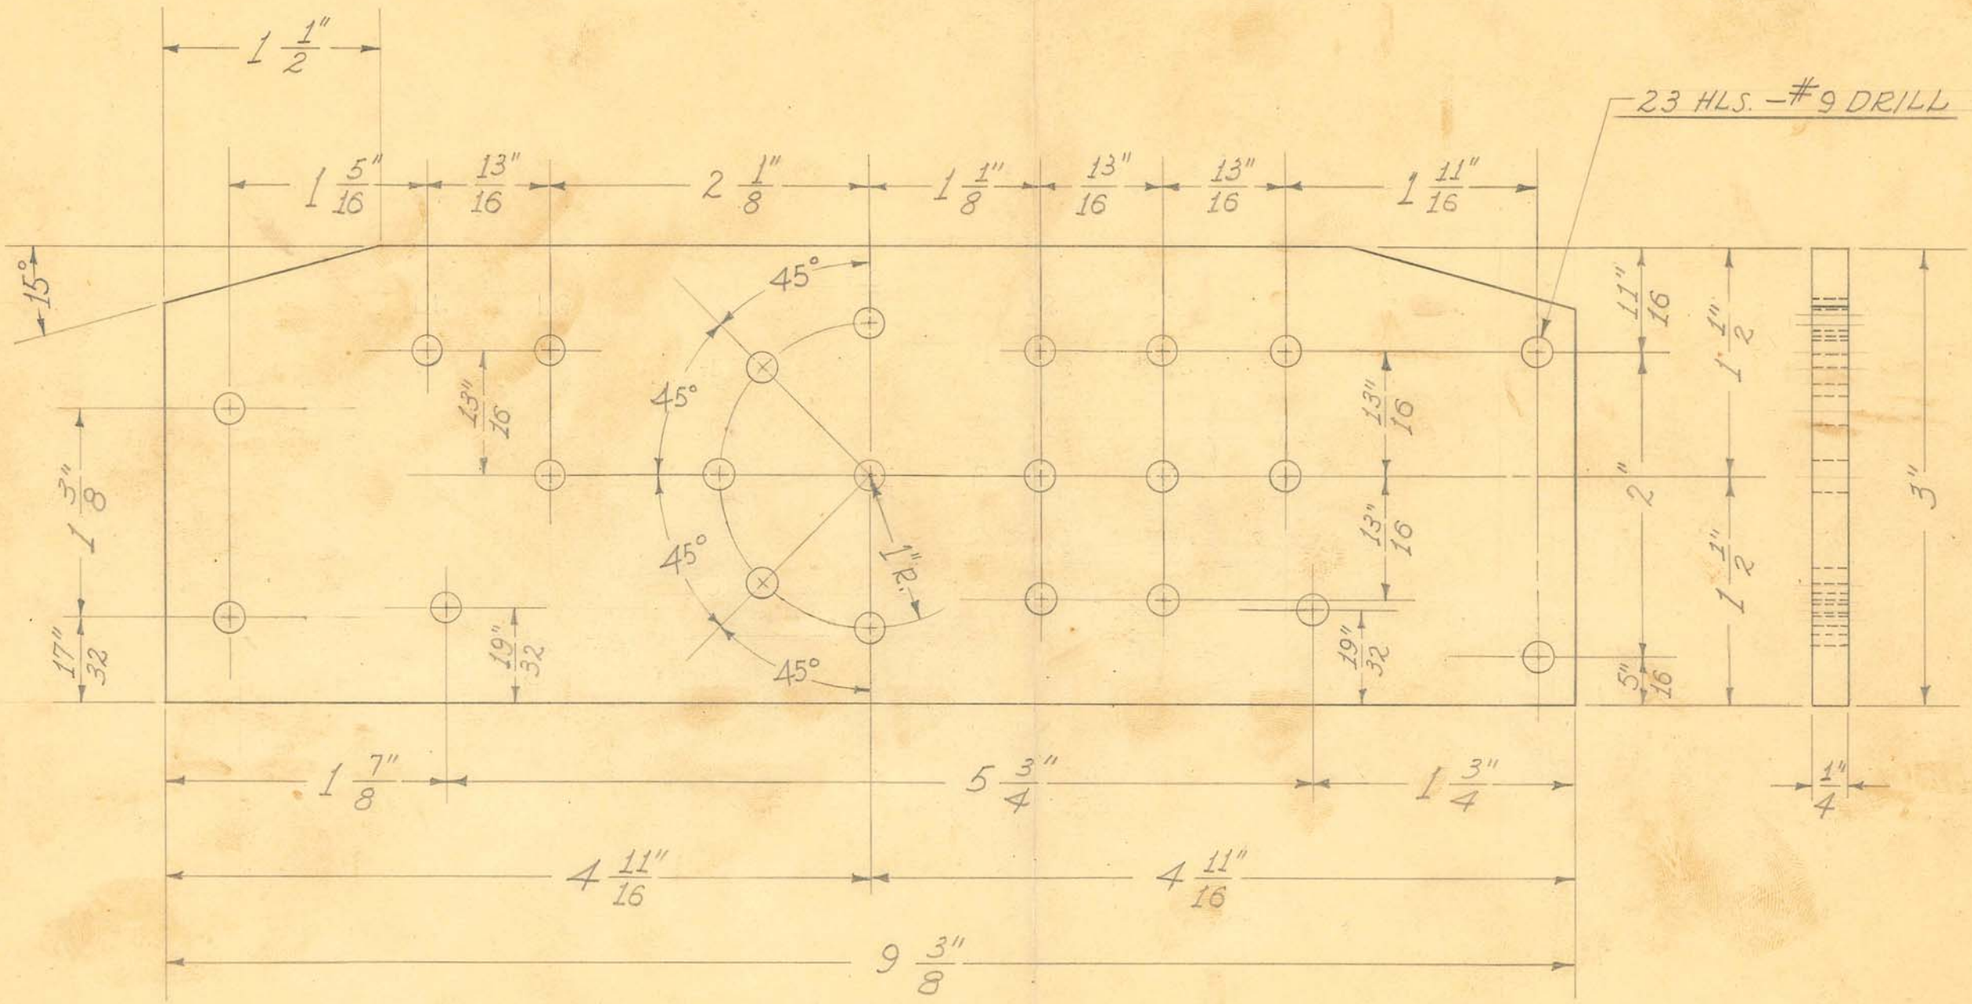

1 REQUIRED

OBSOLETE

Obsolete

SIZE	1/4" SHEET	ISSUE 4-29-38	J.W.
KIND	BAKELITE	CHANGED	
SHAPE		"	
FINISH		"	
TEMP.		"	
PATT.		"	

TITLE: FISCHER MOD. G" SHOCKPROOF FLUOROSCOPE REMOTE CONTROL – TERMINAL BOARD (ENGRAVED)

H. G. FISCHER & CO.
2335 WABANSIA AVE.
CHICAGO, ILL.

CAT. NO.

PART NO. 11464

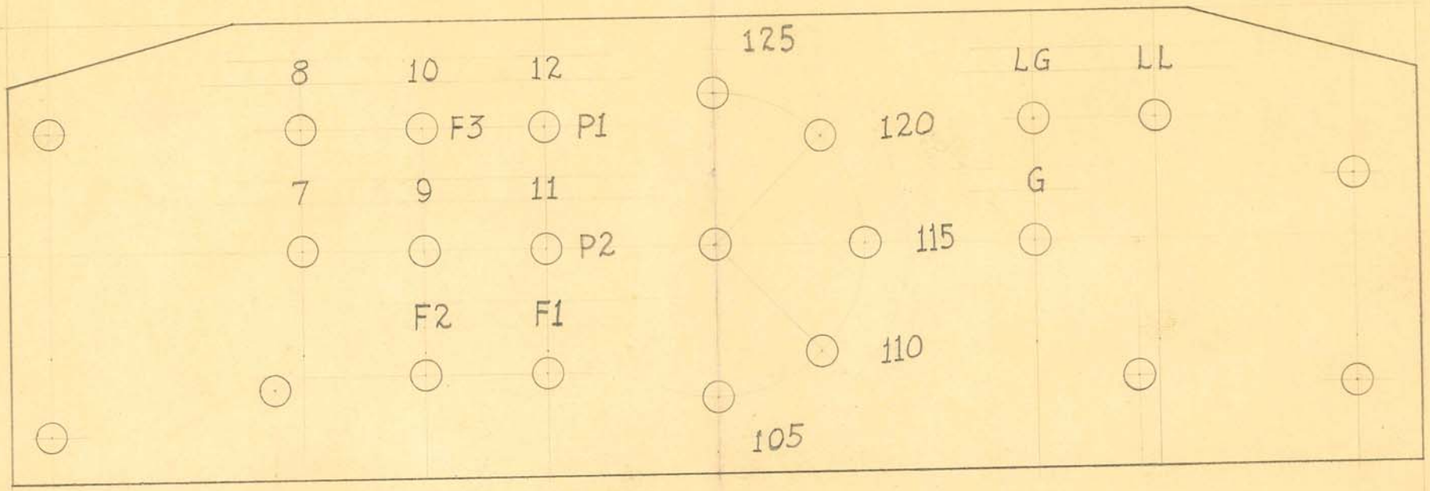

1 REQUIRED

OBSOLETE
Obsolete

SIZE		ISSUE 12-7-38	J.W.	TITLE: FISCHER MOD. "G" SHOCKPROOF FLUOROSCOPE REMOTE CONTROL-TERMINAL BOARD (ENGRAVED)
KIND	FROM 11464	CHANGED		
SHAPE		"		
FINISH		"		
TEMP.		"		
PATT.		"		

H. G. FISCHER & CO.
2335 WABANSIA AVE.
CHICAGO, ILL.

CAT. NO.

PART NO. 11464FA

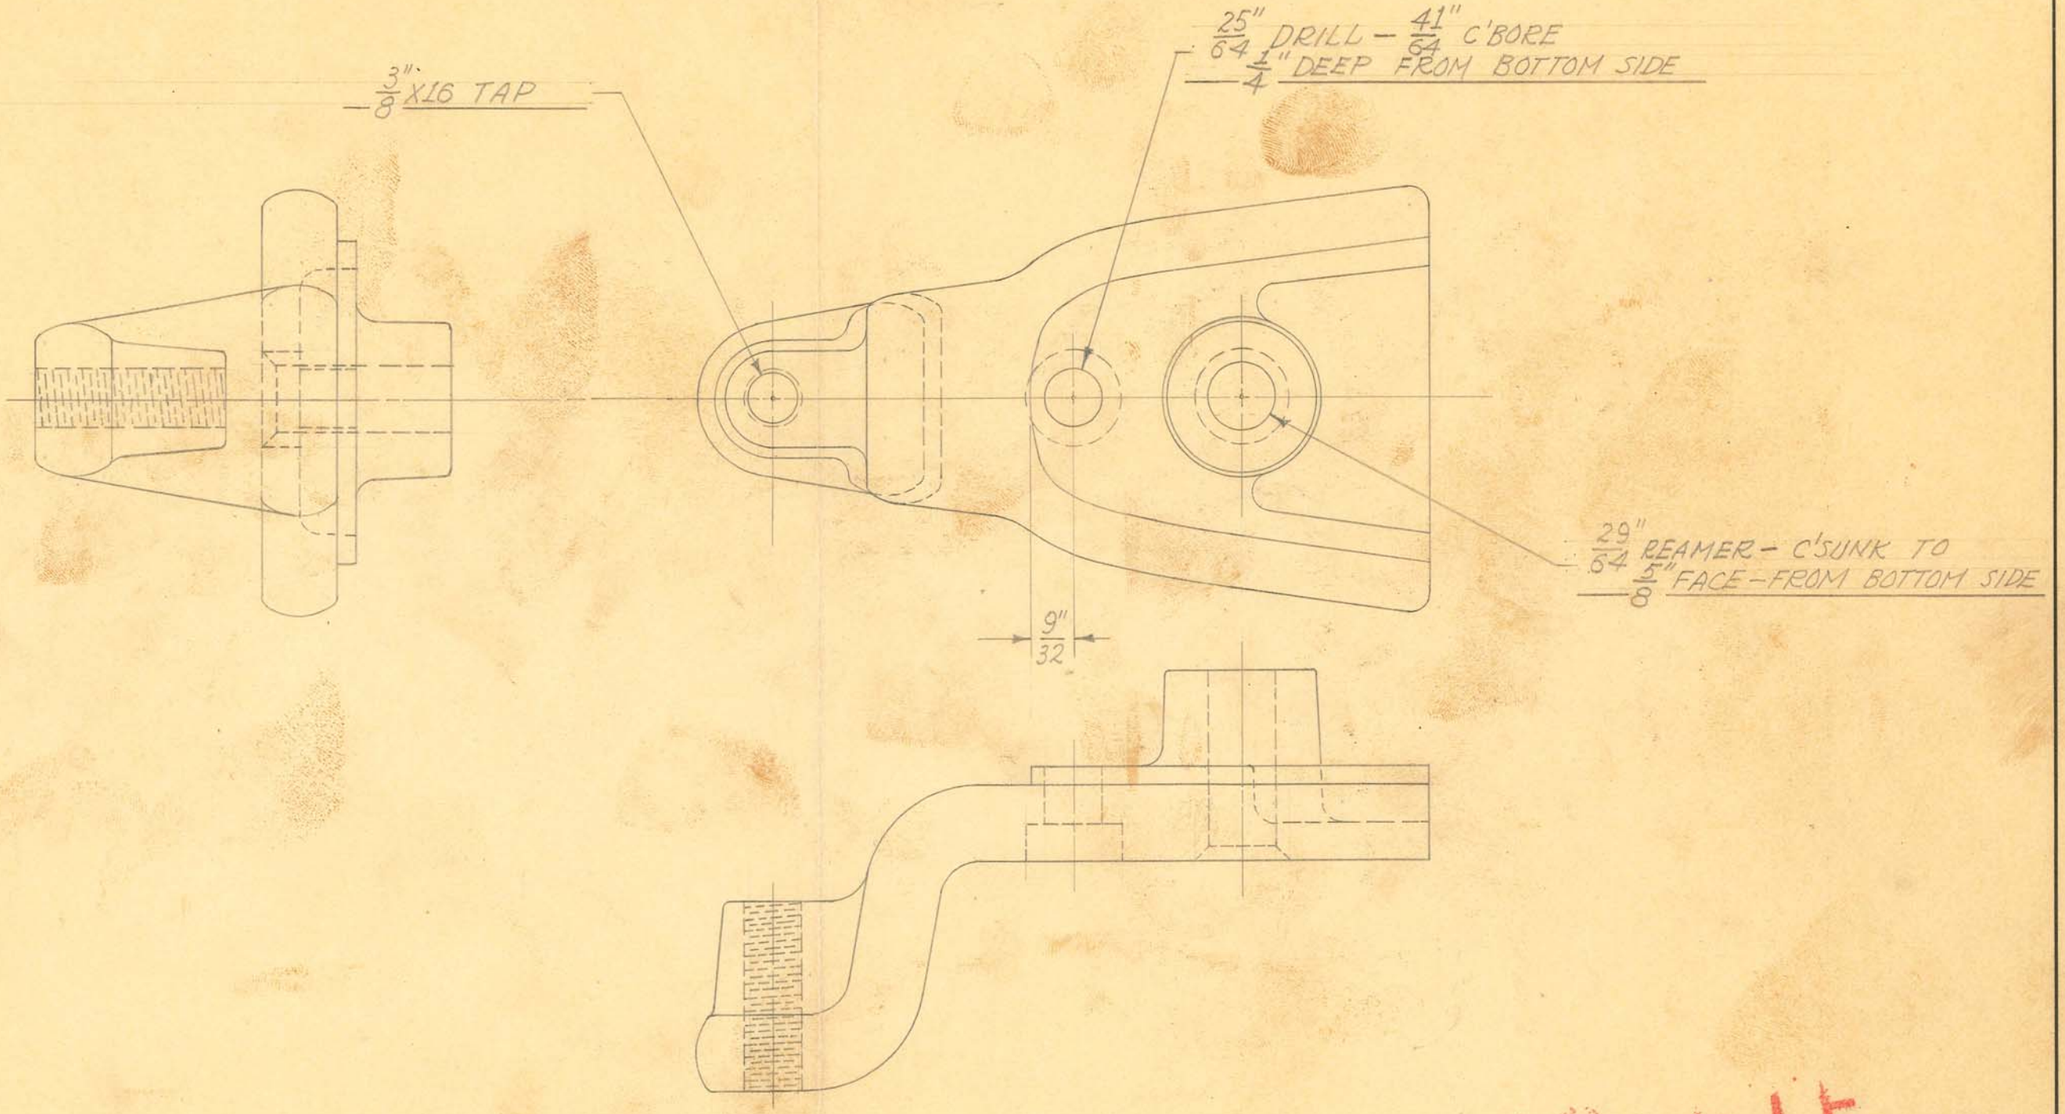

2 REQUIRED

OBSOLETE

Obsolete

SIZE		ISSUE 5-27-38	J.W.	TITLE: FISCHER MOD. "G" SHOCKPROOF FLUOROSCOPE BASE CASTER BLOCK – SMALL
KIND	IRON CASTING	CHANGED		
SHAPE		"		
FINISH	PAINTED	"		
TEMP.		"		
PATT.	1229	"		

H. G. FISCHER & CO.
2335 WABANSIA AVE.
CHICAGO, ILL.

CAT. NO.

PART NO. 11491F

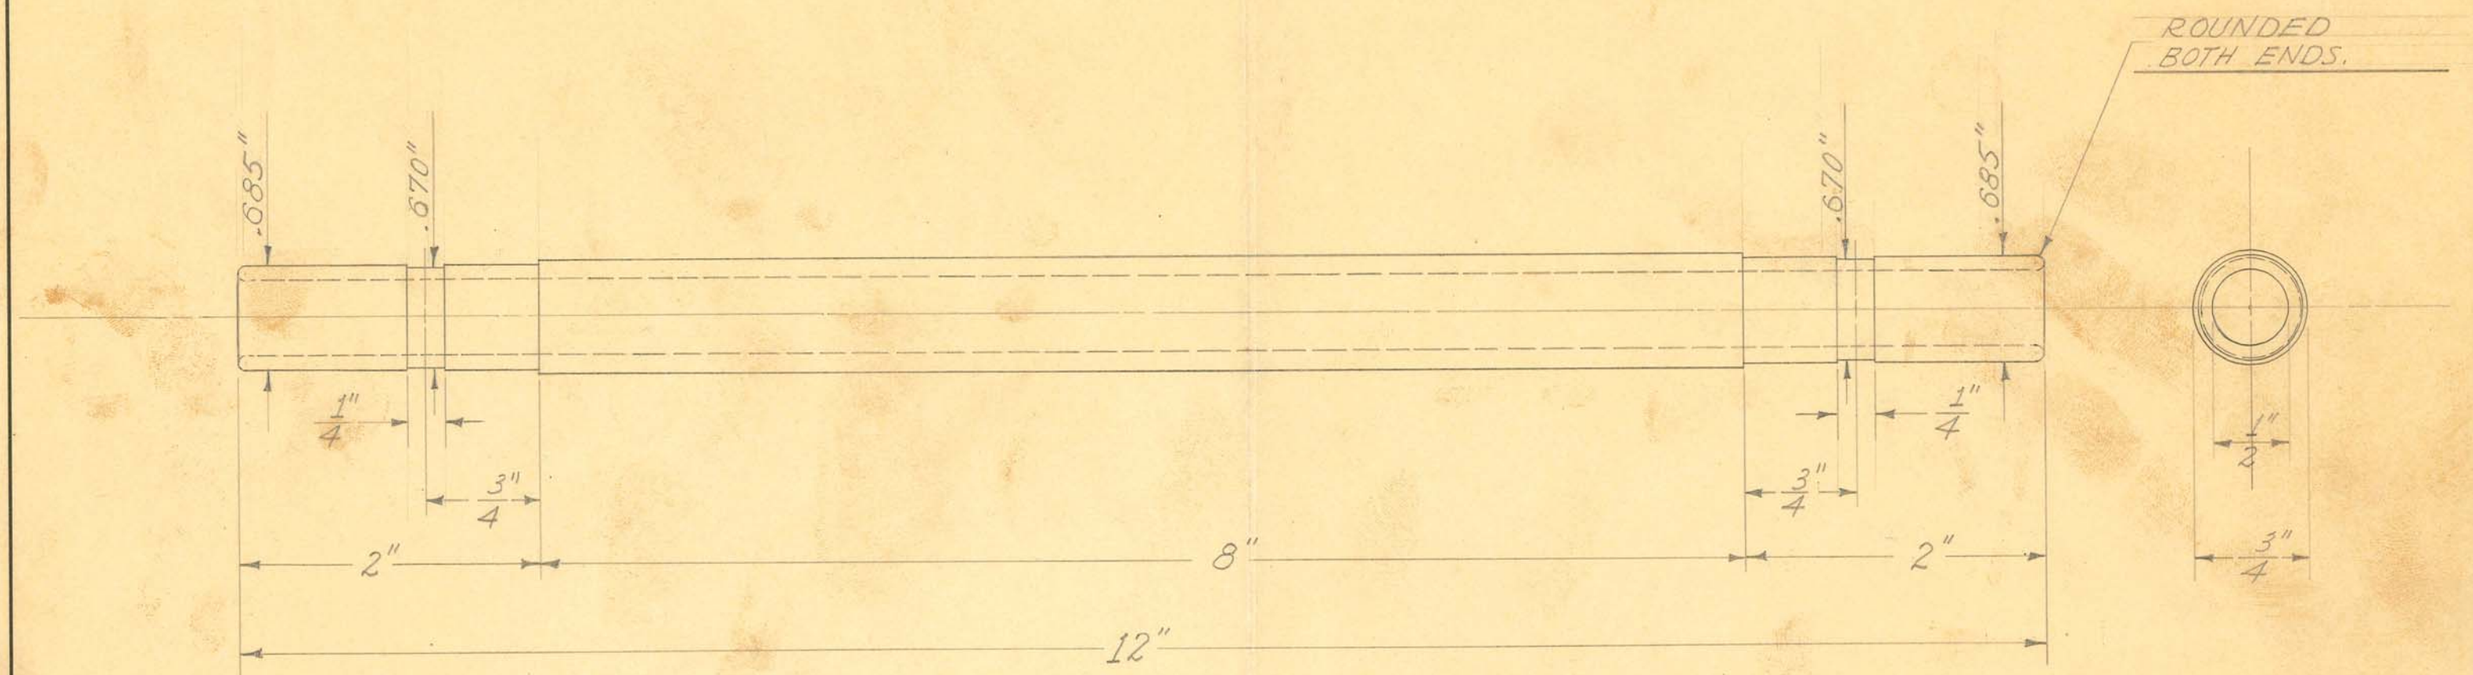

2 REQUIRED

OBSOLETE

SIZE	3/4" O.D. X 1/2" I.D.	ISSUE 5-27-38	J.W.
KIND	C.R. STEEL	CHANGED	
SHAPE	TUBING	"	
FINISH	PAINTED	"	
TEMP.		"	
PATT.		"	

TITLE: FISCHER MOD. "G" SHOCKPROOF FLUOROSCOPE PORTABLE STAND LEG SUPPORT TIE ROD

H. G. FISCHER & CO.
2335 WABANSIA AVE.
CHICAGO, ILL.

CAT. NO.

PART NO. 11503

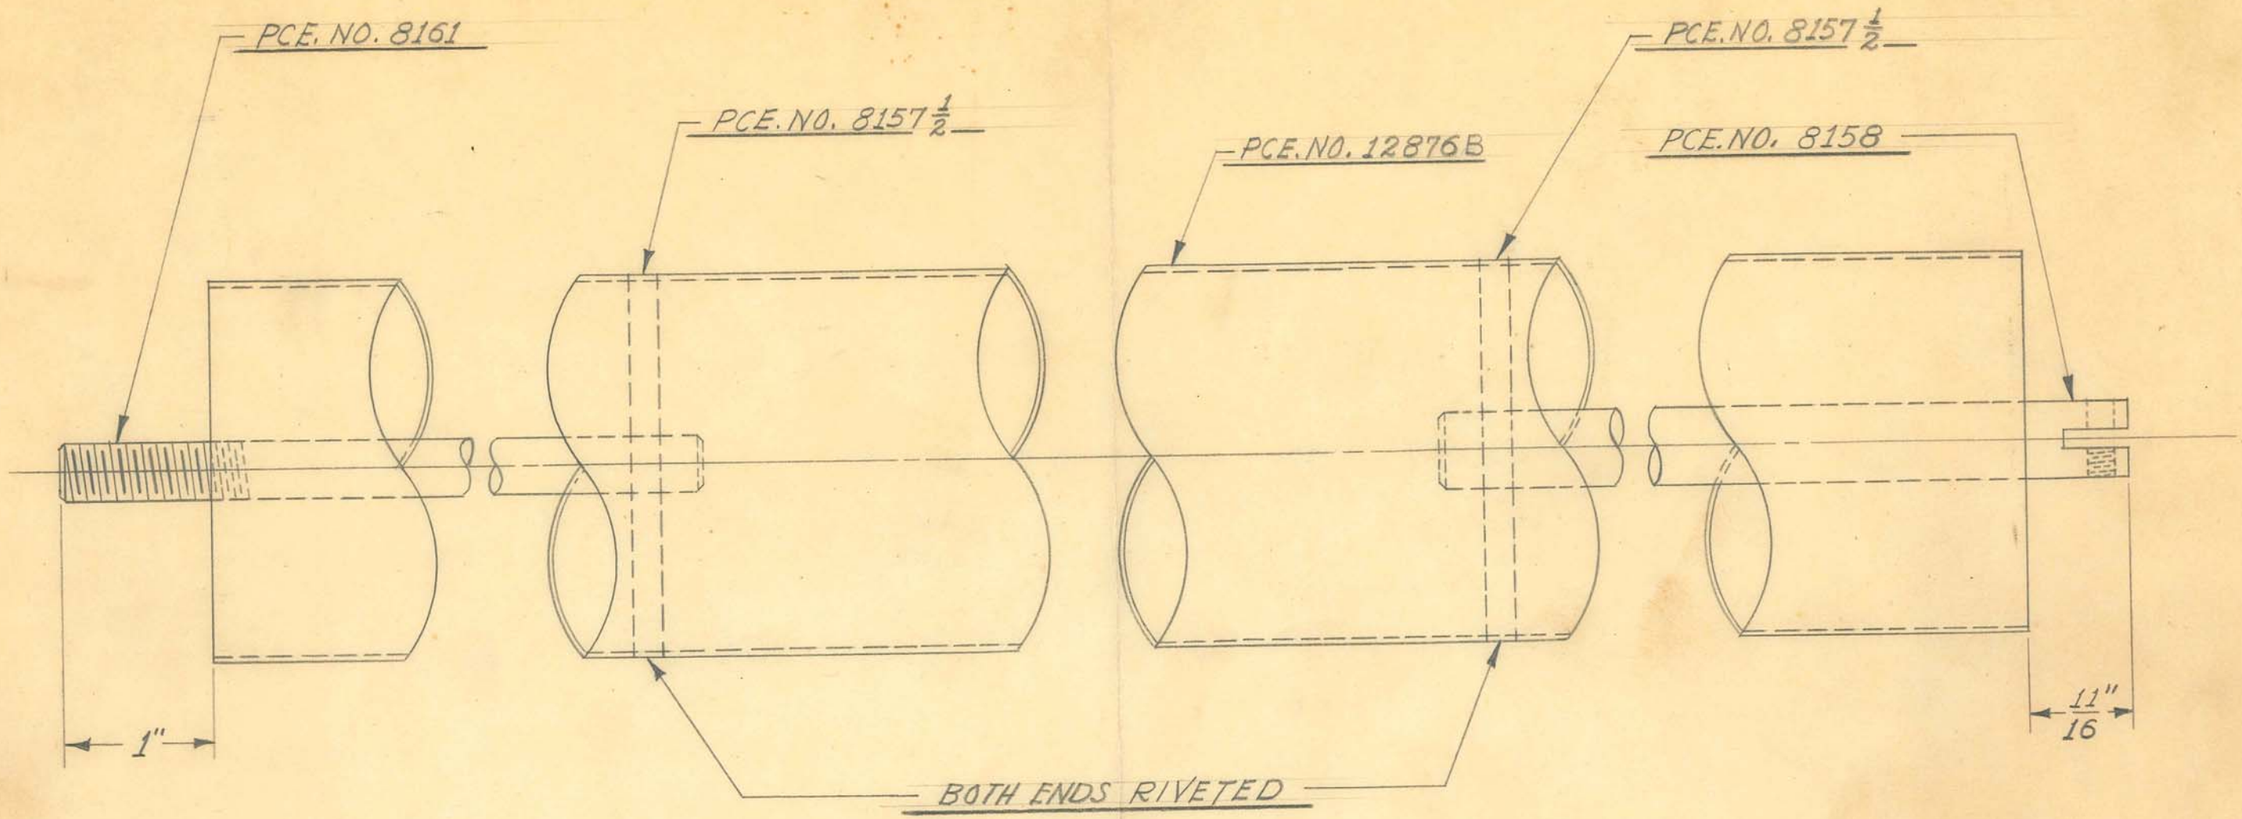

FILL WITH LEAD TO BRING TOTAL WEIGHT UP TO 56 LBS. - 2 OZ.

TOLERANCE — PLUS 1 Lb. MINUS 1/2 Lb.

2 REQUIRED.

OBSOLETE

SIZE		ISSUE 3-20-40	J.W.
KIND		CHANGED	
SHAPE		"	
FINISH		"	
TEMP.		"	
PATT.		"	

TITLE: FISCHER MOD. "GF-15" S.P. FLUOROSCOPE COUNTERWEIGHT ASSEMBLY

H. G. FISCHER & CO.
2335 WABANSIA AVE.
CHICAGO, ILL.

CAT. NO.

PART NO. 11525GA

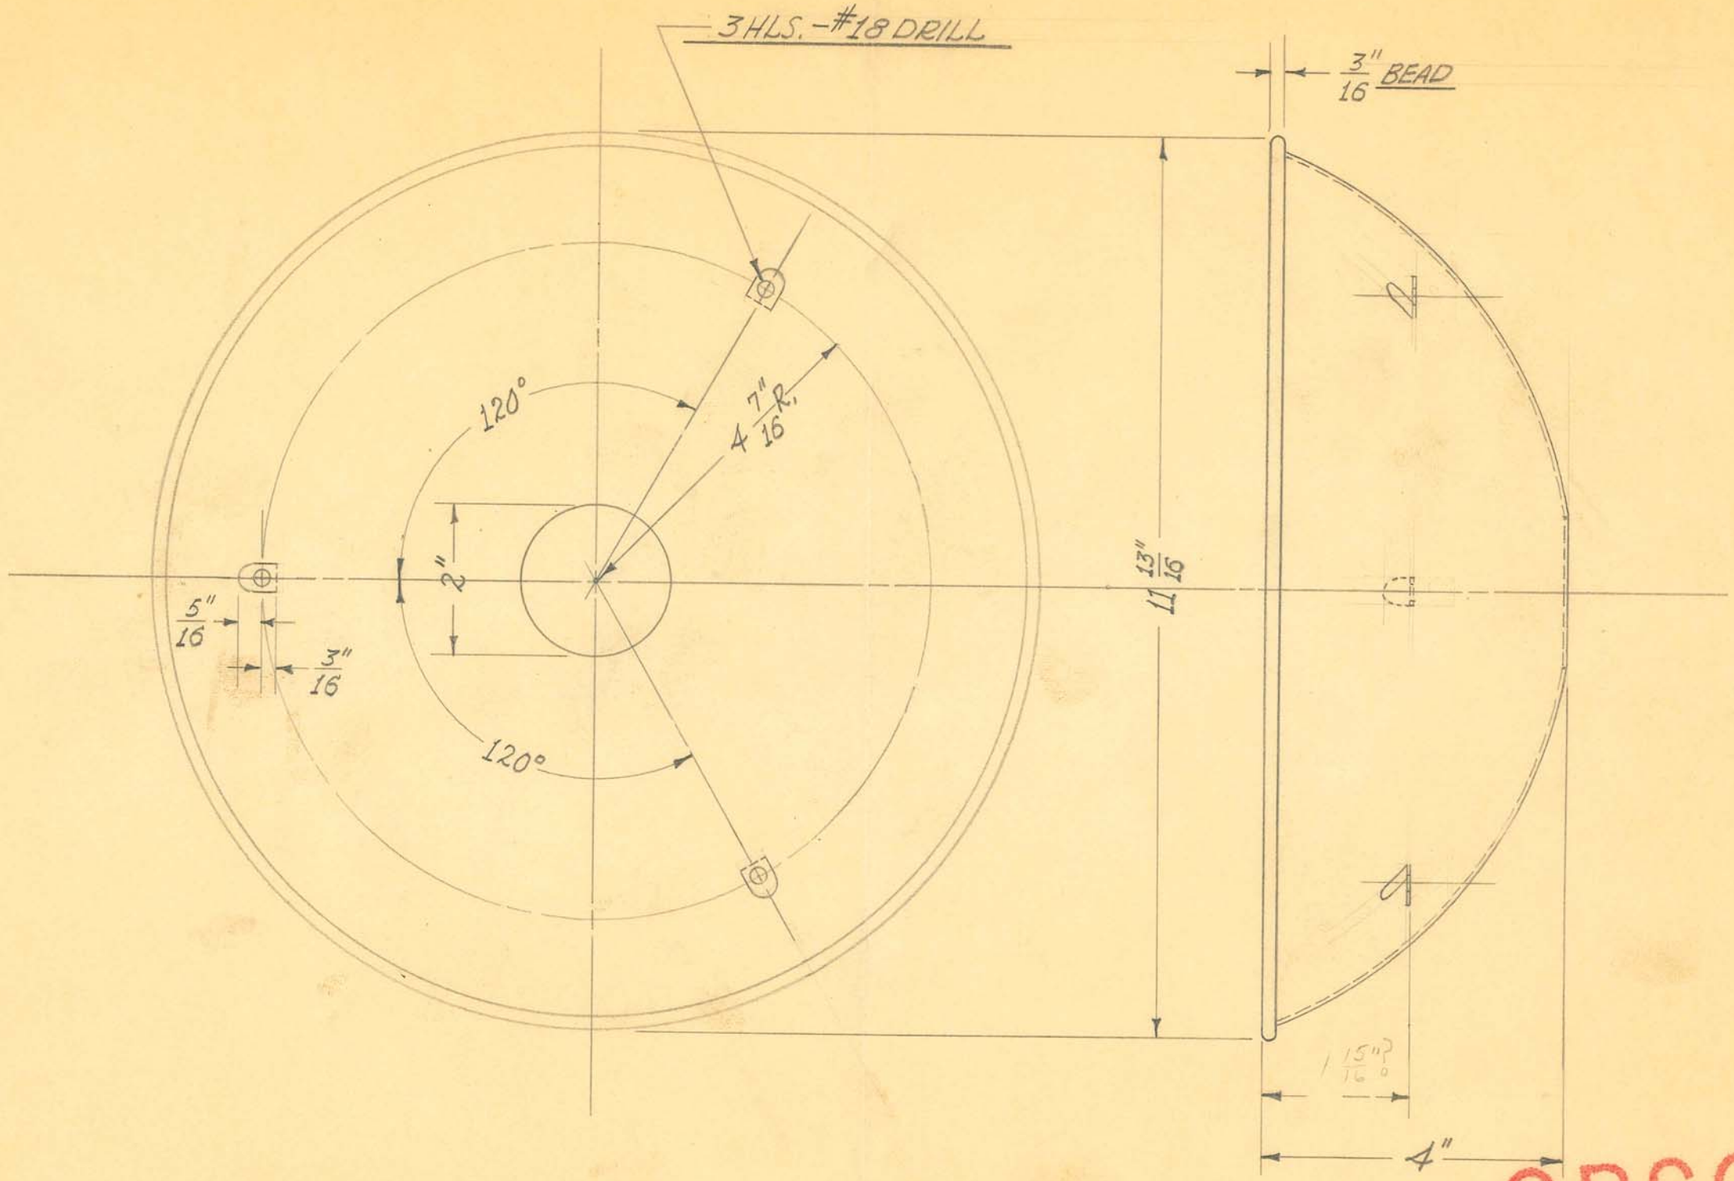

SCALE ~ 1/2 = 1"

FROM 5779

OBSOLETE

SIZE		ISSUE 1-17-39	J.W.
KIND		CHANGED	
SHAPE		"	
FINISH	POLISH INSIDE ONLY	"	
TEMP.		"	
PATT.		"	

TITLE: FISCHER INFRA RED LAMP REFLECTOR

H. G. FISCHER & CO.
2335 WABANSIA AVE.
CHICAGO, ILL.

CAT. NO.

PART NO. 11535

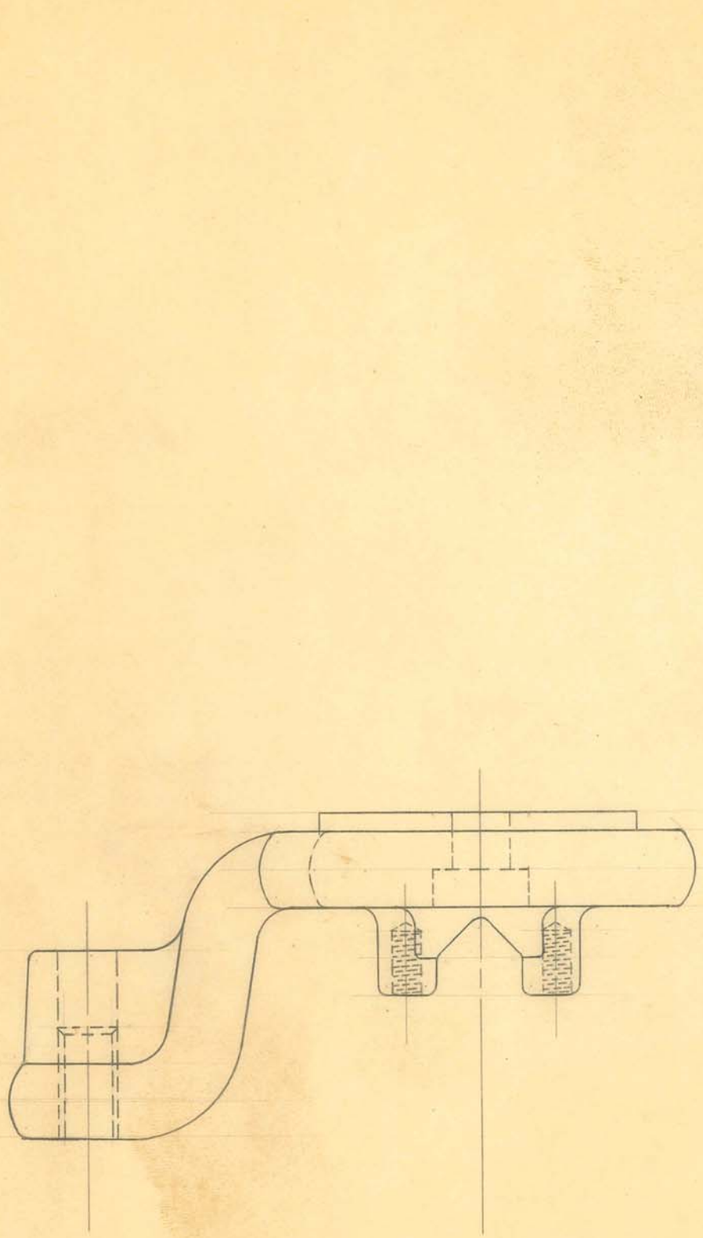

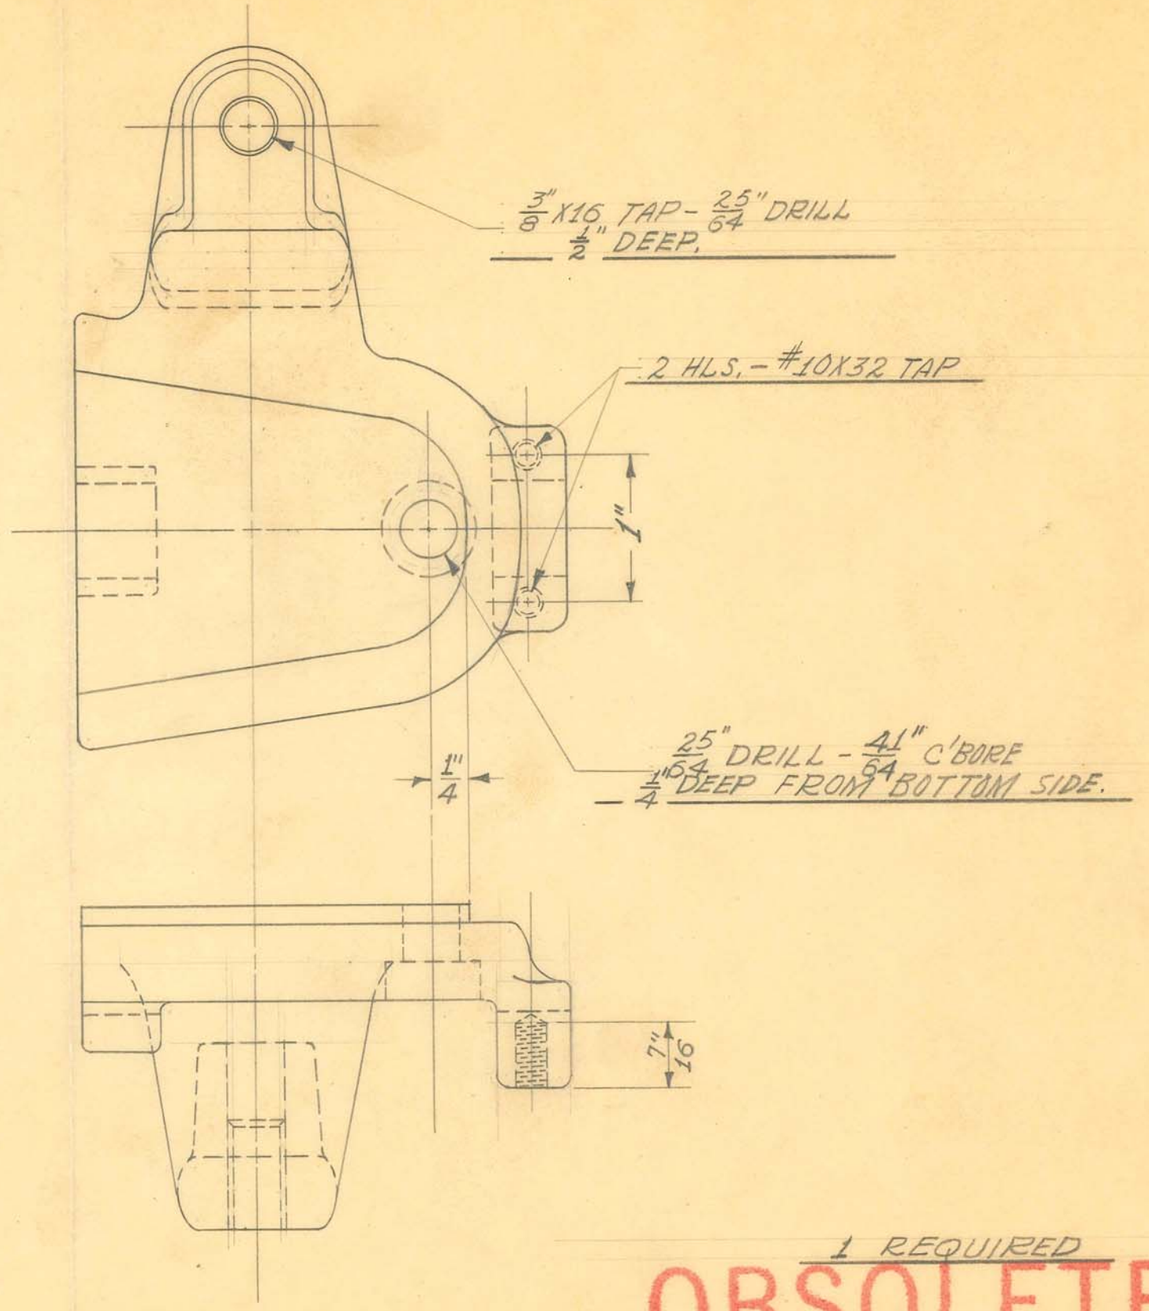

1 REQUIRED

OBSOLETE

SIZE		ISSUE 4-18-40	J.W.	TITLE: FISCHER MOD. "GF" S.P. FLUOROSCOPE BASE ROLLER BLOCK - SMALL - LEFT
KIND	IRON CASTING	CHANGED		
SHAPE		"		
FINISH	PAINTED	"		
TEMP.		"		
	1521	"		

H. G. FISCHER & CO.
2335 WABANSIA AVE.
CHICAGO, ILL.

CAT. NO.

PART NO. 11545F

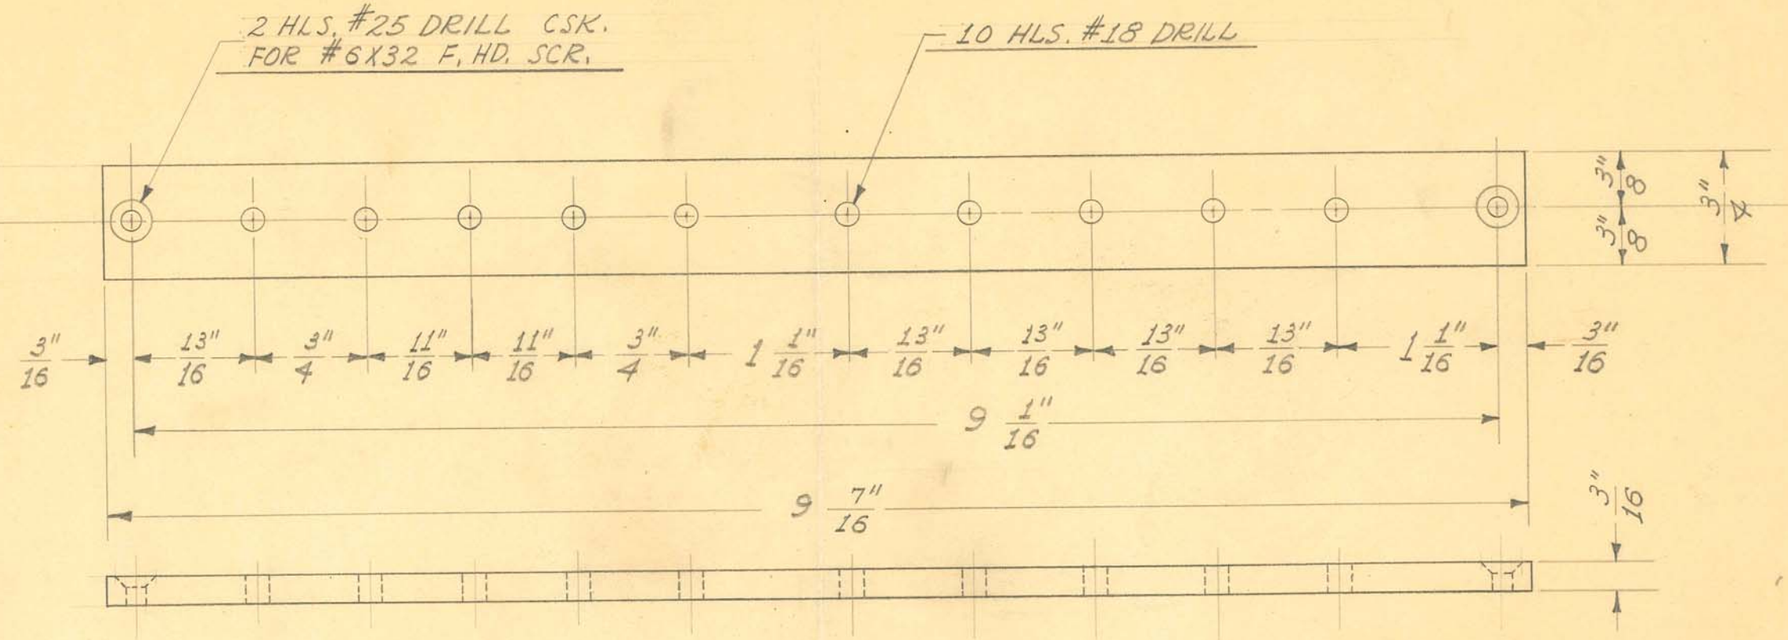

1 REQUIRED

OBSOLETE

SIZE	3/16" SHEET	ISSUE 11-2-37	J.W.	TITLE: FISCHER MOD. "100-100" REMOTE CONTROL TIMER – CONTROL CASE TERMINAL BOARD
KIND	BAKELITE	CHANGED		
SHAPE		"		
FINISH		"		
TEMP.		"		
PATT.		"		

H. G. FISCHER & CO.
2338 WABANSIA AVE.
CHICAGO, ILL.

CAT. NO.

PART NO. 11004

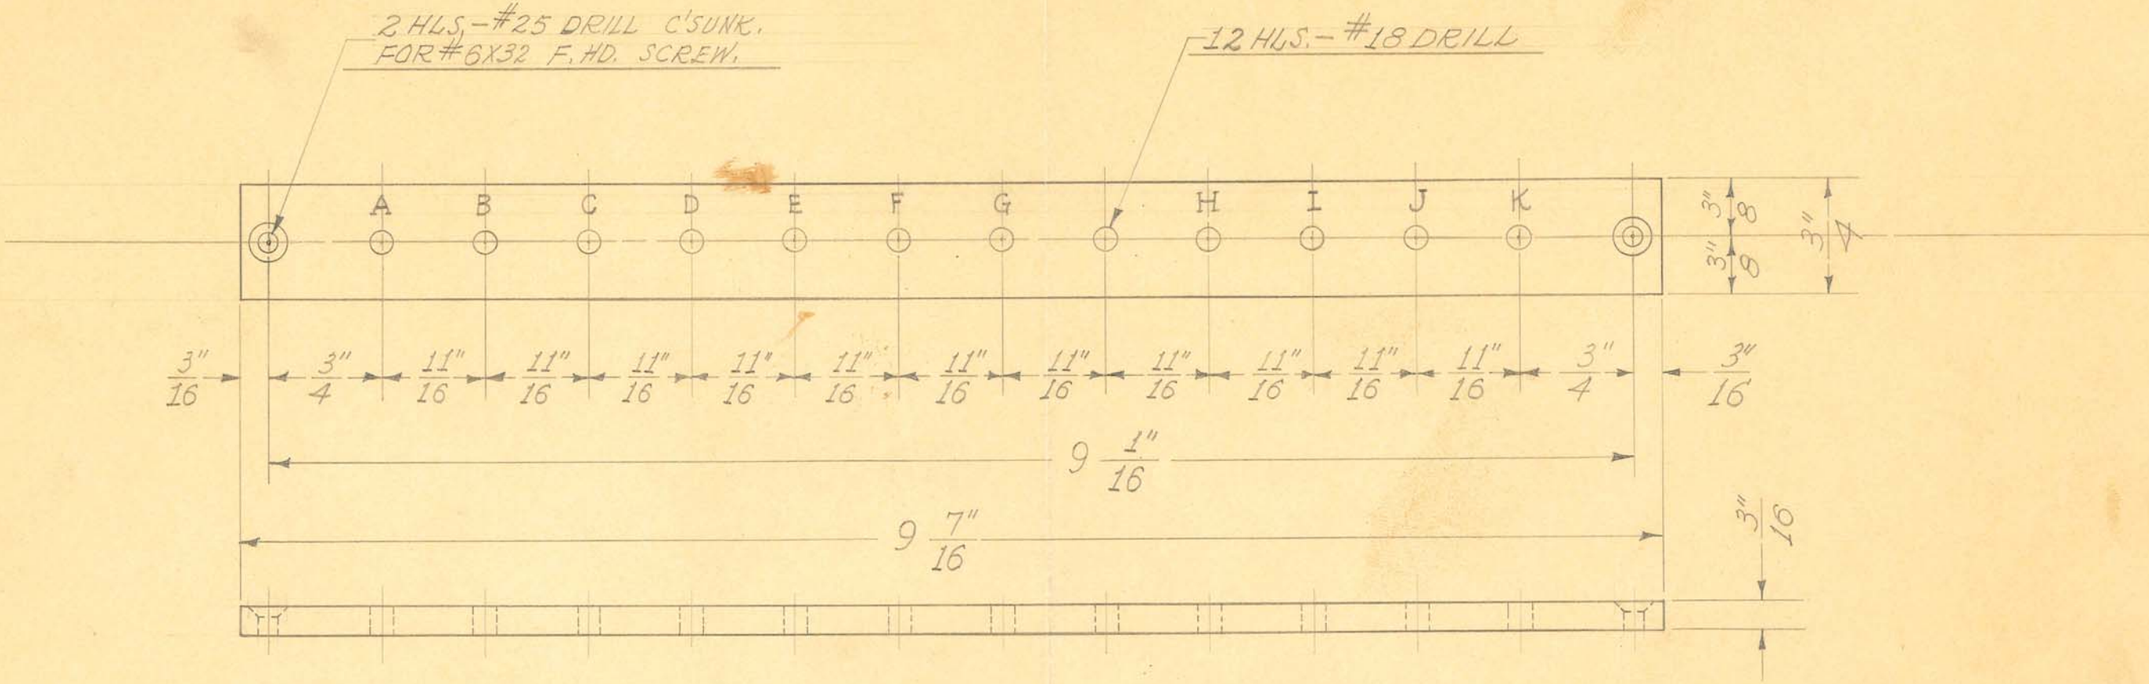

1 REQUIRED

OBSOLETE

SIZE	3/16" SHEET	ISSUE 5-18-38	J.W.
KIND	BAKELITE	CHANGED	
SHAPE		"	
FINISH		"	
TEMP.		"	
PATT.		"	

TITLE: FISCHER MOD. "100-100" REMOTE CONTROL TIMER-CONTROL CASE TERMINAL BOARD

H. G. FISCHER & CO.
2335 WABANSIA AVE.
CHICAGO. ILL.

CAT. NO.

PART NO. 11004A

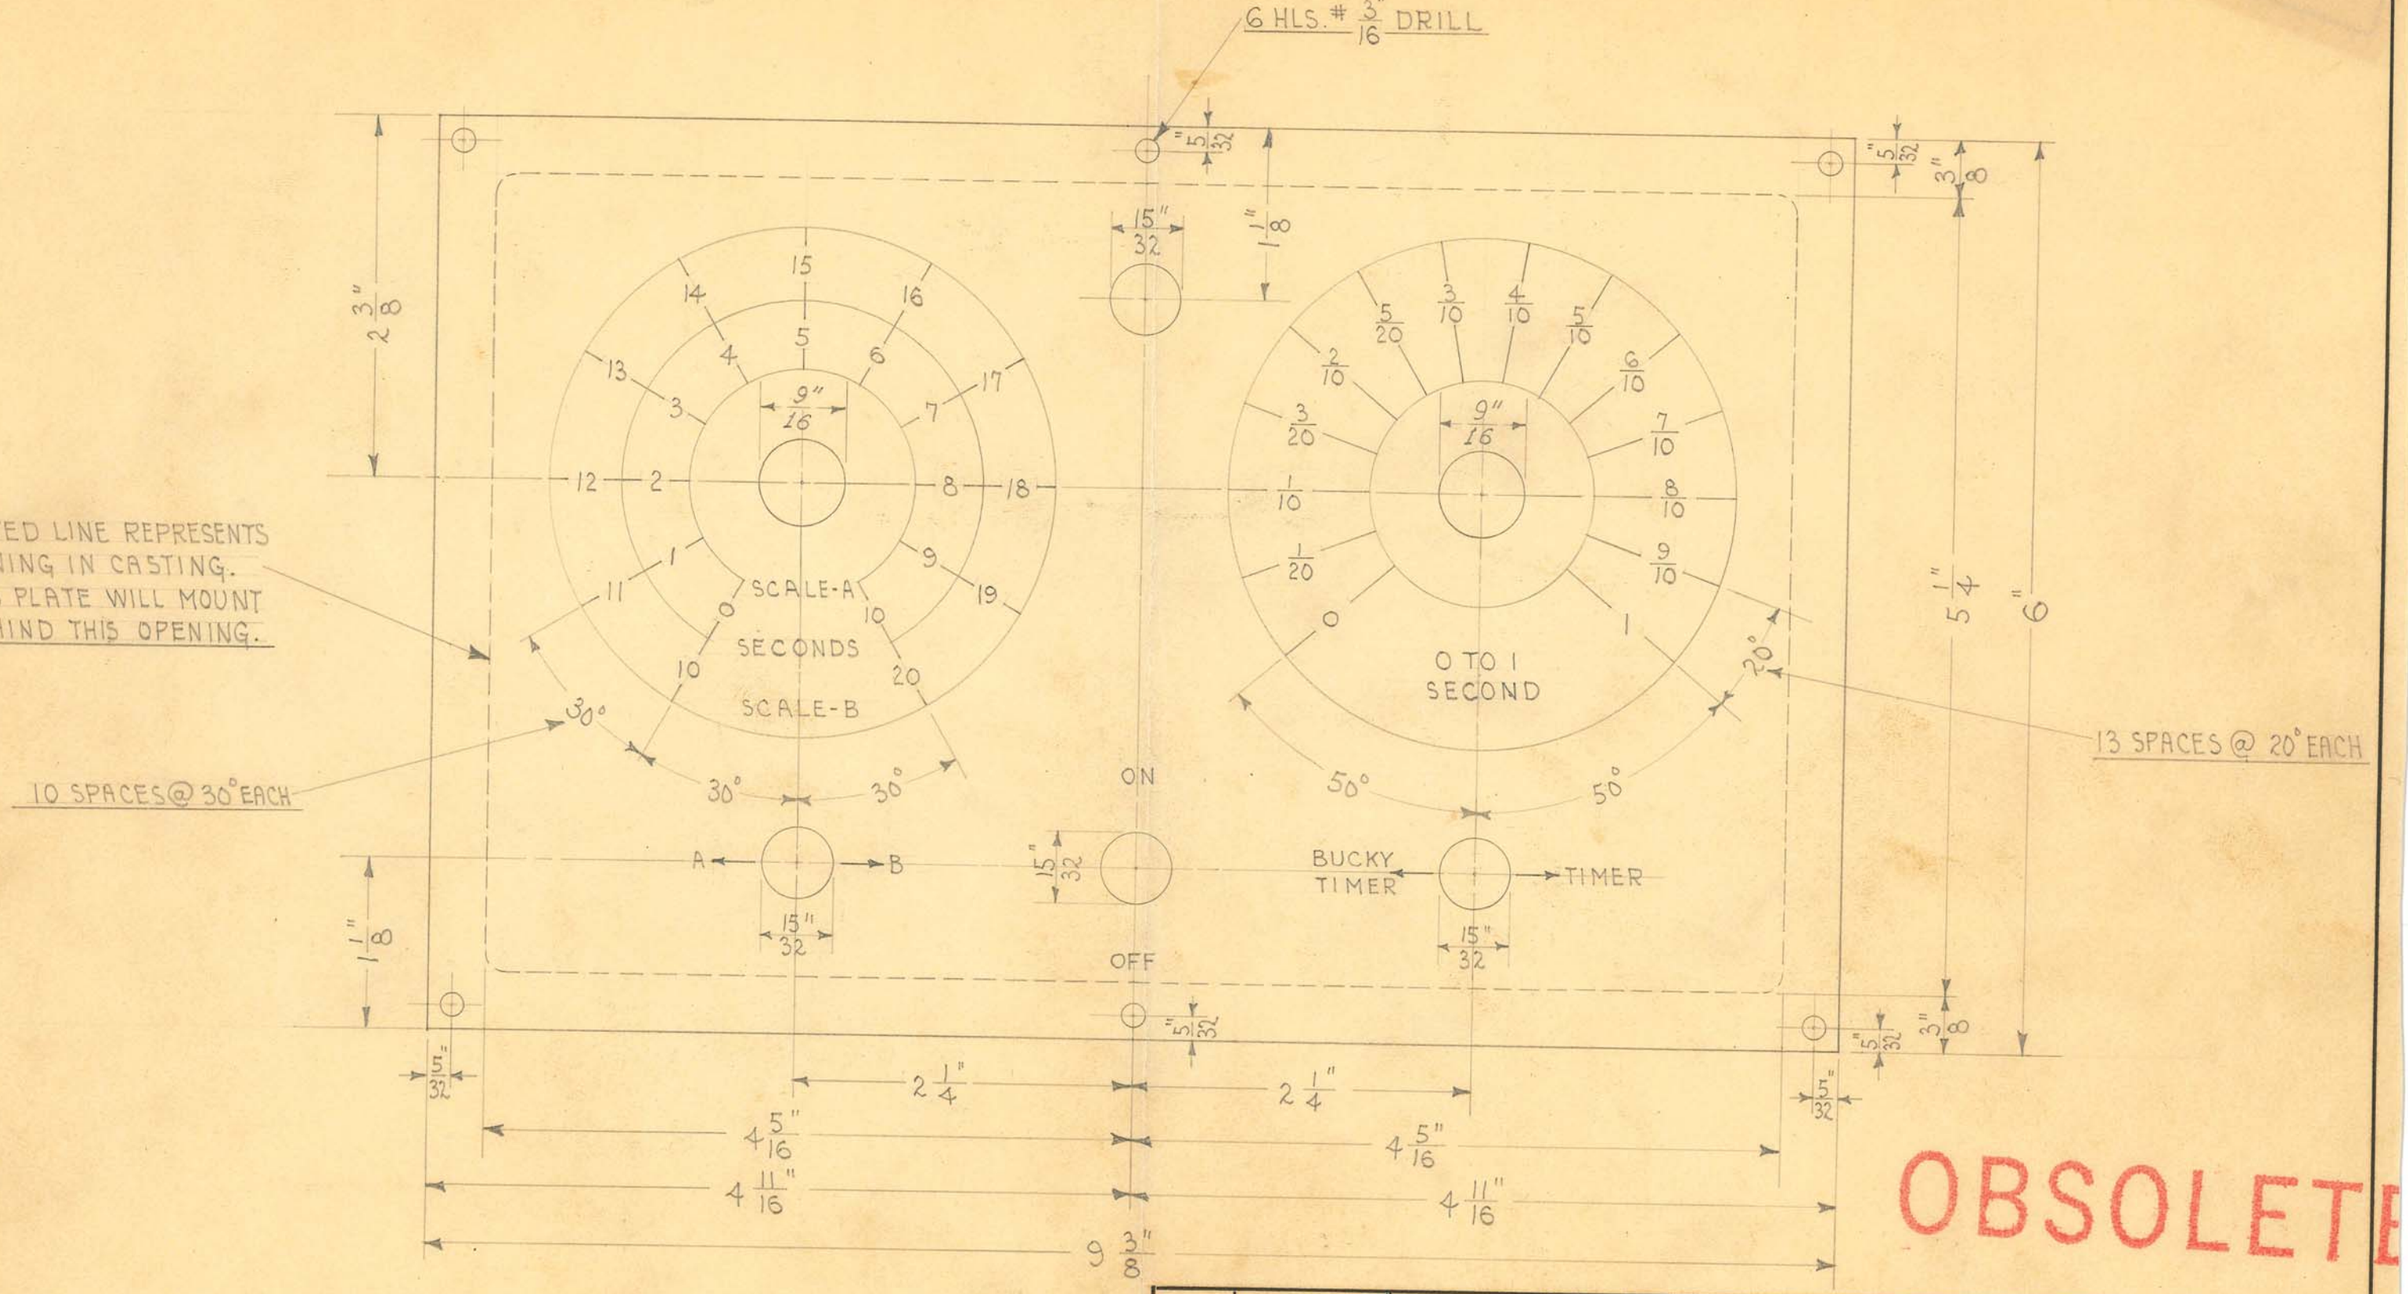

OBSOLETE

SIZE		ISSUE 10-5-37	J.E.	TITLE: MODEL "100-100" ELECTRONIC TIMER CONTROL PLATE
KIND		CHANGED 12-22-37	J.W.	
SHAPE		"		
FINISH		"		
TEMP.		"		
PATT.		"		

H. G. FISCHER & CO.
2335 WABANSIA AVE.

CAT. NO.

PART NO. 10084

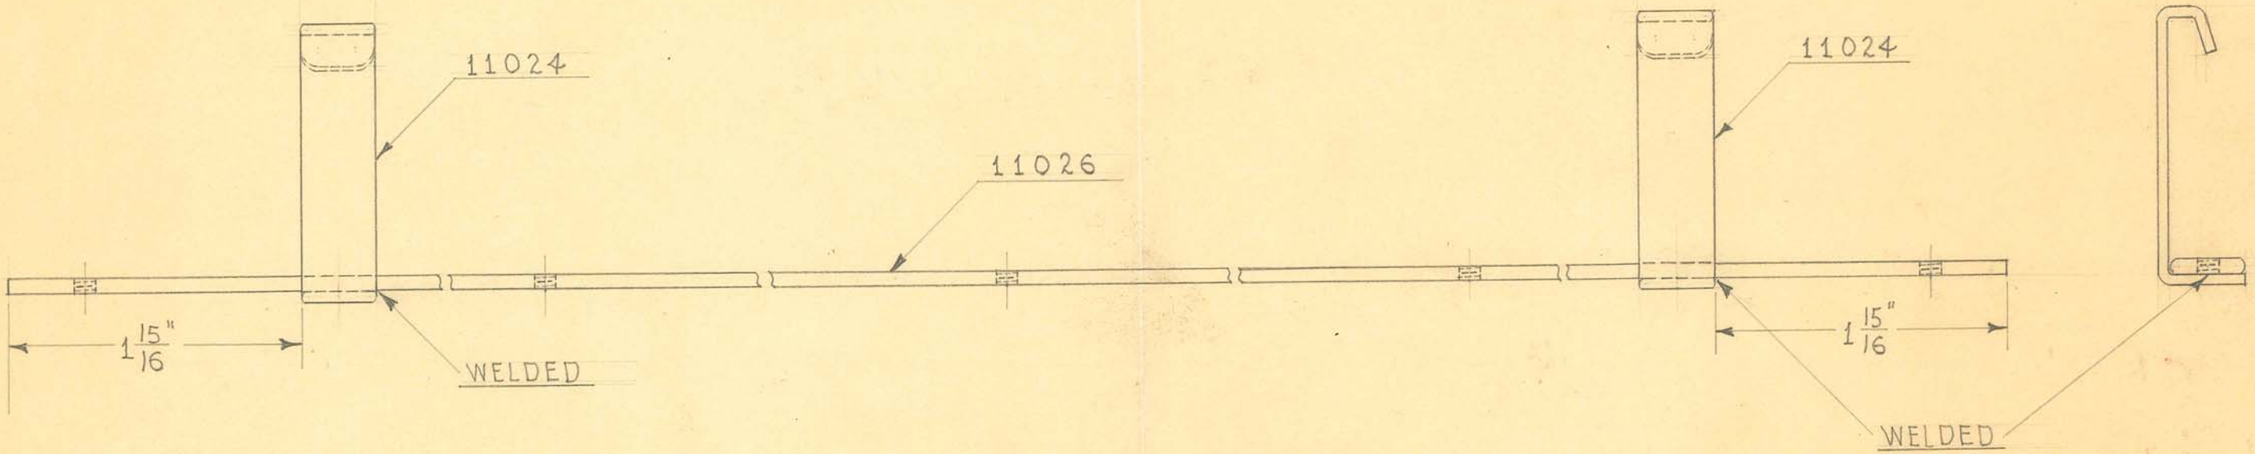

1 REQUIRED

OBSOLETE

SIZE		ISSUE 10-8-37	A.E.
KIND		CHANGED	
SHAPE		"	
FINISH	CAD.#23	"	
TEMP.		"	
PATT.		"	

TITLE: WALL FORM CASSETTE HOLDER
CASSETTE COVER STRIP & BRKT. ASSEM.

H. G. FISCHER & CO.
2335 WABANSIA AVE.
CHICAGO, ILL.

CAT. NO.

PART NO. 11013G

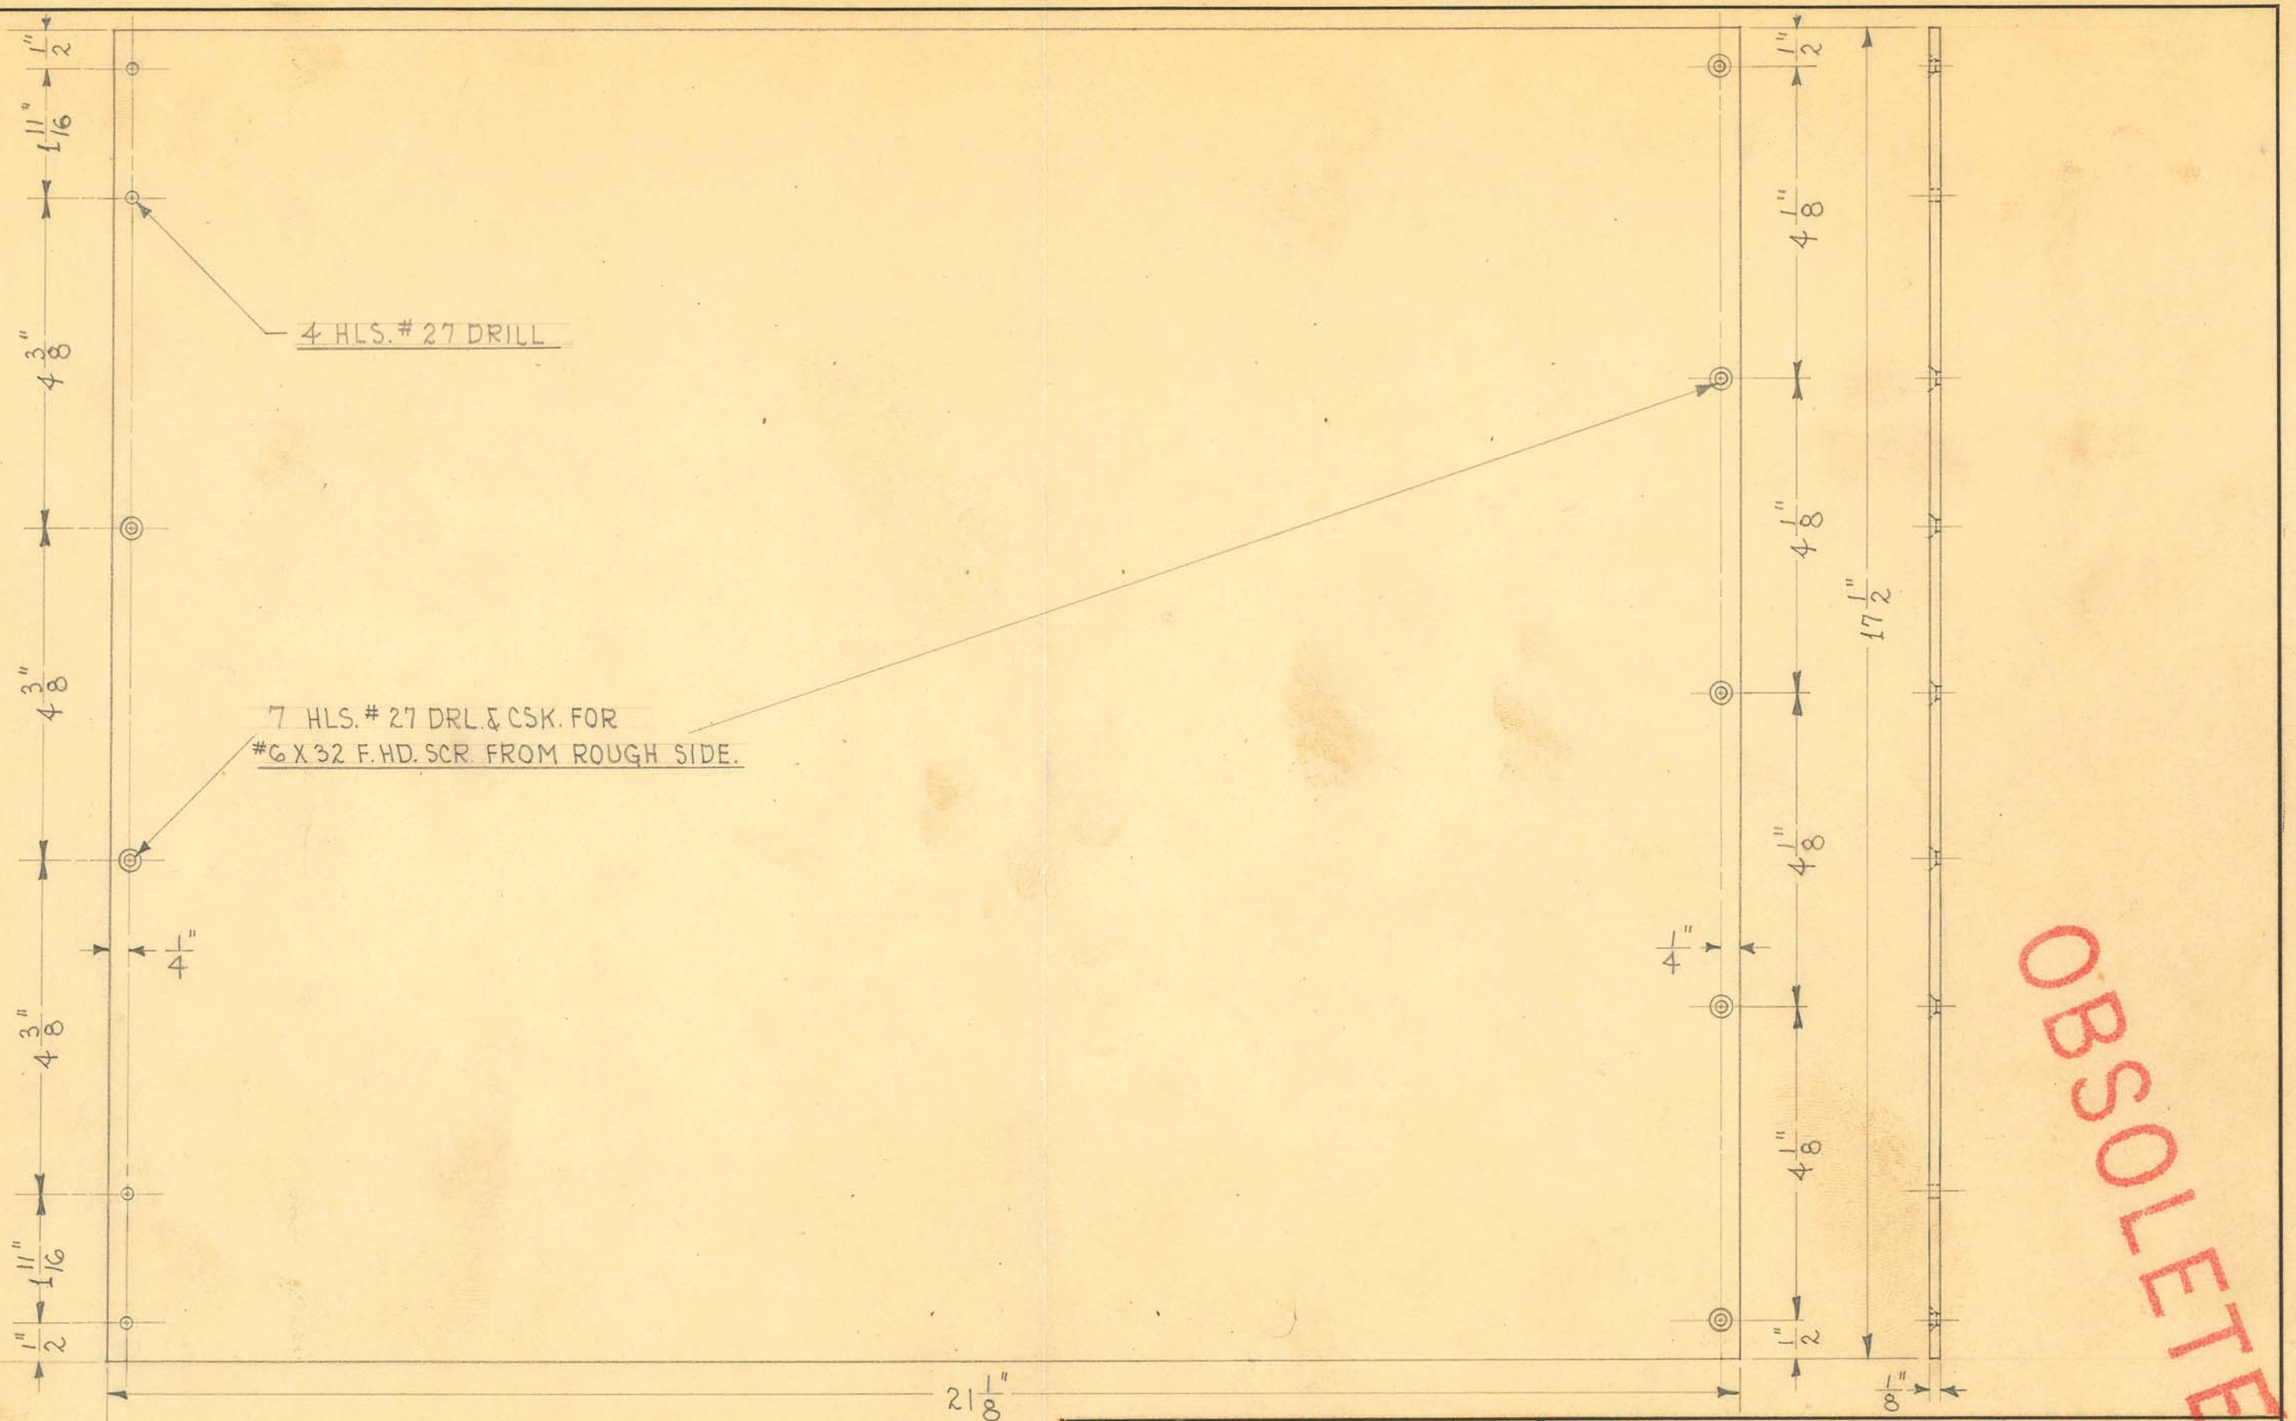

OBSOLETE

SIZE	21 1/8" X 17 1/2" X 1/8"	ISSUE 10-8-37	H. E.
KIND	PRESSWOOD	CHANGED	
SHAPE		"	
FINISH	GREEN LACQUER	"	
TEMP.		"	
PATT.		"	

TITLE:
WALL FORM CASSETTE HOLDER
CASSETTE COVER

H. G. FISCHER & CO.
2335 WABANSIA AVE.
CHICAGO, ILL.

CAT. NO.

PART NO. 11022F

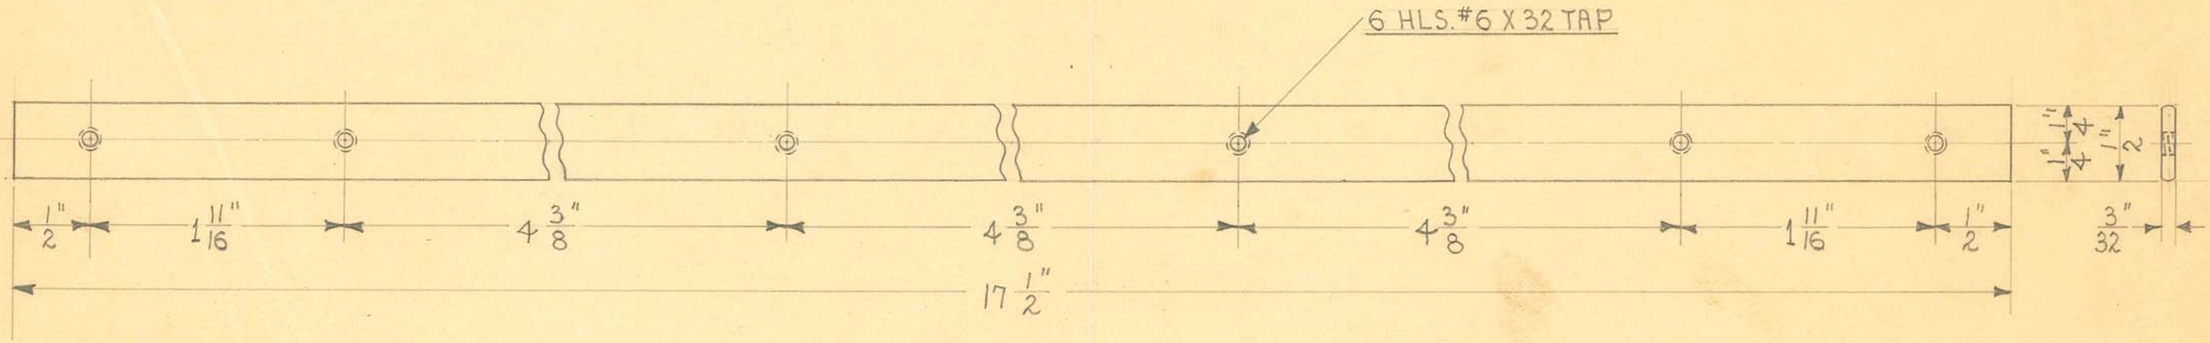

1 REQUIRED

OBSOLETE

SIZE	1/2" X 3/32"	ISSUE 10-8-37	W.E.
KIND	FLAT WIRE	CHANGED	
SHAPE		"	
FINISH	CAD. #23	"	
TEMP.		"	

TITLE:
WALL FORM CASSETTE HOLDER
CASSETTE COVER STRIP - LOWER

H. G. FISCHER & CO.
2335 WABANSIA AVE.

CAT. NO.

PART NO. 11023

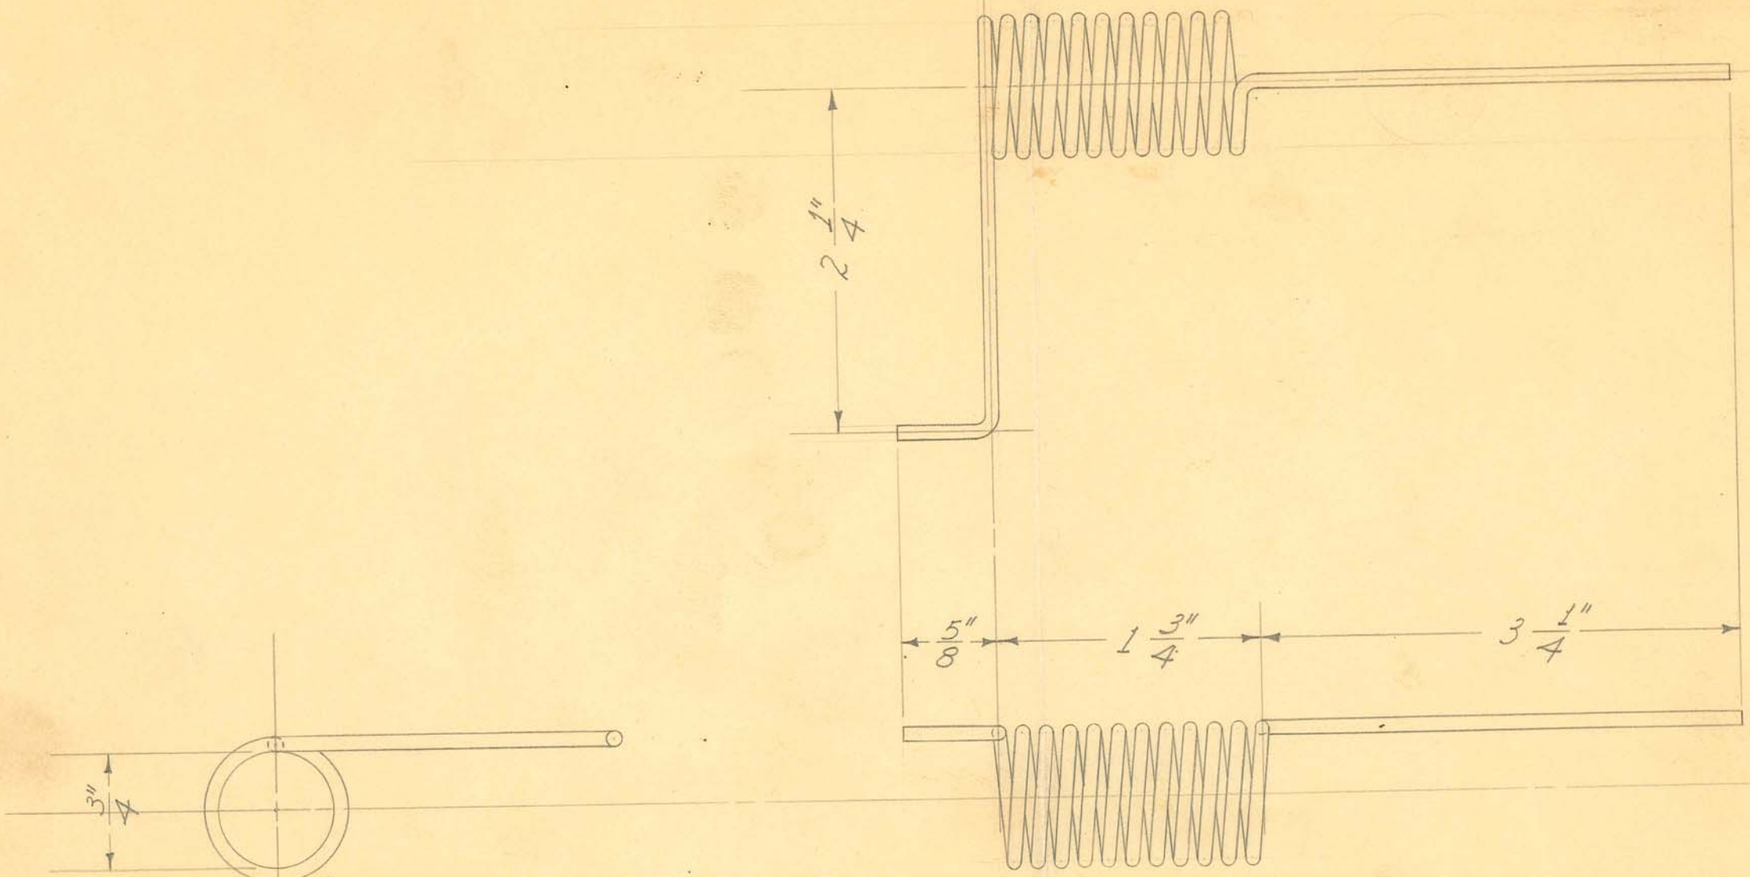

11 TURNS

1 REQUIRED

OBSOLETE

SIZE	#10 TINNED	ISSUE 3-10-38	J.W	TITLE: MOD. PORT. "C-6" PATIENT'S TUNING COIL-LEFT
KIND	COPPER WIRE	CHANGED		
SHAPE		"		
FINISH		"		
TEMP.		"		
PATT.		"		

H. G. FISCHER & CO.
2335 WABANSIA AVE.
CHICAGO, ILL.

CAT. NO.

PART NO. 11047

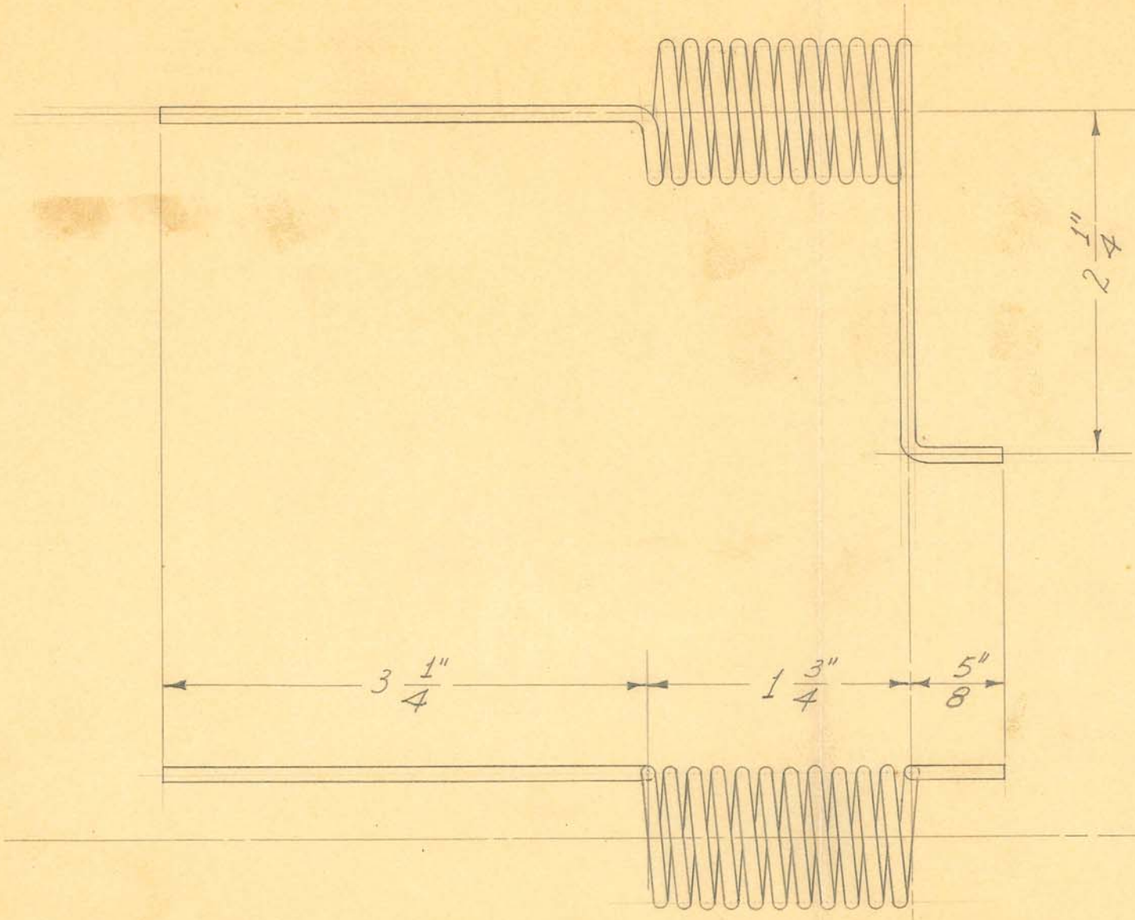

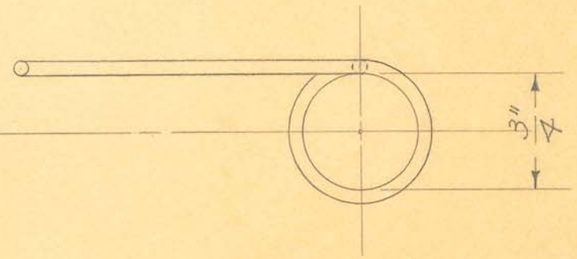

11 TURNS

1 REQUIRED

OBSOLETE

SIZE	#10 TINNED	ISSUE 3-11-38	J.W.
KIND	COPPER WIRE	CHANGED	
SHAPE		"	
FINISH		"	
TEMP.		"	

TITLE: MOD. PORT. "C-6" PATIENT'S TUNING COIL -RIGHT

H. G. FISCHER & CO.
2335 WABANSIA AVE.

CAT. NO.

PART NO. 11048

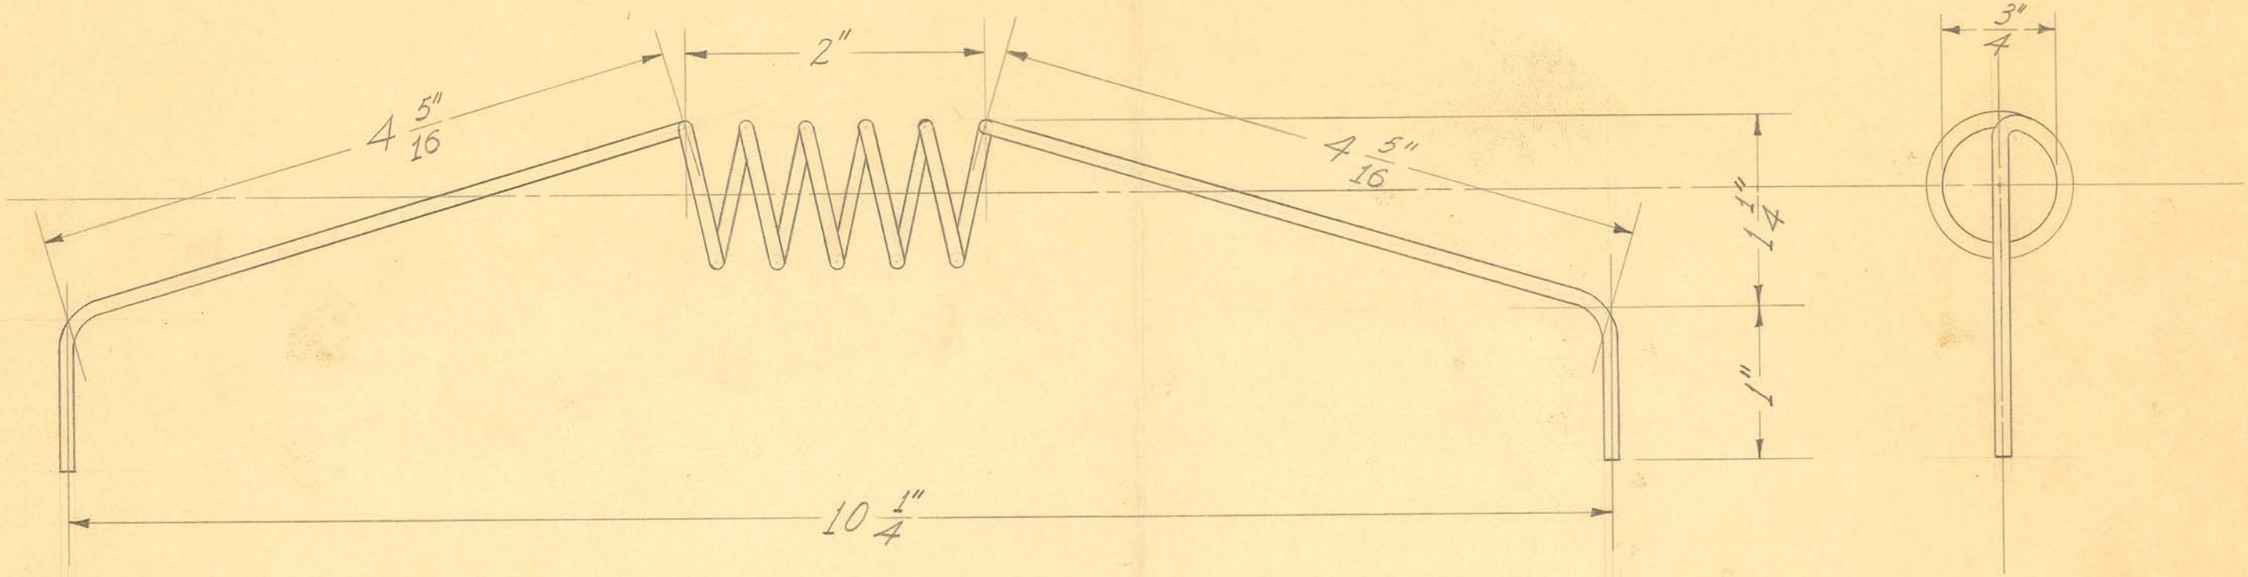

5 TURNS.

1 REQUIRED

OBSOLETE

SIZE	#10 TINNED	ISSUE 2-3-38	J.W.
KIND	COPPER WIRE	CHANGED	
SHAPE		"	
FINISH		"	
TEMP.		"	

TITLE: MOD. PORT. "C-6" PICKUP COIL

H. G. FISCHER & CO.
2335 WABANSIA AVE.
CHICAGO, ILL.

CAT. NO.

PART NO. 11049

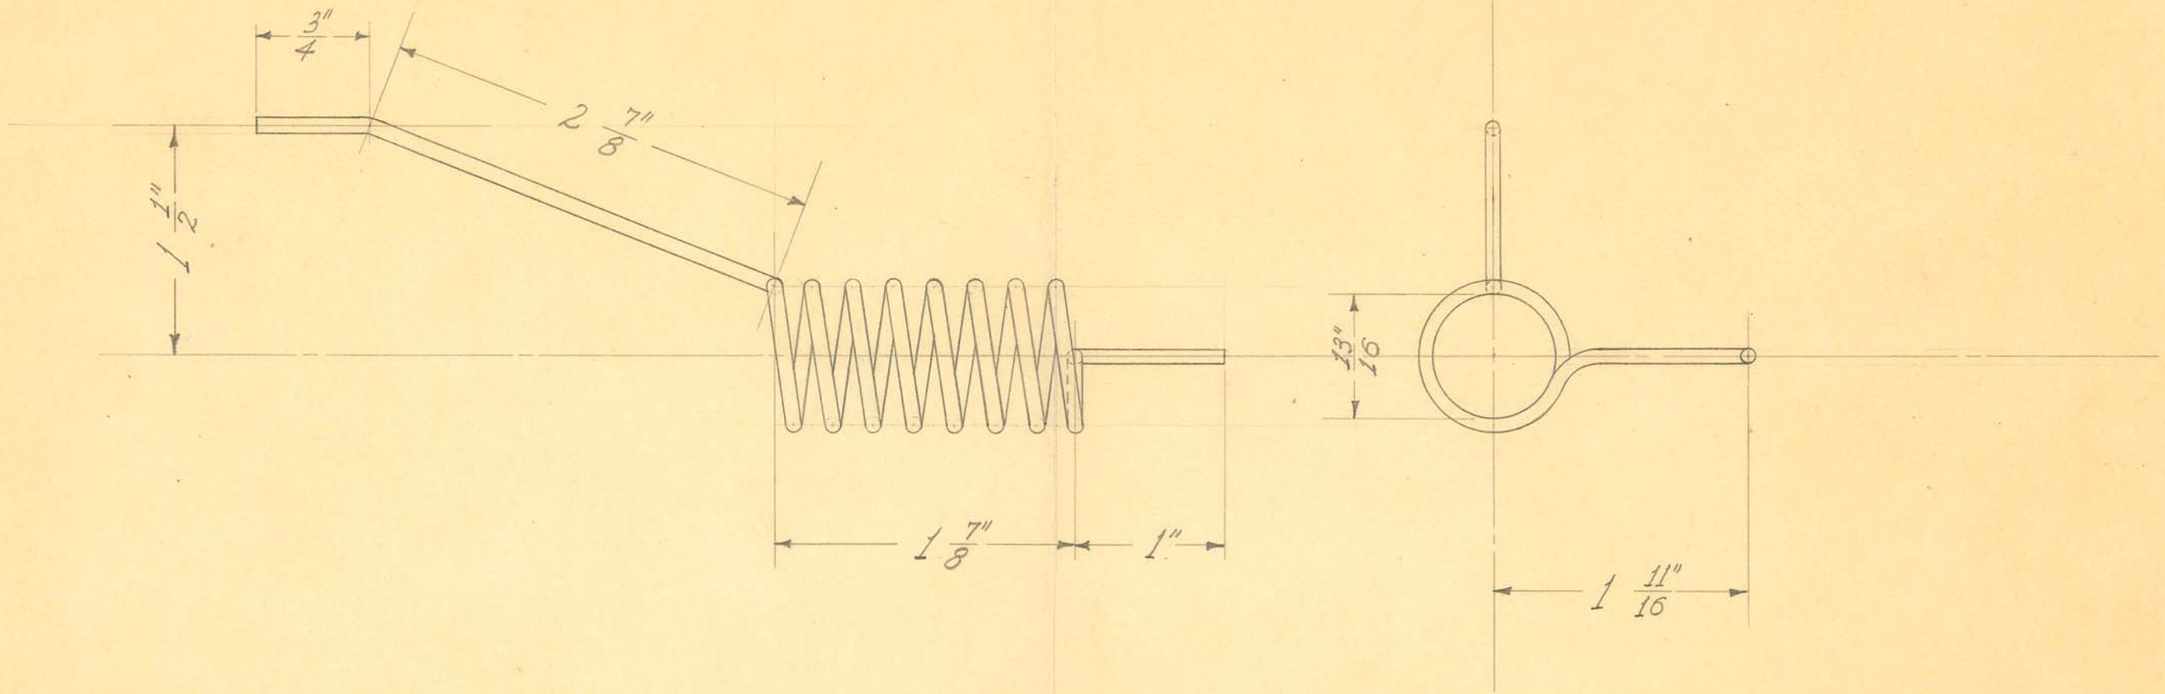

7 3/4 TURNS

1 REQUIRED

OBSOLETE

SIZE	#10 TINNED	ISSUE 1-6-38	J.W.
KIND	COPPER WIRE	CHANGED	
SHAPE		"	
FINISH		"	
TEMP.		"	

TITLE: MOD. PORT. "C-12" PATIENT'S TUNING COIL - LEFT

H. G. FISCHER & CO. | CAT. | PART 1105B

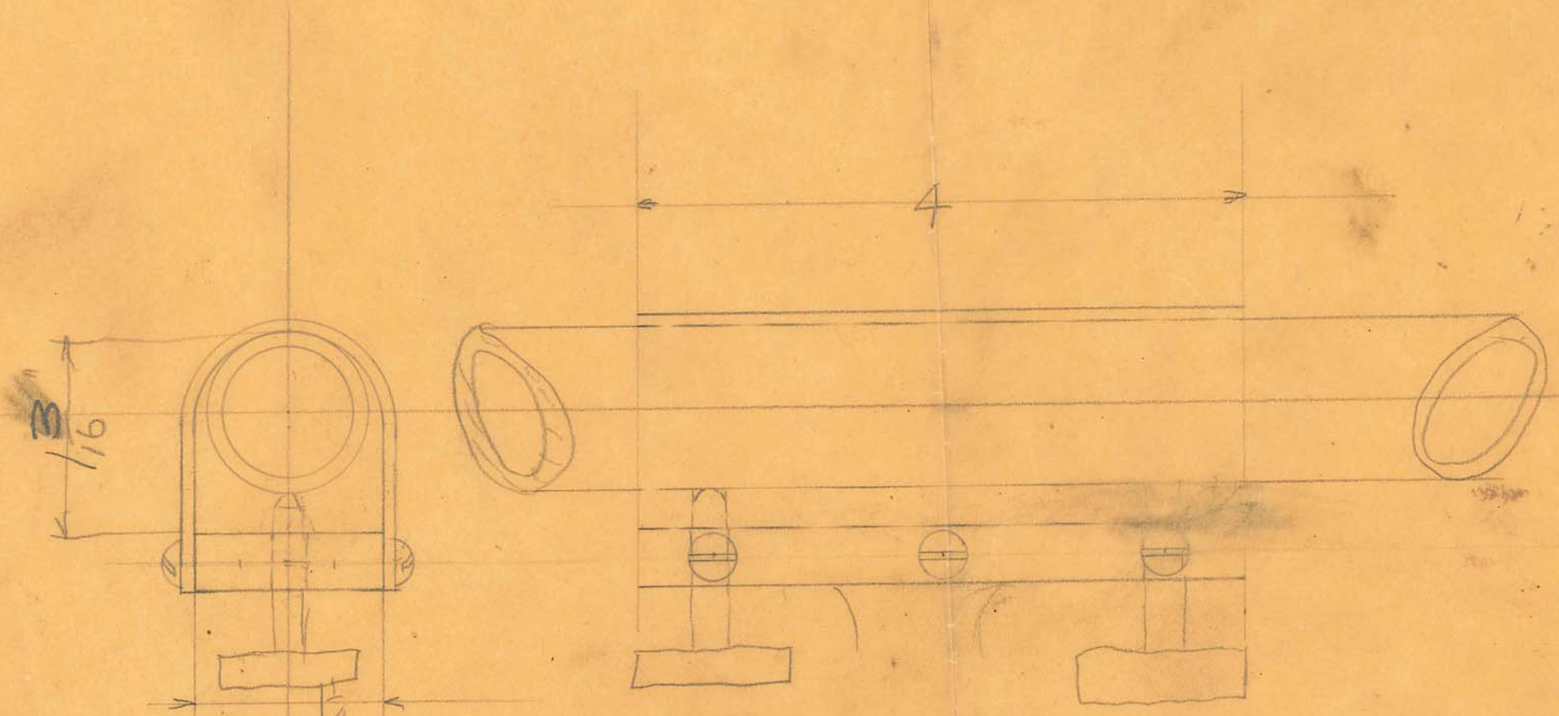

5 REQUIRED

OBSOLETE

OBSOLETE

SIZE		ISSUE	
KIND		CHANGED	
SHAPE		" "	
FINISH		" "	
TEMP.		" "	
PATT.		" "	

TITLE: S-109

HUNTS ORDER No.

H. G. FISCHER & CO.
2335 WABANSIA AVE.
CHICAGO, ILL.

CAT. NO.

PART NO.

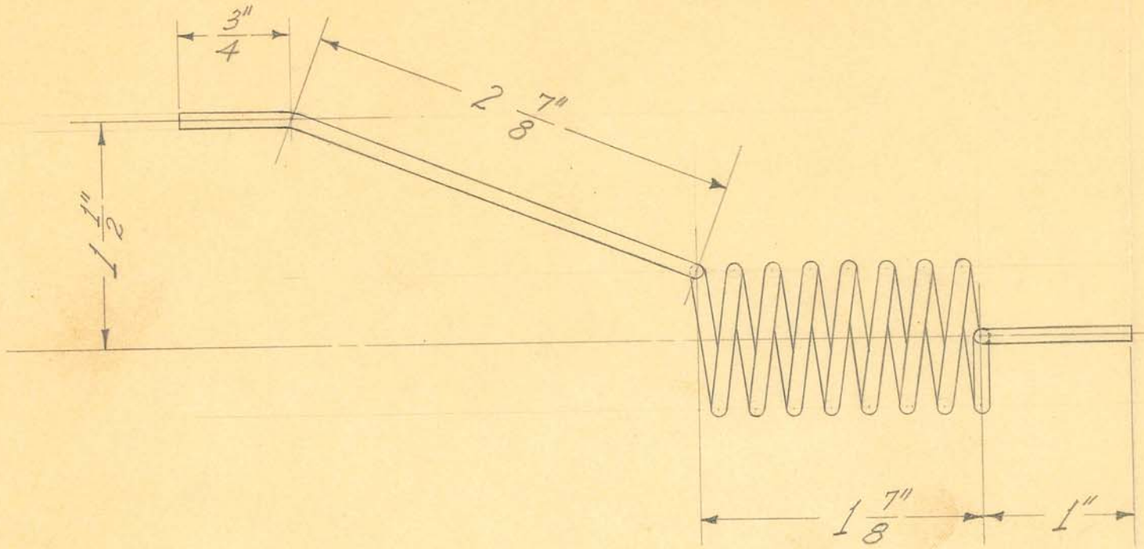

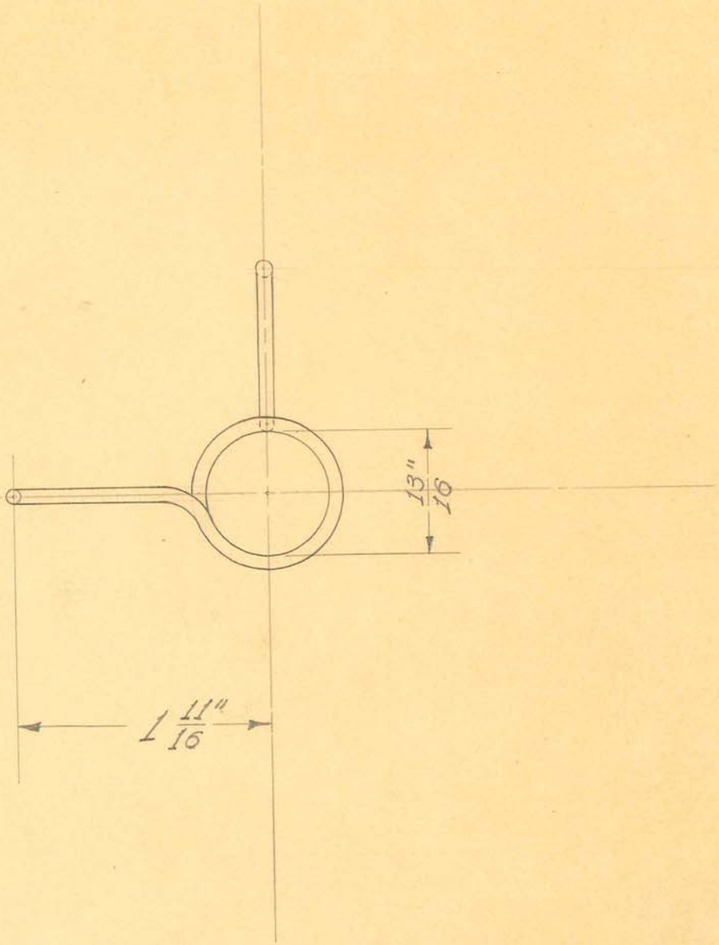

7 3/4 TURNS

1 REQUIRED

OBSOLETE

SIZE	#10 TINNED	ISSUE 1-6-38	J.W.	TITLE: MOD. PORT. "C-12" PATIENT'S TUNING COIL -RIGHT
KIND	COPPER WIRE	CHANGED		
SHAPE		"		
FINISH		"		
TEMP.		"		
PATT.		"		

H. G. FISCHER & CO.
2335 WABANSIA AVE.
CHICAGO, ILL.

CAT. NO.

PART NO. 11059

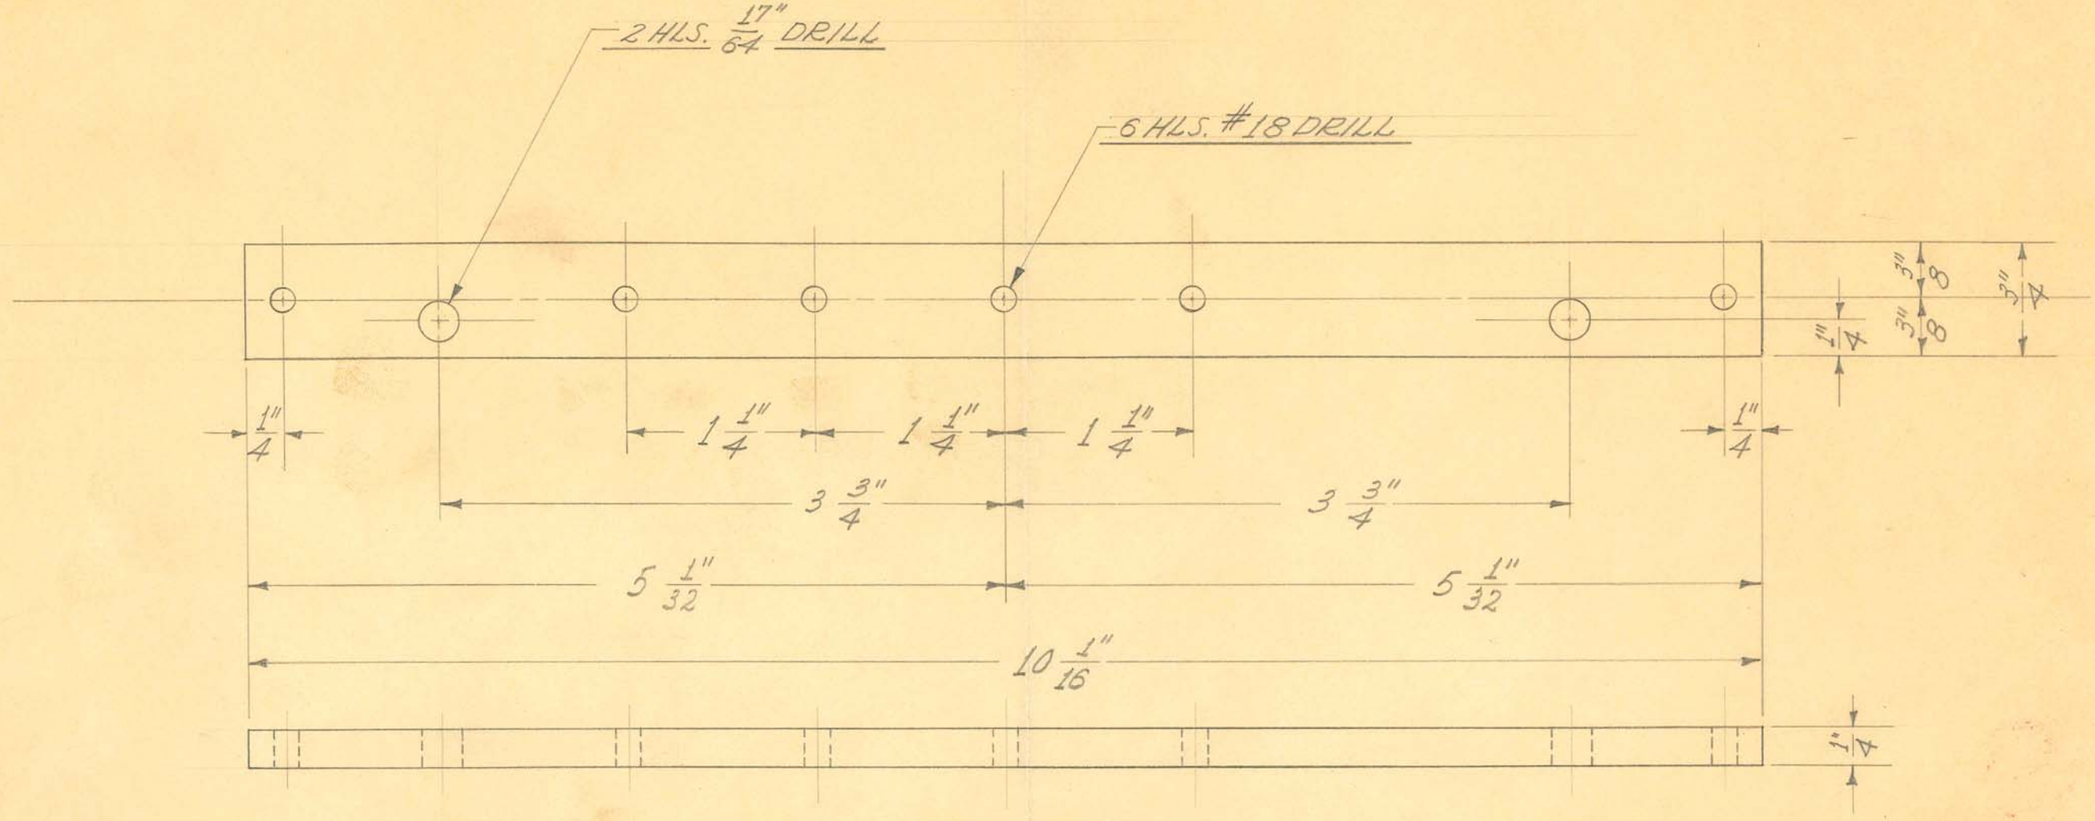

1 REQUIRED

OBSOLETE

SIZE	1/4" SHEET	ISSUE 1-6-37	J.W.
KIND	BAKELITE	CHANGED	
SHAPE		"	
FINISH		"	
TEMP.		"	
PATT.		"	

TITLE:
MOD. PORT. "C." TRANSFORMER
TERMINAL STRIP – UPPER

H. G. FISCHER & CO.
2335 WABANSIA AVE.
CHICAGO, ILL.

CAT. NO.

PART NO. 11068

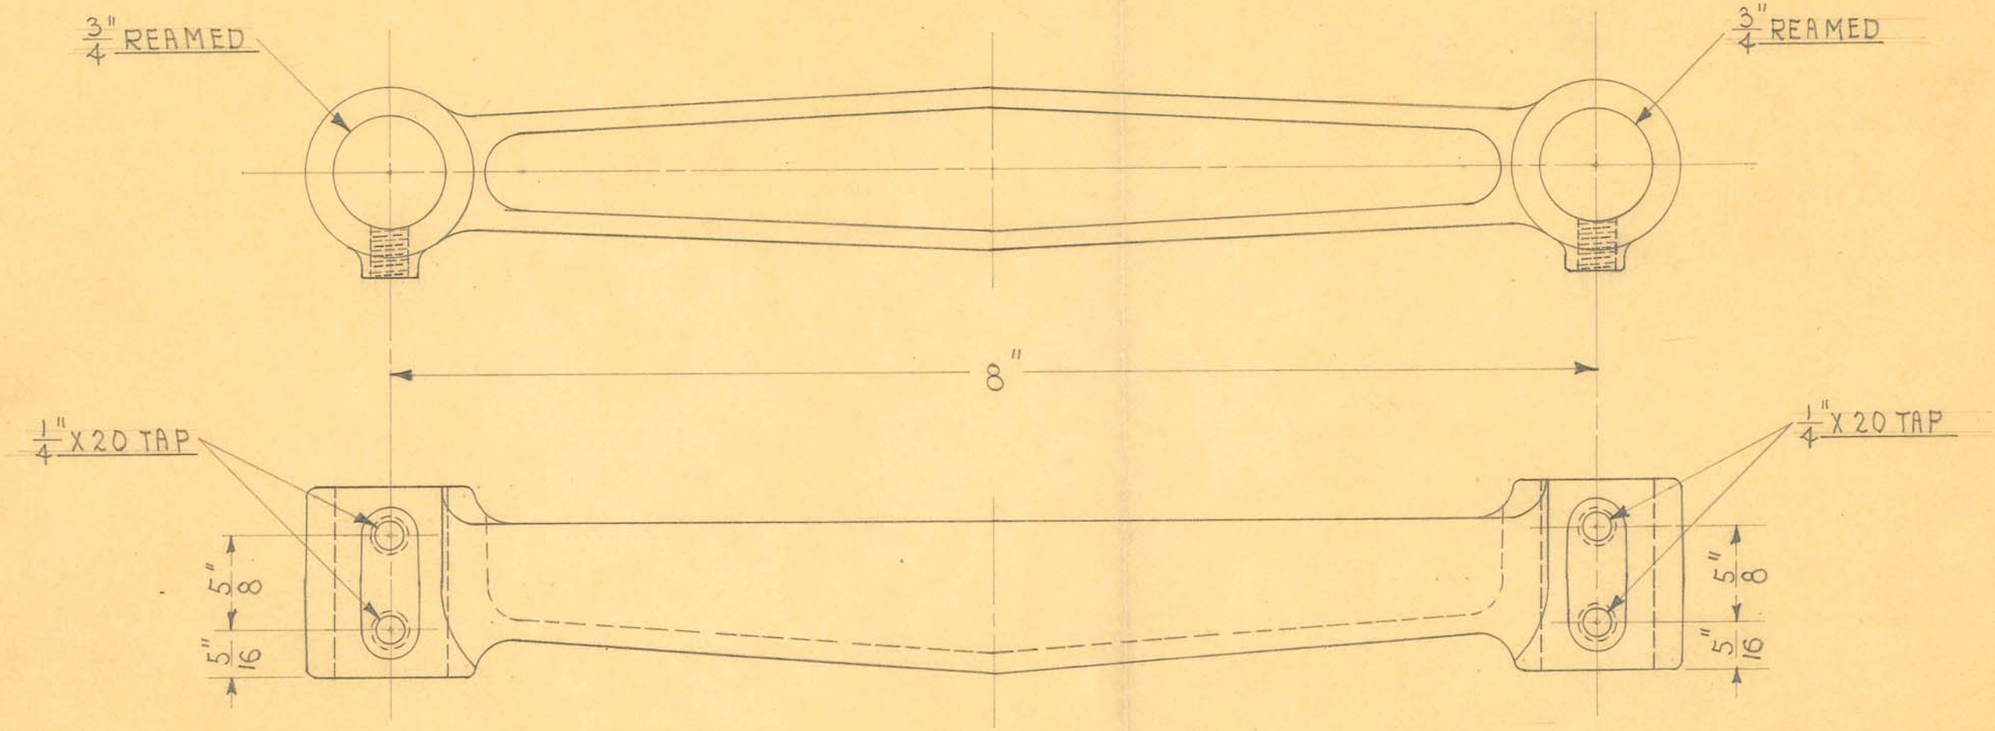

1 REQUIRED

OBSOLETE

Obsolete

SIZE		ISSUE 3-3-38	AE.
KIND	ALUM. CASTING	CHANGED	
SHAPE		"	
FINISH	PAINTED	"	
TEMP.		"	
PATT.	9607-1209	"	

TITLE: FISCHER MODEL "G" SHOCKPROOF FLUOROSCOPE - TRANSF. SLIDE RODS TIE

H. G. FISCHER & CO.
2335 WABANSIA AVE.
CHICAGO, ILL.

CAT. NO.

PART NO. 11236F

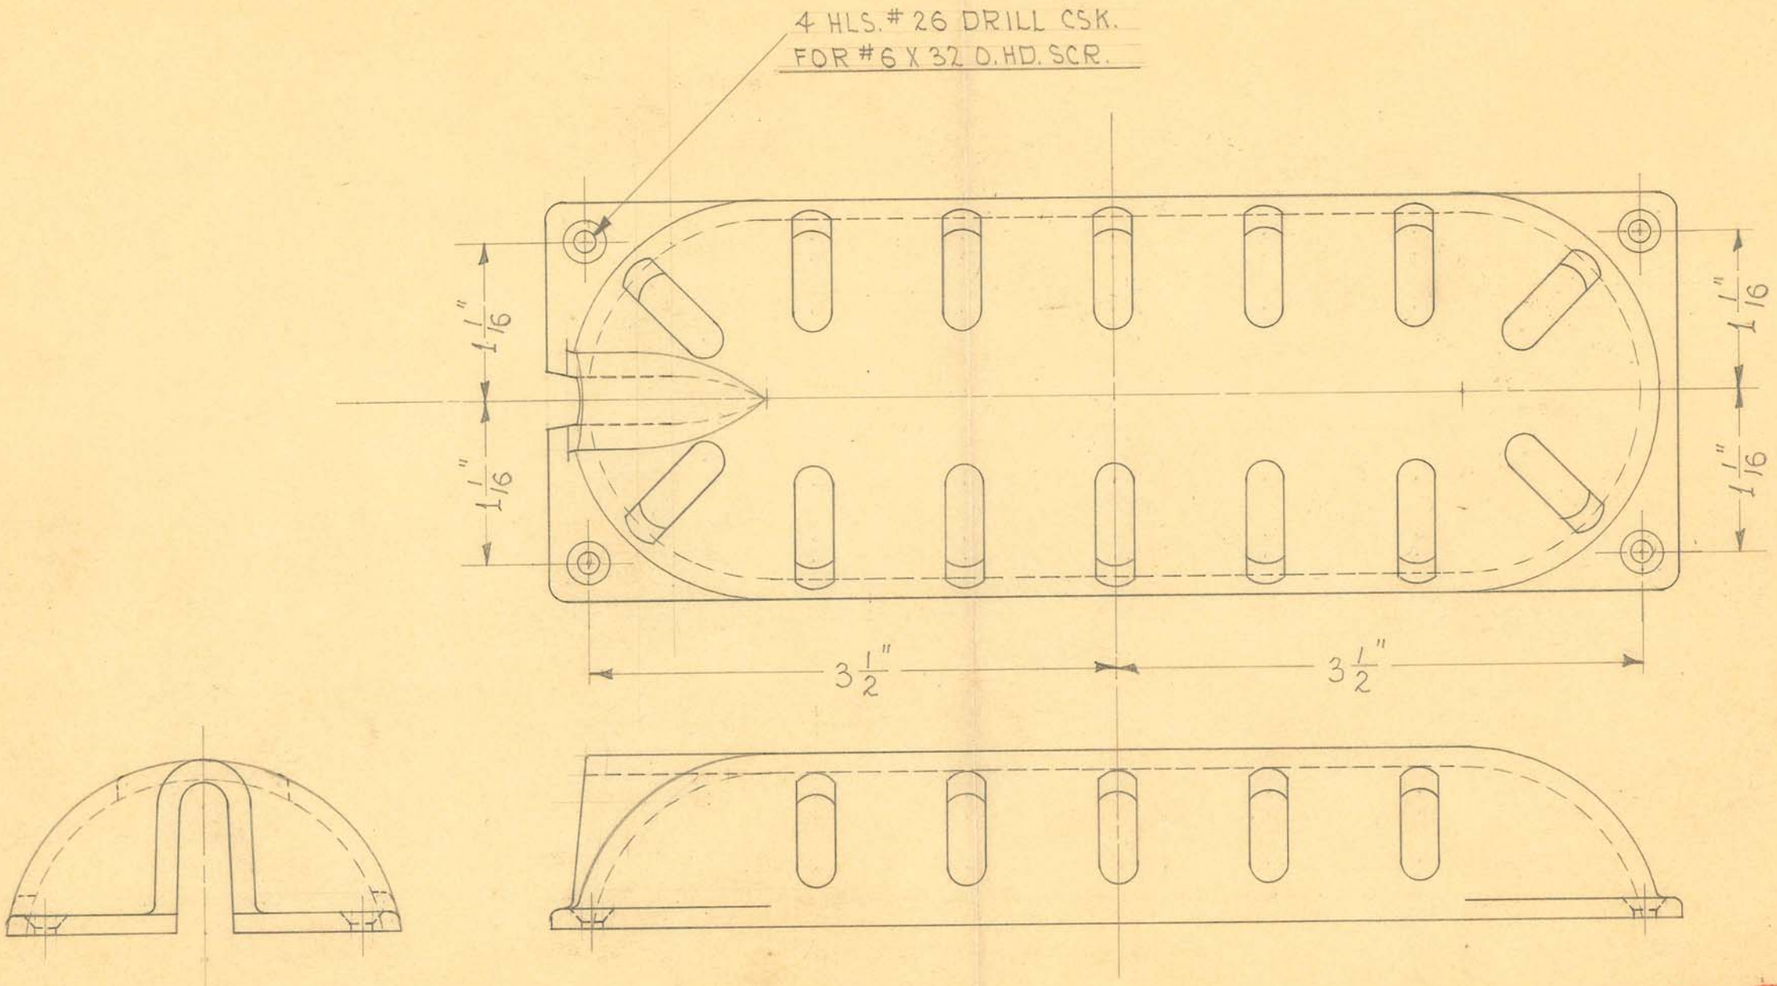

1 REQUIRED

OBSOLETE

Obsolete

SIZE		ISSUE 3-22-38	A.E.
KIND	ALUM. CASTING	CHANGED	
SHAPE		"	
FINISH	PAINTED	"	
TEMP.		"	
PATT.	1215	"	

TITLE: FISCHER MOD. "G" SHOCKPROOF FLUOROSCOPE-SCREEN FRAME SUPPORTING ARM COVER

H. G. FISCHER & CO.
2335 WABANSIA AVE.
CHICAGO, ILL.

CAT. NO.

PART NO. 11266F

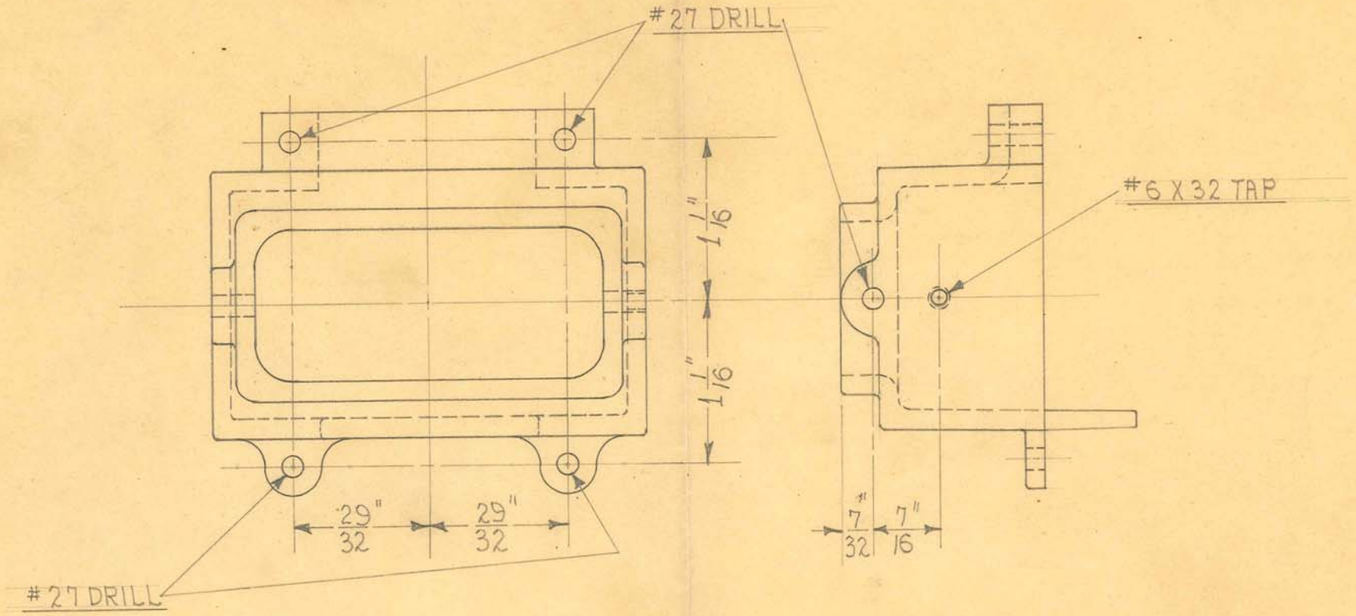

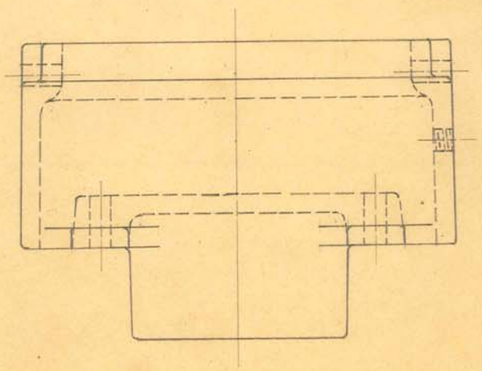

1 REQUIRED

OBSOLETE

obsolete

SIZE		ISSUE 3-14-38	A.E.
KIND	ALUM. CASTING	CHANGED	
SHAPE		"	
FINISH	PAINTED	"	
TEMP.		"	
PATT.	9518-1206	"	

TITLE: FISCHER MOD. "G" SHOCKPROOF FLUOROSCOPE-TANK RECEPTACLE BOX

H. G. FISCHER & CO. 2335 WABANSIA AVE. CHICAGO, ILL.	CAT. NO.	PART NO. 11272F

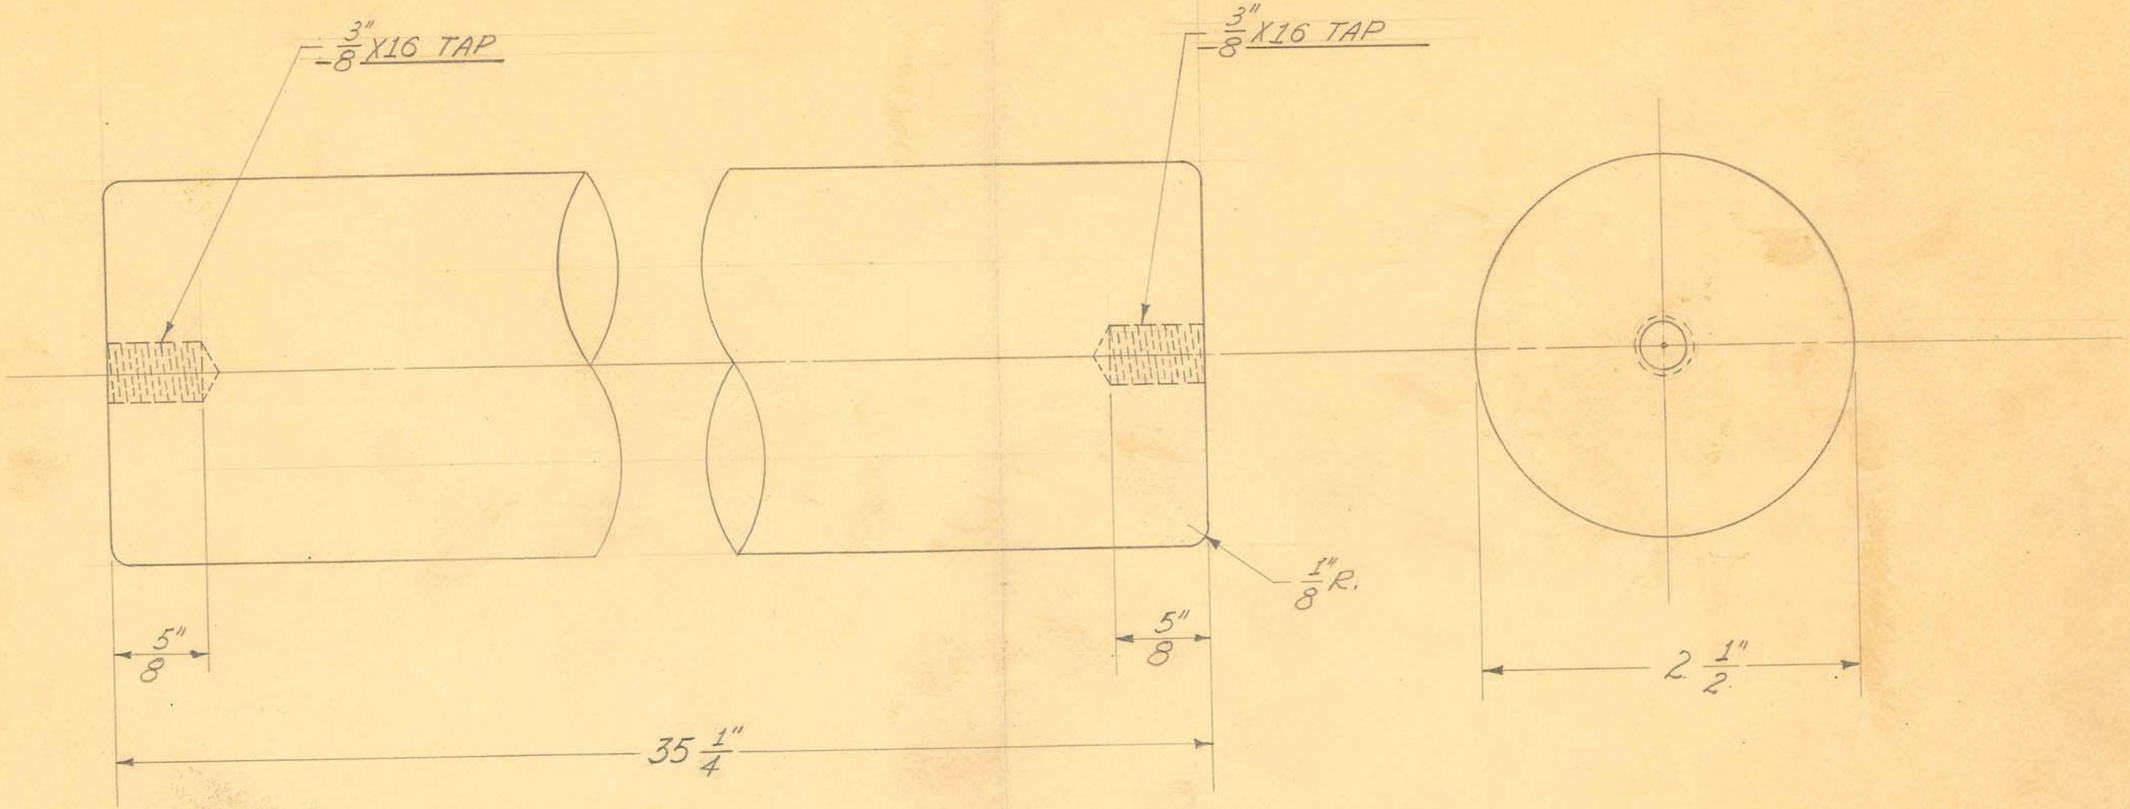

2 REQUIRED

OBSOLETE

SIZE	2½" DIAM.	ISSUE 2-25-38	J.W.	TITLE: FISCHER MOD. "G" SHOCKPROOF FLUOROSCOPE COUNTERWEIGHT
KIND	C.R. STEEL	CHANGED		
SHAPE	ROD	"		
FINISH		"		
TEMP.		"		
PATT.		"		

H. G. FISCHER & CO.
2335 WABANSIA AVE.
CHICAGO, ILL.

CAT. NO.

PART NO. 11316AF

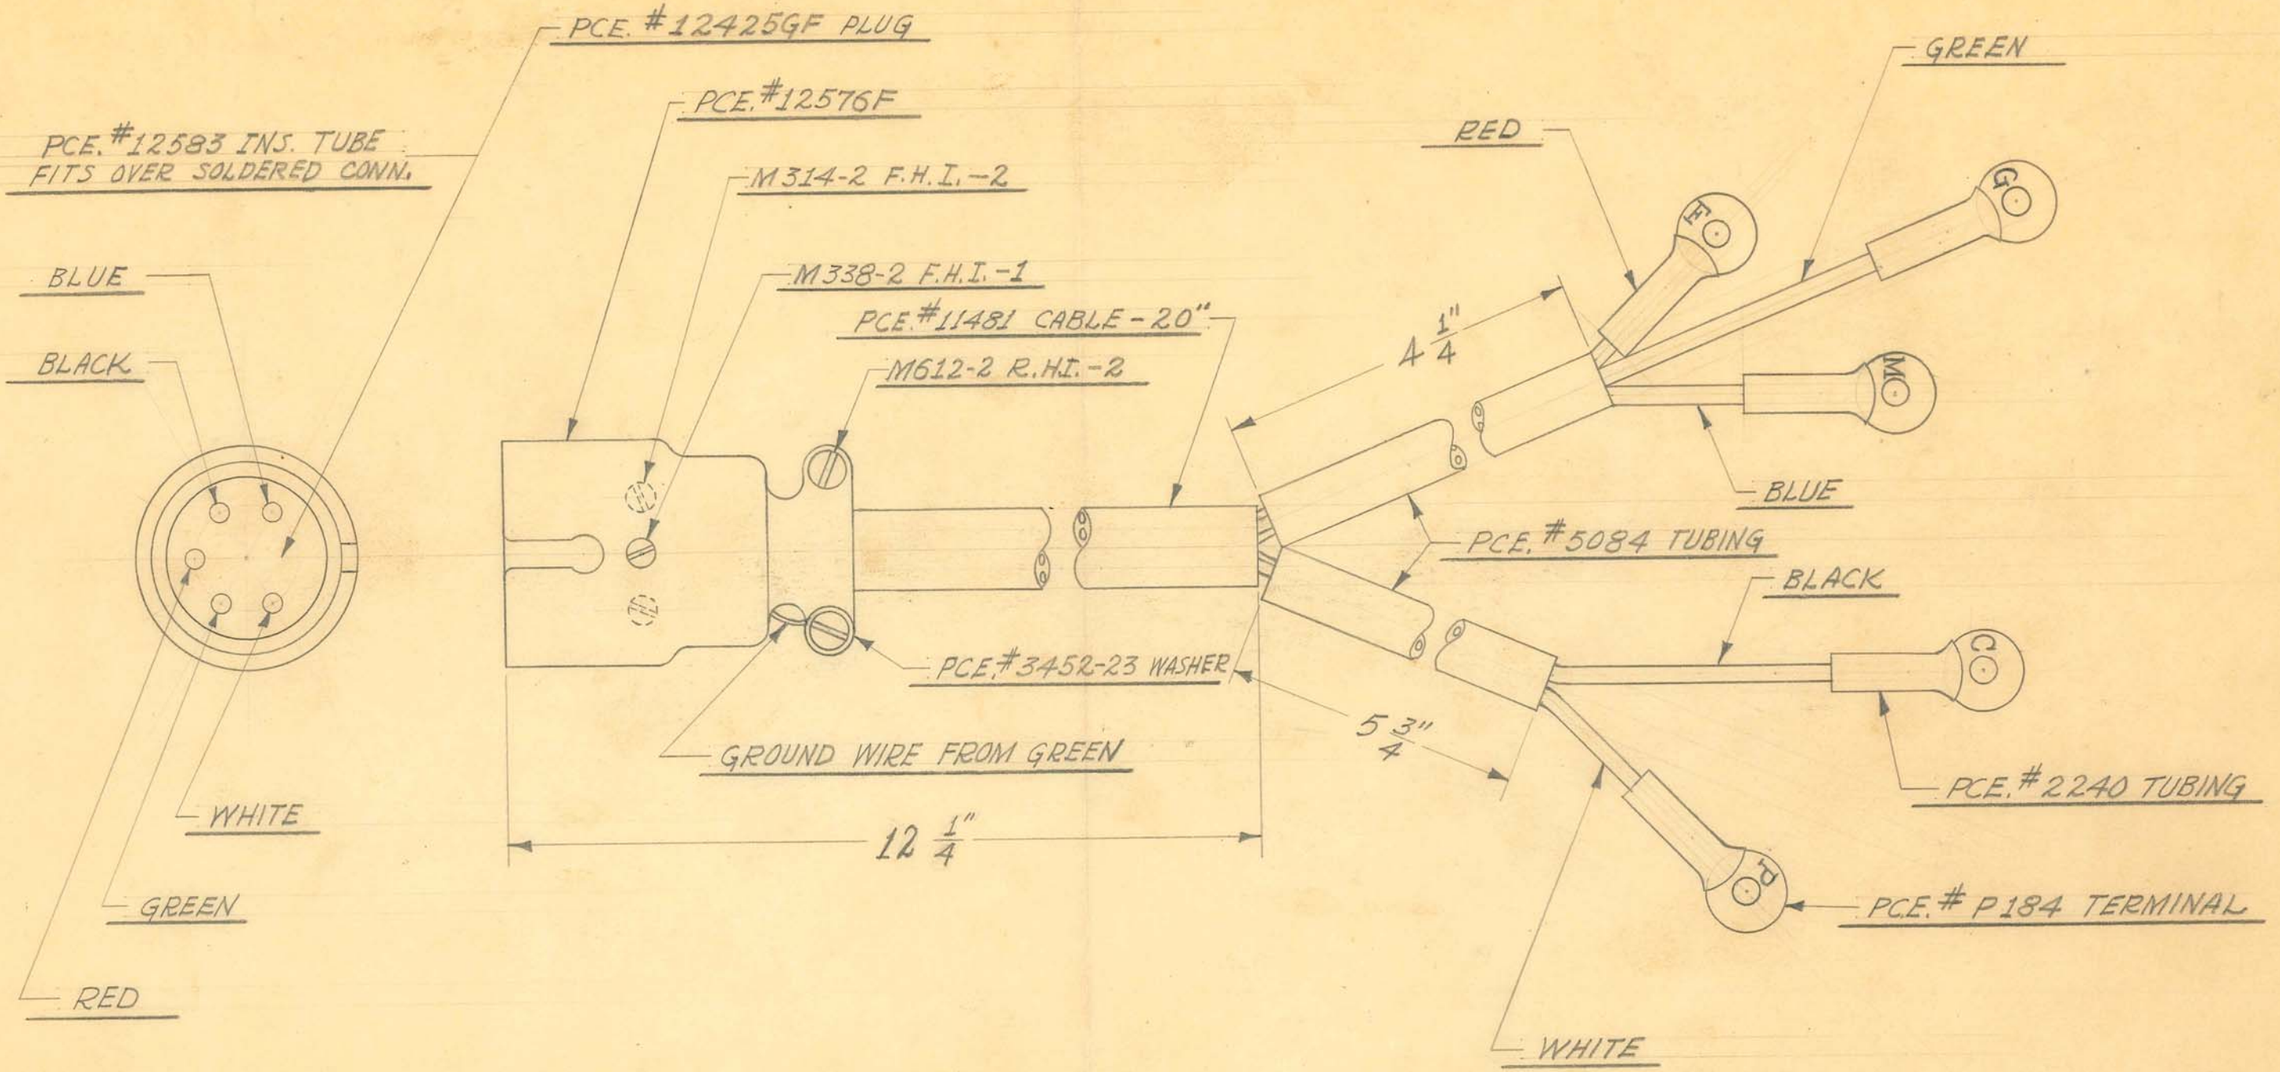

OBSOLETE

SIZE		ISSUE 3-22-40	J.W.
KIND		CHANGED	
SHAPE		"	
FINISH		"	
TEMP.		"	
PATT.		"	

TITLE: FISCHER MOD. "GF" S.P. FLUOROSCOPE TRANSF. CABLE CONN. CORD ASSEMBLY

H. G. FISCHER & CO.
2335 WABANSIA AVE.
CHICAGO, ILL.

CAT. NO.

PART NO. 11365G

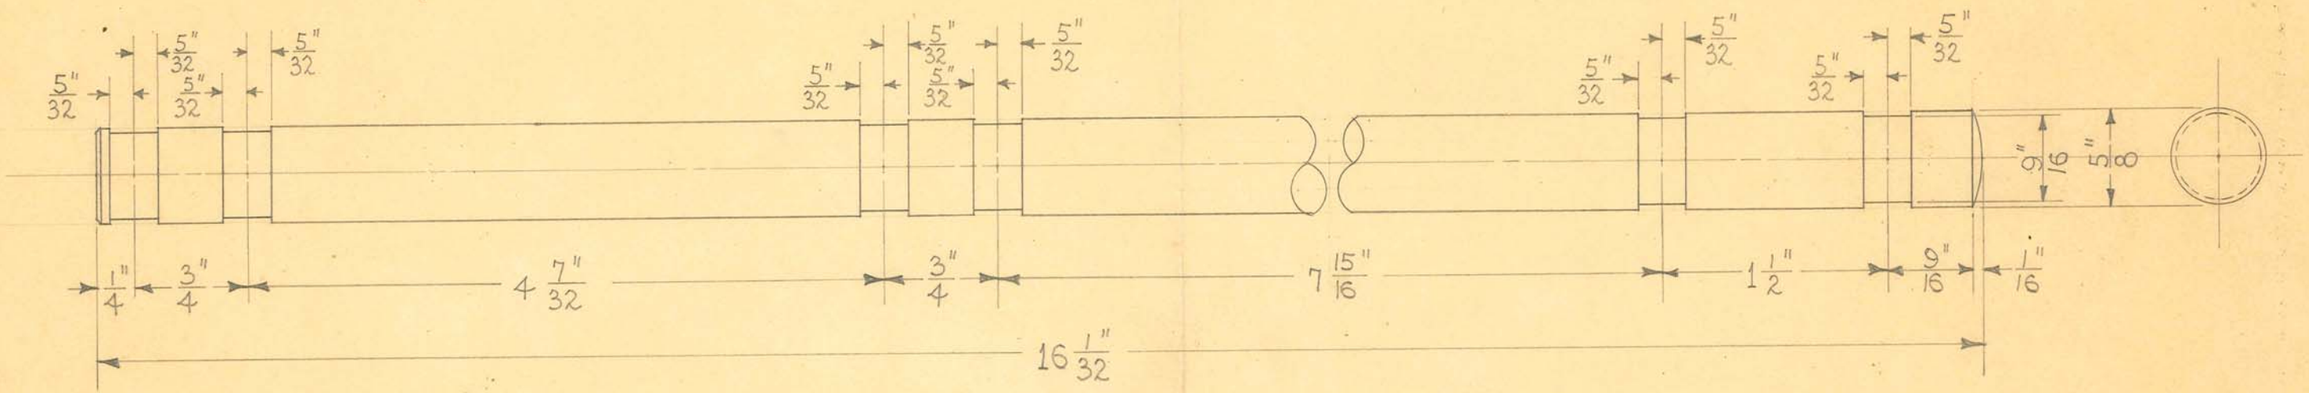

2 REQUIRED

OBSOLETE

Obsolete

SIZE	5/8" DIAM.	ISSUE 3-24-38	J.E.
KIND	JEWELERS ROD	CHANGED	
SHAPE		"	
FINISH	CAD. #23	"	
TEMP.		"	
PATT.		"	

TITLE: FISCHER MOD."G" SHOCKPROOF FLUOROSCOPE-SCREEN FRAME SUPPORT ARM ROD

H. G. FISCHER & CO. 2335 WABANSIA AVE. CHICAGO, ILL.	CAT. NO.	PART NO. 11372

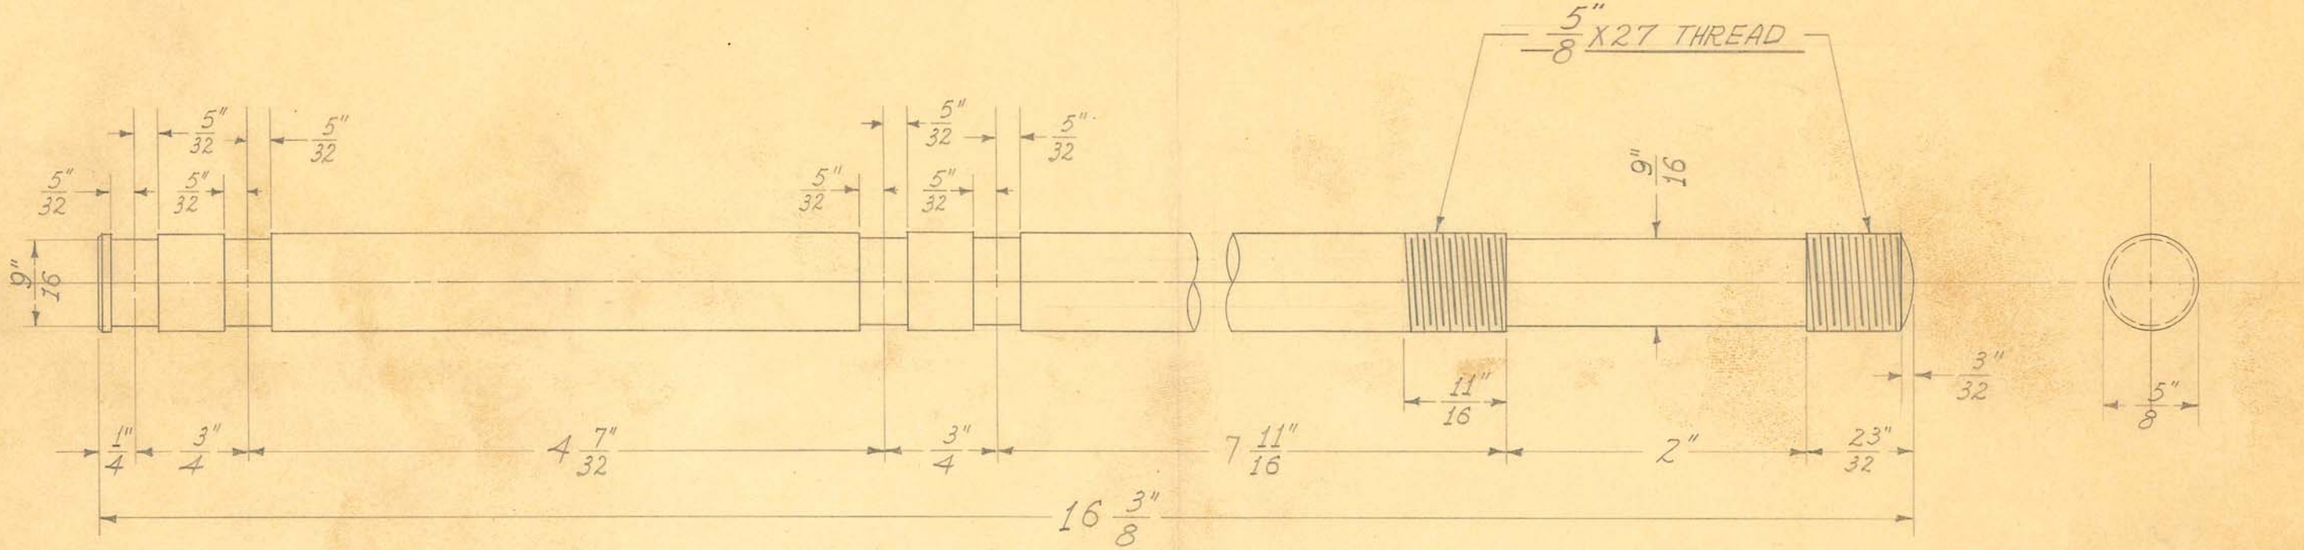

2 REQUIRED

OBSOLETE

Obsolete

SIZE	5/8" DIAM.	ISSUE 7-15-38	J.W.
KIND	JEWELERS ROD	CHANGED	
SHAPE		"	
FINISH	CAD. #23	"	
TEMP.		"	
DATE		"	

TITLE: FISCHER MOD. "G" SHOCKPROOF FLUOROSCOPE SCREEN FRAME. SUPPORT ARM ROD

H. G. FISCHER & CO.
2335 WABANSIA AVE.
CHICAGO, ILL.

CAT. NO.

PART NO. 11372A

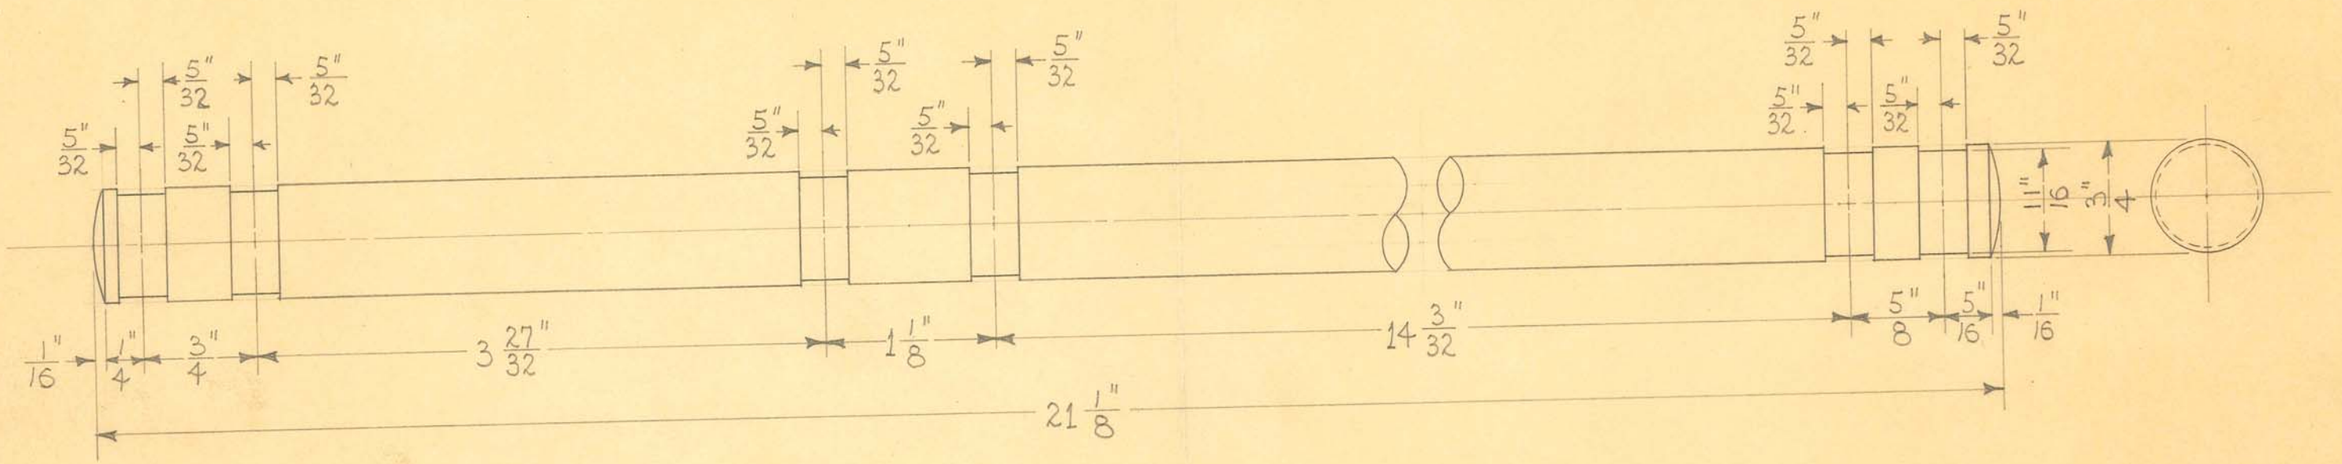

2 REQUIRED

OBSOLETE

Obsolete

SIZE	3/4" DIAM.	ISSUE 3-24-38	A.E.
KIND	JEWELERS ROD	CHANGED	
SHAPE		"	
FINISH	CAD. #23	"	
TEMP.		"	
PATT.		"	

TITLE: FISCHER MOD."G" SHOCKPROOF FLUOROSCOPE-
TRANSFORMER SLIDE ROD

H. G. FISCHER & CO.
2335 WABANSIA AVE.
CHICAGO, ILL.

CAT. NO.

PART NO. 11374

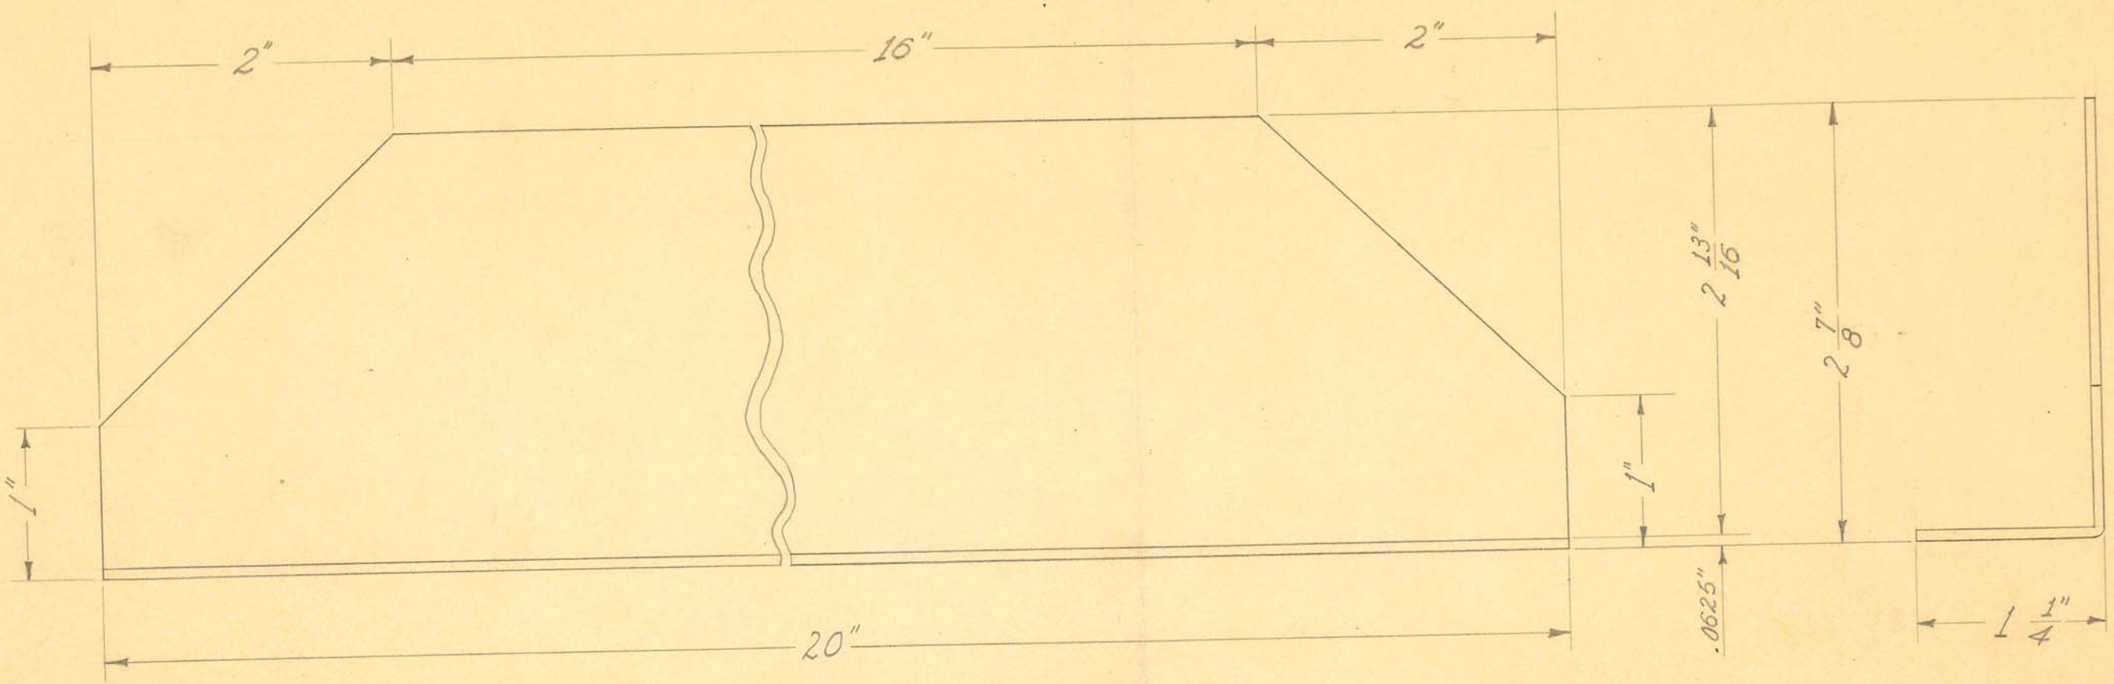

1 REQUIRED

OBSOLETE

OBSOLETE

SIZE	#16GA.(.0625")	ISSUE 3-7-38	J.W.	TITLE: FISCHER MOD. "G" SHOCKPROOF FLUOROSCOPE PANEL CLAMP PLATE - BOTTOM
KIND	C.R. STEEL	CHANGED		
SHAPE	SHEET	"		
FINISH		"		
TEMP.		"		
PATT.		"		

H. G. FISCHER & CO.
2335 WABANSIA AVE.
CHICAGO, ILL.

CAT. NO.

PART NO. 11382

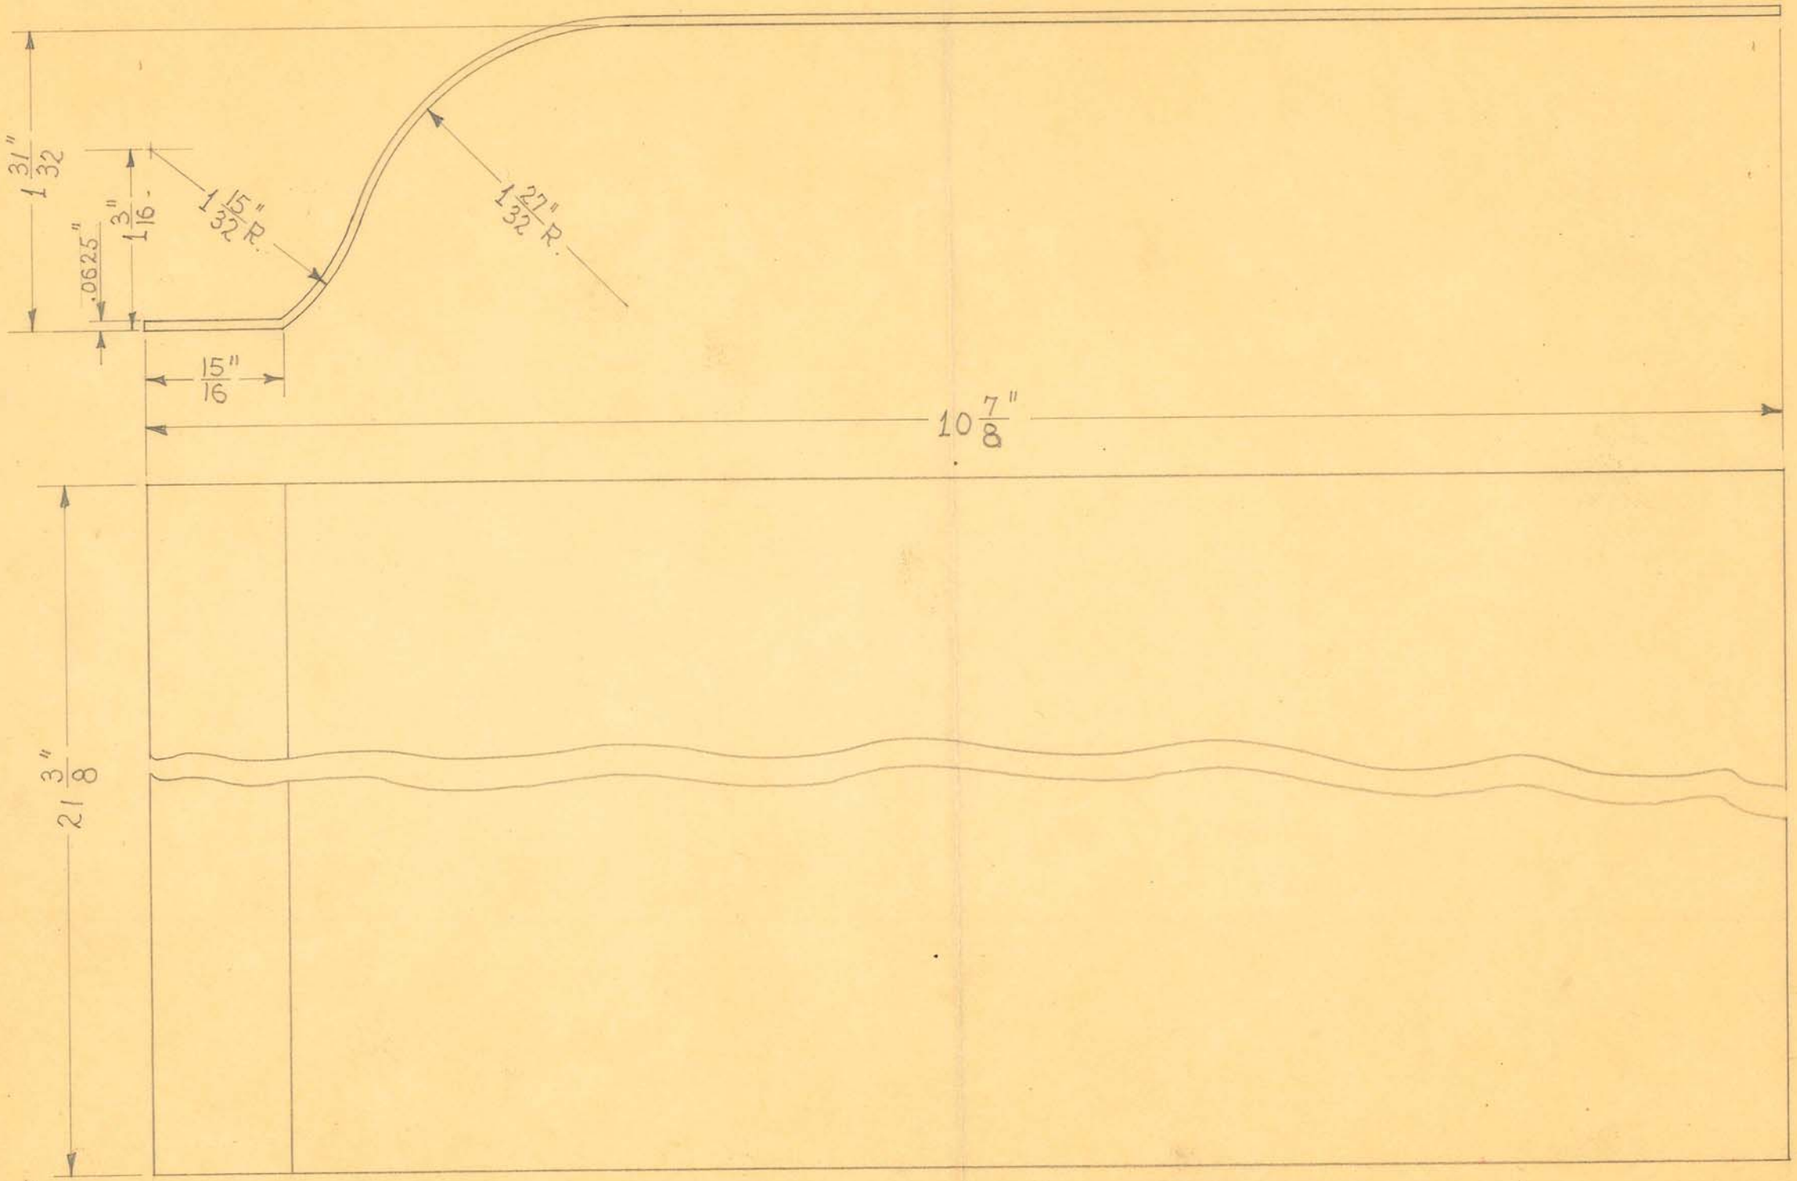

1 REQUIRED

SIZE	#16 U.S.S.GA.(.0625)	ISSUE 3-16-38	H.E.
KIND	C.R. STEEL	CHANGED	
SHAPE	SHEET	"	
FINISH		"	
TEMP.		"	
PATT.		"	

OBSOLETE

TITLE: FISCHER MOD."G" SHOCKPROOF FLUOROSCOPE-
FRONT COVER PLATE-LEFT

H. G. FISCHER & CO.
2333 WABANSIA AVE.
CHICAGO, ILL.

CAT. NO.

PART NO. 11407

VOID
Obsolete

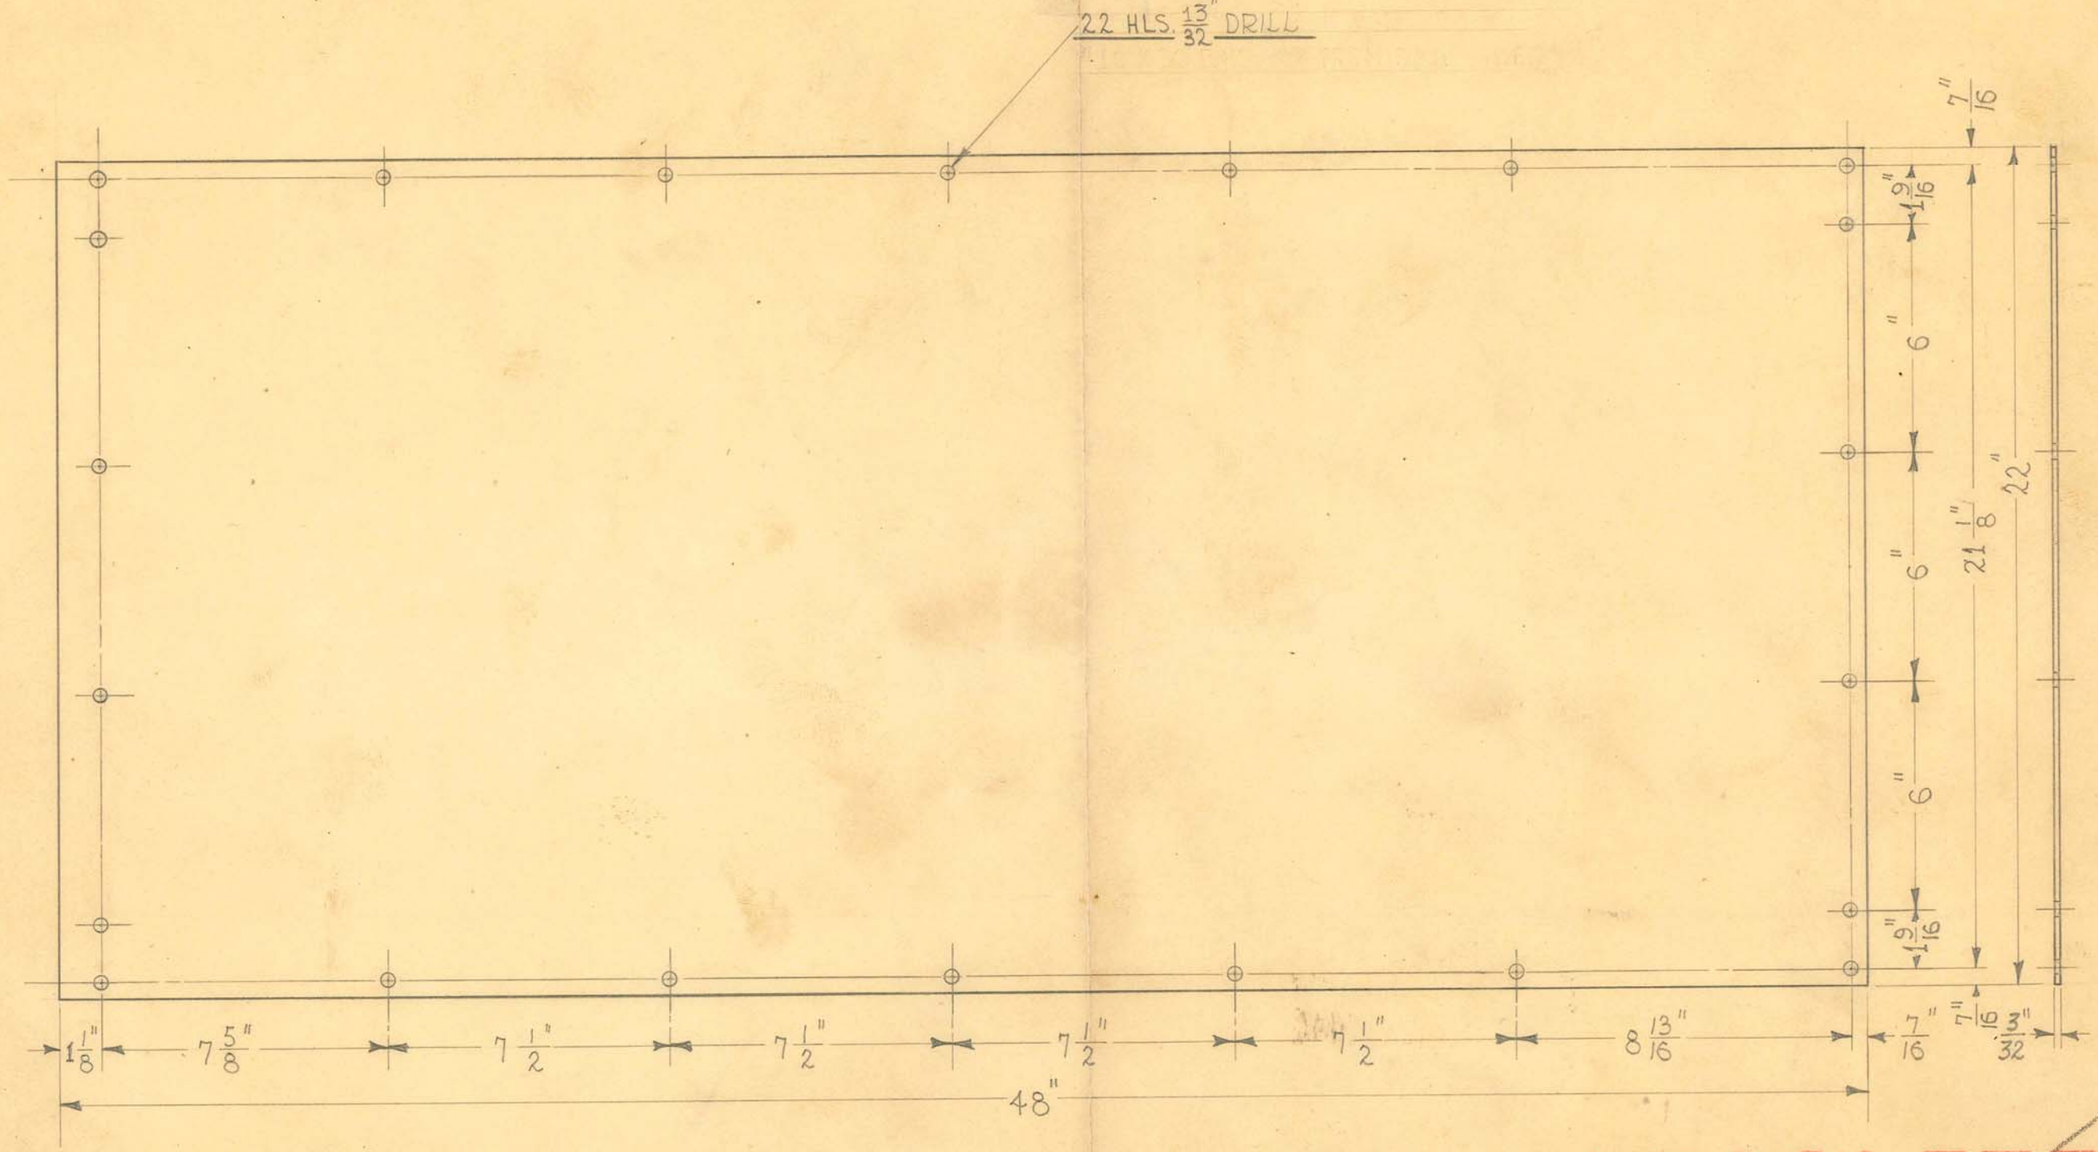

SCALE ÷ 1/4" = 1"

1 REQUIRED

OBSOLETE

Obsolete 11-30-48

SIZE	48"X22"X3/32"	ISSUE 4-18-38	W.E.
KIND	FORMICA	CHANGED 10-10-38	J.W.
SHAPE	B 1612	" 1-3-40	J.W.
FINISH		"	
TEMP.		"	
PATT.		"	

TITLE: FISCHER MOD."G" SHOCKPROOF FLUOROSCOPE-FRONT BAKELITE PANEL (DRILLED)

H. G. FISCHER & CO.
2335 WABANSIA AVE.
CHICAGO, ILL.

CAT. NO.

PART NO. 11408AF

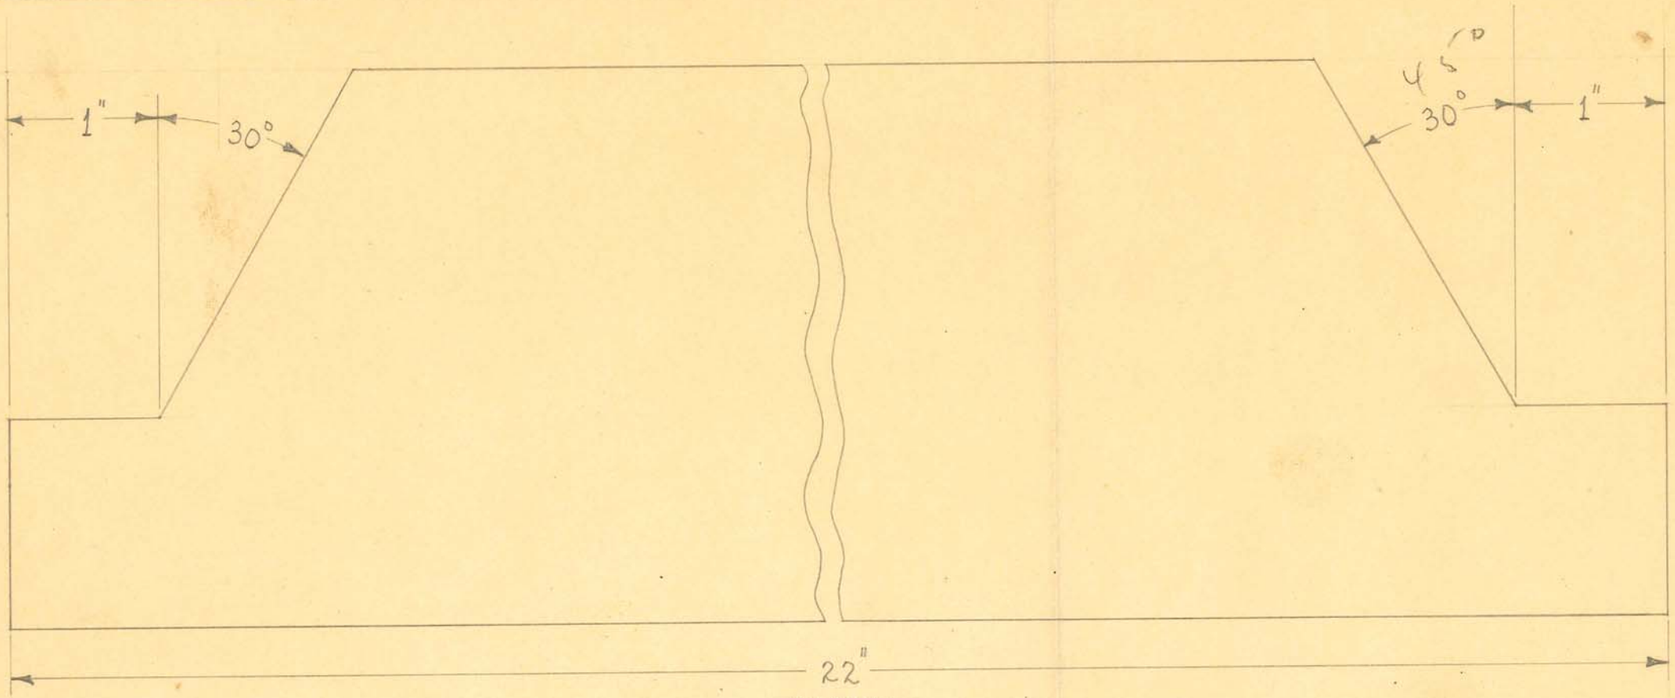

BLANK

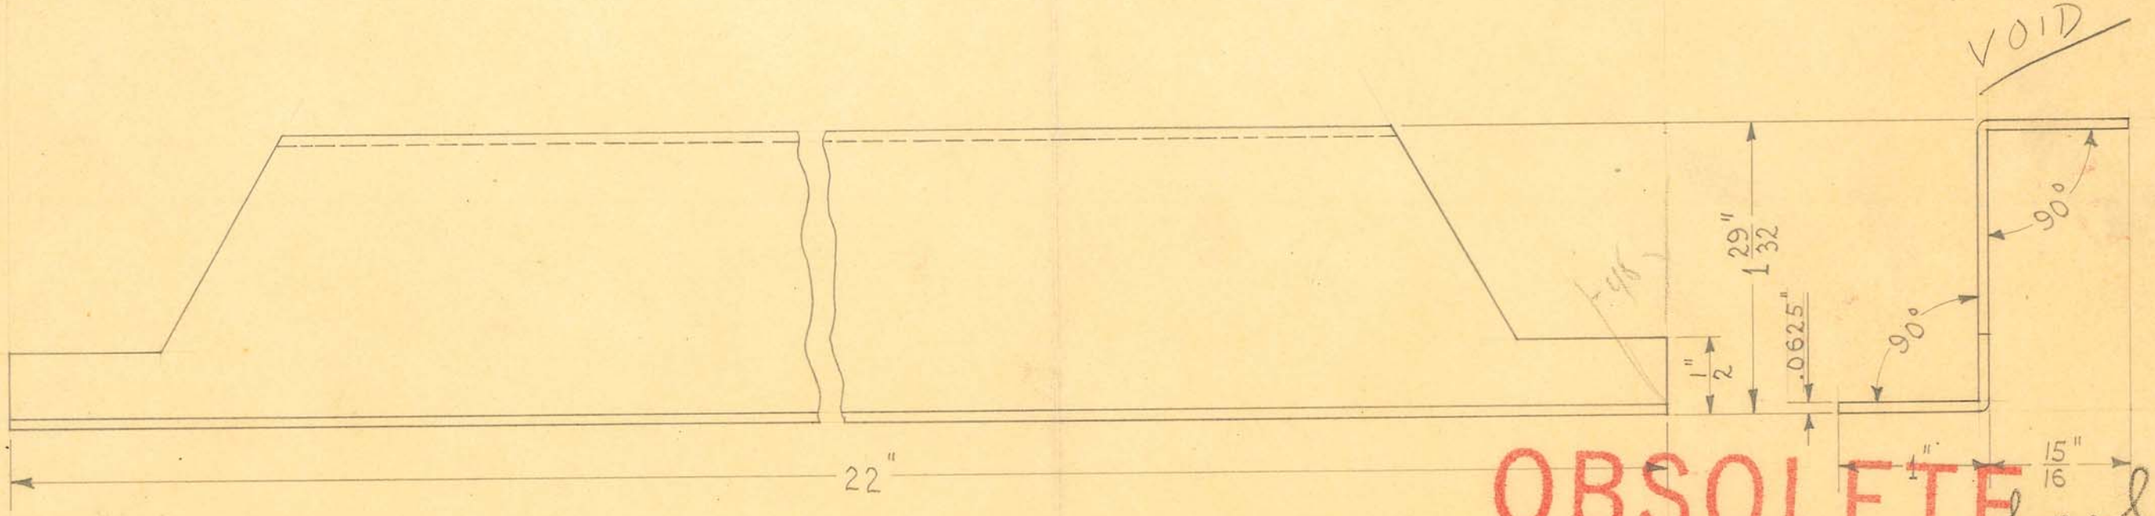

OBSOLETE Obsolete

1 REQUIRED

SIZE	16 U.S.S. GA. (.0625)	ISSUE 3-16-38	A.E.
KIND	C.R. STEEL	CHANGED	
SHAPE	SHEET	"	
FINISH		"	
TEMP.		"	
PATT.		"	

TITLE: FISCHER MOD. "G" SHOCKPROOF FLUOROSCOPE-FRONT COVER PLATE ANGLE-TOP

H. G. FISCHER & CO.
2335 WABANSIA AVE.
CHICAGO, ILL.

CAT. NO.

PART NO. 11409

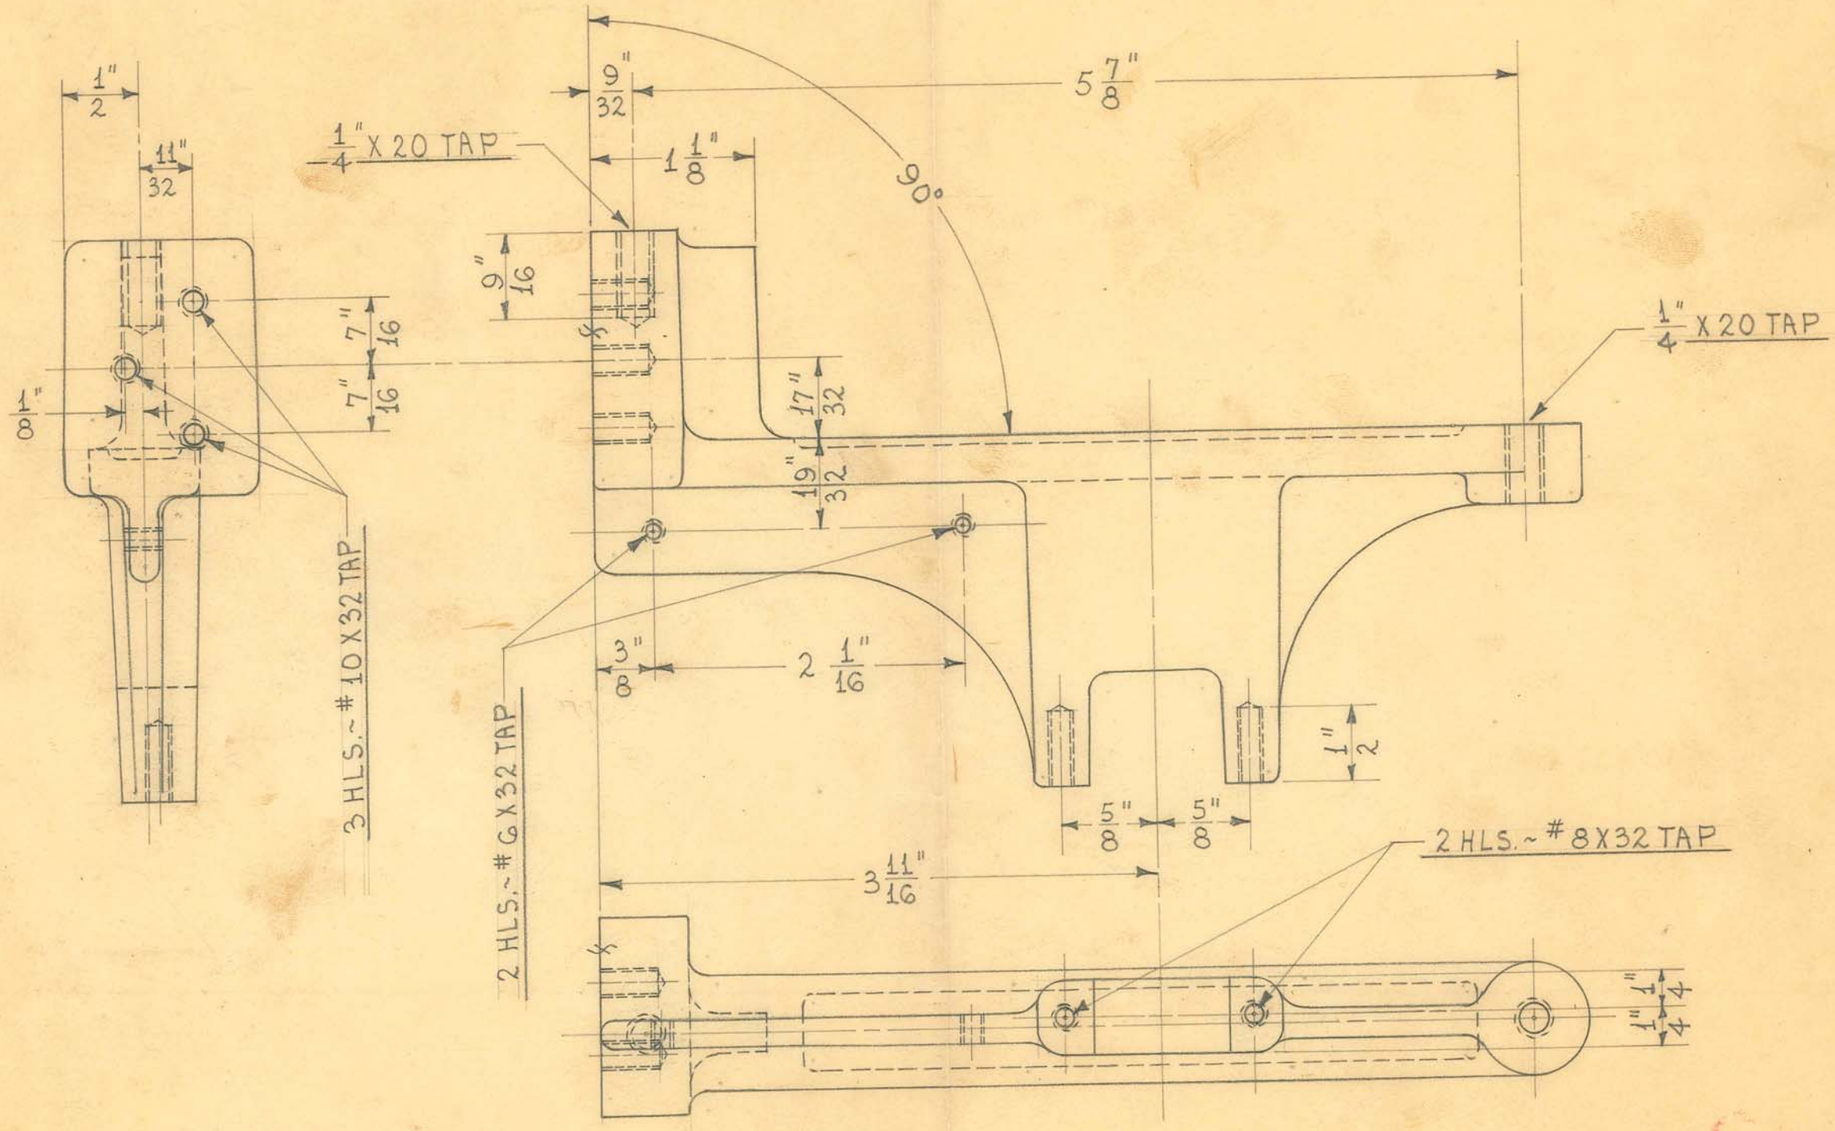

1 REQUIRED

OBSOLETE

SIZE		ISSUE 3-22-45	HE.
KIND	IRON CASTING	CHANGED	
SHAPE		"	
FINISH		"	
TEMP.		"	
PATT.	1496	"	

TITLE: FISCHER MOD. "G" SHOCKPROOF FLUOROSCOPE TRANSFORMER SUPPORT - RIGHT

H. G. FISCHER & CO. 2338 WABANSIA AVE. CHICAGO, ILL.	CAT. NO.	PART NO. 11442AF

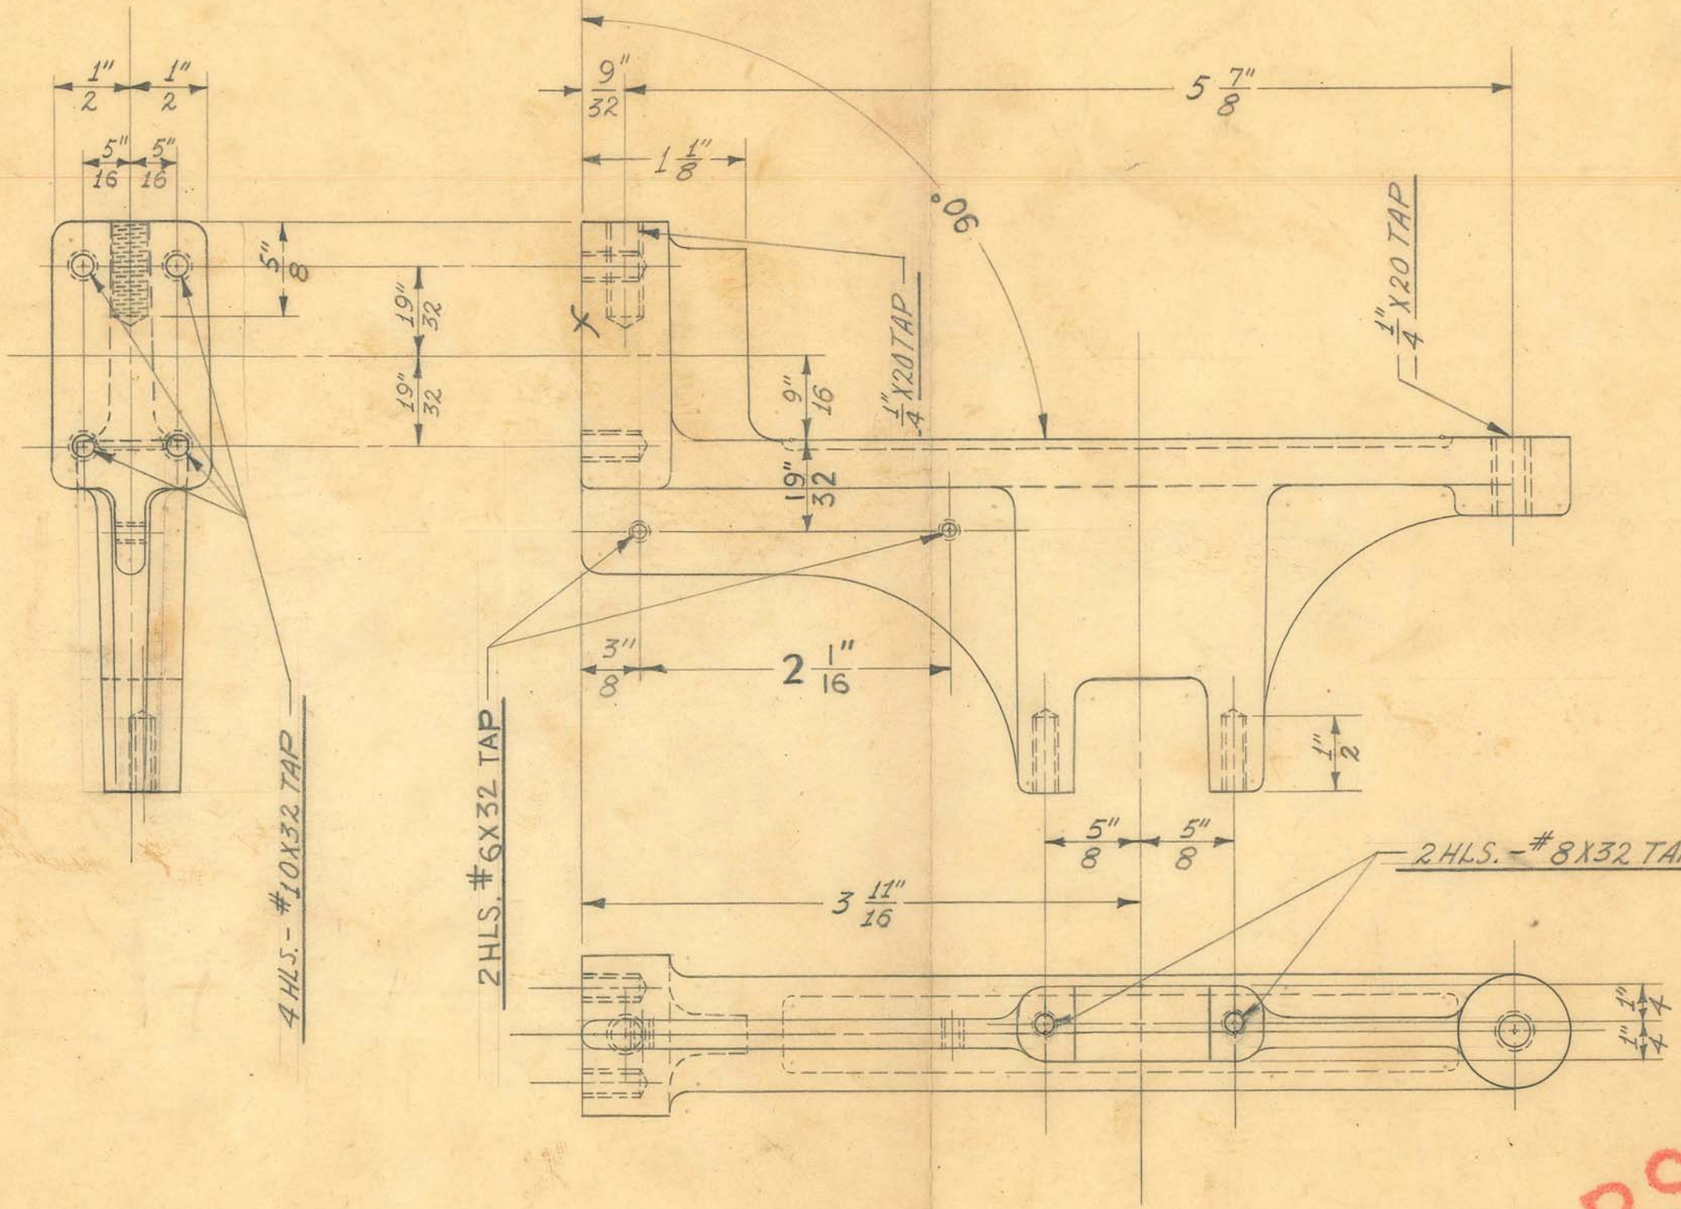

1 REQUIRED

OBSOLETE

Obsolete

SIZE		ISSUE 2-2-40	J.W.
KIND	IRON CASTING	CHANGED 2-5-42	J.V.W.
SHAPE		"	
FINISH		"	
TEMP.		"	
PATT.	1496	"	

TITLE:
FISCHER MOD. "G" SHOCKPROOF FLUOROSCOPE
TRANSFORMER SUPPORT - RIGHT

H. G. FISCHER & CO.
2335 WABANSIA AVE.
CHICAGO, ILL.

CAT. NO.

PART NO. 11442FA

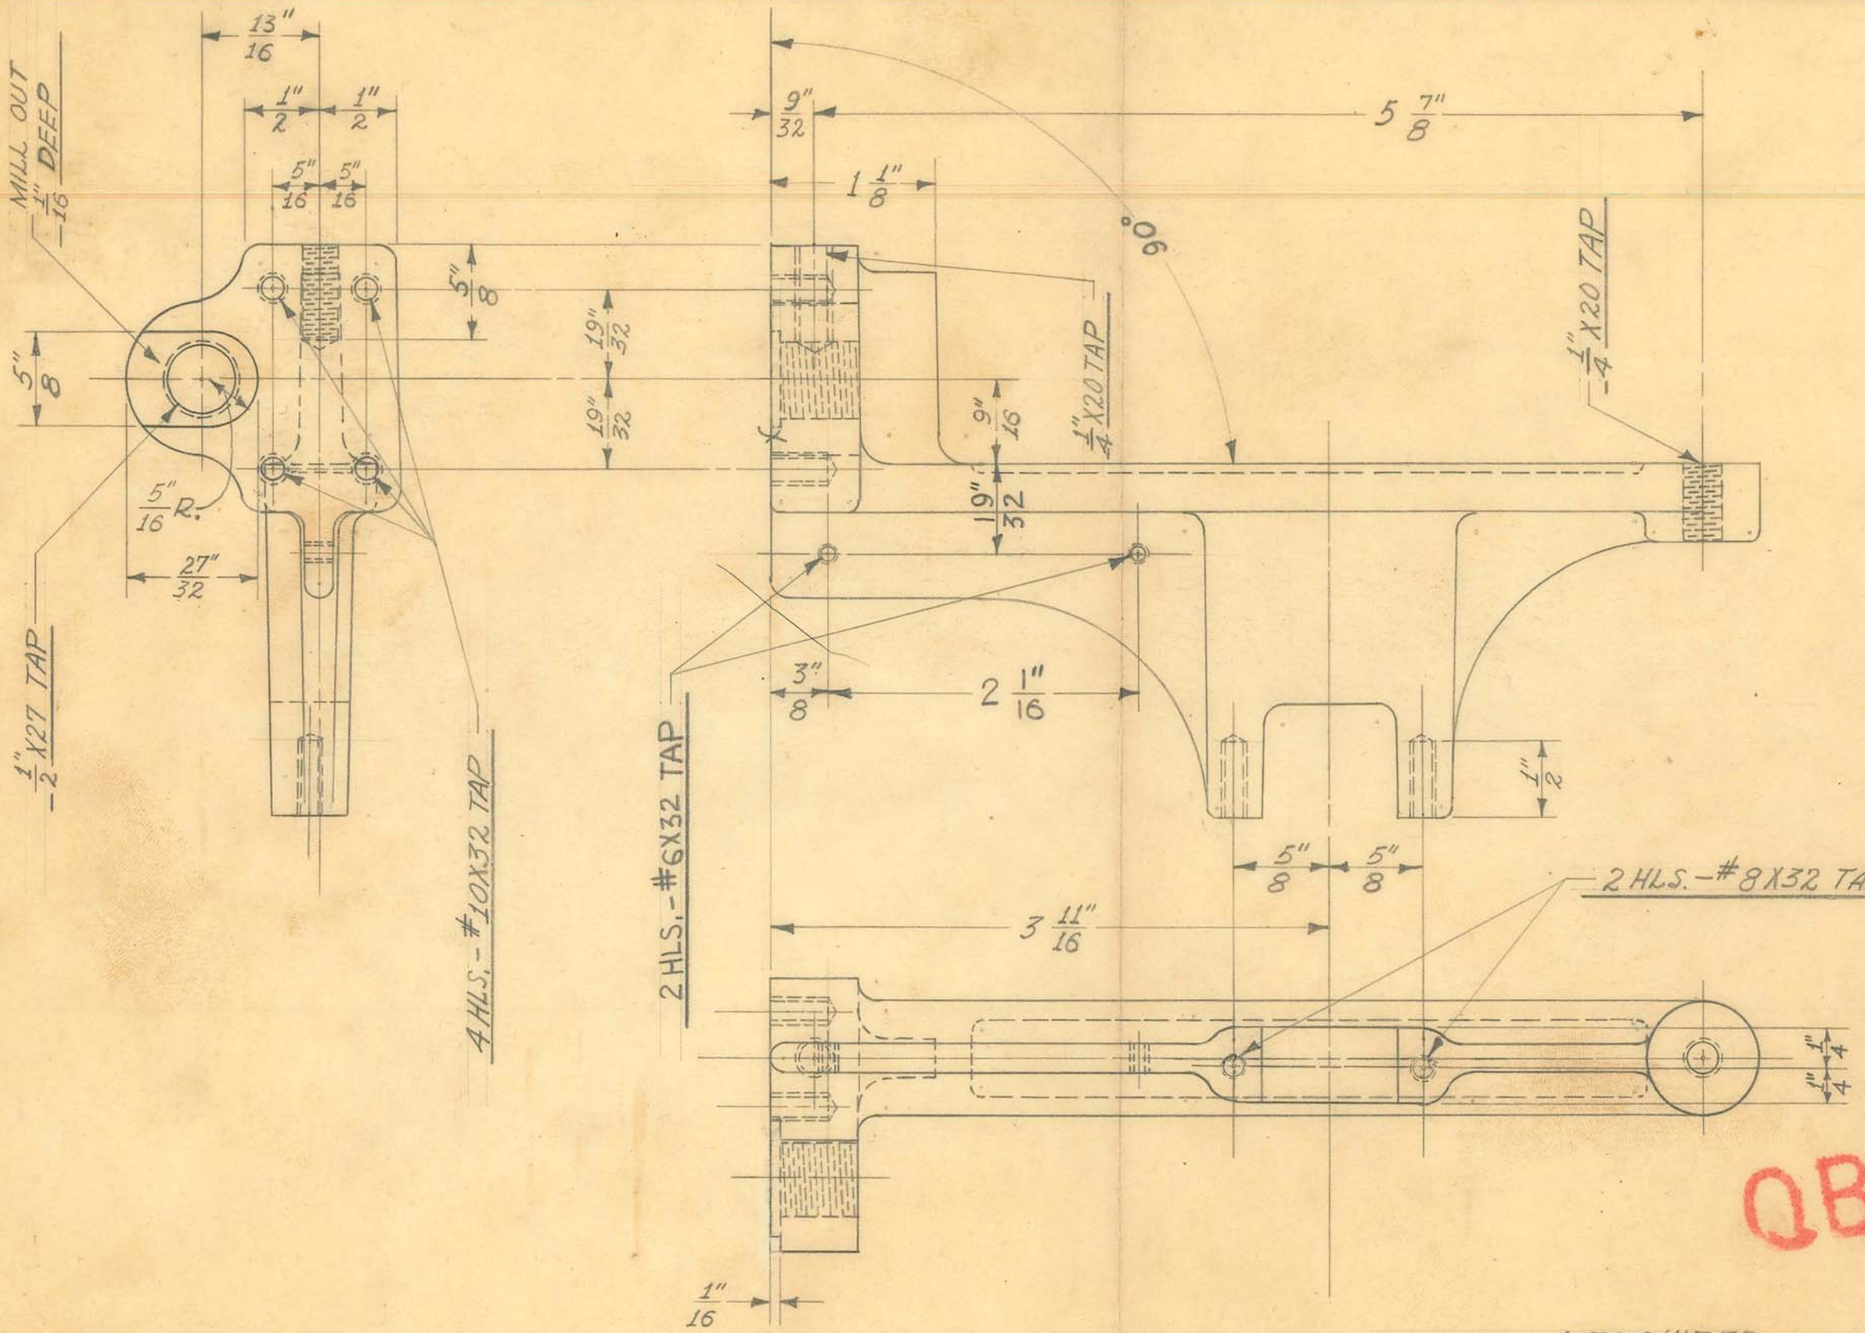

1 REQUIRED

OBSOLETE

Obsolete

SIZE		ISSUE 1-29-40	J.W.
KIND	IRON CASTING	CHANGED 2-5-42	J.V.W.
SHAPE		"	
FINISH		"	
TEMP.		"	
	1407		

TITLE:
FISCHER MOD. "G" SHOCKPROOF FLUOROSCOPE
TRANSFORMER SUPPORT - LEFT

H. G. FISCHER & CO.
2335 WABANSIA AVE.

CAT. NO.

PART NO. 11442 1/2 FA

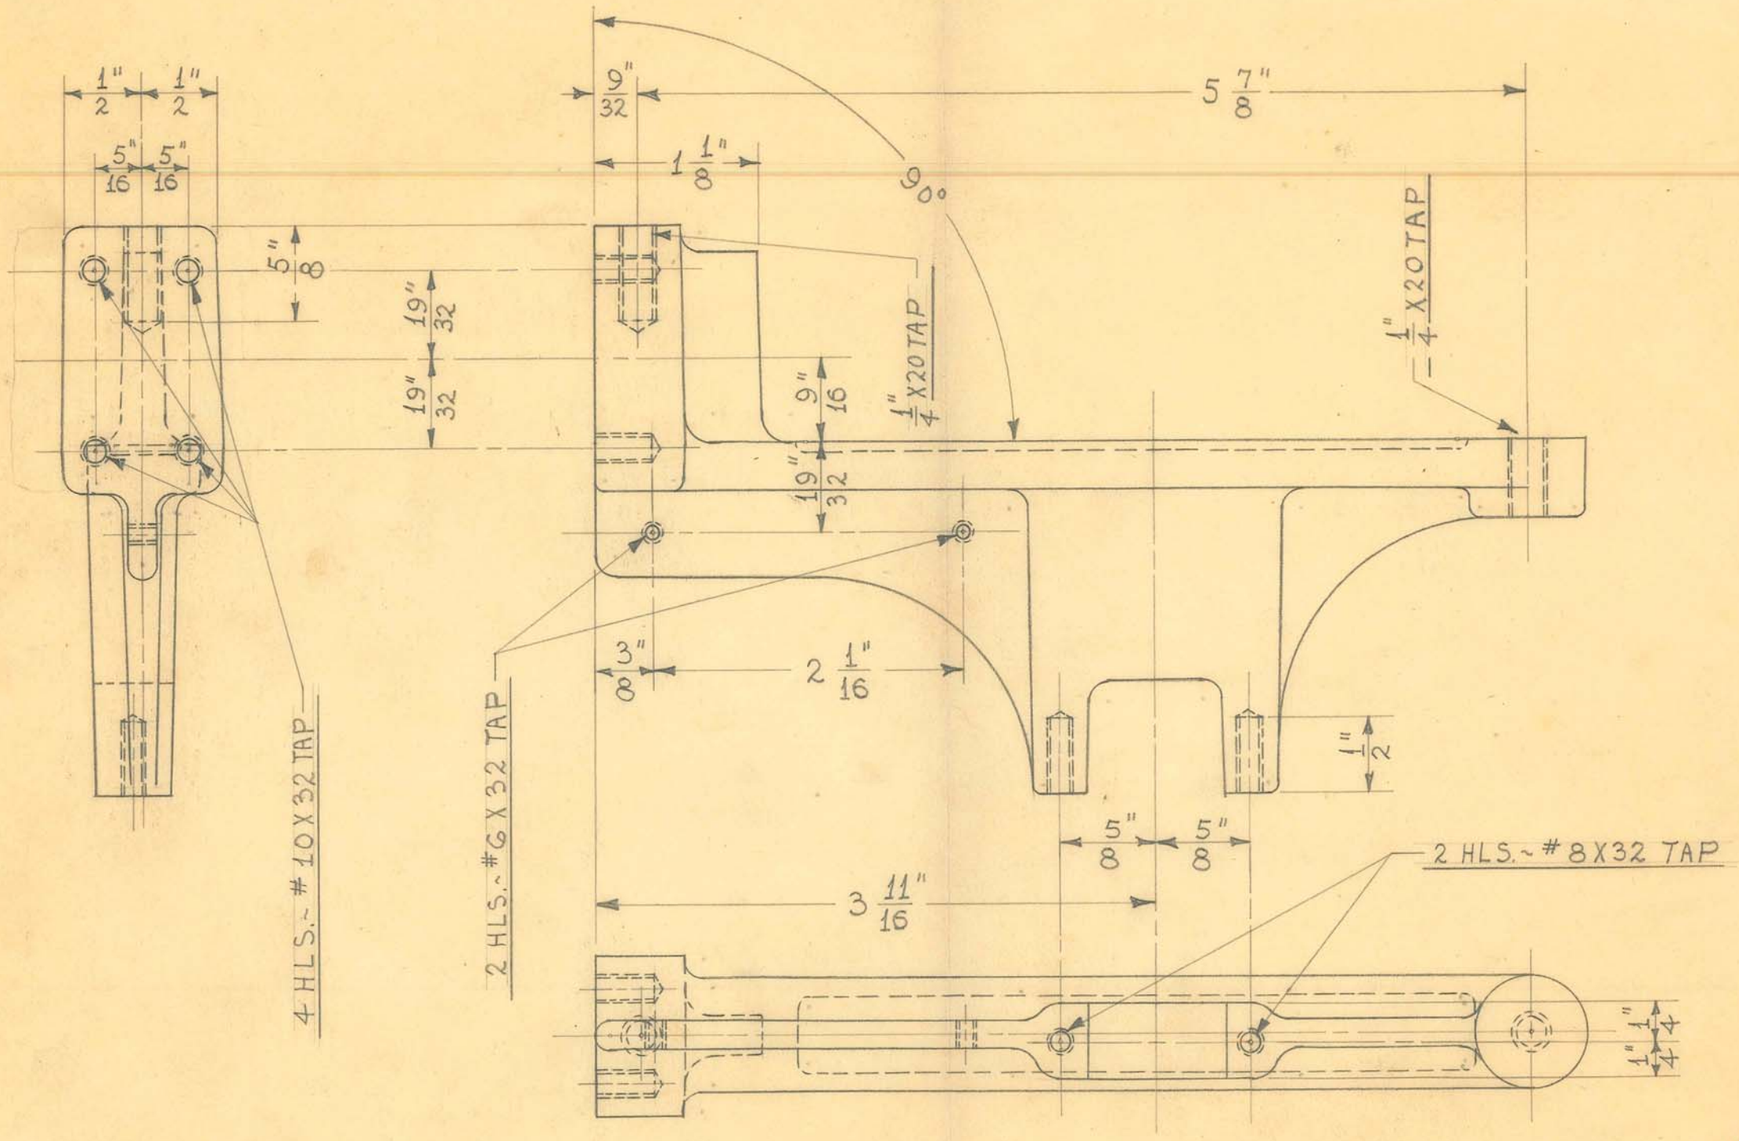

1 REQUIRED

OBSOLETE

Obsolete

SIZE		ISSUE 5-5-43	HE.
KIND	IRON CASTING	CHANGED	
SHAPE		"	
FINISH		"	
TEMP.		"	
DIE	1497	"	

TITLE:
FISCHER MOD. "G" SHOCKPROOF FLUOROSCOPE
TRANSFORMER SUPPORT ~ LEFT

H. G. FISCHER & CO.
2335 WABANSIA AVE.
CHICAGO, ILL.

CAT. NO.

PART NO. 11442 1/2 AFA

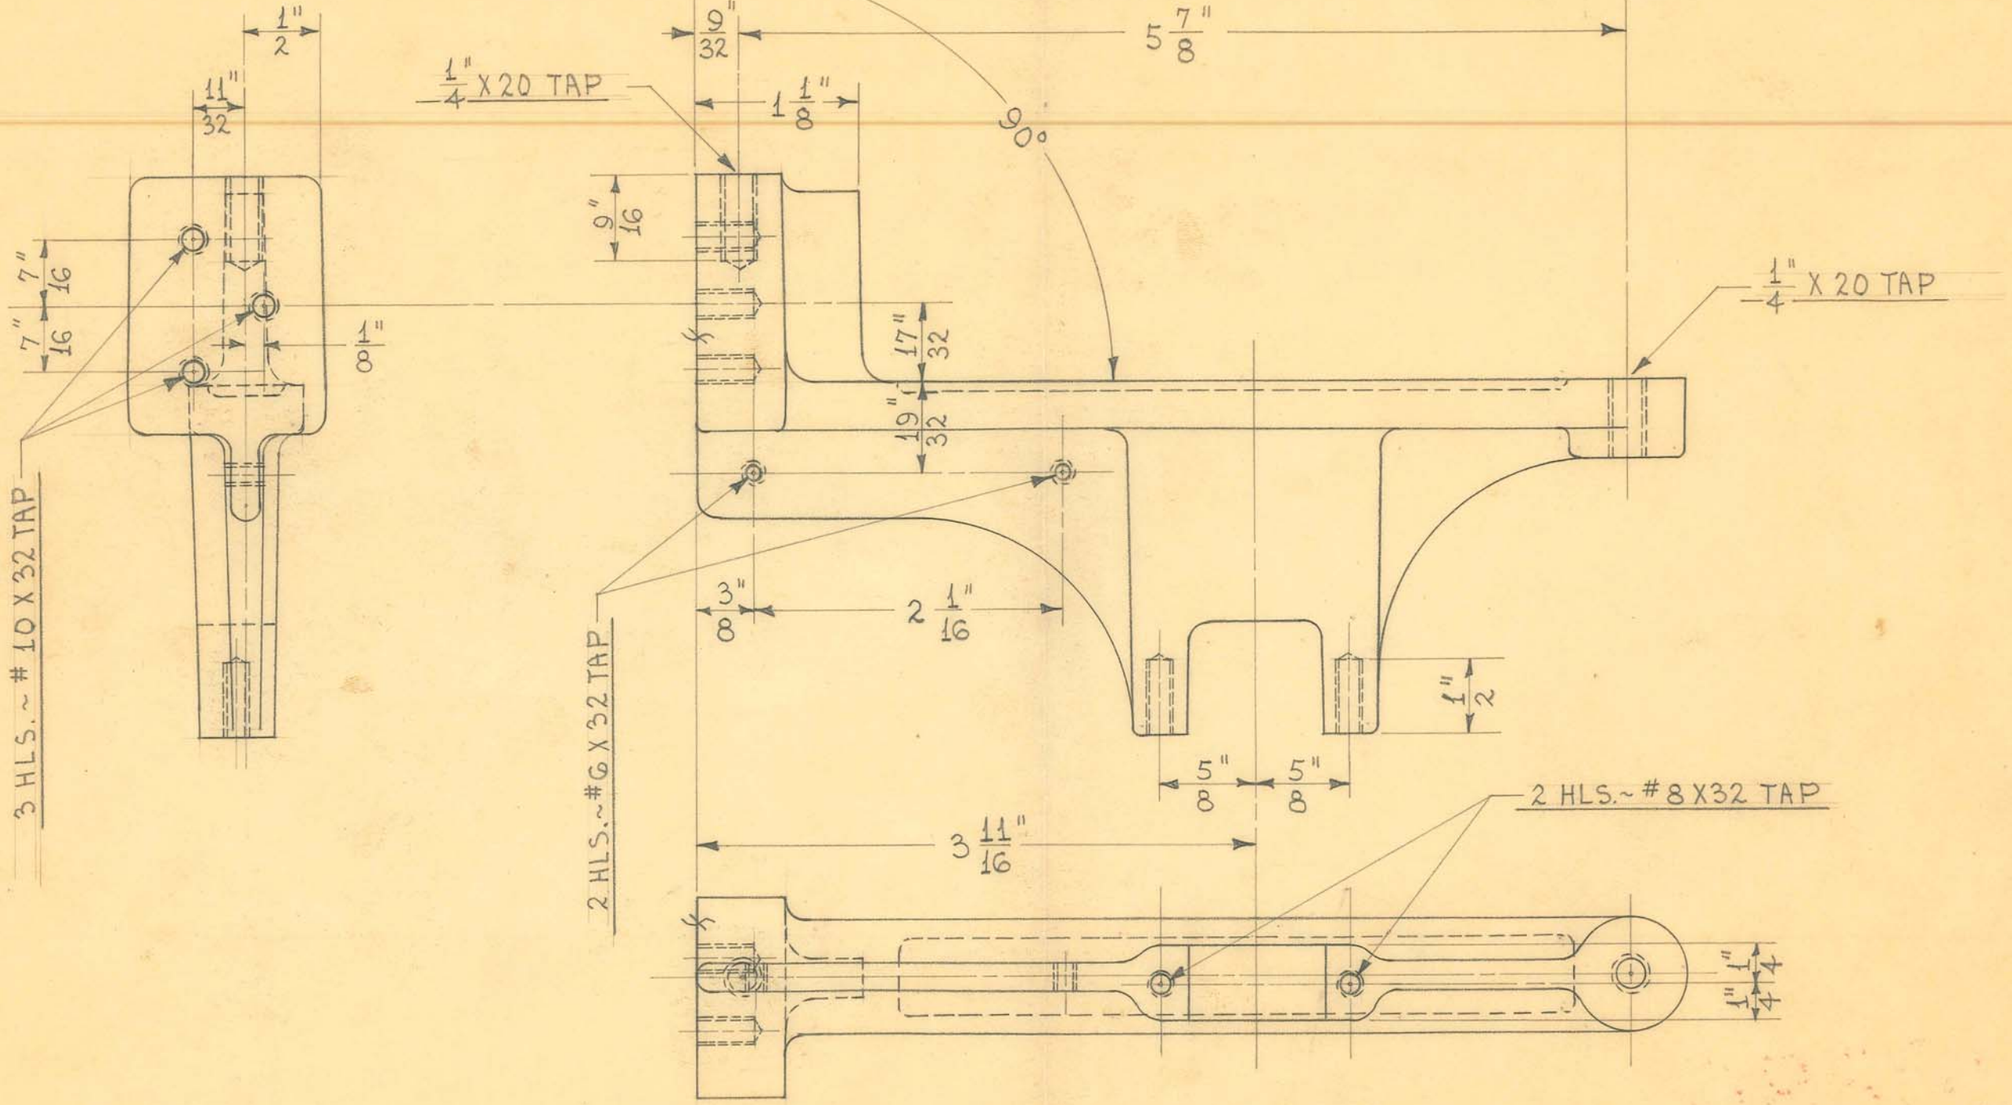

1 REQUIRED

OBSOLETE

SIZE		ISSUE 3-23-45	HE.
KIND	IRON CASTING	CHANGED	
SHAPE		"	
FINISH		"	
TEMP.		"	
PATT.	1497	"	

TITLE: FISCHER MOD. "G" SHOCKPROOF FLUOROSCOPE TRANSFORMER SUPPORT ~ LEFT

H. G. FISCHER & CO.
2335 WABANSIA AVE.
CHICAGO, ILL.

CAT. NO.

PART NO. 11442 1/2 BF

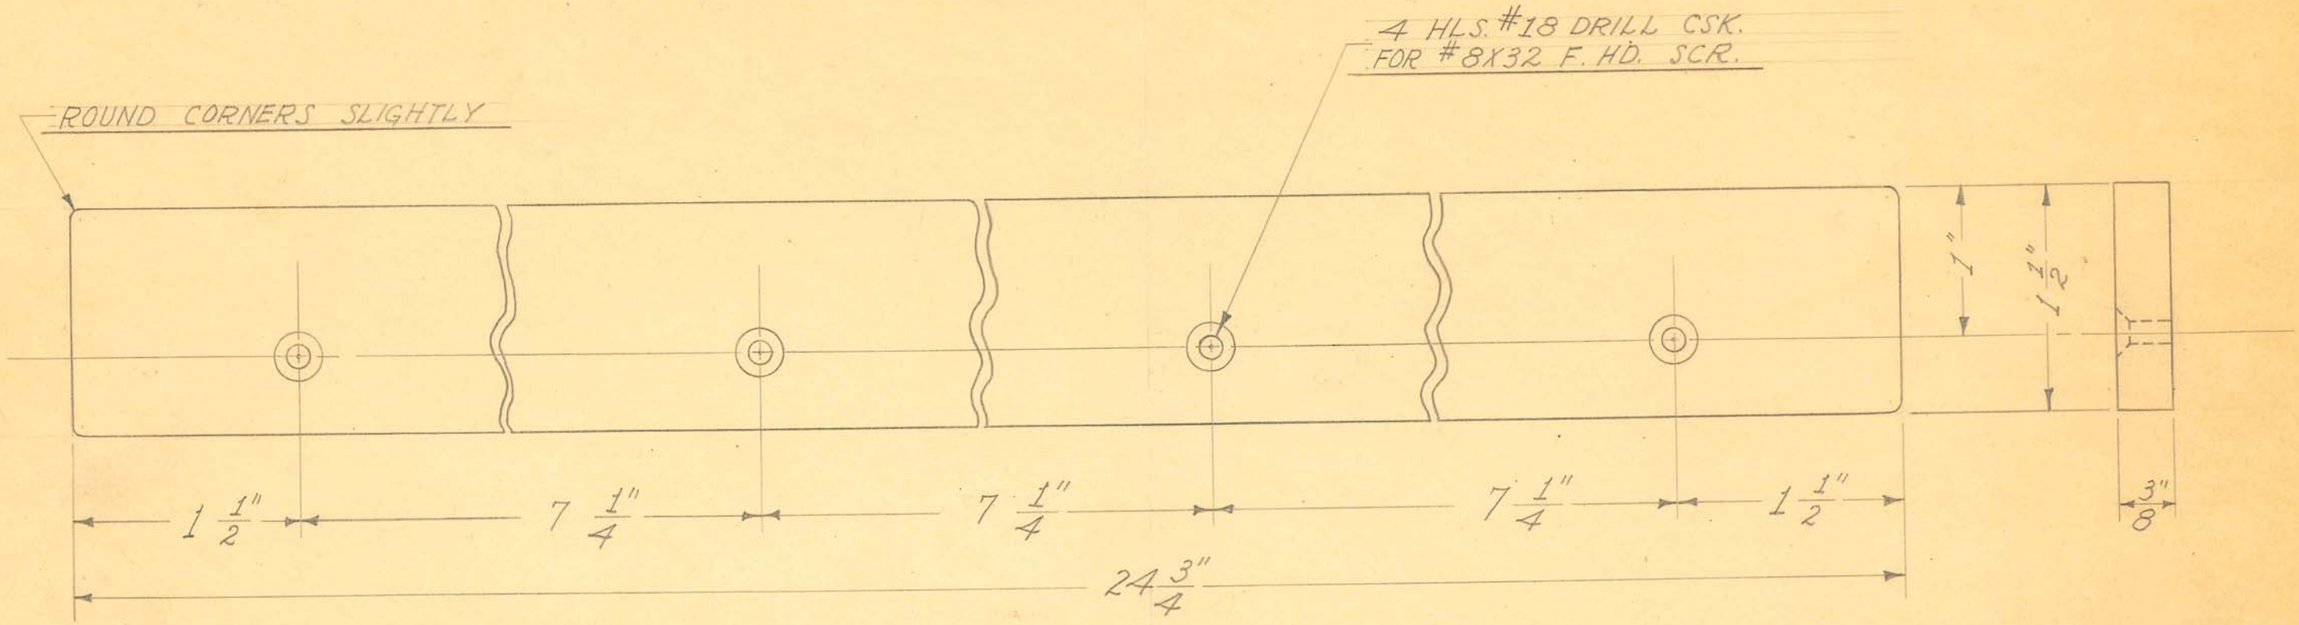

1 REQUIRED

OBSOLETE

SIZE	3/8" X 1 1/2"	ISSUE 5-1-37	J.W.	TITLE: FISCHER SYNCHROTIMED BUCKY MTG. STRIP FOR COMPRESSION ATTACH.- ROLLER END
KIND	C. DRAWN STEEL	CHANGED		
SHAPE		"		
FINISH	CAD. #23	"		
TEMP.		"		
PATT.		"		

H. G. FISCHER & CO.
2335 WABANSIA AVE.
CHICAGO, ILL.

CAT. NO.

PART NO. 10561

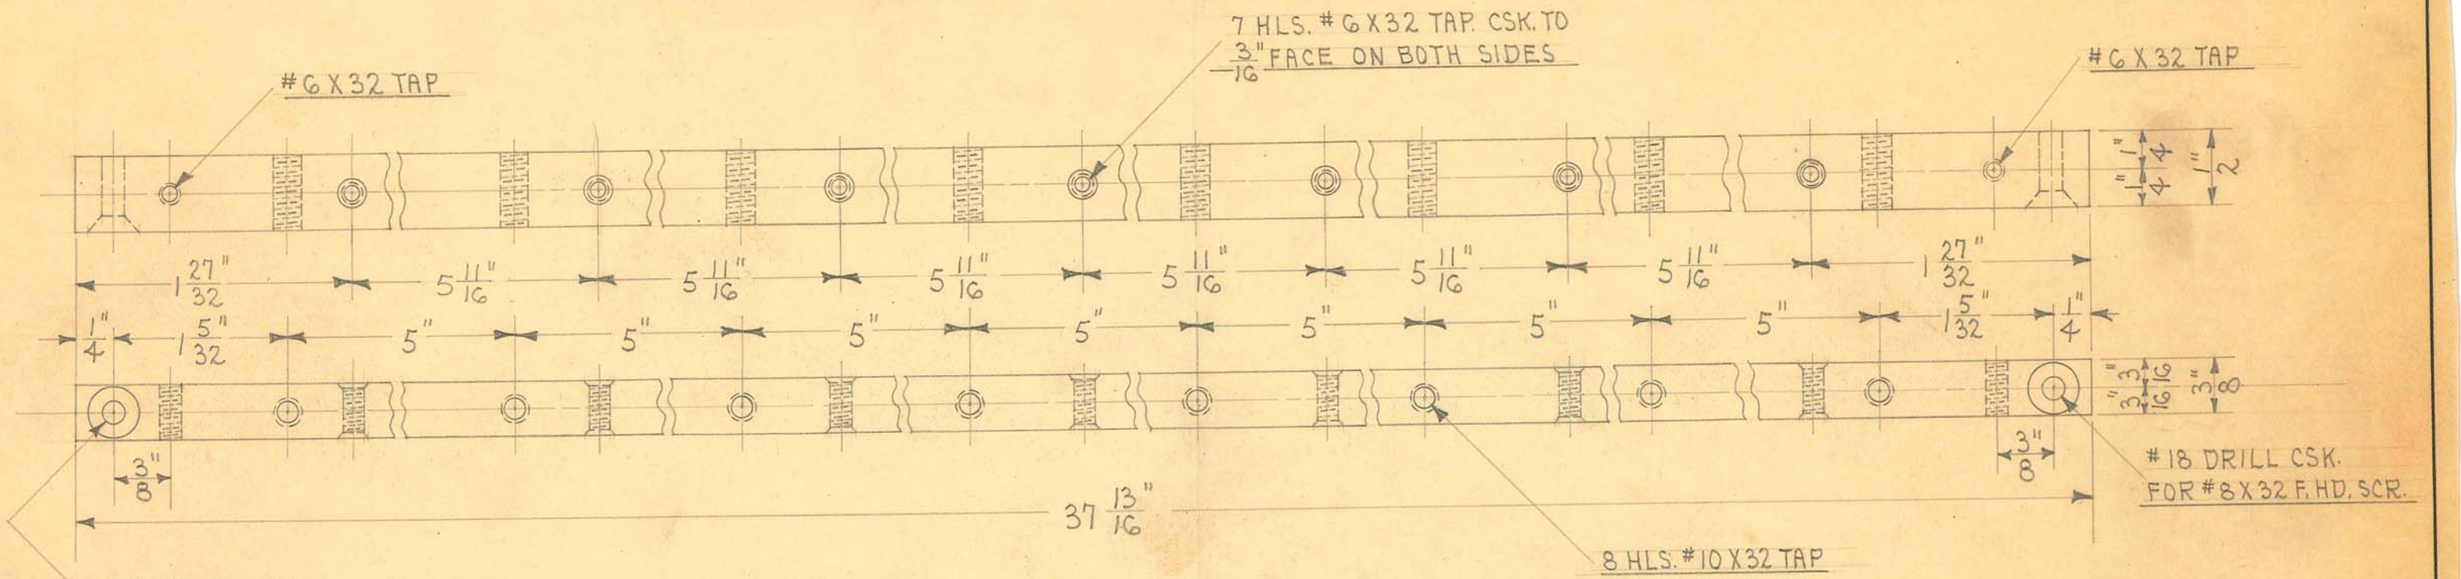

2 REQUIRED

OBSOLETE

SIZE	3/8" X 1/2"	ISSUE 5-13-37	N.E.
KIND	C.R. STEEL	CHANGED	
SHAPE		"	
FINISH		"	
TEMP.		"	
PATT.		"	

TITLE: FISCHER 36" SYNCHROTIMED BUCKY GRID FRAME TIE ROD

H. G. FISCHER & CO.
2335 WABANSIA AVE.
CHICAGO, ILL.

CAT. NO.

PART NO. 10571

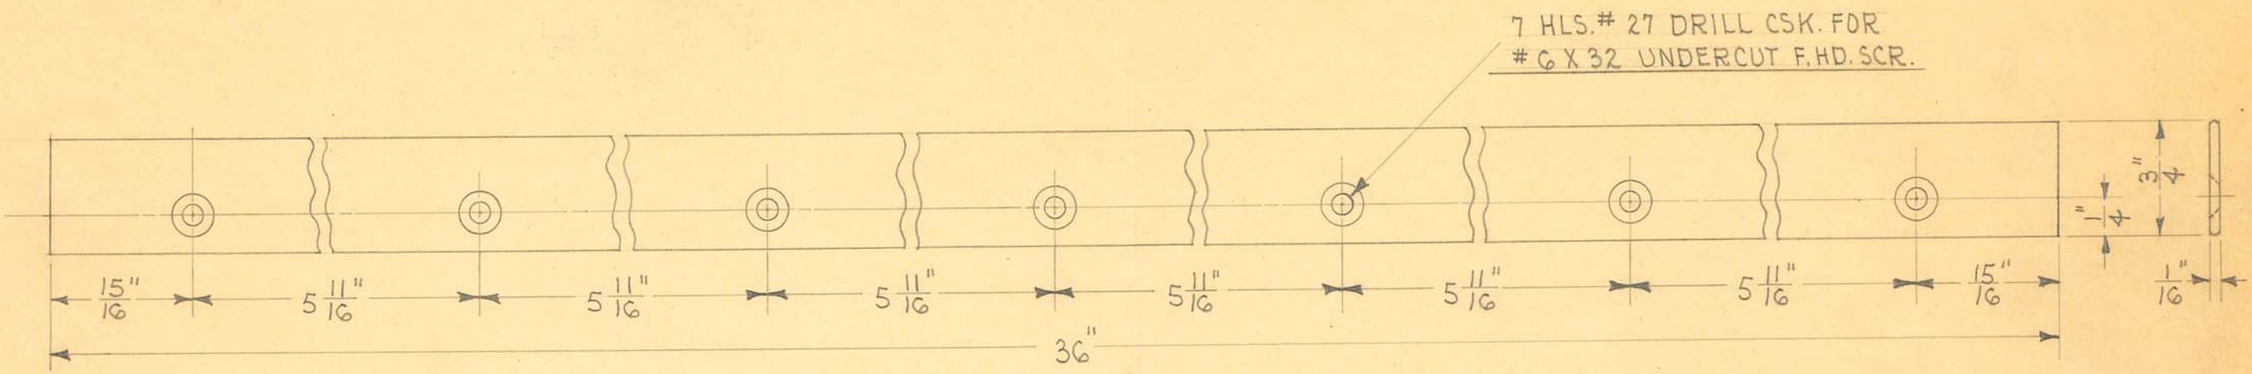

4 REQUIRED

OBSOLETE

obsolete

SIZE	1/16" X 3/4"	ISSUE 5-13-37	A.E.
KIND	FLAT WIRE	CHANGED	
SHAPE		"	
FINISH	CAD. # 23	"	
TEMP.		"	
PATT.		"	

TITLE: FISCHER 36" SYNCHROTIMED BUCKY GRID FRAME TIE ROD REINFORCING STRIP

H. G. FISCHER & CO.
2335 WABANSIA AVE.
CHICAGO, ILL.

CAT. NO.

PART NO. 10572

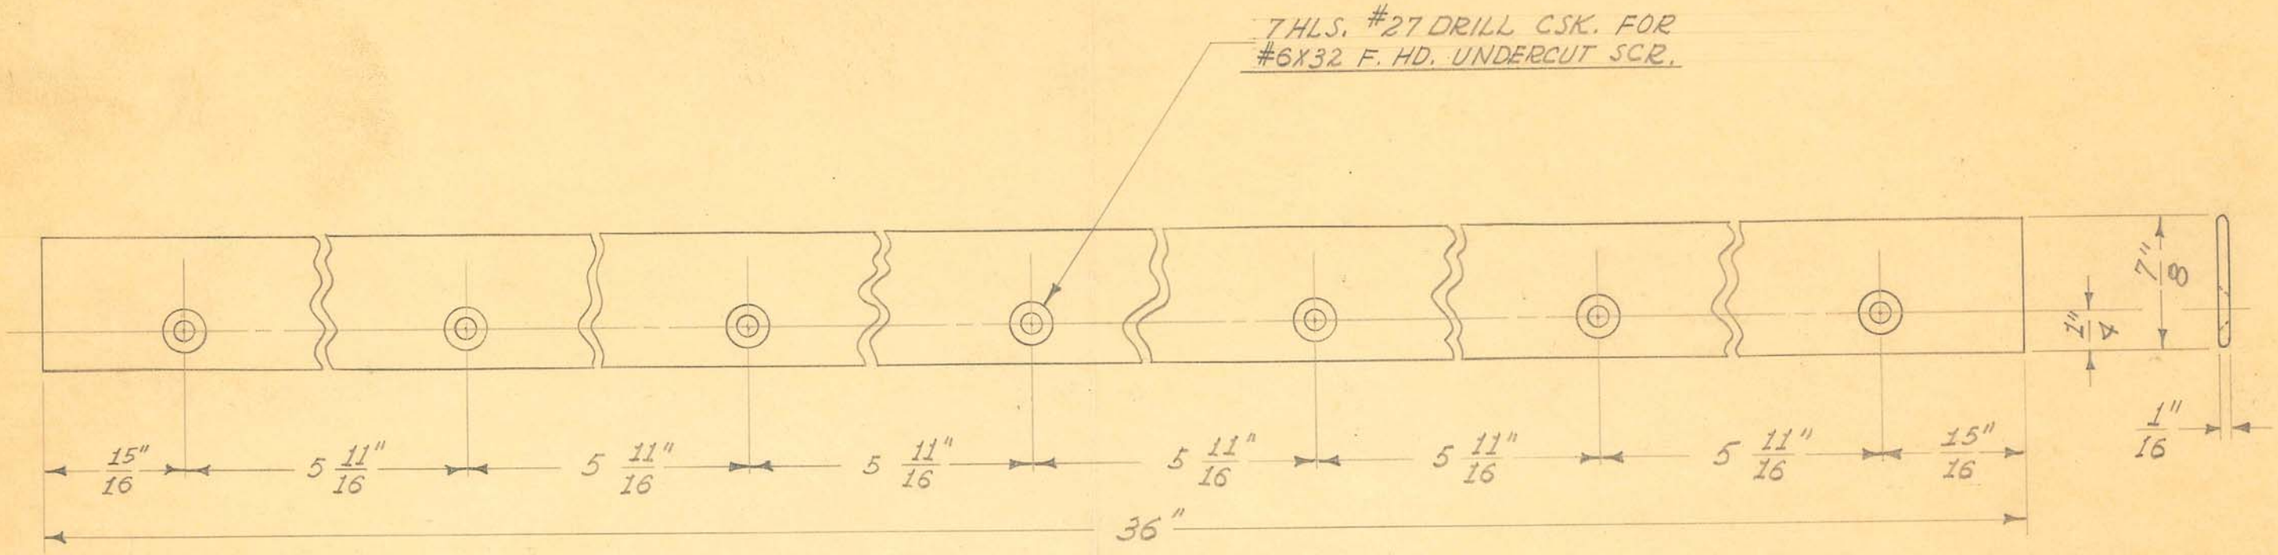

2 REQUIRED

OBSOLETE

SIZE	1/16" X 7/8"	ISSUE 8-11-37	J.W.	
KIND	FLAT WIRE	CHANGED		
SHAPE		"		
FINISH	CAD. #23	"		
TEMP.		"		
PATT.		"		

TITLE:
FISCHER 36" SYNCHROTIMED BUCKY
GRID FRAME TIE ROD REINFORCING STRIP
- BOTTOM

H. G. FISCHER & CO.
2335 WABANSIA AVE.
CHICAGO, ILL.

CAT. NO.

PART NO. 10572A

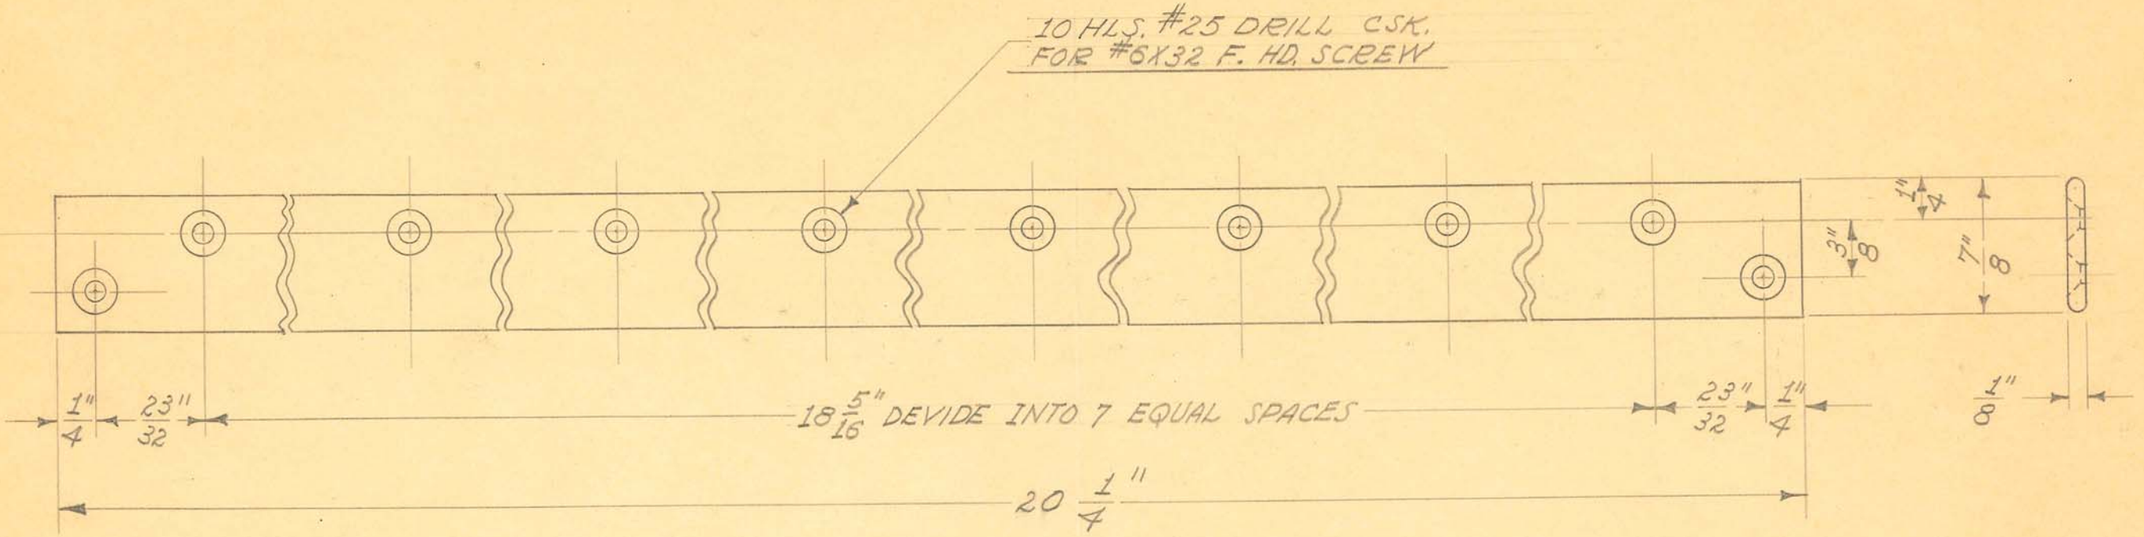

2 REQUIRED

OBSOLETE

SIZE	1/8" X 7/8"	ISSUE 8-11-37	J.W.	TITLE: FISCHER 36" SYNCHROTIMED BUCKY GRID-BOTTOM CLAMPING STRIP
KIND	FLAT WIRE	CHANGED		
SHAPE		"		
FINISH	CAD. #23	"		
TEMP.		"		
PATT.		"		

H. G. FISCHER & CO.
2335 WABANSIA AVE.
CHICAGO, ILL.

CAT. NO.

PART NO. 10581

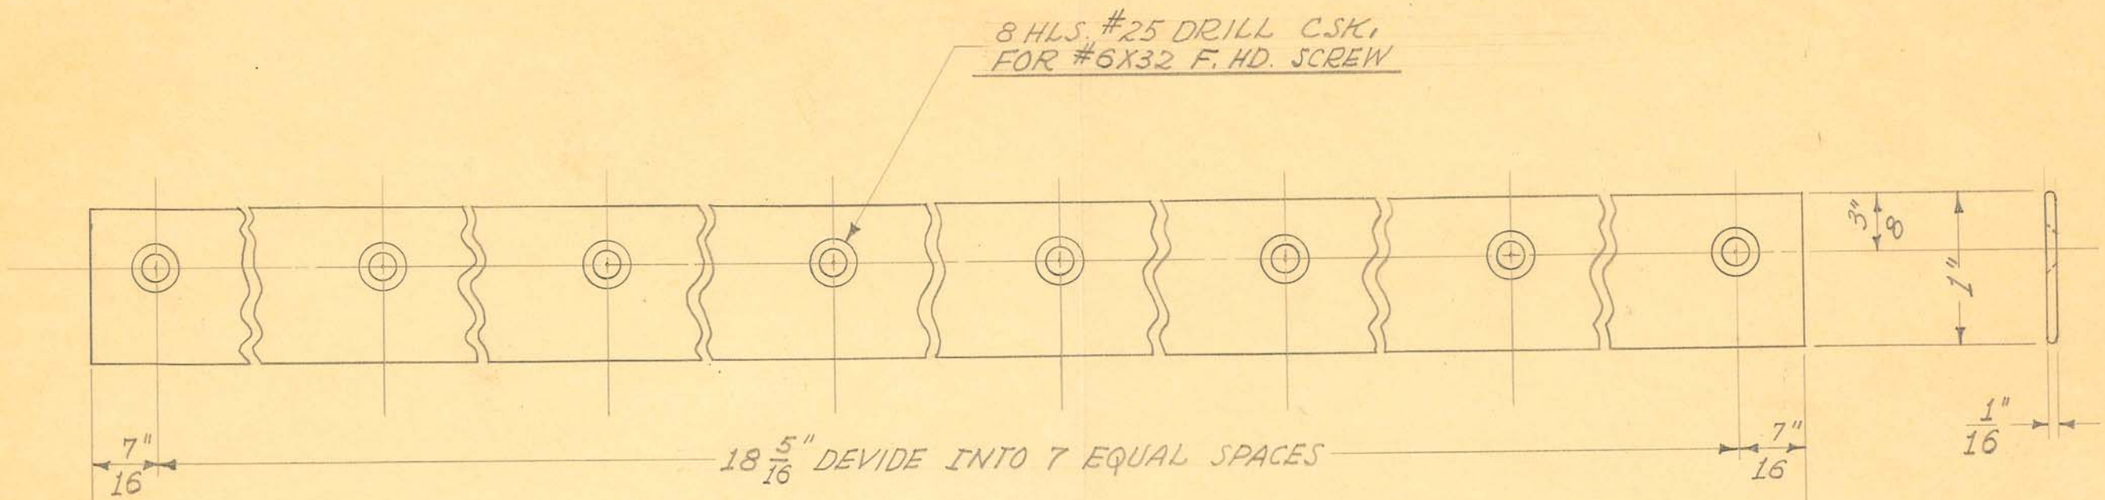

2 REQUIRED

OBSOLETE

SIZE	1/16"X 1"	ISSUE	8-11-37	J.W.
KIND	FLAT WIRE	CHANGED		
SHAPE		"		
FINISH	CAD. #23	"		
TEMP.		"		
PATT.		"		

TITLE: FISCHER 36" SYNCHROTIMED BUCKY GRID-TOP CLAMPING STRIP

H. G. FISCHER & CO.
2335 WABANSIA AVE.
CHICAGO. ILL.

CAT. NO.

PART NO. 10582

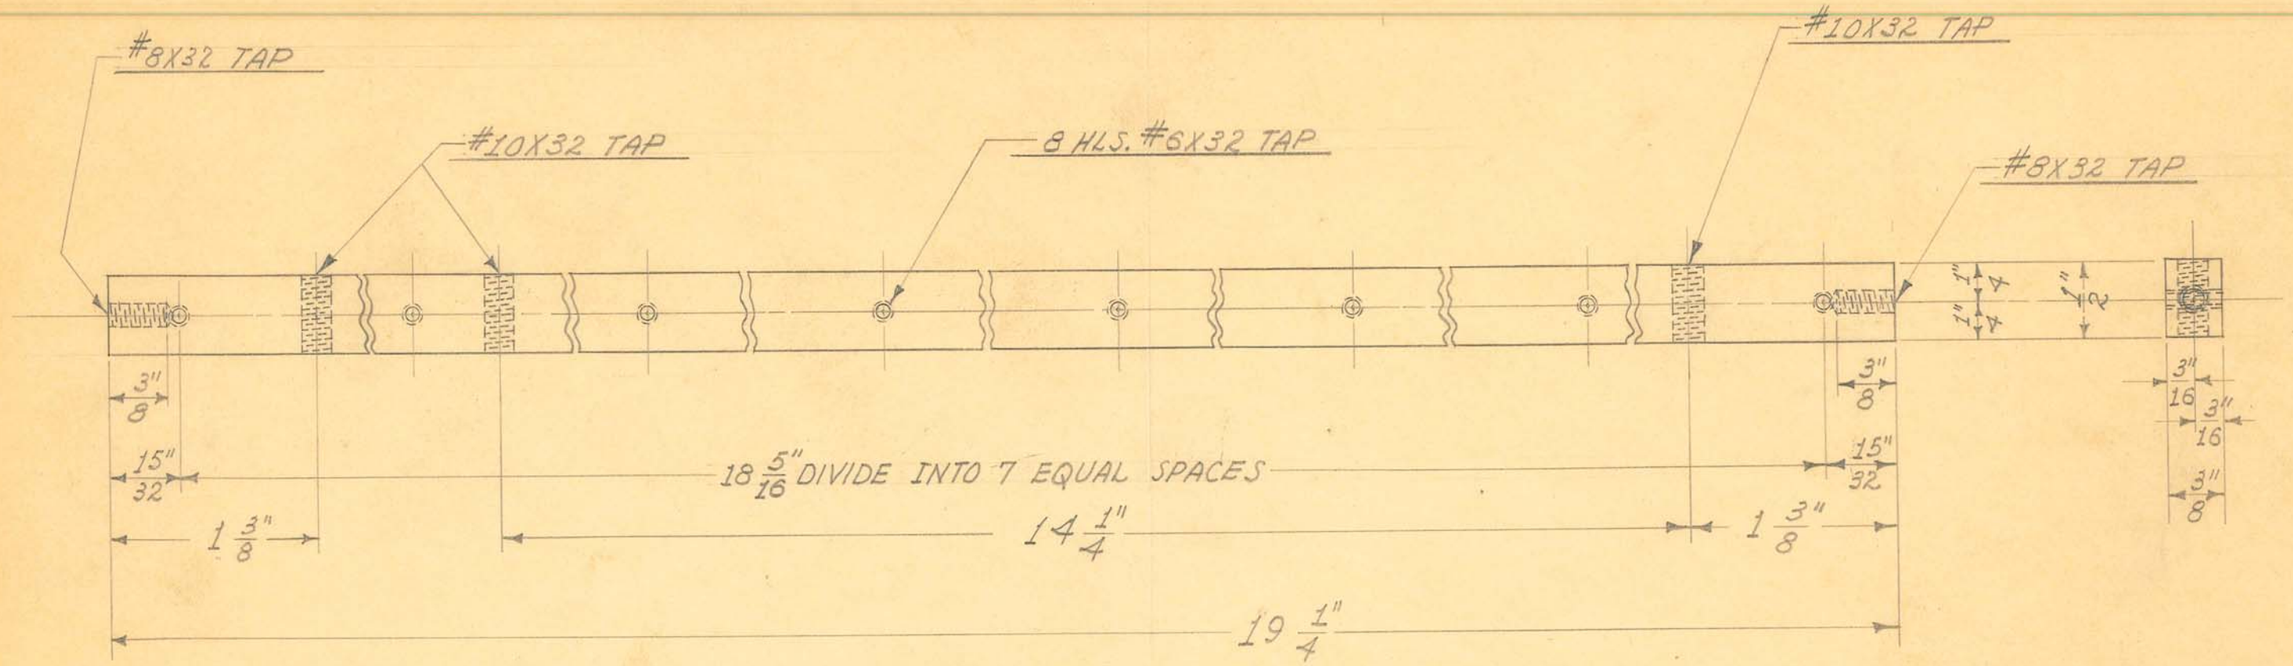

2 REQUIRED

OBSOLETE

3/8" x 1/2" ALUMINUM BAR

SIZE	~~3/8" x 1/2"~~	ISSUE 8-11-37	J.W.
KIND	~~C.R. STEEL~~	CHANGED	
SHAPE	~~BAR~~	"	
FINISH	~~CAD. #23~~	"	
TEMP.		"	
PATT.		"	

TITLE: FISCHER 36" SYNCHROTIMED BUCKY GRID FRAME END BAR

H. G. FISCHER & CO.
2335 WABANSIA AVE.
CHICAGO, ILL.

CAT. NO.

PART NO. 10583

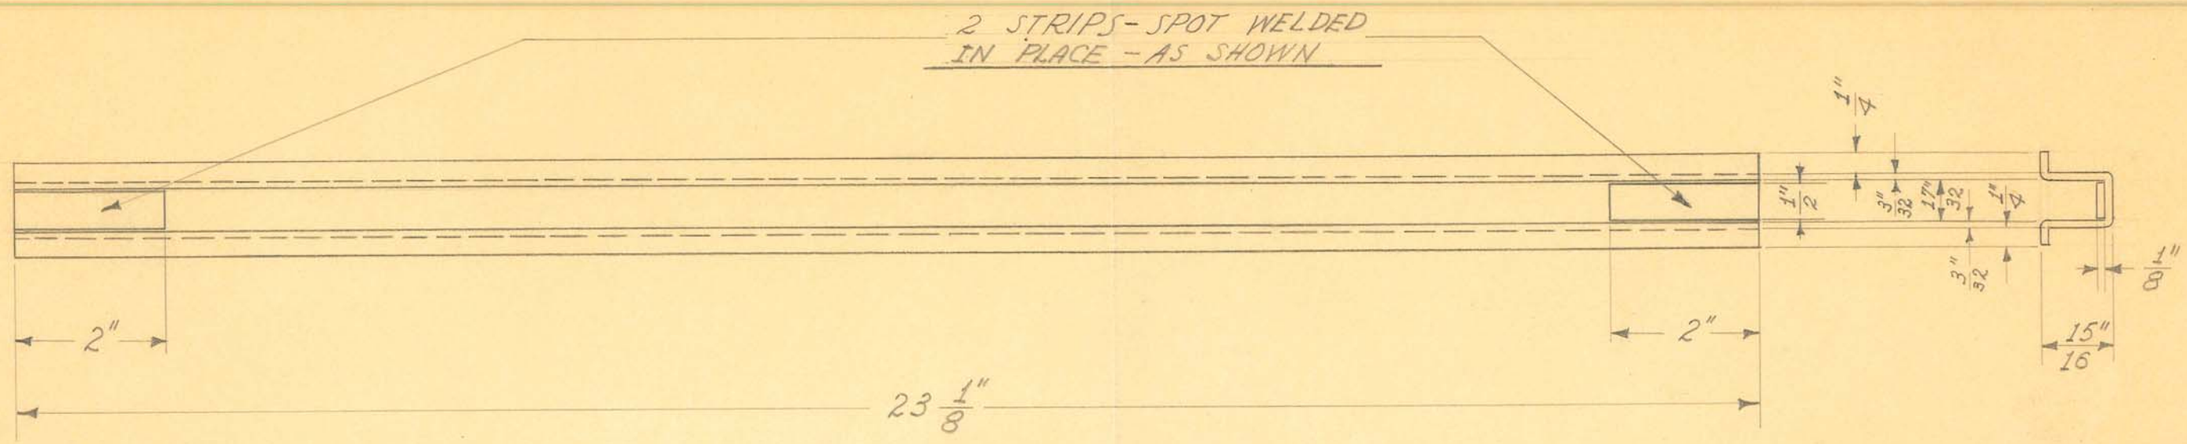

SCALE ~ 1/2" = 1"

OBSOLETE

Obsolete

SIZE	3/32" SHEET	ISSUE	10-20-37	J.W.
KIND	C.R. STEEL	CHANGED		
SHAPE		"		
FINISH		"		
TEMP.		"		
		"		

TITLE: 36" SYNCHROTIMED BUCKY CASSETTE HOLDER SUPPORT

H. G. FISCHER & CO.
2335 WABANSIA AVE.
CHICAGO, ILL.

CAT. NO.

PART NO. 10598

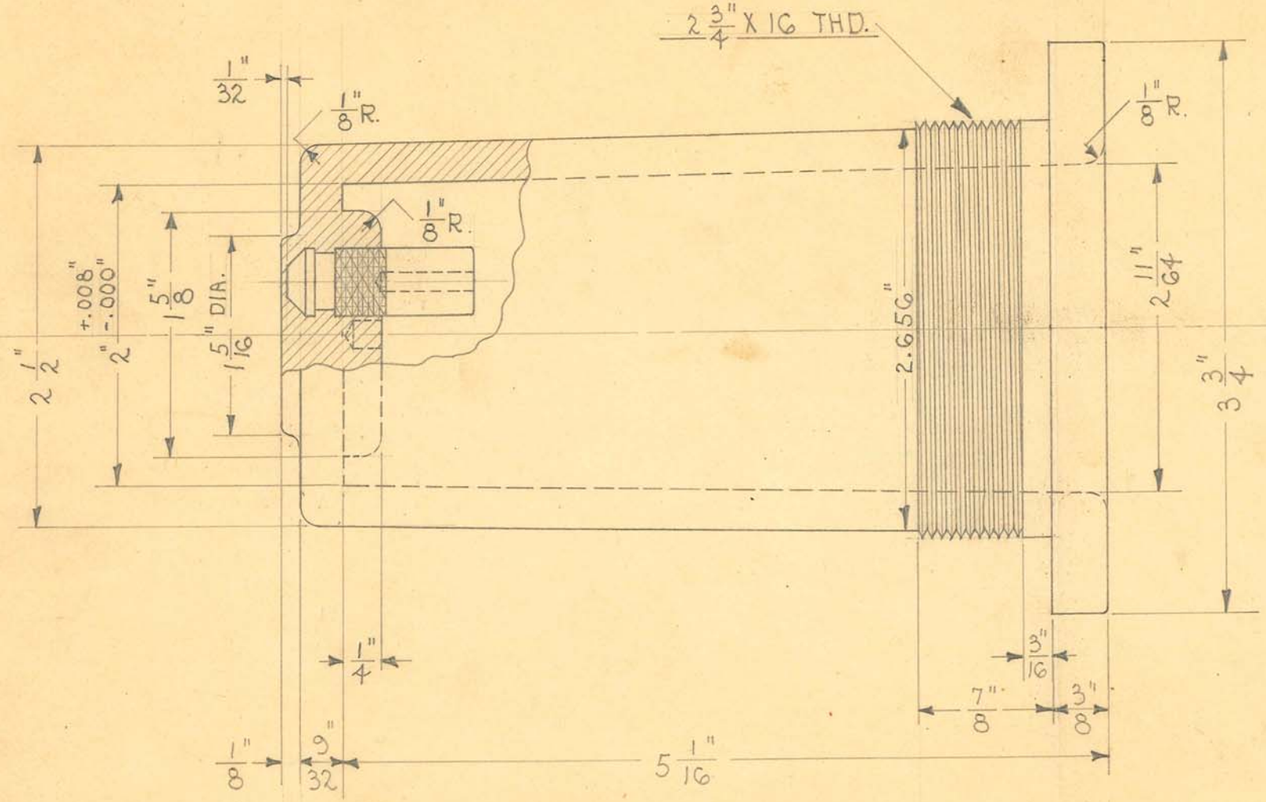

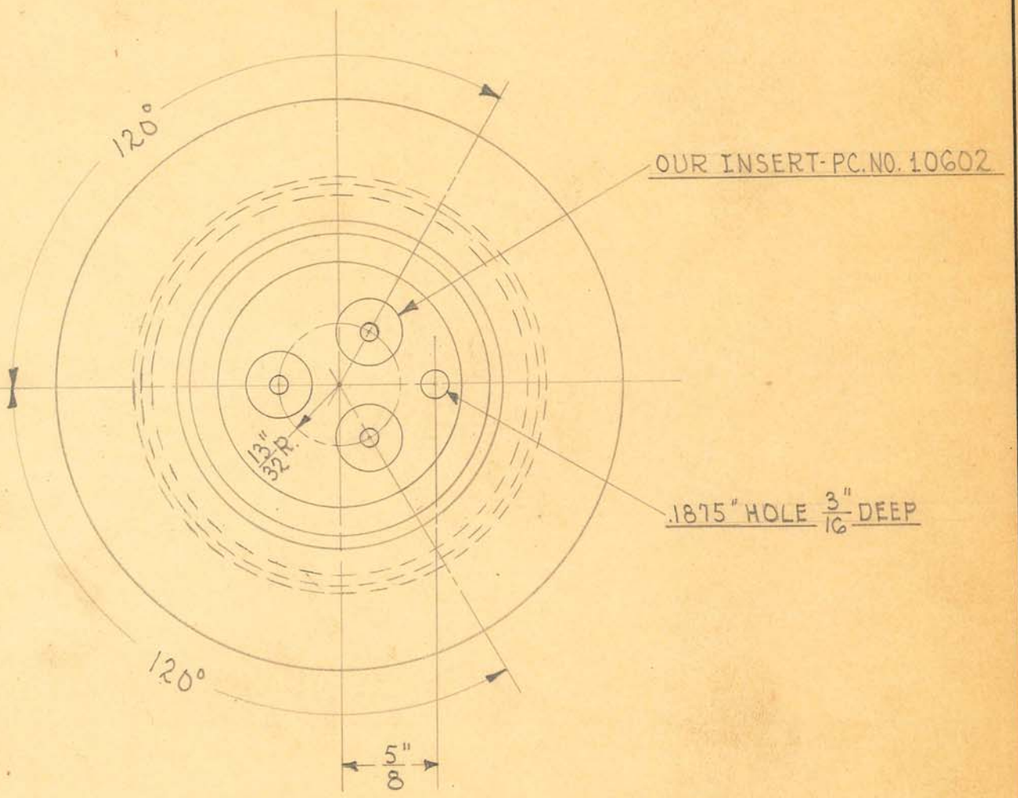

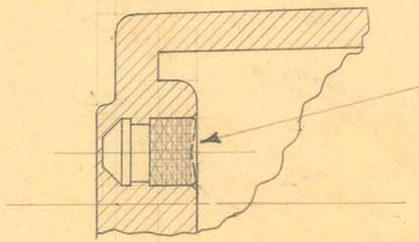

INSERTS DRILLED OFF BY
C. M. P. CORP. AFTER MOLDING

OBSOLETE

C.M.P.C. MOLD - M2029

SIZE		ISSUED 6-3-37	J.B.
KIND	MOLDED BAKELITE	CHANGED	
SHAPE	MOLD # 1788	"	
FINISH		"	
TEMP.		"	
PATT.		"	

TITLE:
MODEL "100-100" TRANSFORMER
SUBMERGED HIGH TENSION POST SOCKET

H. G. FISCHER & CO.
2335 WABANSIA AVE.
CHICAGO, ILL.

CAT. NO.

PART NO. 10601G

P10301

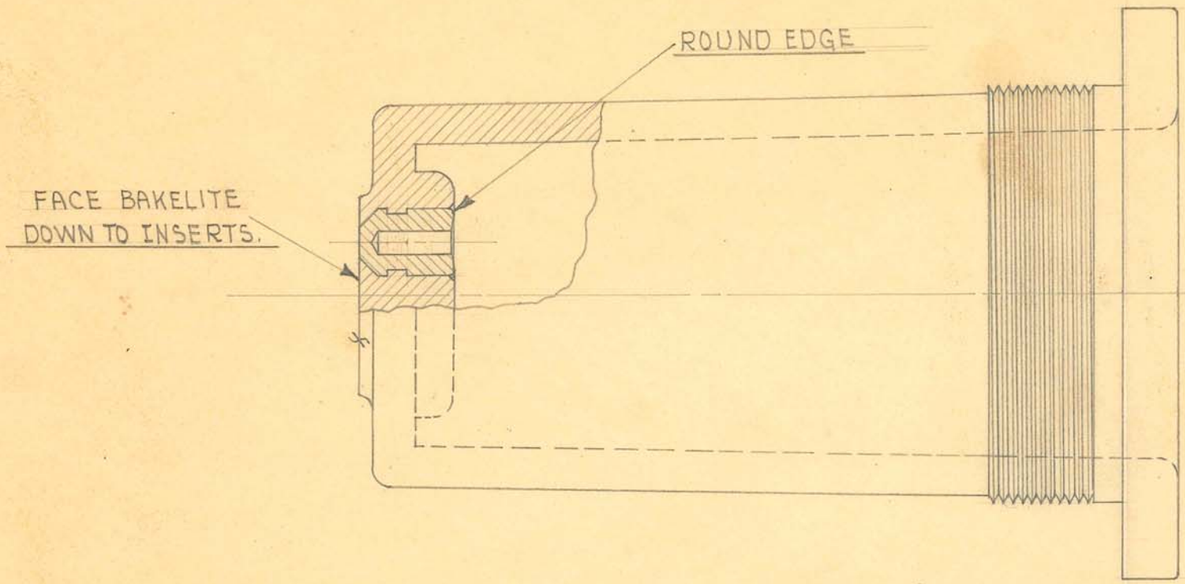

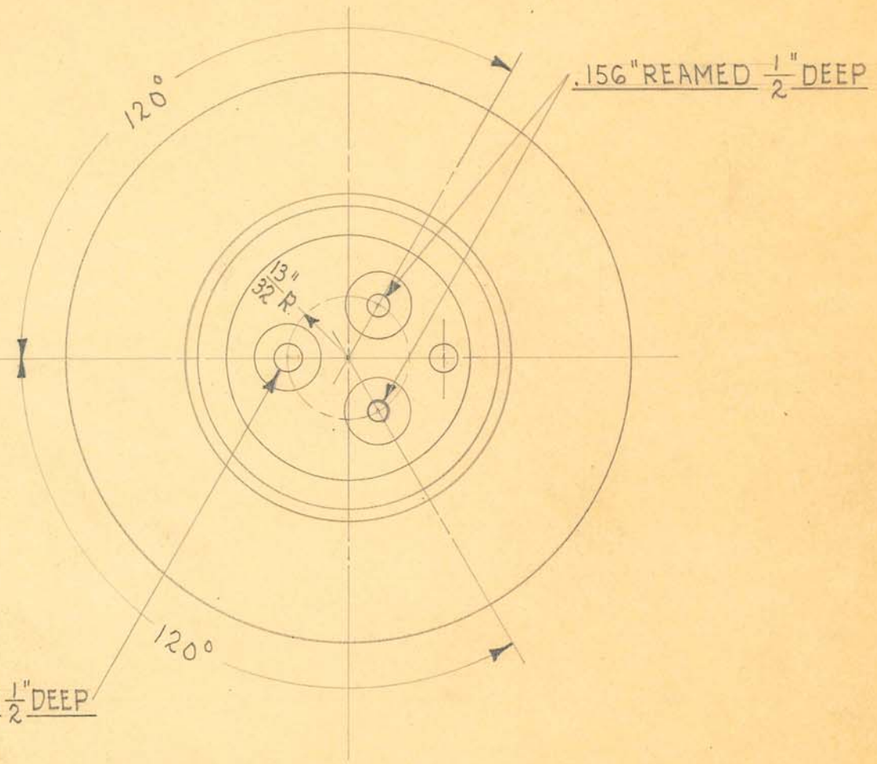

2 REQUIRED

OBSOLETE

SIZE		ISSUE 6-3-37	H.G.
KIND	MOLDED BAKELITE	CHANGED	
~~STAGE~~	MOLD # 1788	"	
FINISH		"	
TEMP.		"	
PATT.		"	

TITLE:
MODEL "100-100" TRANSFORMER
SUBMERGED HIGH TENSION POST SOCKET

H. G. FISCHER & CO.
2335 WABANSIA AVE.
CHICAGO, ILL.

CAT. NO.

PART NO. 10601GF

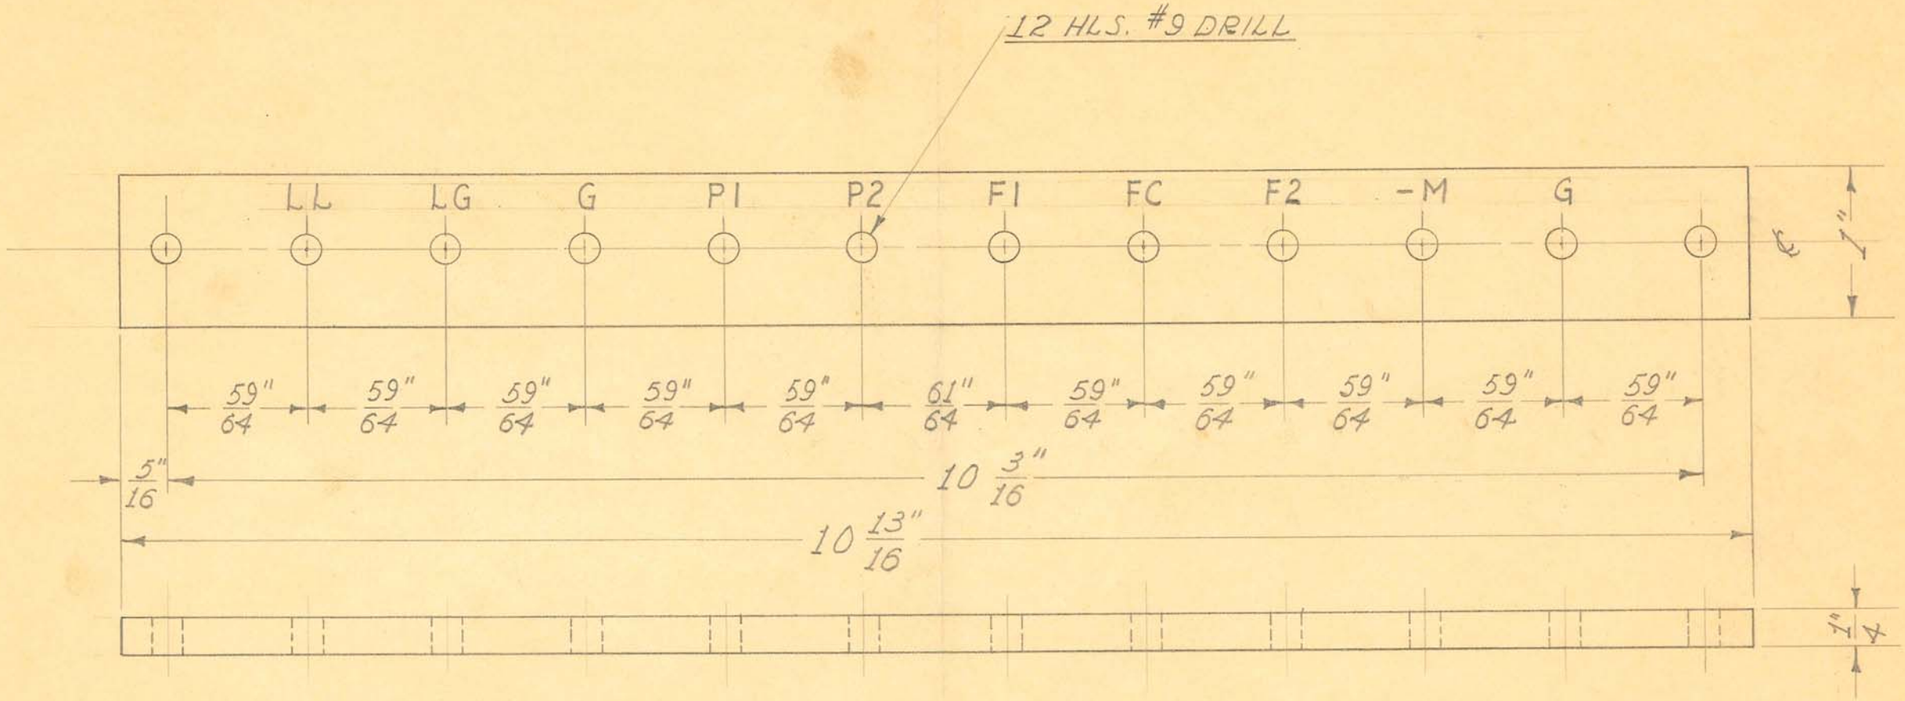

1 REQUIRED

OBSOLETE

SIZE	1/4" SHEET	ISSUE 3-16-37	J.W.
KIND	BAKELITE	CHANGED	
SHAPE		"	
FINISH		"	
TEMP.		"	
PATT.		"	

TITLE: MODEL "100-100" REMOTE CONTROL- PRIMARY TERMINAL BOARD

H. G. FISCHER & CO.
2335 WABANSIA AVE.
CHICAGO, ILL.

CAT. NO.

PART NO. 10611

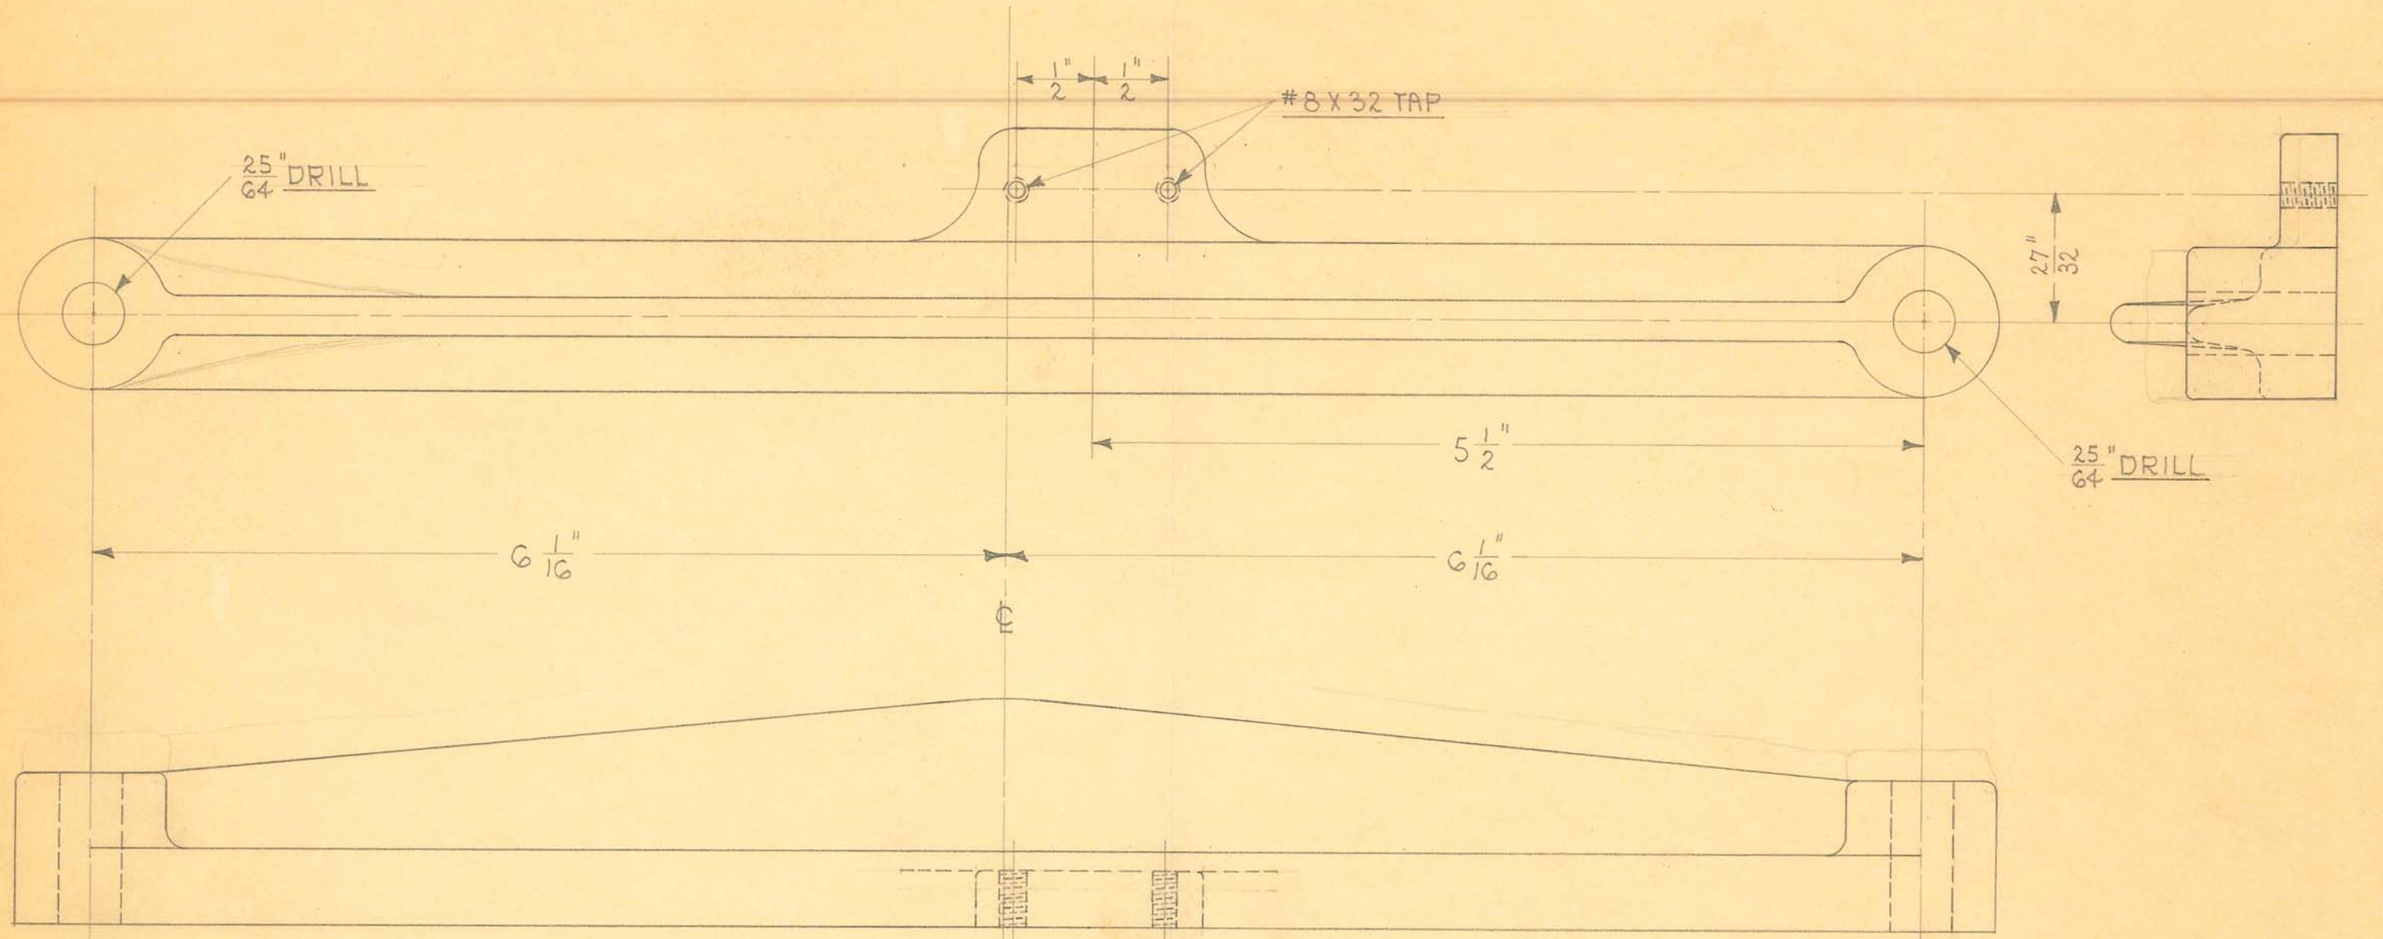

1 REQUIRED

OBSOLETE

OBSOLETE

SIZE		ISSUE 2-10-37	A.E.
KIND	IRON CASTING	CHANGED	
SHAPE		"	
FINISH		"	
TEMP.		"	
	0225-1080	"	

TITLE: MODEL "100-100" TRANSFORMER CLAMP-RIGHT

H. G. FISCHER & CO.
2335 WABANSIA AVE.

CAT. NO.

PART NO. 10621F

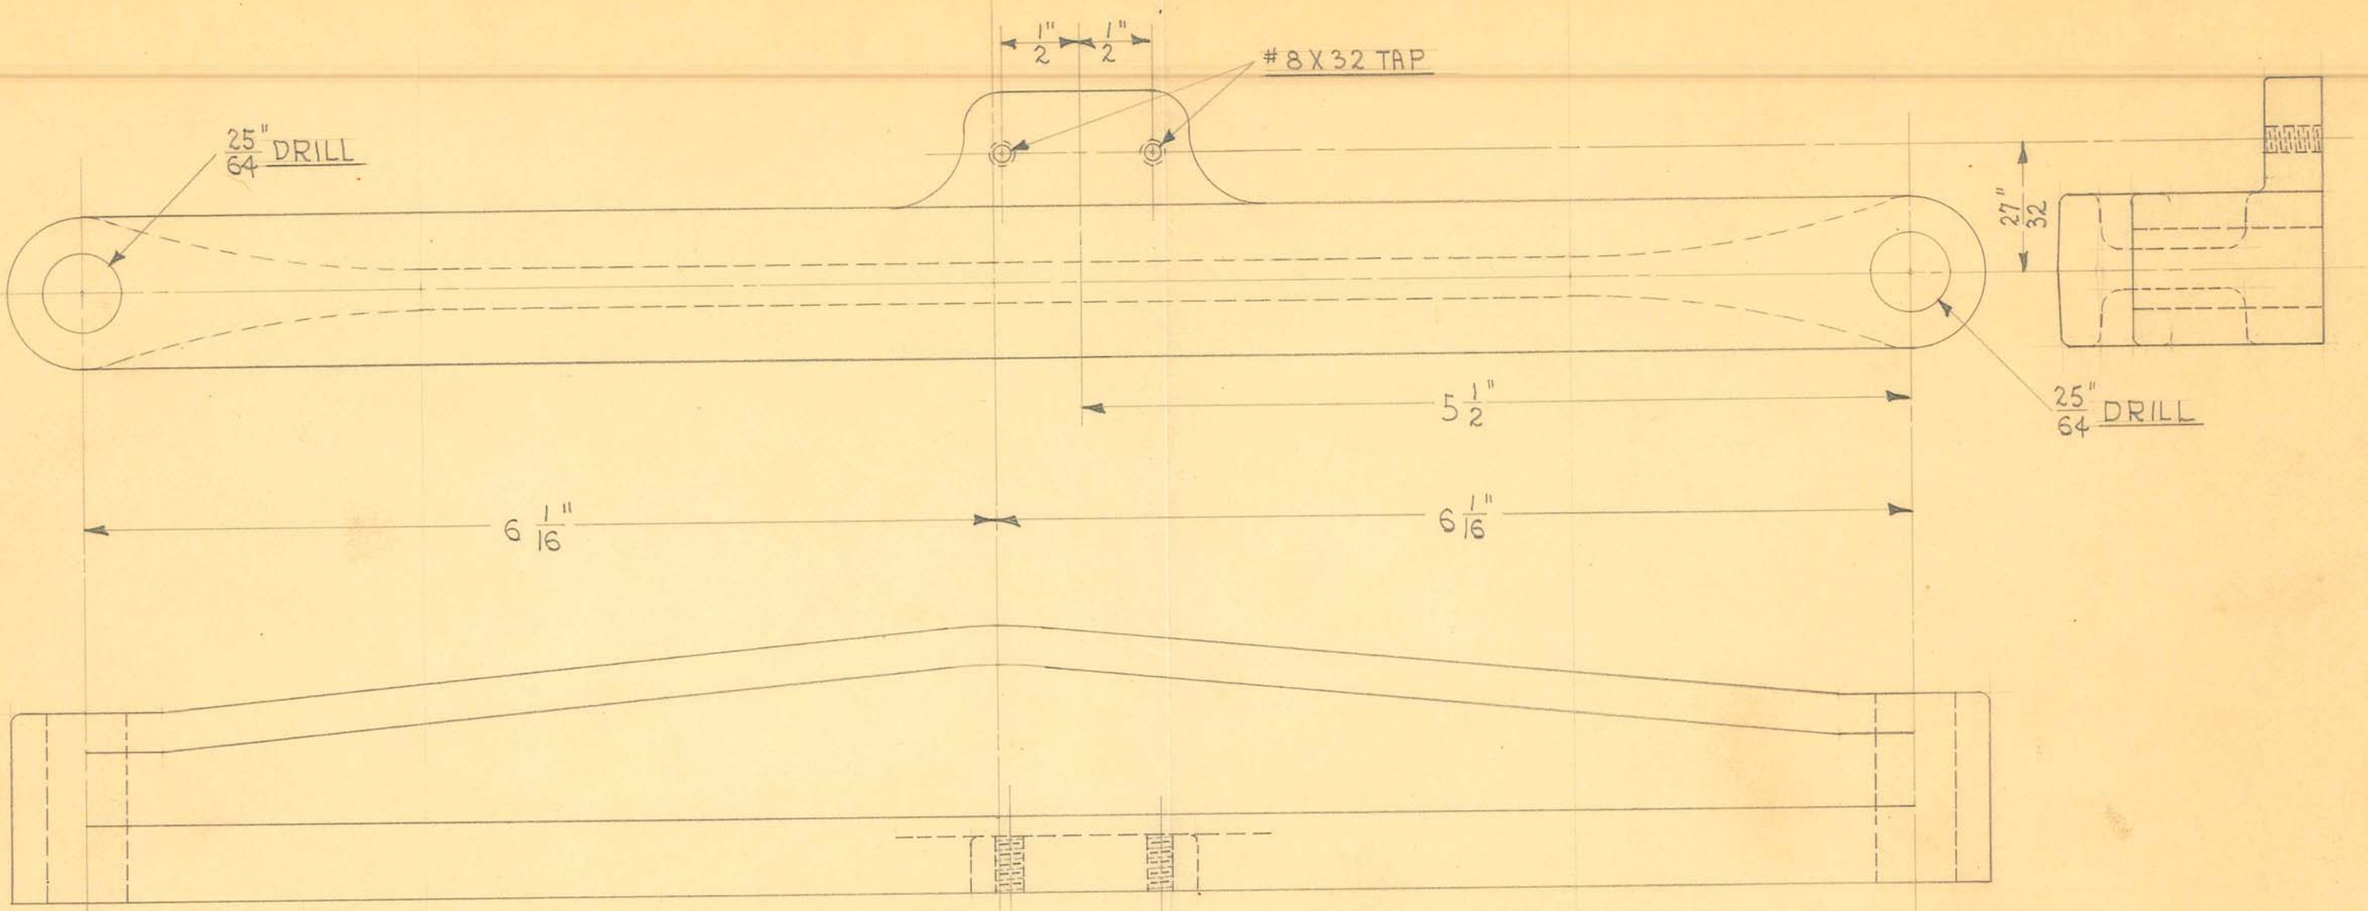

1 REQUIRED

OBSOLETE

SIZE		ISSUE 12-9-37	H.E.
KIND	IRON CASTING	CHANGED	
SHAPE		"	
FINISH		"	
TEMP.		"	
PATT.	8698-1185	"	

TITLE: MODEL "100-100" TRANSFORMER CLAMP-RIGHT

H. G. FISCHER & CO. 2335 WABANSIA AVE. CHICAGO, ILL.	CAT. NO.	PART NO. 10621AF

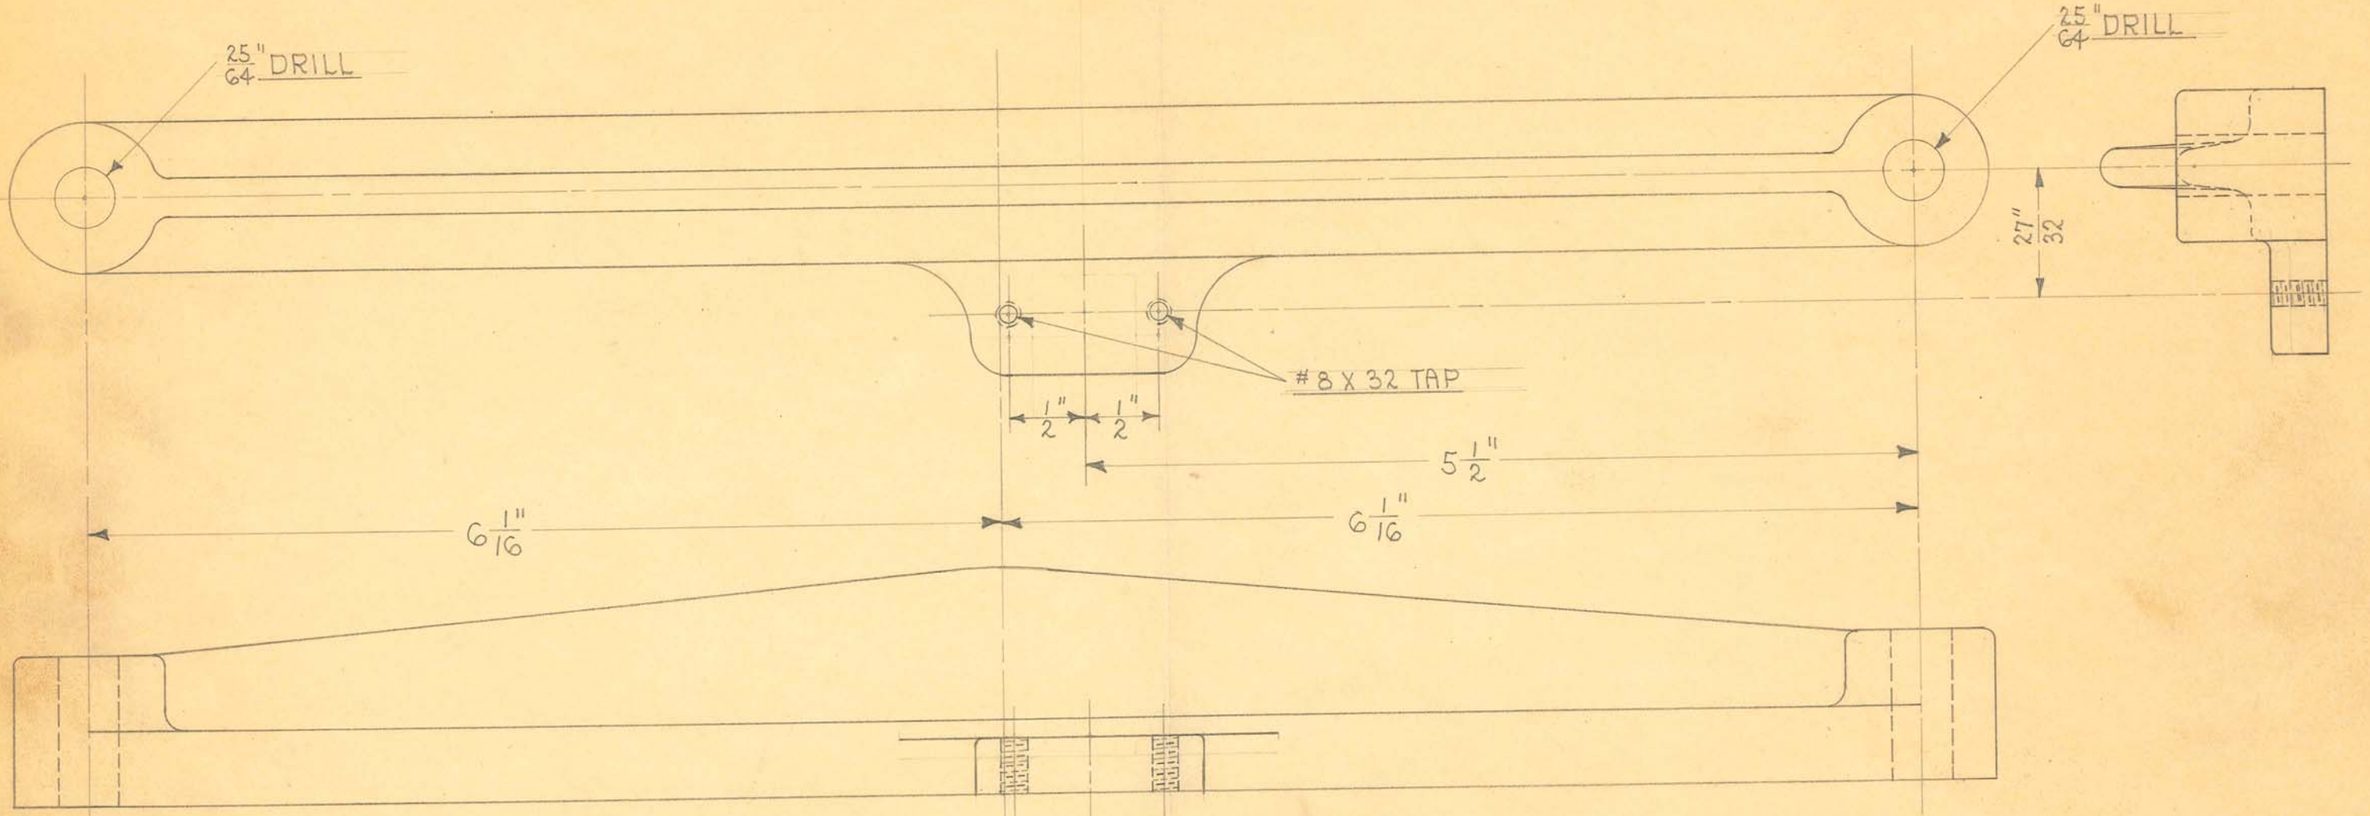

1 REQUIRED

OBSOLETE

OBSOLETE

SIZE		ISSUE 2-10-37	J.E.
KIND	IRON CASTING	CHANGED	
SHAPE		"	
FINISH		"	
TEMP.		"	
PATT.	8551-1068	"	

TITLE: MODEL "100-100" TRANSFORMER CLAMP-LEFT

H. G. FISCHER & CO.
2335 WABANSIA AVE.
CHICAGO, ILL.

CAT. NO.

PART NO. 10622F

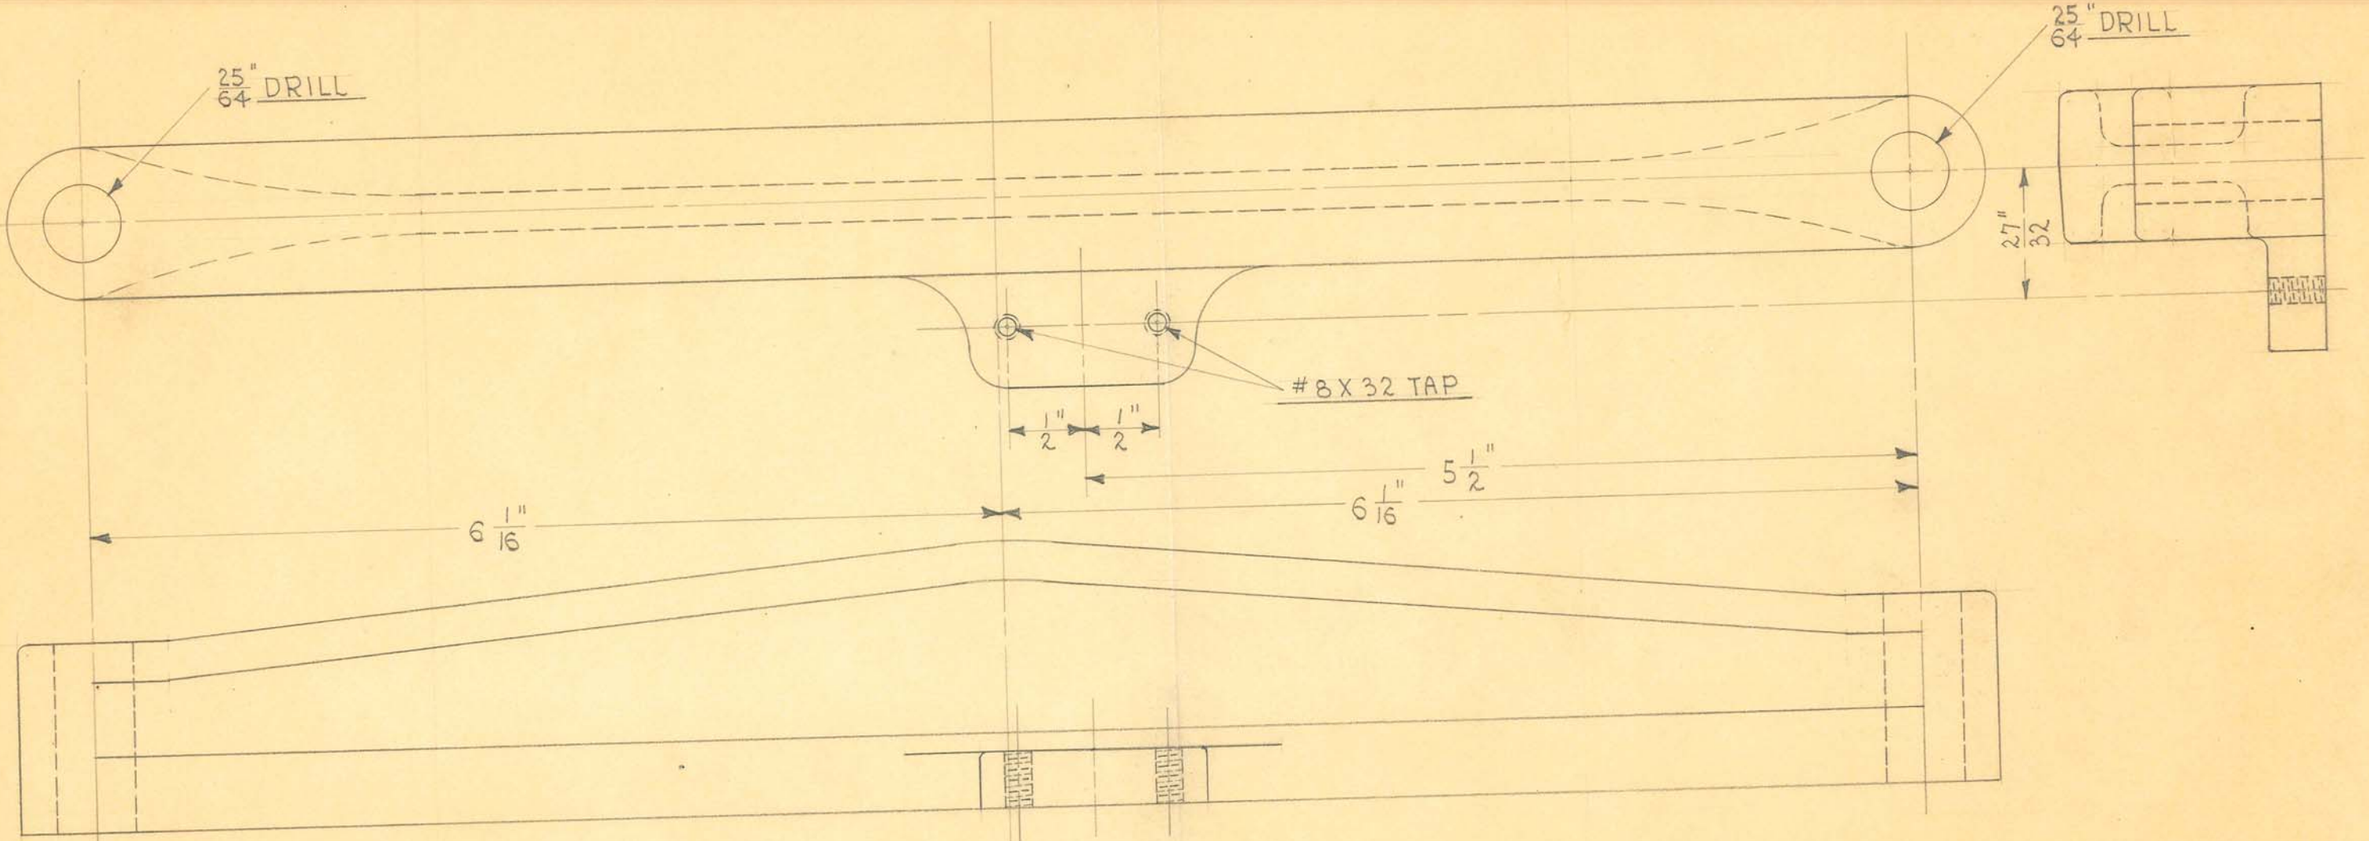

1 REQUIRED

OBSOLETE

SIZE		ISSUE 12-9-37	A.E.
KIND	IRON CASTING	CHANGED	
SHAPE		"	
FINISH		"	
TEMP.		"	
PATT.	8697-1184	"	

TITLE: MODEL "100-100" TRANSFORMER CLAMP-LEFT

H. G. FISCHER & CO.
2335 WABANSIA AVE.
CHICAGO, ILL.

CAT. NO.

PART NO. 10622AF

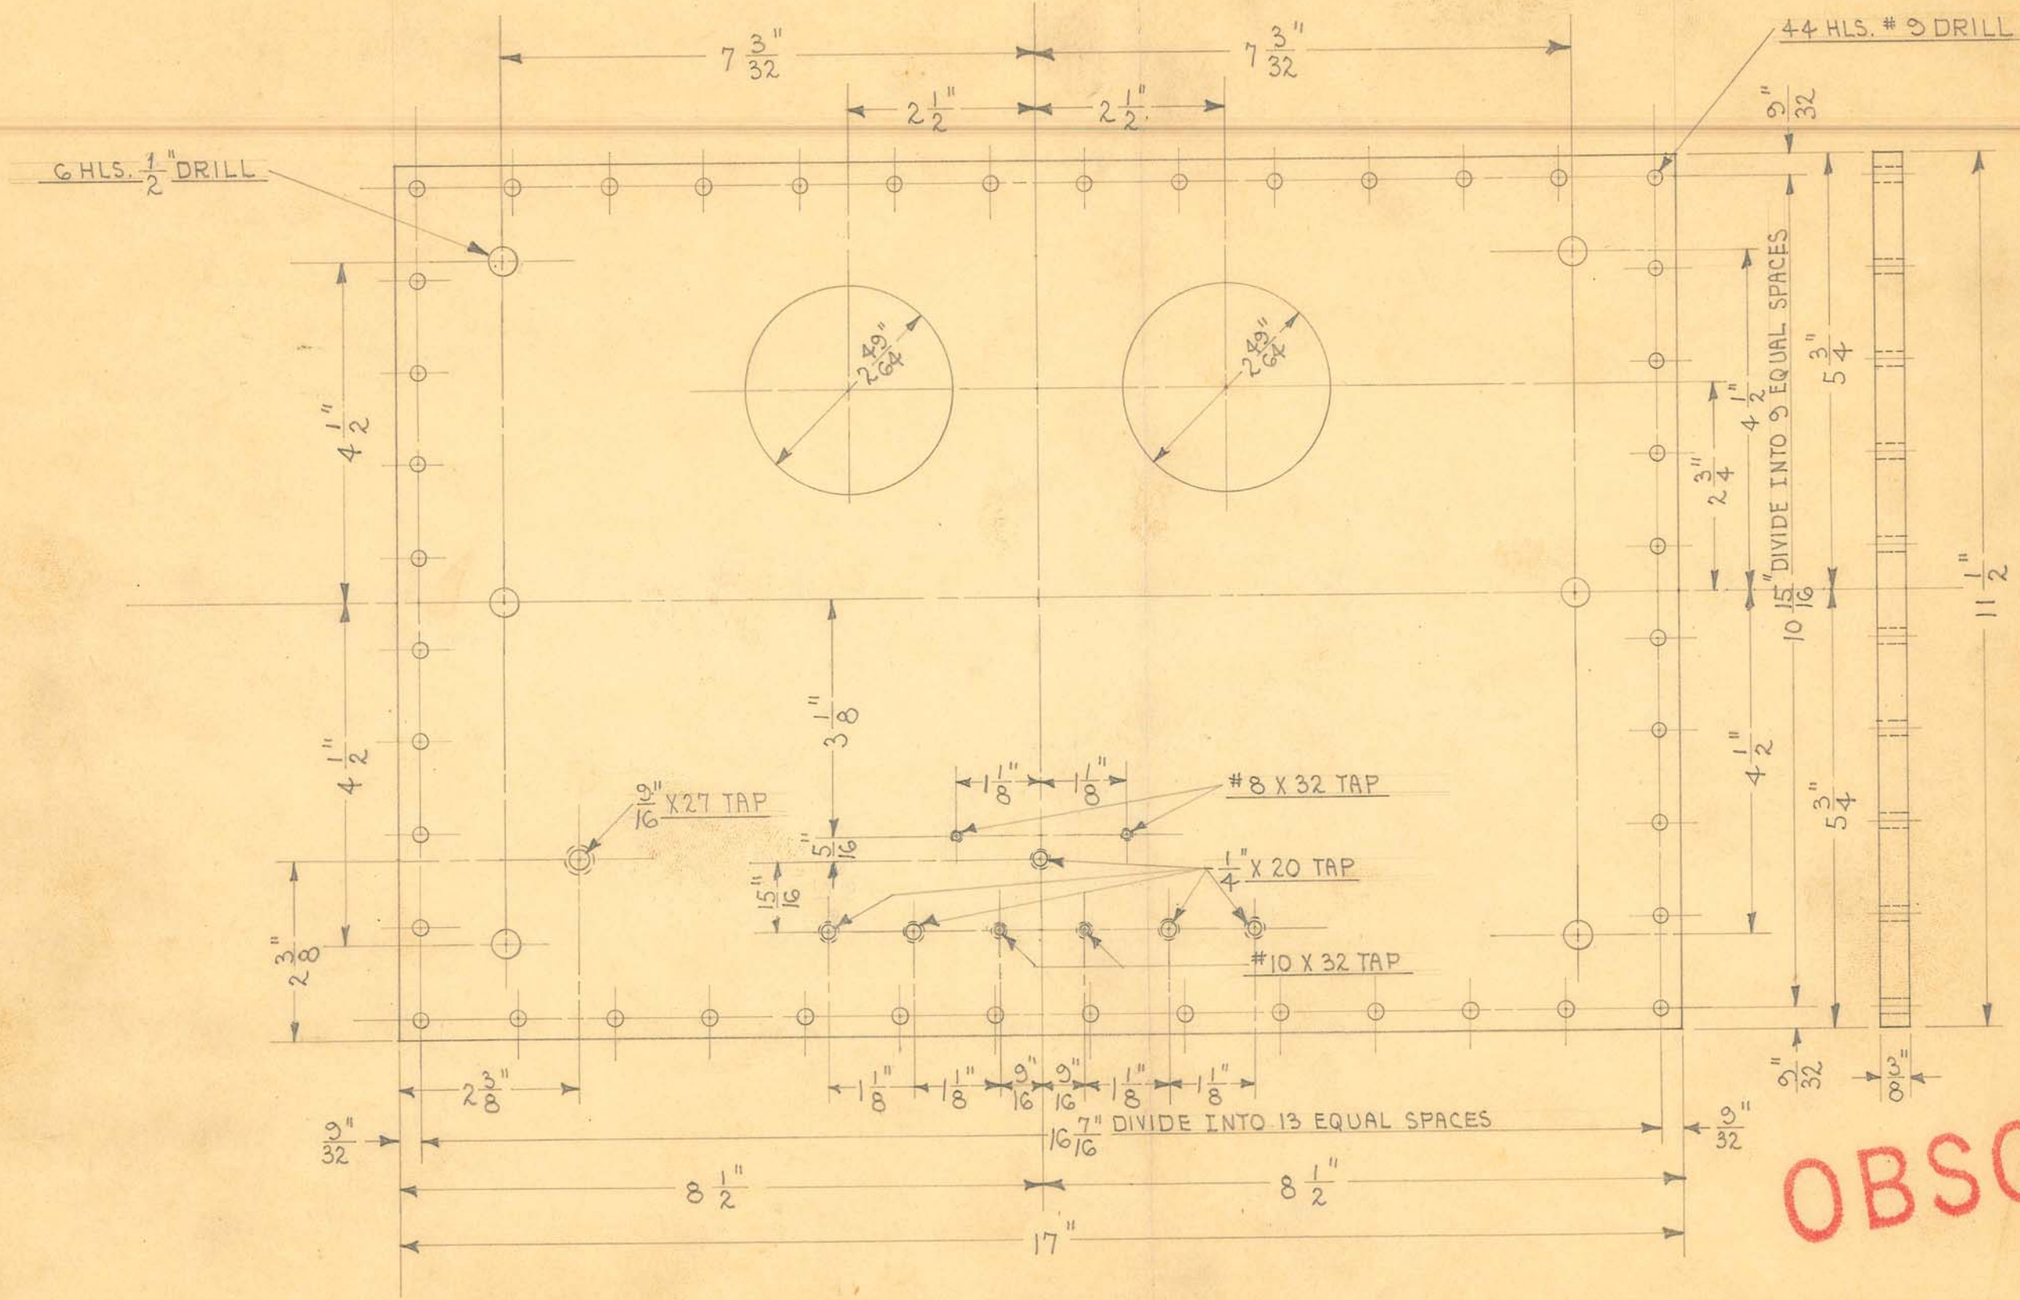

SCALE: 1/2" = 1"

SIZE	11½"X17"X3/8"	ISSUE 2-10-37	A.E.
KIND	BAKELITE	CHANGED	
SHAPE	SHEET	" 12-14-37	A.E.
FINISH		"	
TEMP.		"	
PATT.		"	

TITLE: MODEL "100-100" TRANSFORMER PANEL

H. G. FISCHER & CO.
2335 WABANSIA AVE.
CHICAGO, ILL.

CAT. NO.

PART NO. 10623A

OBSOLETE

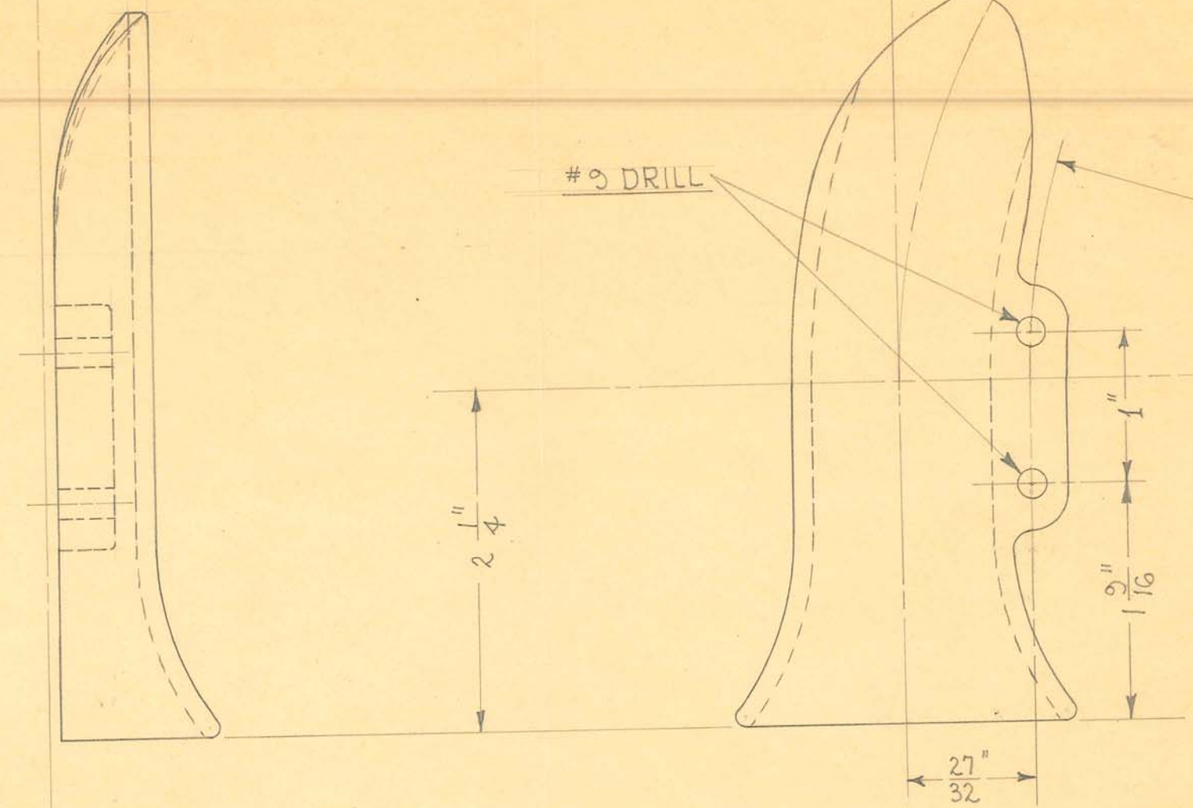

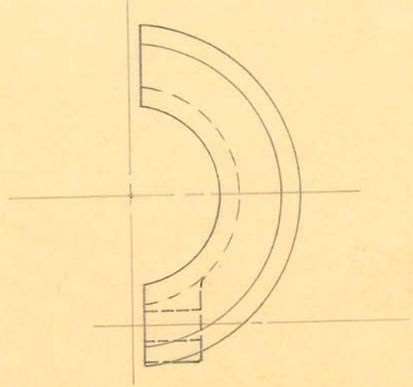

2 REQUIRED

OBSOLETE

SIZE		ISSUE 4-19-37	A.E.
KIND	ALUM. CASTING	CHANGED	
SHAPE		"	
FINISH	KRIST. #55	"	
TEMP.		"	
PATT.	421-1095	"	

TITLE: MODEL "100-100" TRANSFORMER END H.T. CABLE CLAMP - RIGHT

H. G. FISCHER & CO.
2335 WABANSIA AVE.
CHICAGO. ILL.

CAT. NO.

PART NO. 10665F

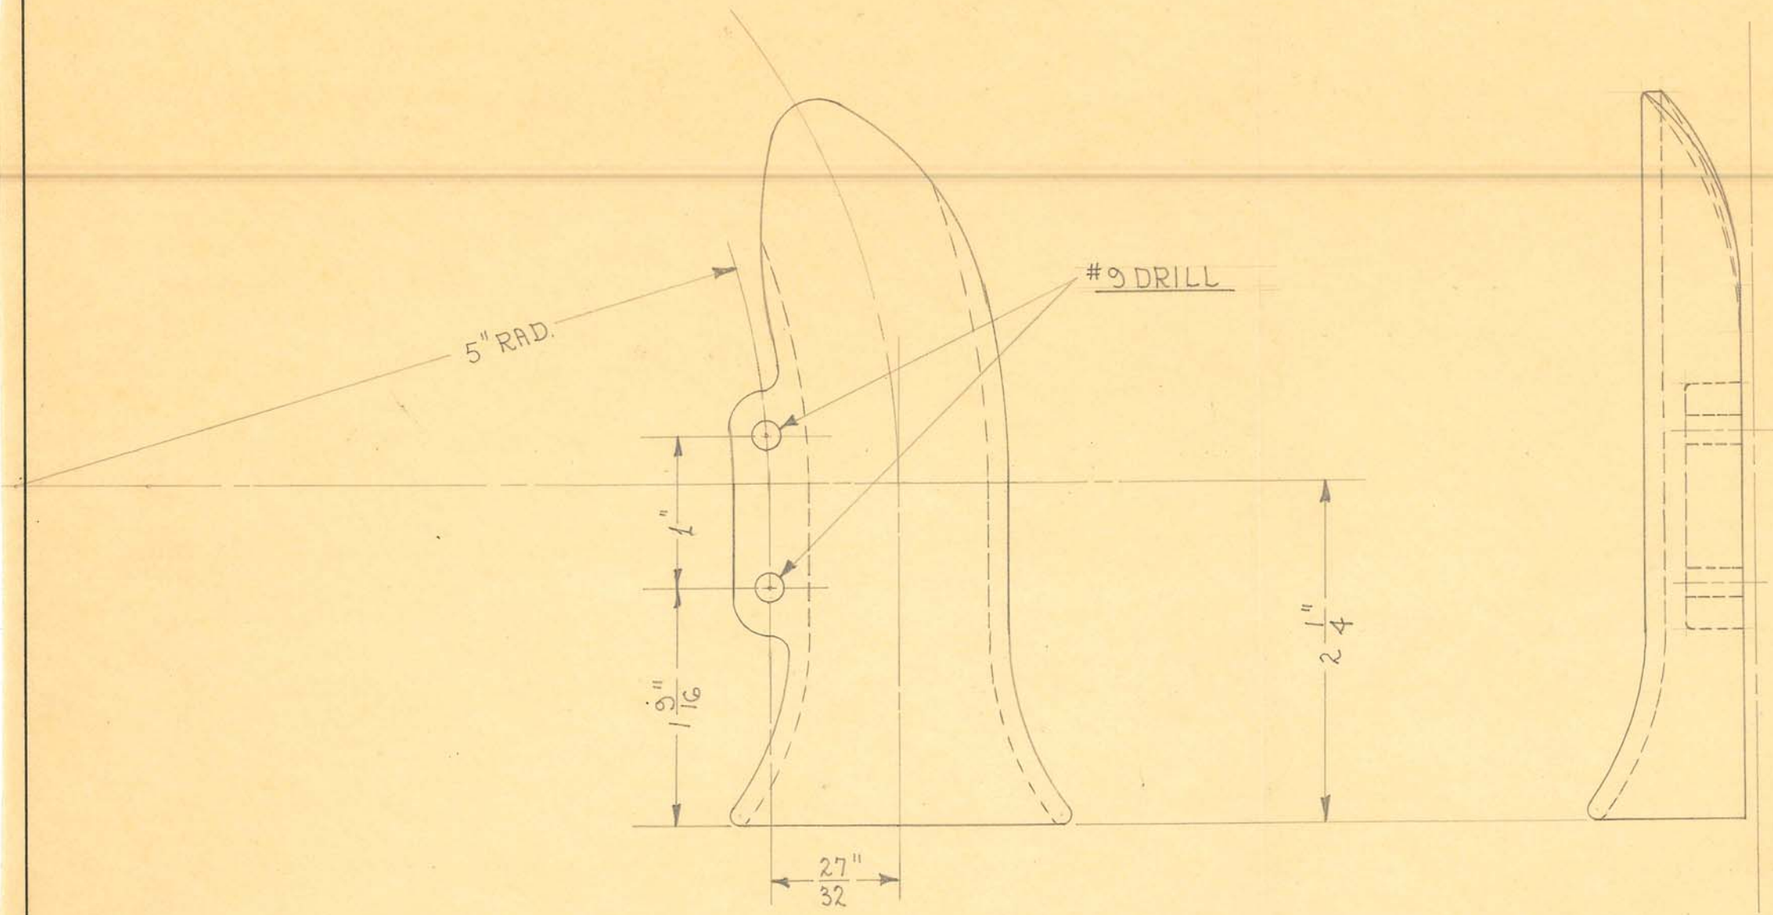

2 REQUIRED

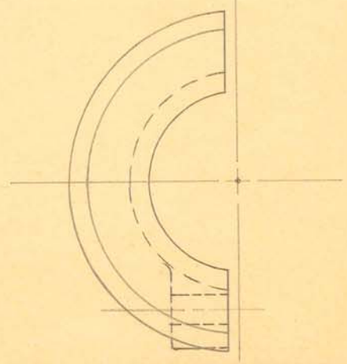

OBSOLETE

SIZE		ISSUE 4-19-37	A.E.
KIND	ALUM. CASTING	CHANGED	
SHAPE		"	
FINISH	KRIST. #55	"	
TEMP.		"	
PATT.	420-1096	"	

TITLE: MODEL "100-100" TRANSFORMER END H. T. CABLE CLAMP - LEFT

H. G. FISCHER & CO. 2335 WABANSIA AVE. CHICAGO, ILL.	CAT. NO.	PART NO. 106666F

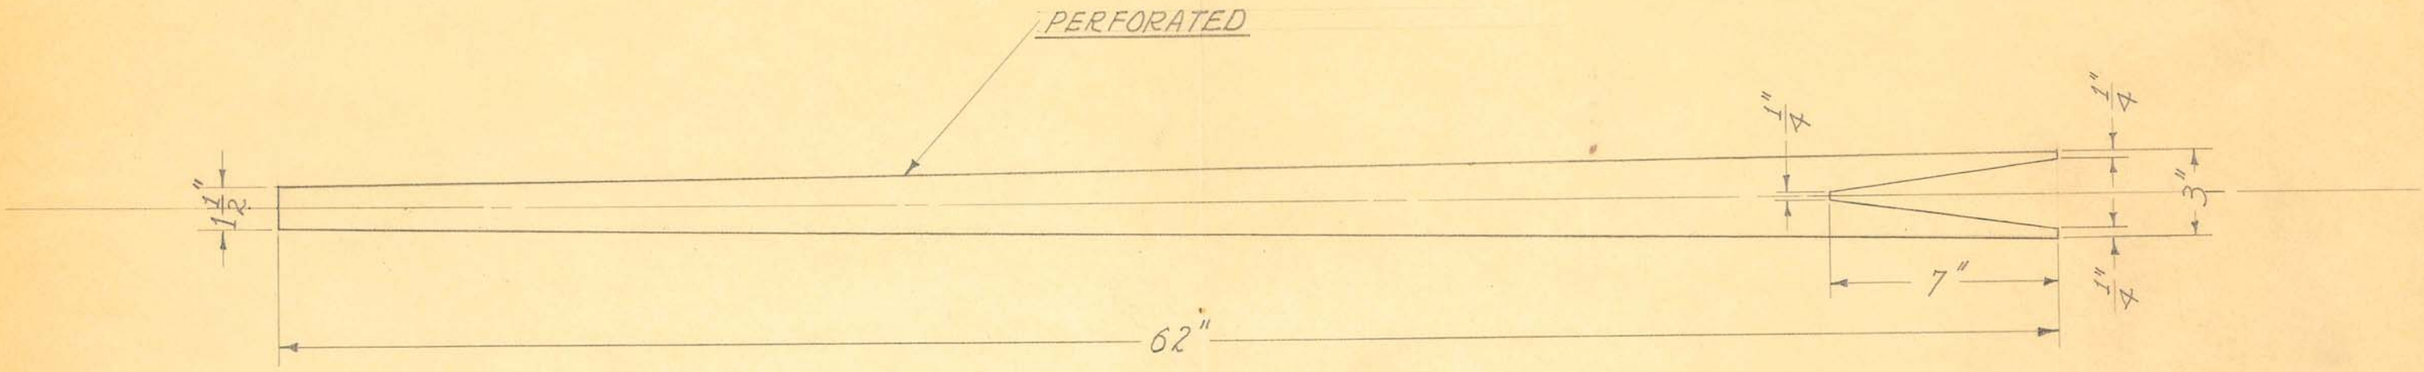

SCALE ÷ 3"/16 = 1"

2 REQUIRED

OBSOLETE

SIZE	.010" SHEET	ISSUE 4-8-37	J.W.	TITLE: MODEL "100-100" H.T. CABLE TRANSF.— STRESS CONE STRIP
KIND	OILED CLOTH	CHANGED		
SHAPE		"		
FINISH		"		
TEMP.		"		
PATT.		"		

H. G. FISCHER & CO.
2335 WABANSIA AVE.
CHICAGO, ILL.

CAT. NO.

PART NO. 10679

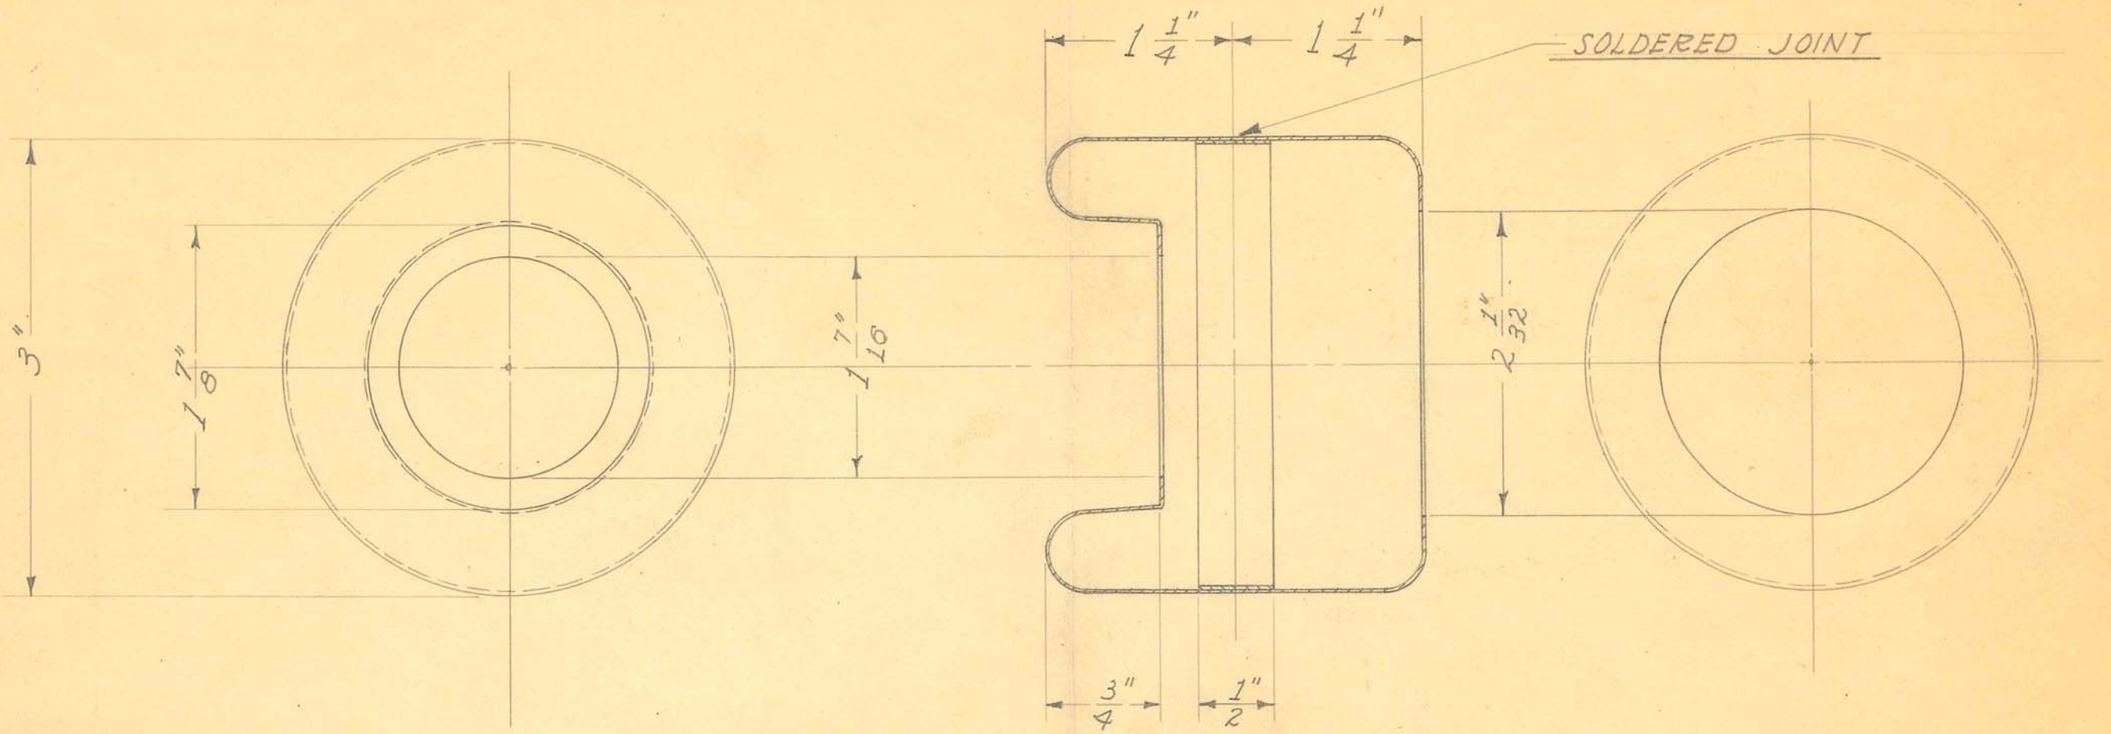

SPIN FROM #20 B.&S. GAUGE SHEET BRASS

OBSOLETE

SIZE		ISSUE 5-13-37	J.W.	
KIND		CHANGED		
SHAPE		"		
FINISH		"		
TEMP.		"		
PATT.		"		

TITLE: FISCHER MOD. "100-100" "X"-RAY TUBE SOCKET HOUSING

H. G. FISCHER & CO.
2335 WABANSIA AVE.
CHICAGO, ILL.

CAT. NO.

PART NO. 10686

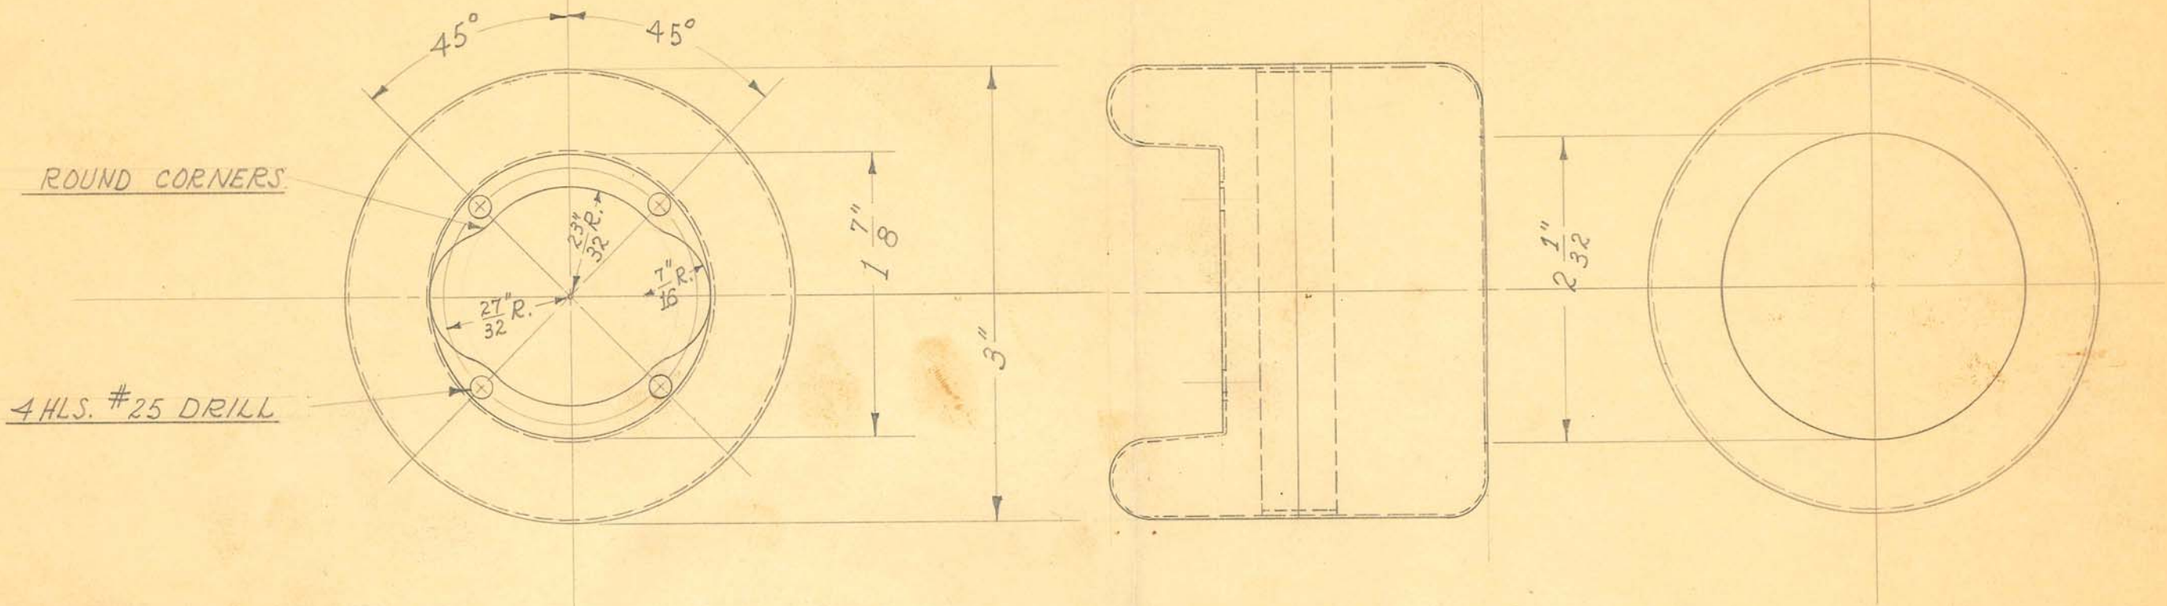

1 REQUIRED

OBSOLETE

SIZE		ISSUE 5-12-37	J.W.	TITLE: FISCHER MOD. "100-100" "X"-RAY TUBE SOCKET HOUSING
KIND		CHANGED		
SHAPE		"		
FINISH	BLACK #80	"		
TEMP.		"		
PATT.		"		

H. G. FISCHER & CO.
2335 WABANSIA AVE.
CHICAGO, ILL.

CAT. NO.

PART NO. 10686F

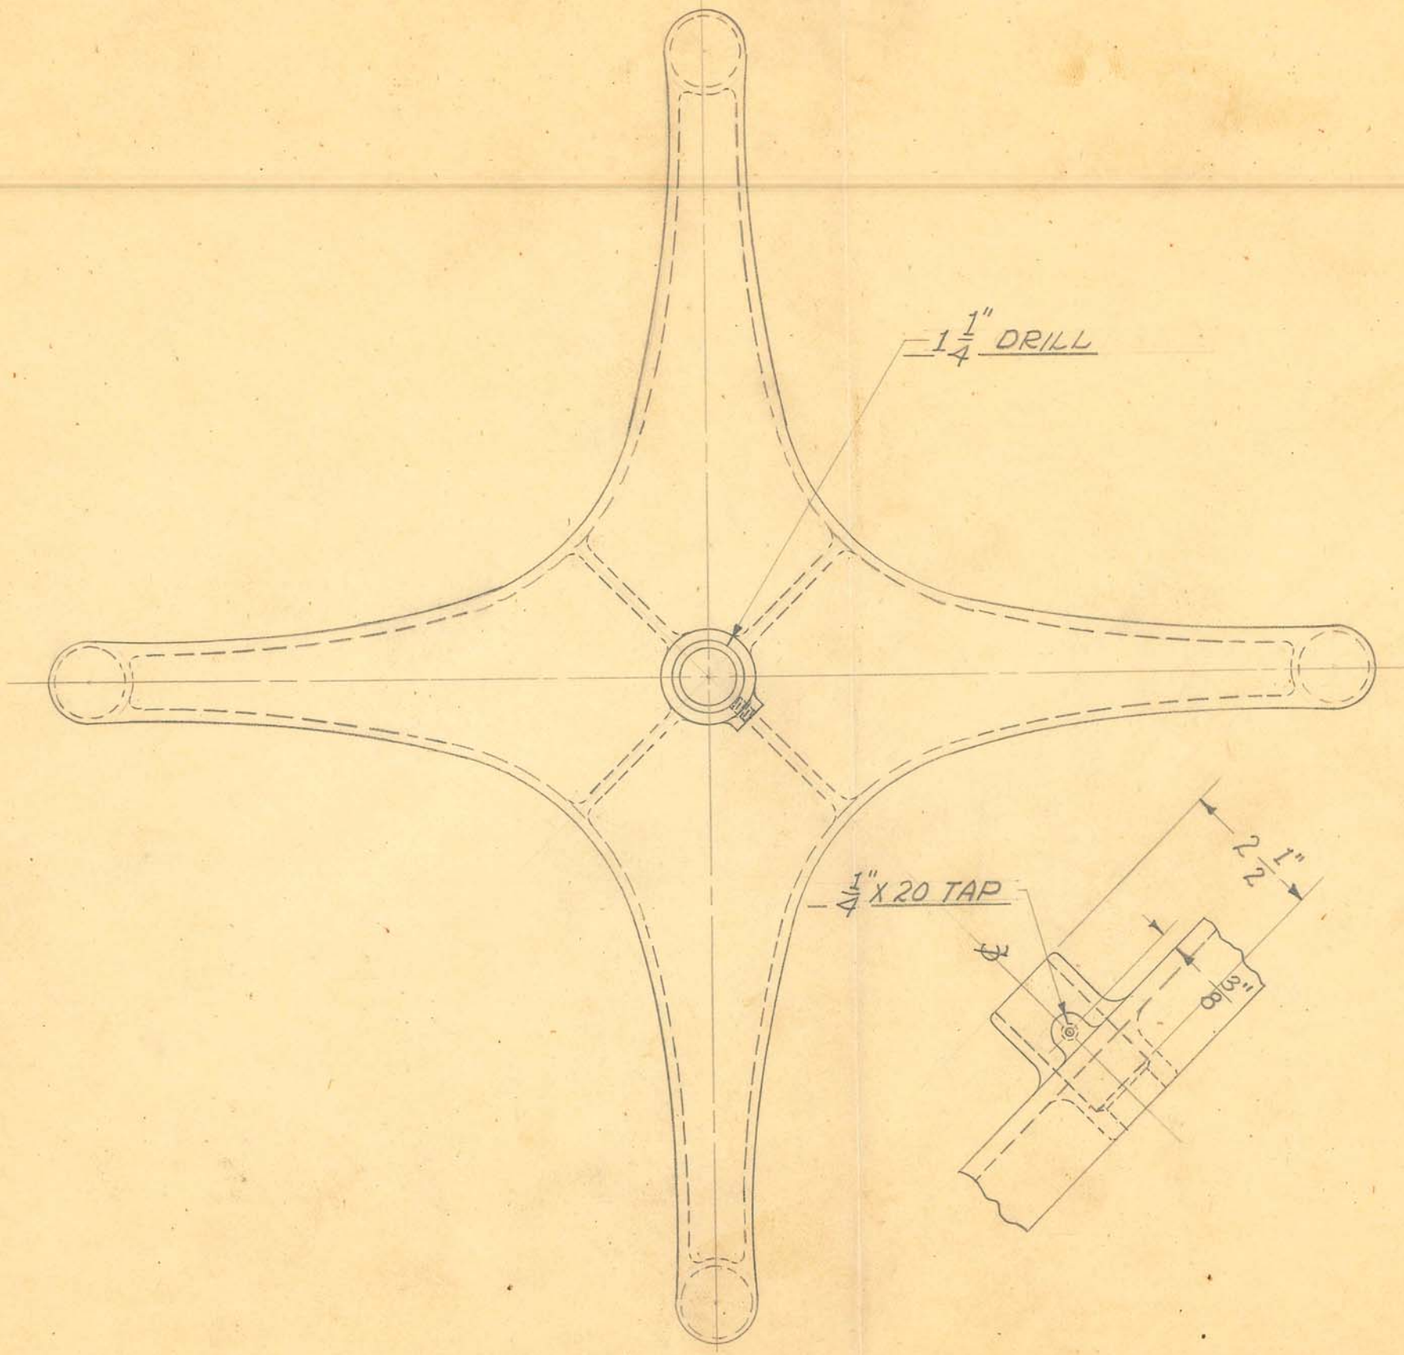

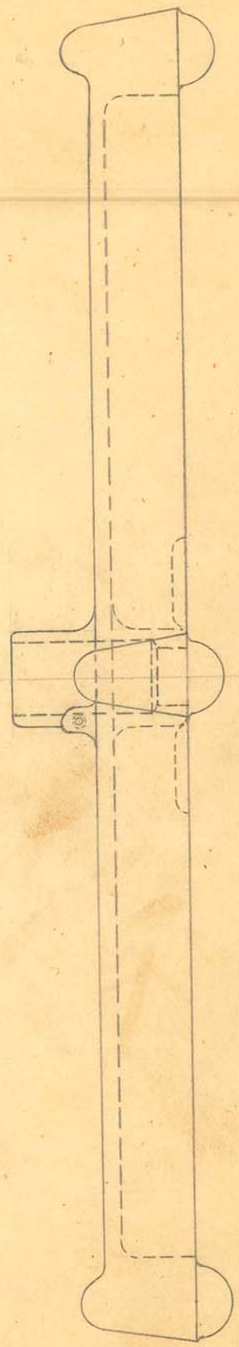

OBSOLETE

SCALE ÷ 3/8" = 1"

SIZE		ISSUE 4-22-37	J.W.	
KIND	IRON CASTING	CHANGED		
SHAPE		"		
FINISH	KRIST. #55	"		
TEMP.		"		
PATT.	628-1101	"		

TITLE: CONDENSER ELECTRODE HOLDER BASE

H. G. FISCHER & CO.
2335 WABANSIA AVE.
CHICAGO, ILL.

CAT. NO.

PART NO. 10710F

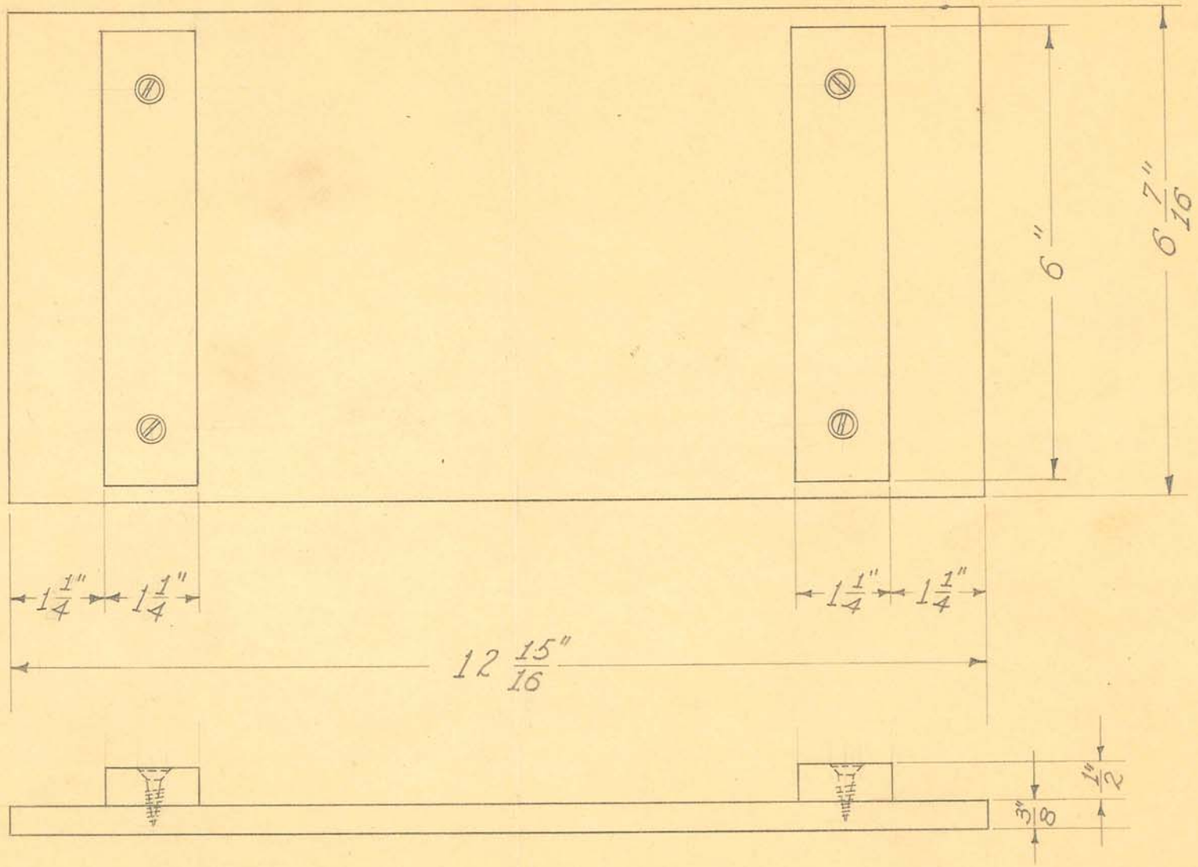

SCALE ÷ 1/2" = 1"

OBSOLETE

SIZE	3/8" LAMINATED	ISSUED 5-4-37	J.W.	TITLE: SHORT WAVE OSCILLATING TUBE TESTER – BASE – BLANK
KIND	VENEER	CHANGED		
SHAPE		"		
FINISH	SHELLAC	"		
TEMP.		"		
PATT.		"		

H. G. FISCHER & CO.
2335 WABANSIA AVE.
CHICAGO, ILL.

CAT. NO.

PART NO. 10726G

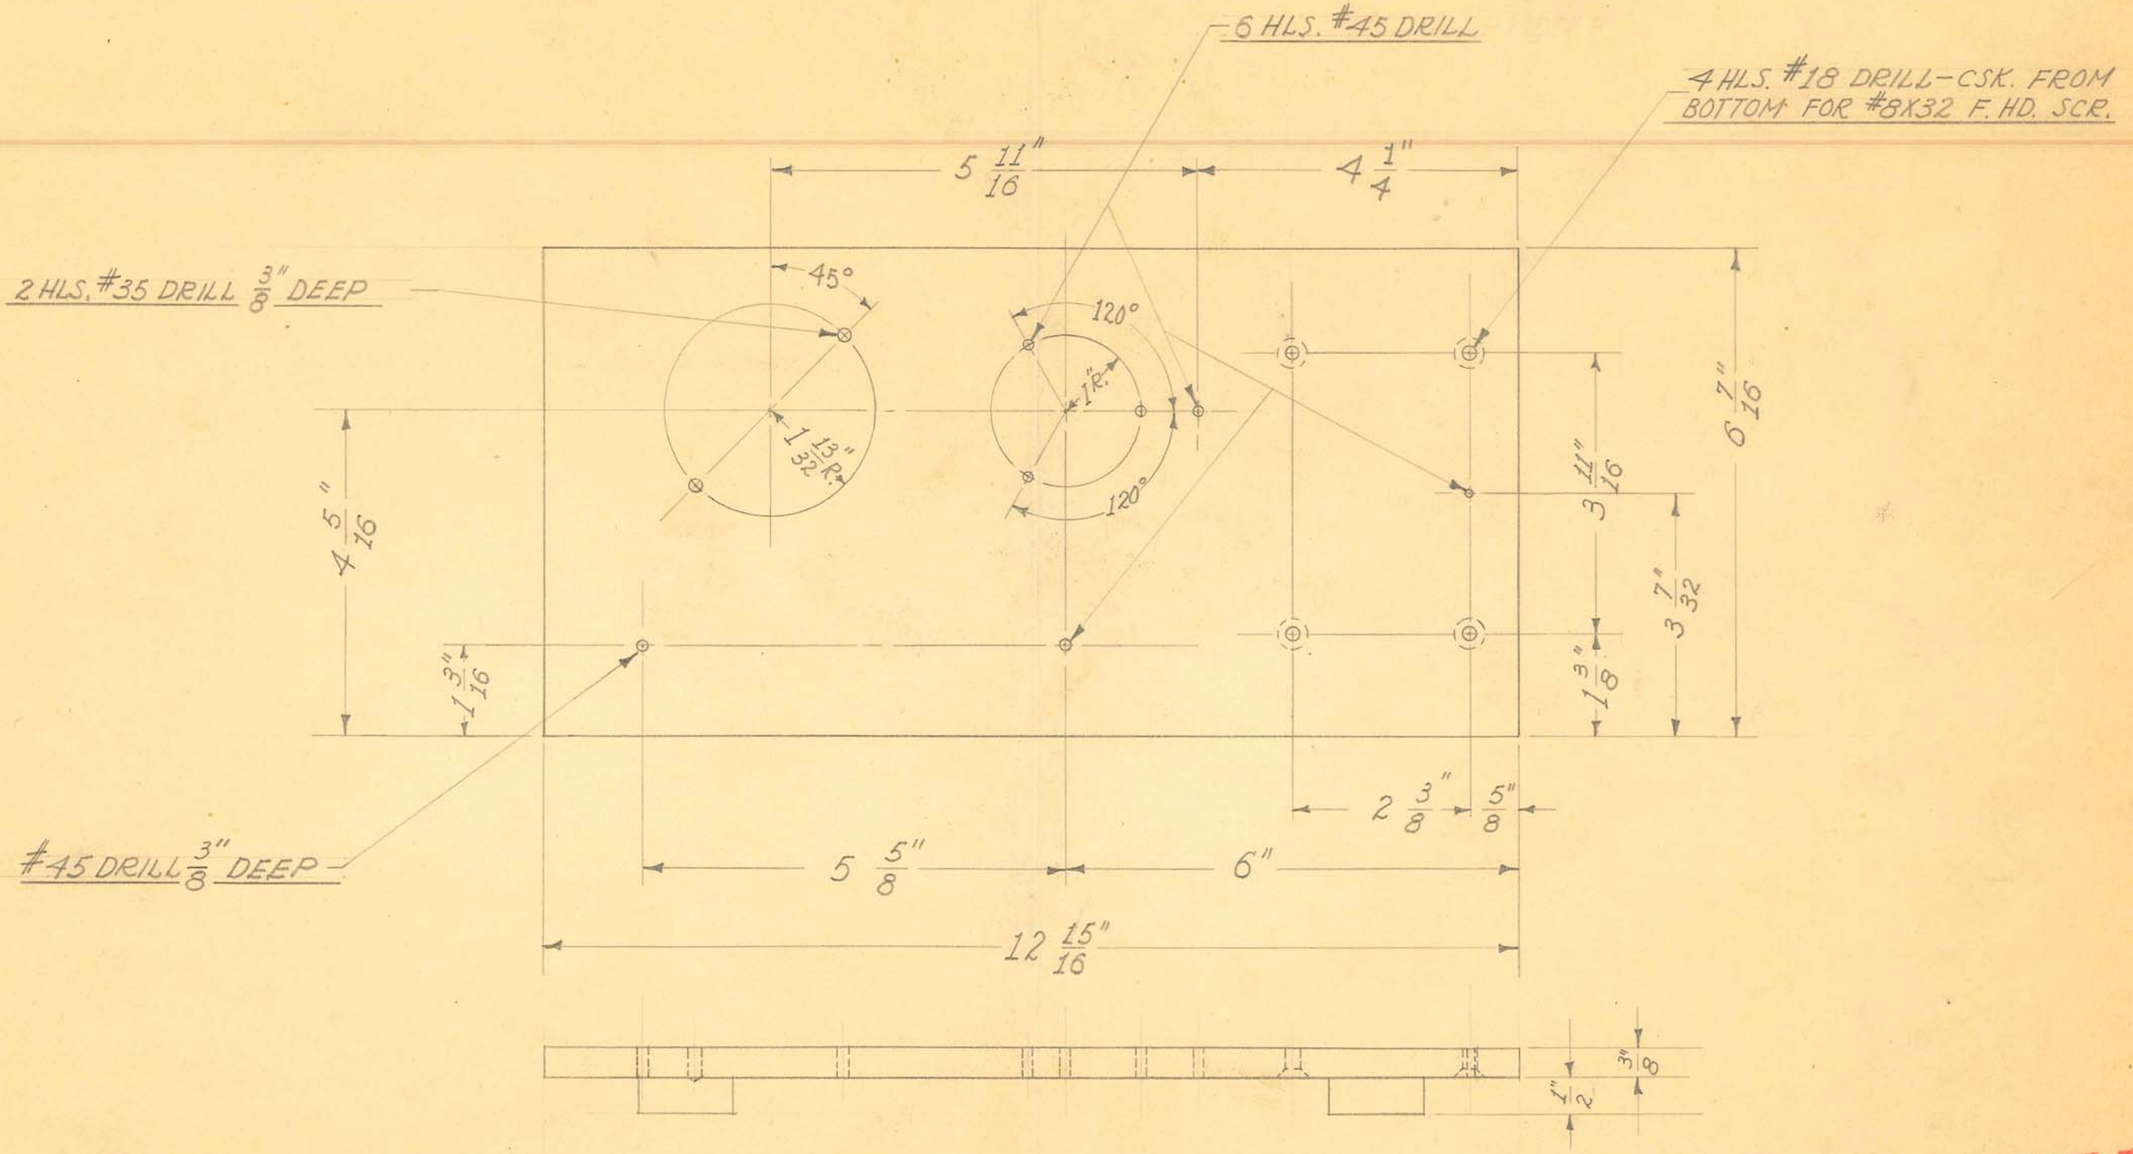

SCALE ÷ 1/2" = 1"

1 REQUIRED

OBSOLETE

SIZE		ISSUE 5-4-37	J.W.
KIND		CHANGED	
SHAPE		"	
FINISH		"	
TEMP.		"	
PATT.		"	

TITLE: SHORT WAVE OSCILLATING TUBE TESTER BASE.

H. G. FISCHER & CO.
2335 WABANSIA AVE.
CHICAGO, ILL.

CAT. NO.

PART NO. 10726GF

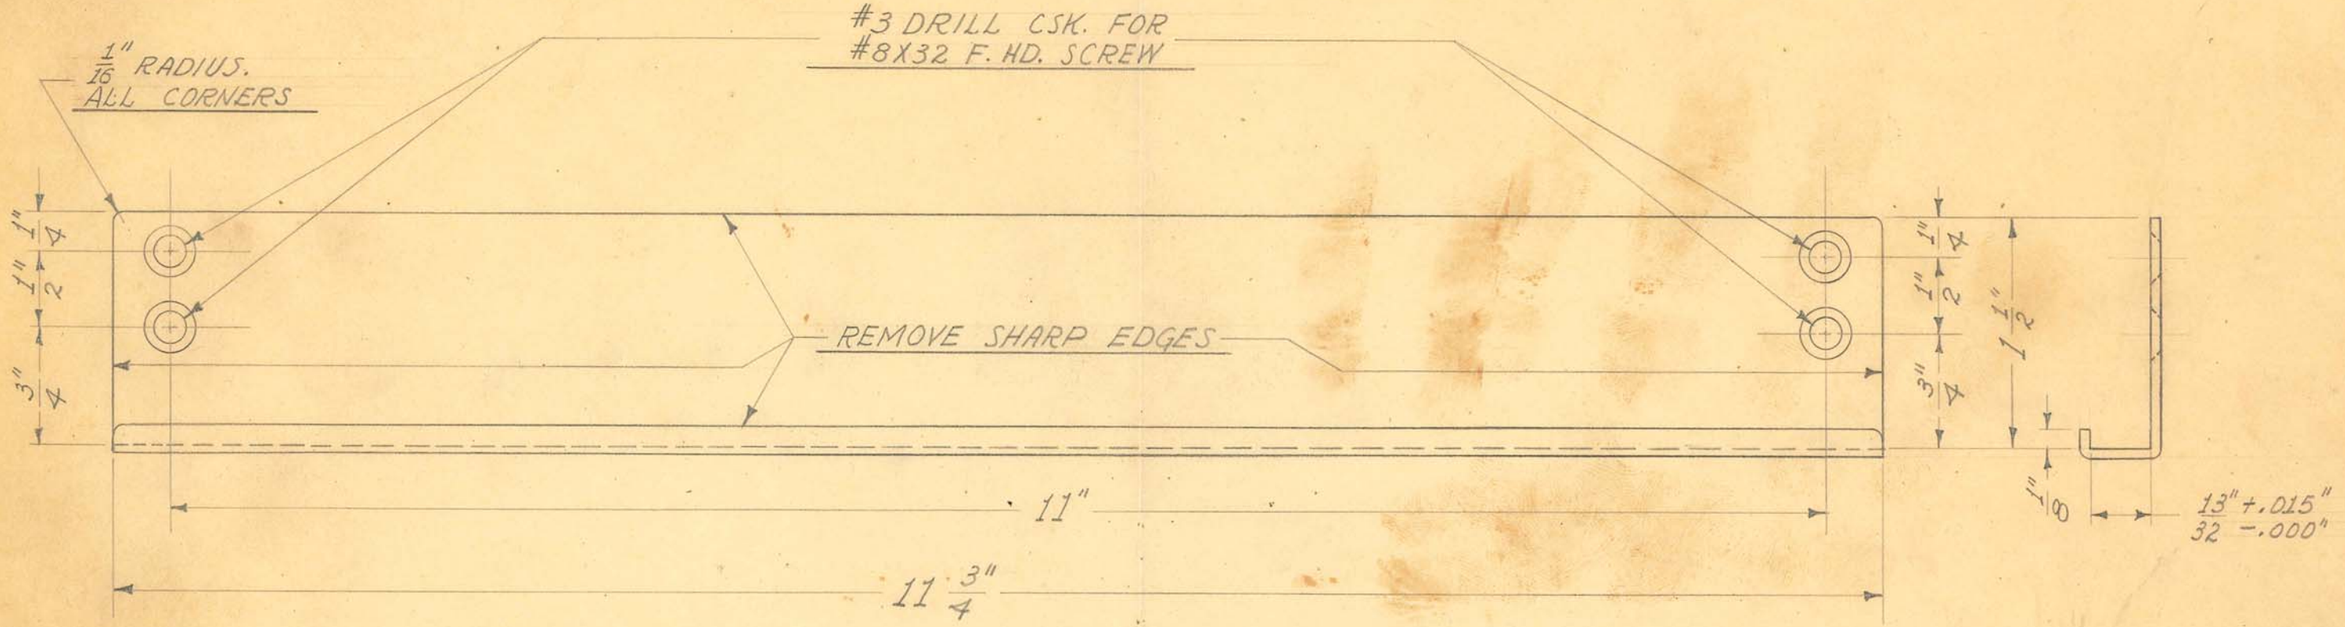

1 REQUIRED

OBSOLETE

SIZE		ISSUE 6-9-37	J.W.	TITLE: IMMOBILIZING & COMPRESSION ATTACHMENT - MOUNTING STRIP (DRILLED)
KIND		CHANGED		
SHAPE		"		
FINISH	CAD. #23	"		
TEMP.		"		
PATT.		"		

H. G. FISCHER & CO.
2335 WABANSIA AVE.
CHICAGO, ILL.

CAT. NO.

PART NO. 10731

10731

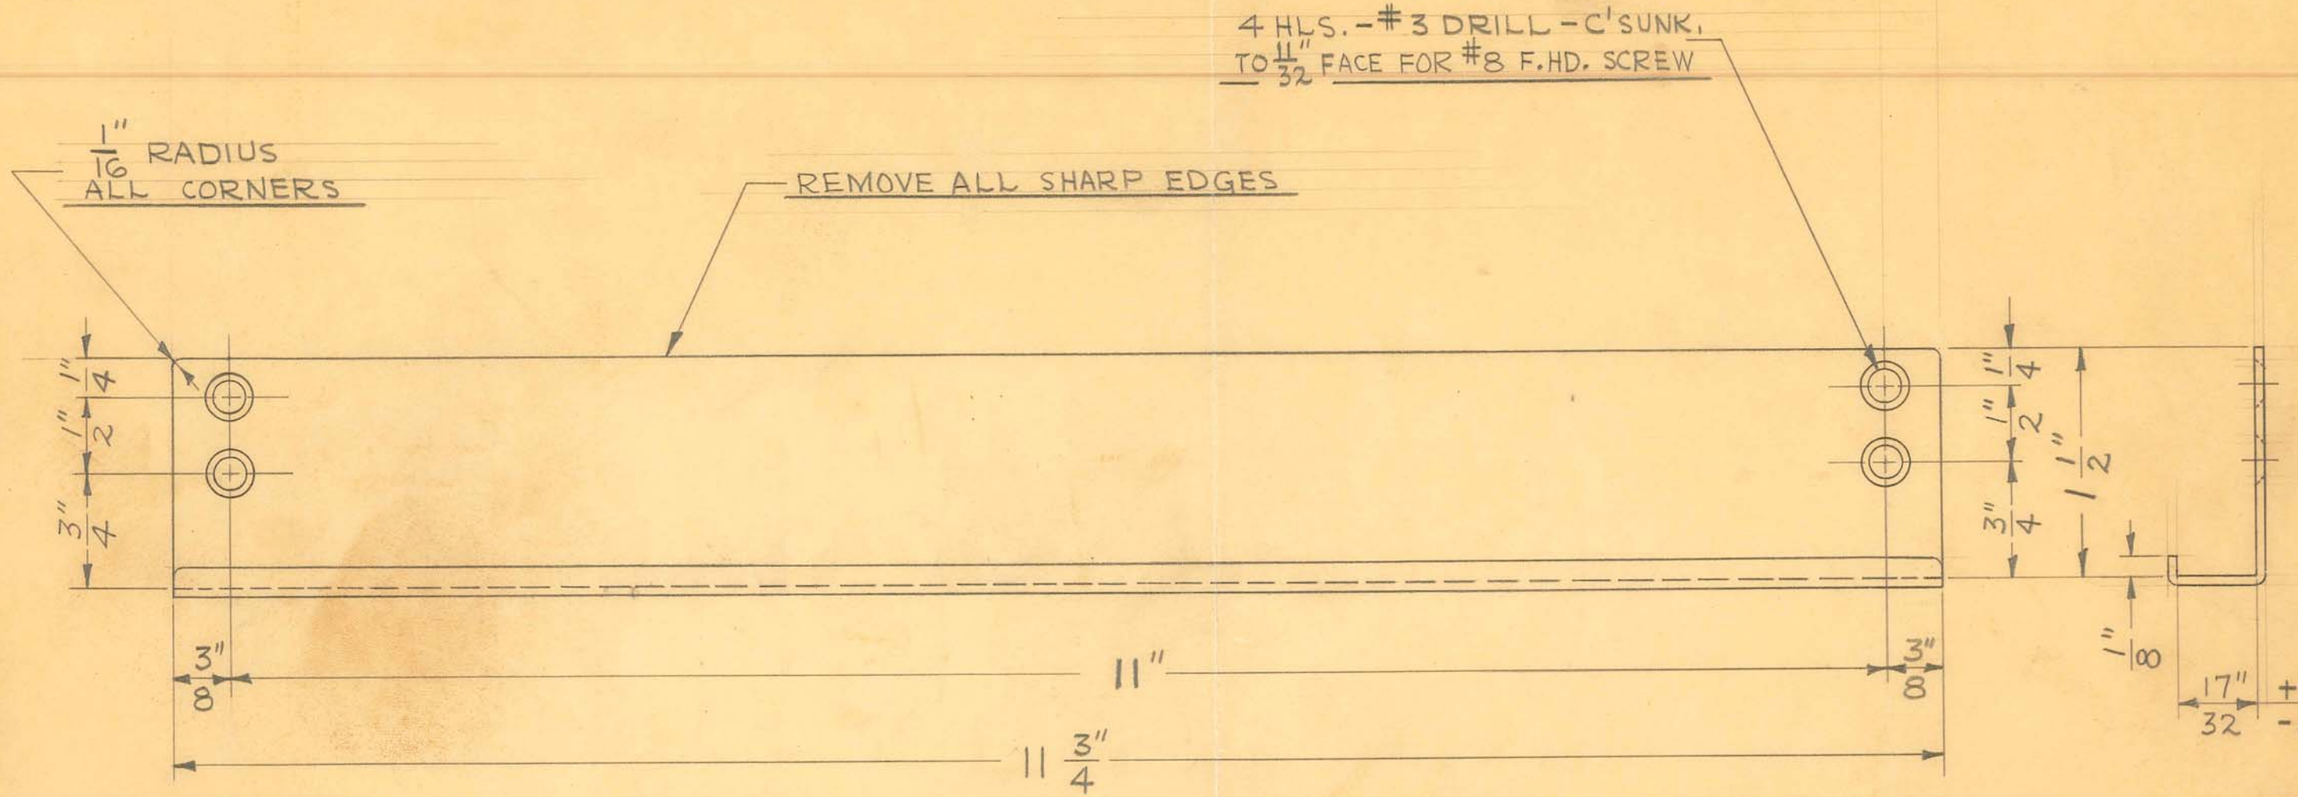

1 REQUIRED

OBSOLETE

SIZE	#16GA.(.062")	ISSUE 11-9-46	J.V.W.
KIND	C.R.STEEL	CHANGED	
SHAPE	SHEET	"	
FINISH	CAD.#23	"	
TEMP.		"	
PATT.		"	

TITLE: IMMOBILIZING & COMPRESSION ATTACHMENT - MOUNTING STRIP FOR 1/2" SIDE BAR

H. G. FISCHER & CO.
2338 WABANSIA AVE.
CHICAGO. ILL.

CAT. NO.

PART NO. 10731A

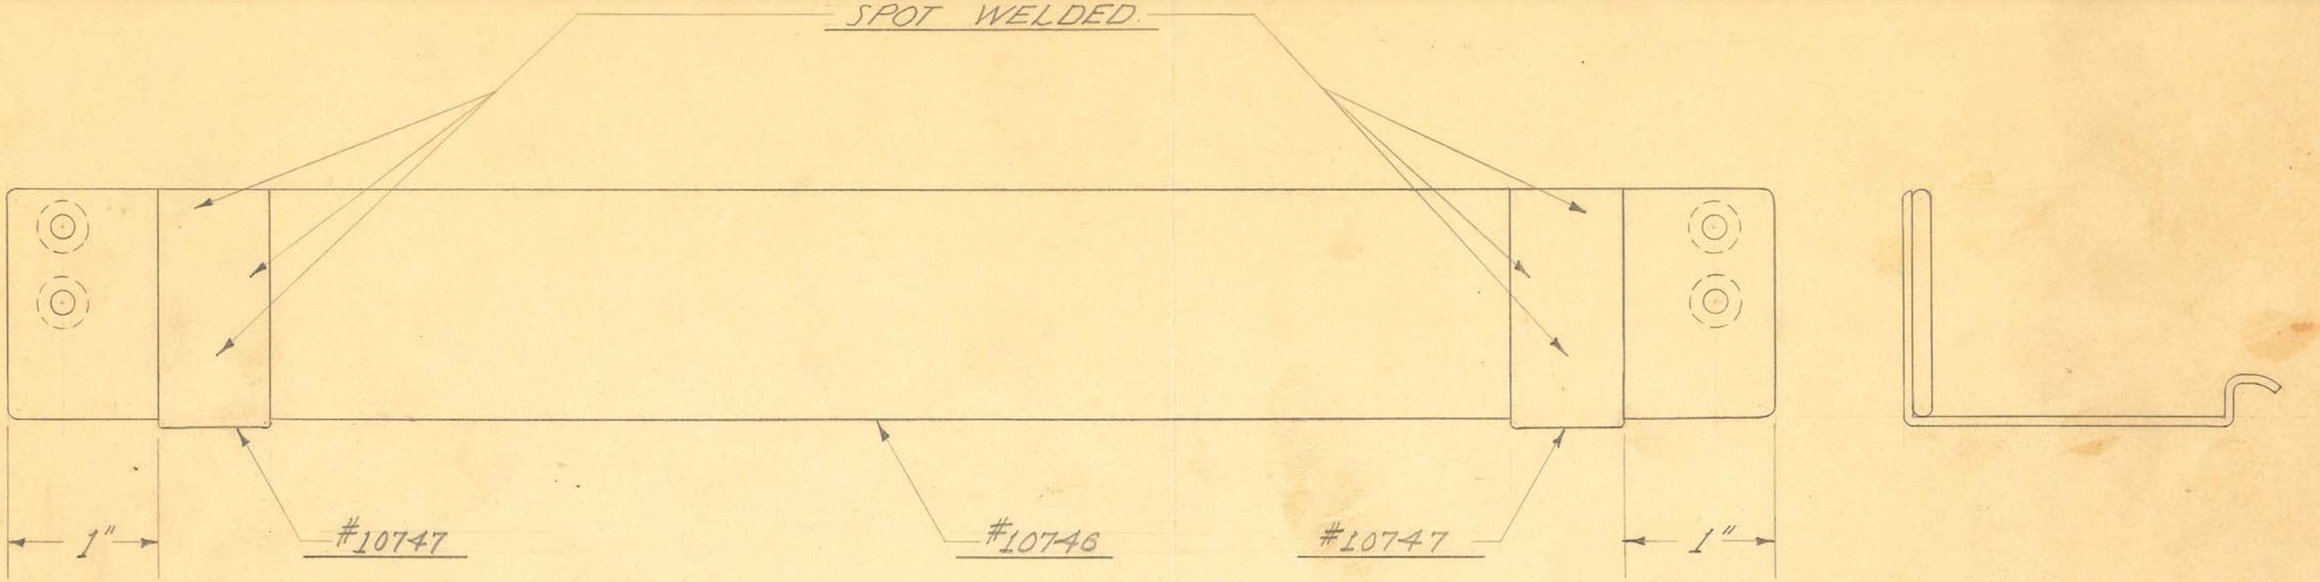

1 REQUIRED

OBSOLETE

SIZE		ISSUE 9-15-37	J.W.
KIND		CHANGED	
SHAPE		"	
FINISH	CAD. #23	"	
TEMP.		"	
PATT.		"	

TITLE: DOUBLE IMM. & COMP. ATTACH. FOR VERTICAL ADJ. ATTACH.-MTG. STRIP ASSEM.

H. G. FISCHER & CO.
2335 WABANSIA AVE.
CHICAGO, ILL.

CAT. NO.

PART NO. 10746G

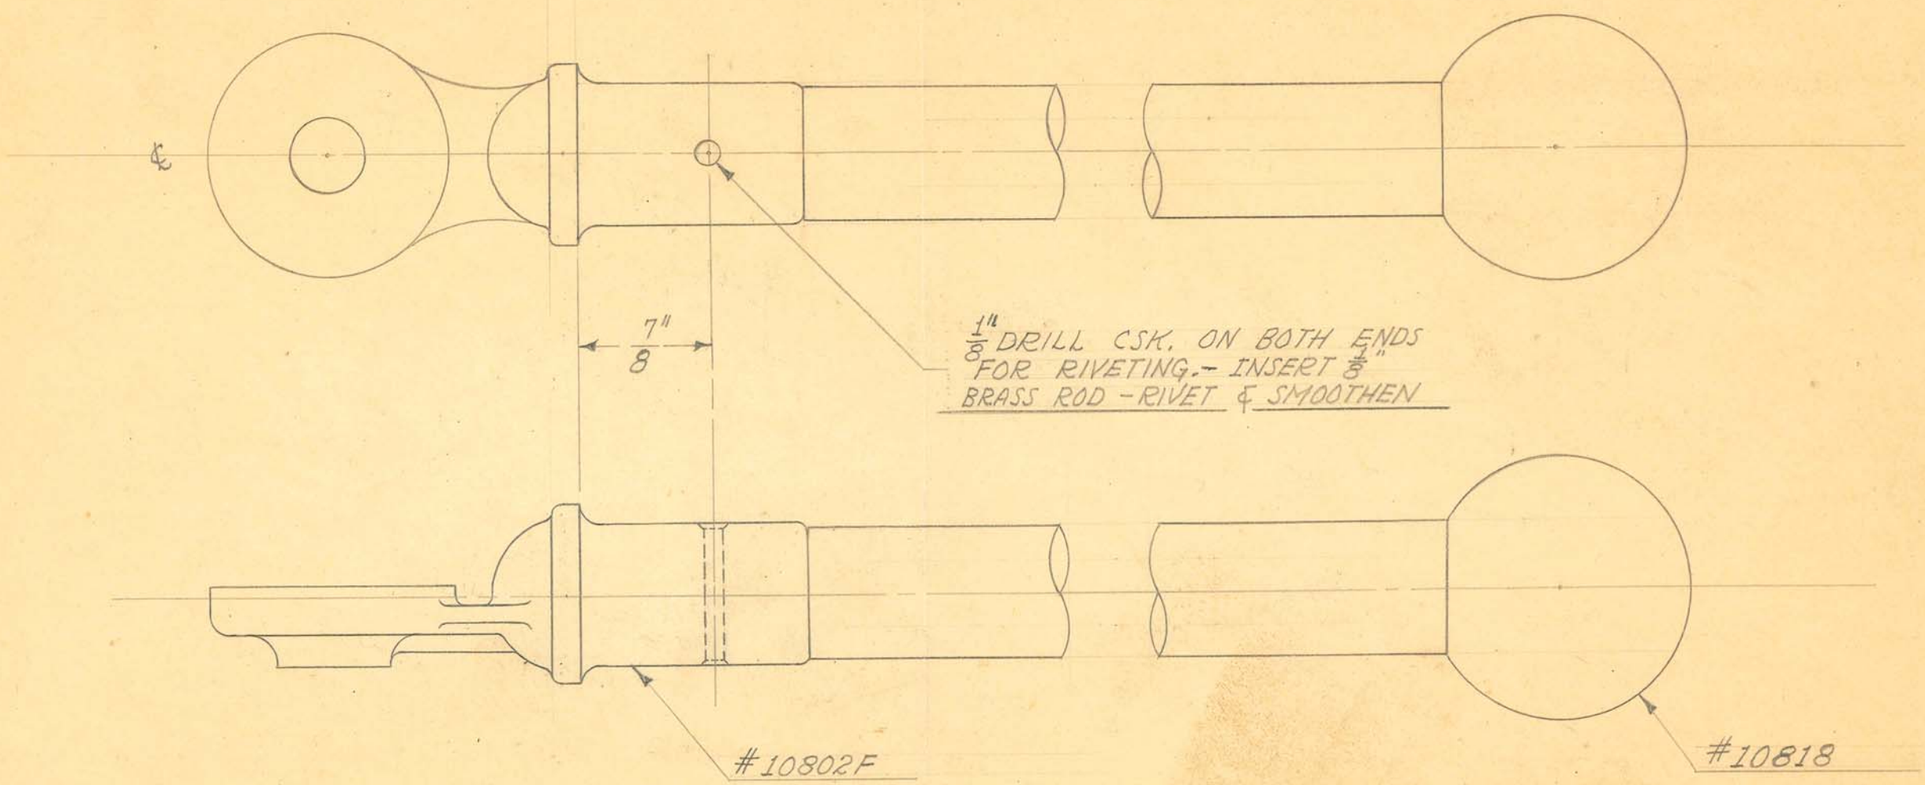

2 REQUIRED

OBSOLETE

SIZE		ISSUE 8-19-37	J.W.	TITLE: SHORT WAVE AIR SPACED ELECT. HOLDER SUPPORT ARM ASSEMBLY
KIND		CHANGED		
SHAPE		"		
FINISH	KRIST. #55	"		
TEMP.		"		
PATT.		"		

H. G. FISCHER & CO.
2335 WABANSIA AVE.
CHICAGO, ILL.

CAT. NO.

PART NO. 10819G

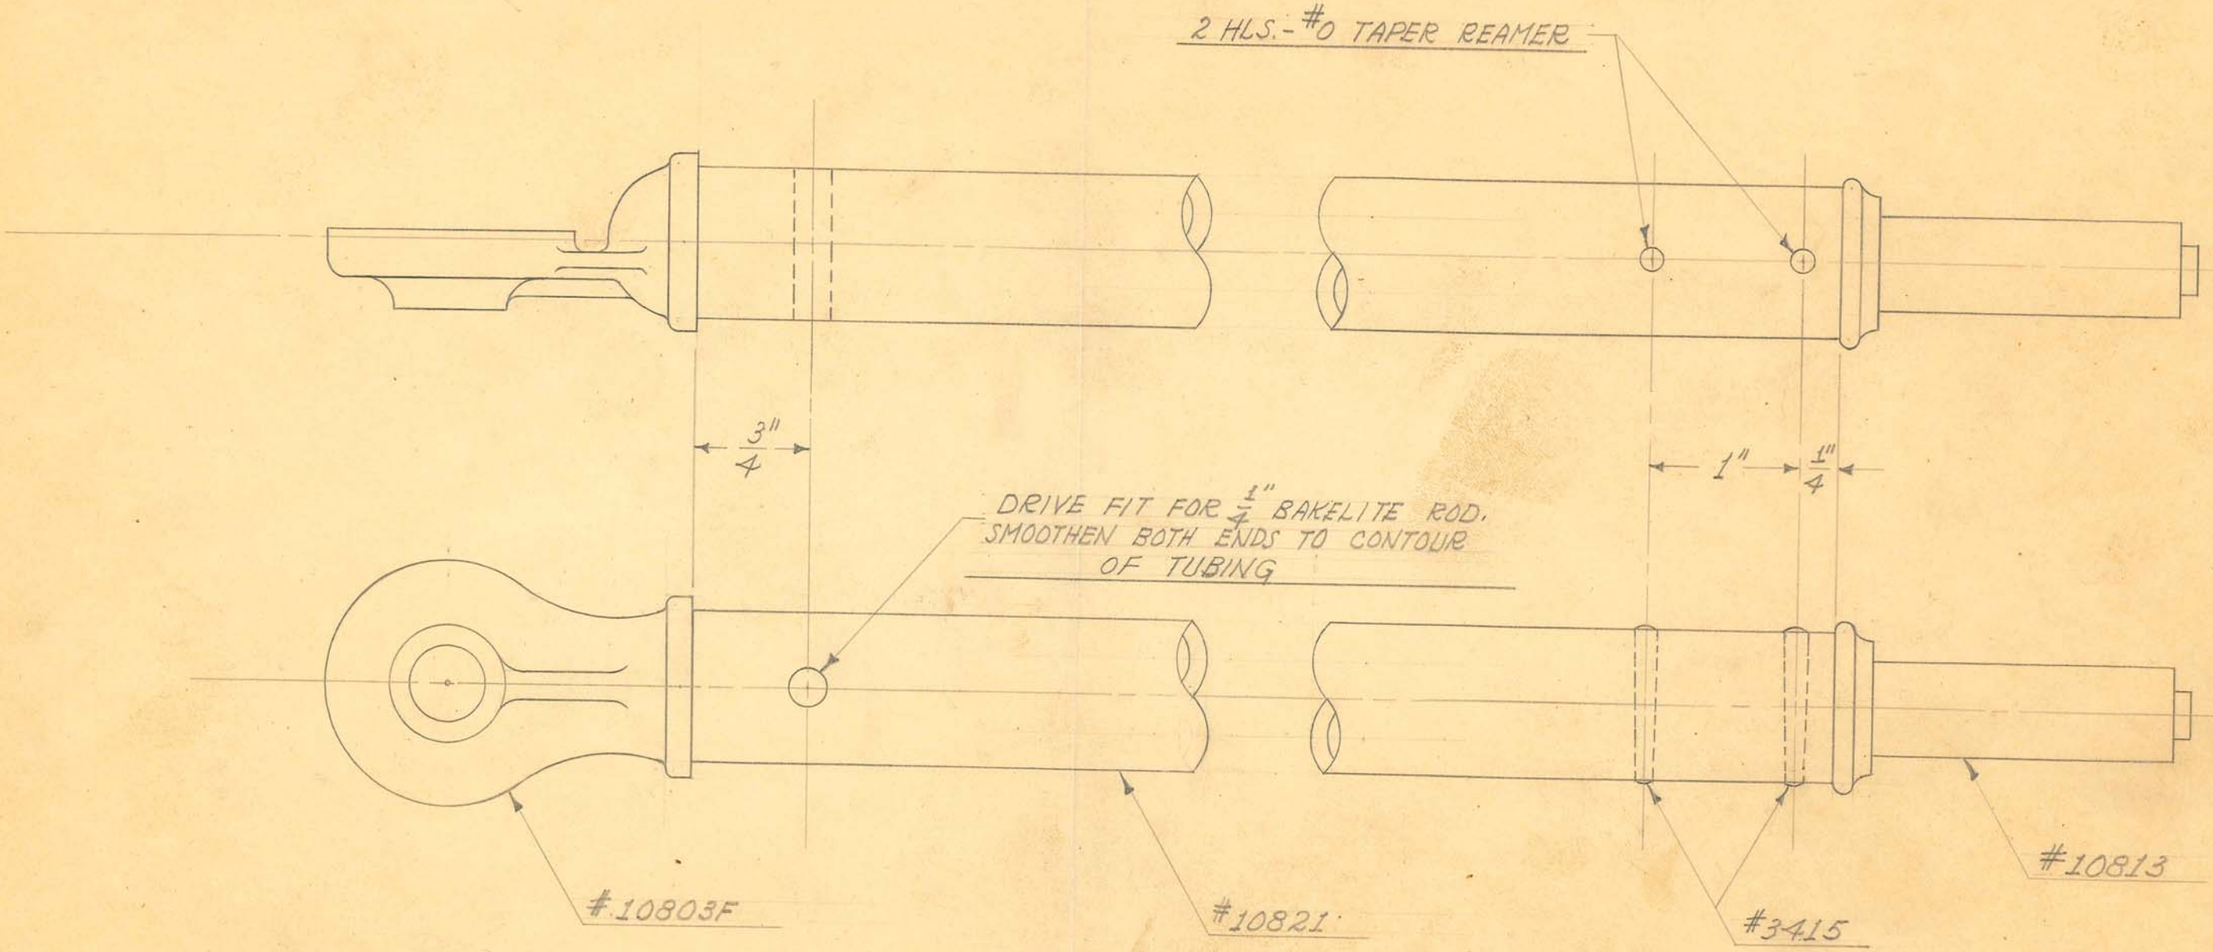

2 REQUIRED

OBSOLETE

SIZE		ISSUE 8-19-37	J.W.
KIND		CHANGED	
SHAPE		"	
FINISH		"	
TEMP.		"	
PATT.		"	

TITLE: SHORT WAVE AIR SPACED ELECT. HOLDER SUPPORT TUBE ASSEMBLY

H. G. FISCHER & CO.
2335 WABANSIA AVE.
CHICAGO, ILL.

CAT. NO.

PART NO. 10820G

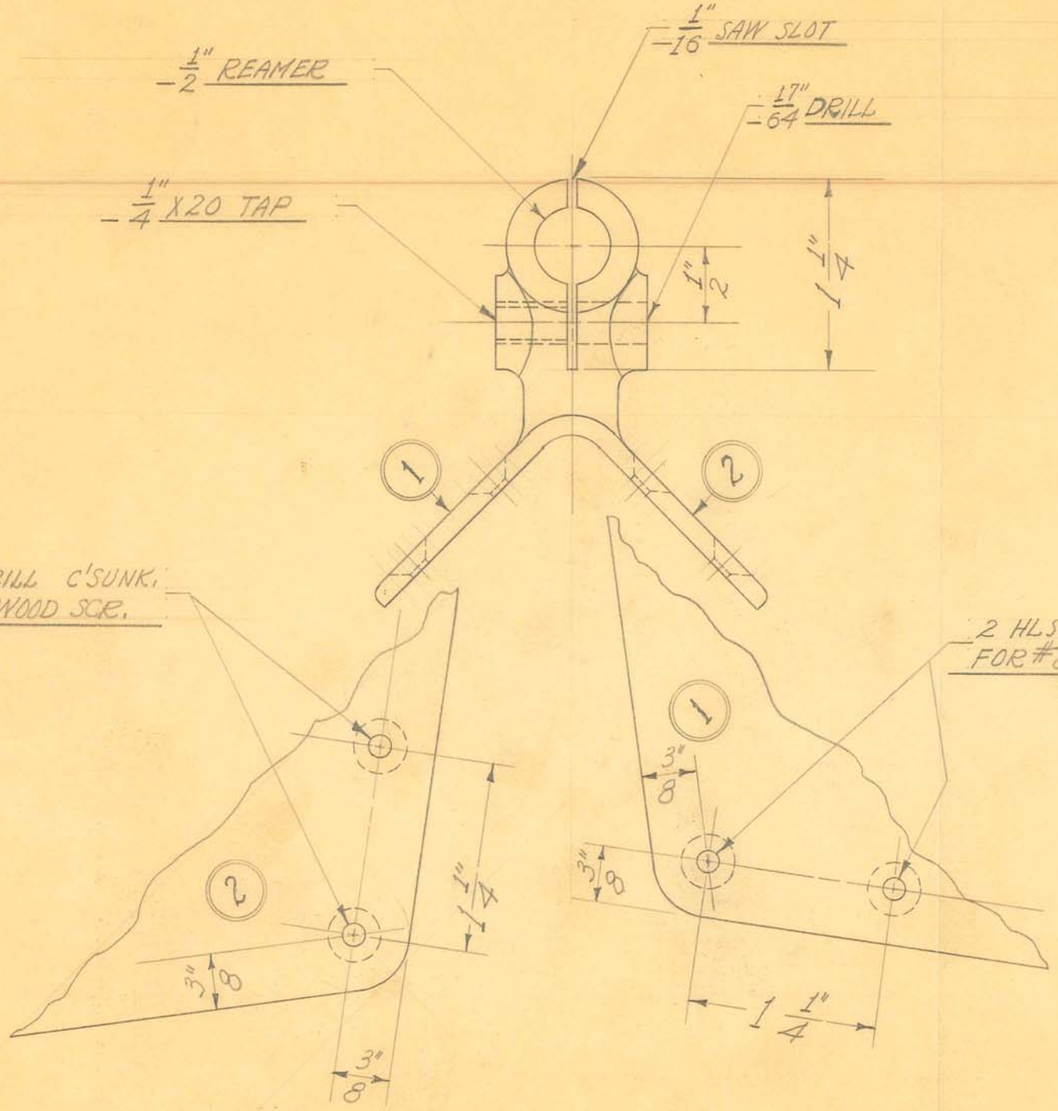

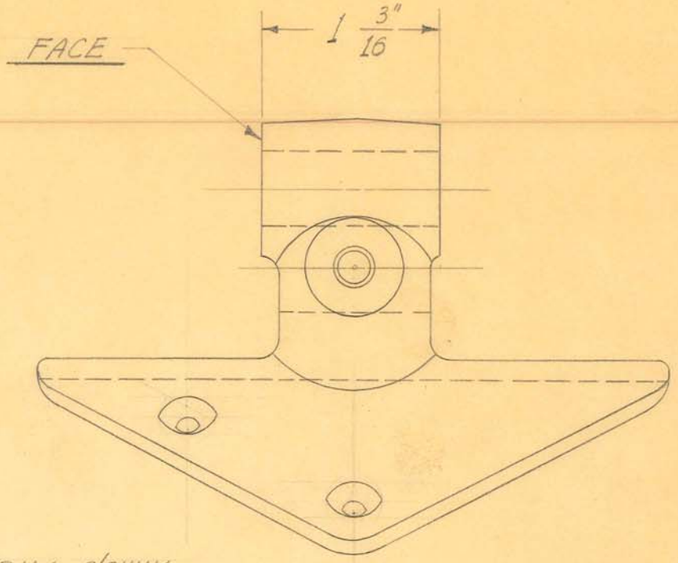

1 REQUIRED

OBSOLETE

SIZE		ISSUE 3-14-38	J.W.	TITLE: SHORT WAVE AIR SPACED ELECT. HOLDER SUPPORT BRACKET
KIND	IRON CASTING	CHANGED		
SHAPE		"		
FINISH	KRIST. #65	"		
TEMP.		"		
PATT.	4141-1138	"		

H. G. FISCHER & CO.
2335 WABANSIA AVE.
CHICAGO, ILL.

CAT. NO.

PART NO. 10822AF

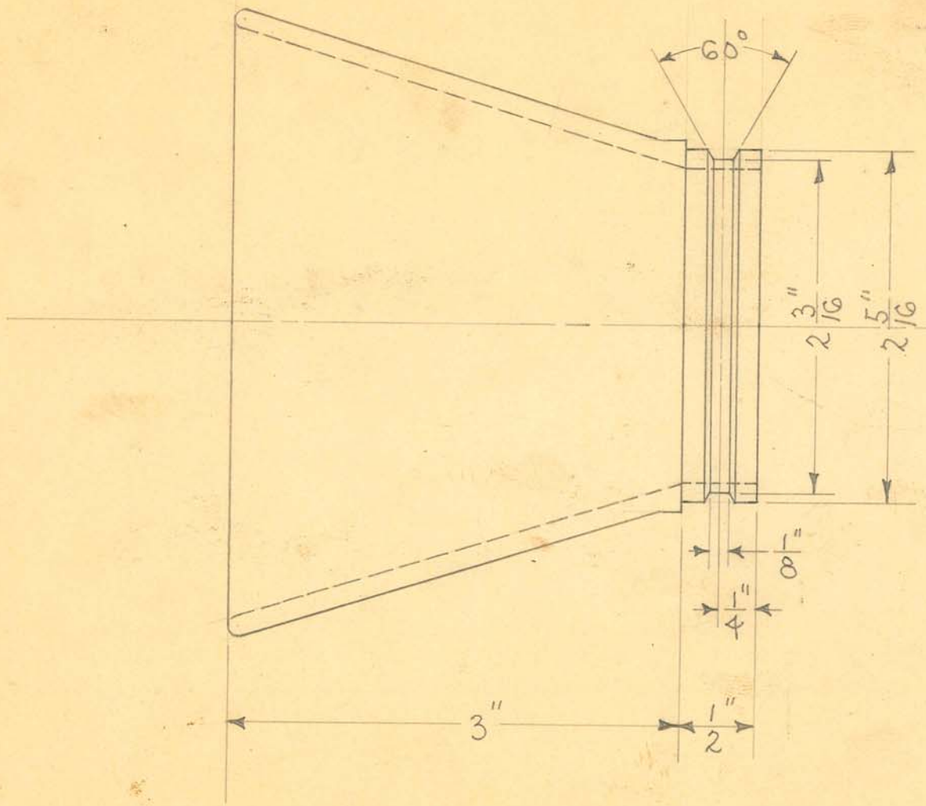

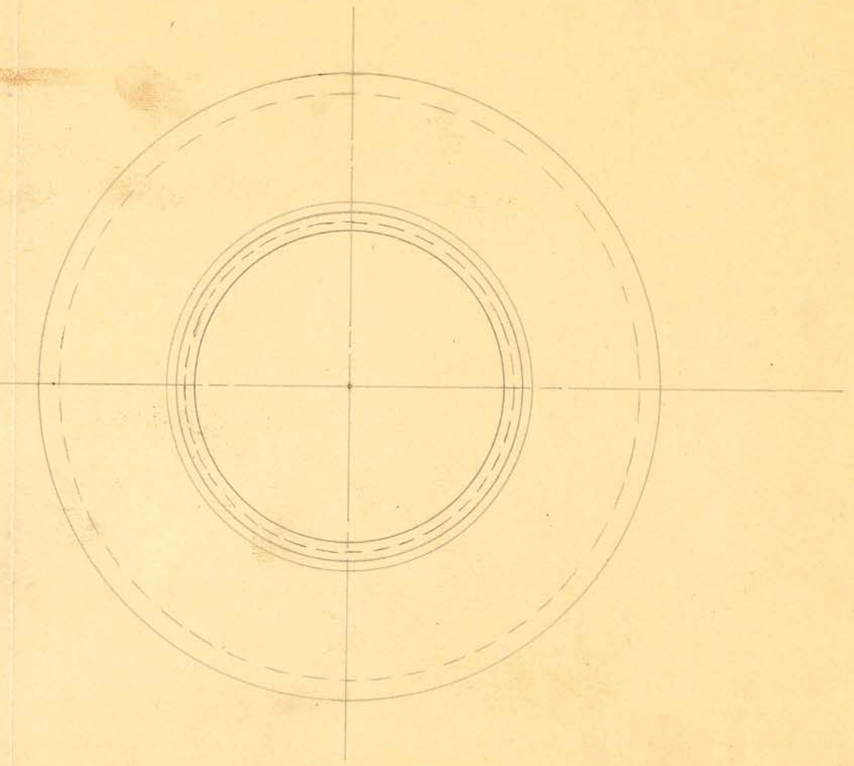

1 REQUIRED

OBSOLETE

SIZE	XR11 ALUM.	ISSUE 9-9-37	A.E.	TITLE: "H" PORTABLE X-RAY UNIT CONE
KIND	ALLOY CASTING	CHANGED		
SHAPE		"		
FINISH	KRIST. #55	"		
TEMP.		"		
PATT.	5114-1151	"		

H. G. FISCHER & CO.
2335 WABANSIA AVE.
CHICAGO, ILL.

CAT. NO. 4402

PART NO. 10851 F

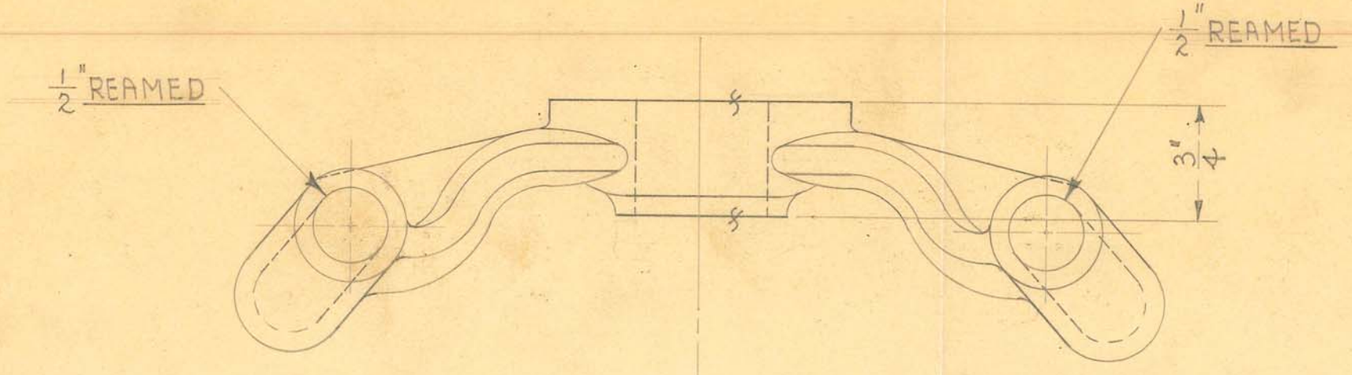

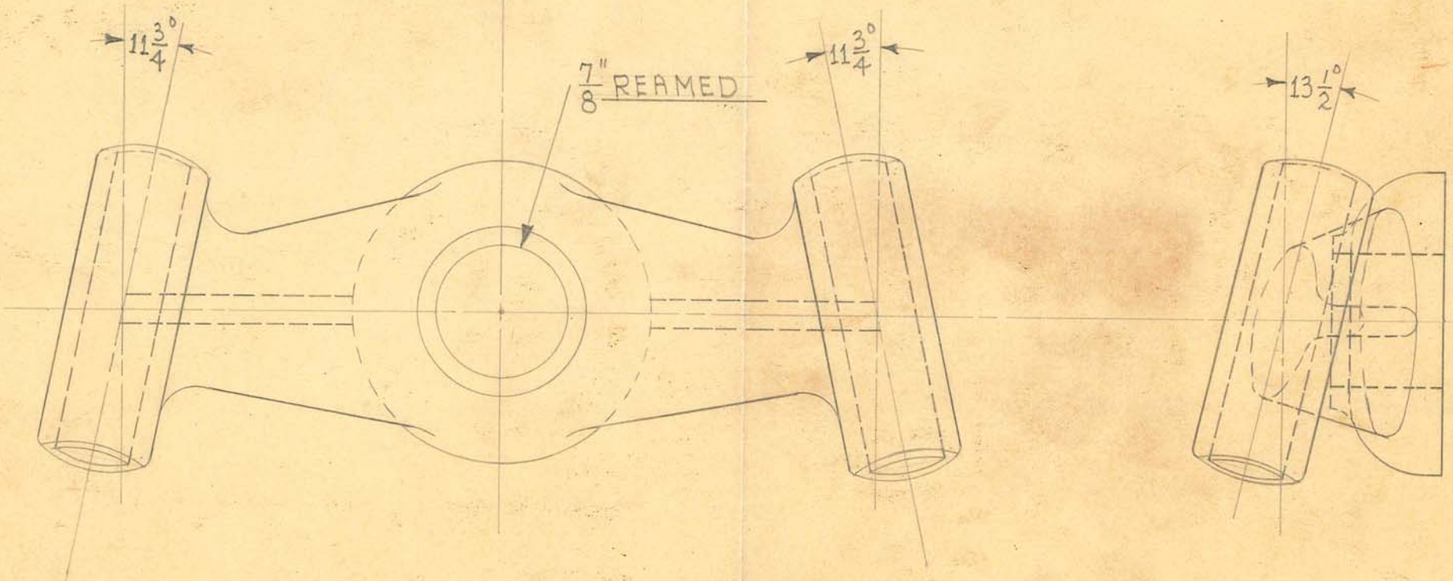

2 REQUIRED

OBSOLETE

SIZE		ISSUE 9-8-37	J.E.
KIND	ALUM. CASTING	CHANGED	
SHAPE		"	
FINISH	KRIST. #55	"	
TEMP.		"	
PATT.	4090-1134	"	

TITLE: "H" PORTABLE X-RAY UNIT TANK LEG SUPPORT

H. G. FISCHER & CO.
2335 WABANSIA AVE.
CHICAGO, ILL.

CAT. NO.

PART NO. 10855F

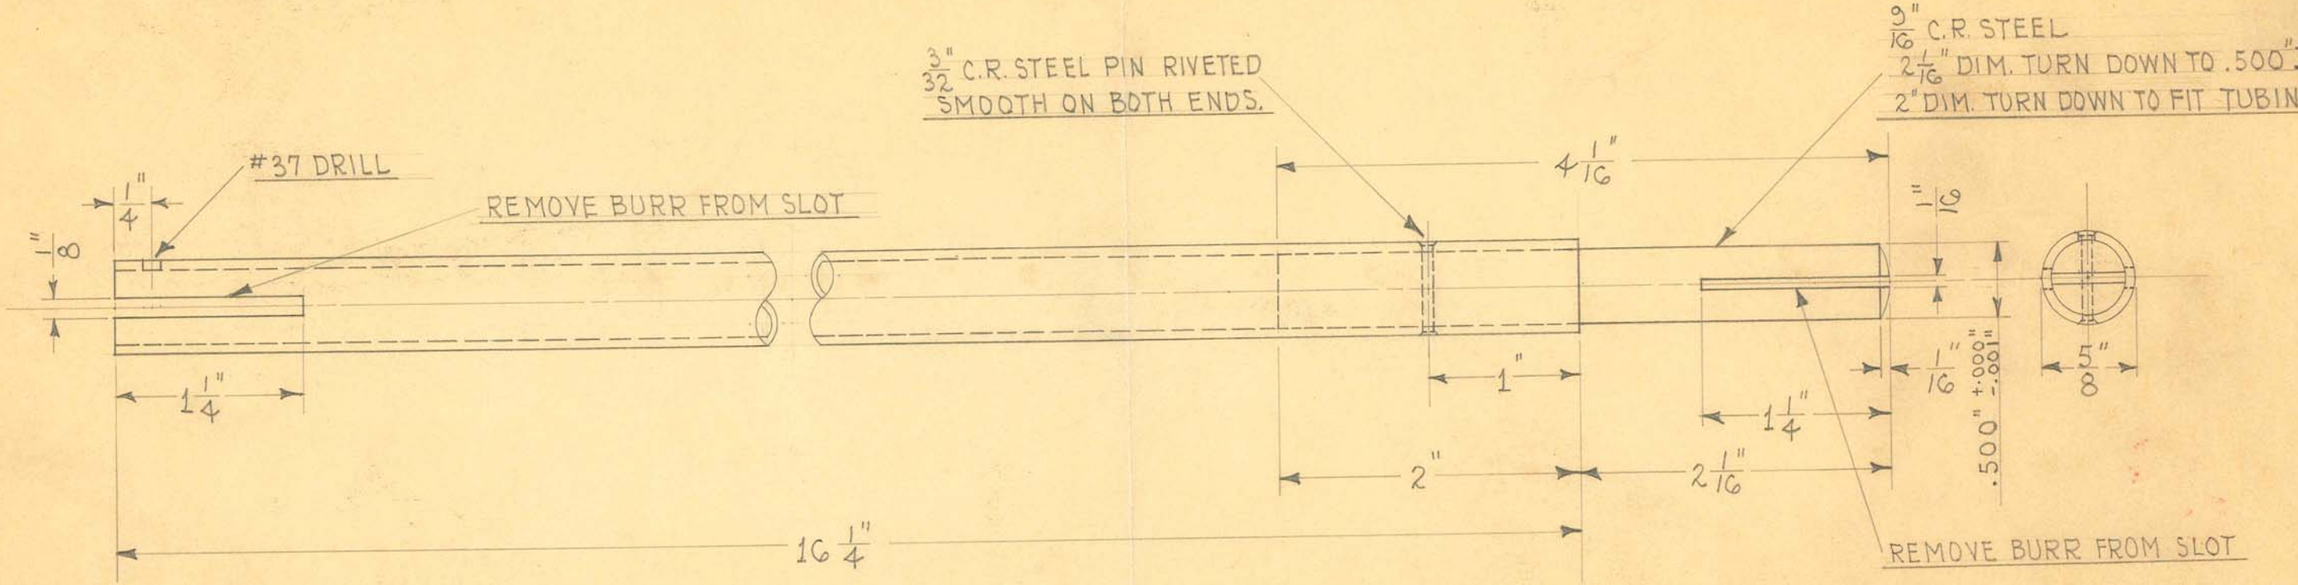

4 REQUIRED

FINISH

CHROME #2 ≈ 1/2" ROD. POLISH ROUNDED END.

KRIST. #55 ≈ 5/8" O.D. TUBE.

OBSOLETE

SIZE	1/2" I.D. X 5/8" O.D.	ISSUE 9-8-37	H.E.
KIND	STEEL TUBING	CHANGED	
SHAPE		"	
FINISH	SEE ABOVE	"	
TEMP.		"	
PATT.		"	

TITLE: "H" PORTABLE X-RAY UNIT LEG ASSEMBLY

H. G. FISCHER & CO.
2335 WABANSIA AVE.
CHICAGO, ILL.

CAT. NO.

PART NO. 10857G

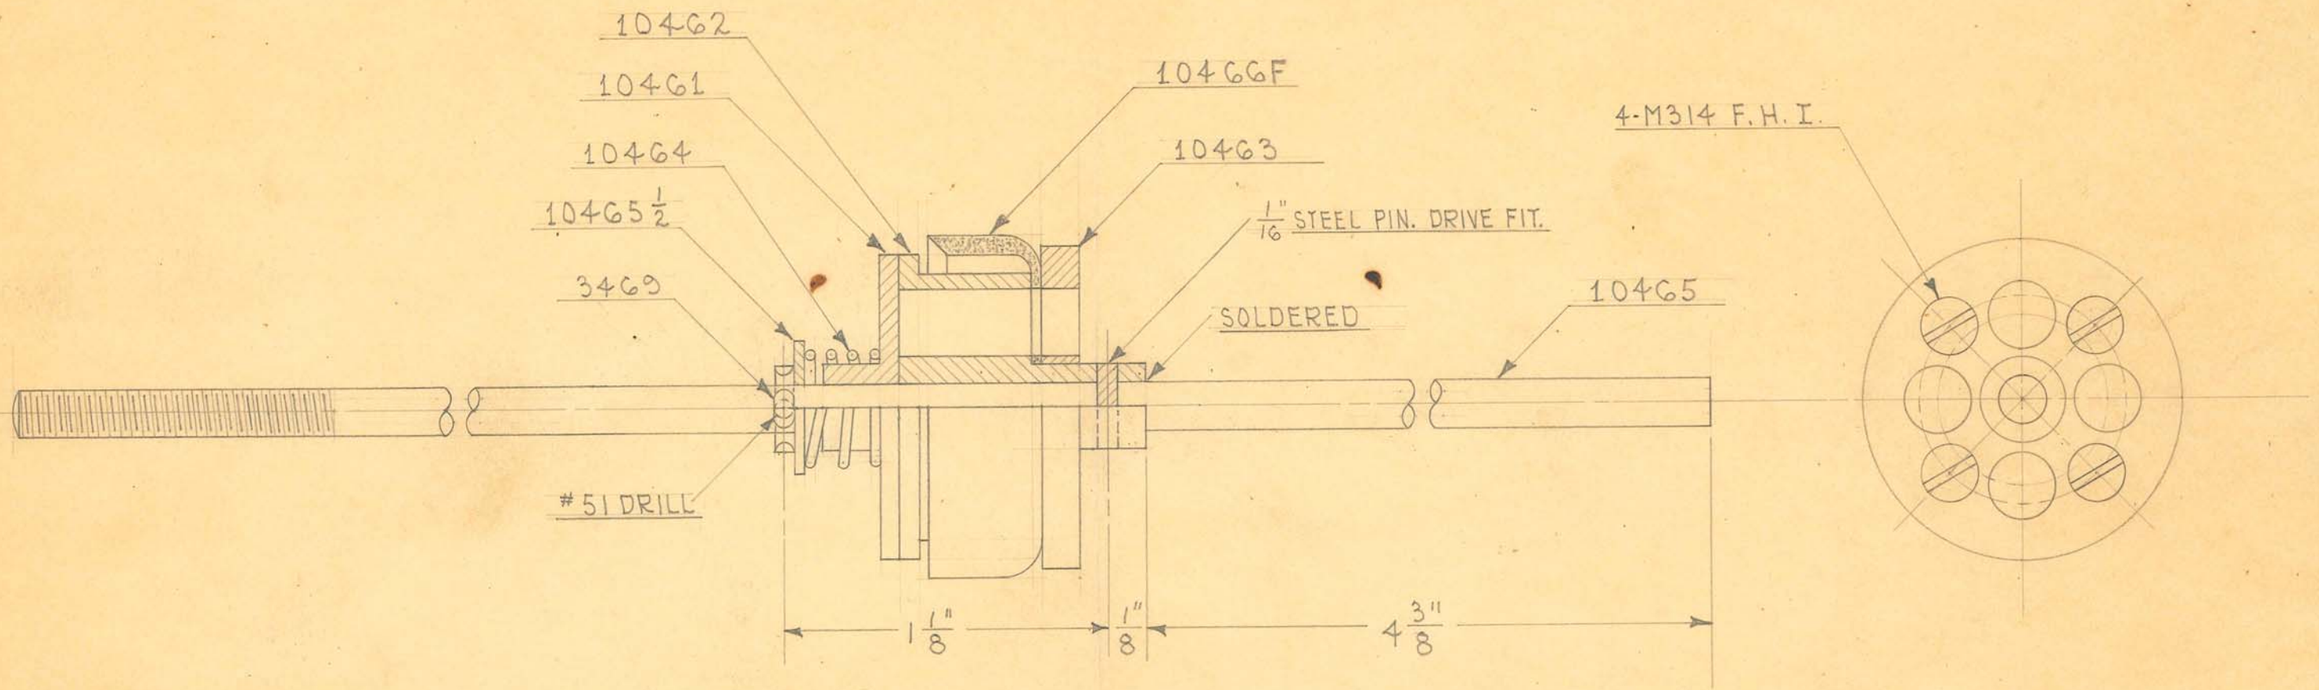

1 REQUIRED

SCALE ~ 1" = 1/2"

OBSOLETE

SIZE		ISSUE 3-29-37	A.E.	TITLE: SYNCHROTIMED BUCKY PISTON ASSEM.
KIND		CHANGED		
SHAPE		"		
FINISH		"		
TEMP.		"		
PATT.		"		

H. G. FISCHER & CO.
2335 WABANSIA AVE.
CHICAGO, ILL.

CAT. NO.

PART NO. 104606

#8 X 32 TAP

9/16"

CSK. SLIGHTLY FOR SOLDERING.

#8 X 32 TAP

1 1/4"

1 5/16"

1 5/8"

7/16"

3/8"

3/4"

5/16"

1/16"

13/16"

1 9/16"

1 1/2"

45°

45°

15/16"

6 HLS. # 10 X 32 TAP

1 3/16" R.

9/16"

11/16"

1 1/8"

4-"V" GROOVES FOR GASKET APPROX. 1/64" DEEP.

SCALE ~ 1" = 1/2"

1 REQUIRED

OBSOLETE

SIZE		ISSUE 2-24-37	J.E.
KIND	BRASS CASTING	CHANGED	
SHAPE		"	
FINISH		"	
TEMP.		"	
PATT.	8932-1074	"	

TITLE: FISCHER SYNCHROTIMED BUCKY CYLINDER HEAD

H. G. FISCHER & CO.
2335 WABANSIA AVE.
CHICAGO, ILL.

CAT. NO.

PART NO. 10479F

4-"V" GROOVES FOR GASKET APPROX. 1/64" DEEP.

#74 DRILL

#76 DRILL

60°

3/16" R.

#71 DRILL

#66 DRILL

#53 DRILL

#58 DRILL

1/4" REAMED

1 3/8"

7/16"

3/4"

1/16"

1/16" 1/4" 1/16"

1/2" X 27 THD.

60°

11/16"

9/16"

7/16"

1/2"

15/16"

11/32" DRILL

#19 DRILL

1 1/2"

2 9/16"

1 1/2"

3/4"

15°

1 1/4"

1"

1/16"

1/2"

1/16"

5/8"

1/32"

23/32"

3/4"

3/16" R.

13/16" R.

6 HLS. #9 DRILL

45°

45°

4 HLS. #10 X 32 TAP

SCALE ≈ 1" = 1/2"

1 REQUIRED

"V" GROOVE FOR GASKET APPROX. 1/64" DEEP.

SIZE	FROM 10480½	ISSUE 2-24-37	A.B.
KIND	BRASS CASTING	CHANGED	
SHAPE		"	
FINISH		"	
TEMP.		"	
PATT.	8987-1077	"	

TITLE:

FISCHER SYNCHROTIMED BUCKY

CYLINDER HEAD VALVE (REGULAR)

OBSOLETE

H. G. FISCHER & CO.
2335 WABANSIA AVE.
CHICAGO, ILL.

CAT. NO.

PART NO. 10480F

4-"V" GROOVES FOR GASKET APPROX. 1/64" DEEP

1 3/8" 7/16" 3/4" 1/16" 1/16" 1/4" 1/16"

1/2" X 27 THD.

60°

11/16" 9/16" 7/16" 1/2" 15/16"

11/32 DRILL

#19 DRILL

1 1/2" 1 1/2" 1 9/16" 3/4" 15° 1" 1 1/4"

1 3/16" R. 13/16" R.

1/16" 1/2" 1/16" 5/8" 1/32" 23/32" 3/4"

6 HLS. #9 DRILL

45° 45°

1/4" REAMED

4 HLS. #10X32 TAP

SCALE ÷ 1" = 1/2"

1 REQUIRED

"V" GROOVE FOR GASKET APPROX. 1/64" DEEP

SIZE		ISSUE 7-13-39	J.W.
KIND	BRASS CASTING	CHANGED	
SHAPE		"	
FINISH		"	
TEMP.		"	
PATT.	8987-1077	"	

TITLE: FISCHER SYNCHROTIMED BUCKY CYLINDER HEAD VALVE

OBSOLETE

H. G. FISCHER & CO.
2335 WABANSIA AVE.
CHICAGO, ILL.

CAT. NO.

PART NO. 10480 1/2

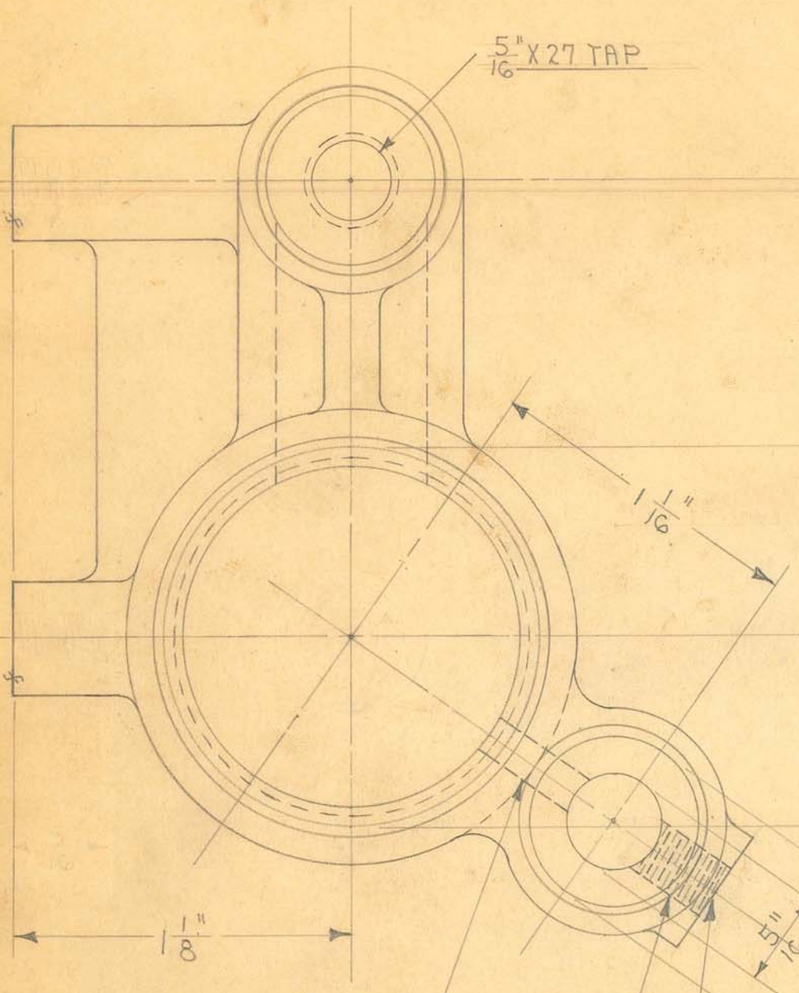

FACE WITH 1/2" COUNTERBORE
TO FLAT SURFACE AROUND HOLE

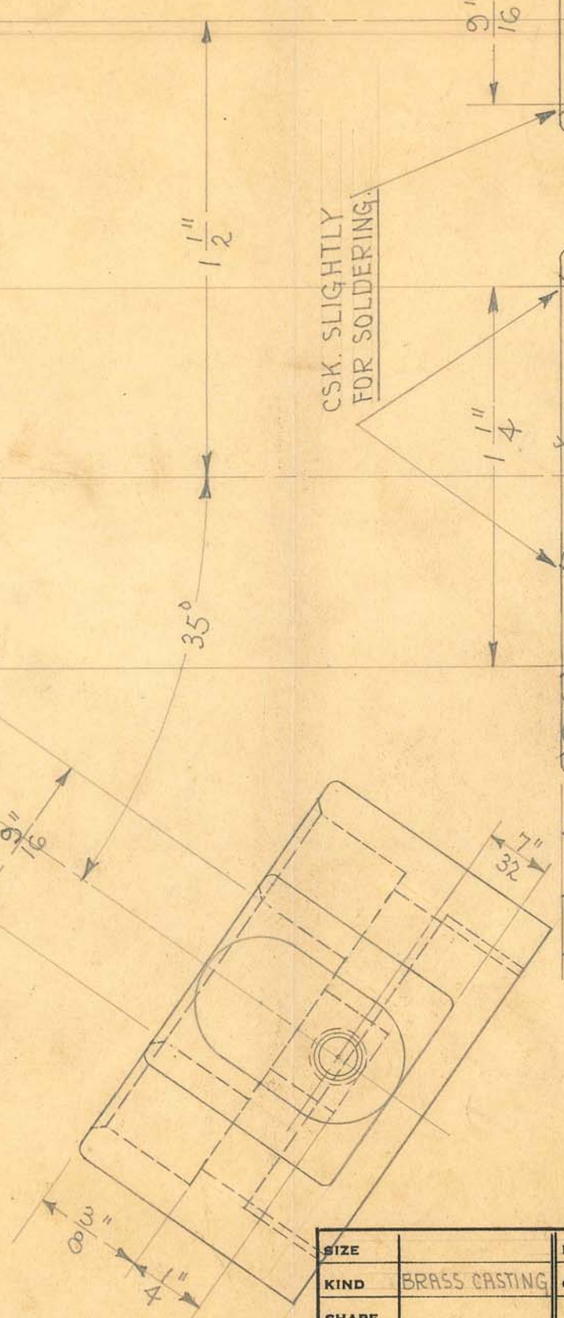

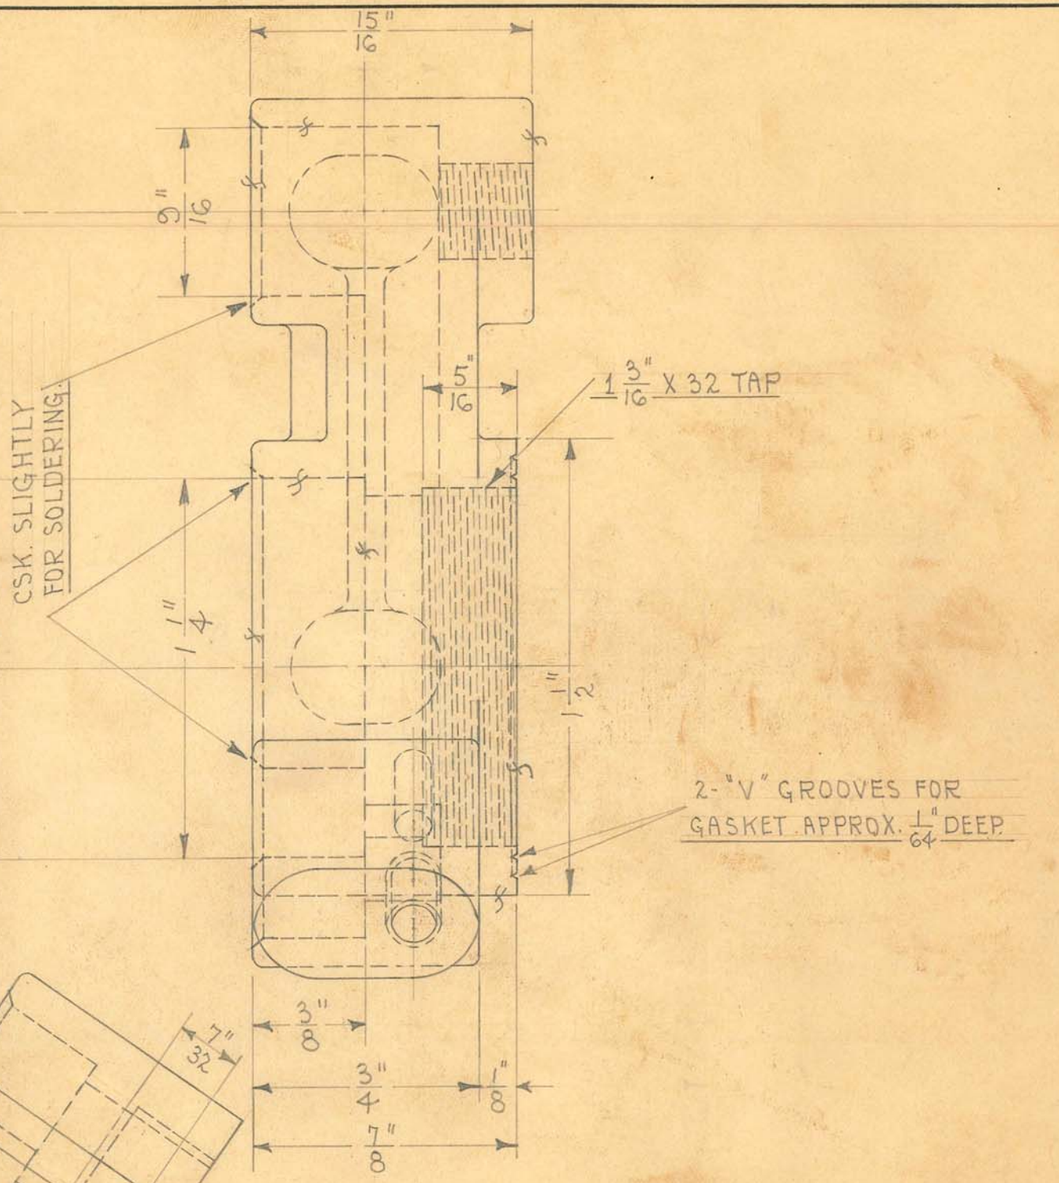

SCALE ~ 1" = 1/2"

1 REQUIRED

SIZE		ISSUE 2-25-37	J.F.E.
KIND	BRASS CASTING	CHANGED	
SHAPE		"	
FINISH		"	
TEMP.		"	
PATT.	8933-1075	"	

TITLE:
FISCHER SYNCHROTIMED BUCKY
EXPANSION CHAMBER SUPPORT

OBSOLETE

H. G. FISCHER & CO.
2335 WABANSIA AVE.
CHICAGO, ILL.

CAT. NO.

PART NO. 10481F

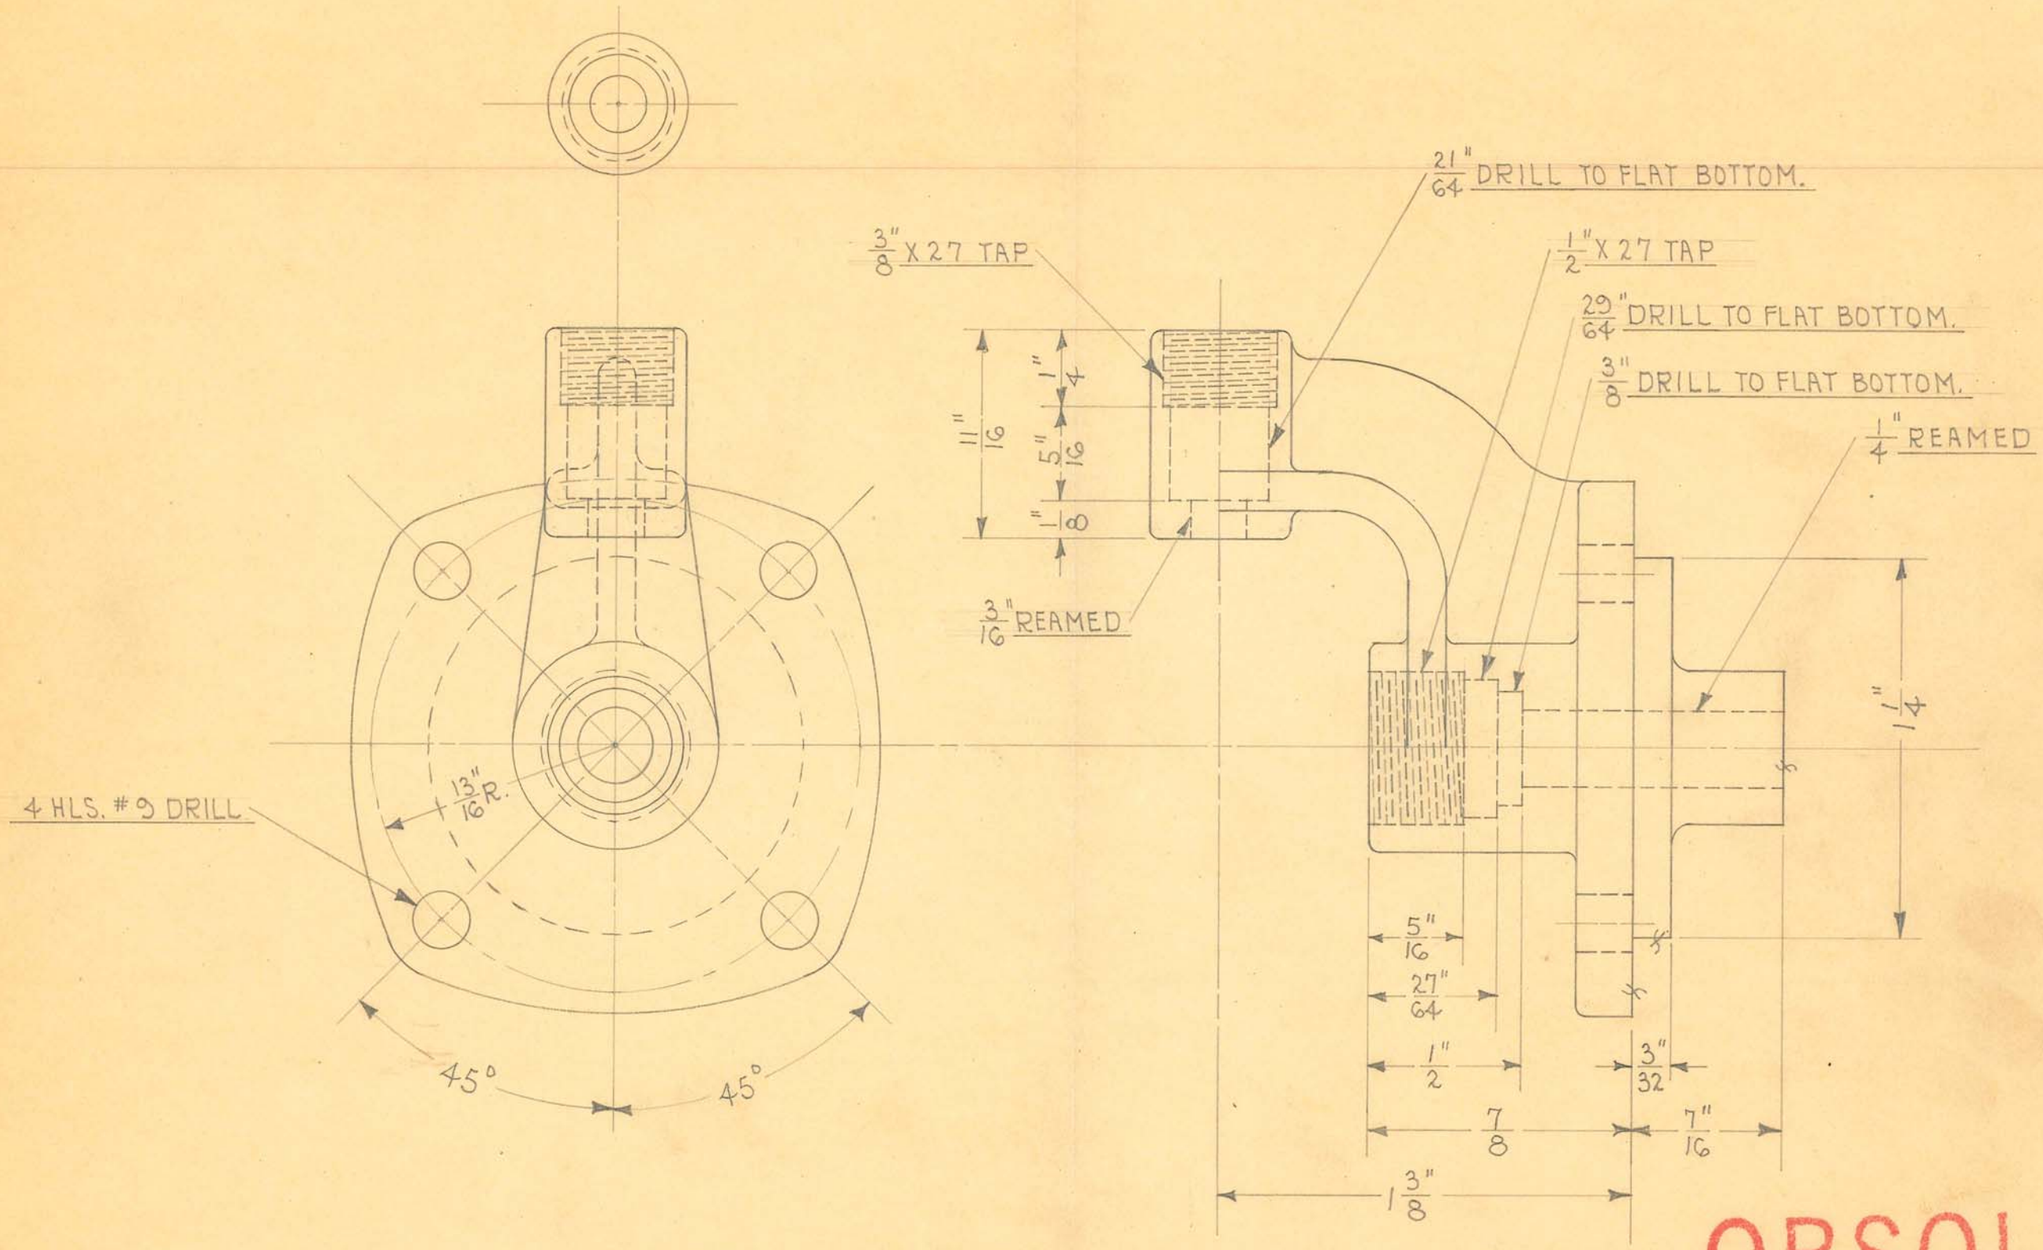

SCALE ÷ 1" = 1/2"

1 REQUIRED

OBSOLETE

SIZE		ISSUE 2-25-37	H.E.
KIND	BRASS CASTING	CHANGED	
SHAPE		"	
FINISH	BLACK #80	"	
TEMP.		"	
PATT.	8986-1076	"	

TITLE:
FISCHER SYNCHROTIMED BUCKY
CYLINDER HEAD VALVE CONTROL HEAD

H. G. FISCHER & CO.
2335 WABANSIA AVE.
CHICAGO, ILL.

CAT. NO.

PART NO. 10502F

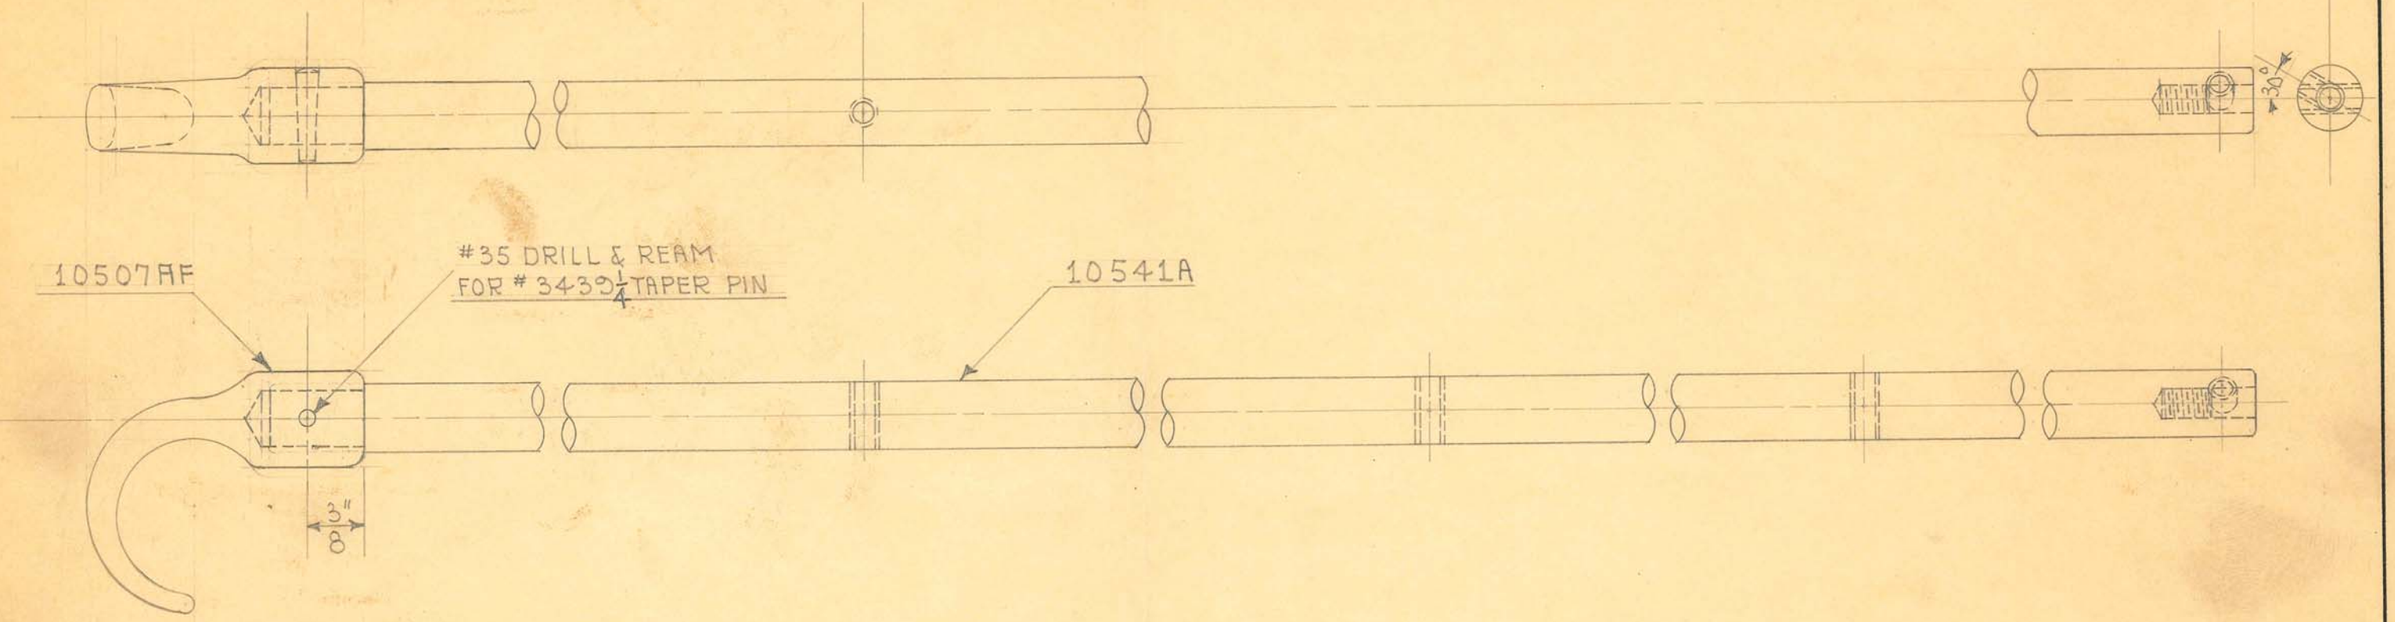

1 REQUIRED

OBSOLETE

SIZE		ISSUE 4-5-37	A.E.
KIND		CHANGED 6-21-37	A.E.
SHAPE		"	
FINISH		"	
TEMP.		"	
PATT.		"	

TITLE: FISCHER SYNCHROTIMED BUCKY GRID SETTING ROD ASSEM.

H. G. FISCHER & CO.
2335 WABANSIA AVE.
CHICAGO, ILL.

CAT. NO.

PART NO. 10540GA

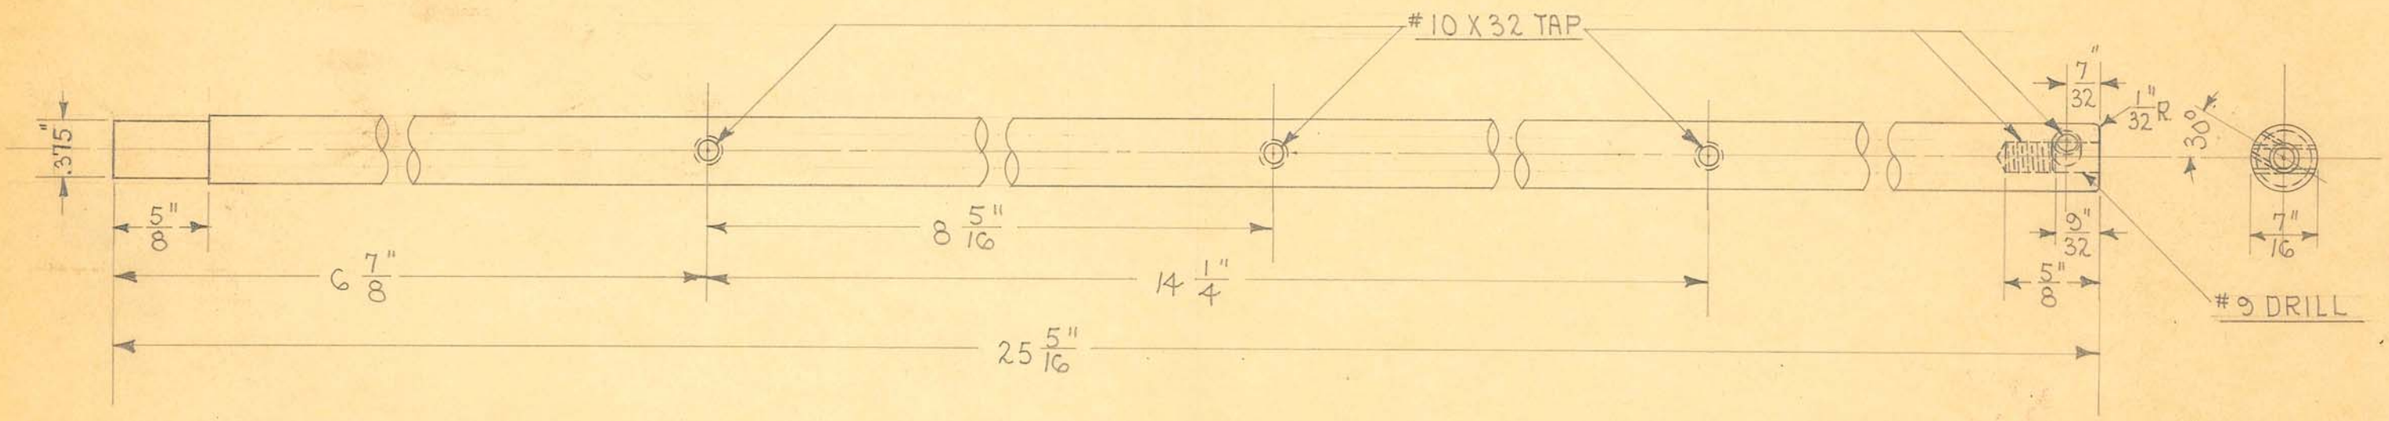

1 REQUIRED

OBSOLETE

SIZE	7/16" DIAM.	ISSUE 4-5-37	H.E.
KIND	DRILL ROD	CHANGED 6-21-37	H.E.
SHAPE		"	
FINISH	CAD. # 23	"	
TEMP.		"	
PATT.		"	

TITLE:
FISCHER SYNCHROTIMED BUCKY
GRID SETTING ROD

H. G. FISCHER & CO.
2335 WABANSIA AVE.
CHICAGO, ILL.

CAT. NO.

PART NO. 10541A

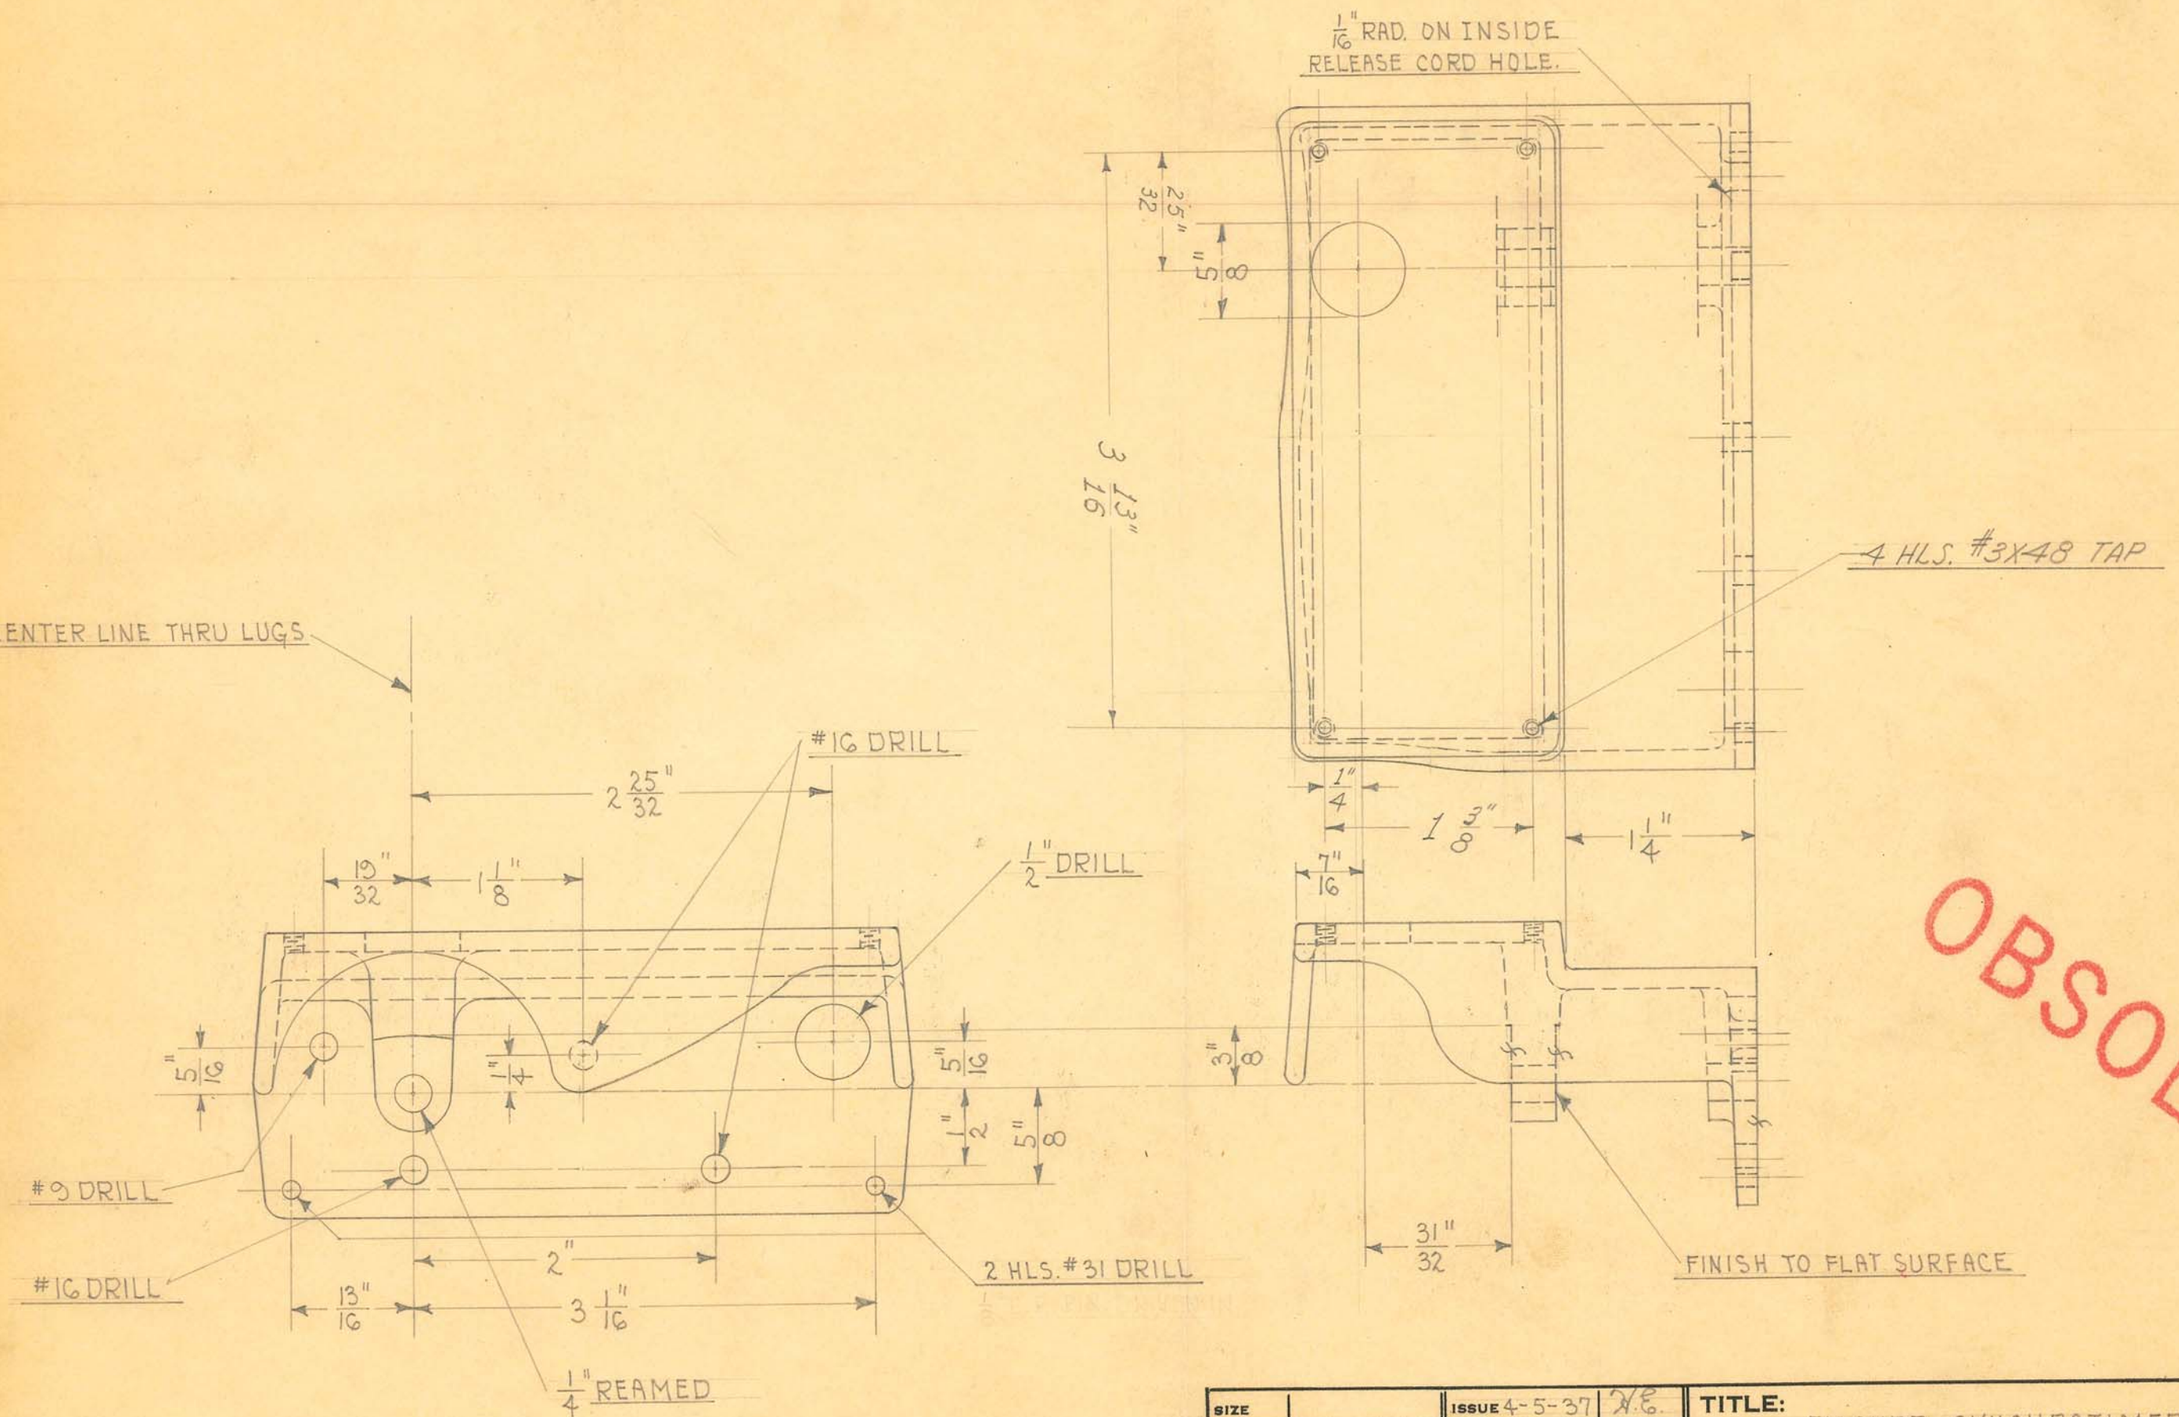

OBSOLETE

SIZE		ISSUE 4-5-37	N.E.
KIND	ALUM. CASTING	CHANGED	
SHAPE		"	
FINISH	POLISH & BUFF	"	
TEMP.		"	
PATT.	8134-1061	"	

TITLE: FISCHER SYNCHROTIMED BUCKY SELECTOR KNOB COVER

H. G. FISCHER & CO.
2335 WABANSIA AVE.
CHICAGO, ILL.

CAT. NO.

PART NO. 10550F

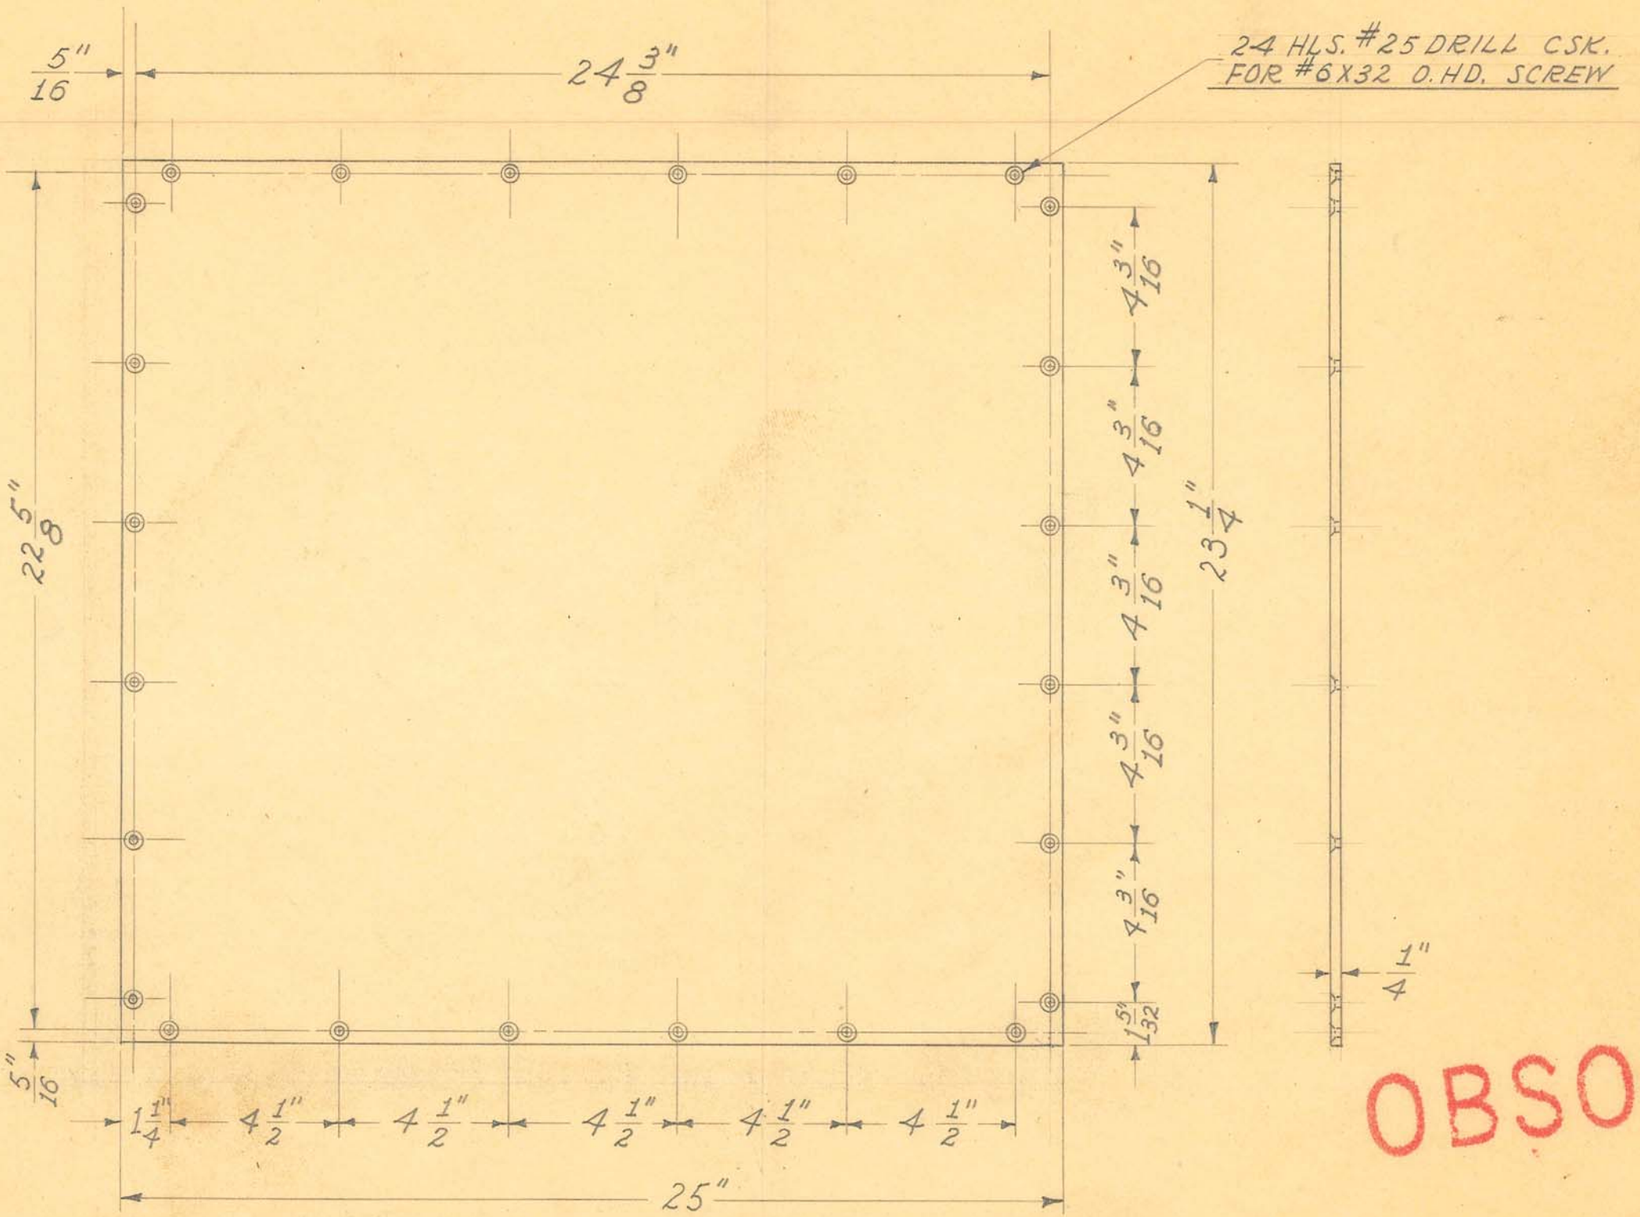

OBSOLETE

obsolete

SCALE : 1/4" = 1"

1 REQUIRED

SIZE	25"X23 1/4"X1/4"	ISSUE 4-30-37	J.W.	
KIND	TEMPERED	CHANGED		
~~CORE~~	PRESSWOOD	"		
FINISH		"		
TEMP.		"		
PATT.		"		

TITLE:
FISCHER SYNCHROTIMED BUCKY
PRESSWOOD TOP

H. G. FISCHER & CO.
2335 WABANSIA AVE.
CHICAGO, ILL.

CAT. NO.

PART NO. 10558F

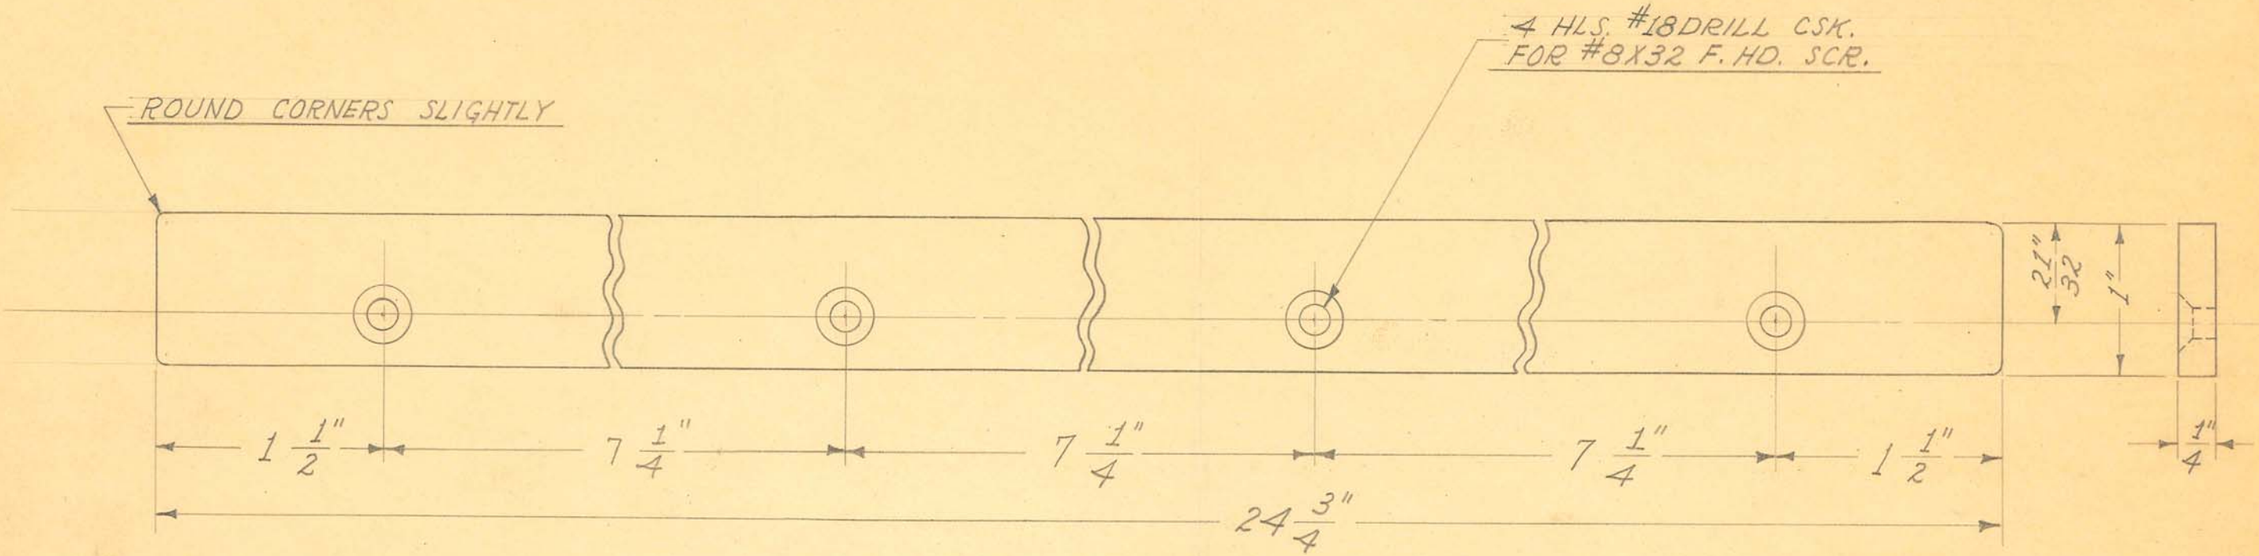

1 REQUIRED

OBSOLETE

SIZE	1/4" X 1"	ISSUE 5-1-37	J.W.	TITLE: FISCHER SYNCHROTIMED BUCKY MTG. STRIP FOR COMPRESSION ATTACH.-HOOK END
KIND	C. DRAWN STEEL	CHANGED		
SHAPE		"		
FINISH	CAD. #23	"		
TEMP.		"		
PATT.		"		

H. G. FISCHER & CO.
2335 WABANSIA AVE.
CHICAGO, ILL.

CAT. NO.

PART NO. 10559

B

TITLE: ~~REMOTE HAND CONTROL SWITCH HOLDER~~ (SOUND HEAD HOOK)

H. G. FISCHER & CO.
FRANKLIN PARK, ILLINOIS

PART NO. 10180C

DATE 1-26-55 | DR BY J.V.W. | CH'K'D.

REVISION	DATE	BY
A WAS #3003-SD 1/8" SH. ALUM.	4-5-55	J.V.W.
B ADD SPREAD		
C SPREAD		

PATTERN | FINISH POLISH SEE NOTE | SCALE FULL

TOOLS: BLANK & PIERCE DIE #12221 | MATERIAL #18-8 2B FINISH #302 STAINLESS STEEL .075" SHEET

DIMENSIONS UNLESS OTHERWISE SPECIFIED
FRACTIONAL ± .015
DECIMAL ± .005
ANGULAR ± ½°

USED ON	QTY.
20925GD	1

~~"V" DIE TOOL #11837~~
SPREAD IN MULTIFORM BENDER
FORM TOOL #14467

WAS 1 23/64 11-7-67 J.V.W.

Replaced w/10180 ECO# 0261 9-27-74 JL

PUT IN TUMBLING BARREL TO REMOVE SHARP EDGES & DIE MARKS.

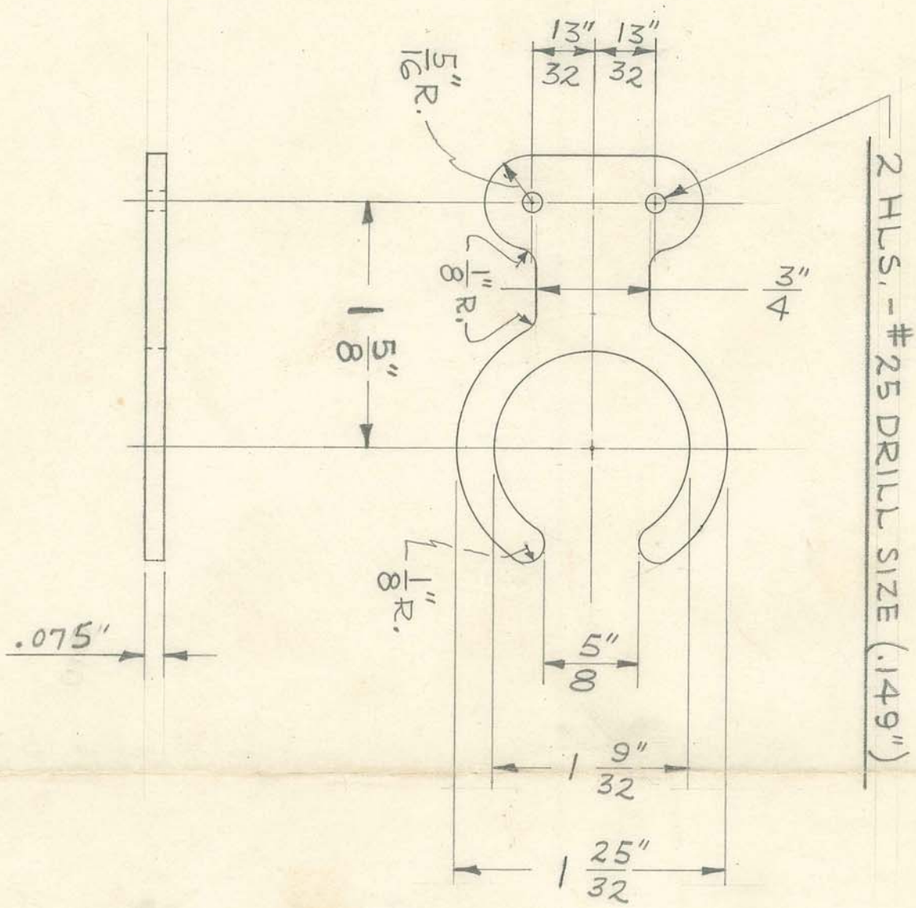

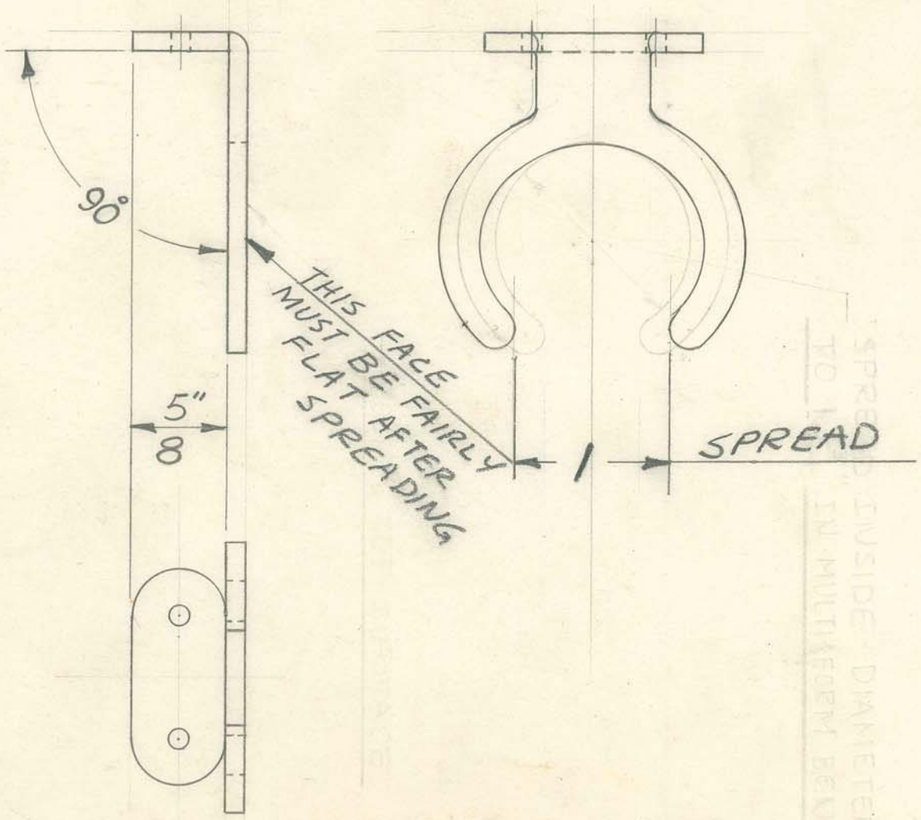

1 REQUIRED

— BEFORE BENDING — PUT THRU FLATTENING DIE IF NECESSARY.

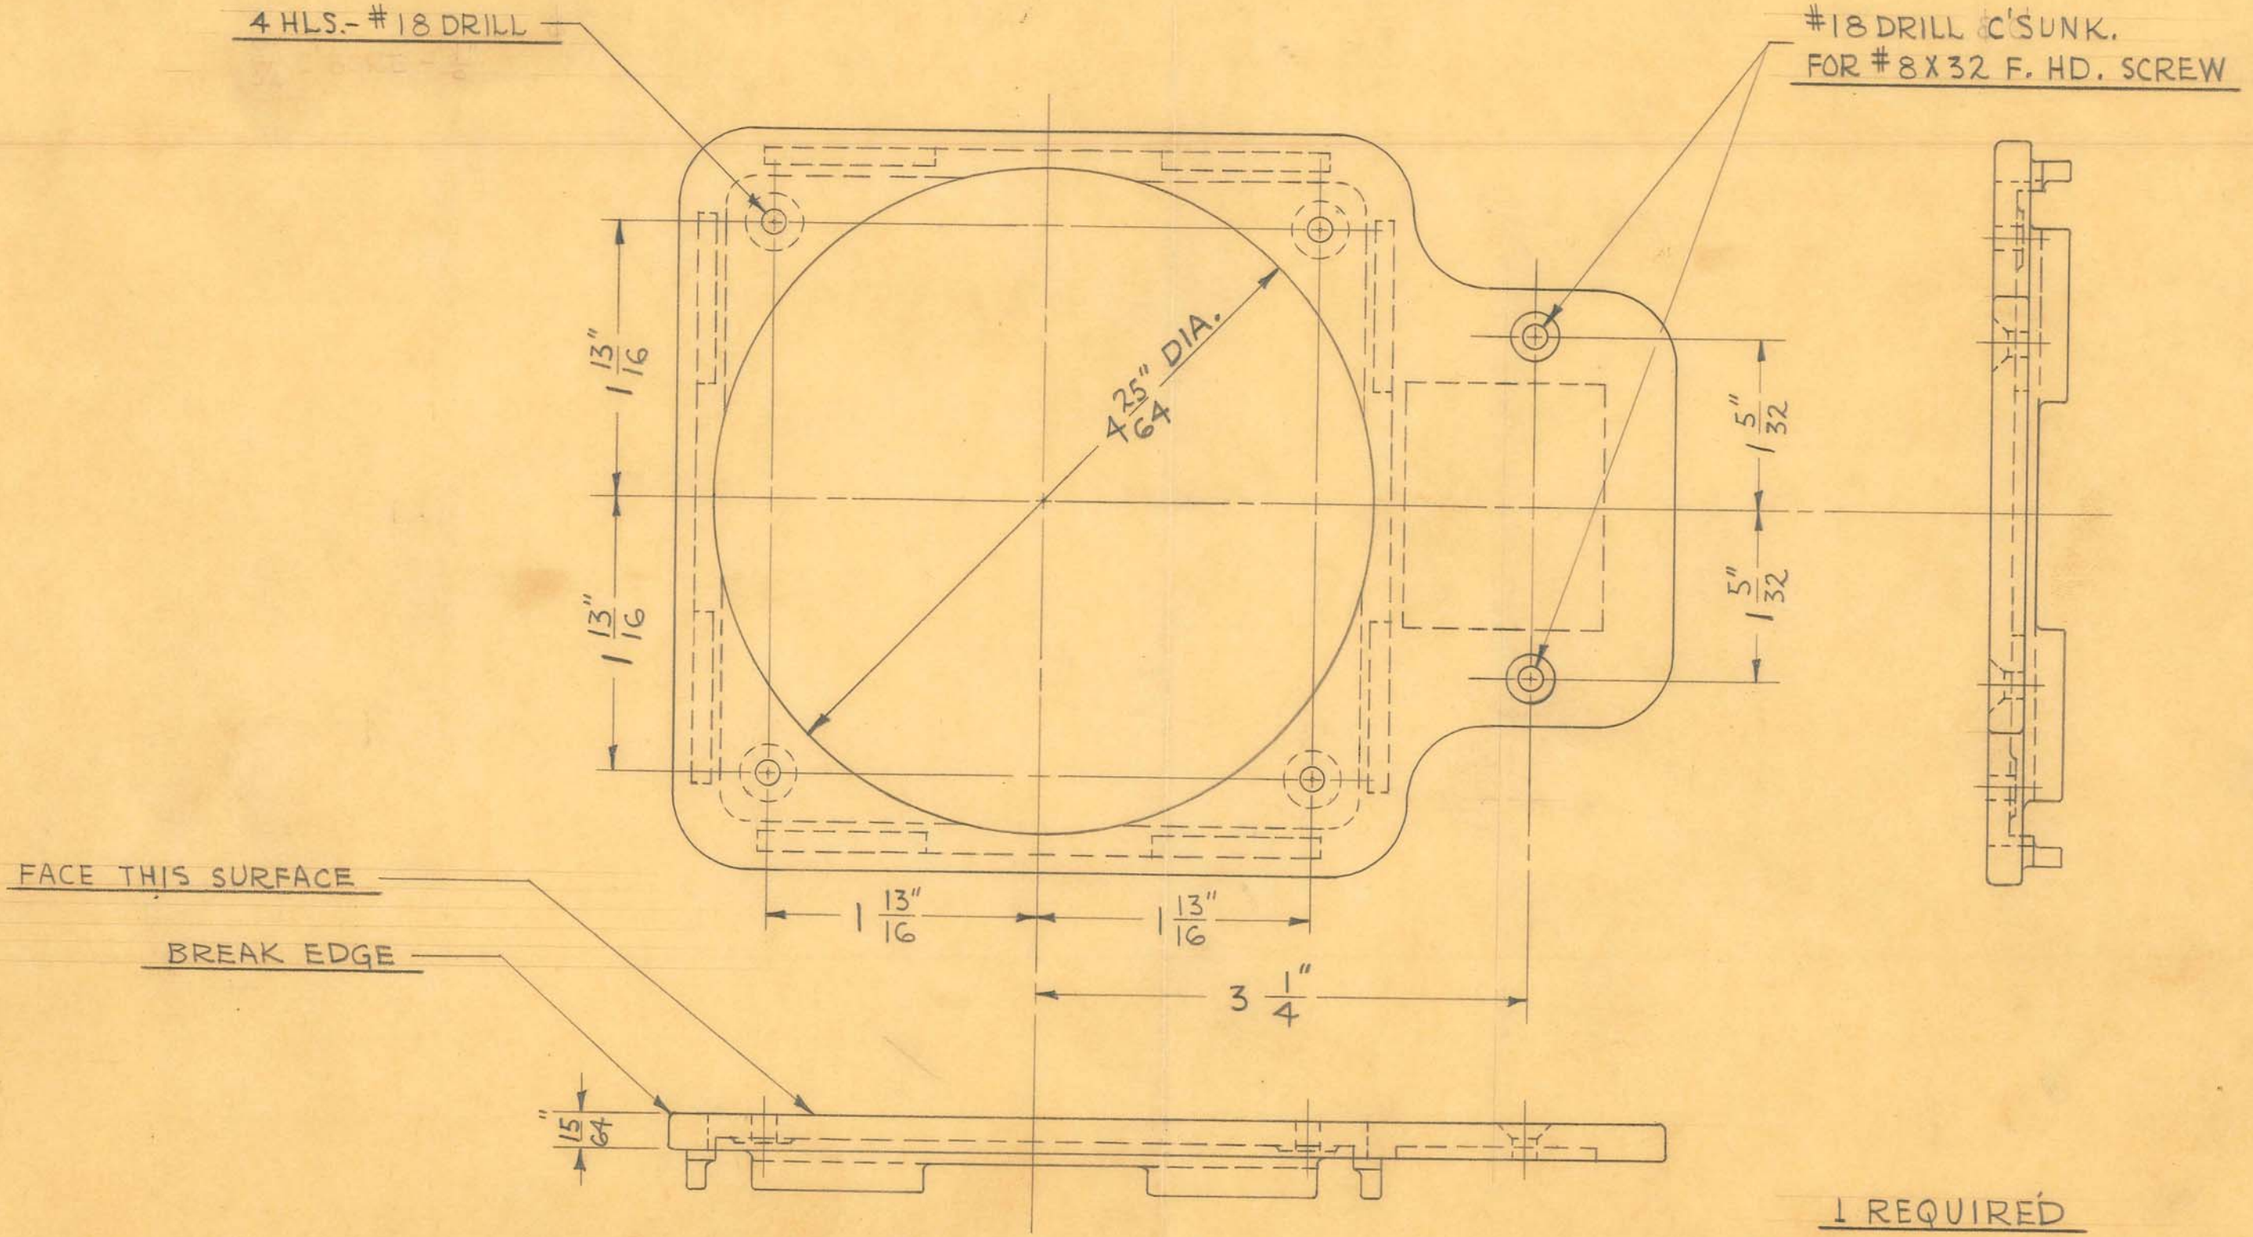

1 REQUIRED

OBSOLETE

SIZE	FROM # 15695	ISSUE 5-16-46	J.V.W.
KIND		CHANGED	
SHAPE		"	
FINISH	PAINTED	"	
TEMP.		"	
DIE	2007	"	

TITLE: LIEBEL-FLARSHEIM THERAPY TIMER
HOUSING - FRONT COVER

H. G. FISCHER & CO.
2335 WABANSIA AVE.

CAT. NO.

PART NO. 15687

TBJ21

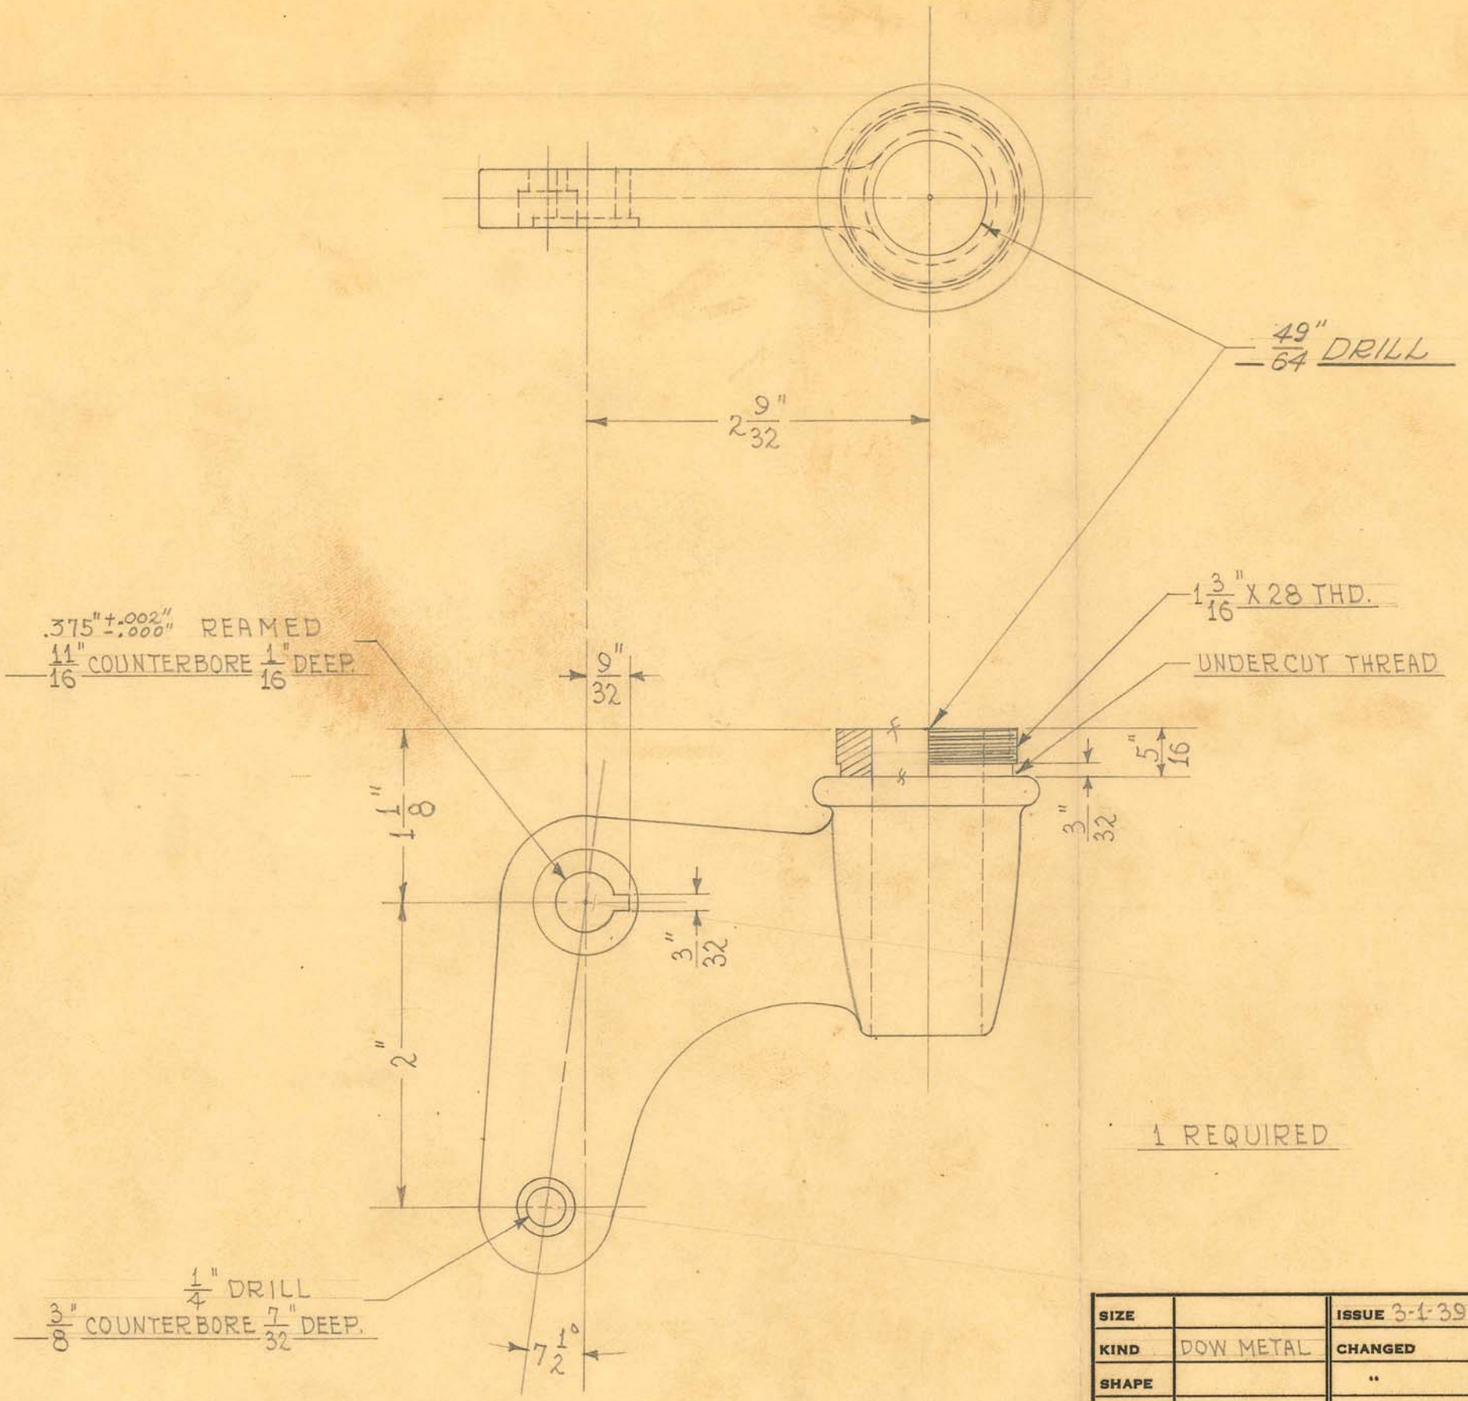

1 REQUIRED

OBSOLETE

Obsolete

SIZE		ISSUE 3-1-39	HE.
KIND	DOW METAL	CHANGED	
SHAPE		"	
FINISH	PAINTED	"	
TEMP.		"	
PATT.	1299	"	

TITLE:
WALL MODEL DENTAL X-RAY UNIT-
COUNTERBALANCE SPRING & TUBE SUPP. - LEFT

H. G. FISCHER & CO.
2335 WABANSIA AVE.
CHICAGO, ILL.

CAT. NO.

PART NO. 12346

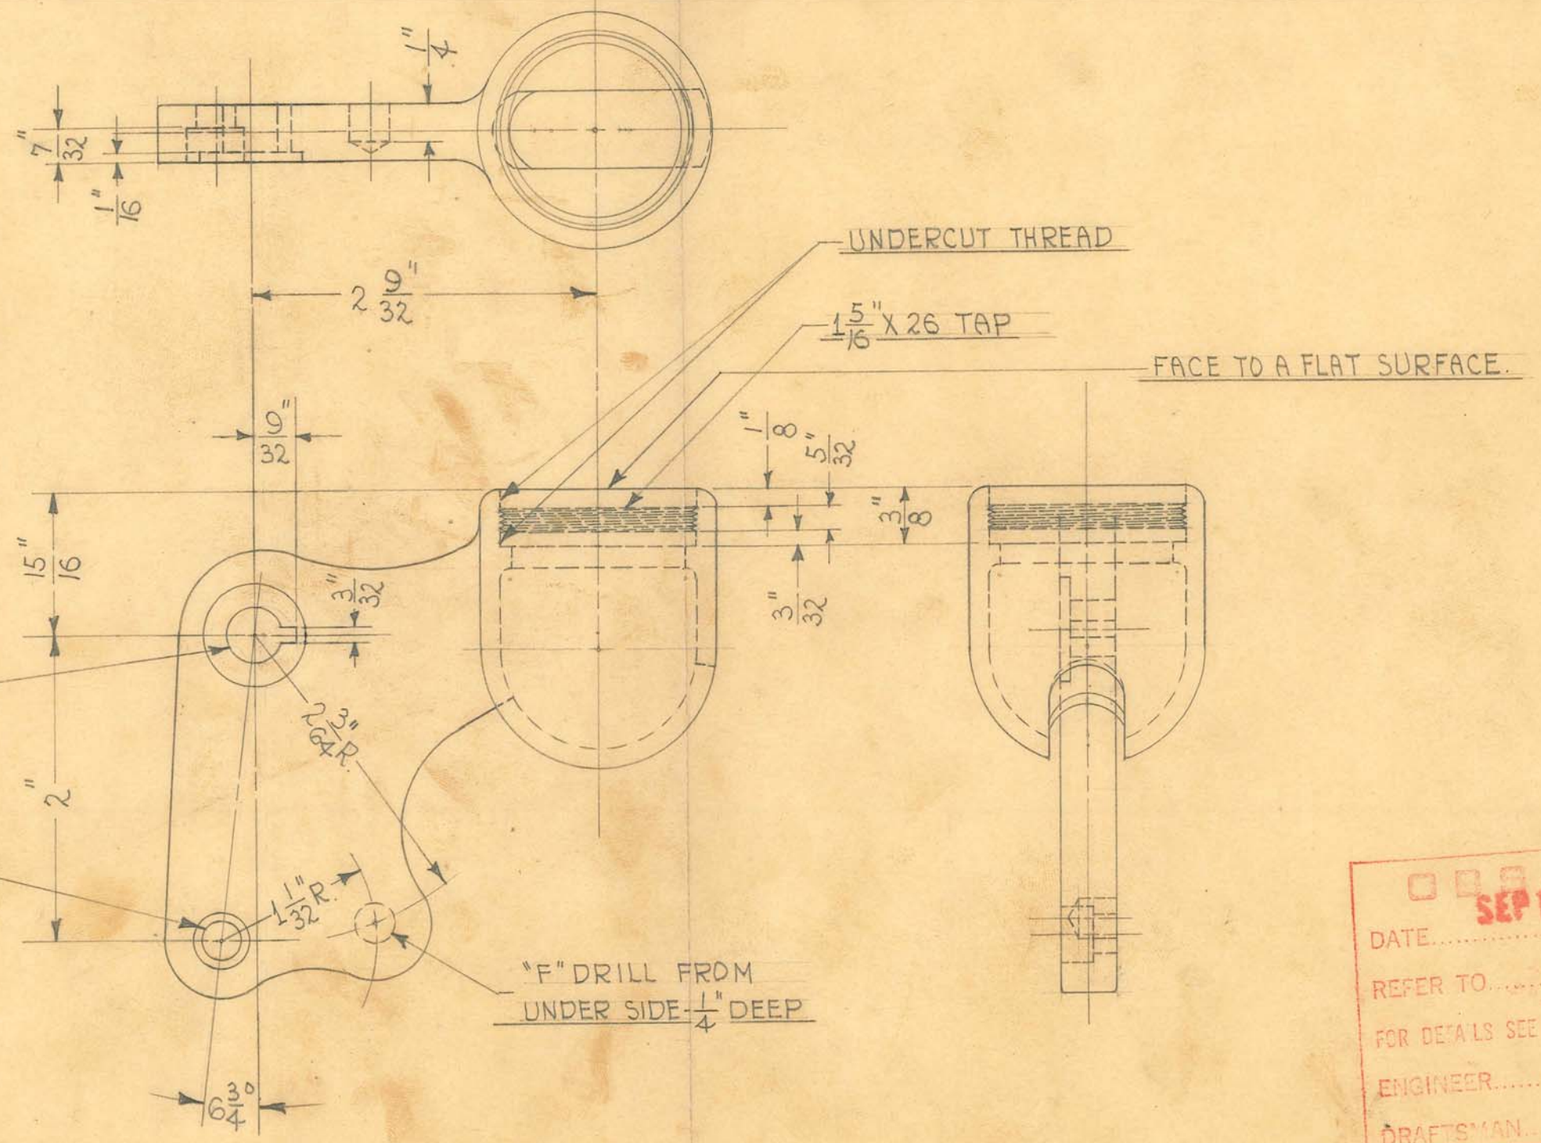

1 REQUIRED

#214 ALUMINUM 7-11-50

SIZE		ISSUE 2-12-40	HE.
KIND	~~ALUMINUM~~	CHANGED 4-1-44	HE.
SHAPE	~~CASTING~~	" 7-11-50	J.V.W.
FINISH	PAINTED	"	
TEMP.		"	
DIE	1490	"	

TITLE: WALL MODEL DENTAL X-RAY UNIT- COUNTERBALANCE SPRING & TUBE SUPP.- LEFT

H. G. FISCHER & CO. 2335 WABANSIA AVE. CHICAGO, ILL. | CAT. NO. | PART NO. 12346C

OBSOLETE
SEP 17 1975
DATE
REFER TO
FOR DETAILS SEE E. C. O. #
ENGINEER
DRAFTSMAN

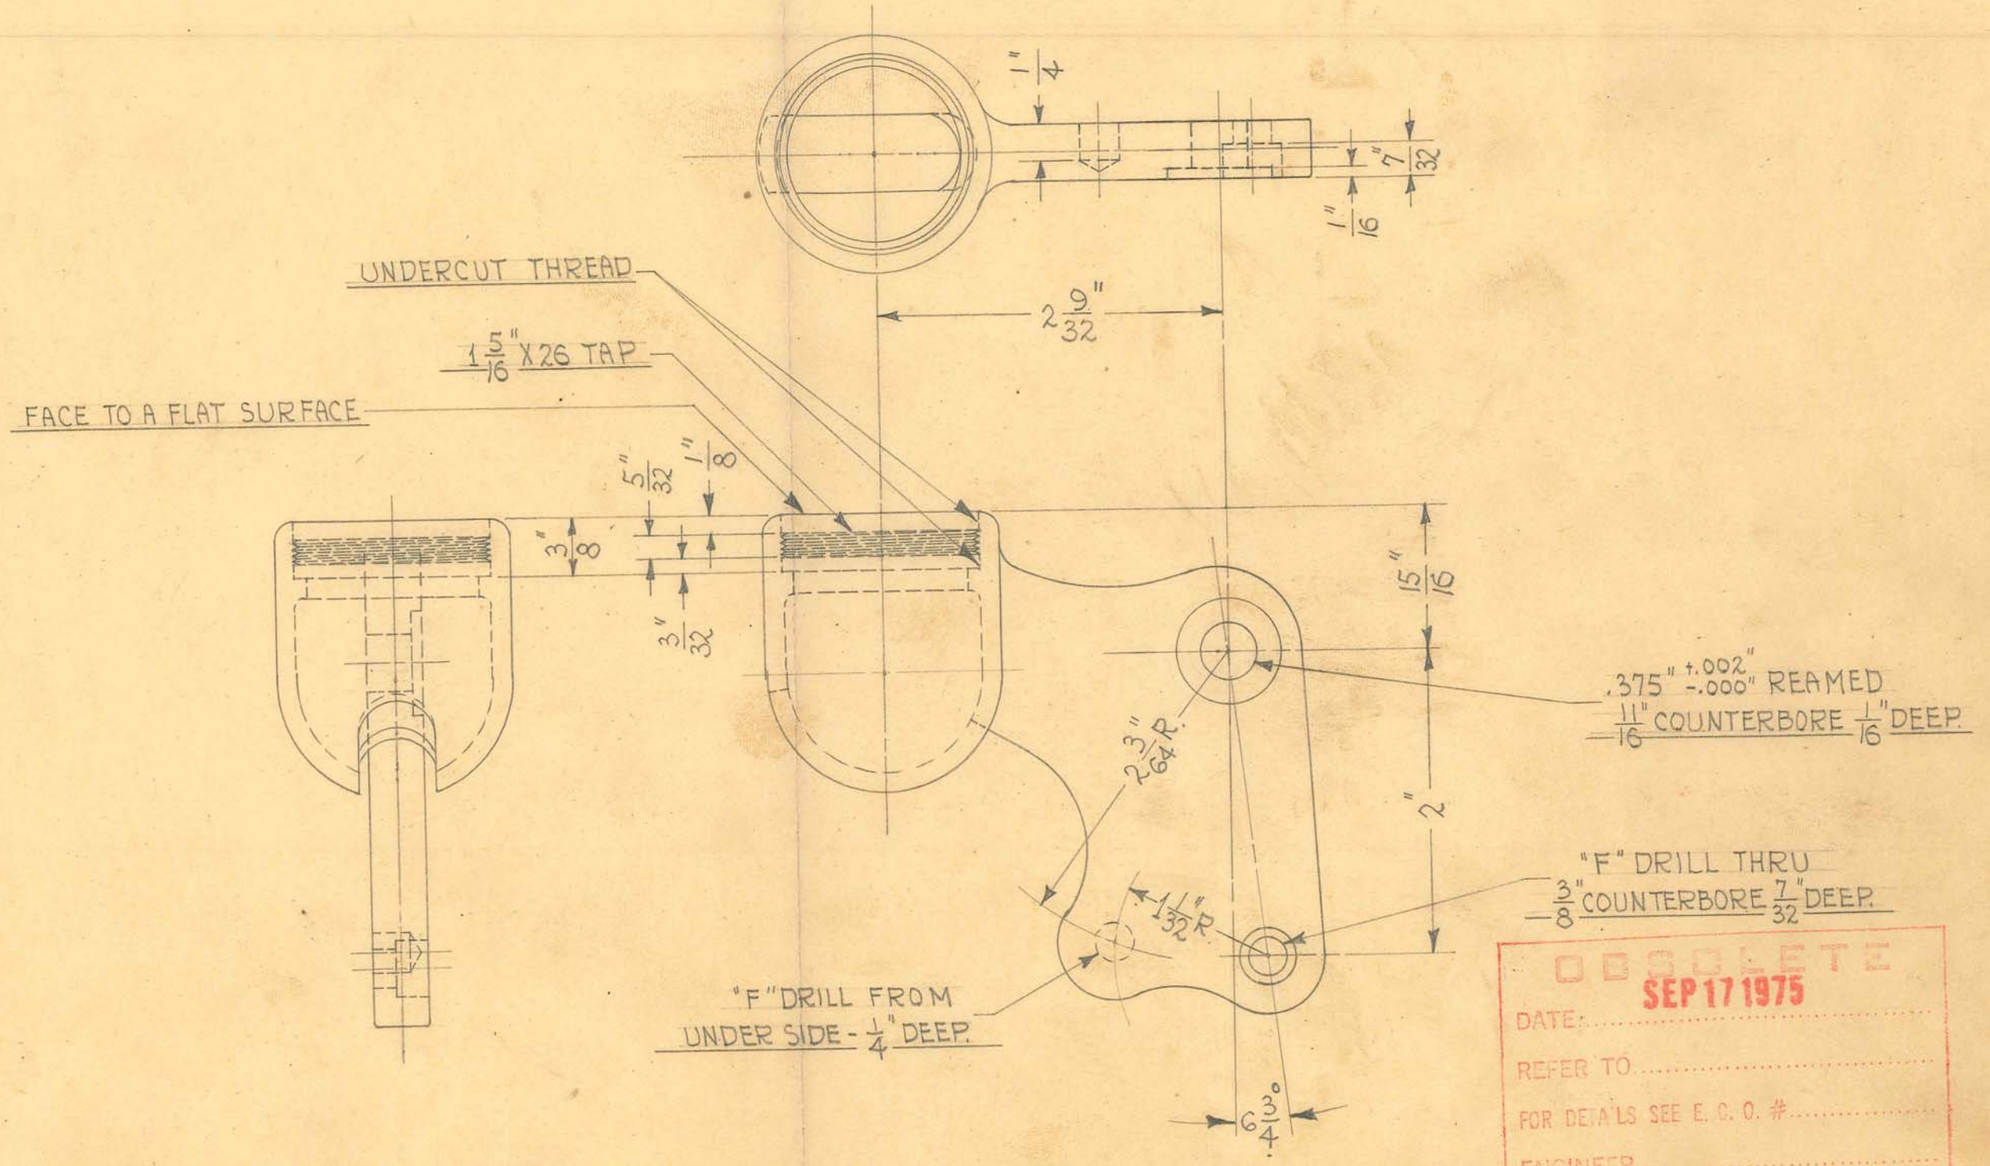

1 REQUIRED

#214 ALUMINUM 7-11-50

OBSOLETE
SEP 17 1975
DATE:
REFER TO:
FOR DETAILS SEE E. C. O. #:
ENGINEER:
DRAFTSMAN:

SIZE		ISSUE 2-12-40	H.E.
KIND	~~ALUMINUM~~	CHANGED 4-1-44	H.E.
SHAPE	~~CASTING~~	" 7-11-50	J.V.W.
FINISH	PAINTED	"	
TEMP.		"	
PATT.	1490	"	

TITLE: WALL MODEL DENTAL X-RAY UNIT-
COUNTERBALANCE SPRING & TUBE SUPP. - RIGHT

H. G. FISCHER & CO.
2335 WABANSIA AVE.
CHICAGO, ILL.

CAT. NO.

PART NO. 12354CF

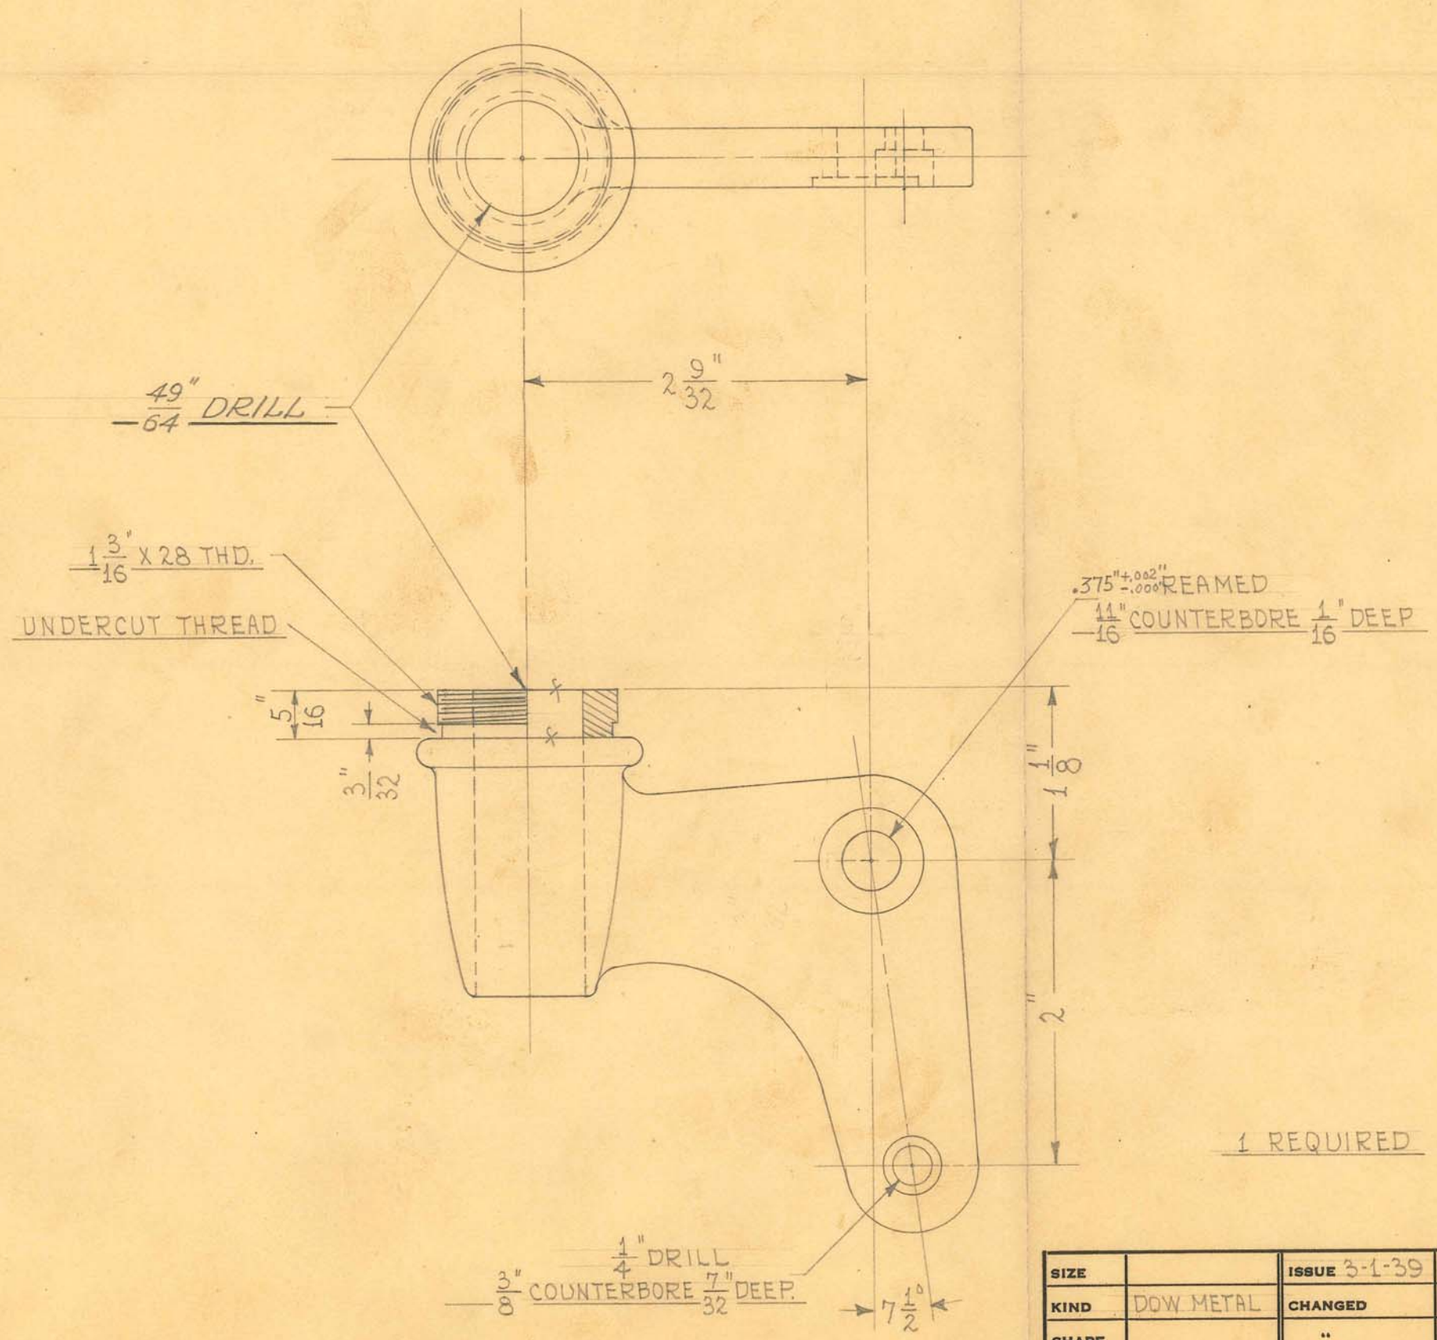

1 REQUIRED

OBSOLETE

Obsolete

SIZE		ISSUE 3-1-39	HE
KIND	DOW METAL	CHANGED	
SHAPE		"	
FINISH	PAINTED	"	
TEMP.		"	
PATT.	1299	"	

TITLE: WALL MODEL DENTAL X-RAY UNIT- COUNTERBALANCE SPRING & TUBE SUPP.- RIGHT

H. G. FISCHER & CO.
2335 WABANSIA AVE.
CHICAGO, ILL.

CAT. NO.

PART NO. 12354F

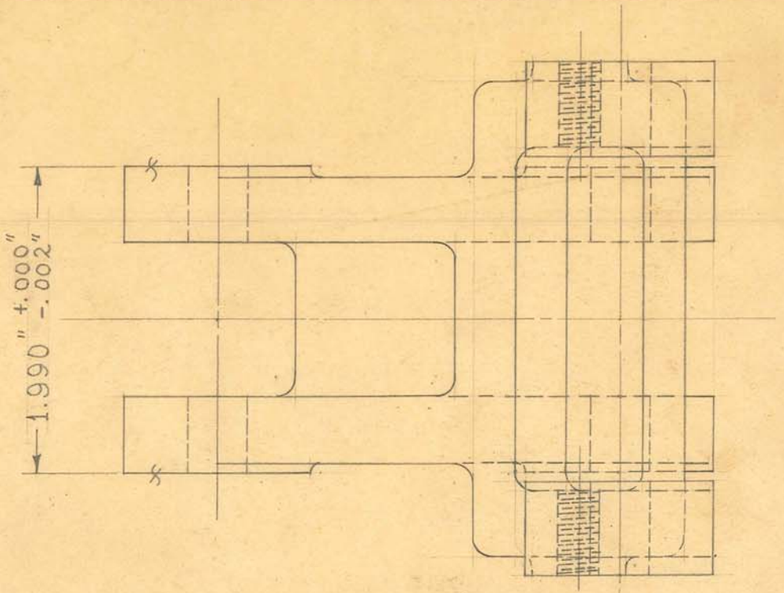

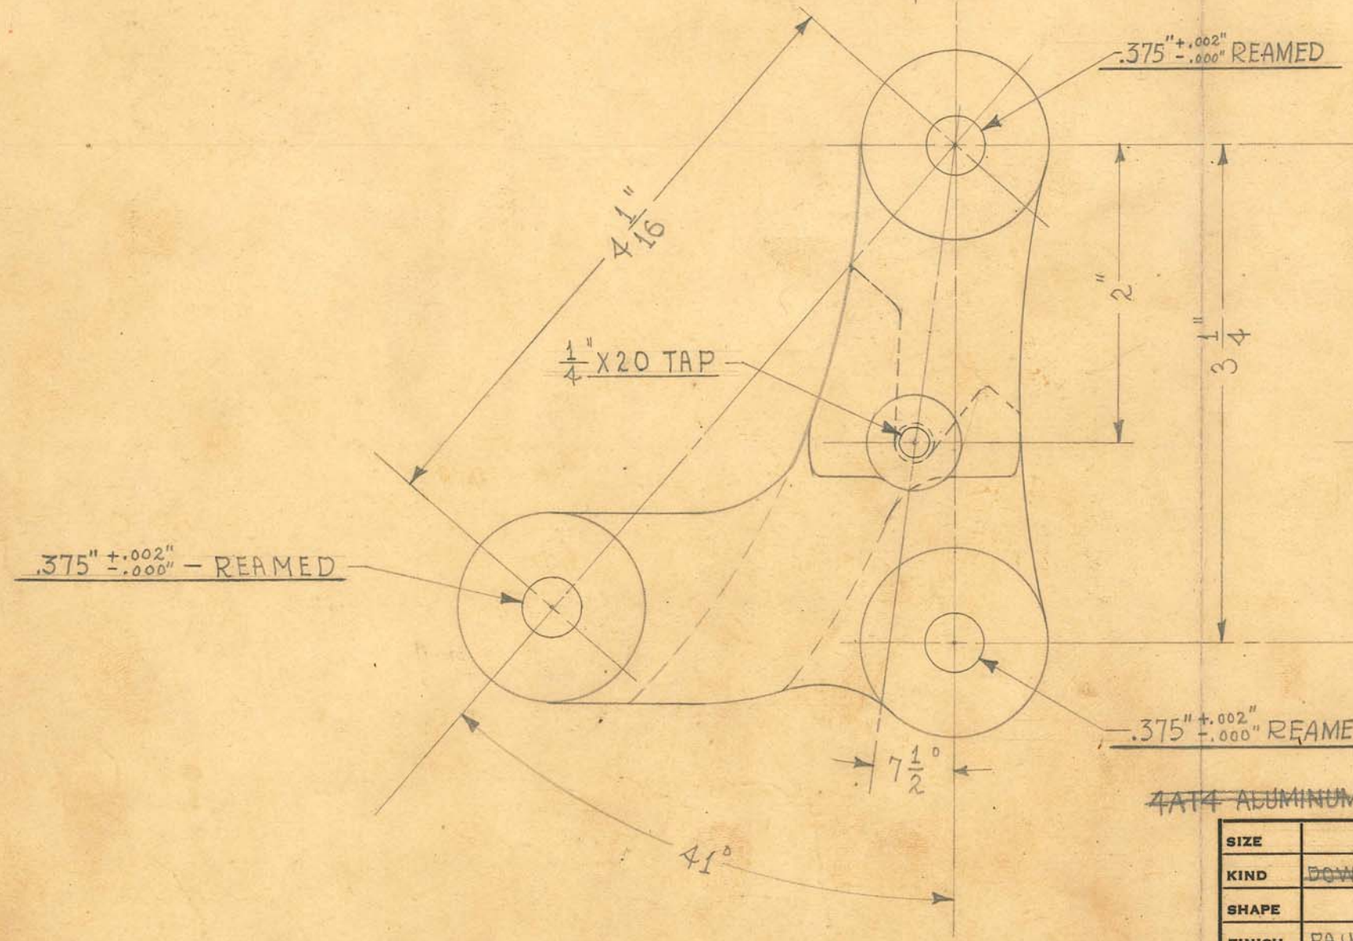

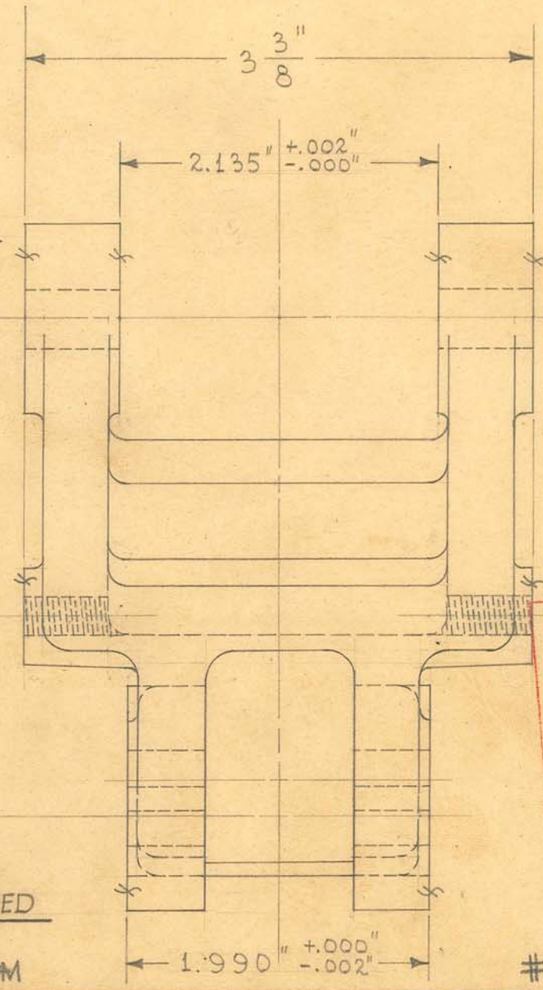

~~4AT4 ALUMINUM~~

#214 ALUMINUM 7-11-50

OBSOLETE
SEP 17 1975
DATE
REFER TO
FOR DETAILS SEE E. C. O. #
ENGINEER
DRAFTSMAN

SIZE		ISSUE 3-2-39	H.E.
KIND	~~DOW METAL~~	CHANGED	
SHAPE		" 7-11-50	J.V.W.
FINISH	PAINTED	"	
TEMP.		"	
PATT.	1300	"	

TITLE: WALL MODEL DENTAL X-RAY UNIT- COUNTERBALANCE SUPPORT

H. G. FISCHER & CO.
2335 WABANSIA AVE.
CHICAGO, ILL.

CAT. NO.

PART NO. 12375BF

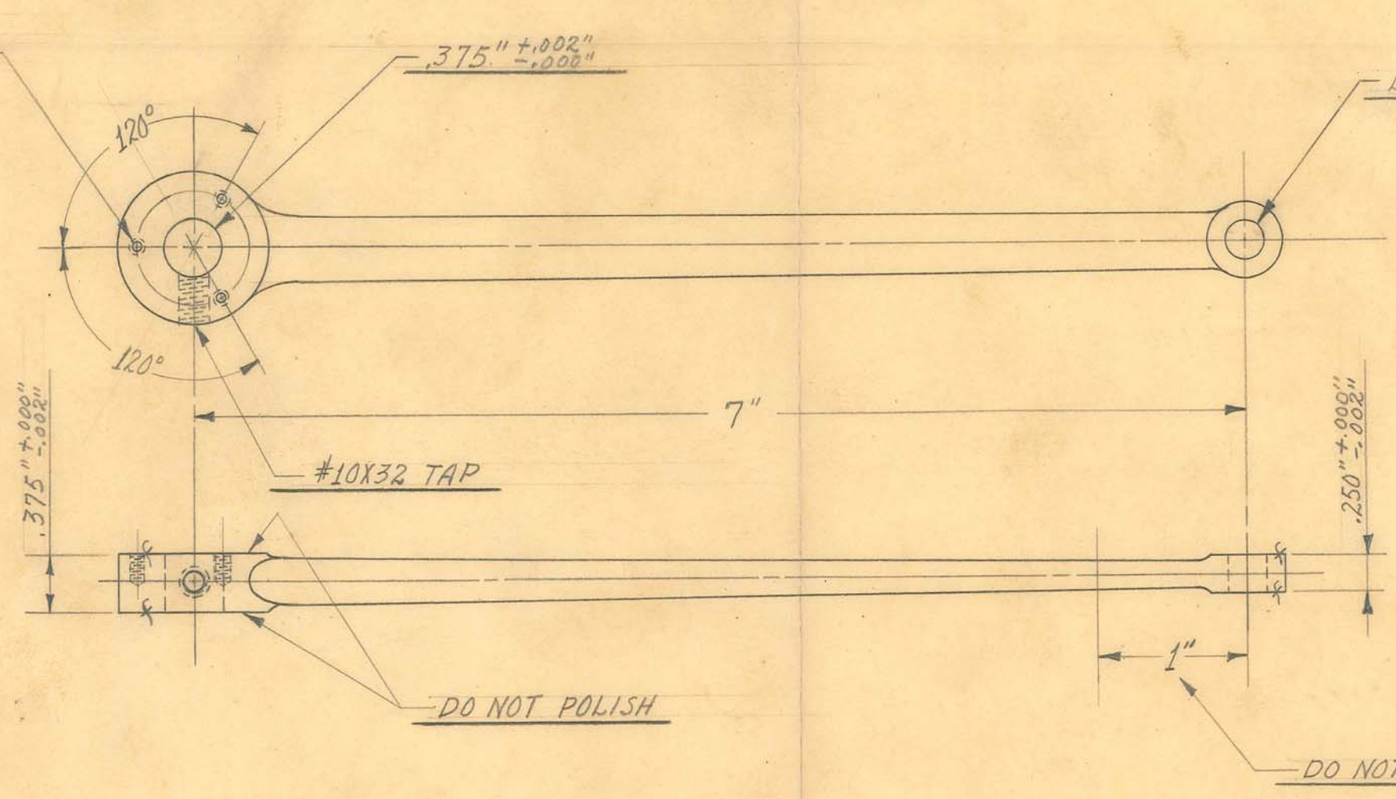

2 REQUIRED

OBSOLETE
SEP 17 1975
DATE
REFER TO
FOR DETAILS SEE E. C. O. #
ENGINEER
DRAFTSMAN

FINISH:
CHROME #2 & POLISH EXCEPT
WHERE MARKED (DO NOT POLISH)

SIZE	BRONZE	ISSUE 1-29-40	J.W.
KIND	CASTING	CHANGED	
SHAPE		"	
FINISH	CHROME #2 SEE NOTE	"	
TEMP.		"	
PATT.	1489	"	

TITLE:
WALL MODEL DENTAL X-RAY UNIT
COUNTERBALANCE CONNECTING ROD
-RIGHT

H. G. FISCHER & CO.
2335 WABANSIA AVE.
CHICAGO. ILL.

CAT. NO.

PART NO. 12405 1/2

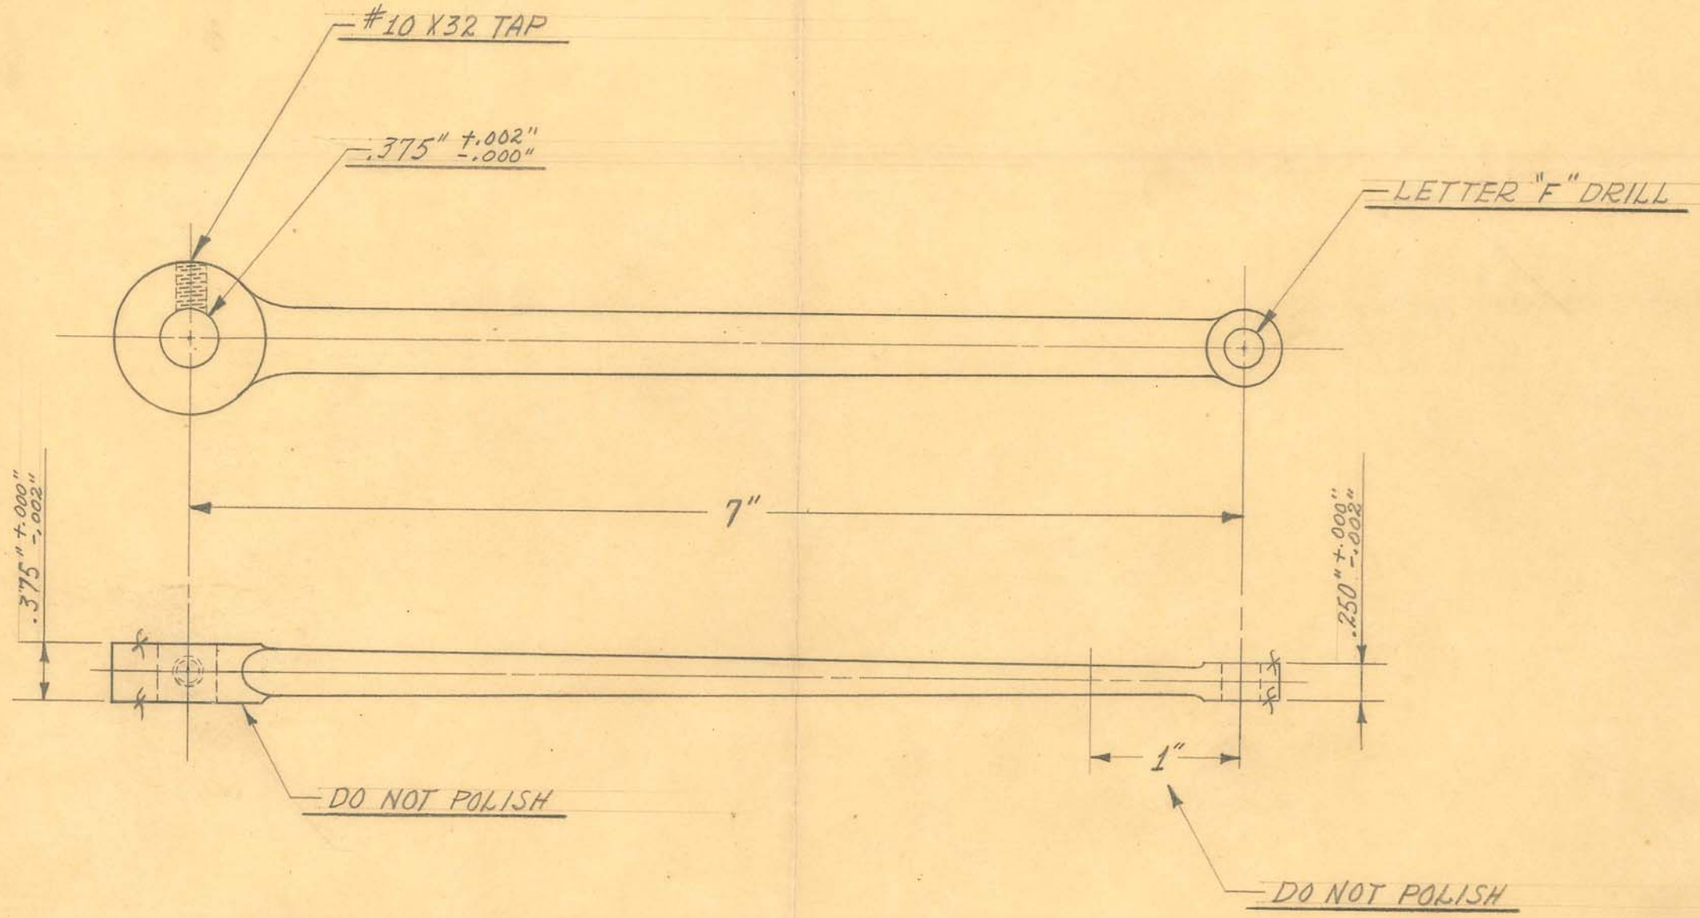

1 REQUIRED

FINISH:
CHROME #2 & POLISH EXCEPT
WHERE MARKED (DO NOT POLISH)

OBSOLETE obsolete

SIZE	BRONZE	ISSUE 1-29-40	J.W.
KIND	CASTING	CHANGED	
SHAPE		"	
FINISH	CHROME #2 SEE NOTE	"	
TEMP.		"	
PATT.	1489	"	

TITLE:
WALL MODEL DENTAL X-RAY UNIT
COUNTERBALANCE CONNECTING ROD
-LEFT

H. G. FISCHER & CO.
2335 WABANSIA AVE.
CHICAGO, ILL.

CAT. NO.

PART NO. 12406 1/2 F

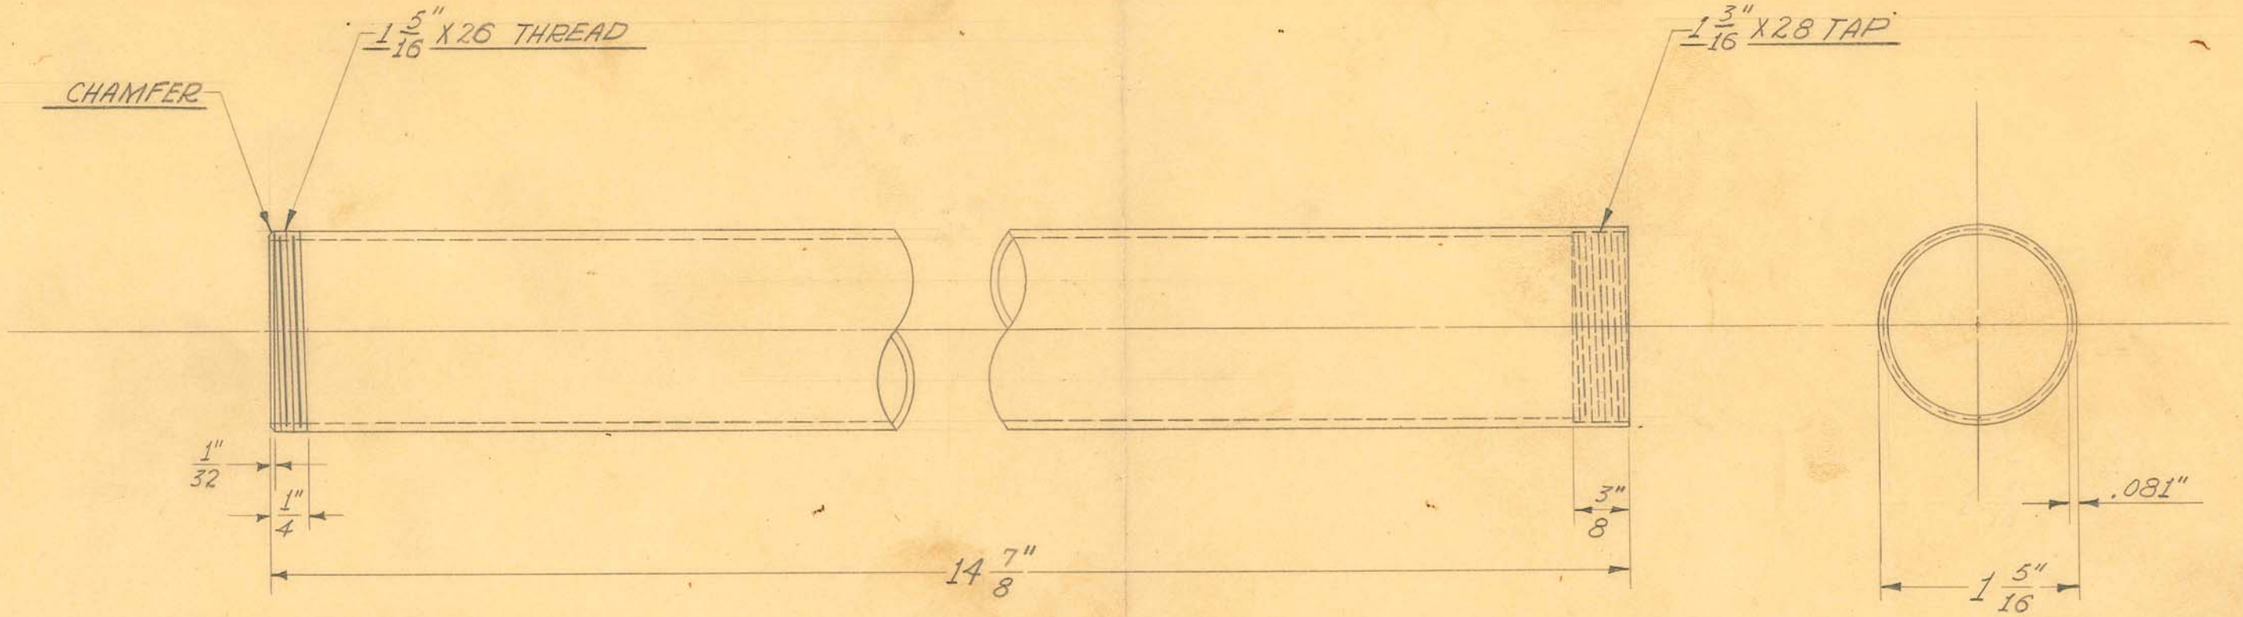

2 REQUIRED

OBSOLETE

Obsolete

SIZE	1 5/16" O.D. X .081 W.	ISSUE 3-2-39	J.W.
KIND	BRASS	CHANGED	
SHAPE	TUBING	"	
FINISH	PAINTED	"	
TEMP.		"	
PATT.		"	

TITLE: WALL MODEL DENTAL "X-RAY" UNIT
COUNTERBALANCE TUBE

H. G. FISCHER & CO.
2335 WABANSIA AVE.
CHICAGO, ILL.

CAT. NO.

PART NO. 12409A

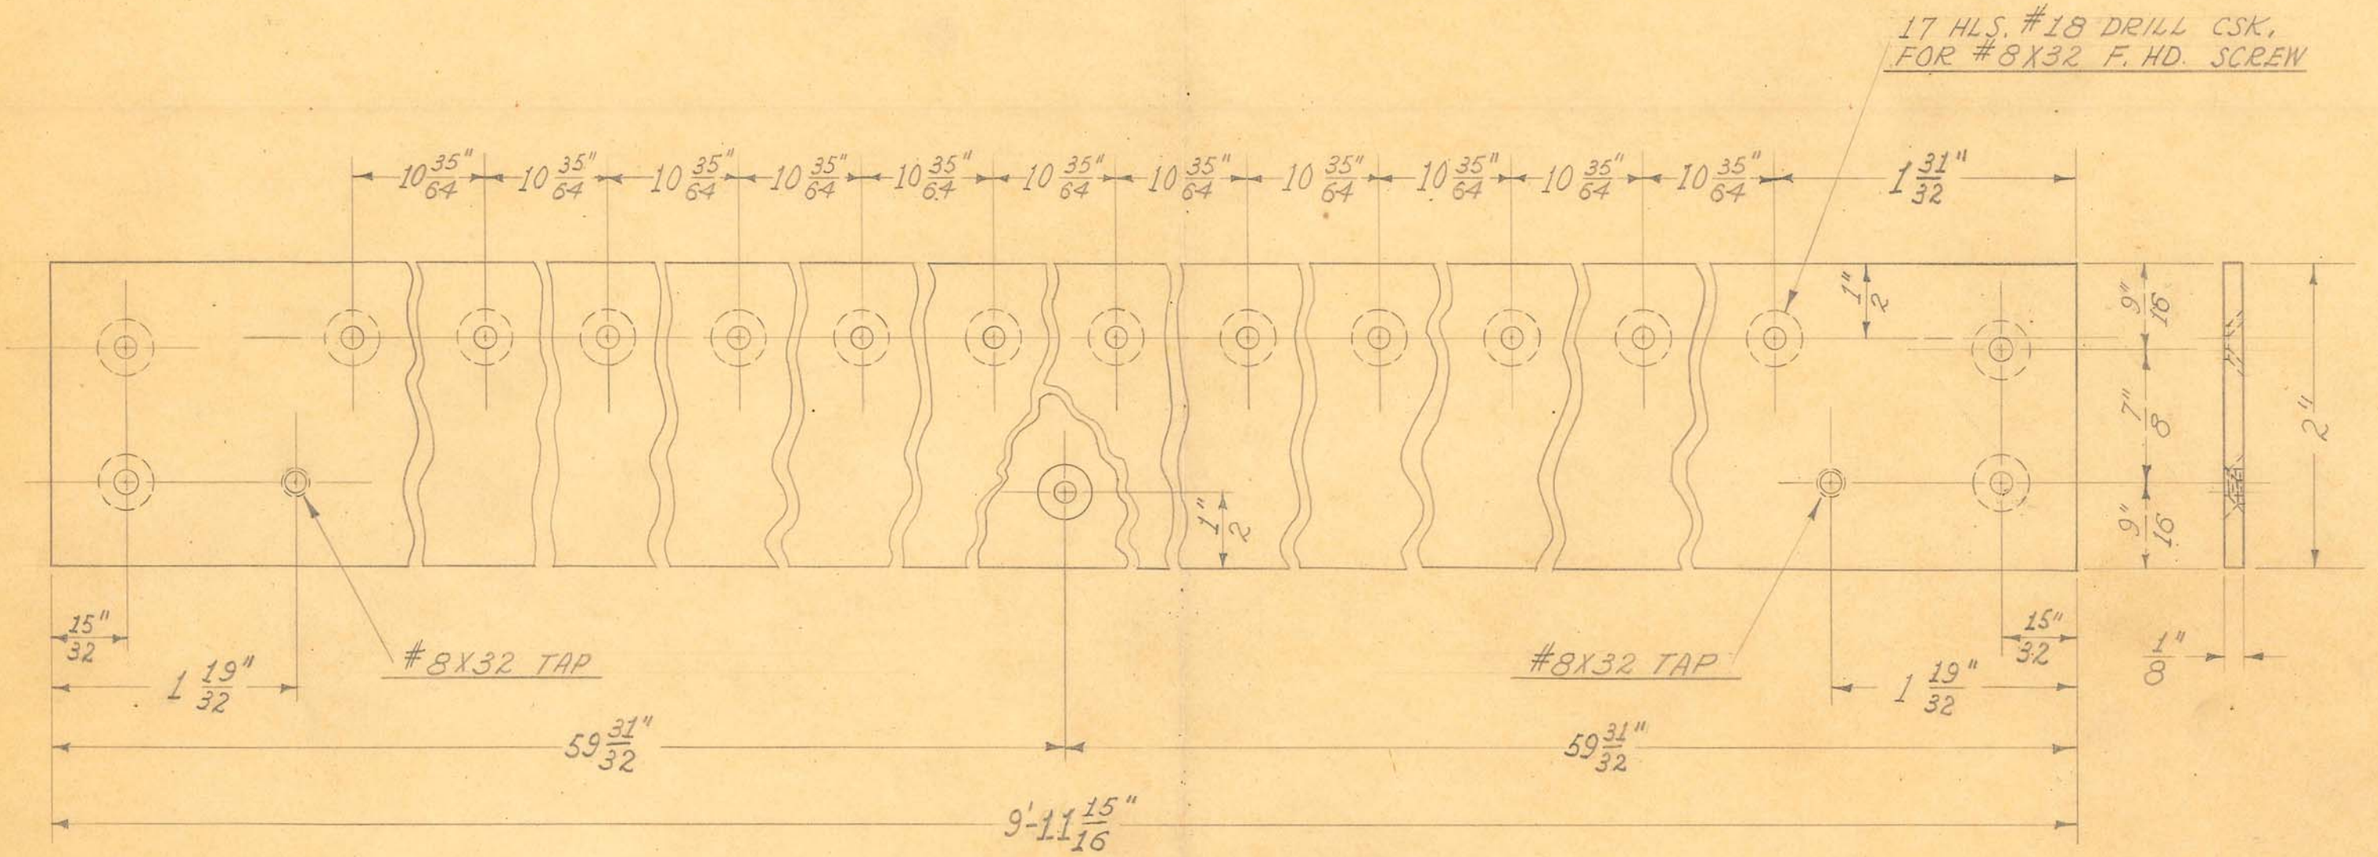

1 REQUIRED

OBSOLETE

SIZE	1/8" X 2"	ISSUE 3-20-37	J.W.	TITLE: FISCHER "SP-60" & "DSP-20" 10' RAIL RAIL PLATE
KIND	C.R. STEEL	CHANGED		
SHAPE		"		
FINISH	CAD. & LAC.	"		
TEMP.	#26	"		
PATT.		"		

H. G. FISCHER & CO.
2335 WABANSIA AVE.
CHICAGO, ILL.

CAT. NO.

PART NO. 10334A

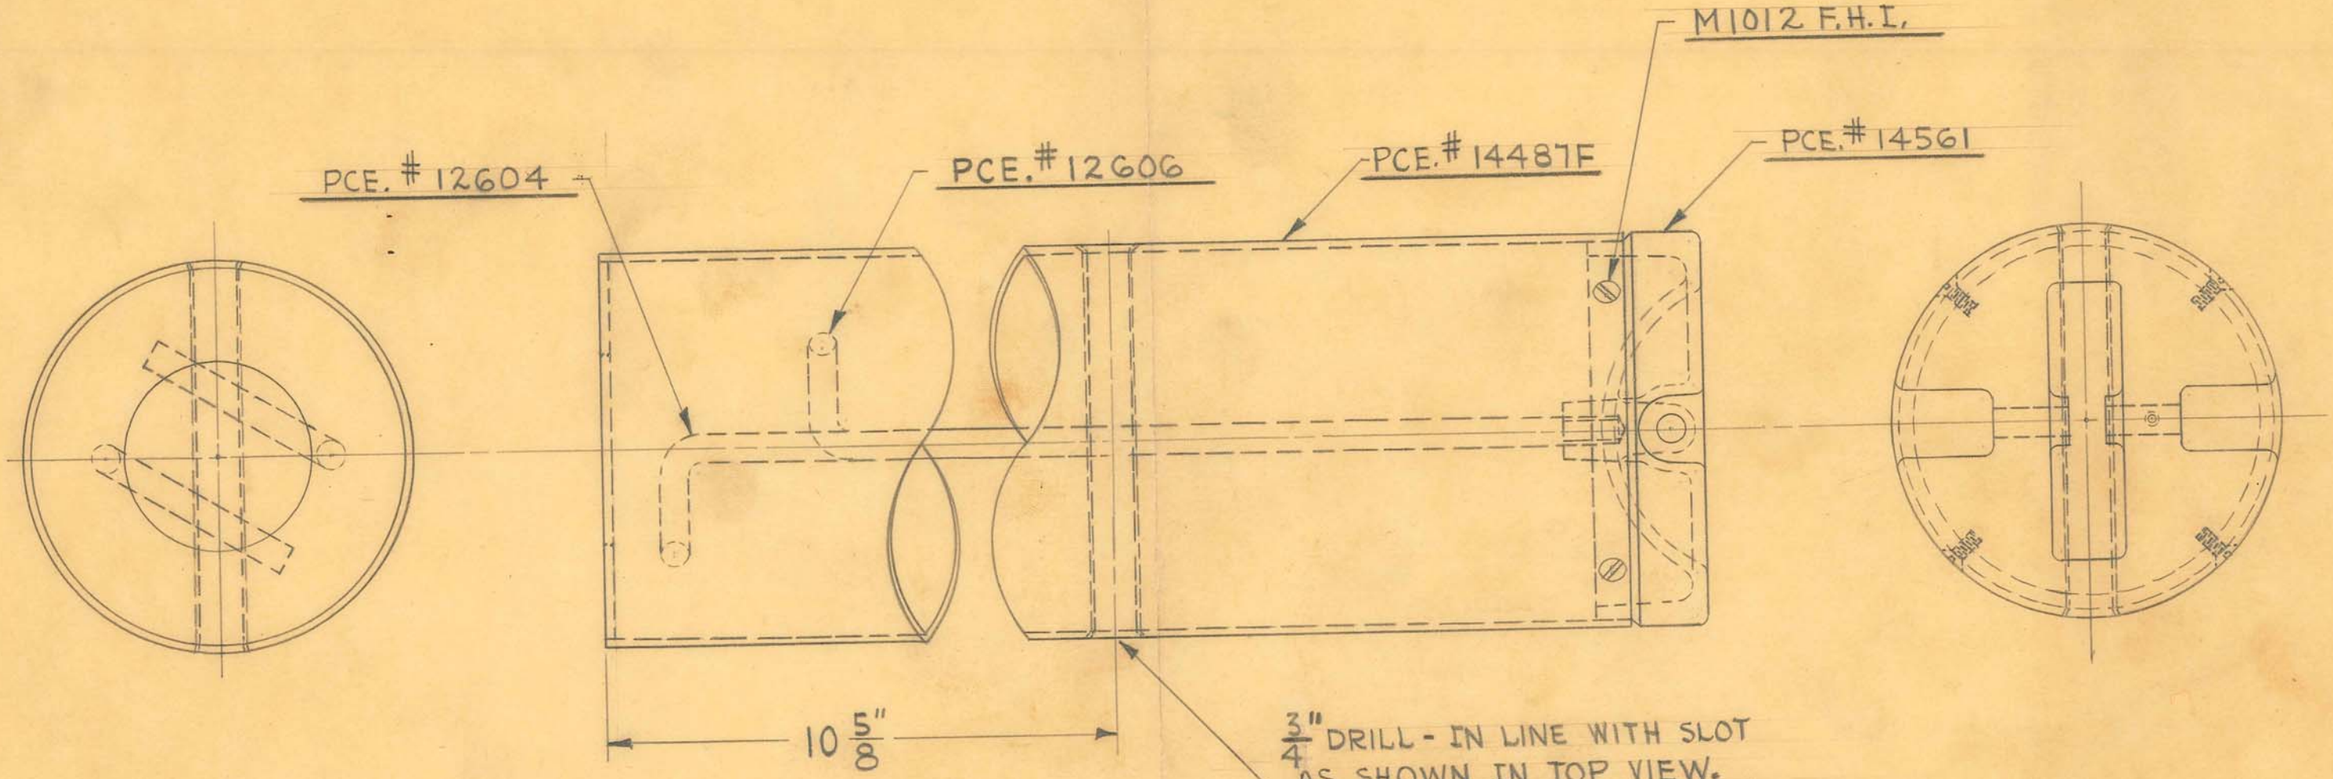

SCREW RODS INTO TOP CAP AS SHOWN.
FASTEN TUBE TO TOP CAP WITH #10X32 SCREWS.
FILL WITH LEAD SO THAT TOTAL WEIGHT = 134 LBS. PLUS 1 Lb. MINUS 1/2 Lb.

1 REQUIRED

OBSOLETE

ALUMINUM CASTINGS ON VERTICAL CARRIAGE

SIZE		ISSUE 11-13-46	J.V.W.	TITLE: FISCHER "TV-30-96" RAD. & FLUO. UNIT COUNTERWEIGHT ASSEMBLY
KIND		CHANGED		
SHAPE		" 12-24-46	J.V.W.	
FINISH		"		
TEMP.		"		
PATT.		"		

H. G. FISCHER & CO.
2335 WABANSIA AVE.
CHICAGO. ILL.

CAT. NO.

PART NO. 14488GA

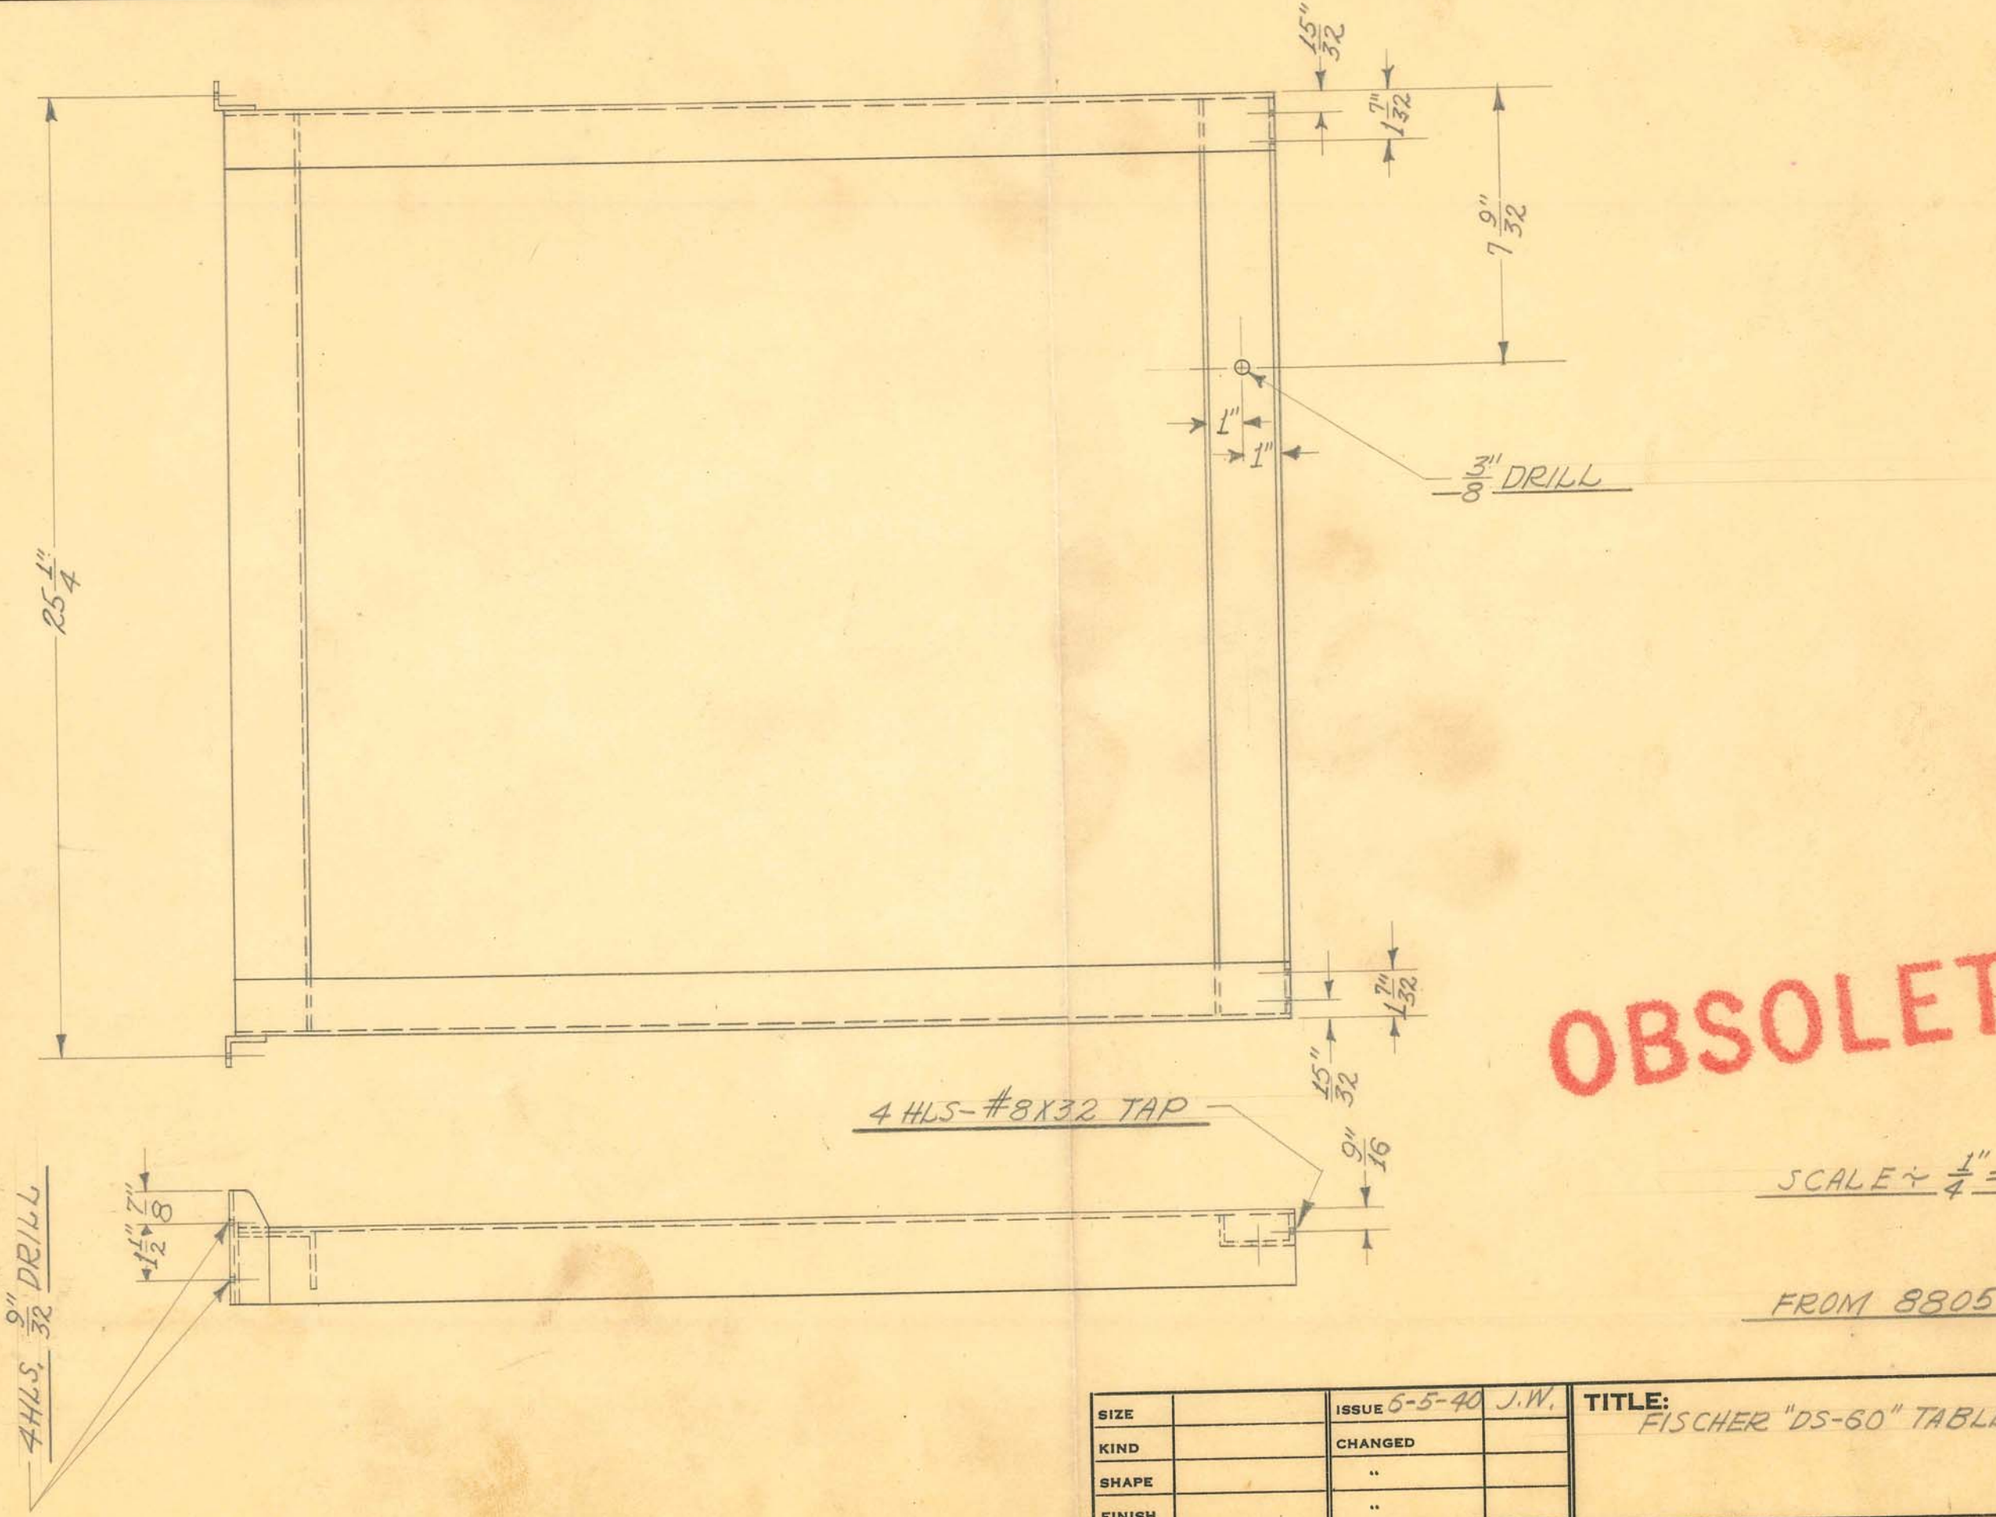

OBSOLETE

SCALE ~ 1/4" = 1"

FROM 8805

Obsolete

SIZE		ISSUE 6-5-40	J.W.	
KIND		CHANGED		
SHAPE		"		
FINISH		"		
TEMP.		"		
PATT.		"		

TITLE: FISCHER "DS-60" TABLE LEG (DRILLED)

H. G. FISCHER & CO.
2335 WABANSIA AVE.
CHICAGO. ILL.

CAT. NO.

PART NO. 8805F

ARC WELD SEAMS
GRIND END FLAT

$\frac{7}{16}$" DRILL

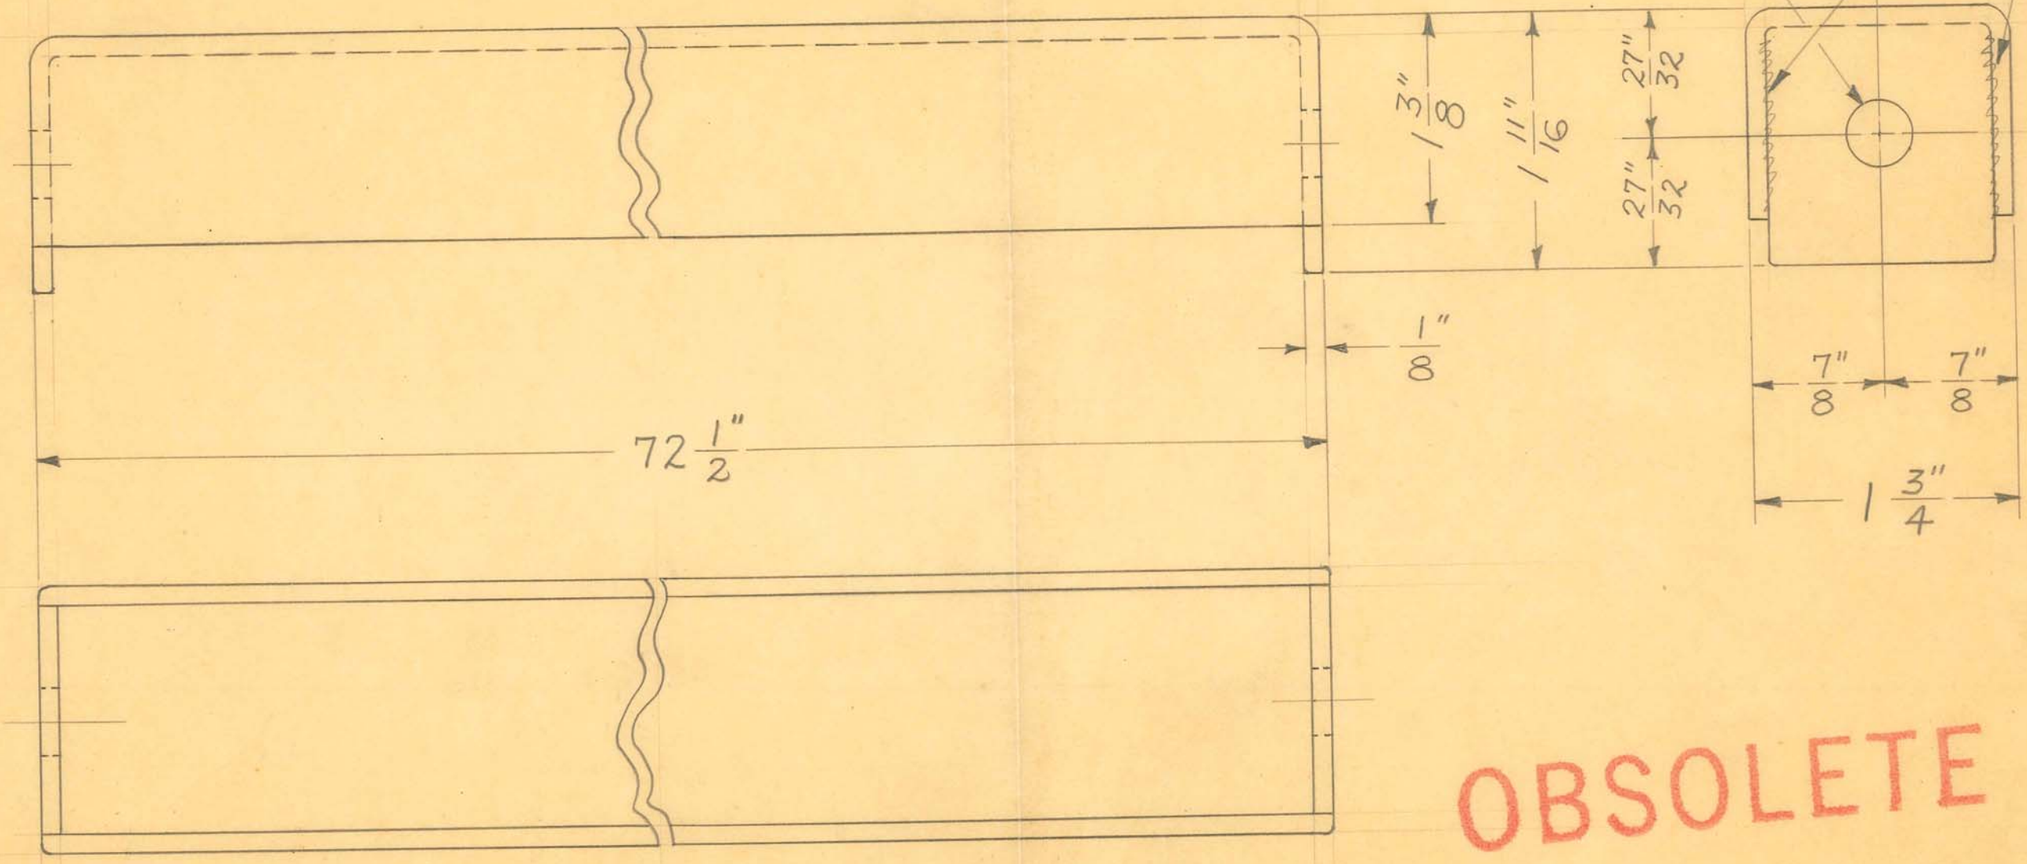

#11 GA. (.1196") SHEET COLD ROLLED STEEL

OBSOLETE

1 REQUIRED

SIZE		ISSUE 8-29-46	J.V.W.	TITLE: FISCHER RADIOGRAPHIC TABLE CENTER SUPPORT CHANNEL
KIND		CHANGED		
SHAPE		"		
FINISH	PAINTED	"		
TEMP.		"		
PATT.		"		

H. G. FISCHER & CO.
2335 WABANSIA AVE.
CHICAGO, ILL.

CAT. NO.

PART NO. 8809 1/2

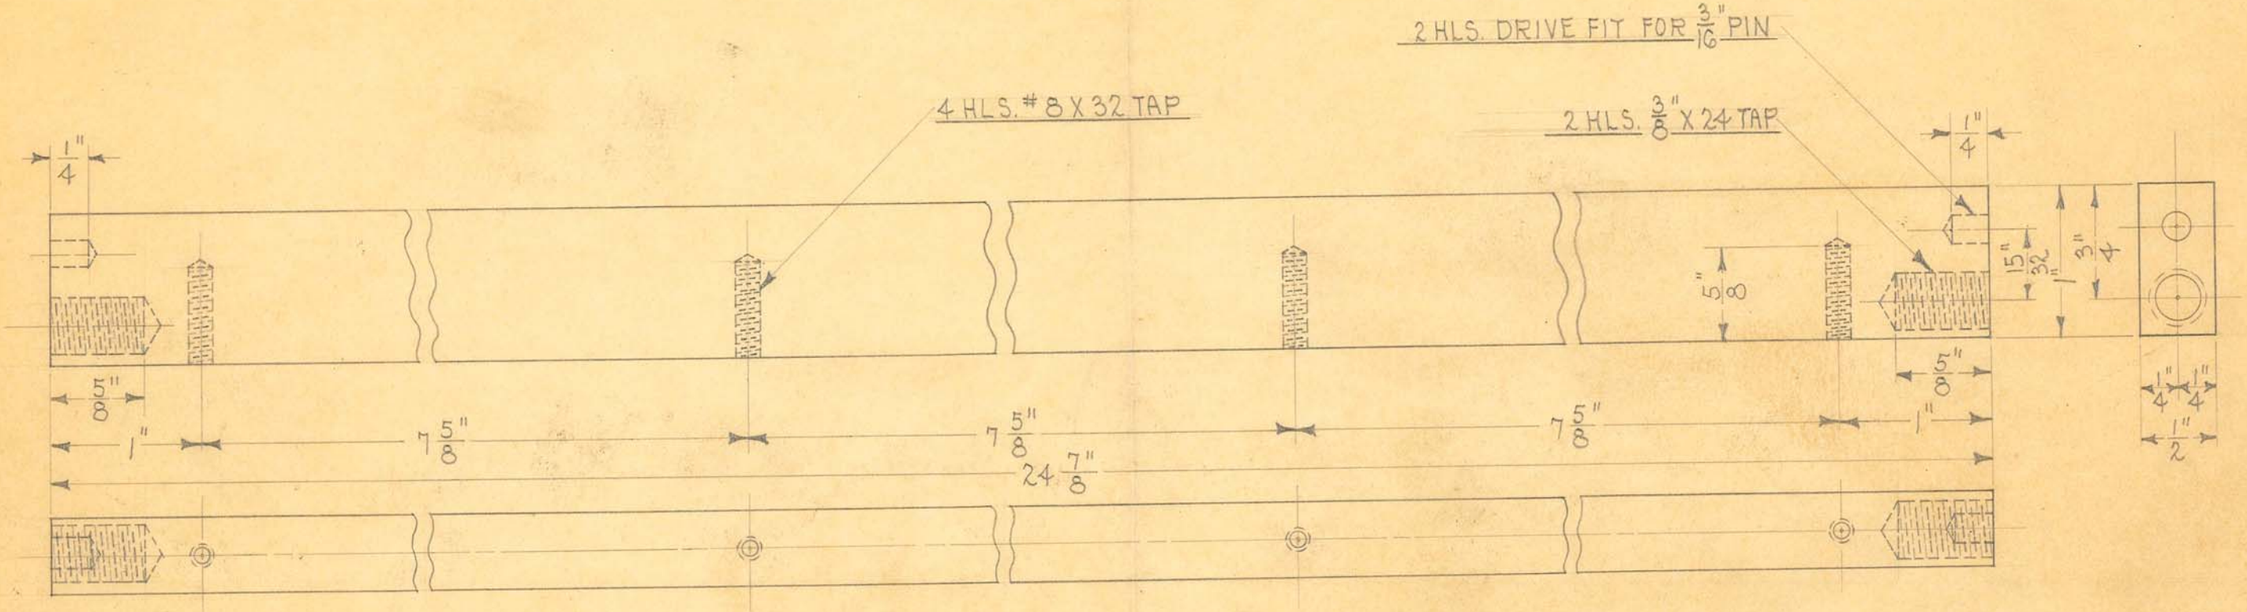

2 REQUIRED

OBSOLETE

SIZE	1/2" X 1"	ISSUE 7-20-34	A.E.	TITLE: FISCHER "D-S-CO" TABLE END SPACING BAR
KIND	C.R. STEEL	CHANGED		
SHAPE		" "		
FINISH	CADMIUM #23	" "		
TEMP.		" "		
PATT.		" "		

H. G. FISCHER & CO.
2335 WABANSIA AVE.
CHICAGO, ILL.

CAT. NO.

PART NO. 8811

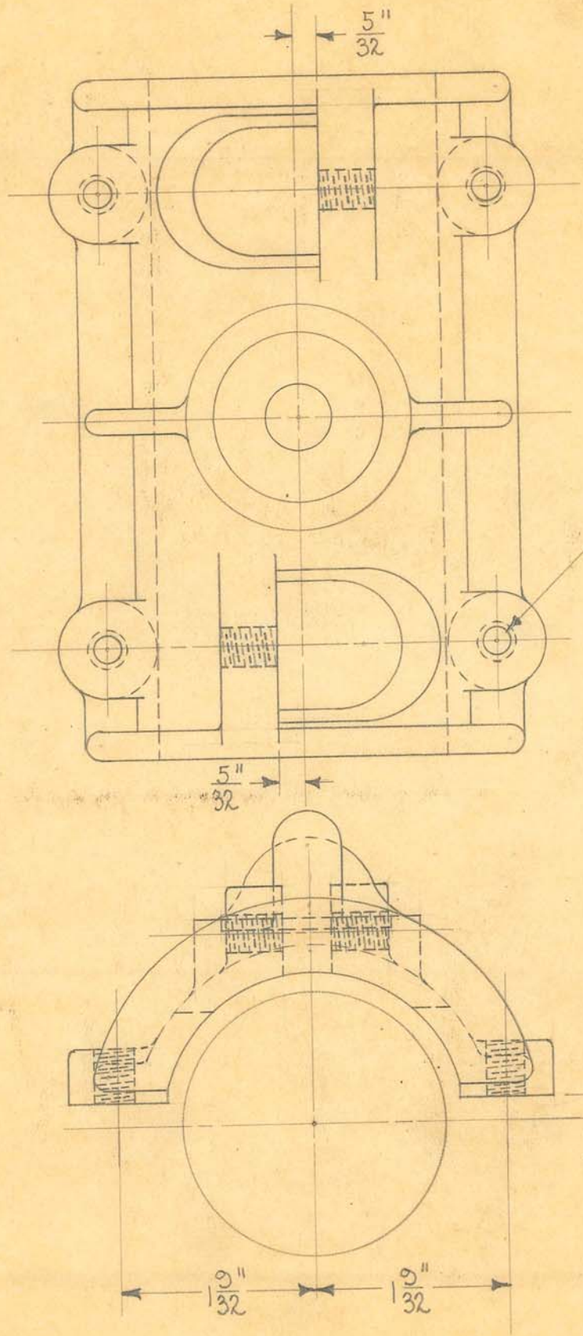

6 HLS. 1/4" X 20 TAP

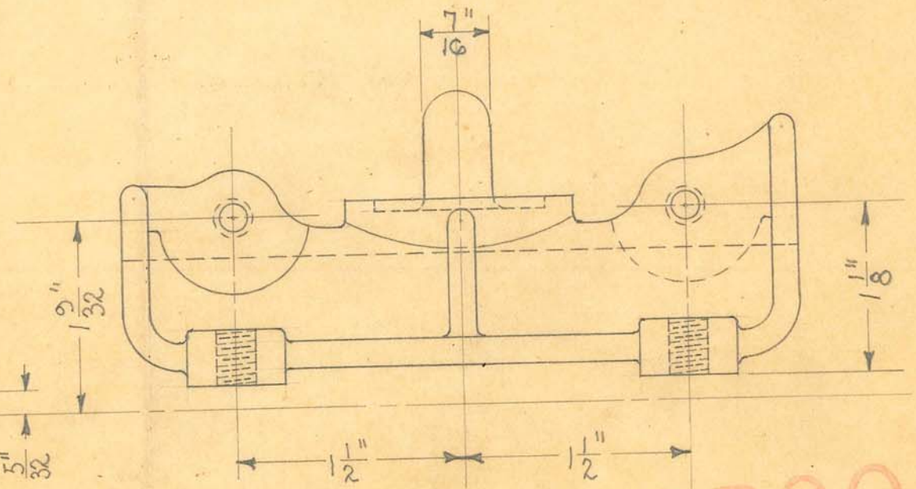

2 REQUIRED

OBSOLETE

SIZE		ISSUE 3-30-34	J.F.C.	TITLE: FISCHER "D-S-GO" TABLE TUBE RAIL BALL BEARING SUPPORT
KIND	IRON CASTING	CHANGED		
SHAPE		" "		
FINISH	BLK. LACQUER	" "		H. G. FISCHER & CO. 2335 WABANSIA AVE. CHICAGO, ILL. — CAT. NO. — PART NO. 8814F
TEMP.		" "		
PATT.	7682-693	" "		

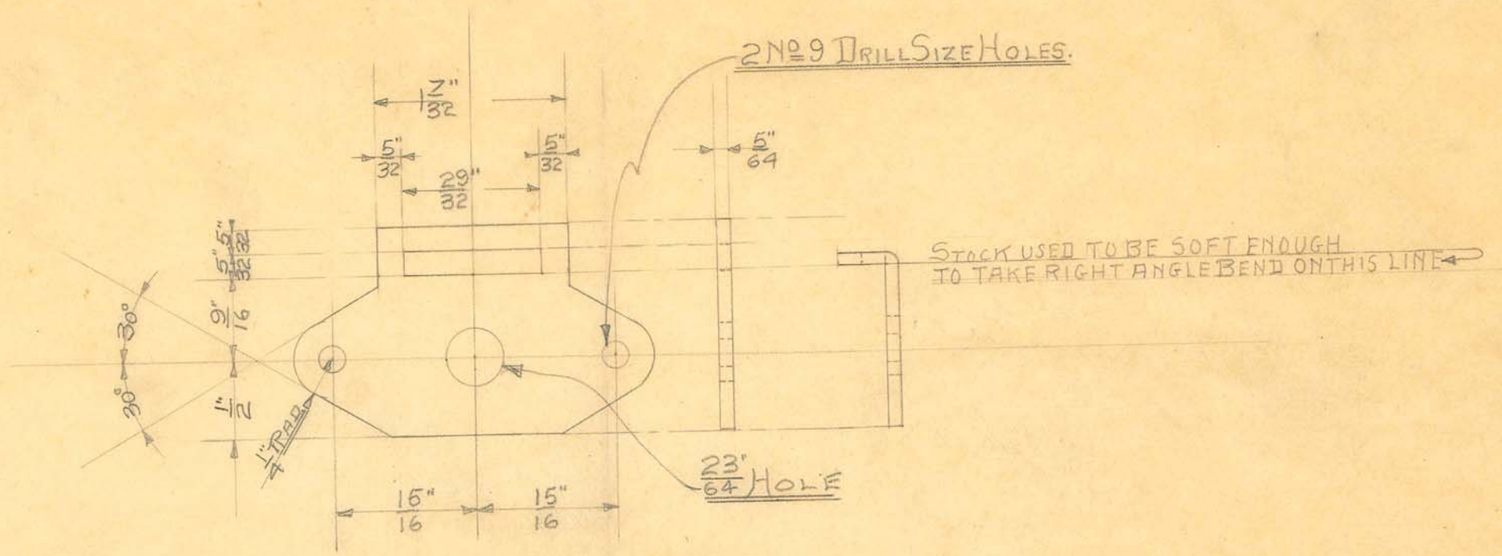

SIZE	5/64 Sheet	ISSUE 3-7-34	HWL.	TITLE: D.S. 60 UNIT BASE STOP RELEASE LEVER CLAMP PLATE - BLANK
KIND	Soft C.R. Steel	CHANGED		
SHAPE		" "		
FINISH		" "		
TEMP.		" "		
PATT.		" "		

H. G. FISCHER & CO.
2335 WABANSIA AVE.
CHICAGO, ILL.

CAT. NO.

PART NO. 8828

OBSOLETE

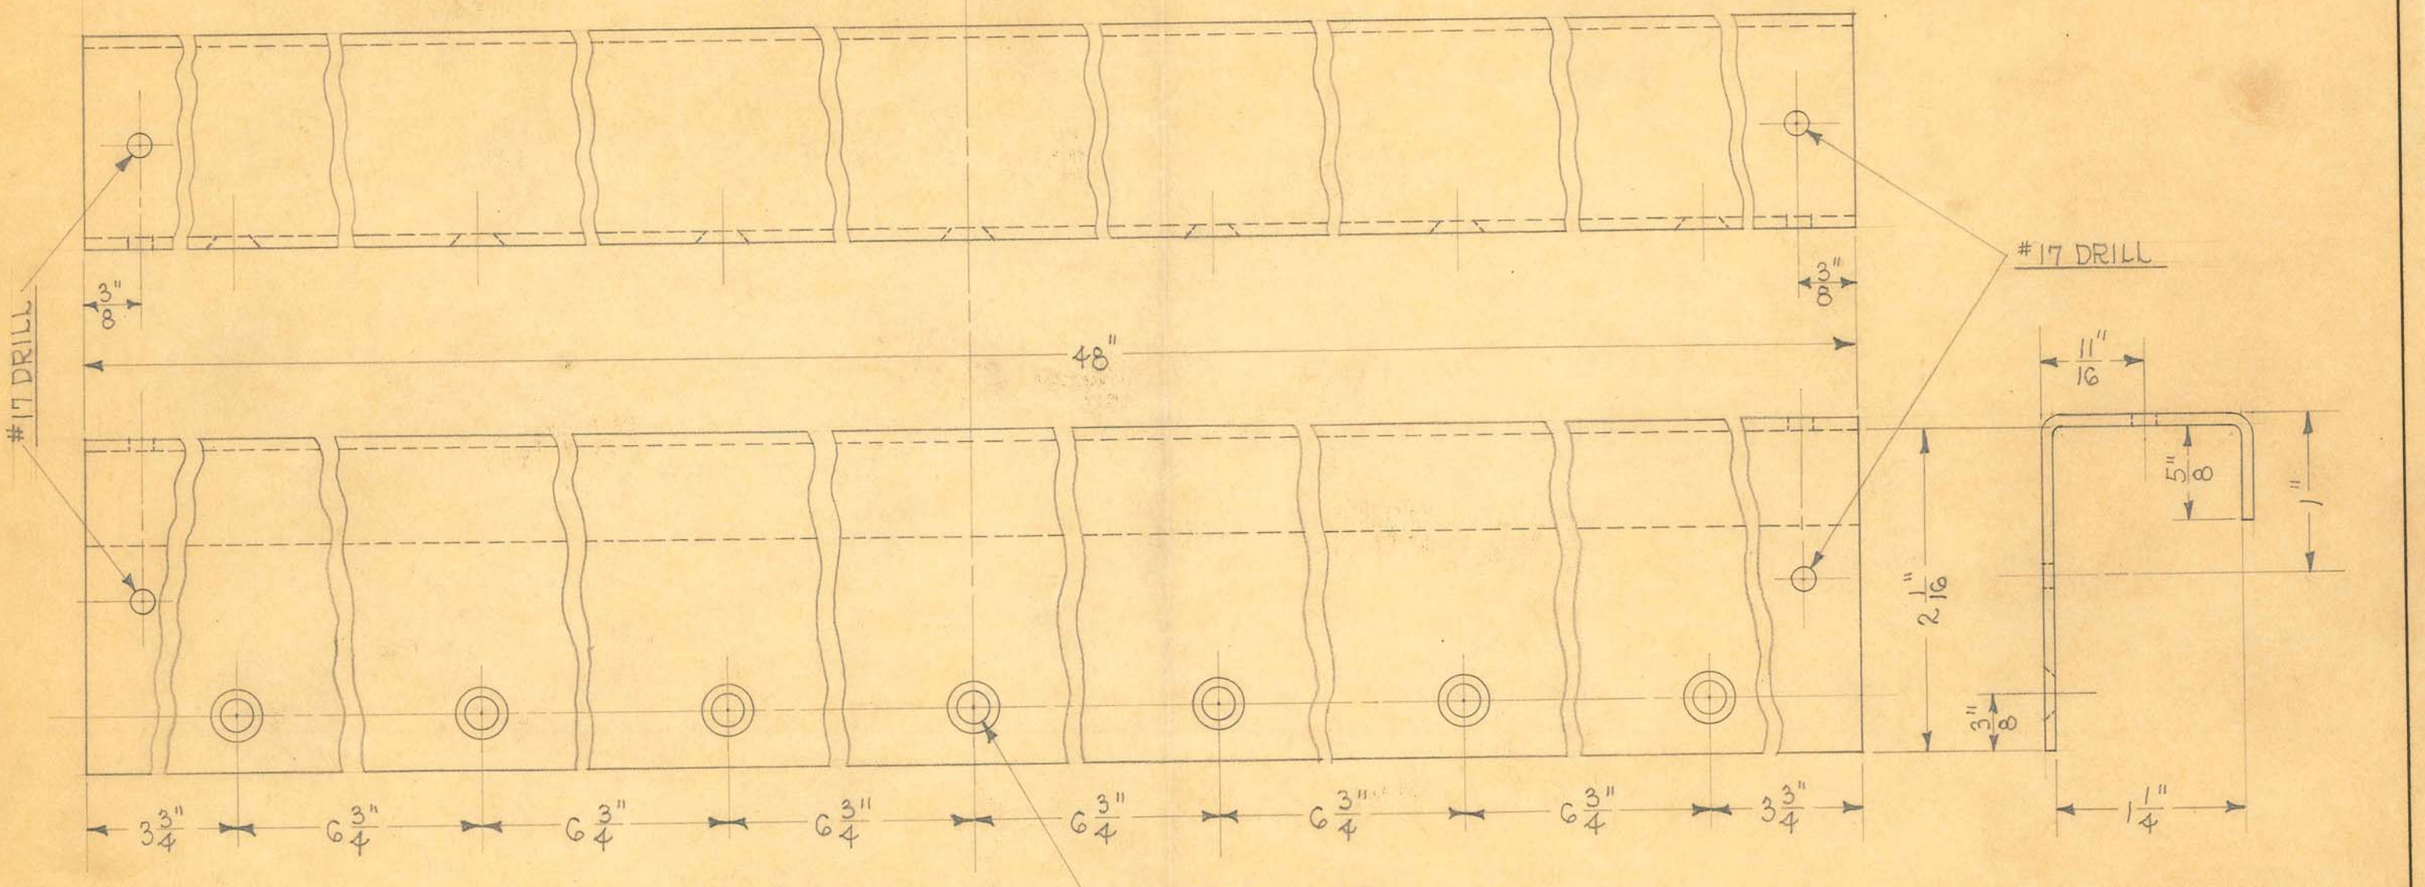

2 REQUIRED

OBSOLETE

SIZE	#14 GA. (.0781")	ISSUE 2-19-34	A.E.	TITLE: FISCHER "D-S-GO" UNIT PANEL CHANNEL (DRILLED)
KIND	SHEET STEEL	CHANGED		
SHAPE		" "		
FINISH	BLK. LACQUER	" "		
TEMP.		" "		
PATT.		" "		

H. G. FISCHER & CO.
2335 WABANSIA AVE.
CHICAGO, ILL.

CAT. NO.

PART NO. 8833F

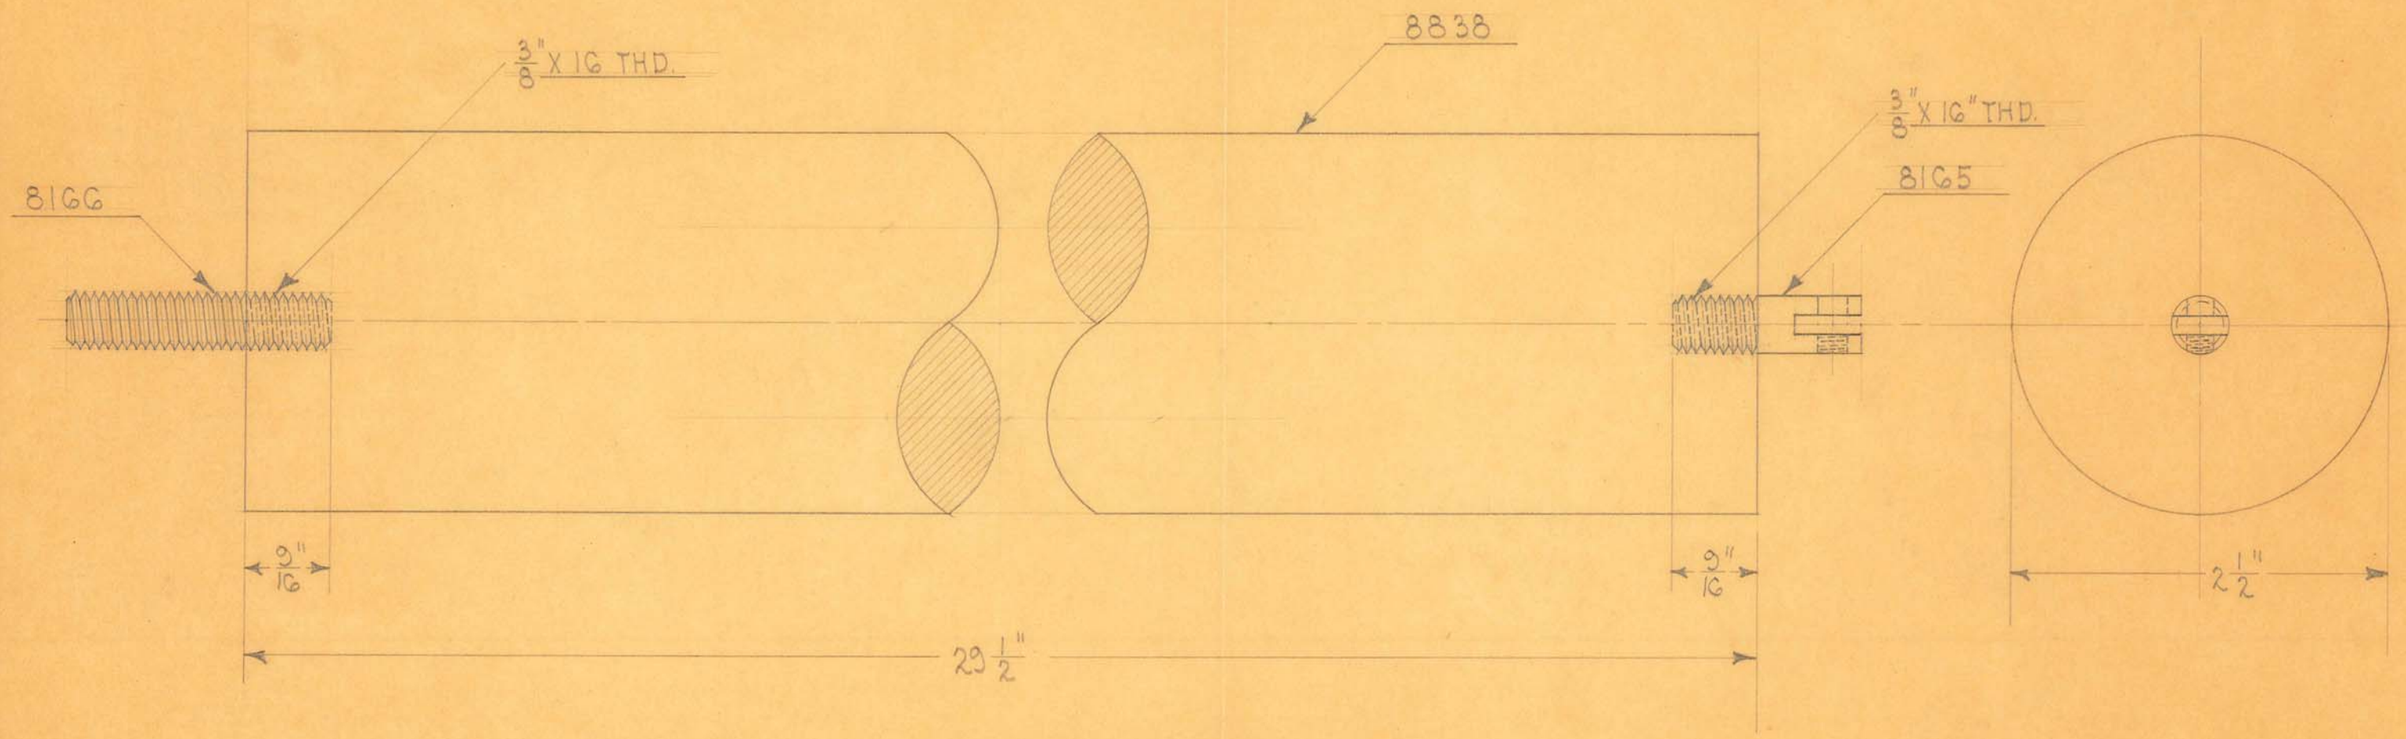

TOTAL WEIGHT- 41 LBS.

2 REQUIRED

OBSOLETE

SIZE		ISSUED 3-26-35	2/6
KIND		CHANGED	
SHAPE		" "	
FINISH		" "	
TEMP.		" "	
PATT.		" "	

TITLE: FISCHER "DS-GO" UNIT COUNERWEIGHT ASSEM.

H. G. FISCHER & CO.
2335 WABANSIA AVE.
CHICAGO, ILL.

CAT. NO.

PART NO. 8838G

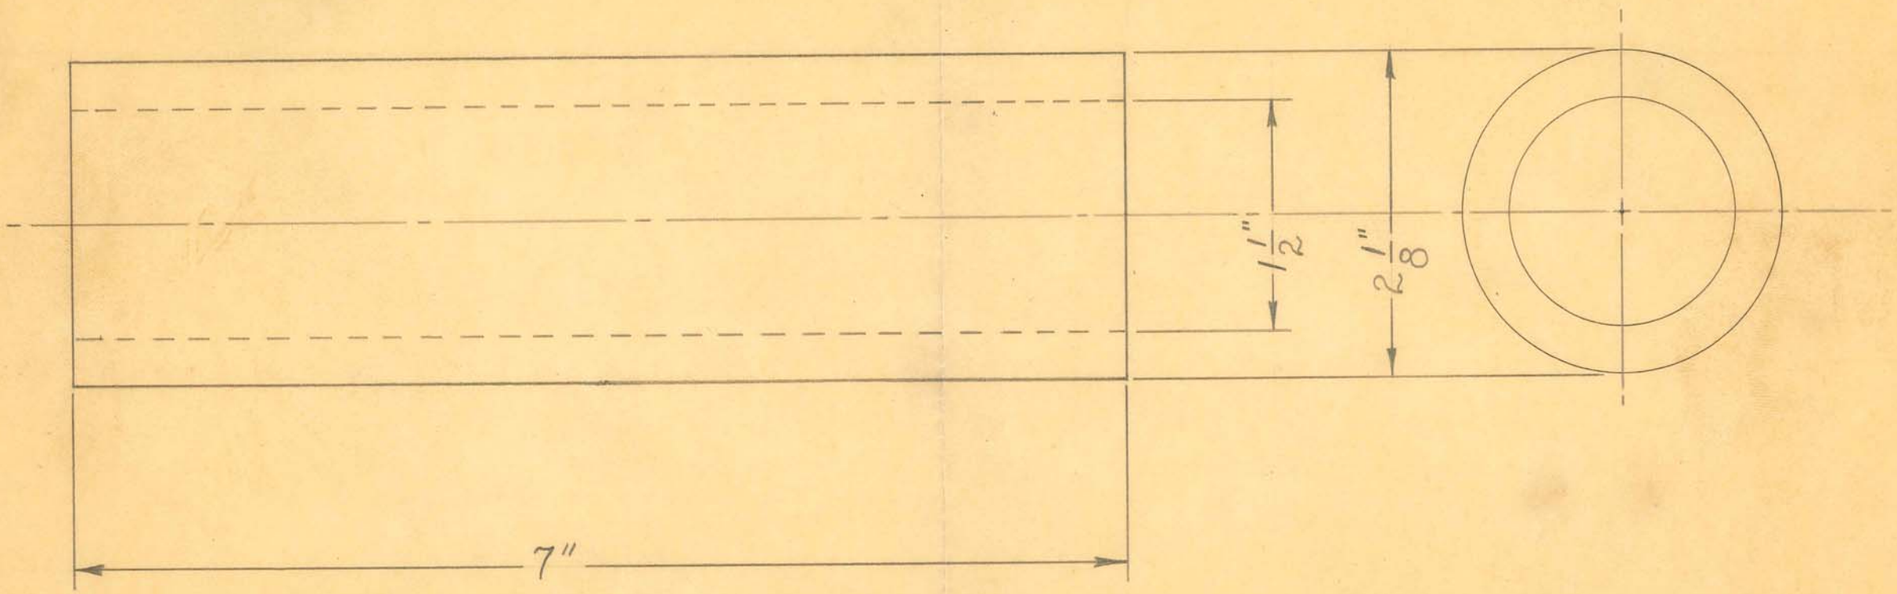

2 REQUIRED

OBSOLETE

2 1/8" O.D. X 1 1/2" I.D. HARD RUBBER TUBING

SIZE		ISSUE 6-18-47	W.J.	TITLE: FISCHER "PRECISION 200" X-RAY UNIT BROAD & FINE TRANSF. SECONDARY TUBE
KIND		CHANGED		
SHAPE		"		
FINISH		"		
TEMP.		"		
PATT.		"		

H. G. FISCHER & CO.
2335 WABANSIA AVE.
CHICAGO, ILL.

CAT. NO.

PART NO. 16901

BLACK SIDE UP

REMOVE GLOSS FROM PANEL
1" DIAMETER ON NATURAL SIDE.

3 HLS. - $\frac{5}{16}$" DRILL

46 HOLES - #18 DRILL

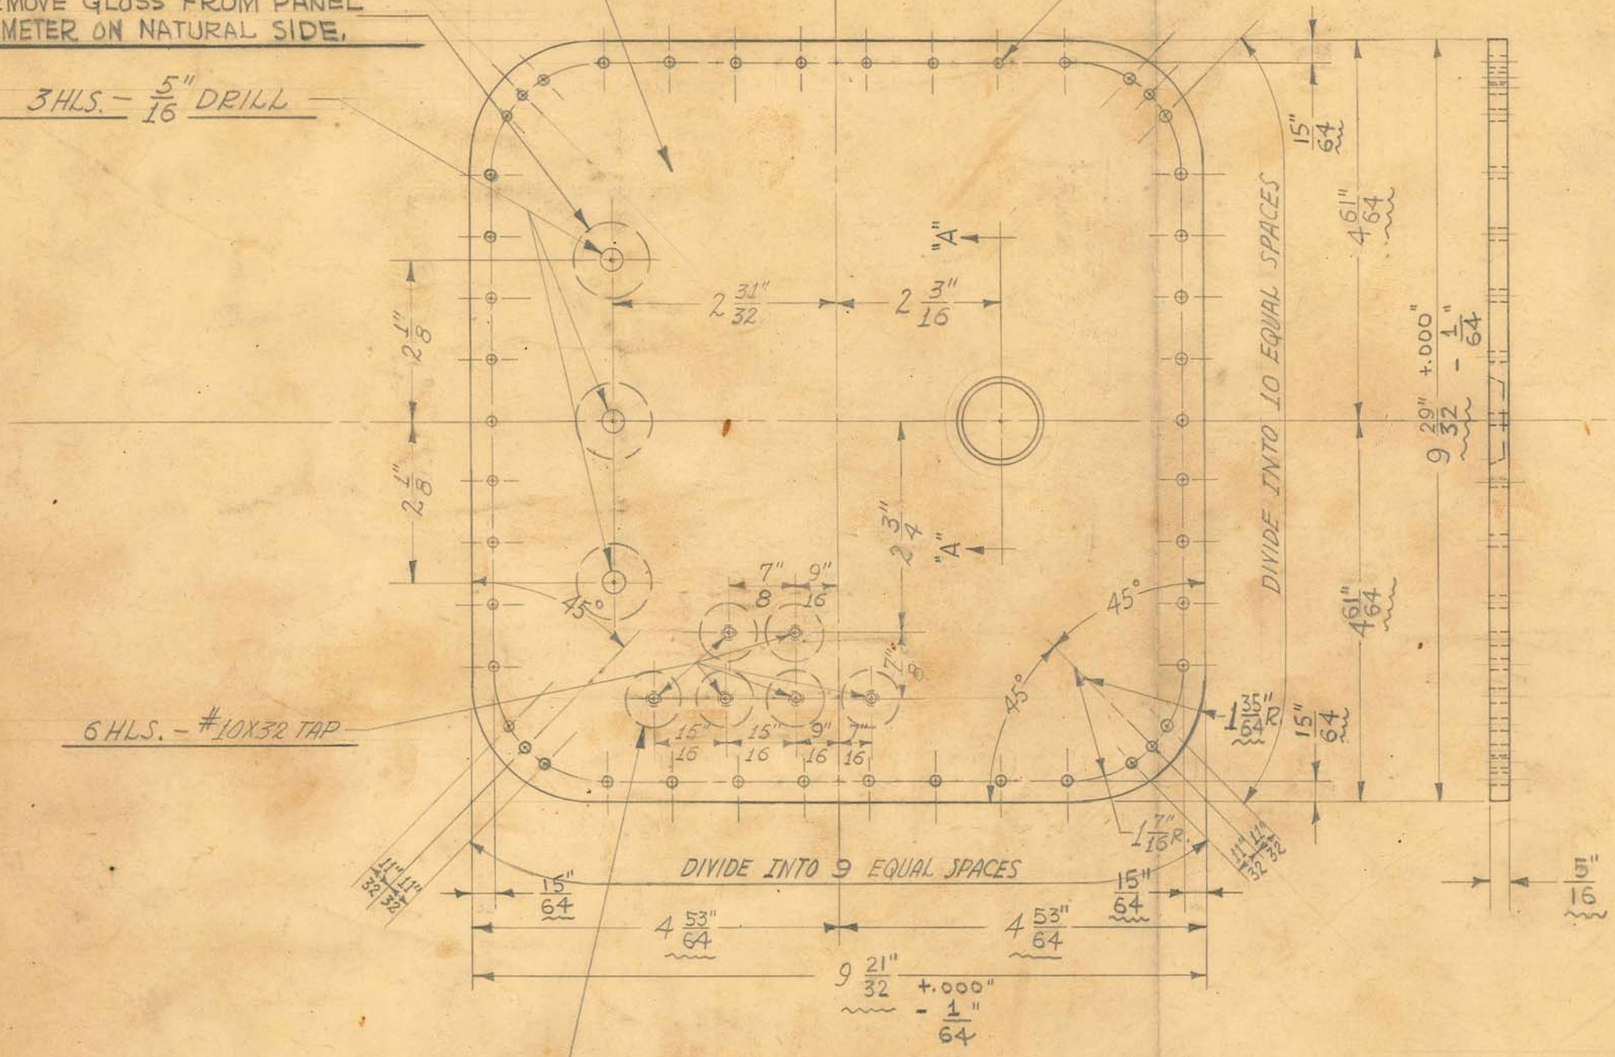

6 HLS. - #10X32 TAP

REMOVE GLOSS FROM PANEL
$\frac{3}{4}$" DIAMETER ON NATURAL SIDE.

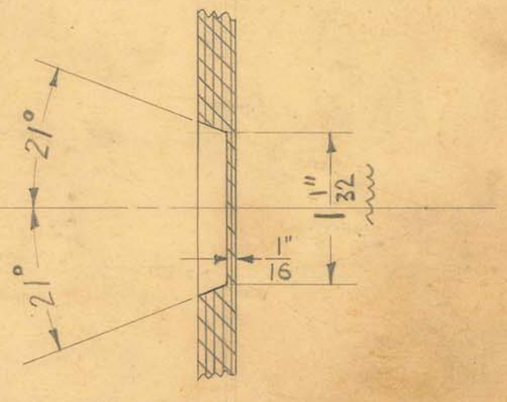

SECTION THRU "A"-"A"

SCALE ~ FULL SIZE

SCALE ~ HALF SIZE

1 REQUIRED

OBSOLETE

SIZE	5/16" SHEET	ISSUE 12-12-40	J.V.W.
KIND	LITHARGE IMP.	CHANGED	
SHAPE	BAKELITE	"	
FINISH		"	
TEMP.		"	
PATT.		"	

TITLE: U.S.A. SHOCKPROOF DENTAL X-RAY UNIT
TRANSF. HEAD TANK PANEL

H. G. FISCHER & CO.
2335 WABANSIA AVE.
CHICAGO, ILL.

CAT. NO.

PART NO. 13616F

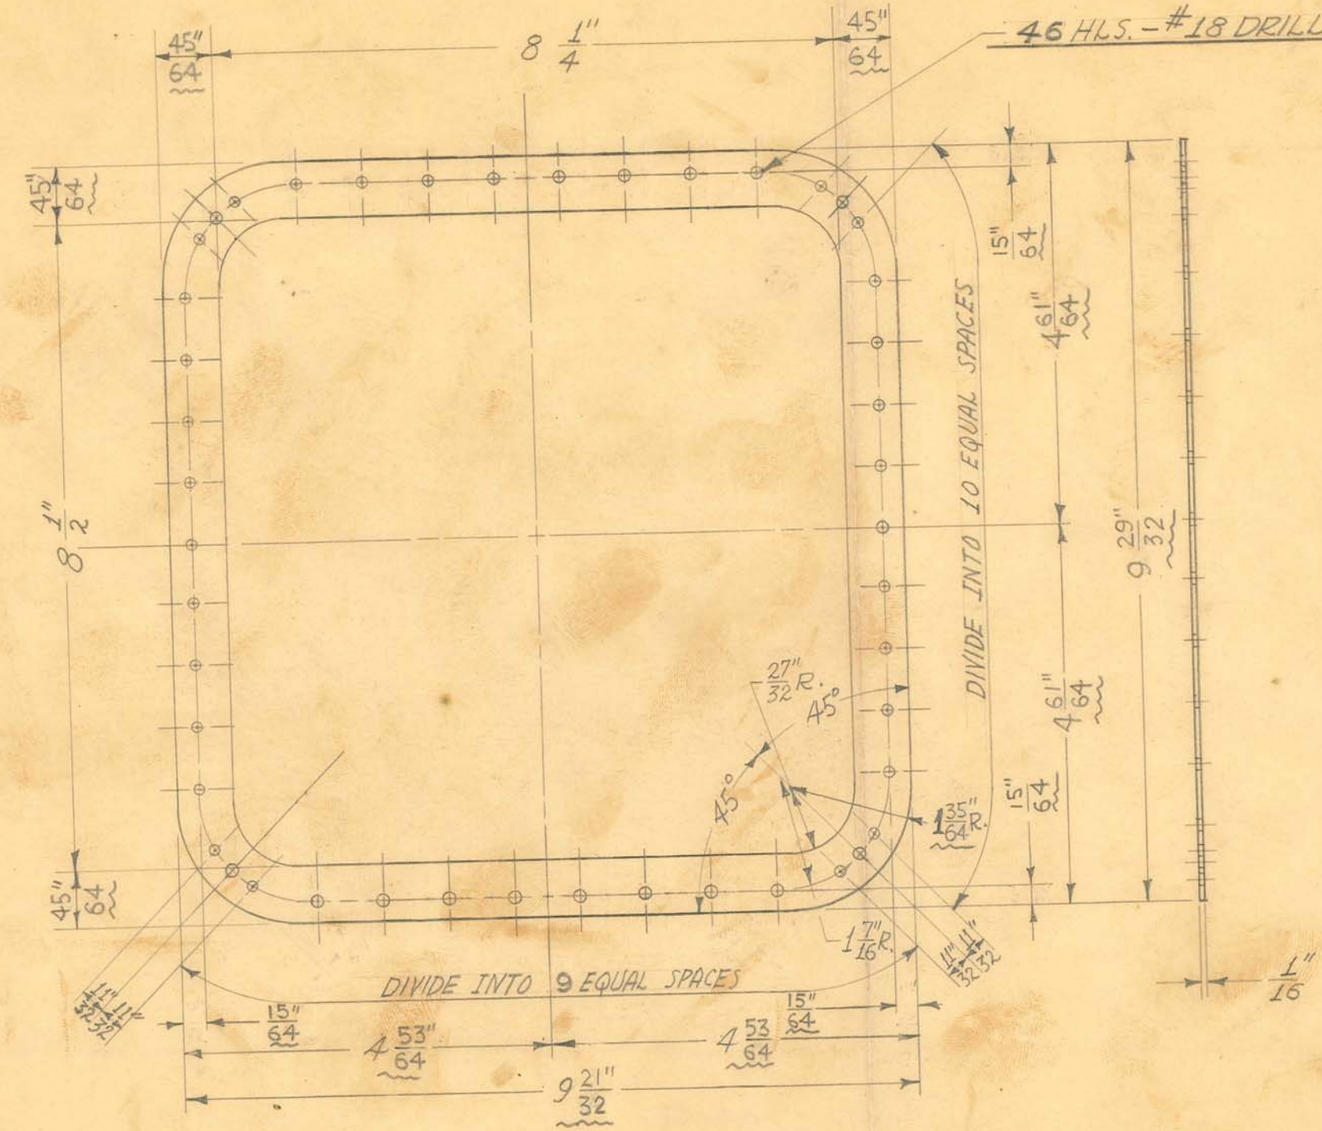

OBSOLETE

SCALE ≈ HALF SIZE

1 REQUIRED

Obsolete / Duplicate

SIZE	1/16" SHEET	ISSUE 12-16-40	J.V.W.
KIND	NEOPRENE	CHANGED	
SHAPE		"	
FINISH		"	
TEMP.		"	
PATT.		"	

TITLE: U.S.A. SHOCKPROOF DENTAL X-RAY UNIT
TRANSF. HEAD TANK PANEL - GASKET

H. G. FISCHER & CO.
2335 WABANSIA AVE.
CHICAGO, ILL.

CAT. NO.

PART NO. 13617

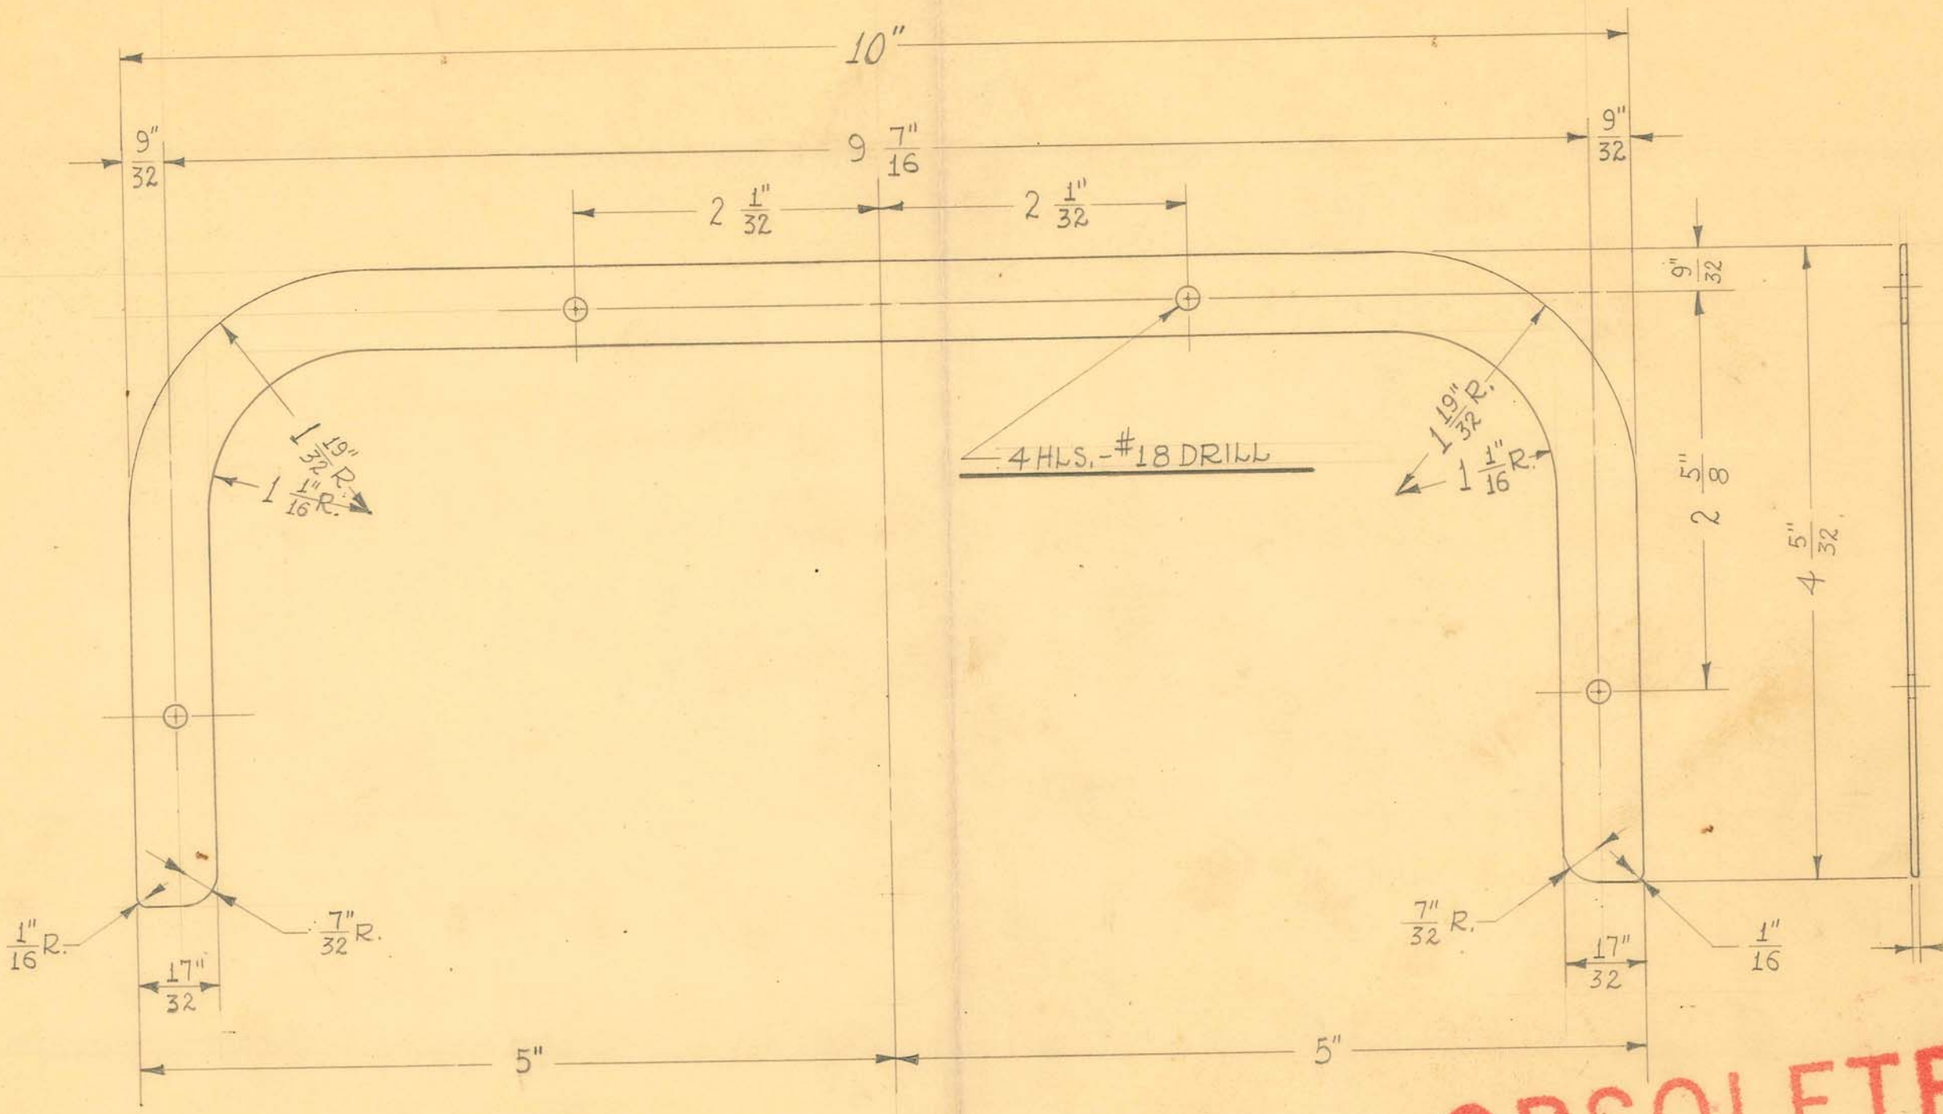

OBSOLETE

Obsolete

2 REQUIRED

SIZE	3/64" SHEET	ISSUE 1-8-41	J.Y.W.	TITLE: U.S.A. SHOCKPROOF DENTAL X-RAY UNIT TRANSF. HEAD SCREW SHIELD
KIND	C.R. STEEL	CHANGED		
SHAPE		"		
FINISH	OHR, #2 POLISH ONE SIDE ONLY	"		
TEMP.		"		
PATT.		"		

H. G. FISCHER & CO.
2338 WABANSIA AVE.
CHICAGO, ILL.

CAT. NO.

PART NO. 13618

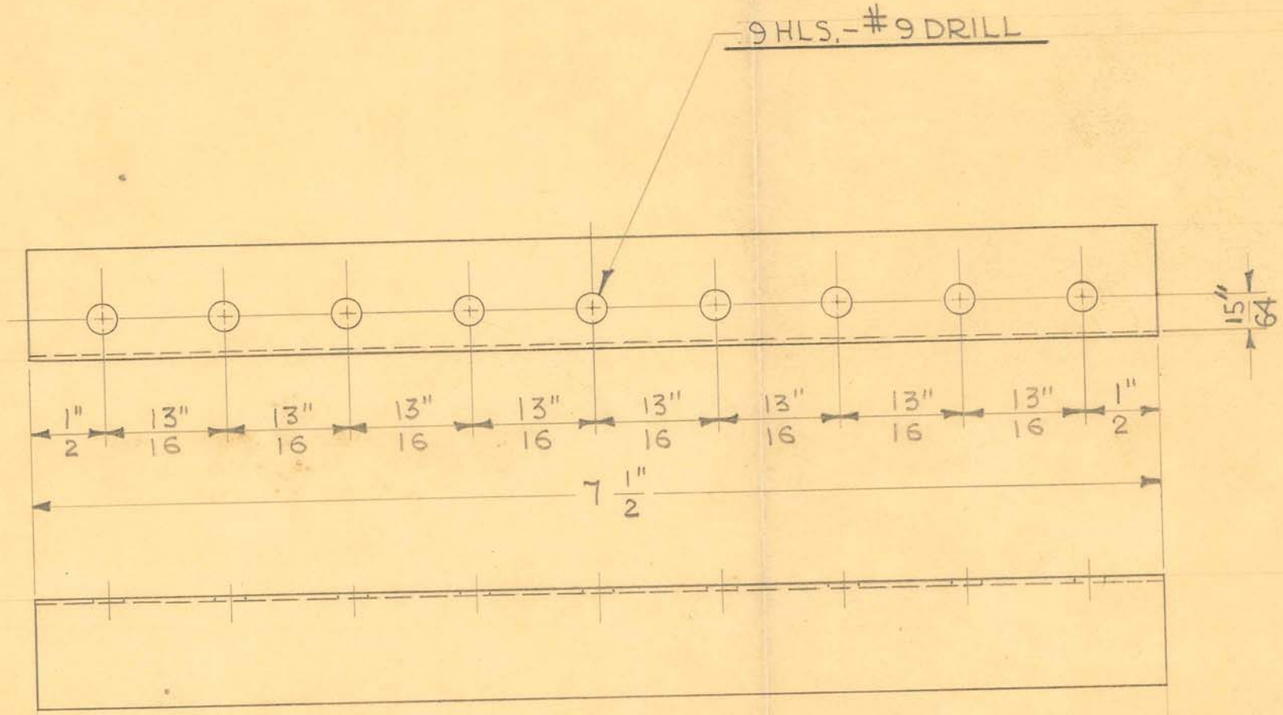

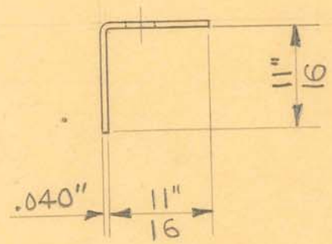

1 REQUIRED

OBSOLETE

Obsolete

SIZE	.040" SHEET	ISSUE 6-10-41	J.V.W.
KIND	LEAD	CHANGED	
SHAPE		"	
FINISH		"	
TEMP.		"	
PATT.		"	

TITLE: U.S.A. SHOCKPROOF DENTAL X-RAY UNIT
TUBE HEAD - LEAD PROTECTION SHIELD

H. G. FISCHER & CO.
2335 WABANSIA AVE.
CHICAGO. ILL.

CAT. NO.

PART NO. 13619

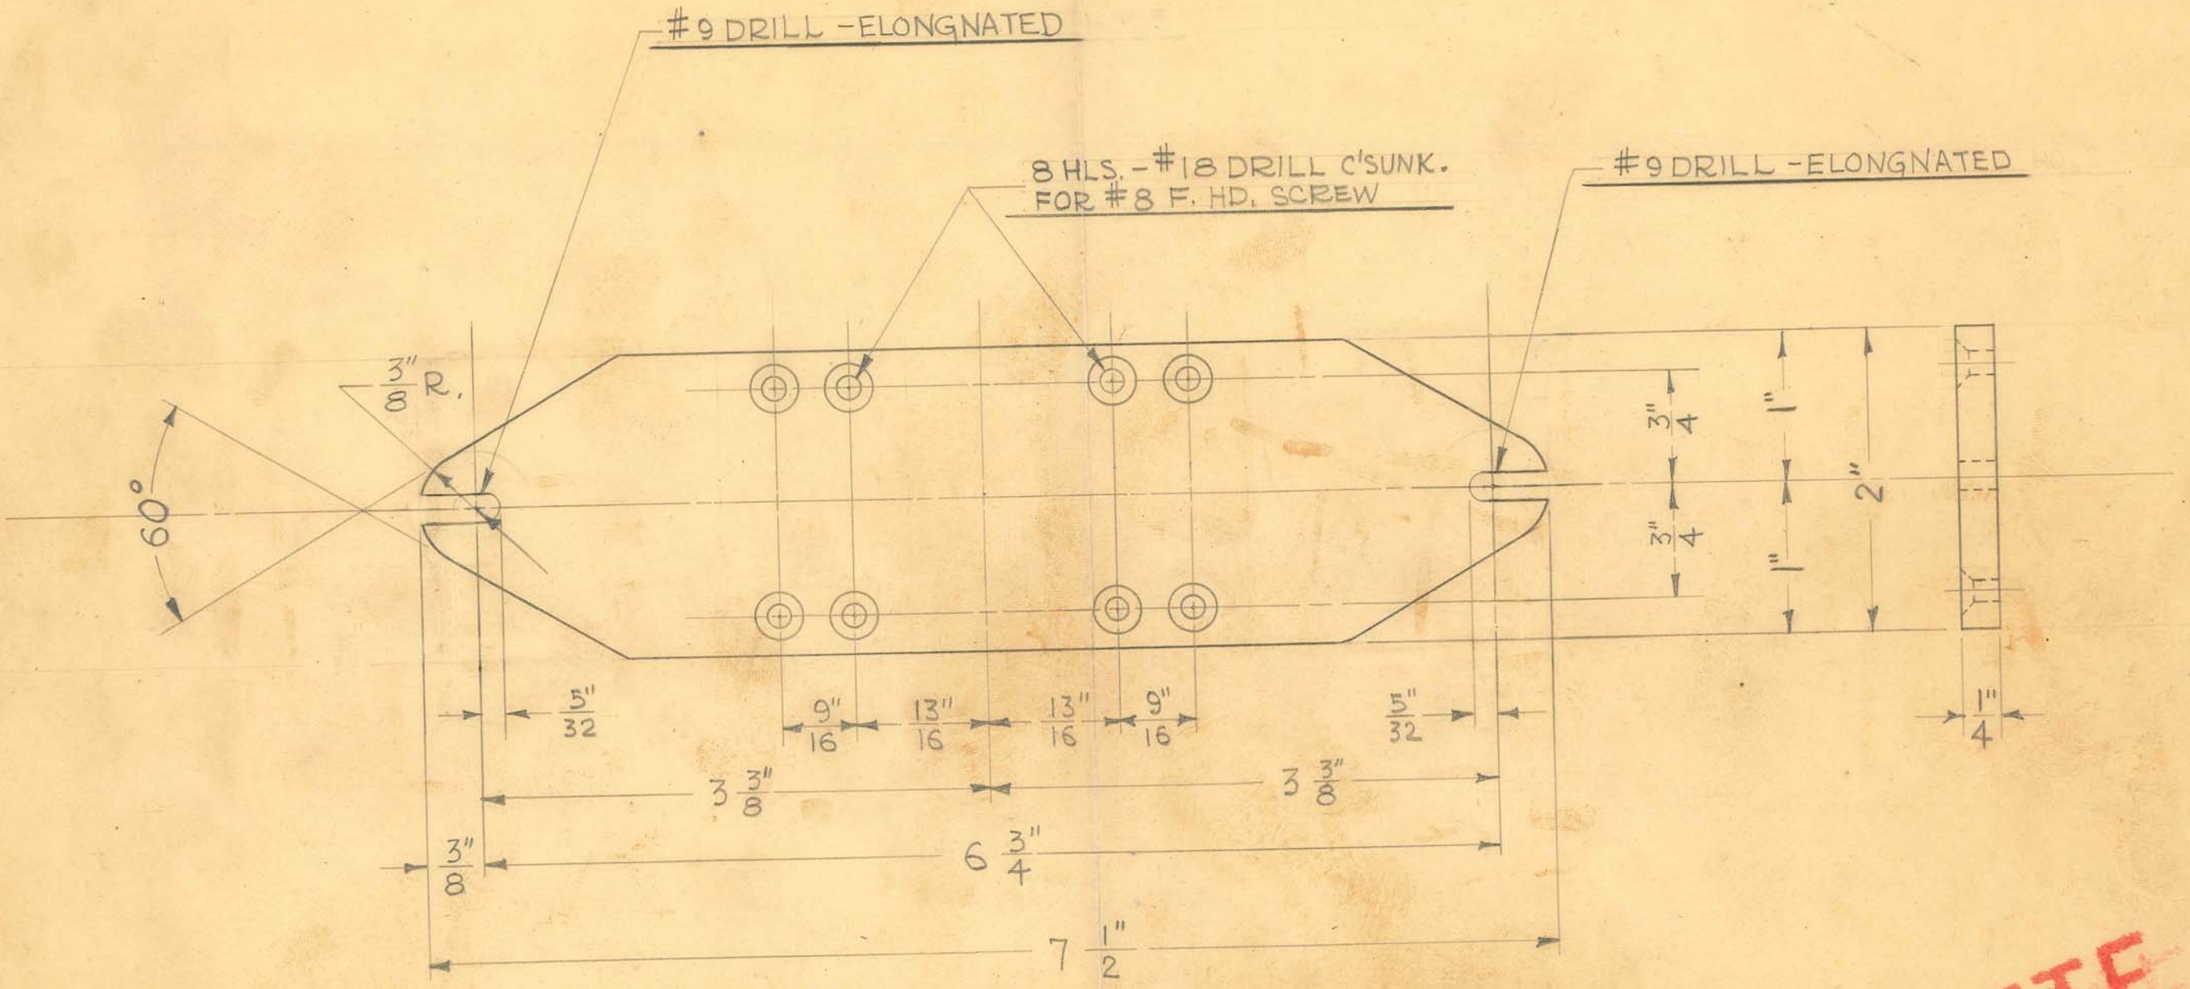

1 REQUIRED

OBSOLETE

obsolete

SIZE	1/4" SHEET	ISSUE 5-22-41	J.Y.W.
KIND	BLK. BAKELITE	CHANGED	
SHAPE		"	
FINISH		"	
TEMP.		"	
PATT.		"	

TITLE: U.S.A. SHOCKPROOF DENTAL X-RAY UNIT
X-RAY TUBE MOUNTING BOARD

H. G. FISCHER & CO.
2335 WABANSIA AVE.
CHICAGO, ILL.

CAT. NO.

PART NO. 13624

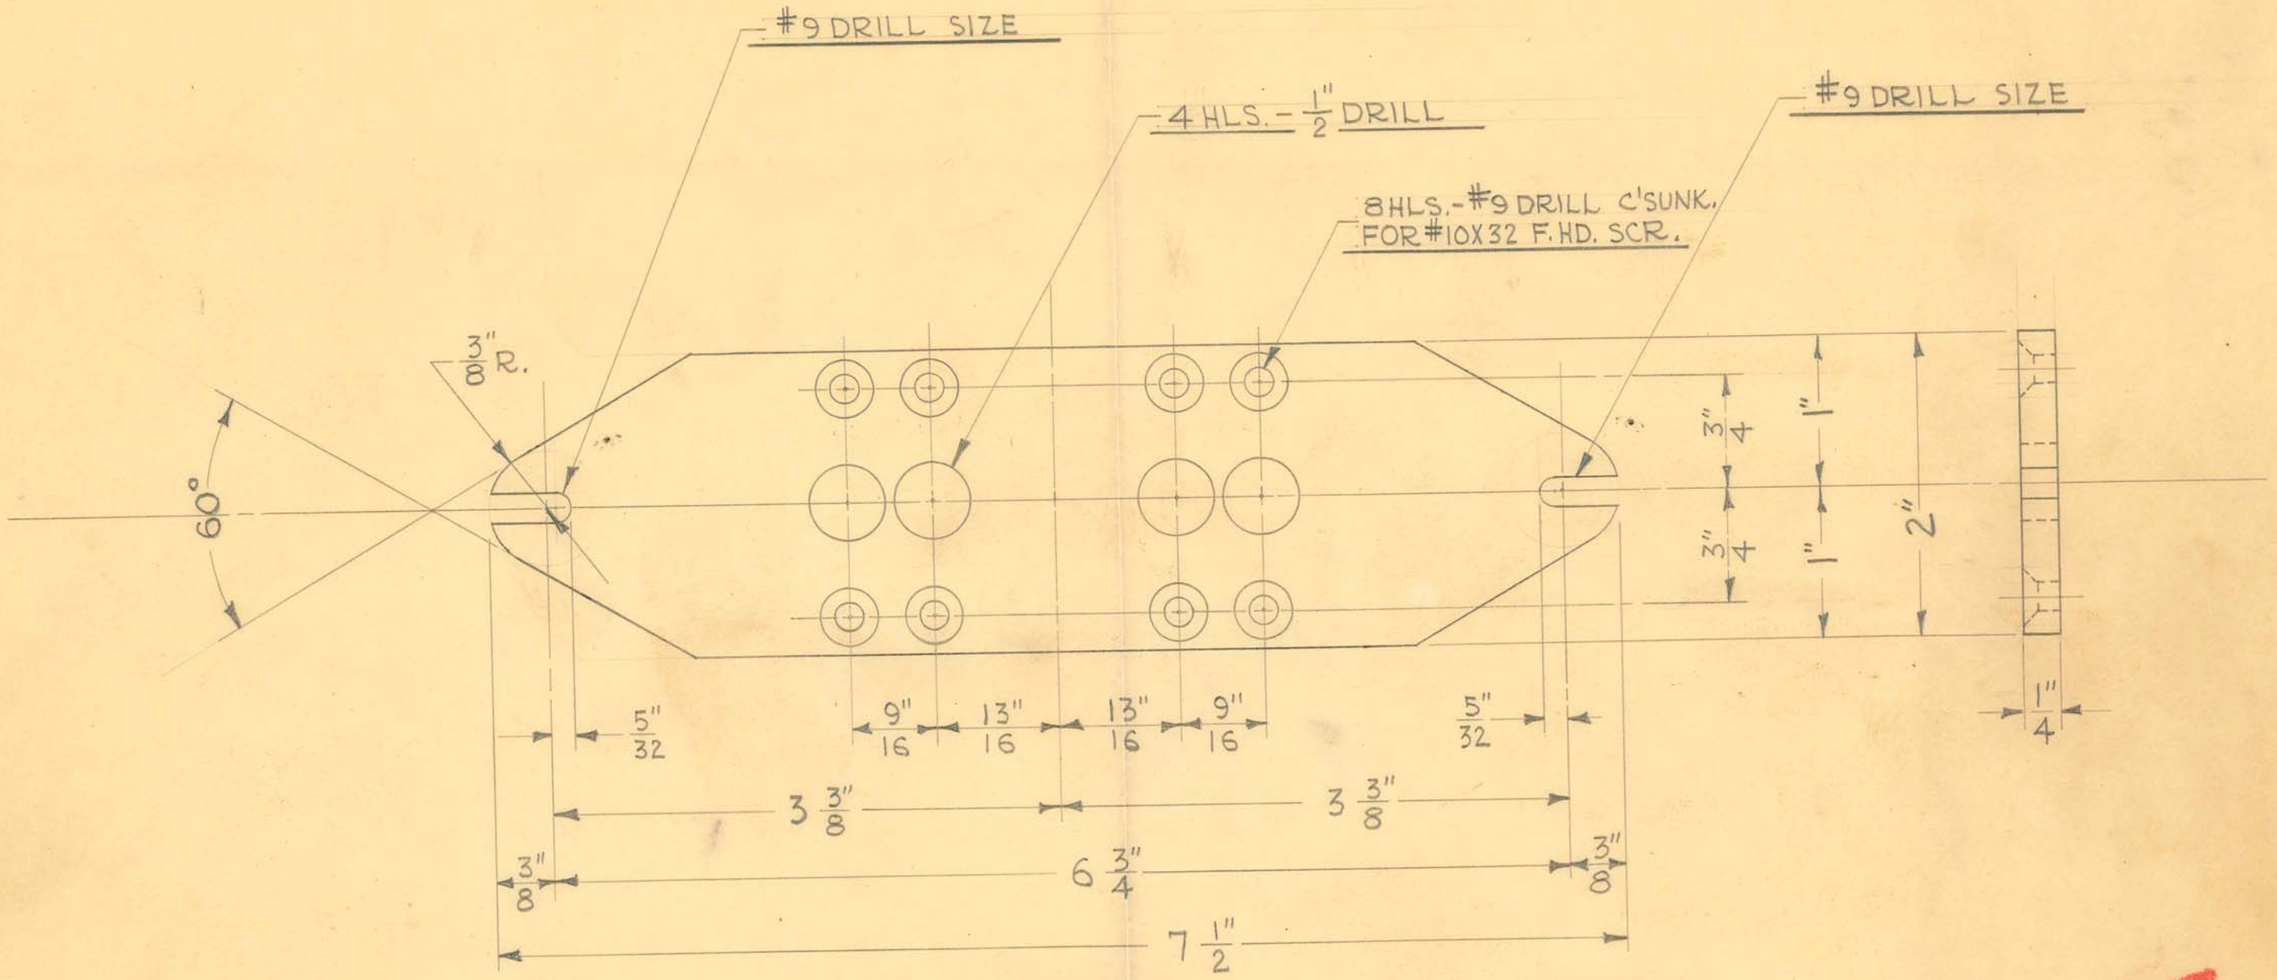

1 REQUIRED

OBSOLETE

Obsolete

SIZE	1/4" SHEET	ISSUE 7-31-41	J.V.W.
KIND	BLK. BAKELITE	CHANGED	
SHAPE		"	
FINISH		"	
TEMP.		"	
PATT.		"	

TITLE:
U.S.A. SHOCKPROOF DENTAL X-RAY UNIT
X-RAY TUBE MOUNTING BOARD

H. G. FISCHER & CO.
2335 WABANSIA AVE.
CHICAGO. ILL.

CAT. NO.

PART NO. 13624

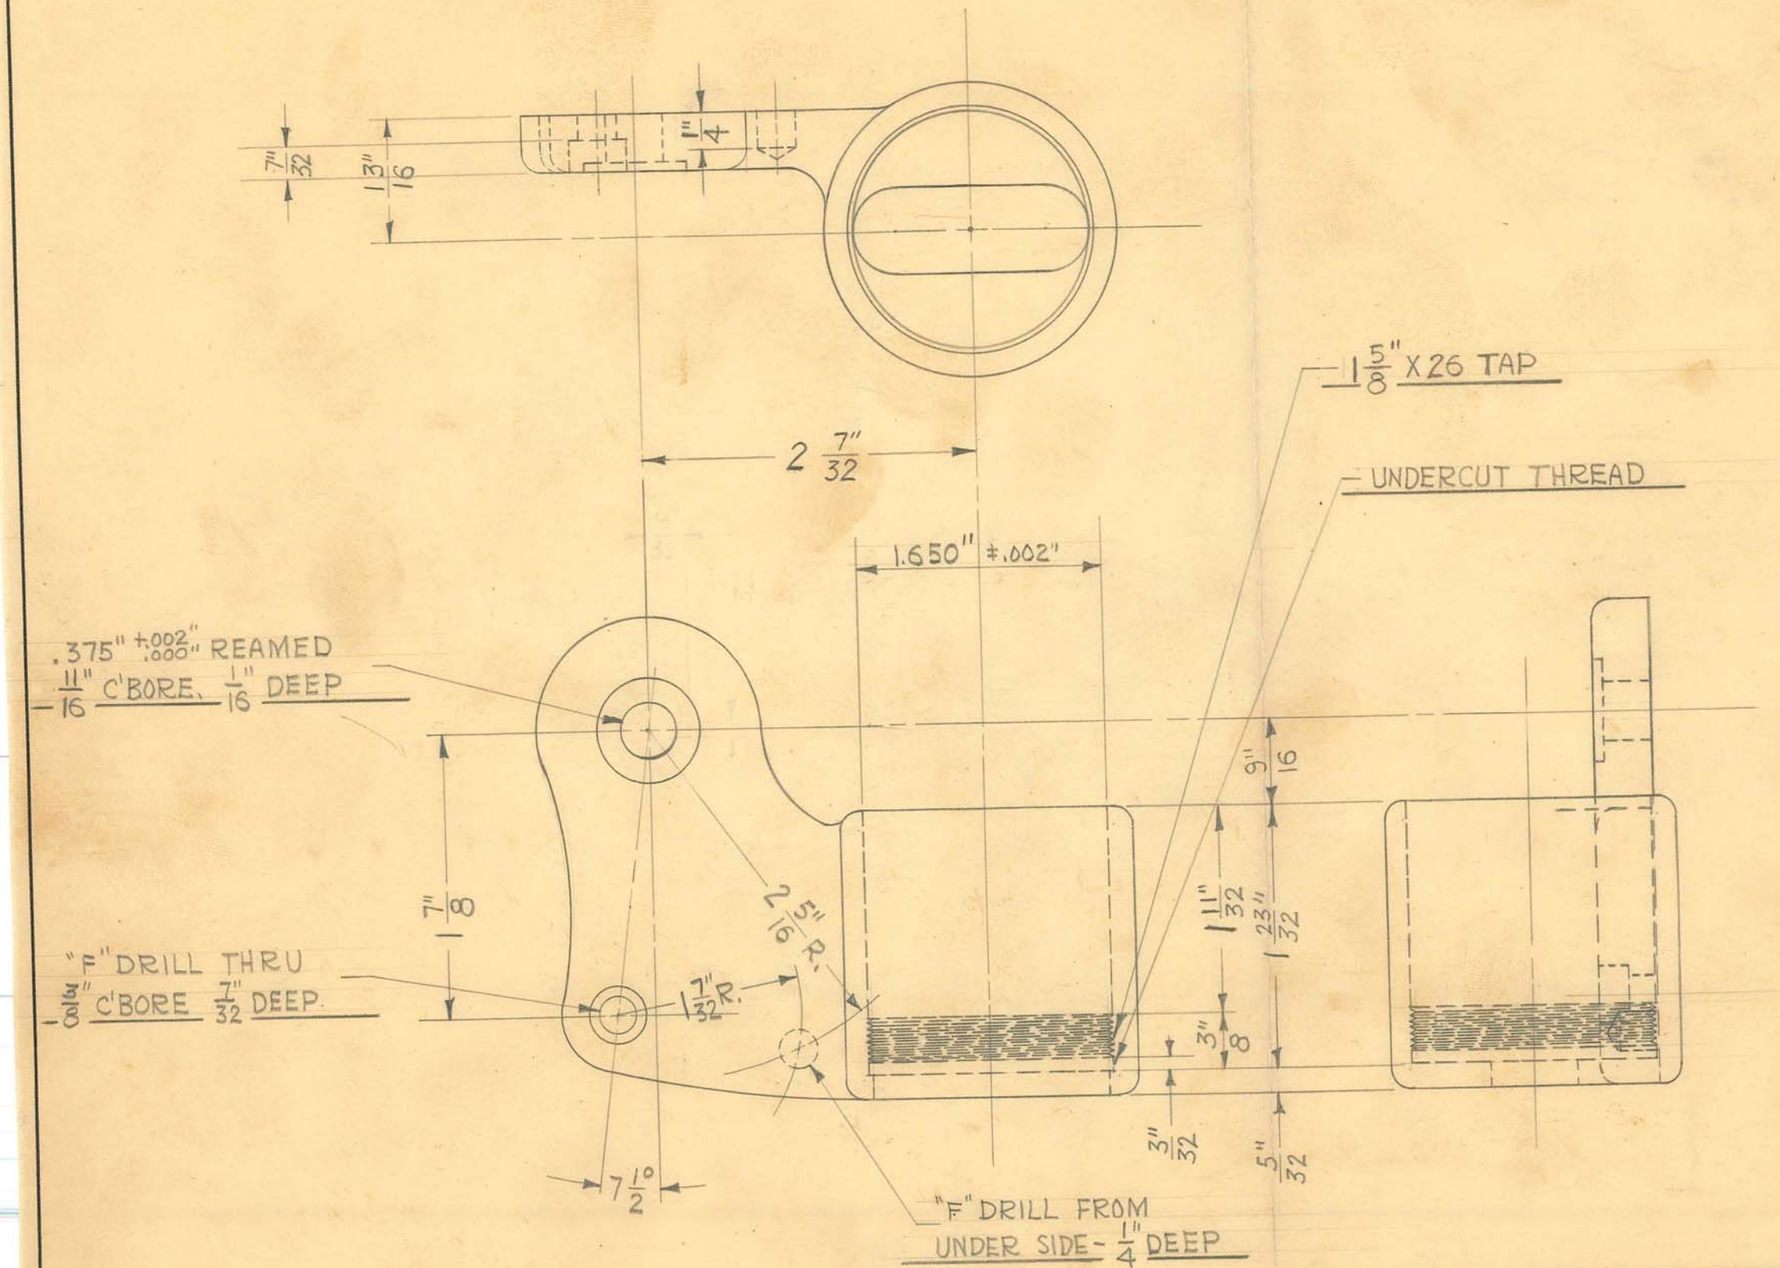

OBSOLETE

1 REQUIRED

SIZE		ISSUE 2-10-41	J.V.W.
KIND	IRON CASTING	CHANGED	
SHAPE		" 10-23-42	HE.
FINISH	PAINTED	"	
TEMP.		"	
PATT.	1658	"	

TITLE: ARMY SHOCKPROOF DENTAL X-RAY UNIT
COUNTERBALANCE SPG. & TUBE SUPP. - LEFT

H. G. FISCHER & CO.
2338 WABANSIA AVE.
CHICAGO, ILL.

CAT. NO.

PART NO. 13638AF

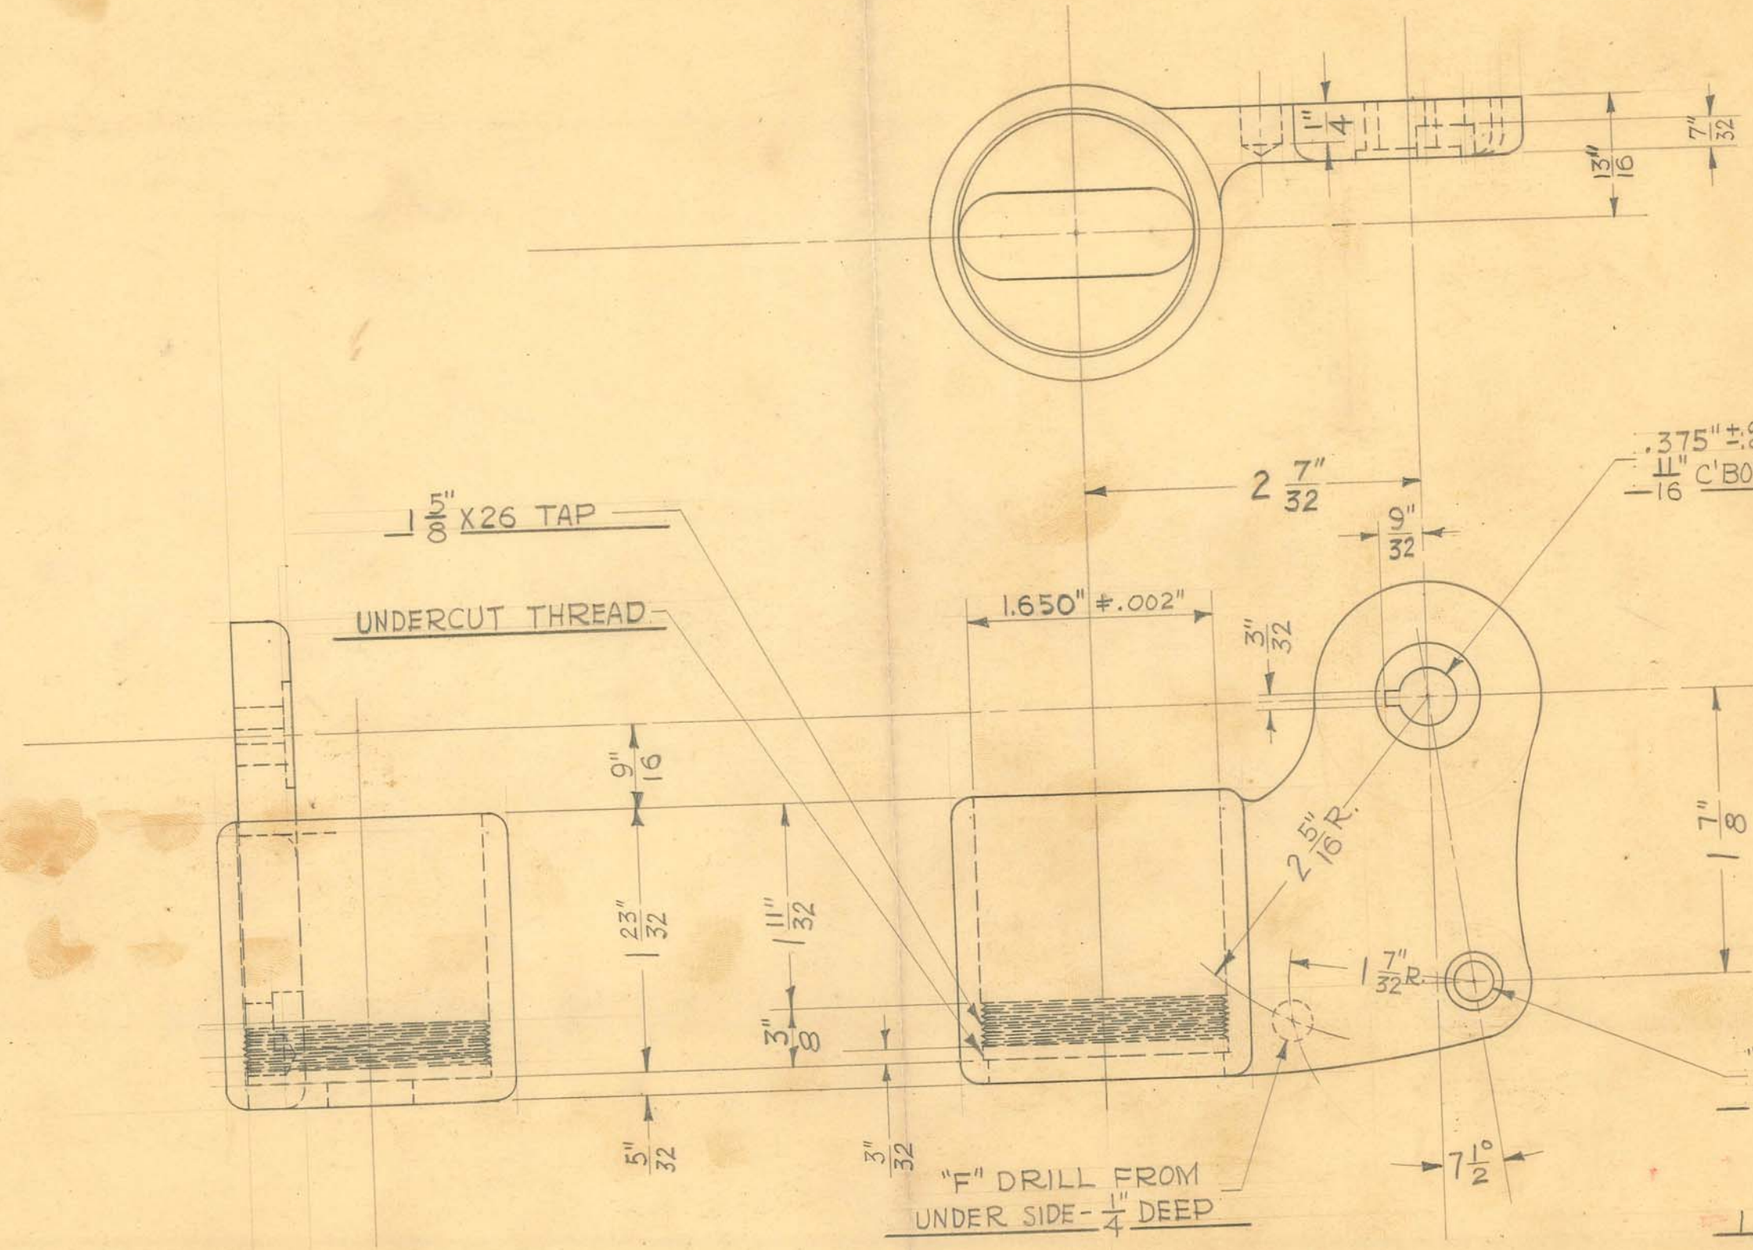

OBSOLETE

SIZE		ISSUE 2-11-41	J.V.W.
KIND	IRON CASTING	CHANGED	
SHAPE		" 10-23-42	H.E.
FINISH	PAINTED	"	
TEMP.		"	
PATT.	1659	"	

TITLE: ARMY SHOCKPROOF DENTAL X-RAY UNIT
COUNTERBALANCE SPG. & TUBE SUPP. - RIGHT

H. G. FISCHER & CO.
2338 WABANSIA AVE.
CHICAGO, ILL.

CAT. NO.

PART NO. 13639AF

1 REQUIRED

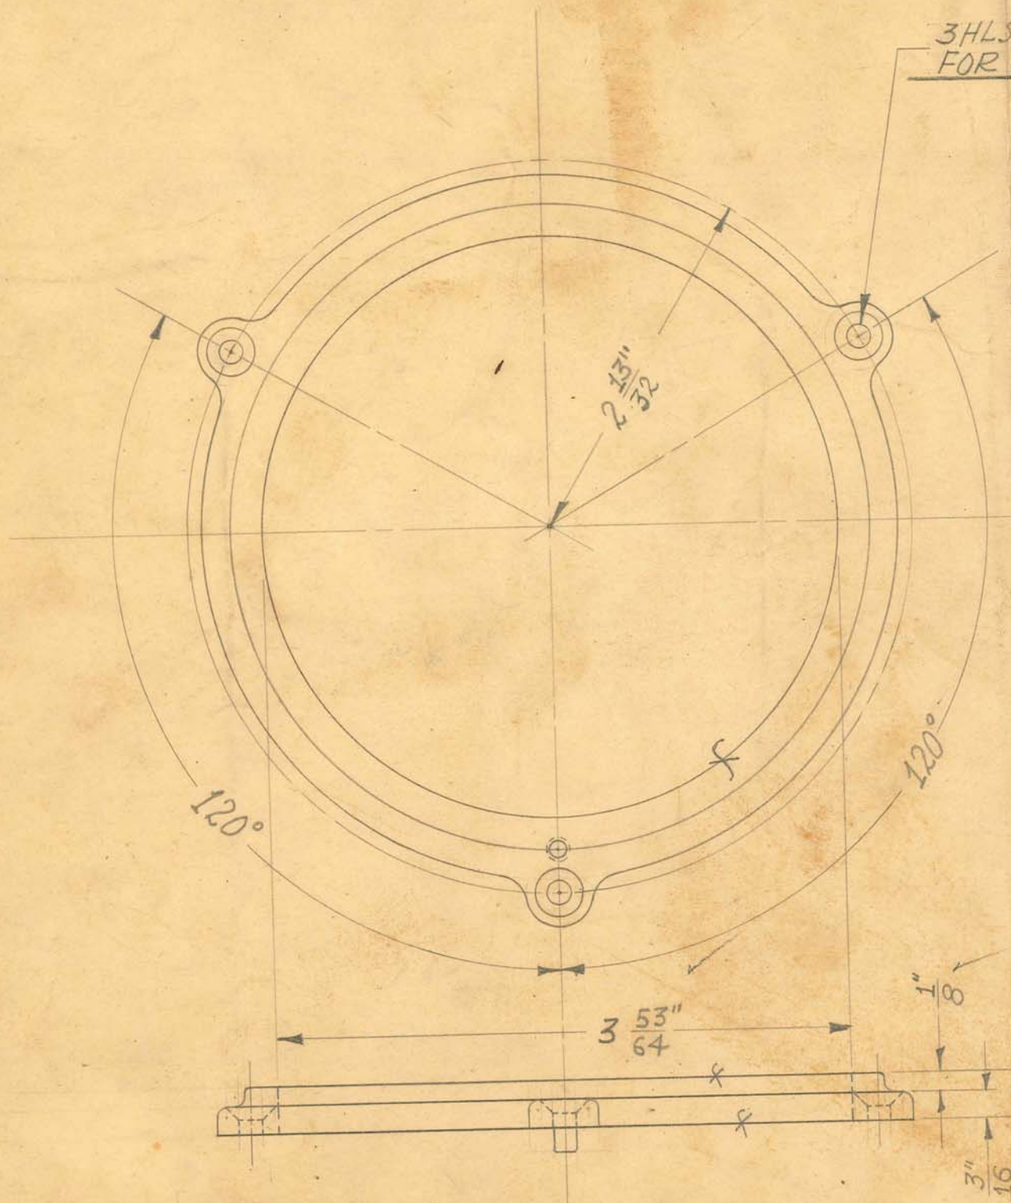

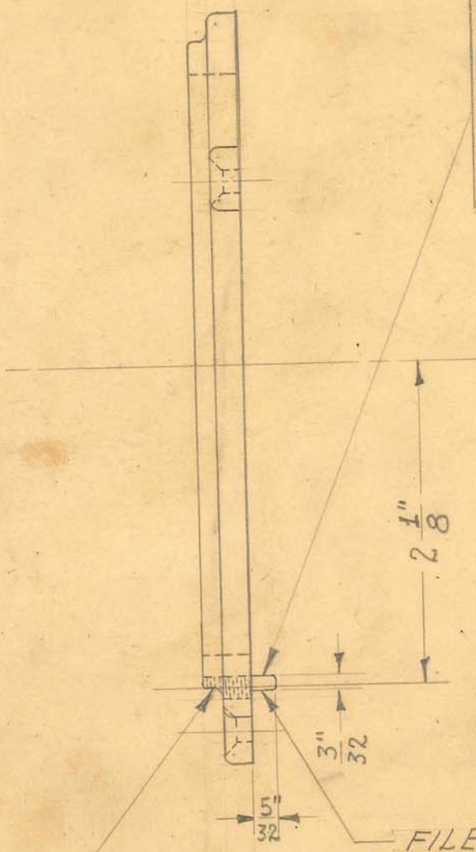

3 HLS. – #25 DRILL C'SUNK FOR #6X32 O.HD. SCR.

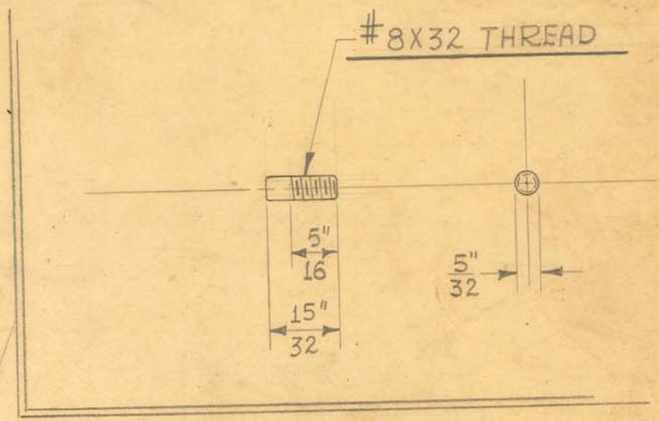

FILE THIS SIDE TO DIMENSION

#8X32 TAP IN CASTING – SCREW IN PIN
FILE PIN DOWN TO CONTOUR OF CASTING

2 REQUIRED

OBSOLETE

SIZE	IRON	ISSUE 1-9-41	J.Y.W.
KIND	CASTING	CHANGED	
SHAPE		"	
FINISH	PAINTED	"	
TEMP.		"	
PATT.	1662	"	

TITLE: U.S.A. SHOCKPROOF DENTAL X-RAY UNIT
CONTROL BOX – METER HOUSING BEARING RING

H. G. FISCHER & CO.
2335 WABANSIA AVE.
CHICAGO, ILL.

CAT. NO.

PART NO. 13642GA

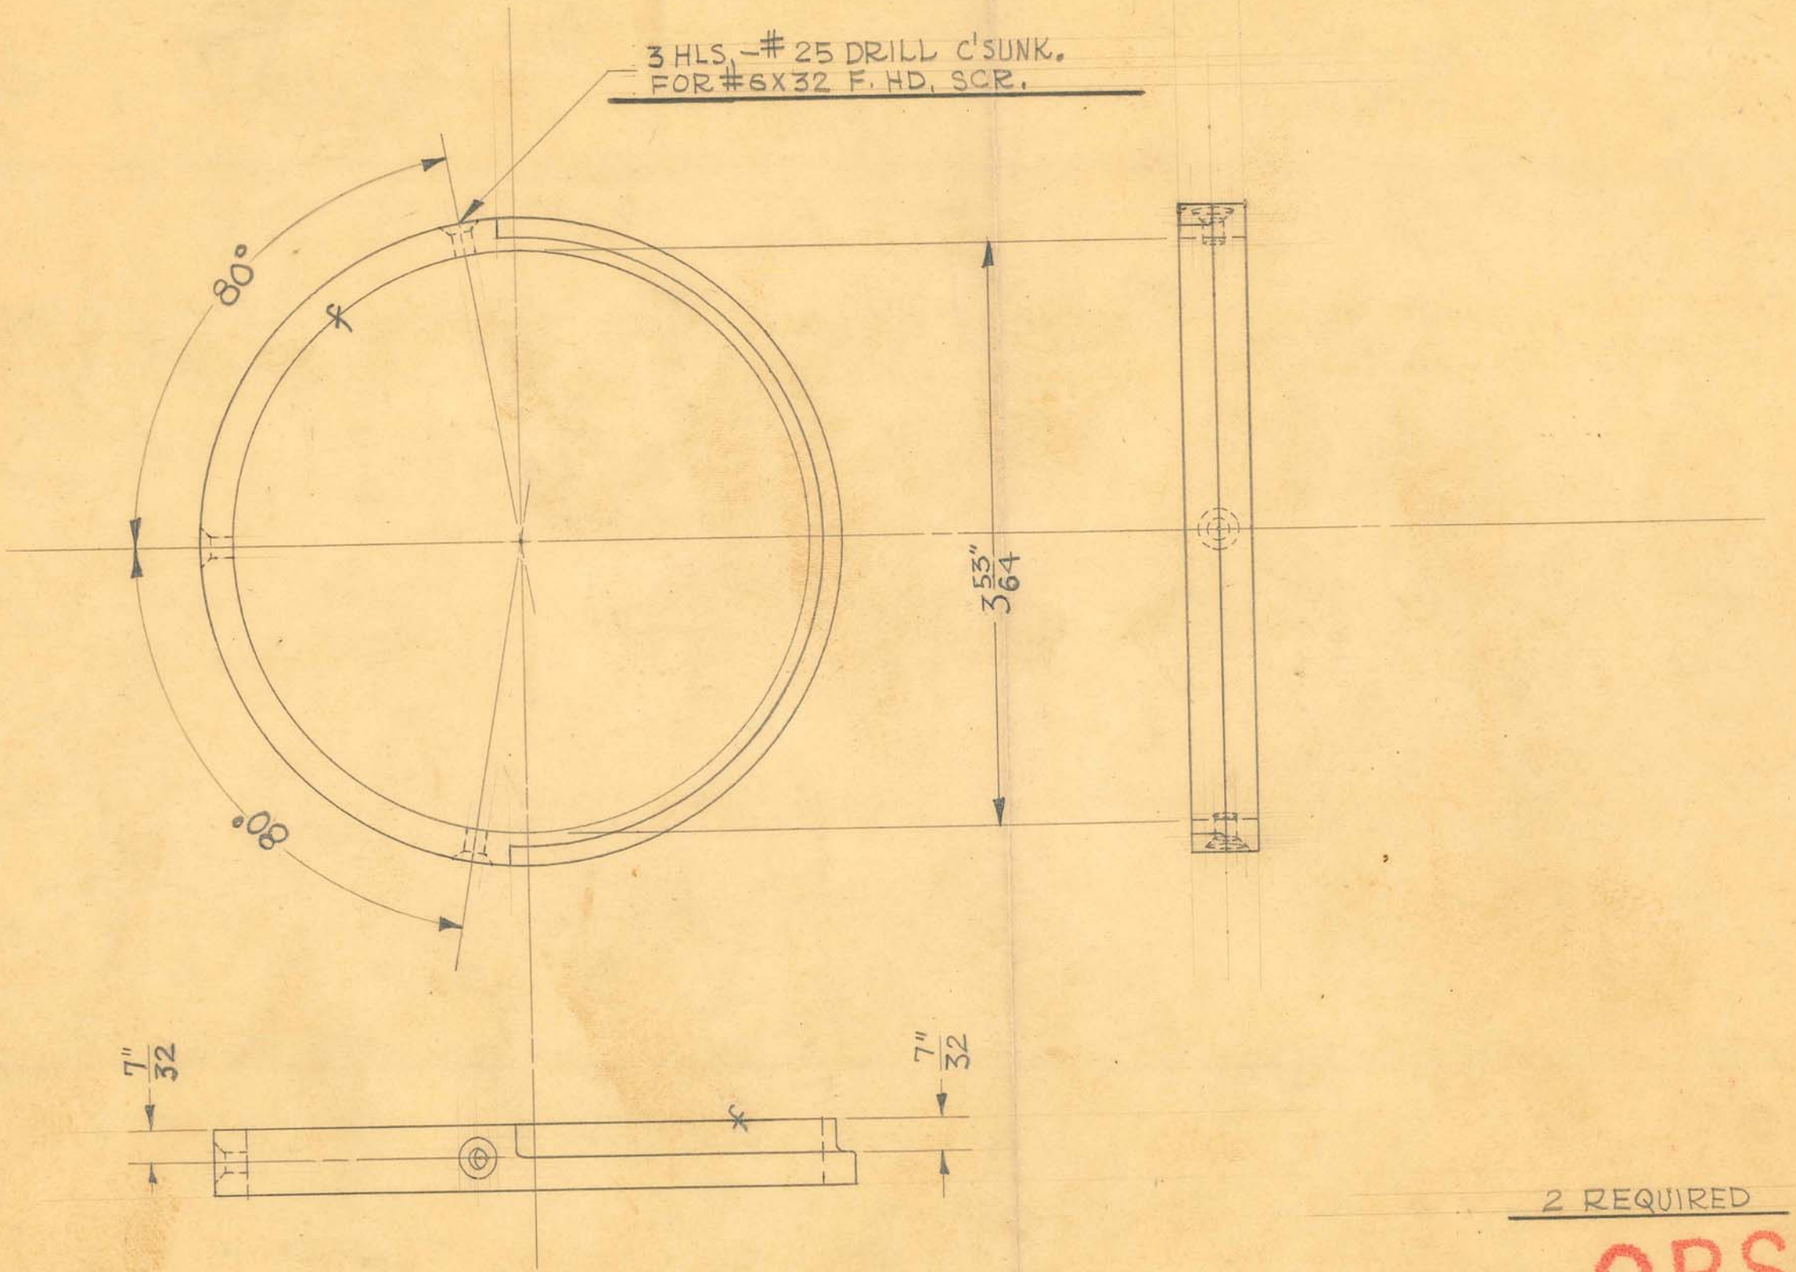

2 REQUIRED

OBSOLETE

SIZE	IRON	ISSUE 6-27-41	J.V.W.
KIND	CASTING	CHANGED	
SHAPE		"	
FINISH	BLACK #80	"	
TEMP.		"	
PATT.	1663	"	

TITLE: U.S.A. SHOCKPROOF DENTAL X-RAY UNIT
CONTROL BOX-METER HOUSING LOCK RING

H. G. FISCHER & CO.
2335 WABANSIA AVE.
CHICAGO, ILL.

CAT. NO.

PART NO. 13643AF

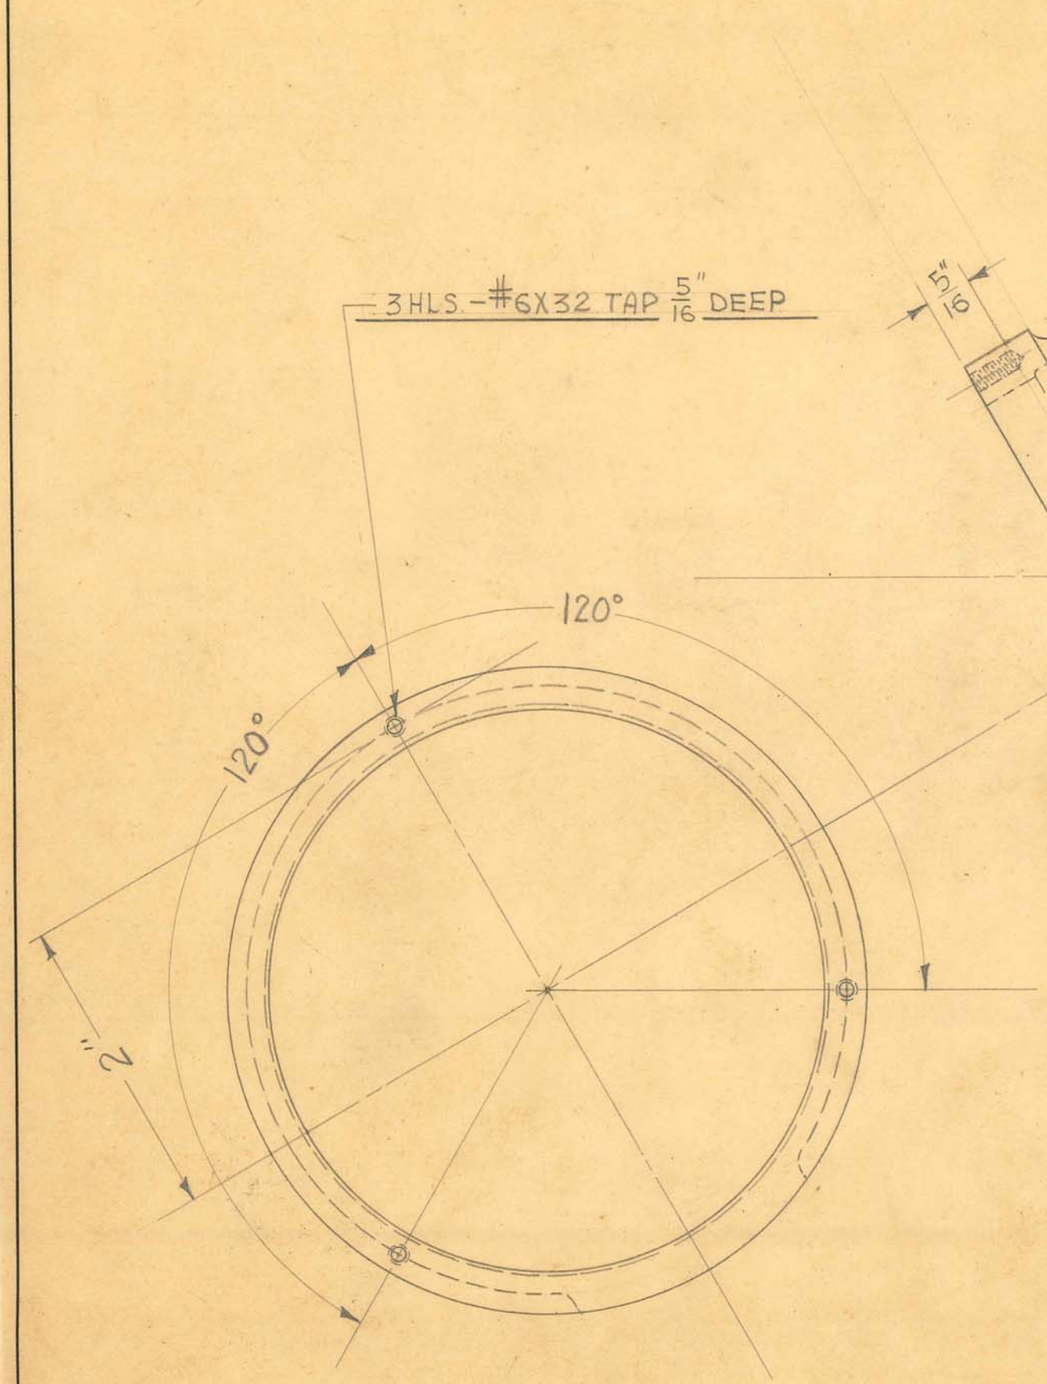

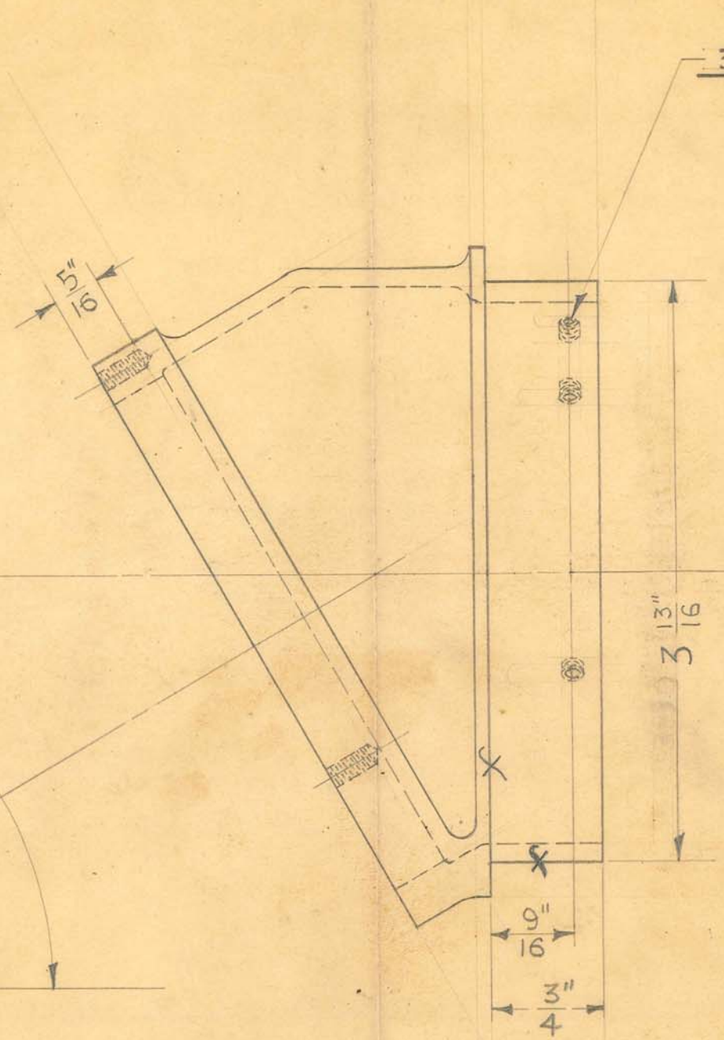

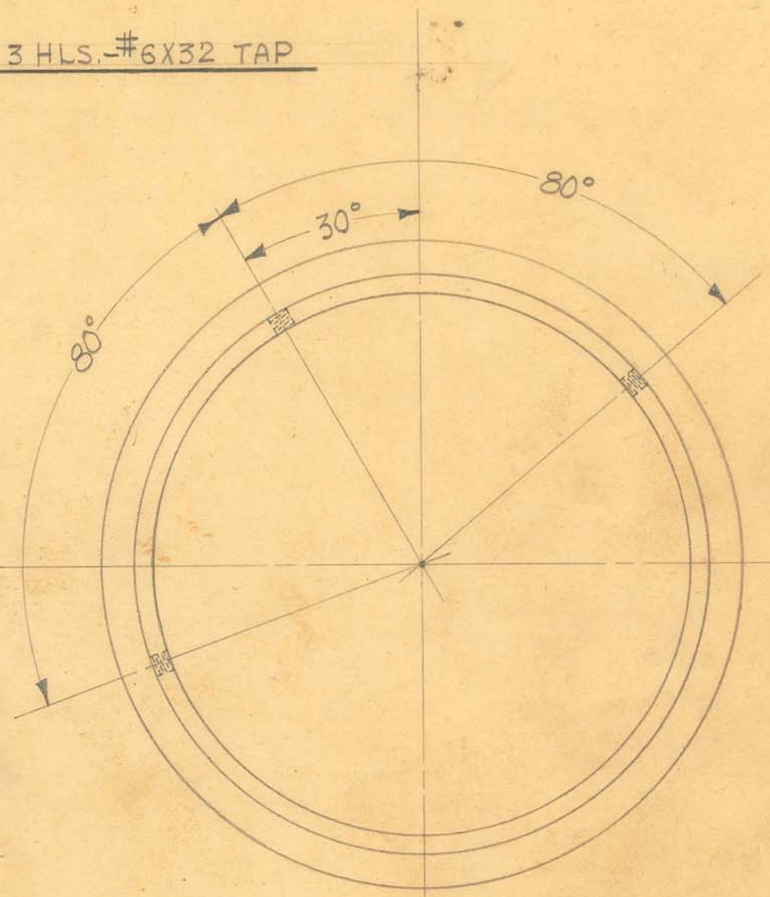

2 REQUIRED

OBSOLETE

Obsolete

SIZE	#12	ISSUE 6-27-41	J.V.W.
KIND	ALUM. CAST	CHANGED	
SHAPE		"	
FINISH	PAINTED	"	
TEMP.		"	
PATT.	1664	"	

TITLE: U.S.A. SHOCKPROOF DENTAL X-RAY UNIT CONTROL BOX - METER HOUSING

H. G. FISCHER & CO.
2338 WABANSIA AVE.
CHICAGO, ILL.

CAT. NO.

PART NO. 13644F

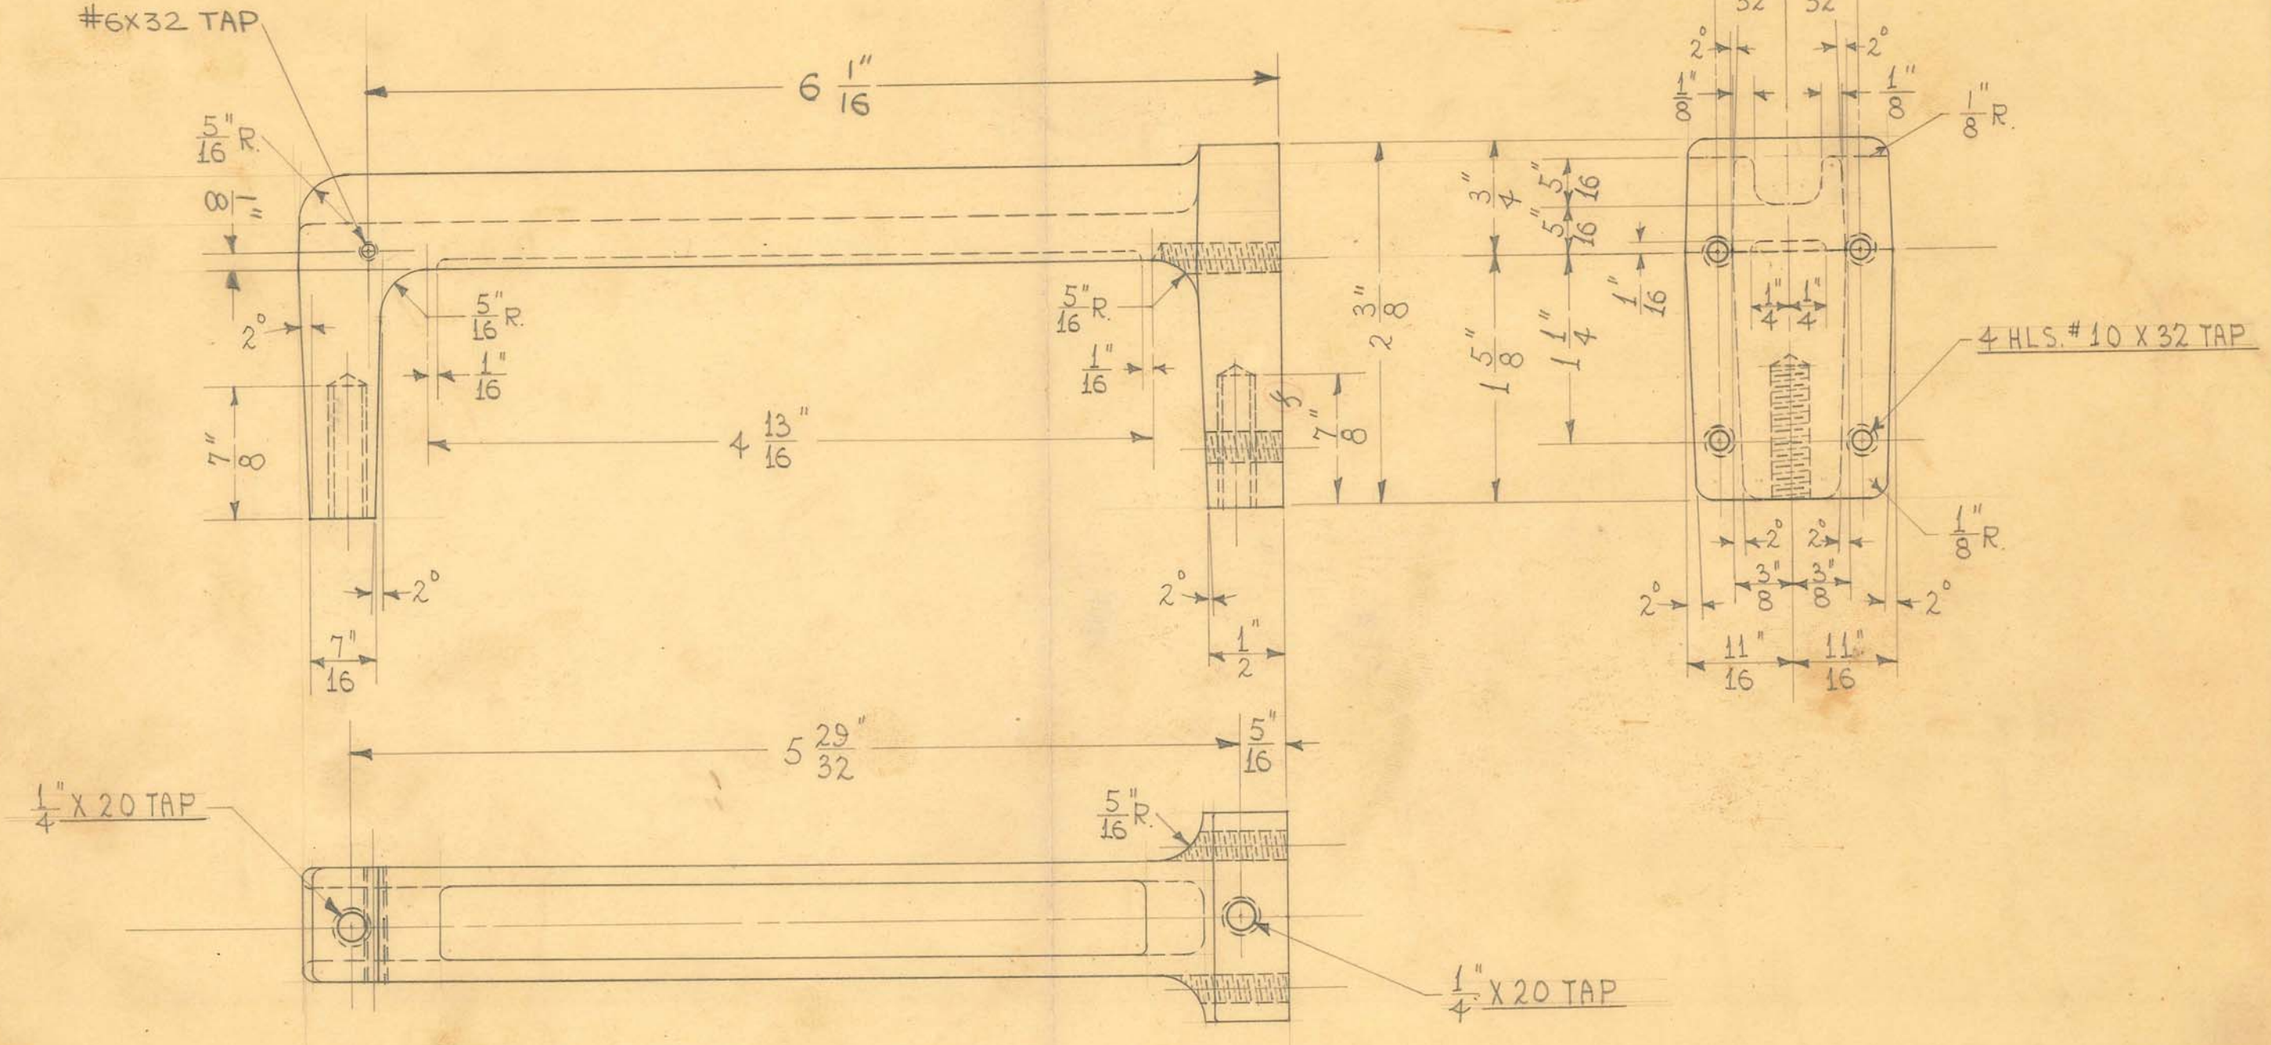

OBSOLETE

SIZE	IRON	ISSUE 11-25-40	HE.	TITLE: U.S.A. SHOCKPROOF DENTAL X-RAY UNIT- AUTO TRANSF. SUPPORT
KIND	CASTING	CHANGED		
SHAPE		"		
FINISH	BLACK #80	"		
TEMP.		"		H. G. FISCHER & CO. 2335 WABANSIA AVE. CHICAGO, ILL. — CAT. NO. — PART NO. 13647AF
PATT.	1666	"		

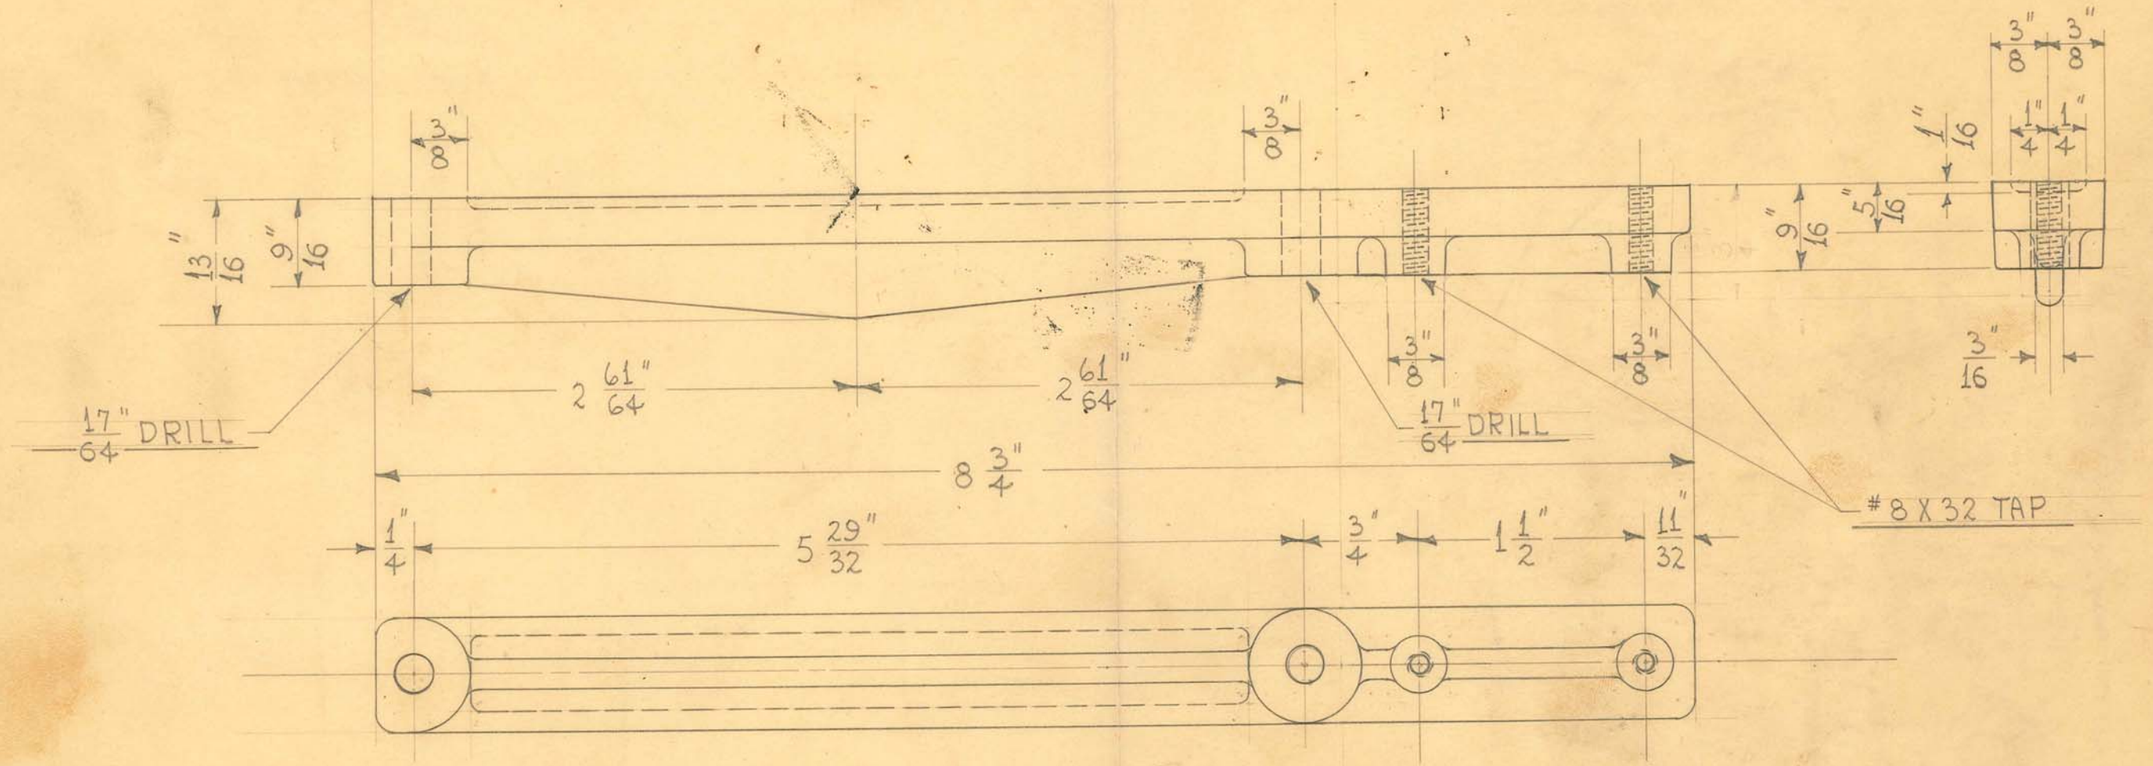

OBSOLETE

SIZE	IRON	ISSUE 11-25-40	HE.
KIND	CASTING	CHANGED	
SHAPE		"	
FINISH	BLACK #80	"	
TEMP.		"	
PATT.	1667	"	

TITLE: U.S.A. SHOCKPROOF DENTAL X-RAY UNIT- AUTO TRANSF. CLAMP

H. G. FISCHER & CO.
2335 WABANSIA AVE.
CHICAGO, ILL.

CAT. NO.

PART NO. 13648AF

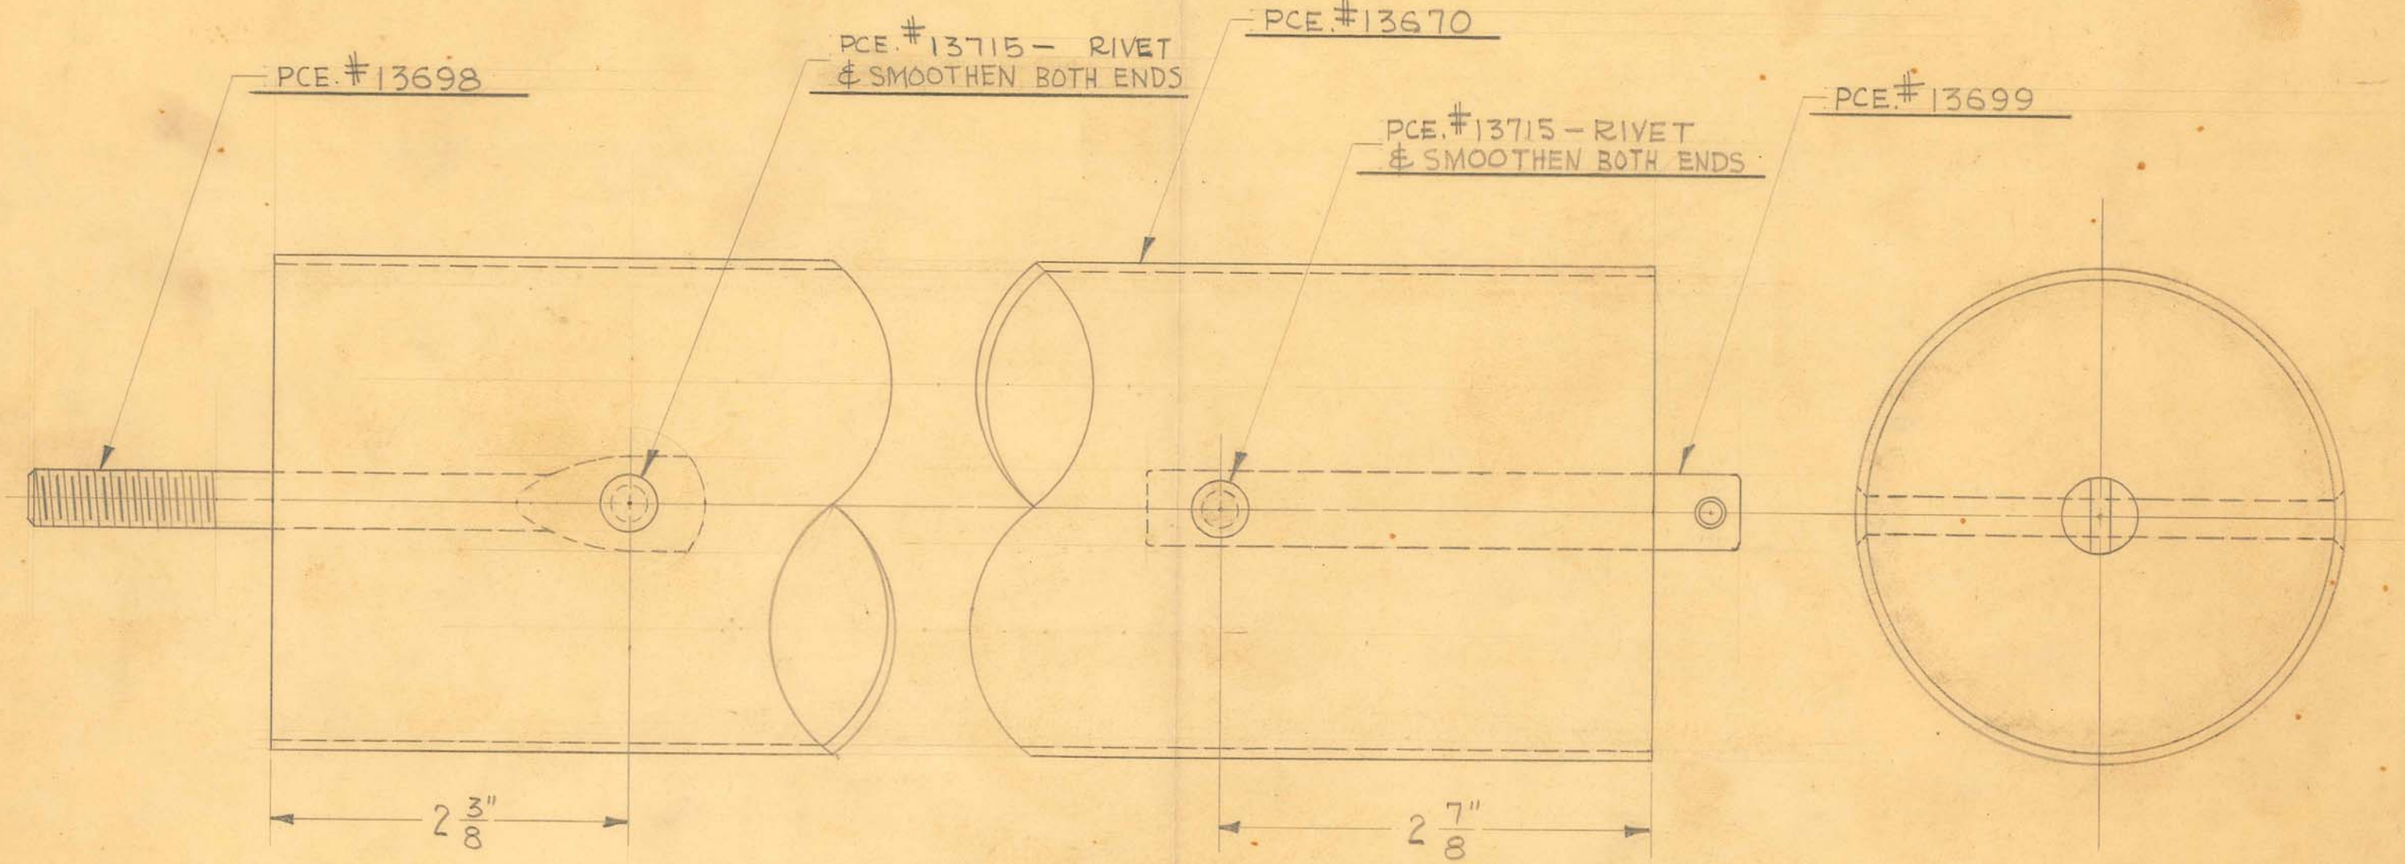

CENTER STUDS. FILL WITH LEAD
TO BRING TOTAL WEIGHT UP TO-60LBS.

OBSOLETE
Obsolete

SIZE		ISSUE 8-5-41	J.V.W.
KIND		CHANGED	
SHAPE		"	
FINISH		"	
TEMP.		"	

TITLE:
U.S.A. SHOCKPROOF DENTAL X-RAY
COUNTERWEIGHT ASSEMBLY

H. G. FISCHER & CO.
2335 WABANSIA AVE.

CAT. NO.

PART NO. 13665G

4 HLS. – 2 HOLES EACH SIDE
$\frac{1}{4}$" DRILL – C'SUNK FOR RIVETING

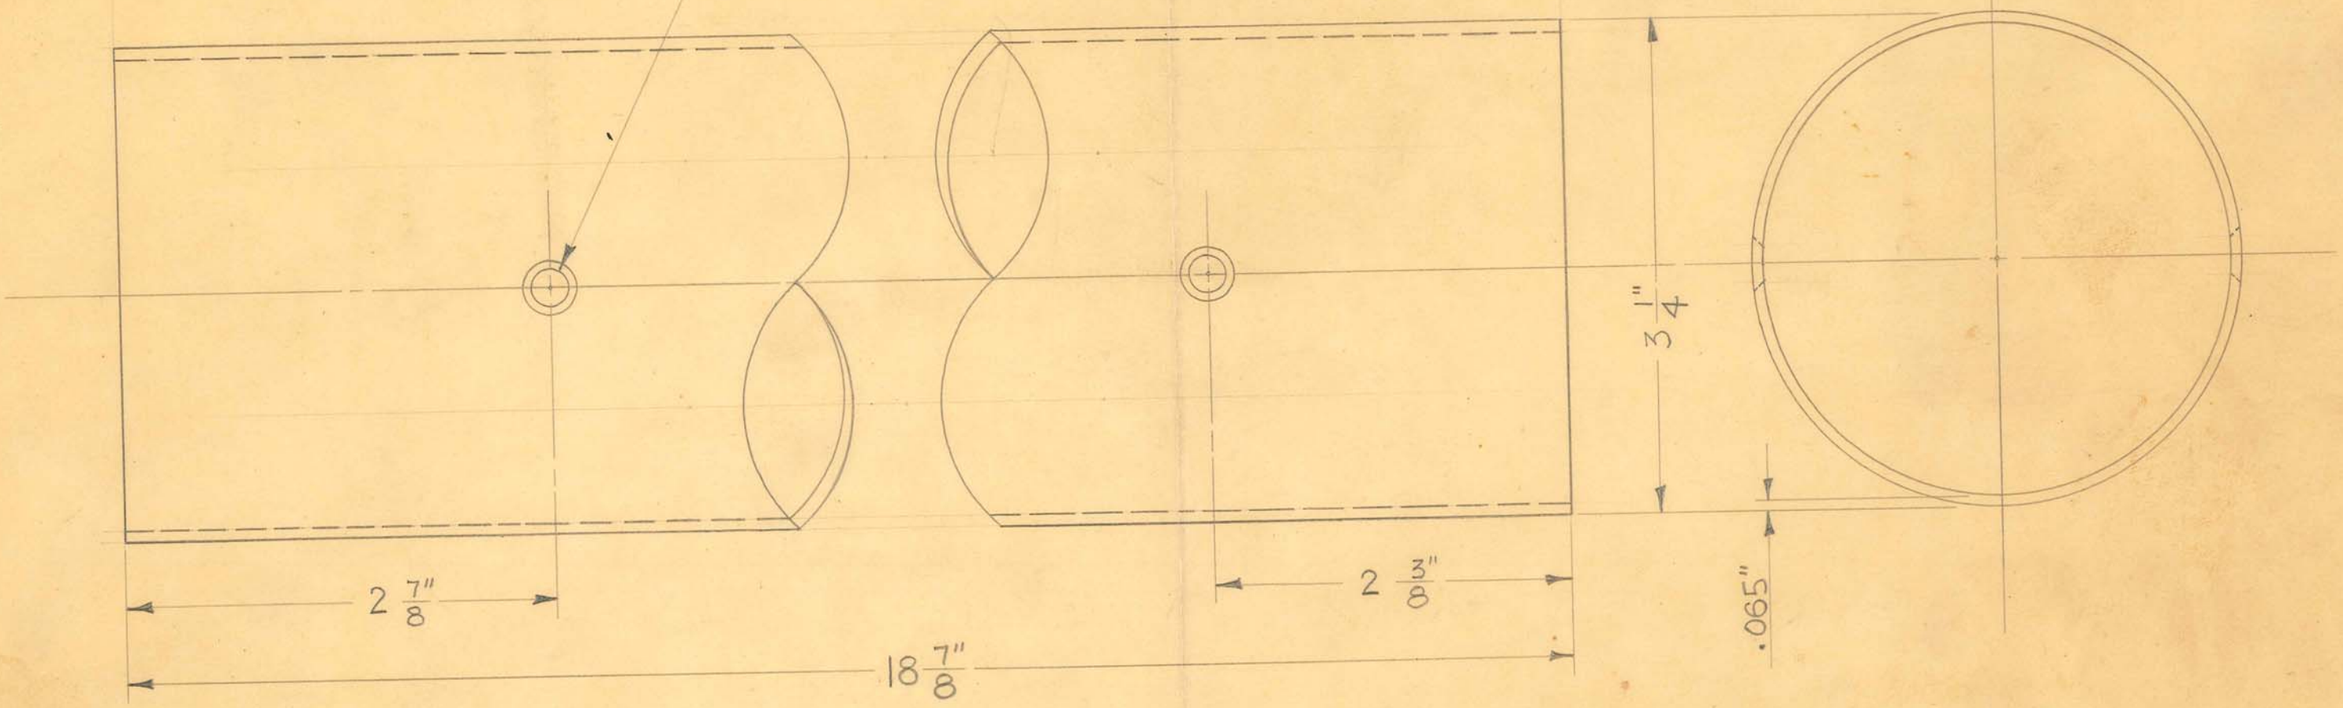

$3\frac{1}{4}$" O.D. X #16 GA. (.065") WALL SHELBY SEAMLESS STEEL TUBING

2 REQUIRED

OBSOLETE
Obsolete

SIZE		ISSUE 8-4-41	J.V.W.
KIND		CHANGED	
SHAPE		"	
FINISH		"	
TEMP.		"	
PATT.		"	

TITLE: U.S. ARMY SHOCKPROOF DENTAL X-RAY COUNTERWEIGHT TUBE

H. G. FISCHER & CO.
2335 WABANSIA AVE.
CHICAGO, ILL.

CAT. NO.

PART NO. 13670

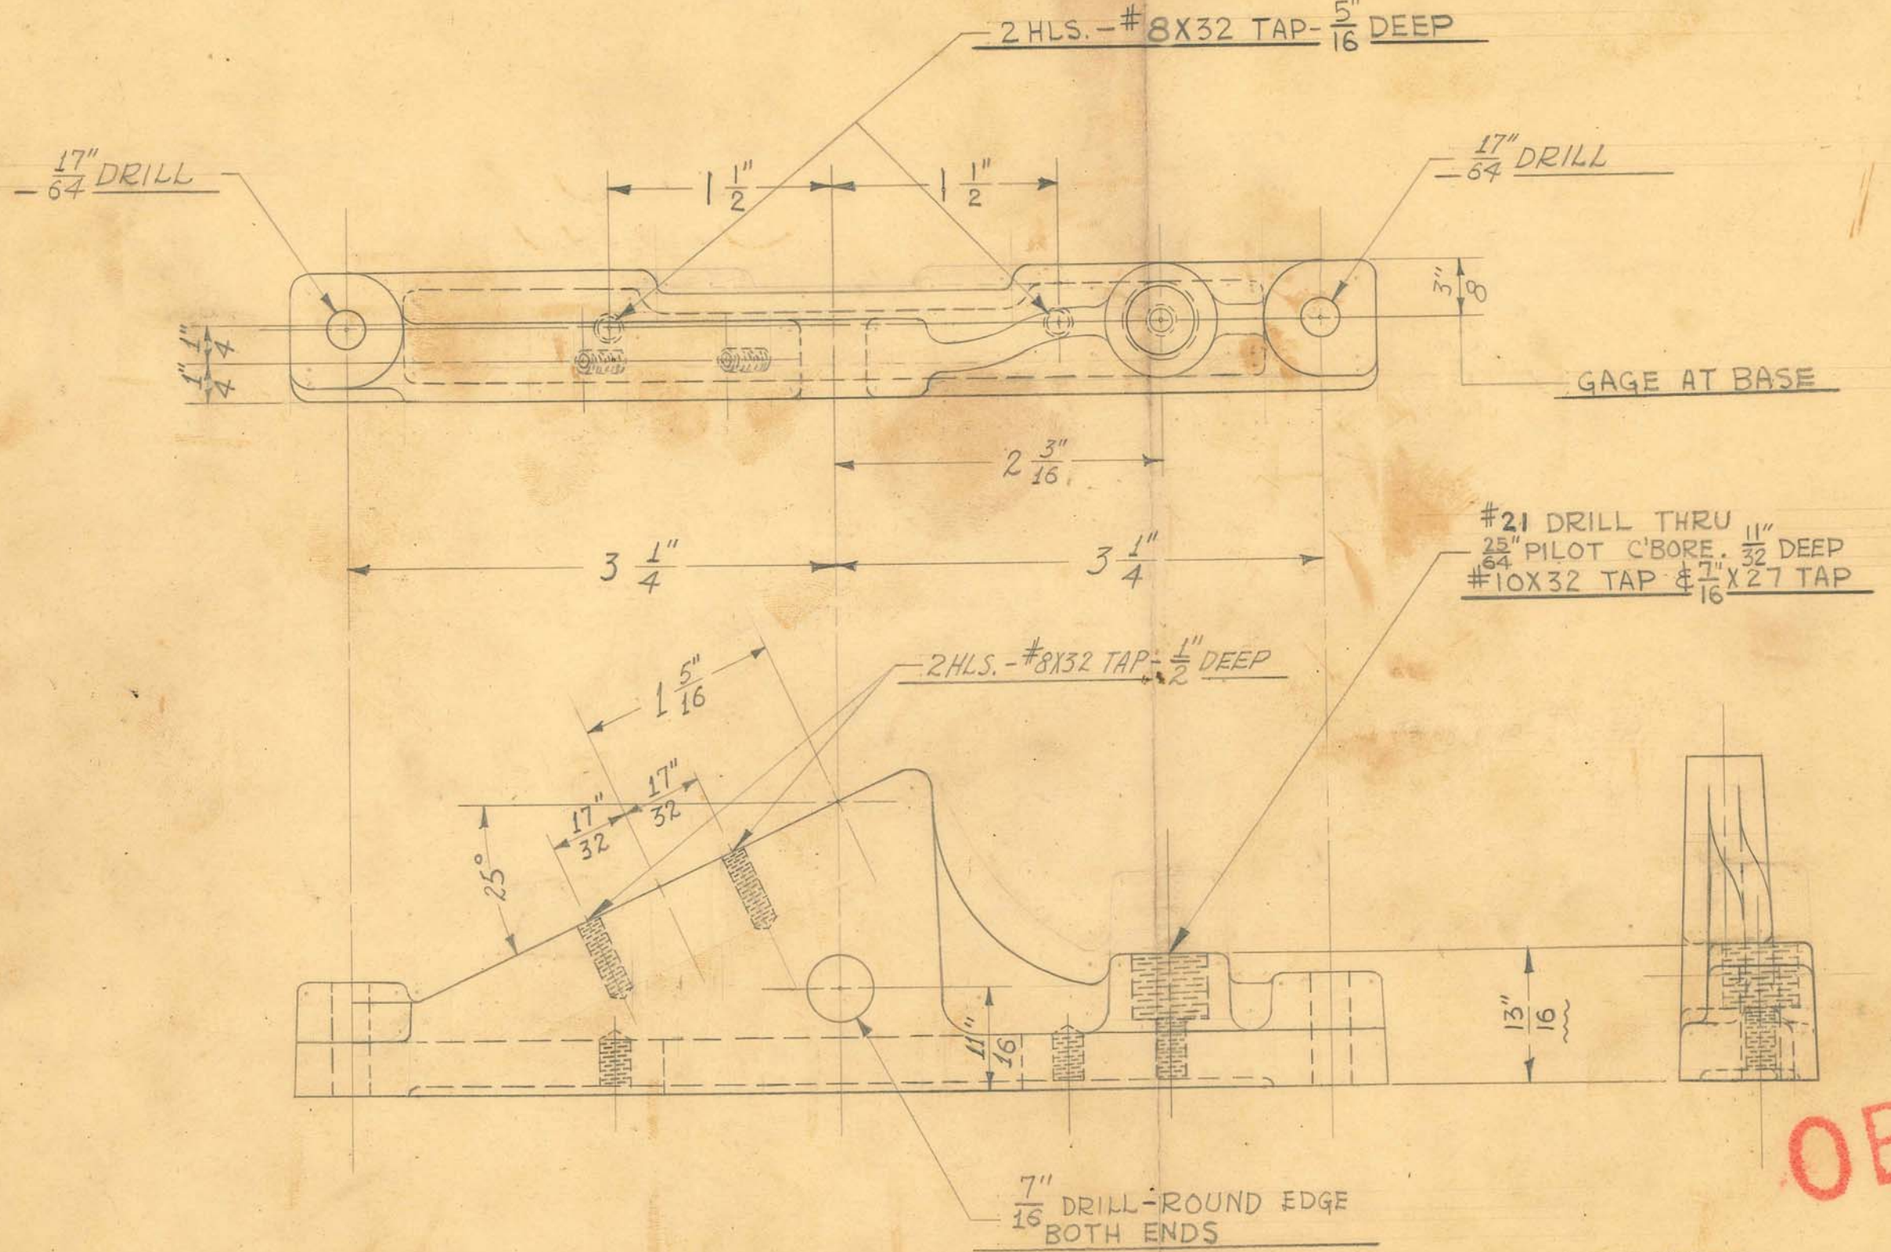

1 REQUIRED

OBSOLETE

Obsolete

SIZE	#214	ISSUE 12-27-40	J.V.W.
KIND	ALUM. CASTING	CHANGED 5-25-42	J.V.W.
SHAPE		"	
FINISH		"	
TEMP.		"	
PATT.	1690	"	

TITLE: U.S.A. SHOCKPROOF DENTAL X-RAY UNIT
TRANSF. CLAMP & FIL. TRANSF. SUPP. — LEFT

H. G. FISCHER & CO.
2335 WABANSIA AVE.
CHICAGO, ILL.

CAT. NO.

PART NO. 13676FA

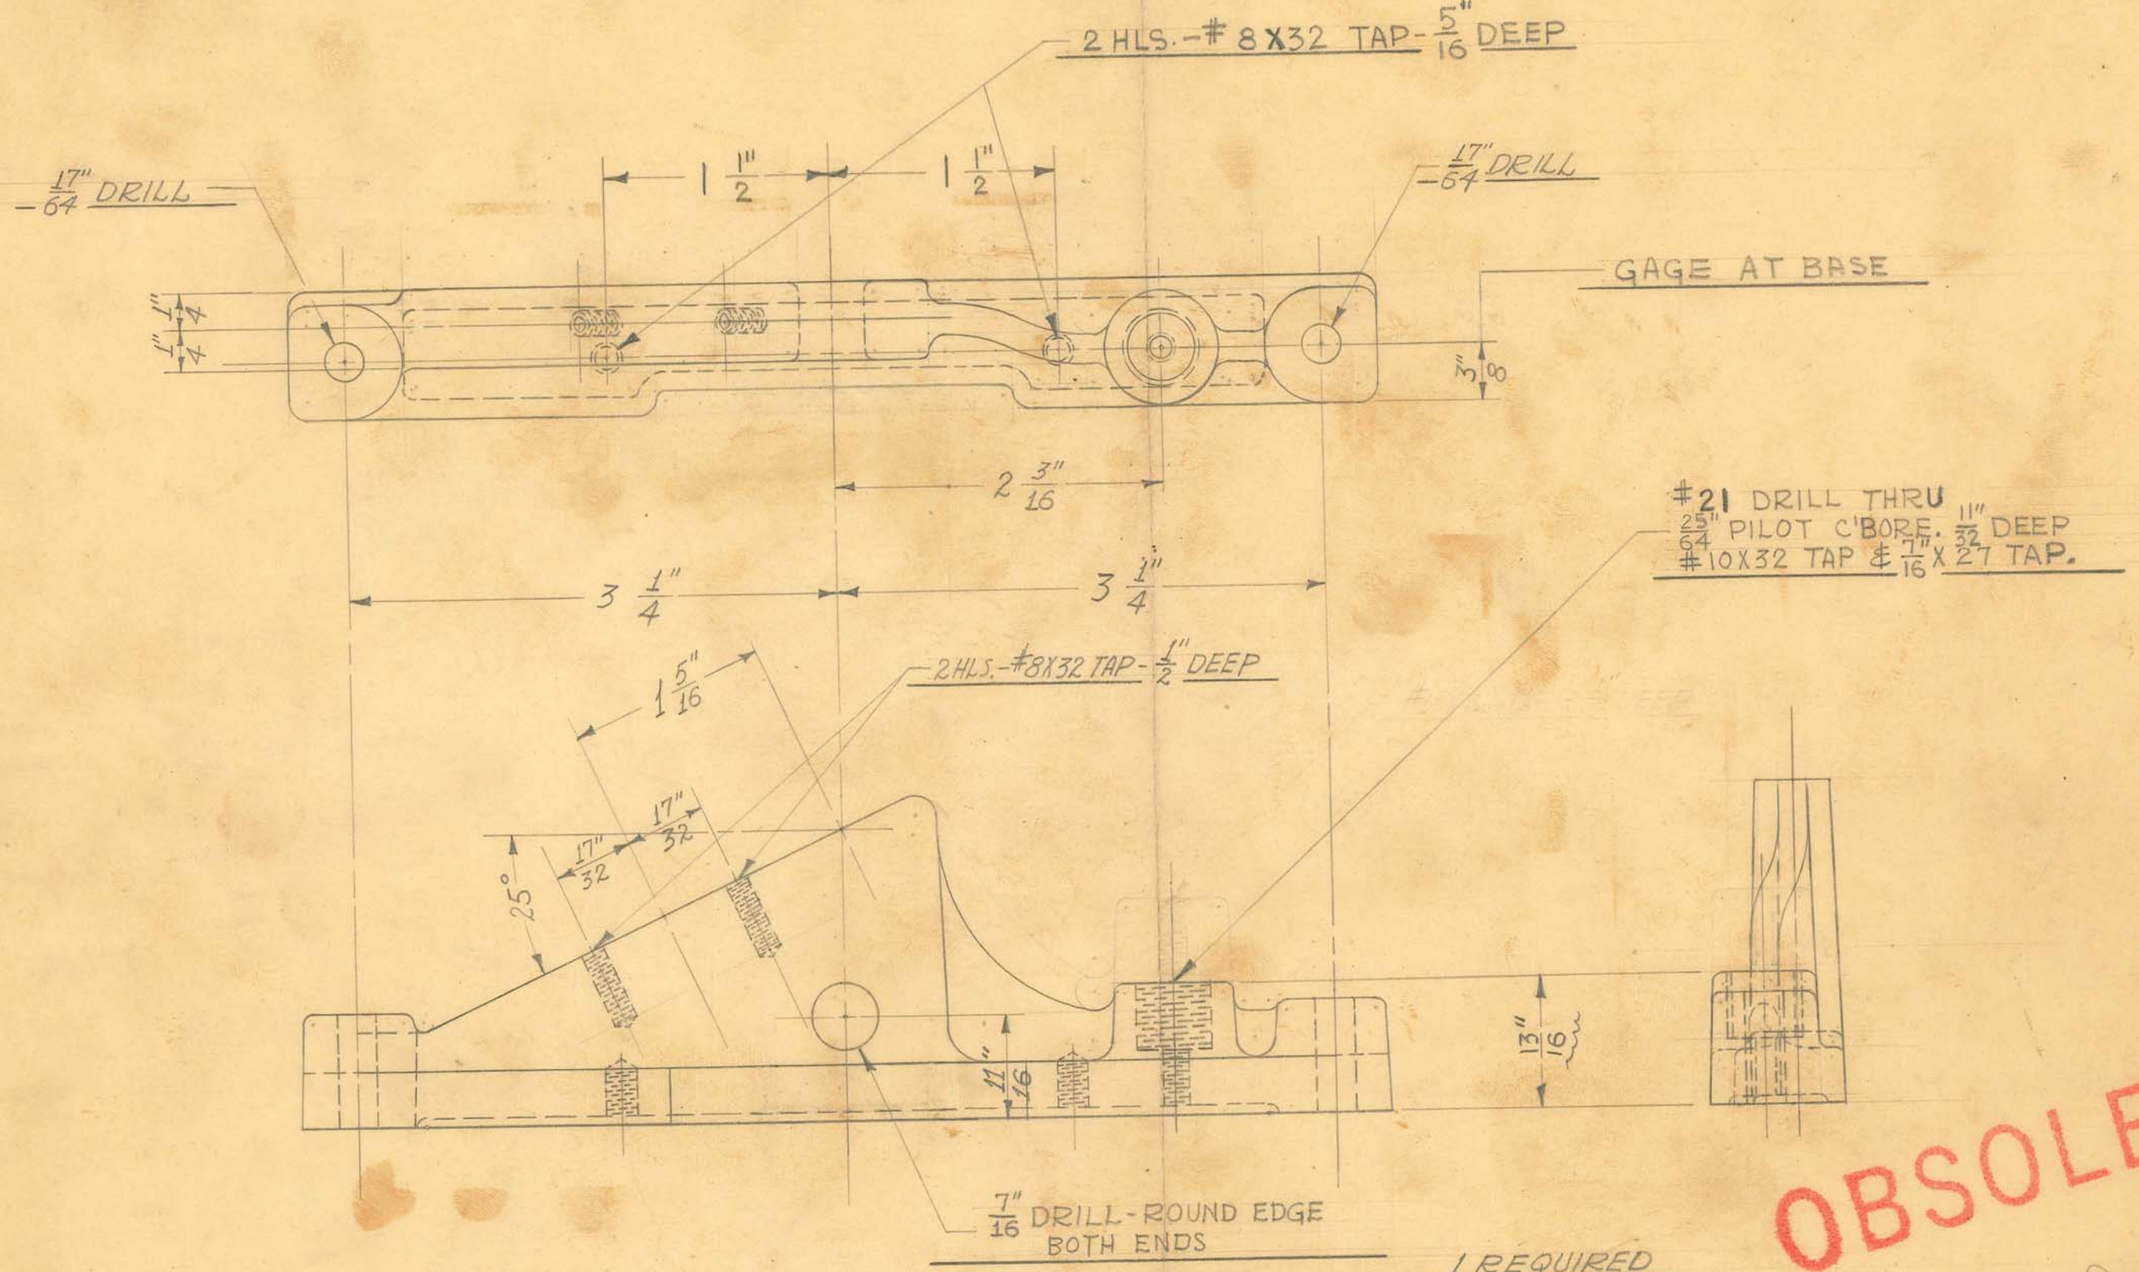

OBSOLETE

Obsolete

SIZE	#214	ISSUE 12-27-40	J.V.W.	TITLE: U.S.A. SHOCKPROOF DENTAL X-RAY UNIT TRANSF. CLAMP & FIL. TRANSF. SUPP.-RIGHT
KIND	ALUM. CASTING	CHANGED 5-25-42	J.V.W.	
SHAPE		"		
FINISH		"		
TEMP.		"		
PATT.	1691	"		

H. G. FISCHER & CO.
2338 WABANSIA AVE.
CHICAGO, ILL.

CAT. NO.

PART NO. 13677FA

8 HLS.- #35 DRILL SIZE

$2\frac{3}{16}$" $2\frac{3}{16}$"

$3\frac{31}{32}$" 2" 2" $3\frac{31}{32}$"

$\frac{3}{16}$" R. $\frac{3}{16}$" R. $\frac{3}{16}$" R.

$2\frac{1}{16}$" $1\frac{13}{32}$" $1\frac{23}{32}$"

$\frac{13}{16}$" $1\frac{1}{8}$" OFF $\frac{15}{32}$" ON

$\frac{13}{32}$" $1\frac{9}{32}$"

$\frac{25}{64}$" $1\frac{1}{8}$" R. 25°

FILAMENT CONTROL

30° 30°

$4\frac{9}{16}$"

$6\frac{5}{32}$"

$12\frac{5}{16}$"

LINE SWITCH

SAFETY CIRCUIT BREAKER

$\frac{21}{64}$" $\frac{21}{64}$"

$1\frac{9}{64}$" $1\frac{9}{64}$"

$1\frac{3}{8}$" $1\frac{3}{8}$"

$\frac{25}{64}$" $1\frac{1}{8}$" R. 30°

KILOVOLTAGE CONTROL.

15° 15°

2 HLS.-#25 DRILL

$4\frac{9}{16}$"

$6\frac{5}{32}$"

$2\frac{1}{32}$" $1\frac{19}{32}$" $1\frac{29}{32}$" $1\frac{1}{32}$" $4\frac{5}{32}$"

OBSOLETE

SIZE		ISSUE 5-23-41	HE.	TITLE: ARMY DENTAL X-RAY UNIT - CONTROL DIAL PLATE
KIND		CHANGED		
SHAPE		"		
FINISH		"		
TEMP.		"		
PATT.		"		

H. G. FISCHER & CO.
2335 WABANSIA AVE.
CHICAGO, ILL.

CAT. NO.

PART NO. 13681

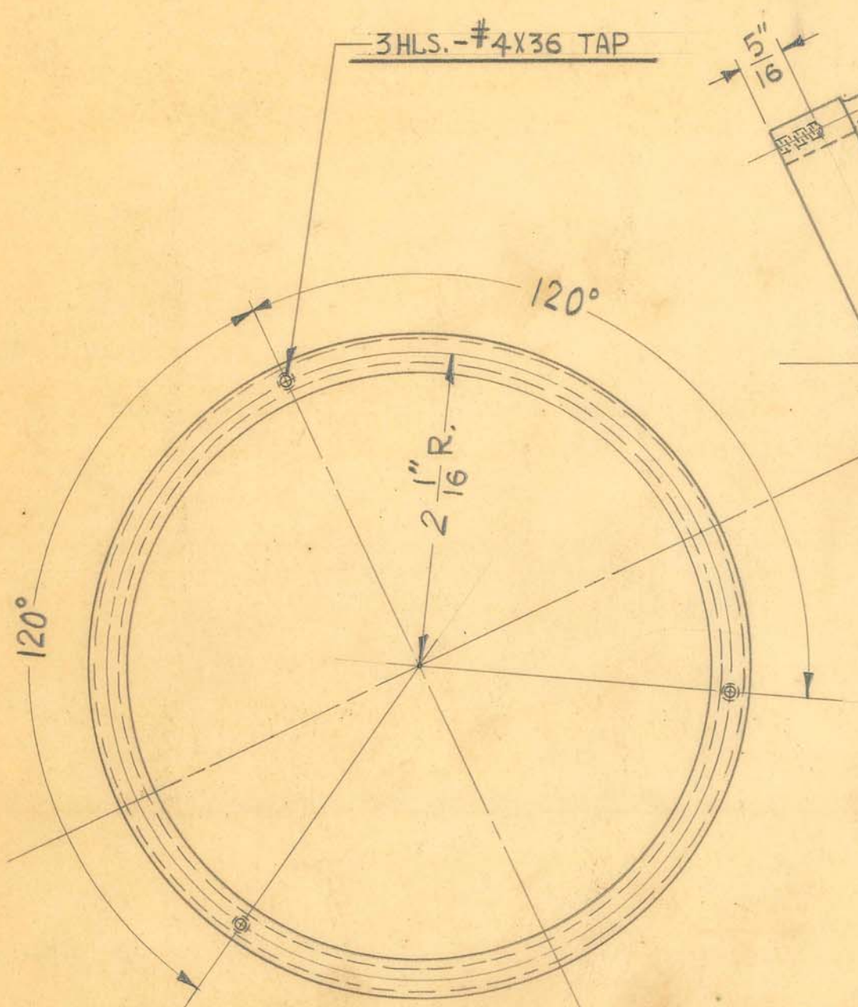

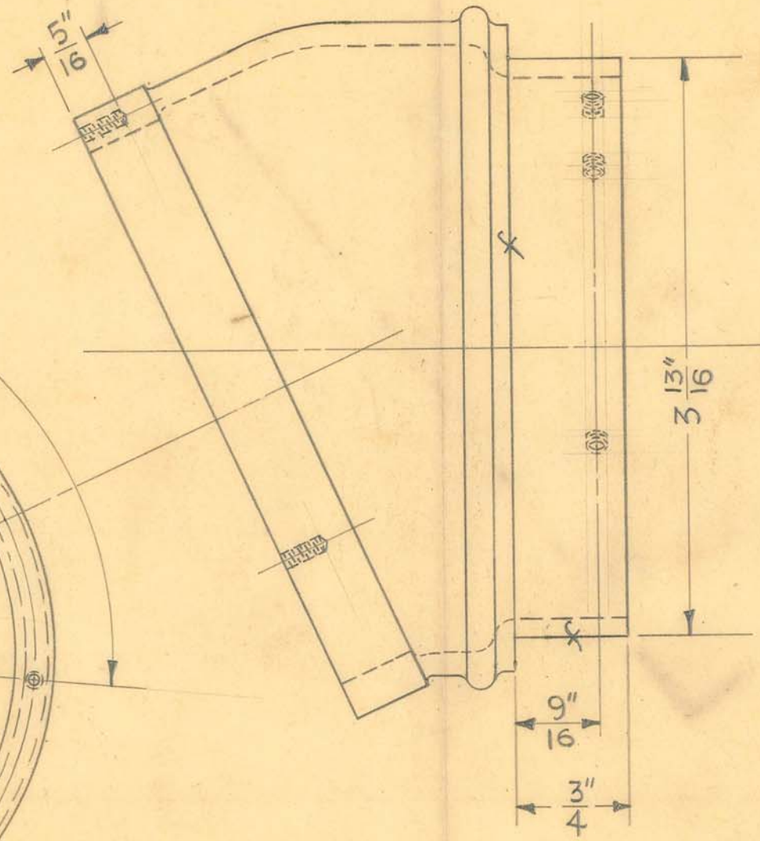

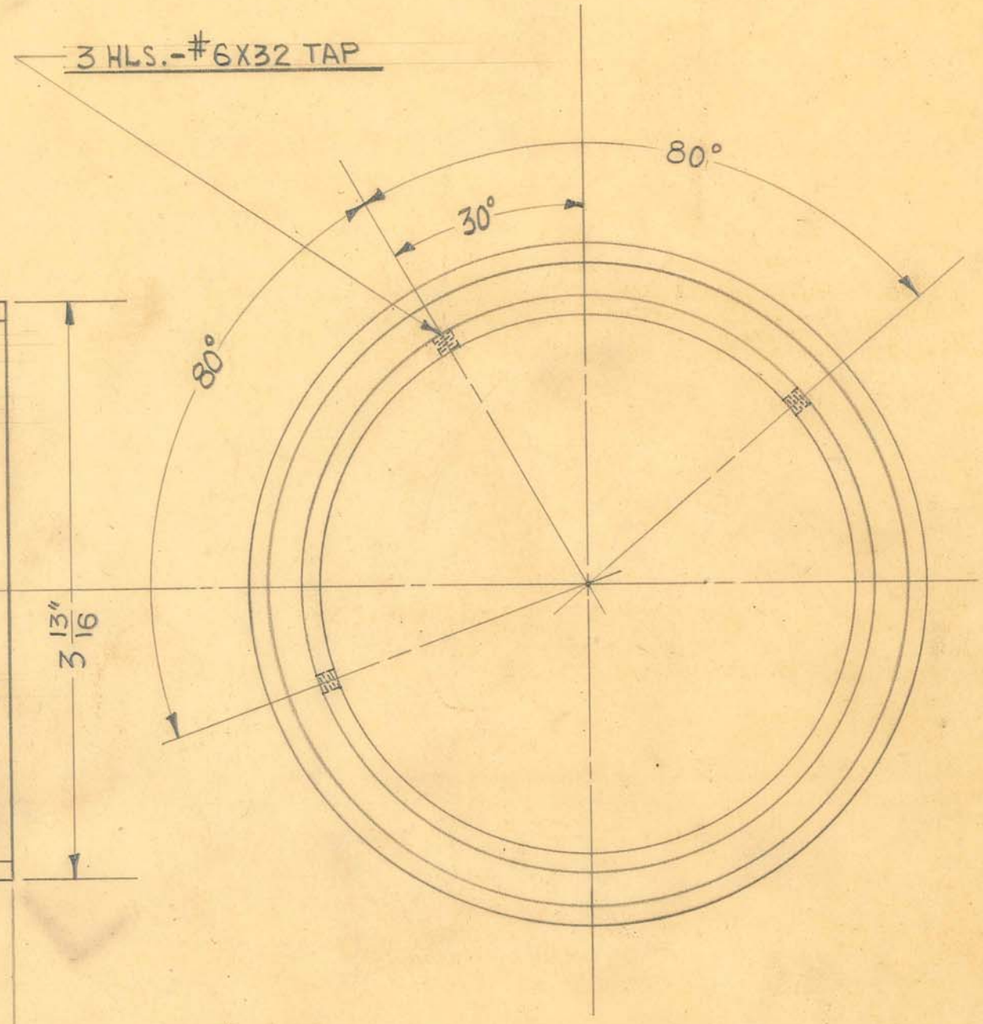

2 REQUIRED

OBSOLETE

SIZE	IRON	ISSUE 4-11-42	J.N.W.
KIND	CASTING	CHANGED	
SHAPE		"	
FINISH	PAINTED	"	
TEMP.		"	
PATT.	1885	"	

TITLE: FISCHER MOD. "AGA" DENTAL X-RAY UNIT CONTROL BOX METER HOUSING

H. G. FISCHER & CO.
2335 WABANSIA AVE.
CHICAGO, ILL.

CAT. NO.

PART NO. 13682F

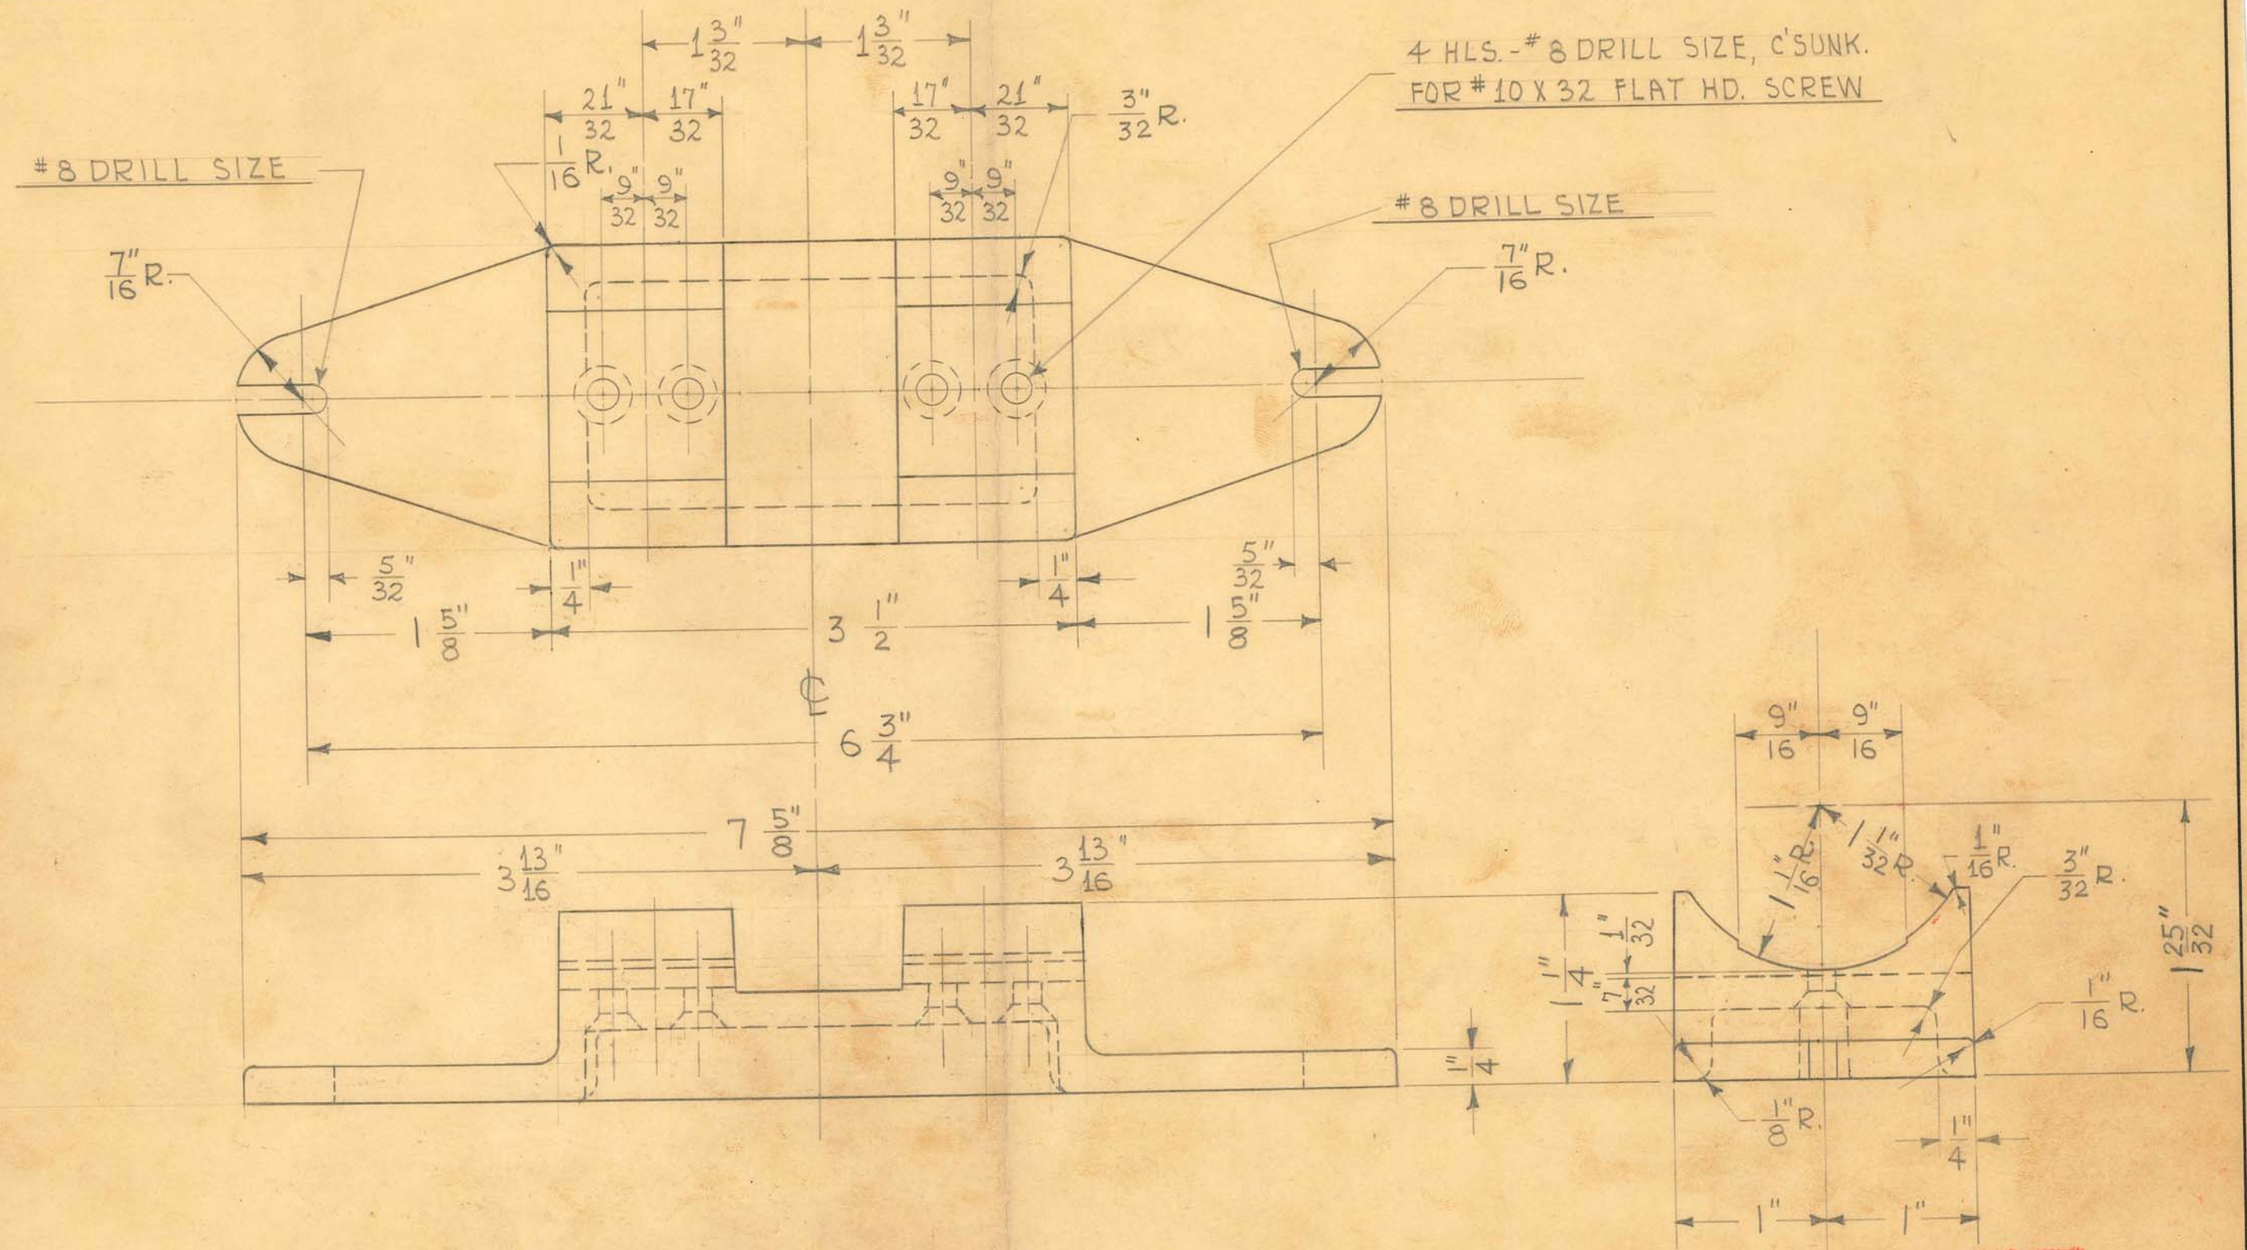

1 REQUIRED

OBSOLETE

MOLD # 1813

SIZE		ISSUE 6-5-41	J.V.W.
KIND	BAKELITE	CHANGED	
SHAPE	MOLDED	" 9-23-42	H.E.
FINISH		"	
TEMP.		"	
PATT.		"	

TITLE: U.S.A. SHOCKPROOF DENTAL X-RAY
X-RAY TUBE MOUNTING BOARD

H. G. FISCHER & CO.
2338 WABANSIA AVE.
CHICAGO, ILL.

CAT. NO.

PART NO. 13684

2 HLS. -#18 DRILL

2 HLS. -#25 DRILL C'SUNK. FOR #6 F. HD. SCREW

2 HLS. -#8X32 TAP

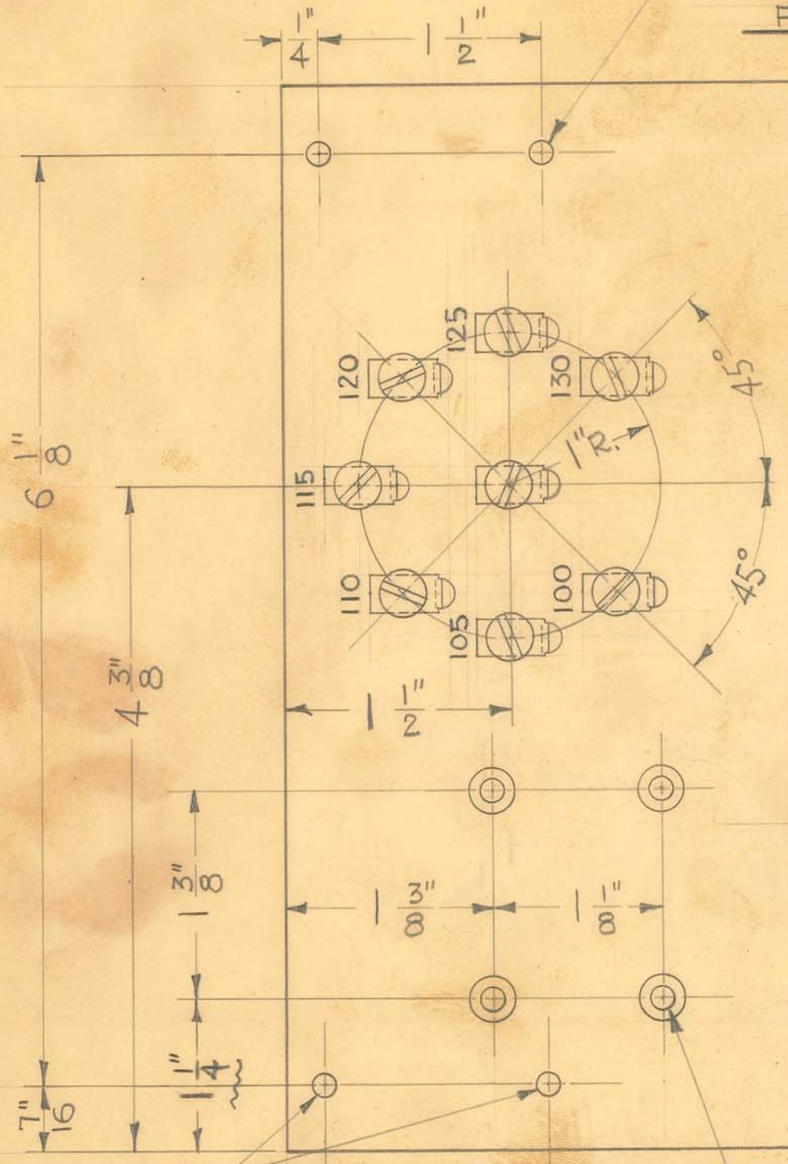

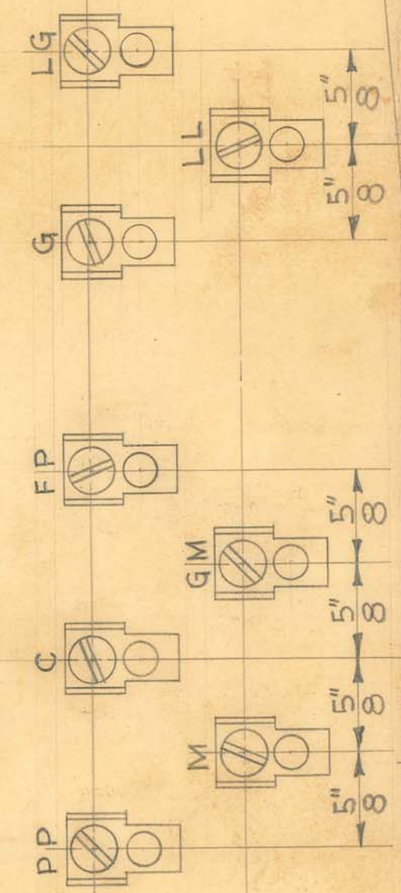

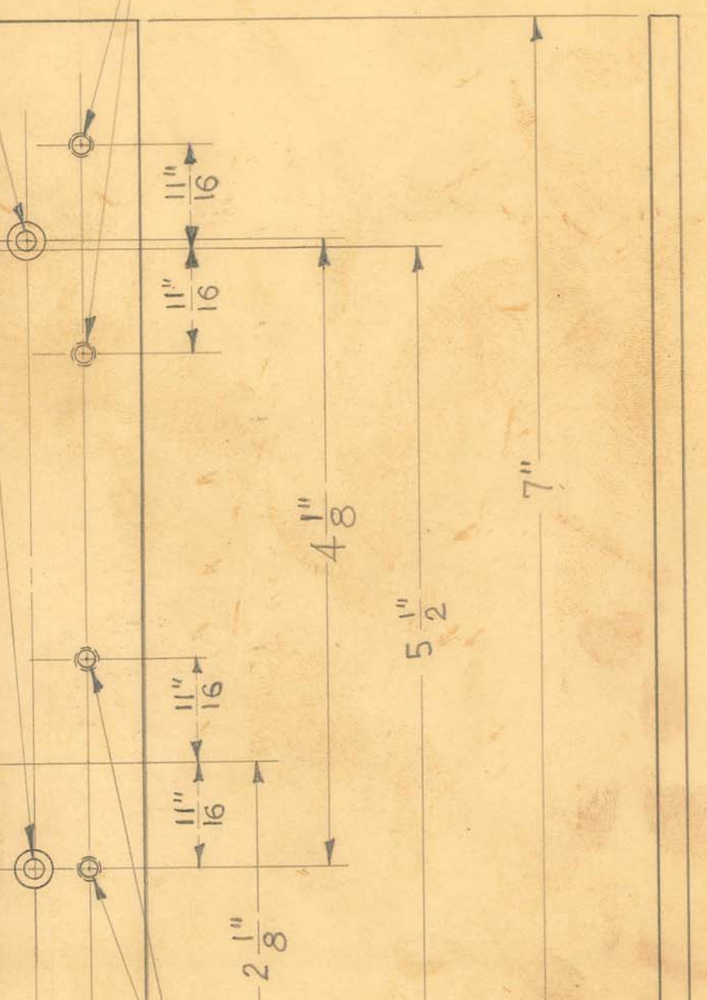

2 HLS. -#18 DRL.

4 HLS. -#18 DRILL C'SUNK. FOR #8 F. HD. SCR.

2 HLS. -#8X32 TAP

1/8"

OBSOLETE

SIZE		ISSUE 6-20-41	J.V.W.
KIND		CHANGED	
SHAPE		"	
FINISH		"	
TEMP.		"	
PATT.		"	

TITLE: U.S.A. SHOCKPROOF DENTAL X-RAY UNIT CONTROL BOX-VOLTAGE CHANGE & TERMINAL BOARD

H. G. FISCHER & CO.
2335 WABANSIA AVE.
CHICAGO, ILL.

CAT. NO.

PART NO. 13685G

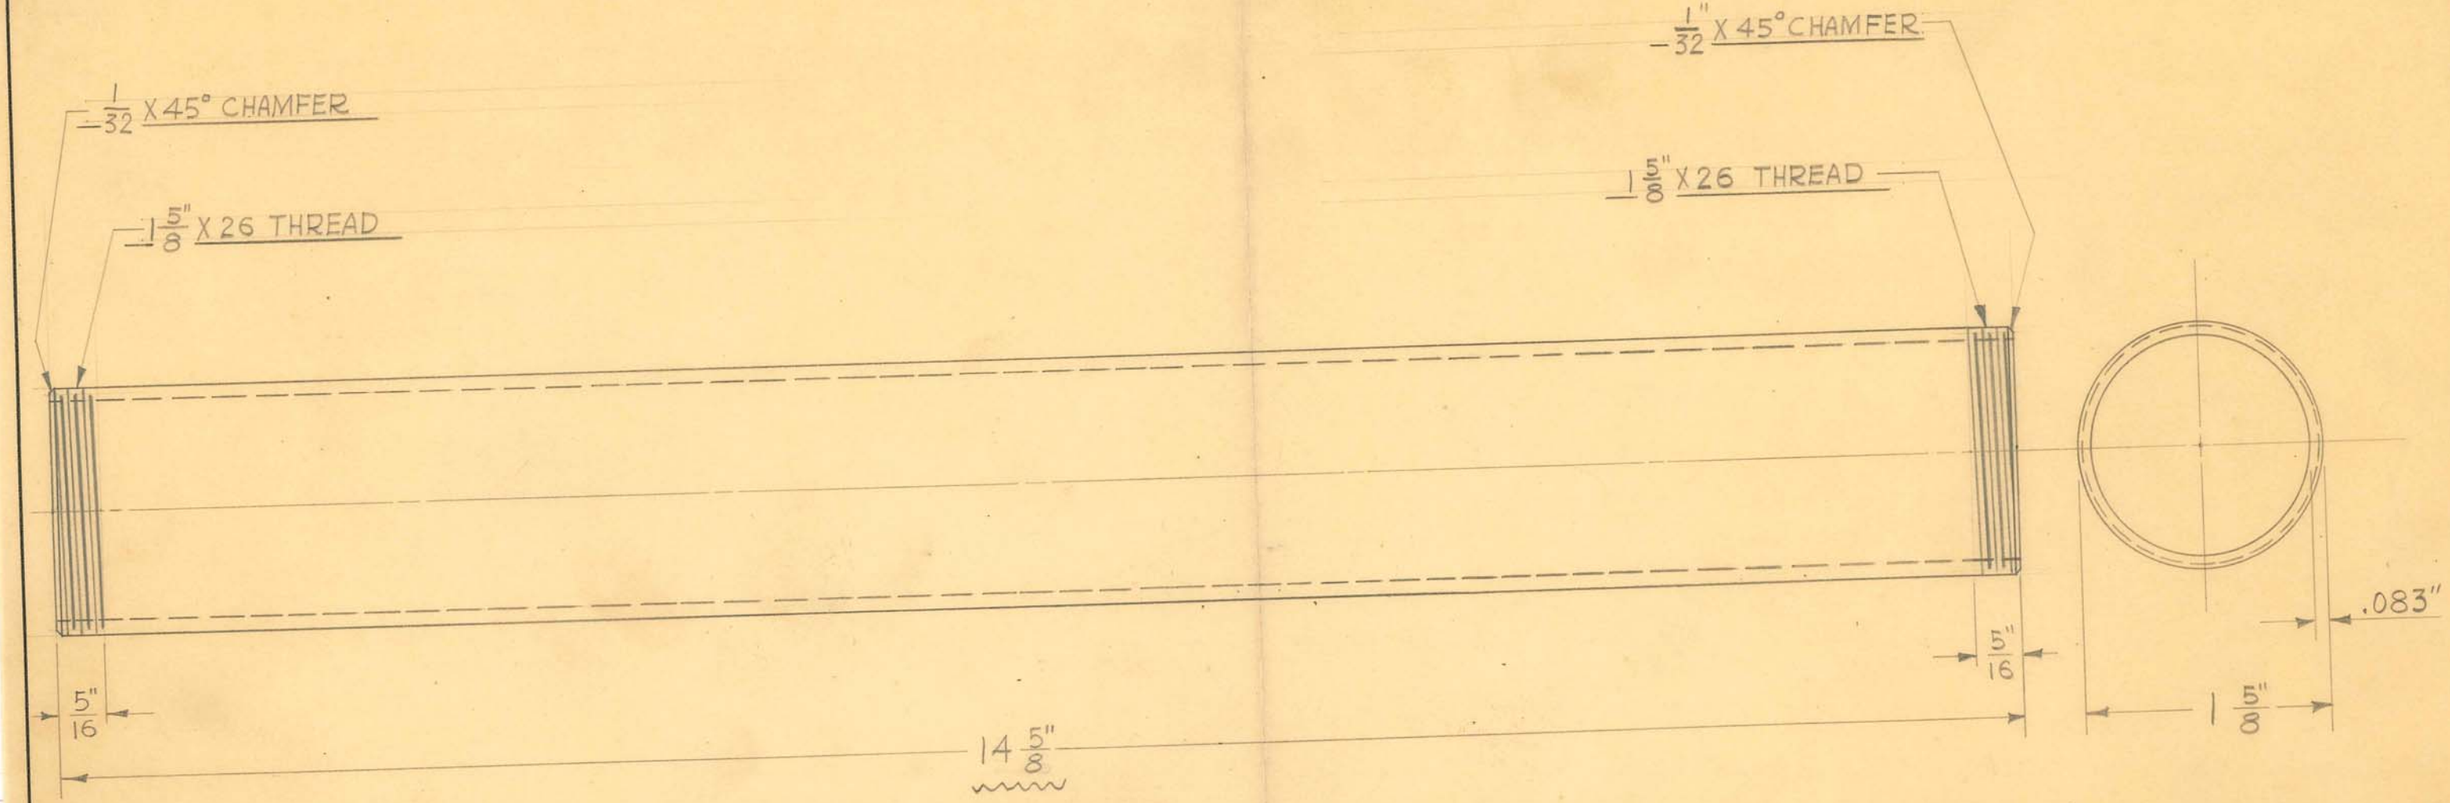

REMOVE BURR FROM INSIDE OF TUBE-ON BOTH ENDS

1 5/8" O.D. X #14 GA. (.083") WALL SHELBY SEAMLESS STEEL TUBING

2 REQUIRED

OBSOLETE

SIZE		ISSUE 1-30-41	J.V.W.
KIND		CHANGED	
SHAPE		"	
FINISH	PAINTED	"	
TEMP.		"	
PATT.		"	

TITLE: ARMY SHOCKPROOF DENTAL X-RAY UNIT
COUNTERBALANCE TUBE

H. G. FISCHER & CO.
2338 WABANSIA AVE.
CHICAGO, ILL.

CAT. NO.

PART NO. 13686

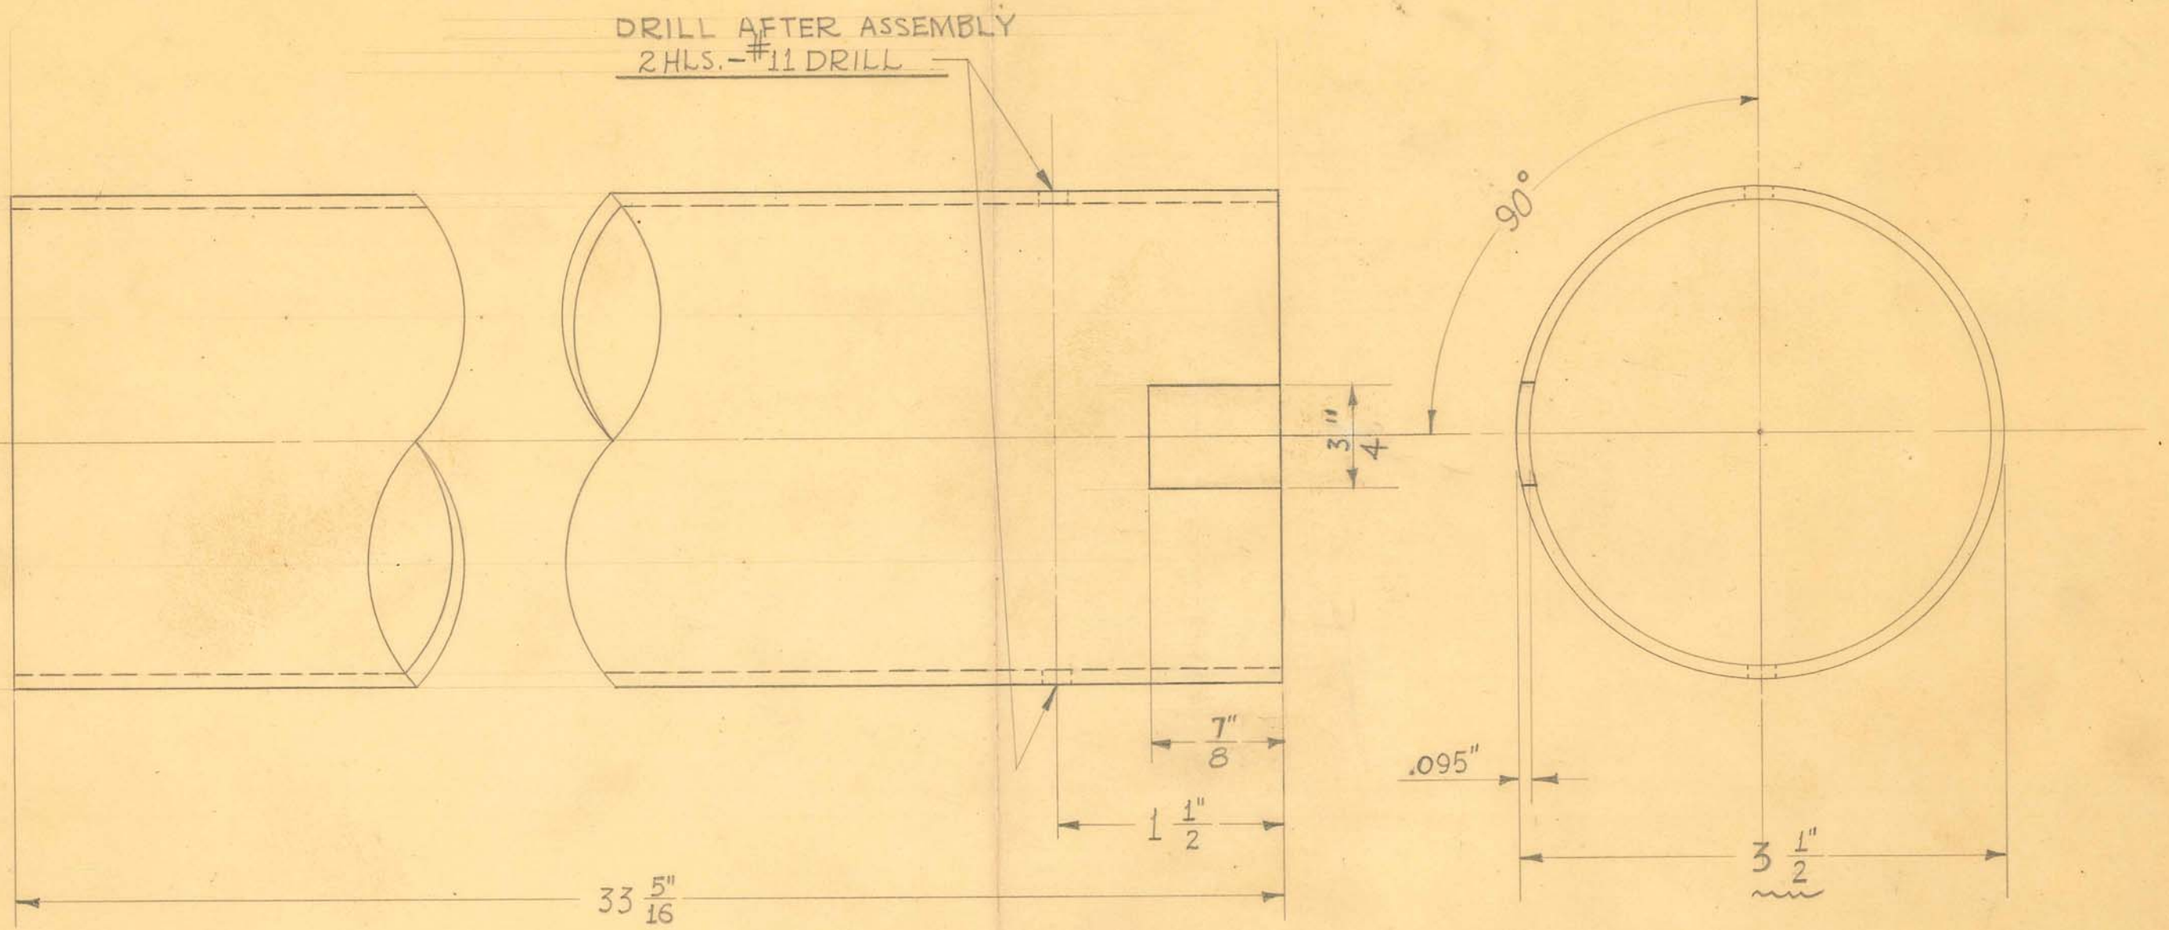

3 1/2" O.D. X #13 GA. WALL SHELBY SEAMLESS STEEL TUBING

2 REQUIRED

OBSOLETE

Obsolete

SIZE		ISSUE 1-22-41	J.V.W.
KIND		CHANGED	
SHAPE		"	
FINISH	CAD. #23	"	
TEMP.		"	
PATT.		"	

TITLE:
ARMY SHOCKPROOF DENTAL X-RAY UNIT
UPRIGHT GUIDE TUBE

H. G. FISCHER & CO.
2338 WABANSIA AVE.
CHICAGO, ILL.

CAT. NO.

PART NO. 13748F

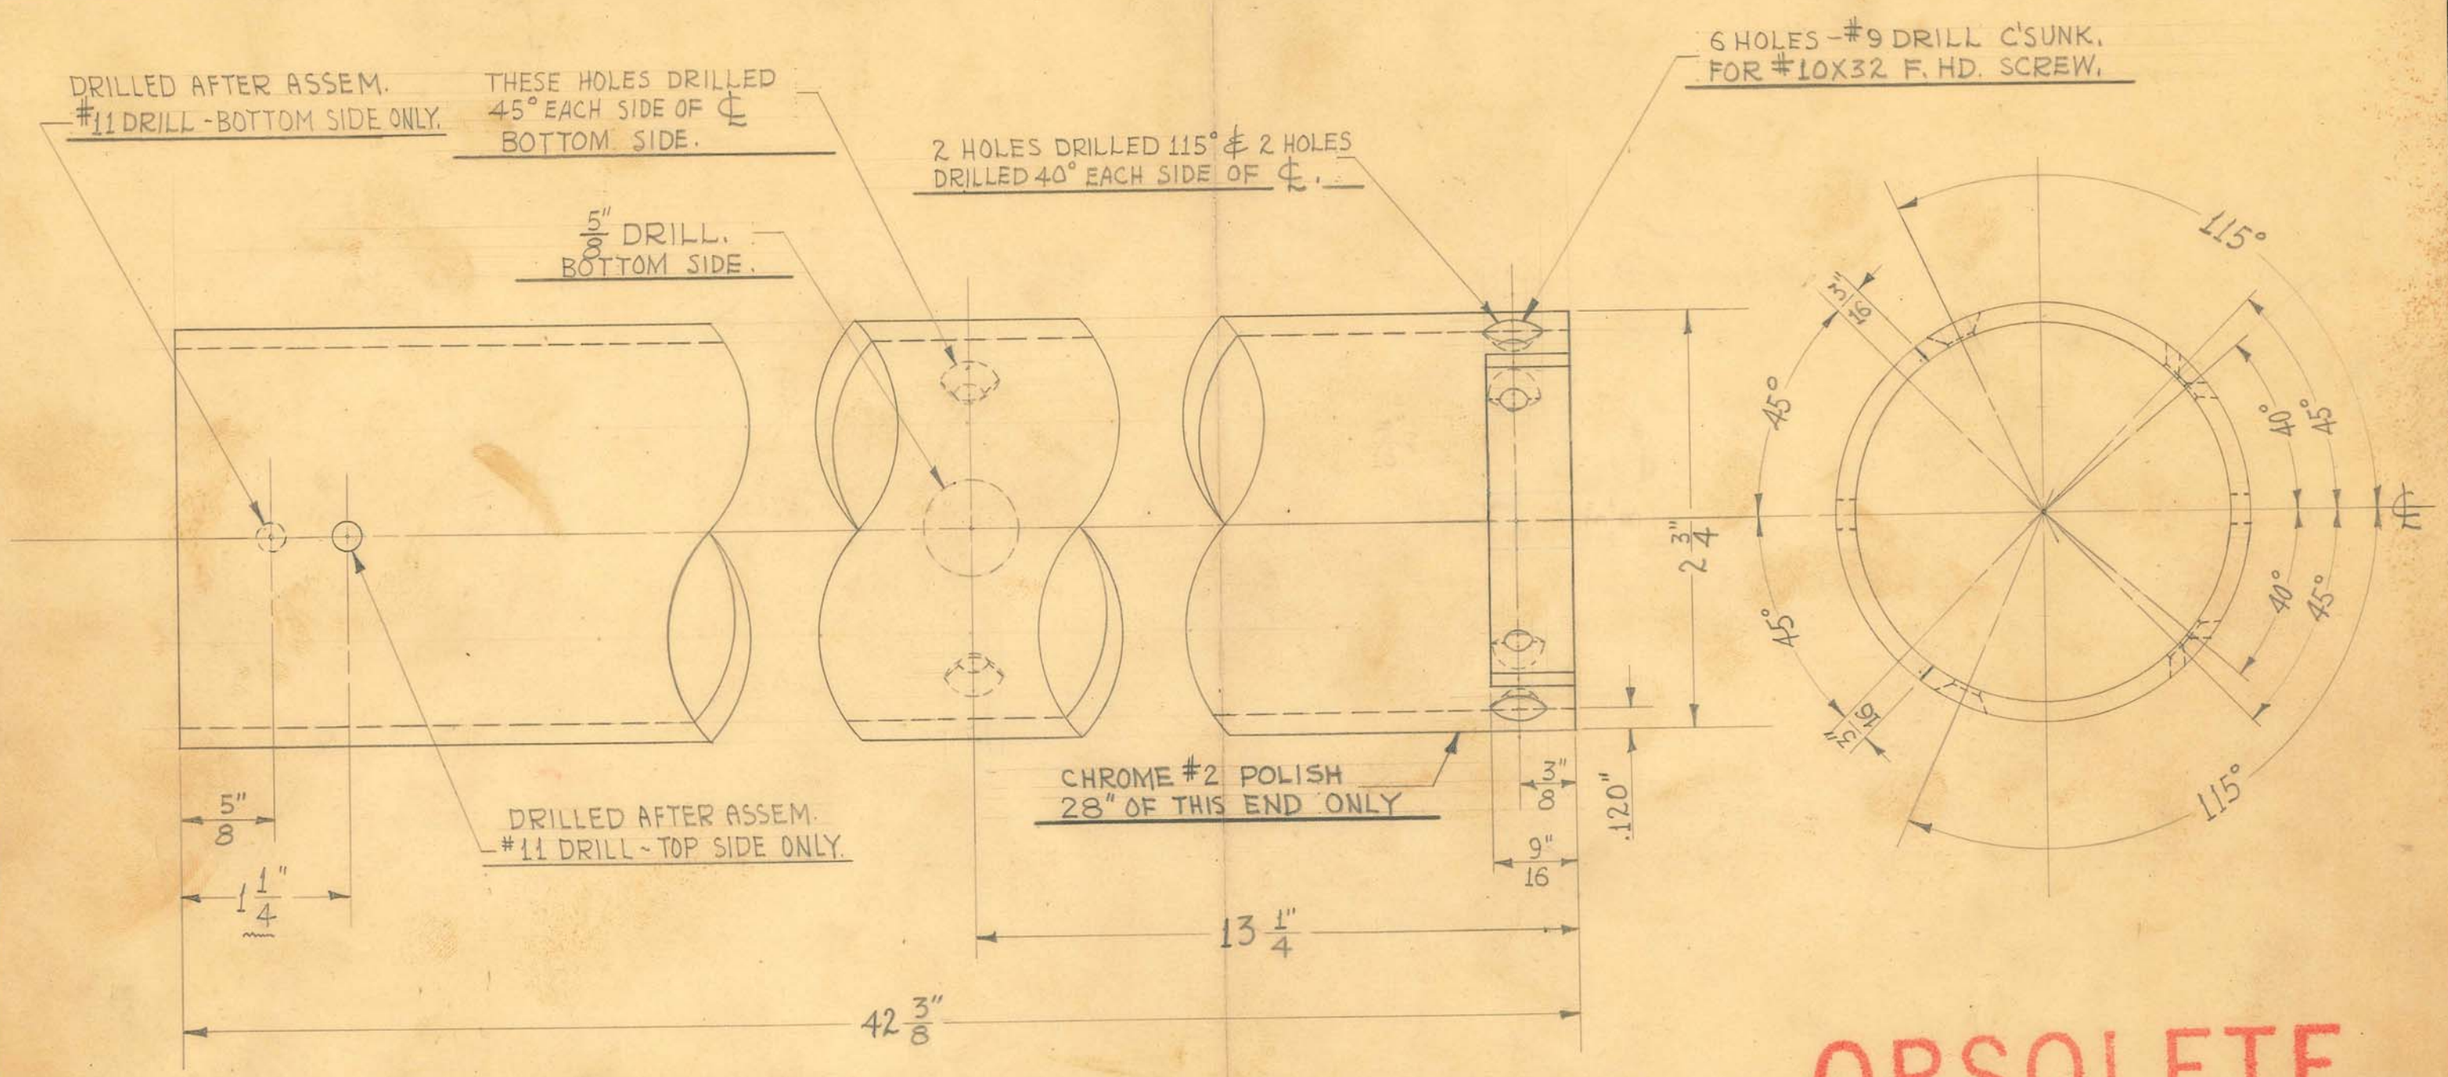

OBSOLETE

2 3/4" O.D. X #11GA. (.120") WALL - SHELBY SEAMLESS STEEL TUBING

1 REQUIRED

Obsolete

SIZE		ISSUE 1-22-41	J.V.W.
KIND		CHANGED	
SHAPE		"	
FINISH	SEE NOTE	"	
TEMP.		"	
PATT.		"	

TITLE: ARMY SHOCKPROOF DENTAL X-RAY UNIT
UPRIGHT TUBE

H. G. FISCHER & CO.
2335 WABANSIA AVE.
CHICAGO, ILL.

CAT. NO.

PART NO. 13749F

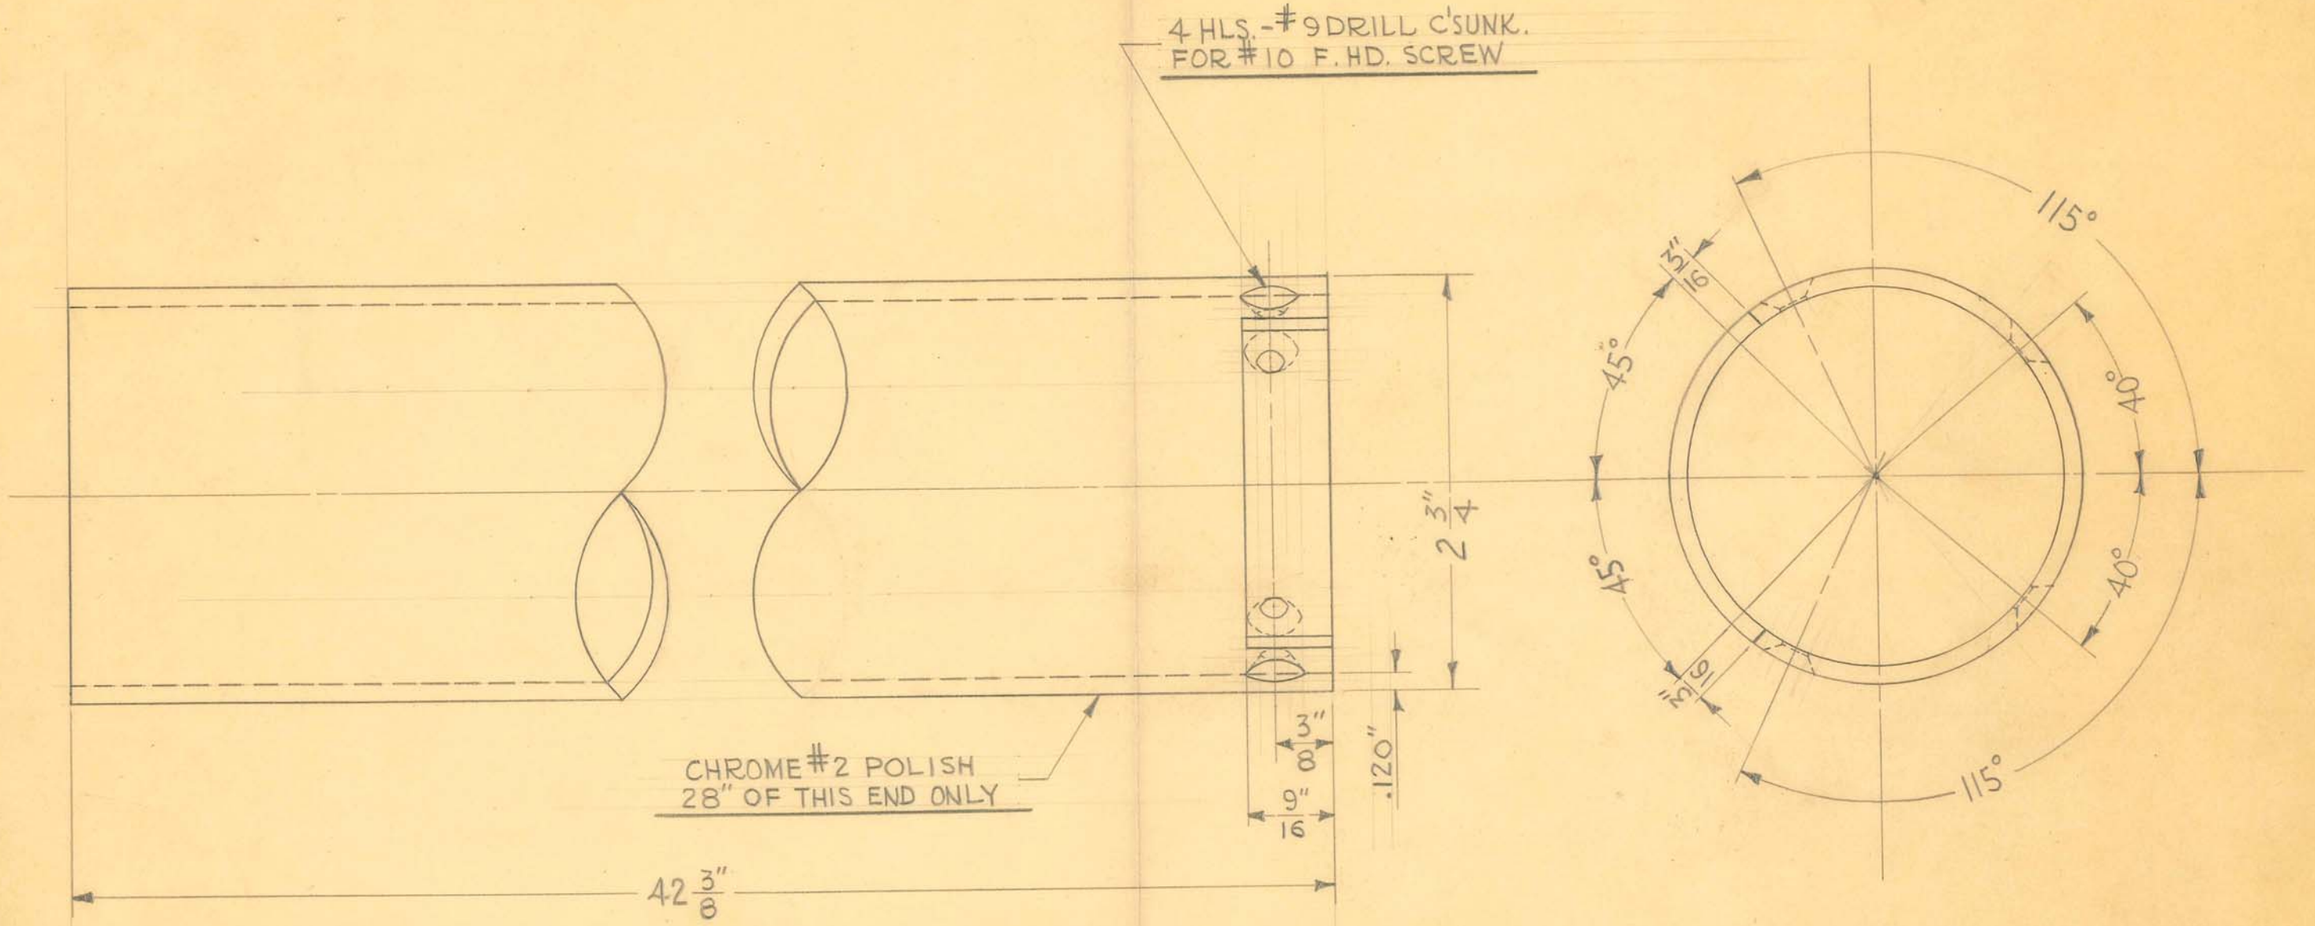

2 3/4" O.D. X # 11 GA. (.120") WALL SHELBY SEAMLESS STEEL TUBING

1 REQUIRED

OBSOLETE

SIZE		ISSUE 6-15-42	J.V.W.	TITLE: FISCHER "AGA" S.P. DENTAL X-RAY UNIT UPRIGHT TUBE
KIND		CHANGED		
SHAPE		"		
FINISH	SEE NOTE	"		
TEMP.		"		
PATT.		"		

H. G. FISCHER & CO.
2335 WABANSIA AVE.
CHICAGO, ILL.

CAT. NO.

PART NO. 13749FA

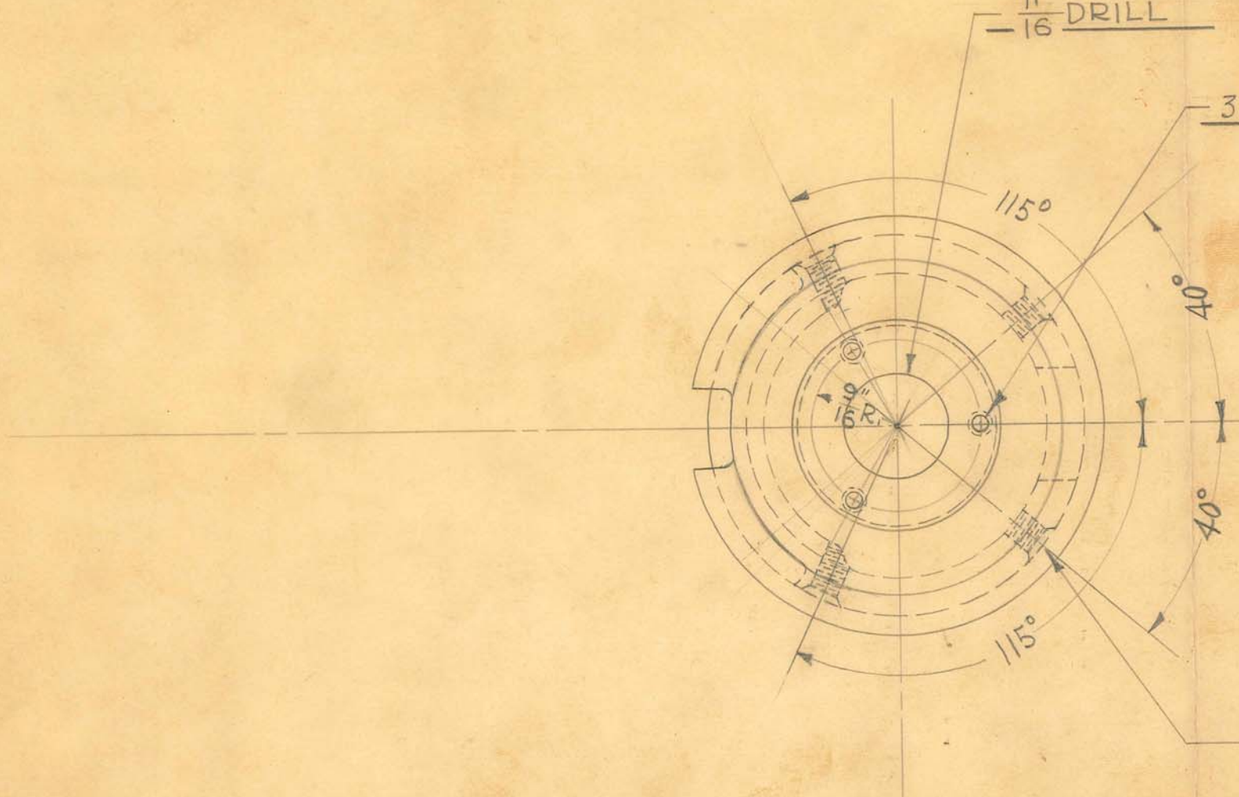

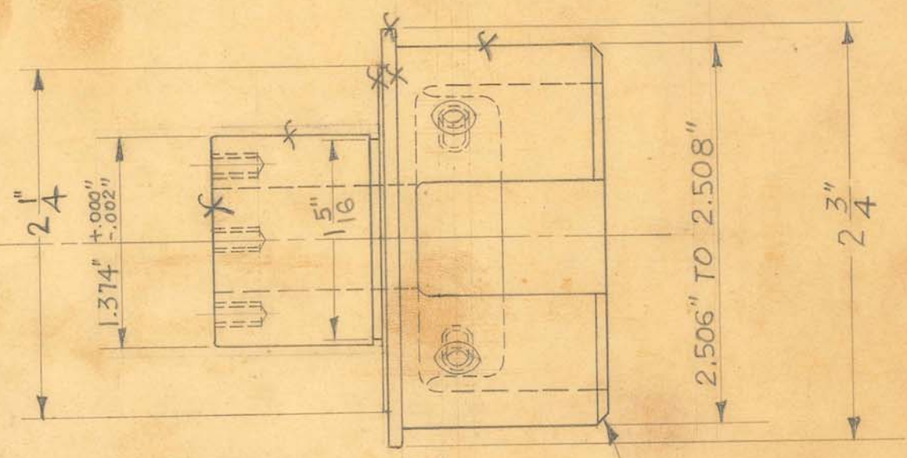

4 HLS. -#10X32 TAP - C'SUNK. TO 9/32 FACE

1/16 X45° CHAMFER

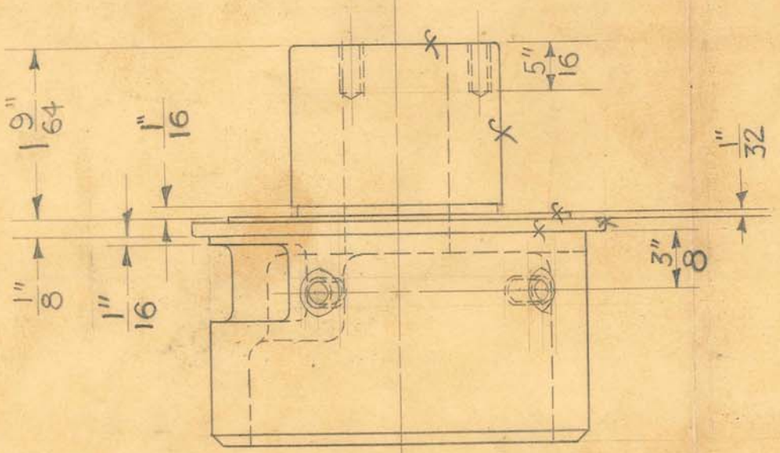

OBSOLETE

1 REQUIRED

SIZE	80-10-10	ISSUE 6-12-41	J.V.W.	TITLE: U.S.A. SHOCKPROOF DENTAL X-RAY UNIT UPRIGHT TUBE SWIVEL BEARING
KIND	BRONZE	CHANGED		
SHAPE		"		
FINISH		"		
TEMP.		"		
PATT.	1668	"		

H. G. FISCHER & CO. 2333 WABANSIA AVE. CHICAGO, ILL. | CAT. NO. | PART NO. 13750F

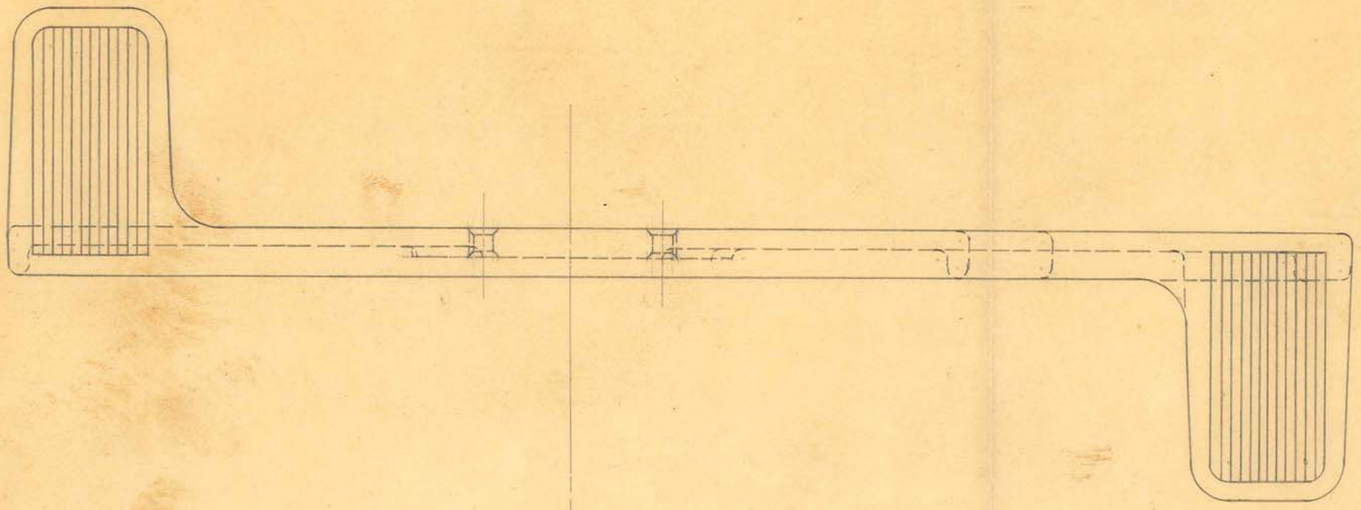

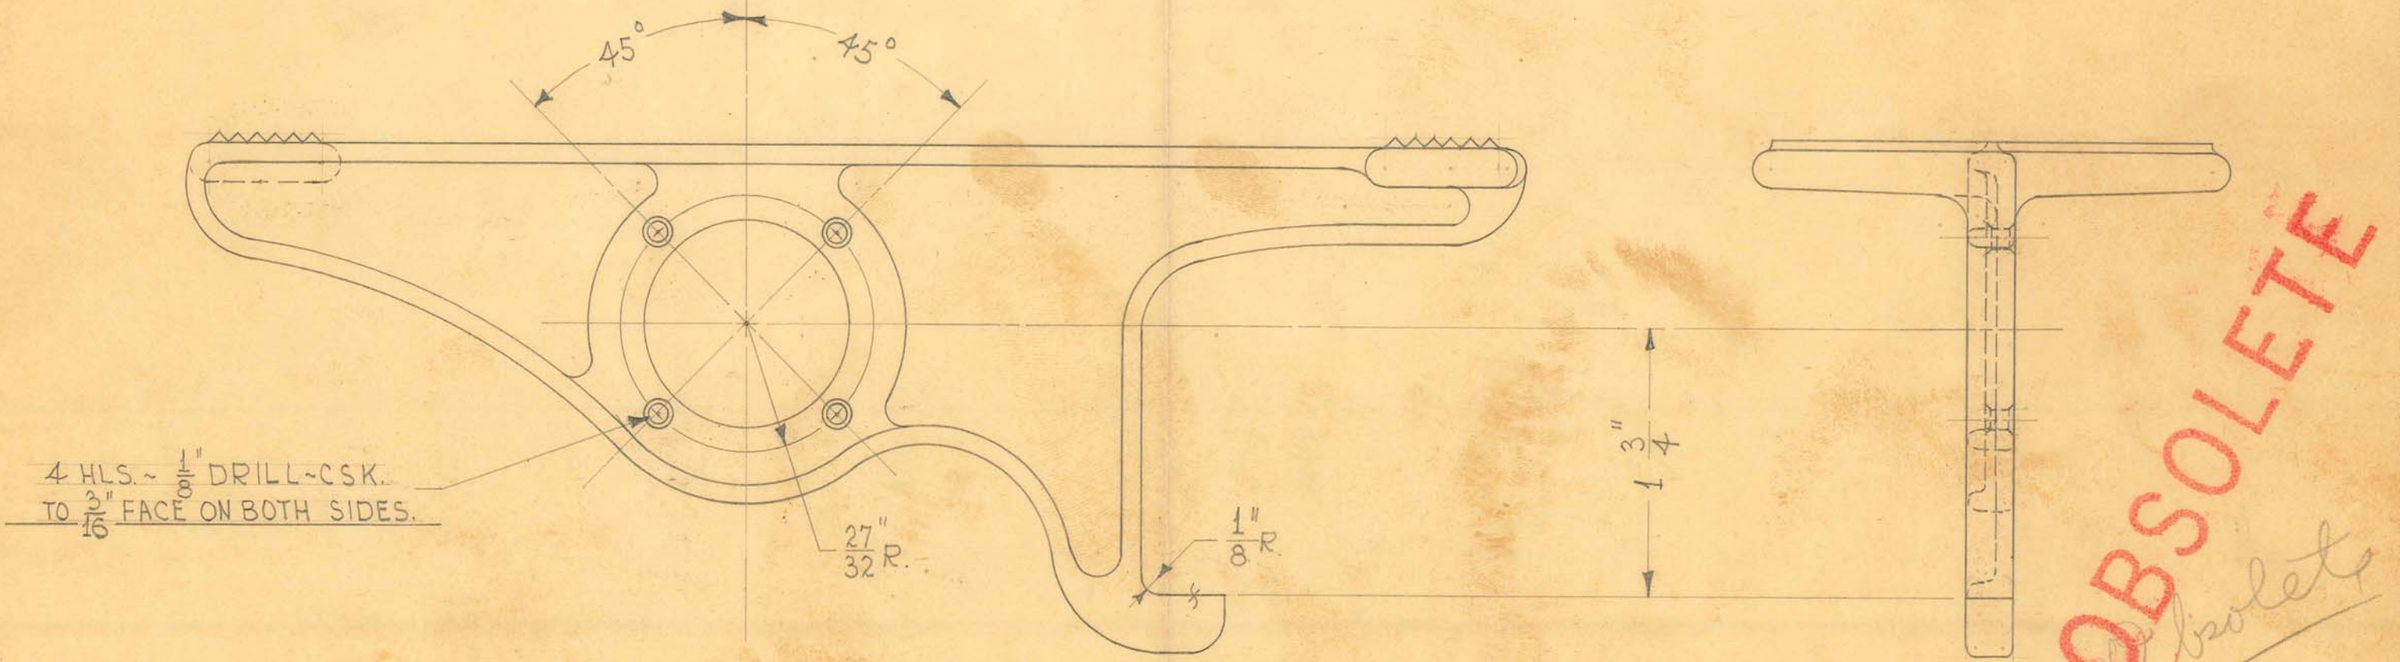

OBSOLETE
Obsolete

RIGHT LEVER SHOWN

RIGHT ~ PATT. # 1783
LEFT ~ PATT. # 1784

SIZE	#80-10-10	ISSUE 6-27-41	HE.
KIND	BRONZE CASTING	CHANGED	
SHAPE		"	
FINISH		"	
TEMP.		"	
DATE		"	

TITLE: ARMY SHOCKPROOF DENTAL X-RAY UNIT- WHEEL LOCK LEVER - RIGHT & LEFT

H. G. FISCHER & CO.
2335 WABANSIA AVE.
CHICAGO, ILL.

CAT. NO.

PART NO. 13751 ~ LEFT
13752 ~ RIGHT

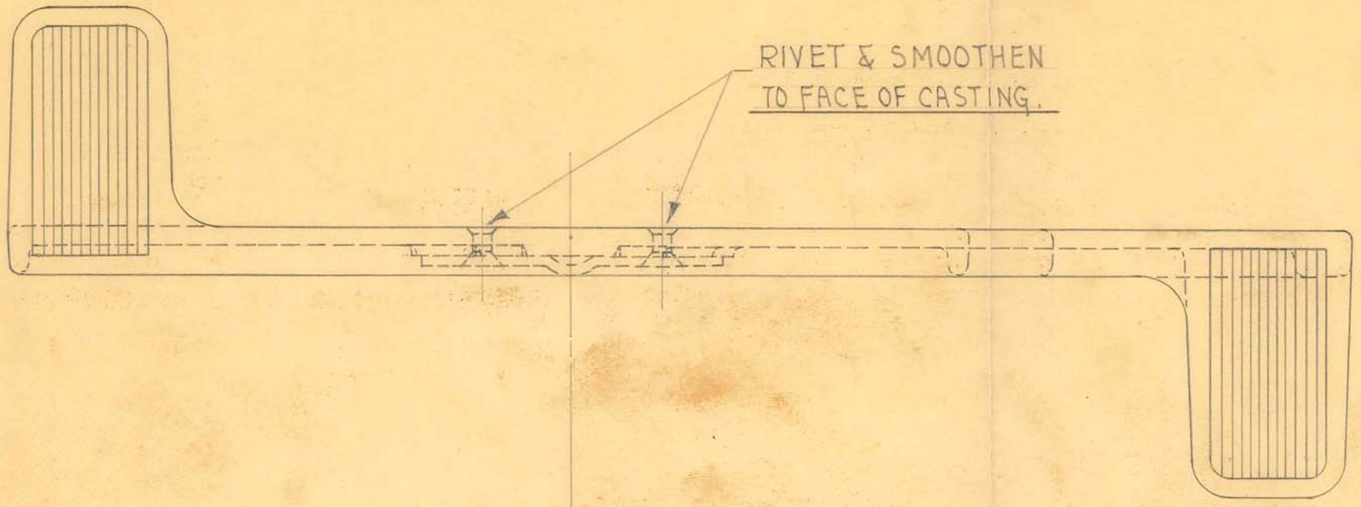

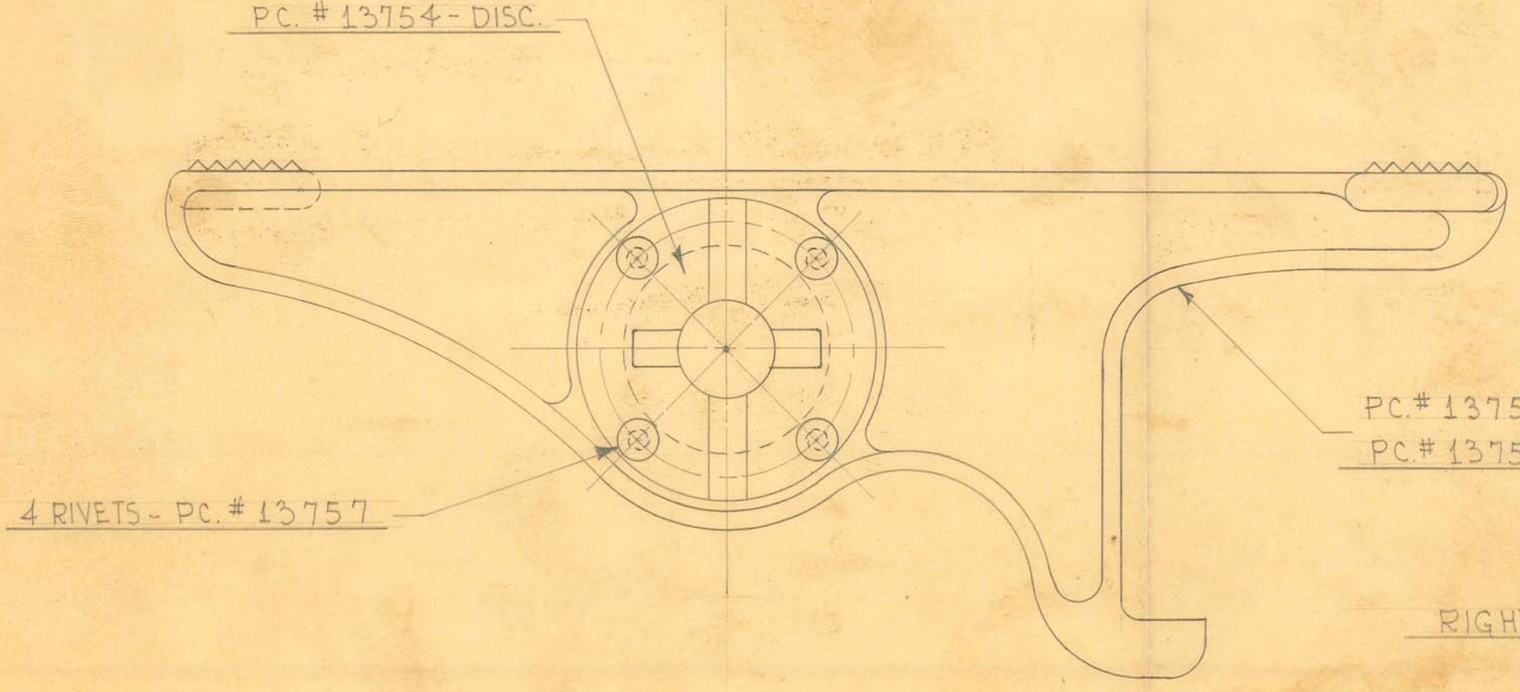

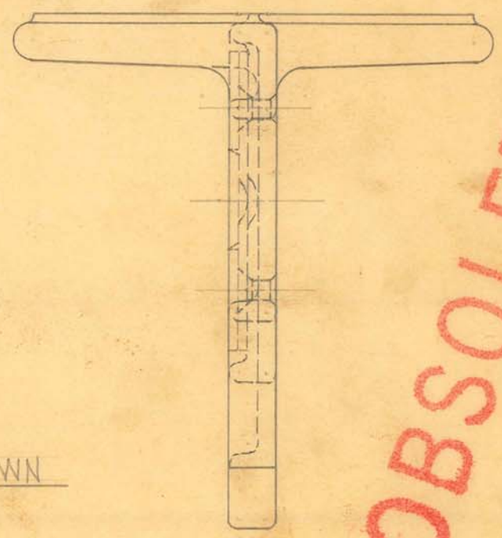

OBSOLETE

1 OF EACH REQUIRED

RIGHT LEVER SHOWN

SIZE		ISSUE 7-1-41	HE
KIND		CHANGED	
SHAPE		"	
FINISH	CAD # 23	"	
TEMP.		"	
PATT.		"	

TITLE: ARMY SHOCKPROOF DENTAL X-RAY UNIT - WHEEL LOCK LEVER - RIGHT & LEFT

H. G. FISCHER & CO.
2338 WABANSIA AVE.
CHICAGO, ILL.

CAT. NO.

PART NO. 13755G - RIGHT
13756G - LEFT

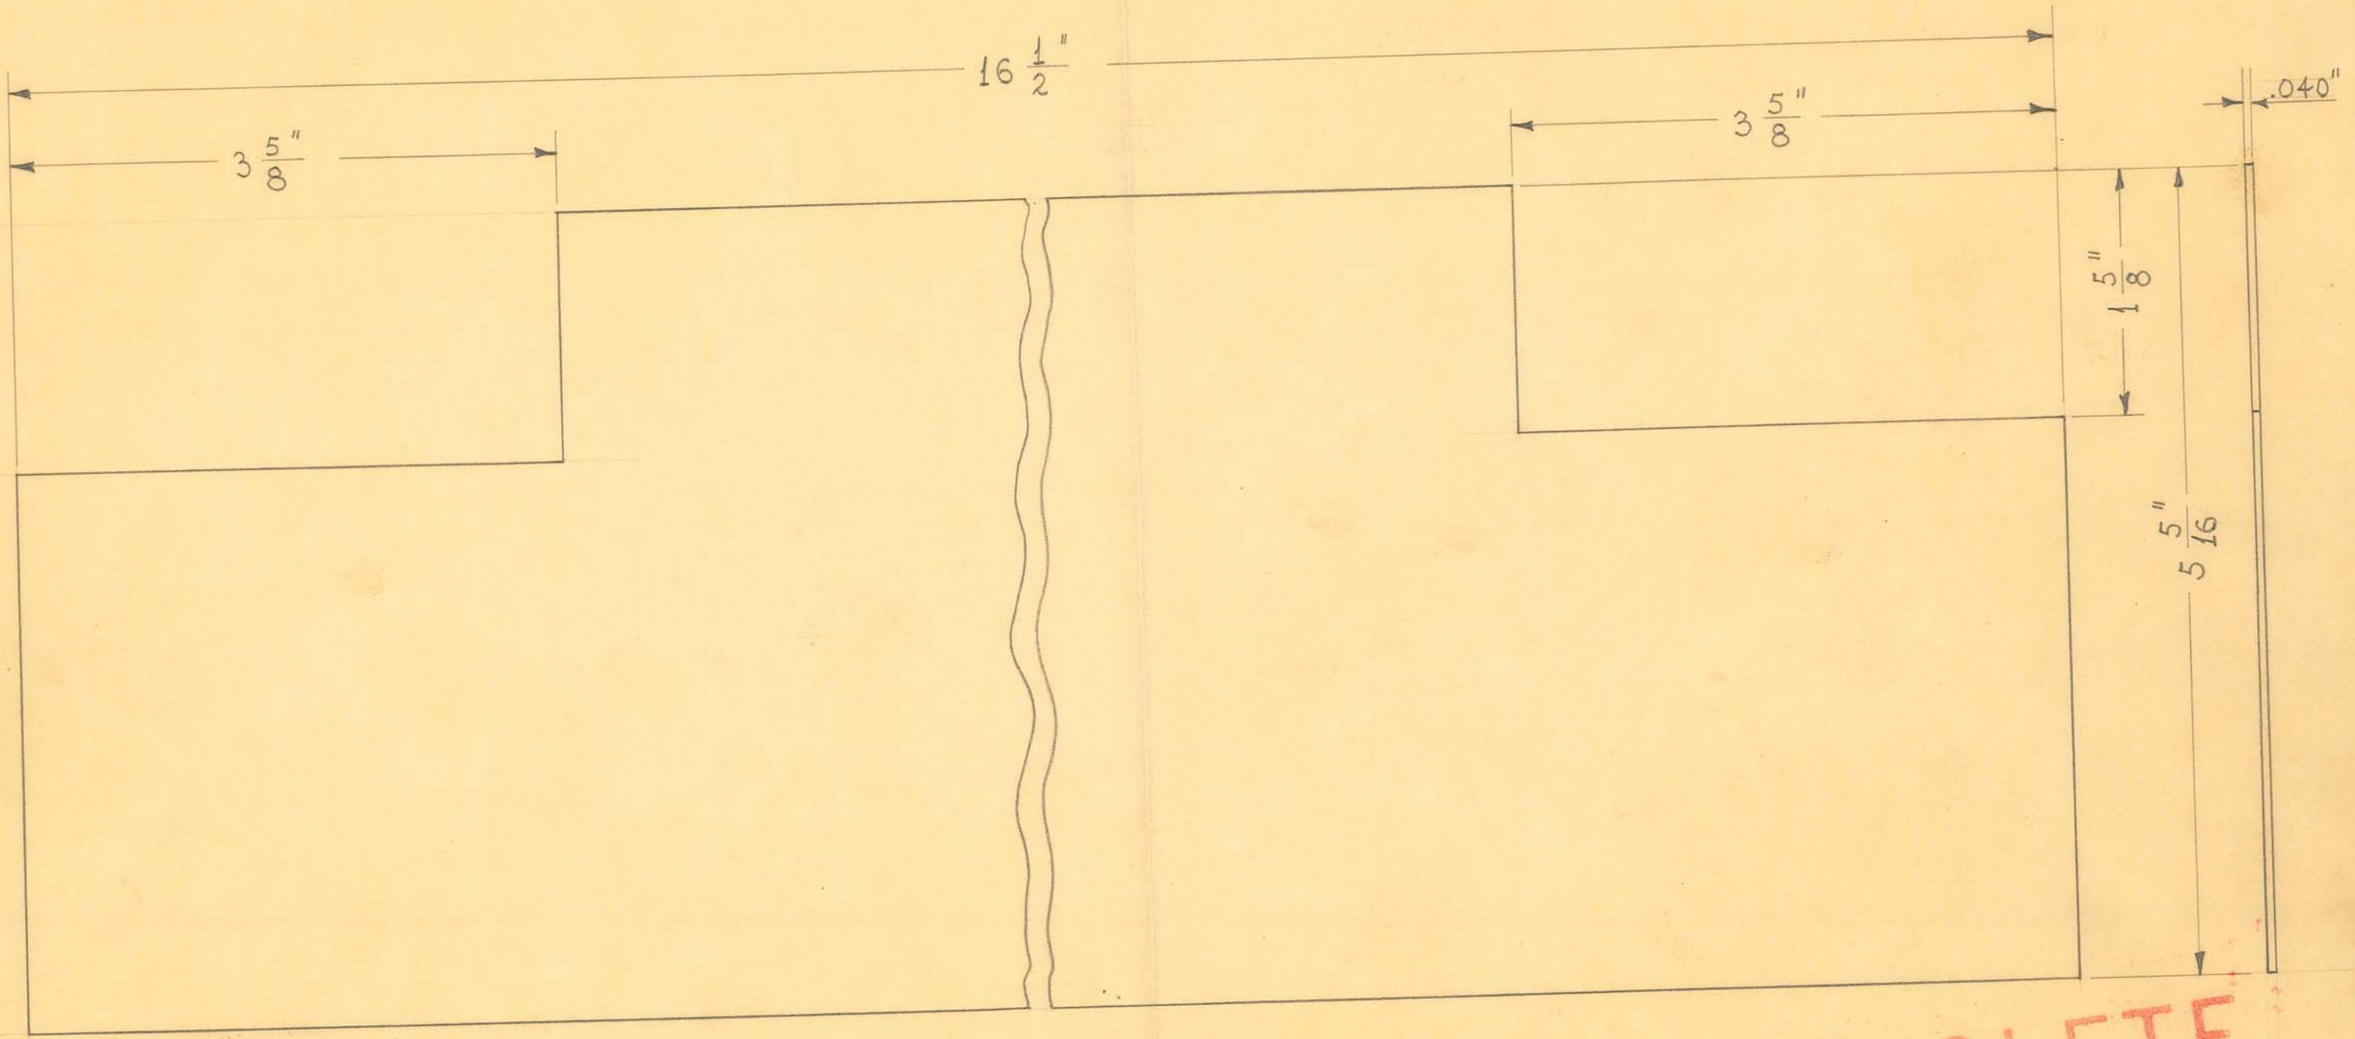

OBSOLETE

1 REQUIRED

SIZE	.040"	ISSUE 11-27-42	HE.	TITLE: ARMY SHOCKPROOF DENTAL X-RAY UNIT- TRANSFORMER SHIELD
KIND	SHEET LEAD	CHANGED		
SHAPE		"		
FINISH		"		
TEMP.		"		
PATT.		"		

H. G. FISCHER & CO.
2335 WABANSIA AVE.
CHICAGO. ILL.

CAT. NO.

PART NO. 13779

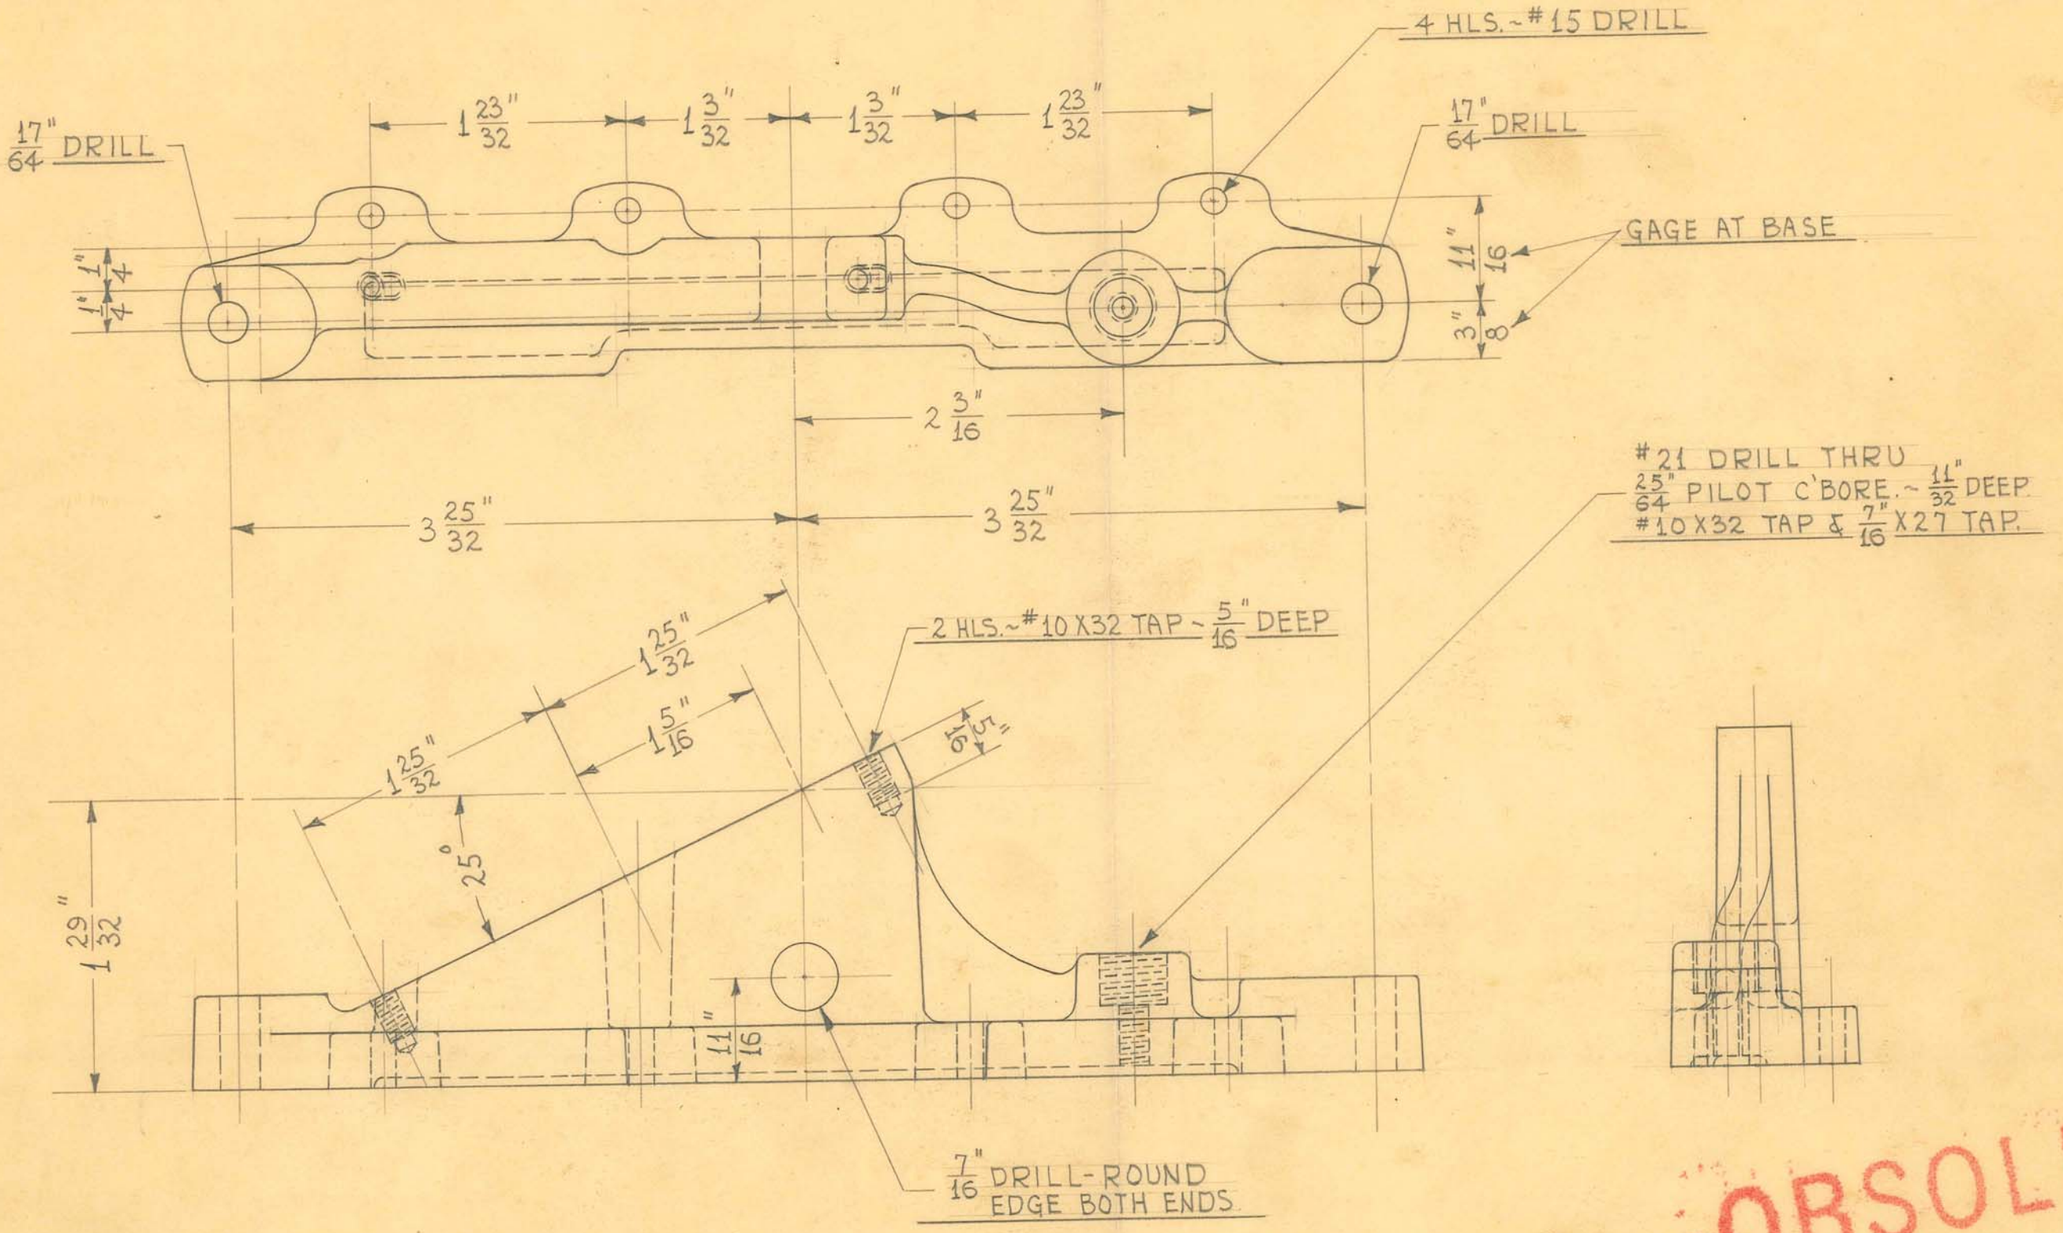

1 REQUIRED

OBSOLETE

SIZE		ISSUE 9-25-42	HE.
KIND	IRON CASTING	CHANGED	
SHAPE		"	
FINISH		"	
TEMP.		"	
PATT.	1953	"	

TITLE: FISCHER "AGA" S.P. DENTAL X-RAY UNIT~ TRANSF. CLAMP & FIL. TRANSF. SUPP. ~RIGHT

H. G. FISCHER & CO.
2338 WABANSIA AVE.
CHICAGO, ILL.

CAT. NO.

PART NO. 13782F

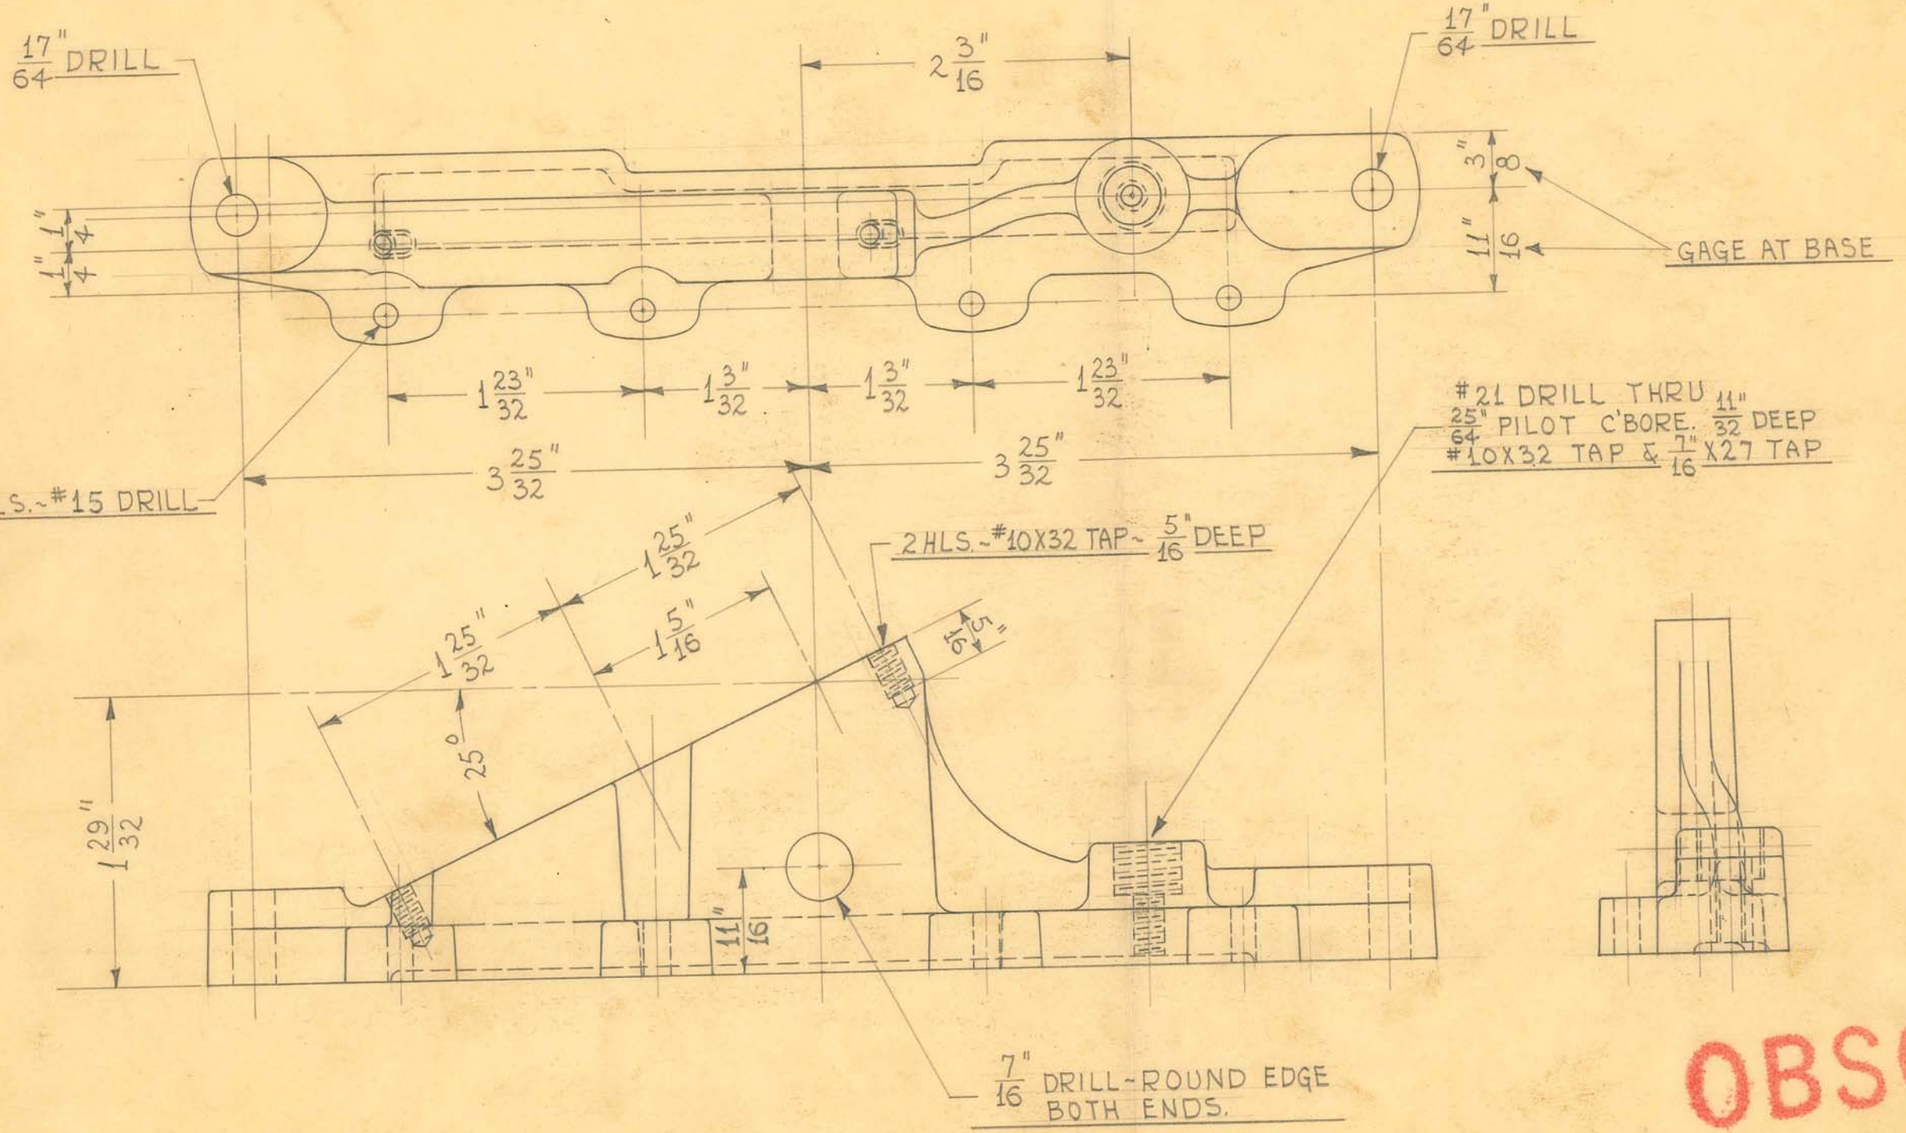

1 REQUIRED

OBSOLETE

SIZE		ISSUE 9-25-42	HE.
KIND	IRON CASTING	CHANGED	
SHAPE		"	
FINISH		"	
TEMP.		"	
PATT.	1952	"	

TITLE: FISCHER "AGA" S.P. DENTAL X-RAY UNIT~ TRANSF. CLAMP & FIL. TRANSF. SUPP. ~ LEFT

H. G. FISCHER & CO.
2335 WABANSIA AVE.
CHICAGO, ILL.

CAT. NO.

PART NO. 13783F

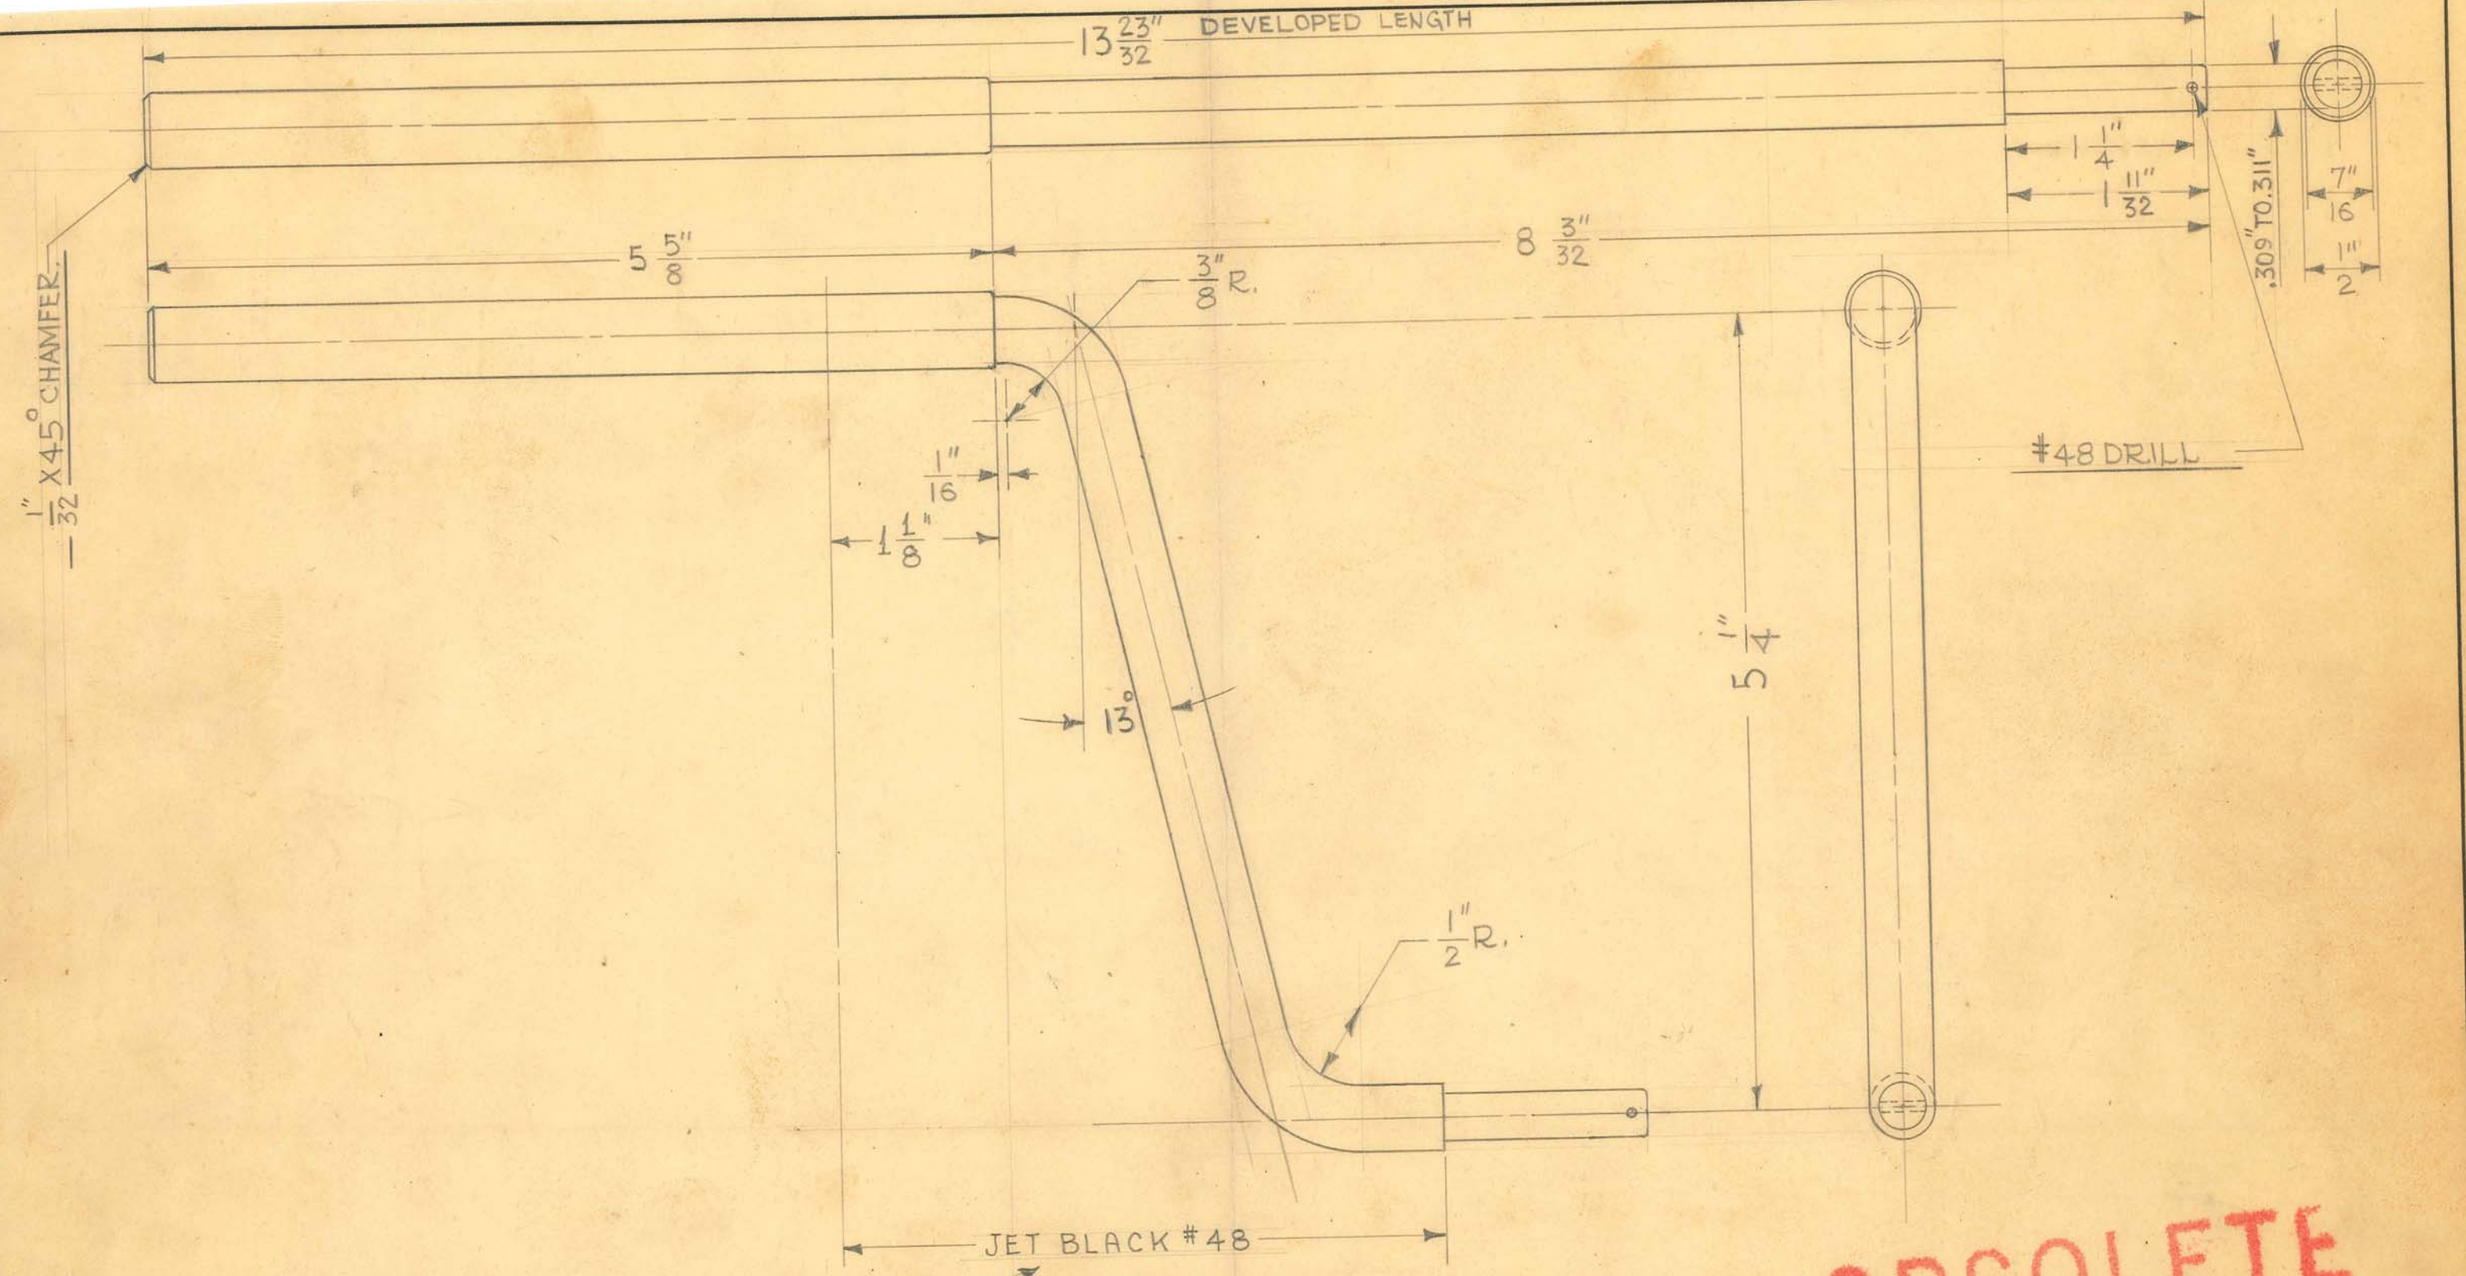

FINISH NOTE:-
CHROME WHITE #3
JET BLACK #48 PER MARKING

1 REQUIRED

OBSOLETE

SIZE	1/2" DIA.	ISSUE 6-12-42	J.V.W.
KIND	C.R. STEEL	CHANGED	
SHAPE		"	
FINISH	SEE NOTE	"	
TEMP.		"	
PATT.		"	

TITLE: FISCHER MOD. "AGA" S.P. DENTAL X-RAY VERTICAL CRANK HANDLE

H. G. FISCHER & CO.
2335 WABANSIA AVE.
CHICAGO, ILL.

CAT. NO.

PART NO. 13788

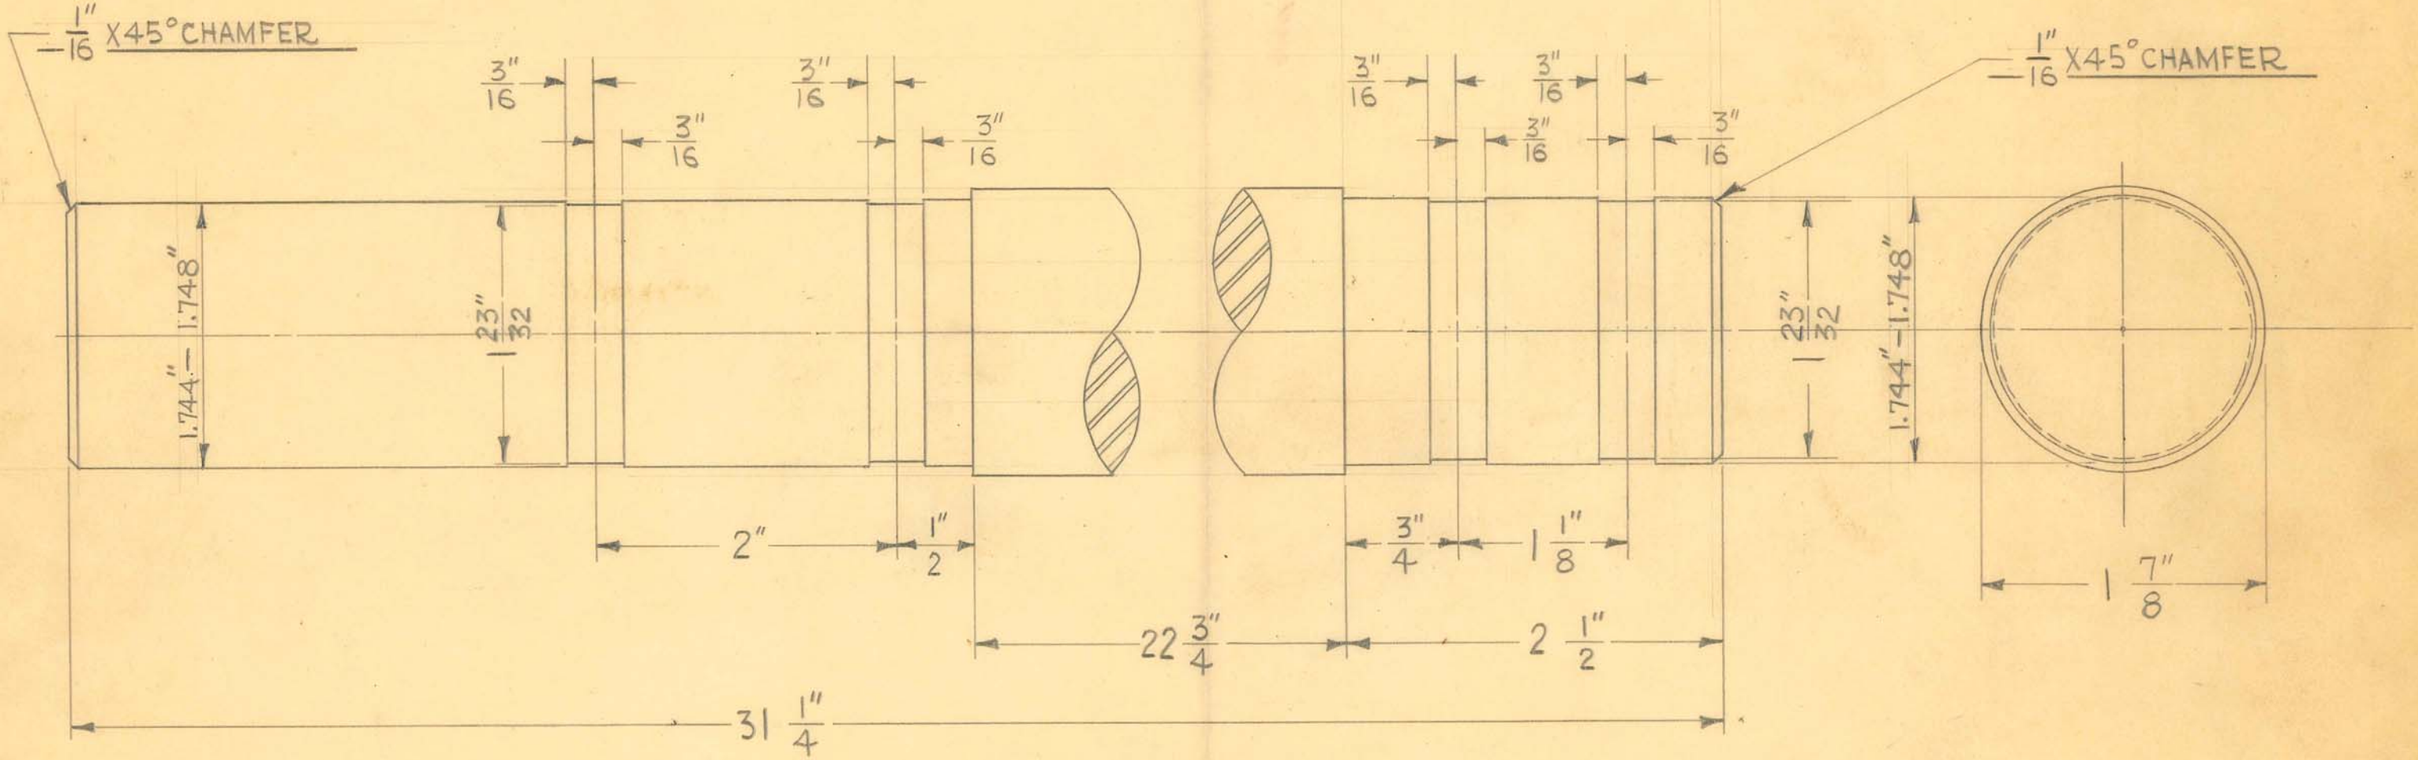

2 REQUIRED

OBSOLETE

SIZE	1⅞" DIA.	ISSUE 6-15-42	J.V.W.
KIND	C.R. STEEL	CHANGED	
SHAPE		"	
FINISH	CHR. W. #3	"	
TEMP.		"	
PATT.		"	

TITLE: FISCHER MOD. "AGA" S.P. DENTAL X-RAY UPRIGHT GUIDE ROD

H. G. FISCHER & CO.
2338 WABANSIA AVE.
CHICAGO, ILL.

CAT. NO.

PART NO. 13789

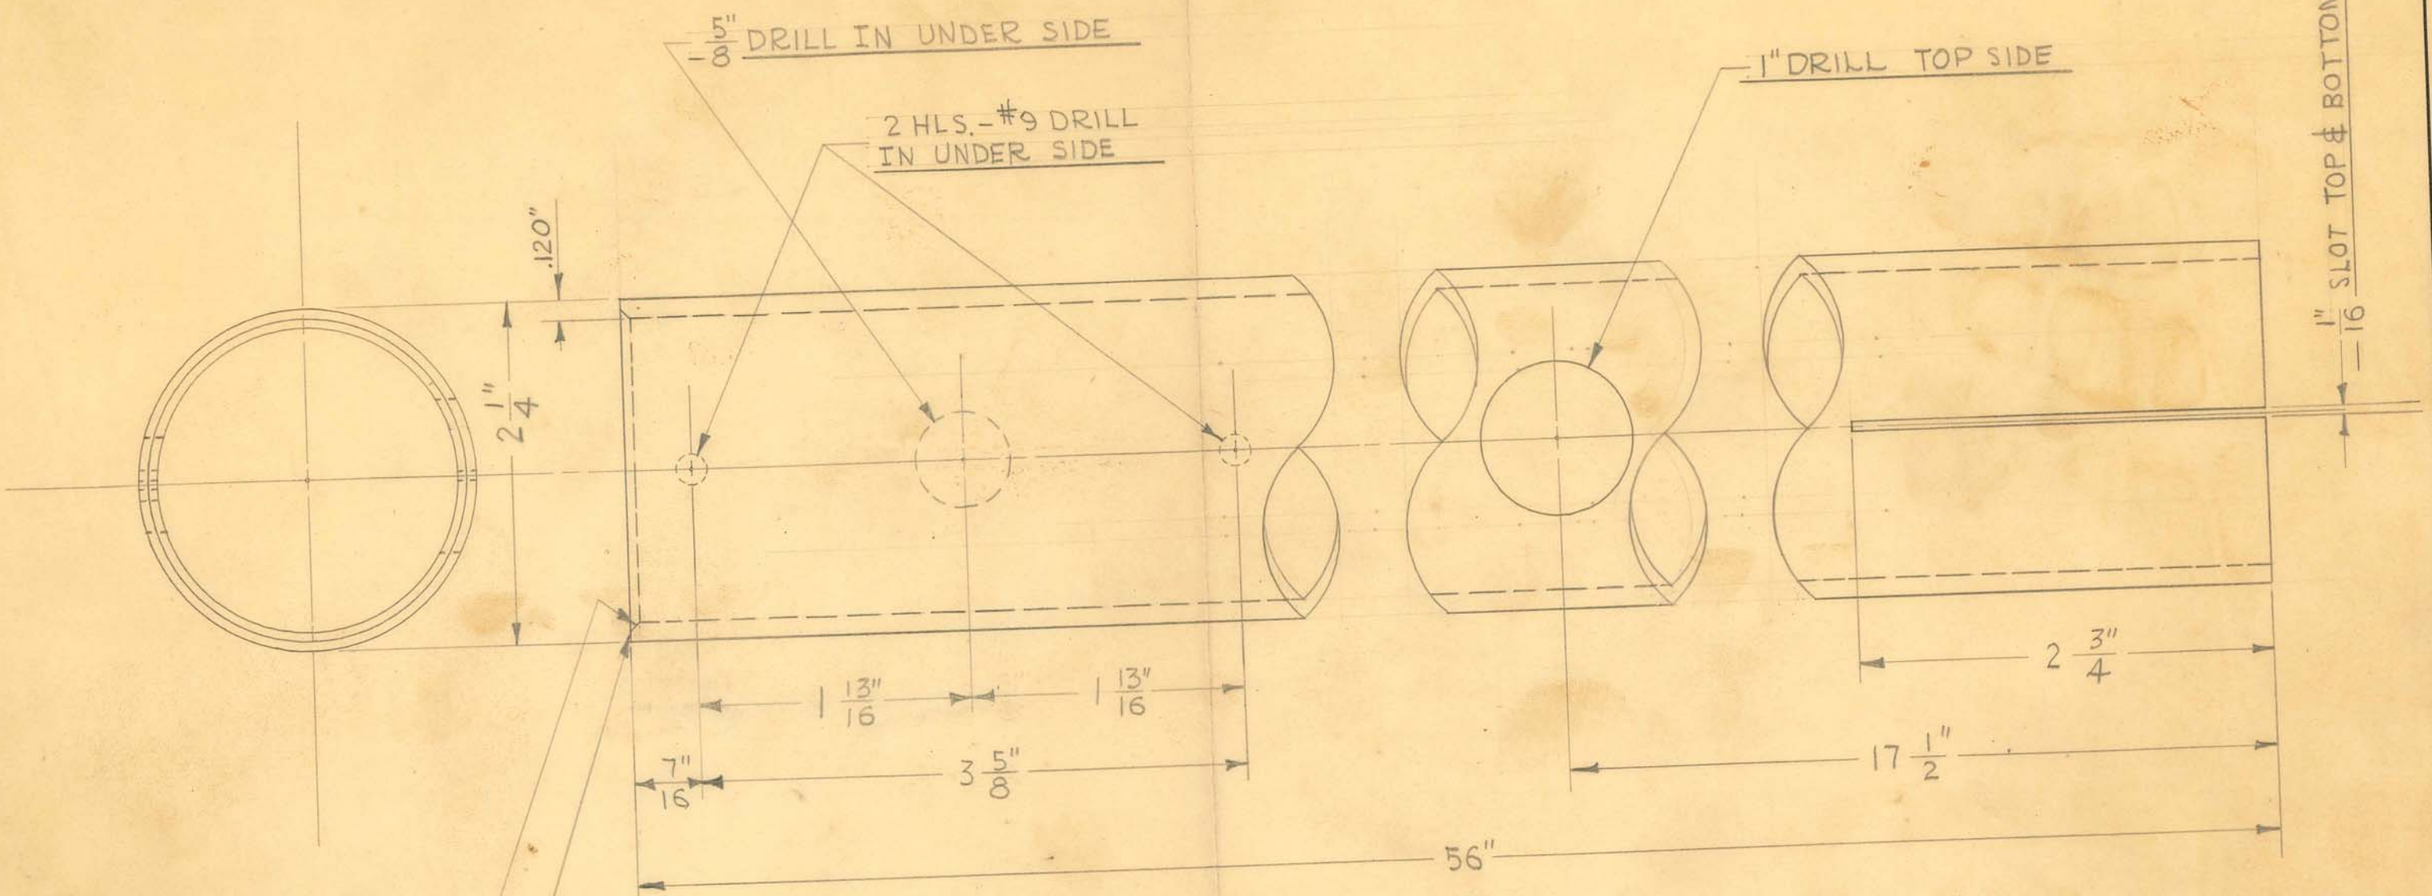

1 REQUIRED

2 1/4" O.D. X #11GA. (.120") WALL SHELBY SEAMLESS STEEL TUBING

OBSOLETE

Obsolete

SIZE		ISSUE 4-10-41	J.V.W.
KIND		CHANGED	
SHAPE		"	
FINISH	SEE NOTE	"	
TEMP.		"	
PATT.		"	

TITLE: FISCHER MOBILE DENTAL X-RAY UNIT
INNER UPRIGHT TUBE

H. G. FISCHER & CO.
2335 WABANSIA AVE.
CHICAGO, ILL.

CAT. NO.

PART NO. 13801

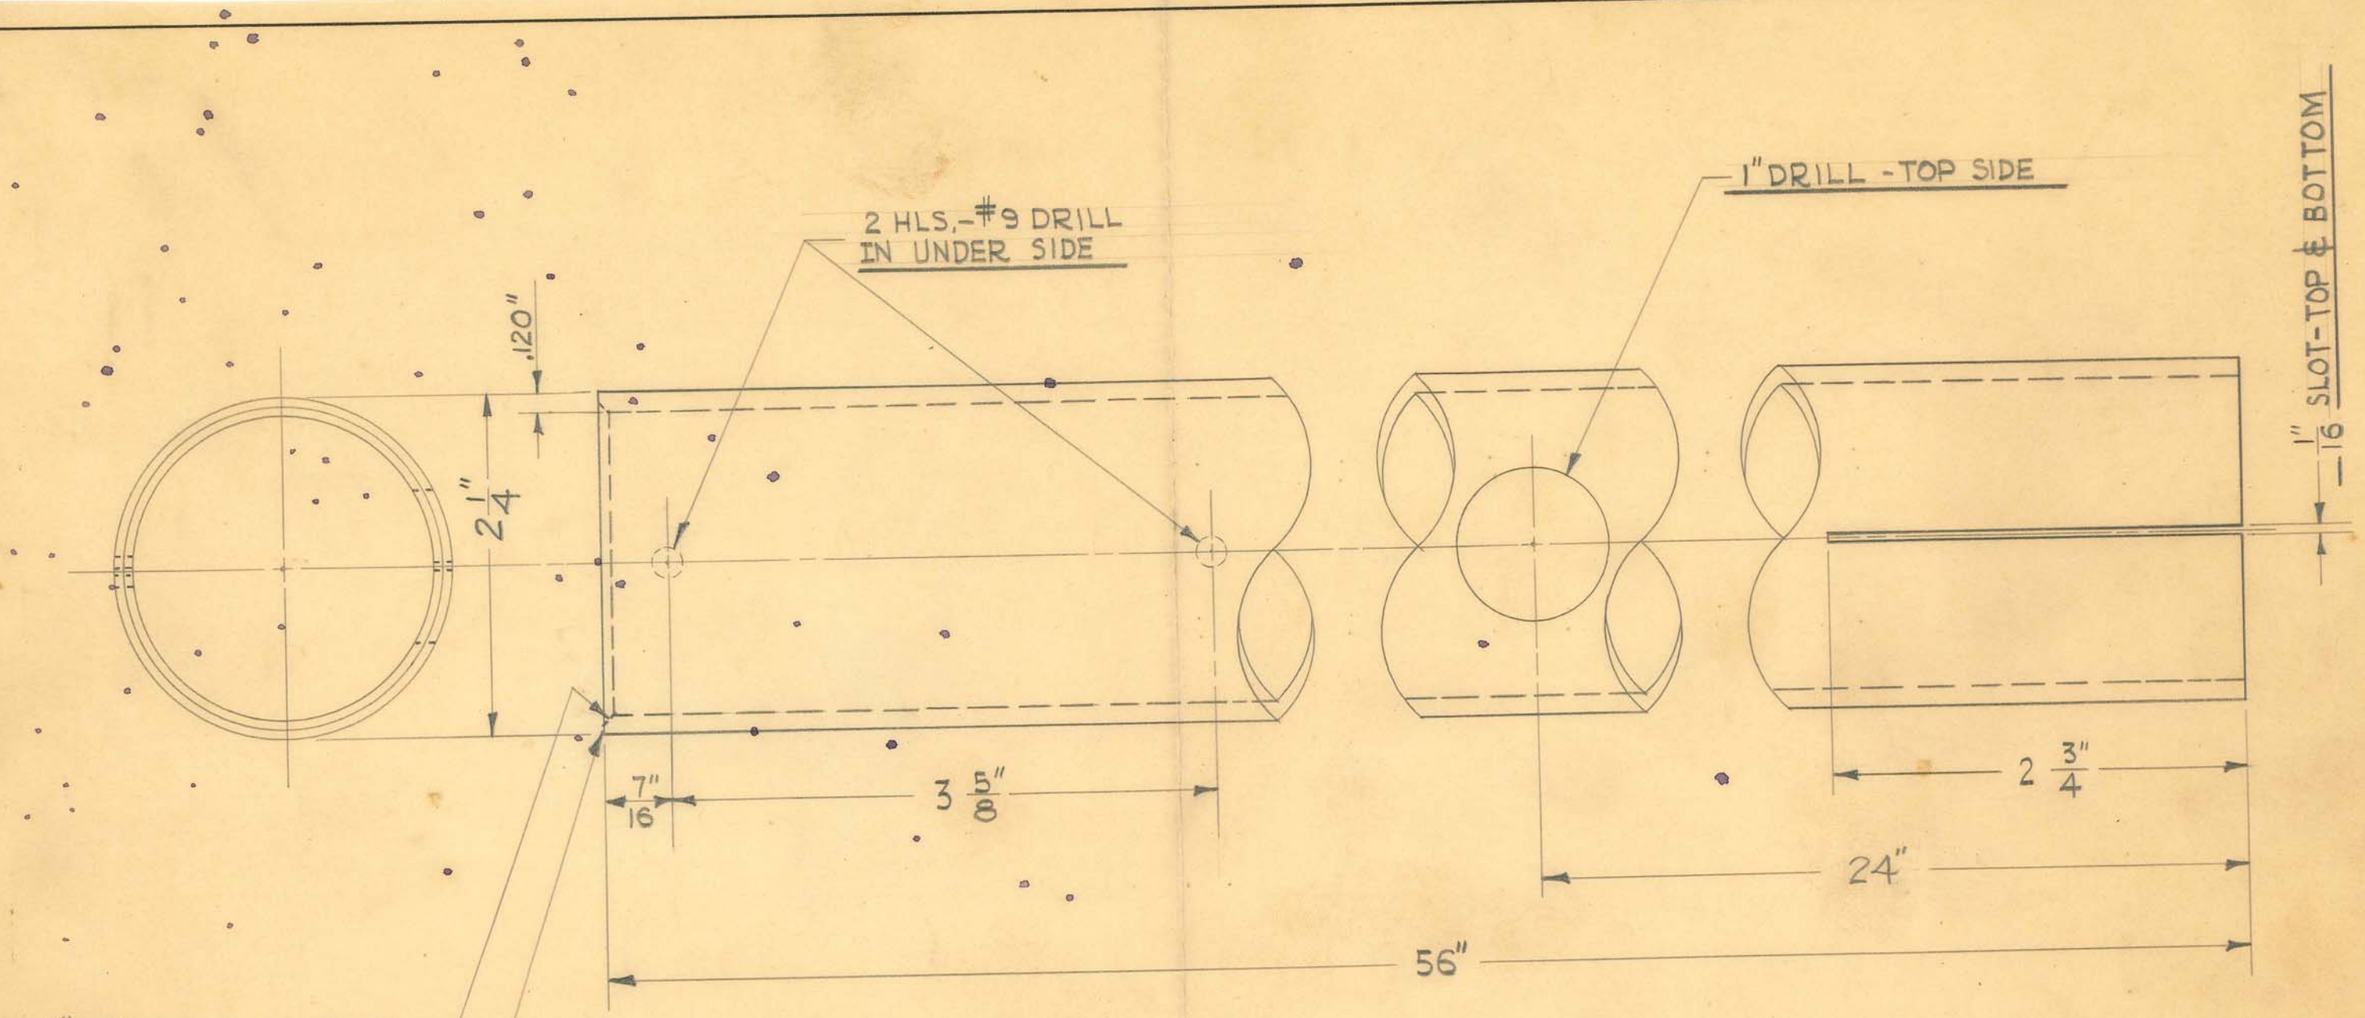

1 REQUIRED

2 1/4" O.D. X #11 GA. (.120) WALL SHELBY SEAMLESS STEEL TUBING

OBSOLETE

Obsolete

SIZE		ISSUE 12-8-41	J.V.W.
KIND		CHANGED	
SHAPE		"	
FINISH	SEE NOTE	"	
TEMP.		"	
PATT.		"	

TITLE: FISCHER MOBILE DENTAL X-RAY UNIT
INNER UPRIGHT TUBE

H. G. FISCHER & CO.
2338 WABANSIA AVE.
CHICAGO, ILL.

CAT. NO.

PART NO. 13801A

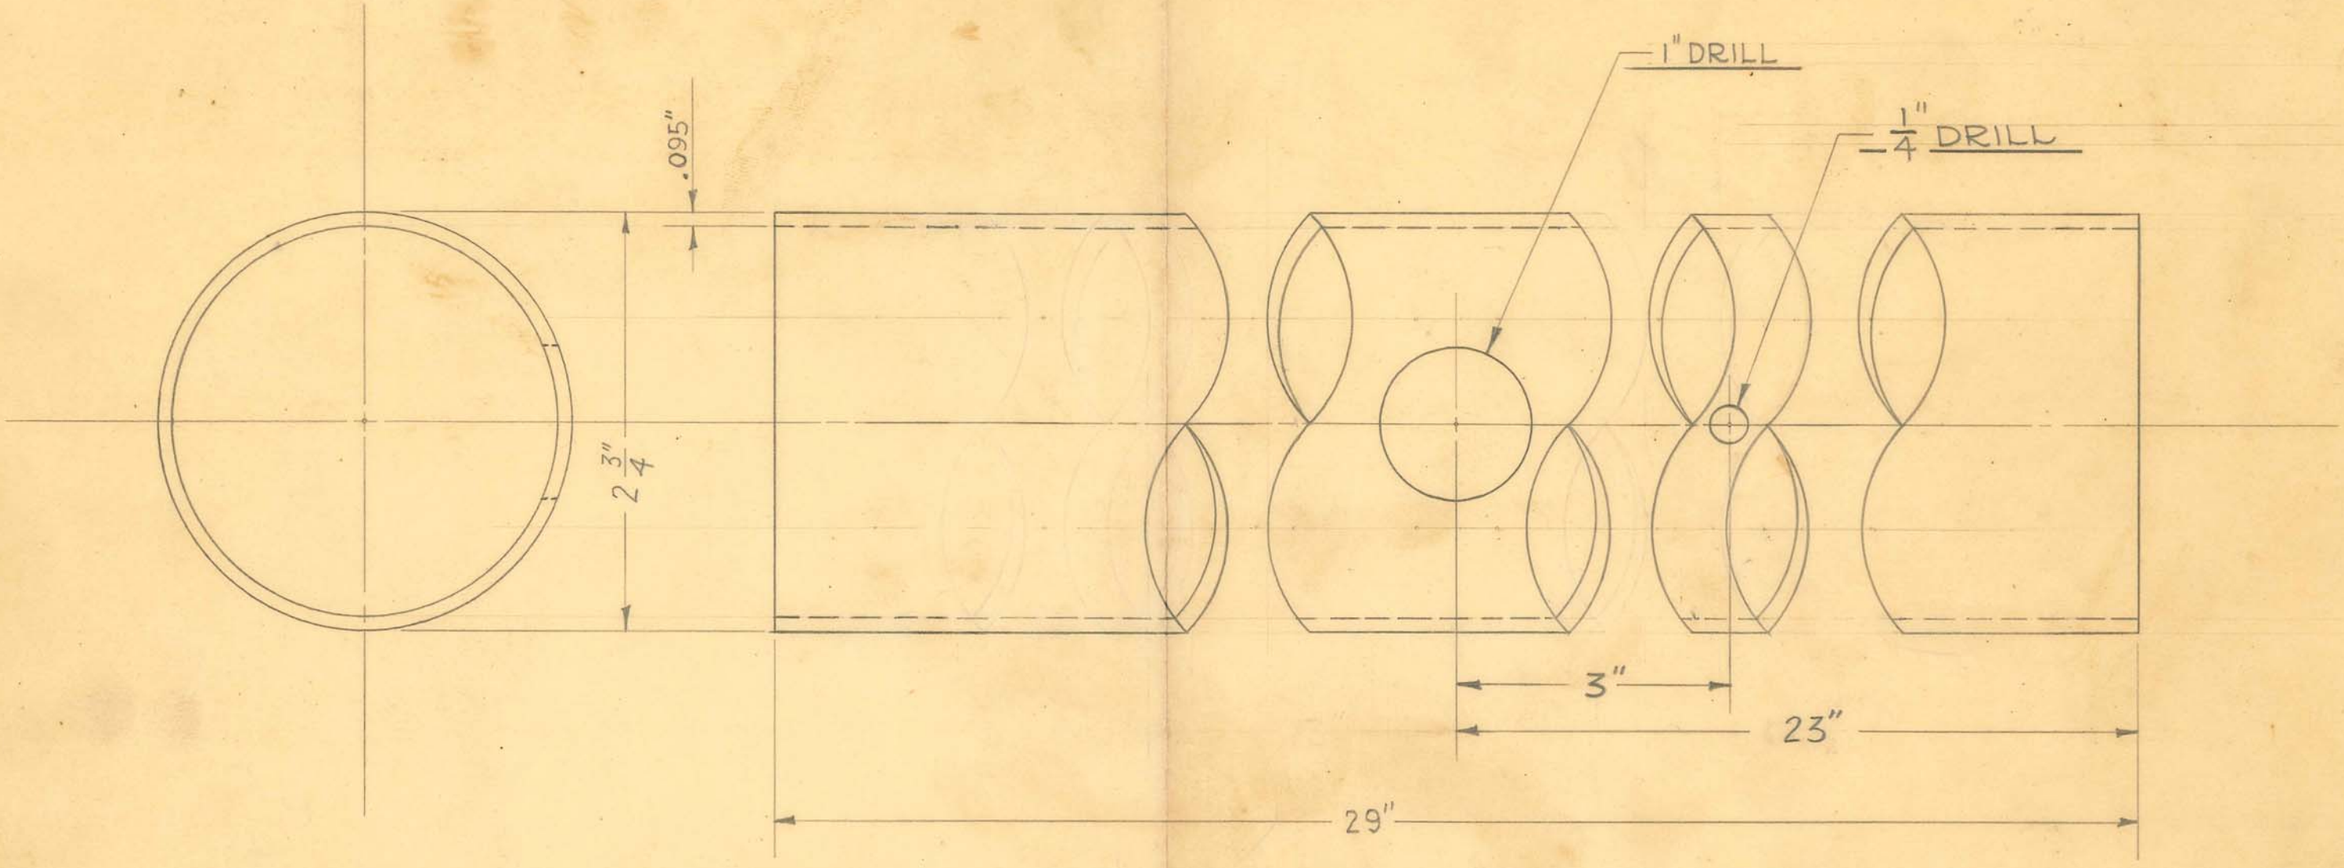

1 REQUIRED

2 3/4" O.D. X #13 GA. (.095") WALL SHELBY SEAMLESS STEEL TUBING

OBSOLETE

Obsolete

SIZE		ISSUE 4-10-41	J.V.W.
KIND		CHANGED	
SHAPE		"	
FINISH	DU-LITE #8	"	
TEMP.		"	
PATT.		"	

TITLE: FISCHER MOBILE DENTAL X-RAY UNIT
OUTER UPRIGHT TUBE - DRILLED

H. G. FISCHER & CO.
2335 WABANSIA AVE.
CHICAGO, ILL.

CAT. NO.

PART NO. 13802F

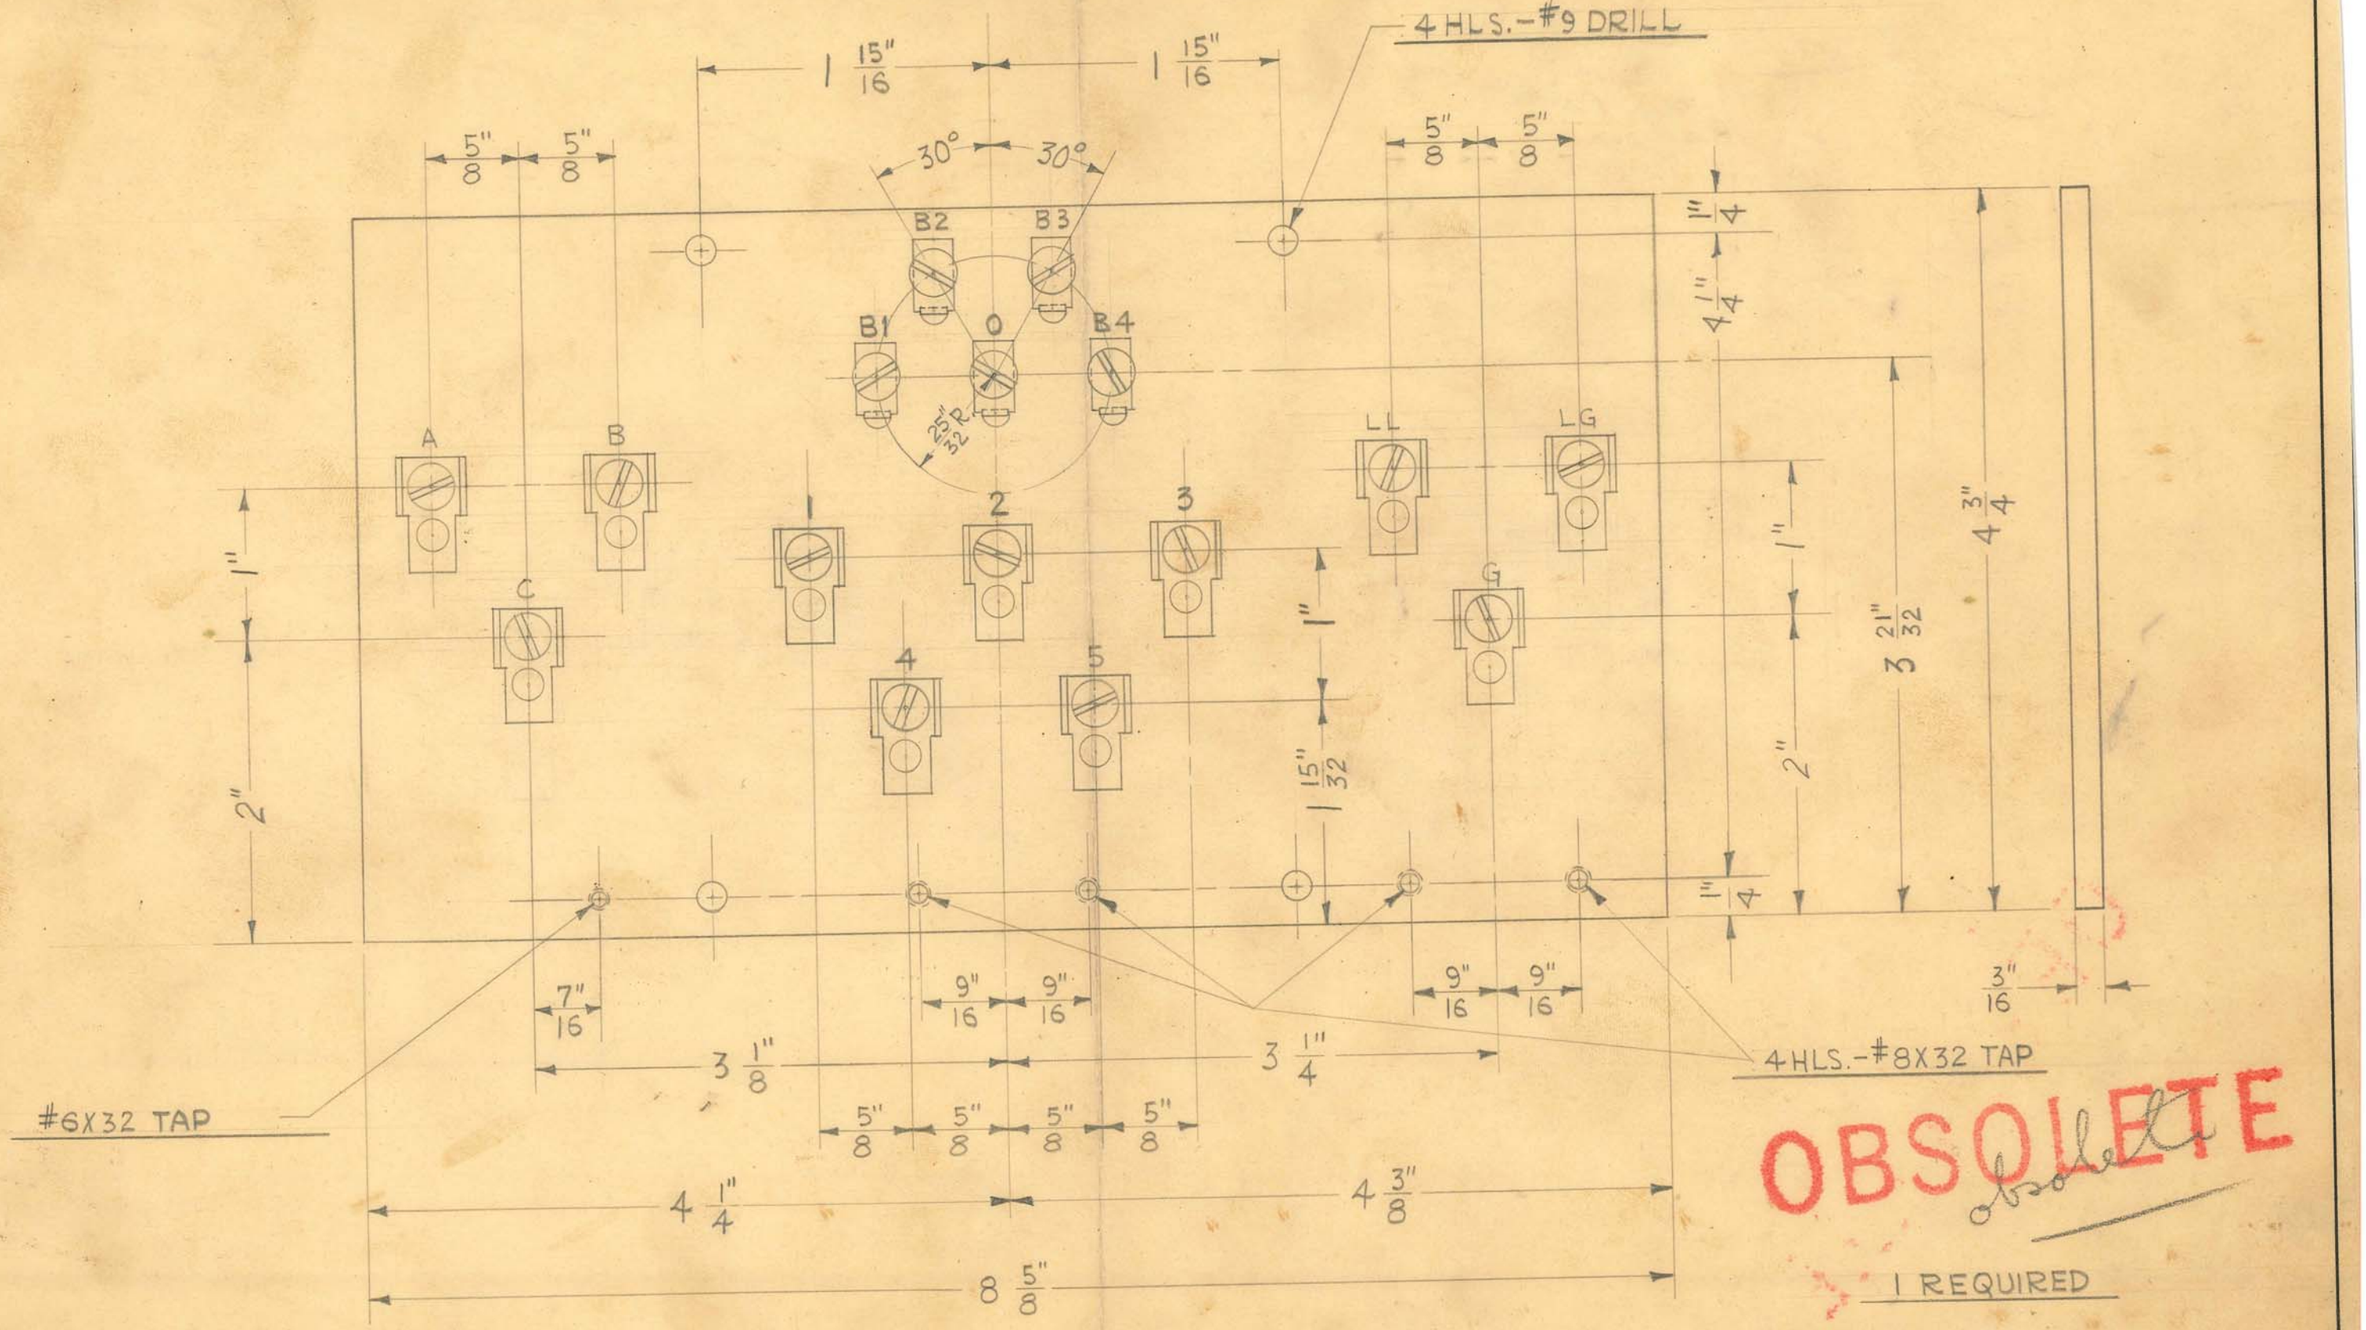

OBSOLETE

Obsolete

1 REQUIRED

SIZE		ISSUE 4-2-41	J.V.W.
KIND		CHANGED	
SHAPE		"	
FINISH		"	
TEMP.		"	
DATE		"	

TITLE: FISCHER MOBILE DENTAL X-RAY UNIT CONTROL BOX TERMINAL BOARD

H. G. FISCHER & CO.
2335 WABANSIA AVE.
CHICAGO, ILL.

CAT. NO.

PART NO. 13824G

TITLE: DENTAL FILTER-DIAPHRAGM

H. G. FISCHER & CO.
FRANKLIN PARK, ILLINOIS

DATE 10-14-57 | DR. BY J.V.W. | CH'K'D.

PART NO. 13904

REVISION	DATE	BY

PATTERN | FINISH | SCALE FULL

TOOLS | MATERIAL

DIMENSIONS UNLESS OTHERWISE SPECIFIED
FRACTIONAL ± .015
DECIMAL ± .005
ANGULAR ± ½°

CATALOG #3568

OBSOLETE

OBSOLETE

1

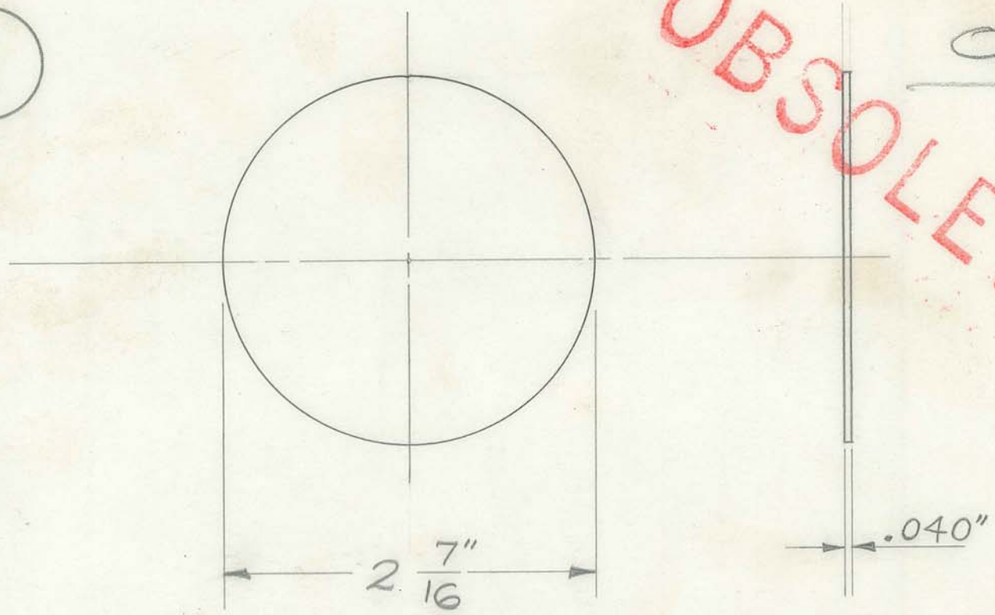

2

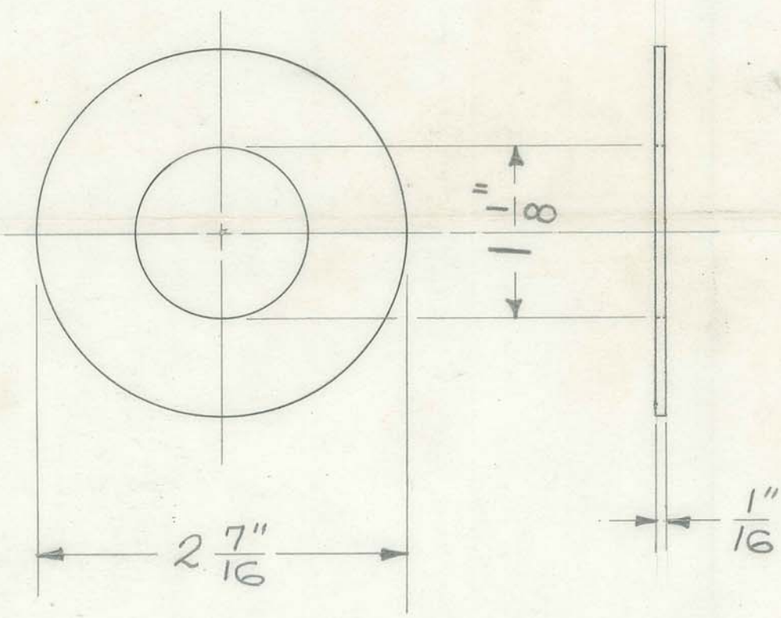

DEPT.	AMT.	ITEM NO.	NAME	PART NO. OR MATERIAL
S	2	1	ALUM. DISC	.040" SHEET #1100-H14 ALUMINUM
S	1	2	LEAD DISC	1/16" SHEET LEAD
B.O. M		3	ADHESIVE ASSEMBLE	#18933

3 COAT WITH ADHESIVE — WHEN TACKY PRESS TOGETHER

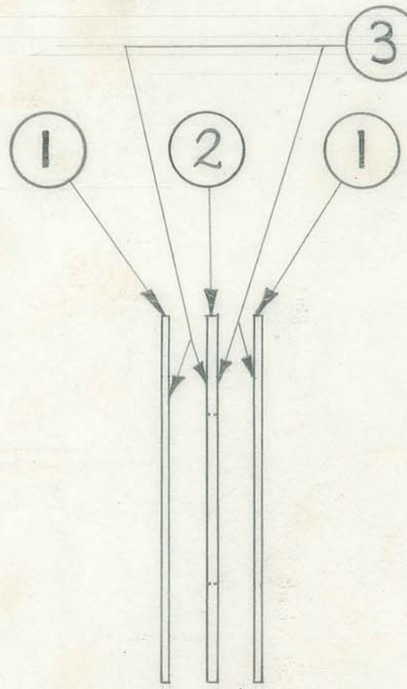

REMOVE ADHESIVE FROM OUTSIDE SURFACES

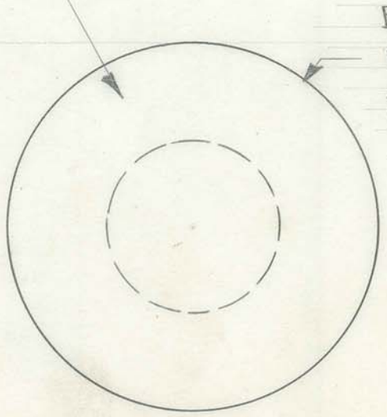

BLEND EDGES WITH FILE. MUST FIT #12370BF CONE HOLDER.

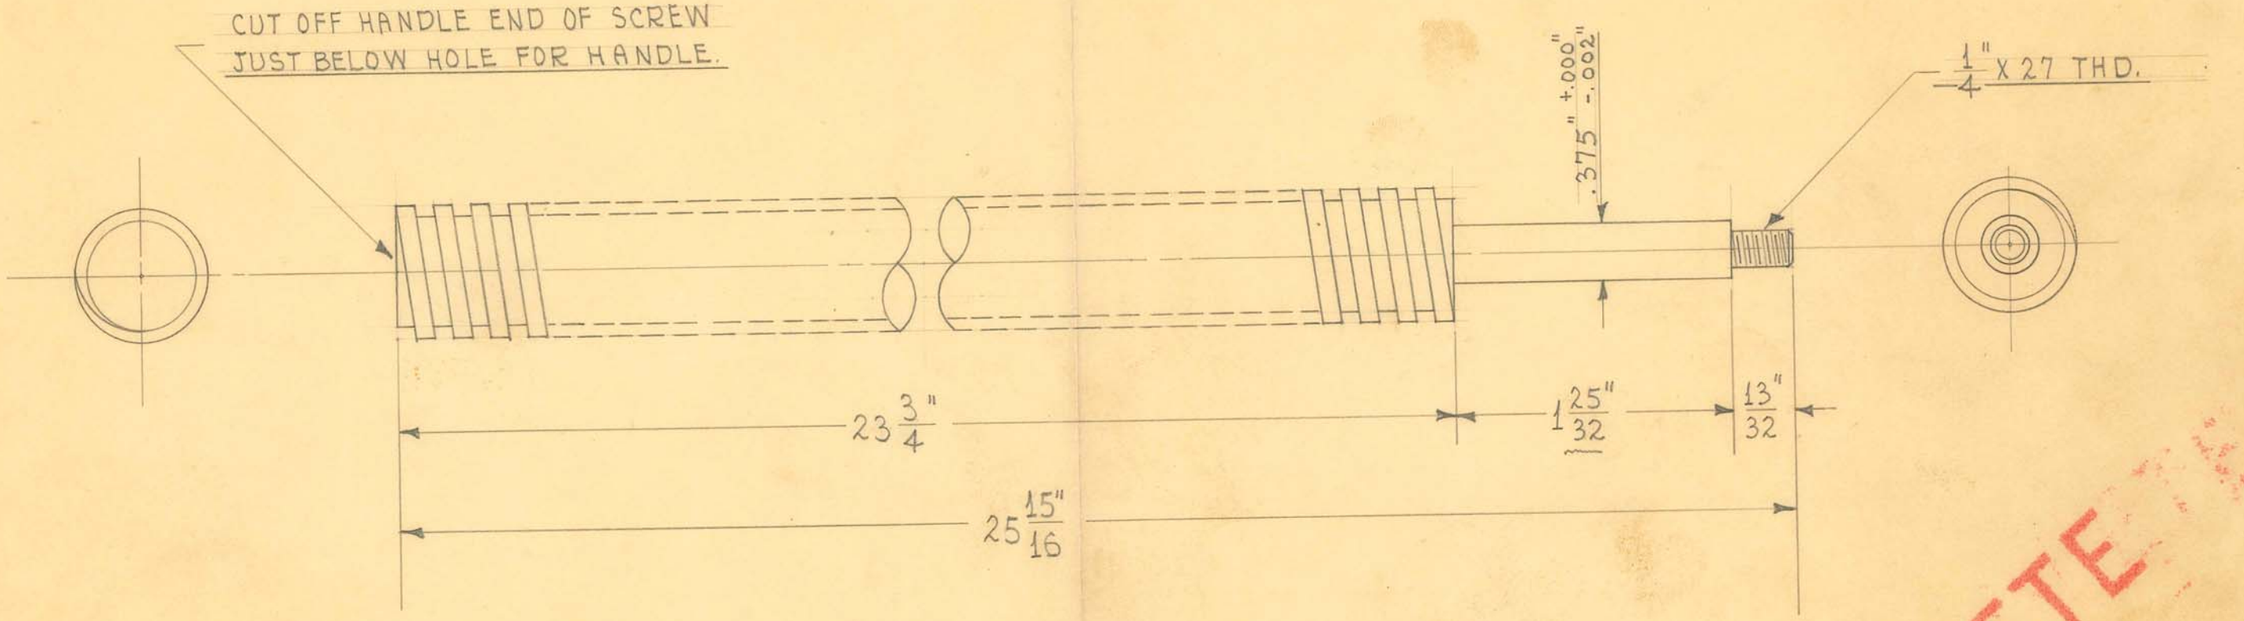

1 REQUIRED

OBSOLETE

SIZE	FROM 14717	ISSUE 11-6-42	HE.
KIND		CHANGED	
SHAPE		"	
FINISH		"	
TEMP.		"	
PATT.		"	

TITLE: ARMY SHOCKPROOF DENTAL X-RAY UNIT-
RAISING SCREW

H. G. FISCHER & CO.
2338 WABANSIA AVE.
CHICAGO. ILL.

CAT. NO.

PART NO. 13934

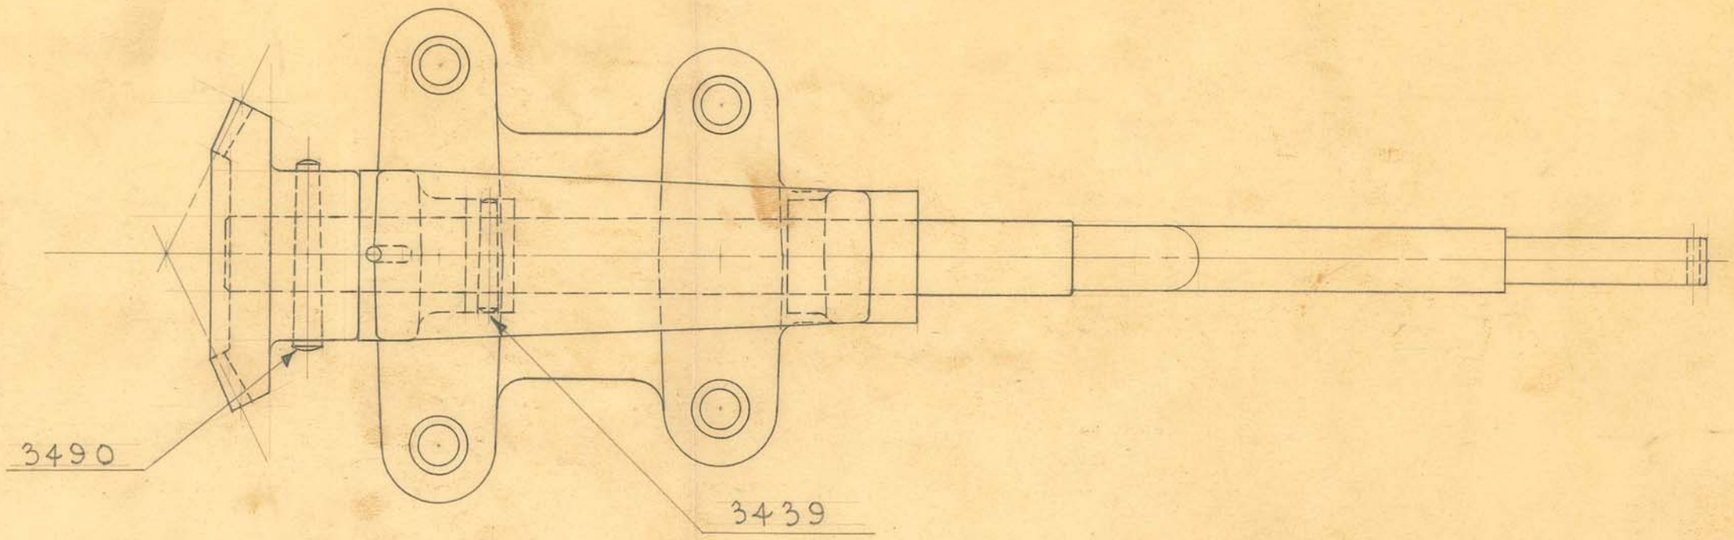

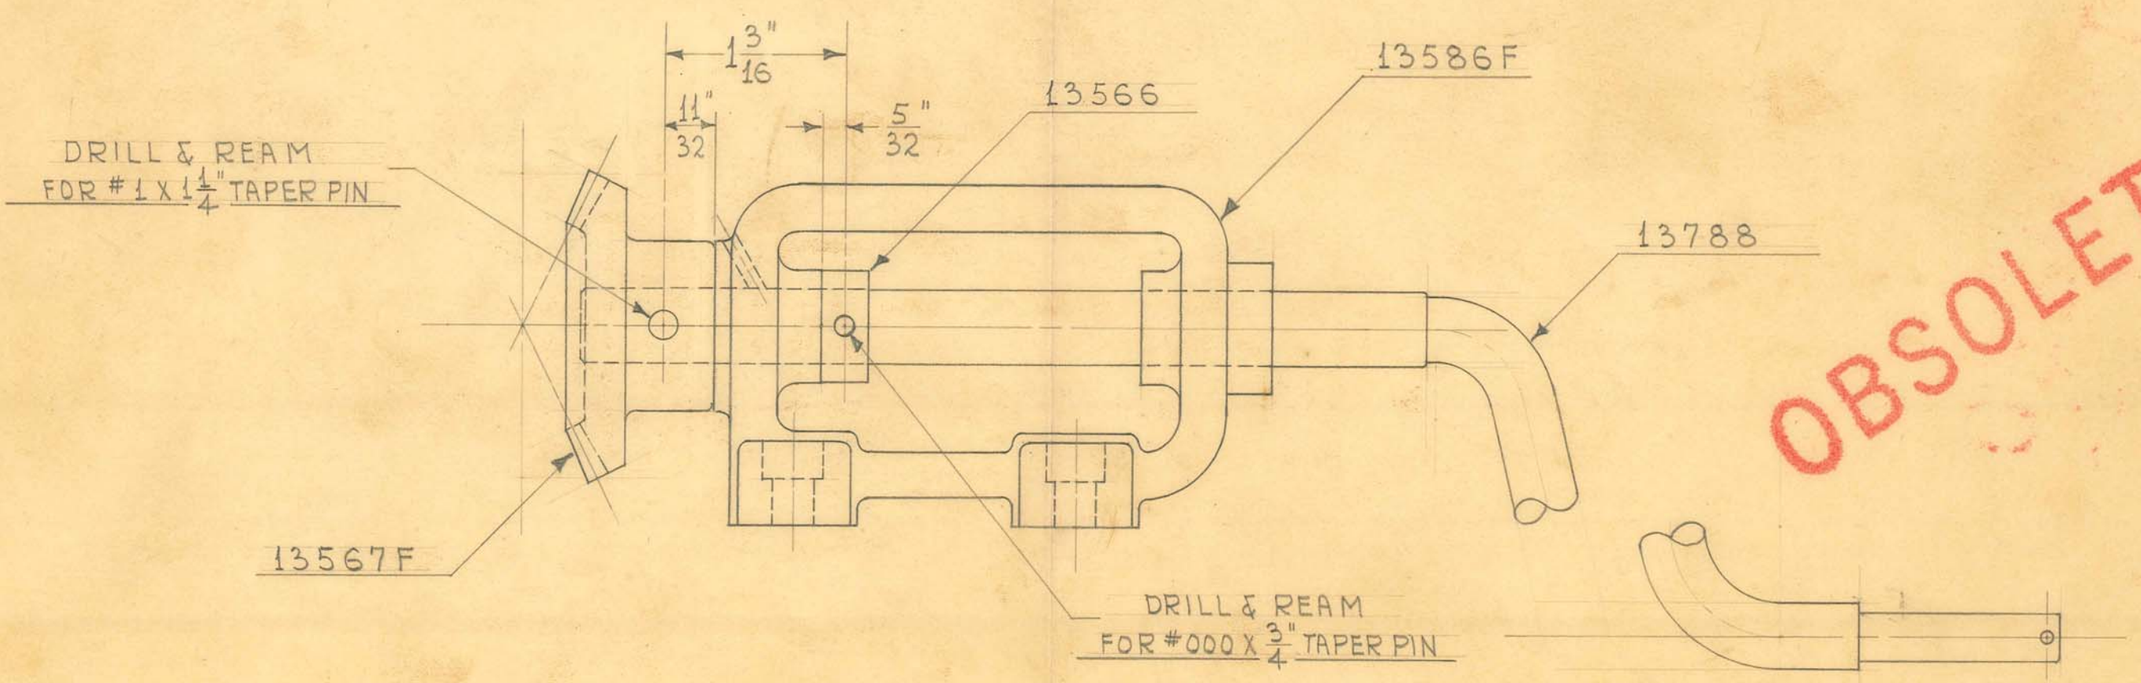

OBSOLETE

1 REQUIRED

SIZE		ISSUE 11-9-42	HE
KIND		CHANGED	
SHAPE		"	
FINISH		"	
TEMP.		"	

TITLE:
ARMY SHOCKPROOF DENTAL X-RAY UNIT-
RAISING GEAR ASSEMBLY

H. G. FISCHER & CO.
2335 WABANSIA AVE.

CAT. NO.

PART NO. 13935G

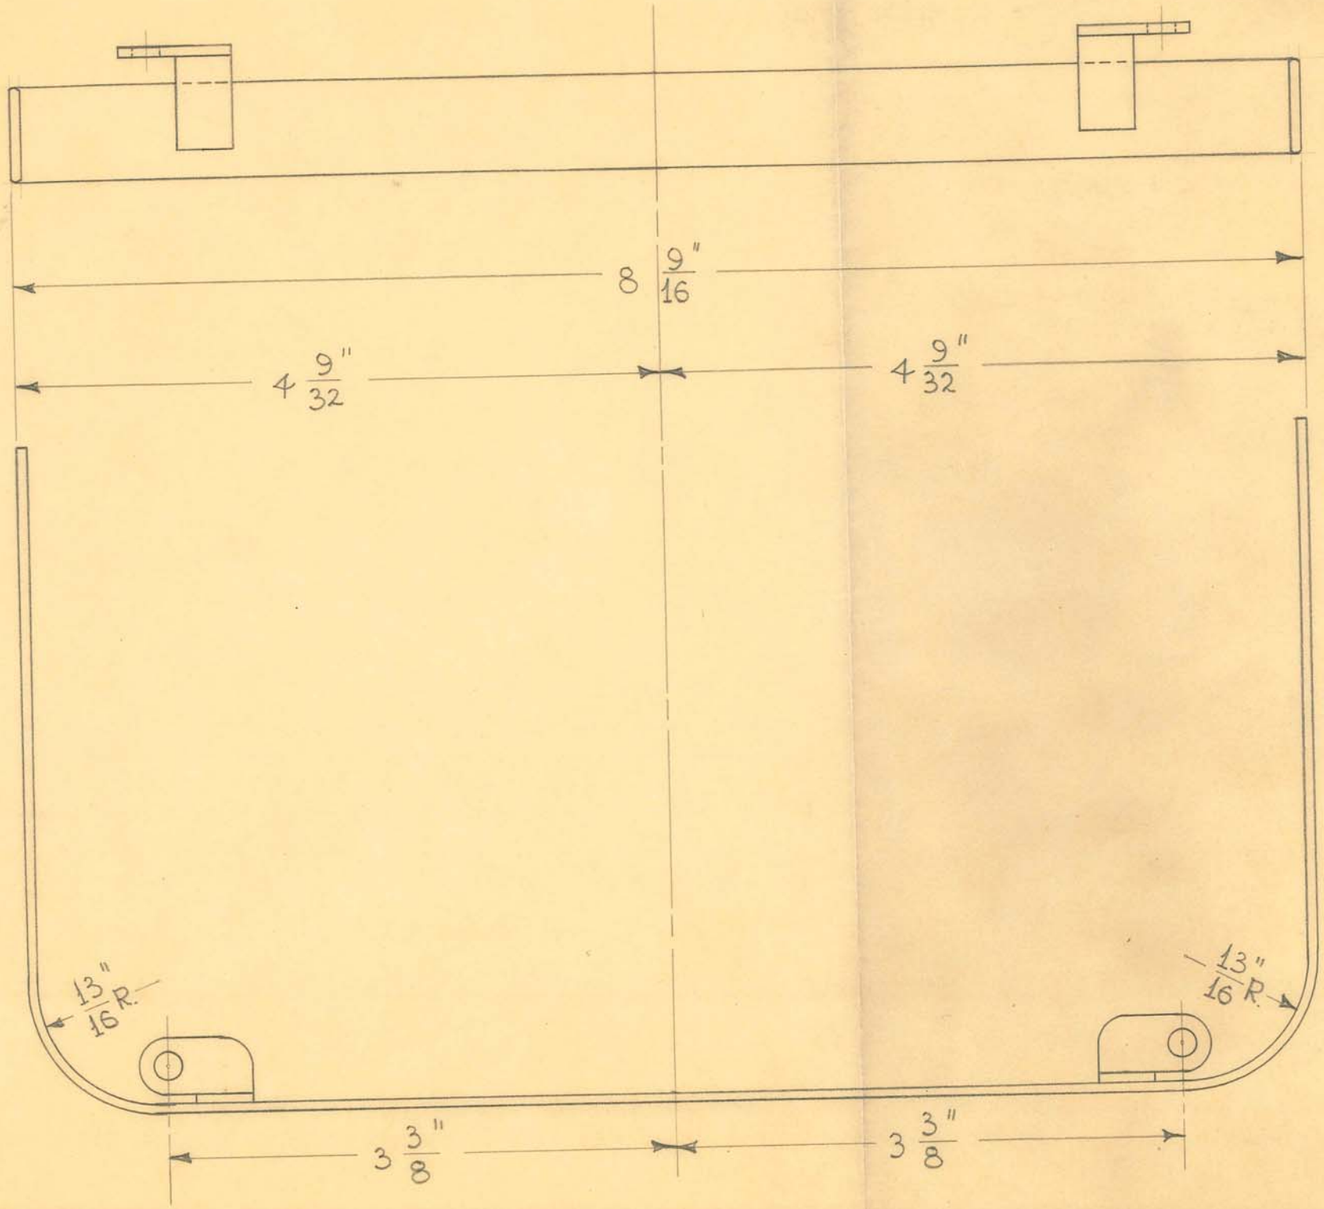

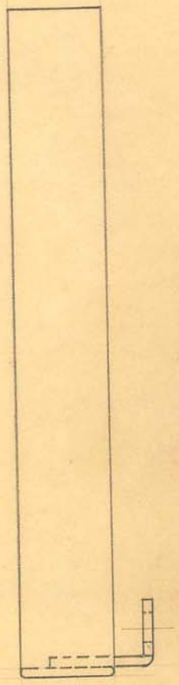

OBSOLETE

Cancelled

1 REQUIRED

SIZE	FROM 13942G	ISSUE 11-28-42	HE.	TITLE: ARMY SHOCKPROOF DENTAL X-RAY UNIT- TRANSF. SHIELD BRKT. ASSEM. (FORMED)
KIND		CHANGED		
SHAPE		"		
FINISH		"		
TEMP.		"		
PATT.		"		

H. G. FISCHER & CO.
2338 WABANSIA AVE.
CHICAGO, ILL.

CAT. NO.

PART NO. 13949 GF

REMOVE PLATE FROM TANK
25/64" DRILL THRU - 9/16" C'BORE - 5/8" DEEP - FROM BACK SIDE.

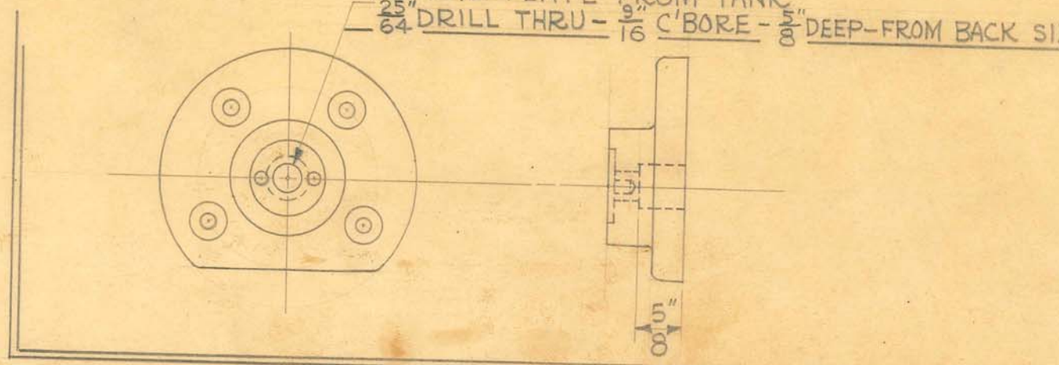

25/64" DRILL - 1/2" DEEP

2 HLS. - 3/16" REAMED - 7/32" DEEP

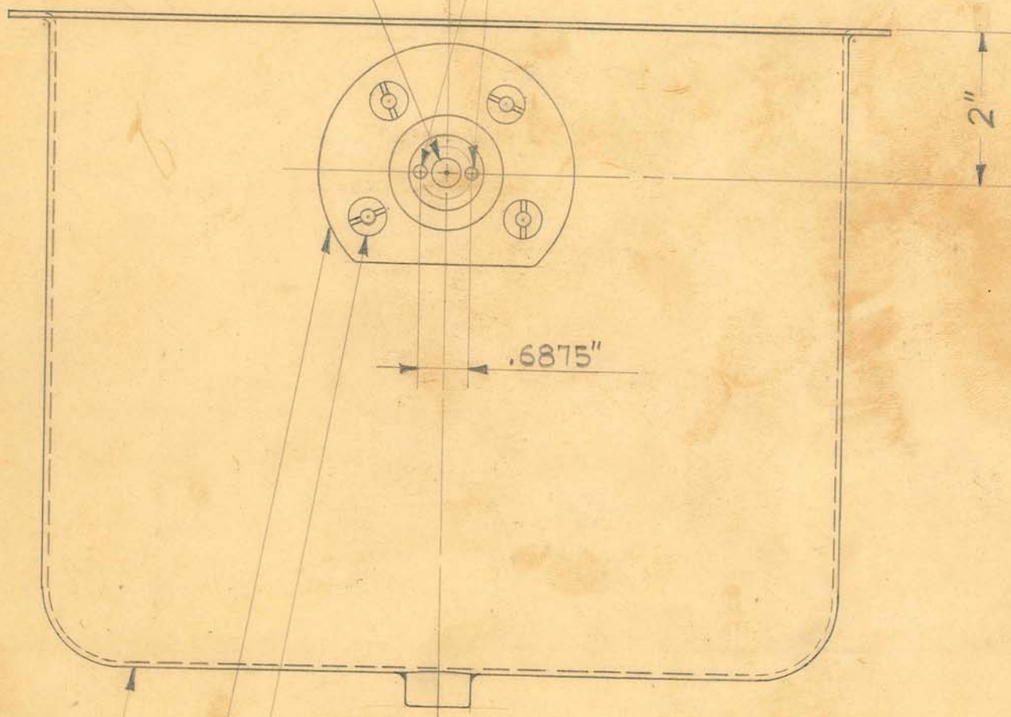

PCE. # 12621

PCE. # 13993F

PCE. # 13961GA

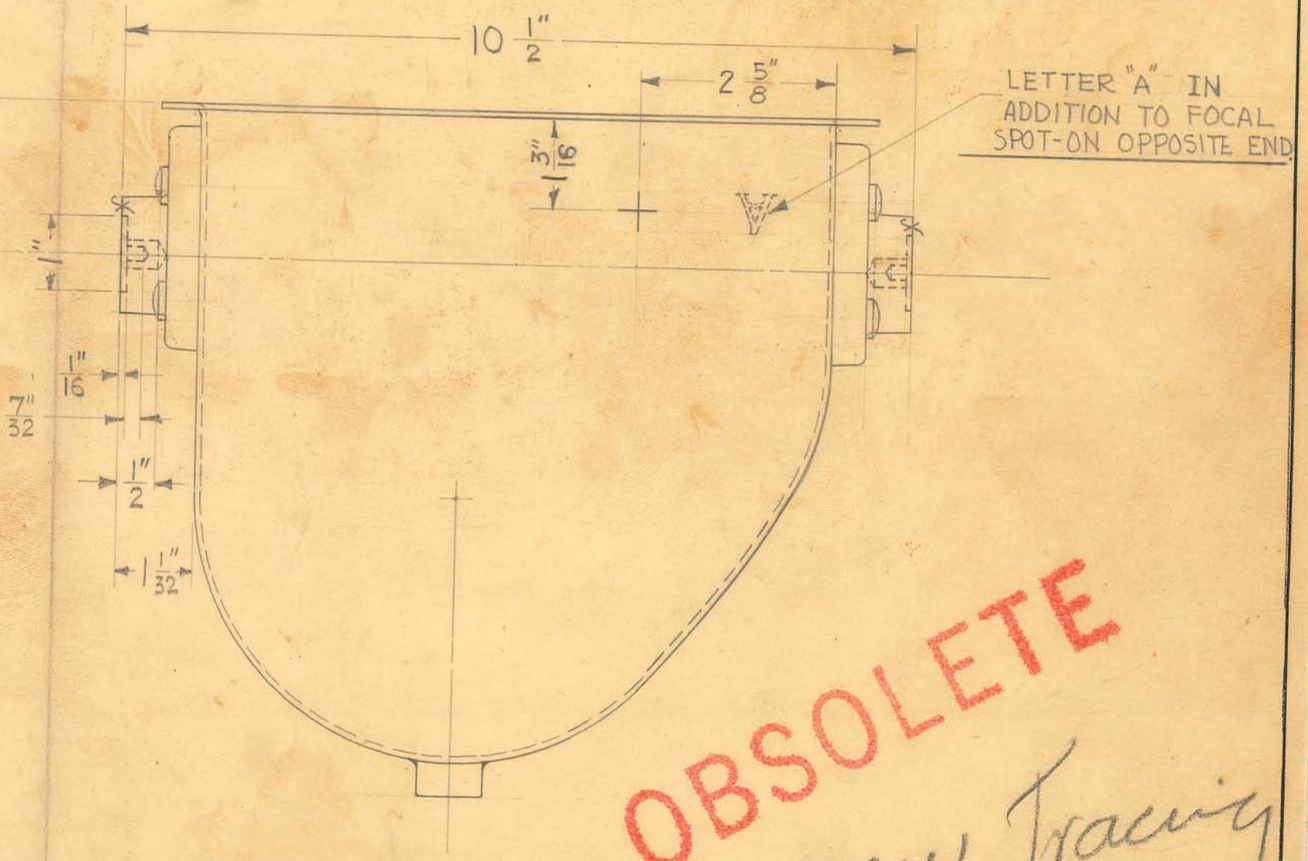

LETTER "A" IN ADDITION TO FOCAL SPOT - ON OPPOSITE END

OBSOLETE
See new Tracing
6-14-57

SIZE		ISSUE 8-22-41	J.V.W.	TITLE: U.S. NAVY X-RAY UNIT TRANSF. TANK & BEARING PLATE ASSEM.
KIND		CHANGED 5-5-43	H.E.	
SHAPE		"		
FINISH		"		
TEMP.		"		
PATT.		"		

H. G. FISCHER & CO.
2338 WABANSIA AVE.
CHICAGO, ILL.

CAT. NO.

PART NO. 13952 GA

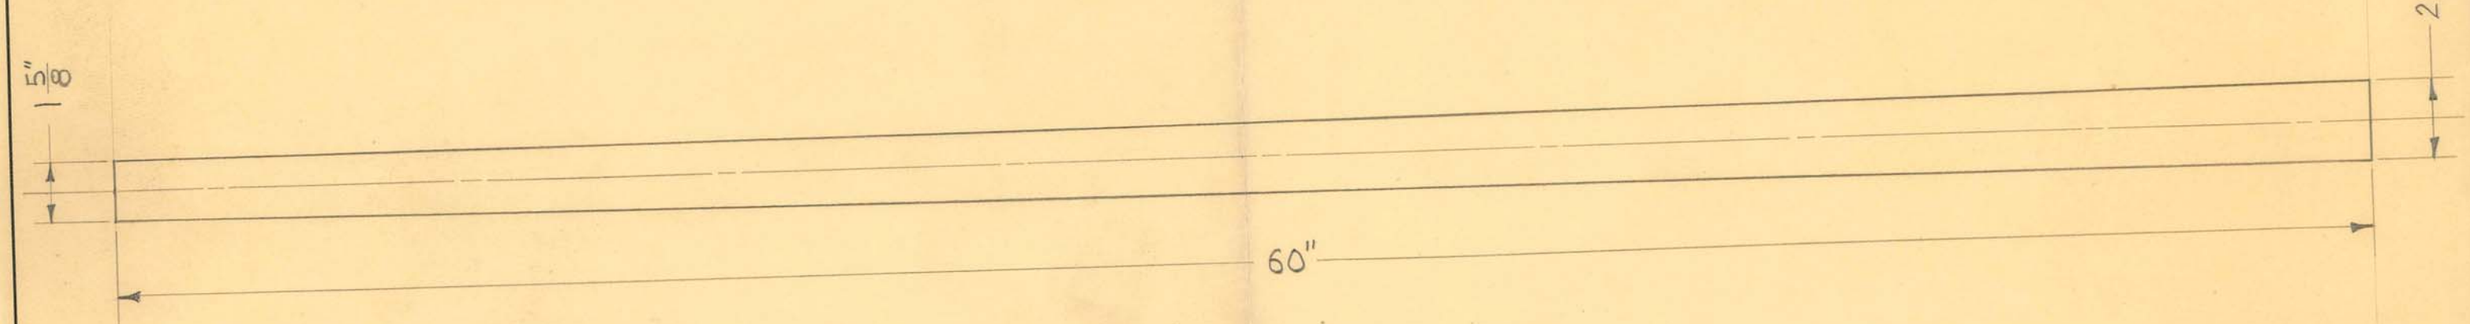

SCALE ≈ 1/4" = 1"

1 REQUIRED

OBSOLETE

Obsolete

SIZE		ISSUE 6-3-41	J.V.W.	TITLE: U.S. NAVY X-RAY UNIT - FILAMENT TRANSF. SECONDARY INSULATING STRIP
KIND	FROM 3286	CHANGED		
SHAPE		"		
FINISH		"		
TEMP.		"		
PATT.		"		

H. G. FISCHER & CO.
2335 WABANSIA AVE.
CHICAGO. ILL.

CAT. NO.

PART NO. 13954

TITLE
FISCHER "ANM" X-RAY UNIT
TANK PANEL GASKET

H. G. FISCHER & CO.
FRANKLIN PARK, ILLINOIS

DATE 1-9-53 | DR. BY J.V.W. | CH'K'D.

PART NO. 13963

REVISION	DATE	BY

PATTERN | FINISH | SCALE HALF SIZE

TOOLS CUT ON SQUARE SHEARS
RADIUS PUNCHES #7202 (BIN Z-4)
PUNCH HLS. THRU DRILL JIG #7181 (BIN Z-4)

MATERIAL 1/16" SHEET NEOPRENE
#2065 — #70 DUROMETER TEST

DIMENSIONS UNLESS OTHERWISE SPECIFIED
FRACTIONAL ± .015
DECIMAL ± .005
ANGULAR ± ½°

OBSOLETE

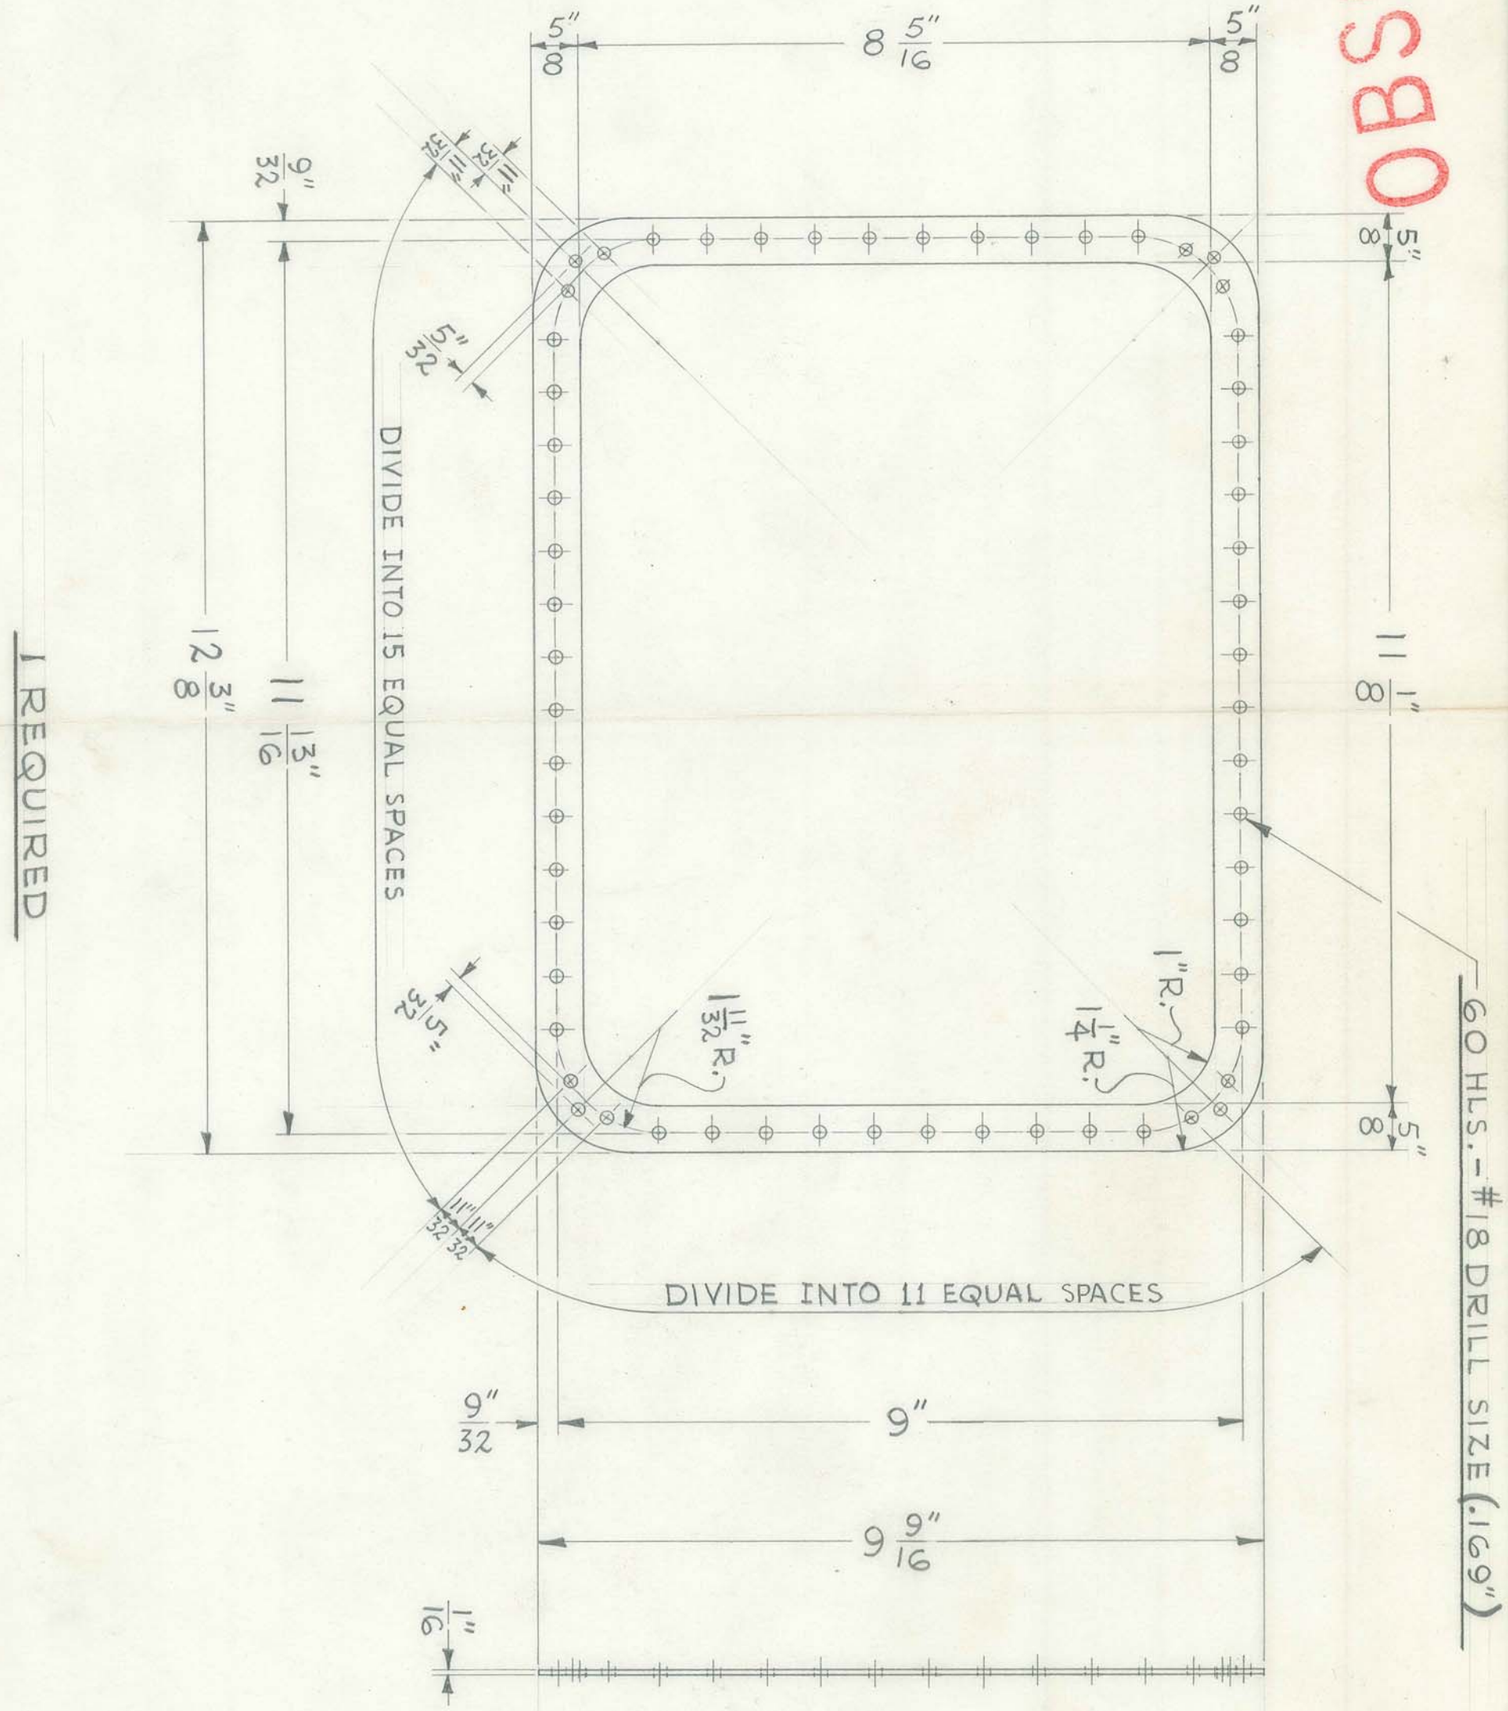

FOLDER #110

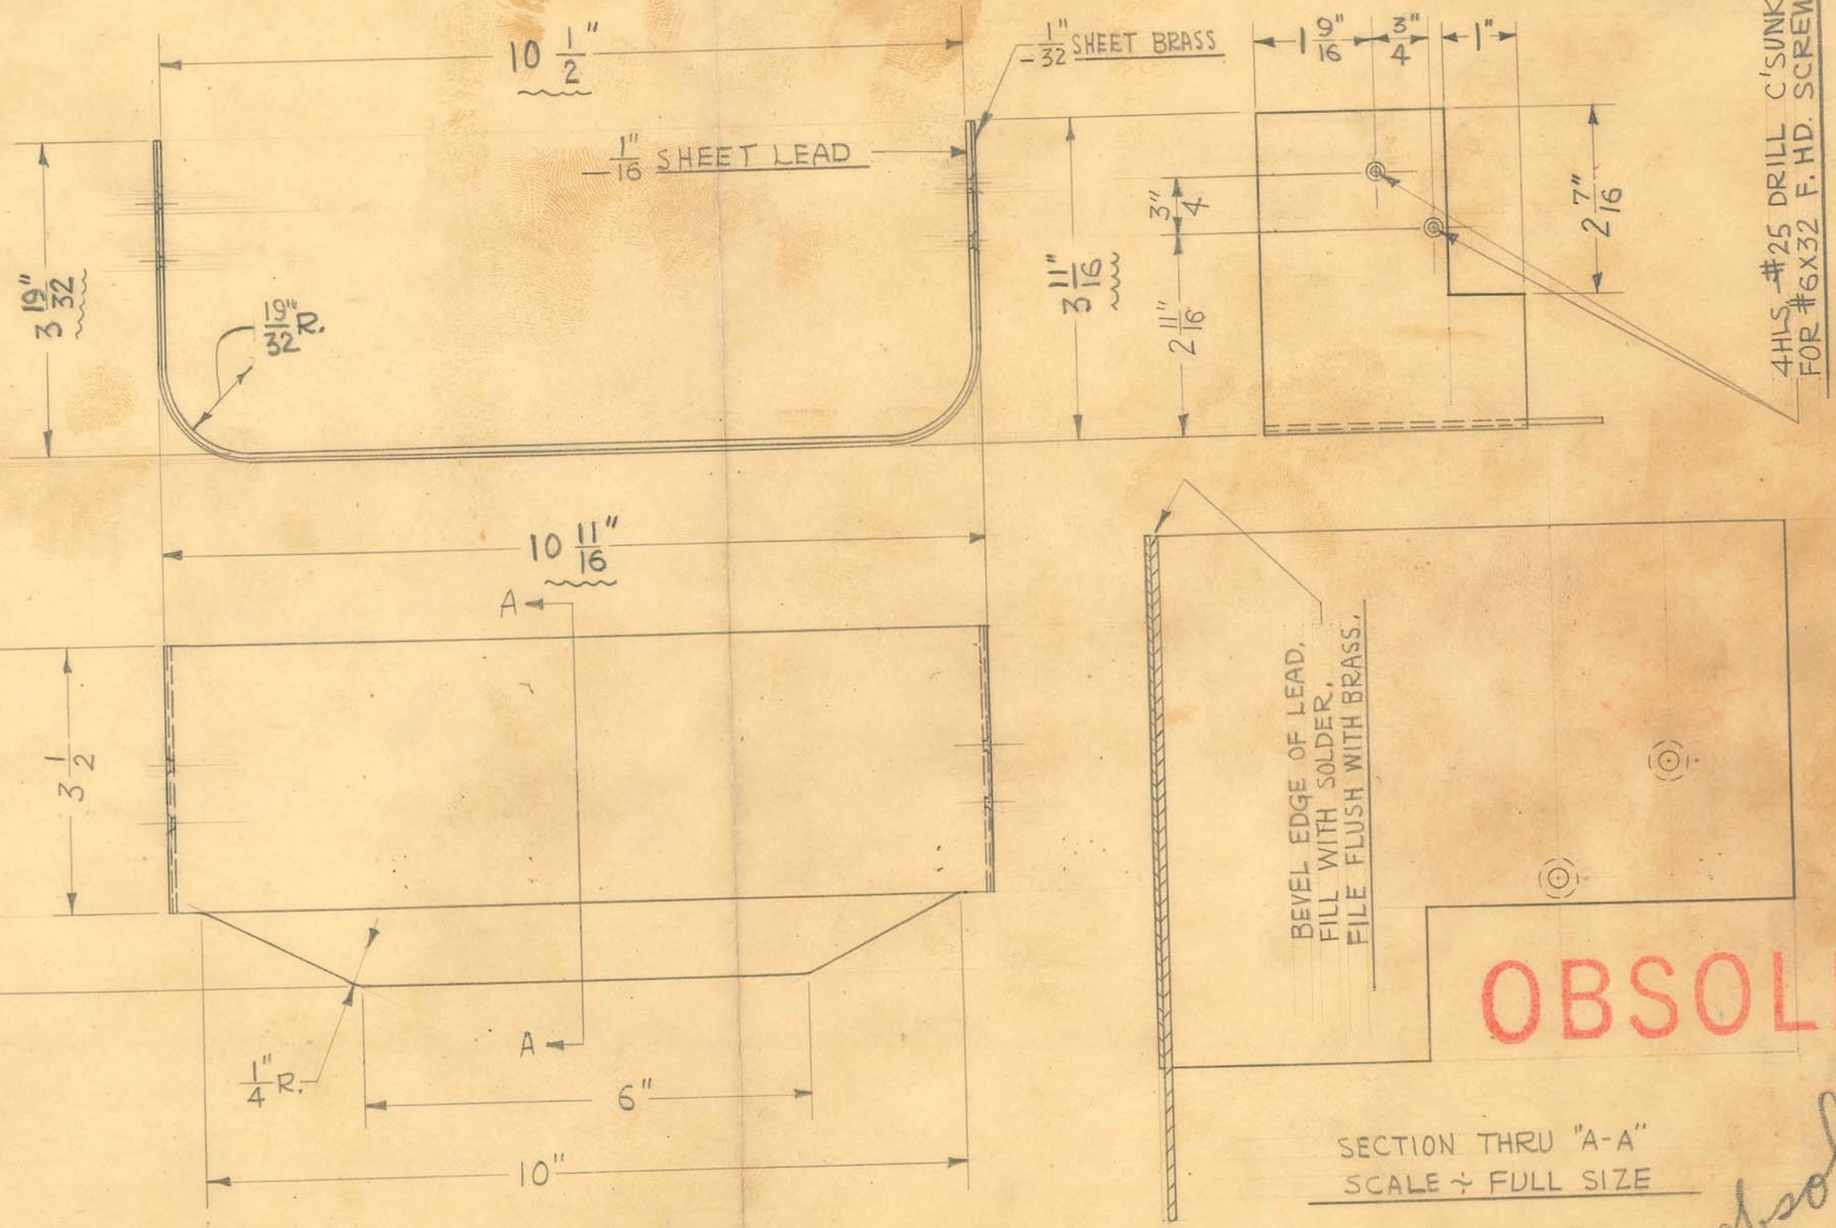

SECTION THRU "A-A"
SCALE ÷ FULL SIZE

DEVELOPED LENGTH = ____

SCALE ÷ HALF SIZE

OBSOLETE

Obsolete

SIZE		ISSUE 3-31-41	J.V.W.
KIND		CHANGED 2-6-41	J.V.W.
SHAPE		"	
FINISH		"	
TEMP.		"	
PATT.		"	

TITLE:
U.S. NAVY X-RAY UNIT
TANK — X-RAY SHIELD

H. G. FISCHER & CO.
2335 WABANSIA AVE.
CHICAGO, ILL.

CAT. NO.

PART NO. 13965GA

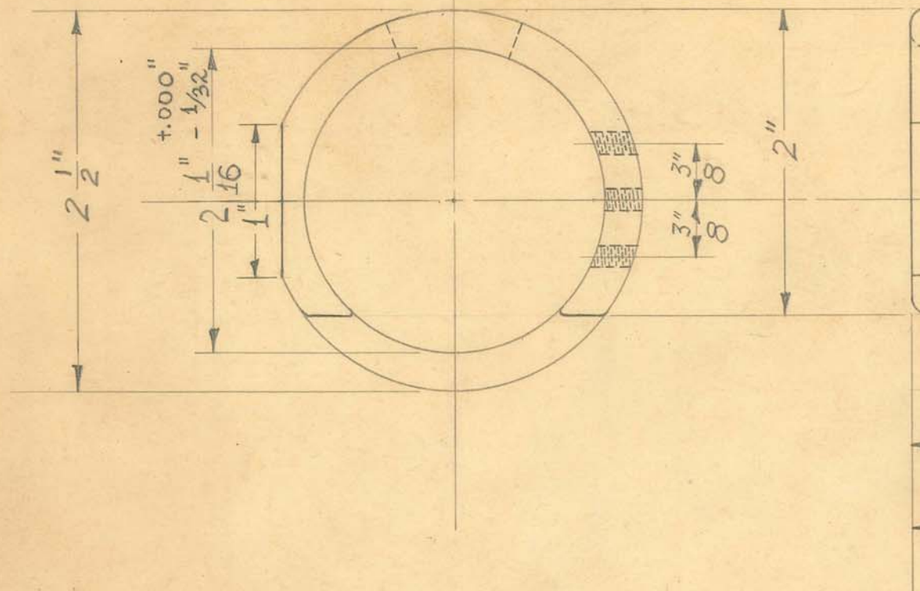

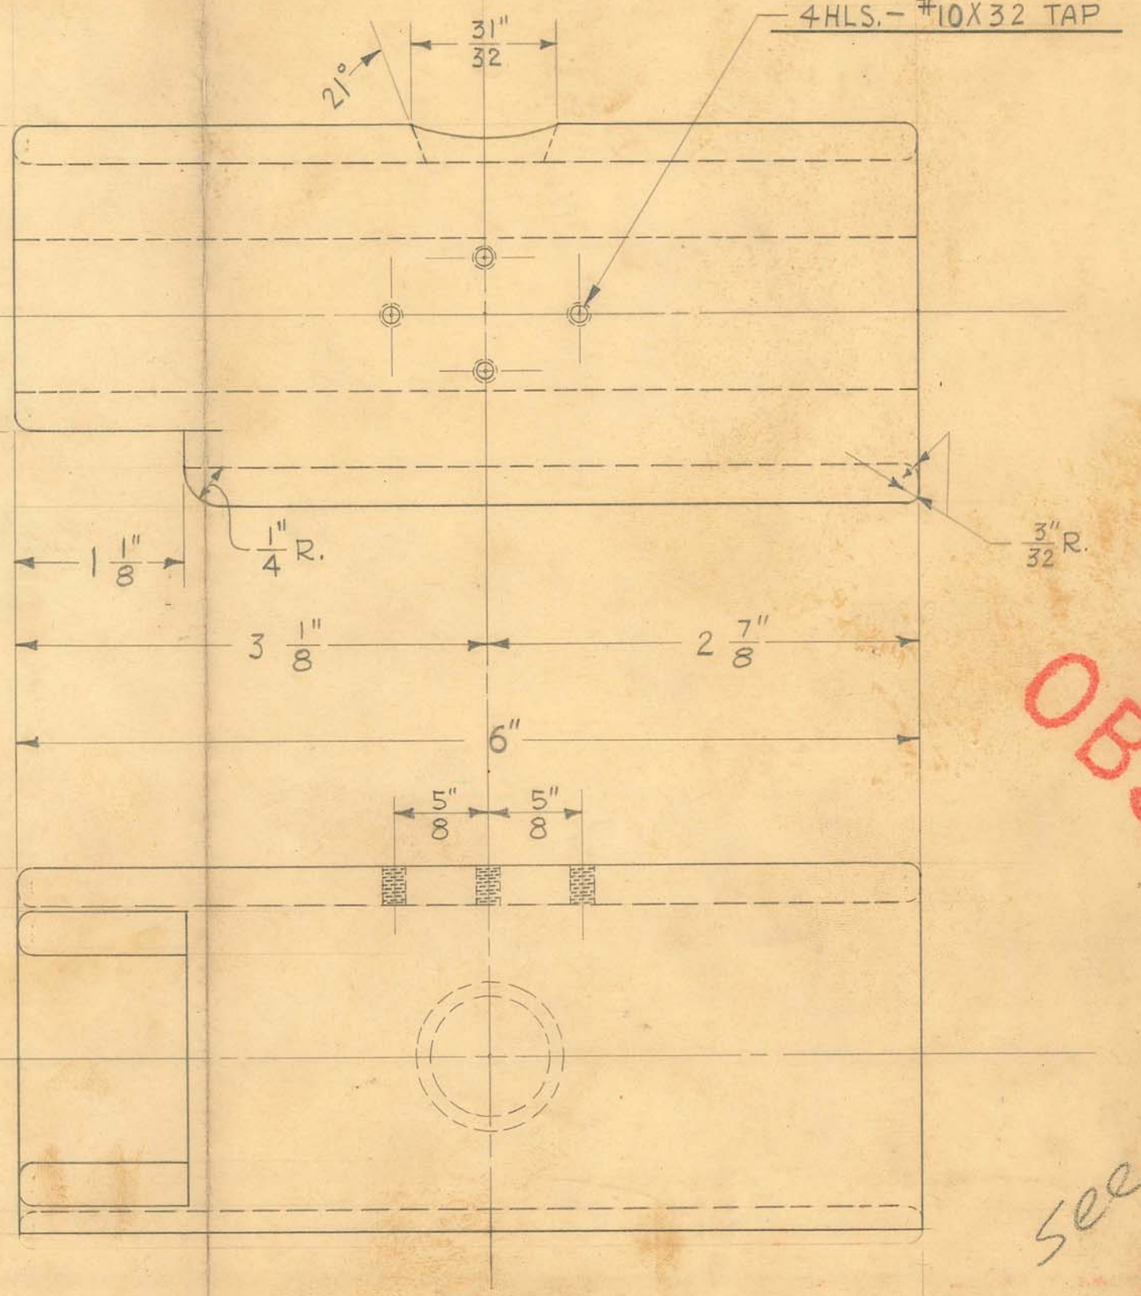

8-70 HR
PCE. NO. 12649GA

5-70 H.R.
PCE. NO. 12650GA

6-70 HR.
PCE. NO. 13957G

MATERIAL

2 1/2" O.D. X 2 1/16" - 1/32" + .000" I.D. X-OPAKE TUBING.

FROM # 13968 C

OBSOLETE

see new Tracing

SIZE		ISSUE 3-31-41	J.V.W.
KIND	SEE NOTE	CHANGED 6-24-42	J.V.W.
SHAPE		" 2-2-43	HE
FINISH		" 3-30-61	R.C.T.
TEMP.		"	
PATT.		"	

TITLE:
U.S. NAVY X-RAY UNIT
X-RAY TUBE - SHIELD - FINISHED

H. G. FISCHER & CO.
2335 WABANSIA AVE.
CHICAGO, ILL.

CAT. NO.

PART NO. 13968CF

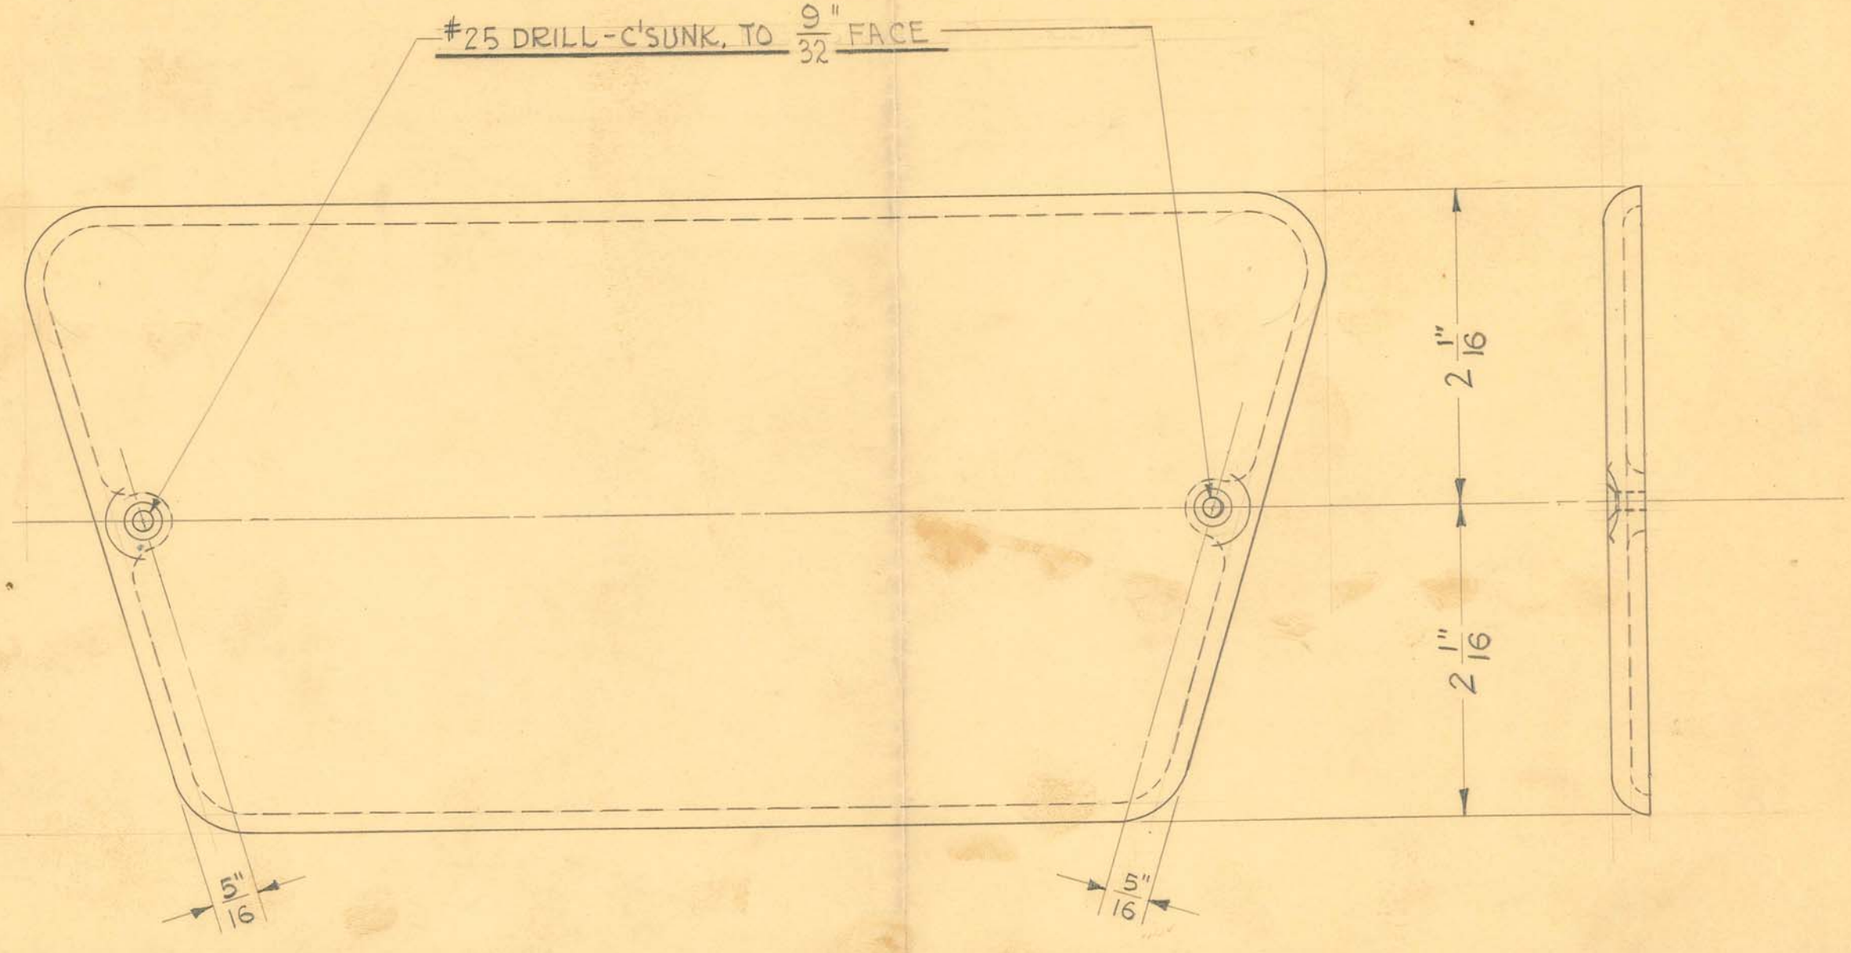

1 REQUIRED

OBSOLETE

SIZE	#12	ISSUE 5-10-41	J.V.W.
KIND	ALUM. CASTING	CHANGED	
SHAPE		"	
FINISH	PAINTED	"	
TEMP.		"	
PATT.	1749	"	

TITLE: U.S. NAVY X-RAY UNIT
CONTROL HOUSING TERMINAL COVER

H. G. FISCHER & CO.
2335 WABANSIA AVE.
CHICAGO, ILL.

CAT. NO.

PART NO. 13983F

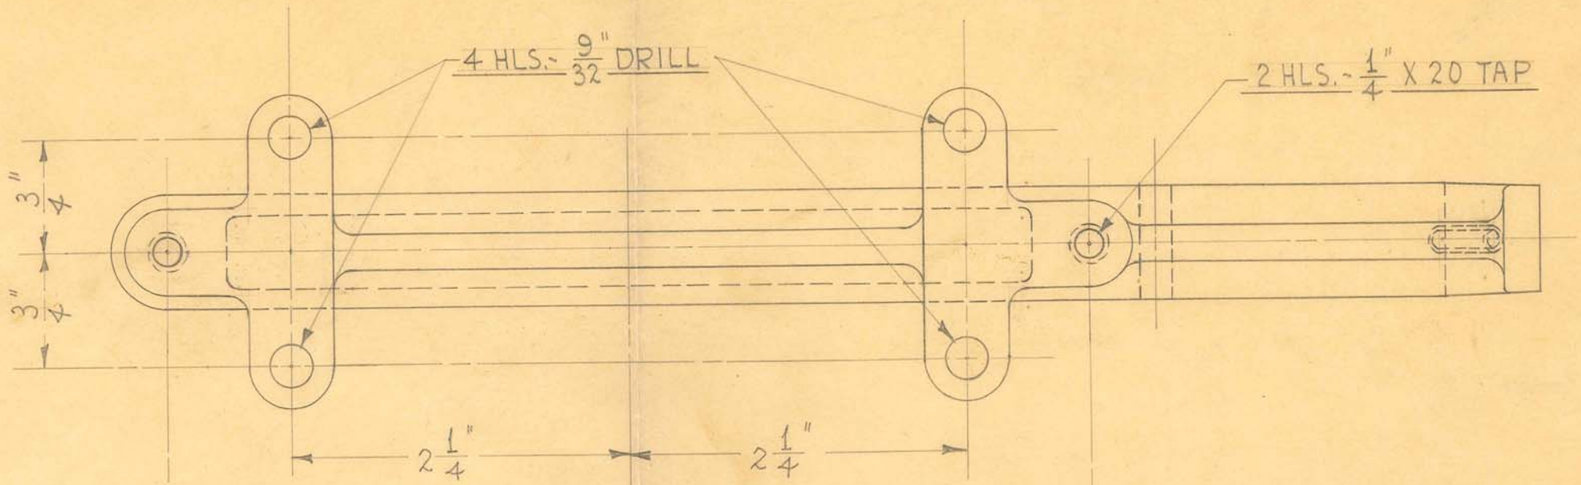

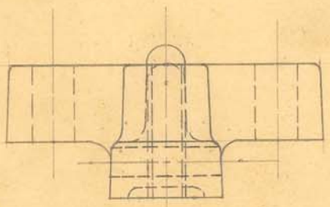

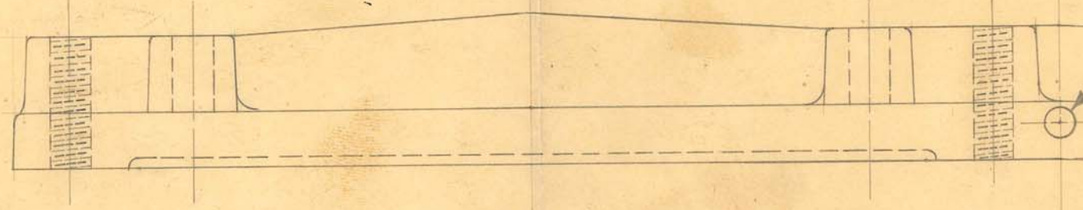

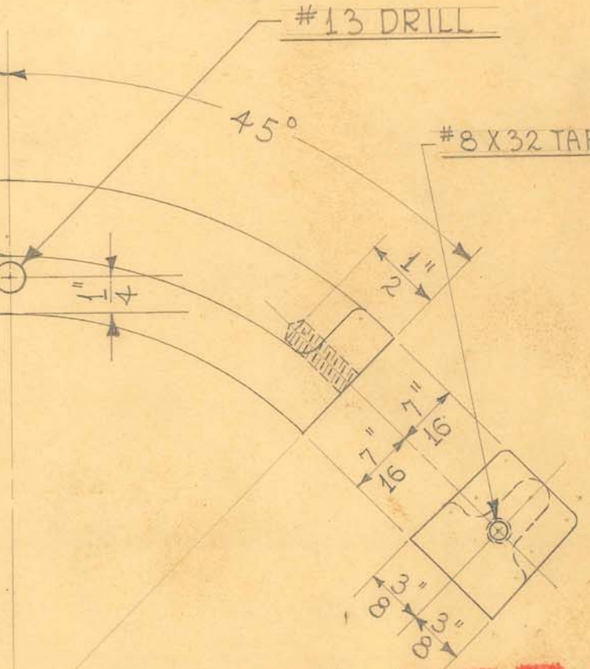

1 REQUIRED

OBSOLETE

SIZE	#214	ISSUE 5-16-41	H.E.
KIND	ALUM. CASTING	CHANGED	
SHAPE		" 7-13-42	H.E.
FINISH	BLACK #80	"	
TEMP.		"	
PATT.	1741	"	

TITLE: U.S. NAVY X-RAY UNIT - CONTROL BOX - AUTO TRANSF. CLAMP - UPPER (RIGHT)

H. G. FISCHER & CO.
2338 WABANSIA AVE.
CHICAGO, ILL.

CAT. NO.

PART NO. 13985FA

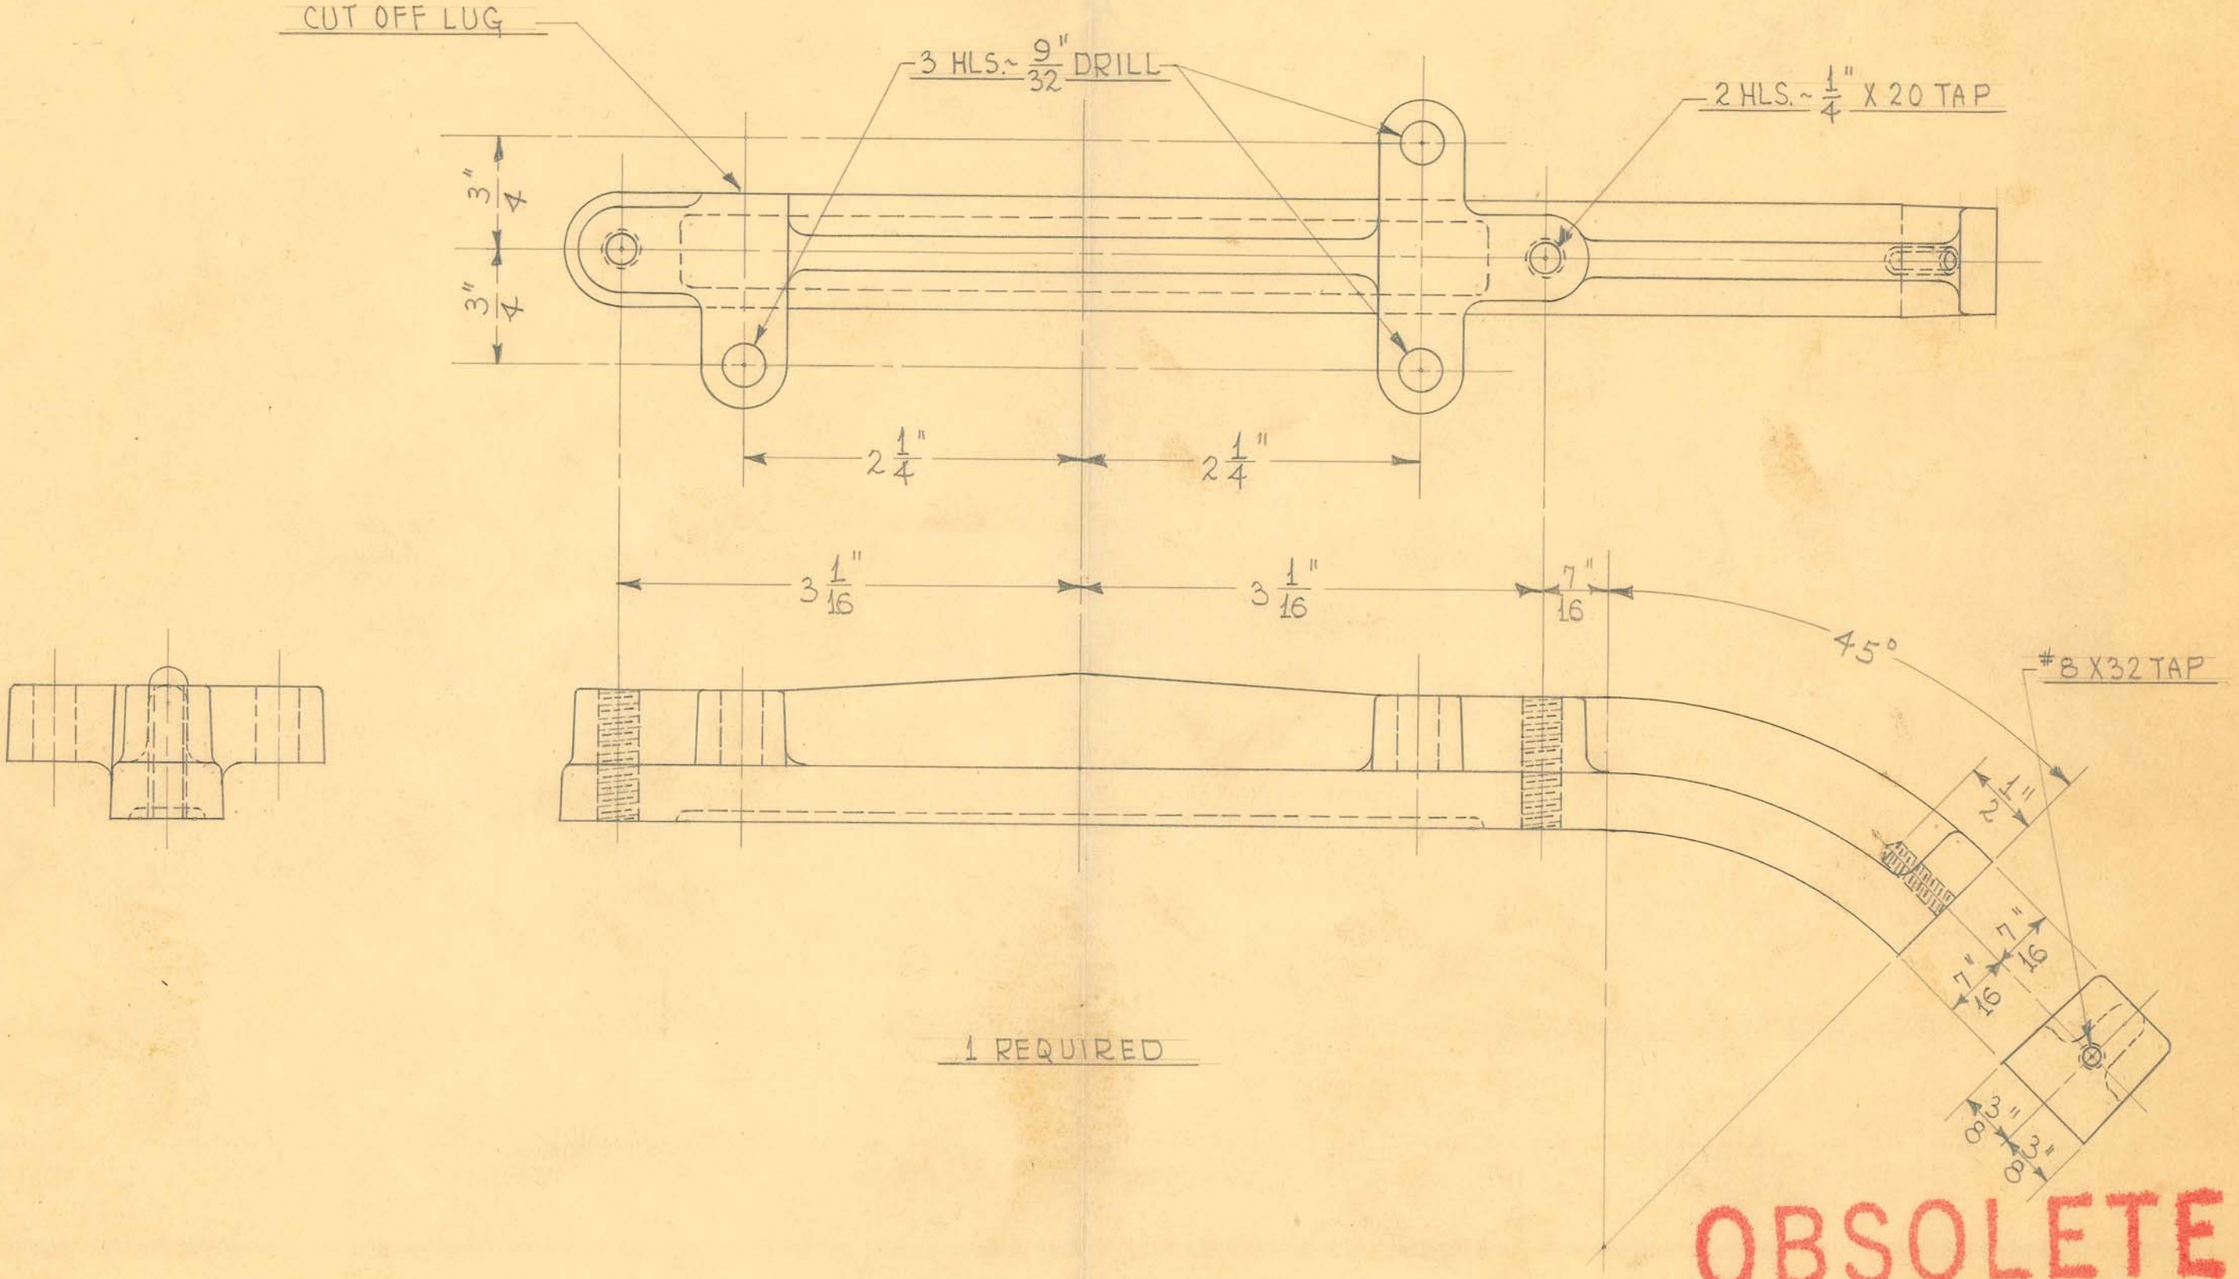

1 REQUIRED

OBSOLETE

SIZE	#214	ISSUE 7-13-42	HE
KIND	ALUM. CASTING	CHANGED	
SHAPE		"	
FINISH	BLACK #80	"	
TEMP.		"	
PATT.	1741	"	

TITLE: U.S. NAVY X-RAY UNIT - CONTROL BOX - AUTO TRANSF. CLAMP ~ UPPER (LEFT)

H. G. FISCHER & CO.
2335 WABANSIA AVE.
CHICAGO, ILL.

CAT. NO.

PART NO. 13985 1/2

TITLE
FISCHER MOBILE BEDSIDE UNIT
TRANSFORMER COVER LEAD STRIP

H. G. FISCHER & CO.
FRANKLIN PARK, ILLINOIS

DATE 6-5-51 | DR. BY W.J. | CH'K'D.

PART NO. PART OF 13994G

REVISION	DATE	BY

PATTERN | FINISH | SCALE HALF

TOOLS
DRILL JIG # 7214

MATERIAL
.040" SHEET LEAD

DIMENSIONS
FRACTIONAL ± .015
DECIMAL ± .005
ANGULAR ± ½°
UNLESS OTHERWISE SPECIFIED

FOLDER # 110

OBSOLETE

Obsolete

SEE NOTE ON MAIN DRAWING

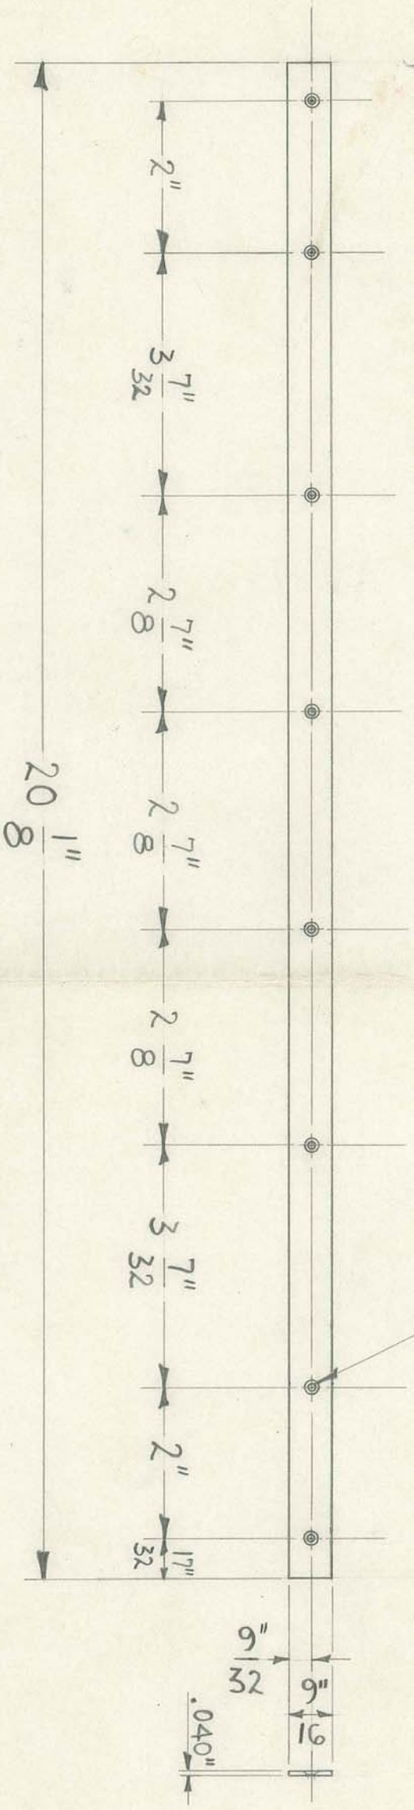

2 REQUIRED

8 HLS. #42 DRILL - C'SINK TO 3/16" FACE

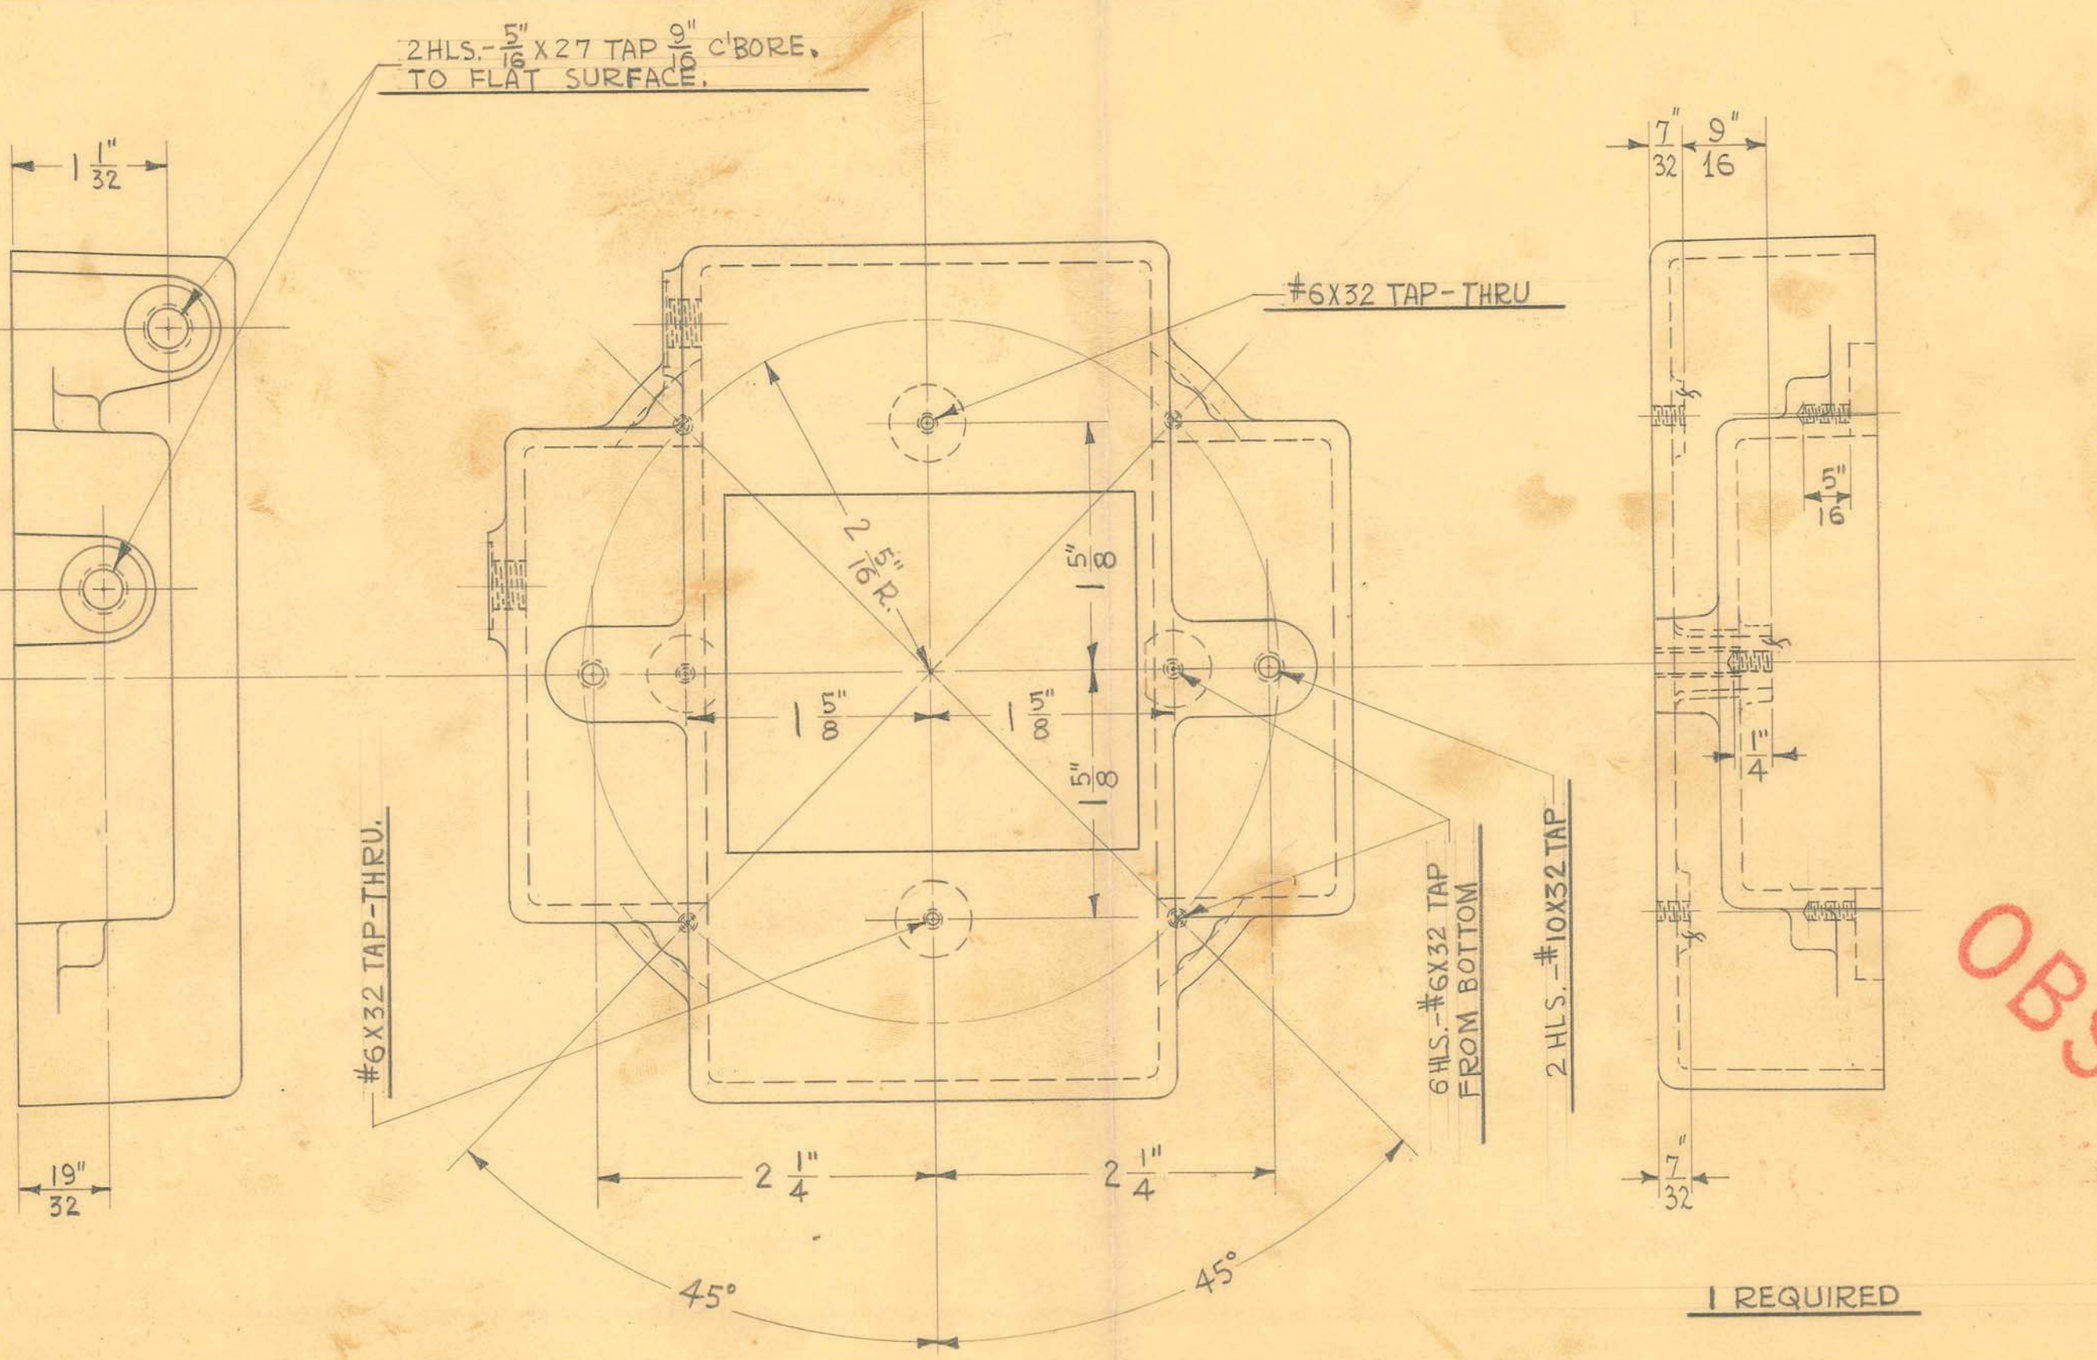

1 REQUIRED

OBSOLETE

SIZE	#12	ISSUE 5-5-41	J.V.W.
KIND	ALUM. CASTING	CHANGED	
SHAPE		"	
FINISH	PAINTED	"	
TEMP.		"	
PATT.	1738	"	

TITLE: U.S. NAVY X-RAY UNIT SHUTTER FRAME

H. G. FISCHER & CO.
2335 WABANSIA AVE.
CHICAGO, ILL.

CAT. NO.

PART NO. 13998F

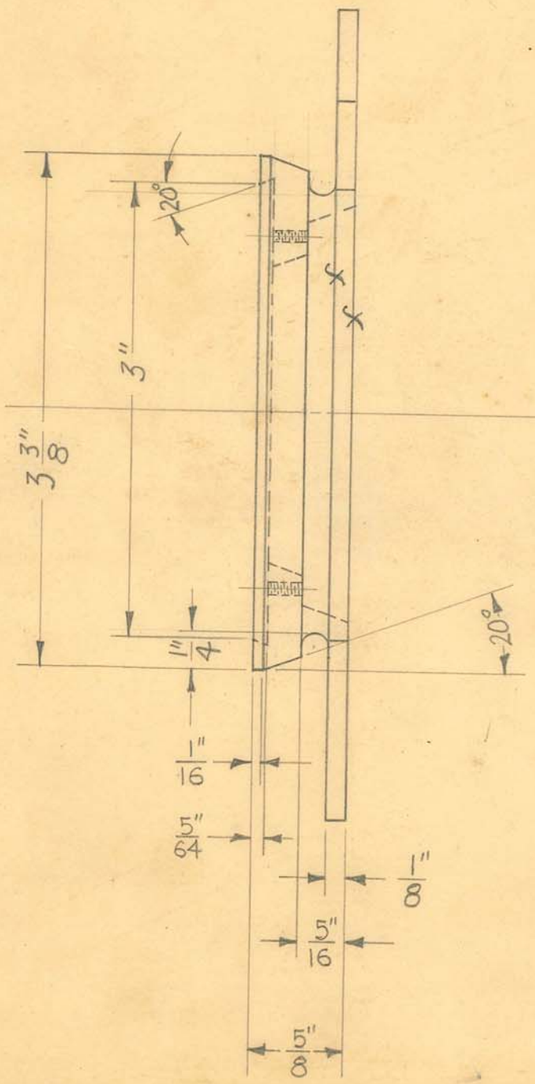

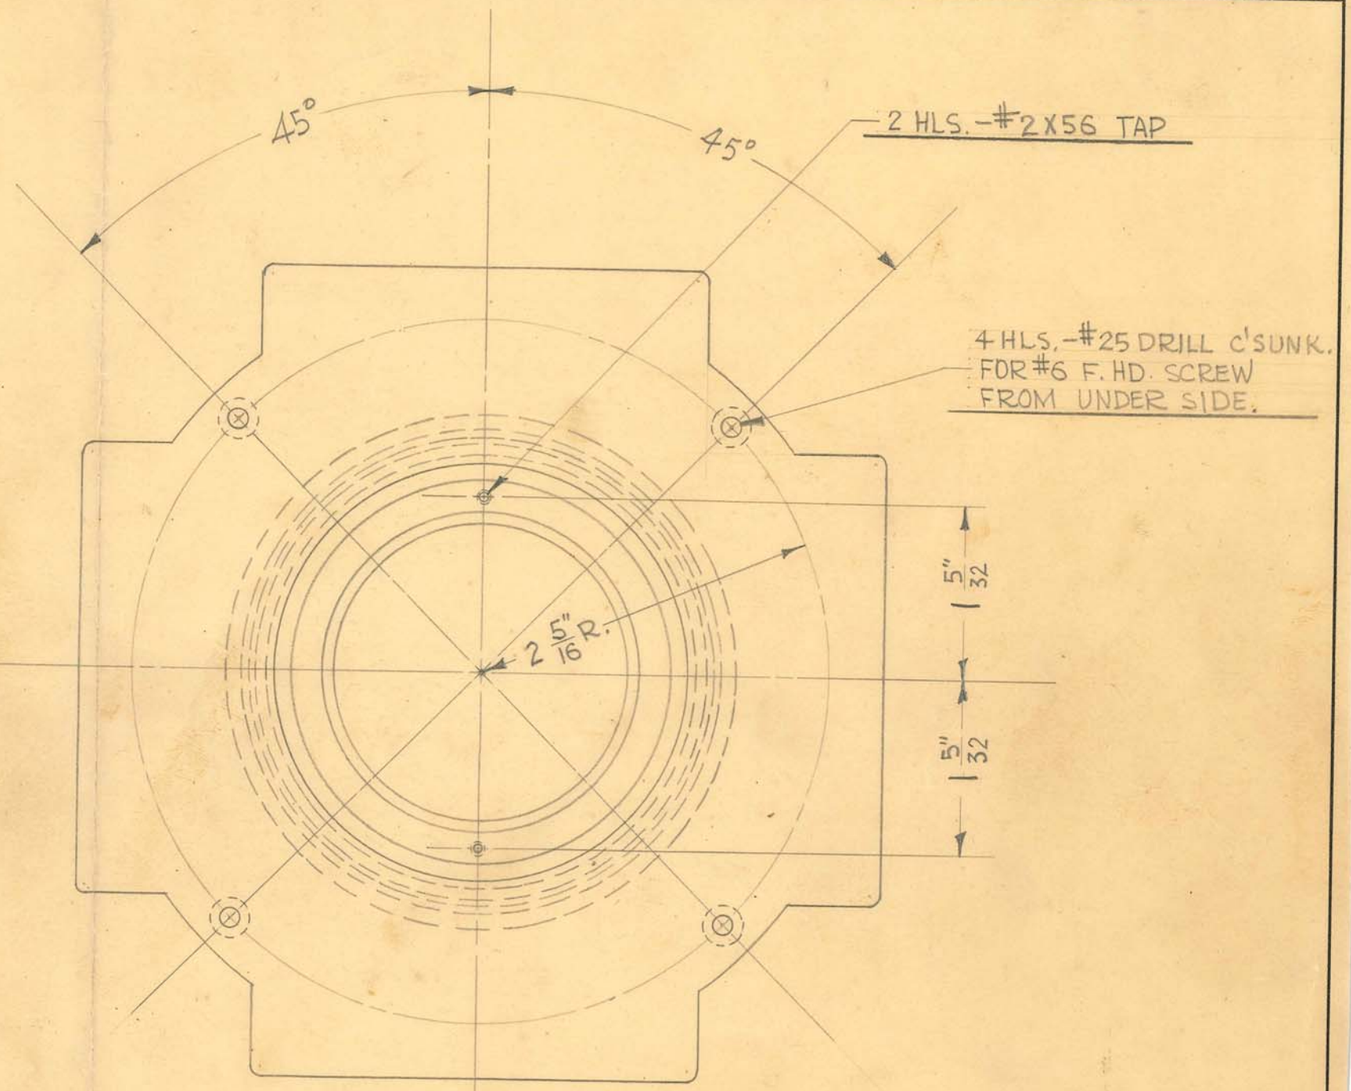

OBSOLETE

1 REQUIRED

SIZE	#12	ISSUE 4-15-41	J.V.W.
KIND	ALUM. CASTING	CHANGED	
SHAPE		"	
FINISH	PAINTED	"	
TEMP.		"	
PATT.	1739	"	

TITLE:
U.S. NAVY X-RAY UNIT
SHUTTER FRAME ADAPTER

H. G. FISCHER & CO.
2335 WABANSIA AVE.
CHICAGO, ILL.

CAT. NO.

PART NO. 1309

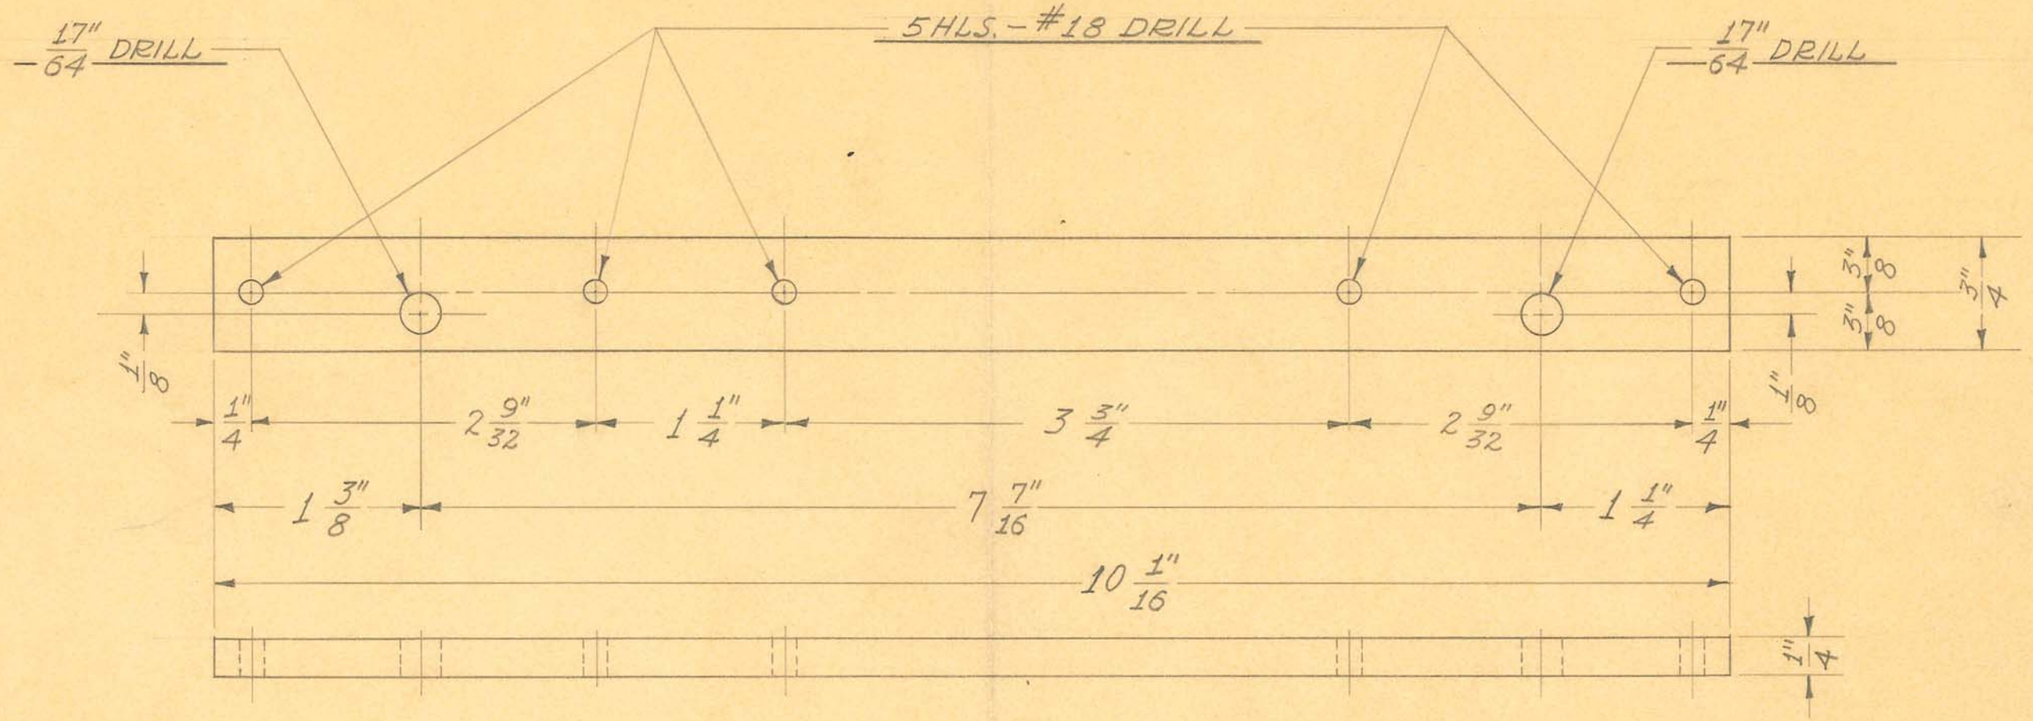

1 REQUIRED

OBSOLETE

SIZE	1/4" SHEET	ISSUE 4-17-39	J.W.
KIND	BLK. BAKELITE	CHANGED	
SHAPE		"	
FINISH		"	
TEMP.		"	
PATT.		"	

TITLE: MOD. "5" SHORT WAVE 6 METER TRANSF. TERM. STRIP-LOWER (FOREIGN)

H. G. FISCHER & CO.
2335 WABANSIA AVE.
CHICAGO, ILL.

CAT. NO.

PART NO. 12572

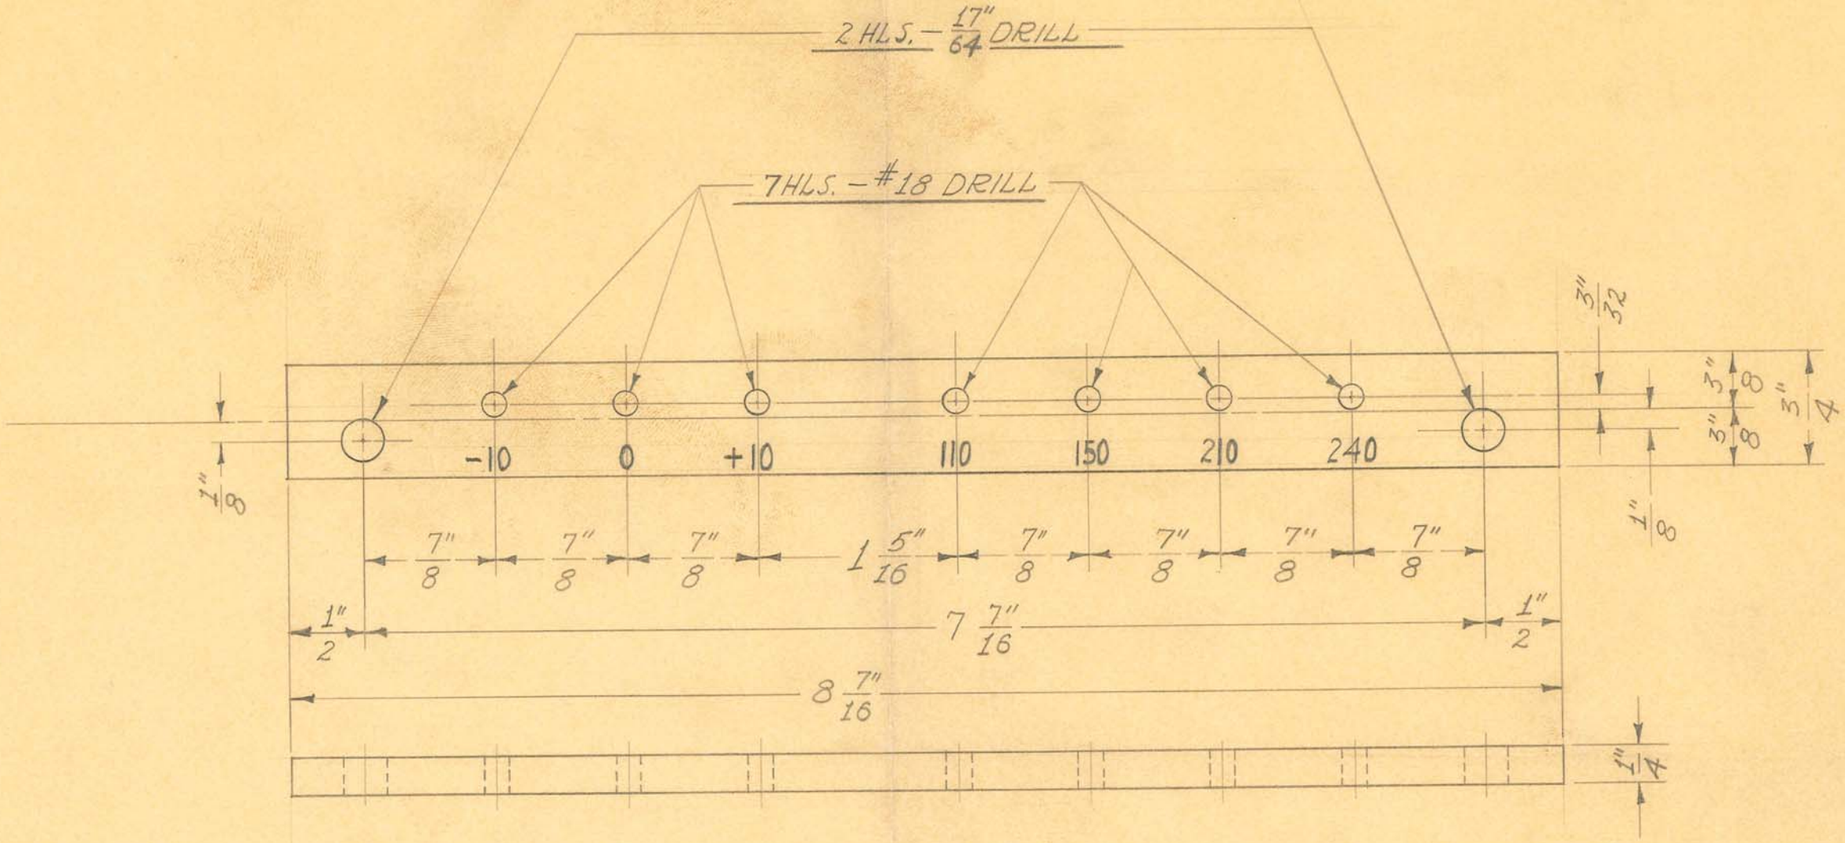

1 REQUIRED

OBSOLETE

SIZE	7/4" SHEET	ISSUE 4-17-39	J.W.
KIND	BLK. BAKELITE	CHANGED	
SHAPE		"	
FINISH		"	
TEMP.		"	
PATT.		"	

TITLE: MOD. "S" S.W. 6 METER – TRANSF. VOLTAGE CHANGE STRIP (FOREIGN) (ENGRAVED)

H. G. FISCHER & CO.
2335 WABANSIA AVE.
CHICAGO, ILL.

CAT. NO.

PART NO. 12573

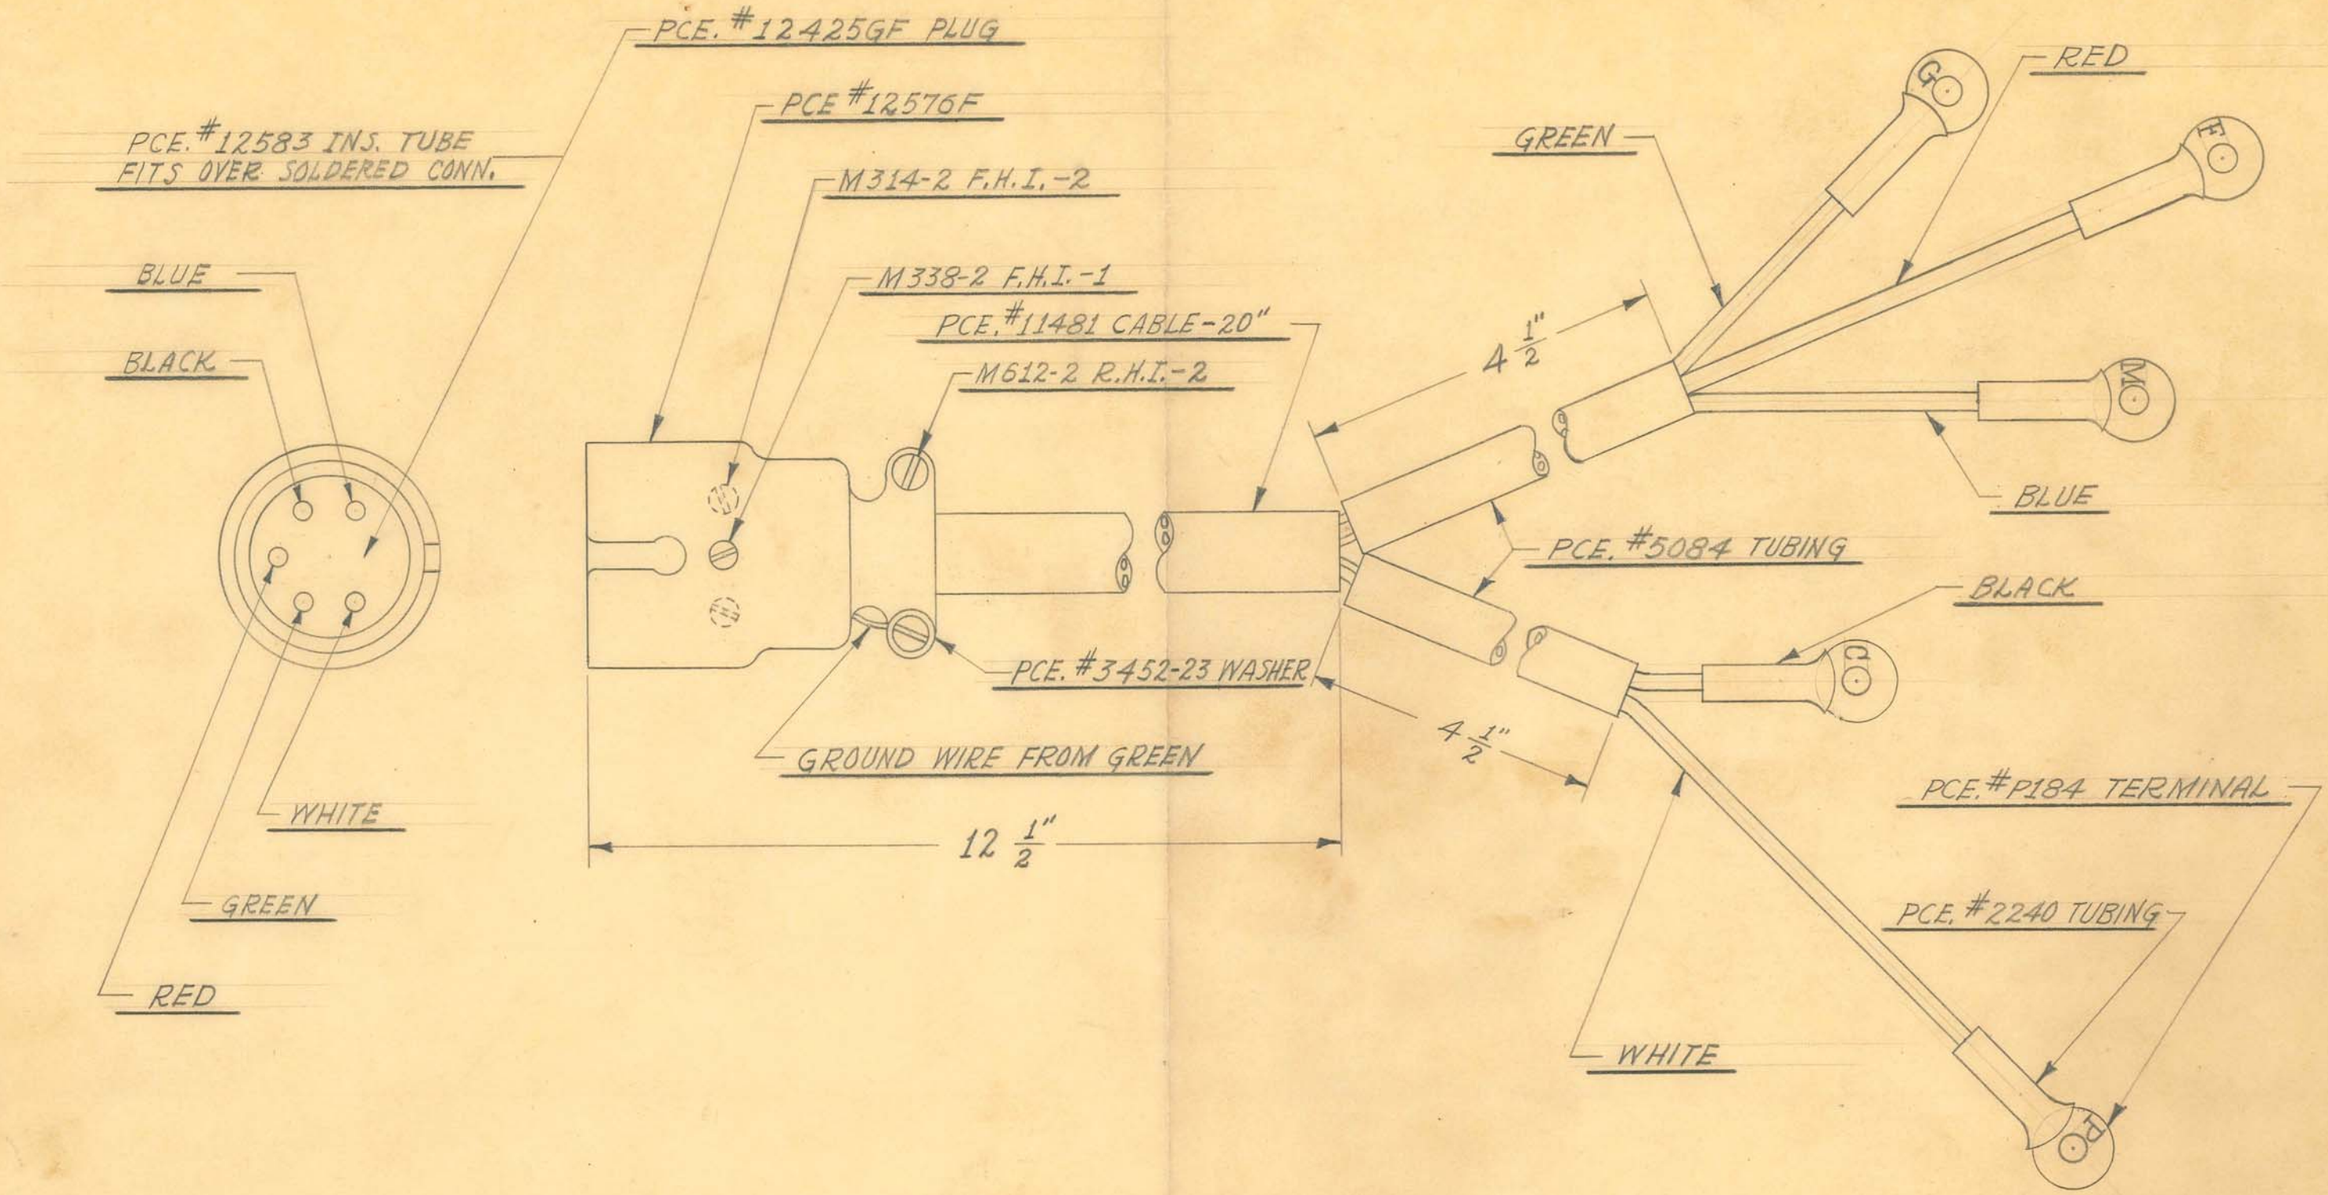

OBSOLETE

SIZE		ISSUE 3-25-40	J.W.
KIND		CHANGED	
SHAPE		"	
FINISH		"	
TEMP.		"	
PATT.		"	

TITLE: FISCHER MOD. "GF" S.P. FLUOROSCOPE TRANSF. CABLE CONN. CORD ASSEMBLY

H. G. FISCHER & CO.
2335 WABANSIA AVE.
CHICAGO. ILL.

CAT. NO.

PART NO. 12580G

#69 (.0292") DRILL

4-"V" GROOVES FOR GASKET APPROX. 1/64" DEEP.

#73 (.024") DRILL

1 3/8" — 7/16" — 3/4"

1/16" — 1/16" — 1/4" — 1/16"

1/2" X 27 THD.

60°

11/16" — 9/16" — 7/16" — 1/2" — 15/16"

11/32" DRILL

#19 DRILL

1 1/2" — 1 1/2" — 1 9/16" — 3/4"

15°

1" — 1 1/4"

1 13/16" R.

13/16" R.

9/16" R.

60° — 60°

#65 (.035") DRILL

#56 (.0465") DRILL

#51 (.067") DRILL

1/4" REAMED

#36 (.1065") DRILL

1/16" — 1/2"

1/16" — 5/8"

1/32" — 23/32"

3/4"

6 HLS. #9 DRILL

4 HLS. #10X32 TAP

45° — 45°

"V" GROOVE FOR GASKET APPROX. 1/64" DEEP

SCALE ~ 1" = 1/2"

1 REQUIRED

SIZE	FROM 10480 1/2	ISSUE 6-29-39	J.W.	TITLE: FISCHER SYNCHROTIMED BUCKY CYLINDER HEAD VALVE (.5 TO 25 SEC.)
KIND	BRASS CASTING	CHANGED		
SHAPE		"		
FINISH		"		
TEMP.		"		
PATT.	8987-1077	"		

OBSOLETE

H. G. FISCHER & CO. 2338 WABANSIA AVE. CHICAGO, ILL. | CAT. NO. | PART NO. 12587

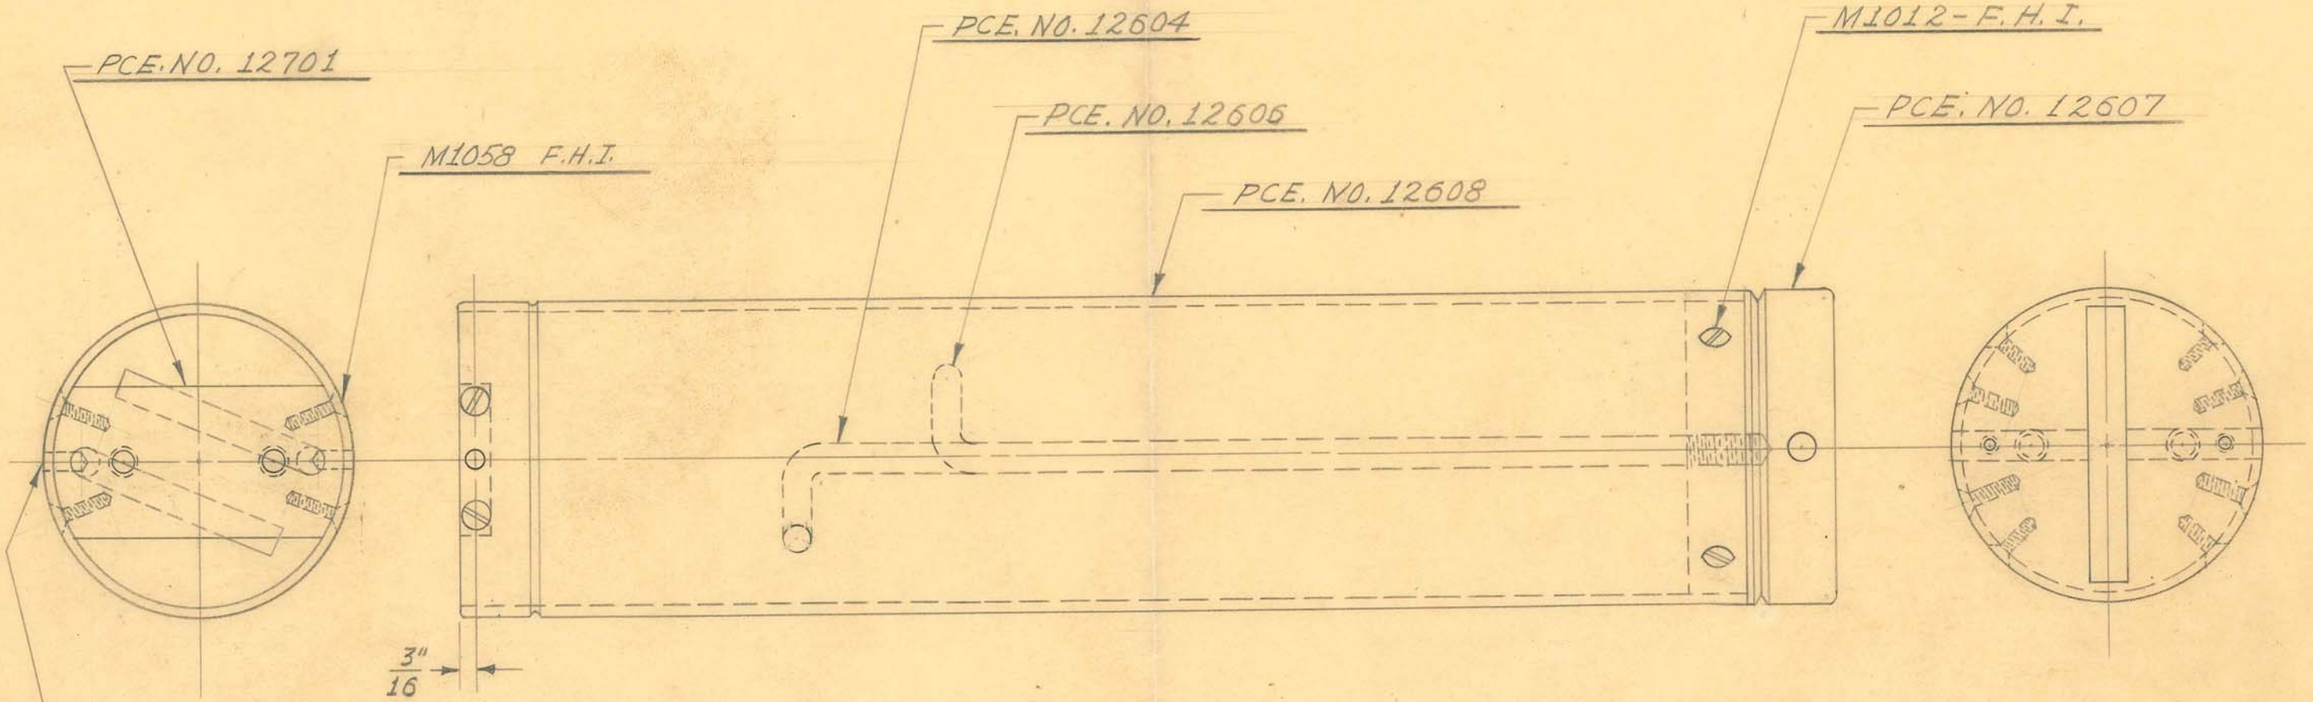

SCREW PLATE IN PLACE - 2 HLS - "E" DRILL $\frac{1}{4}$" DEEP - (IN CENTER OF PLATE) - FOR $\frac{1}{4}$" DIAM. C.R. STEEL PIN - $\frac{1}{2}$" LONG. - DRIVE IN PIN & FILE TO CONTOUR OF TUBE.

SCREW RODS INTO TOP CAP AS SHOWN. FASTEN TUBE TO TOP CAP WITH #10X32 SCREWS. FILL WITH LEAD TO MAKE TOTAL WEIGHT OF 82 LBS.

1 REQUIRED

OBSOLETE
Obsolete

SIZE		ISSUE 8-14-39	J.W.
KIND		CHANGED	
SHAPE		"	
FINISH		"	
TEMP.		"	
PATT.		"	

TITLE: FISCHER MOD. "TM-30-96" MOBILE SHOCKPROOF X-RAY UNIT - COUNTERWEIGHT ASSEMBLY

H. G. FISCHER & CO.
2335 WABANSIA AVE.
CHICAGO, ILL.

CAT. NO.

PART NO. 12605G

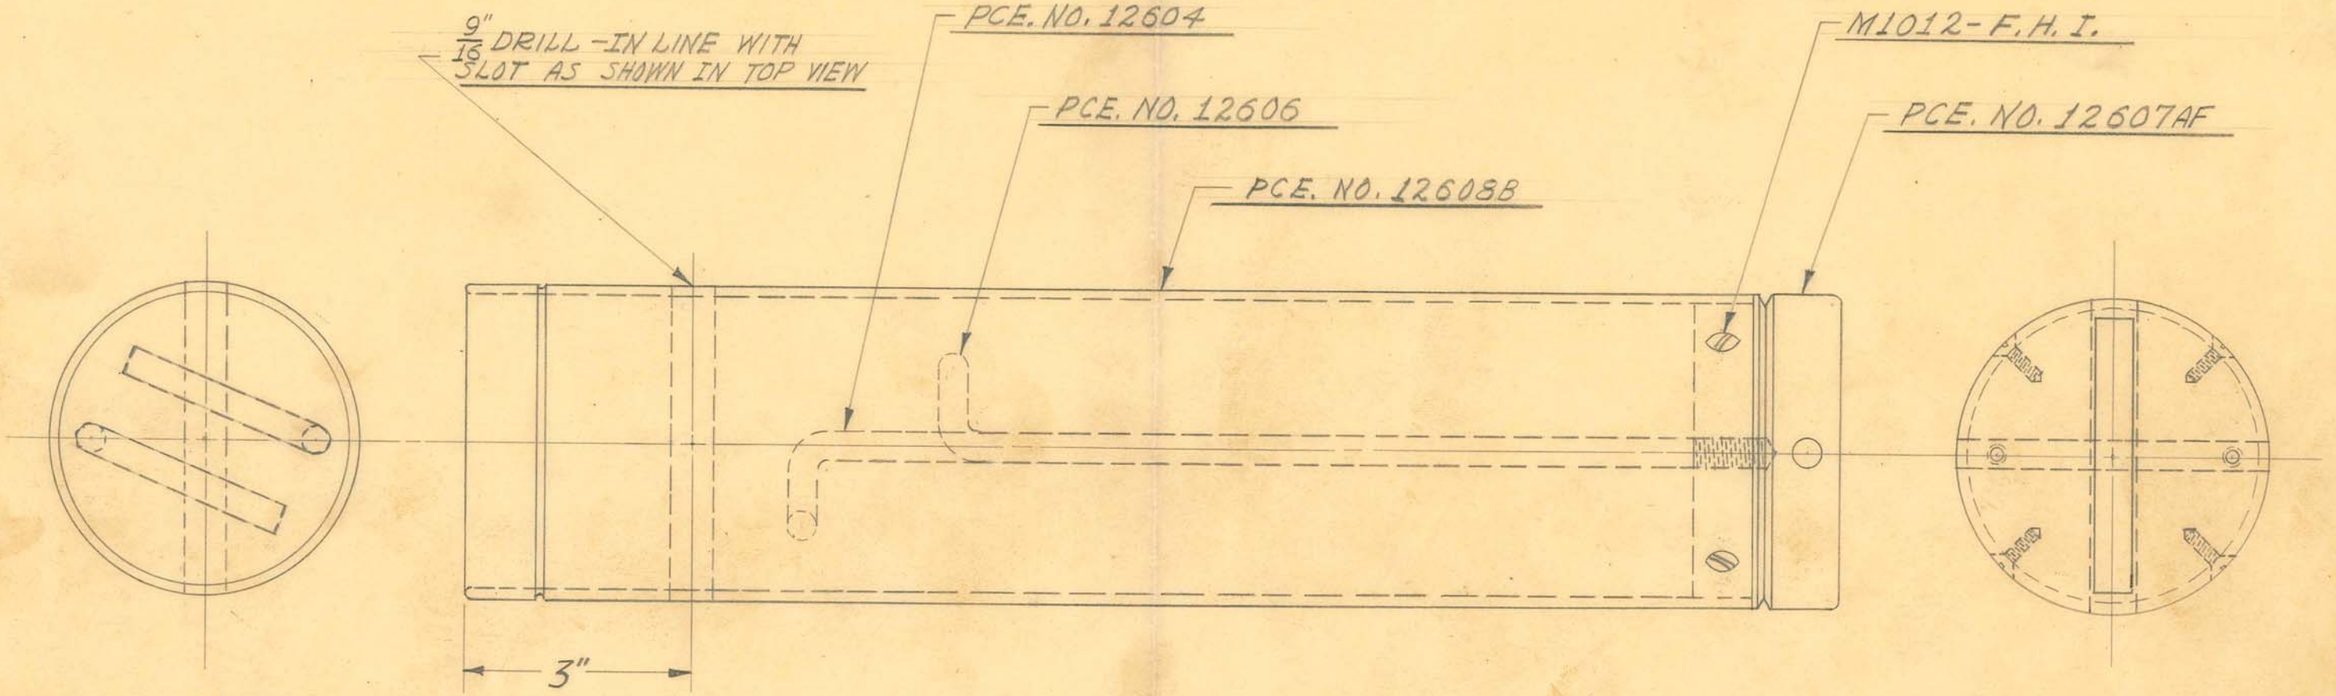

SCREW RODS INTO TOP CAP AS SHOWN. FASTEN TUBE TO TOP CAP WITH #10X32 SCREWS FILL WITH LEAD TO MAKE TOTAL WEIGHT OF 85 LBS.

1 REQUIRED

OBSOLETE

SIZE		ISSUE 8-8-40	J.V.W.
KIND		CHANGED 9-12-40	J.V.W.
SHAPE		"	
FINISH		"	
TEMP.		"	
PATT.		"	

TITLE: FISCHER MOD. "TM-30-96" MOBILE SHOCKPROOF X-RAY UNIT - COUNTERWEIGHT ASSEMBLY

H. G. FISCHER & CO.
2335 WABANSIA AVE.
CHICAGO, ILL.

CAT. NO.

PART NO. 12605GC

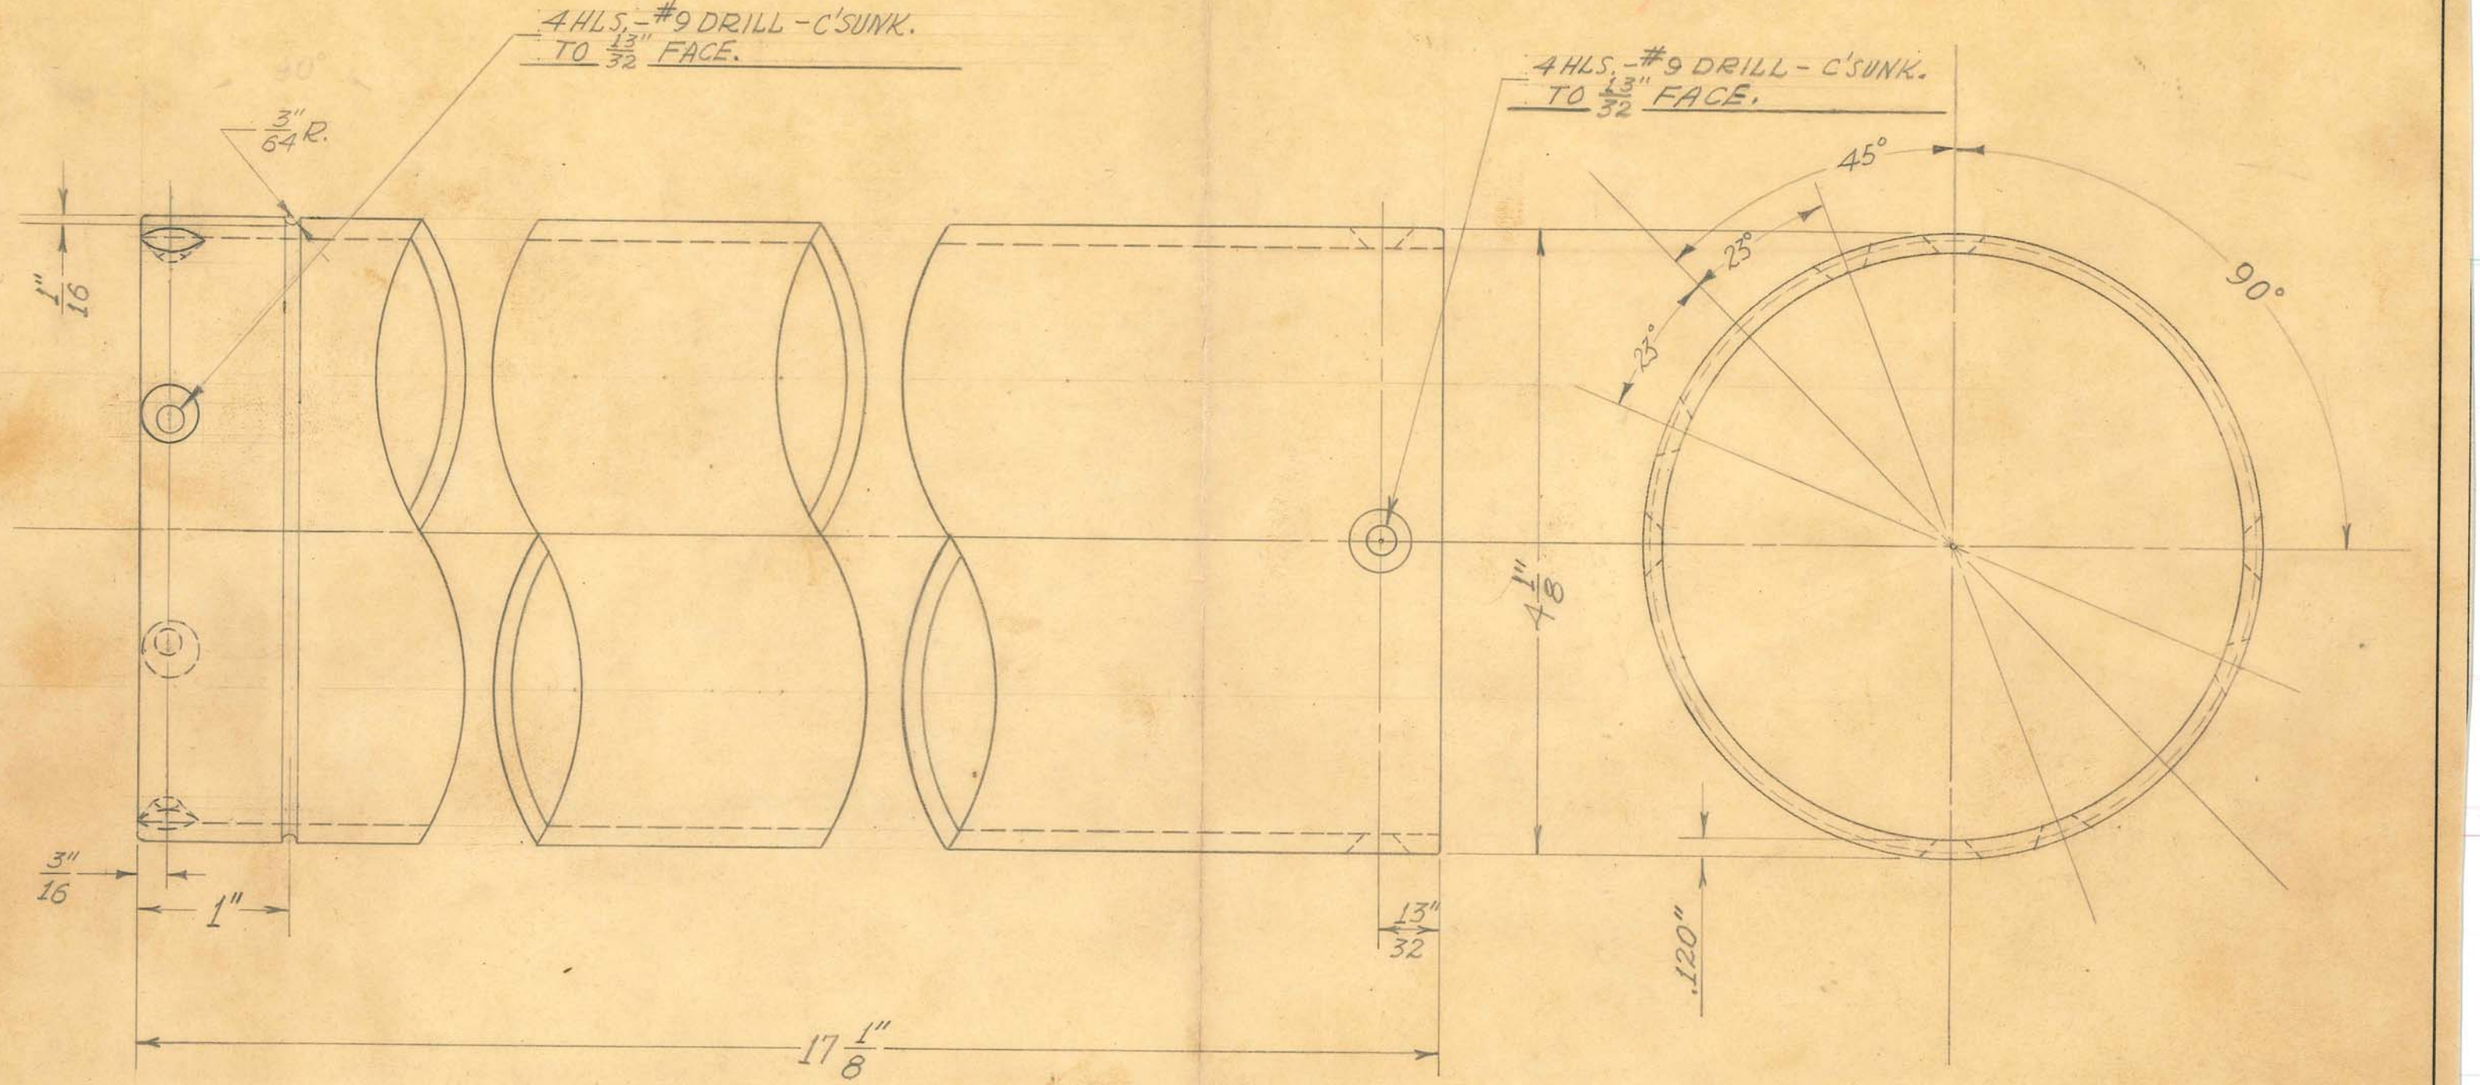

4 1/8" O.D. x #11 GA. (.120") WALL SHELBY SEAMLESS STEEL TUBING

1 REQUIRED

OBSOLETE

obsolete

SIZE		ISSUE 6-7-39	J.W.	**TITLE:** FISCHER MOD. "TM-30-96" MOBILE SHOCKPROOF X-RAY UNIT COUNTERWEIGHT TUBE
KIND		CHANGED		
SHAPE		"		
FINISH		"		
TEMP.		"		
PATT.		"		

H. G. FISCHER & CO.
2335 WABANSIA AVE.
CHICAGO, ILL.

CAT. NO.

PART NO. 12608

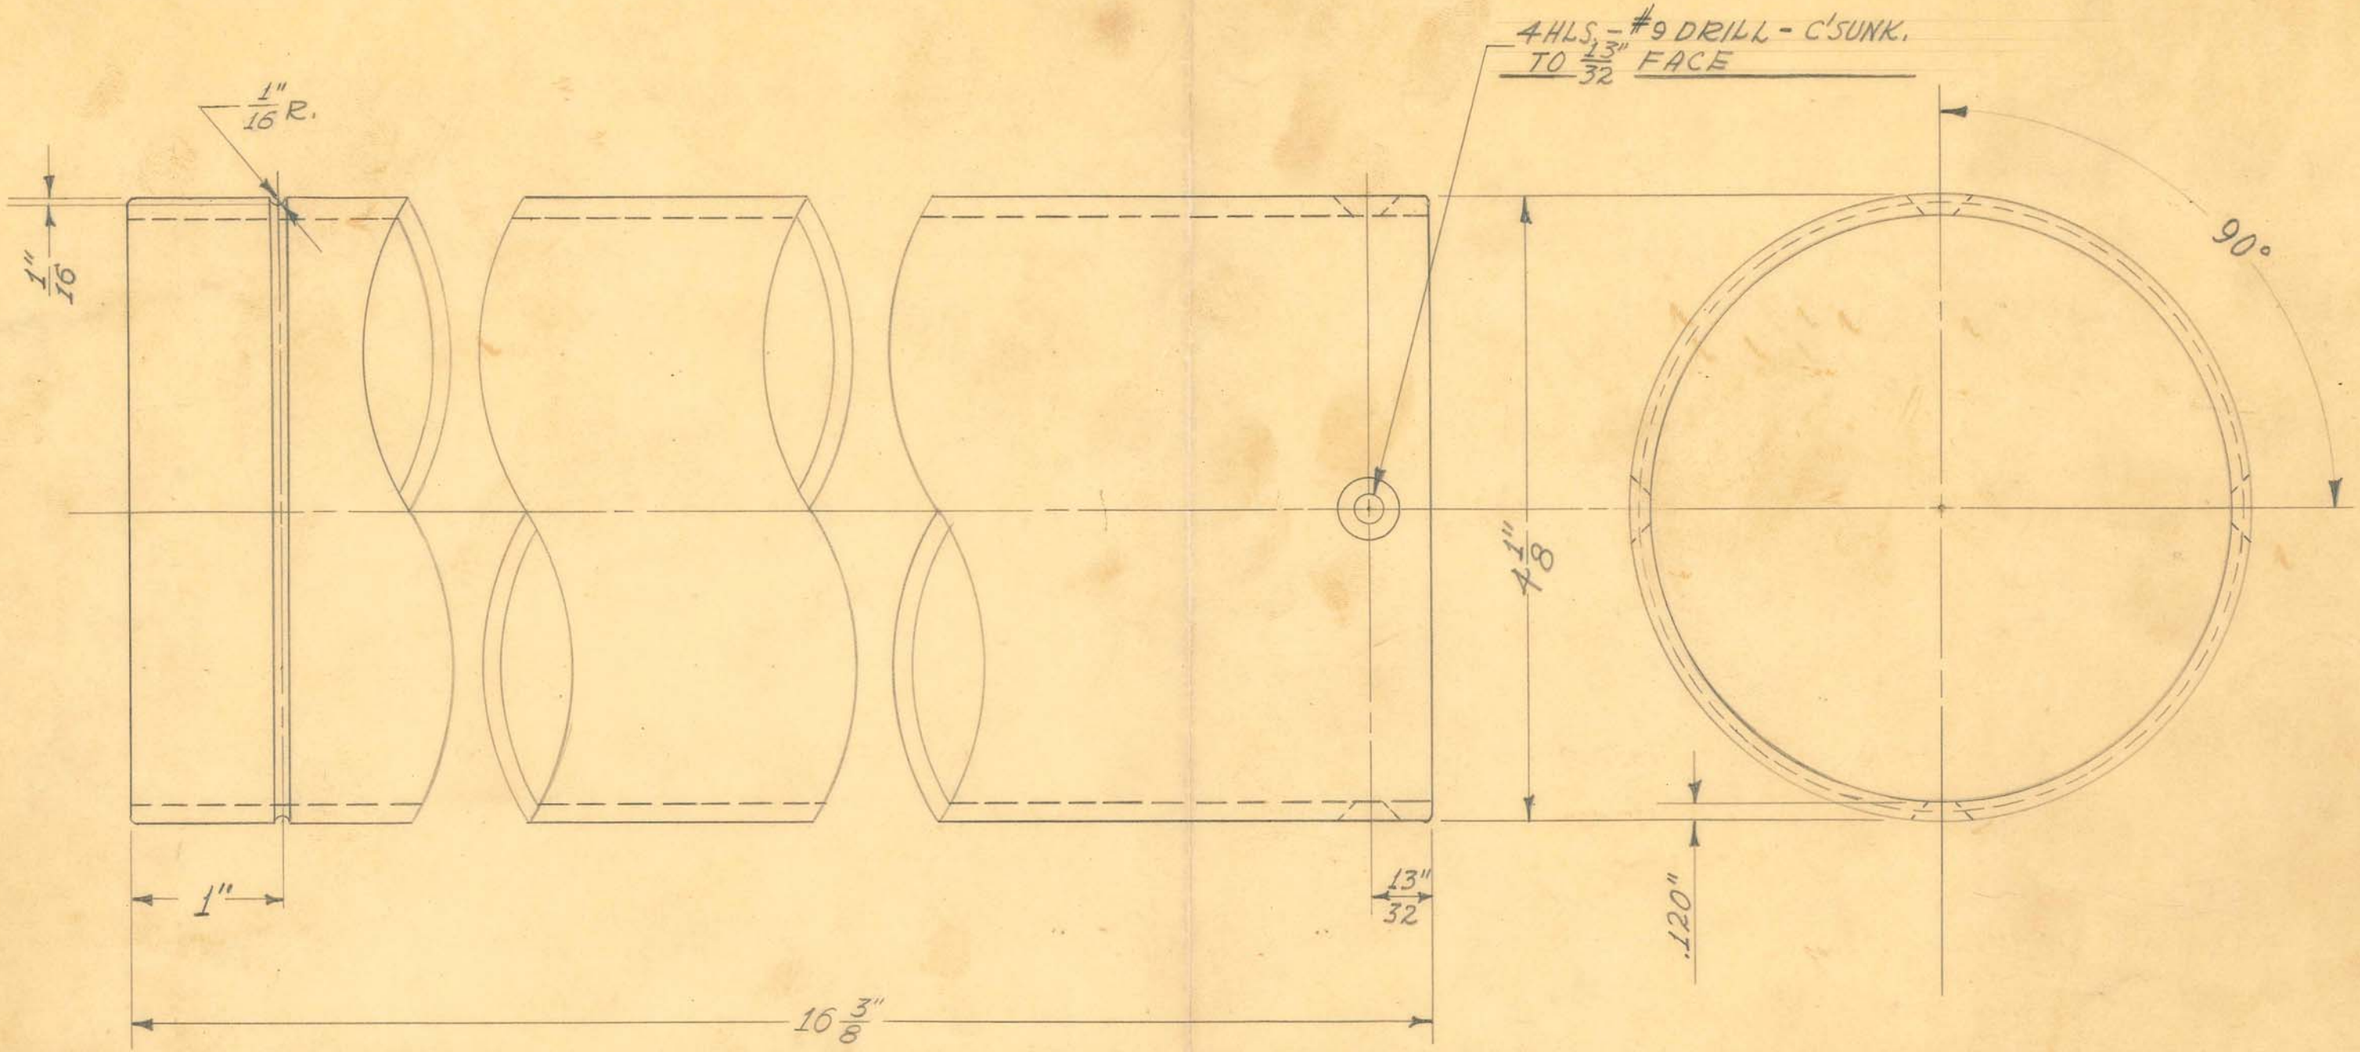

4 1/8" O.D. X #11 GA. (.120") WALL SHELBY SEAMLESS STEEL TUBING

1 REQUIRED

OBSOLETE

SIZE		ISSUE 8-8-40	J.V.W.	TITLE: FISCHER MOD. "TM-30-95" MOBILE SHOCKPROOF X-RAY UNIT COUNTERWEIGHT TUBE
KIND		CHANGED 9-12-40	J.V.W.	
SHAPE		"		
FINISH		"		
TEMP.		"		H. G. FISCHER & CO. 2338 WABANSIA AVE. CHICAGO, ILL. — CAT. NO. — PART NO. 12608B
PATT.		"		

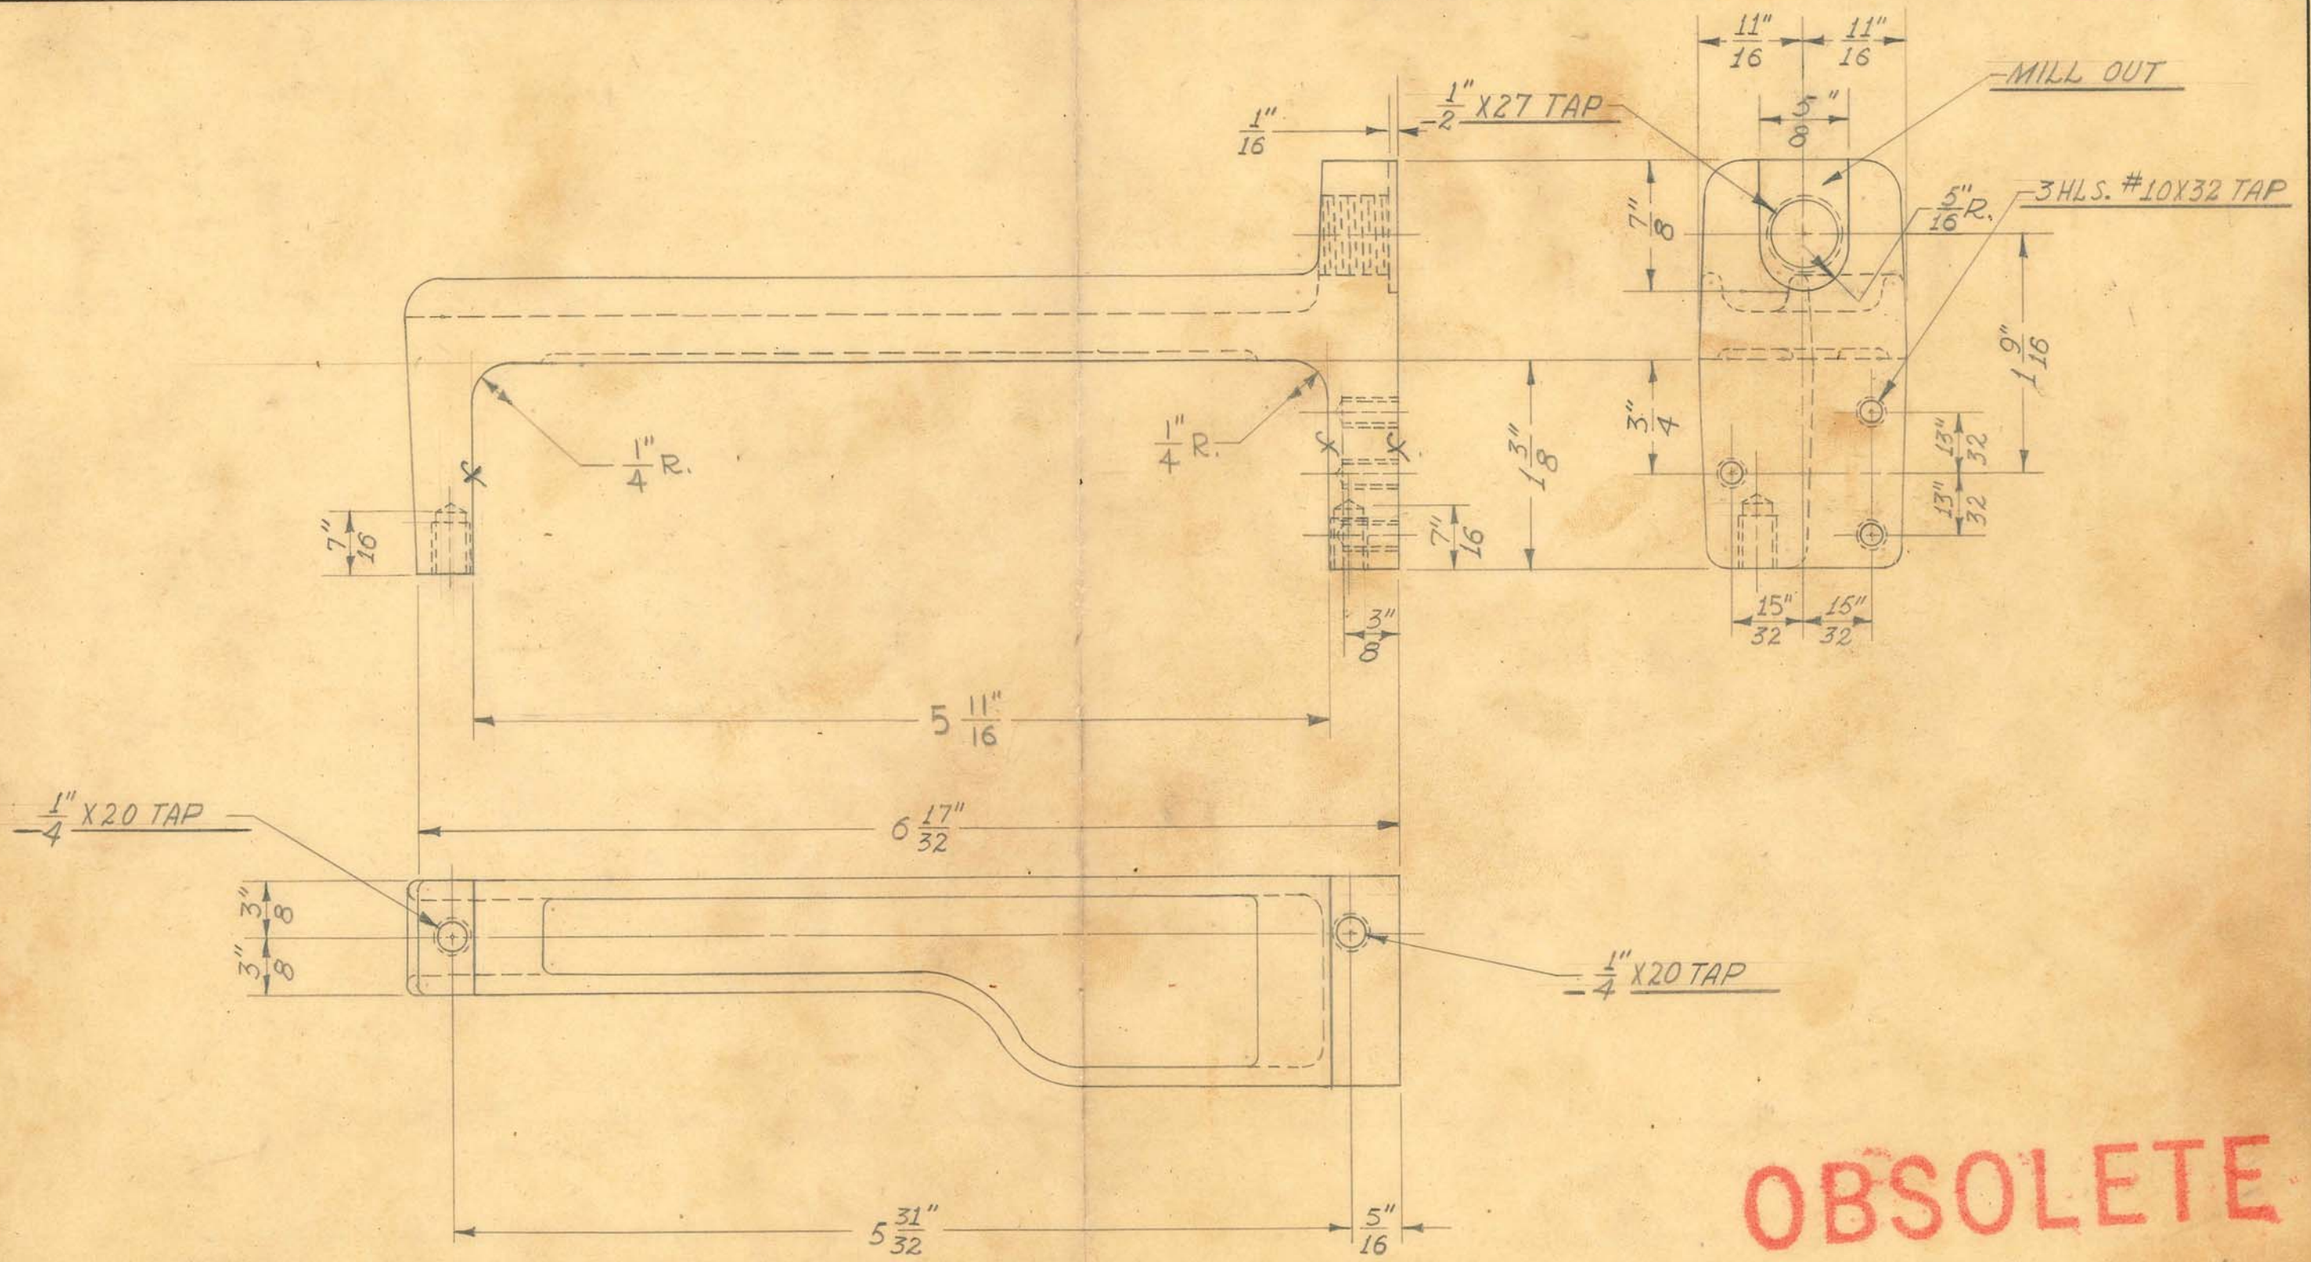

OBSOLETE

1 REQUIRED

Obsolete

SIZE	#214	ISSUE 7-12-39	J.W.
KIND	ALUM. CASTING	CHANGED 6-2-42	J.W.
SHAPE		"	
FINISH		"	
TEMP.		"	
PATT.	1361	"	

TITLE:
FISCHER MOD. "TM-30-96" MOBILE SHOCKPROOF X-RAY UNIT — TRANSFORMER SUPPORT - LEFT

H. G. FISCHER & CO.
2335 WABANSIA AVE.
CHICAGO, ILL.

CAT. NO.

PART NO. 12611FA

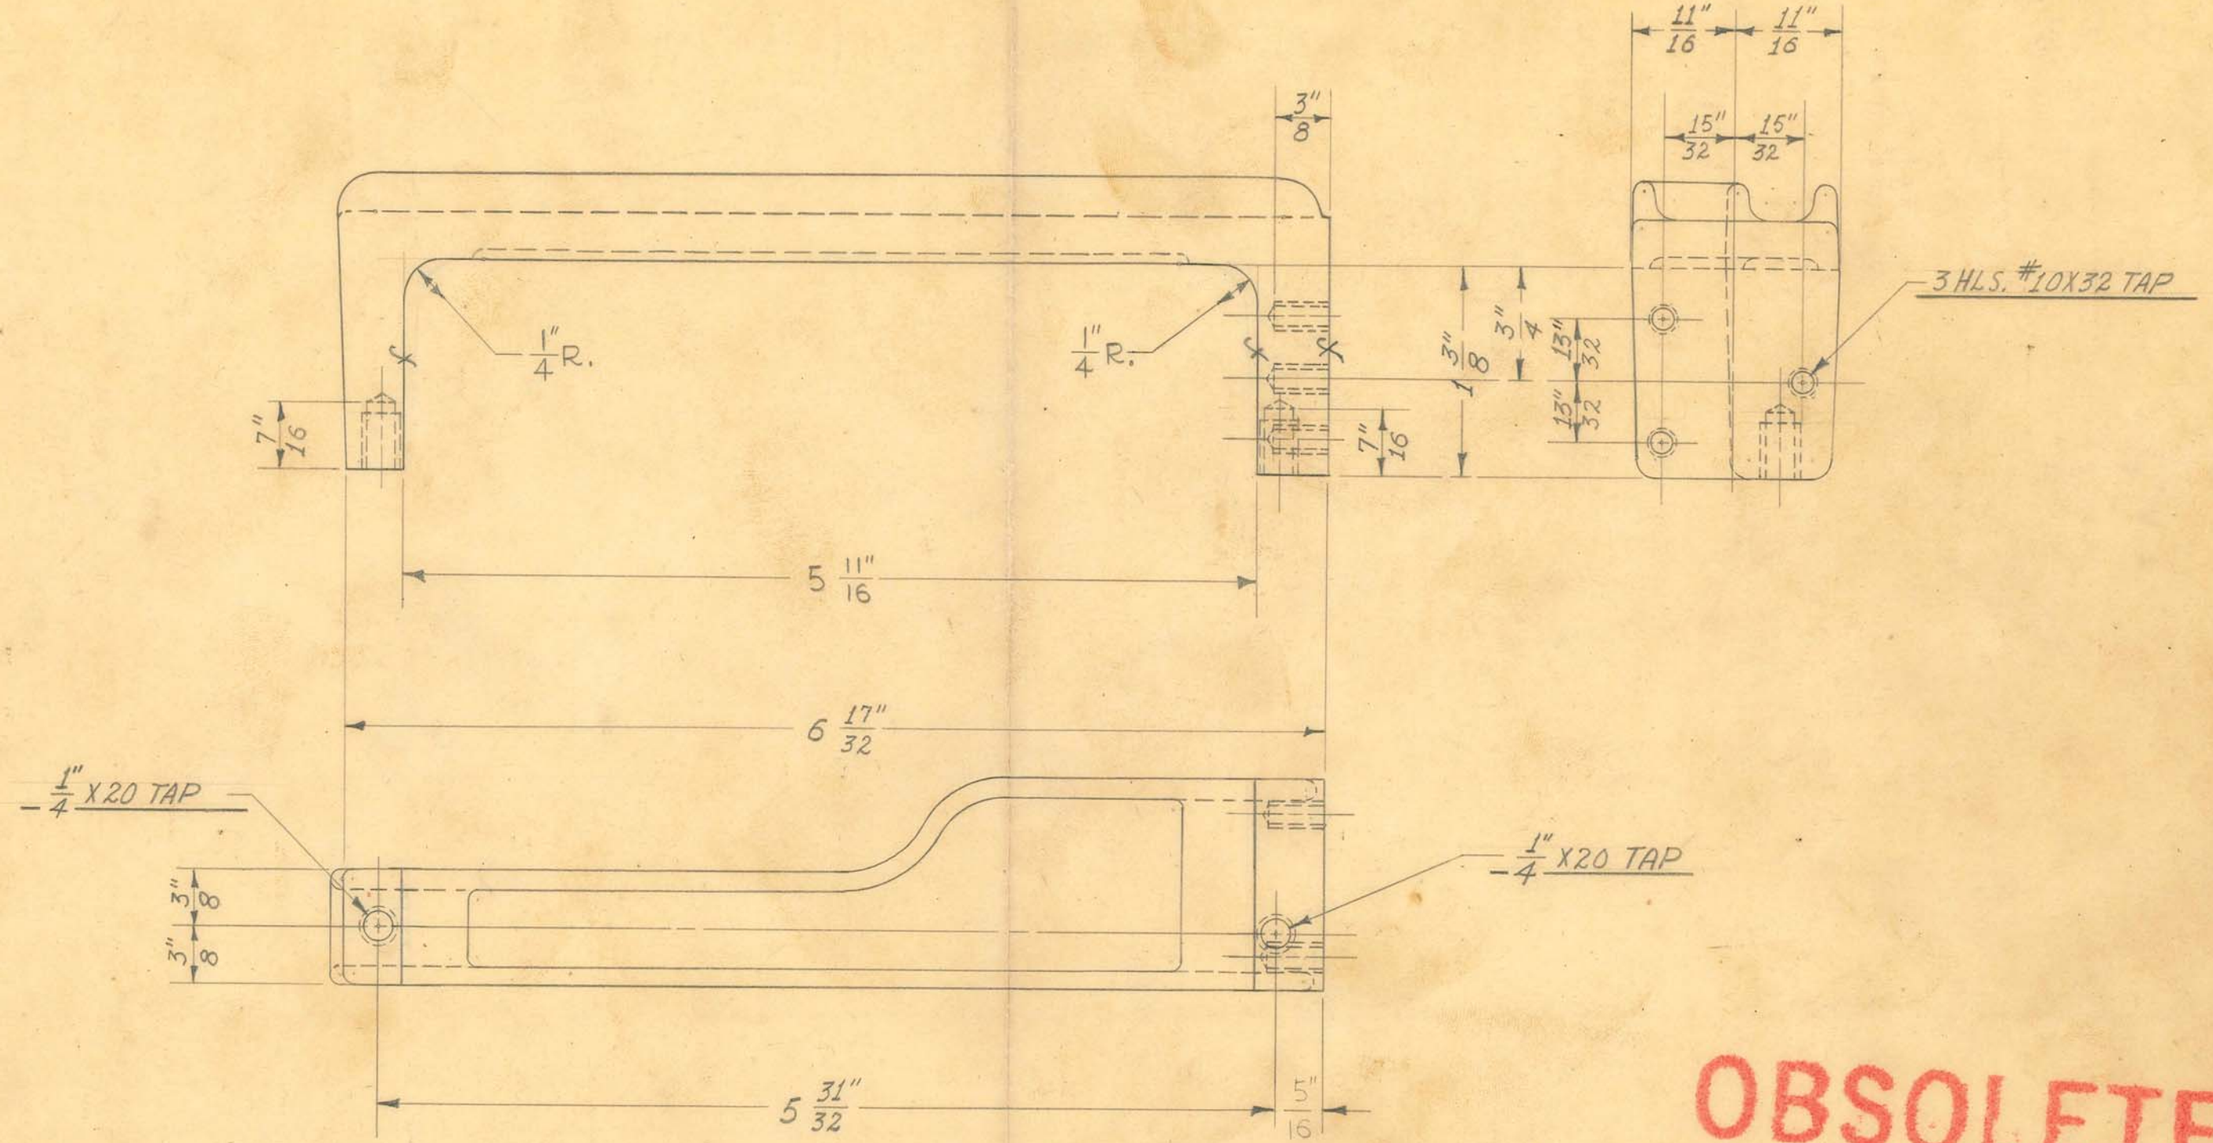

OBSOLETE

1 REQUIRED

Obsolete

SIZE	#214	ISSUE 7-12-39	J.W.	TITLE: FISCHER MOD. "TM-30-96" MOBILE SHOCKPROOF X-RAY UNIT TRANSFORMER SUPPORT-RIGHT
KIND	ALUM. CASTING	CHANGED 6-2-42	J.W.	
SHAPE		"		
FINISH		"		
TEMP.		"		
PATT.	1362	"		

H. G. FISCHER & CO.
2338 WABANSIA AVE.
CHICAGO, ILL.

CAT. NO.

PART NO. 12612FA

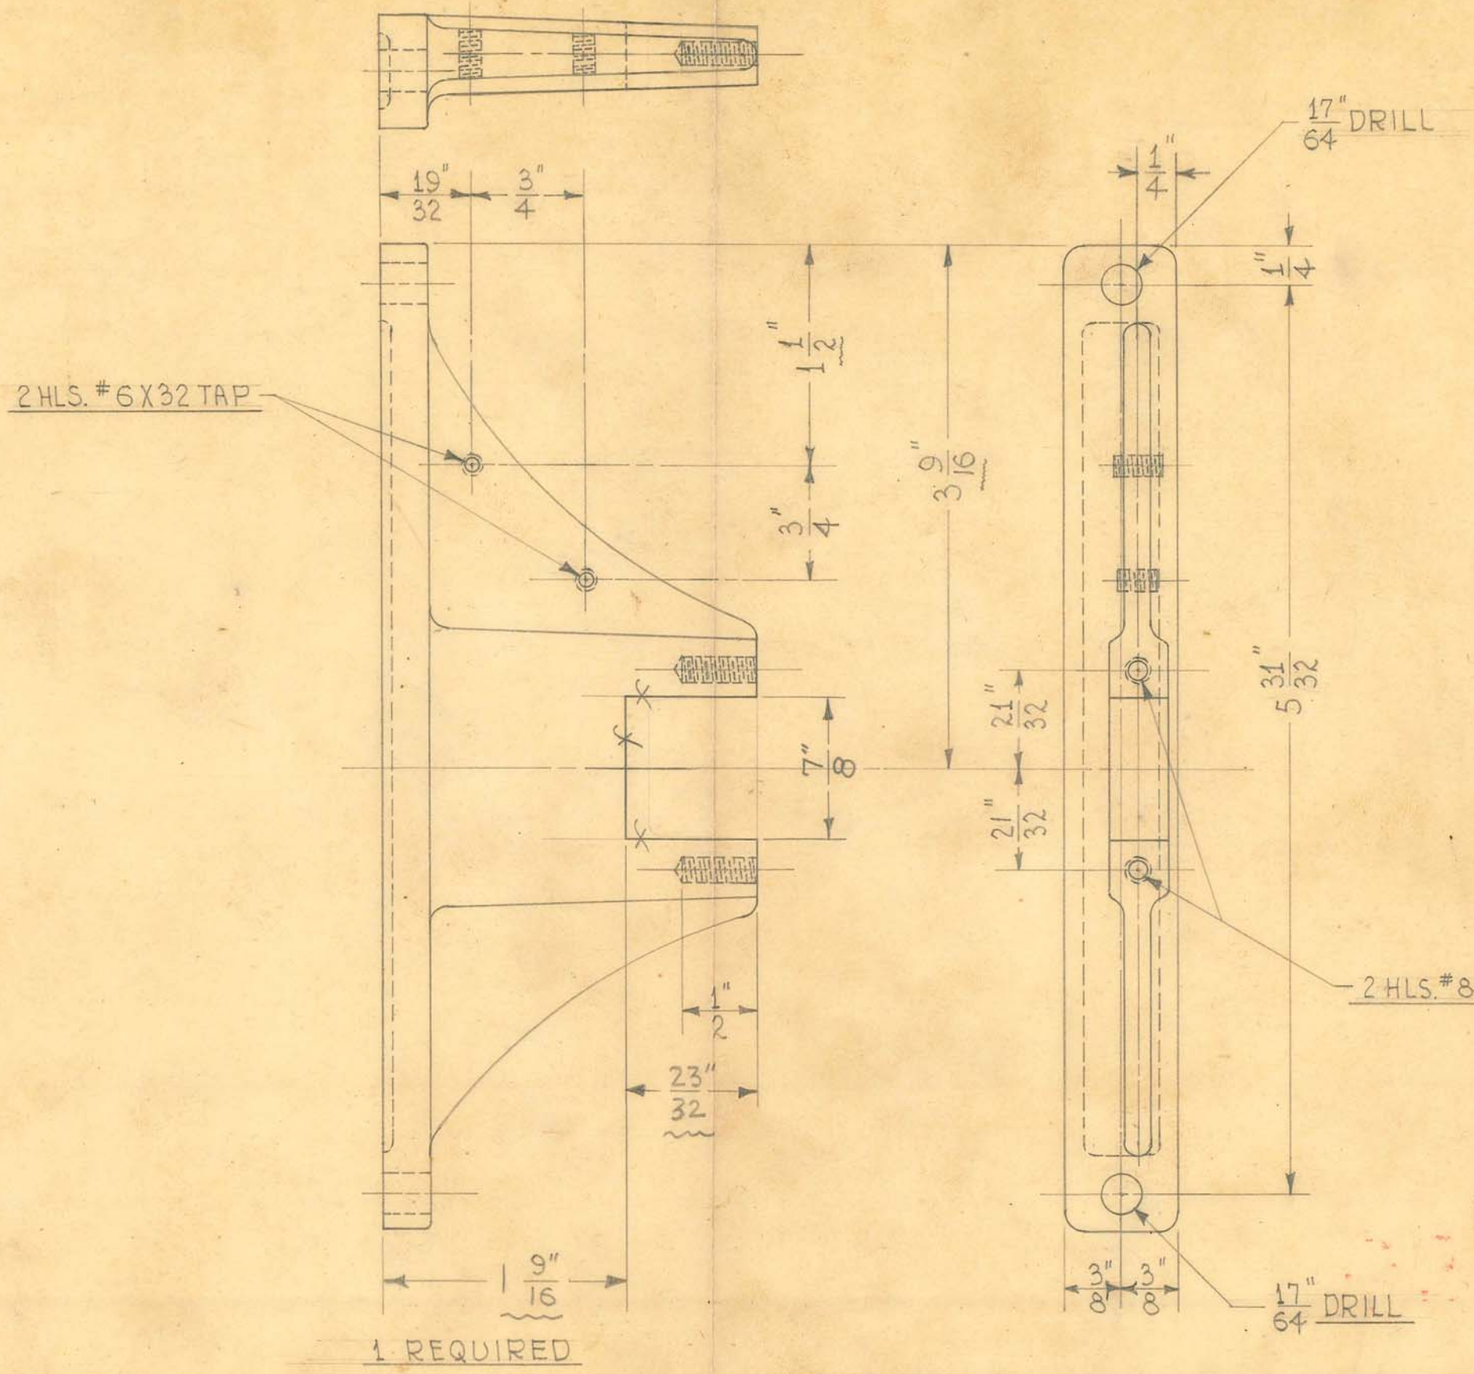

1 REQUIRED

OBSOLETE

SIZE		ISSUE 6-27-39	H.E.
KIND	IRON CASTING	CHANGED 6-2-42	J.V.W.
SHAPE		"	
FINISH		"	
TEMP.		"	
PATT.	1363	"	

TITLE:
FISCHER MOD. "TM-30-96" MOBILE SHOCKPROOF
X-RAY UNIT - TRANSF. CLAMP & FIL. TRANSF. SUPP. - RIGHT

H. G. FISCHER & CO.
2335 WABANSIA AVE.
CHICAGO, ILL.

CAT. NO.

PART NO. 12613FA

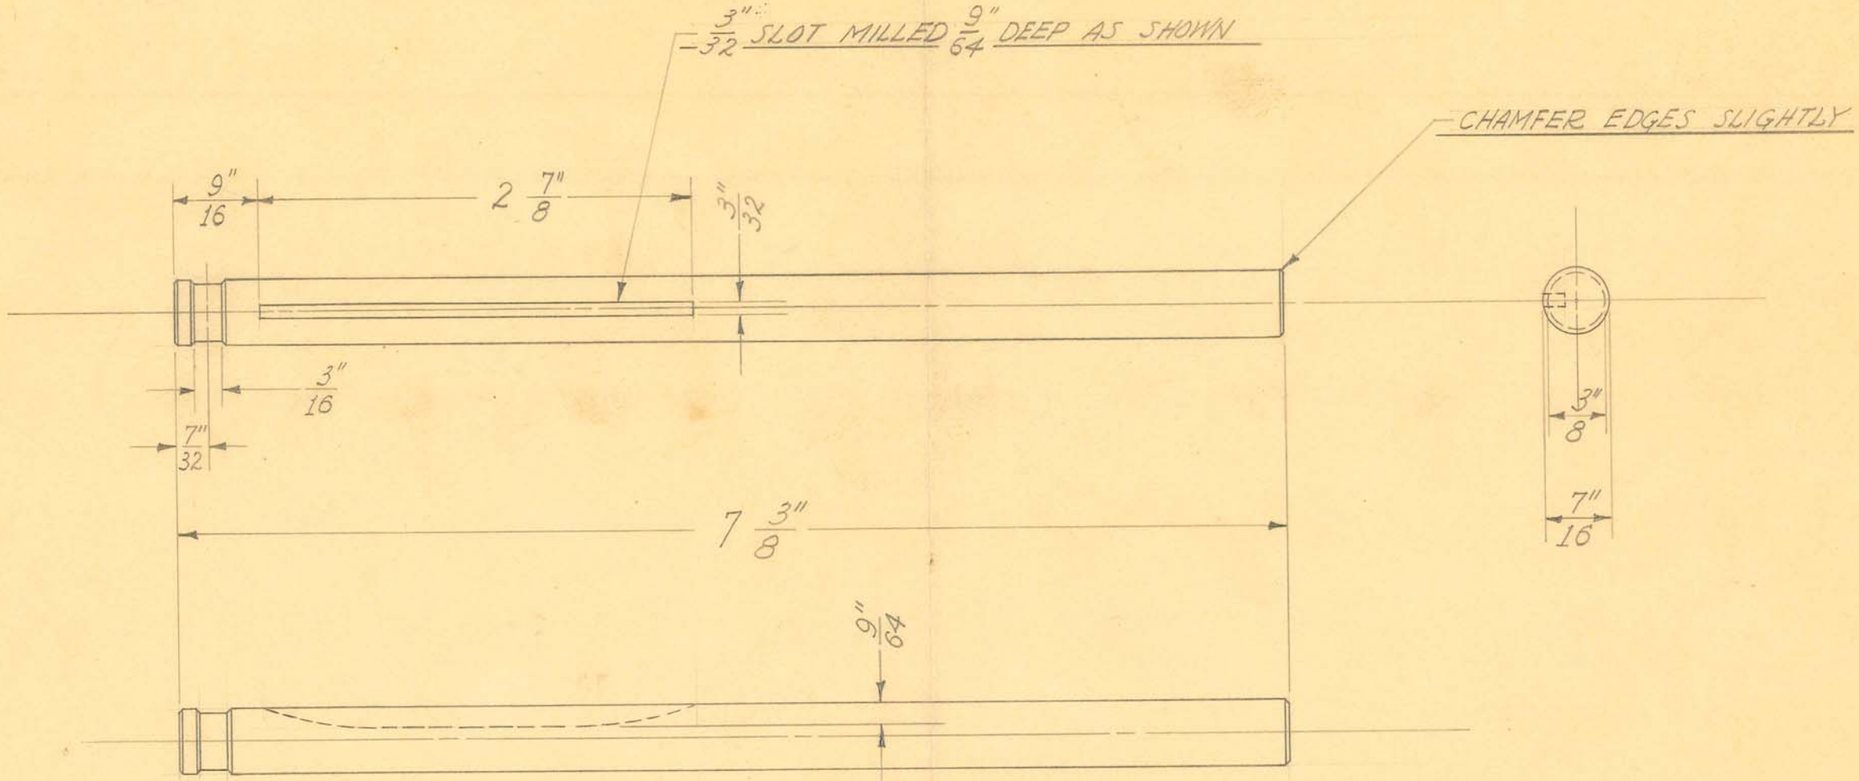

1 REQUIRED

OBSOLETE

SIZE	7/16" DIAM.	ISSUE 5-12-38	J.W.
KIND	JEWELERS ROD	CHANGED	
SHAPE		"	
FINISH		"	
TEMP.		"	
PATT.		"	

TITLE: FISCHER MOD. "J" GALV. & CONT. CURR. GEN. SURGE UNIT - COLLECTOR RING SHAFT

H. G. FISCHER & CO.
2335 WABANSIA AVE.
CHICAGO, ILL.

CAT. NO.

PART NO. 11166

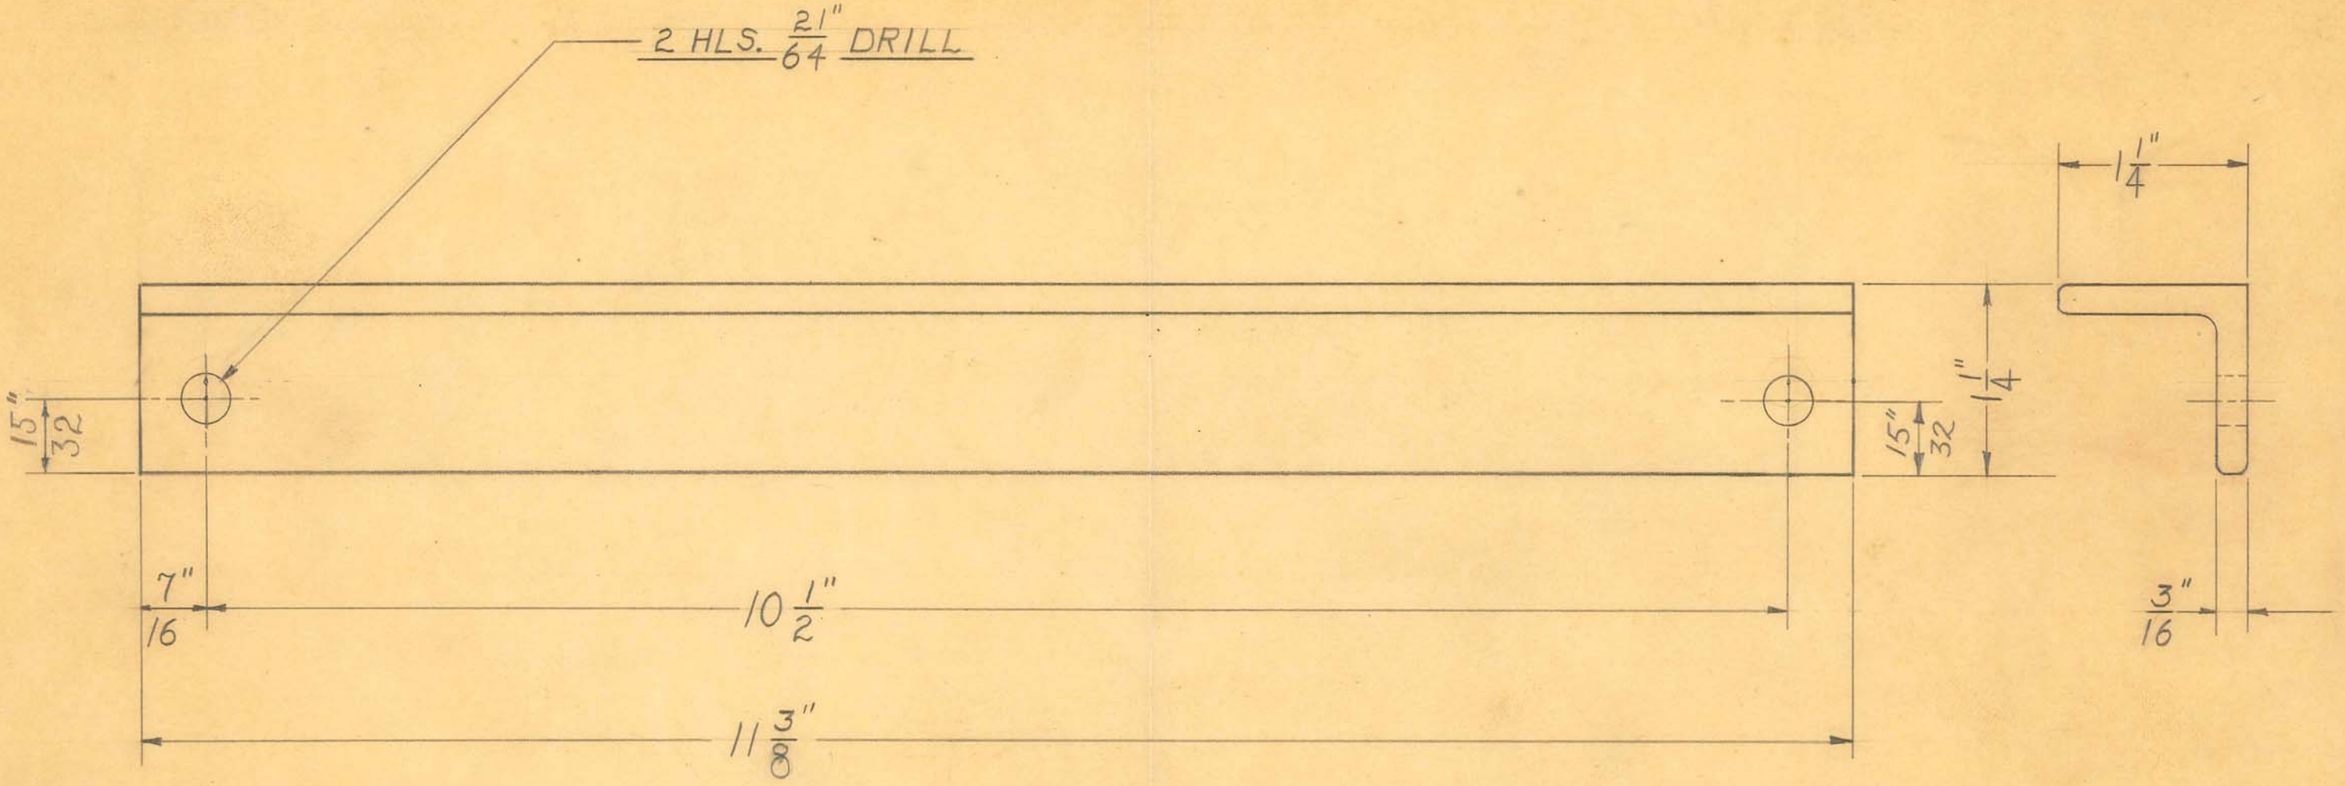

2 REQUIRED

OBSOLETE

1 1/4" X 1 1/4" X 3/16" ANGLE IRON

DRILL JIG TOOL #9346

SIZE		ISSUE 6-24-47	W.J.	TITLE: FISCHER "PRECISION 200" X-RAY UNIT POWER TRANSF. CLAMP
KIND		CHANGED	.	
SHAPE		"		
FINISH	BLACK #80	"		
TEMP.		"		
PATT.		"		

H. G. FISCHER & CO.
2335 WABANSIA AVE.
CHICAGO, ILL.

CAT. NO.

PART NO. 16912

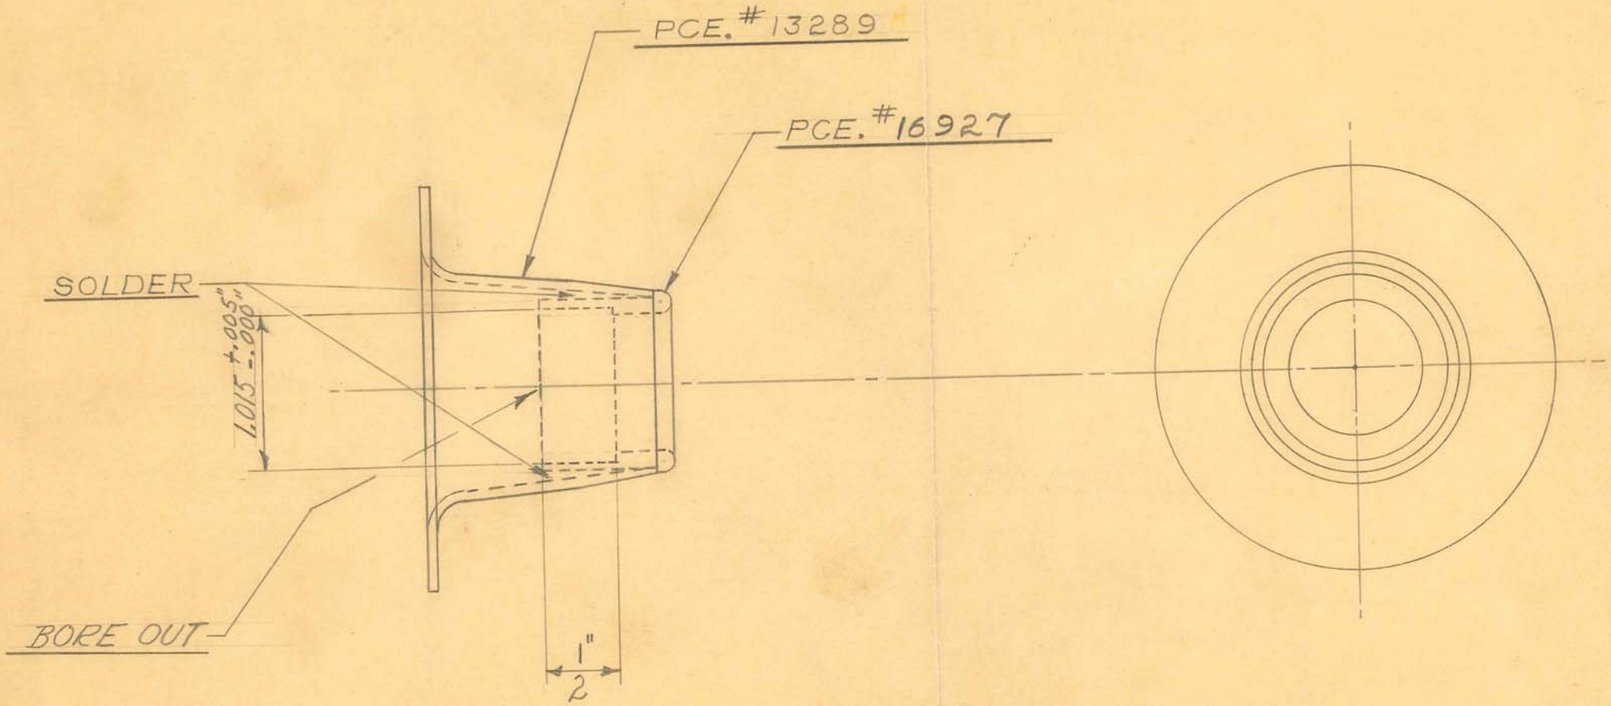

2 REQUIRED

OBSOLETE

OBSOLETE
11-16-47

SIZE		ISSUE 6-26-47	W.J.
KIND		CHANGED	
SHAPE		"	
FINISH	CAD. #23	"	
TEMP.		"	
PATT.		"	

TITLE:
FISCHER "PRECISION 200" X-RAY UNIT
H.T. TRANSF. CABLE CONE — ASSEMBLY

H. G. FISCHER & CO.
2335 WABANSIA AVE.
CHICAGO, ILL.

CAT. NO.

PART NO. 16926G

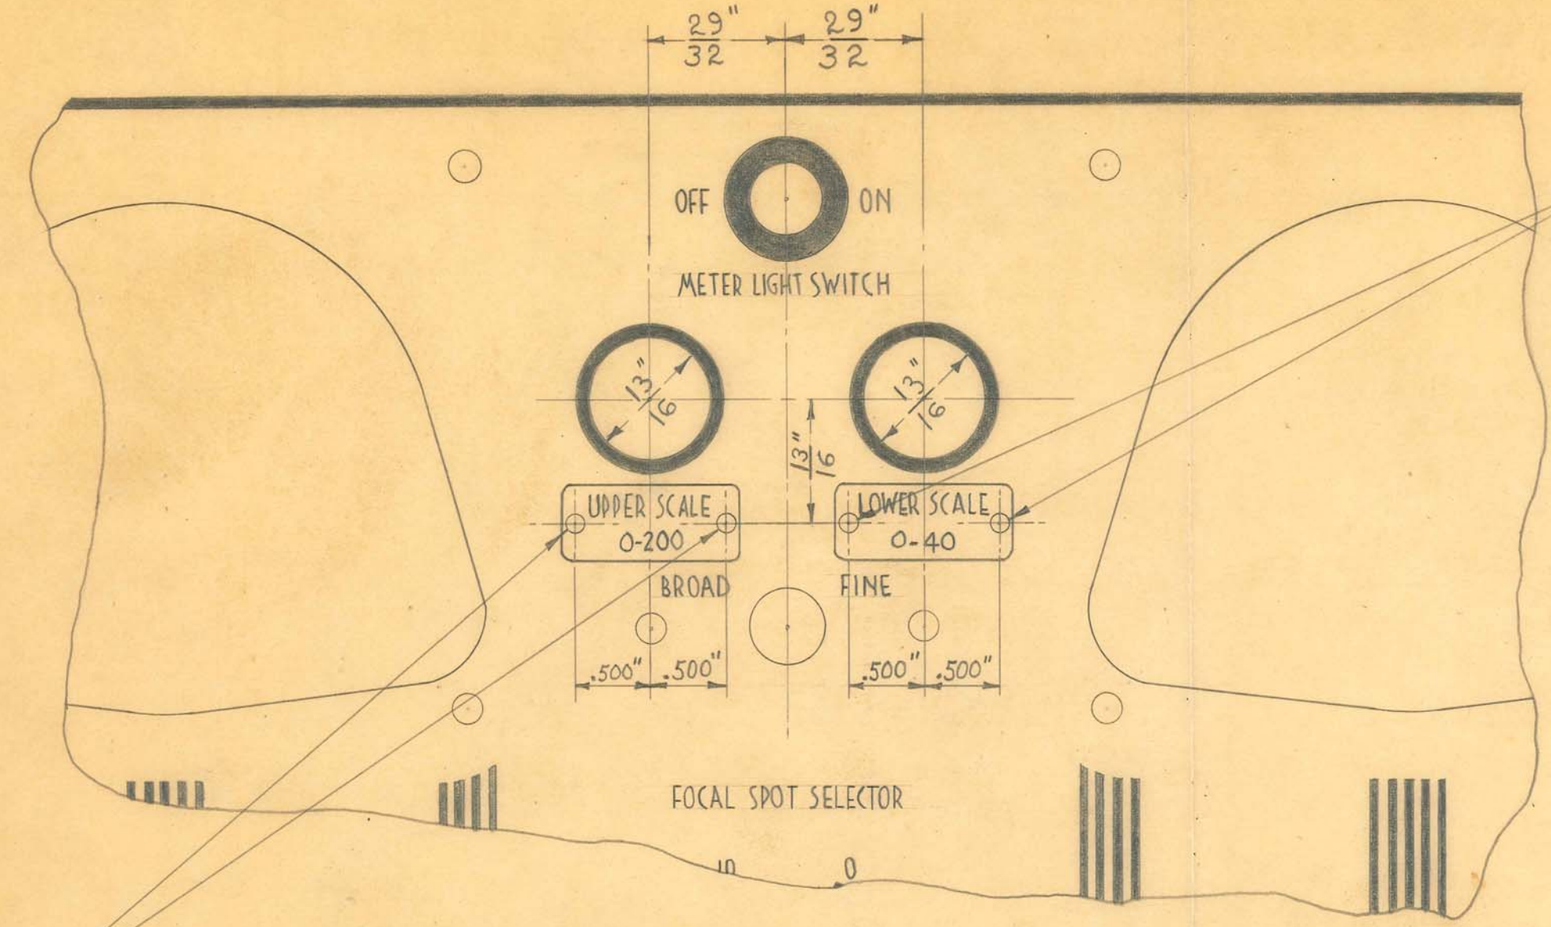

DRILL 2 HLS. #51 DRILL
C'SINK BOTTOM SIDE FOR
RIVETING. LAY PCE #16946 PLATE
IN PLACE. INSERT ESCUTCHEON
PINS & RIVET ON BACK SIDE.
FILE FLUSH WITH BOTTOM
OF DIAL PLATE.

DRILL 2 HLS. #51 DRILL
C'SINK BOTTOM SIDE FOR RIVETING
LAY PCE. #16947 PLATE IN PLACE
INSERT ESCUTCHEON PINS
& RIVET ON BACK SIDE
FILE FLUSH WITH BOTTOM
OF DIAL PLATE

1 REQUIRED

DRILL JIG TOOL #9425

DIMENSIONS	
FRACTIONAL	± .015
DECIMAL	± .005
ANGULAR	± ½°
UNLESS OTHERWISE SPECIFIED	

SIZE		ISSUE 7-28-47	W.J.	TITLE: FISCHER "PRECISION 200" X-RAY UNIT CONTROL DIAL PLATE
KIND		CHANGED		
SHAPE		"		
FINISH		"		
TEMP.		"		
PATT.		"		

H. G. FISCHER & CO.
2335 WABANSIA AVE.
CHICAGO, ILL.

CAT. NO.

PART NO. 16944G

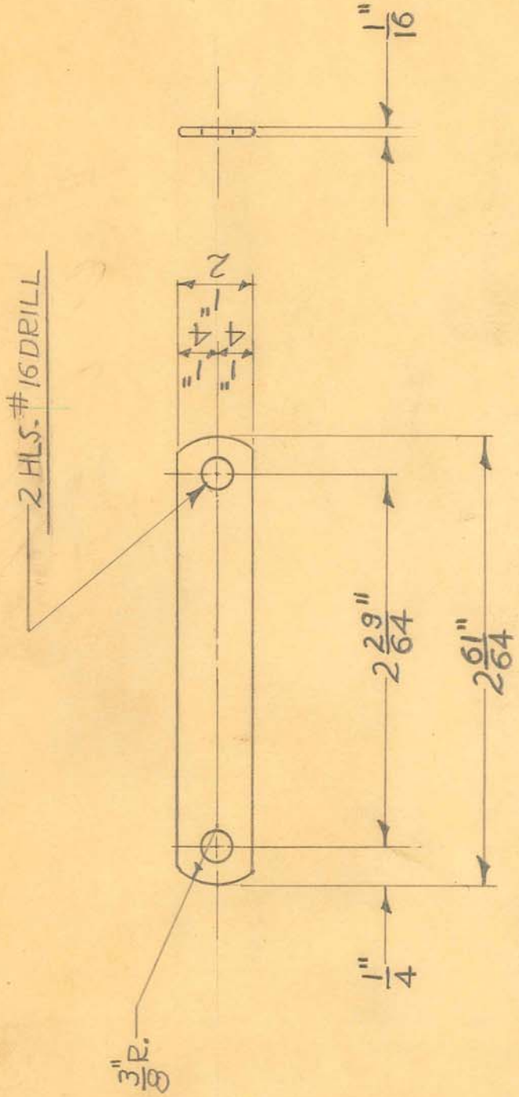

FIRST OPERATION

CUT OFF AND PERFORATING DIE TOOL # 721 BIN Y5
FORMING DIE TOOL # 6372 BIN Z 7

SEE CUT OFF DIE FOR PCE. # 8776 1/2

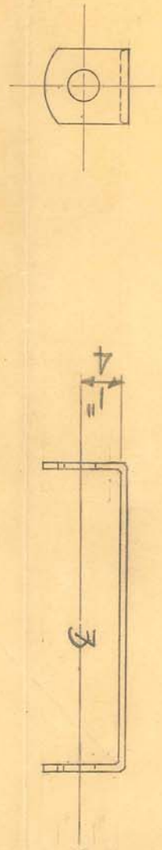

SECOND OPERATION

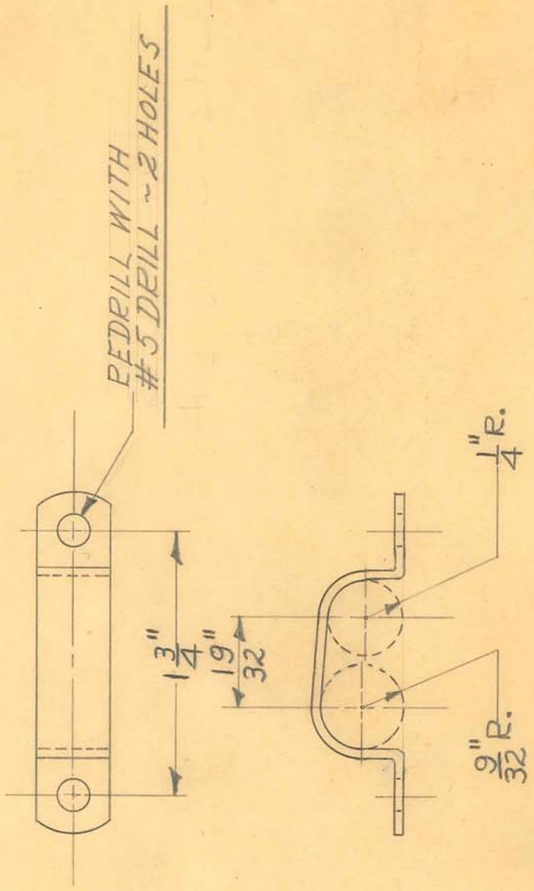

THIRD OPERATION

OBSOLETE

1 - REQUIRED

FORMING FIXTURE TOOL # 9500

SIZE	1/16" X 1/2"	ISSUE 10-24-47	J.M.F
KIND	FLAT WIRE	CHANGED	
SHAPE		"	
FINISH		"	
TEMP.		"	
PATT.		"	

TITLE: FISCHER PRECISION 200 X-RAY POWER CLAMP CABLE

H. G. FISCHER & CO.
2338 WABANSIA AVE.
CHICAGO, ILL.

CAT. NO.

PART NO. 16953

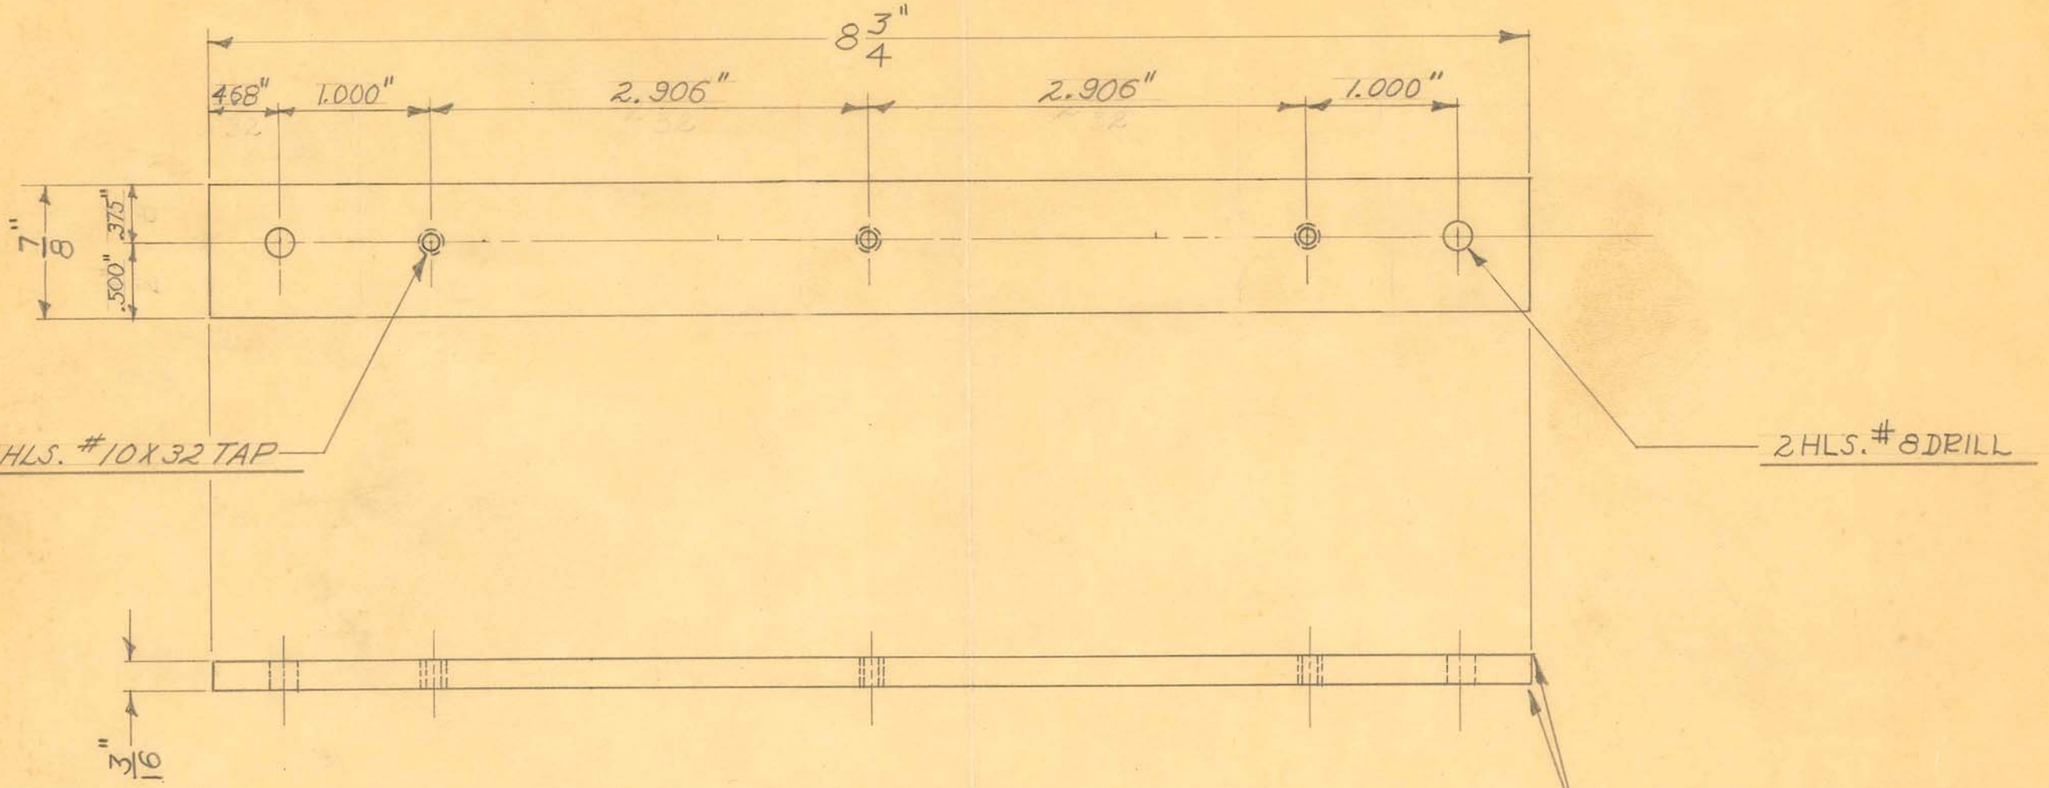

1- REQUIRED

OBSOLETE

DRILL JIG TOOL # 9493

DIMENSIONS
FRACTIONAL ± .015
DECIMAL ± .005
ANGULAR ± ½°
UNLESS OTHERWISE SPECIFIED

SIZE	3/16" X 7/8"	ISSUE 10-20-47	J.M.F
KIND	C.R. STEEL	CHANGED	
SHAPE	BAR	"	
FINISH	BLACK #80	"	
TEMP.		"	
PATT.		"	

TITLE: FISCHER PRECISION 200 X-RAY FIXED RESISTOR MTG. BOARD STRIP

H. G. FISCHER & CO.
2335 WABANSIA AVE.
CHICAGO, ILL.

CAT. NO.

PART NO. 16955

7 HOLES # 5 DRILL

1/2" DRILL

RUBBER STAMP LETTERS IN WHITE

10"

2.906" 2.906"

.625" .812" 1.375" 1.375" 1.375" 1.000" 1.187" 1.125"

H1 H2 X1 X2

4"

1.250"

.750"

1.000"

.625"

2.750"

.375" 4.500" 4.875"

1/4"

8 HLS. # 16 DRILL

1-REQUIRED

OBSOLETE

1/4" SHEET XX BLACK BAKELITE DRILL JIG TOOL # 9498

DIMENSIONS	
FRACTIONAL	± .015
DECIMAL	± .005
ANGULAR	± ½°
UNLESS OTHERWISE SPECIFIED	

SIZE		ISSUE 10-20-47	J.M.F	TITLE: FISCHER "PRECISION 200" X RAY FIXED RESISTOR TERMINAL BOARD
KIND		CHANGED		
SHAPE		"		
FINISH		"		
TEMP.		"		
PATT.		"		

H. G. FISCHER & CO.
2335 WABANSIA AVE.
CHICAGO, ILL.

CAT. NO.

PART NO. 16956

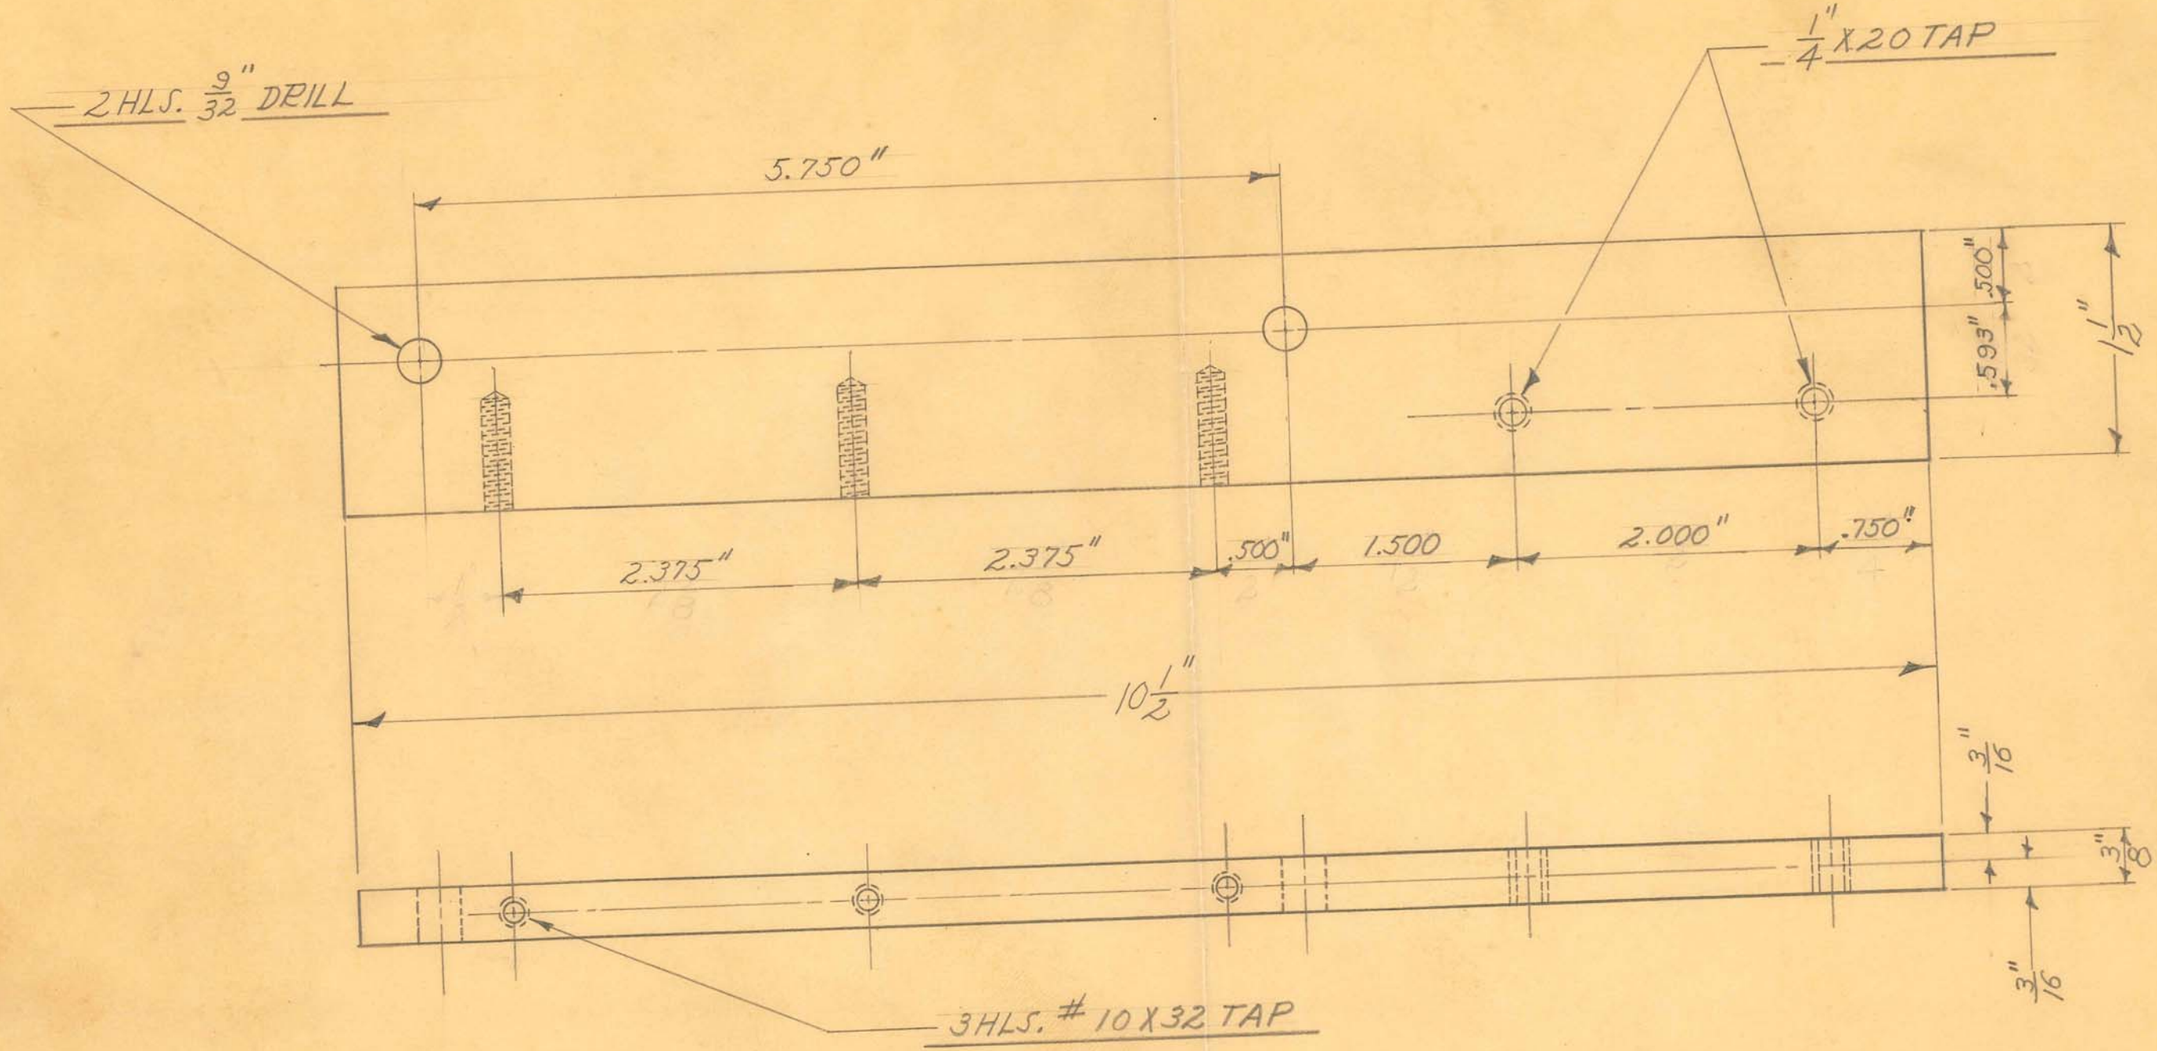

OBSOLETE

DRILL JIG TOOL # 9492

DIMENSIONS
FRACTIONAL ± .010
DECIMAL ± .005
ANGULAR ± ½°
UNLESS OTHERWISE SPECIFIED

SIZE	3/8" X 1 1/2"	ISSUE 10-20-47	J.M.F	TITLE: FISCHER PRECISION 200 X RAY TRANSFORMER CLAMP RIGHT
KIND	C.R. STEEL	CHANGED		
SHAPE	BAR	"		
FINISH	BLACK #80	"		
TEMP.		"		
PATT.		"		

H. G. FISCHER & CO.
2335 WABANSIA AVE.
CHICAGO, ILL.

CAT. NO.

PART NO. 16958

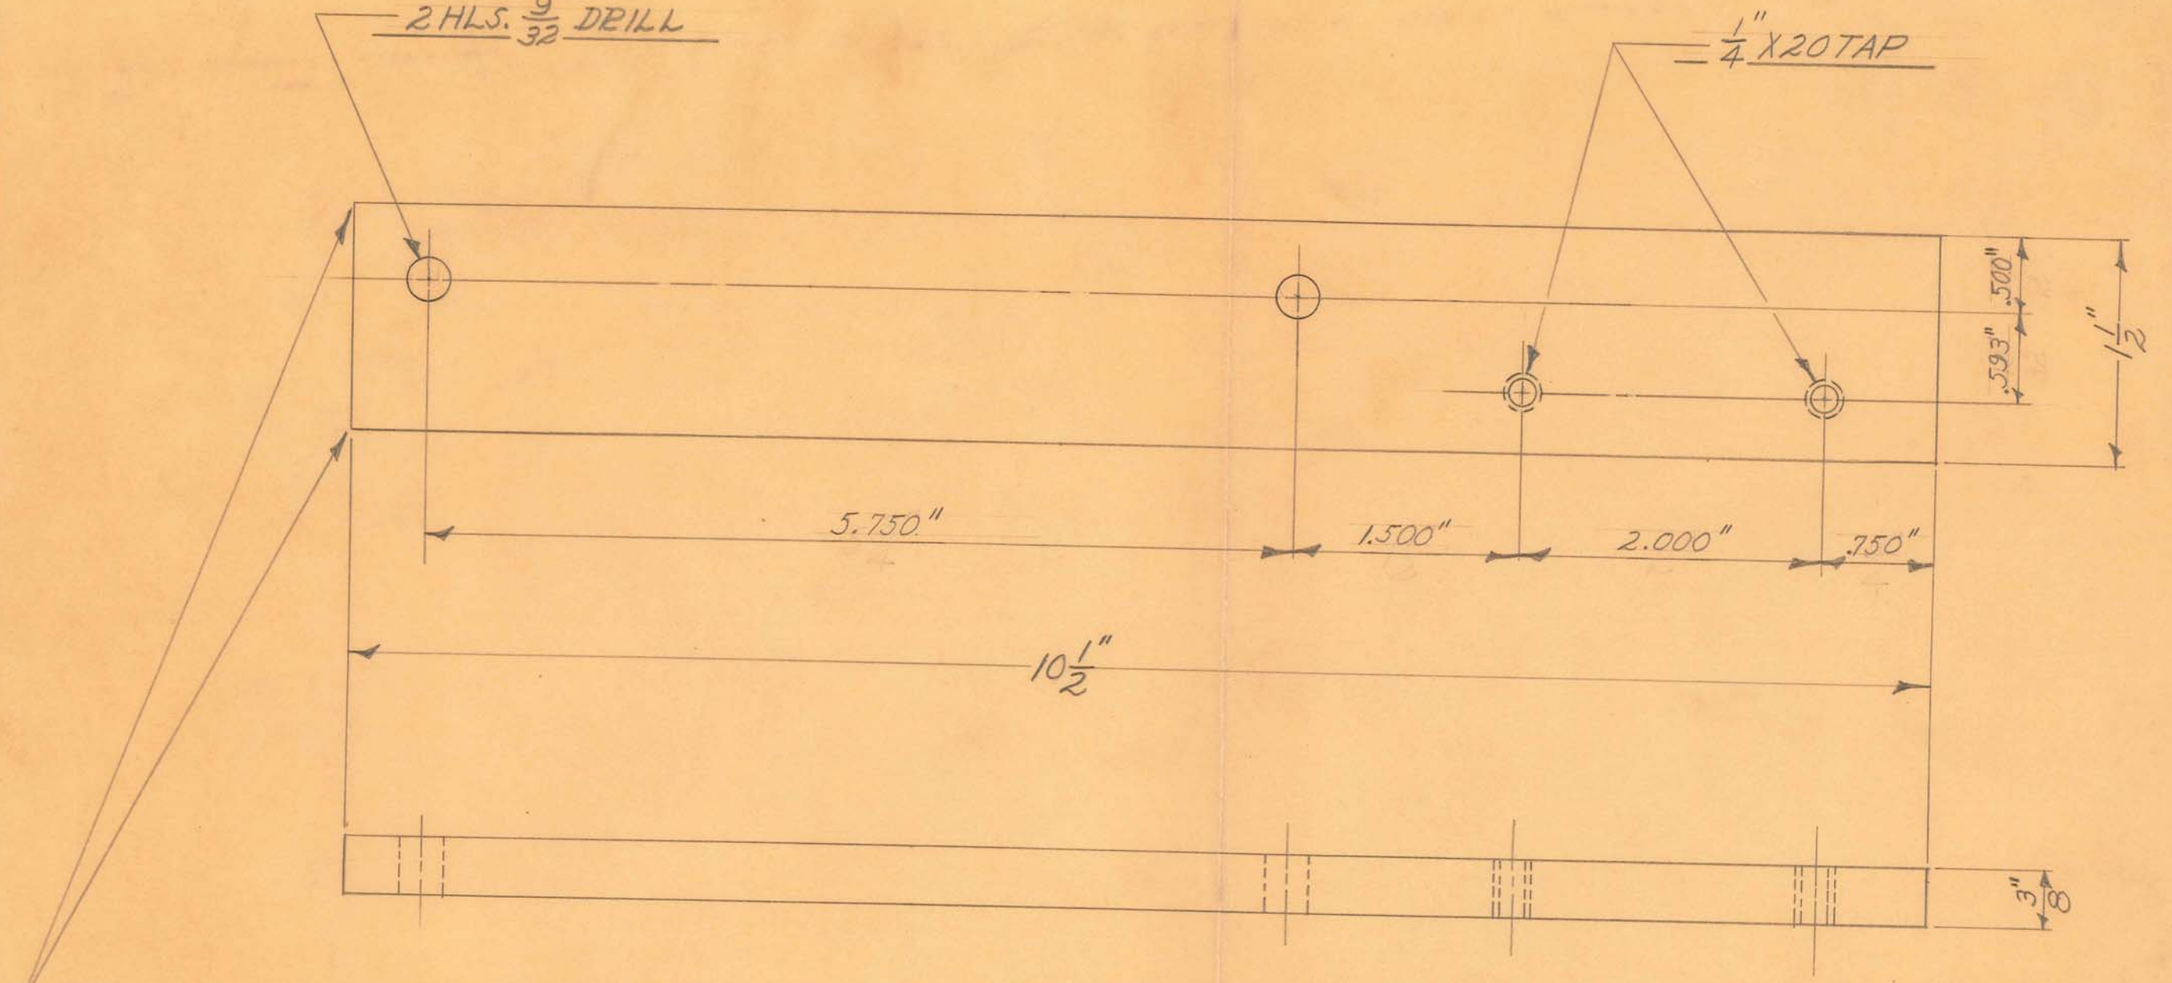

1-REQUIRED

OBSOLETE

DRILL JIG TOOL #9492

SIZE	3/8 X 1 1/2"	ISSUE 10-20-47	J.M.F	
KIND	C.R. STEEL	CHANGED		
SHAPE	BAR	"		
FINISH	BLACK #80	"		
TEMP.		"		
PATT.		"		

DIMENSIONS
FRACTIONAL ± .015
DECIMAL ± .005
ANGULAR ± 1/2°
UNLESS OTHERWISE SPECIFIED

TITLE: FISCHER PRECISION 200 X RAY TRANSFORMER CLAMP LEFT

H. G. FISCHER & CO.
2335 WABANSIA AVE.
CHICAGO, ILL.

CAT. NO.

PART NO. 16959

TITLE: CONE, DIFFUSING

PATTERN | FINISH | SCALE 2:1

MATERIAL: NYLON .750 DIA. ROD

TOOLS

H. G. FISCHER & CO.
FRANKLIN PARK, ILLINOIS

PART NO. 169-744

DATE 1/10/71 | DR. BY [illegible] | CH'K'D.

DIMENSIONS—UNLESS OTHERWISE SPECIFIED:
FRACTIONAL ± .015 | DECIMAL ± .005 | ANGULAR ± 1/2°
THREAD CHAMFER UP TO 5/16 D.-1/32 X 45° | 3/8 D. & OVER - 1/16 X 45°
REMOVE ALL BURRS & SHARP CORNERS

USED ON	QTY.	USED ON	QTY.
208-421	1		

REVISION	DATE	BY
A CHG. HT. dim. W/23 .043	2-25-71	DAK.
B WAS 50024 A E.C.O 1049	3/24/71	AHP
C WAS 146° E.C.O. 1062	9-6-71	J.W.

OBSOLETE
DATE 12/18/71
REFER TO P.E.V.P.
FOR DETAILS SEE E. C. O. # 1522
ENGINEER
DRAFTSMAN Andy P.

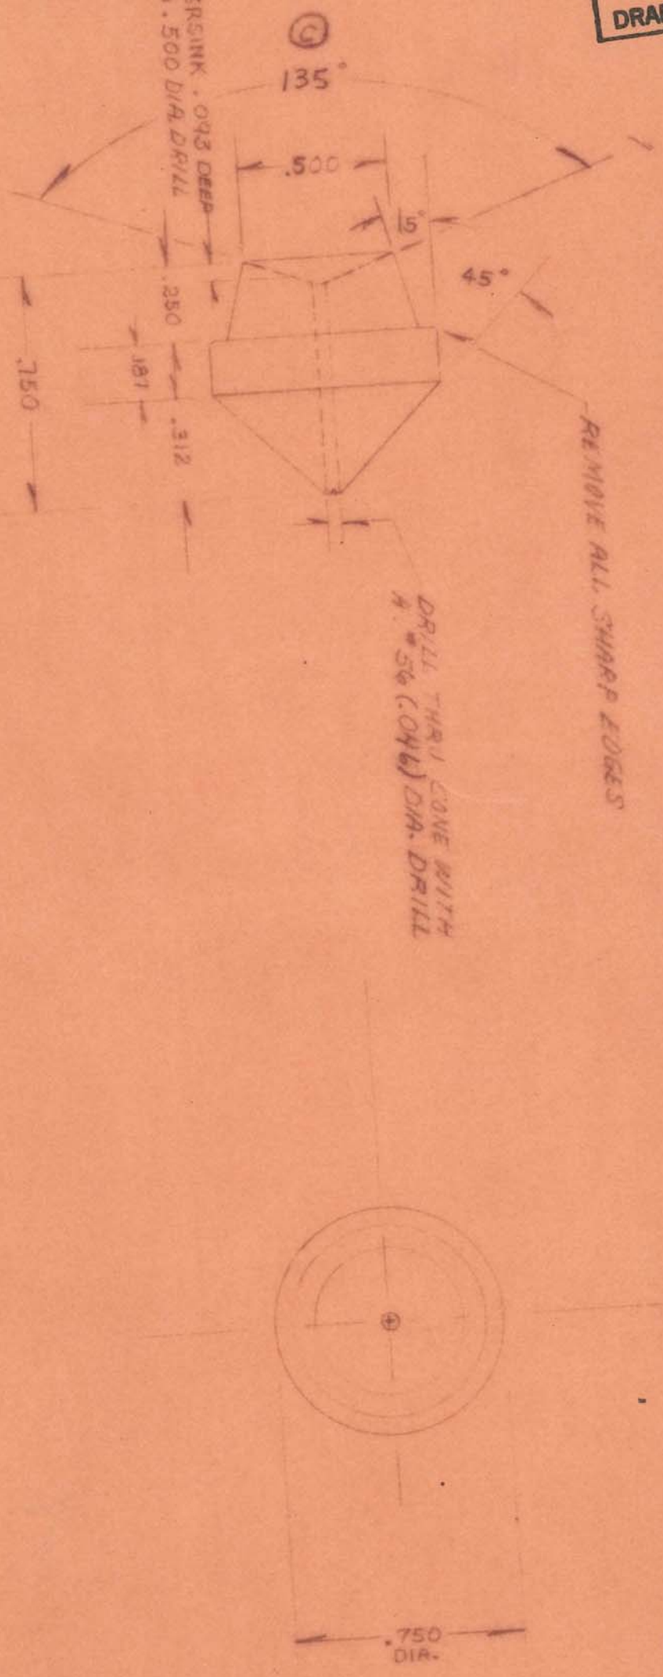

NOTE:
POLISH ALL SURFACES AFTER FINAL MACH. OPERATION.

DO NOT SCALE DRAWING.

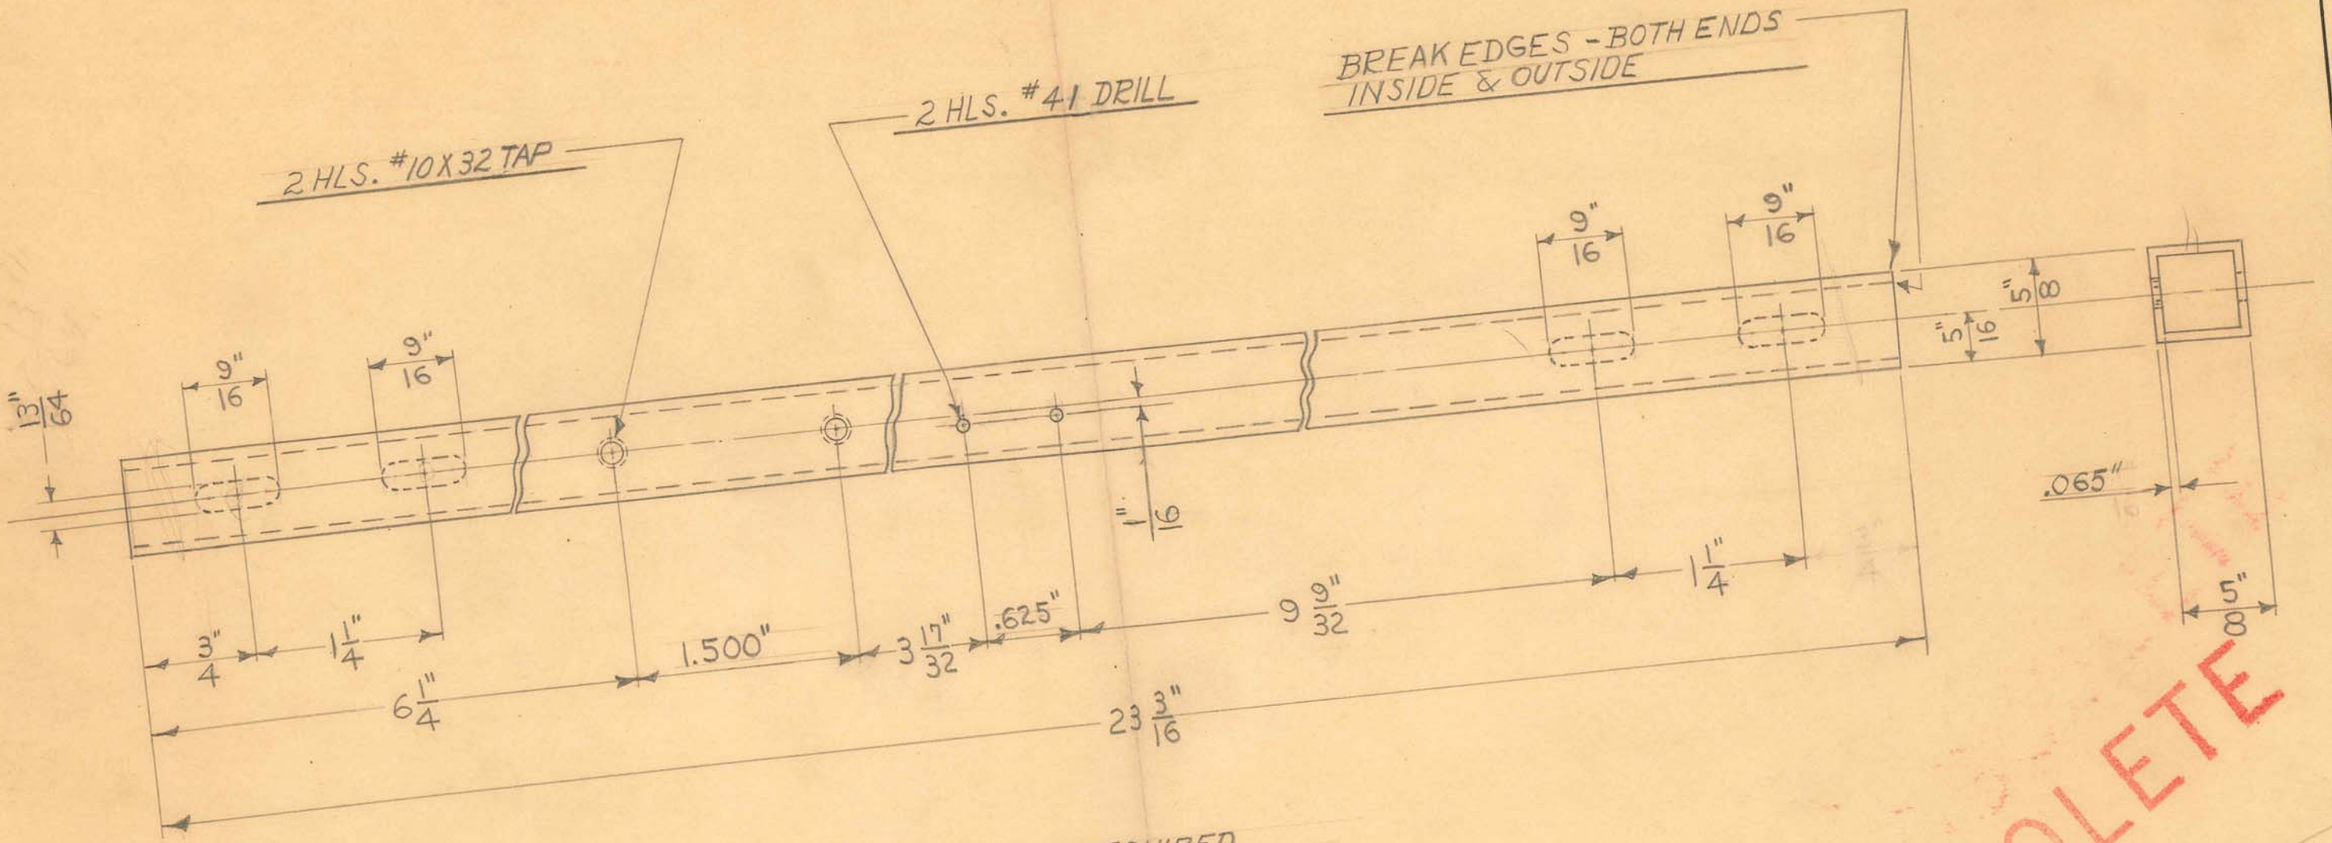

1-REQUIRED

5/8" SQUARE X 16GA. (.065") WALL SEAMLESS STEEL TUBING

OBSOLETE

obsolete

		ISSUE	1-13-48	J.M.F
SIZE		CHANGED		
KIND		"		
SHAPE		"		
FINISH		"		
TEMP.		"		
PATT.				

DIMENSIONS
FRACTIONAL ± .015
DECIMAL ± .005
ANGULAR ± 1/2°
UNLESS OTHERWISE SPECIFIED

TITLE: FISCHER PRECISION "200" X-RAY BUCKY LEVELING SUPP. TUBE

H. G. FISCHER & CO.
2335 WABANSIA AVE.
CHICAGO, ILL.

CAT. NO.

PART NO. 16977

673-665

NEXT ASSEMBLY	
PART NO.	QTY.
208-428	1

SERIES

NUMBER 169-791

PARTS LIST

ITEM	PART NO.	QTY.

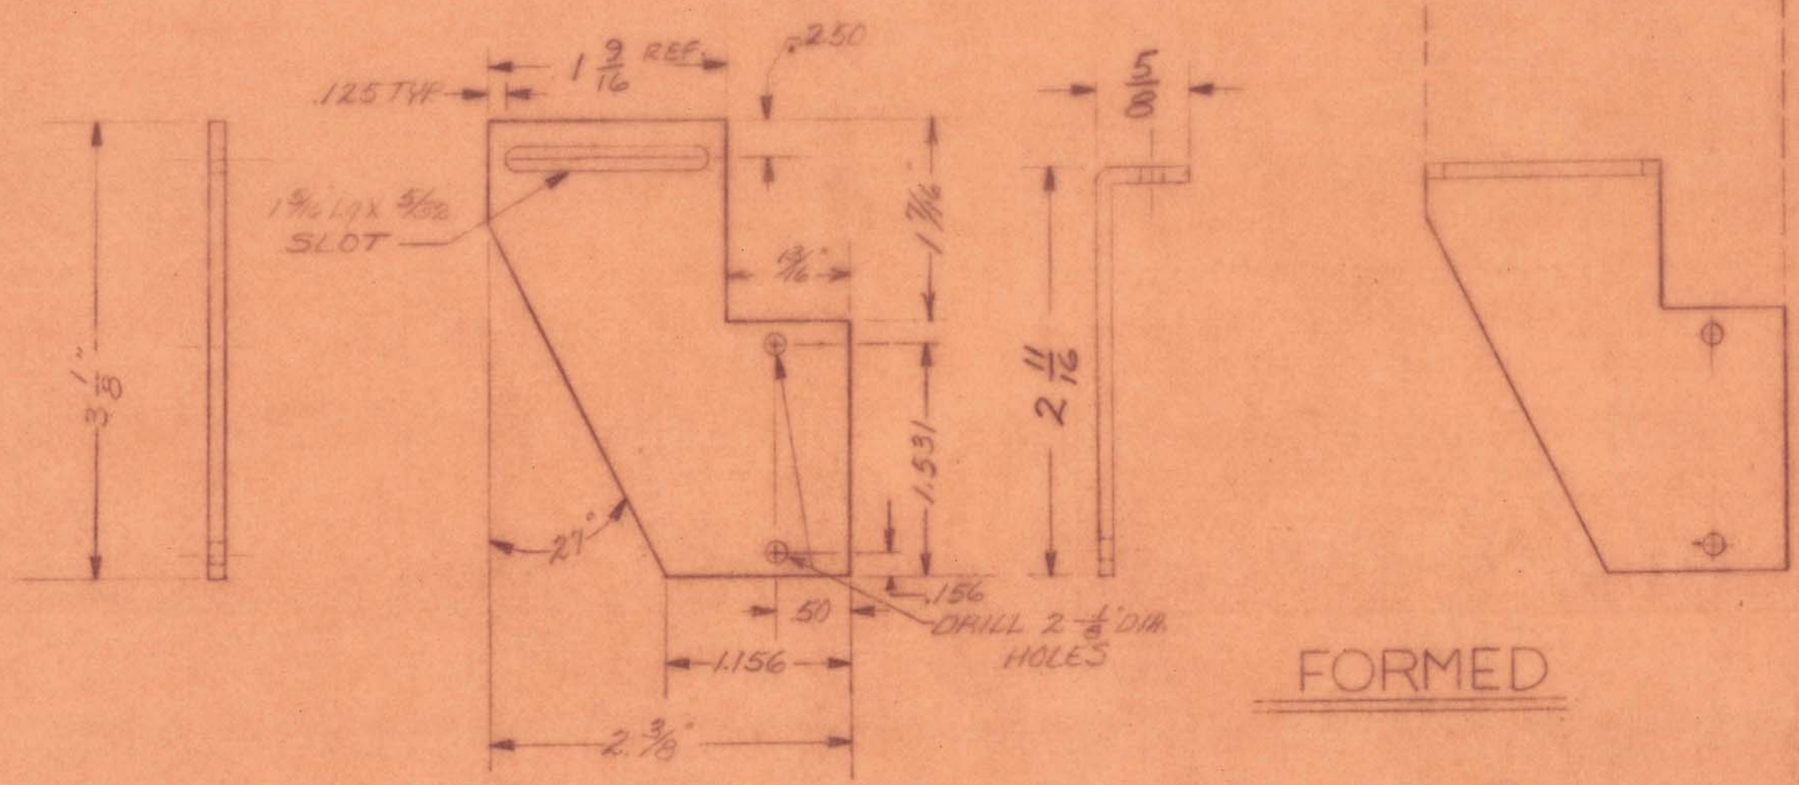

OBSOLETE
DATE 12-4-71
REFER TO ECO. REV. B
FOR DETAILS SEE E. C. O. # 1404
ENGINEER
DRAFTSMAN RS

LTR	DESCRIPTION	ECO	DATE
A	NEW TRACING	1332	9/16/71

LTR	DESCRIPTION	ECO	DATE

MATERIAL: 11 GA. (120) C.R.S.
SPEC. NO.
ENG. SPEC.: PAINT #316
SPEC. NO.

DIMENSIONS ARE IN INCHES
TOLERANCES UNLESS OTHERWISE SPEC.
DECIMALS: X ±.1, XX ±.03, XXX ±.005; ANGLES ±½°

SCALE: FULL
NET WEIGHT

DRAFTSMAN: JW 9-15-71
CHECKER: CBS

ENGINEER

APPROVAL

GRACO INC.
Minneapolis, Minnesota

TITLE: BRACKET

FEDERAL STOCK NO.

SIZE	CODE IDENT. NO.	NUMBER
B	25980	169-791

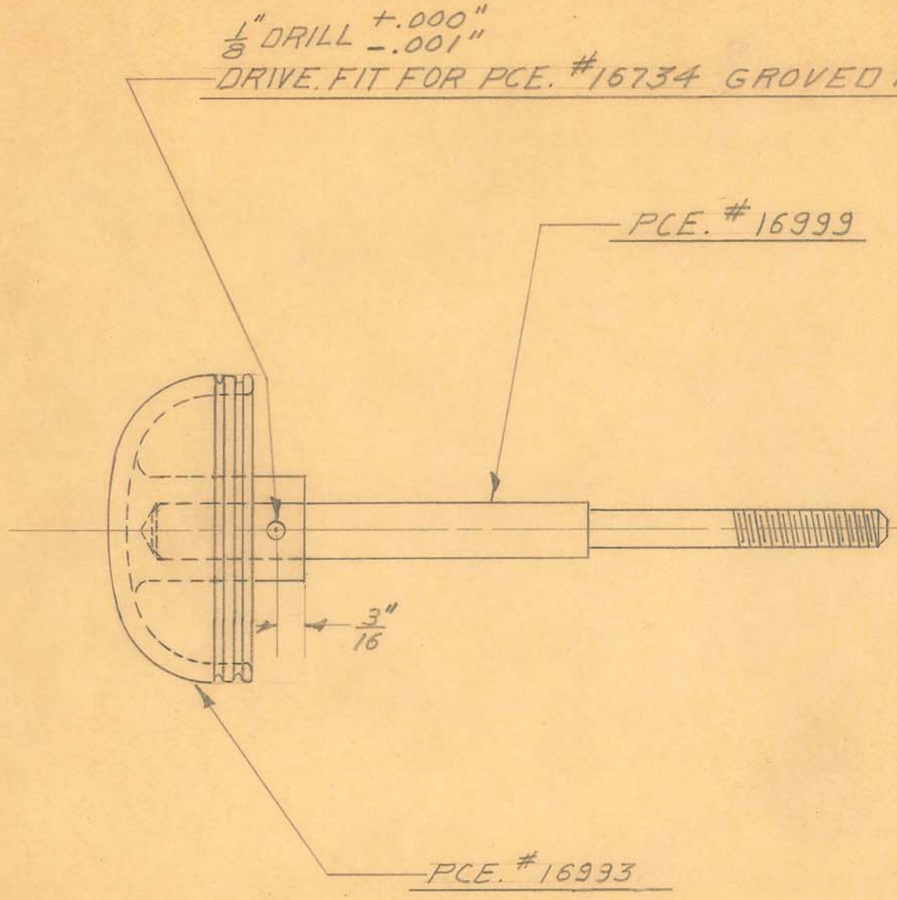

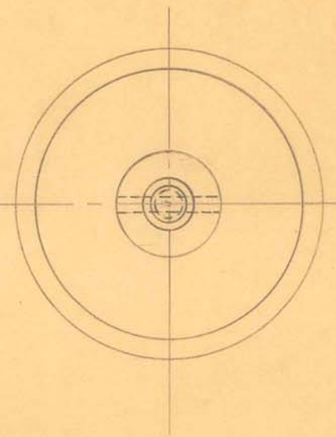

1 REQUIRED

OBSOLETE

8-31-50

DRILL JIG TOOL #9429

SIZE		ISSUE 7-22-47	J.M.F	TITLE: FISCHER "PRECISION 200" X RAY UNIT VERTICAL SPINE UNIT BUCKY LOCK ASSEMBLY
KIND		CHANGED		
SHAPE		"		
FINISH		"		
TEMP.		"		
PATT.		"		

H. G. FISCHER & CO.
2335 WABANSIA AVE.
CHICAGO, ILL.

CAT. NO.

PART NO. 16988 G

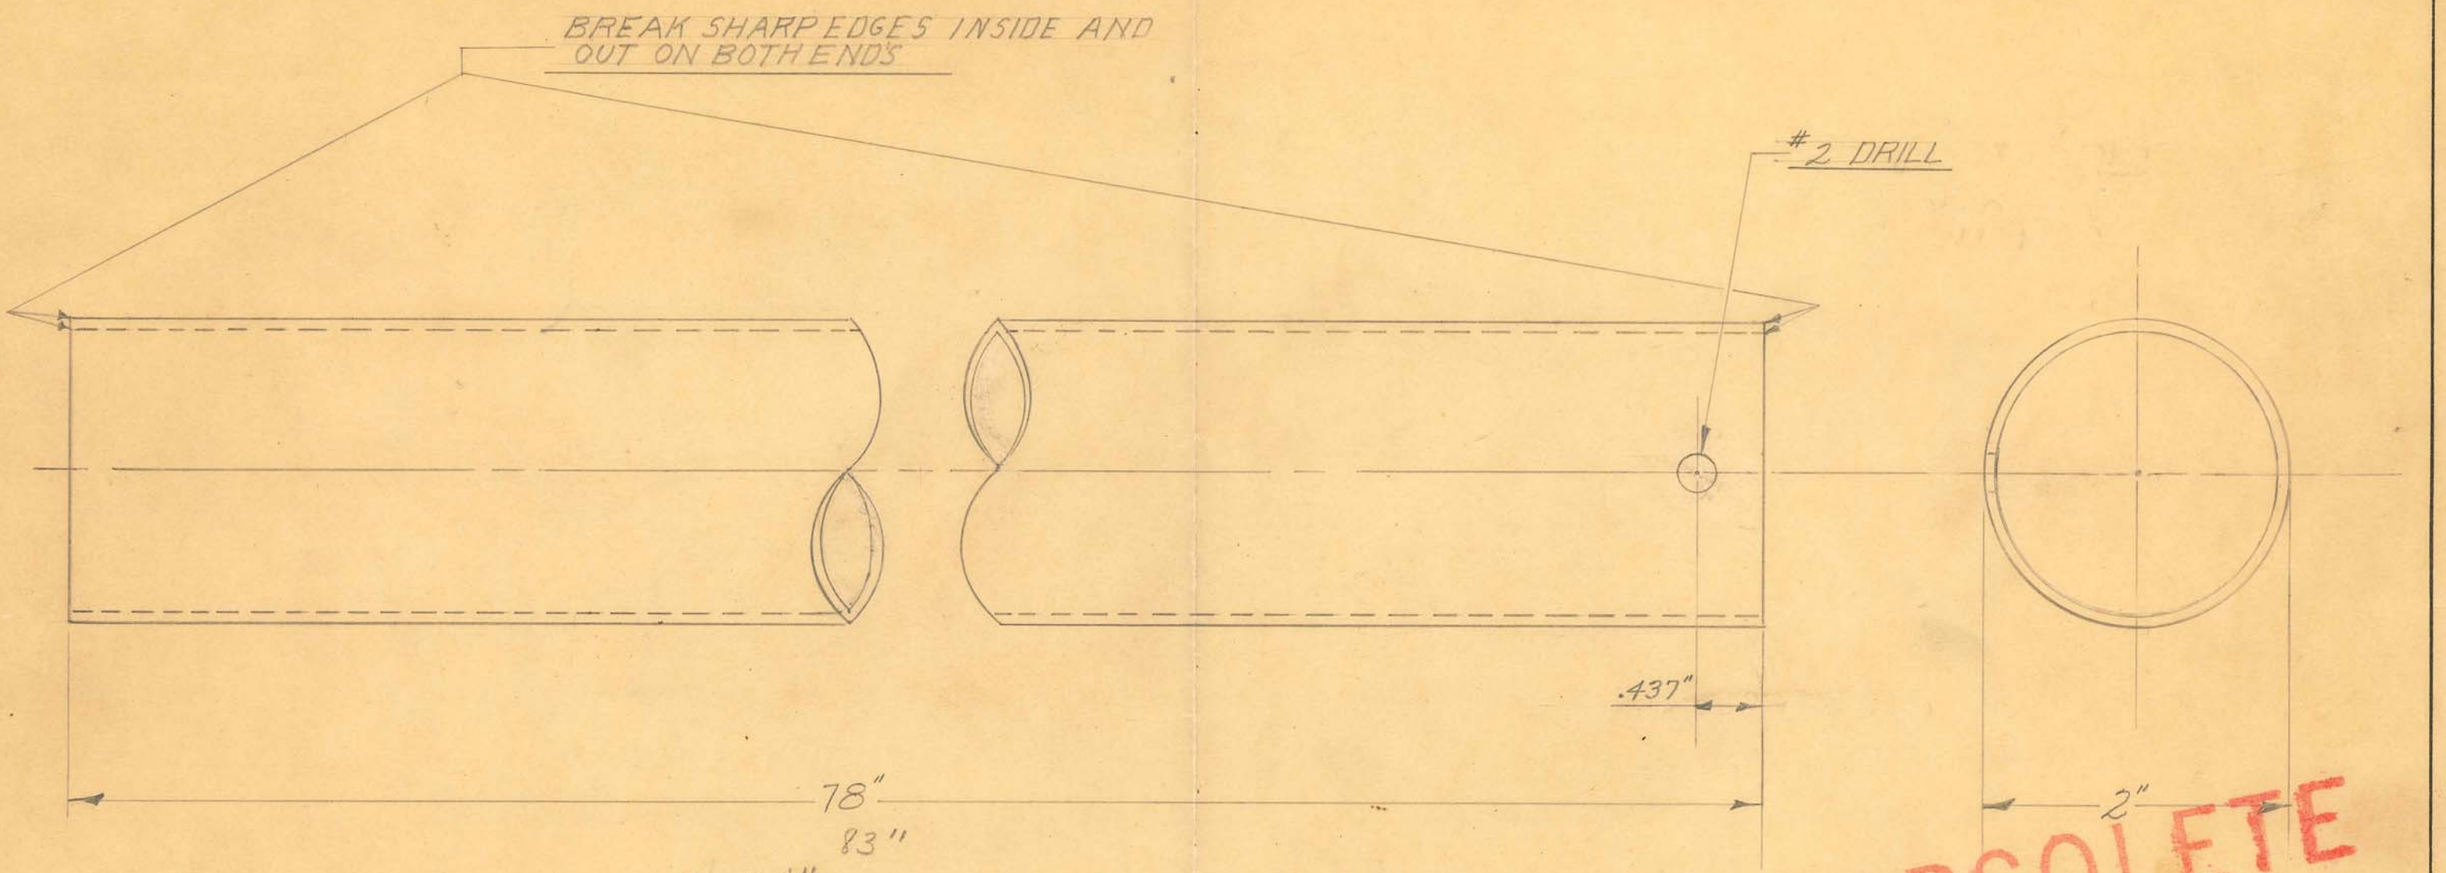

83"

6 FT. 11 1/4" LONG

2" O.D. X 16 GA. (.065") X 6'-6 1/8" LONG
WELDED BURRED INSIDE STEEL TUBING

1 - REQUIRED

OBSOLETE

Obsolete

DRILL JIG TOOL #9394

SIZE	~~FROM~~	ISSUE 7-18-47	J.M.F	TITLE: FISHER" PRECISION 200" X RAY UNIT BUCKY STAND VERTICAL TUBE
KIND	11091	CHANGED		
SHAPE		"		
FINISH	CHROME #2	"		
TEMP.		"		
PATT.		"		

H. G. FISCHER & CO.
2335 WABANSIA AVE.
CHICAGO, ILL.

CAT. NO.

PART NO. 16996

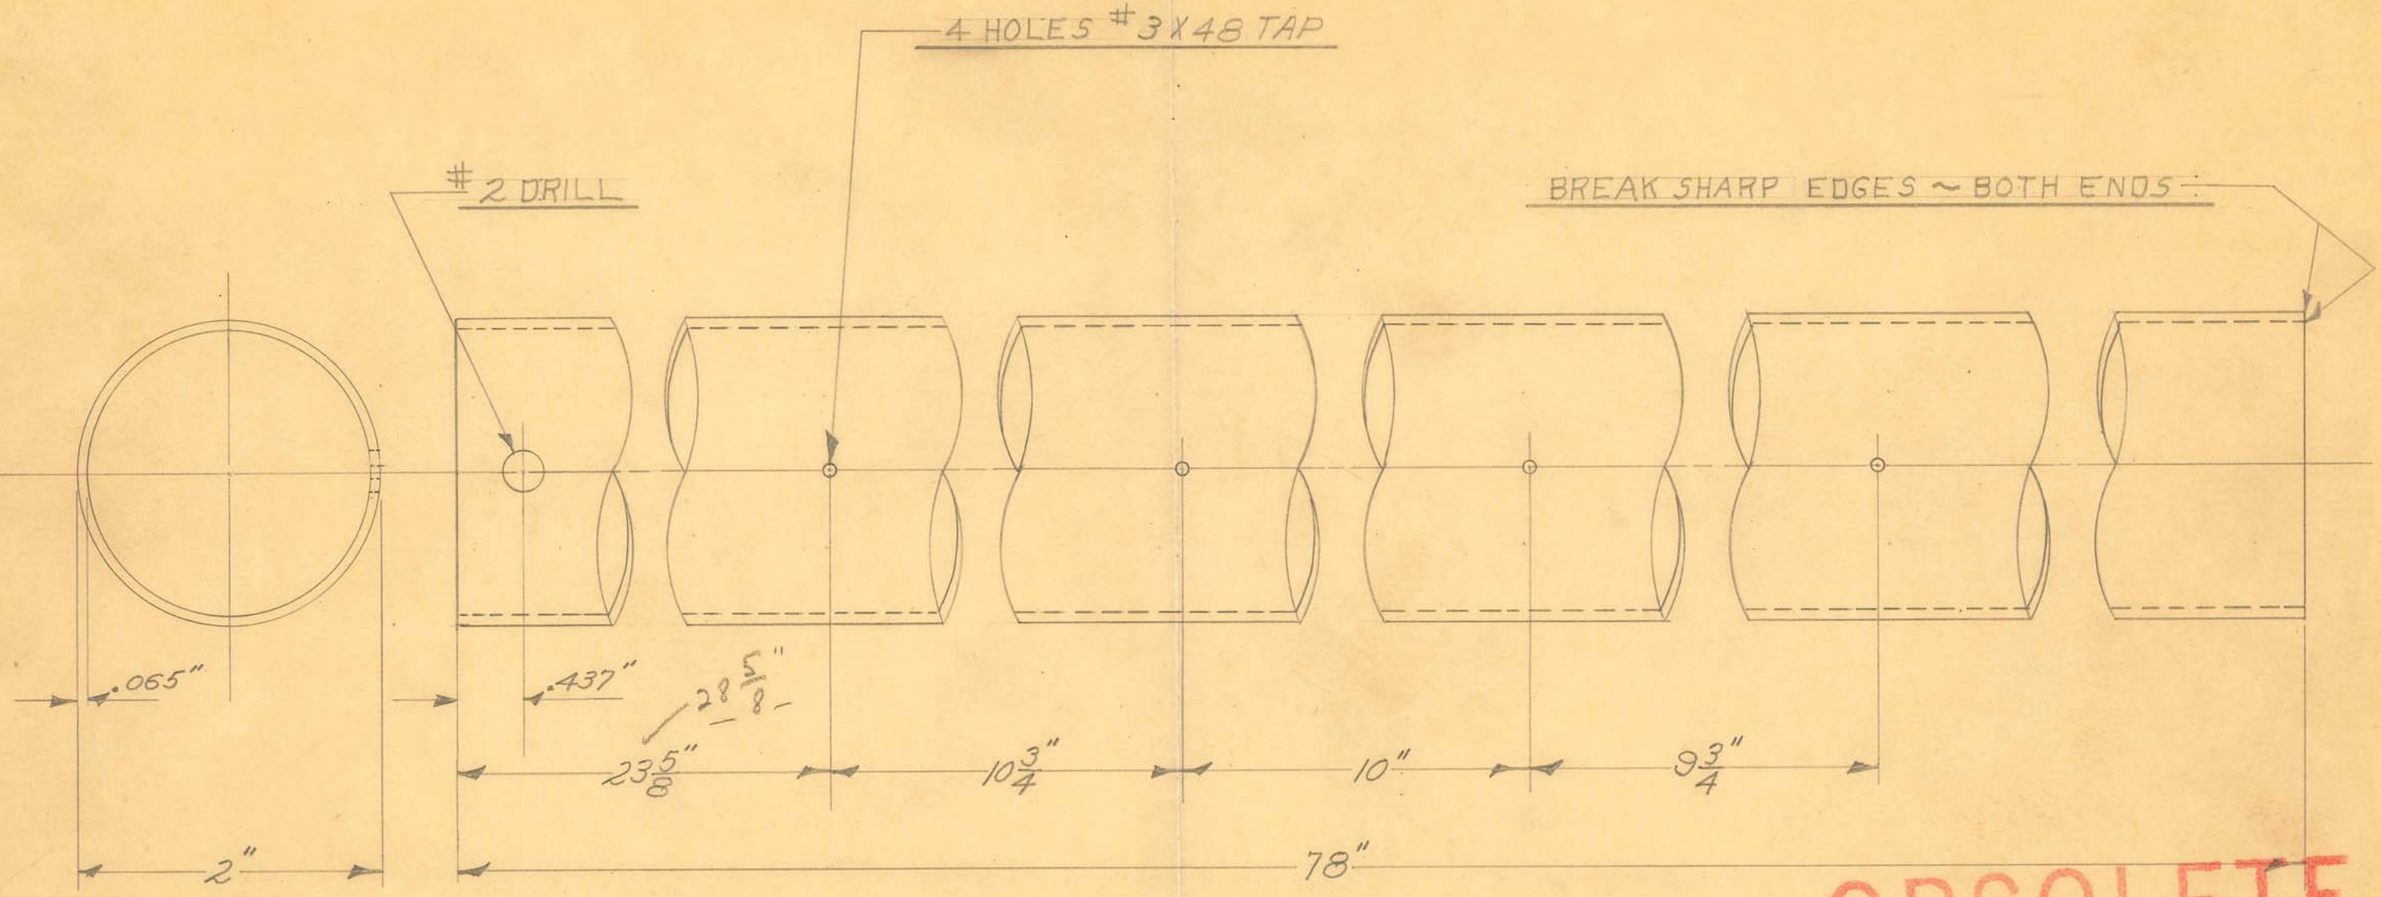

6 FT. 11 1/4" LONG

2" O.D. X 16 GA. (065") X 6' X 6 1/8" LONG
WELDED BURRED INSIDE STEEL TUBING

1-REQUIRED

OBSOLETE

Obsolete

DRILL JIG TOOL #9394

SIZE	FROM	ISSUE 8-15-47	JF	TITLE: FISCHER "PRECISION 200" X-RAY BUCKY STAND VERT. TUBE SCALE SIDE
KIND	11491	CHANGED		
SHAPE		"		
FINISH	CHROME #2	"		
TEMP.		"		
PATT.		"		

DIMENSIONS
FRACTIONAL ± .015
DECIMAL ± .005
ANGULAR ± 1/2°
UNLESS OTHERWISE SPECIFIED

H. G. FISCHER & CO.
2335 WABANSIA AVE.
CHICAGO, ILL.

CAT. NO.

PART NO. 16996 1/2

17635 — 2 pcs. 1/4" Tubing 5 11/16" LONG each

16234 Beads = 99

— #16 GA WIRE 19" LONG

ASSEMBLY

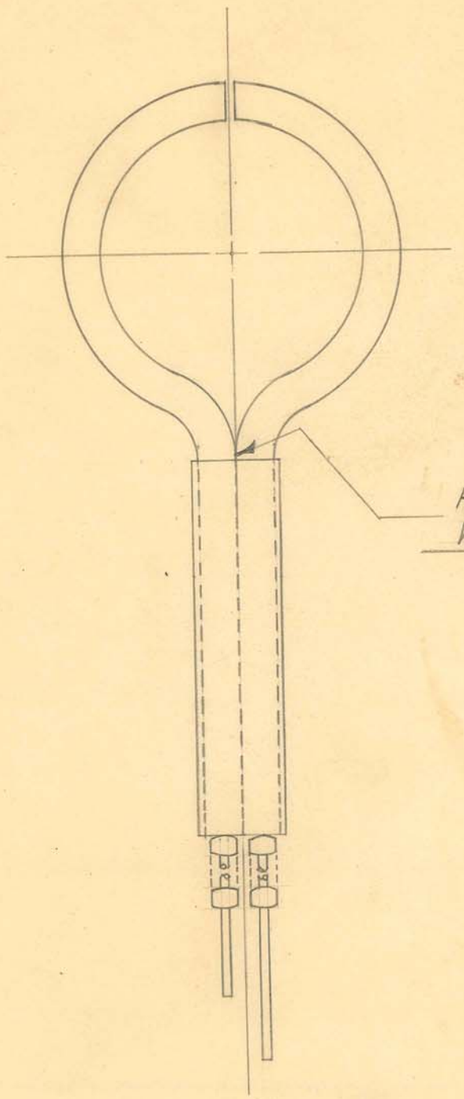

FILL THIS SPACE WITH SOLDER

1 - REQUIRED

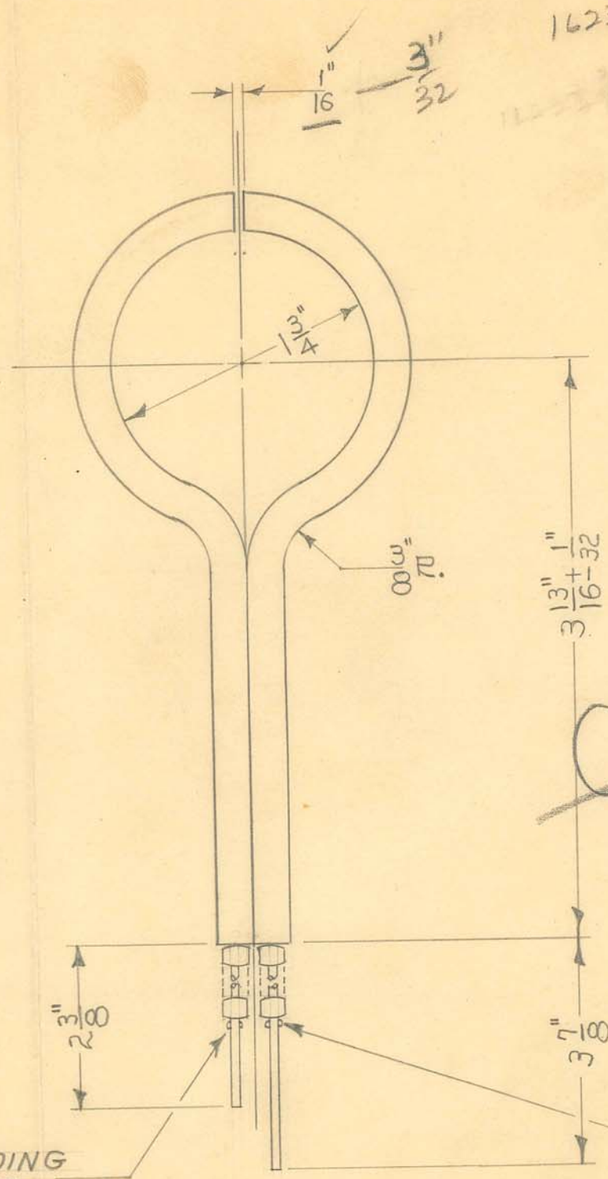

CRIMP AFTER BENDING 9 BEADS EXPOSED

CRIMP AFTER BENDING 18 BEADS EXPOSED

16334

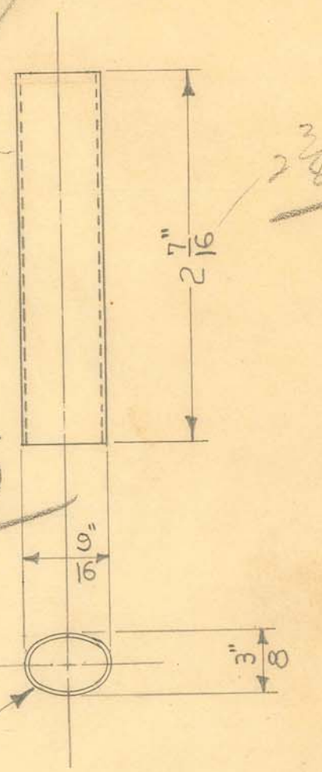

Obsolete 3-9-49

FLATTEN TO THIS SHAPE

OBSOLETE

MATERIALS TO BE USED AS SPECIAFIED ON YOUR DRAWING NO. L-11722

DIMENSIONS	
FRACTIONAL	± .015
DECIMAL	± .005
ANGULAR	± 1/2°

SIZE		ISSUE 1-2-48	J.M.F
KIND		CHANGED	
SHAPE		"	
FINISH		"	
TEMP.		"	
PATT.		"	

TITLE: FISCHER MODEL "200" PORTABLE DIATHERMY FARRADAY PICK UP LOOP

H. G. FISCHER & CO.
2335 WABANSIA AVE.
CHICAGO, ILL.

CAT. NO.

PART NO. 17049

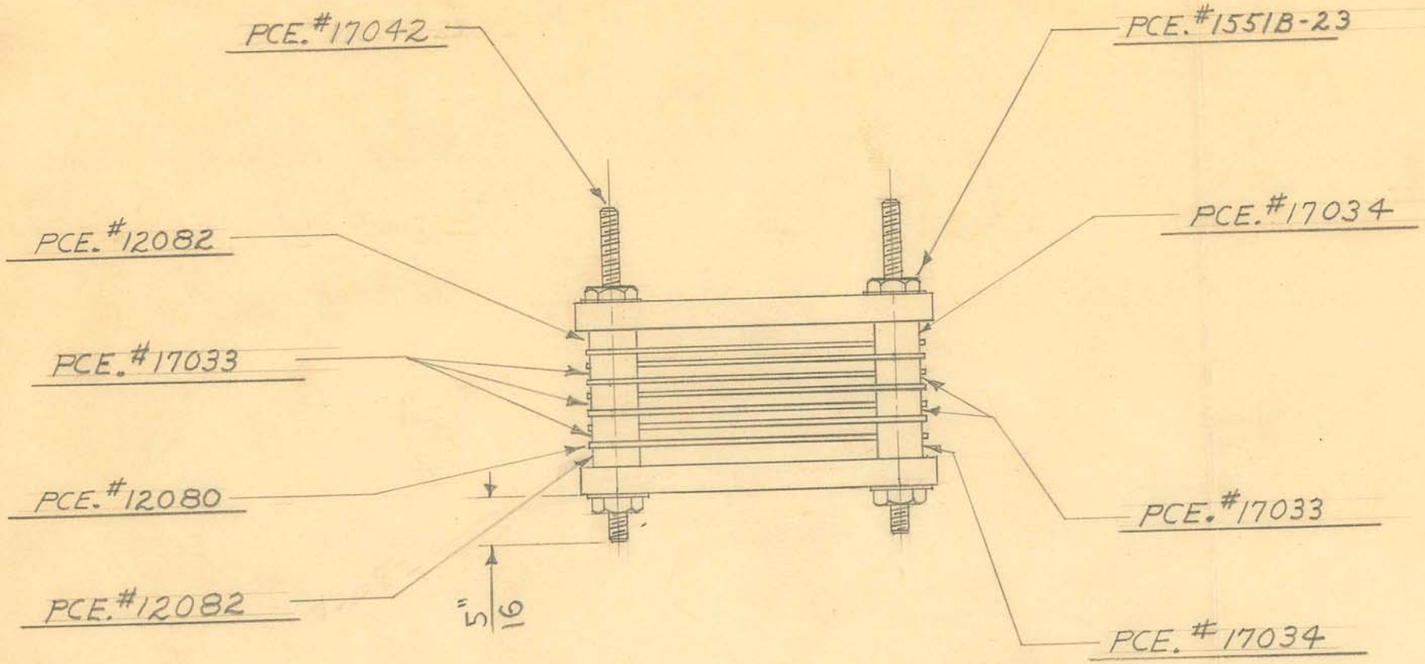

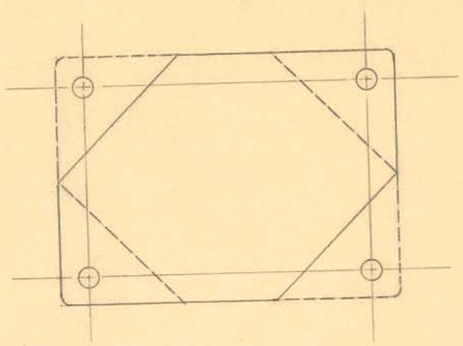

ASSEMBLY OF PLATES

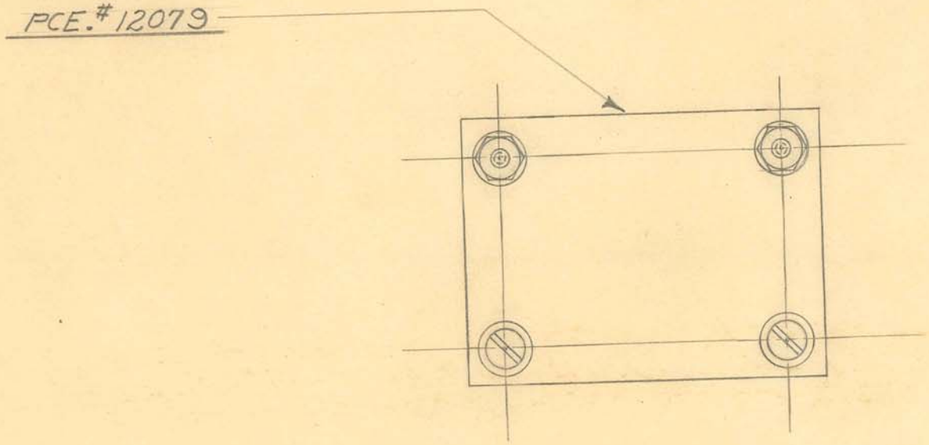

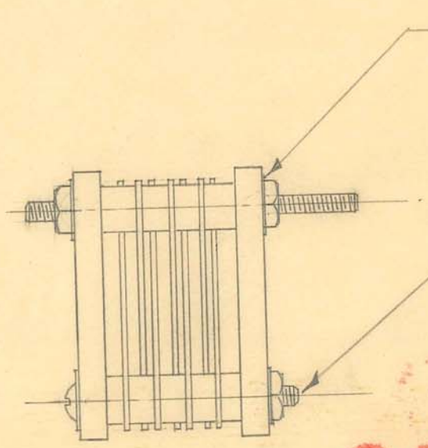

1-REQUIRED

OBSOLETE

Obsolete

SIZE		ISSUE 1-3-47	J.M.F
KIND		CHANGED	
SHAPE		"	
FINISH		"	
TEMP.		"	
PATT.		"	

DIMENSIONS
FRACTIONAL ± .015
DECIMAL ± .005
ANGULAR ± 1/2°
UNLESS OTHERWISE SPECIFIED

TITLE:
FISCHER MODEL "200" PORTABLE DIATHERMY
GRID CONDENSER ASSEM.

H. G. FISCHER & CO.
2335 WABANSIA AVE.
CHICAGO, ILL.

CAT. NO.

PART NO. 17050G

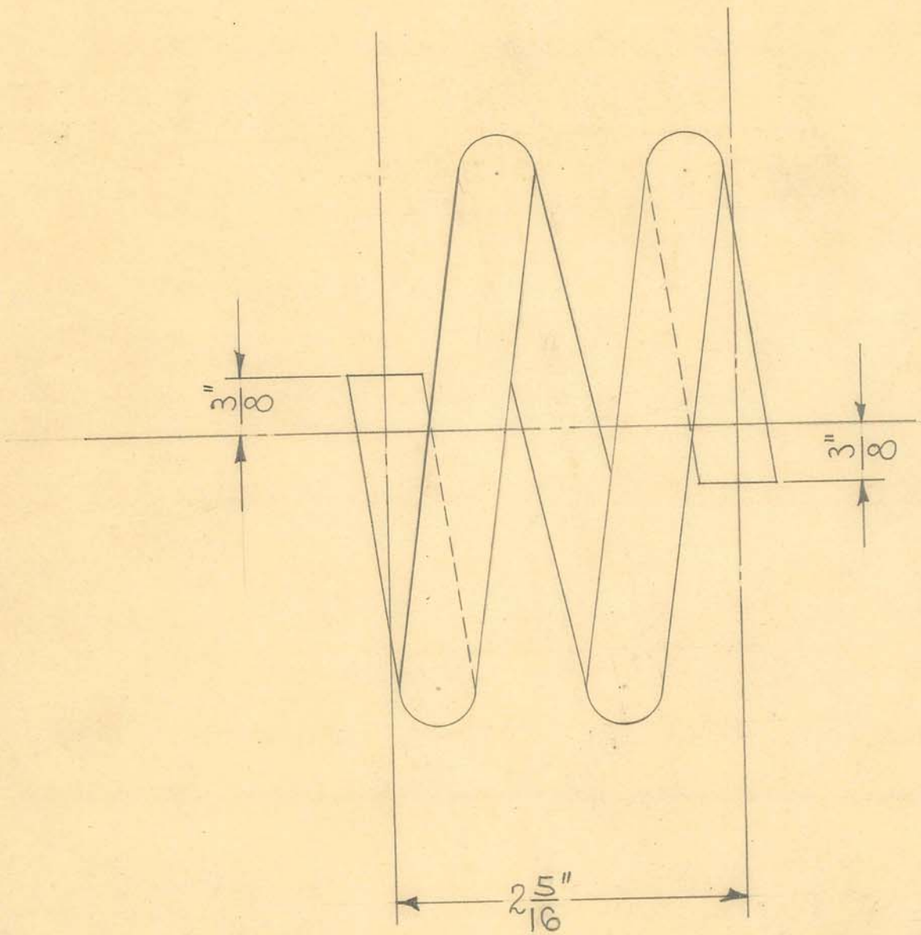

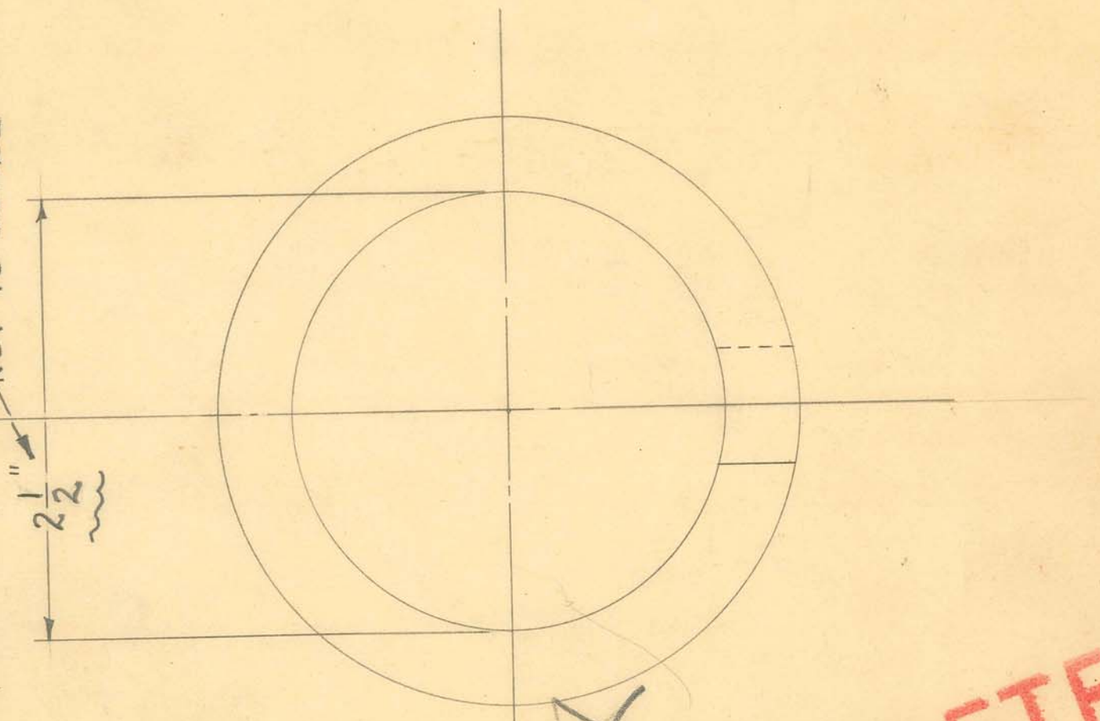

2 TURNS

1 REQUIRED

WAS 2 7/8" I.D.
CHANGE APPROVED 2-17-48

OBSOLETE
4-12-49
W.J.

1/2" O.D. X 21 GA. (.032") WALL ~ COPPER TUBING

COIL WINDING FIXTURE TOOL # 10081
FORMING ARBOR TOOL # 10083

DIMENSIONS	
FRACTIONAL	± .015
DECIMAL	± .005
ANGULAR	± 1/2°

SIZE		ISSUE 1-2-48	W.J.
KIND		CHANGED	
SHAPE		" 2-17-48	J.N.W.
FINISH		"	
TEMP.		"	
PATT.		"	

TITLE:
FISCHER MODEL "200" PORTABLE DIATHERMY
OSCILLATING COIL

H. G. FISCHER & CO. 2335 WABANSIA AVE. CHICAGO. ILL.	CAT. NO.	PART NO. 17051

4 HLS.- #37 DRILL (.104")

DOTTED OUTLINE SHOWS KNOB
TO BE MOUNTED IN FINAL ASSEMBLY

DIMENSION FOR HOLE

7/16" DRILL

1/8" R.

H.G. Fischer & CO. CHICAGO, ILL.

OUTPUT VERNIER

7/8"

7/8"

2"

2"

4"

2 11/32"

5 15/16"

5 15/16"

1/8"

12 1/8"

DIAL-BORDER-VERTICAL LINES
AND TRADEMARK-PLAIN
ANNODIZED ALUMINUM.
BACKGROUND - BLACK

OBSOLETE

TEMPLATE TOOL #9693

DIMENSIONS	
FRACTIONAL	± .015
DECIMAL	± .005
ANGULAR	± 1/2°

		ISSUE 1-23-48	J.V.W.
SIZE			
KIND		CHANGED	
SHAPE		"	
FINISH		"	
TEMP.		"	
PATT.		"	

TITLE:
FISCHER MOD. "200" PORTABLE DIATHERMY
UPPER DIAL PLATE

H. G. FISCHER & CO.
2335 WABANSIA AVE.
CHICAGO, ILL.

CAT. NO.

PART NO. 17064

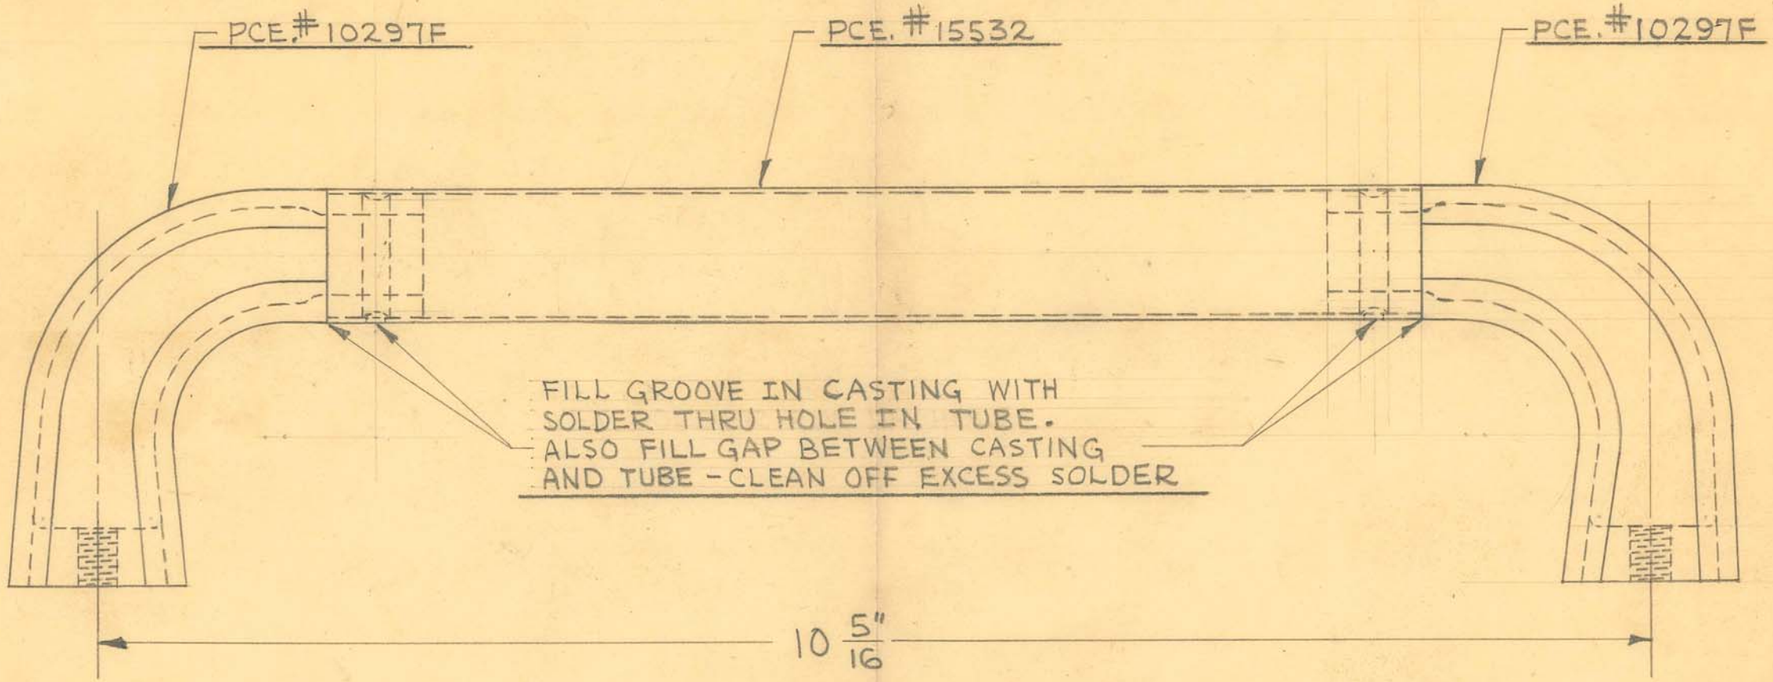

2 REQUIRED

OBSOLETE

SIZE		ISSUE 2-25-44	J.V.W.	TITLE: FISCHER "VC" SHORT WAVE APP. CABINET HANDLE ASSEMBLY
KIND		CHANGED		
SHAPE		"		
FINISH		"		
TEMP.		"		
PATT.		"		

H. G. FISCHER & CO.
2335 WABANSIA AVE.
CHICAGO, ILL.

CAT. NO.

PART NO. 15533G

TITLE: FISCHER DELUXE "400" DIATHERMY INDUCTION CABLE TIP ASSEMBLY

H. G. FISCHER & CO.
FRANKLIN PARK, ILLINOIS

PART NO. 15544GB

DATE 3-28-49 DR. BY J.V.W. CH'KD.

REVISION	DATE	BY
B1 ADDED C'SINK.	6/2/61	RCT

OBSOLETE

PATTERN

FINISH WH. NICKEL #13 – SEE NOTE

SCALE FULL

TOOLS RING GAUGES #9806

MATERIAL 5/8" DIA. BRASS ROD
5/16" DIA. BRASS ROD – SELECTED STOCK

DIMENSIONS
FRACTIONAL ± .015
DECIMAL ± .005
ANGULAR ± ½°
UNLESS OTHERWISE SPECIFIED

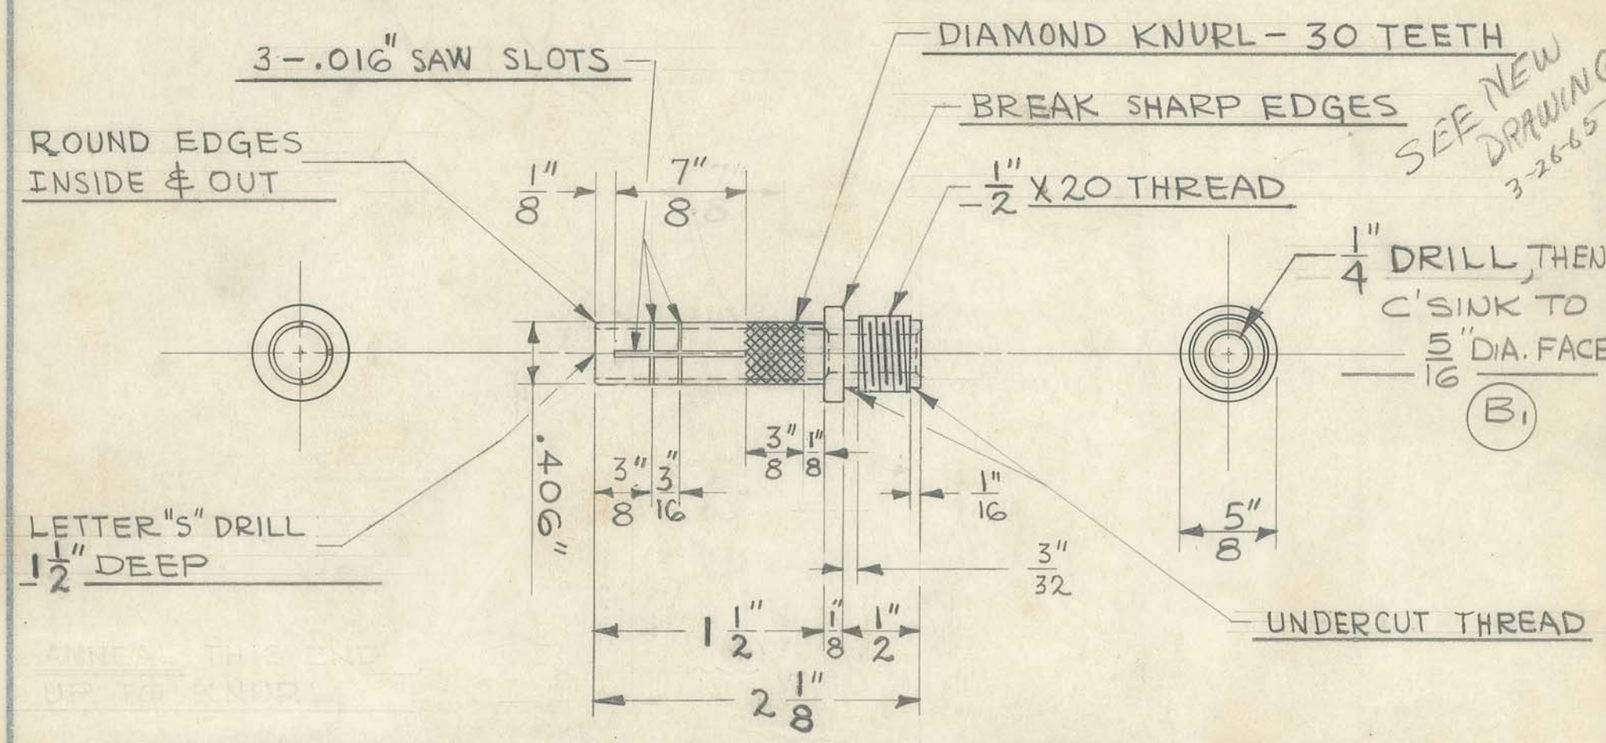

SELECTED STOCK – MUST FIT .313" RING GAUGE

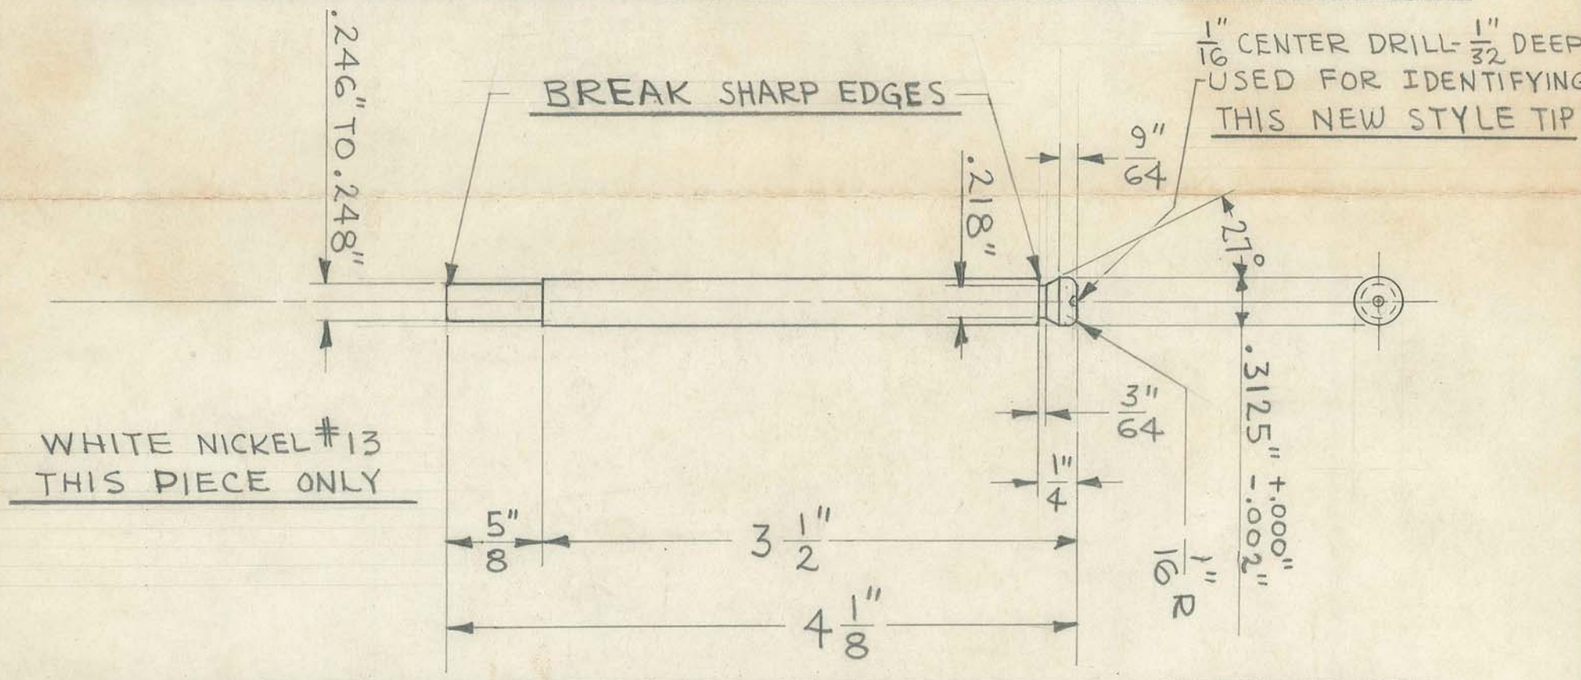

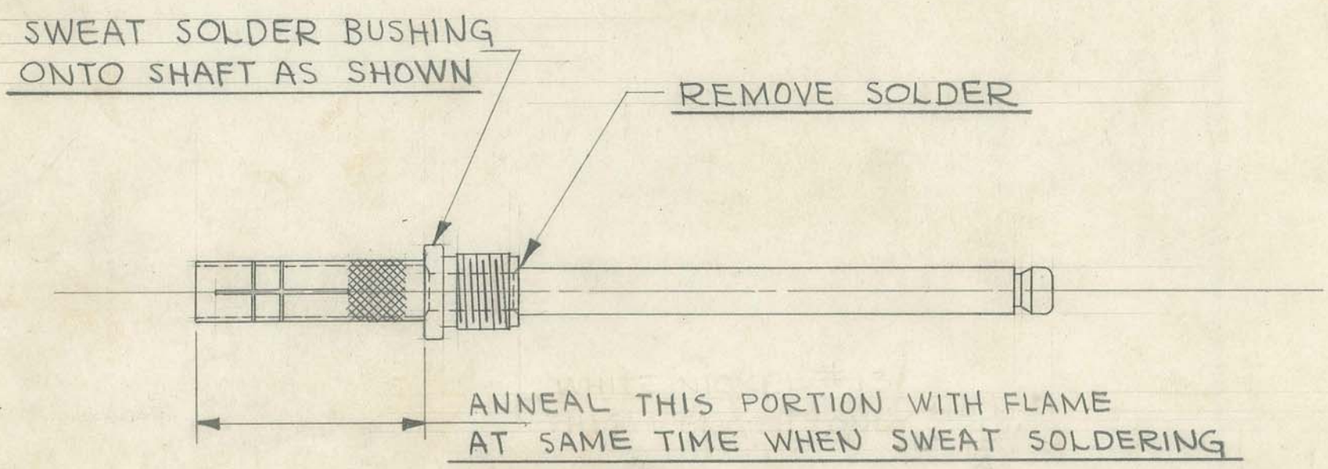

2 REQUIRED

FOLDER #129

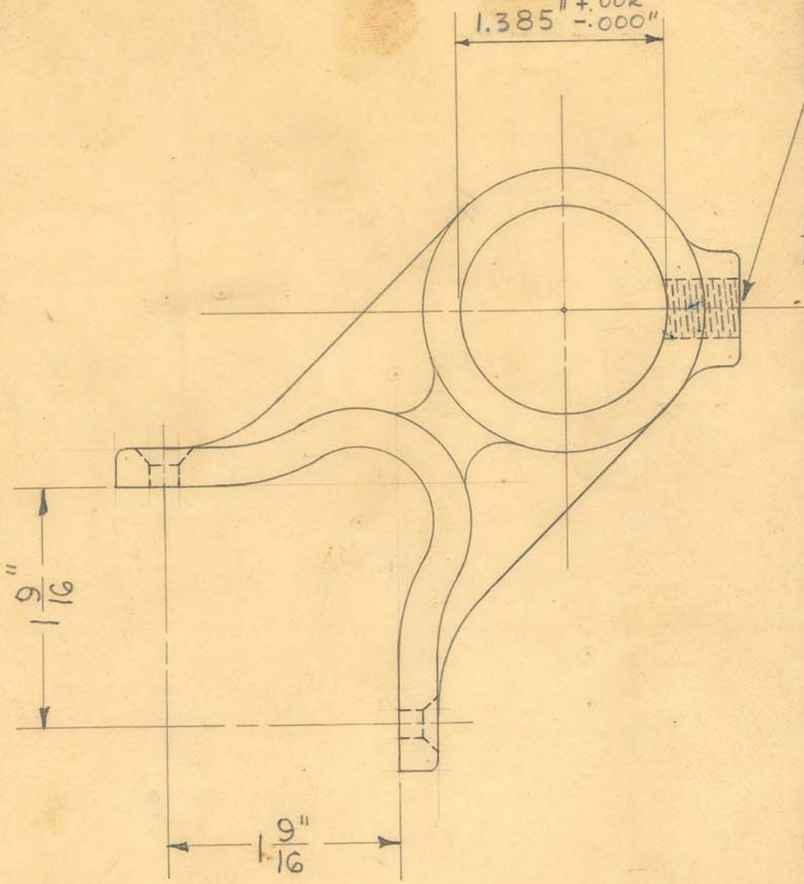

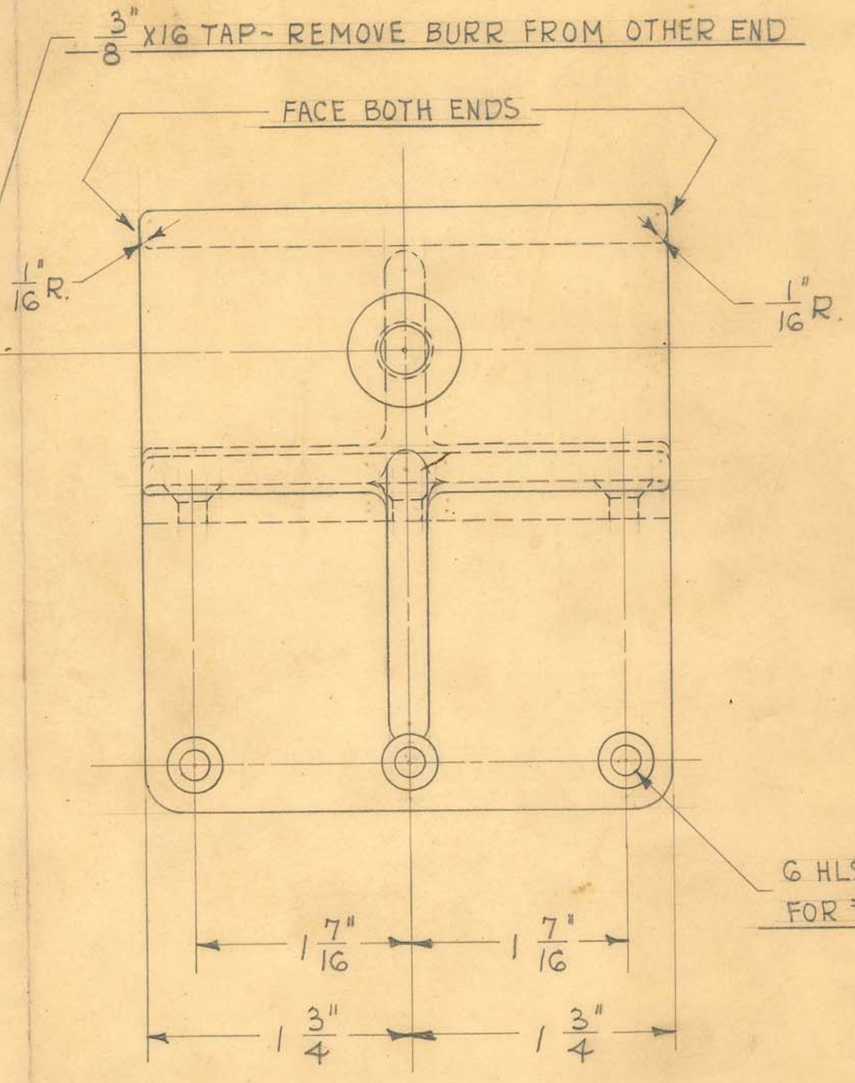

1 REQUIRED

OBSOLETE

DRILL JIG #8716
FACING MANDREL #6858
DRILL JIG #6820
GAUGE #15527A

SIZE		ISSUE 3-11-44	HE.	TITLE: FISCHER "VC" SHORT WAVE APPARATUS~ IND. COIL ELECT. ARM SUPPORT BRACKET
KIND	#214 ALUM.	CHANGED		
SHAPE		" (A) WAS 1.378" TO 1.380"	6-15-55	
FINISH	PAINTED	"		
TEMP.		"		
PATT.	2001	"		

H. G. FISCHER & CO.
2335 WABANSIA AVE.
CHICAGO, ILL.

CAT. NO.

PART NO. 15527AF

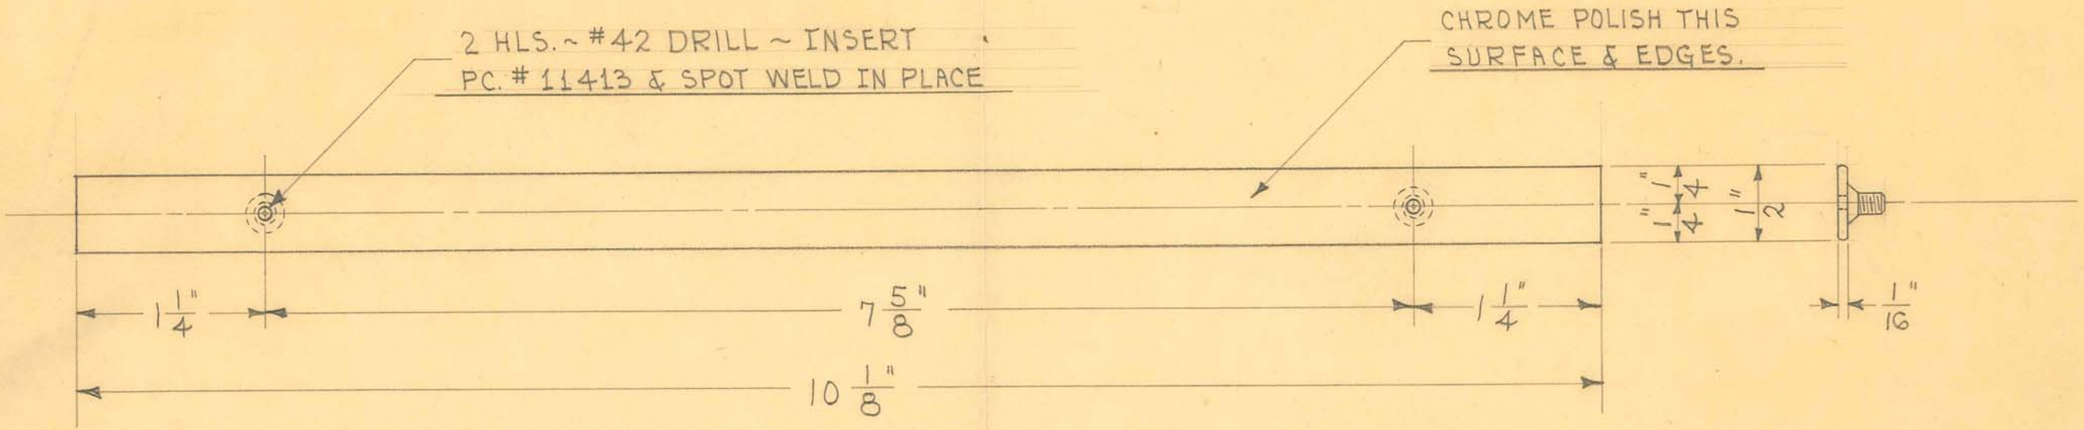

1 REQUIRED

OBSOLETE

SIZE	1/2" X 1/16"	ISSUE 2-26-44	H.
KIND	FLAT WIRE	CHANGED	
SHAPE		"	
FINISH	CHROME #2	"	
TEMP.		"	
PATT.		"	

TITLE: FISCHER "VC" SHORT WAVE APPARATUS~ CABINET FINISHING STRIP~TOP

H. G. FISCHER & CO.
2335 WABANSIA AVE.
CHICAGO, ILL.

CAT. NO.

PART NO. 15529G

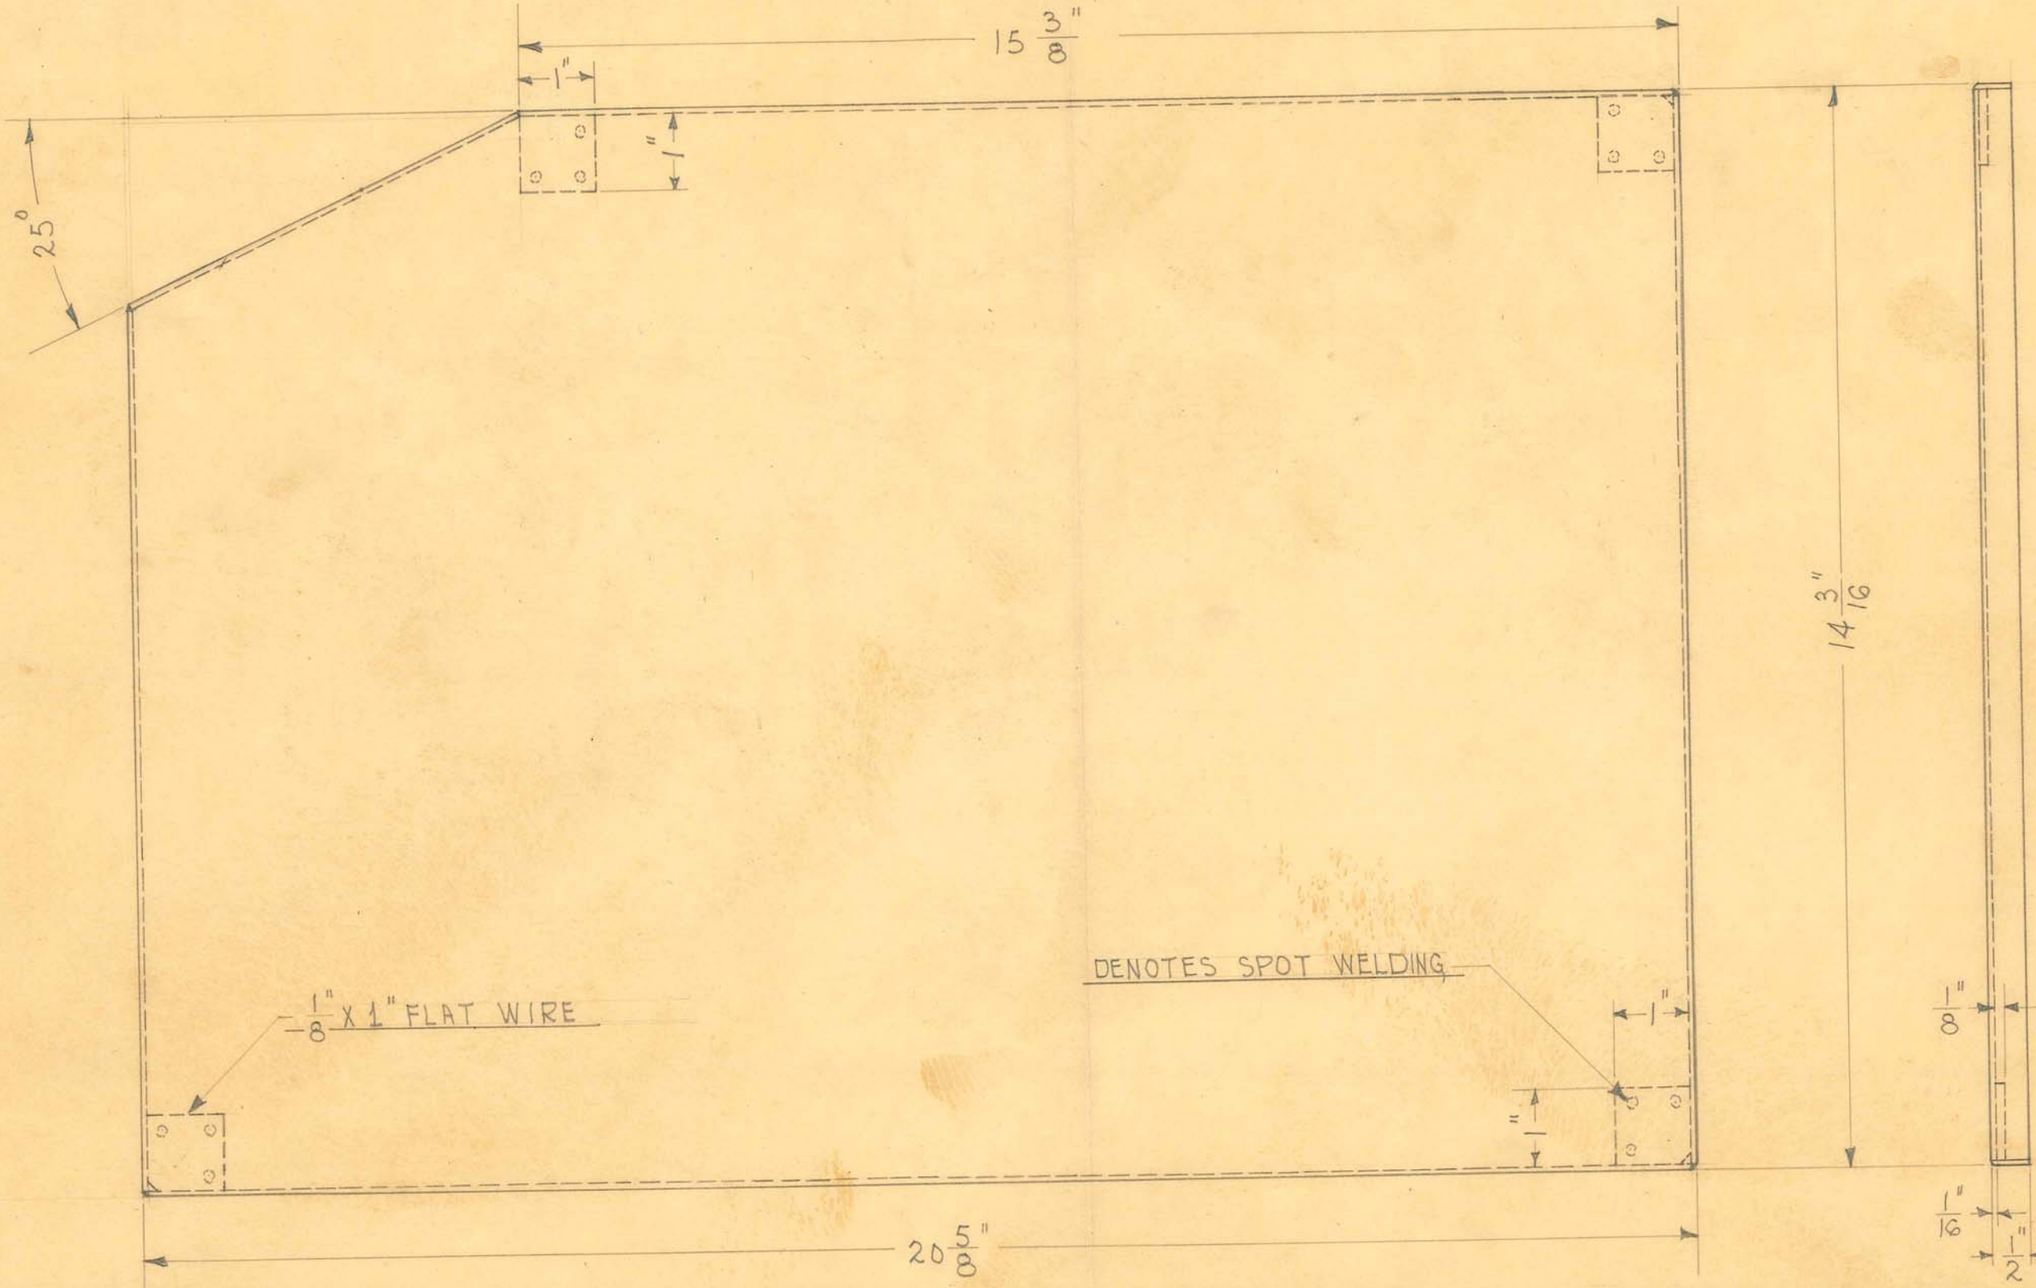

OBSOLETE

SCALE ~ 1/2" = 1"

1 REQUIRED

SIZE	1/16" SHEET	ISSUE 6-28-44	HE.
KIND	C.R. STEEL	CHANGED	
SHAPE		"	
FINISH		"	
TEMP.		"	
PATT.		"	

TITLE: FISCHER "VC" SHORT WAVE APPARATUS~ CABINET~ SIDE DOOR (LEFT)

H. G. FISCHER & CO.
2335 WABANSIA AVE.
CHICAGO, ILL.

CAT. NO.

PART NO. PARTY OF 15525G

23 3/8"

7/8" | 1/16" THICK GRILL | 1/8" X 7/8" FLAT WIRE | 7/8"

1/8"

7/8"

20 11/16"

5 1/2"

1 1/16"

7/8" R. | 1/2" R.

1/2"

1 1/16" | 15/16" | 15/16" | 1 1/16"

7 5/8"

3/16" DIA. X 5/16" IRON RIVET (TACK WELD AROUND HEAD)

11 11/16" | 11 11/16"

8 1/8" | 8 1/8"

1/4" | 1/4"

1/16" | 1/16"

1/16" | 1/8" | 1/16"

3/16" | 5/16"

7/8"

SCALE ÷ 1/2" = 1"

1 REQUIRED

OBSOLETE

SIZE	1/16" SHEET	ISSUE 7-5-44	H.
KIND	C.R. STEEL	CHANGED	
SHAPE		"	
FINISH		"	
TEMP.		"	
PAT.		"	

TITLE: FISCHER "VC" SHORT WAVE APPARATUS - CABINET - REAR DOOR

H. G. FISCHER & CO.
2335 WABANSIA AVE.
CHICAGO, ILL.

CAT. NO.

PART NO. PART OF 15525 G

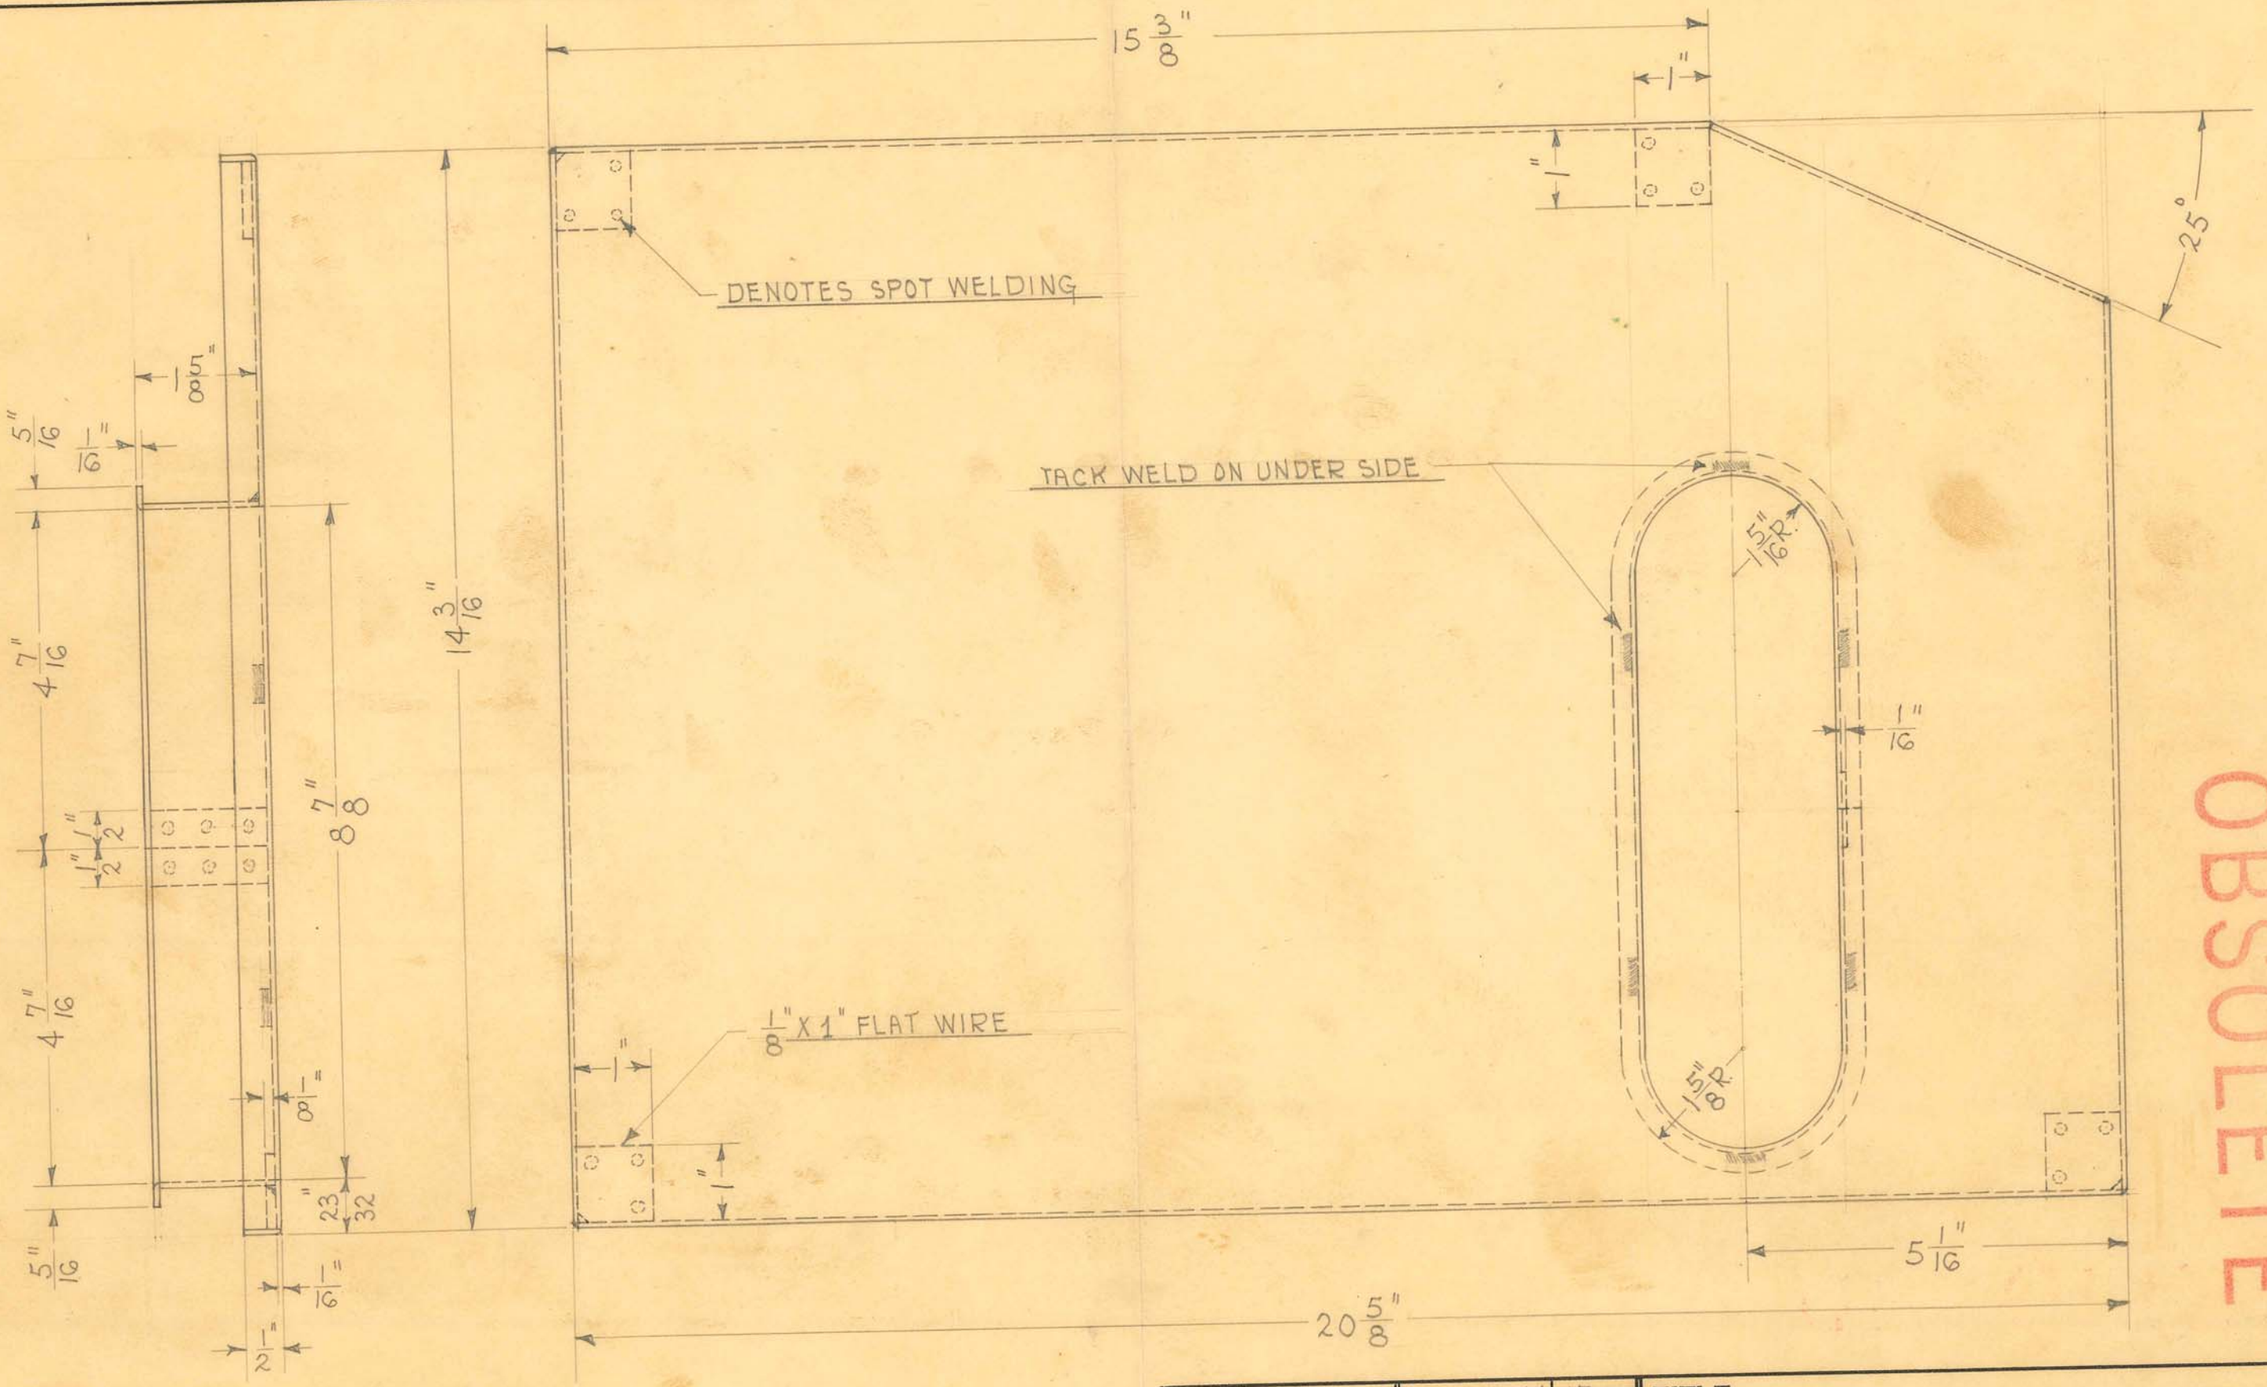

SCALE ÷ 1/2" = 1"

1 REQUIRED

SIZE	1/16" SHEET	ISSUE 6-28-44	HE.	
KIND	C.R. STEEL	CHANGED		
SHAPE		"		
FINISH		"		
TEMP.		"		
PATT.		"		

TITLE: FISCHER "VC" SHORT WAVE APPARATUS - CABINET - SIDE DOOR (RIGHT)

H. G. FISCHER & CO.
2335 WABANSIA AVE.
CHICAGO, ILL.

CAT. NO.

PART NO. PART OF 15525G

OBSOLETE

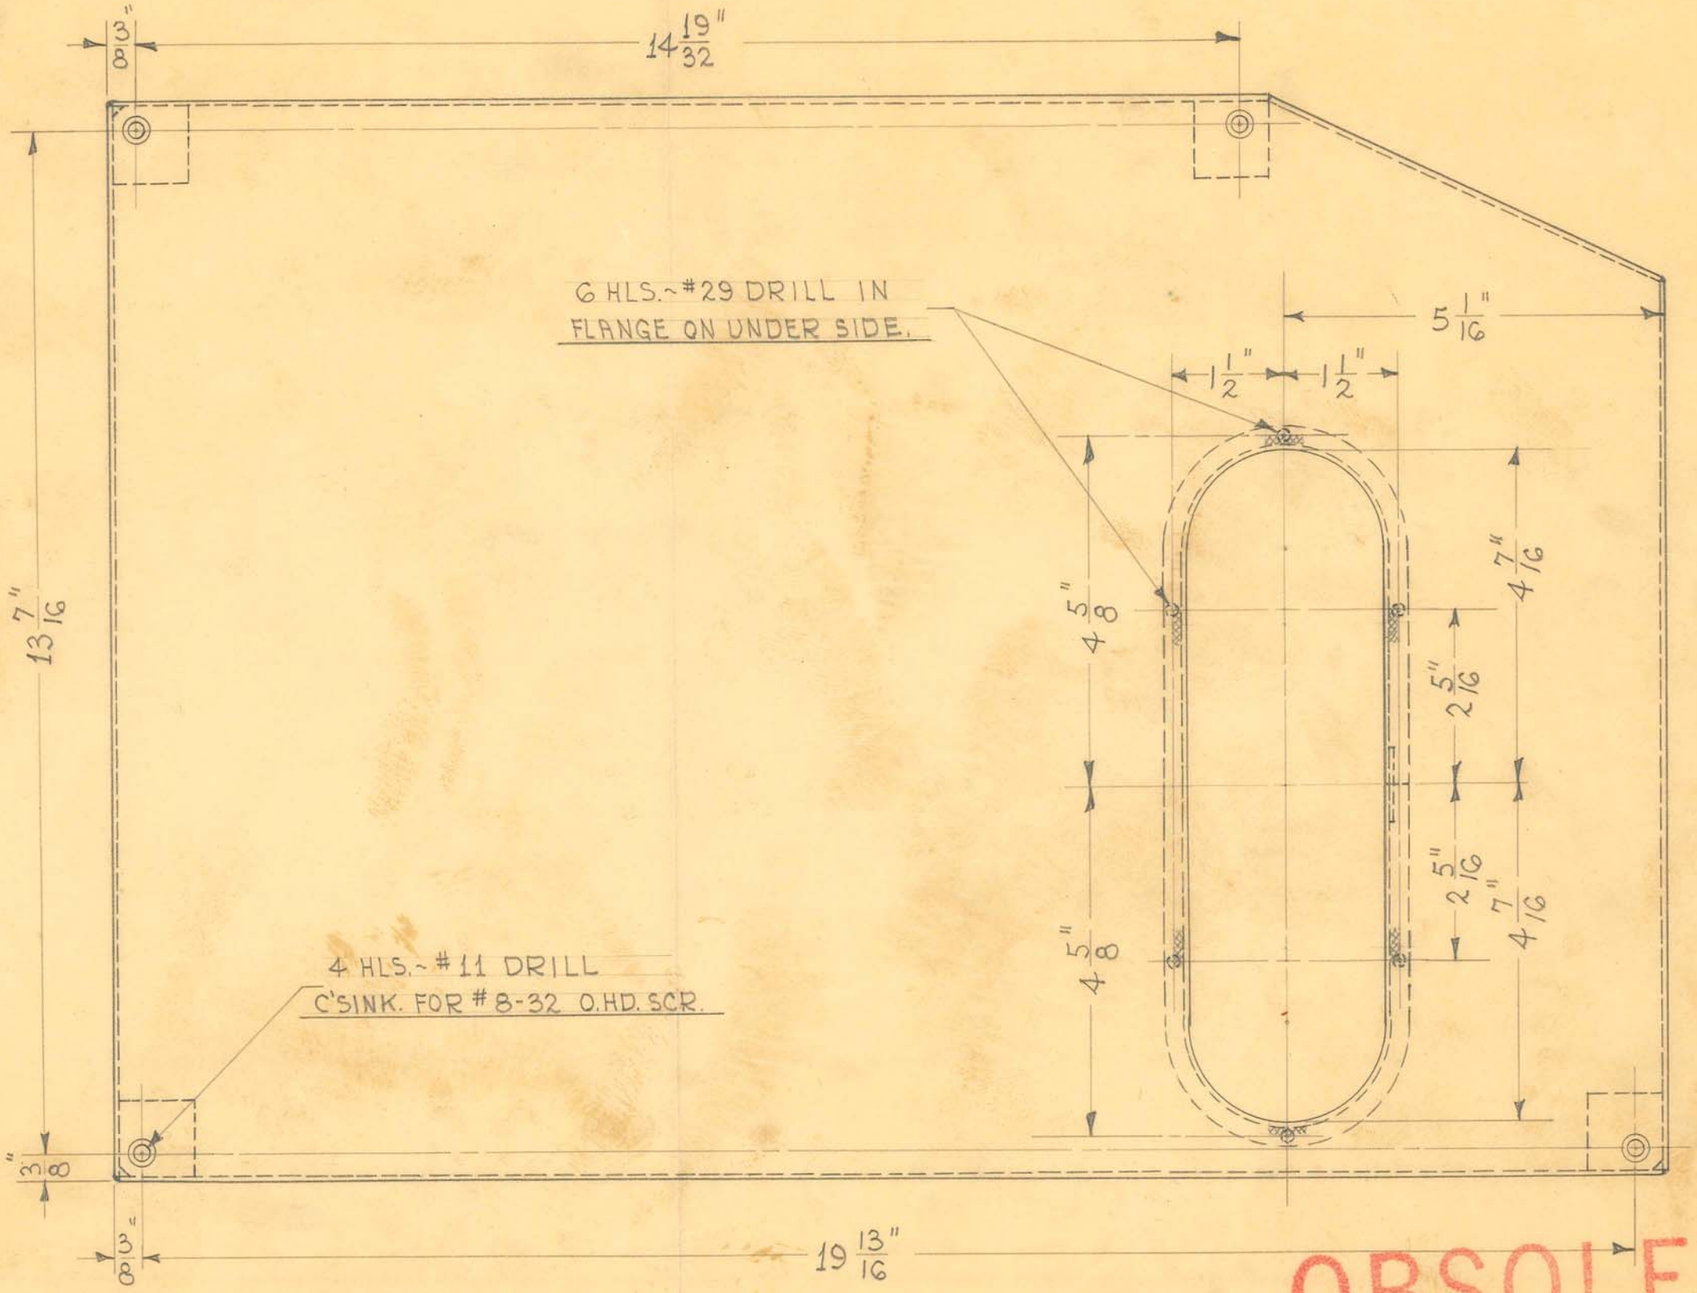

OBSOLETE

SCALE ~ 1/2" = 1"

1 REQUIRED

SIZE		ISSUE 6-28-44	HE.
KIND		CHANGED	
SHAPE		"	
FINISH	PAINTED	"	
TEMP.		"	
PATT.		"	

TITLE: FISCHER "VC" SHORT WAVE APPARATUS~ CABINET- SIDE DOOR ~ RIGHT (DRILLED)

H. G. FISCHER & CO.
2335 WABANSIA AVE.
CHICAGO, ILL.

CAT. NO.

PART NO. PART OF 15525GF

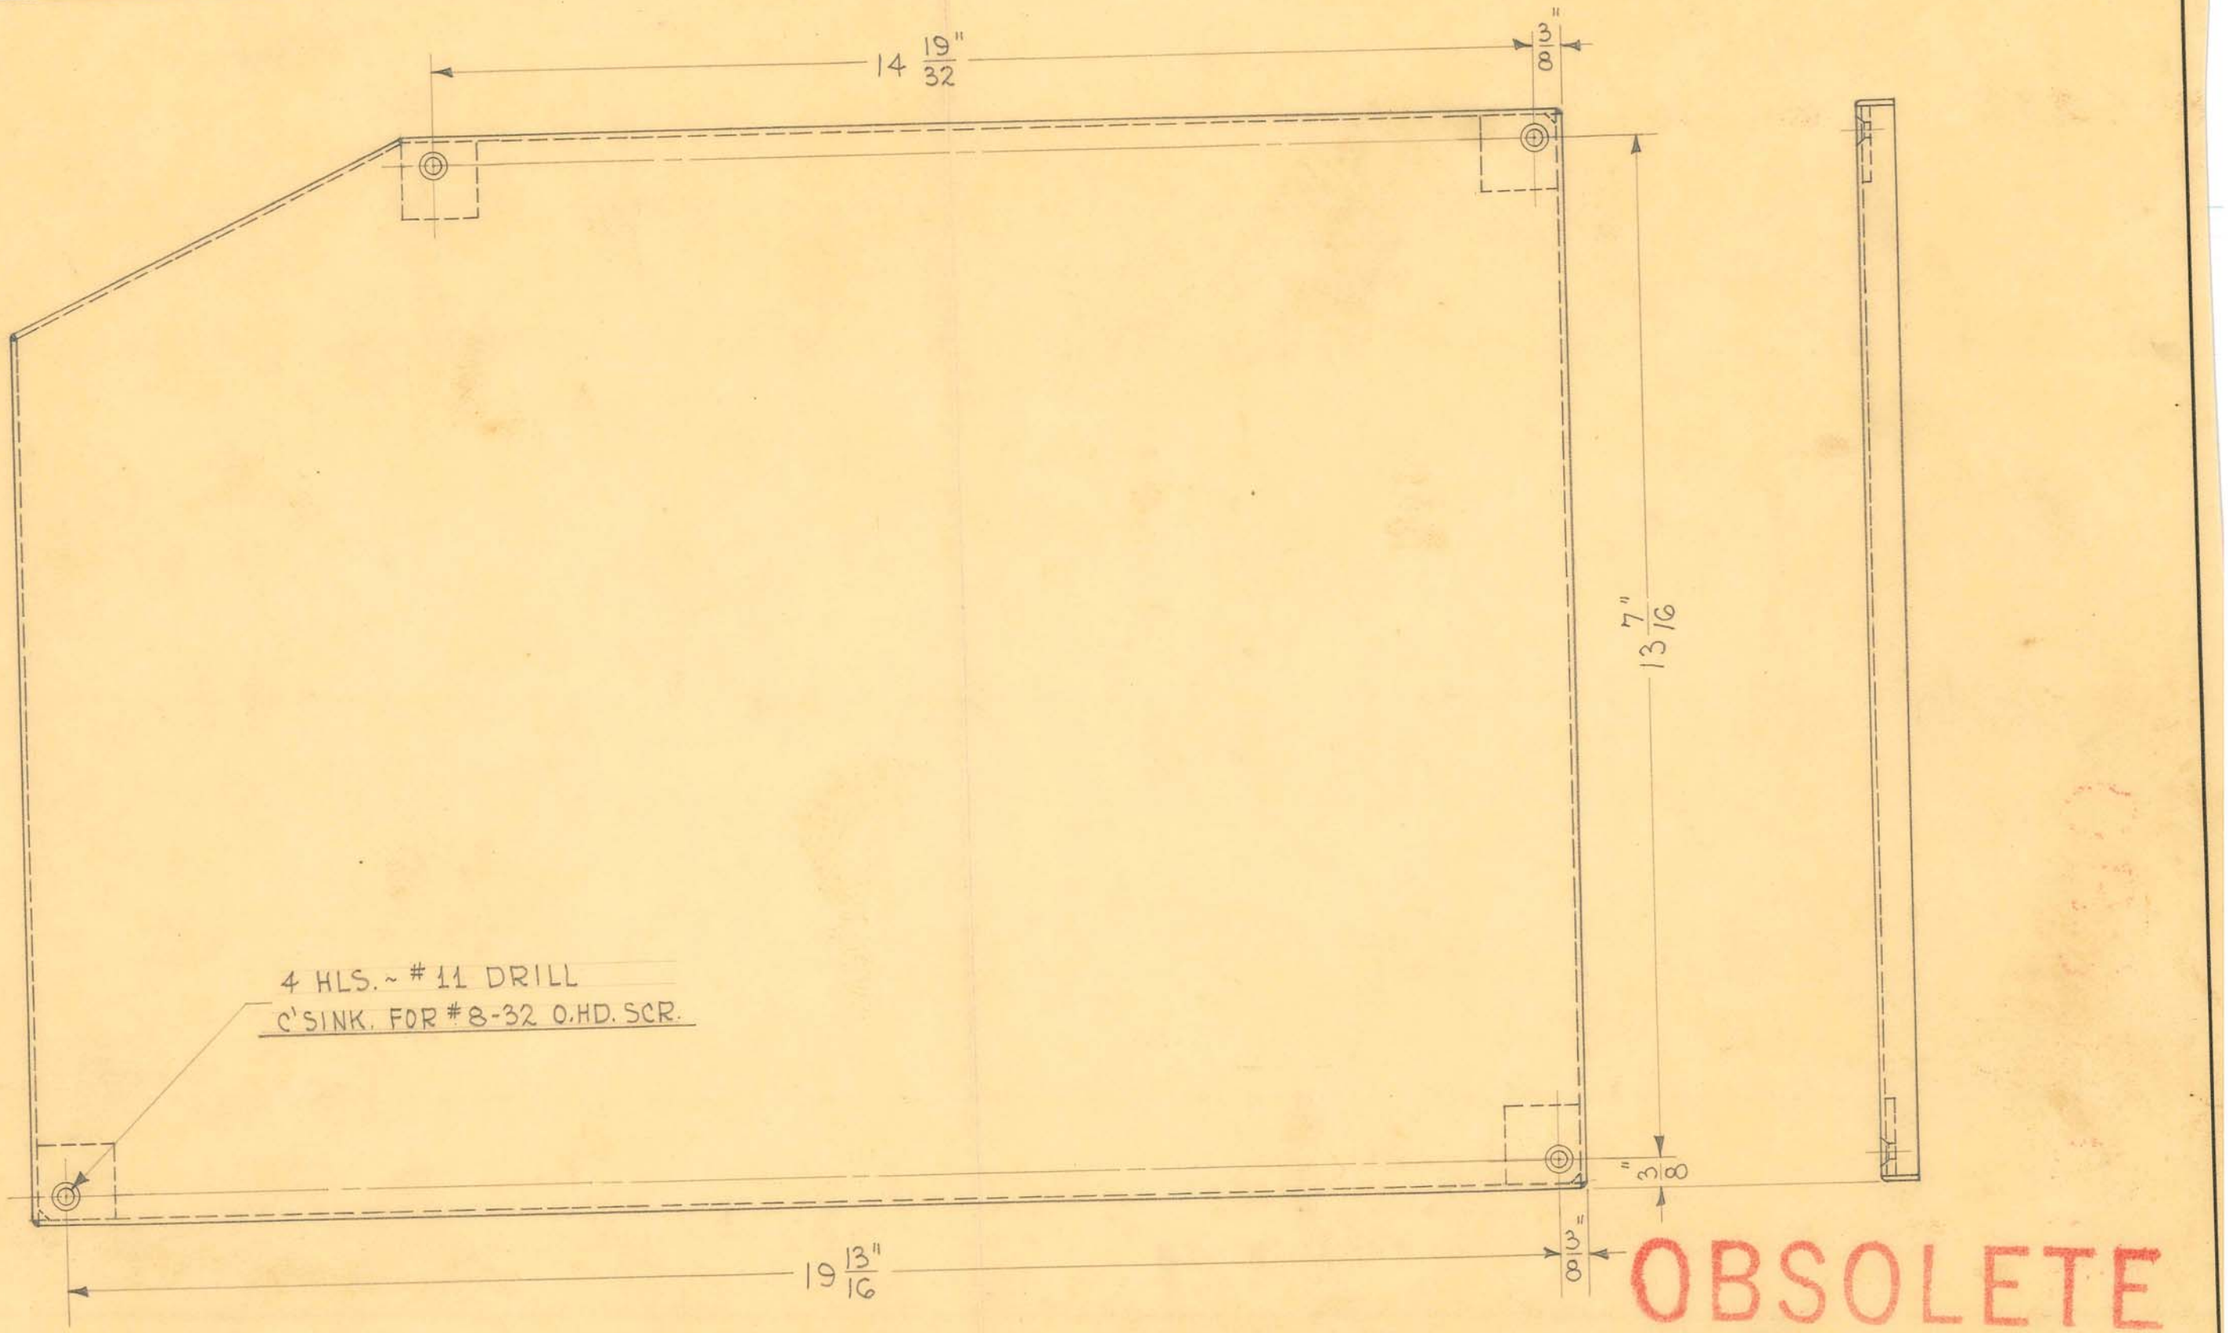

OBSOLETE

SCALE: 1/2" = 1"

1 REQUIRED

SIZE		ISSUE 6-28-44	HE.
KIND		CHANGED	
SHAPE		"	
FINISH	PAINTED	"	
TEMP.		"	
PATT.		"	

TITLE: FISCHER "VC" SHORT WAVE APPARATUS ~ CABINET ~ SIDE DOOR ~ LEFT (DRILLED)

H. G. FISCHER & CO.
2335 WABANSIA AVE.
CHICAGO, ILL.

CAT. NO.

PART NO. PART OF 15525GF

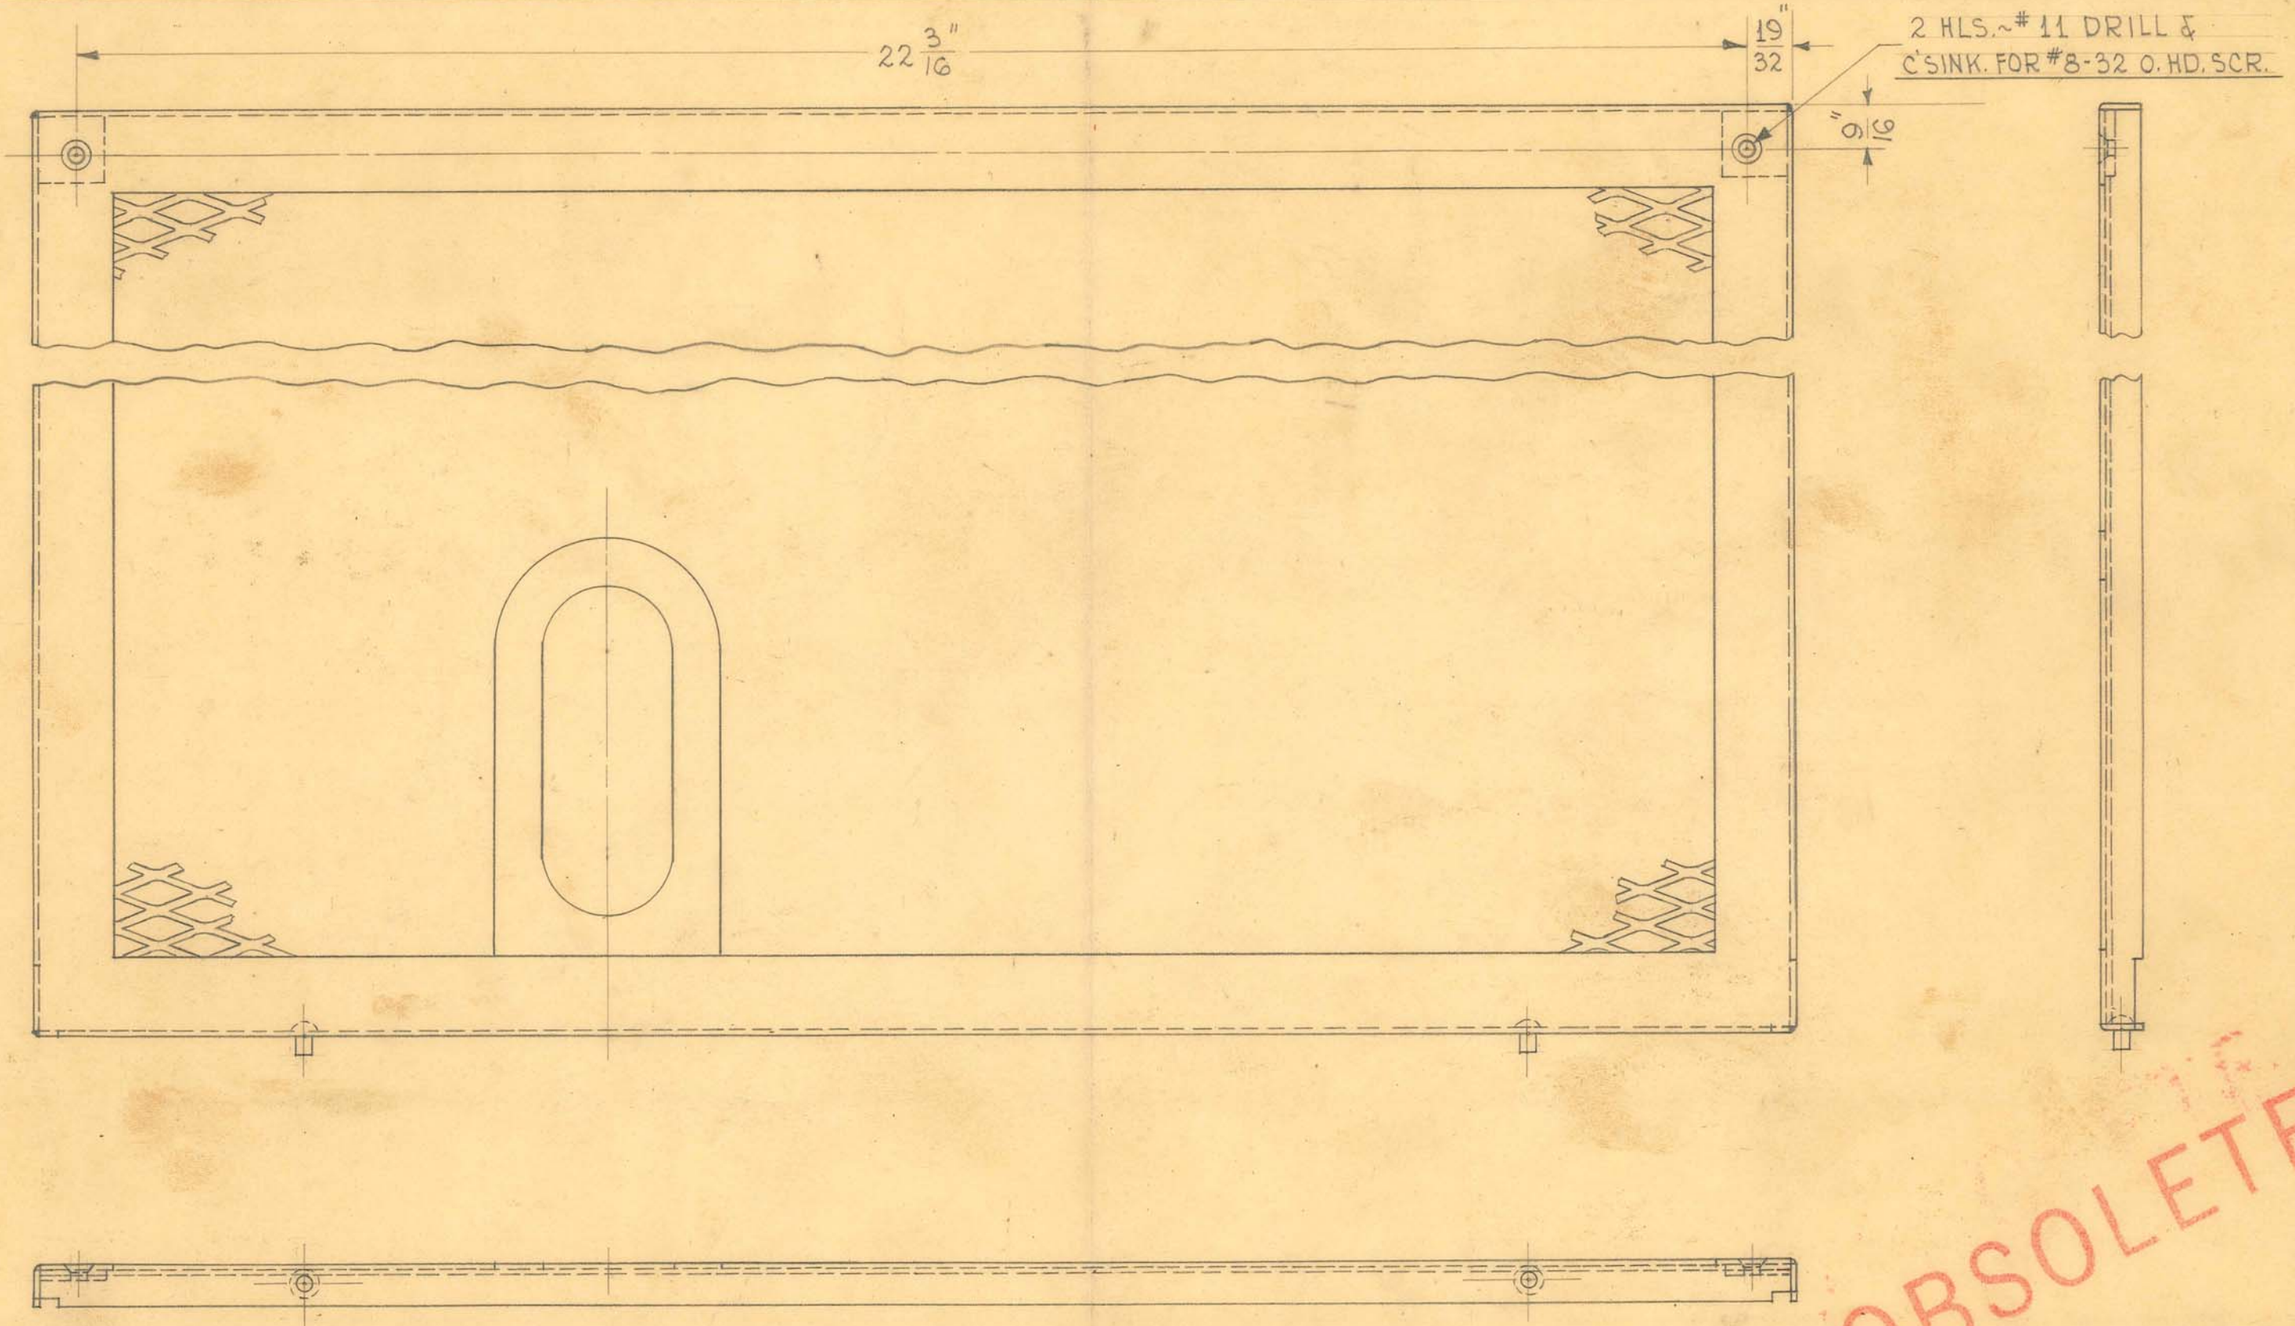

SCALE: 1/2" = 1"

1 REQUIRED

OBSOLETE

SIZE		ISSUE 7-6-44	H.
KIND		CHANGED	
SHAPE		"	
FINISH	PAINTED	"	
TEMP.		"	
PATT.		"	

TITLE: FISCHER "VC" SHORT WAVE APPARATUS ~ CABINET ~ REAR DOOR (DRILLED)

H. G. FISCHER & CO.
2335 WABANSIA AVE.
CHICAGO, ILL.

CAT. NO.

PART NO. PART OF 15525GF

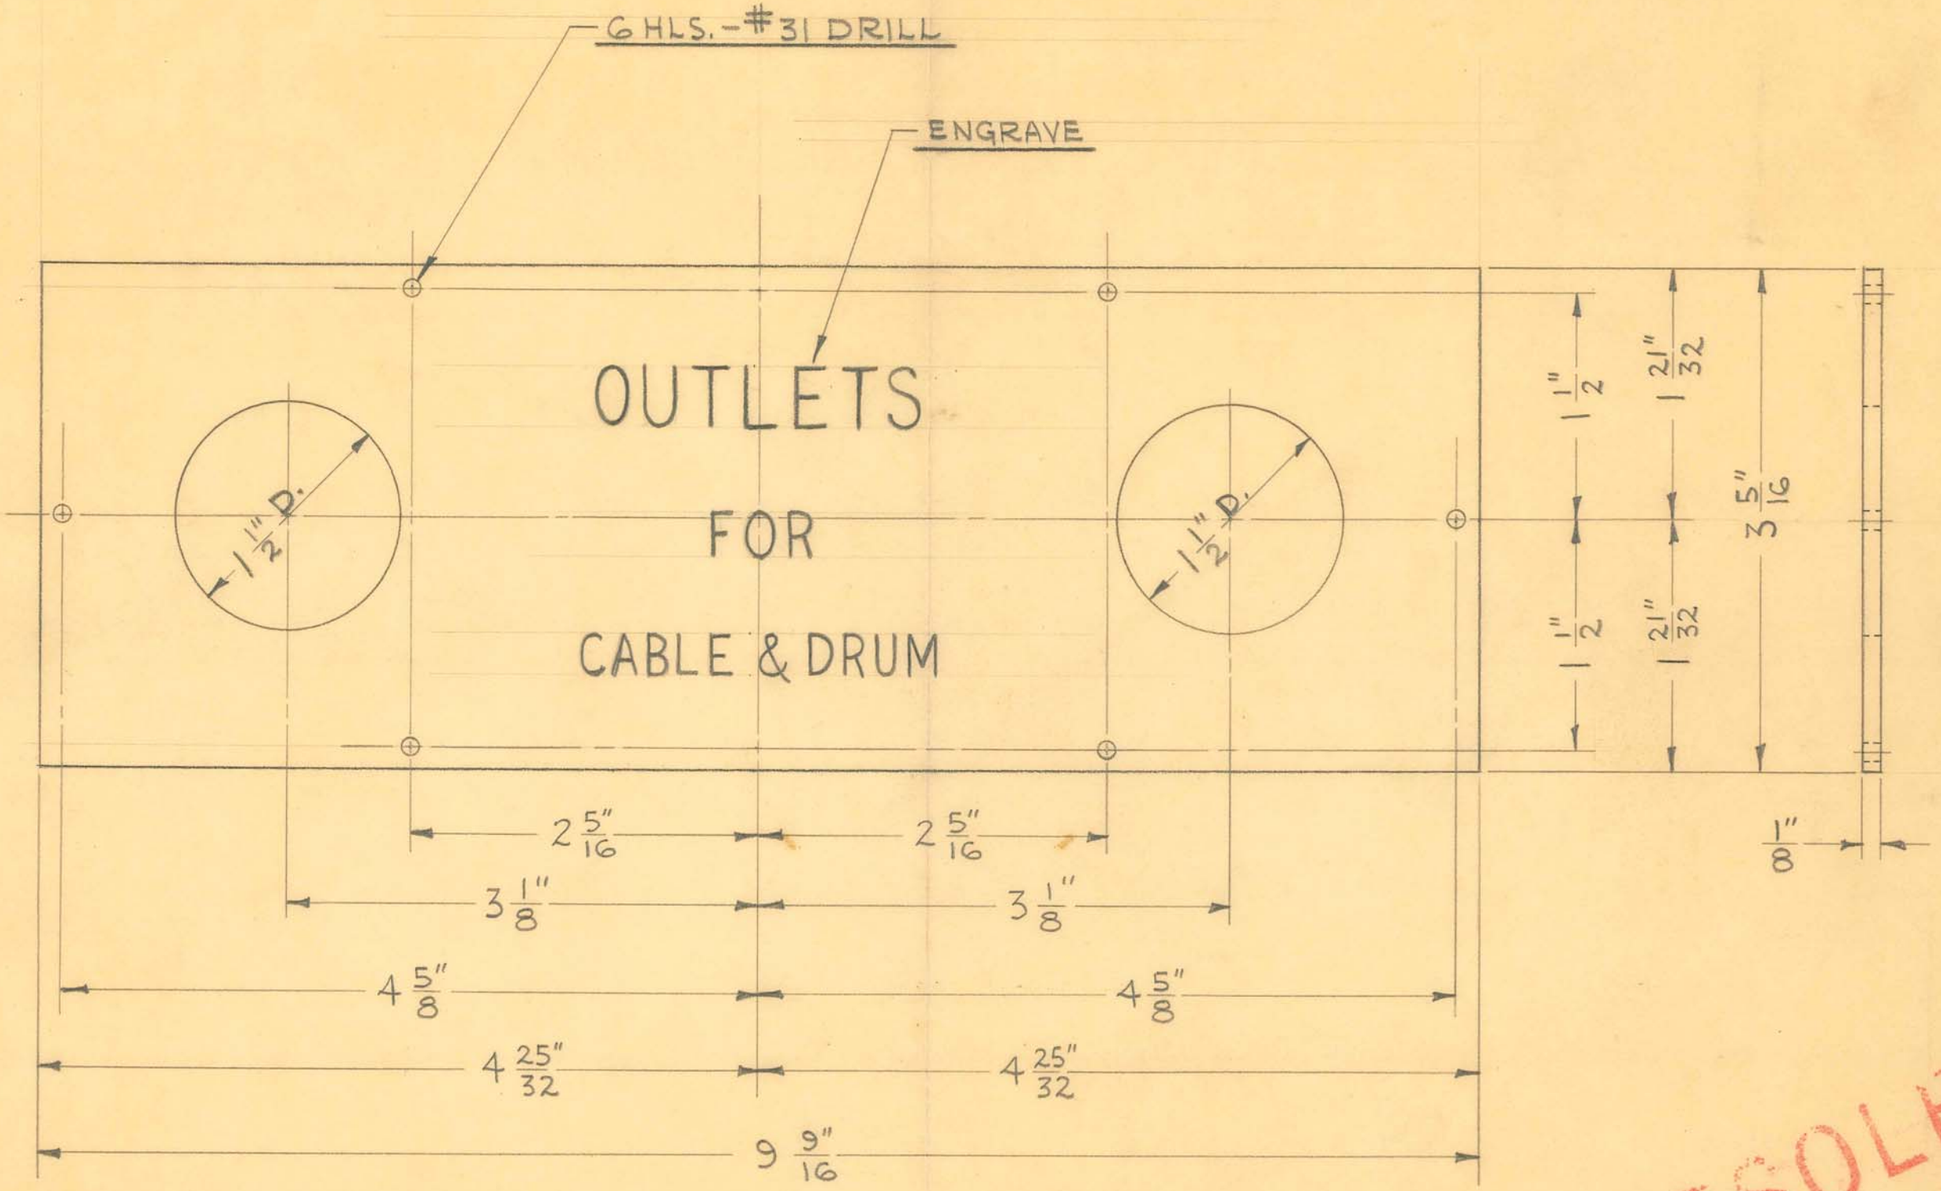

1 REQUIRED

OBSOLETE

SIZE	1/8" SHEET	ISSUE 2-29-44	J.N.W.	
KIND	WHITE CORE	CHANGED		
SHAPE	BAKELITE	"		
FINISH		"		
TEMP.		"		

TITLE:
FISCHER "VC" SHORT WAVE APP.
CABINET CABLE & DRUM PLATE

H. G. FISCHER & CO.
2335 WABANSIA AVE.

CAT. NO.

PART NO. 155264

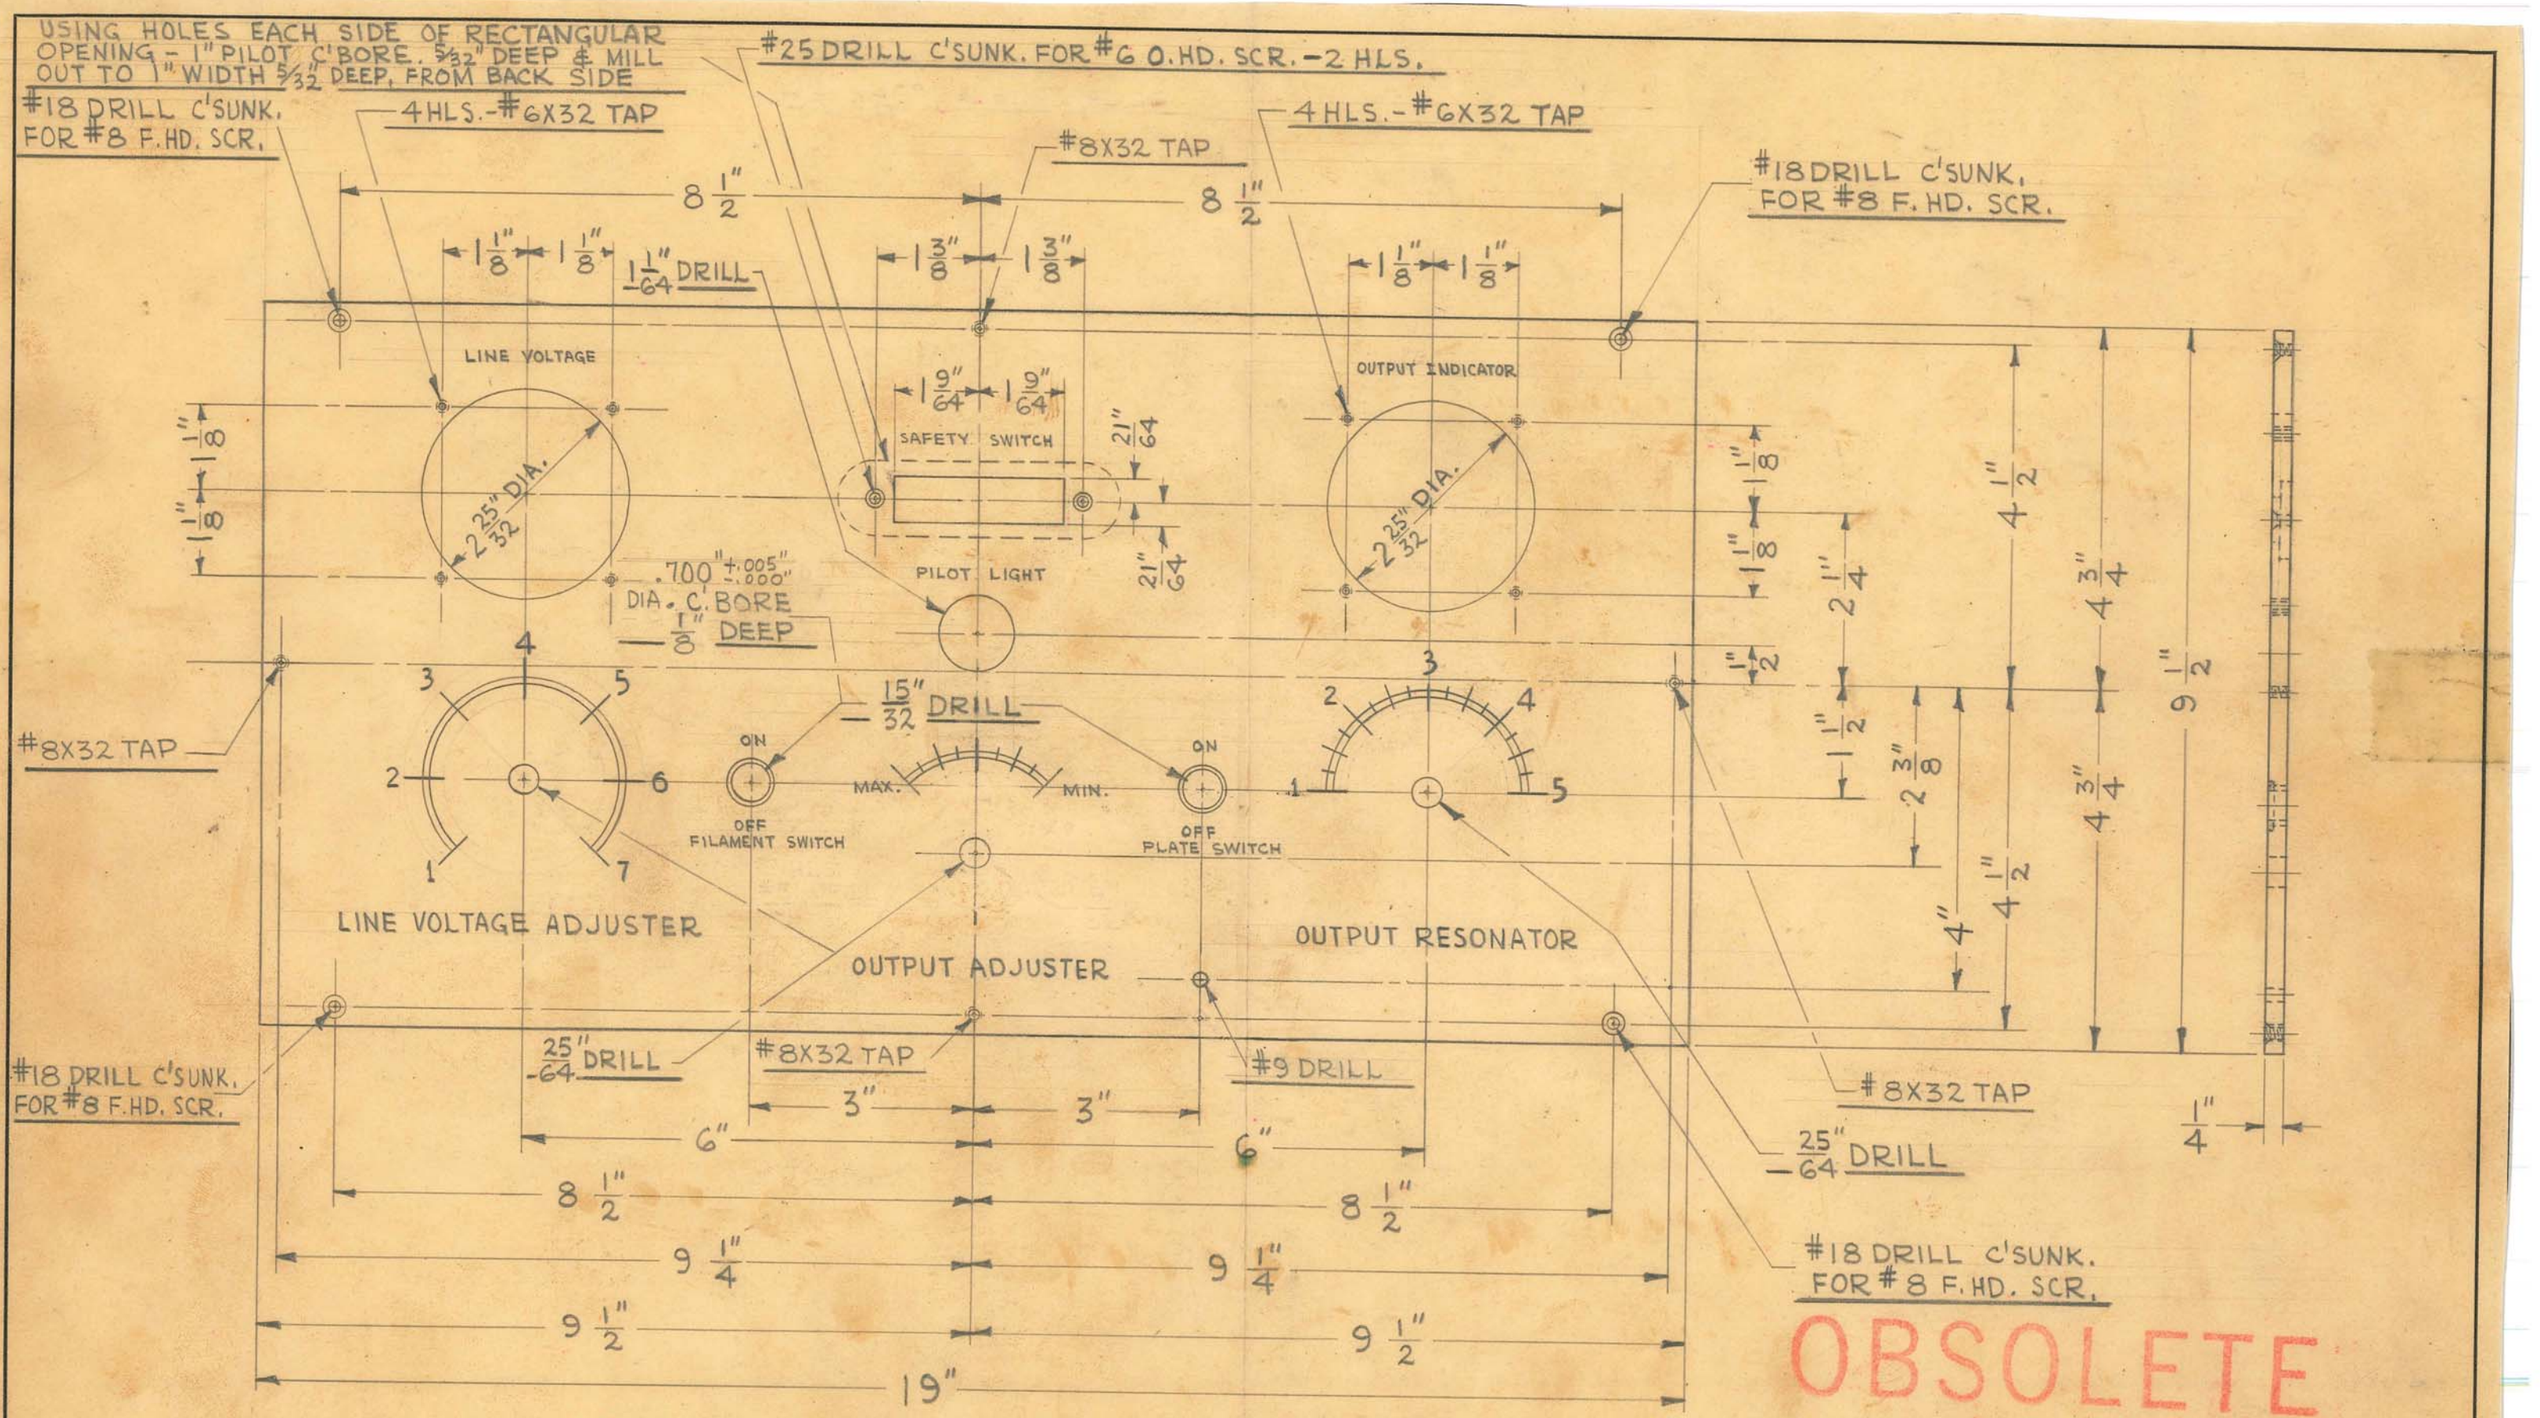

OBSOLETE

SCALE ÷ HALF SIZE

1 REQUIRED

SIZE	1/4" SHEET	ISSUE 2-21-47	J.V.W.
KIND	WHITE CORE	CHANGED	
SHAPE	BAKELITE	"	
FINISH		"	
TEMP.		"	
PATT.		"	

TITLE: FISCHER "VC" SHORT WAVE APP. AMPLIFIER COMP. – FRONT PANEL

H. G. FISCHER & CO.
2335 WABANSIA AVE.
CHICAGO, ILL.

CAT. NO.

PART NO. 15511F

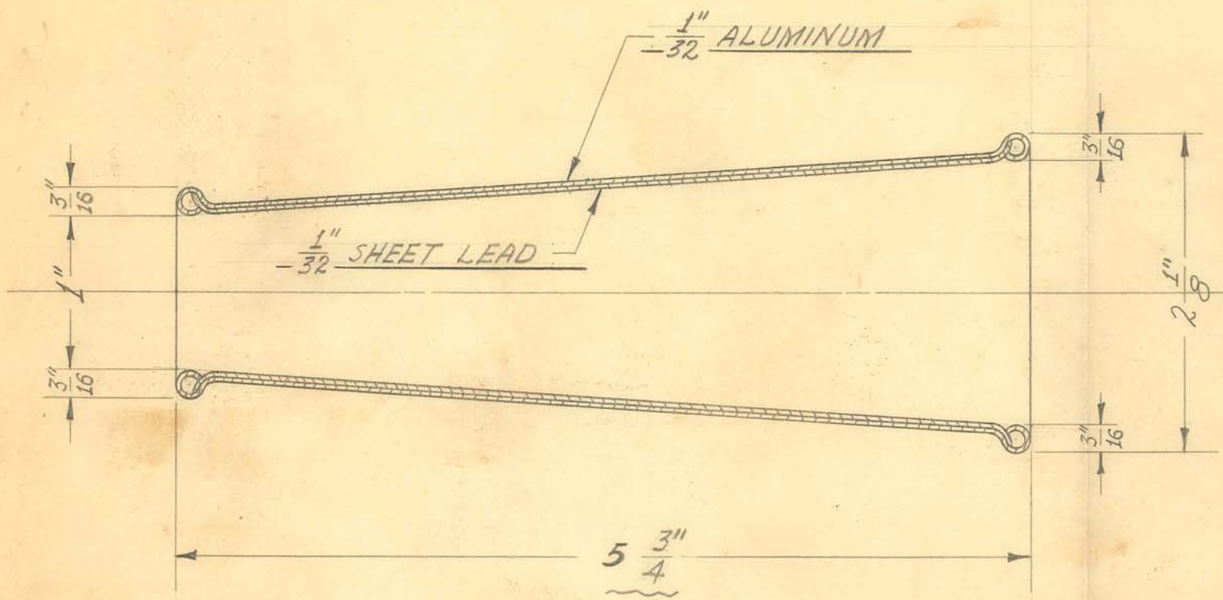

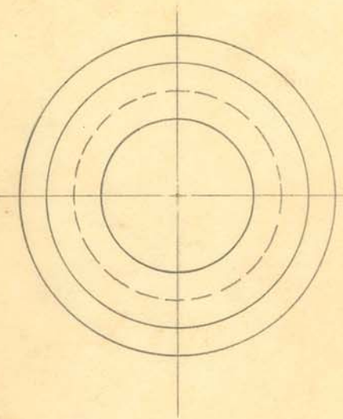

OBSOLETE

SIZE		ISSUE 11-17-39	J.W.
KIND		CHANGED	
SHAPE		"	
FINISH		"	
TEMP.		"	
PATT.		"	

TITLE:
"DSP-20" LEAD LINED CONE
1" OPENING (DISTANCE FROM TARGET TO END OF CONE = 10")

H. G. FISCHER & CO.
2335 WABANSIA AVE.
CHICAGO, ILL.

CAT. NO.

PART NO. 9623 1/2

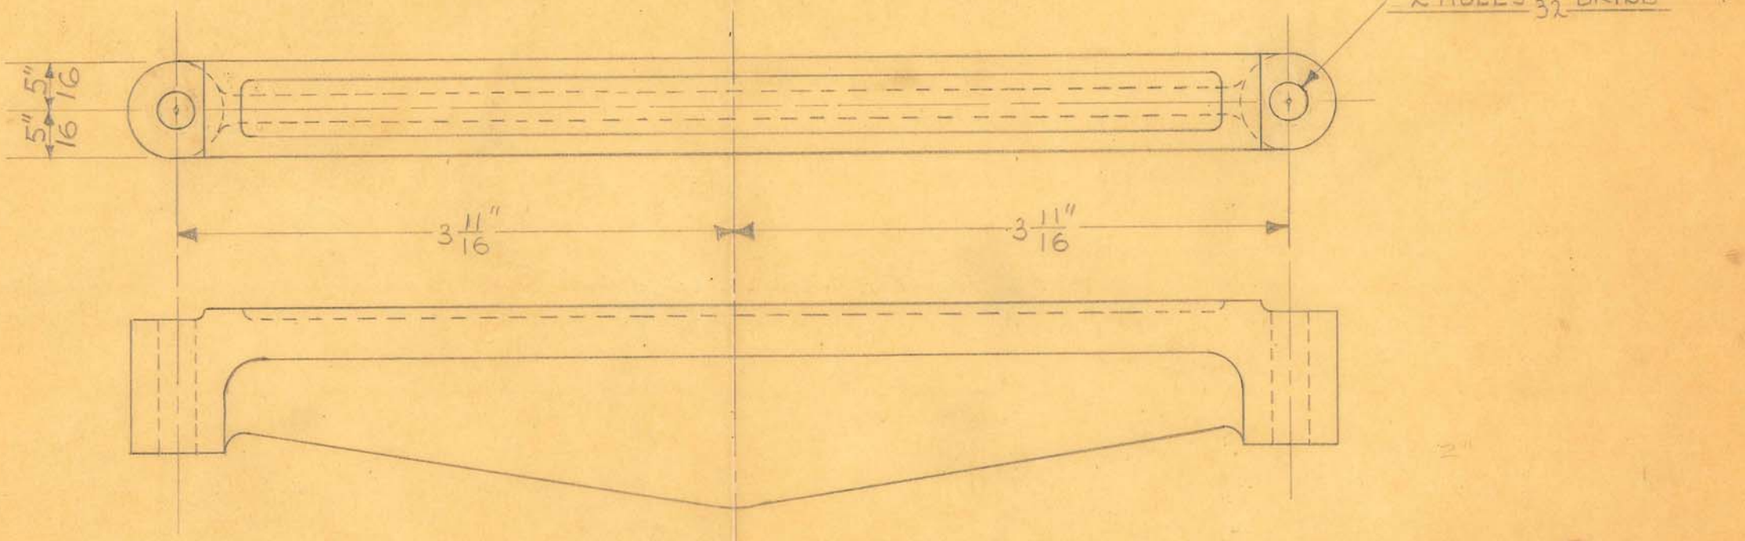

2 REQUIRED

OBSOLETE

SIZE		ISSUE 7-1-35	J.W.
KIND	IRON CASTING	CHANGED	
SHAPE		" "	
FINISH	BLACK #80	" "	
TEMP.		" "	
PART	9633-81F	" "	

TITLE: FISCHER "USW6" PORT. ULTRA SHORT WAVE GEN. POWER TRANSF. SUPPORT - UPPER

H. G. FISCHER & CO.
2335 WABANSIA AVE.
CHICAGO, ILL.

CAT. NO.

PART NO. 9633F

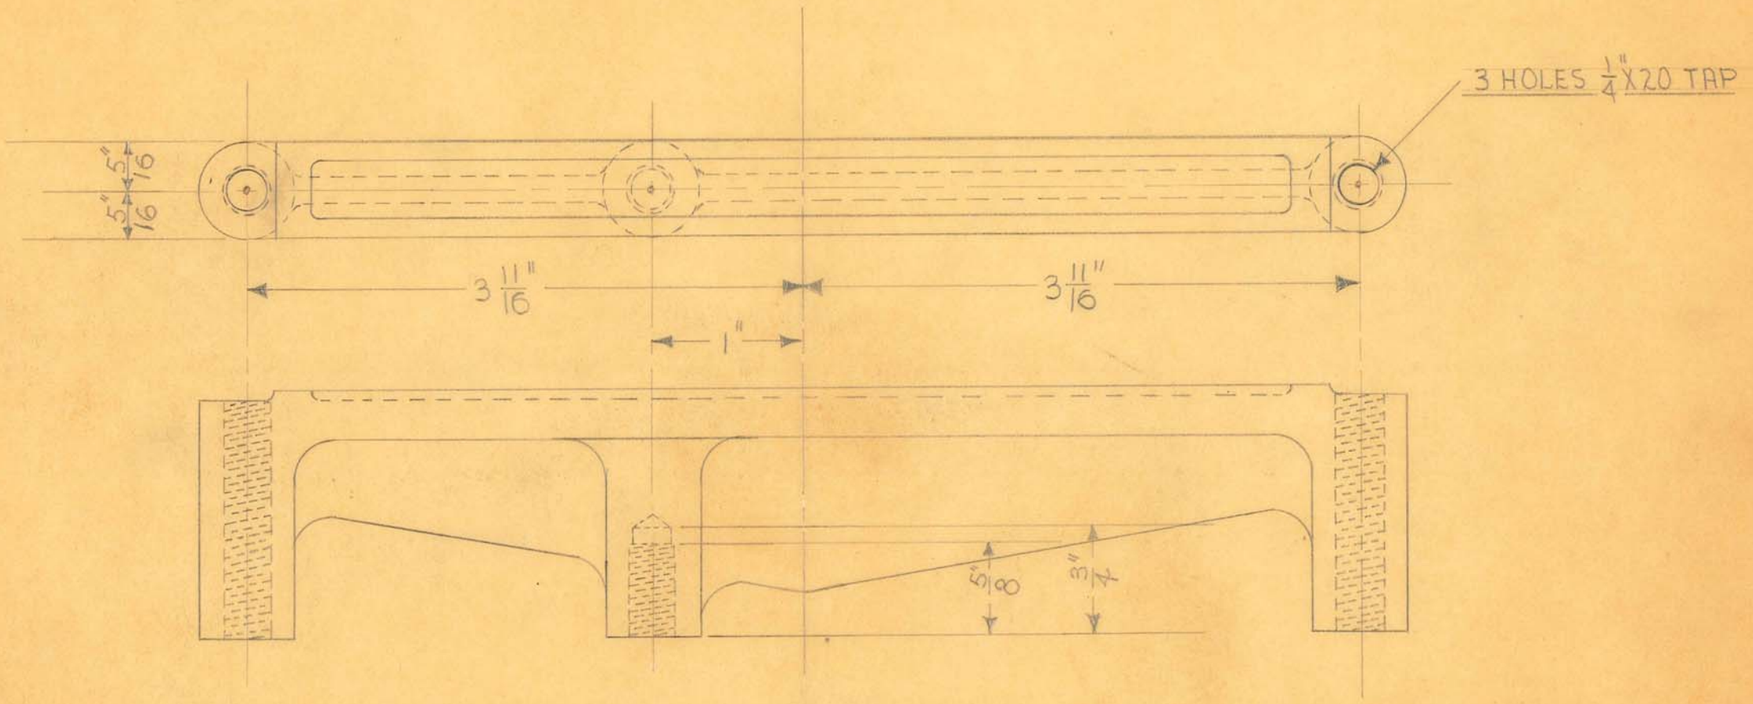

2 REQUIRED

OBSOLETE

SIZE		ISSUE 7-1-35	J.W.	TITLE: FISCHER "USW6" PORT. ULTRA SHORT WAVE GEN. POWER TRANSF. SUPPORT - LOWER
KIND	IRON CASTING	CHANGED		
SHAPE		" "		
FINISH	BLACK #80	" "		
TEMP.		" "		

H. G. FISCHER & CO.
2335 WABANSIA AVE.
CHICAGO, ILL.

CAT. NO.

PART NO. 9634F

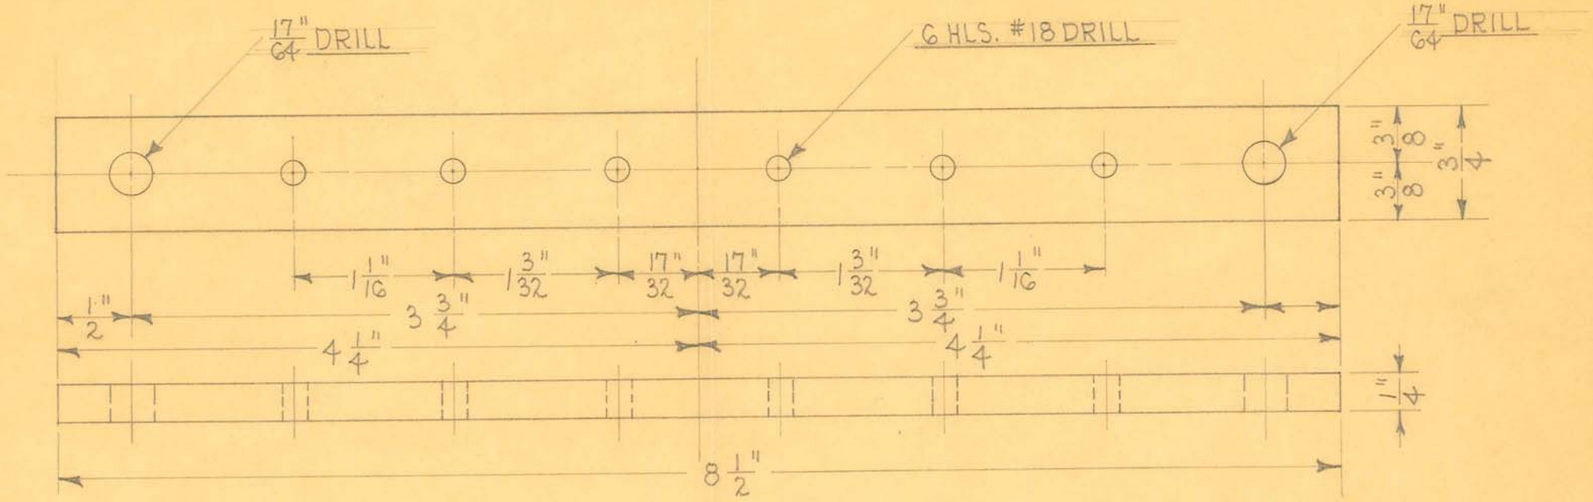

2 REQUIRED

OBSOLETE

SIZE	1/4" RICHELAIN	ISSUE 11-6-35	J.E.
KIND	BAKELITE	CHANGED	
SHAPE	SHEET	" "	
FINISH		" "	
TEMP.		" "	
PATT.		" "	

TITLE: FISCHER "USW-G" PORT. ULTRA SHORT WAVE GEN. POWER TRANSFORMER TERMINAL STRIP

H. G. FISCHER & CO.
2335 WABANSIA AVE.
CHICAGO, ILL.

CAT. NO.

PART NO. 9635

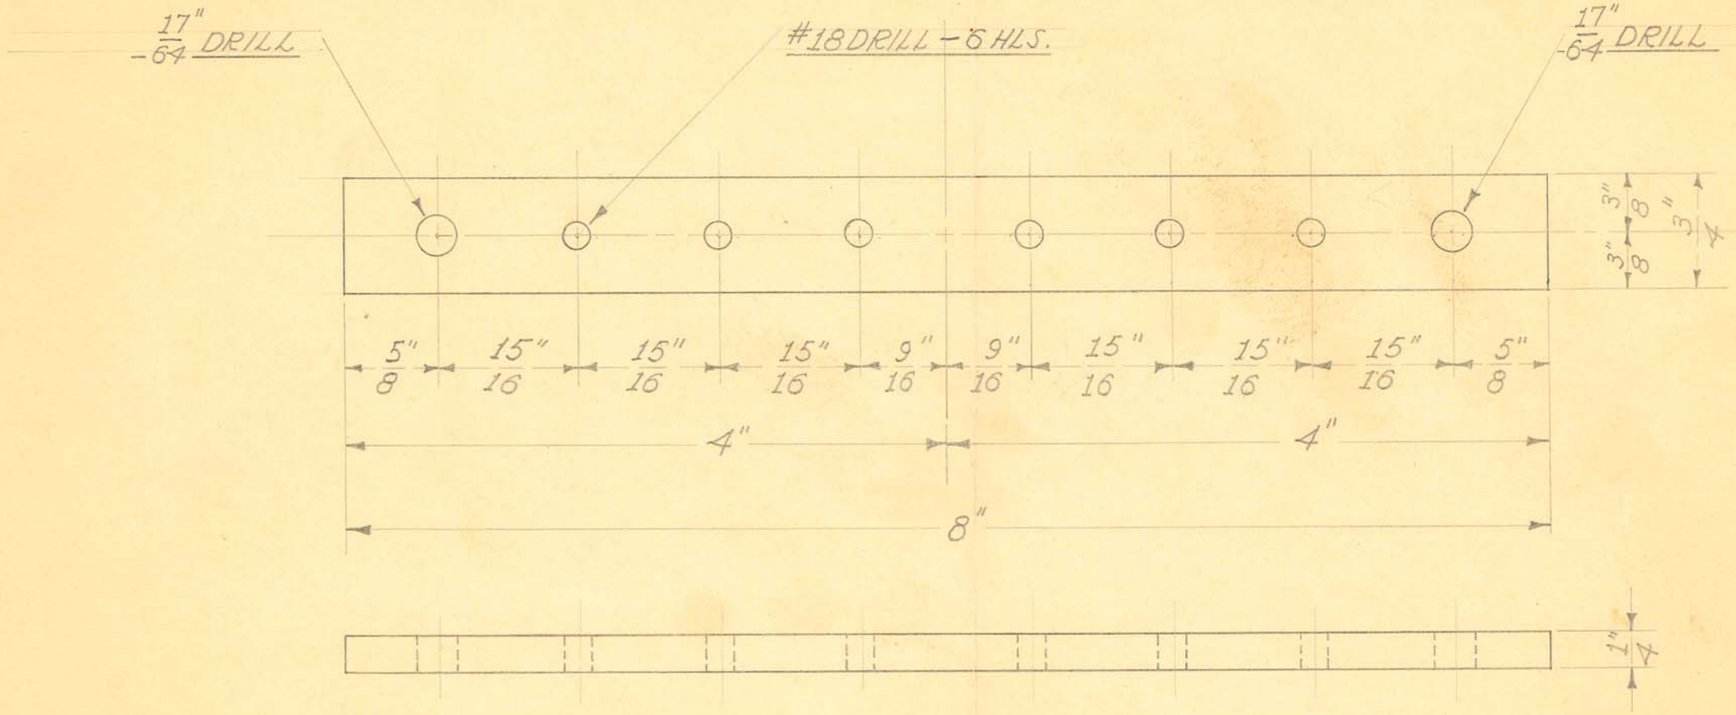

2 REQUIRED

OBSOLETE

SIZE	1/4" SHEET	ISSUE 10-9-35	J.W.	
KIND	BAKELITE	CHANGED		
SHAPE		"		
FINISH		"		
TEMP.		"		
PATT.		"		

TITLE: 25 CYCLE "SW-12" PORT. SHORT WAVE TRANSFORMER TERMINAL STRIP

H. G. FISCHER & CO.
2335 WABANSIA AVE.
CHICAGO, ILL.

CAT. NO.

PART NO. 9635 1/2

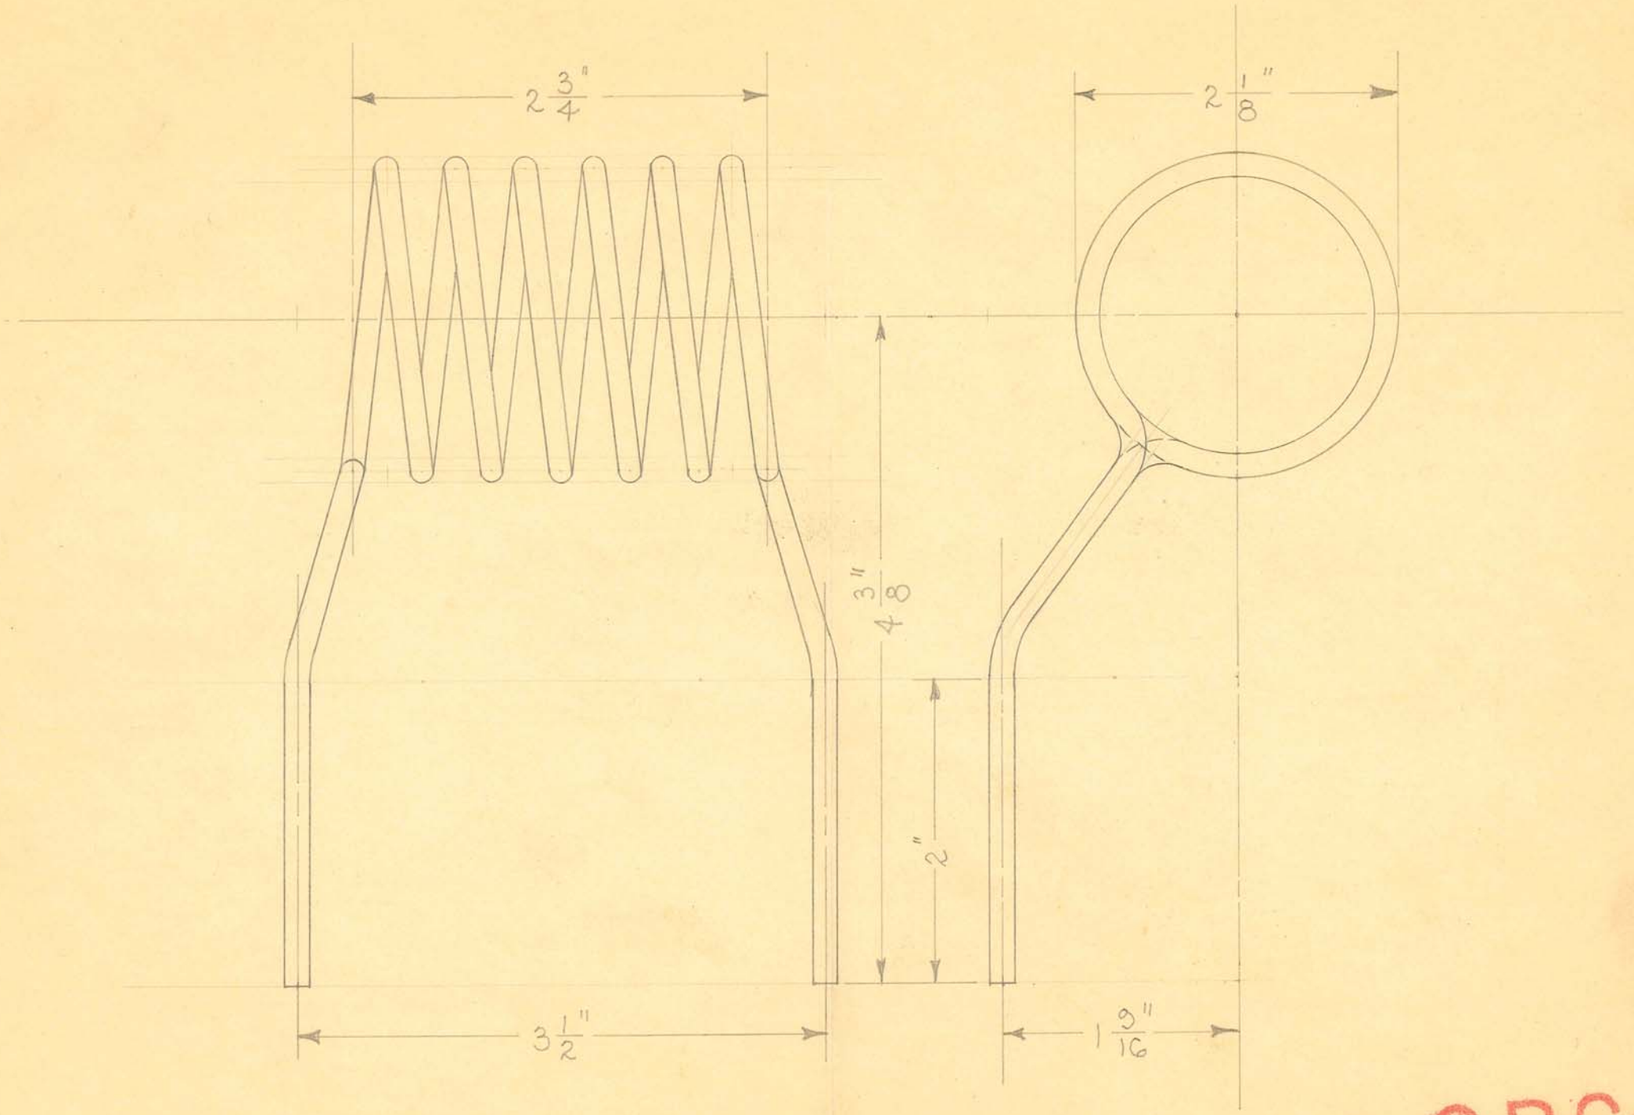

6 TURNS
1 REQUIRED

OBSOLETE
Obsolete

SIZE	#6	ISSUE 9-9-36	A.E.	TITLE: FISCHER "USWG" PORT. ULTRA SHORT WAVE GEN. PLATE COIL
KIND	COPPER WIRE	CHANGED		
SHAPE		"		
FINISH		"		
TEMP.		"		
PATT.		"		

H. G. FISCHER & CO.
2335 WABANSIA AVE.
CHICAGO, ILL.

CAT. NO.

PART NO. 9637A

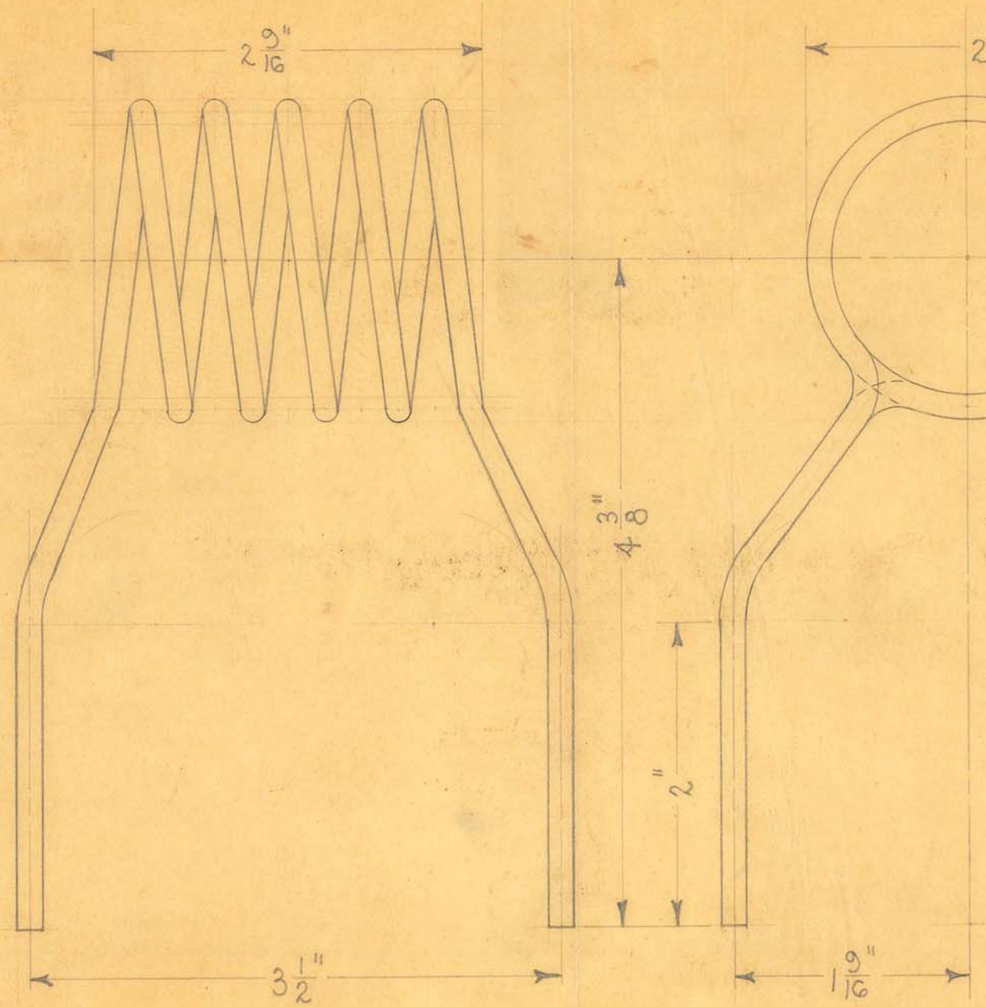

5 TURNS
1 REQUIRED

OBSOLETE

SIZE	#6	ISSUE 7-22-35	A.C.
KIND	COPPER WIRE	CHANGED	
SHAPE		" "	
FINISH		" "	
TEMP.		" "	
PATT.		" "	

TITLE:
FISCHER "USWG" PORT. ULTRA SHORT WAVE
GEN. PLATE COIL

H. G. FISCHER & CO.
2335 WABANSIA AVE.
CHICAGO, ILL.

CAT. NO.

PART NO. 9637

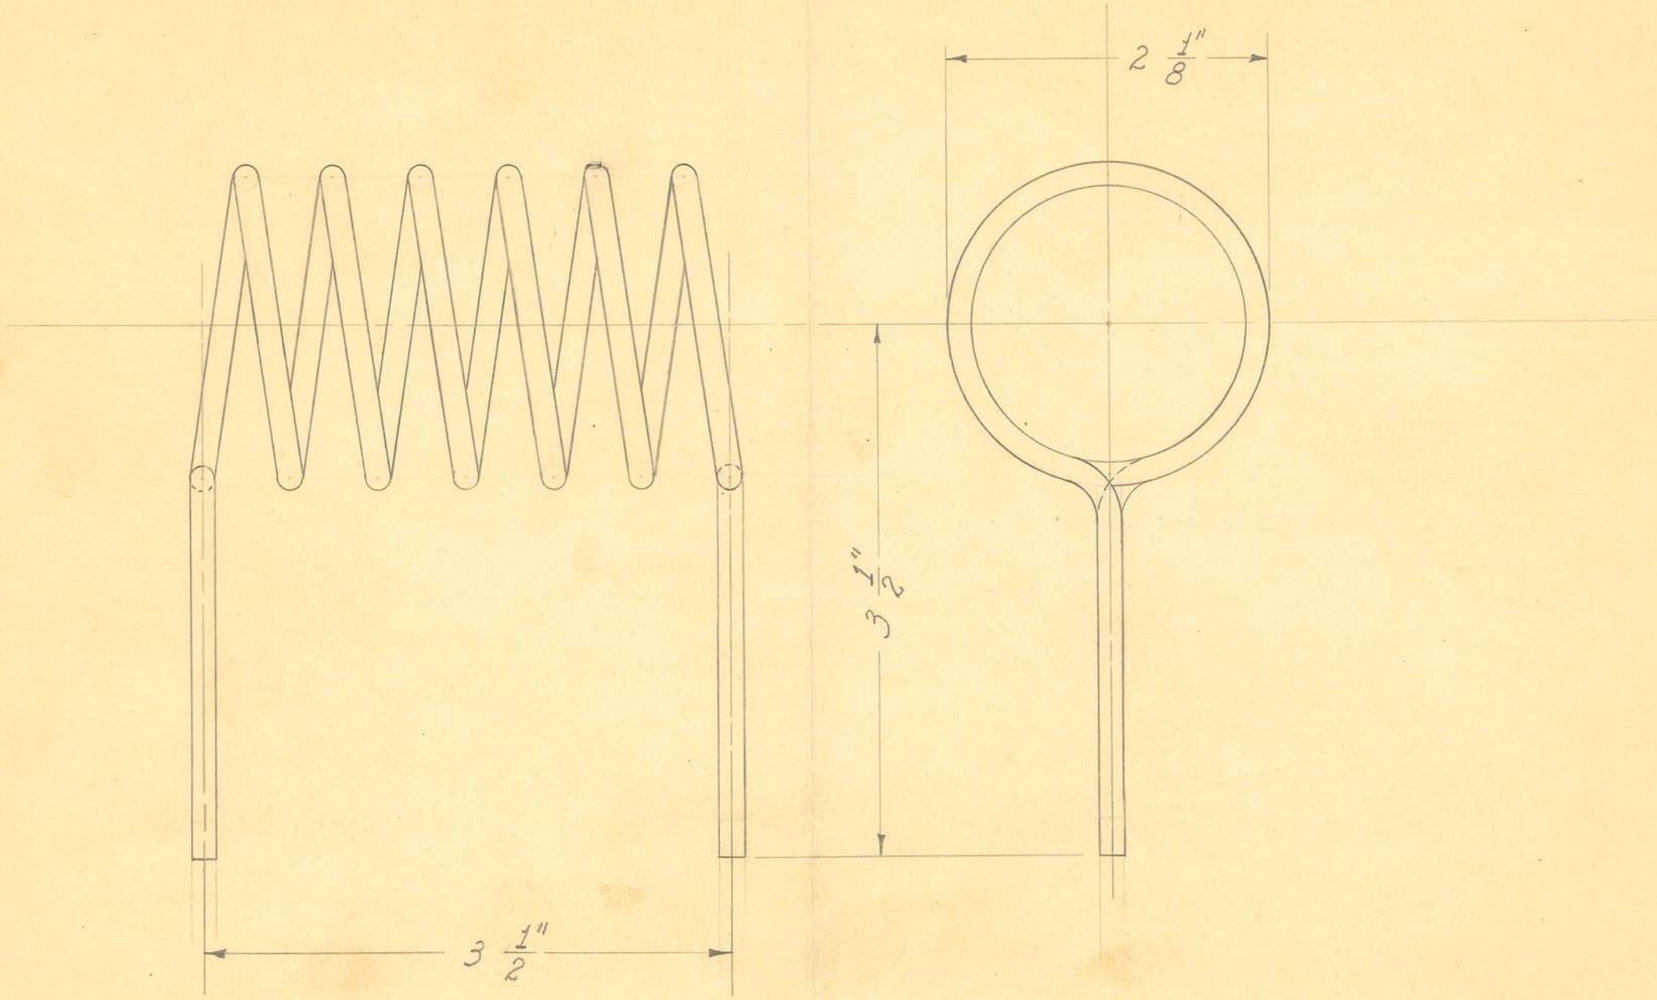

6 TURNS
1 REQUIRED

OBSOLETE

SIZE	#6 BARE	ISSUE 3-25-37	J.W.	TITLE: FISCHER "USW-6" PORT. ULTRA SHORT WAVE GEN. PLATE COIL
KIND	COPPER WIRE	CHANGED		
SHAPE		"		
FINISH		"		
TEMP.		"		
PATT.		"		

H. G. FISCHER & CO.
2335 WABANSIA AVE.
CHICAGO, ILL.

CAT. NO.

PART NO. 9637B

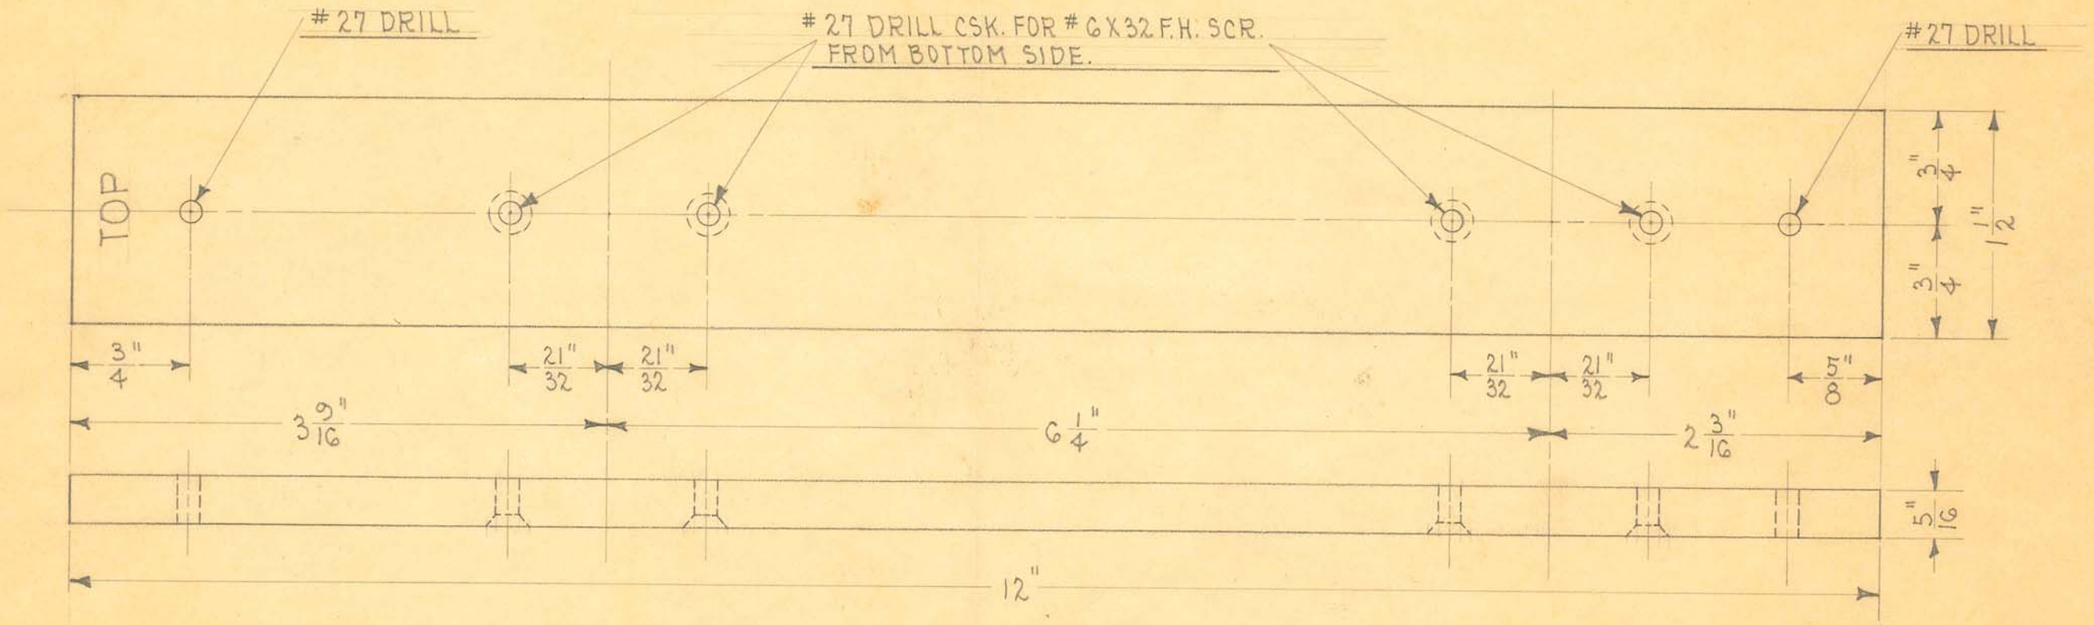

1 REQUIRED

OBSOLETE

SIZE		ISSUE 2-22-35	A.E.
KIND		CHANGED	
SHAPE		" "	
FINISH		" "	
TEMP.		" "	
PATT.		" "	

TITLE: SHORT WAVE HIGH FREQ. OUTFIT AUXILLIARY TUNING COIL MTG. BOARD

H. G. FISCHER & CO.
2335 WABANSIA AVE.
CHICAGO, ILL.

CAT. NO.

PART NO. 8708 1/2 F

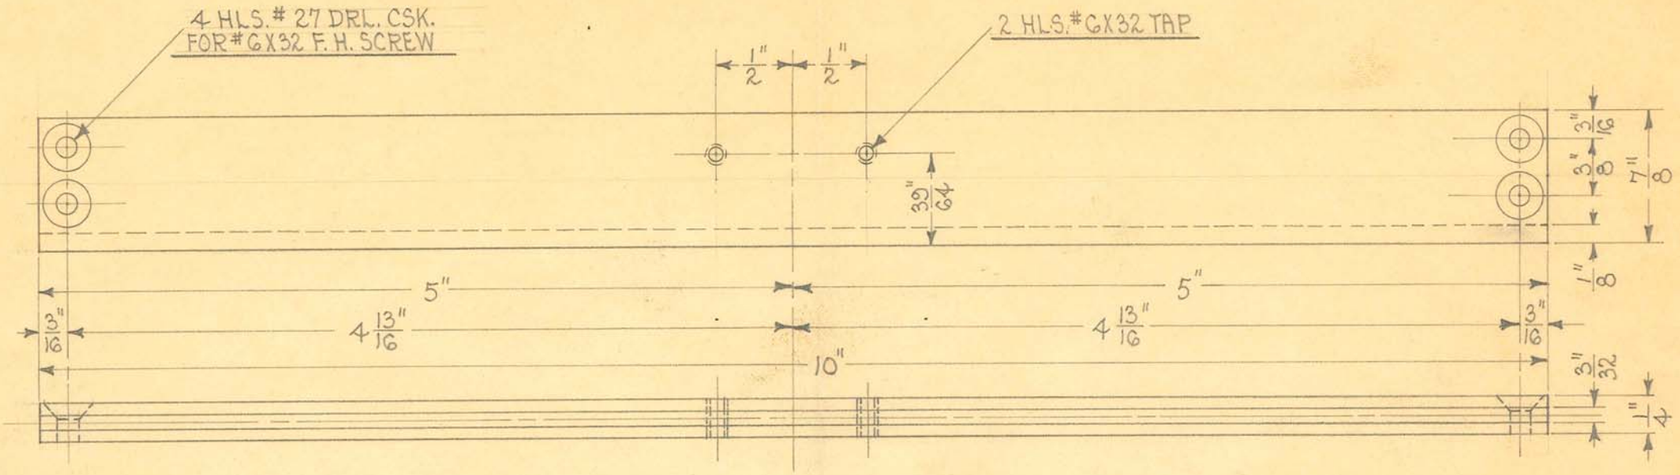

1 REQUIRED

OBSOLETE

SIZE	1/4" SHEET BLACK	ISSUE 3-28-33	H.E.	TITLE: SHORT WAVE HIGH FREQ. OUTFIT VARIOMETER RACK SUPP. - FRONT
KIND	BAKELITE X-X	CHANGED		
SHAPE		" "		
FINISH		" "		
TEMP.		" "		H. G. FISCHER & CO. 2335 WABANSIA AVE. CHICAGO, ILL. — CAT. NO. — PART NO. 8713
PATT.		" "		

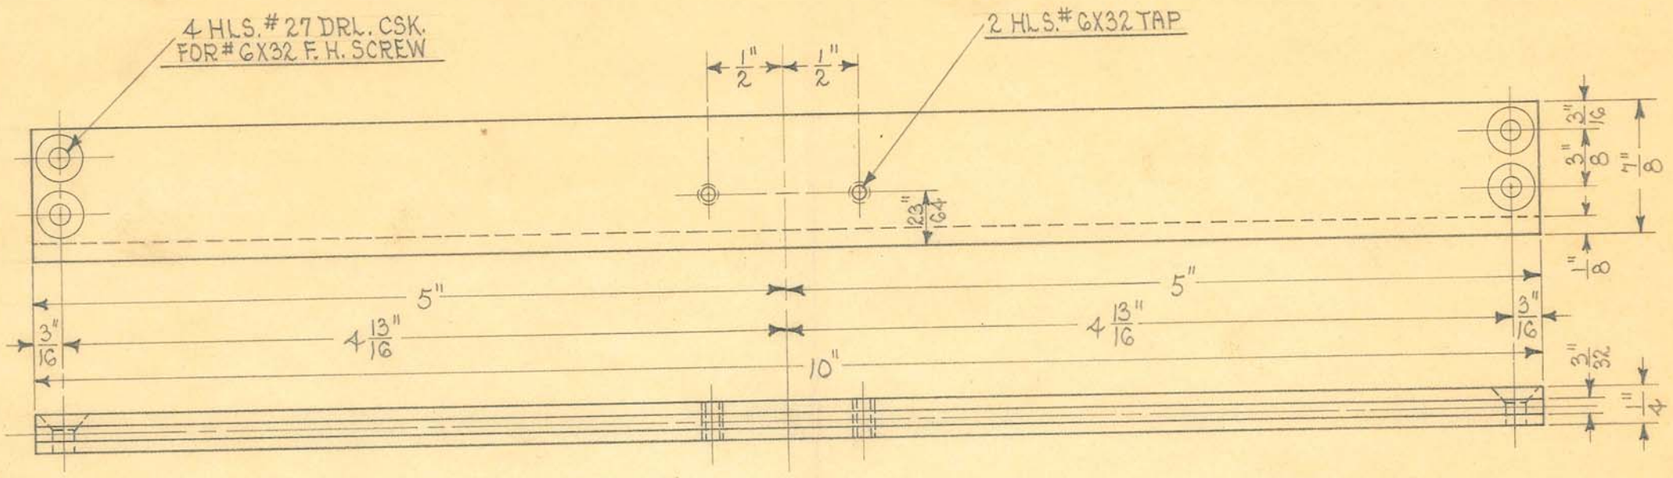

1 REQUIRED

OBSOLETE

SIZE	1/4" SHEET BLACK	ISSUE 3-28-33	H.E.	TITLE: SHORT WAVE HIGH FREQ. OUTFIT VARIOMETER RACK SUPP. - REAR
KIND	BAKELITE "XX"	CHANGED		
SHAPE		" "		
FINISH		" "		
TEMP.		" "		H. G. FISCHER & CO. 2335 WABANSIA AVE. CHICAGO, ILL. — CAT. NO. — PART NO. 8714
PATT.		" "		

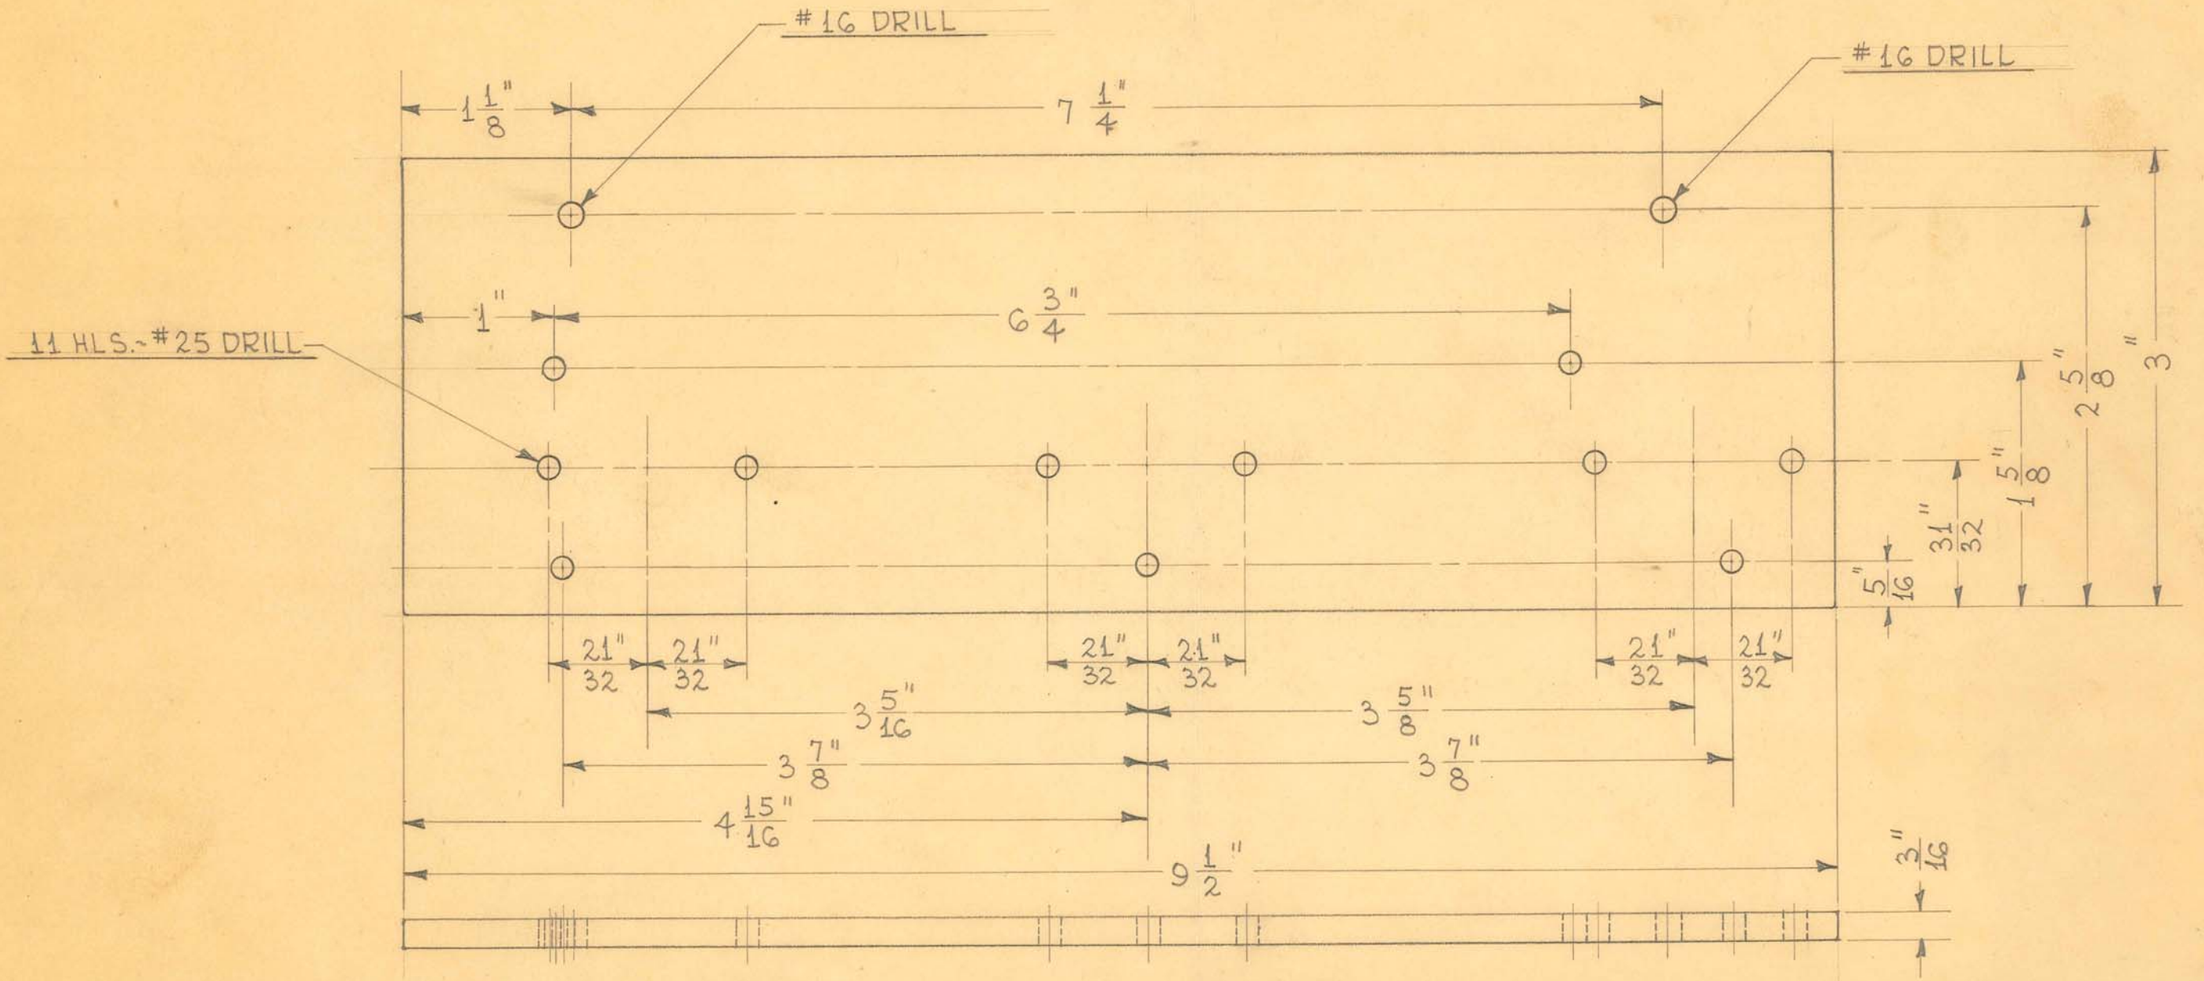

1 REQUIRED

OBSOLETE

SIZE	3/16" SHEET	ISSUE 3-15-45	HE.
KIND	TRANSITE	CHANGED	
SHAPE		"	
FINISH		"	
TEMP.		"	
PATT.		"	

TITLE: FISCHER MOD."A" SHORT WAVE OUTFIT- PLATE COIL MOUNTING BOARD

H. G. FISCHER & CO.
2335 WABANSIA AVE.
CHICAGO, ILL.

CAT. NO.

PART NO. 16056

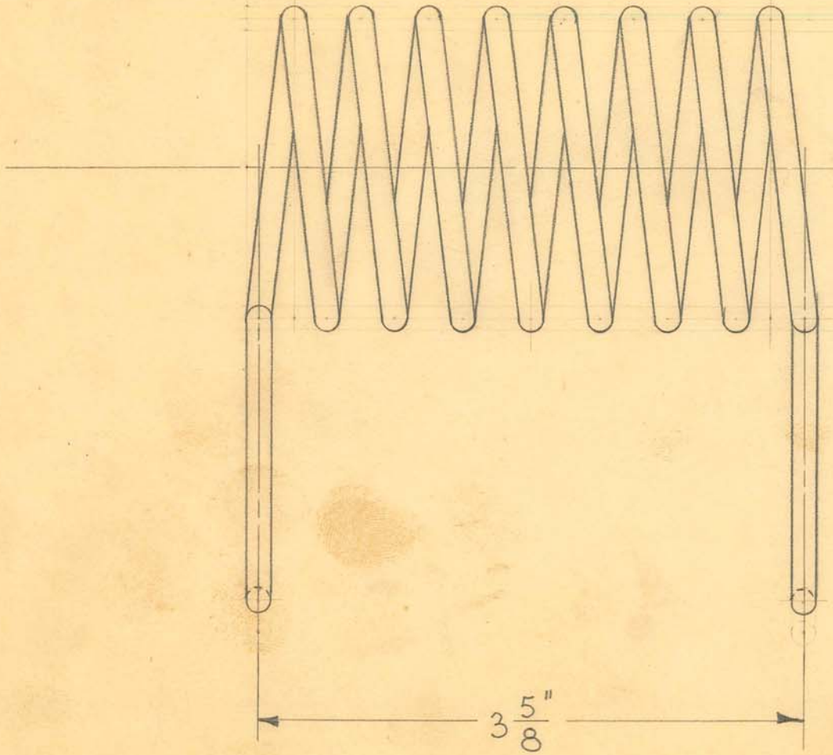

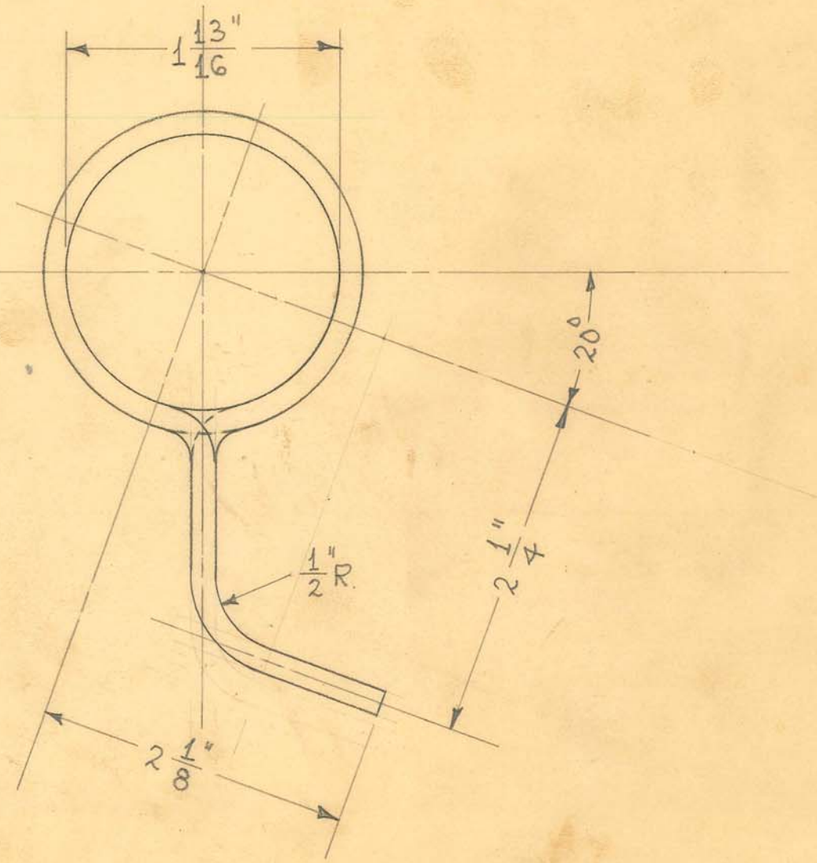

8 TURNS

1 REQUIRED

OBSOLETE

SIZE	#6 BARE	ISSUE 3-13-45	HE.
KIND	COPPER WIRE	CHANGED	
SHAPE		"	
FINISH		"	
TEMP.		"	
PATT.		"	

TITLE: FISCHER MOD. "A" SHORT WAVE OUTFIT- PLATE COIL

H. G. FISCHER & CO.
2335 WABANSIA AVE.
CHICAGO, ILL.

CAT. NO.

PART NO. 16057

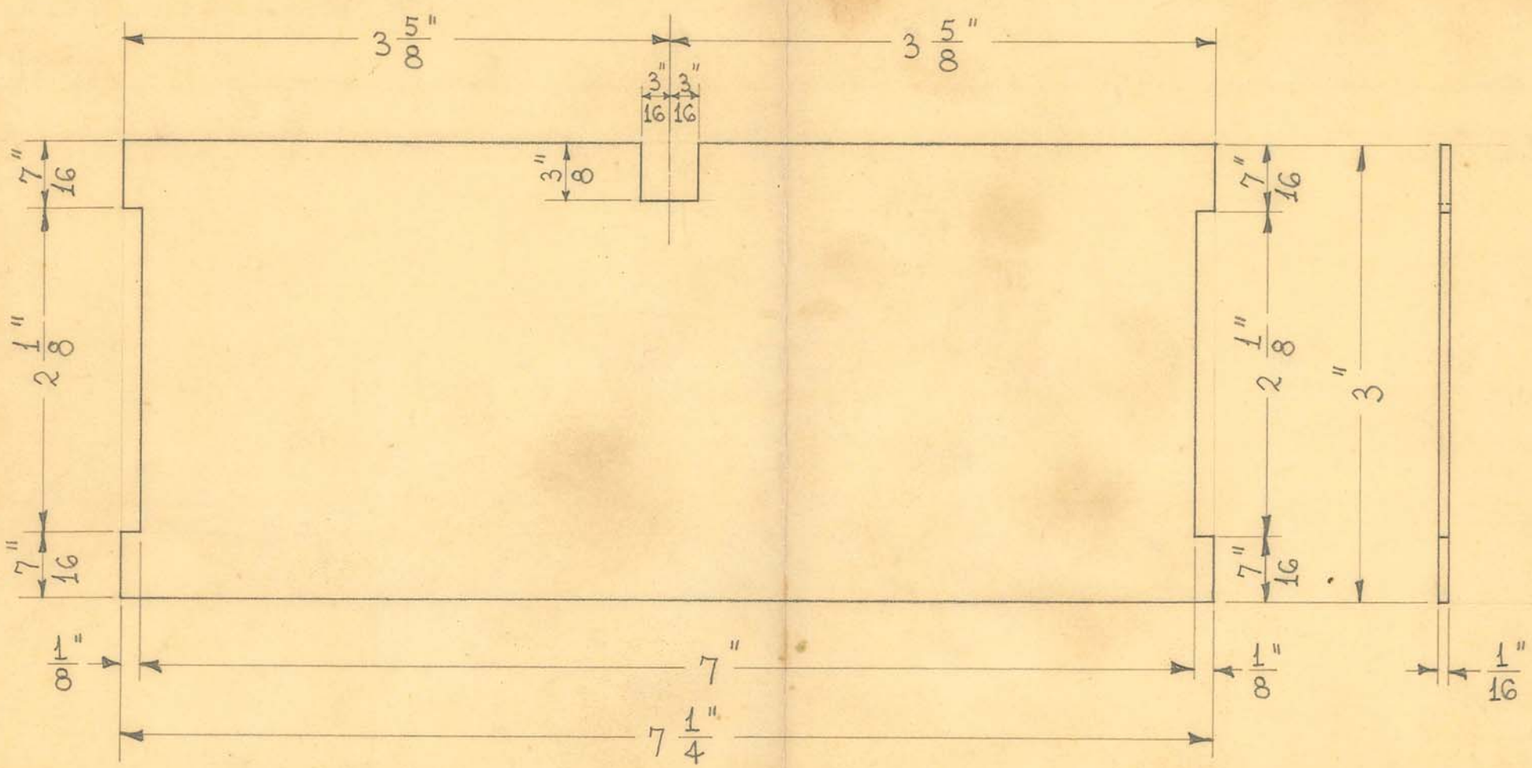

2 REQUIRED

OBSOLETE
OBSOLETE AFTER PRESENT STOCK IS EXHAUSTED
J.K. 11-12-48

SIZE	1/16"X3"X7 1/4"	ISSUE 2-5-45	E.	TITLE: FISCHER MOD. "S" SHORT WAVE OUTFIT- TRANSFORMER BARRIER
KIND	XXX NAT.	CHANGED		
~~SHAPE~~	PILECTO	"		
FINISH		"		
TEMP.		"		
PATT.		"		

H. G. FISCHER & CO.
2335 WABANSIA AVE.
CHICAGO, ILL.

CAT. NO.

PART NO. 15913

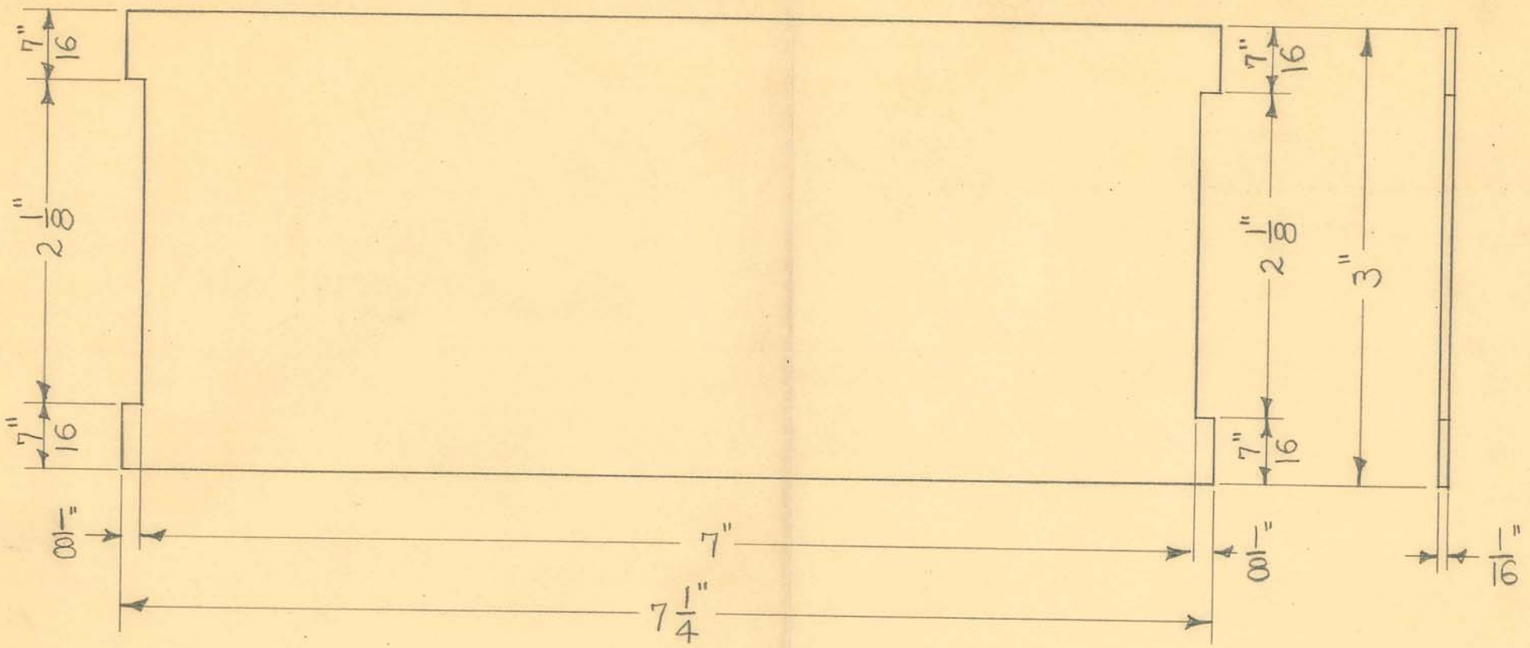

2-REQUIRED

OBSOLETE

OBSOLETE
AFTER PRESENT
STOCK IS EXHAUSTED
J.R.
11-12-48

DIMENSIONS	
FRACTIONAL	± .015
DECIMAL	± .005
ANGULAR	± 1/2°
UNLESS OTHERWISE SPECIFIED	

SIZE	1/16"X3"	ISSUE 1-8-48	J.M.F
KIND	XXX NAT.	CHANGED	
SHAPE	DILECTO	"	
FINISH		"	
TEMP.		"	
PATT.		"	

TITLE:
MODEL "400" FISCHER DELUXE DIATHERMY
TRANSFORMER BARRIER

H. G. FISCHER & CO.
2335 WABANSIA AVE.
CHICAGO, ILL.

CAT. NO.

PART NO. 15913F

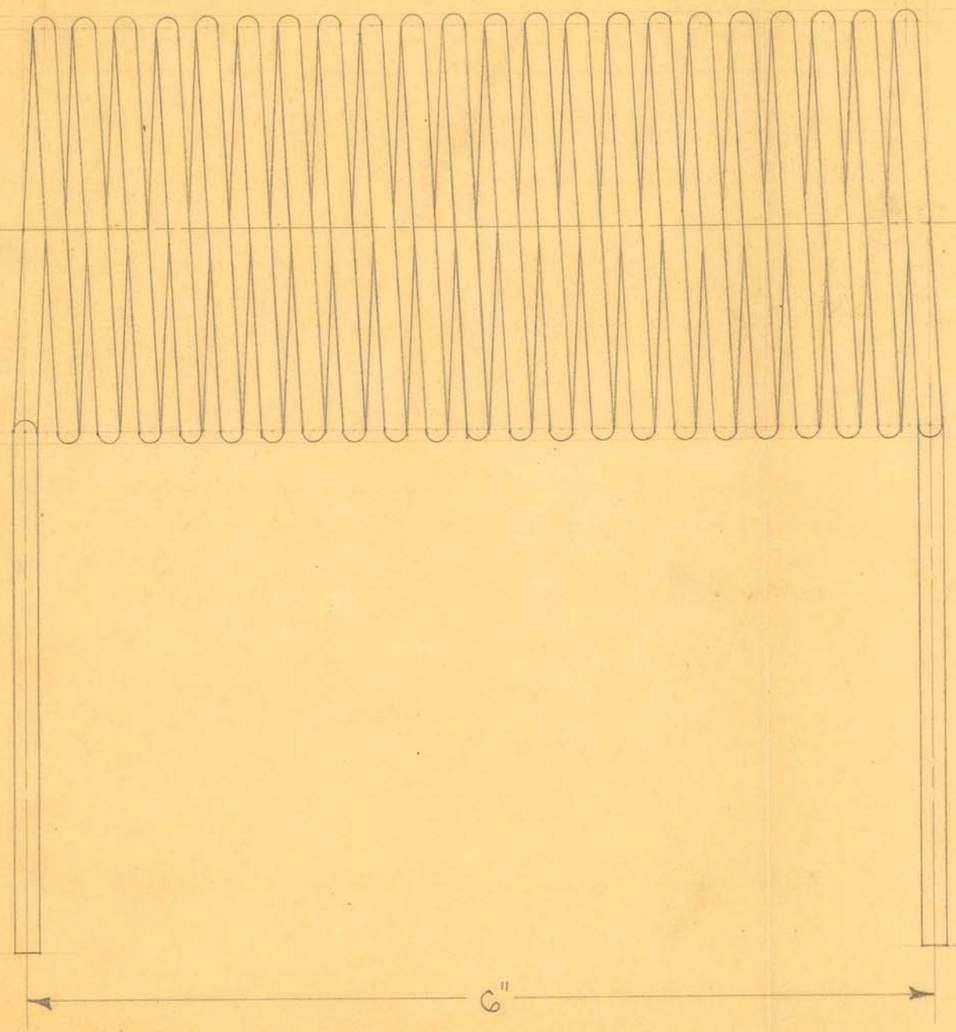

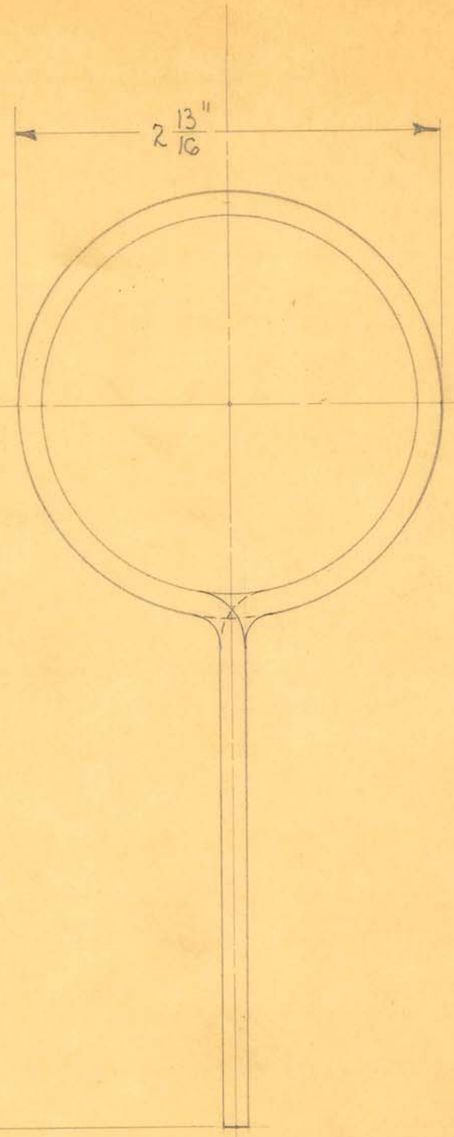

1 REQUIRED
22 TURNS

OBSOLETE

SIZE	# 6 BARE	ISSUE 10-29-35	H.E.	TITLE: FISCHER "SWD-24" SHORT WAVE OSCILLATOR UNIT OSCILLATING COIL
KIND	COPPER WIRE	CHANGED		
SHAPE		" "		
FINISH		" "		
TEMP.		" "		H. G. FISCHER & CO. 2335 WABANSIA AVE. CHICAGO, ILL. — CAT. NO. — PART NO. 9782
PATT.		" "		

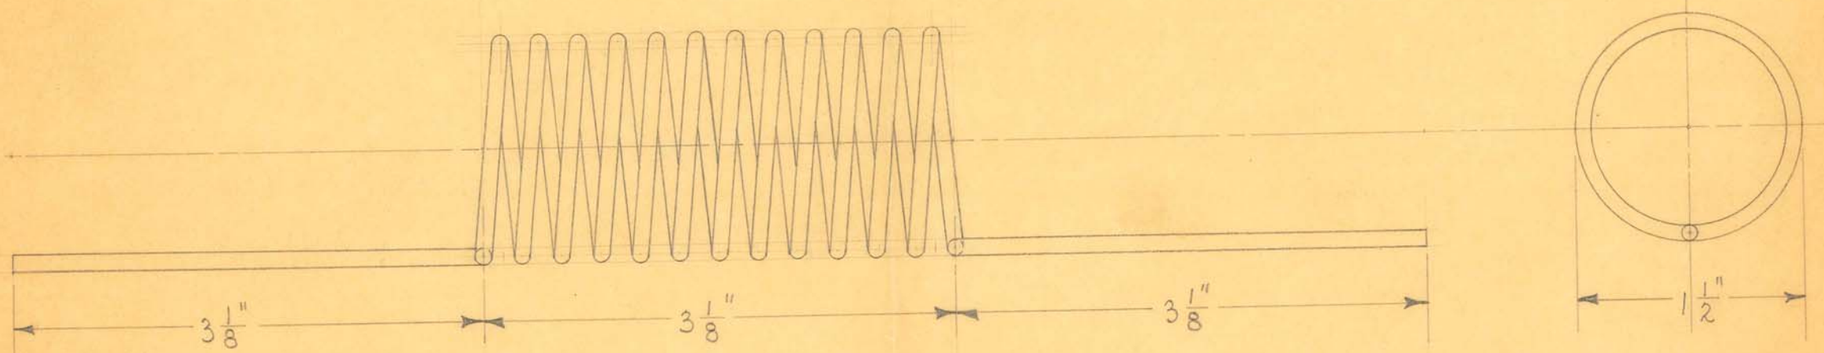

1 REQUIRED
12 TURNS

OBSOLETE

SIZE	#10 TINNED	ISSUE 10-28-35	H.E.
KIND	COPPER WIRE	CHANGED	
SHAPE		" "	
FINISH		" "	
TEMP.		" "	
PATT		" "	

TITLE: FISCHER "SWD-18" SHORT WAVE OSCILLATOR
UNIT GRID COIL

H. G. FISCHER & CO.
2335 WABANSIA AVE.
CHICAGO, ILL.

CAT. NO.

PART NO. 9779

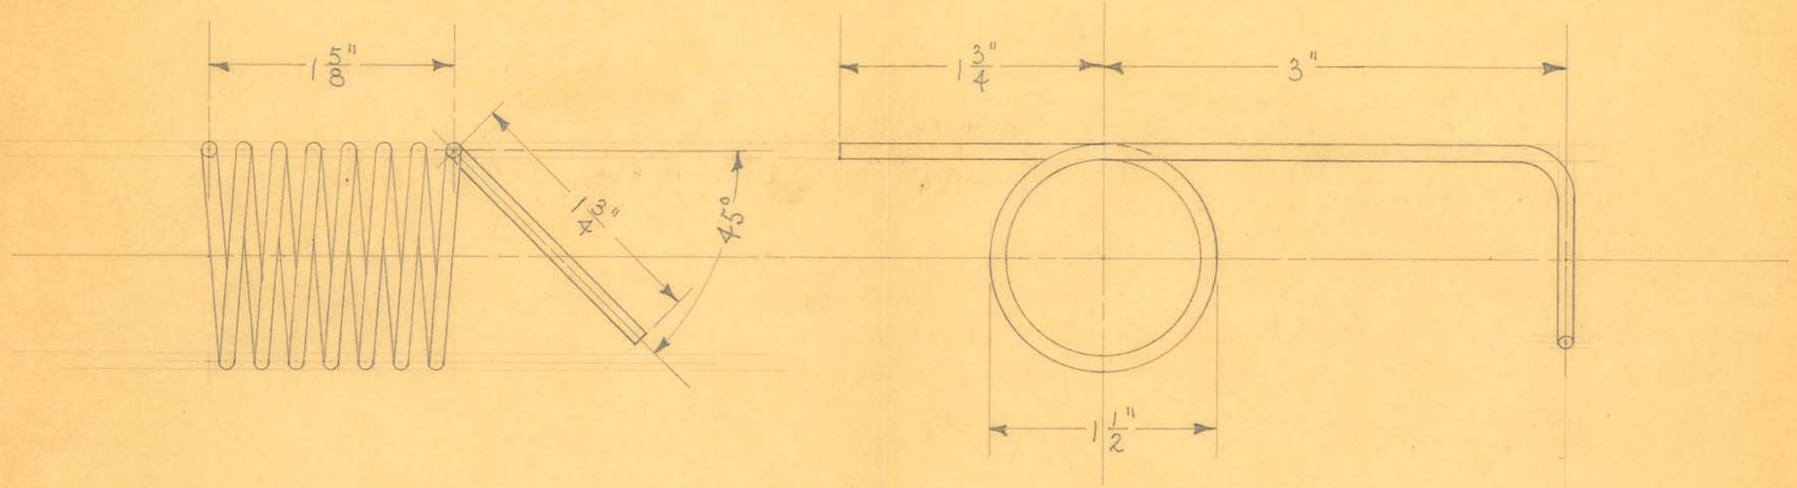

1 REQUIRED
7 TURNS

OBSOLETE

SIZE	#10 TINNED	ISSUE 10-28-35	A.E.	TITLE: FISCHER "SWD-18" SHORT WAVE OSCILLATOR UNIT PATIENT'S TUNING COIL - LEFT
KIND	COPPER WIRE	CHANGED		
SHAPE		" "		
FINISH		" "		
TEMP.		" "		H. G. FISCHER & CO. 2335 WABANSIA AVE. CHICAGO, ILL. — CAT. NO. — PART NO. 3778
PATT.		" "		

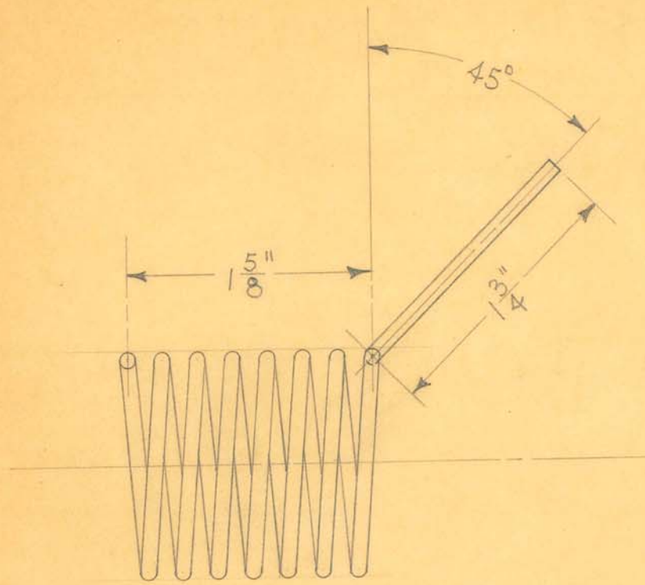

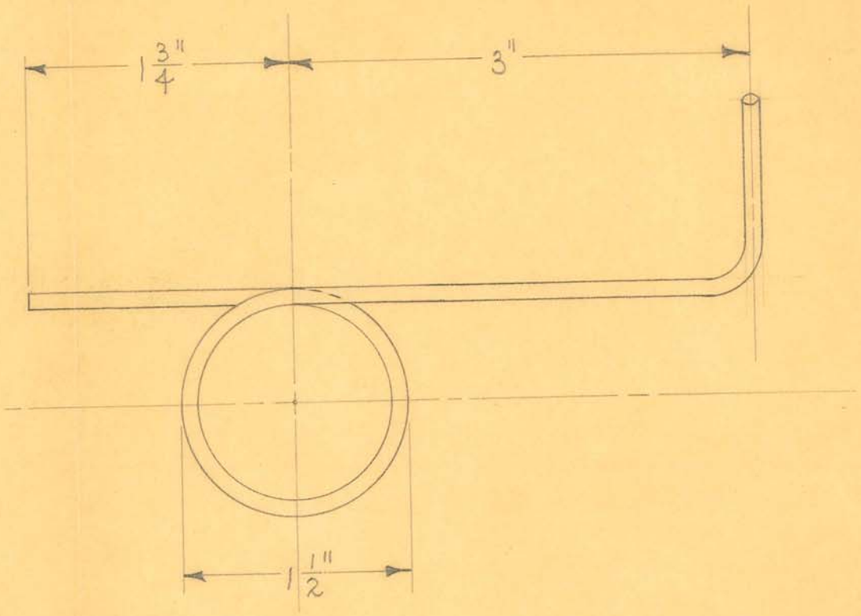

1 REQUIRED
7 TURNS

OBSOLETE

SIZE	#10 TINNED	ISSUE 10-28-35	A.C.	TITLE: FISCHER "SWD-18" SHORT WAVE OSCILLATOR UNIT PATIENT'S TUNING COIL-RIGHT
KIND	COPPER WIRE	CHANGED		
SHAPE		" "		
FINISH		" "		
TEMP.		" "		
PATT.		" "		

H. G. FISCHER & CO.
2335 WABANSIA AVE.
CHICAGO, ILL.

CAT. NO.

PART NO. 9778 1/2

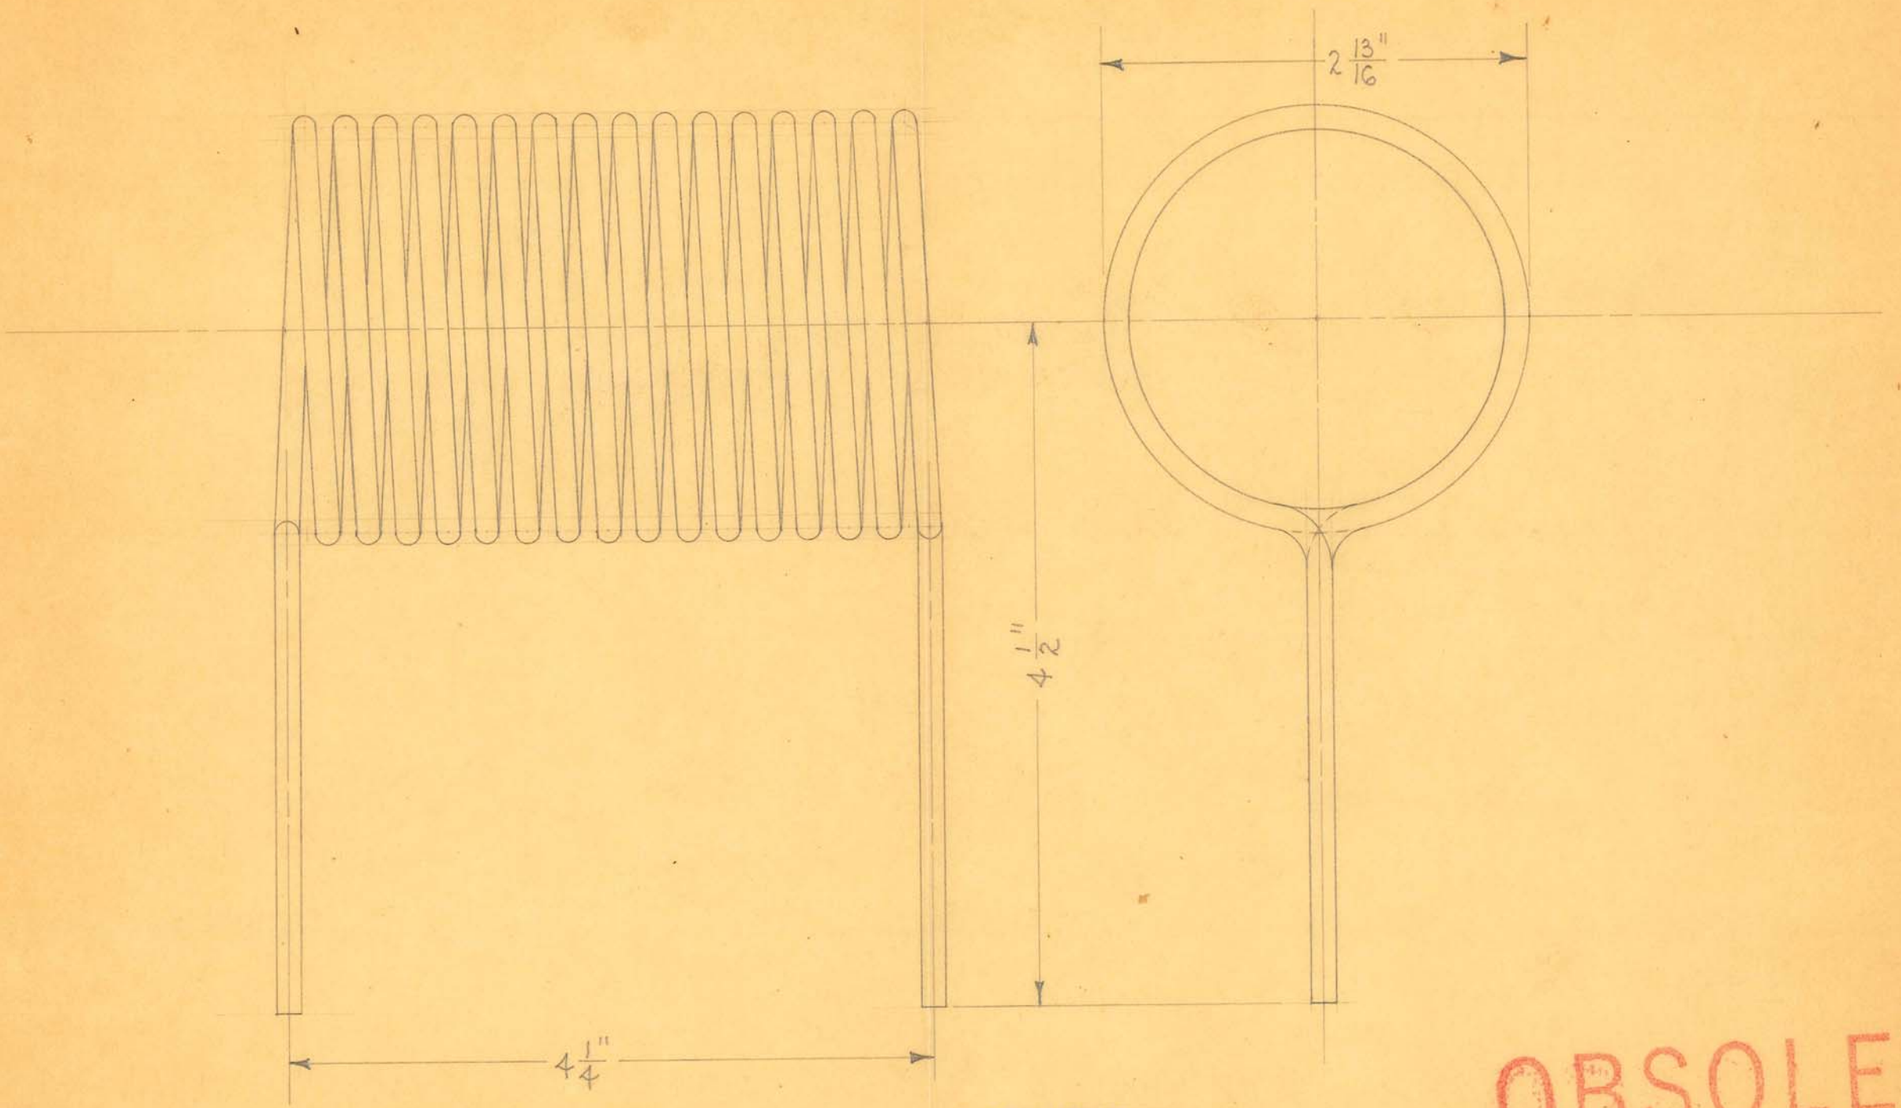

1 REQUIRED
14 TURNS

OBSOLETE

SIZE	#6 BARE	ISSUE 10-28-35	D/E
KIND	COPPER WIRE	CHANGED	
SHAPE		" "	
FINISH		" "	
TEMP.		" "	
PART		" "	

TITLE:
FISCHER "SWD-18" SHORT WAVE OSCILLATOR UNIT
OSCILLATING COIL

H. G. FISCHER & CO.
2335 WABANSIA AVE.
CHICAGO, ILL.

CAT. NO.

PART NO. 9776

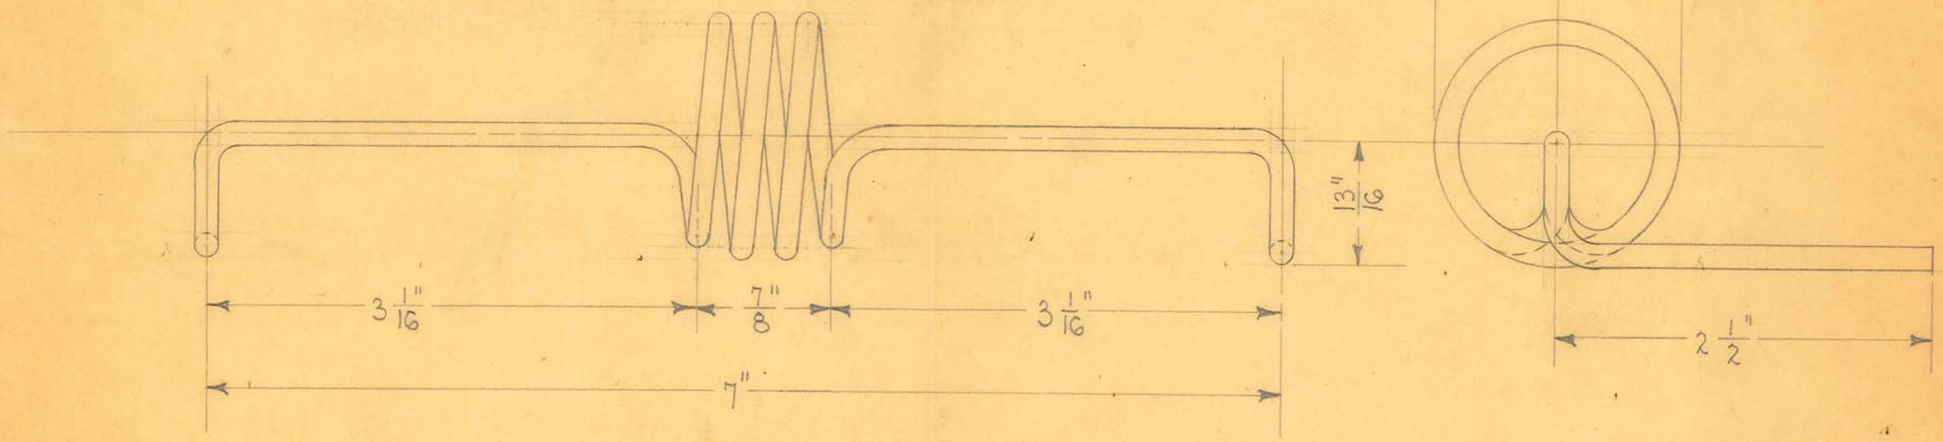

1 REQUIRED
3 TURNS

OBSOLETE

SIZE	#6 BARE	ISSUE 10-25-35	J.E.
KIND	COPPER WIRE	CHANGED	
SHAPE		" "	
FINISH		" "	
TEMP.		" "	
PATT.		" "	

TITLE: FISCHER "SWD-6" SHORT WAVE OSCILLATOR UNIT PICKUP COIL

H. G. FISCHER & CO.
2335 WABANSIA AVE.
CHICAGO, ILL.

CAT. NO.

PART NO. 9768

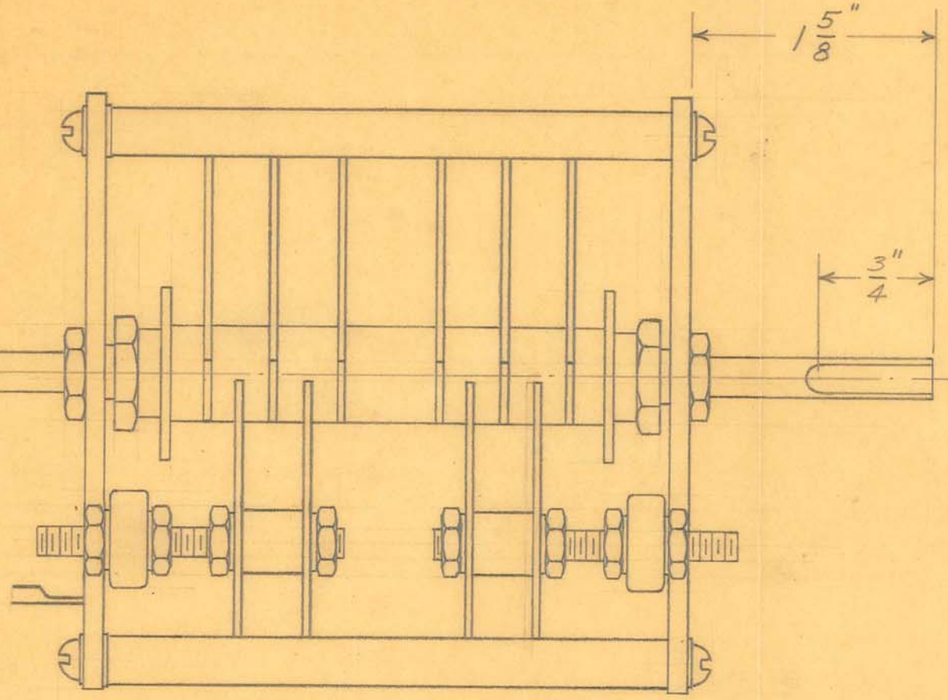

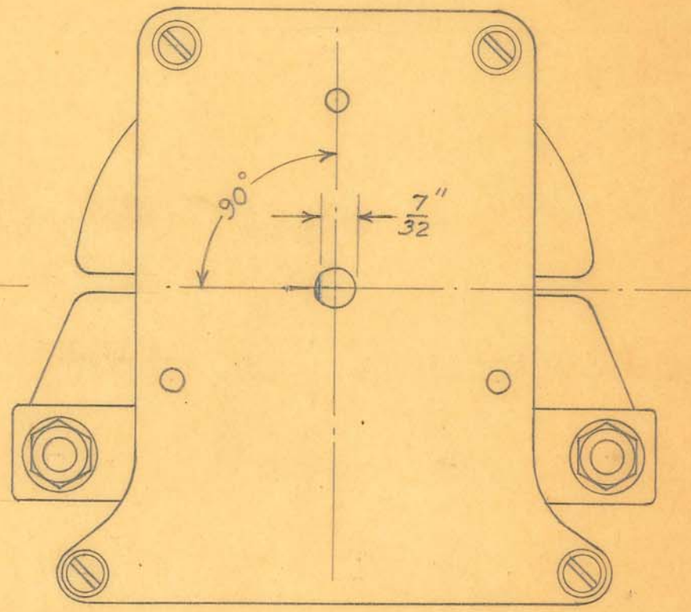

OBSOLETE

SIZE		ISSUE	
KIND		CHANGED	
SHAPE		" "	
FINISH		" "	
TEMP.		" "	
PATT.		" "	

TITLE:
FISCHER "SWD-6" SHORT WAVE OSCIL. UNIT
PATIENTS TUNING CONDENSER

H. G. FISCHER & CO.
2335 WABANSIA AVE.
CHICAGO, ILL.

CAT. NO.

PART NO. 9766G

#30 DRILL
1/4" C.B. 3/64" DEEP

#6 STIPLE

7/16" "B"

21/64 R.

11/16" 23/32" 11/16" 23/32" 11/16"

7/16"

"A" "A"

7/8" 7/8"

11/16"

5/16" 2 3/16" "B"

2 17/32"

37/64" 23/32"

5/64 R. 7/64 R.

2 7/32" 2 7/32"

5/16" 7/16" 1/64"

1/64" 3/32" 9/32"

17/32" 9/16" ℄

3/16" 1/16" 12/32" 3/16"

7/64" 1/16" 2 3/16" 1/16" 7/64"

1/16"

SECTION "A-A"

SECTION "B-B"

SCALE: 1" = 1/2"

OBSOLETE

SIZE		ISSUE 9-28-34	A.E.	TITLE: FISCHER ELECTRO SYNCHROTIMER SELECTOR SWITCH COVER
KIND		CHANGED 6-29-37	J.W.	
SHAPE		" "		
FINISH		" "		
TEMP.		" "		
PATT.		" "		

H. G. FISCHER & CO.
2335 WABANSIA AVE.
CHICAGO, ILL.

CAT. NO.

PART NO. 9061A

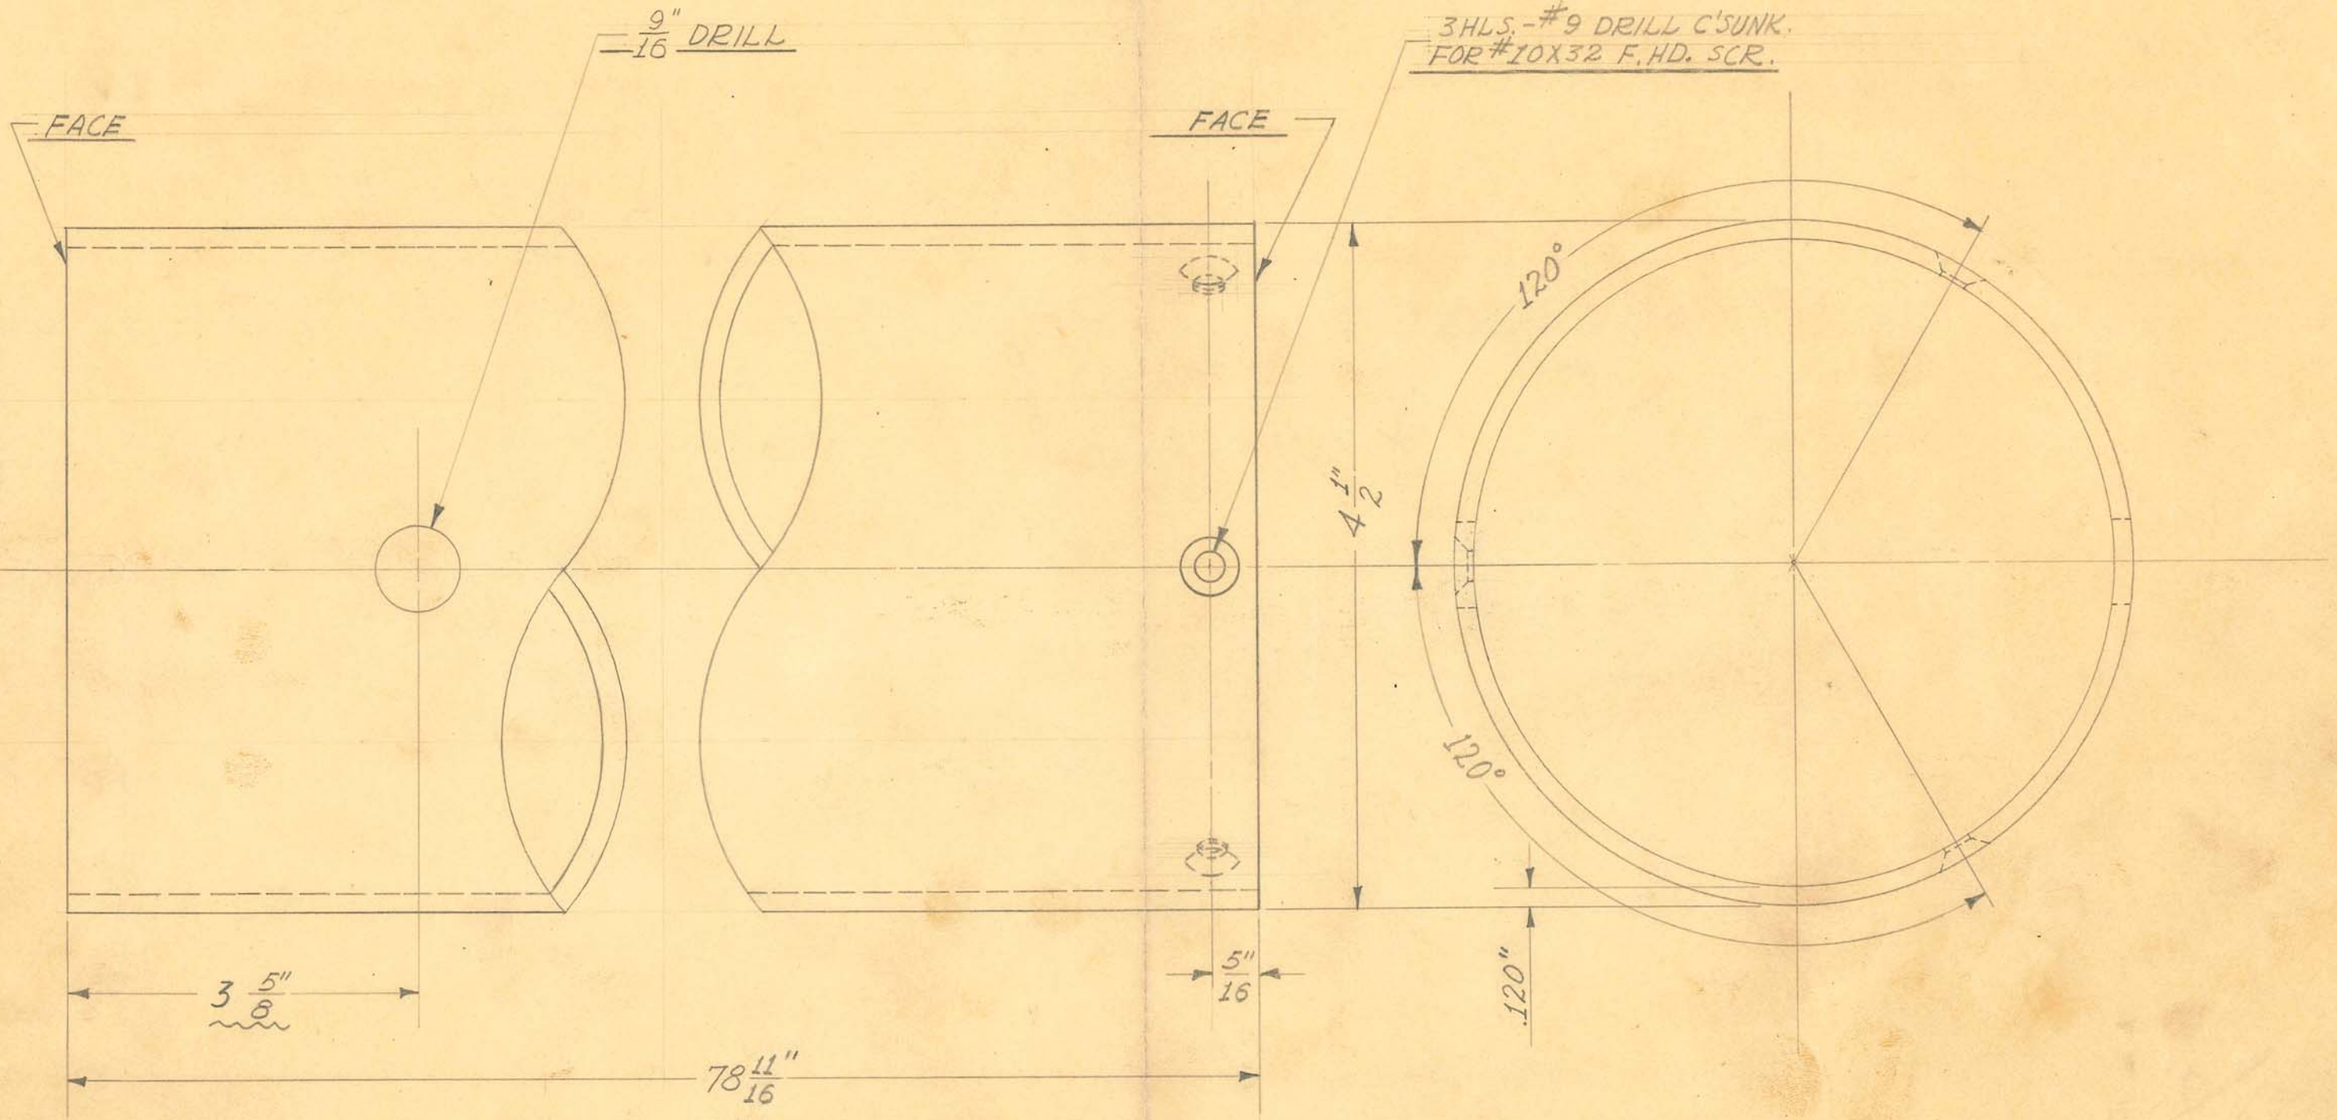

4 1/2" O.D. X #11 GAUGE SHELBY SEAMLESS STEEL TUBING

1 REQUIRED

SIZE		ISSUE 11-18-38	J.W.
KIND		CHANGED 10-5-39	J.W.
SHAPE		" 8-8-40	J.W.
FINISH		"	
TEMP.		"	

TITLE: FISCHER MOD. "GM" MOBILE UNIT - INNER UPRIGHT TUBE - LONG -

OBSOLETE

H. G. FISCHER & CO. 2335 WABANSIA AVE. CHICAGO, ILL.

CAT. NO.

PART NO. 12268AFA

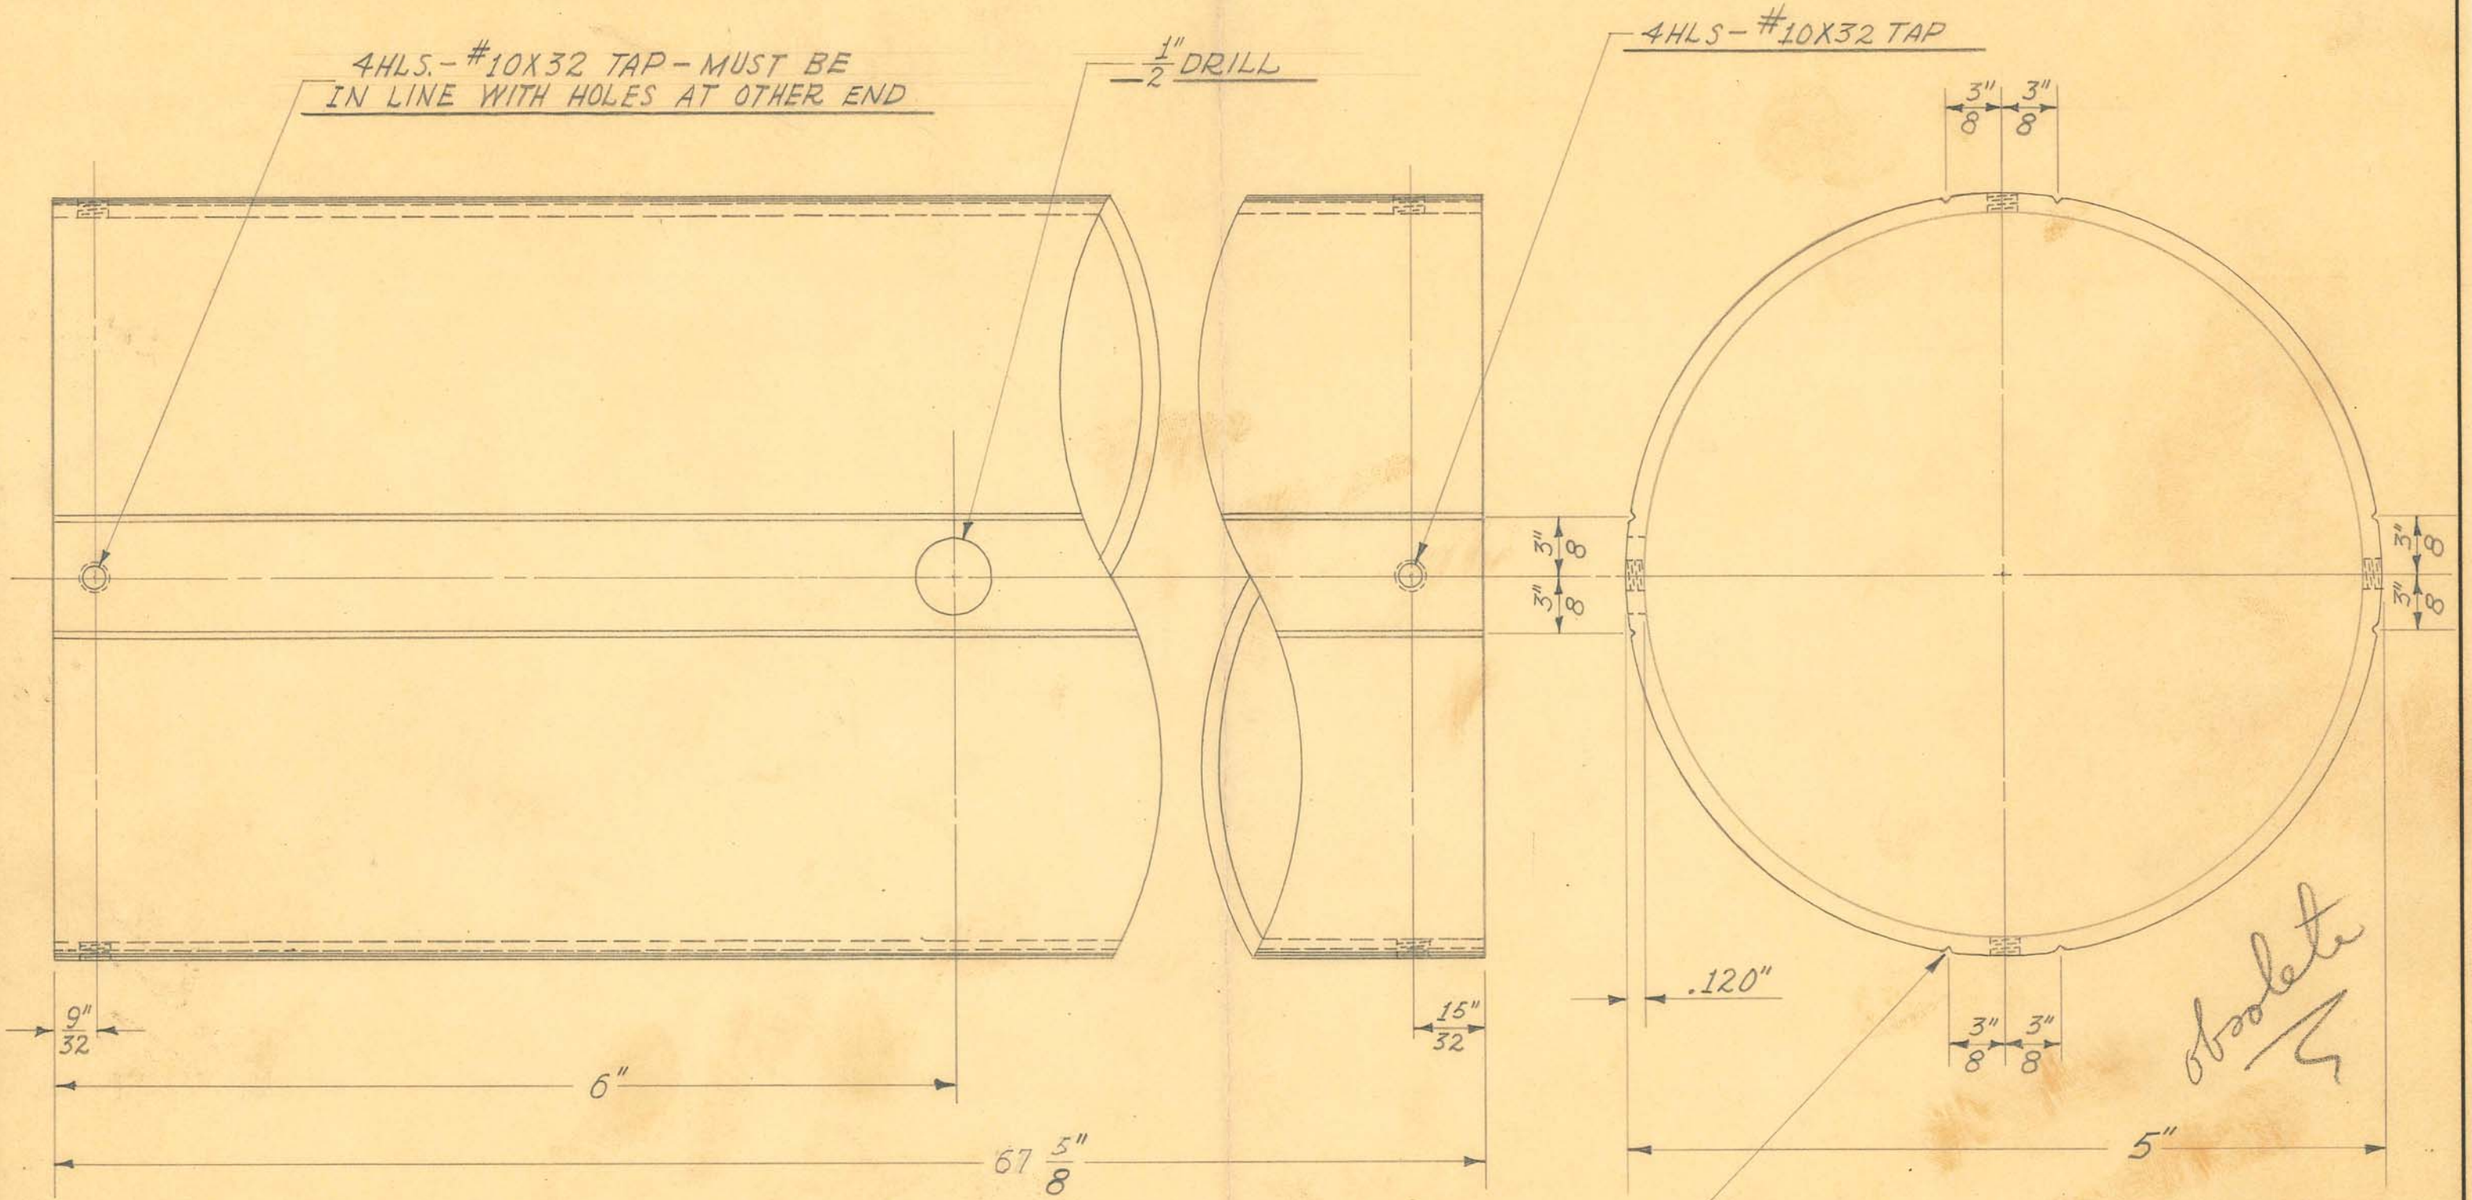

CUT 4 SETS (2 EACH) OF "V" GROOVES - 1/32" DEEP WITH SPECIAL TOOL 3/8" EITHER SIDE OF CENTER OF TAPPED HOLES AS SHOWN.

5" O.D. X #11 GAUGE SHELBY SEAMLESS STEEL TUBING

1 REQUIRED

SIZE		ISSUE 11-18-38	J.W.
KIND		CHANGED	
SHAPE		"	
FINISH		"	
TEMP.		"	
DATE		"	

OBSOLETE

TITLE: FISCHER MOD. "GM" MOBILE UNIT- OUTER UPRIGHT TUBE - SHORT

H. G. FISCHER & CO.
2335 WABANSIA AVE.
CHICAGO, ILL.

CAT. NO.

PART NO. 12269F

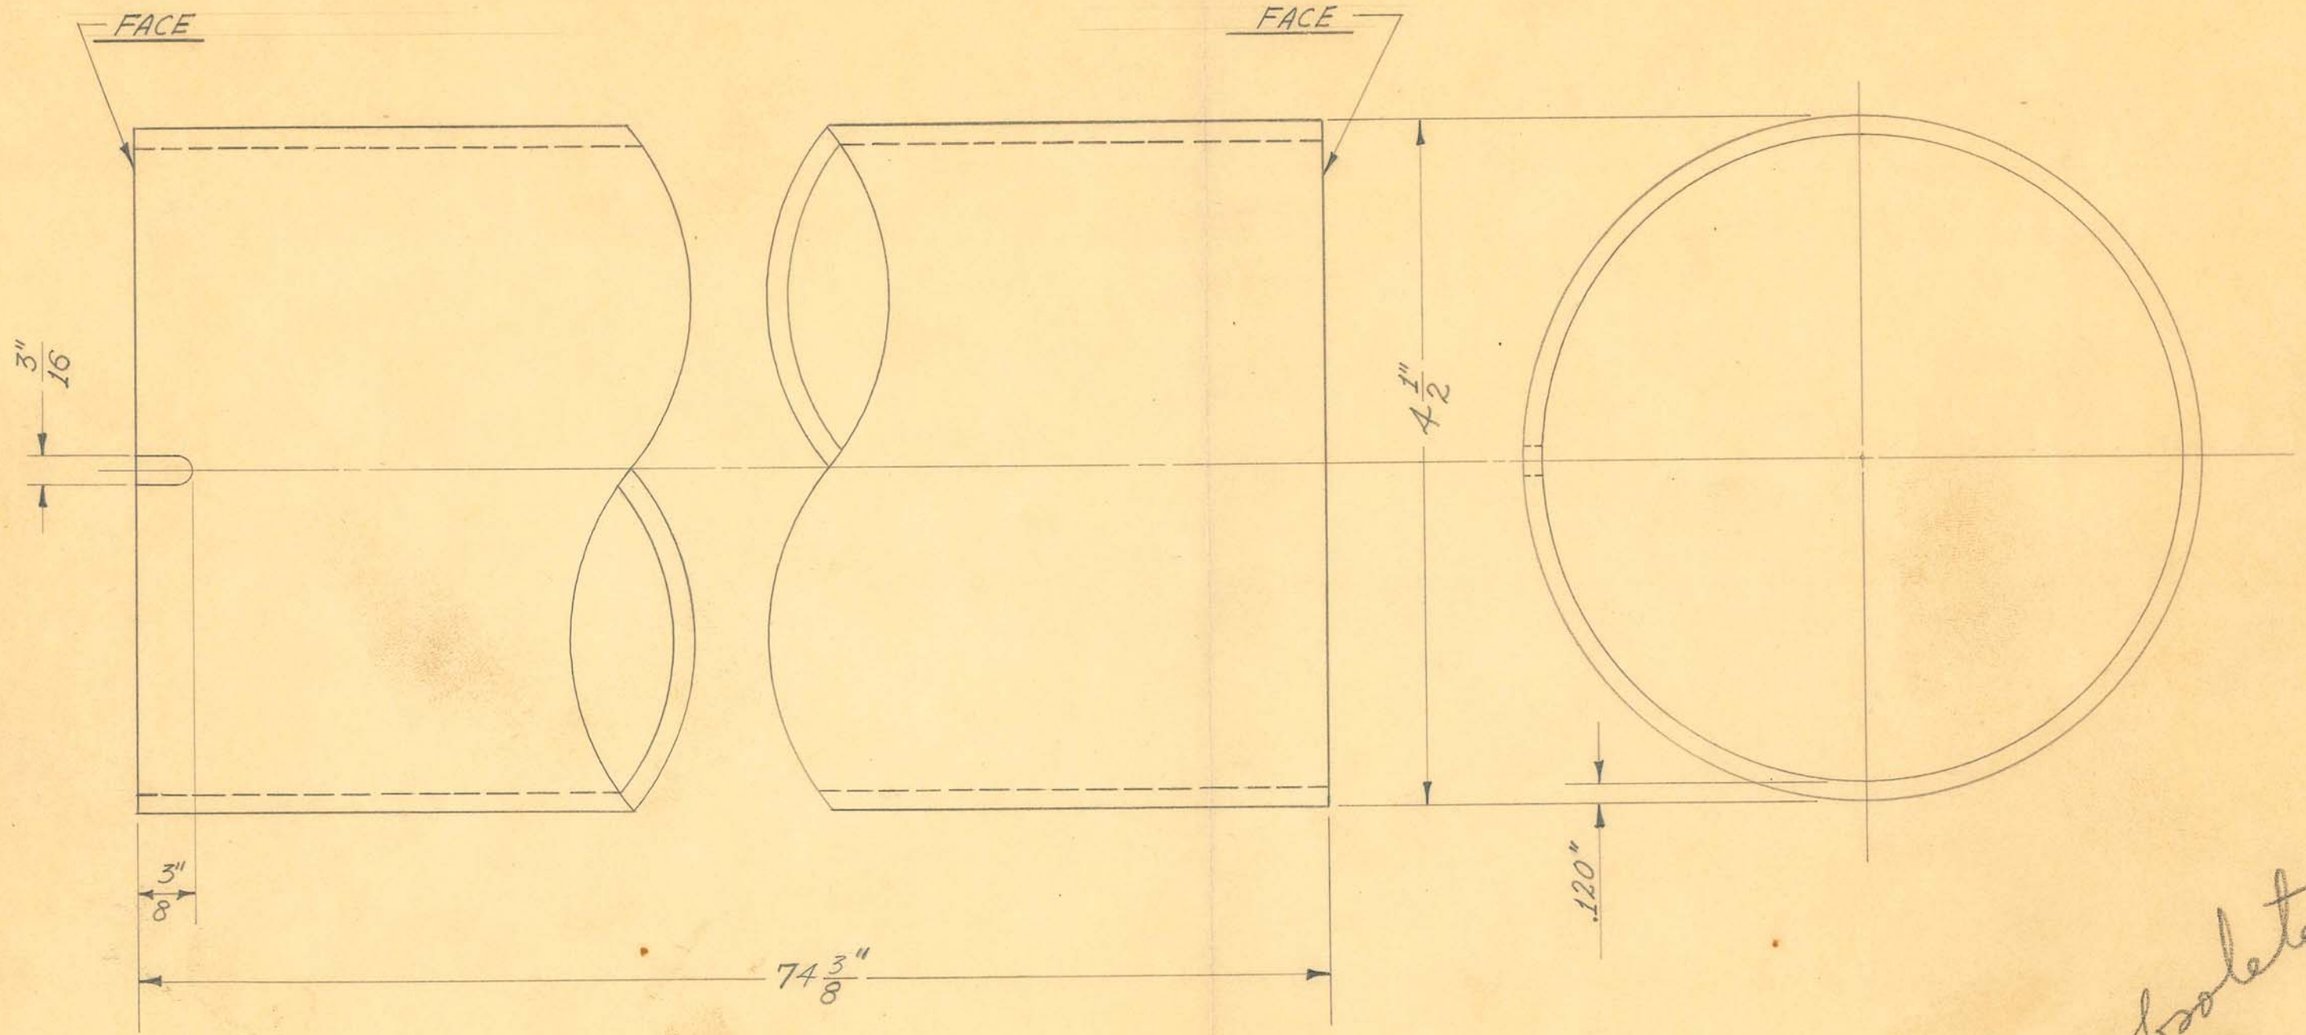

Obsolete

4 1/2" O.D. X #11 GAUGE SHELBY SEAMLESS STEEL TUBING

1 REQUIRED

SIZE		ISSUE 11-18-38	J.W.
KIND		CHANGED	
SHAPE		"	
FINISH		"	
TEMP.		"	
PATT.		"	

TITLE: FISCHER MOD. "GM" MOBILE UNIT - INNER UPRIGHT TUBE - SHORT

OBSOLETE

H. G. FISCHER & CO.
2339 WABANSIA AVE.
CHICAGO, ILL.

CAT. NO.

PART NO. 12270F

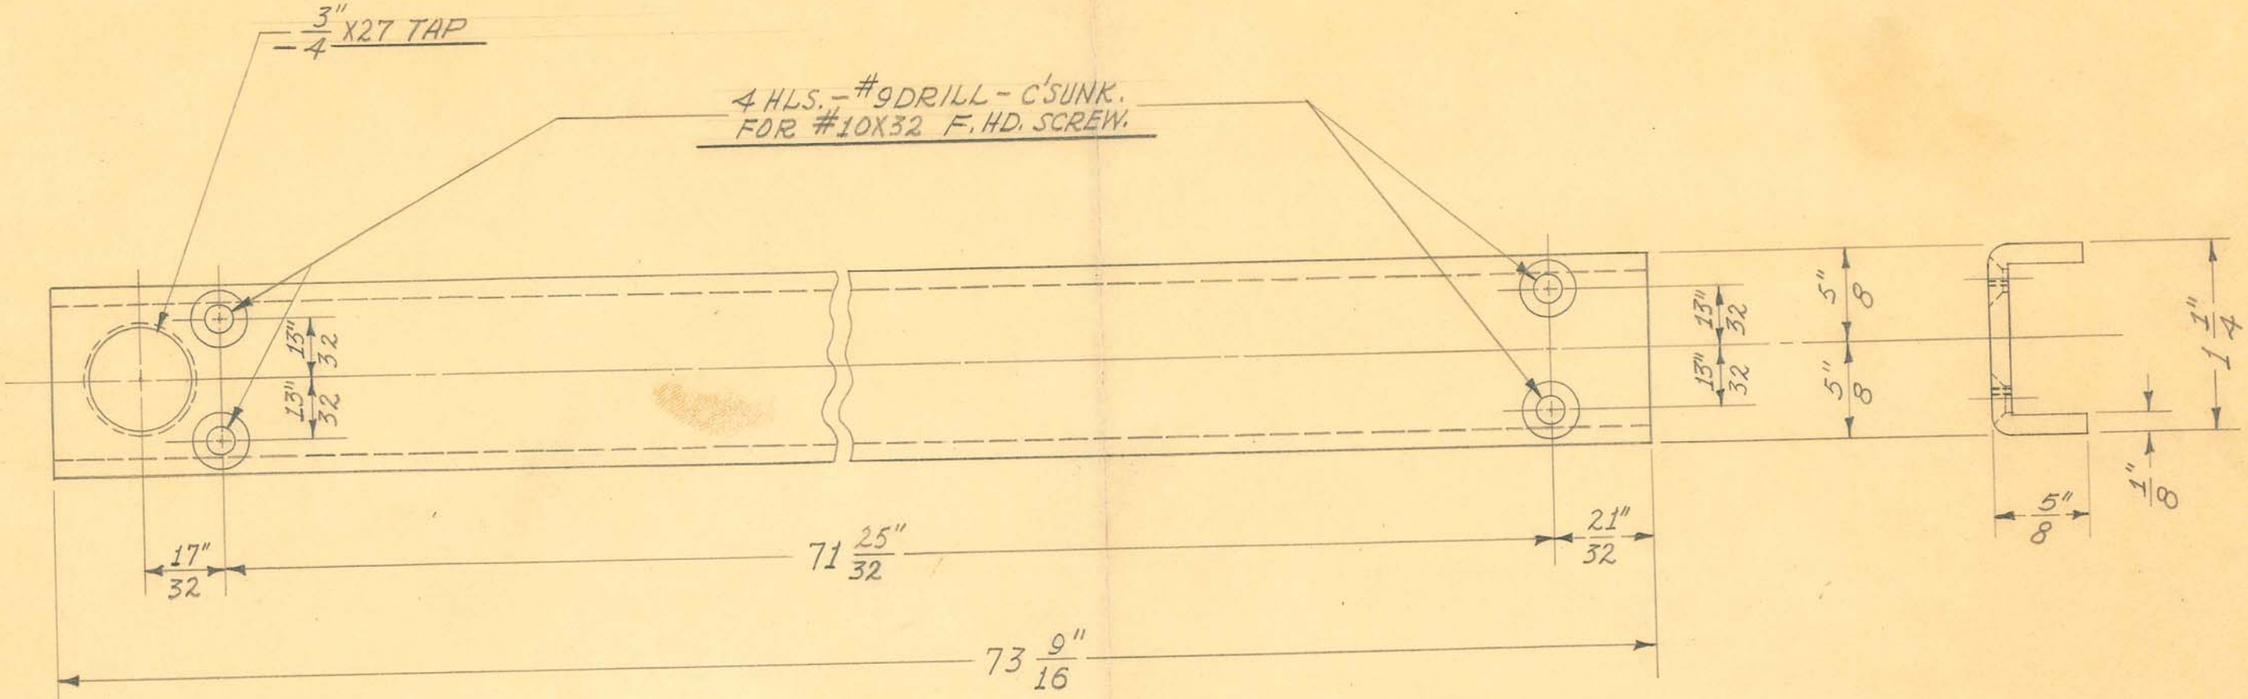

1 REQUIRED

OBSOLETE

SIZE	1 1/4" X 5/8" X 1/8"	ISSUE 11-30-38	J.W.	TITLE: FISCHER MOD. "GM" MOBILE UNIT - UPRIGHT CHANNEL -LONG-
KIND	C.R. STEEL	CHANGED 10-5-39	J.W.	
SHAPE	CHANNEL	"		
FINISH		"		
TEMP.		"		
PATT.		"		

H. G. FISCHER & CO.
2335 WABANSIA AVE.
CHICAGO, ILL.

CAT. NO.

PART NO. 12271F

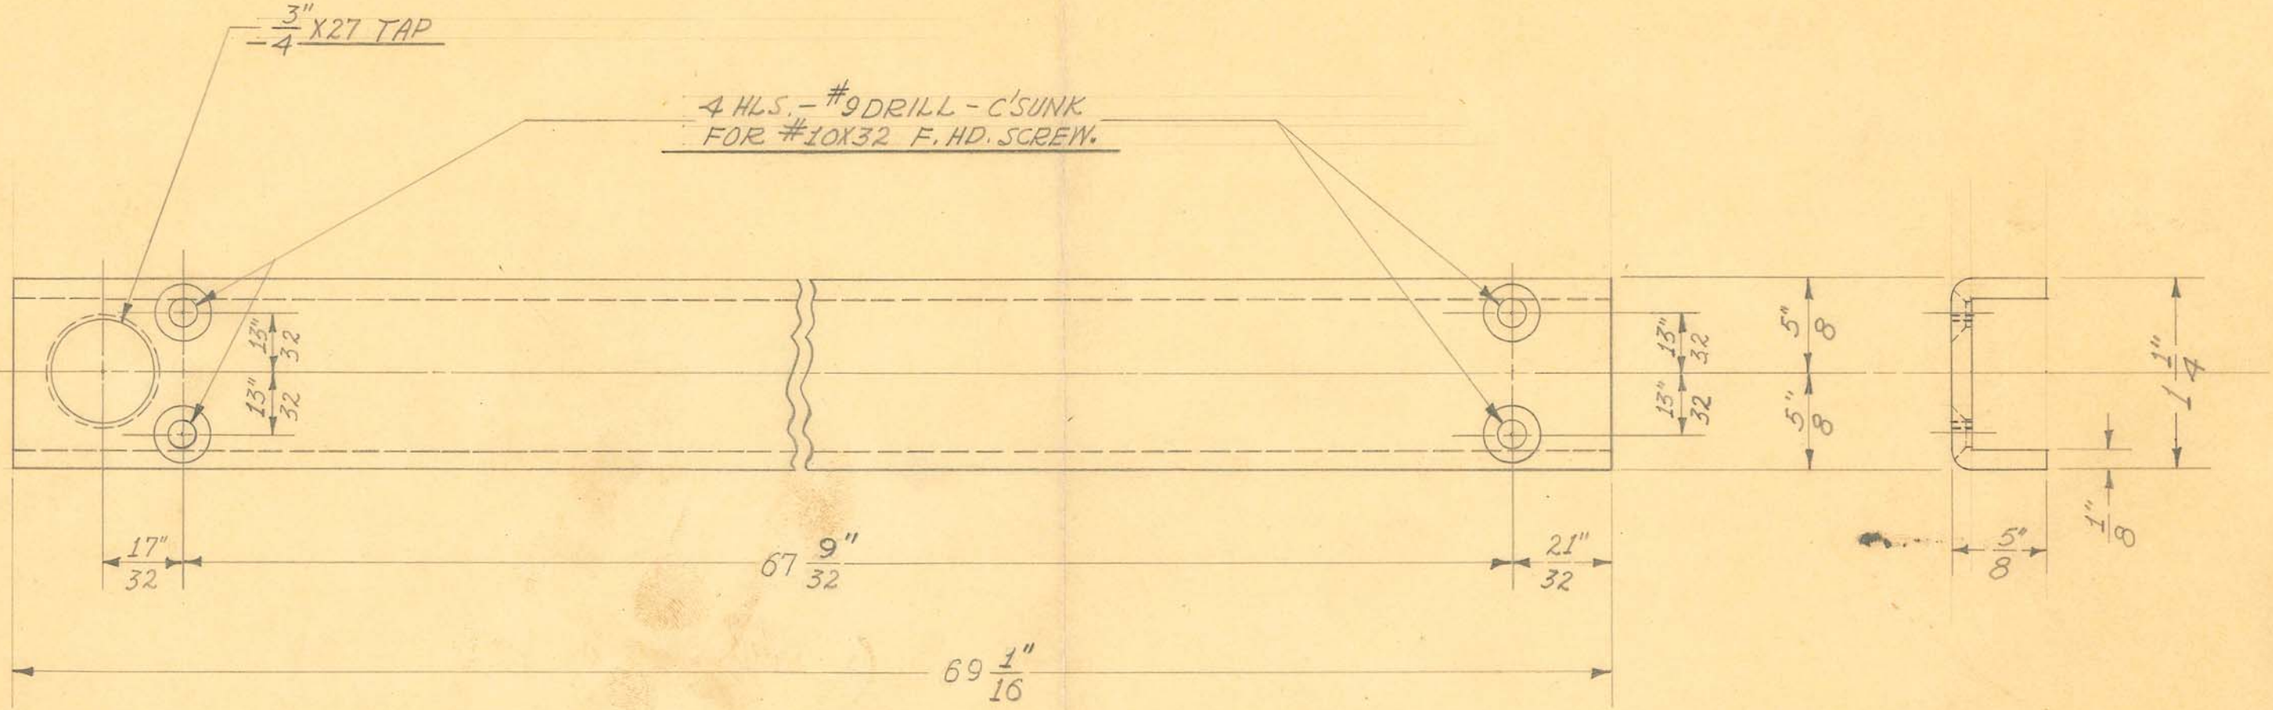

1 REQUIRED

OBSOLETE

Obsolete

SIZE	1 1/4" X 5/8" X 1/8"	ISSUE 11-30-38	J.W.
KIND	C.R. STEEL	CHANGED	
SHAPE	CHANNEL	"	
FINISH		"	
TEMP.		"	

TITLE: FISCHER MOD. "GM"
MOBILE UNIT — UPRIGHT CHANNEL
-SHORT

H. G. FISCHER & CO.
2338 WABANSIA AVE.

CAT. NO.

PART NO. 12272 E

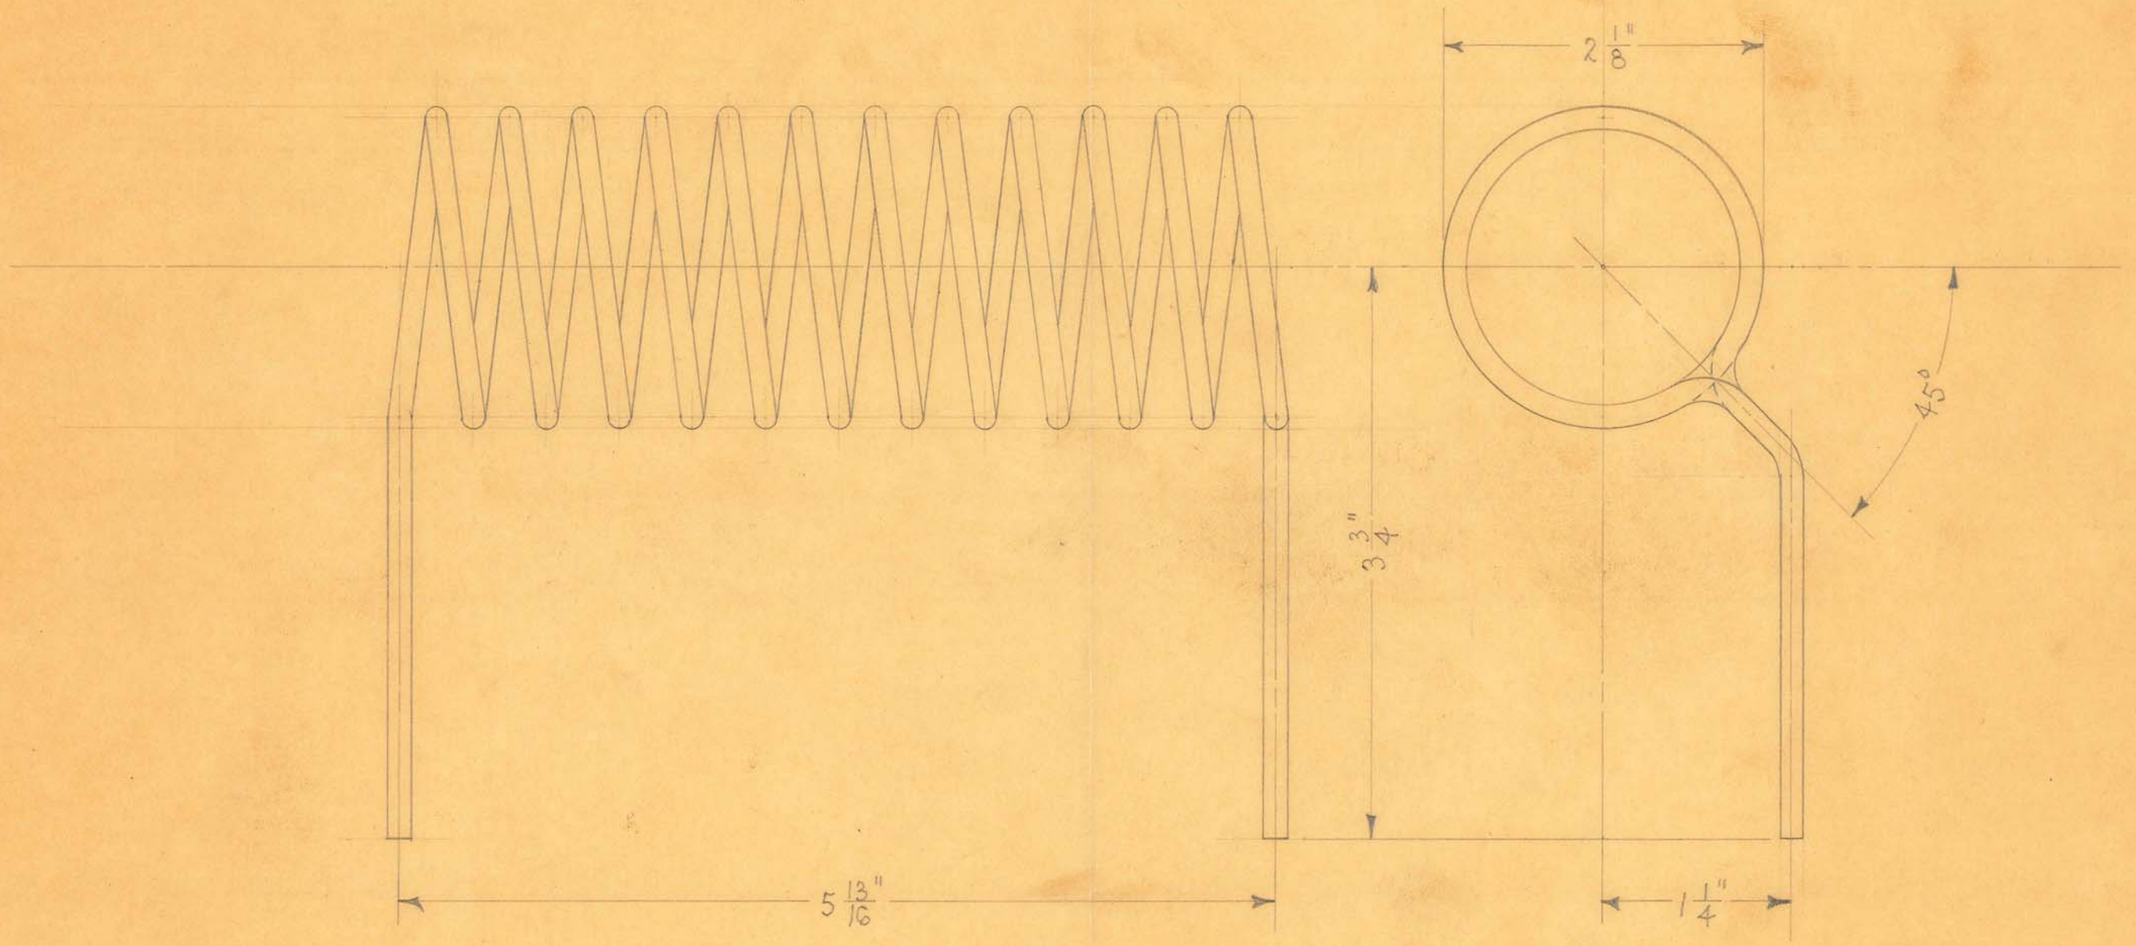

12 TURNS

OBSOLETE

SIZE	#6 BARE	ISSUE 9-19-35	A.E.	TITLE: FISCHER "SW12" PORT. SHORT WAVE H.F. OUTFIT PLATE COIL
KIND	COPPER WIRE	CHANGED		
SHAPE		" "		
FINISH		" "		
TEMP.		" "		H. G. FISCHER & CO. 2335 WABANSIA AVE. CHICAGO, ILL. — CAT. NO. — PART NO. 9652
PATT.		" "		

4 HLS. $\frac{17}{64}$" DRILL

8 HLS. #25 DRILL

$3\frac{3}{4}$" $3\frac{3}{4}$"

$2\frac{5}{8}$" $2\frac{5}{8}$"

$\frac{3}{4}$" $\frac{3}{4}$"

$\frac{3}{8}$"

$\frac{3}{4}$"

$8\frac{1}{2}$"

$7\frac{3}{8}$"

$7\frac{7}{16}$"

$3\frac{7}{8}$"

$\frac{1}{8}$"

$\frac{1}{2}$"

$\frac{3}{8}$"

$8\frac{1}{2}$"

OBSOLETE

SIZE	1/8" SHEET	ISSUE	3-10-37	J. W.
KIND	TRANSITE	CHANGED		
SHAPE		"		
FINISH		"		
TEMP.		"		
DATE		"		

TITLE: MODEL "C" SHORT WAVE TRANSF. HEAT BARRIER

H. G. FISCHER & CO.
2335 WABANSIA AVE.
CHICAGO, ILL.

CAT. NO.

PART NO. 9682FA

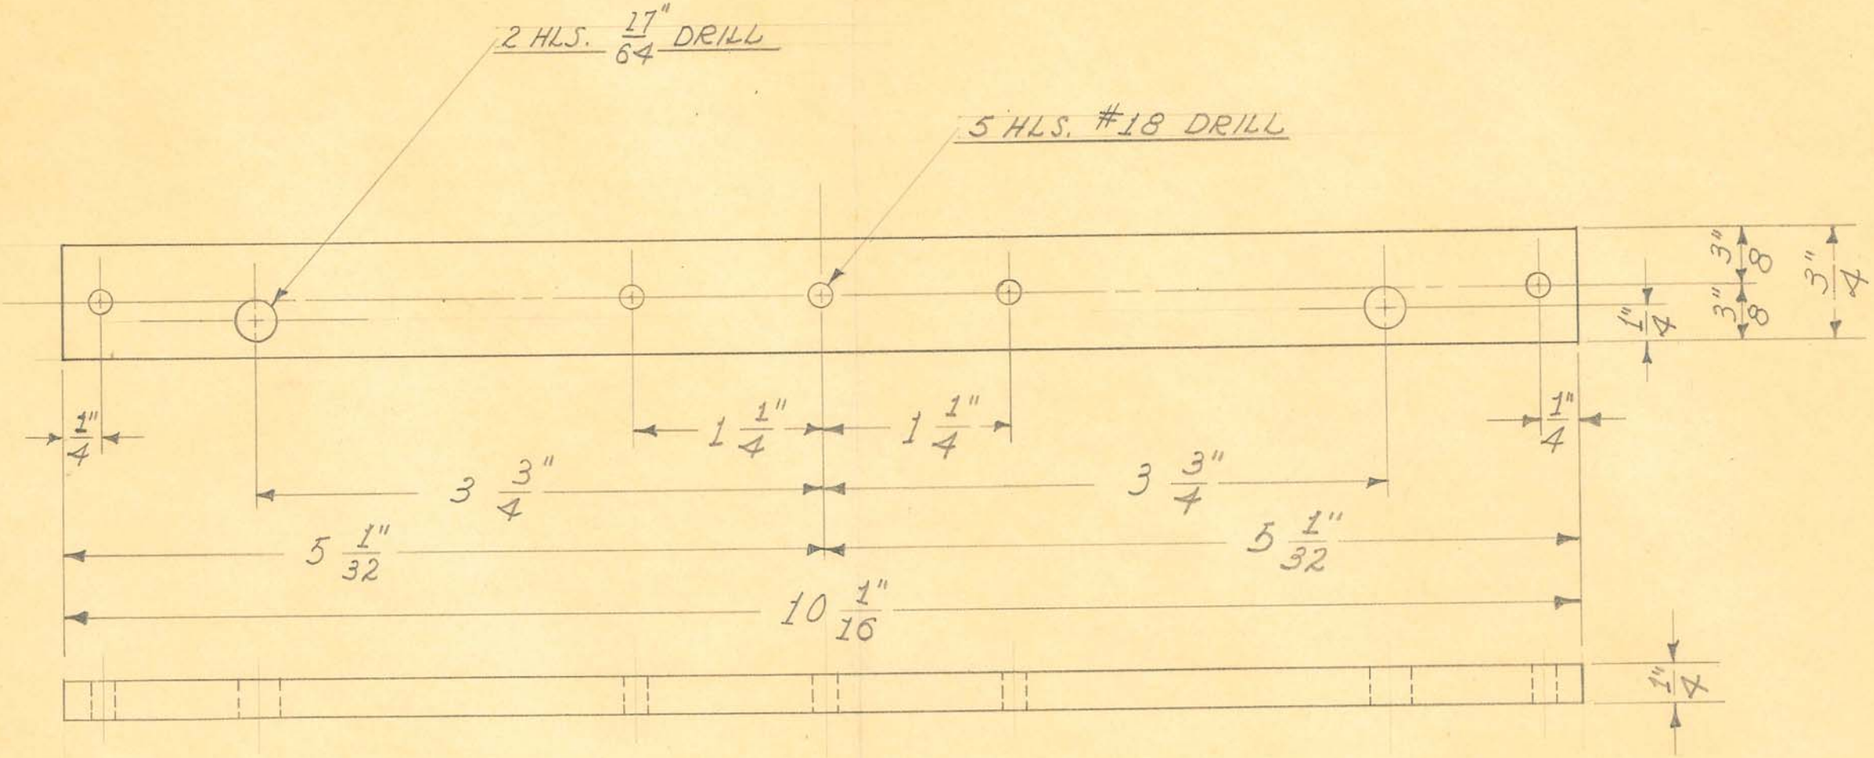

1 REQUIRED

OBSOLETE

SIZE	1/4" SHEET	ISSUE 3-11-37	J.W.	TITLE: MODEL "C" SHORT WAVE TRANSF. TERMINAL STRIP - UPPER
KIND	BAKELITE	CHANGED		
SHAPE		"		
FINISH		"		
TEMP.		"		
DATE		"		

H. G. FISCHER & CO.
2335 WABANSIA AVE.
CHICAGO, ILL.

CAT. NO.

PART NO. 9685

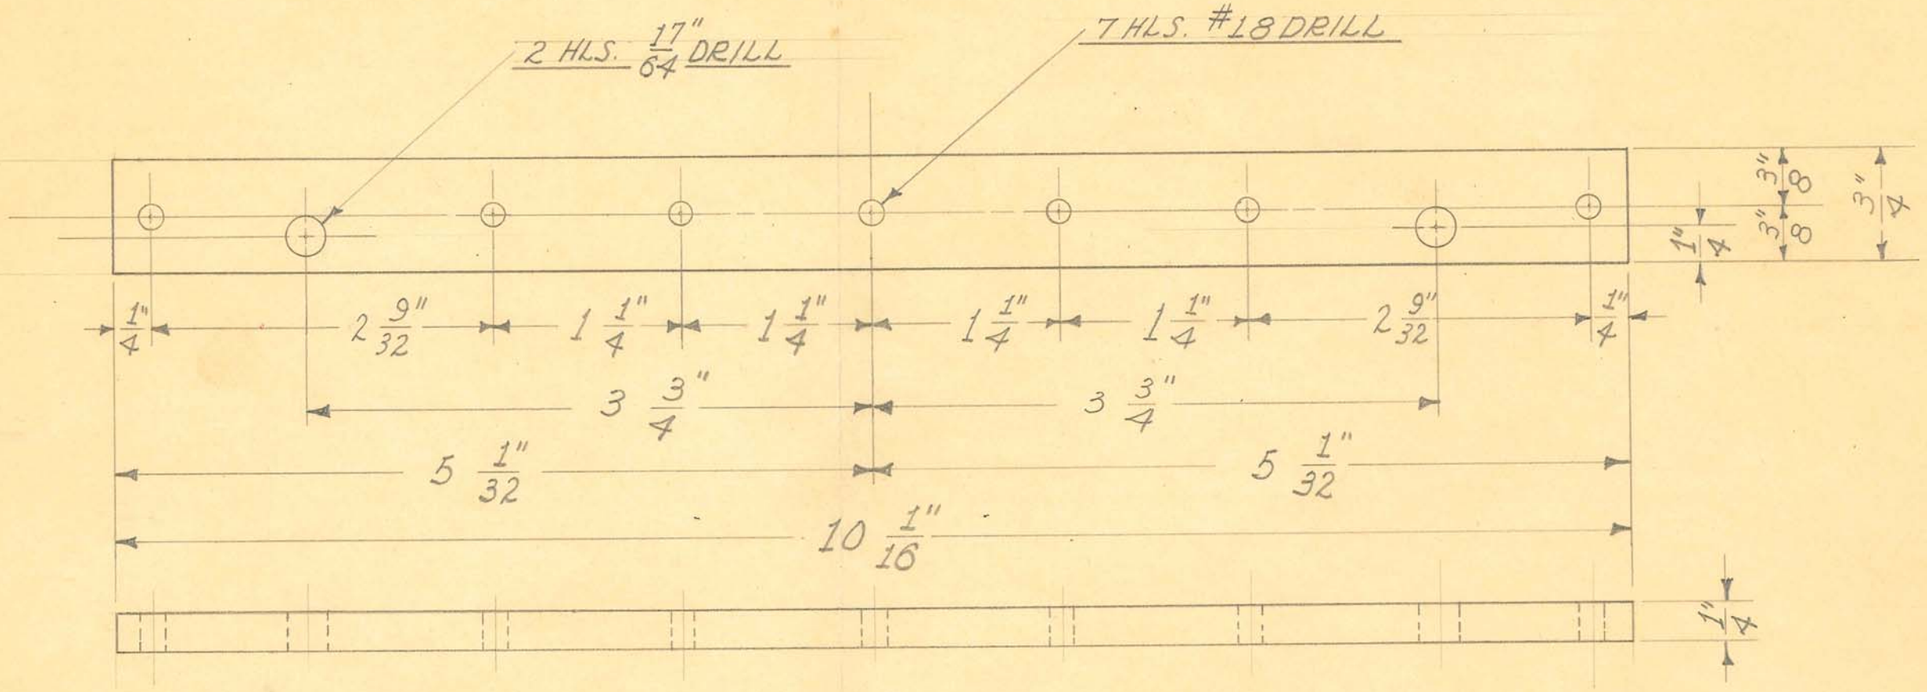

1 REQUIRED

OBSOLETE

SIZE	1/4" SHEET	ISSUE 3-20-37	J.W.
KIND	BAKELITE	CHANGED	
SHAPE		"	
FINISH		"	
TEMP.		"	
		"	

TITLE: MODEL "C" SHORT WAVE TRANSF. TERMINAL STRIP-LOWER

H. G. FISCHER & CO.
2335 WABANSIA AVE.
CHICAGO, ILL.

CAT. NO.

PART NO. 9686

6 HLS. - #37 DRILL SIZE

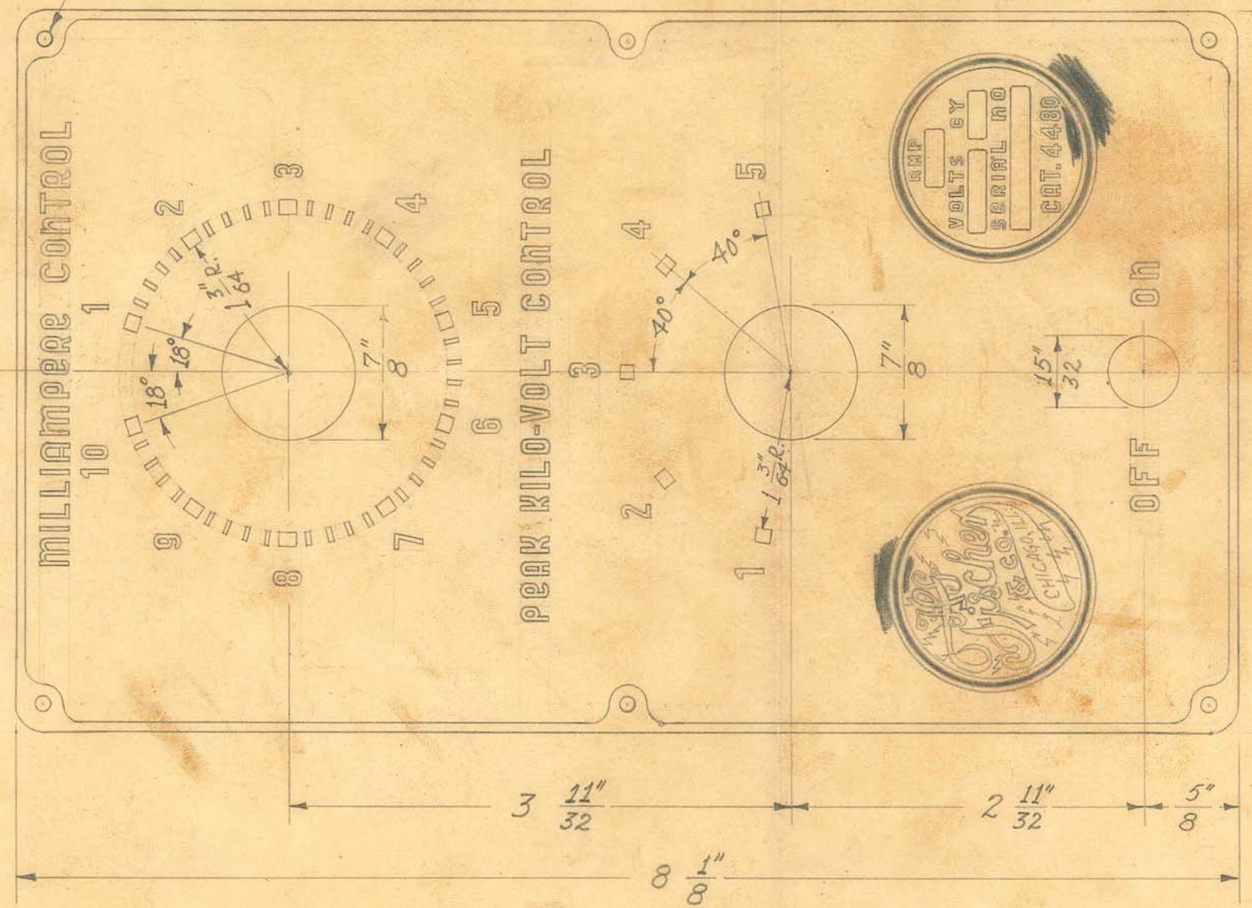

OBSOLETE

Obsolete

SIZE		ISSUE 1-10-39	J.W.	TITLE: MOD. "G" SHOCKPROOF FLUOROSCOPE PORTABLE CONTROL DIAL PLATE
KIND		CHANGED		
SHAPE		"		
FINISH		"		
TEMP.		"		
PATT.		"		

H. G. FISCHER & CO.
2335 WABANSIA AVE.
CHICAGO, ILL.

CAT. NO.

PART NO. 12521

6 HLS. - #37 DRILL SIZE

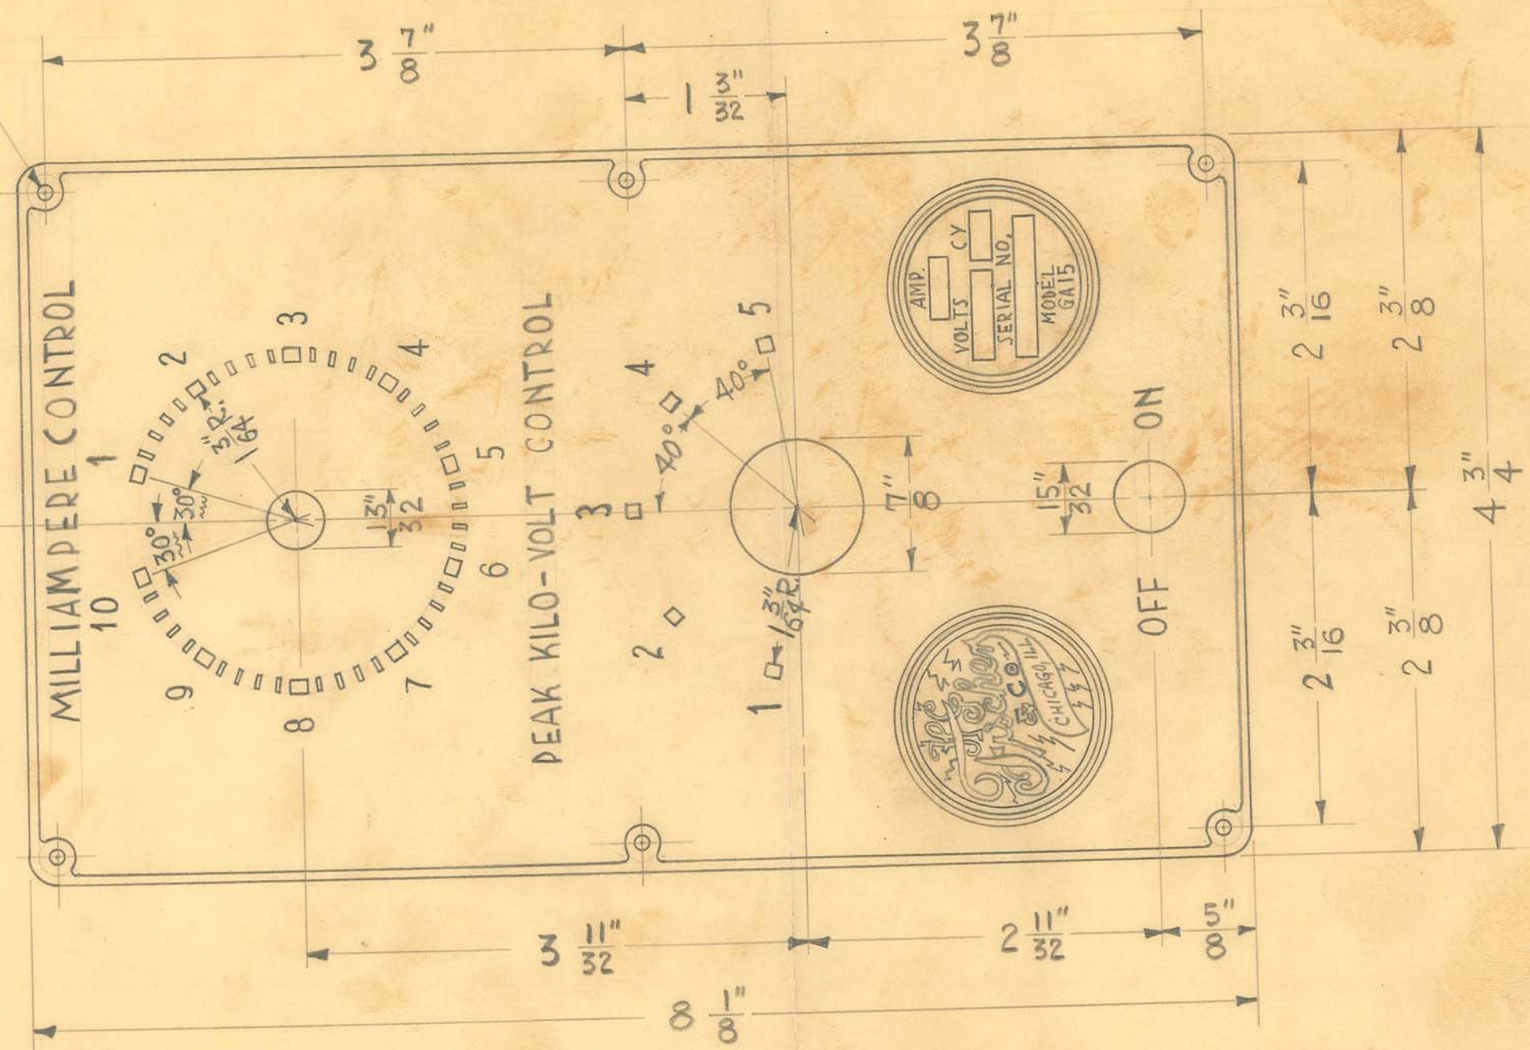

1 REQUIRED

OBSOLETE

SIZE		ISSUE 11-3-41	J.V.W.
KIND		CHANGED	
SHAPE		"	
FINISH		"	
TEMP.		"	
PATT.		"	

TITLE: FISCHER MOD. "GA-15" X-RAY UNIT
INTERMEDIATE CONTROL DIAL PLATE

H. G. FISCHER & CO.
2335 WABANSIA AVE.
CHICAGO, ILL.

CAT. NO.

PART NO. 12521A

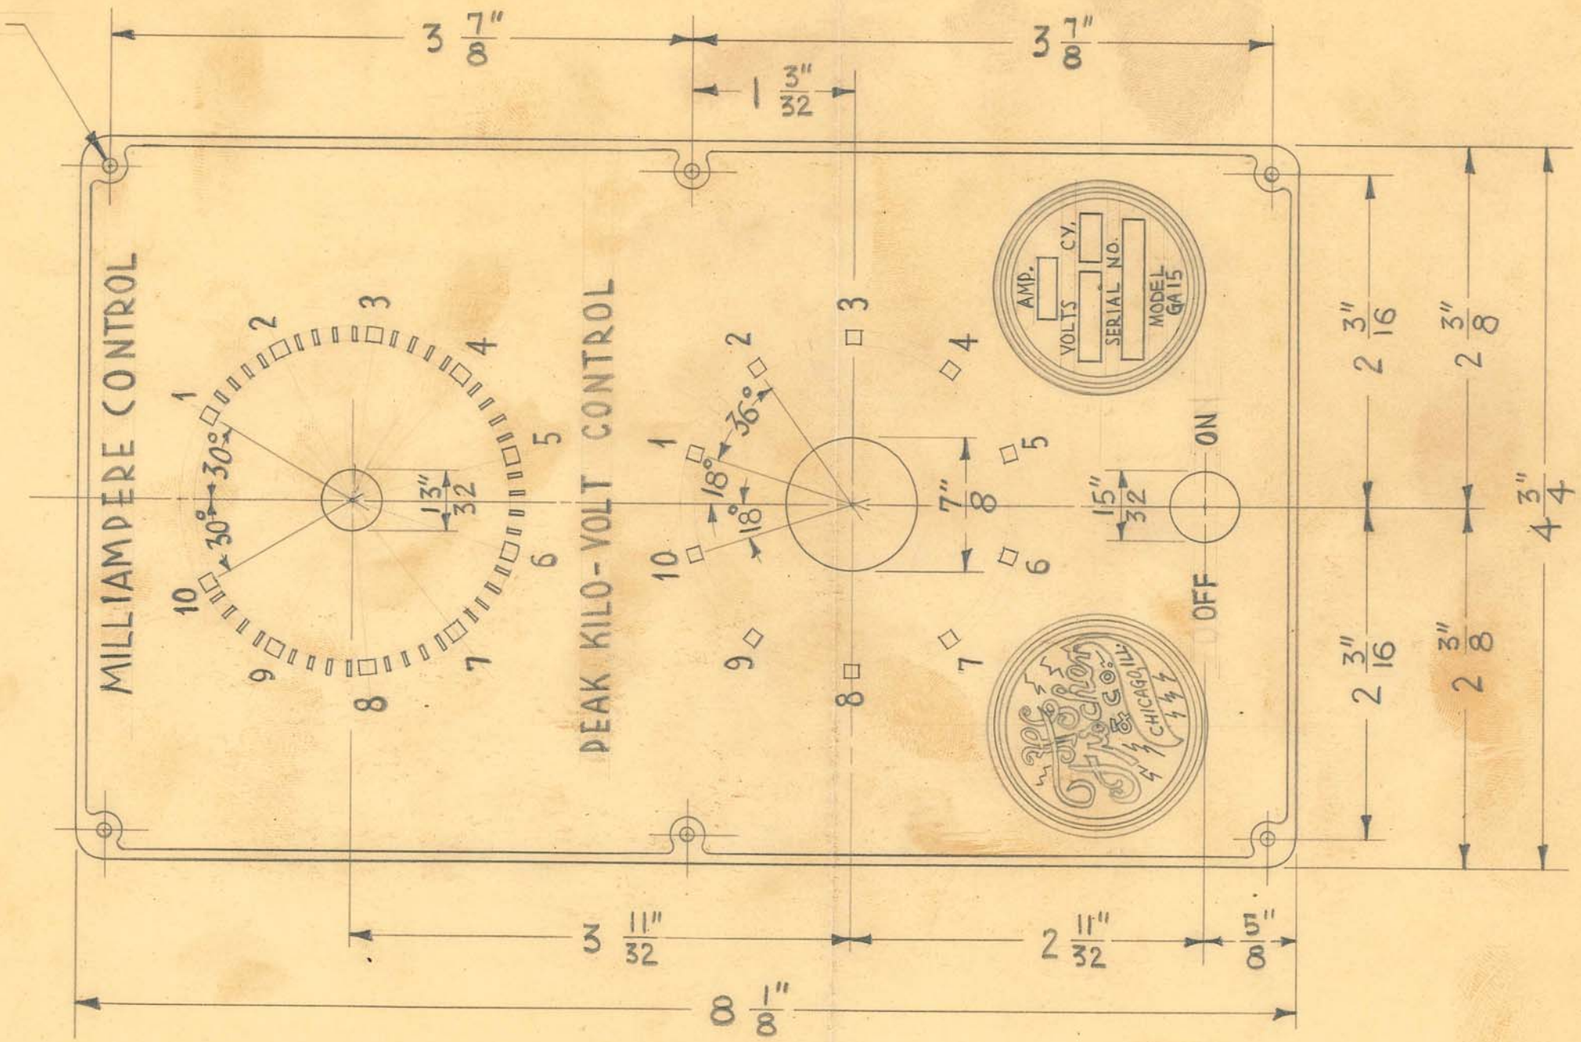

OBSOLETE

SIZE		ISSUE 2-4-42	J.V.W.	
KIND		CHANGED		
SHAPE		"		
FINISH		"		
TEMP.		"		
PATT.		"		

TITLE:
FISCHER MOD. "GA-15" X-RAY UNIT
INTERMEDIATE CONTROL DIAL PLATE

H. G. FISCHER & CO.
2335 WABANSIA AVE.
CHICAGO, ILL.

CAT. NO.

PART NO. 12521B

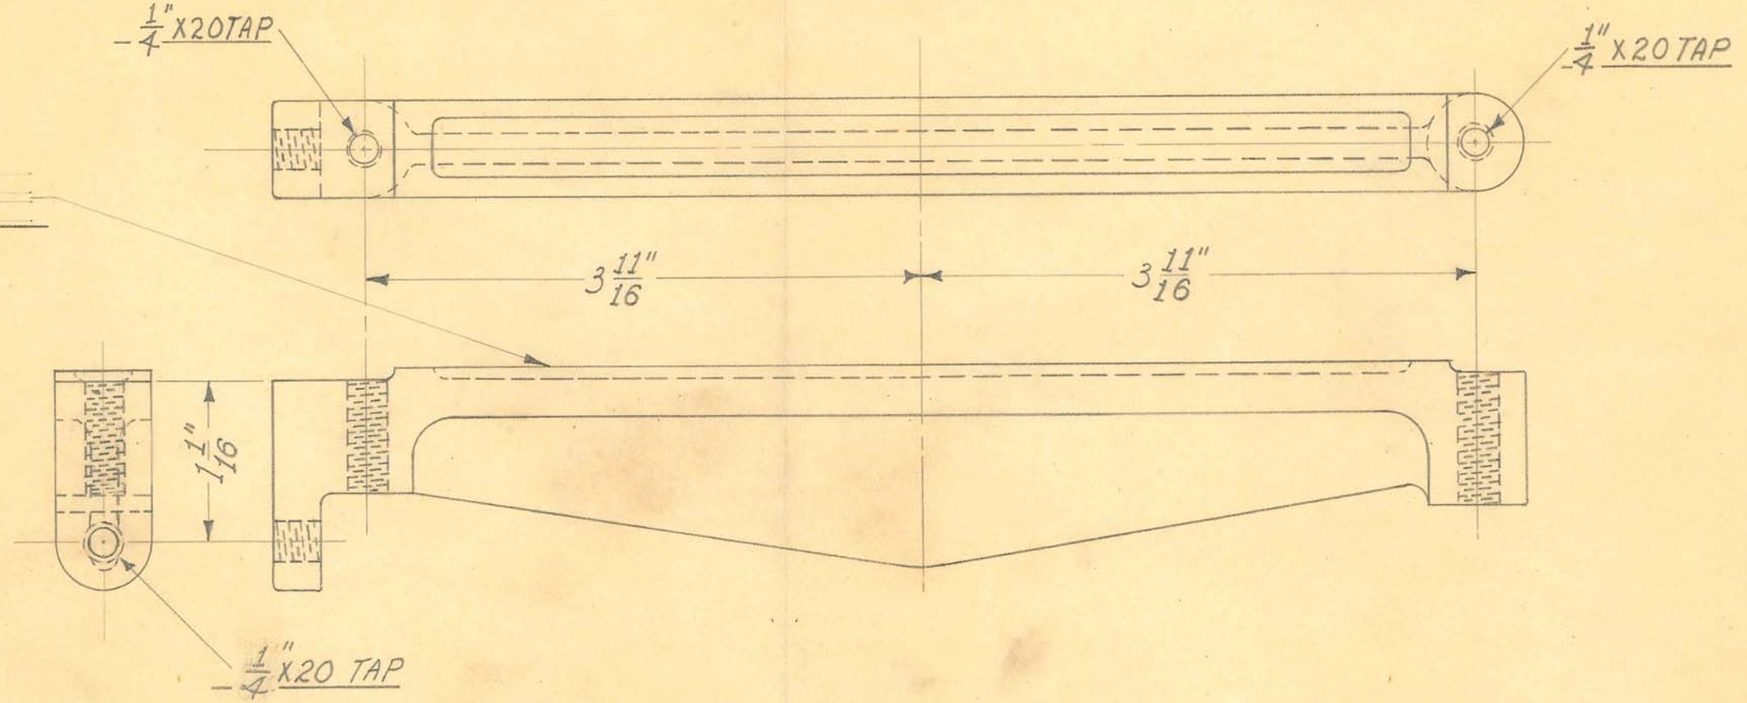

2 REQUIRED

OBSOLETE

SIZE		ISSUE 3-11-37	J.W.	TITLE: MODEL "C" SHORT WAVE H.T. TRANSF. SUPP. - FRONT
KIND	IRON CASTING	CHANGED		
SHAPE		"		
FINISH	BLACK #80	"		
TEMP.		"		
PATT.	4291-917	"		

H. G. FISCHER & CO.
2335 WABANSIA AVE.
CHICAGO. ILL.

CAT. NO.

PART NO. 9687

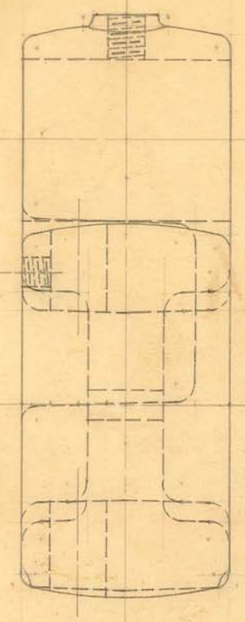

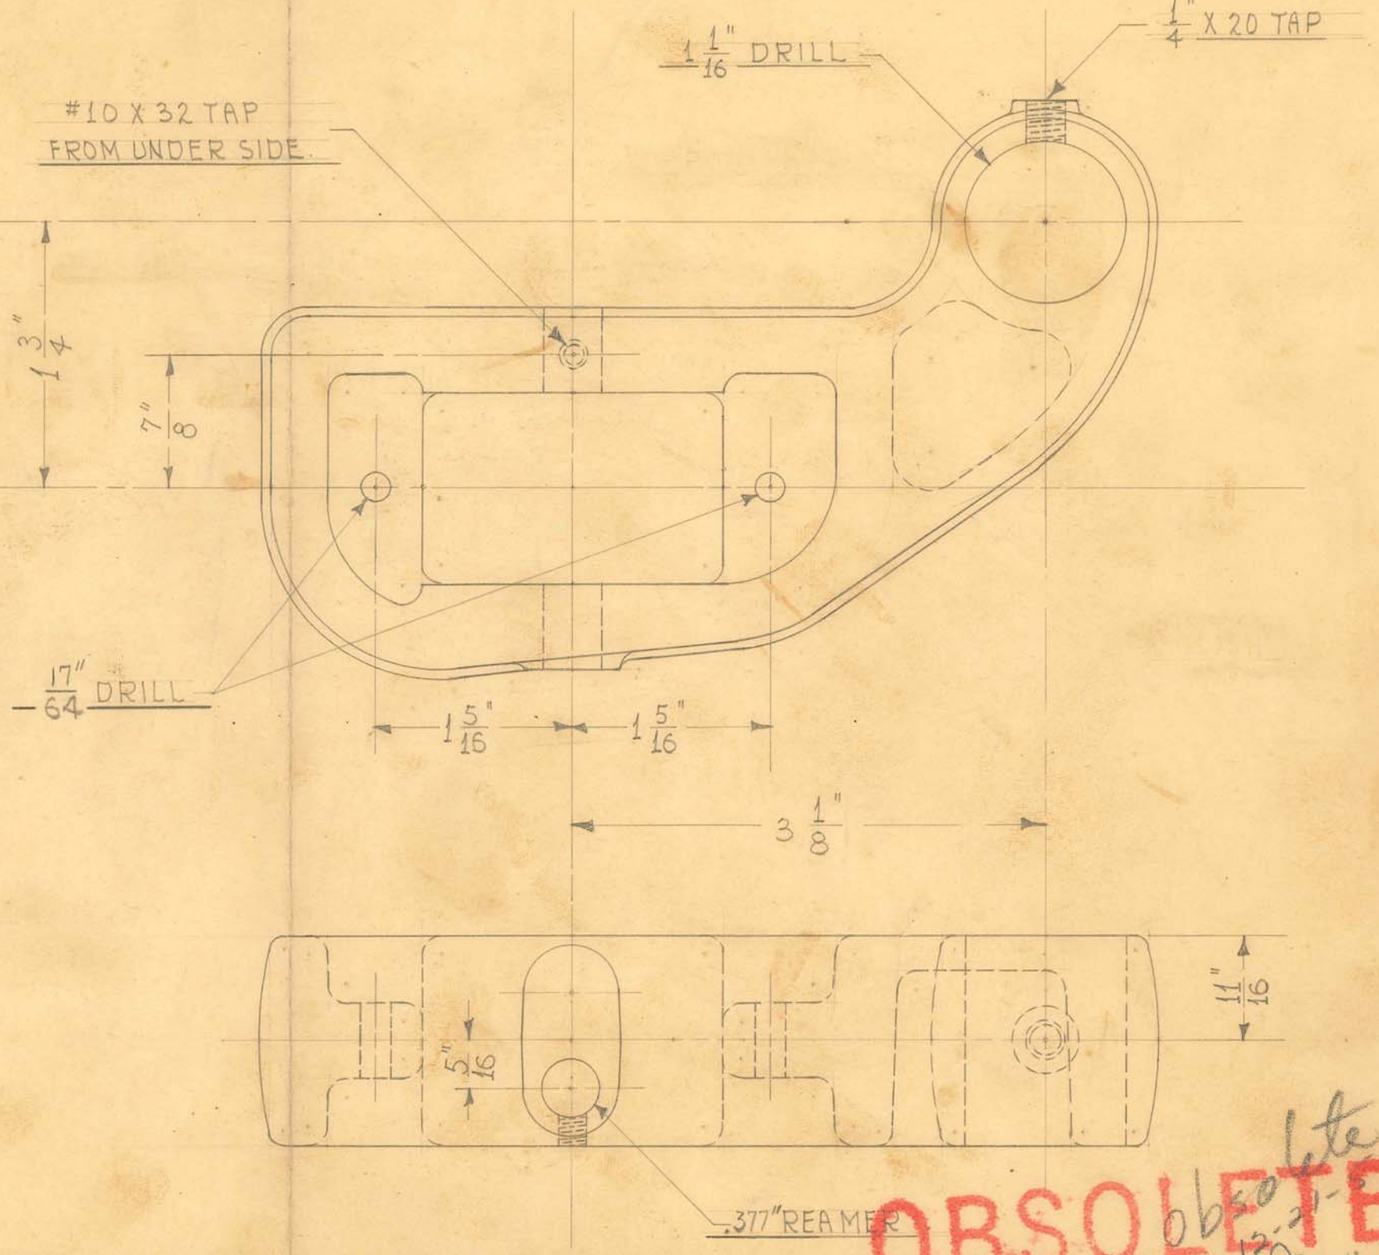

1 REQUIRED

OBSOLETE
Obsolete 12-2-[illegible] See 17425

SIZE		ISSUE 10-11-40	HE.
KIND	IRON CASTING	CHANGED	
SHAPE		"	
FINISH	PAINT	"	
TEMP.		"	

TITLE:
FISCHER MOD. "100-96" X-RAY UNIT-
TILT TABLE ROLLER BLOCK-REAR-RIGHT

H. G. FISCHER & CO. 2335 WABANSIA AVE.	CAT. NO.	PART NO. 13453F

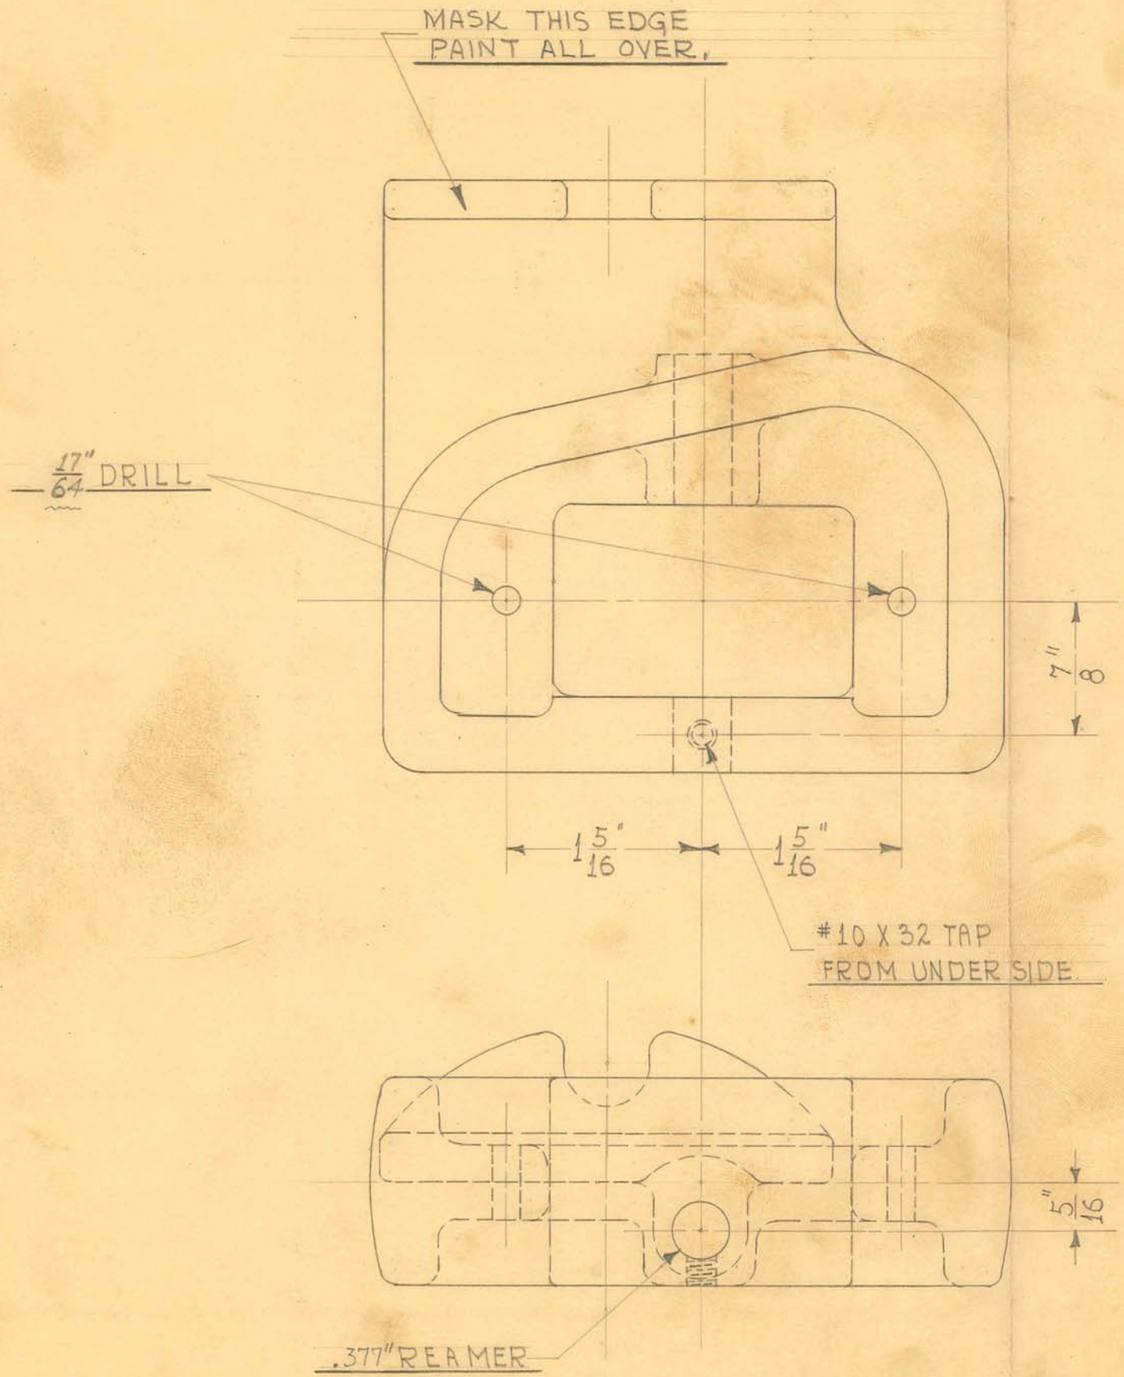

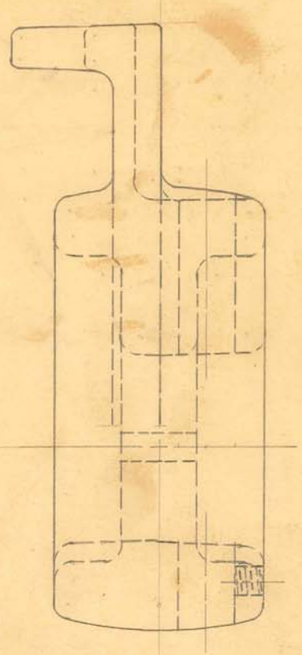

1 REQUIRED

OBSOLETE

SIZE		ISSUE 10-16-40	HE.
KIND	IRON CASTING	CHANGED 12-13-40	J.V.W.
SHAPE		"	
FINISH	CAD. #23 & PAINT	"	
TEMP.	SEE NOTE	"	
PATT.	1631	"	

TITLE: FISCHER MOD. "100-96" X-RAY UNIT - TILT TABLE ROLLER BLOCK - FRONT - LEFT

H. G. FISCHER & CO.
2335 WABANSIA AVE.
CHICAGO, ILL.

CAT. NO.

PART NO. 13456FA

Pattern Junked
E.C.O. 1182

OBSOLETE

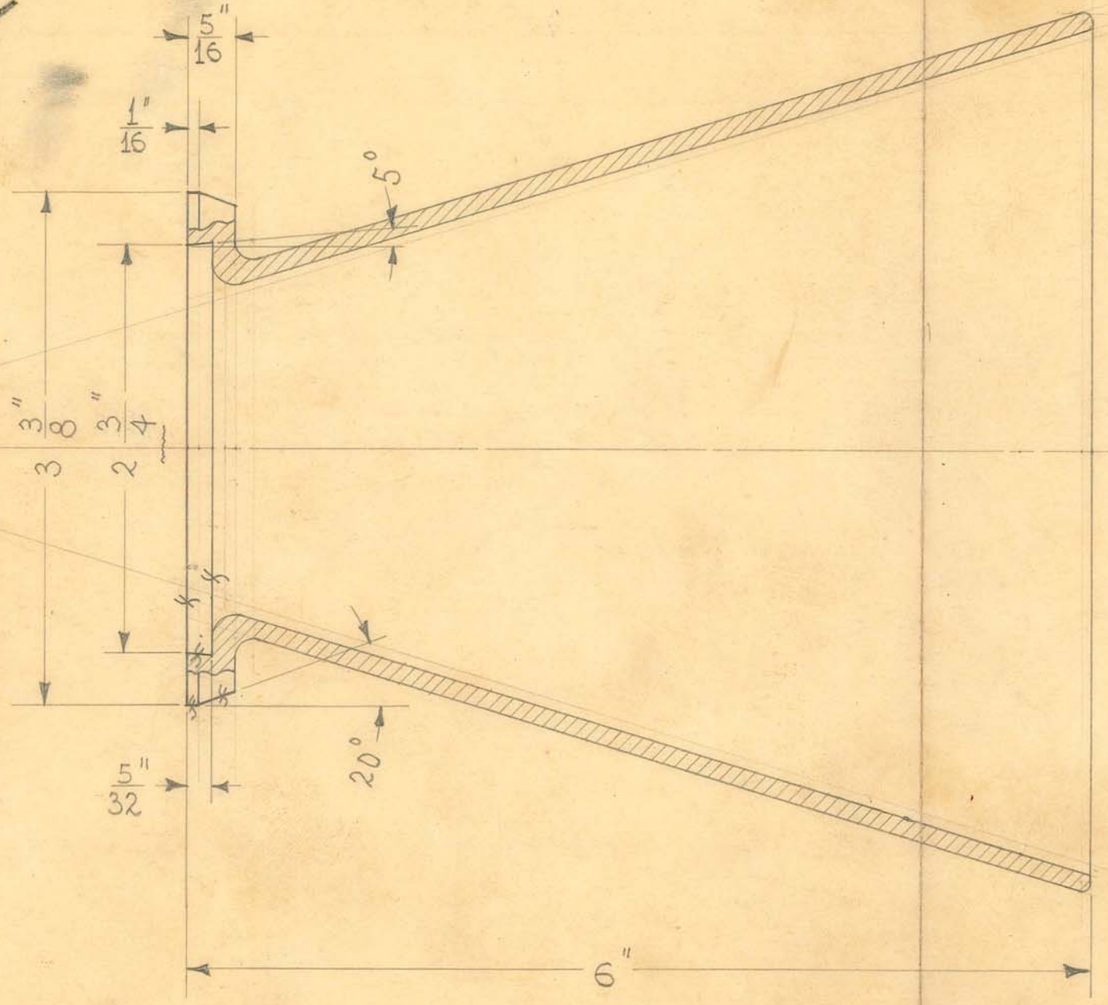

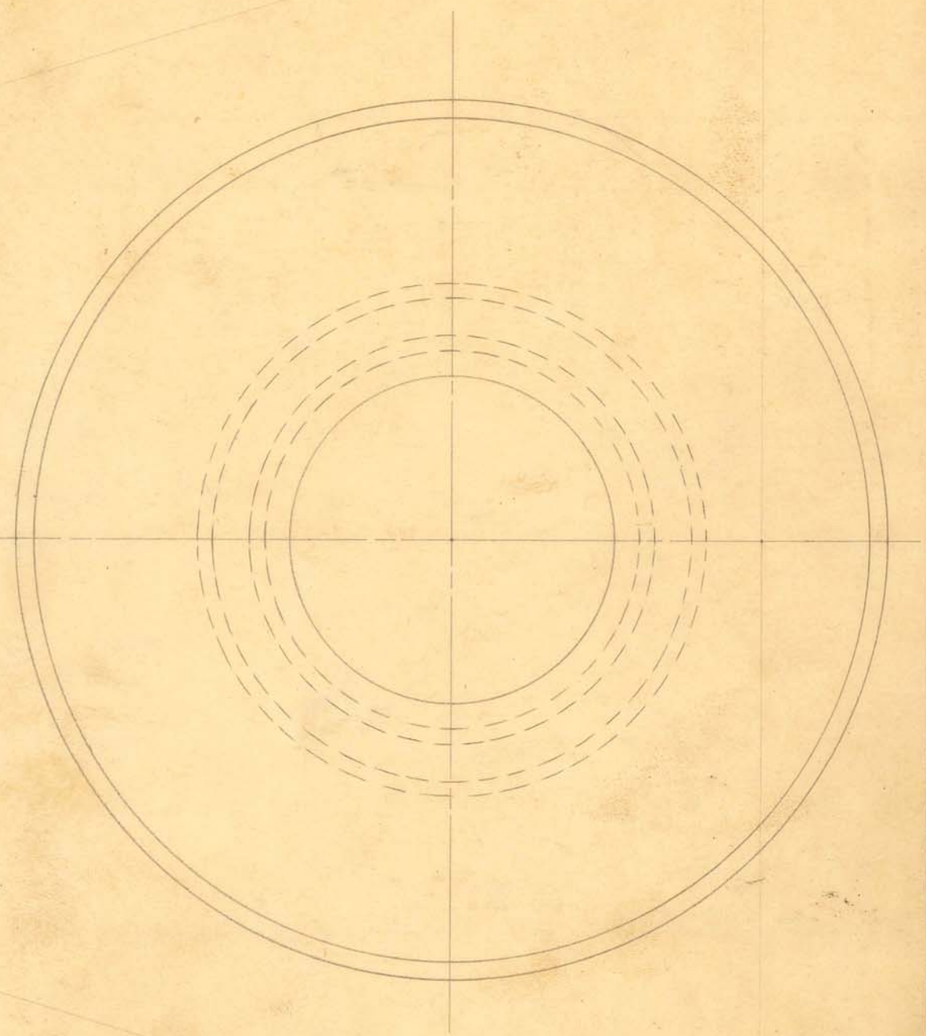

1 REQUIRED

#12 ALUMINUM

NOTE:
MASK ALL SURFACES
MARKED "f" BEFORE PAINTING.

SIZE		ISSUE 10-2-40	HE.
KIND	~~IRON CASTING~~	CHANGED	
SHAPE		"	
FINISH	PAINTED (SEE NOTE)	"	
TEMP.		"	

TITLE: X-RAY CONE SIZED TO EXPOSE A 18" DIAM. CIRCLE AT 30" DISTANCE

H. G. FISCHER & CO.
2335 WABANSIA AVE.

CAT. NO.

PART NO. 13469AF

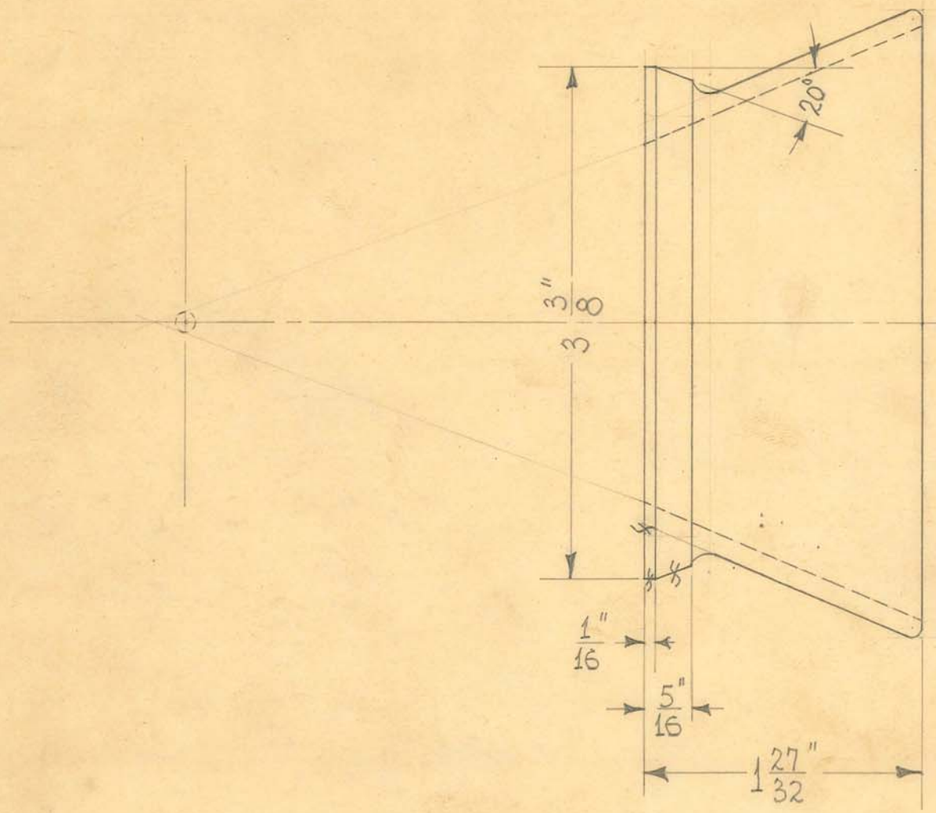

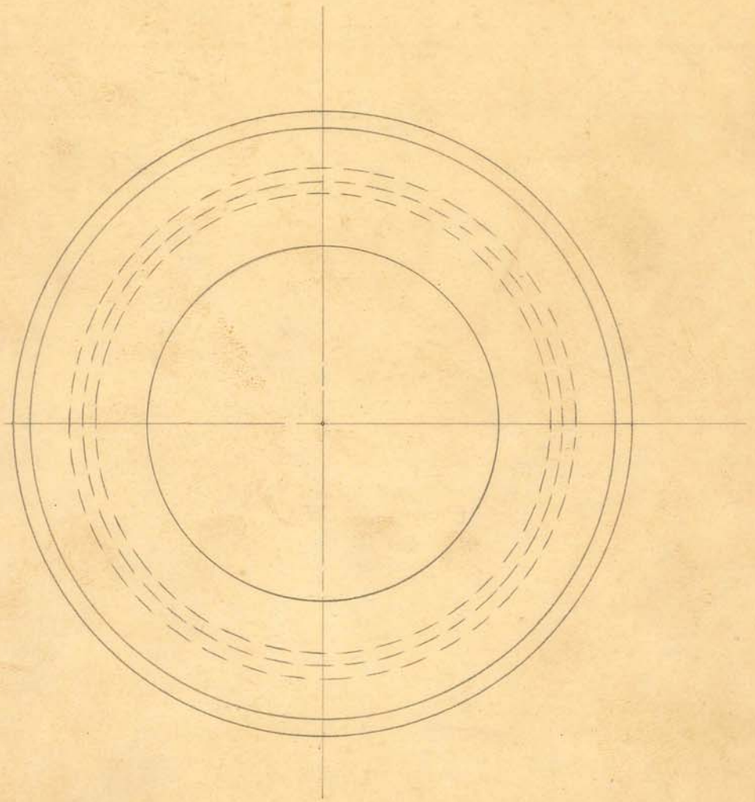

1 REQUIRED

OBSOLETE

NOTE:-
ALL SURFACES MARKED "$" ARE TO BE MASKED BEFORE PAINTING.

#12 ALUMINUM

SIZE		ISSUE 10-1-40	HE.	TITLE: FISCHER MOD. "100-96" X-RAY UNIT- 36" SPINOGRAPH FILTER - CONE SHAPED ADAPTOR
KIND	~~IRON CASTING~~	CHANGED		
SHAPE		"		
FINISH	PRINTED	"		
~~TEMP.~~	(SEE NOTE)	"		
PATT.	1626	"		

H. G. FISCHER & CO.
2335 WABANSIA AVE.
CHICAGO, ILL.

CAT. NO. 3561

PART NO. 13475AF

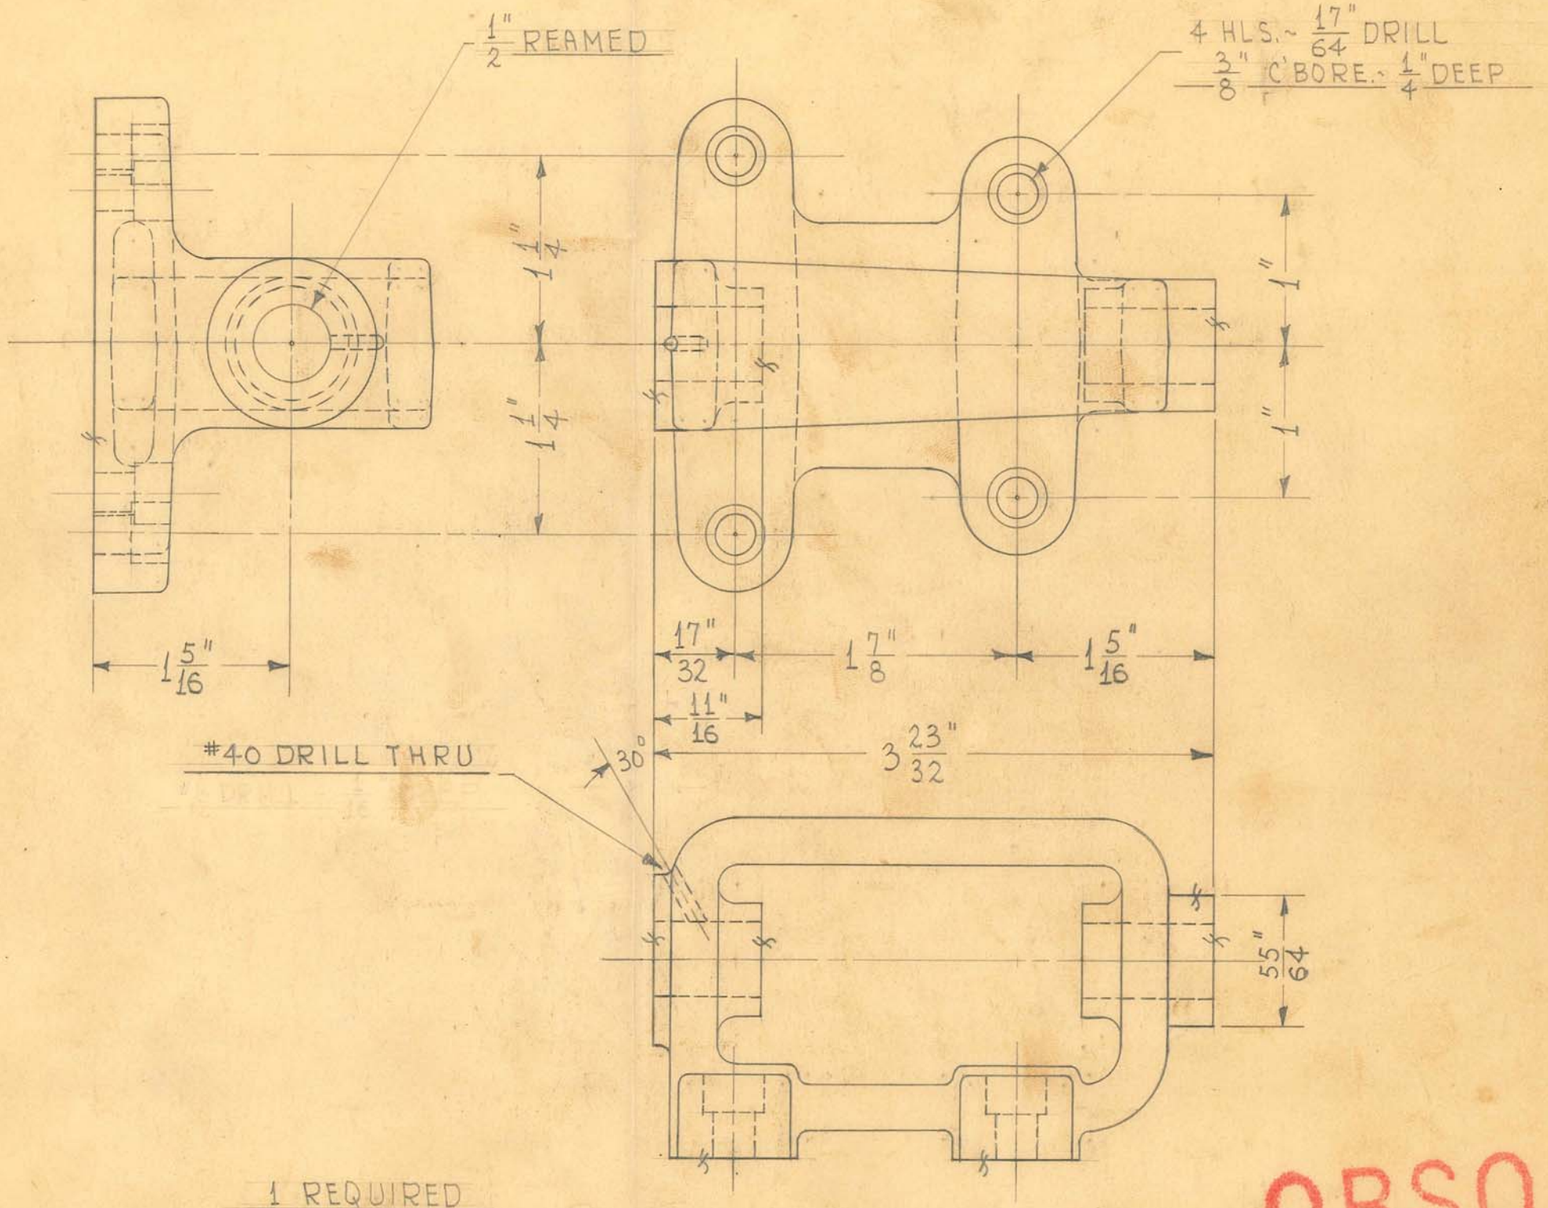

1 REQUIRED

OBSOLETE

SIZE		ISSUE 6-19-42	HE.	TITLE: ARMY SHOCKPROOF DENTAL X-RAY UNIT BEVEL GEAR BRACKET
KIND	IRON CASTING	CHANGED		
SHAPE		"		
FINISH	BLACK #80	"		
TEMP.		"		
PATT.	1895	"		

H. G. FISCHER & CO.
2335 WABANSIA AVE.
CHICAGO, ILL.

CAT. NO.

PART NO. 13586F

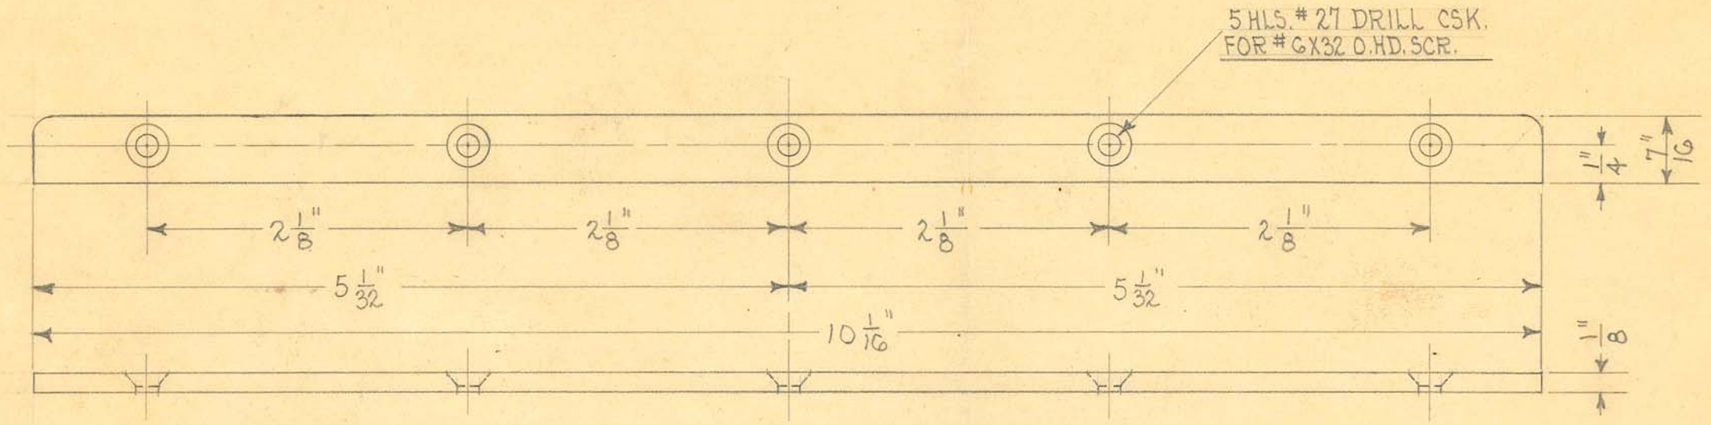

4 REQUIRED

OBSOLETE

SIZE	7/16" X 1/8"	ISSUE 3-6-33	H.E.	TITLE: UNIVERSAL "GO-88" TABLE SLIDE CLAMP STRIP
KIND	C.R. STEEL	CHANGED		
SHAPE		" "		
FINISH	SEE ABOVE	" "		
TEMP.		" "		
PATT.		" "		

H. G. FISCHER & CO.
2335 WABANSIA AVE.
CHICAGO, ILL.

CAT. NO.

PART NO. 8022

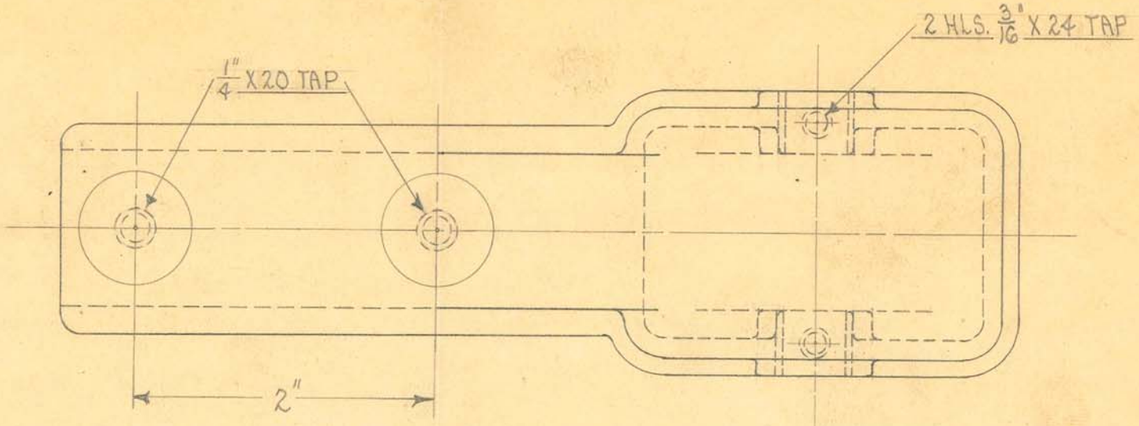

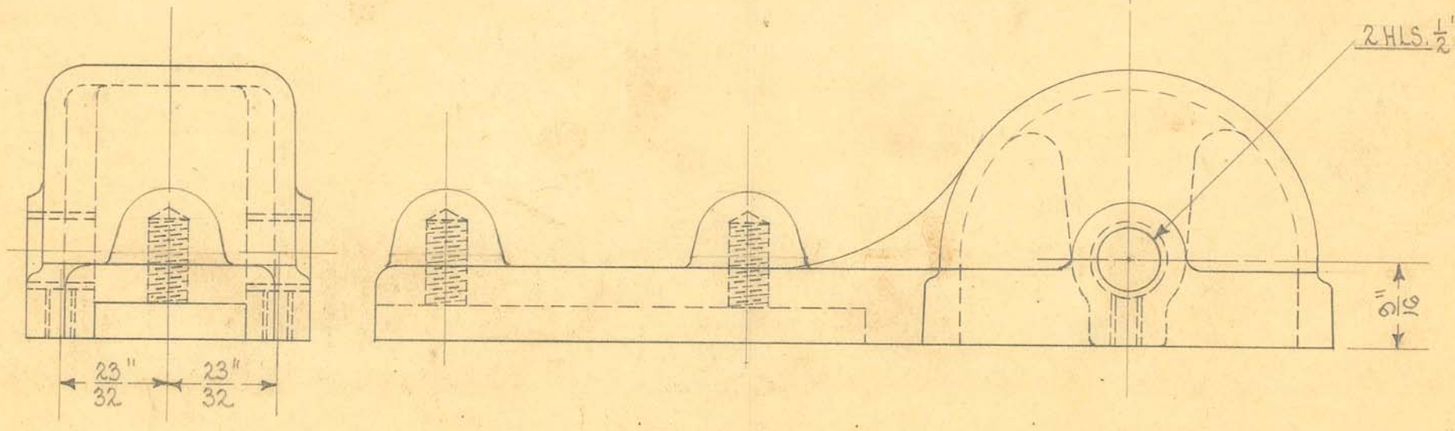

1 REQUIRED

OBSOLETE

SIZE		ISSUE 1-7-33	H.E.	TITLE: UNIVERSAL "60-88" TABLE SMALL GUIDE ROLLER SUPPORT
KIND	IRON CASTING	CHANGED		
SHAPE		" "		
FINISH		" "		
TEMP.		" "		H. G. FISCHER & CO. 2335 WABANSIA AVE. CHICAGO, ILL. — CAT. NO. — PART NO. 8031F
PATT.	2013-609	" "		

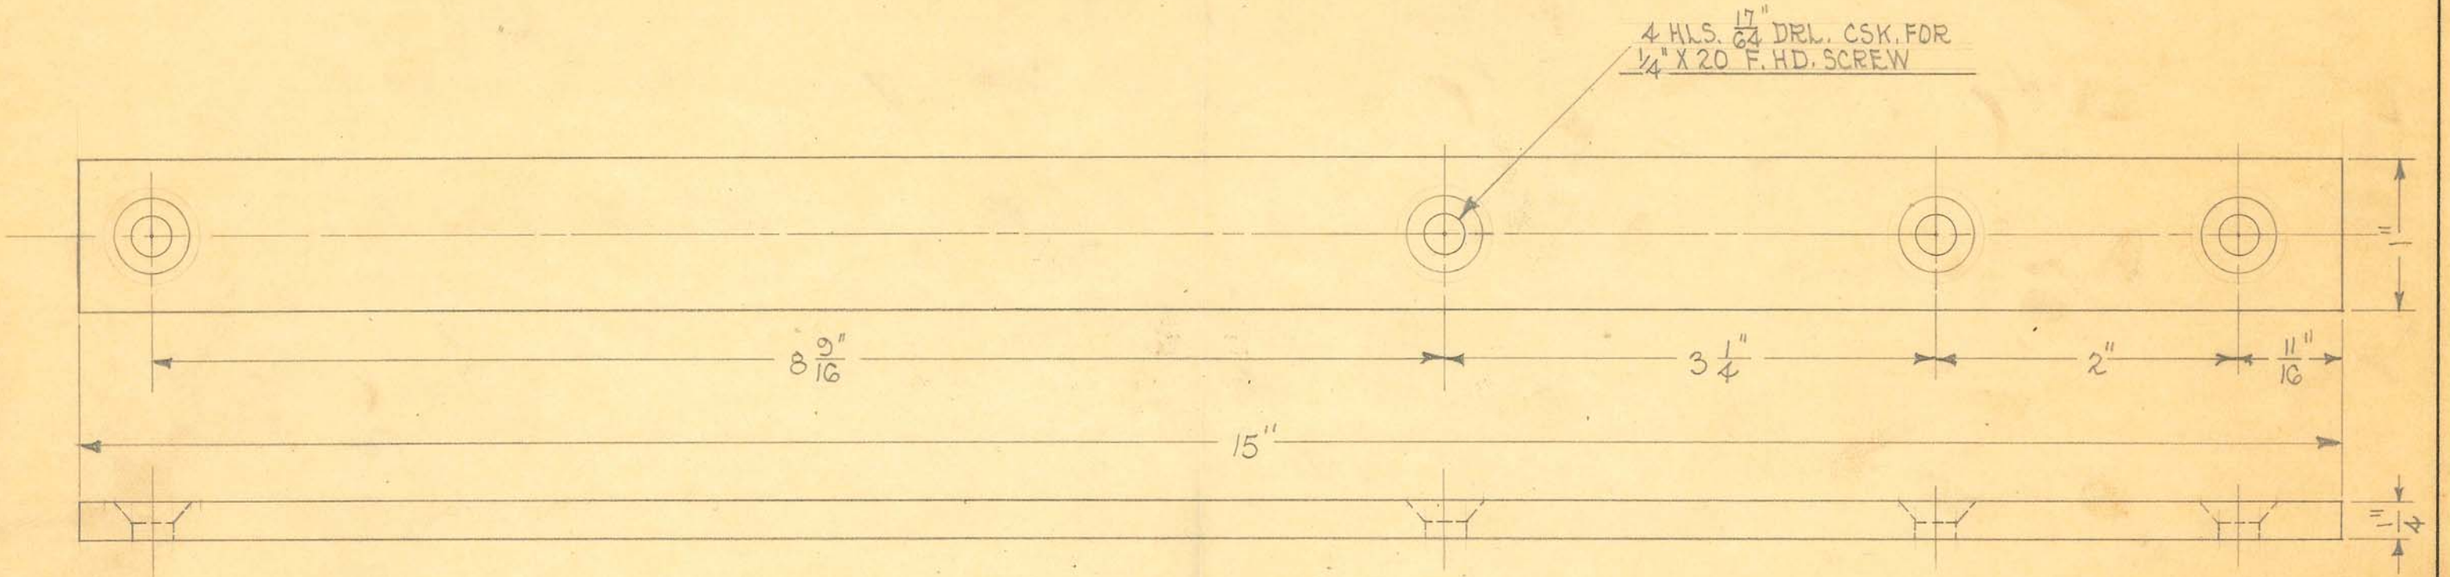

1 REQUIRED

OBSOLETE

SIZE	1/4" X 1"	ISSUE 4-7-33	A.E.	TITLE: UNIVERSAL "GO-88" TABLE SMALL GUIDE ROLLER SUPPORT STRIP
KIND	SPRING STEEL	CHANGED		
SHAPE		" "		
FINISH	STD. BLK #80	" "		
TEMP.		" "		H. G. FISCHER & CO. 2335 WABANSIA AVE. CHICAGO, ILL. — CAT. NO. — PART NO. 8033
PATT.		" "		

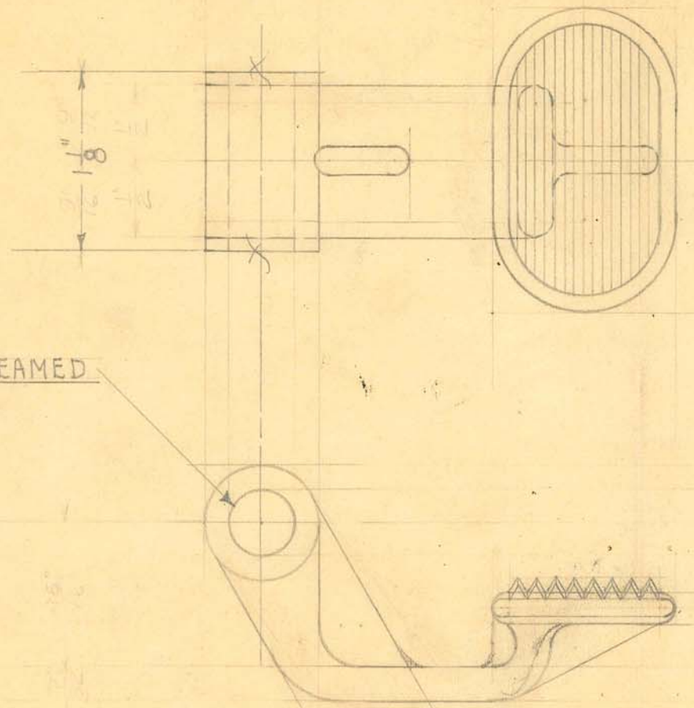

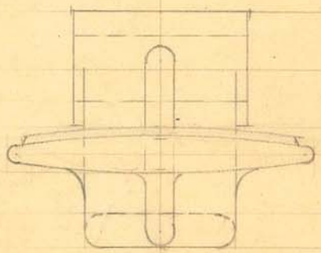

OBSOLETE

SIZE		ISSUE		TITLE: UNIVERSAL "CO-88" TABLE HORIZONTAL LOCKING DEVICE FOOT LEVER
KIND		CHANGED		
SHAPE		" "		
FINISH	CAD. PLATE	" "		
TEMP.		" "		H. G. FISCHER & CO. 2335 WABANSIA AVE. CHICAGO, ILL. — CAT. NO. — PART NO. 8041F
PATT.	1678-587	" "		

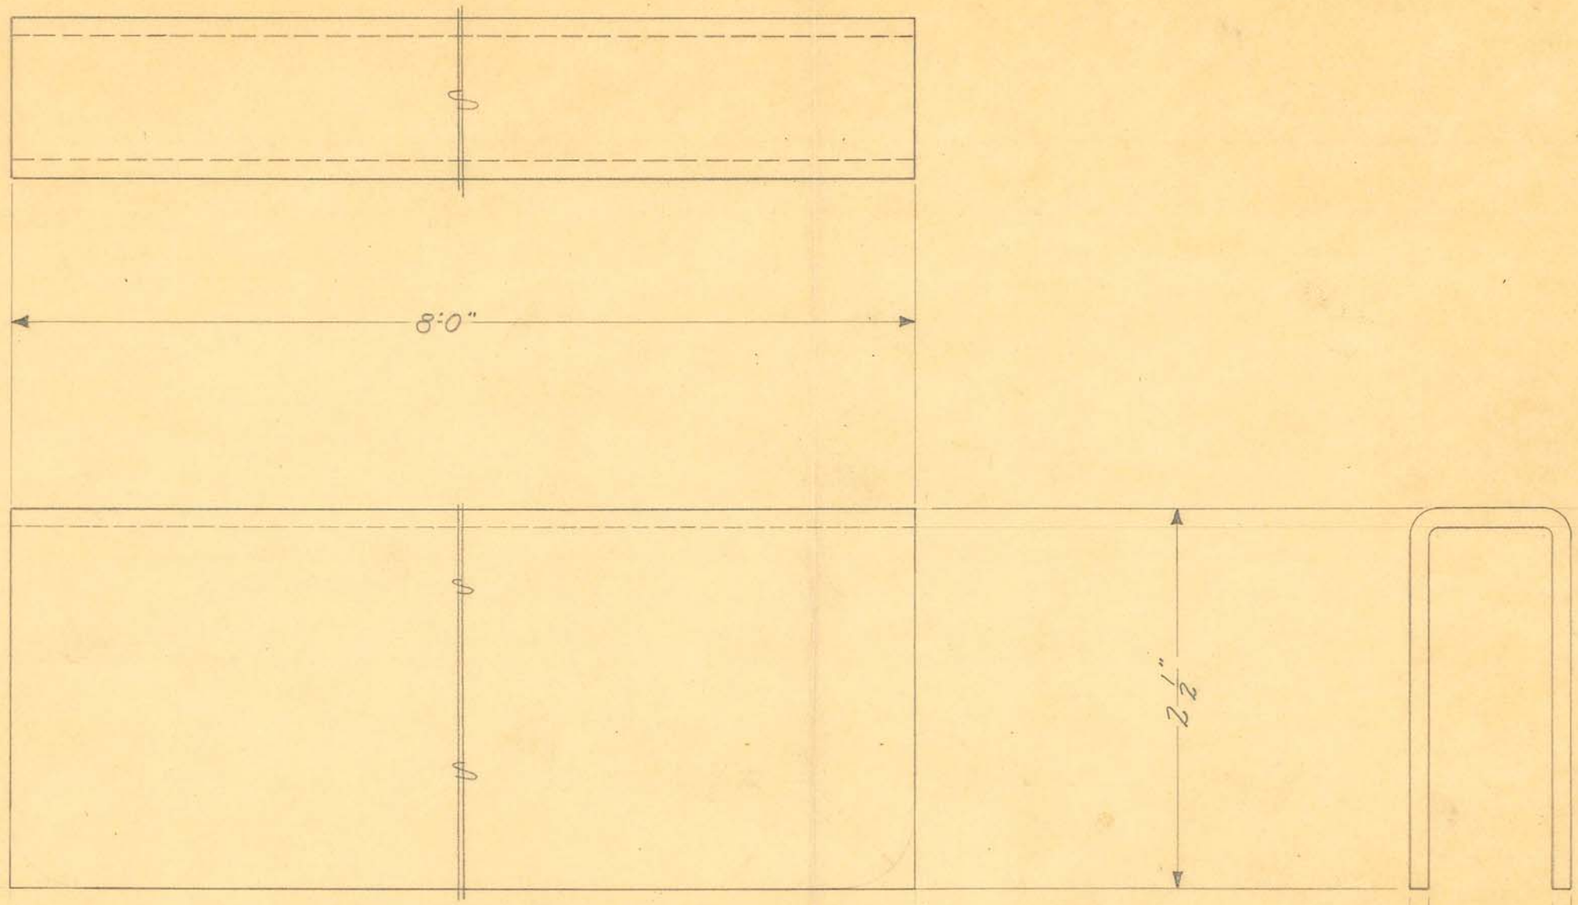

2-REQ'D

OBSOLETE

SIZE	11GA. U.S.S.	ISSUE	
KIND		CHANGED	
SHAPE		" "	
FINISH	NONE	" "	
TEMP.		" "	
PATT.		" "	

TITLE: UNIVERSAL "60-88" TABLE LEG HOLDER

OBSOLETE

H. G. FISCHER & CO.
2335 WABANSIA AVE.
CHICAGO, ILL.

CAT. NO.

PART NO. 8064

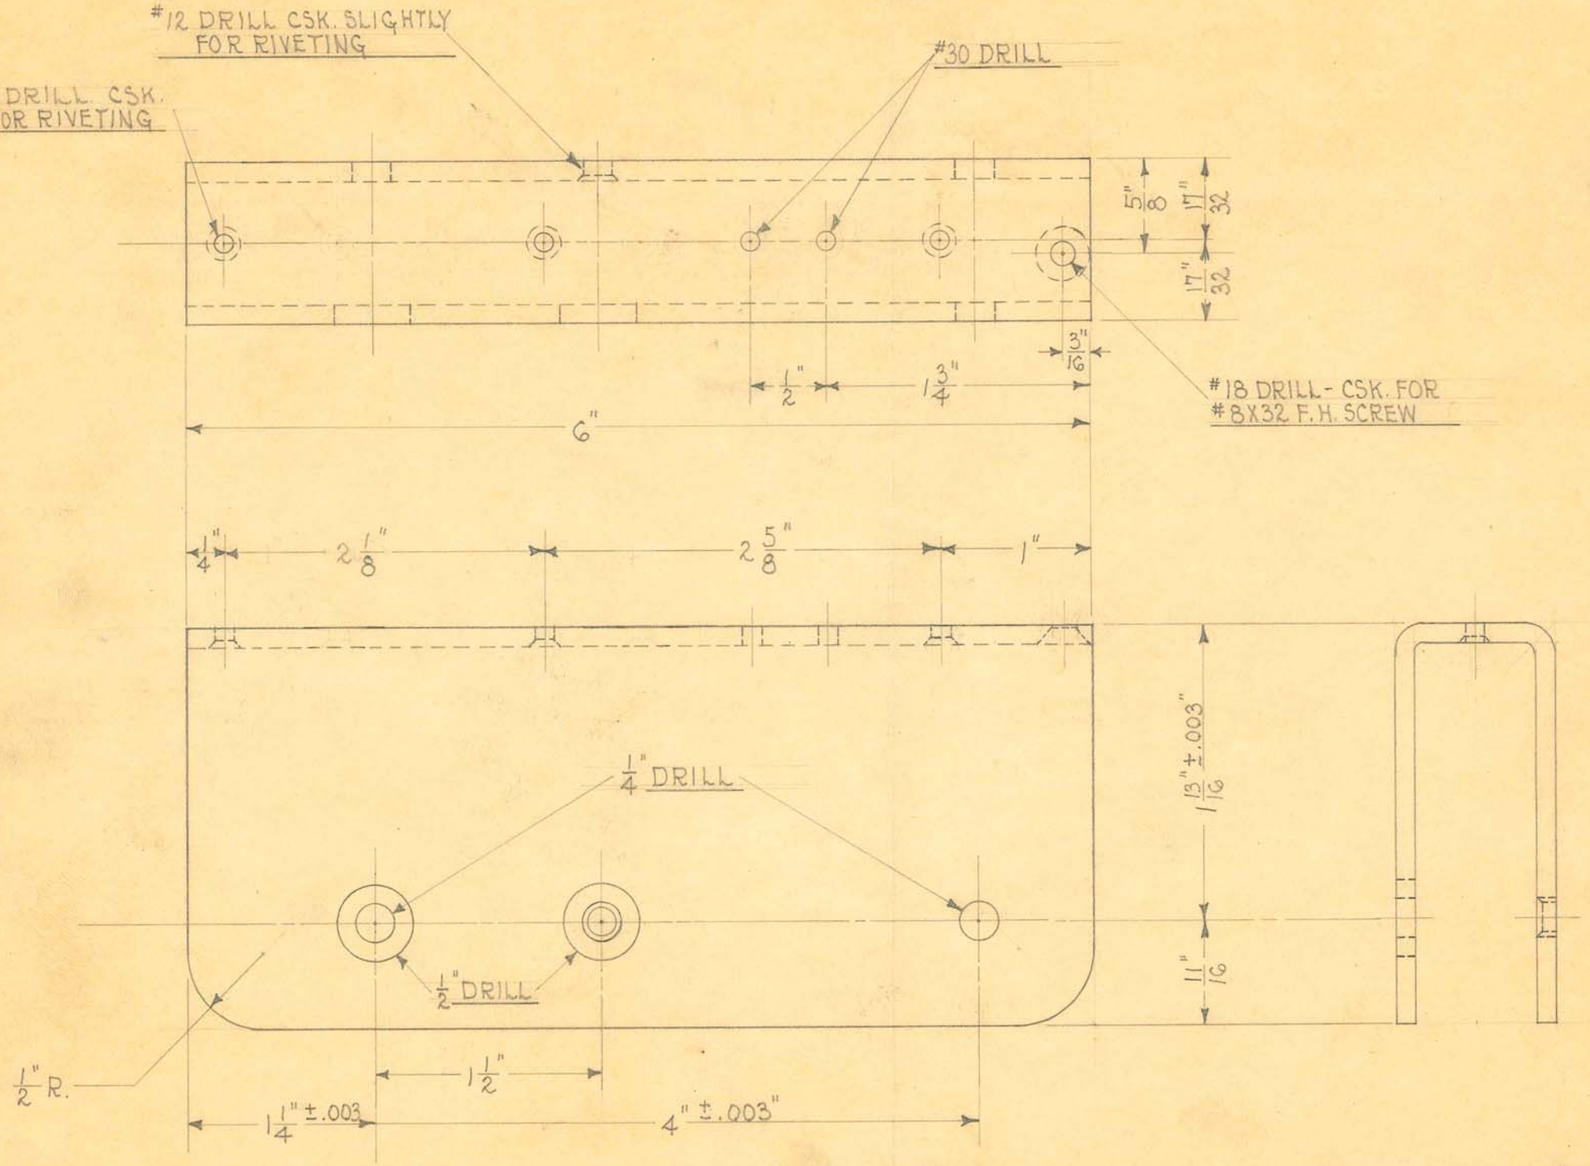

2 REQUIRED

OBSOLETE

SIZE		ISSUE 10-25-33	AE.	TITLE: UNIVERSAL "CO-88" TABLE LEG HOLDER
KIND		CHANGED		
SHAPE		" "		OBSOLETE
FINISH		" "		
TEMP.		" "		
PATT.		" "		

H. G. FISCHER & CO.
2335 WABANSIA AVE.
CHICAGO, ILL.

CAT. NO.

PART NO. 8064F

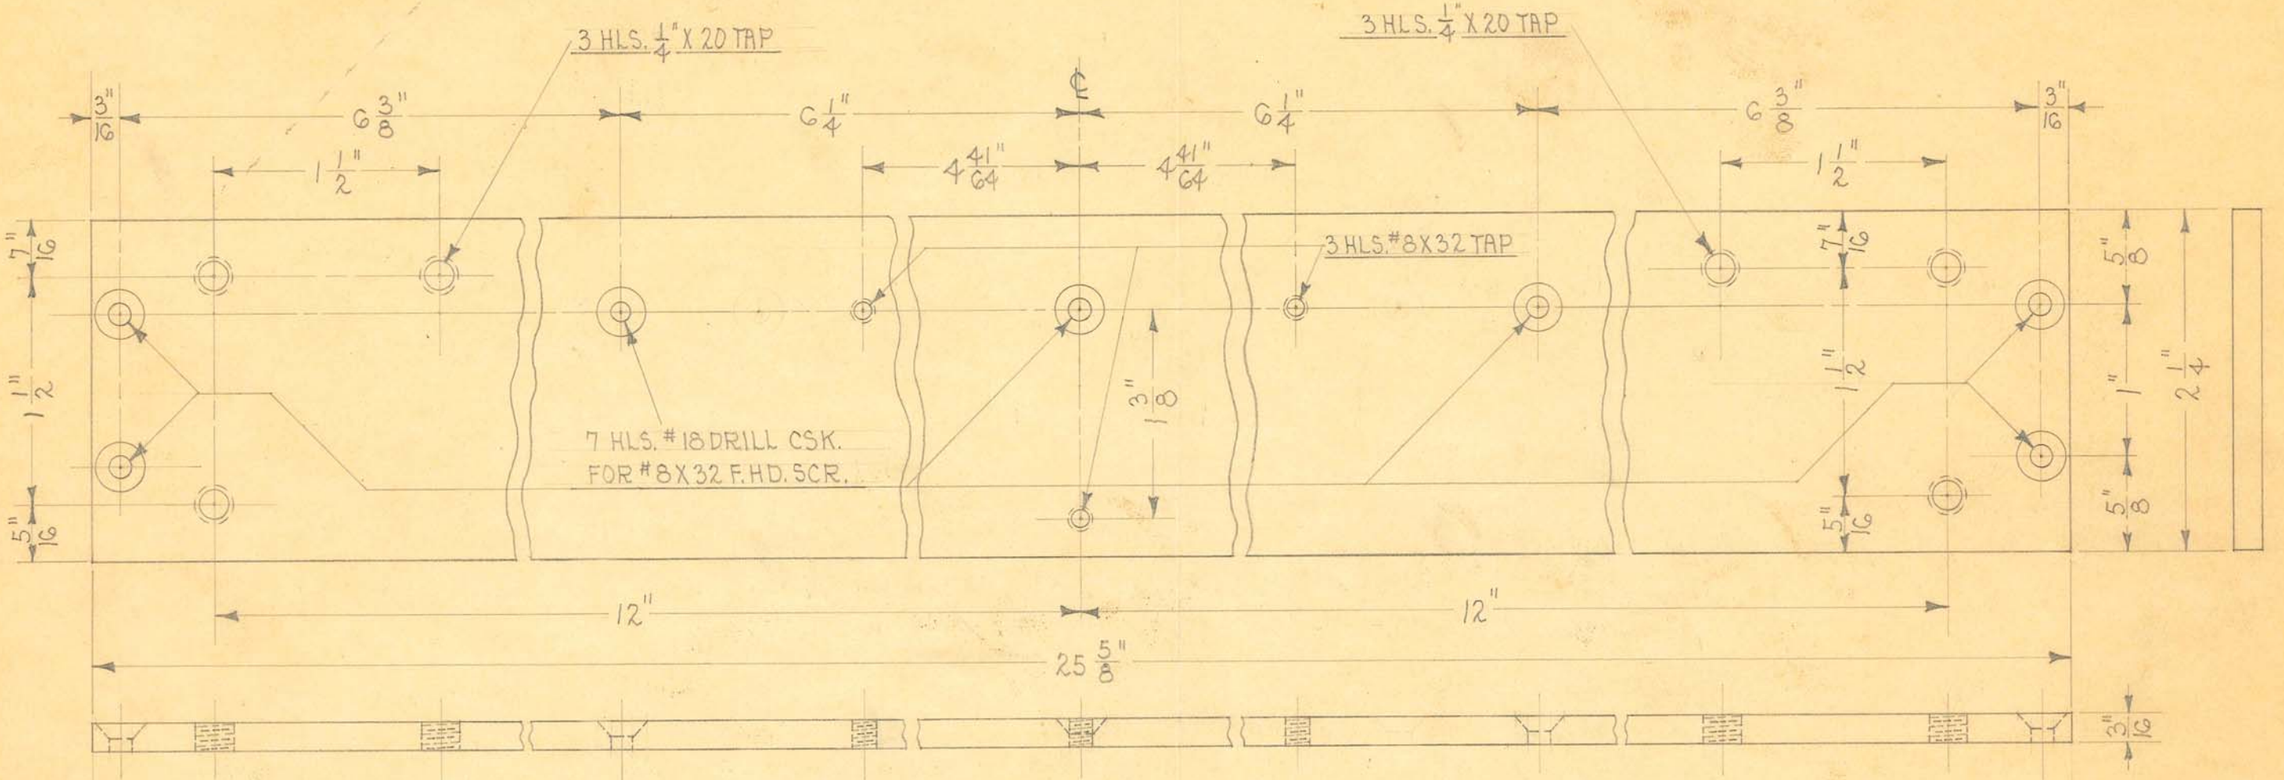

OBSOLETE

SIZE	2¼" X 3/16"	ISSUE 9-11-34	W.E.	TITLE: UNIVERSAL "GO-88" TABLE LEG PLATE
KIND	STRIP C.R. STEEL	CHANGED		
SHAPE		" "		
FINISH	BLACK #70	" "		
TEMP.		" "		
PATT.		" "		

H. G. FISCHER & CO.
2335 WABANSIA AVE.
CHICAGO, ILL.

CAT. NO.

PART NO. 8067A

SATIN CHROME POLISH
OUTSIDE FACES ONLY

4 HLS. #18 DRL. CSK.
FOR #8 X 32 F. HD. SCR.

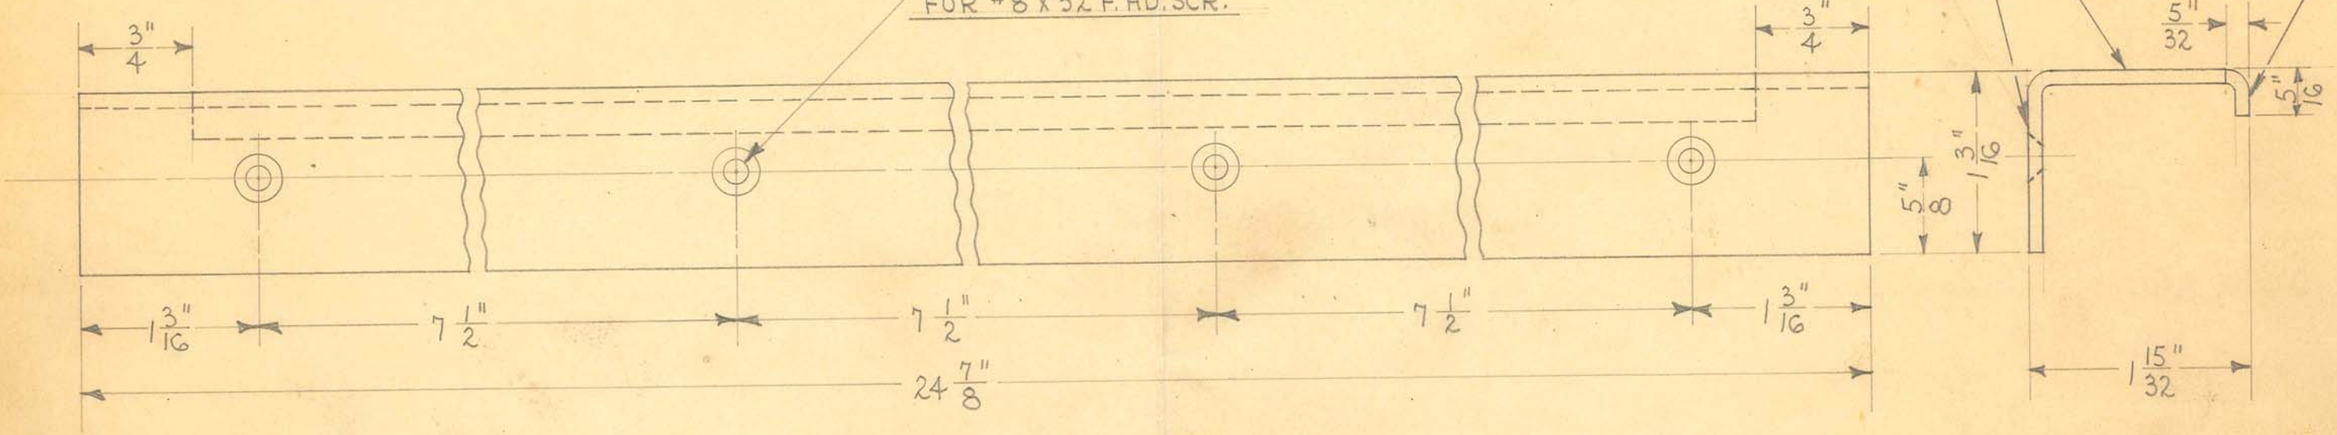

2 REQUIRED

OBSOLETE
obsolete
1-24-51

DRILL JIG #6029 MILL FIX. #5342

SATIN CHROME #4

SIZE	.093"	ISSUE 2-12-37	A.E.
KIND	SHEET STEEL	CHANGED	
SHAPE		"	
FINISH	PAINTED	"	
TEMP.		"	
PATT.		"	

TITLE:
UNIVERSAL "60-88" TABLE
END CHANNEL (DRILLED)

H. G. FISCHER & CO.
2335 WABANSIA AVE.
CHICAGO, ILL.

CAT. NO.

PART NO. 8076AF

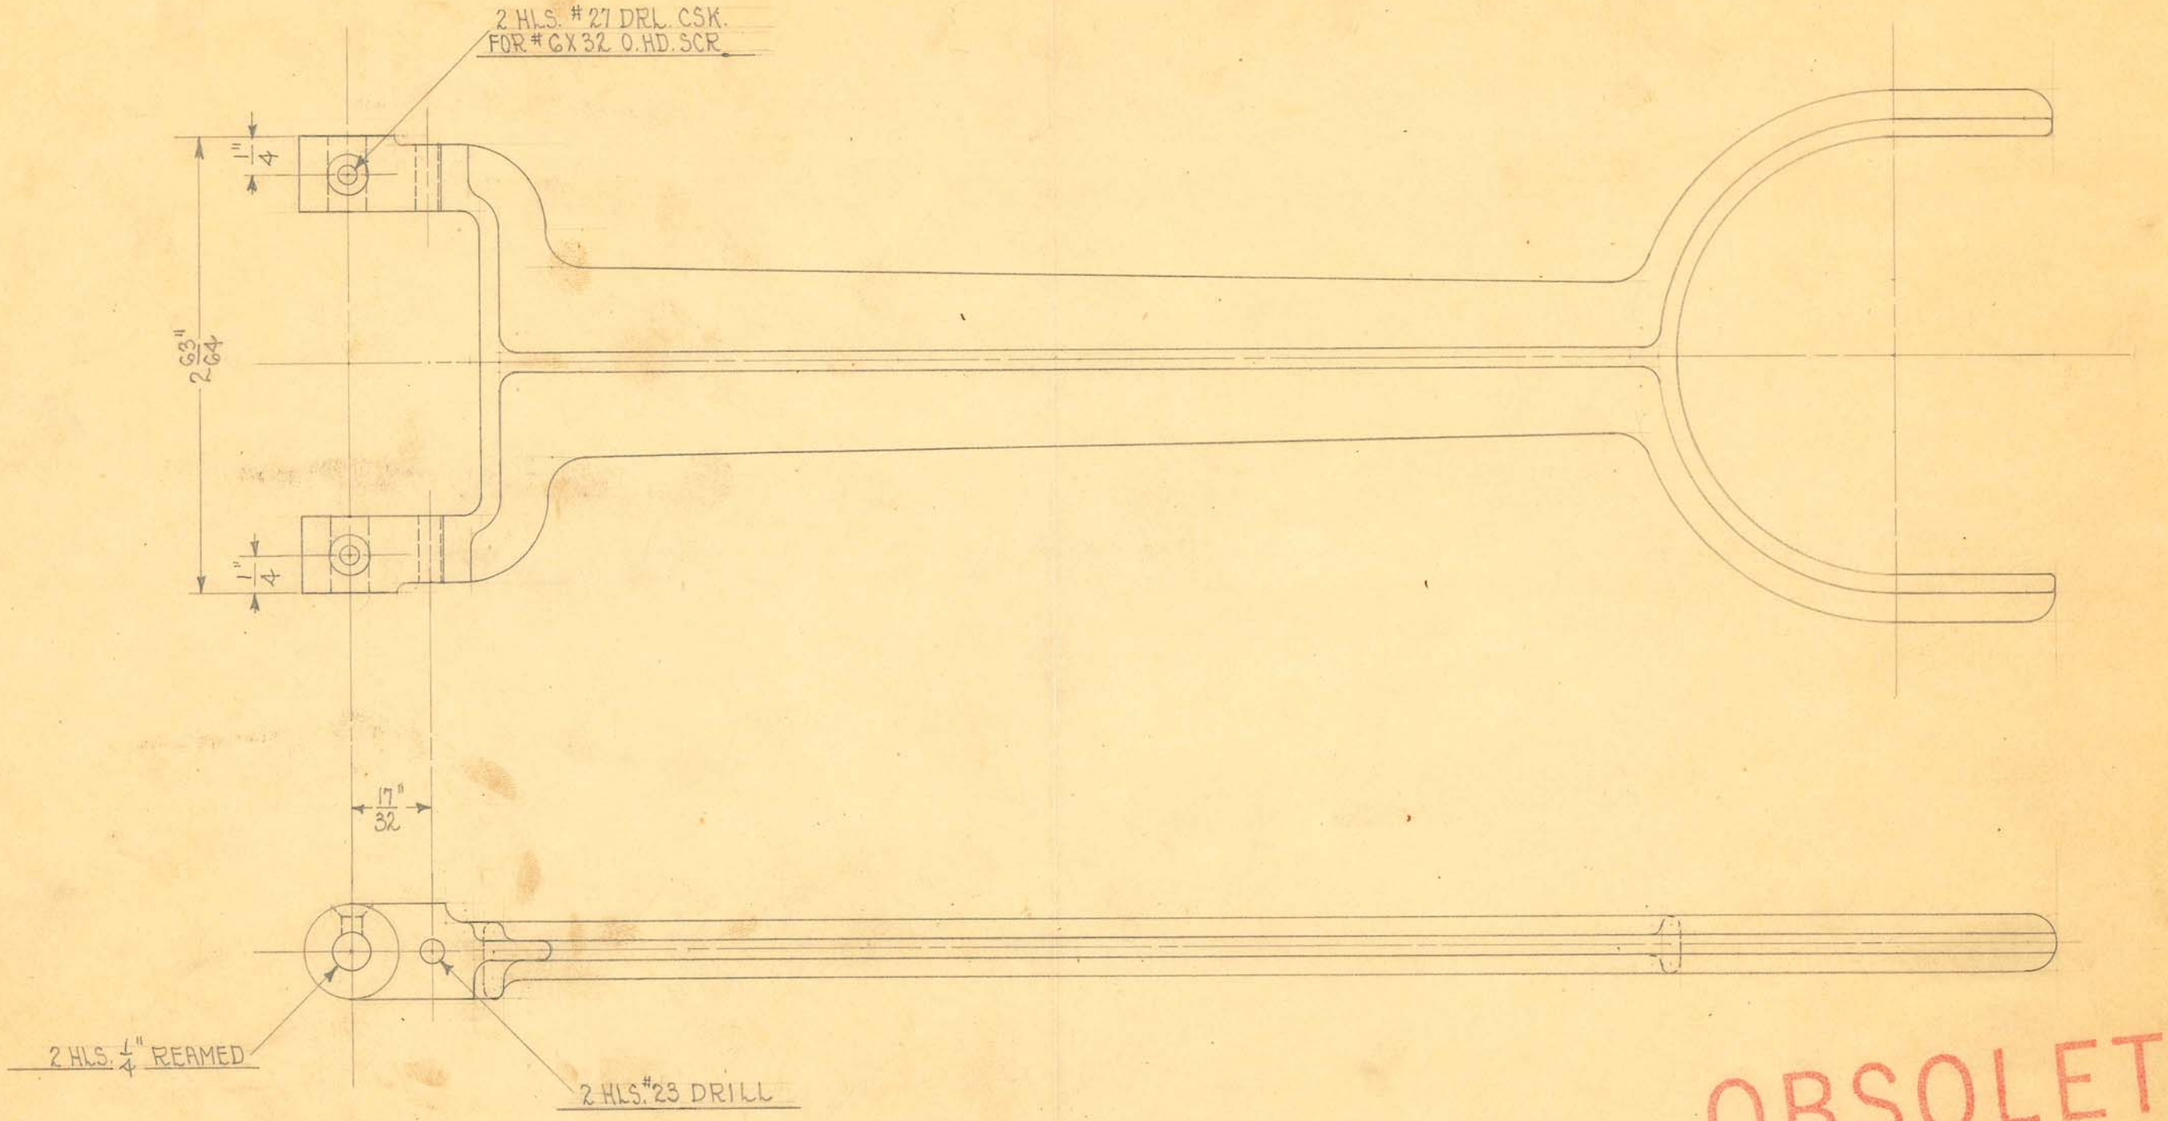

1 REQUIRED

OBSOLETE

SIZE		ISSUE 6-14-33	A.E.
KIND	ALUM. CASTING	CHANGED	
SHAPE		" "	
FINISH	POLISH	" "	
TEMP.		" "	
PATT.	3103-639	" "	

TITLE:
UNIVERSAL "60-88" TABLE
BUCKY OPERATING LEVER

H. G. FISCHER & CO.
2335 WABANSIA AVE.
CHICAGO, ILL.

CAT. NO.

PART NO. 8088F

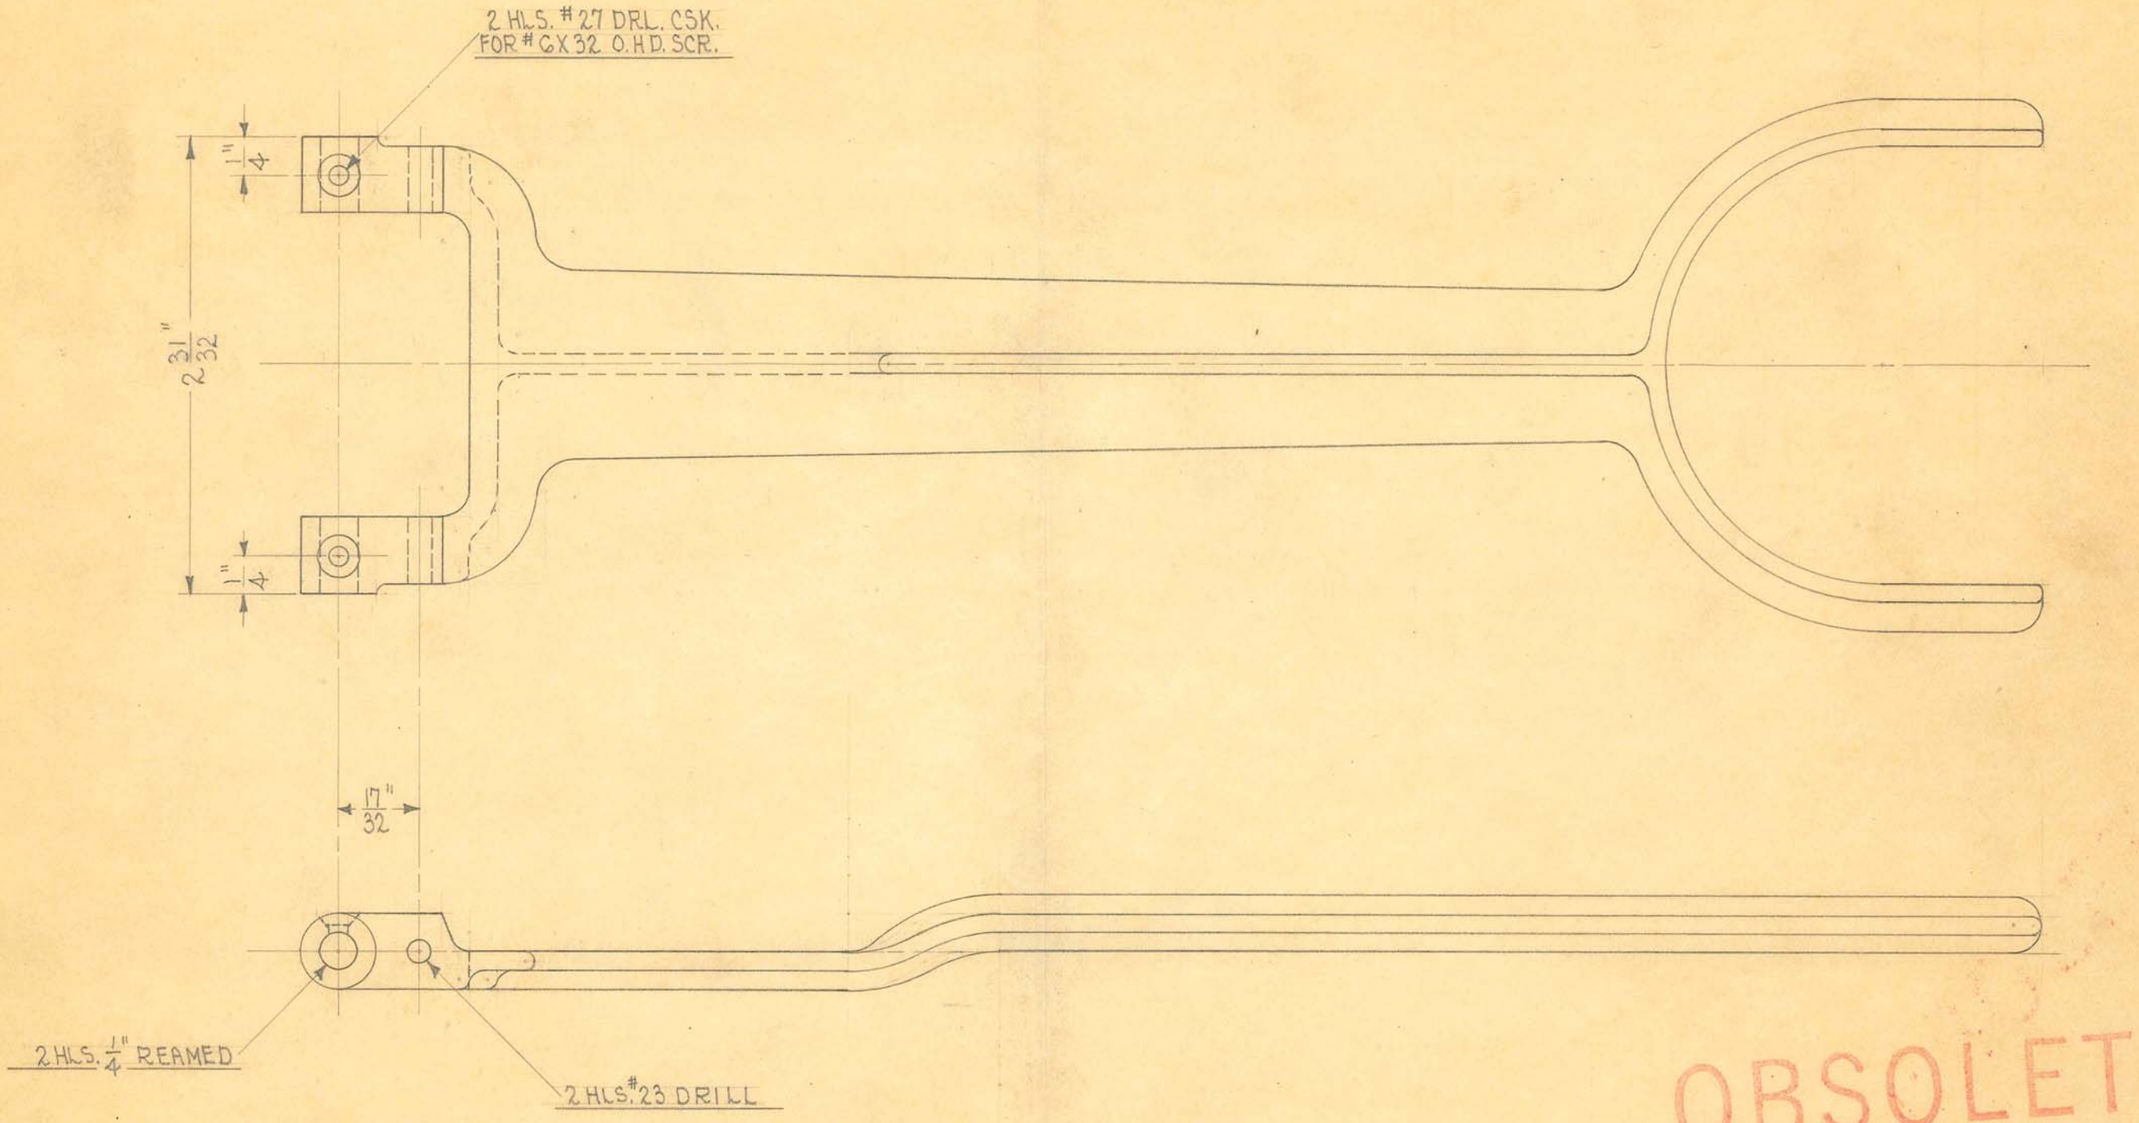

1 REQUIRED

OBSOLETE

SIZE		ISSUE 1-5-33	H.E.
KIND	ALUM. CASTING	CHANGED	
SHAPE		" "	
FINISH	BLK. LACQUER	" "	
TEMP.		" "	
PATT.	3103-C39	" "	

TITLE:
UNIVERSAL "GO-88" TABLE
BUCKY OPERATING LEVER

H. G. FISCHER & CO.
2335 WABANSIA AVE.
CHICAGO, ILL.

CAT. NO.

PART NO. 8088AF

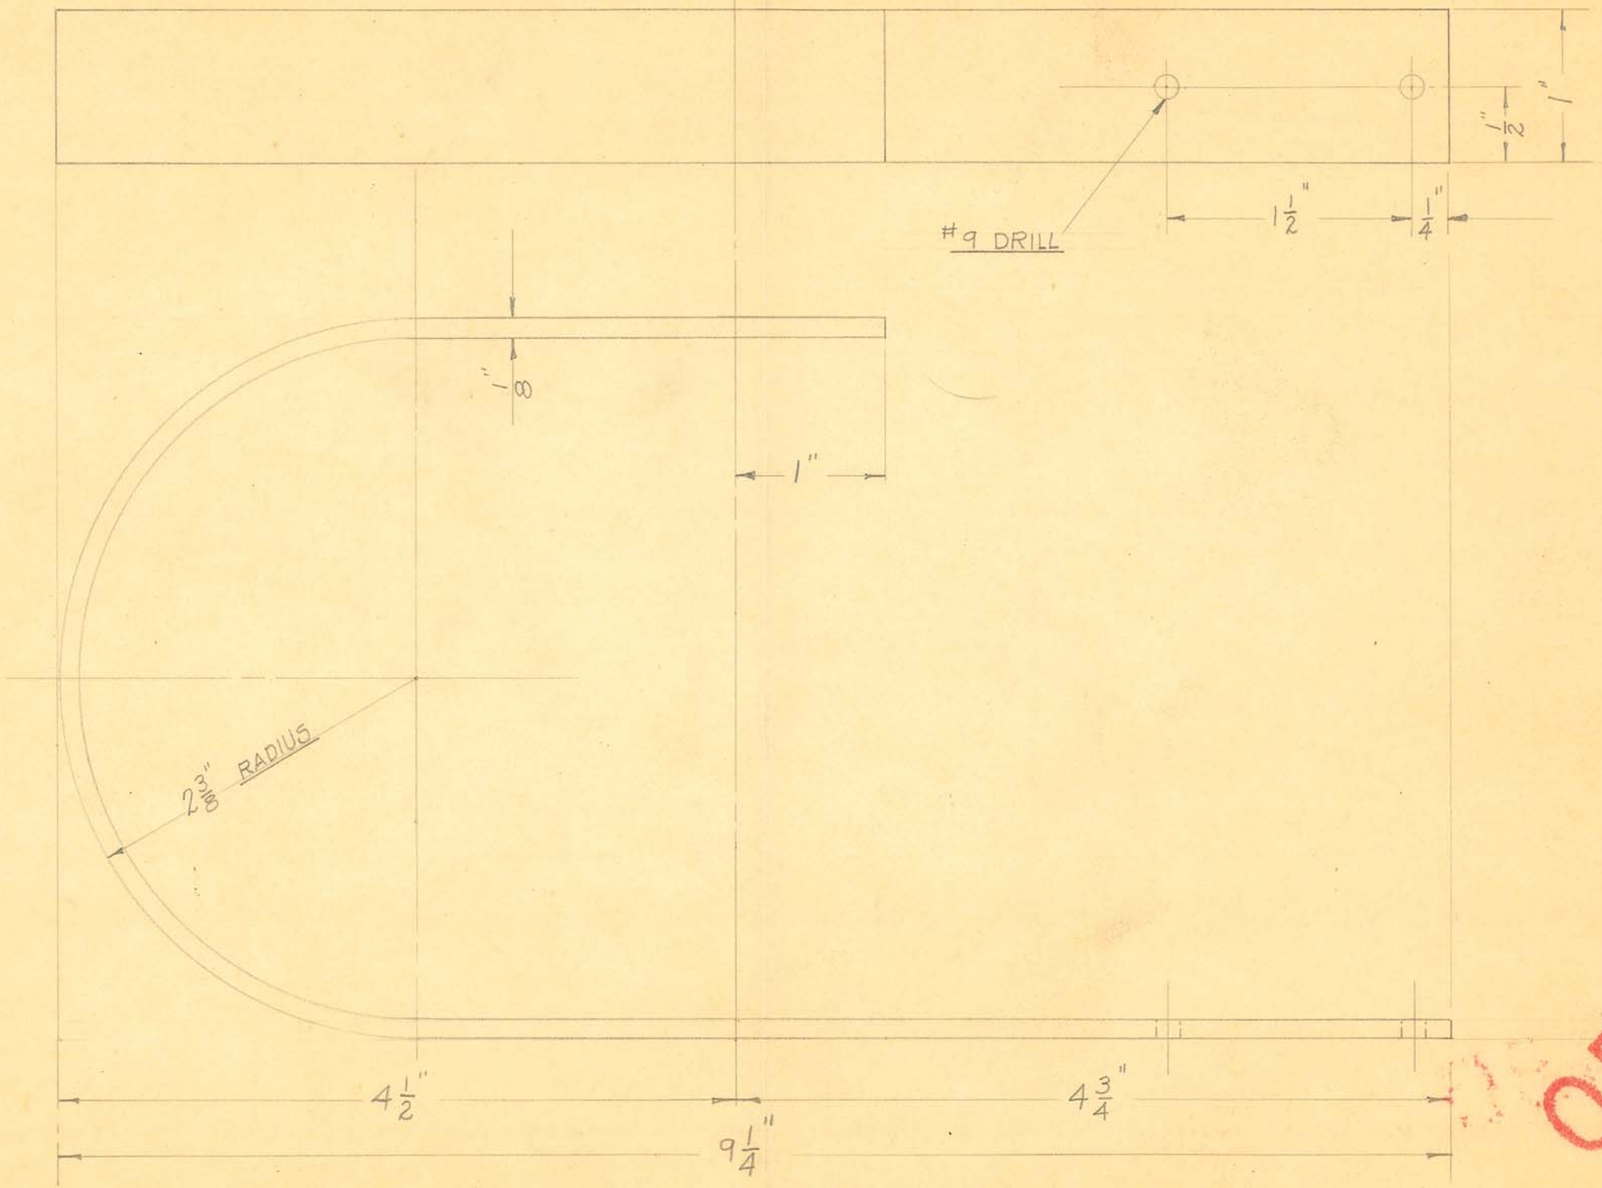

DEVELOPED LENGTH- 17 1/4"

SIZE	1/8 X 1" HOT ROLL	ISSUE	N.P.
KIND	SPRING STEEL	CHANGED	
SHAPE		" "	
FINISH	BLK. LACQUER	" "	
TEMP.		" "	
PATT.		" "	

TITLE: UNIVERSAL "60-88" TABLE BUCKY BUMPER

H. G. FISCHER & CO.
2335 WABANSIA AVE.
CHICAGO, ILL.

CAT. NO.

PART NO. 8095 F

OBSOLETE

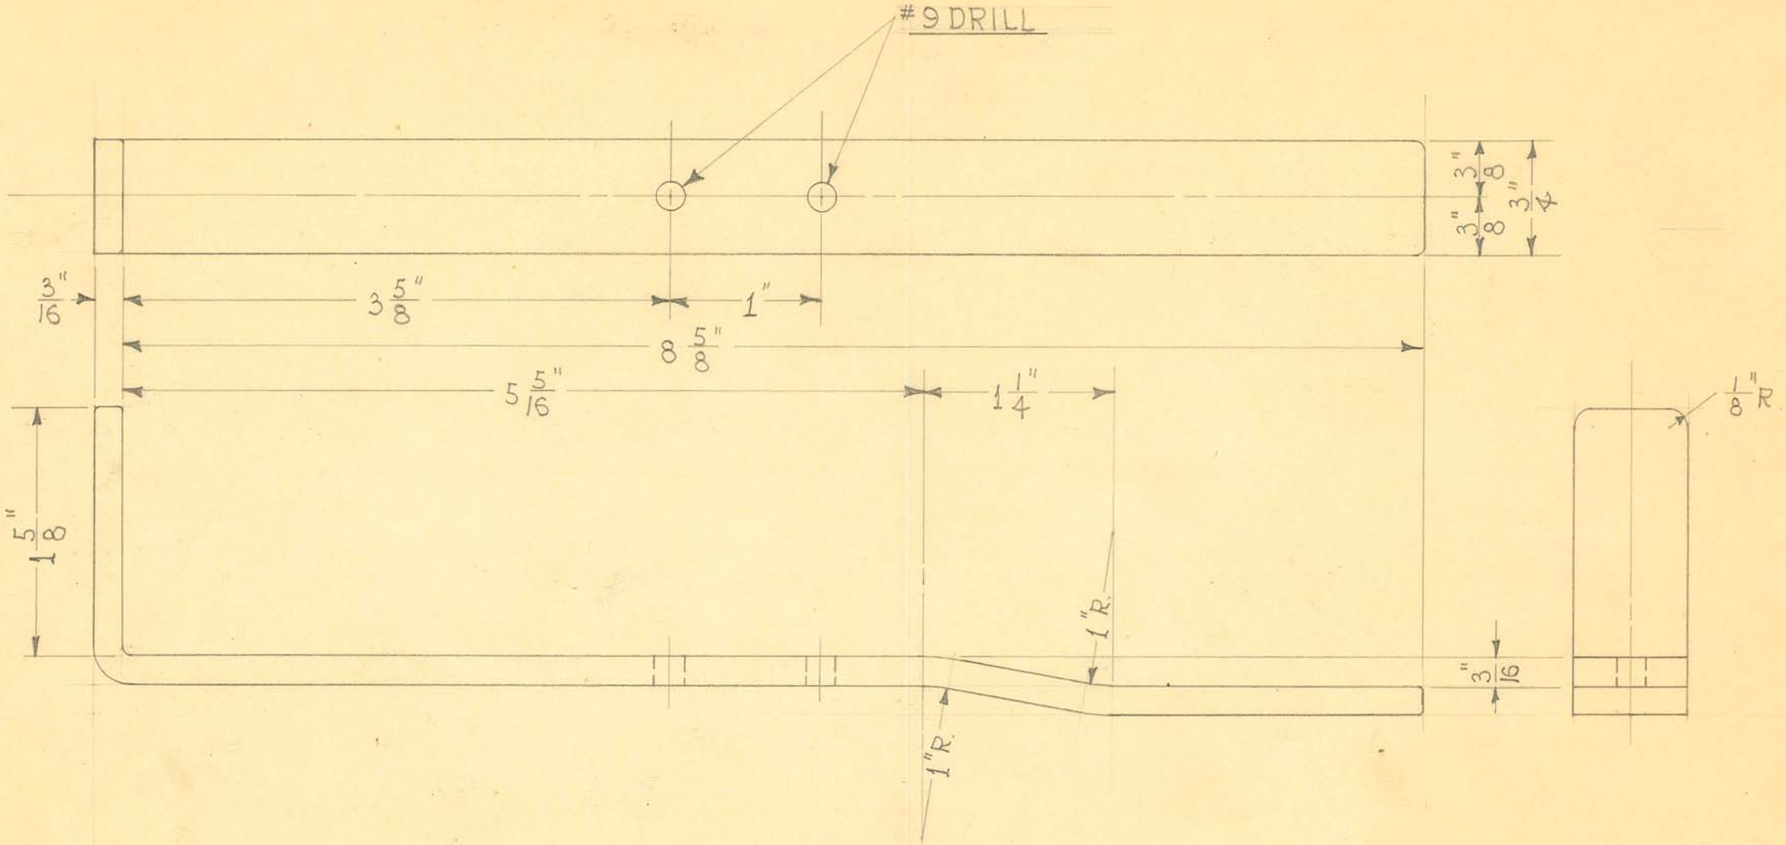

1 REQUIRED

DEVELOPED LENGTH - 10 13/32"

OBSOLETE

SIZE	3/4" X 3/16"	ISSUE 11-2-37	H.E.
KIND	C.R. STEEL	CHANGED	
SHAPE	STRIP	"	
FINISH	KRIST. #57	"	
TEMP.		"	
PATT.		"	

TITLE: UNIVERSAL "60-88" TABLE SYNCHROTIMED BUCKY STOP

H. G. FISCHER & CO.
2335 WABANSIA AVE.
CHICAGO, ILL.

CAT. NO.

PART NO. 8096 1/2

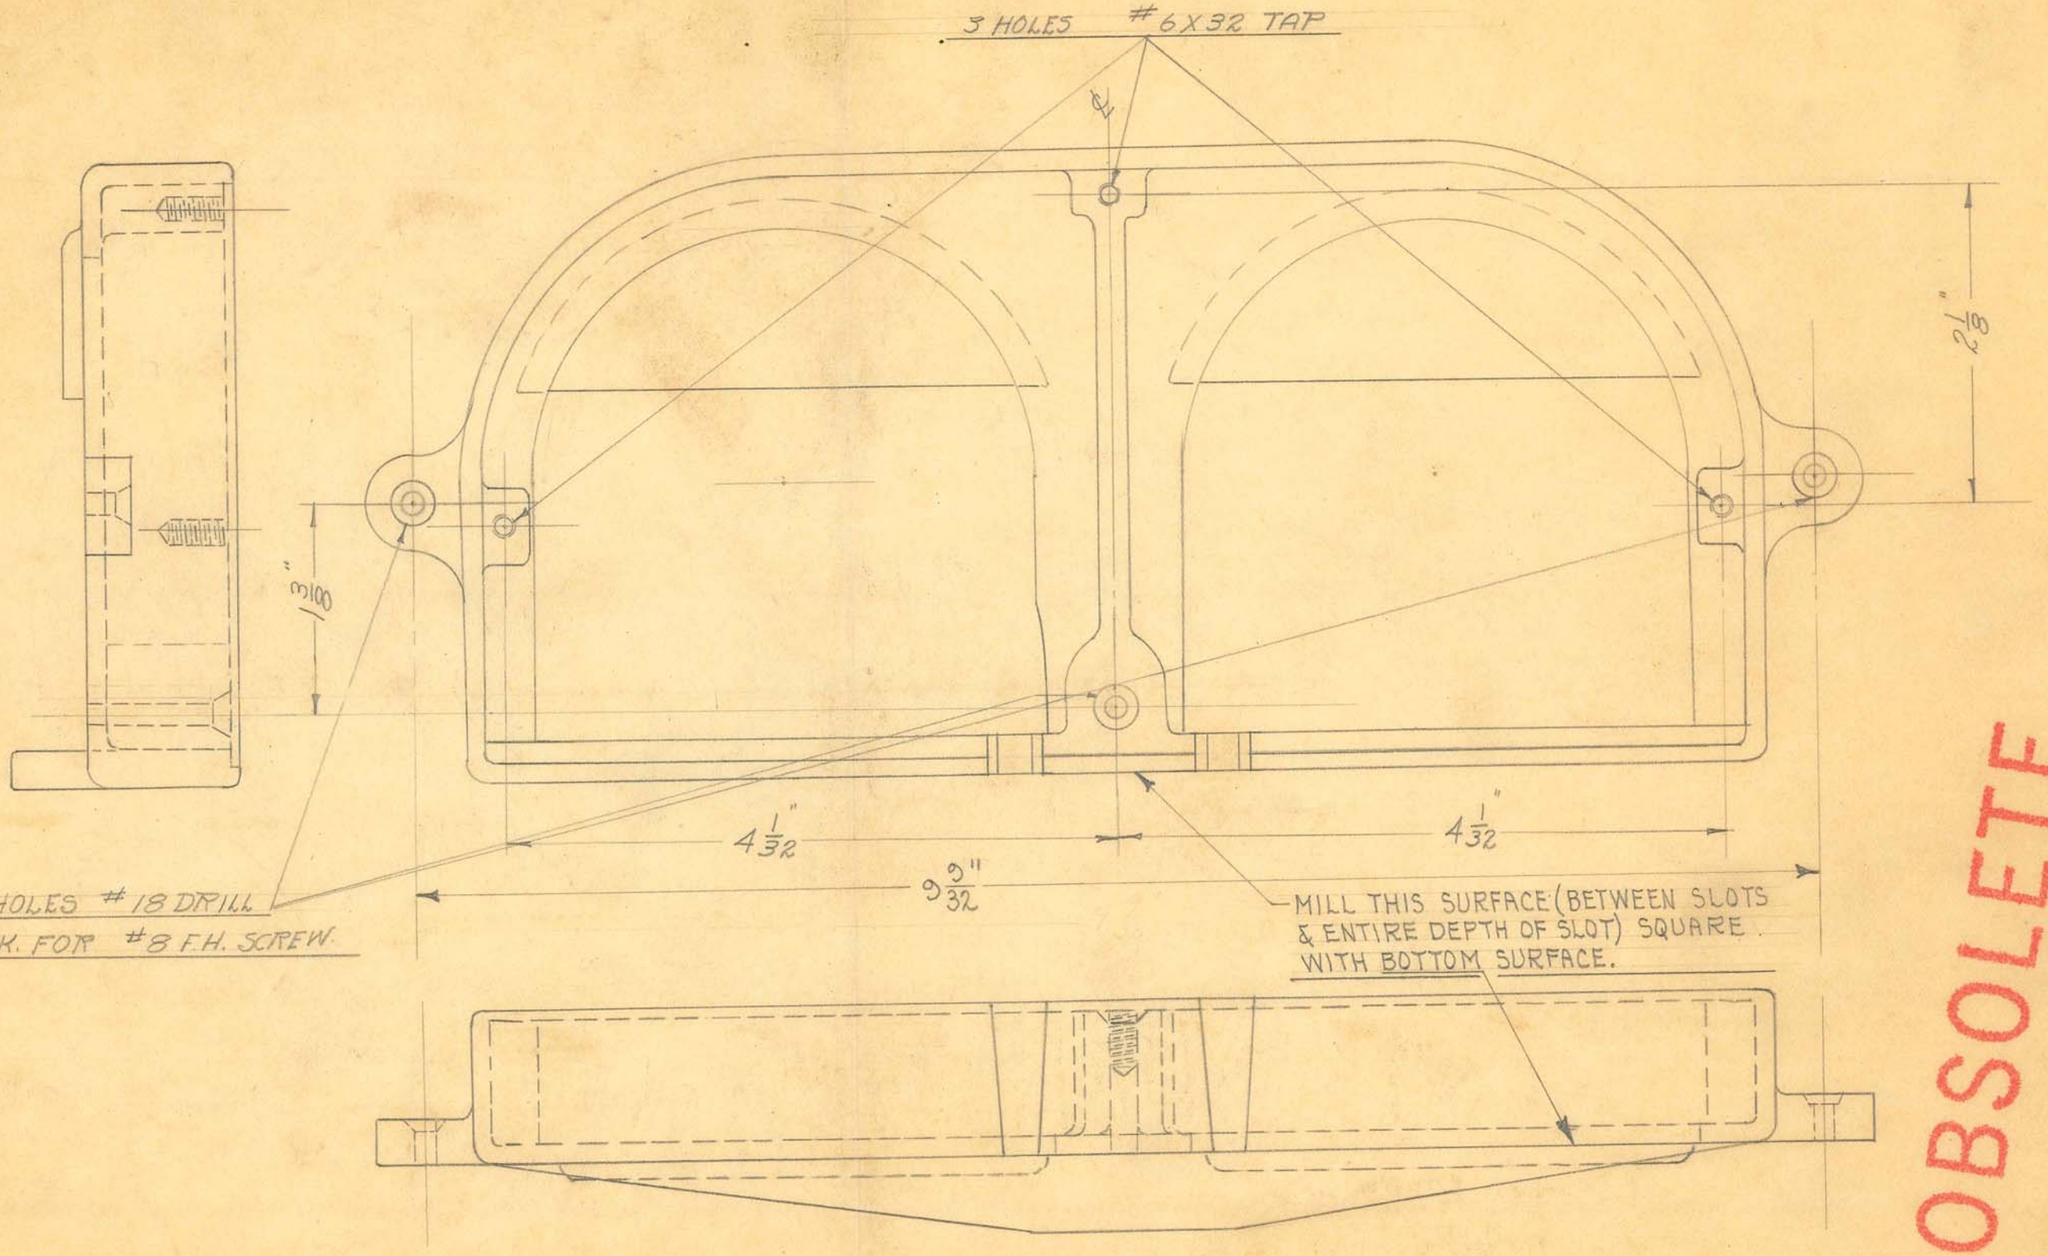

1 REQUIRED

OBSOLETE

SIZE		ISSUE 11-7-33	N.P.
KIND	ALUM. CAST.	CHANGED	
SHAPE		" "	
FINISH	BLK. LACQ.	" "	
TEMP.		" "	
PATT.	1743-590	" "	

TITLE:
UNIVERSAL "60-88" TABLE
BUCKY COUNTERBALANCE HOUSING

H. G. FISCHER & CO.
2335 WABANSIA AVE.
CHICAGO, ILL.

CAT. NO.

PART NO. 8097AF

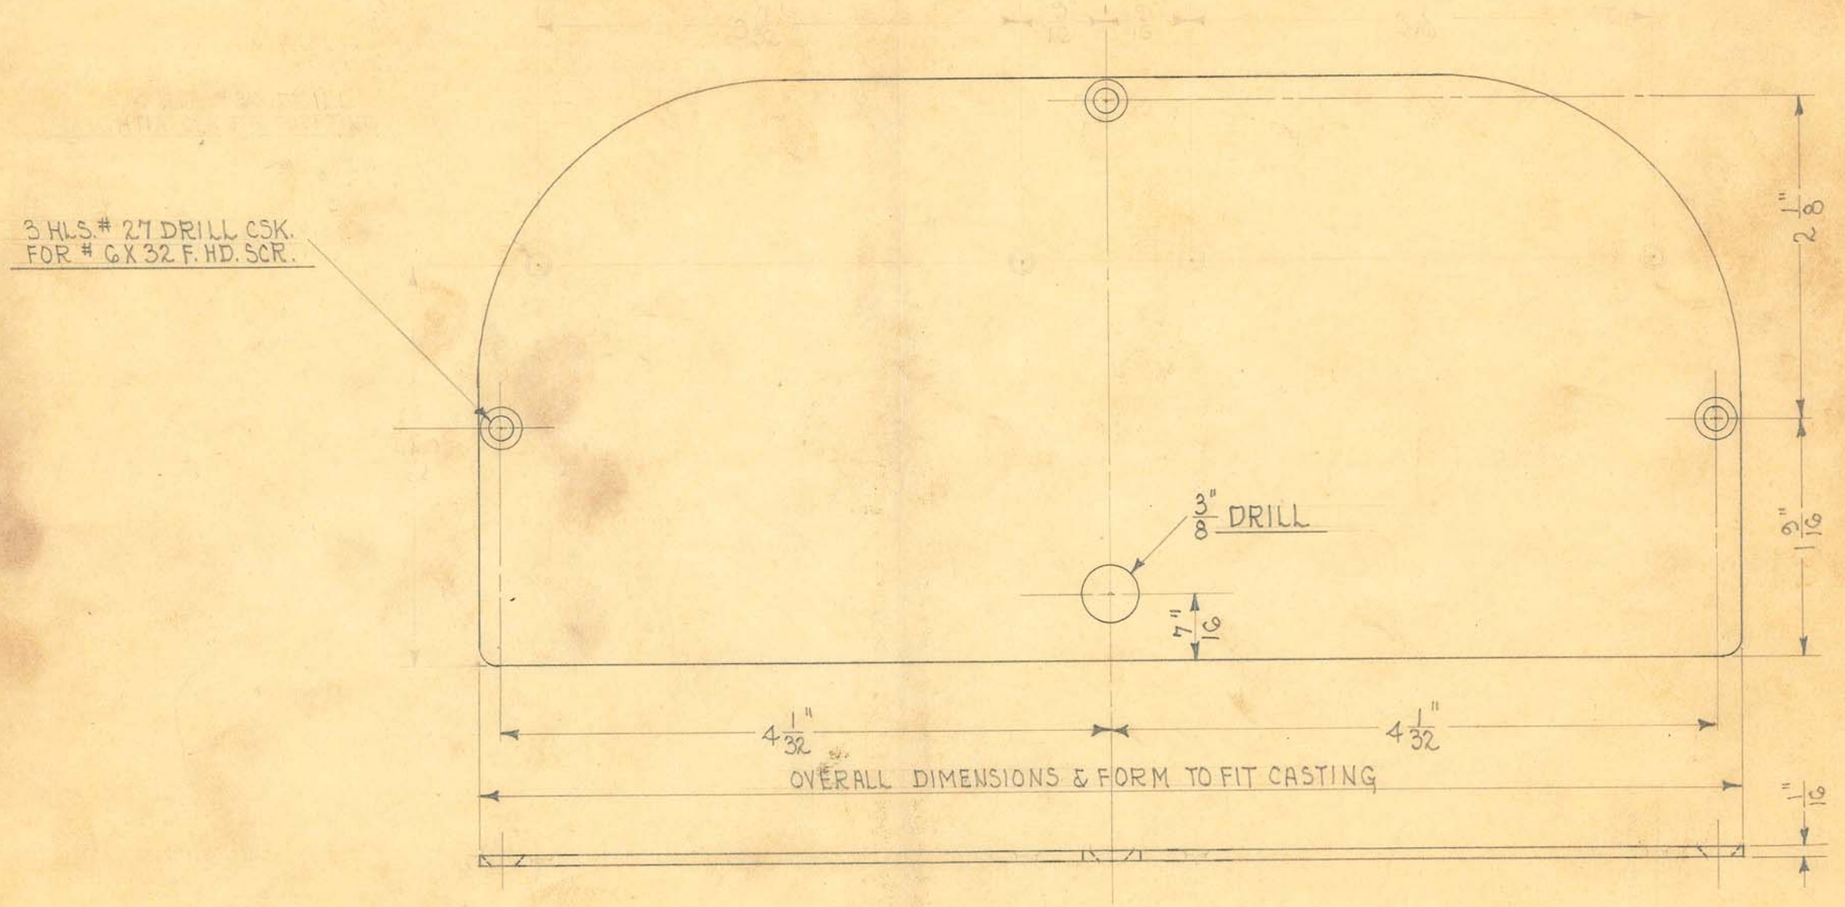

1 REQUIRED

OBSOLETE

SIZE	1/16" SHEET	ISSUE 10-23-33	A.E.
KIND	C.R. STEEL	CHANGED	
SHAPE		" "	
FINISH		" "	
TEMP.		" "	
PATT.		" "	

TITLE:
UNIVERSAL "60-88" TABLE
BUCKY COUNTERBALANCE HOUSING, COVER

H. G. FISCHER & CO.
2335 WABANSIA AVE.
CHICAGO, ILL.

CAT. NO.

PART NO. 8098

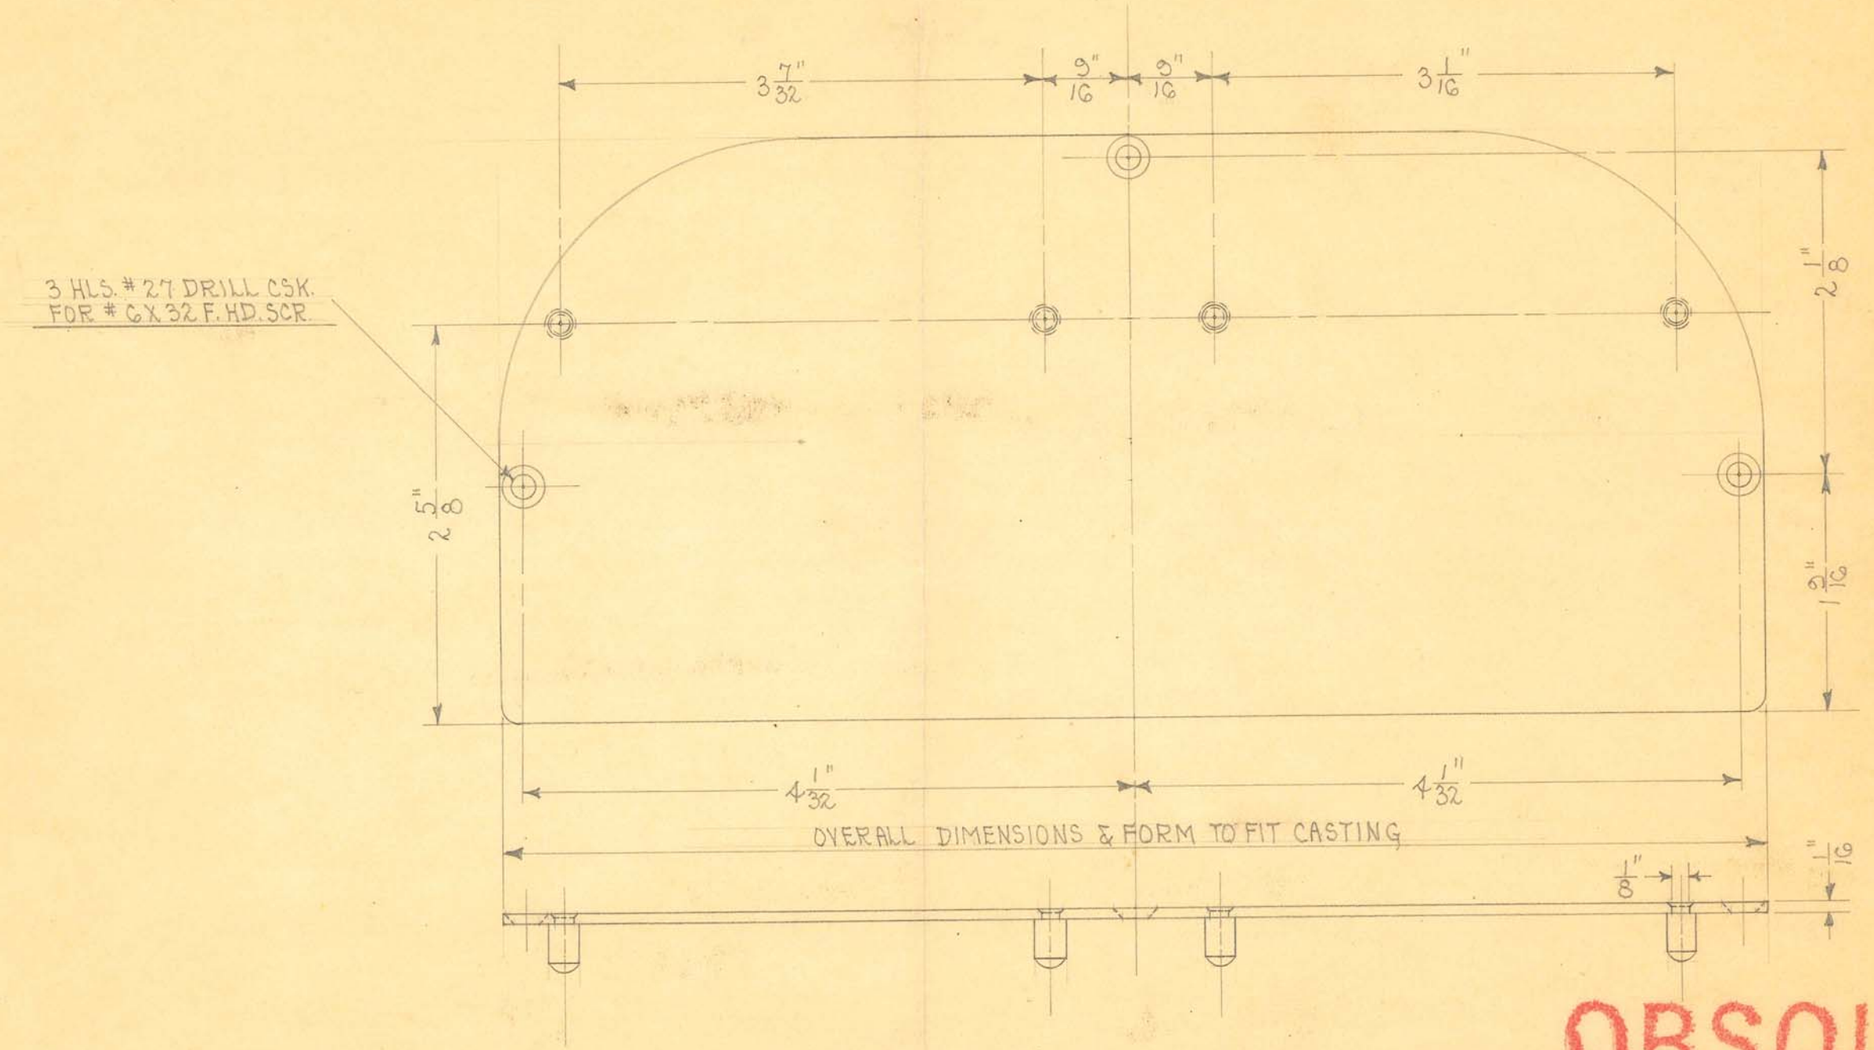

1 REQUIRED

OBSOLETE

SIZE		ISSUE 6-13-33	A.E.
KIND	C.R. STEEL	CHANGED	
SHAPE		" "	
FINISH	BLK. LACQUER	" "	
TEMP.		" "	
PATT.		" "	

TITLE:
UNIVERSAL "GO-88" TABLE
BUCKY COUNTERBALANCE HOUSING COVER ASSEM.

H. G. FISCHER & CO.
2335 WABANSIA AVE.
CHICAGO, ILL.

CAT. NO.

PART NO. 8099G

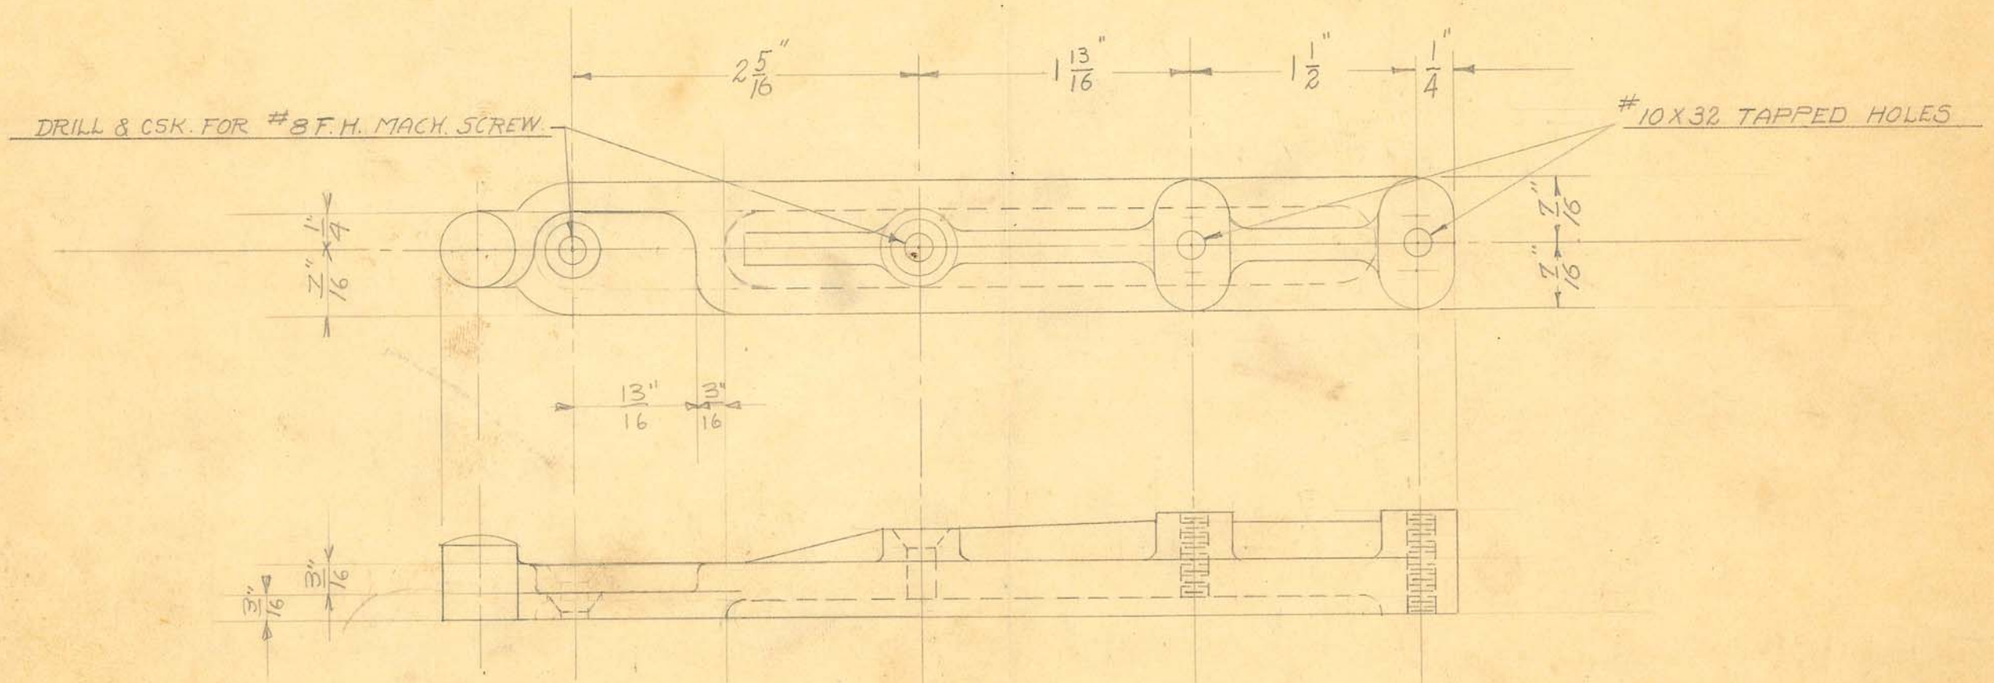

OBSOLETE

SIZE		ISSUE 9-6-33	N.P.
KIND	IRON CAST.	CHANGED	
SHAPE		" "	
FINISH	BLK. LACQ.	" "	
TEMP.		" "	
PATT.	#4930-658	" "	

TITLE: UNIVERSAL "60-88" TABLE SAFETY LOCKING DEVICE SUPPORT.

H. G. FISCHER & CO.
2335 WABANSIA AVE.
CHICAGO, ILL.

CAT. NO.

PART NO. 8111F

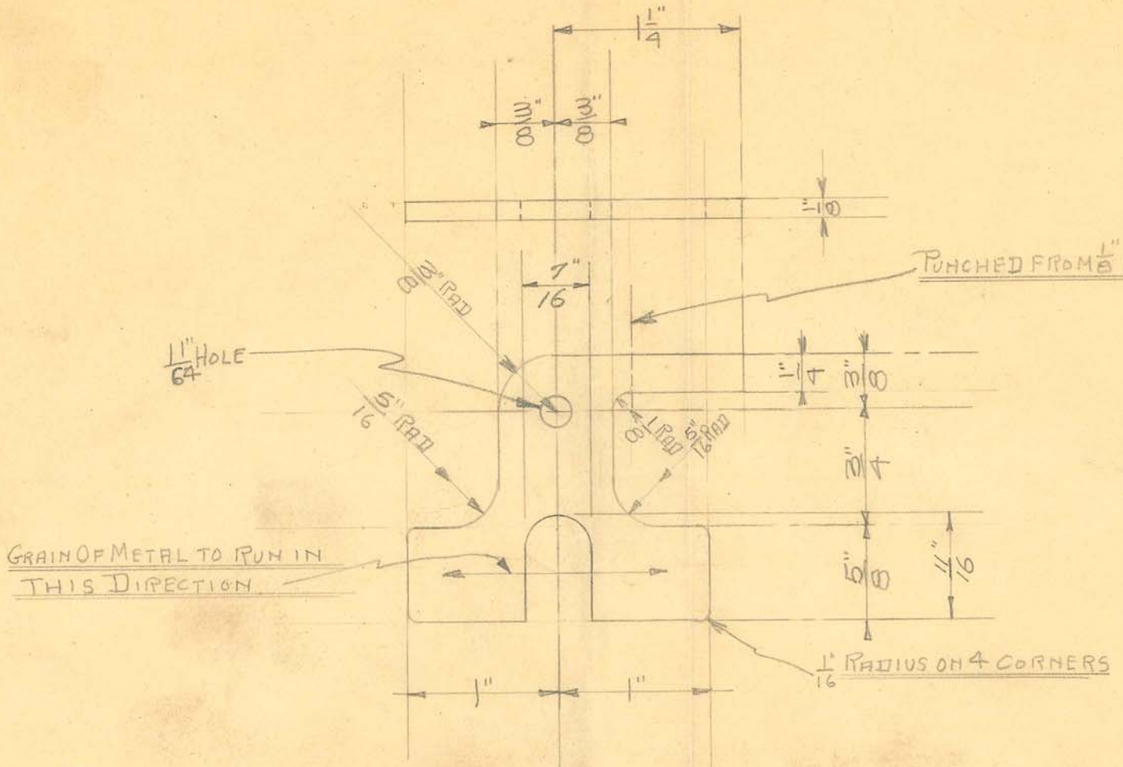

OBSOLETE

SIZE		ISSUE		TITLE: UNIVERSAL "GO-88" TABLE SAFETY LOCK SUPPORT BRACKET - BLANK
KIND		CHANGED		
SHAPE		" "		
FINISH		" "		
TEMP.		" "		
PATT.		" "		

H. G. FISCHER & CO.
2335 WABANSIA AVE.
CHICAGO, ILL.

CAT. NO.

PART NO. 8113

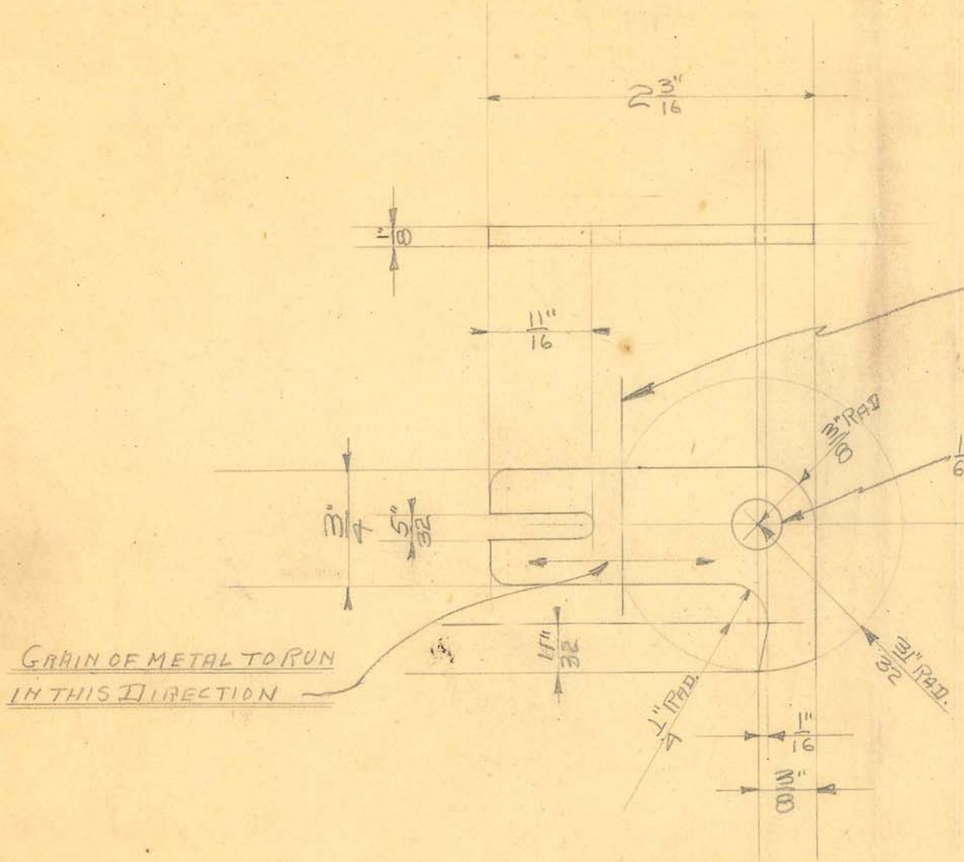

OBSOLETE

SIZE		ISSUE	
KIND		CHANGED	
SHAPE		" "	
FINISH		" "	
TEMP.		" "	
PATT.		" "	

TITLE: UNIVERSAL "GO-88" TABLE SAFETY LOCK DOG-BLANK

H. G. FISCHER & CO.
2335 WABANSIA AVE.
CHICAGO, ILL.

CAT. NO.

PART NO. 8114 1/2

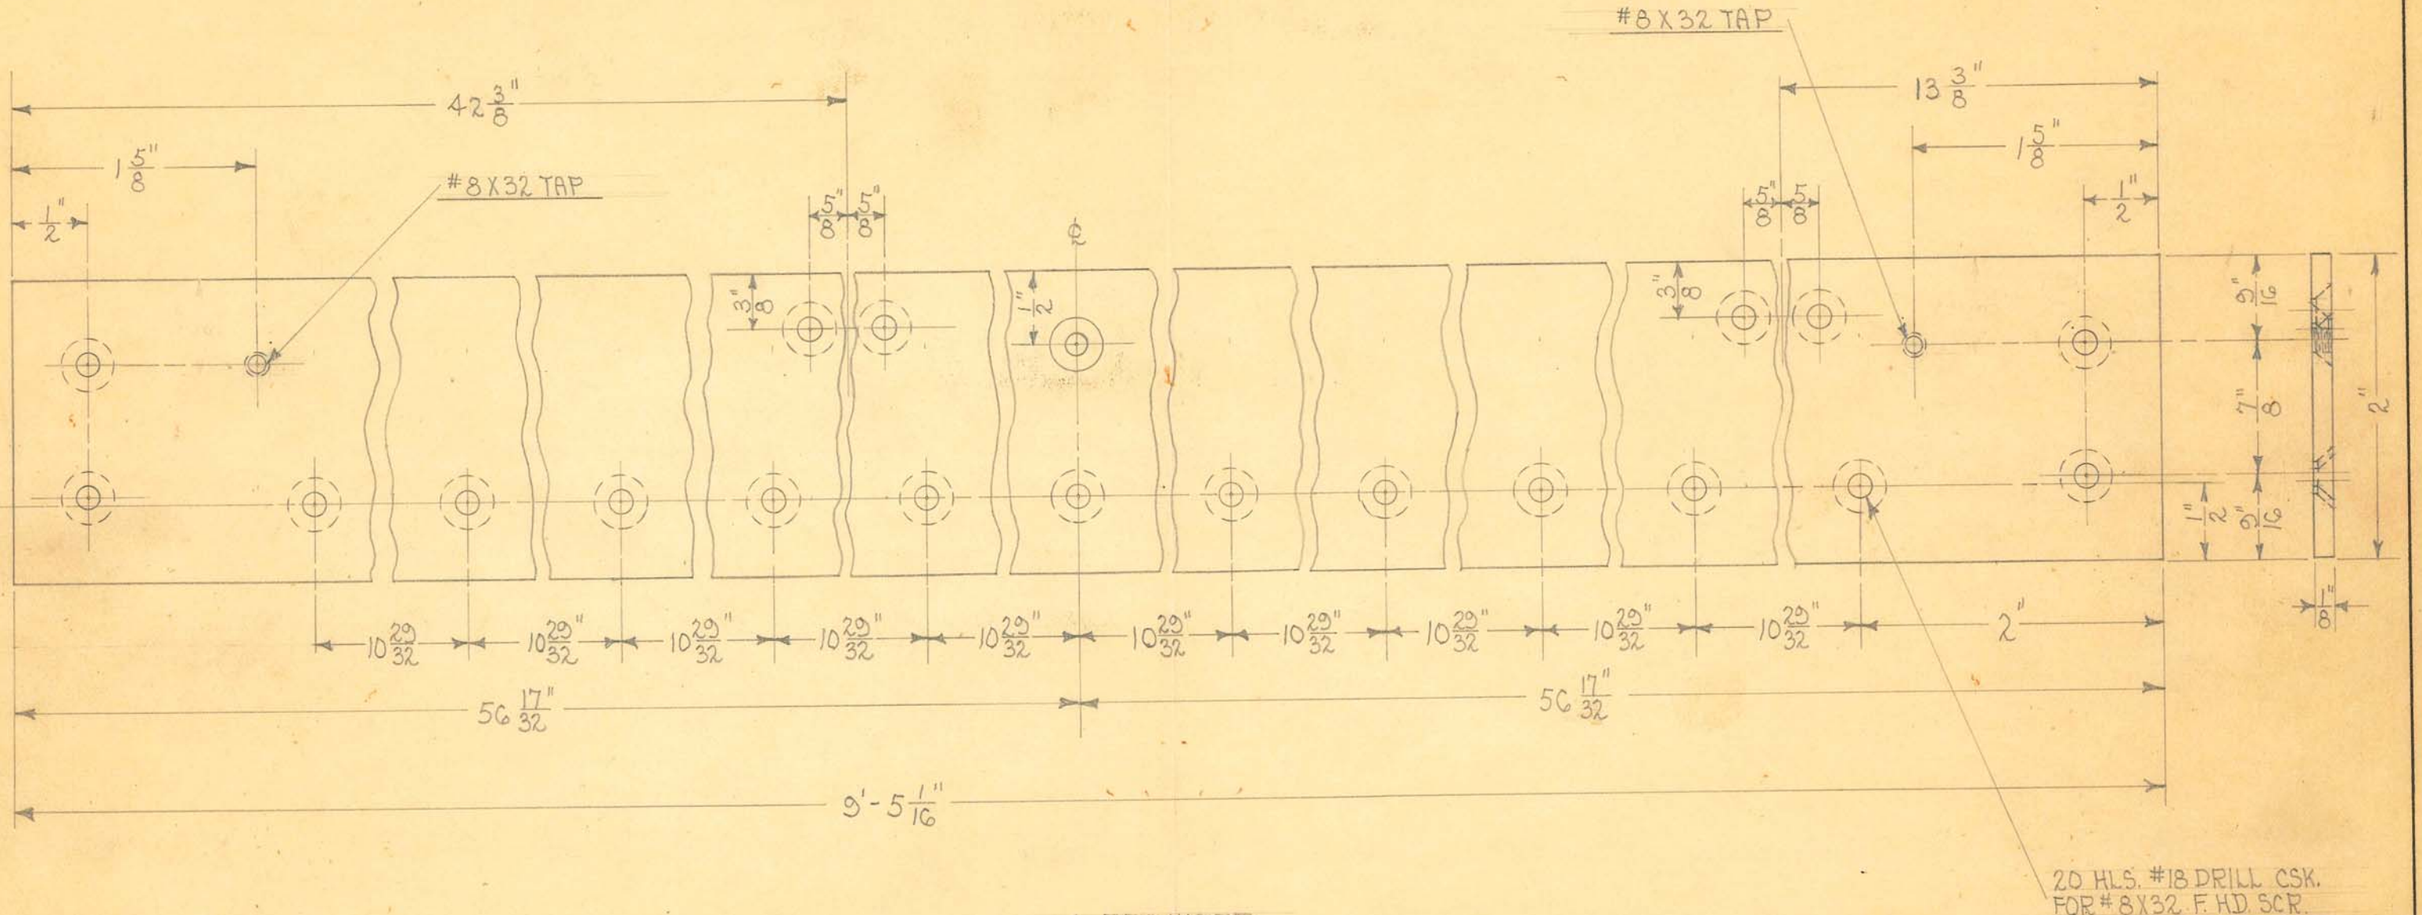

1 REQUIRED

OBSOLETE

SIZE		ISSUE 5-18-33	A.E.
KIND	C.R. STEEL	CHANGED 9-28-34	A.E.
SHAPE		42 3/8" WAS 46 7/8"	
FINISH	BLK. LACQUER	" "	
TEMP.		" "	
PATT.		" "	

TITLE: UNIVERSAL "60-88" TABLE RAIL PLATE

H. G. FISCHER & CO.
2335 WABANSIA AVE.
CHICAGO, ILL.

CAT. NO.

PART NO. 8116A

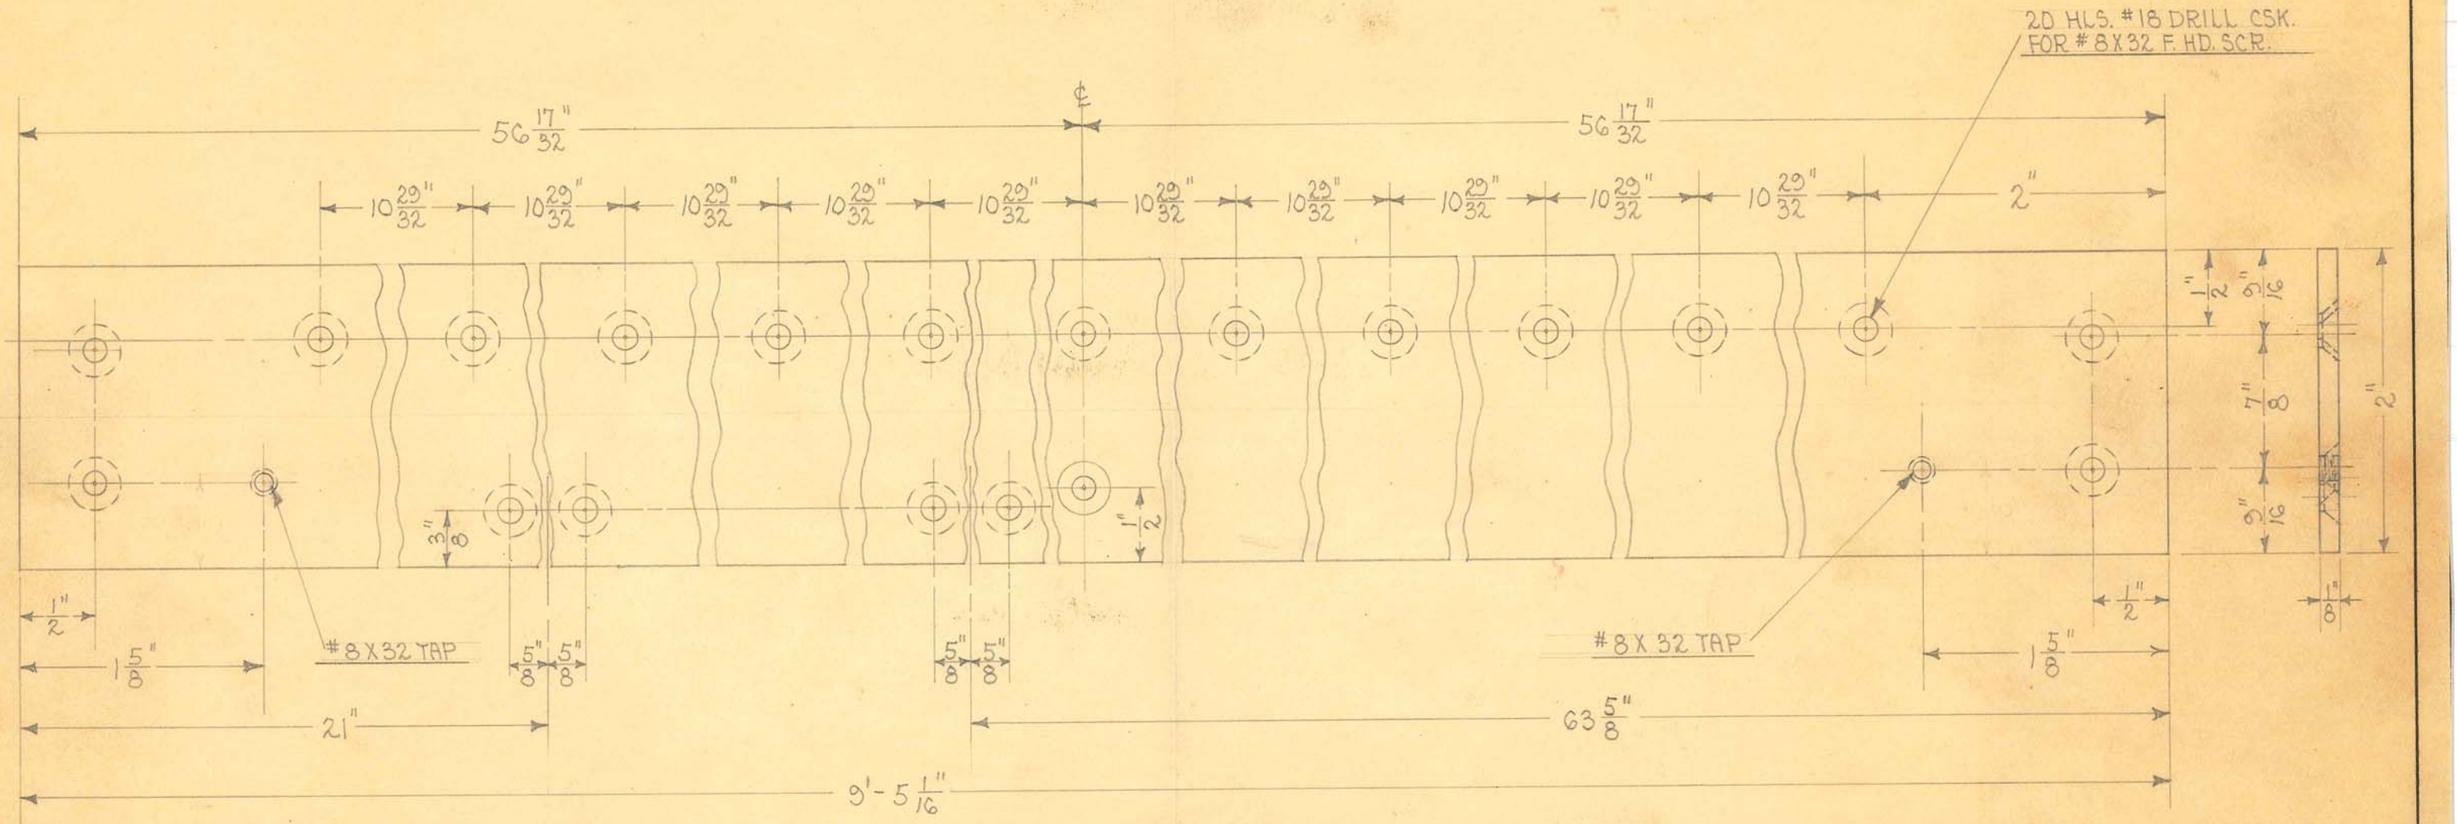

1 REQUIRED

OBSOLETE

SIZE		ISSUE 5-18-33	A.E.
KIND	C.R. STEEL	CHANGED 9-28-34	A.E.
SHAPE		63 5/8" WAS 59 1/8"	
FINISH	BLK. LACQUER	" "	
TEMP.		" "	
PATT.		" "	

TITLE: UNIVERSAL "60-88" TUBE STAND RAIL PLATE

H. G. FISCHER & CO.
2335 WABANSIA AVE.
CHICAGO, ILL.

CAT. NO.

PART NO. 8117A

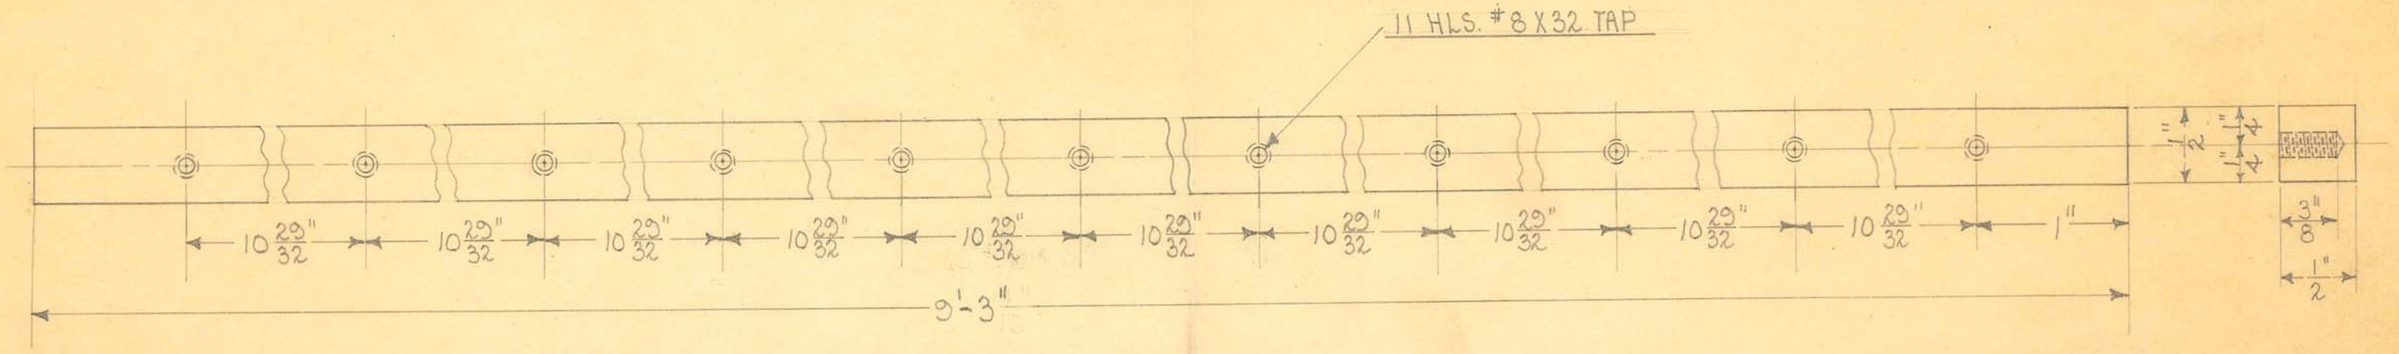

2 REQUIRED

OBSOLETE

SIZE	1/2" SQ.	ISSUE 5-18-33	A.E.	TITLE: UNIVERSAL "GO-88" TABLE & TUBE STAND RAIL
KIND	C.R. STEEL	CHANGED		
SHAPE		" "		
FINISH	CAD. PLATE	" "		
TEMP.		" "		
PATT.		" "		

H. G. FISCHER & CO.
2335 WABANSIA AVE.
CHICAGO, ILL.

CAT. NO.

PART NO. 8118

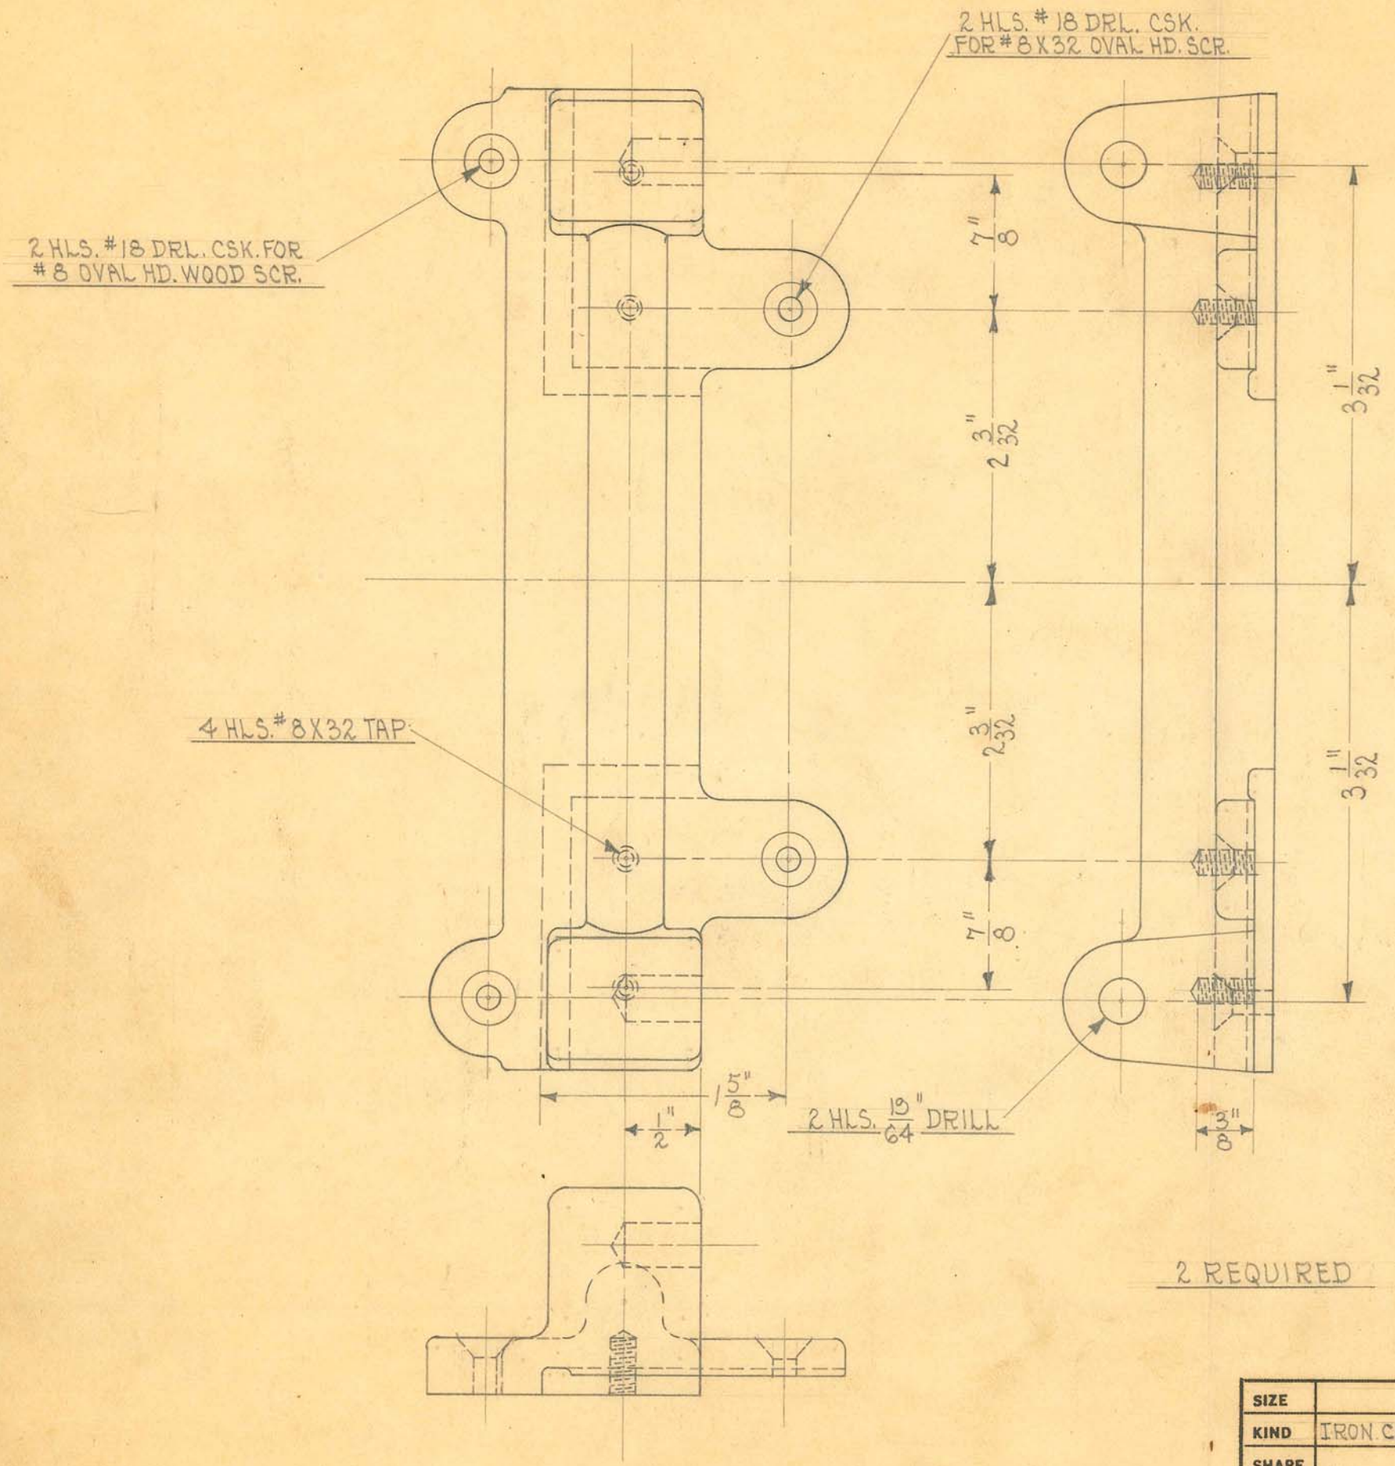

2 REQUIRED

OBSOLETE

SIZE		ISSUE 4-24-33	A.E.	TITLE: UNIVERSAL "GO-88" TUBE STAND RAIL BUMPER
KIND	IRON CASTING	CHANGED		
SHAPE		" "		
FINISH		" "		
TEMP.		" "		H. G. FISCHER & CO. 2335 WABANSIA AVE. CHICAGO, ILL. — CAT. NO. — PART NO. 8119 AF
PATT.	2160-613	" "		

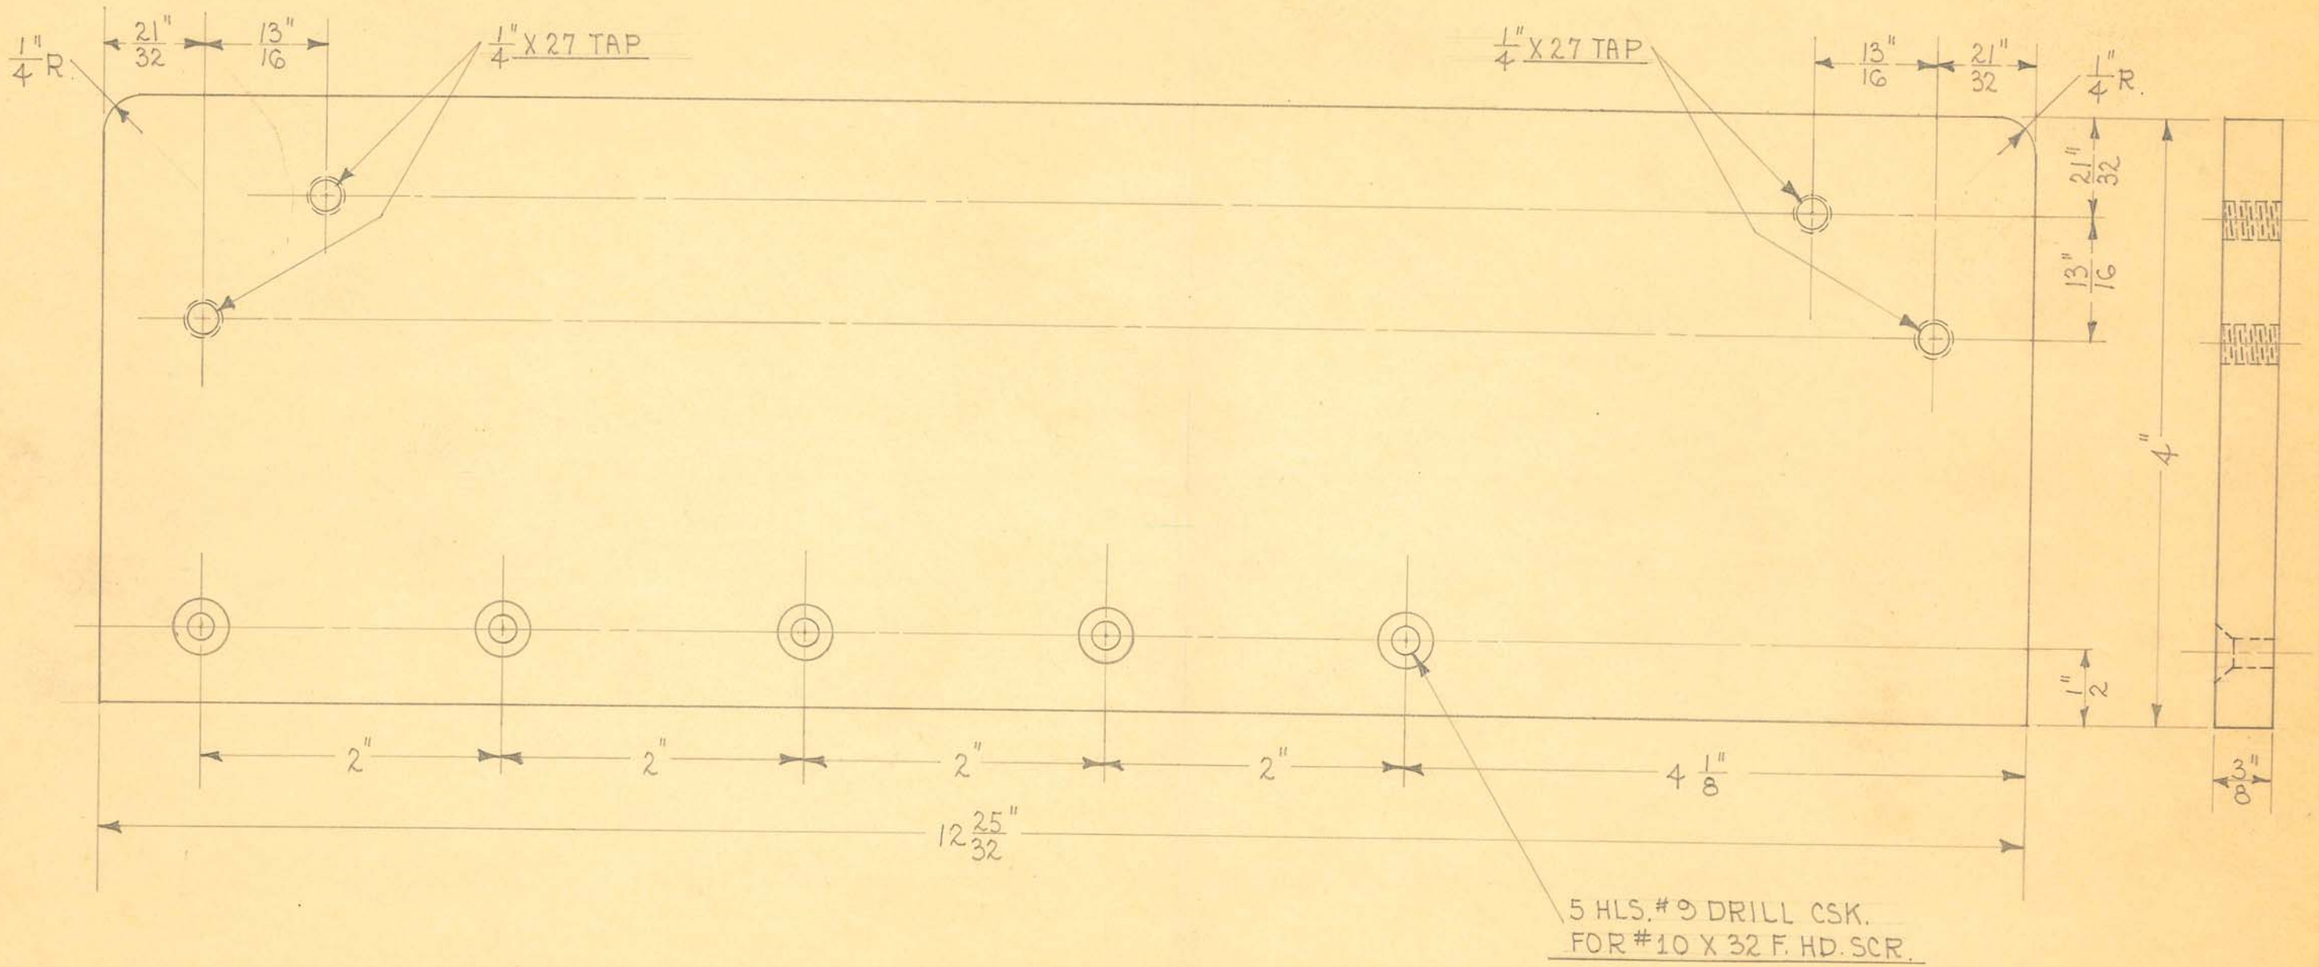

1 REQUIRED

OBSOLETE

SIZE	4" X 3/8"	ISSUE 10-27-36	J.E.
KIND	STRIP C.R. STEEL	CHANGED	
SHAPE		"	
FINISH		"	
TEMP.		"	
PATT.		"	

TITLE:
25 CYCLE "60-88" TUBE STAND BASE
TRANSFORMER SUPPORT STRIP - RIGHT

H. G. FISCHER & CO.
2335 WABANSIA AVE.
CHICAGO, ILL.

CAT. NO.

PART NO. 8128 1/2

8618

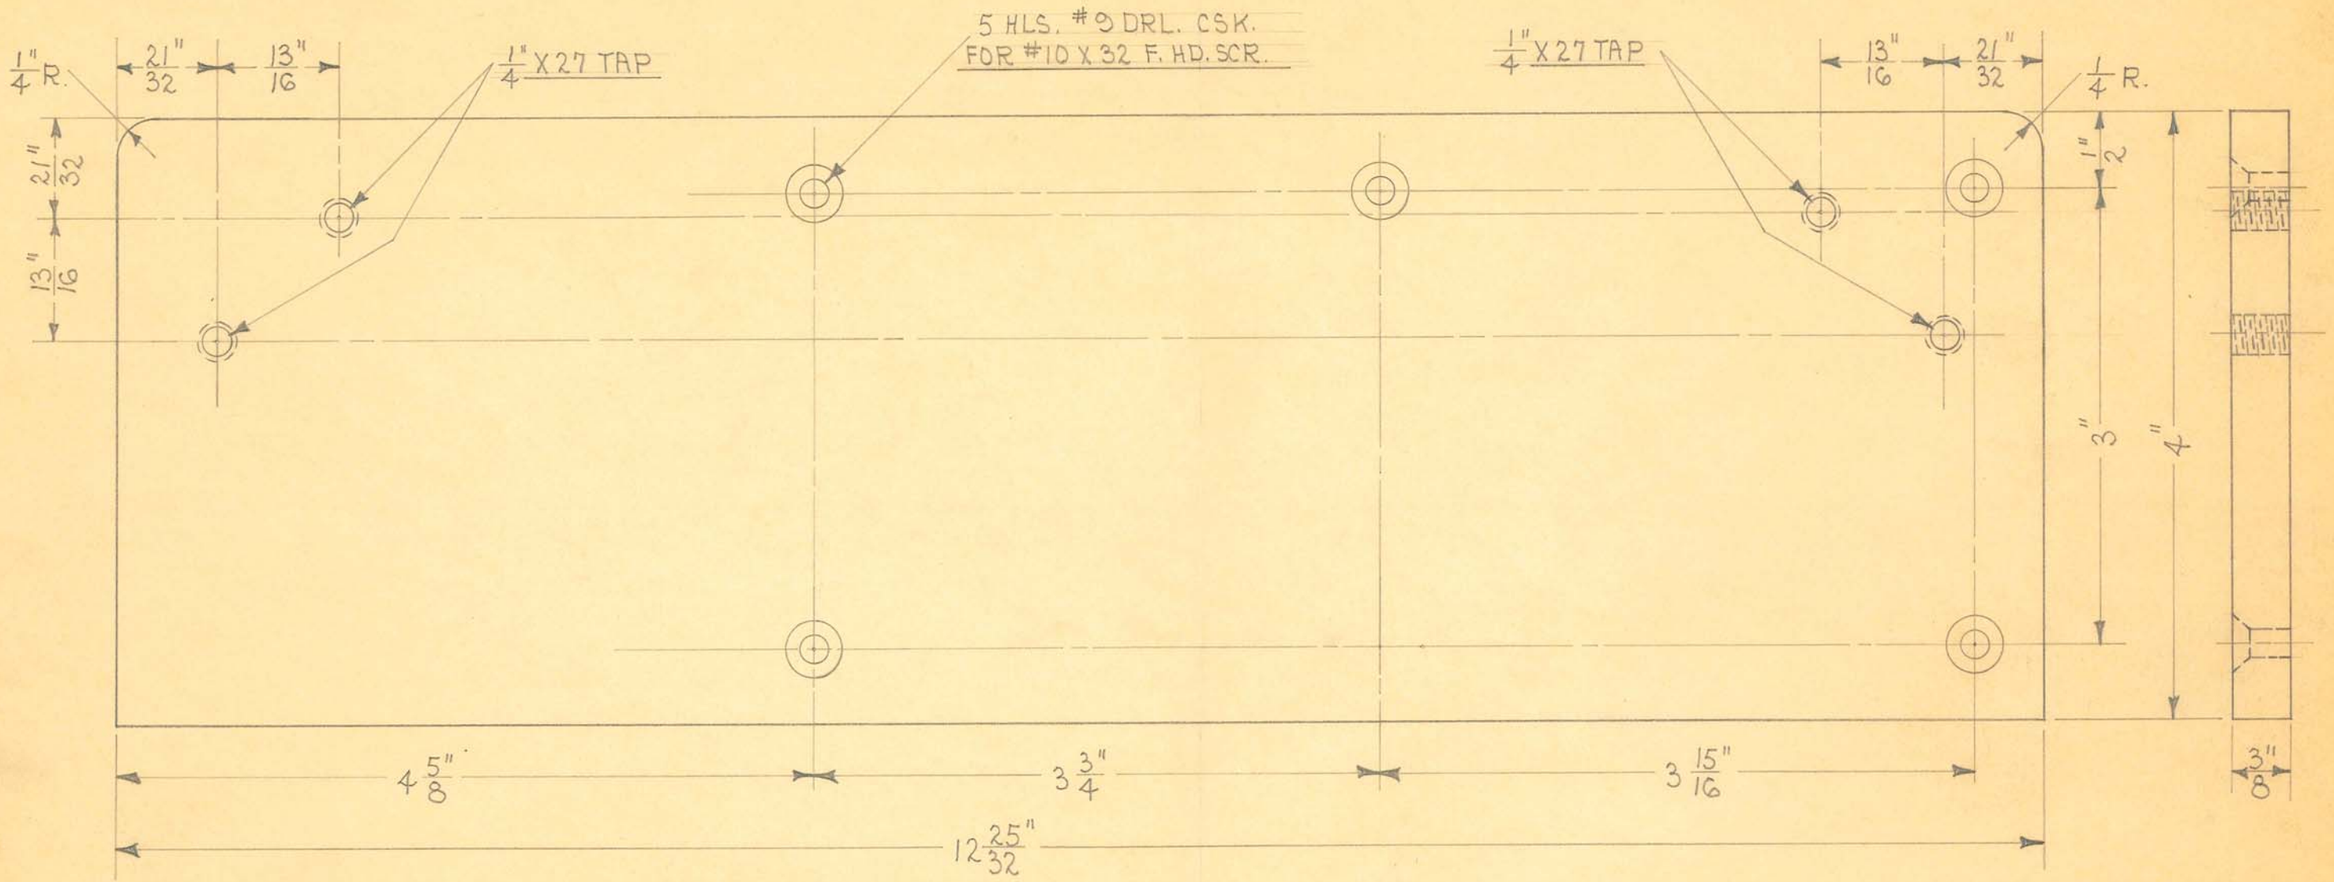

1 REQUIRED

OBSOLETE

SIZE	3/8" X 4"	ISSUE 10-28-36	H.E.
KIND	STRIP C.R. STEEL	CHANGED	
SHAPE		"	
FINISH		"	
TEMP.		"	
PATT.		"	

TITLE:
25 CYCLE "60-88" TUBE STAND BASE
TRANSFORMER SUPPORT STRIP - LEFT

H. G. FISCHER & CO.
2335 WABANSIA AVE.
CHICAGO, ILL.

CAT. NO.

PART NO. 8128 3/4

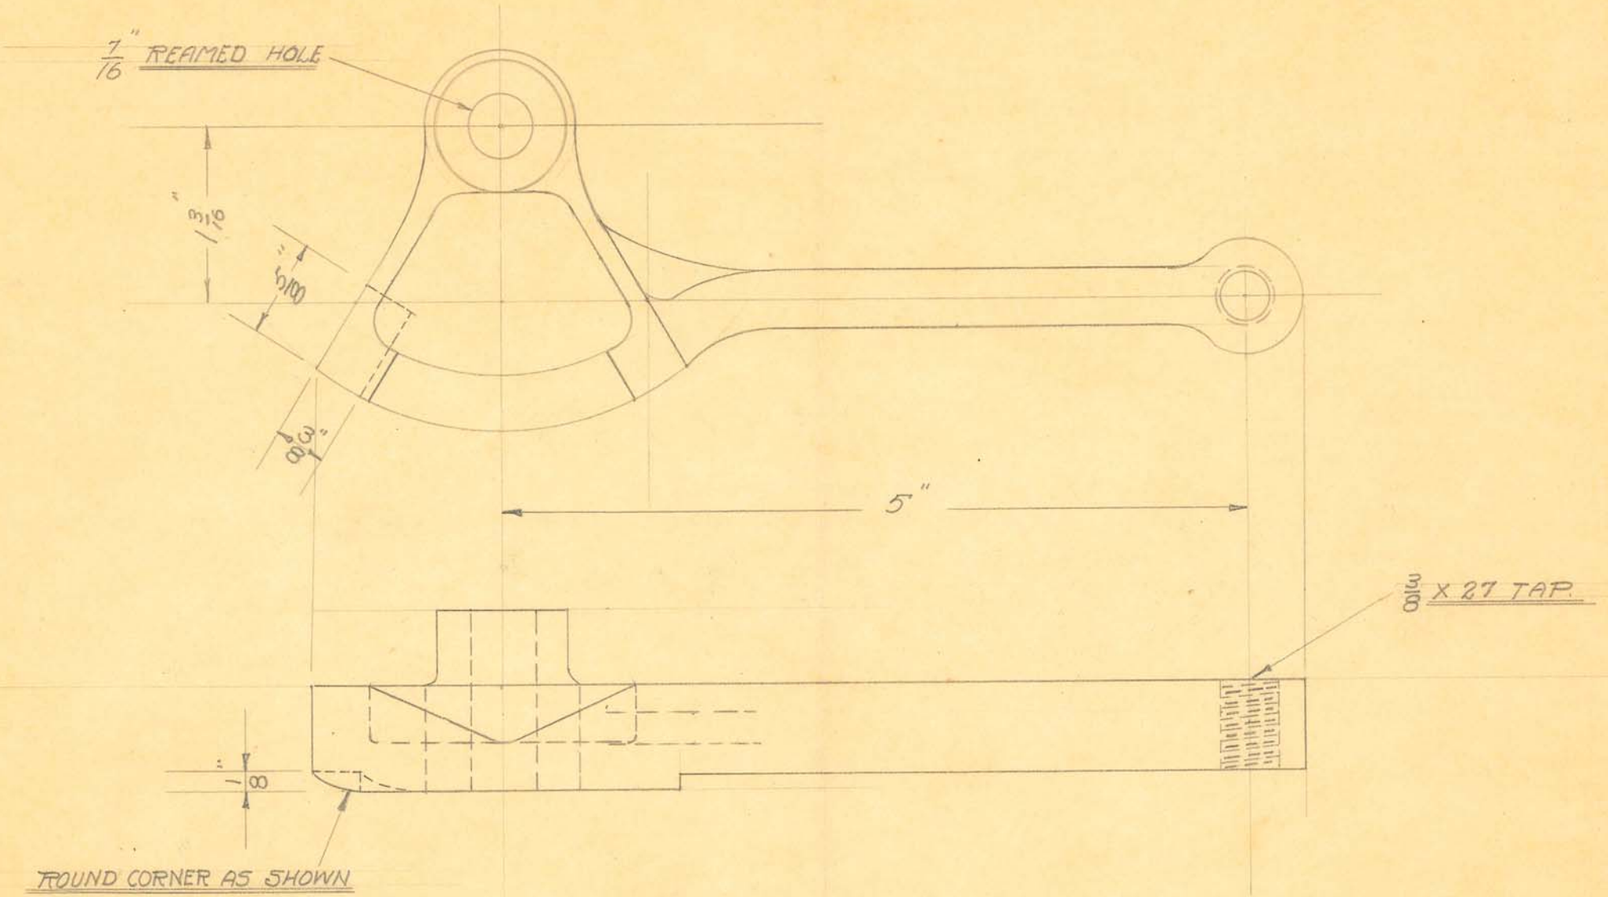

ONE REQUIRED

OBSOLETE

SIZE		ISSUE 10-24-33	N.P.	TITLE: UNIVERSAL "60-88" TUBE STAND LOCK LEVER
KIND		CHANGED		
SHAPE		" "		
FINISH	CHR. POL. LEVER END	" "		
TEMP.		" "		H. G. FISCHER & CO. 2335 WABANSIA AVE. CHICAGO, ILL. — CAT. NO. — PART NO. 8130F
PATT.		" "		

70818

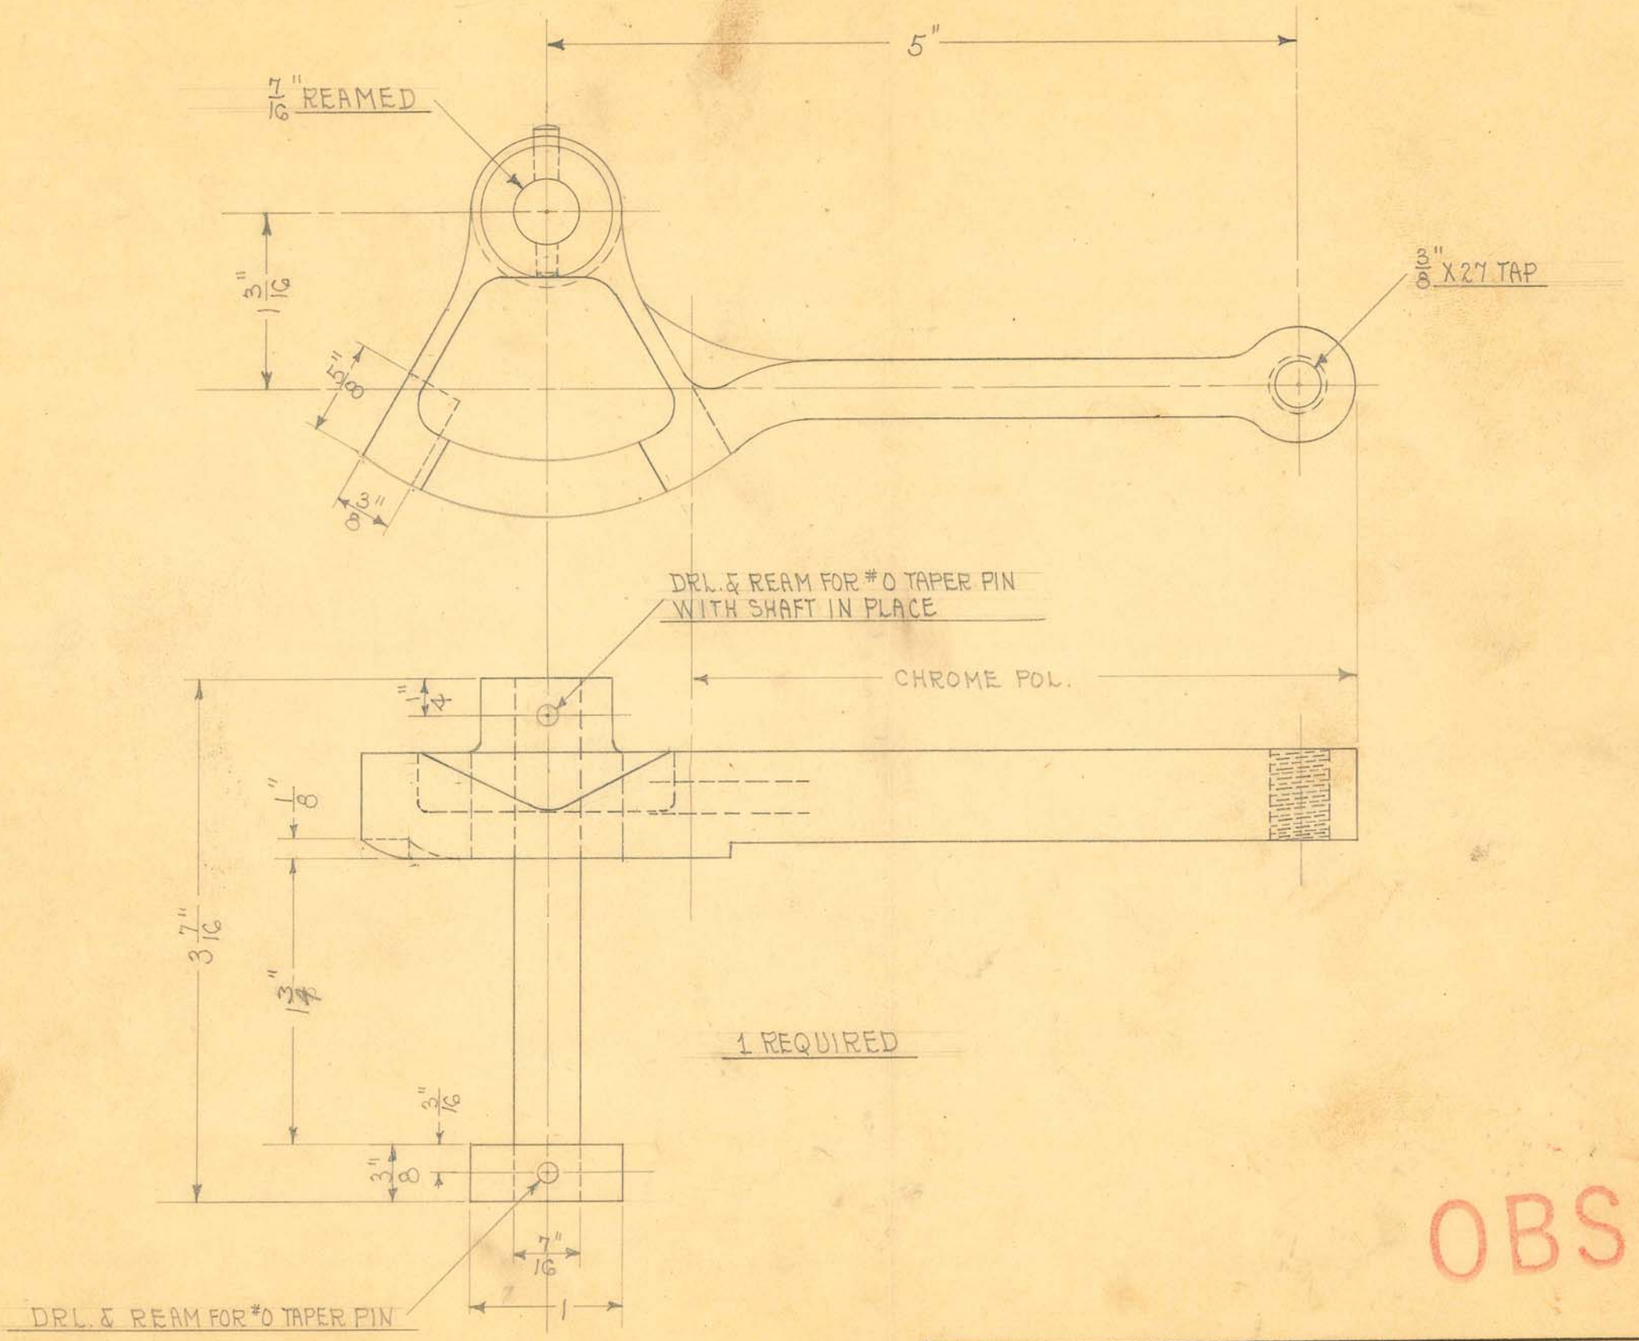

1 REQUIRED

OBSOLETE

SIZE		ISSUE 5-10-33	J.E.
KIND	BRASS CASTING	CHANGED	
SHAPE		" "	
FINISH		" "	
TEMP.		" "	
PATT.	2030-610	" "	

TITLE: UNIVERSAL "60-88" TUBE STAND LOCK LEVER ASSEMBLY

H. G. FISCHER & CO.
2335 WABANSIA AVE.
CHICAGO, ILL.

CAT. NO.

PART NO. 8131G

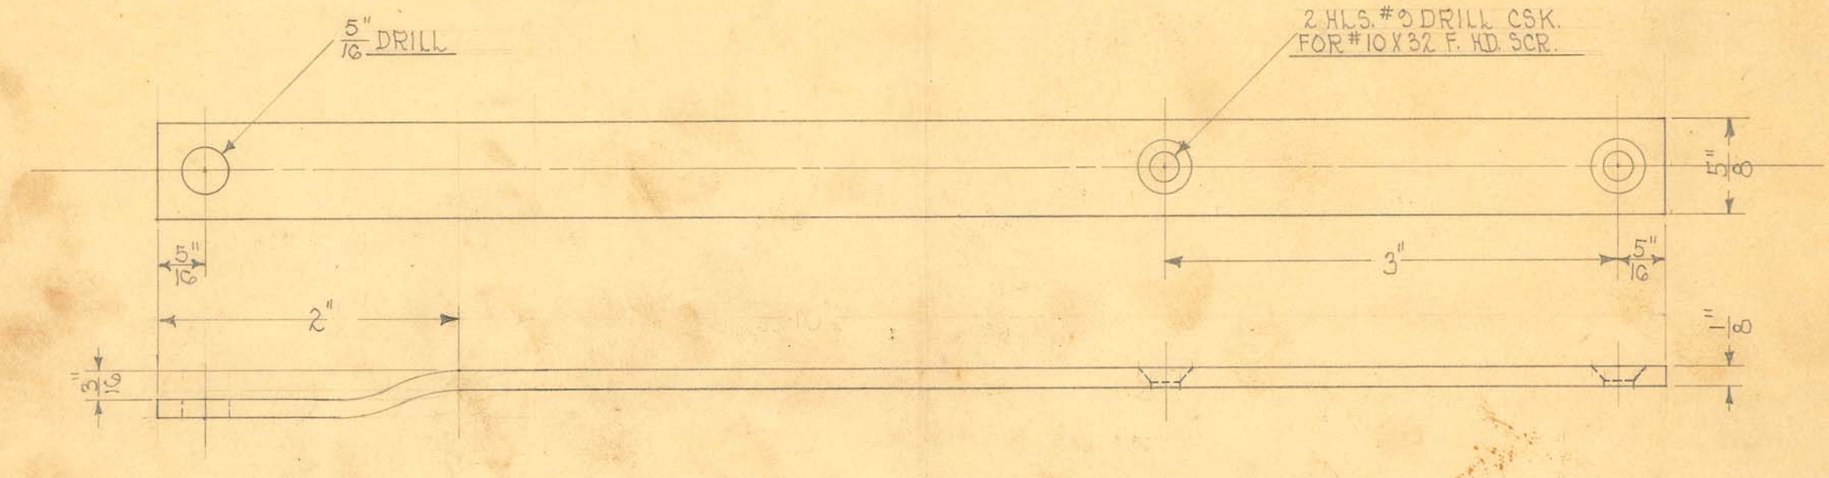

1 REQUIRED

OVERALL LENGTH BEFORE BENDING-10"

OBSOLETE

SIZE	1/8" X 5/8"	ISSUE 5-29-33	A.E.
KIND	SPG. STEEL	CHANGED	
SHAPE		" "	
FINISH	STD. BLK. #80	" "	
TEMP.		" "	
PATT.		" "	

TITLE: UNIVERSAL "60-88" TUBE STAND LOCK FRICTION BAR

H. G. FISCHER & CO.
2335 WABANSIA AVE.
CHICAGO, ILL.

CAT. NO.

PART NO. 8145

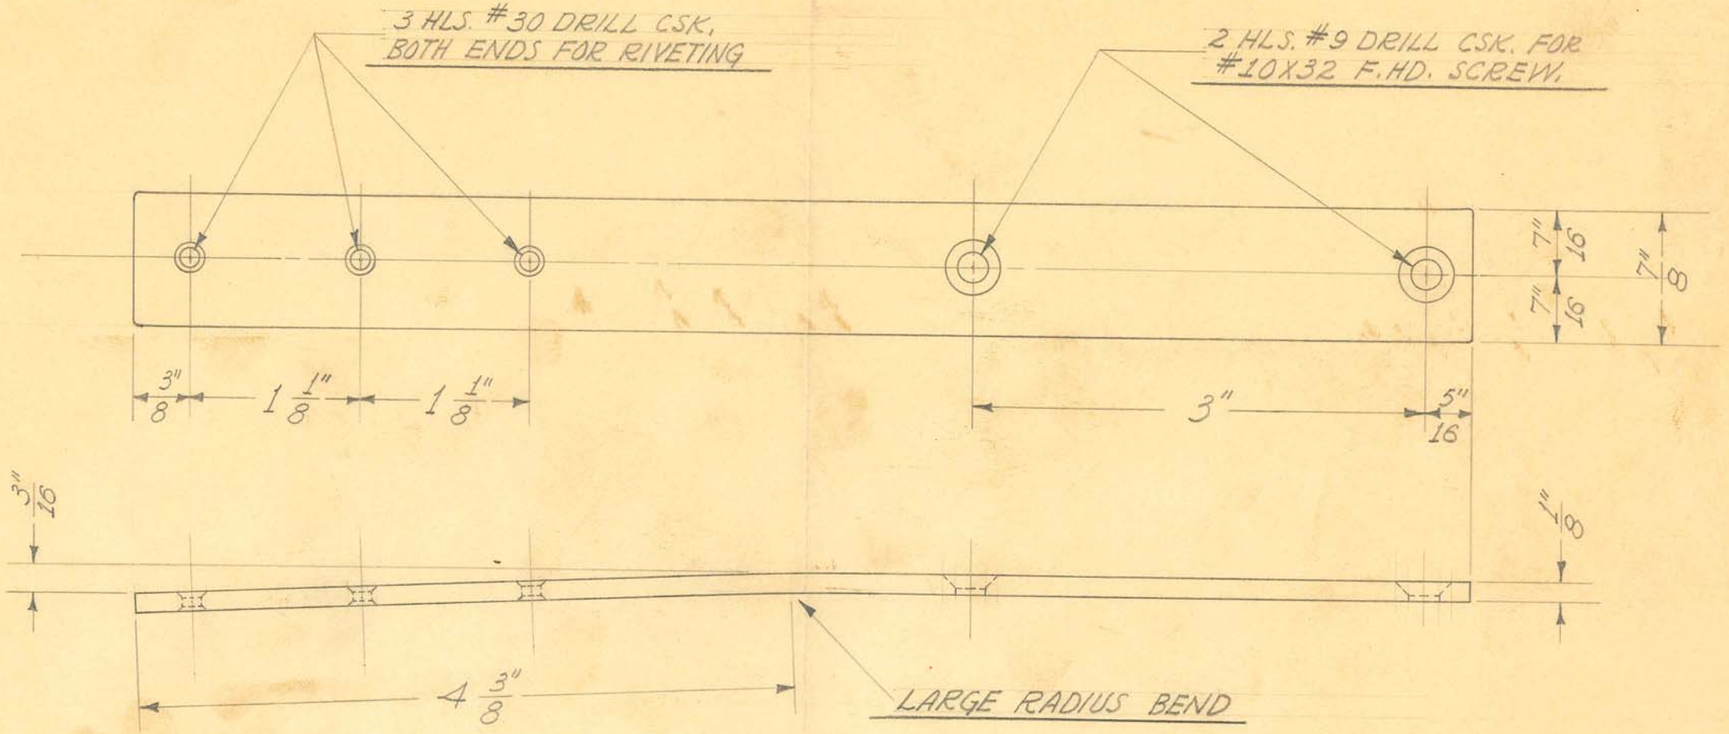

DEVELOPED LENGTH 8 7/8"

1 REQUIRED

OBSOLETE

SIZE	7/8" X 1/8"	ISSUE 12-8-37	J.W.	TITLE: UNIVERSAL "60-88" TUBE STAND LOCK FRICTION BAR
KIND	PHOS. BRONZE	CHANGED		
SHAPE	BAR	"		
FINISH		"		
TEMP.		"		
PATT.		"		

H. G. FISCHER & CO.
2335 WABANSIA AVE.
CHICAGO, ILL.

CAT. NO.

PART NO. 8145A

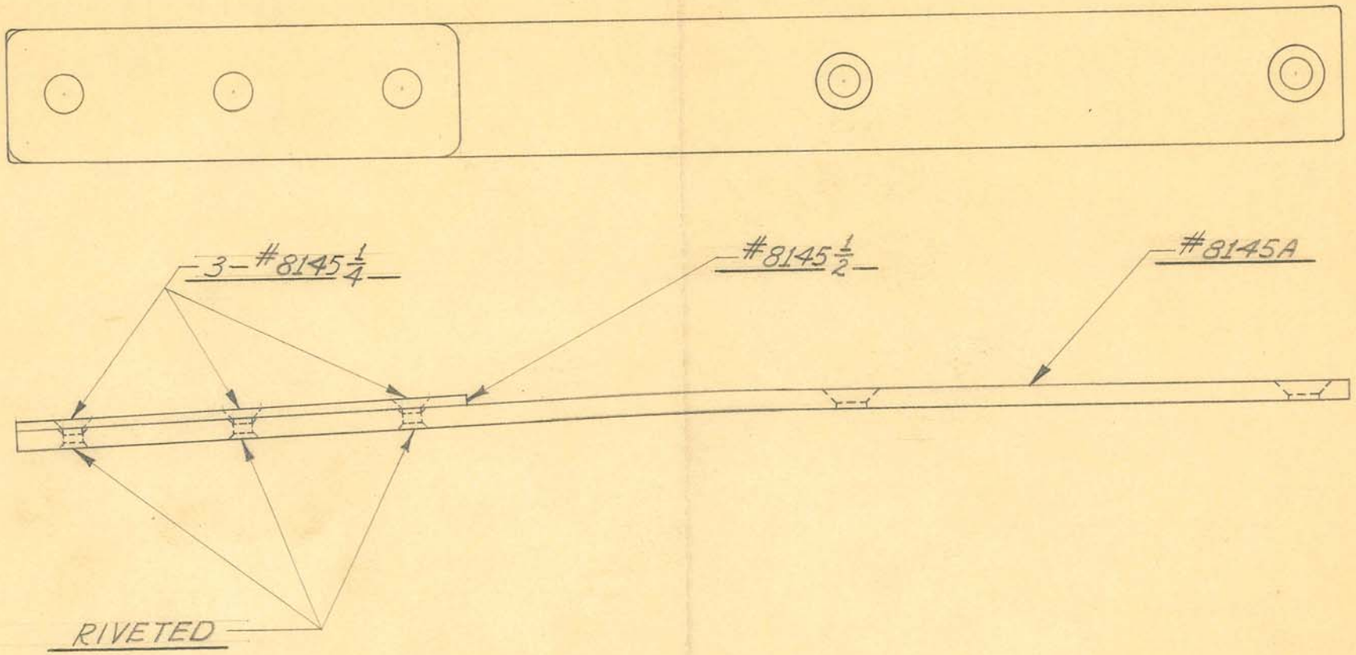

1 REQUIRED

OBSOLETE

SIZE		ISSUE 12-9-37	J.W.	TITLE: UNIVERSAL "60-88" TUBE STAND LOCK FRICTION BAR ASSEMBLY
KIND		CHANGED		
SHAPE		"		
FINISH		"		
TEMP.		"		
PATT.		"		

H. G. FISCHER & CO.
2335 WABANSIA AVE.
CHICAGO, ILL.

CAT. NO.

PART NO. 8145G

TURN TO THIS DIMENSION BY
5 3/4" LONG, TO FIT GAGE #3566.

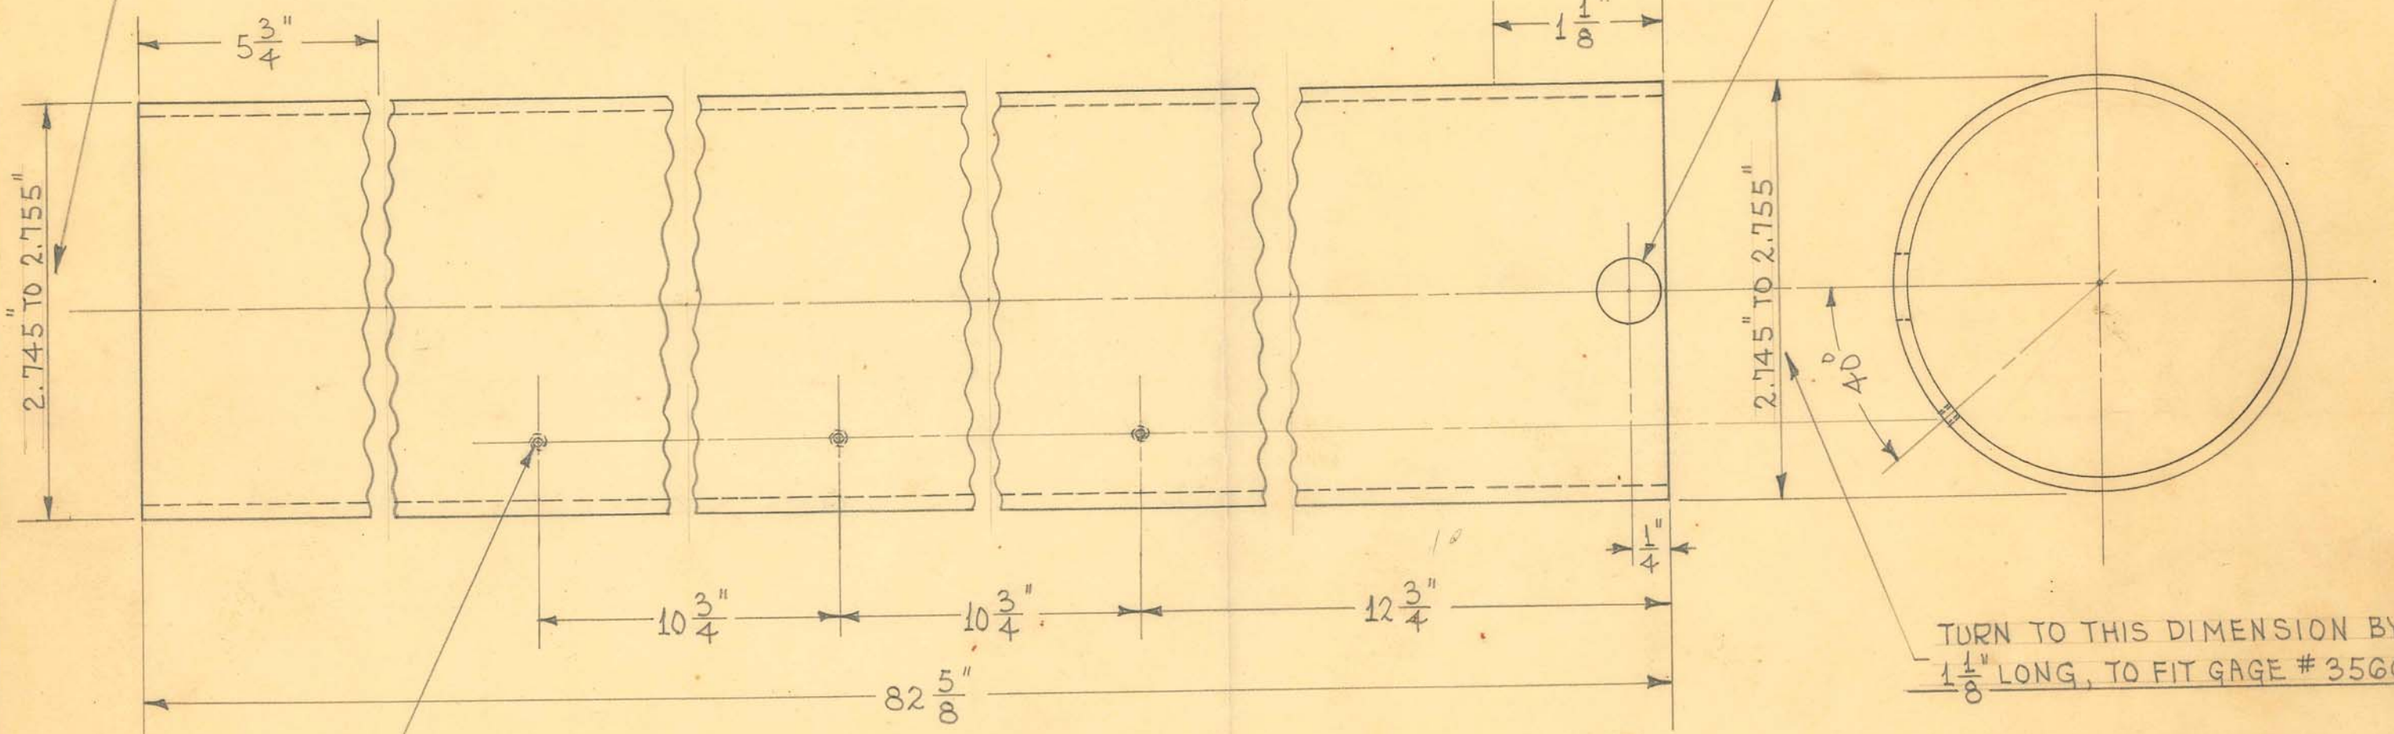

7/16" DRILL

TURN TO THIS DIMENSION BY
1 1/8" LONG, TO FIT GAGE #3566.

1 REQUIRED

OBSOLETE

Obsolete

SIZE	2 3/4" O.D. X 13GA.	ISSUE 7-27-45	HE.	TITLE: UNIVERSAL "GO-88" TUBE STAND ~ UPRIGHT TUBE ~ TUBE SIDE
KIND	SEAMLESS STL.	CHANGED		
SHAPE	TUBING	"		
FINISH	CHROME #2	"		
TEMP.		"		
PATT.		"		

H. G. FISCHER & CO.
2335 WABANSIA AVE.
CHICAGO. ILL.

CAT. NO.

PART NO. 8151 AF

TURN TO THIS DIMENSION BY
5 3/4" LONG, TO FIT GAUGE #3566

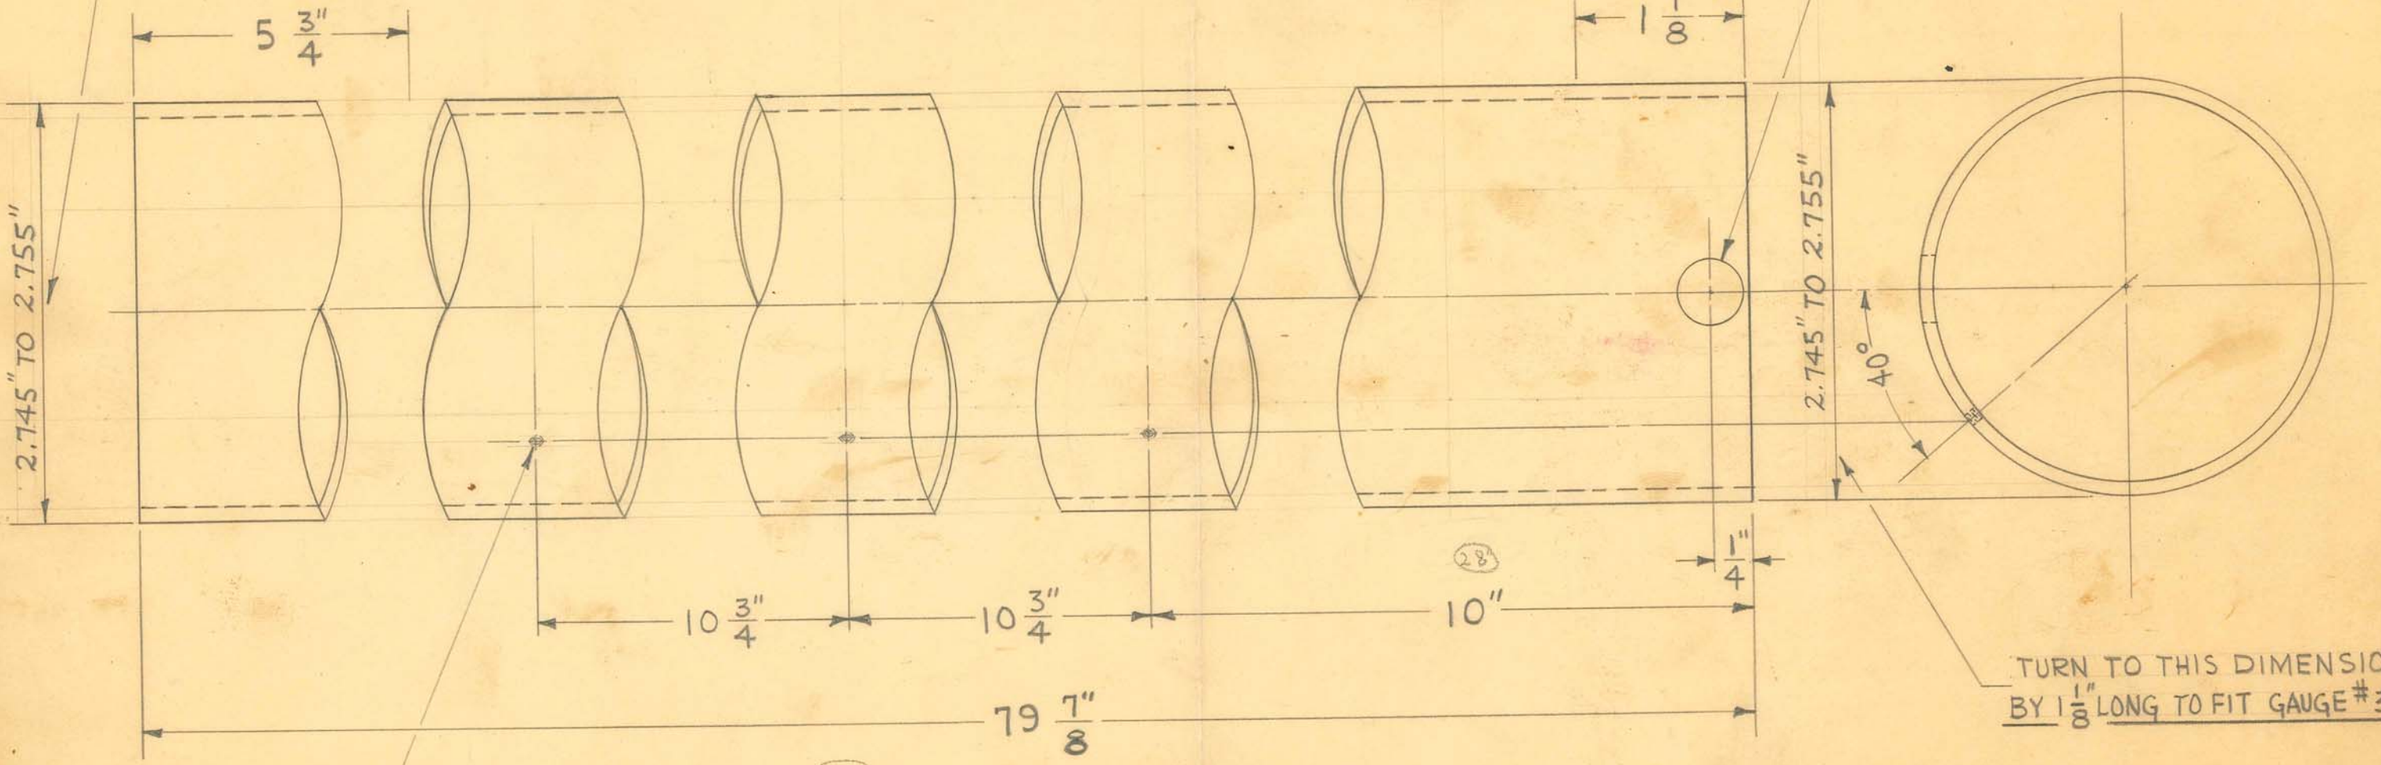

3 HLS. - #2X56 TAP

1 REQUIRED

OBSOLETE

SIZE	2¾" O.D. X #13GA	ISSUE	11-14-45	J.V.W.
KIND	SEAMLESS STL.	CHANGED		
SHAPE	TUBING	"		
FINISH	CHROME #2	"		
TEMP.		"		
PATT.		"		

TITLE:
UNIVERSAL "60-88" TUBE STAND
UPRIGHT TUBE - TUBE SIDE

H. G. FISCHER & CO.
2335 WABANSIA AVE.
CHICAGO, ILL.

CAT. NO.

PART NO. 8151 F

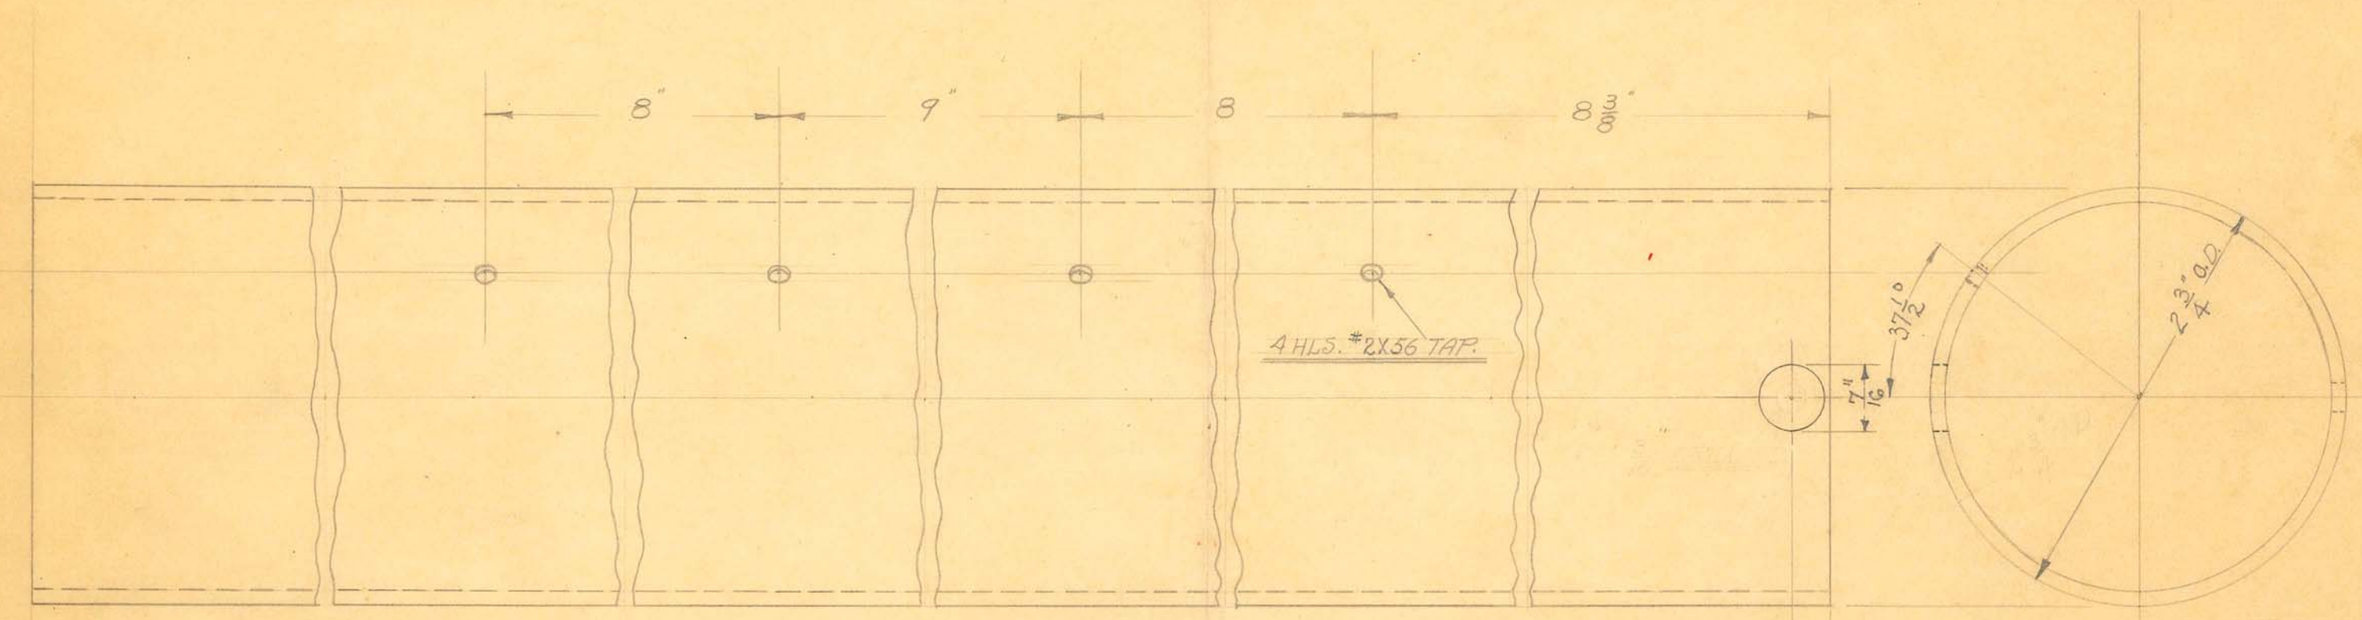

ONE REQUIRED

OBSOLETE

See new Tracing

Obsolete

SIZE	2¾" O.D. X 13 GA.	ISSUE 10-23-33	N.P.	
KIND	SEAMLESS STEEL TUBING	CHANGED		
SHAPE		" "		
FINISH	CHROME PL.	" "		
TEMP.		" "		
PATT.		" "		

TITLE: UNIVERSAL "60-88" TUBE STAND UPRIGHT TUBE. (TUBE SIDE)

H. G. FISCHER & CO.
2335 WABANSIA AVE.
CHICAGO, ILL.

CAT. NO.

PART NO. 8151F.

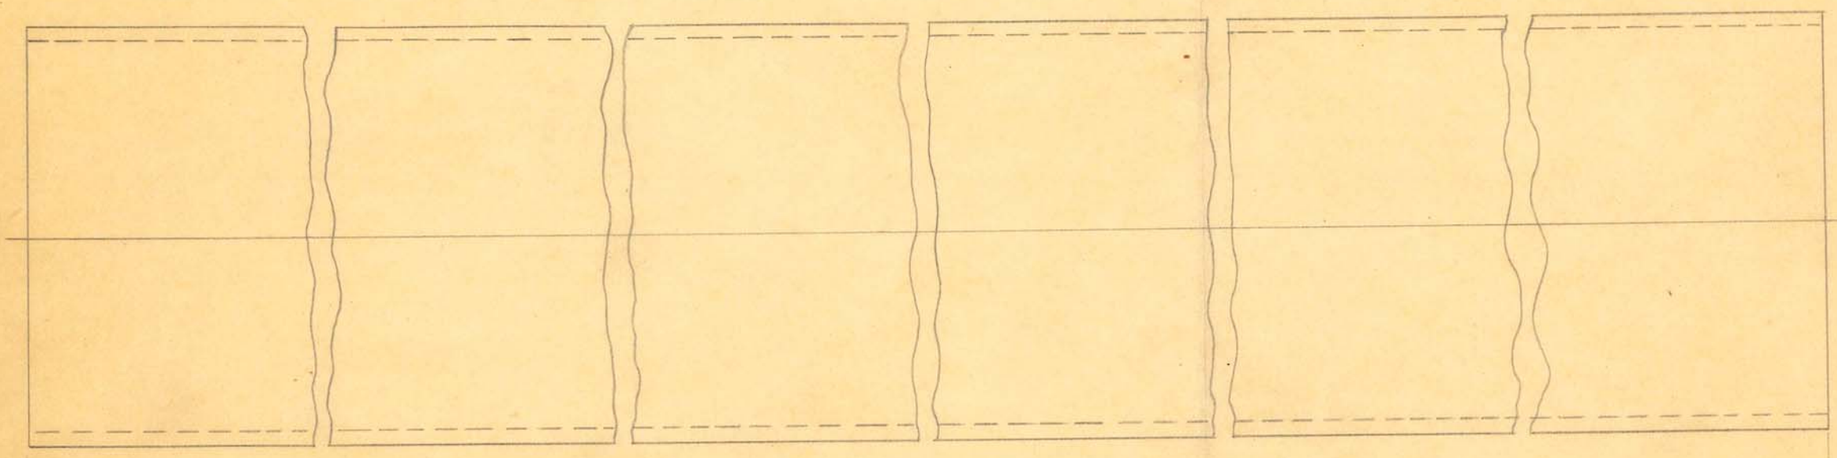

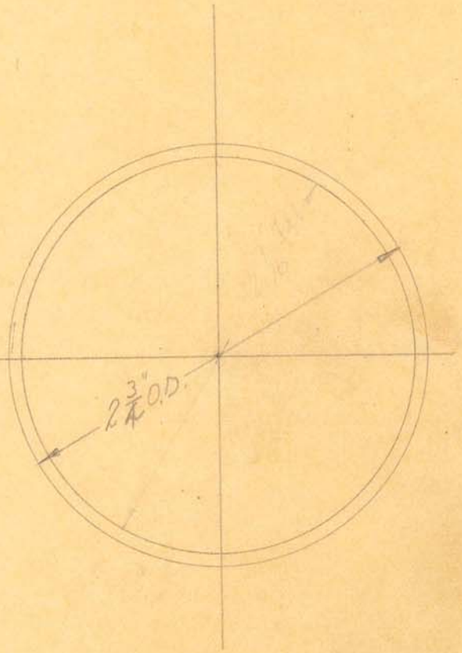

97 7/8"

6'-7 7/8"

(97 7/8") ONE REQUIRED

OBSOLETE

SIZE	2 3/4" O.D. X 13 GA.	ISSUE 10-23-33	N.P.	TITLE: UNIVERSAL "60-88" TUBE STAND UPRIGHT TUBE (SCREEN SIDE)
KIND	SEAMLESS STEEL TUBING	CHANGED		
SHAPE		" "		
FINISH	CHROME PL.	" "		H. G. FISCHER & CO. 2335 WABANSIA AVE. CHICAGO, ILL. — CAT. NO. — PART NO. 8151 1/2 F
TEMP.		" "		
PATT.		" "		

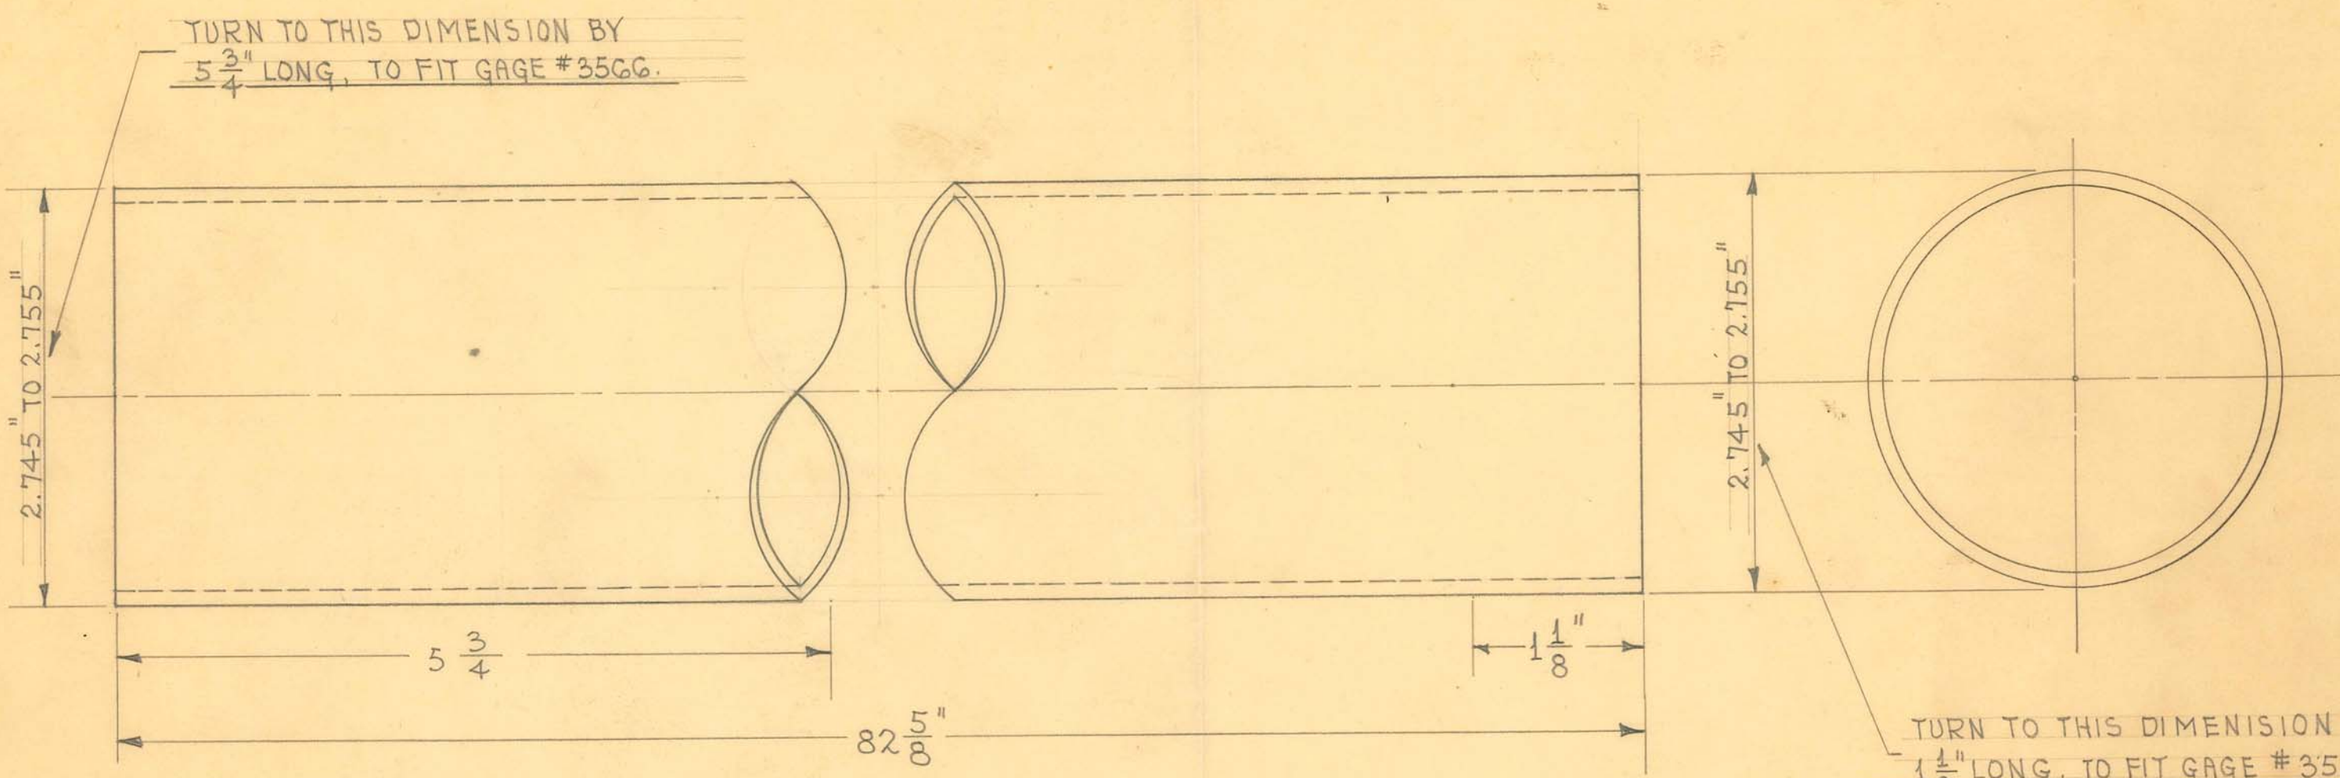

1 REQUIRED

OBSOLETE
obsolete

SIZE	2 3/4" O.D. X 13GA.	ISSUE 7-27-45	HE.	TITLE: UNIVERSAL "60-88" TUBE STAND ~ UPRIGHT TUBE ~ SCREEN SIDE
KIND	SEAMLESS STL.	CHANGED		
SHAPE	TUBING	"		
FINISH	CHROME #2	"		
TEMP.		"		
PATT.		"		

H. G. FISCHER & CO.
2335 WABANSIA AVE.
CHICAGO. ILL.

CAT. NO.

PART NO. 8151 1/2 A

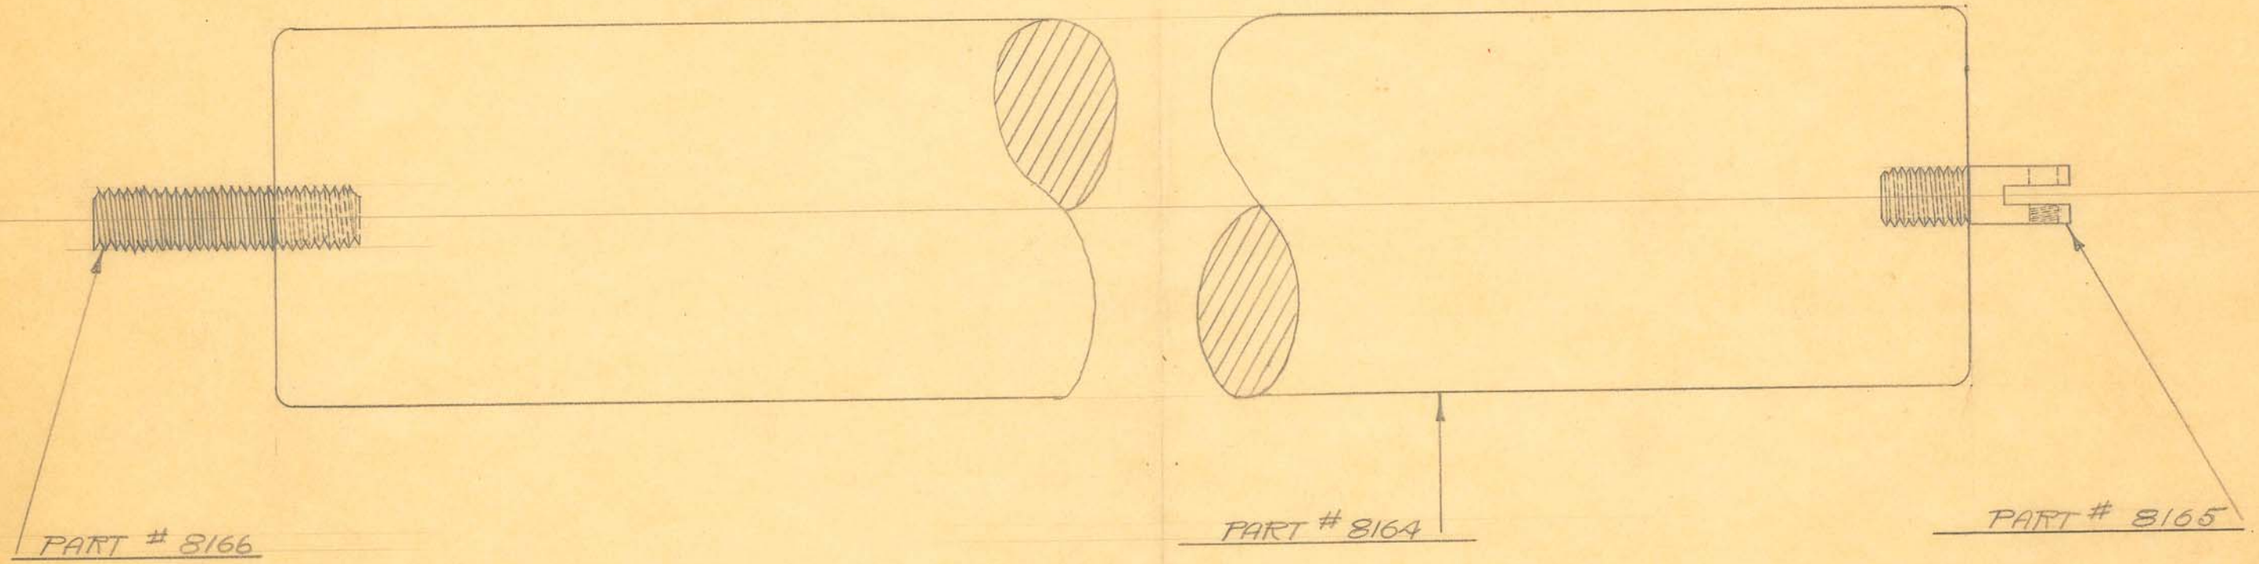

TOTAL WEIGHT 30½ LBS.

OBSOLETE

SIZE		ISSUE	
KIND		CHANGED	
SHAPE		" "	
FINISH		" "	
TEMP.		" "	
PATT.		" "	

TITLE: UNIVERSAL 60-88 TUBE STAND SCREEN SIDE COUNTERWEIGHT ASSEMBLY

H. G. FISCHER & CO.
2335 WABANSIA AVE.
CHICAGO, ILL.

CAT. NO.

PART NO. 8163G

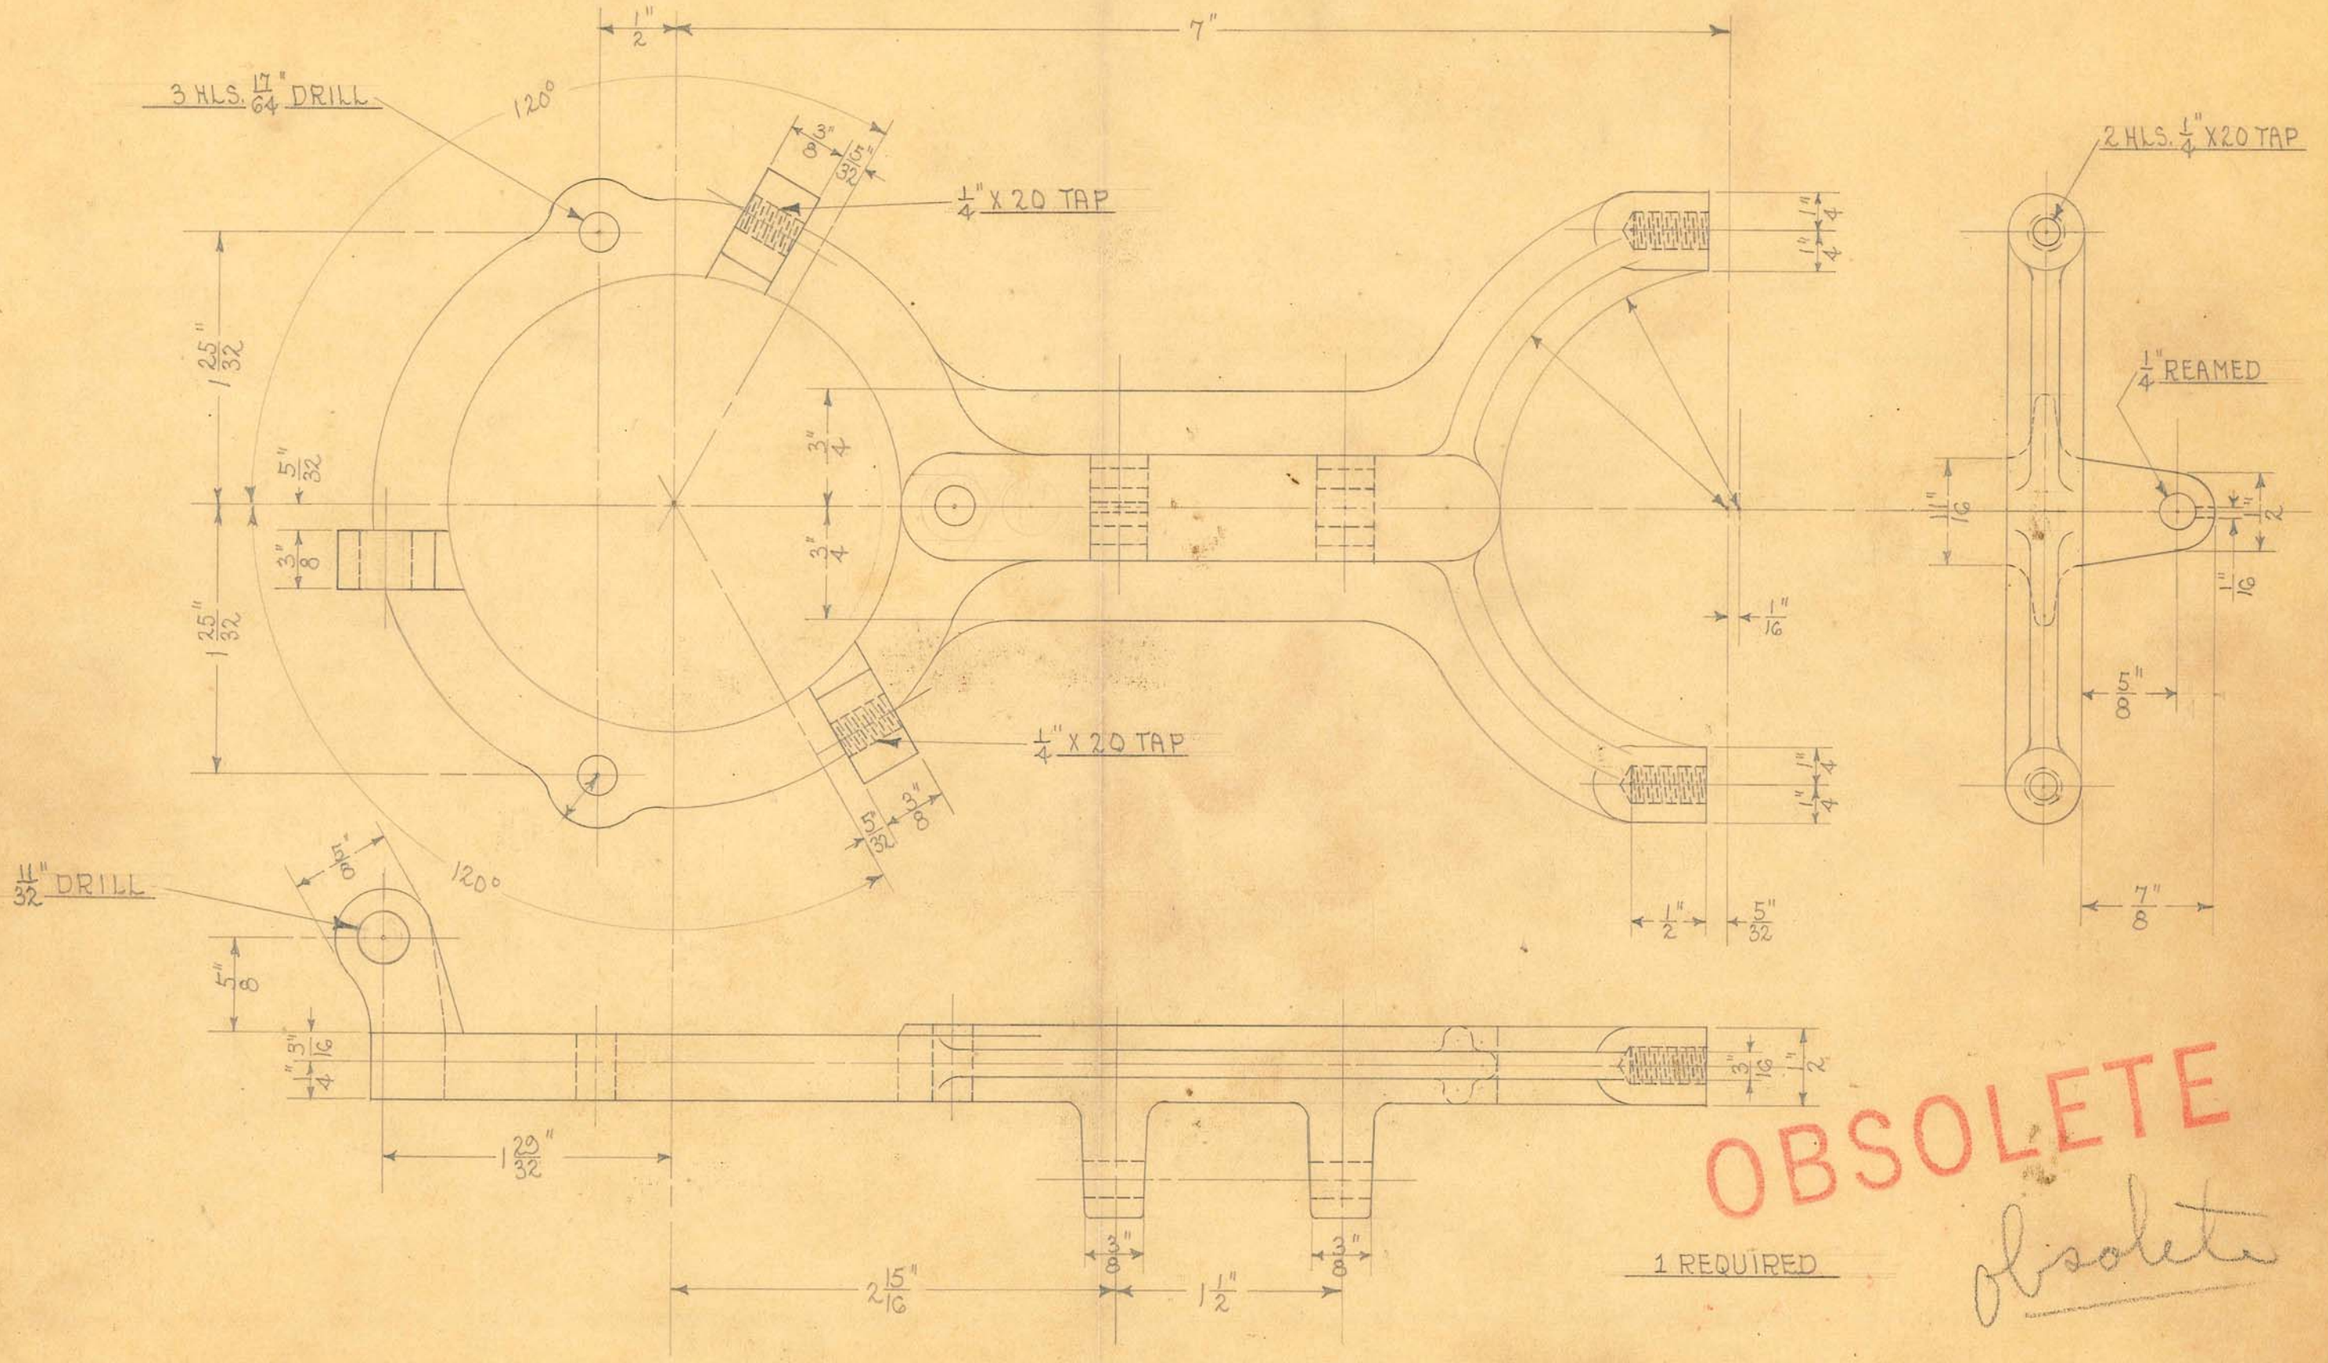

OBSOLETE

1 REQUIRED

obsolete

SIZE		ISSUE	
KIND	ALUM. CASTING	CHANGED	
SHAPE		" "	
FINISH		" "	
TEMP.		" "	
PATT.	1818-599	" "	

TITLE: UNIVERSAL "GO-88" TUBE STAND
SLIDE BALL BEARING SUPP. - LOWER

H. G. FISCHER & CO.
2335 WABANSIA AVE.
CHICAGO, ILL.

CAT. NO.

PART NO. 8171F

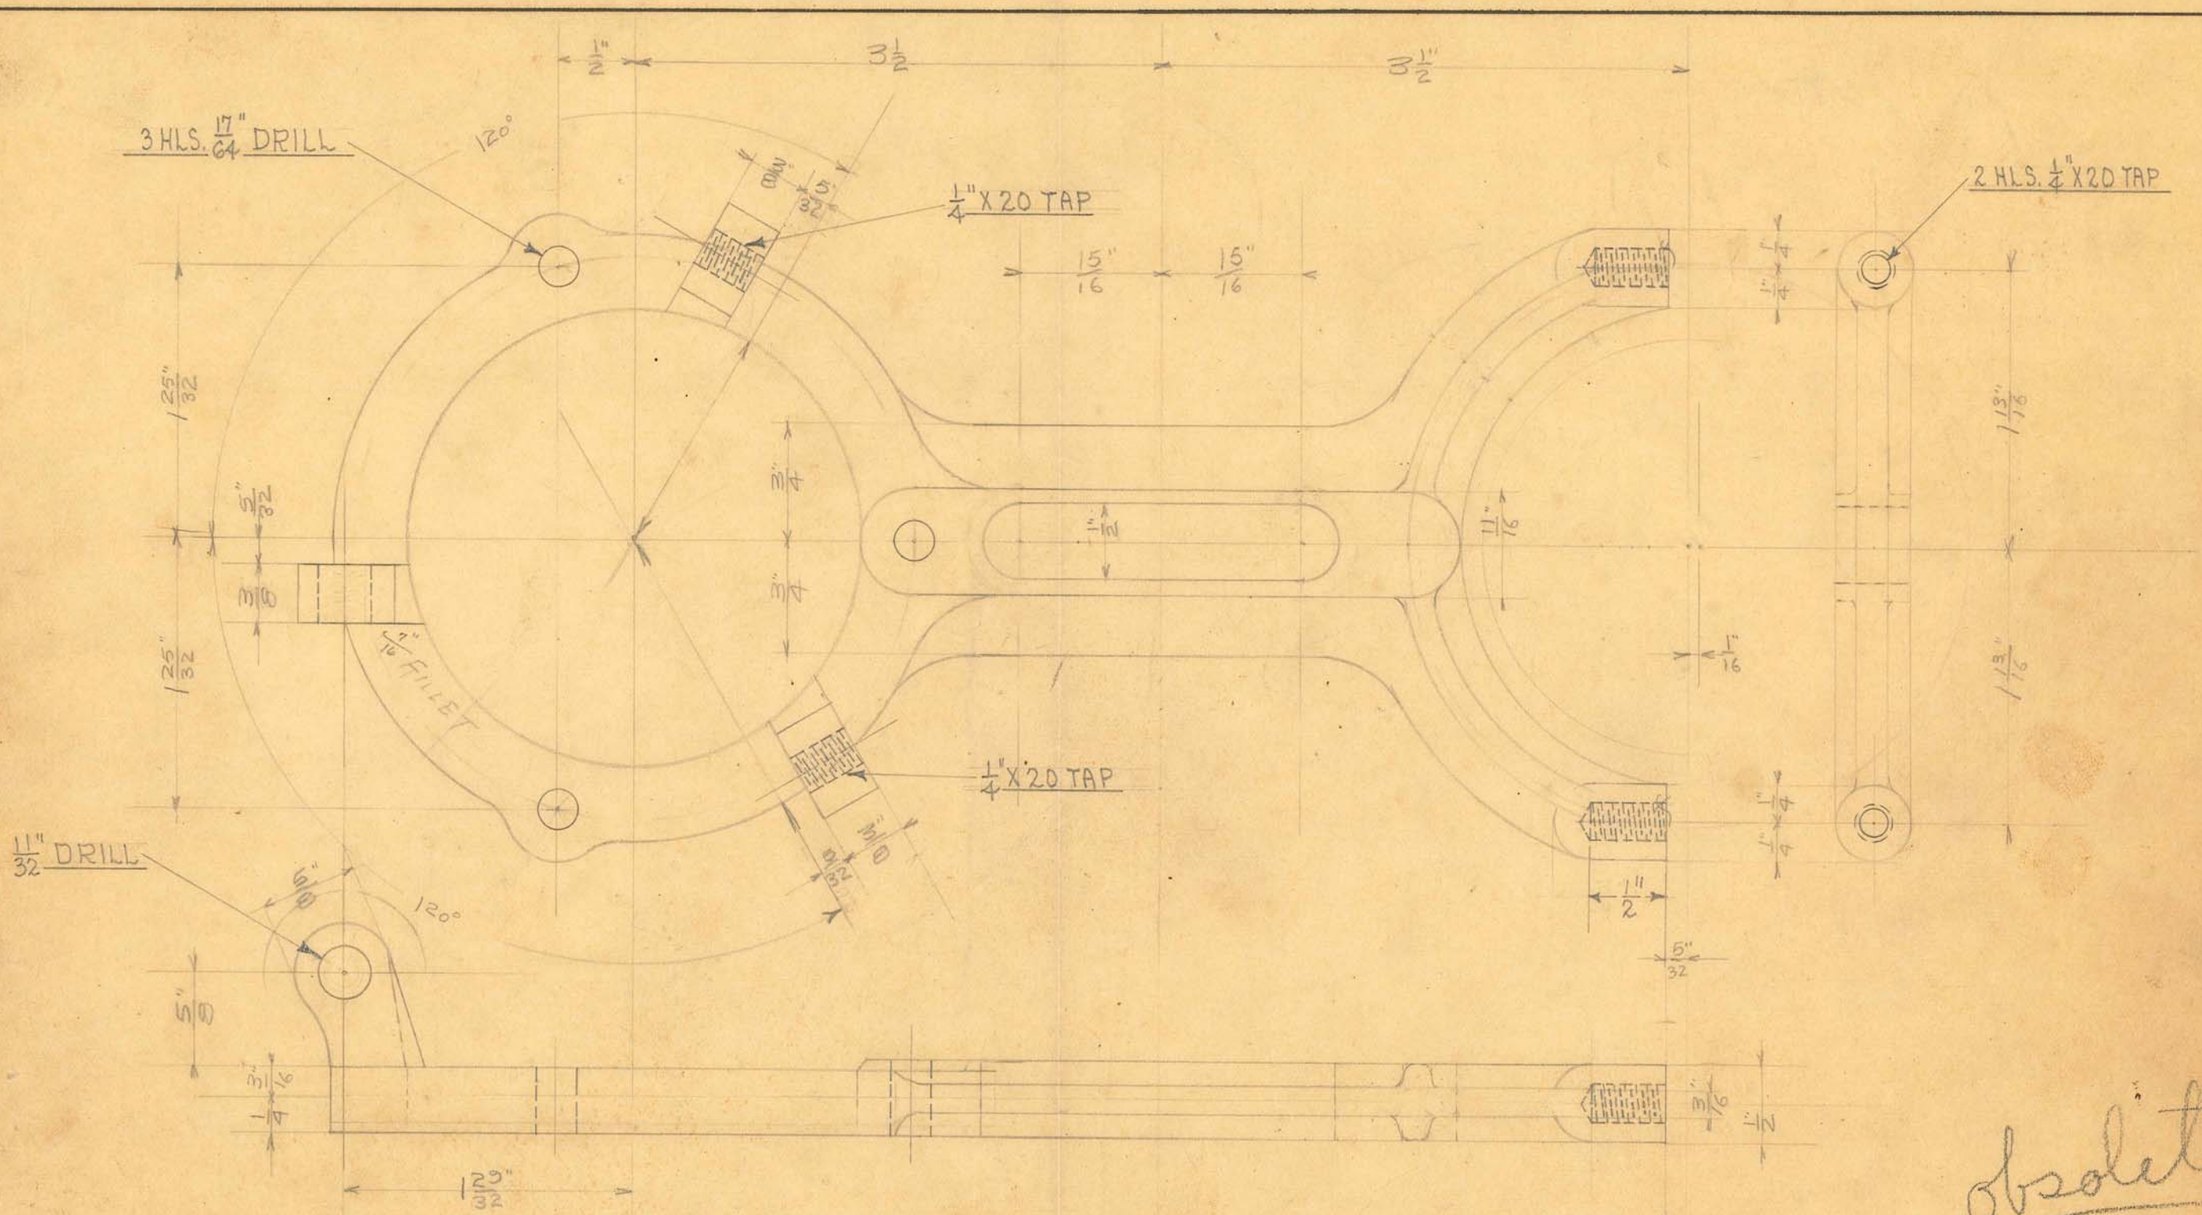

Obsolete

CAST IN ALUMINUM

SCALE FULL SIZE

OBSOLETE

SIZE		ISSUE	
KIND	ALUM. CASTING	CHANGED	
SHAPE		" "	
FINISH		" "	
TEMP.		" "	
PATT.	#1817-598	" "	

TITLE: UNIVERSAL "CO-88" TUBE STAND SLIDE BALL BEARING SUPP.- UPPER

H. G. FISCHER & CO.
2335 WABANSIA AVE.
CHICAGO, ILL.

CAT. NO.

PART NO. 8174F

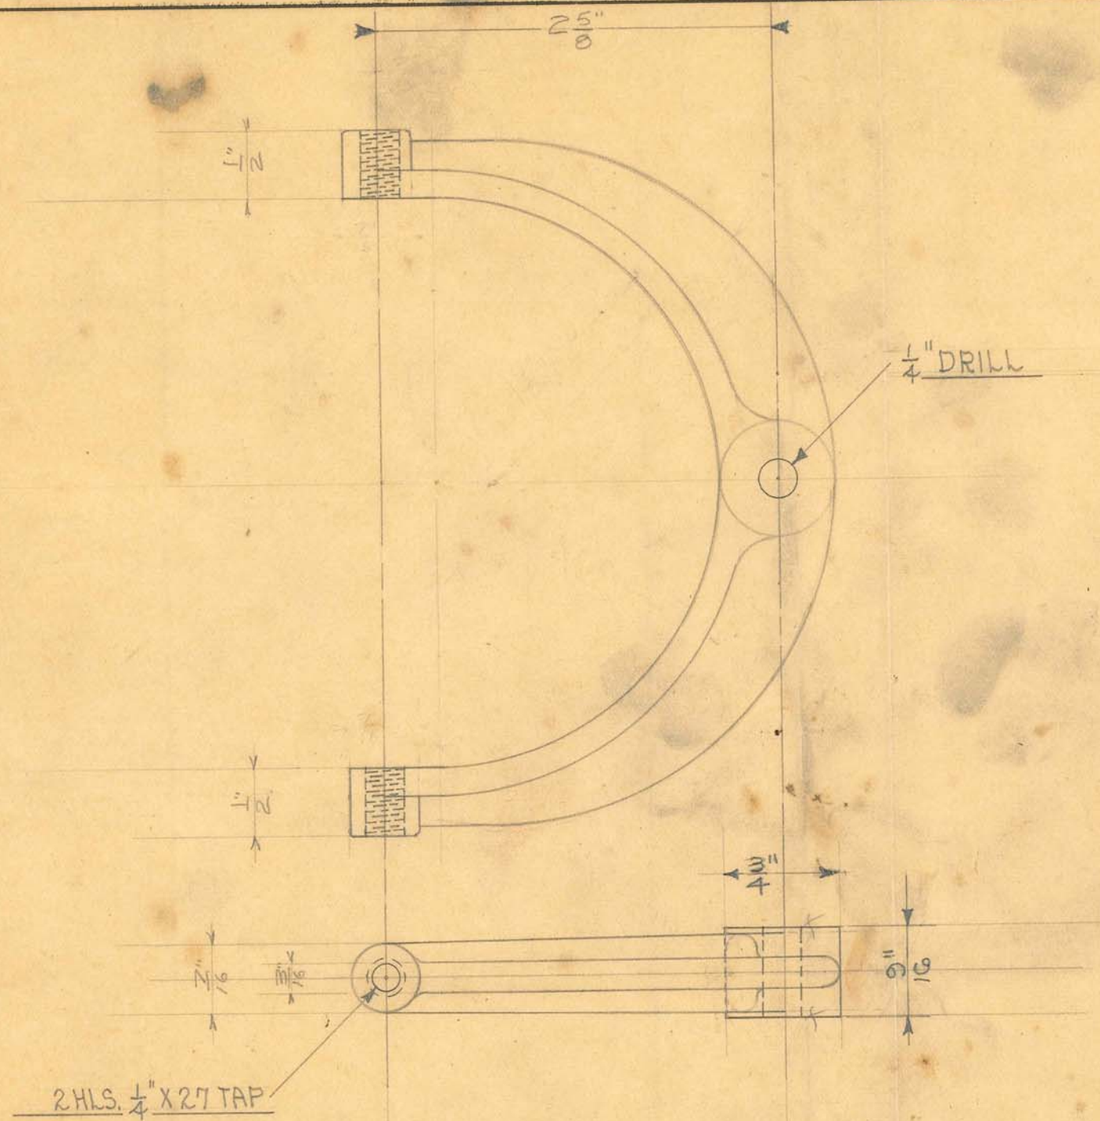

TO BE CAST IN ALUMINUM
2-REQD.
SCALE FULL SIZE

see Tooling

OBSOLETE

SIZE		ISSUE	
KIND	ALUM. CASTING	CHANGED	
SHAPE		" "	
FINISH	BLK. LACQUER	" "	
TEMP.		" "	
PATT.	1816-507	" "	

TITLE: UNIVERSAL "60-88" TUBE STAND SLIDE LOCK

H. G. FISCHER & CO.
2335 WABANSIA AVE.
CHICAGO, ILL.

CAT. NO.

PART NO. 8175F

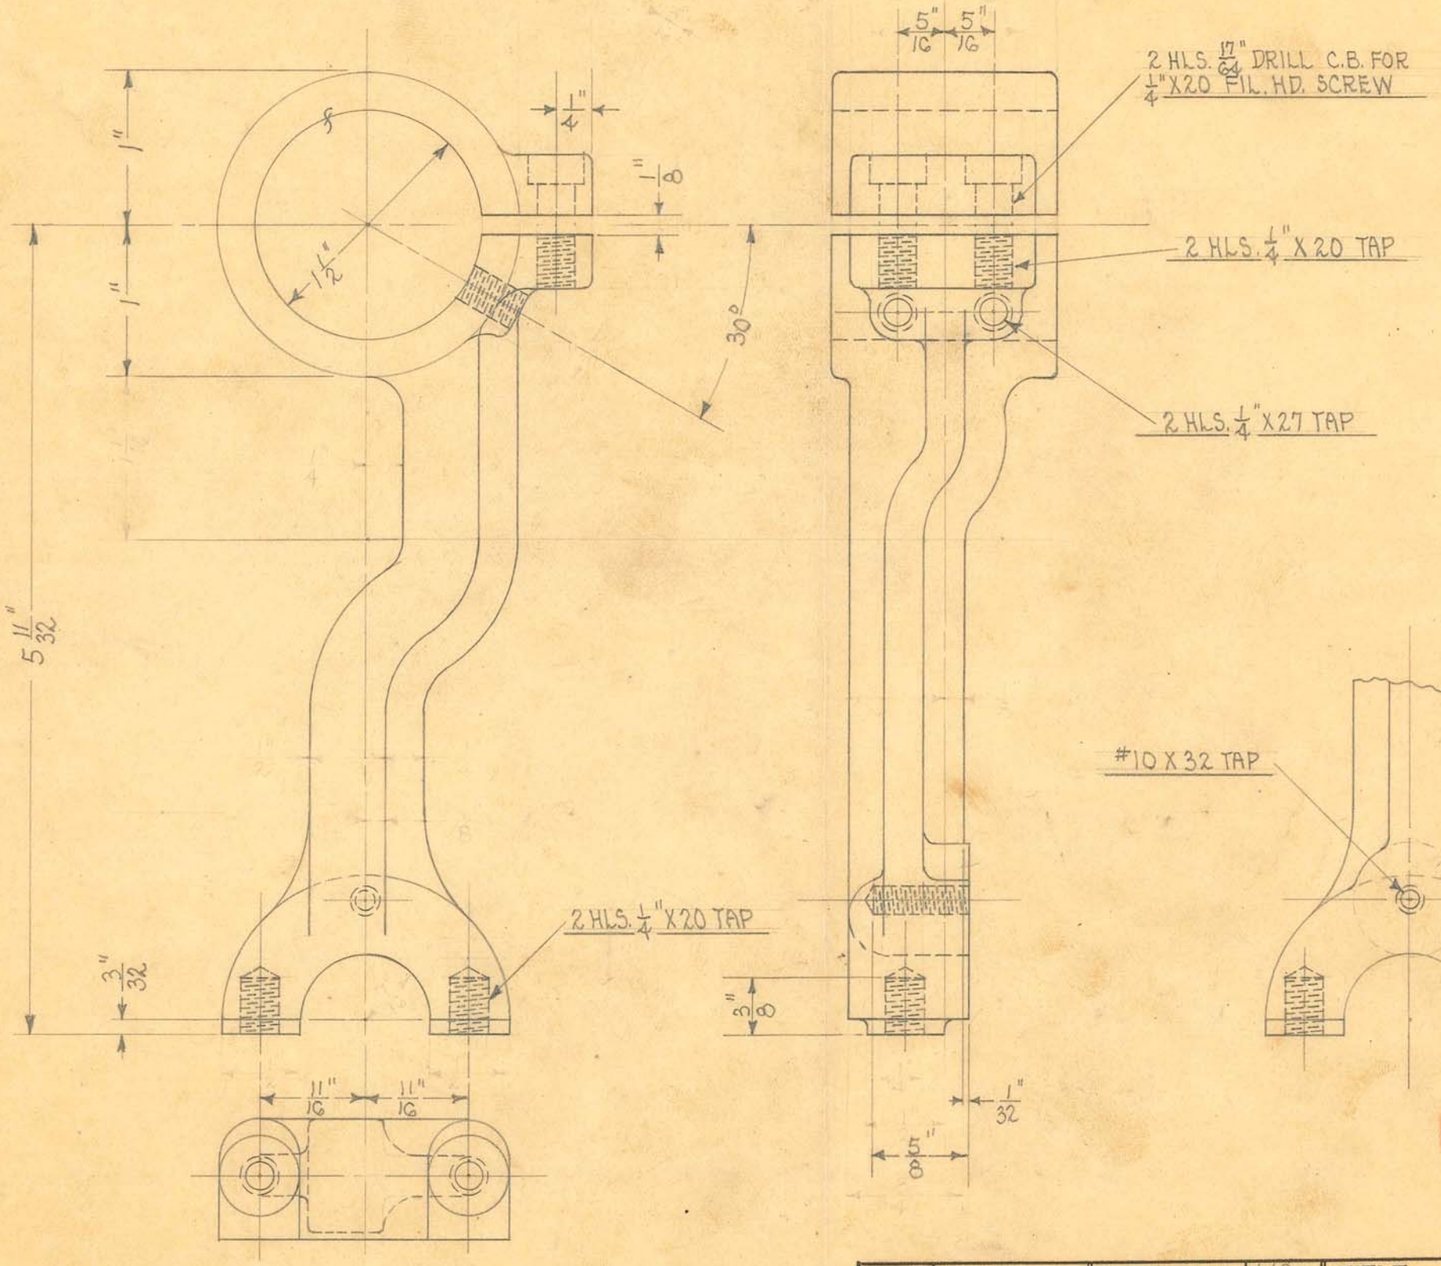

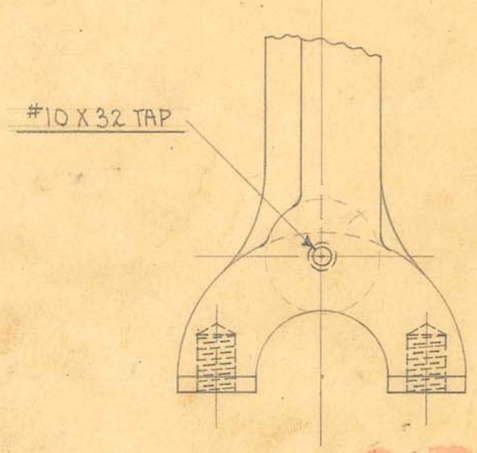

OBSOLETE

1 REQUIRED

SIZE		ISSUE 4-19-33	A.E.
KIND	ALUM. CASTING	CHANGED	
SHAPE		" "	
FINISH	BLK. LACQUER	" "	
TEMP.		" "	
PATT.	2326-615	" "	

TITLE:
UNIVERSAL "60-88" TUBE STAND
HORIZONTAL FLUOROSCOPIC SCREEN GUIDE

H. G. FISCHER & CO.
2335 WABANSIA AVE.
CHICAGO, ILL.

CAT. NO.

PART NO. 8185F

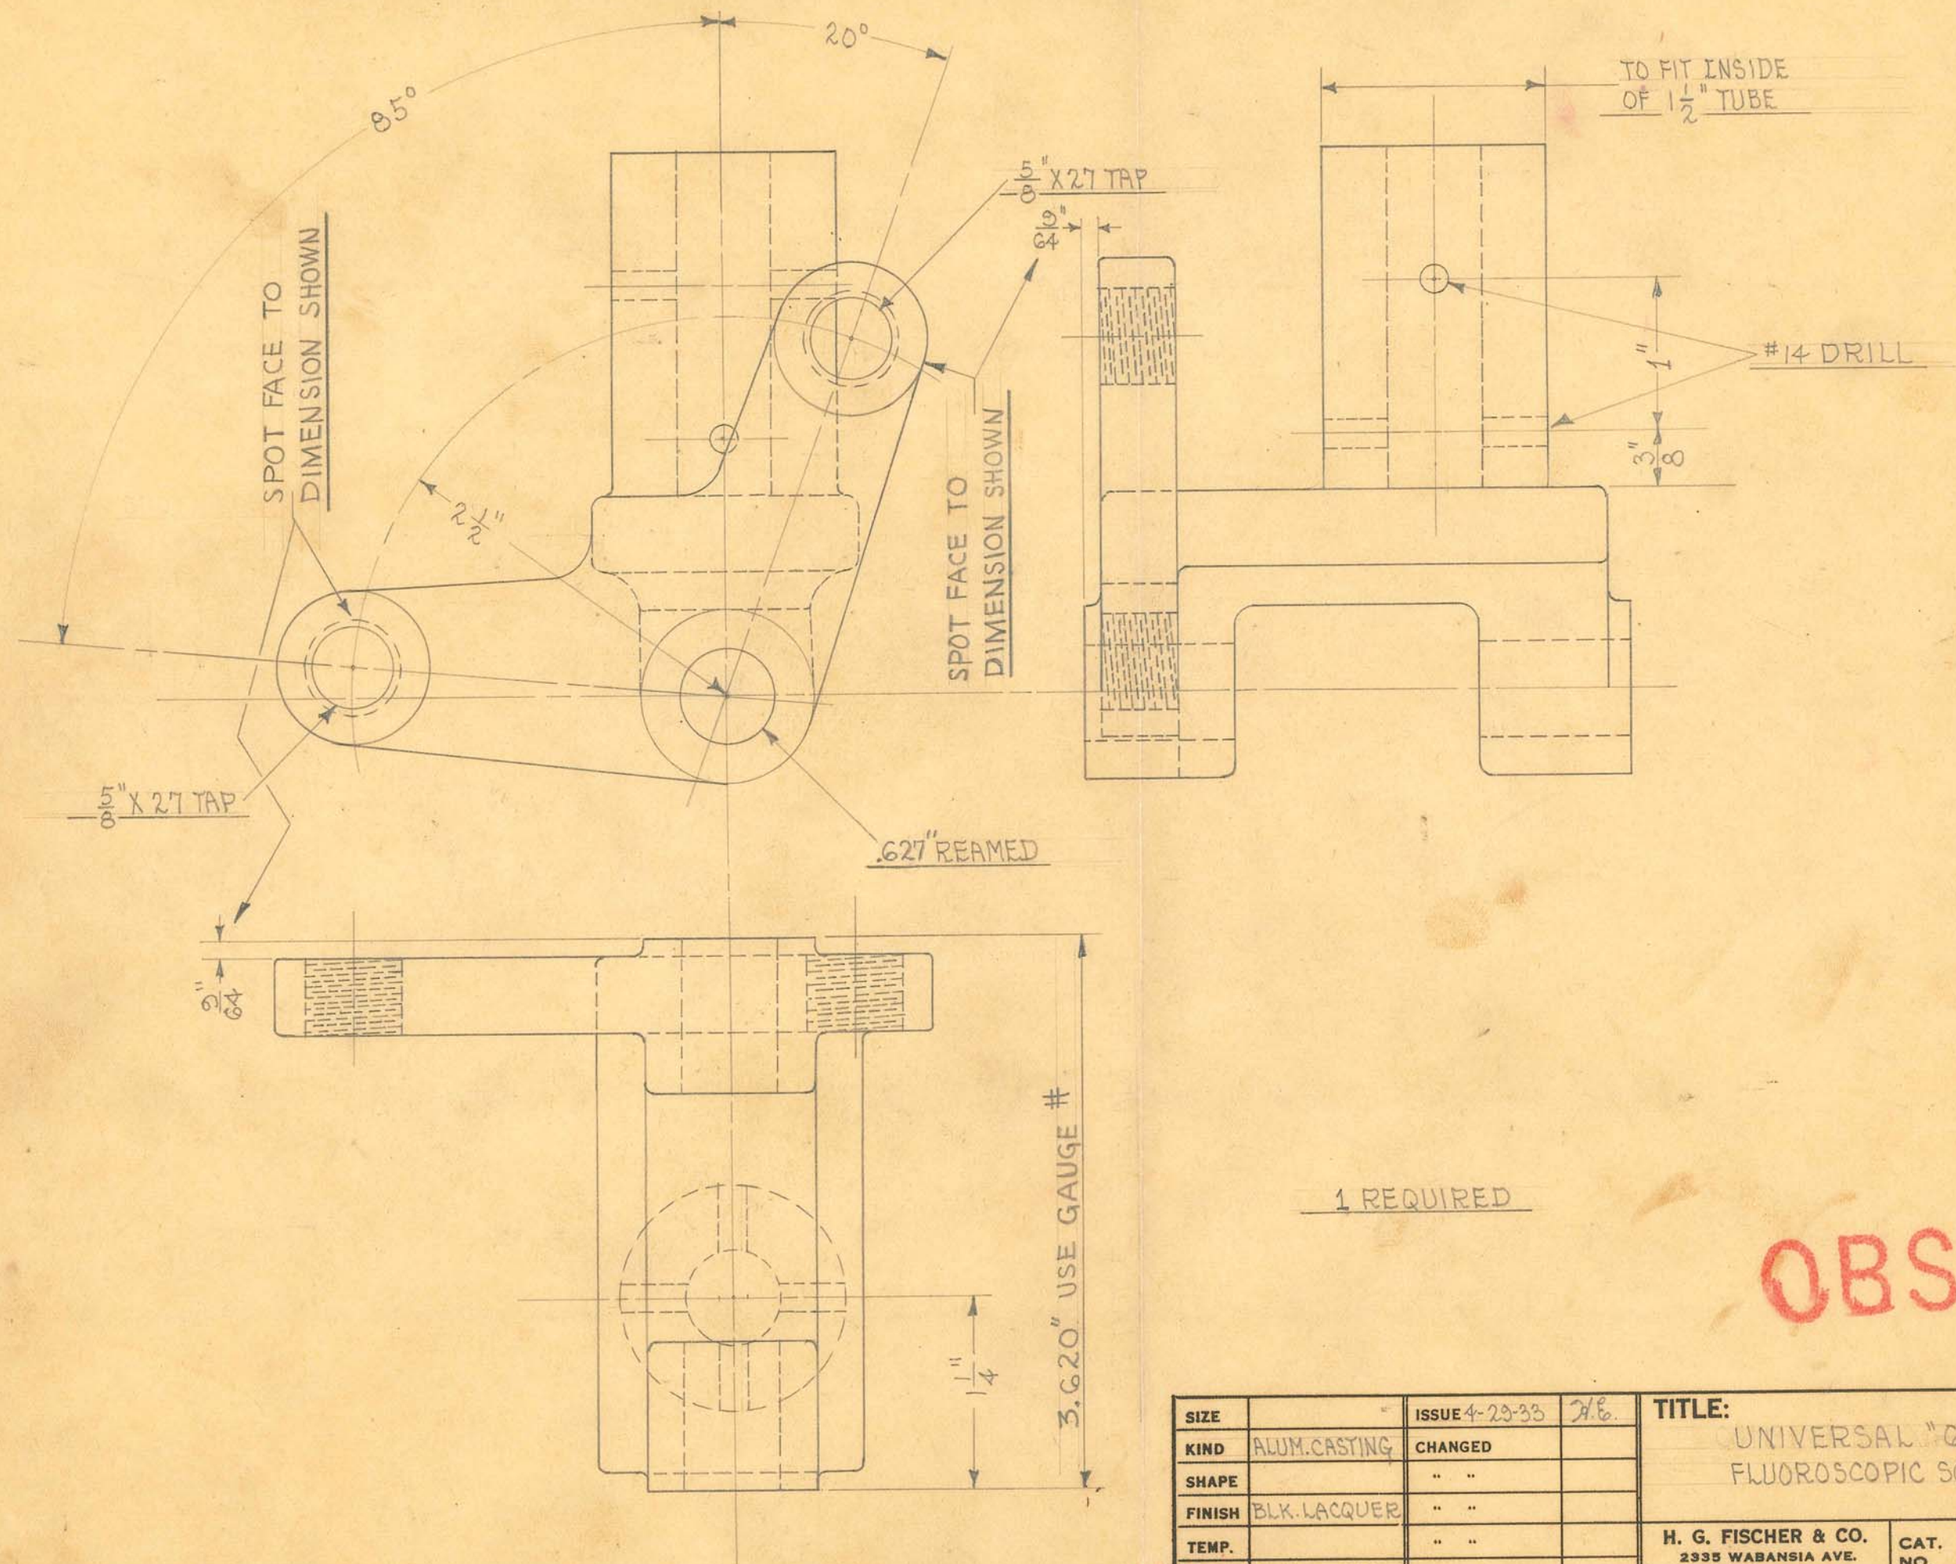

1 REQUIRED

OBSOLETE

SIZE		ISSUE 4-29-33	A.E.
KIND	ALUM. CASTING	CHANGED	
SHAPE		" "	
FINISH	BLK. LACQUER	" "	
TEMP.		" "	
PATT.	2400-G18	" "	

TITLE:
UNIVERSAL "60-88" TUBE STAND
FLUOROSCOPIC SCREEN LOCK PIECE

H. G. FISCHER & CO.
2335 WABANSIA AVE.
CHICAGO, ILL.

CAT. NO.

PART NO. 8190F

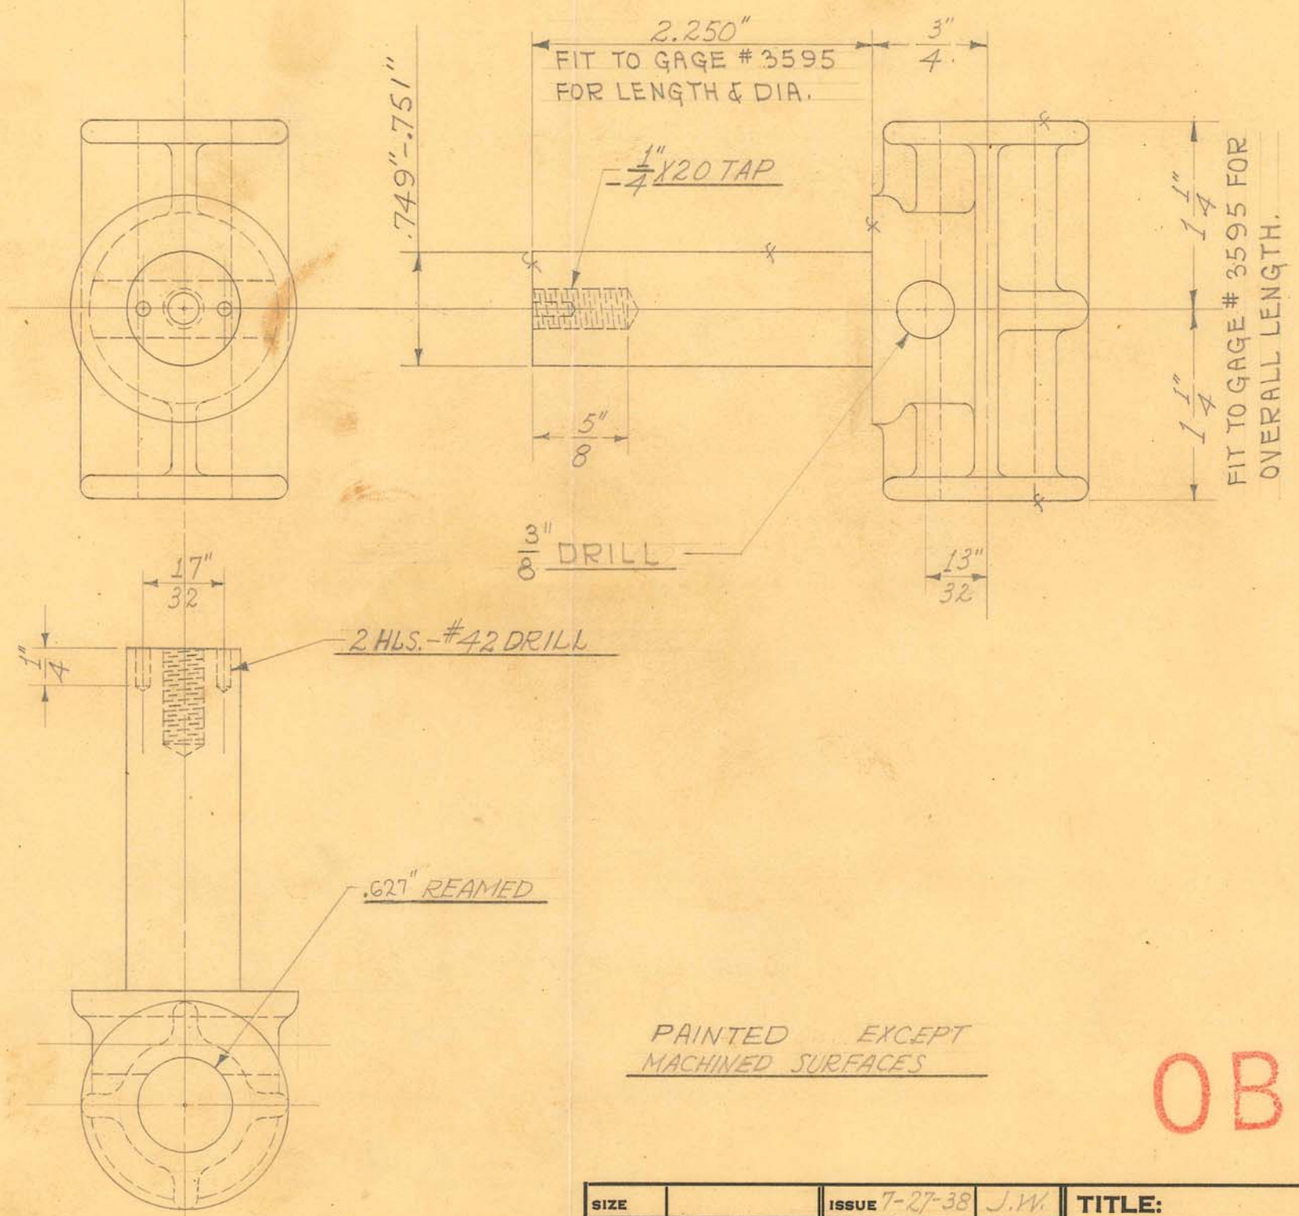

PAINTED EXCEPT
MACHINED SURFACES

OBSOLETE

SIZE		ISSUE 7-27-38	J.W.	TITLE: UNIVERSAL "60-88" TUBE STAND FLUOROSCOPIC SCREEN SWIVEL
KIND	BRASS CASTING	CHANGED		
SHAPE		"		
FINISH	PAINTED	"		
TEMP.		"		
PATT.	2401-610	"		

H. G. FISCHER & CO.
2335 WABANSIA AVE.

CAT. NO.

PART NO. 8202F

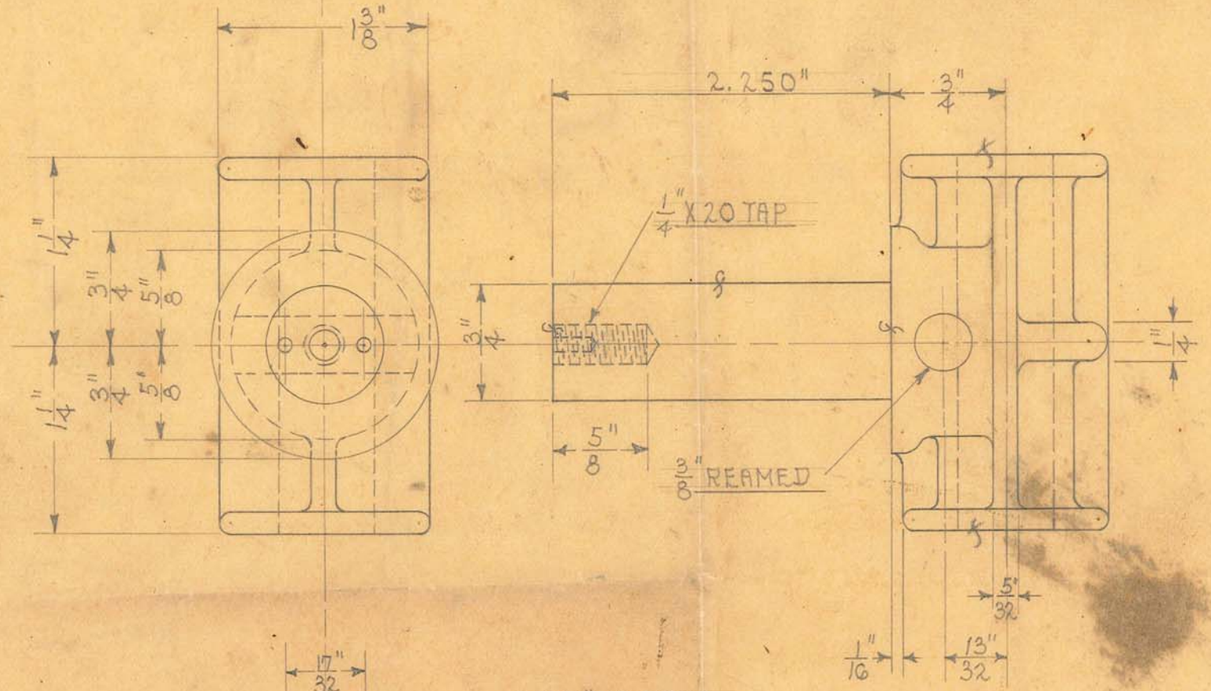

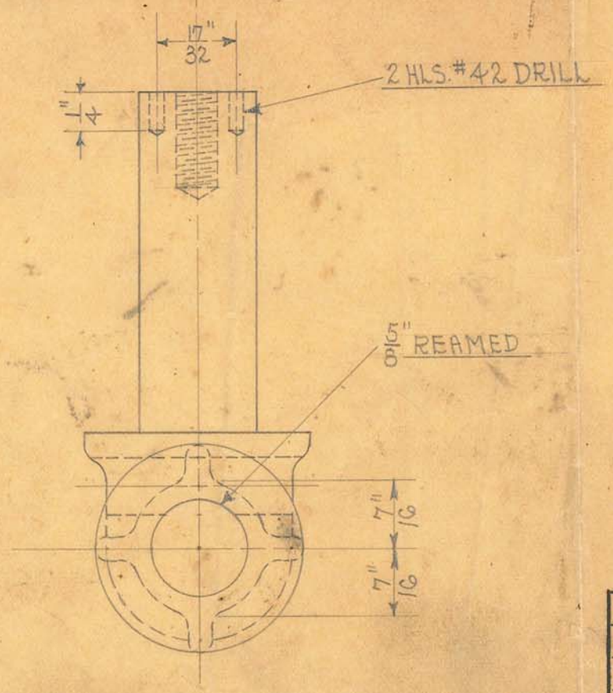

CHROME POL. EXCEPT
MACHINED SURFACES.

use duplicate Tracing

OBSOLETE

SIZE		ISSUE 4-20-33	A.E.
KIND	BRASS CASTING	CHANGED	
SHAPE		" "	
FINISH	CHR. P. EXCEPT	" "	
TEMP.	END (SEE ABOVE)	" "	
PATT.	2401-G19	" "	

TITLE:
UNIVERSAL "GO-88" TUBE STAND
FLUOROSCOPIC SCREEN SWIVEL

H. G. FISCHER & CO.
2335 WABANSIA AVE.
CHICAGO, ILL.

CAT. NO.

PART NO. 8202F

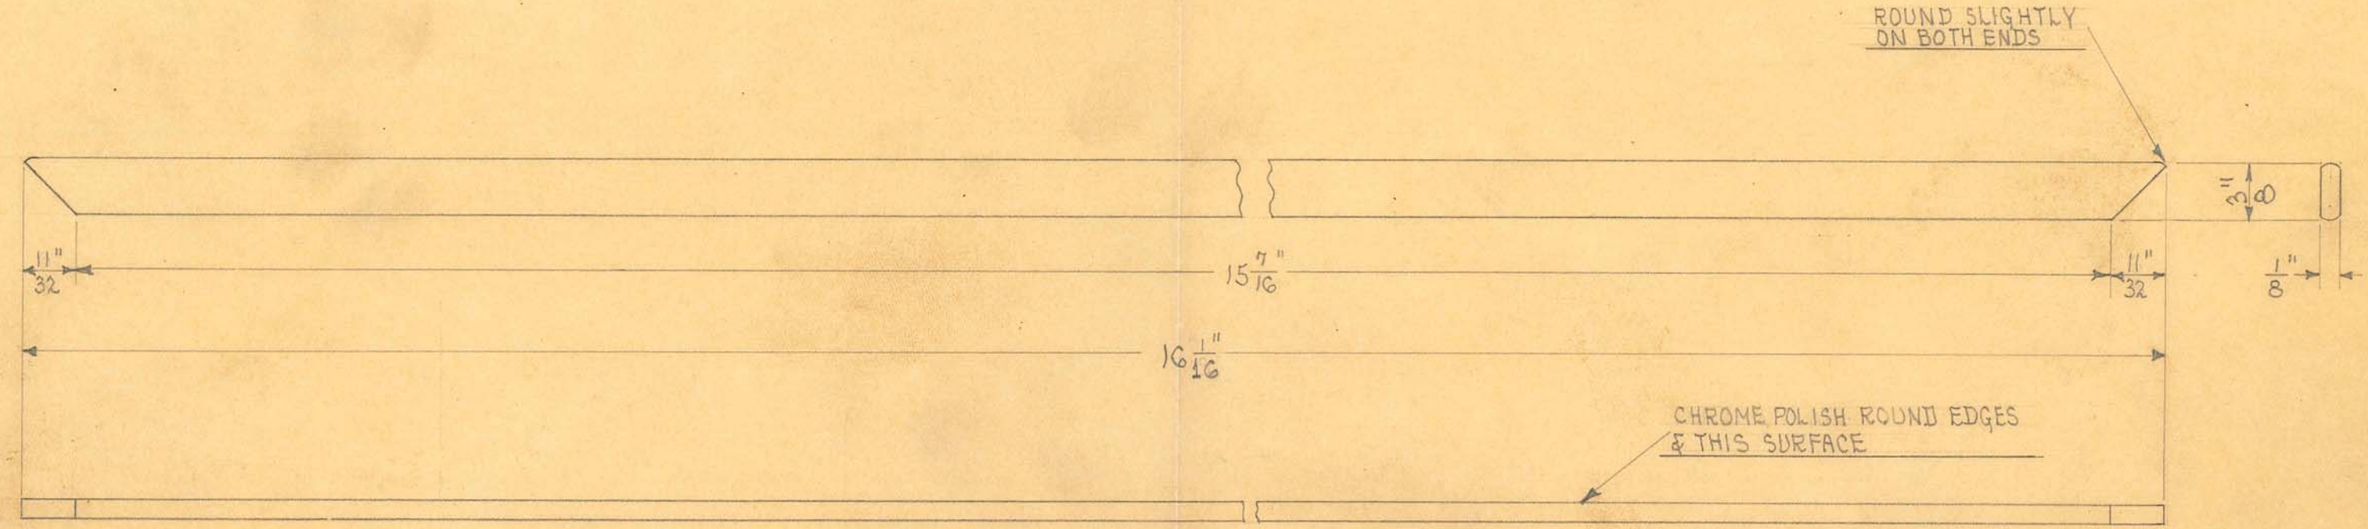

2 REQUIRED

OBSOLETE
Obsolete

SIZE	1/8" X 3/8"	ISSUE 3-1-33	A.E.
KIND	FLAT WIRE	CHANGED	.
SHAPE		" "	
FINISH		" "	
TEMP.		" "	
PATT.		" "	

TITLE:
UNIVERSAL "60-88" TUBE STAND
FLUOROSCOPIC SCREEN CLAMP STRIP (LONG)

H. G. FISCHER & CO.
2335 WABANSIA AVE.
CHICAGO, ILL.

CAT. NO.

PART NO. 8210

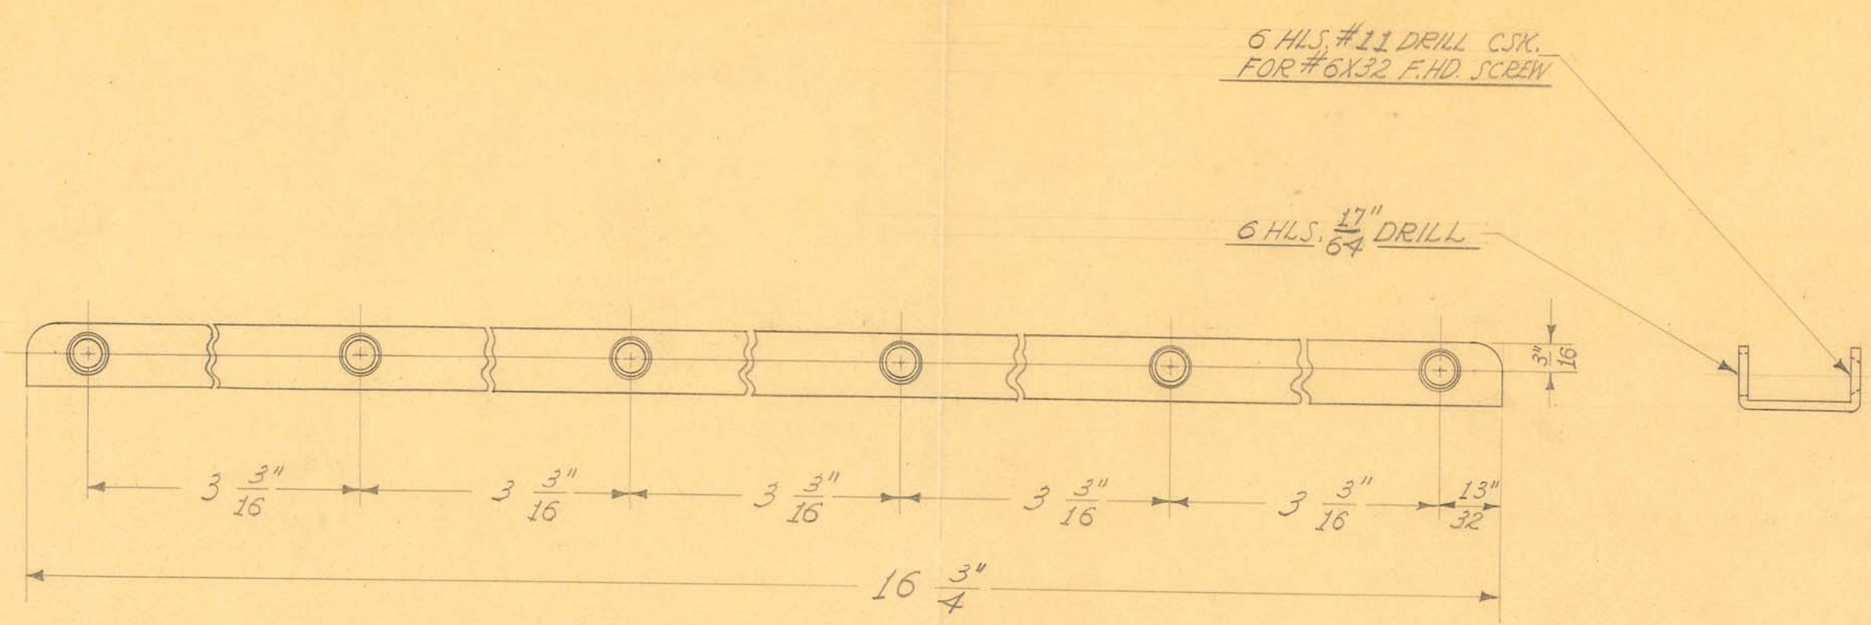

1 REQUIRED

OBSOLETE

SIZE		ISSUE 9-9-37	J.W.
KIND		CHANGED	
SHAPE		"	
FINISH		"	
TEMP.		"	
PATT.		"	

TITLE:
UNIVERSAL "60-88" TUBE STAND - FLUO. SCREEN FRAME - CASSETTE CHANNEL (DIAZ & SUAREZ SO. AMERICA)

H. G. FISCHER & CO.
2335 WABANSIA AVE.
CHICAGO, ILL.

CAT. NO.

PART NO. 8210-1

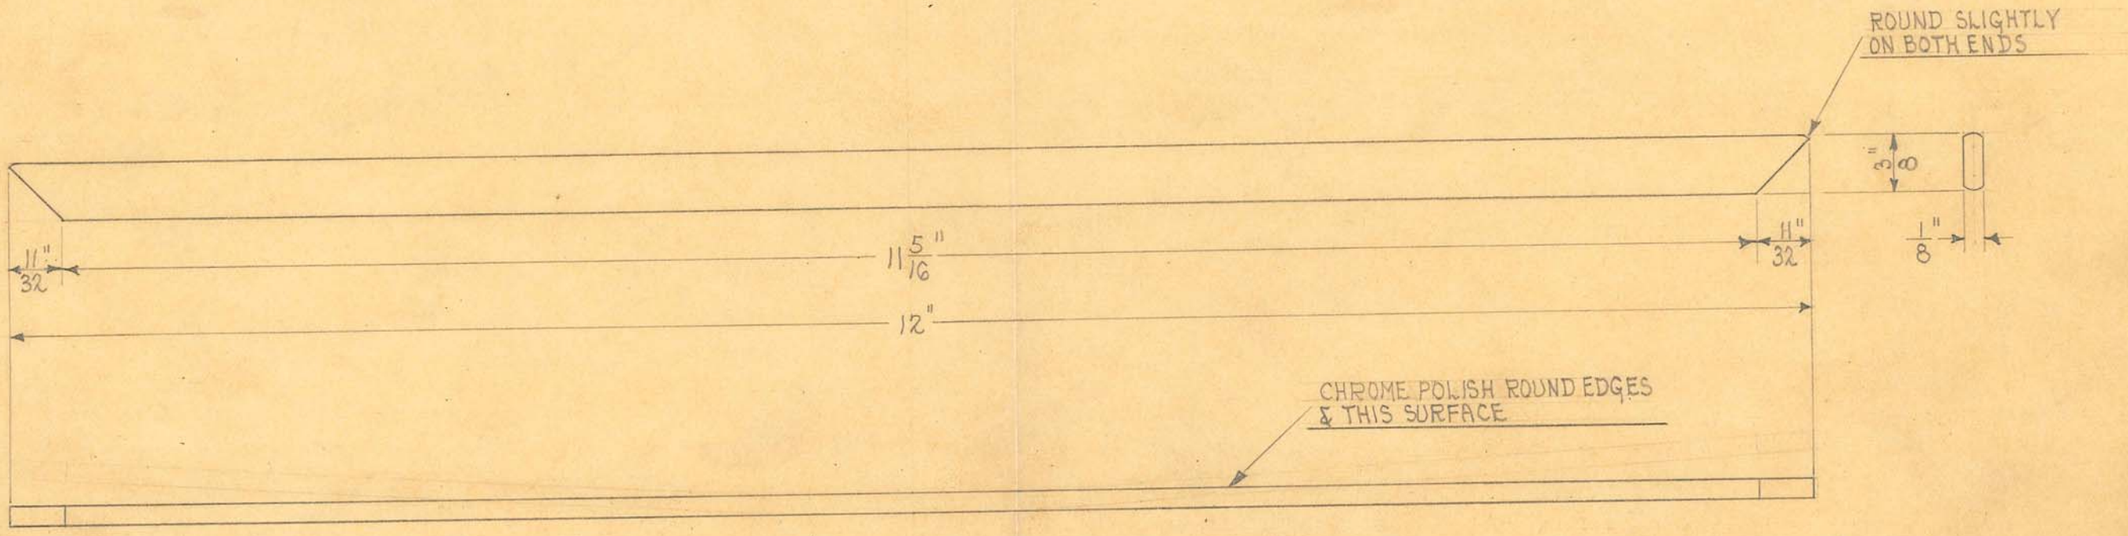

2 REQUIRED

OBSOLETE
Obsolete

SIZE	1/8" X 3/8"	ISSUE 3-1-33	A.E.
KIND	FLAT WIRE	CHANGED	
SHAPE		" "	
FINISH		" "	
TEMP.		" "	
PATT.		" "	

TITLE:
UNIVERSAL "60-88" TUBE STAND
FLUOROSCOPIC SCREEN CLAMP STRIP (SHORT)

H. G. FISCHER & CO.
2335 WABANSIA AVE.
CHICAGO, ILL.

CAT. NO.

PART NO. 8211

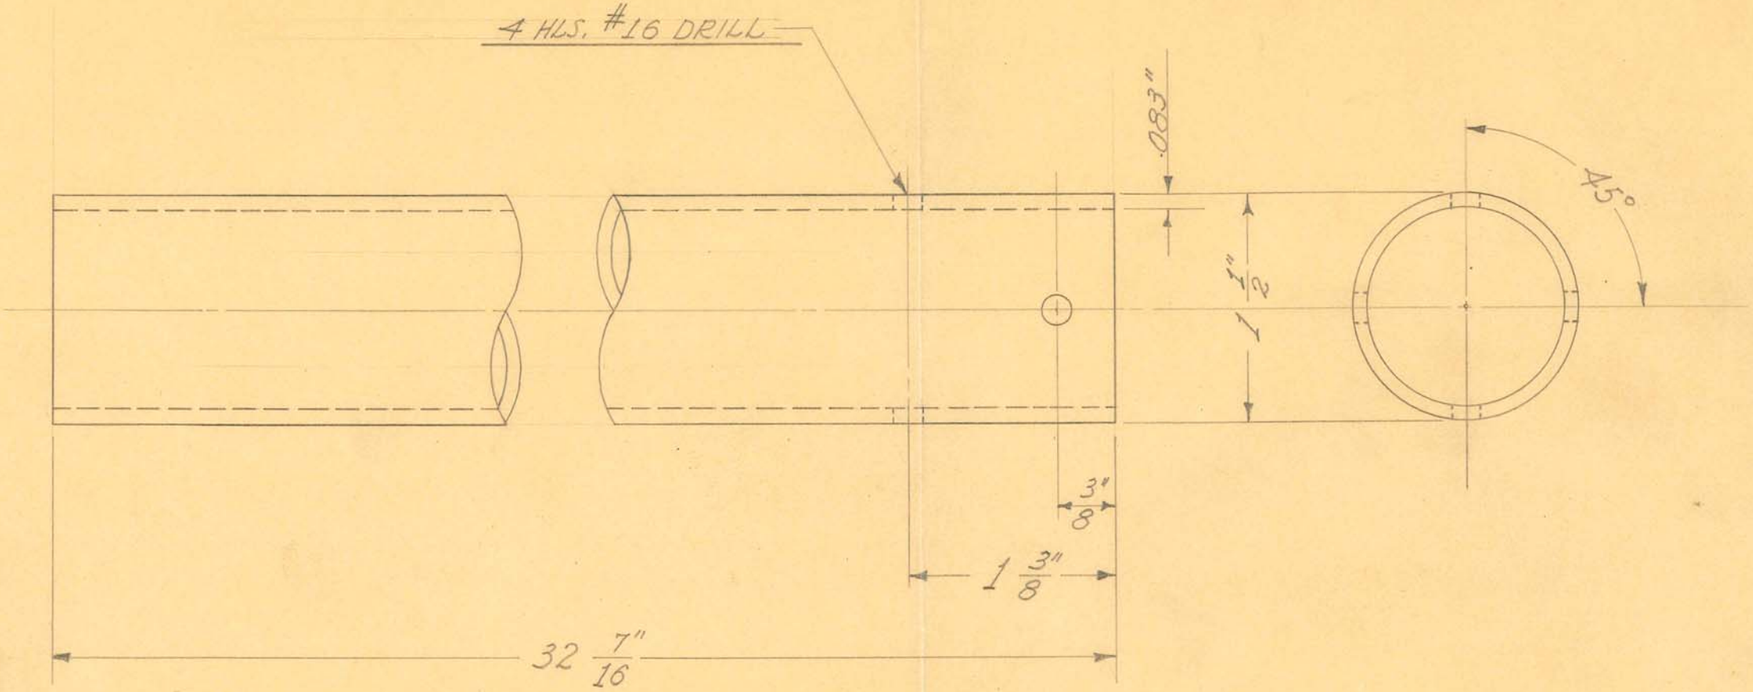

1 REQUIRED

OBSOLETE

SIZE	1½" O.D. X #14 GA.	ISSUE 10-4-37	J.W.
KIND	SEAMLESS - STEEL	CHANGED	
SHAPE	TUBING	"	
FINISH	CHROME #2	"	
TEMP.		"	
PATT.		"	

TITLE:
UNIV. "60-68" TUBE STAND SCREEN SIDE HORIZONTAL TUBE — FINISHED

H. G. FISCHER & CO.
2335 WABANSIA AVE.
CHICAGO, ILL.

CAT. NO.

PART NO. 8215F

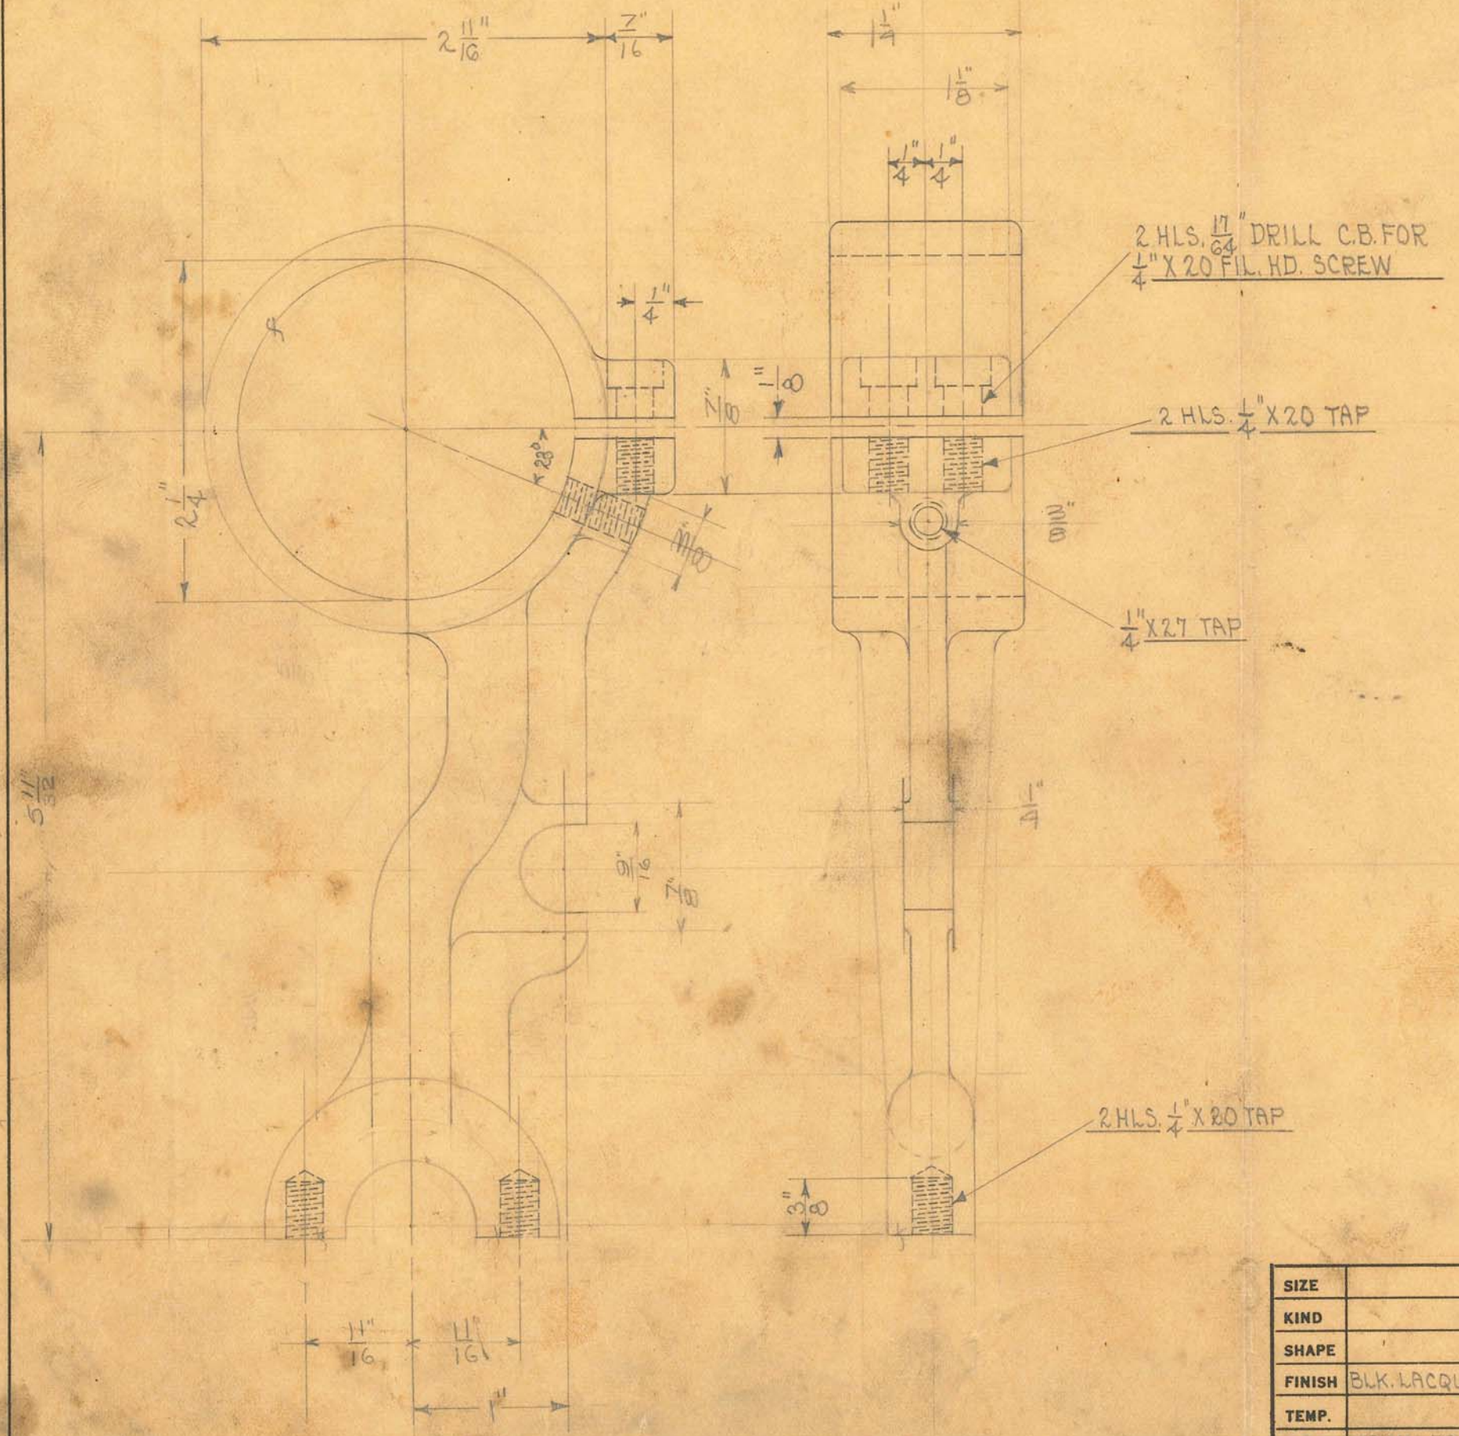

CAST IN ALUMINUM

1 - REQUIRED

See Tracing

OBSOLETE

SIZE		ISSUE		TITLE: UNIVERSAL "60-88" TUBE STAND HORIZONTAL TUBE GUIDE
KIND		CHANGED		
SHAPE		" "		
FINISH	BLK. LACQUER	" "		
TEMP.		" "		H. G. FISCHER & CO. 2335 WABANSIA AVE. CHICAGO, ILL. — CAT. NO. — PART NO. 8232F
PATT.	1810-596	" "		

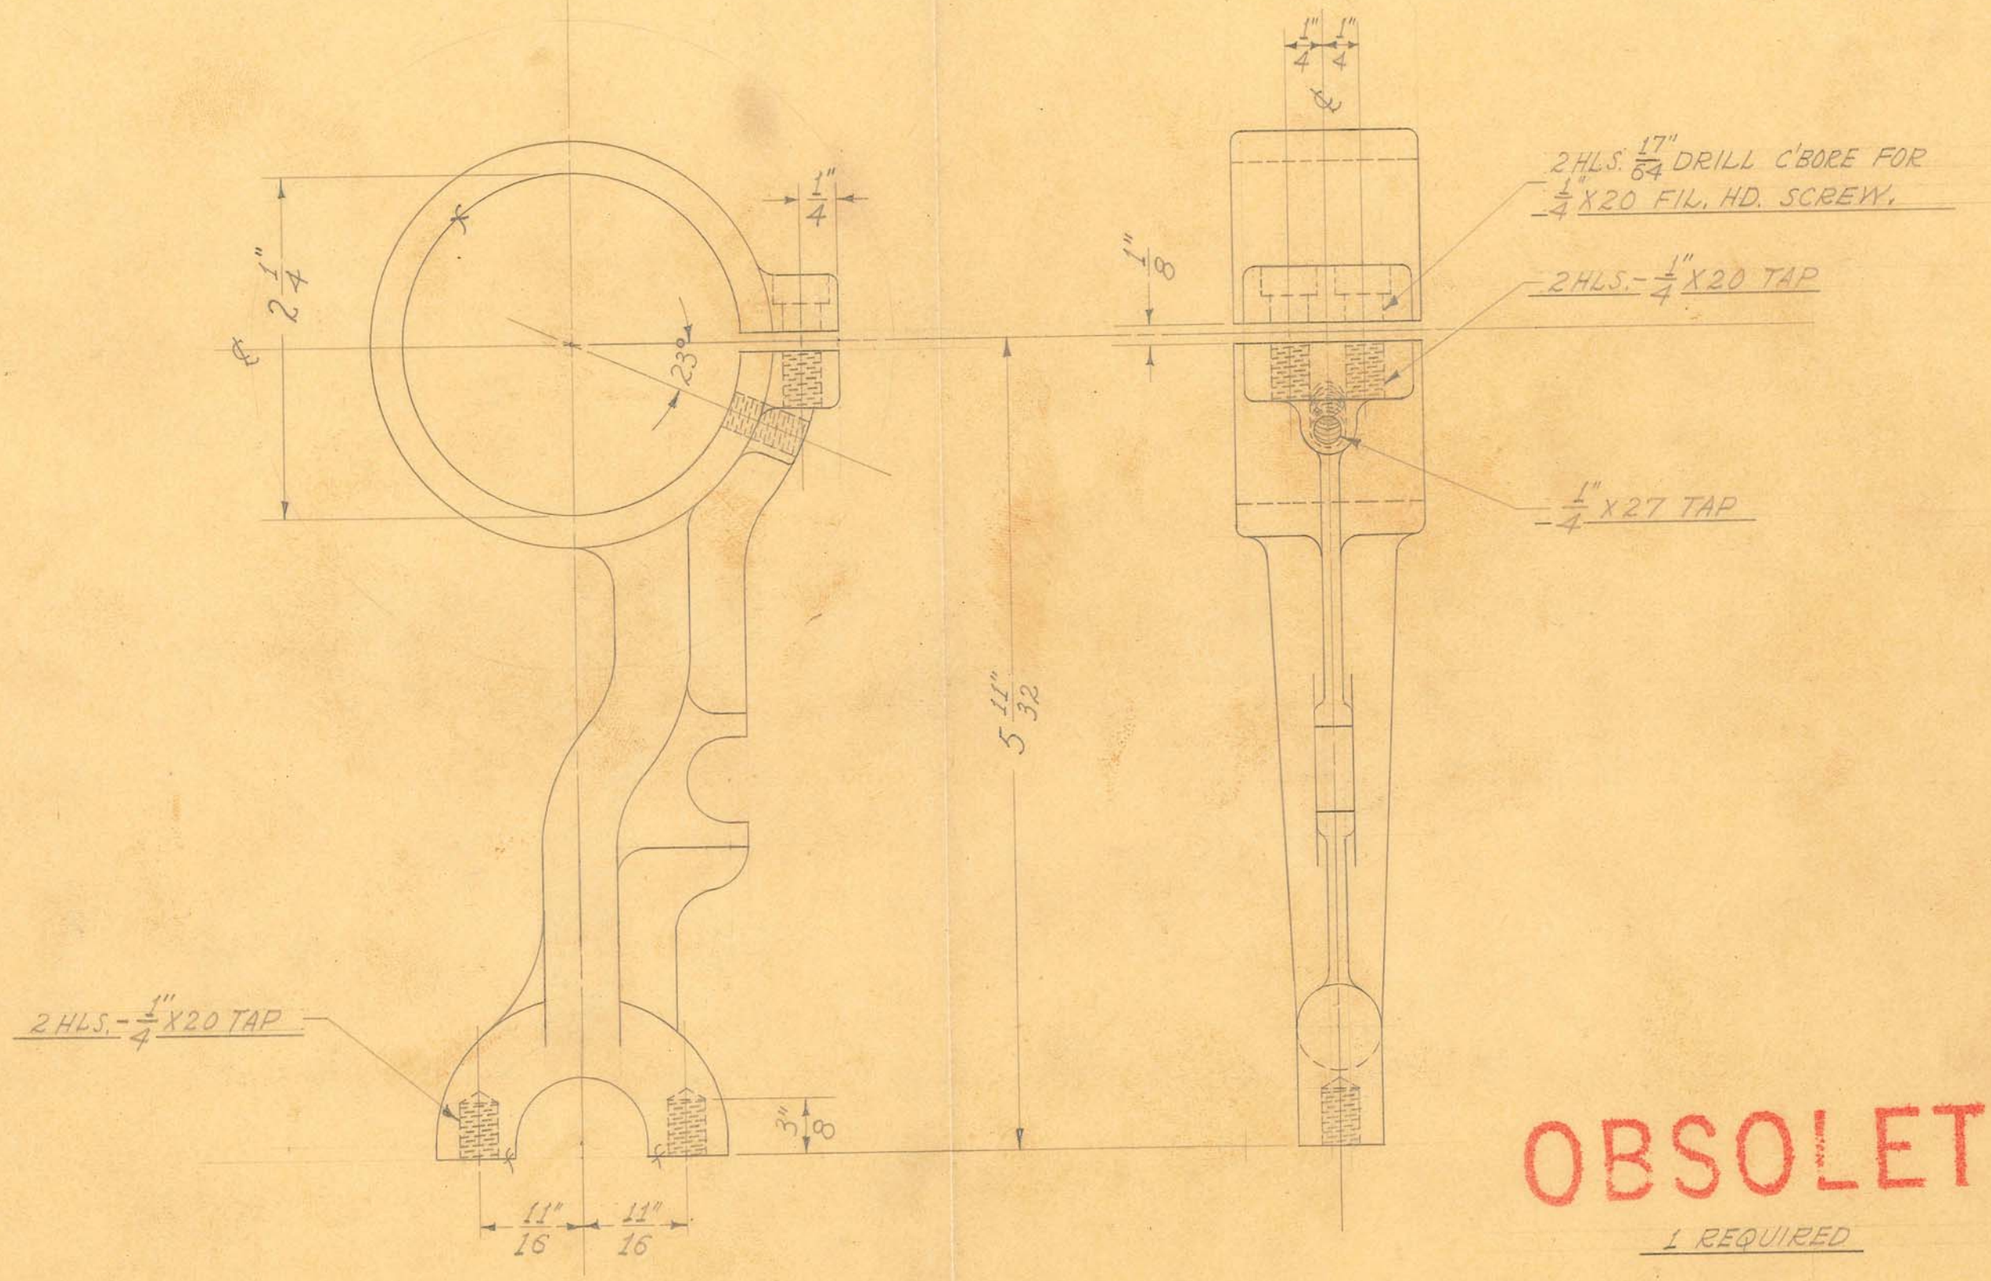

OBSOLETE

1 REQUIRED

SIZE		ISSUE	
KIND		CHANGED	
SHAPE		"	
FINISH	BLK. LACQUER	"	
TEMP.		"	
PATT.	1810-596	"	

TITLE: UNIVERSAL "60-88" TUBE STAND
HORIZONTAL TUBE GUIDE

H. G. FISCHER & CO.
2335 WABANSIA AVE.
CHICAGO, ILL.

CAT. NO.

PART NO. 8232F

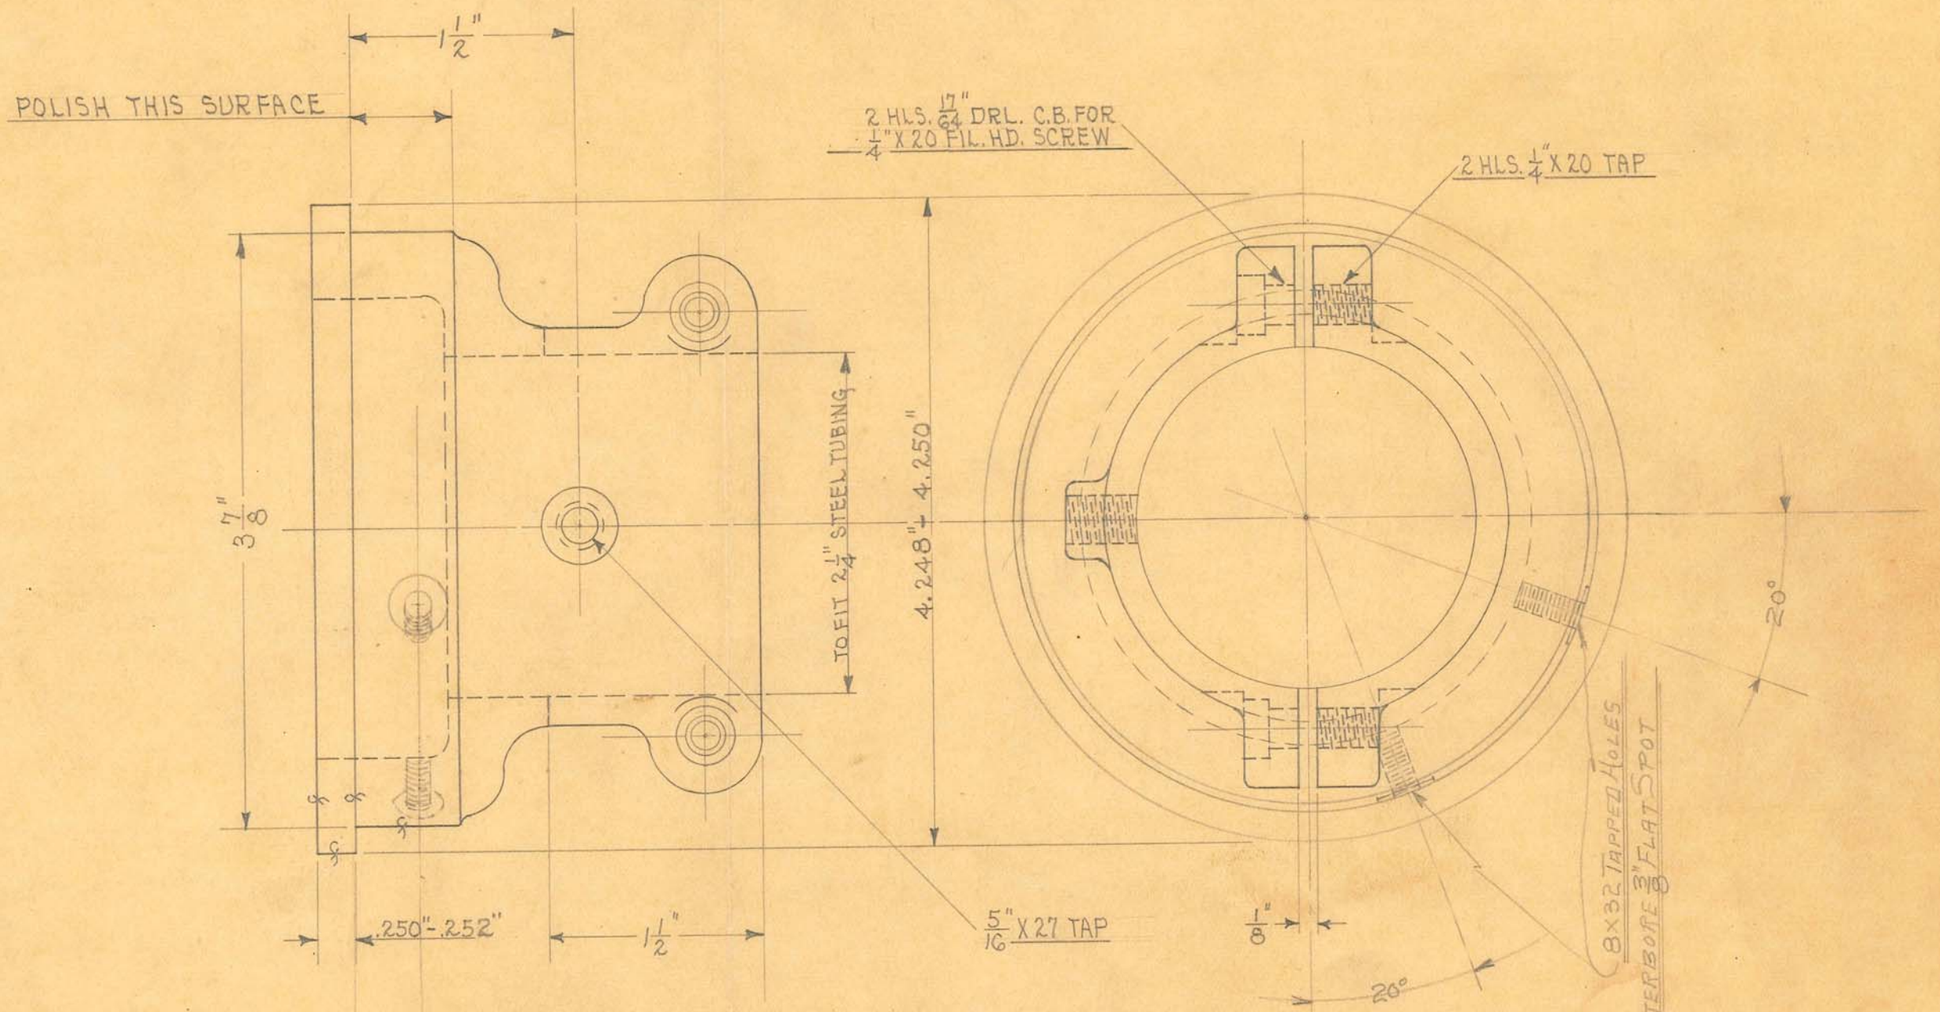

1 REQUIRED

OBSOLETE

SIZE		ISSUE 4-13-33	HE.
KIND	ALUM. CASTING	CHANGED	
SHAPE		" "	
FINISH	BLK. LACQUER	" "	
TEMP.		" "	
PATT.	1935-608	" "	

TITLE: UNIVERSAL "60-88" TUBE STAND HEAD SUPPORT

H. G. FISCHER & CO.
2335 WABANSIA AVE.
CHICAGO, ILL.

CAT. NO.

PART NO. 8238F

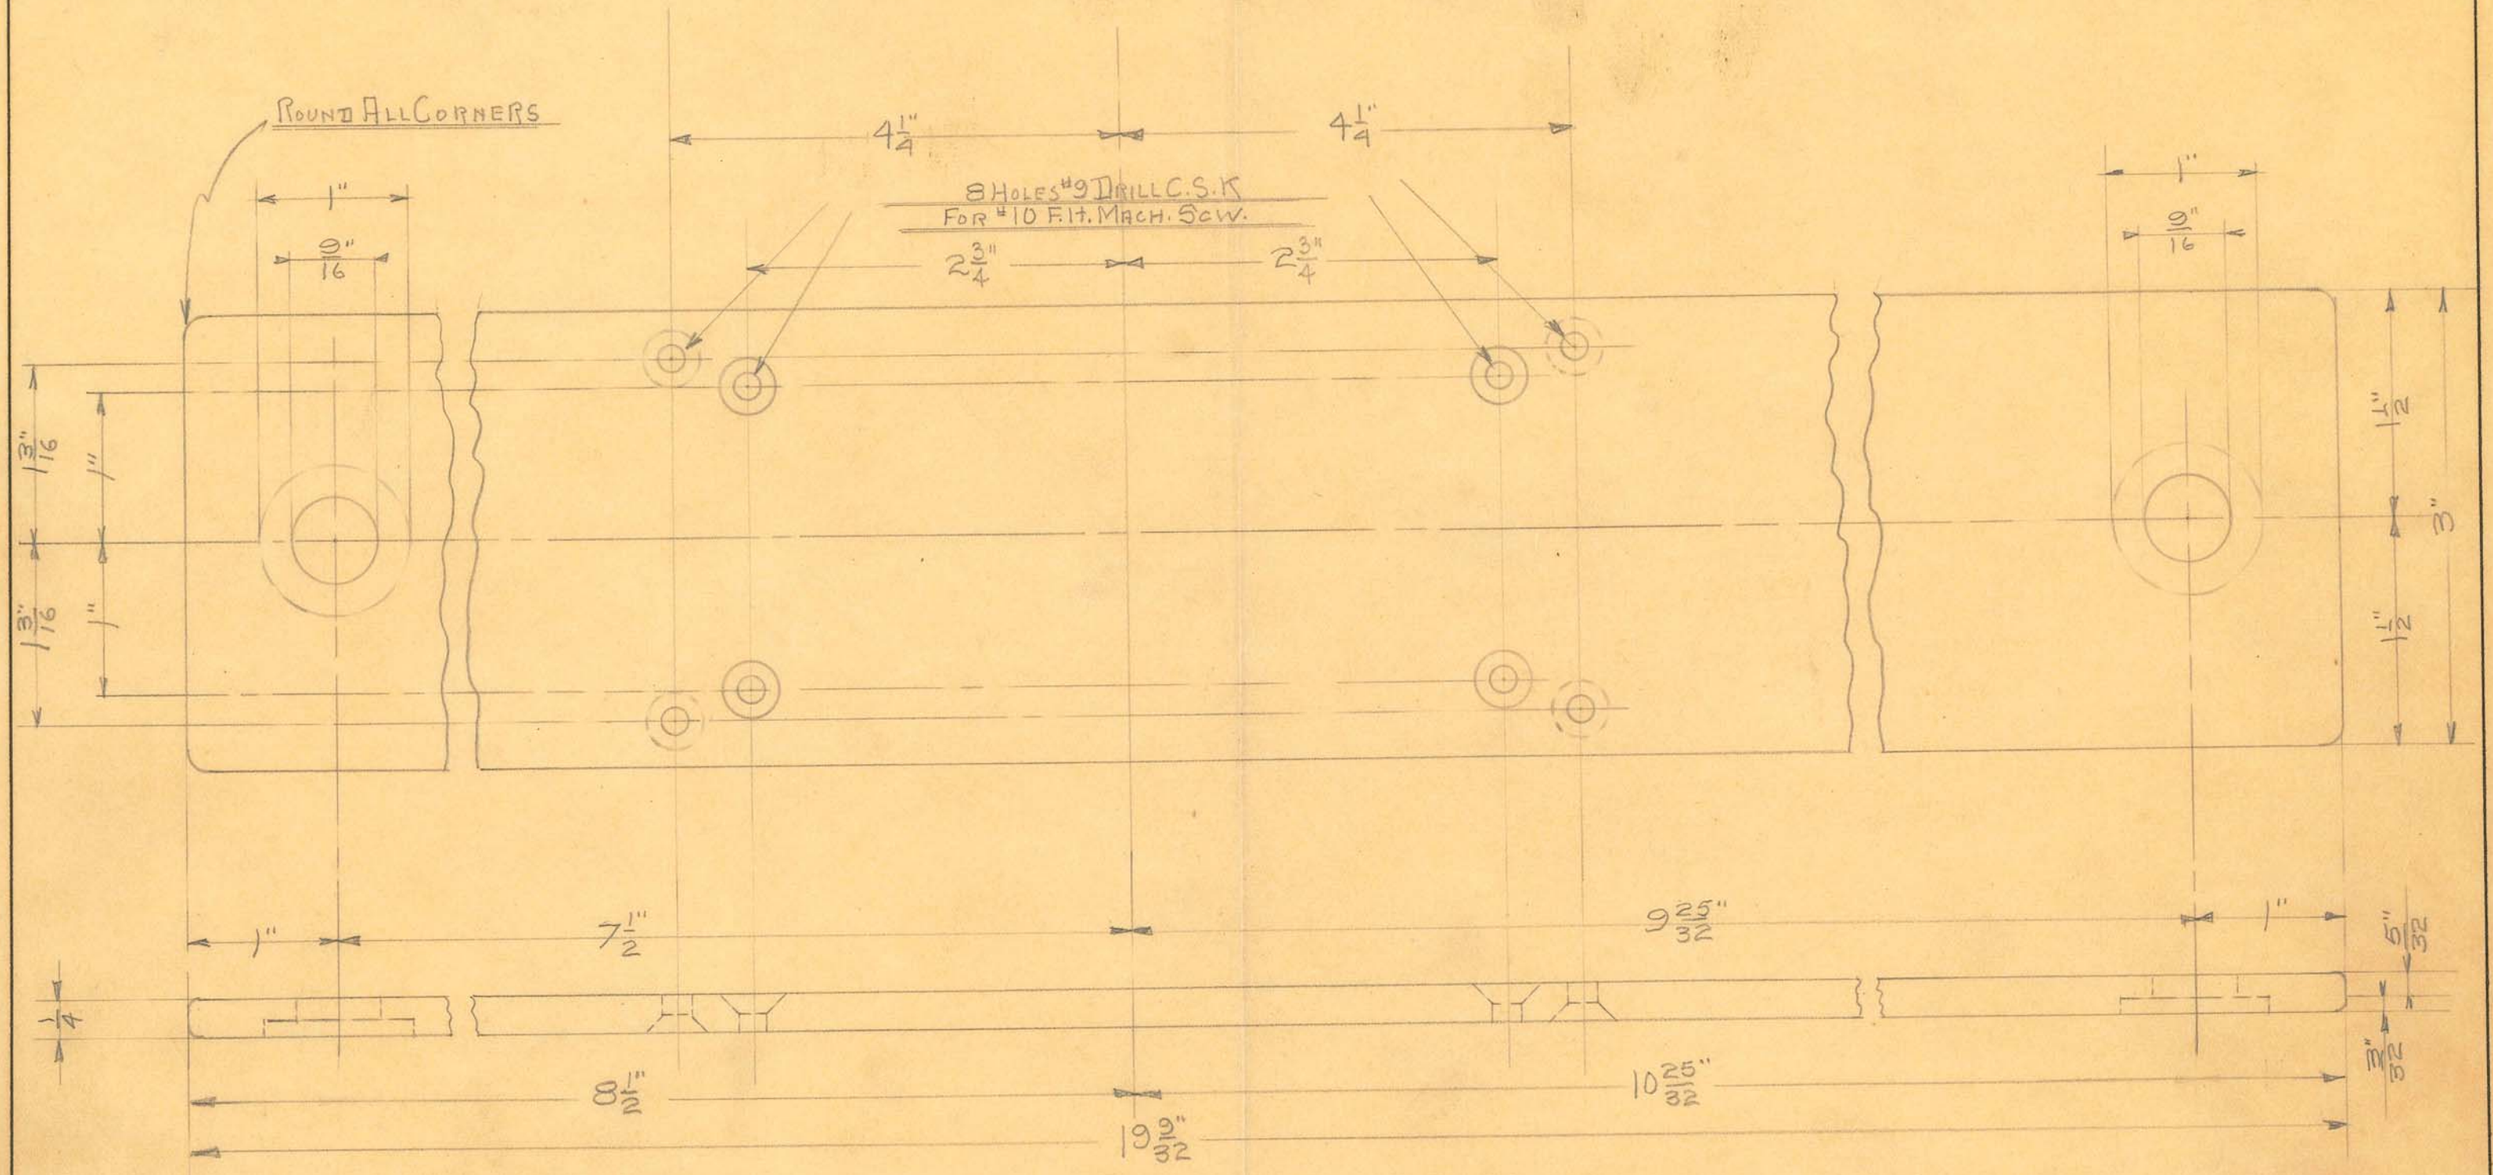

OBSOLETE

SIZE	1/4 SHEET	ISSUE 5-15-33		TITLE: UNIVERSAL 60-88 TUBE MOUNTING BASE
KIND	BAKELITE (RICHELAIN)	CHANGED		
SHAPE		" "		
FINISH		" "		
TEMP.		" "		H. G. FISCHER & CO. 2335 WABANSIA AVE. CHICAGO, ILL. — CAT. NO. — PART NO. 8249
PATT.		" "		

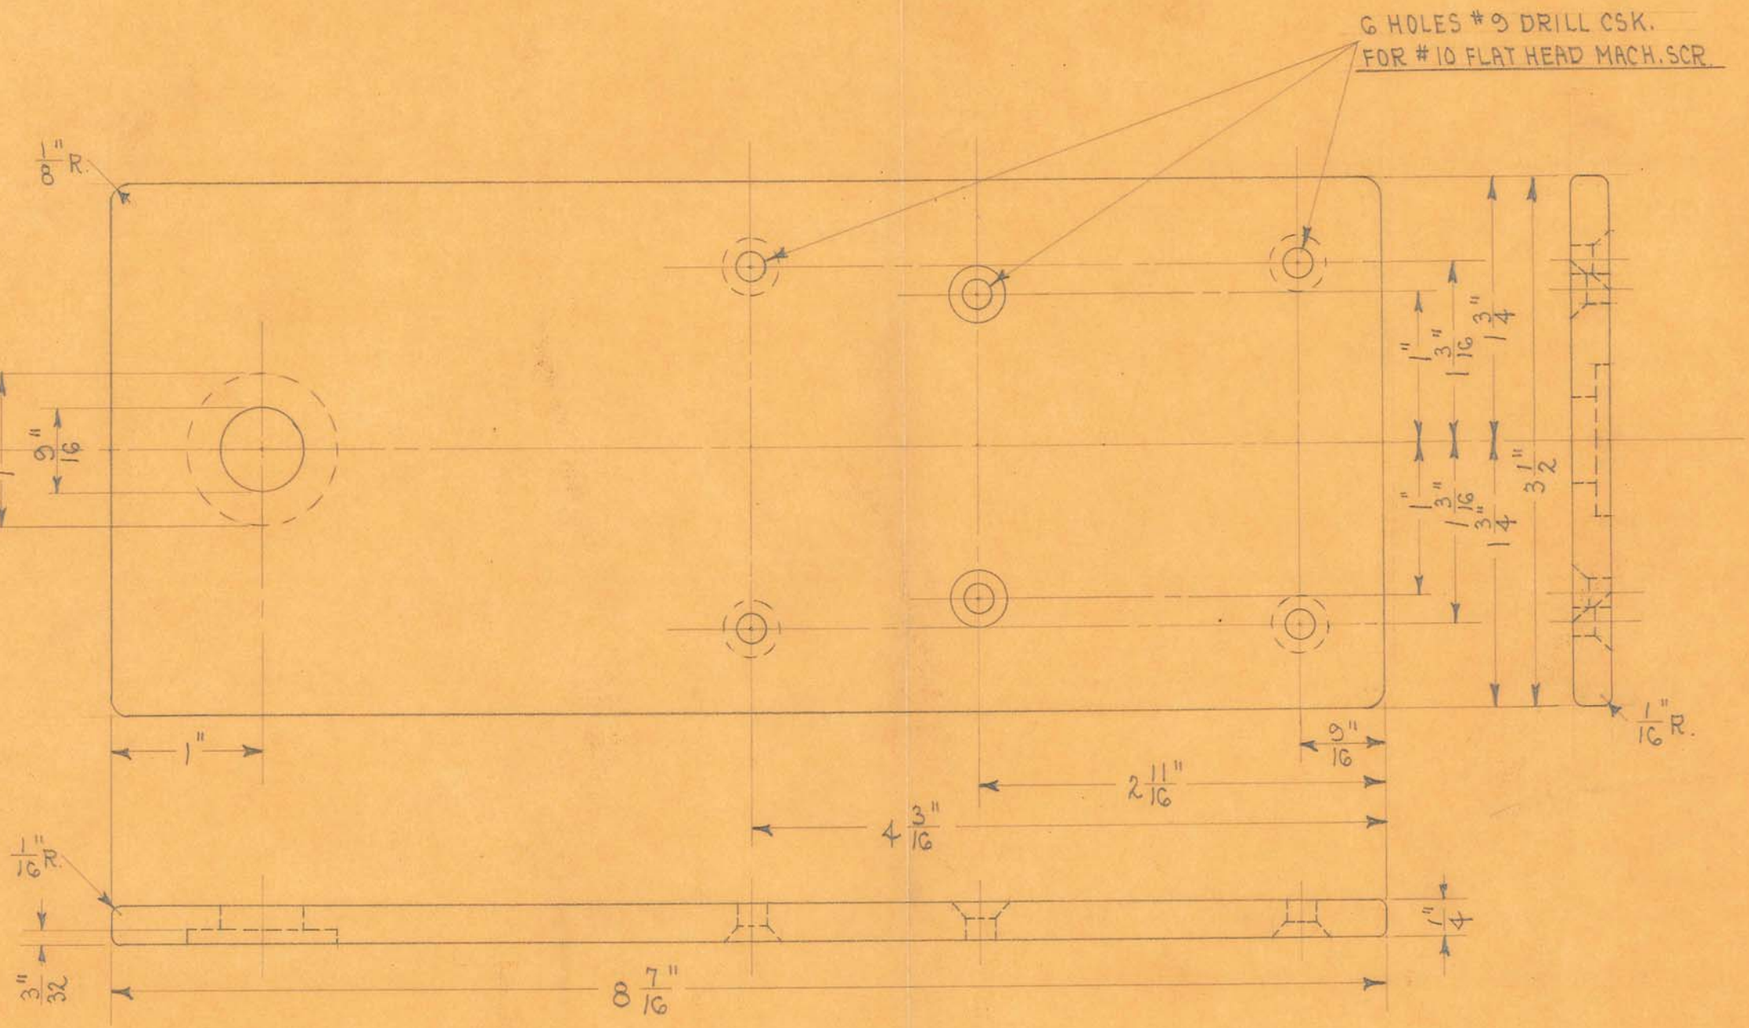

1 REQUIRED
ROUND ALL CORNERS AS SHOWN

OBSOLETE

SIZE	1/4" SHEET	ISSUE 10-11-35	A.E
KIND	MICALEX	CHANGED	
SHAPE		" "	
FINISH		" "	
TEMP.		" "	
PATT.		" "	

TITLE: "CO-88" TUBE MOUNTING BASE - ANODE END

H. G. FISCHER & CO.
2335 WABANSIA AVE.
CHICAGO, ILL.

CAT. NO.

PART NO. 8249 1/4

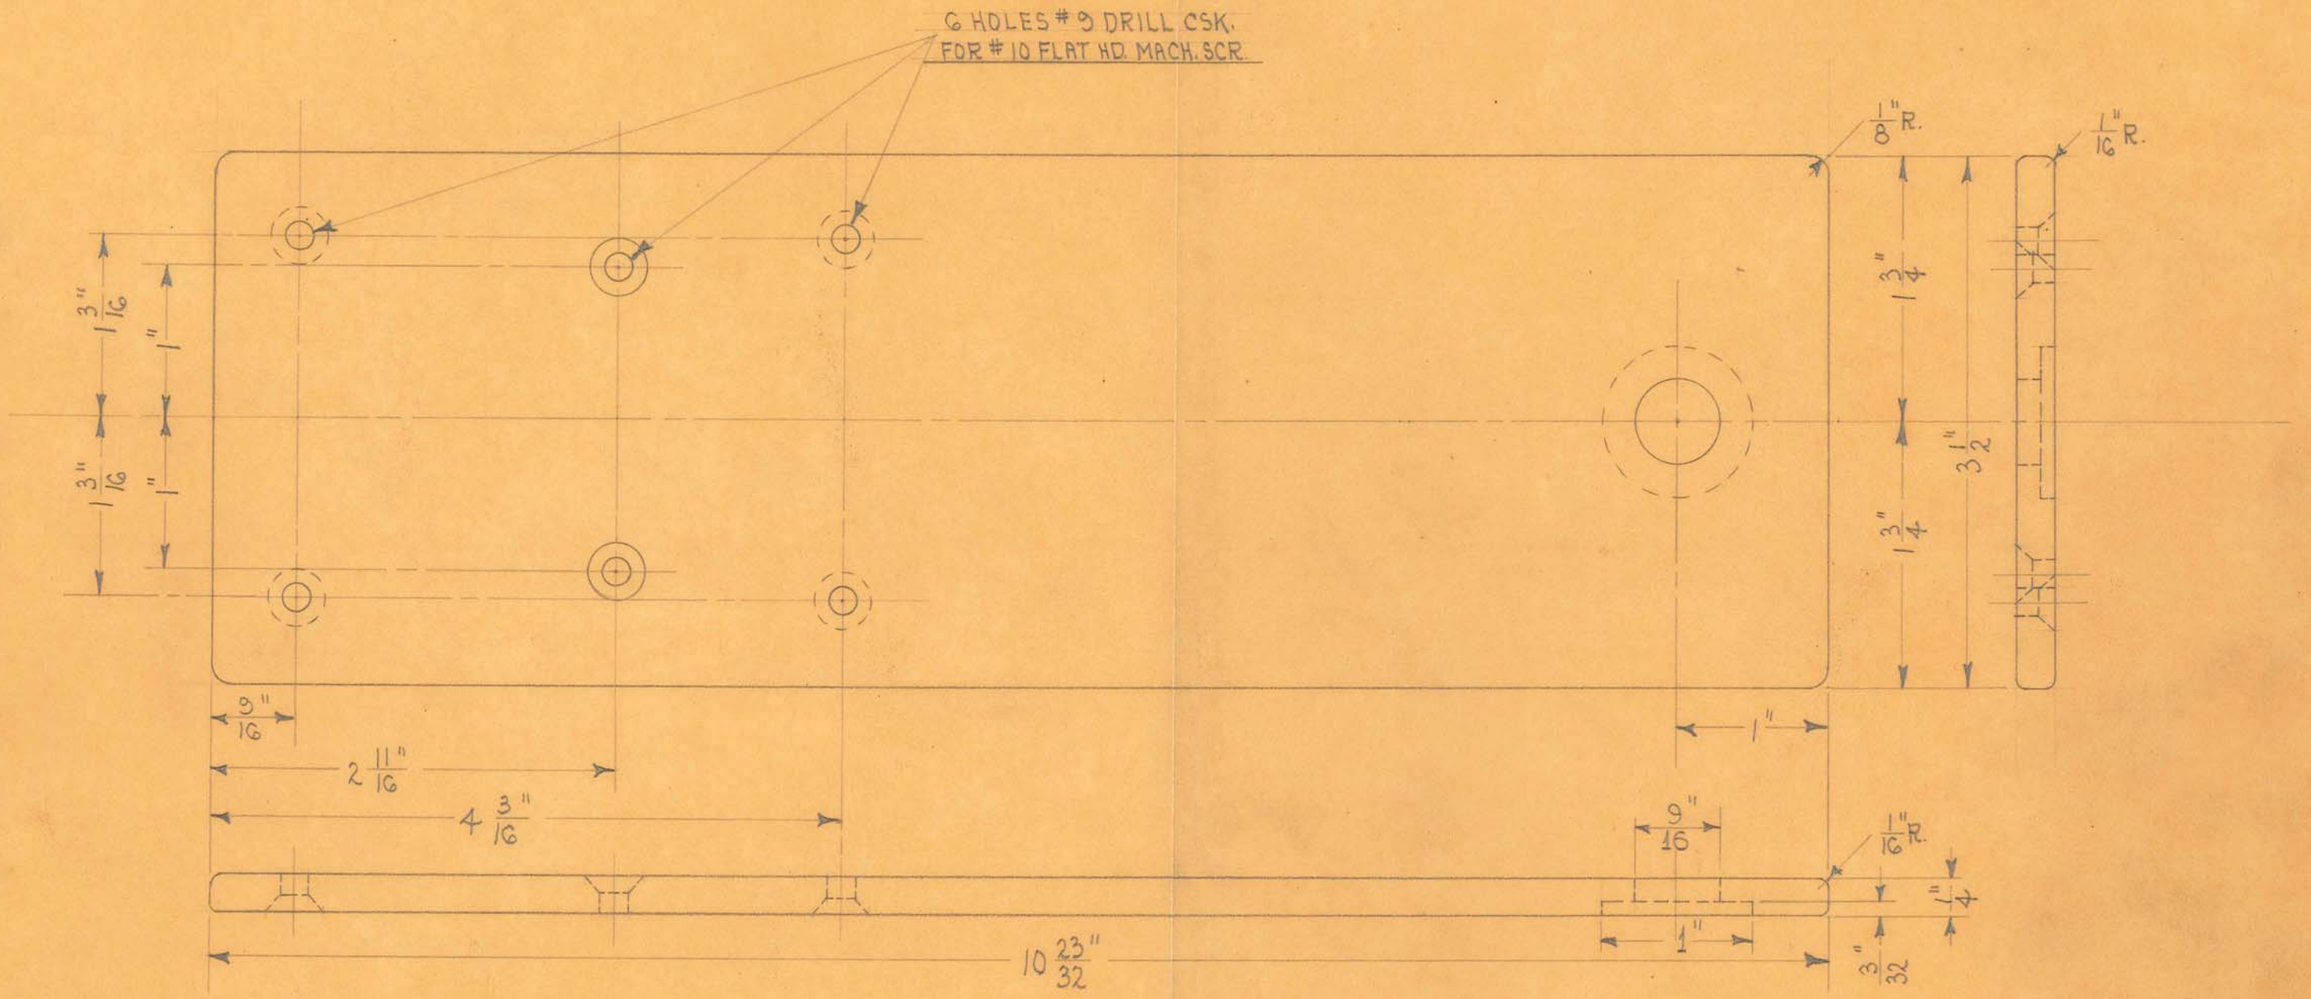

1 REQUIRED

ROUND ALL CORNERS AS SHOWN

SIZE	1/4" SHEET	ISSUE 10-11-35	A.E.
KIND	MICALEX	CHANGED	
SHAPE		" "	
FINISH		" "	
TEMP.		" "	
PATT.		" "	

TITLE: "CO-88" TUBE MOUNTING BASE-CATHODE END

OBSOLETE

H. G. FISCHER & CO.
2335 WABANSIA AVE.
CHICAGO, ILL.

CAT. NO.

PART NO. 8249 1/2

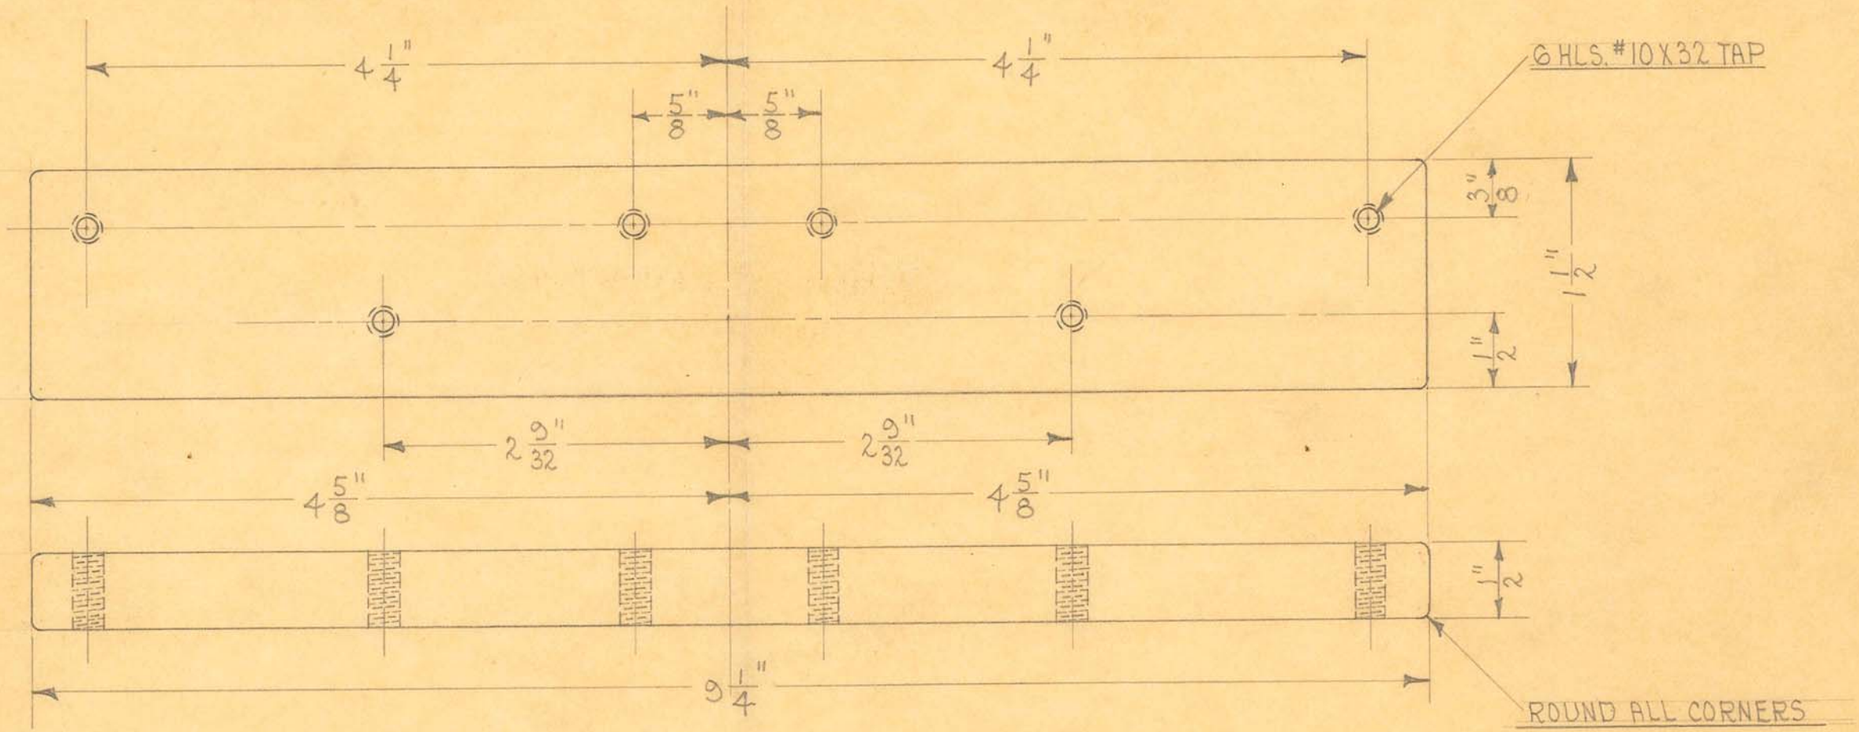

2 REQUIRED

OBSOLETE

SIZE	1/2" SHEET	ISSUE 3-17-36	A.E.
KIND	BAKELITE	CHANGED	
SHAPE		" "	
FINISH		" "	
TEMP.		" "	
PATT.		" "	

TITLE: "60-88" TUBE STAND TUBE MOUNTING SUPPORT STRIP

H. G. FISCHER & CO.
2335 WABANSIA AVE.
CHICAGO, ILL.

CAT. NO.

PART NO. 8250 1/2

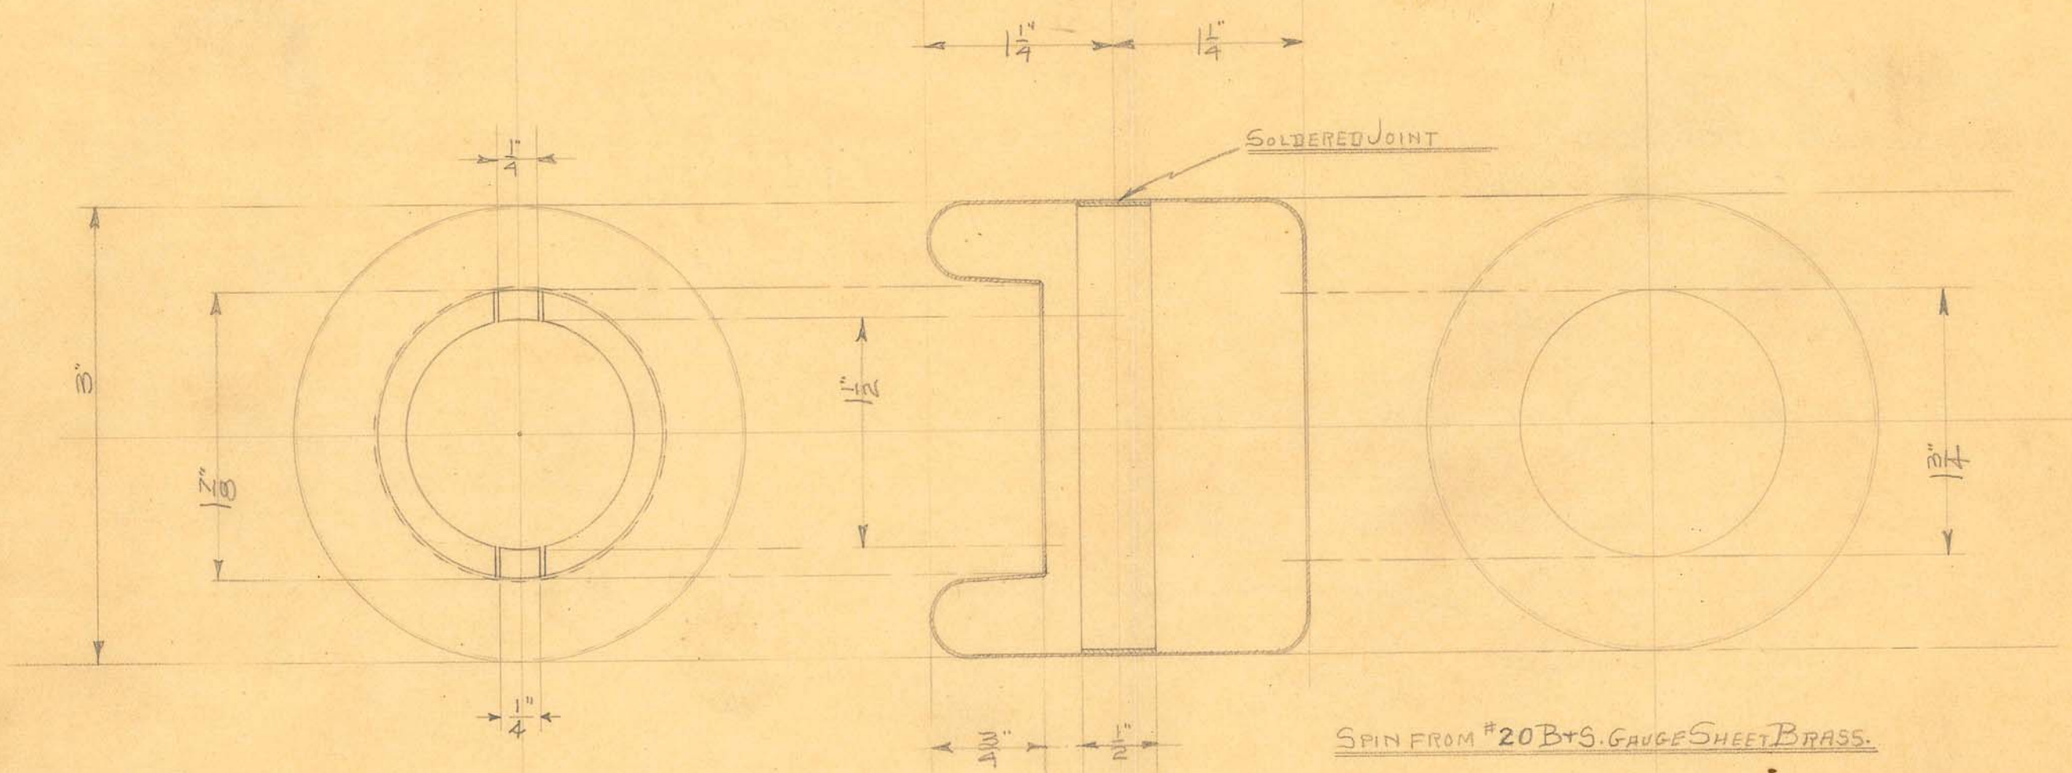

SPIN FROM #20 B+S. GAUGE SHEET BRASS.

OBSOLETE

SIZE		ISSUE	
KIND		CHANGED	
SHAPE		" "	
FINISH	BLACK #80	" "	
TEMP.		" "	
PATT.		" "	

TITLE: UNIVERSAL "GO-88" TUBE STAND
TUBE SOCKET HOUSING

H. G. FISCHER & CO.
2335 WABANSIA AVE.
CHICAGO, ILL.

CAT. NO.

PART NO. 8258F

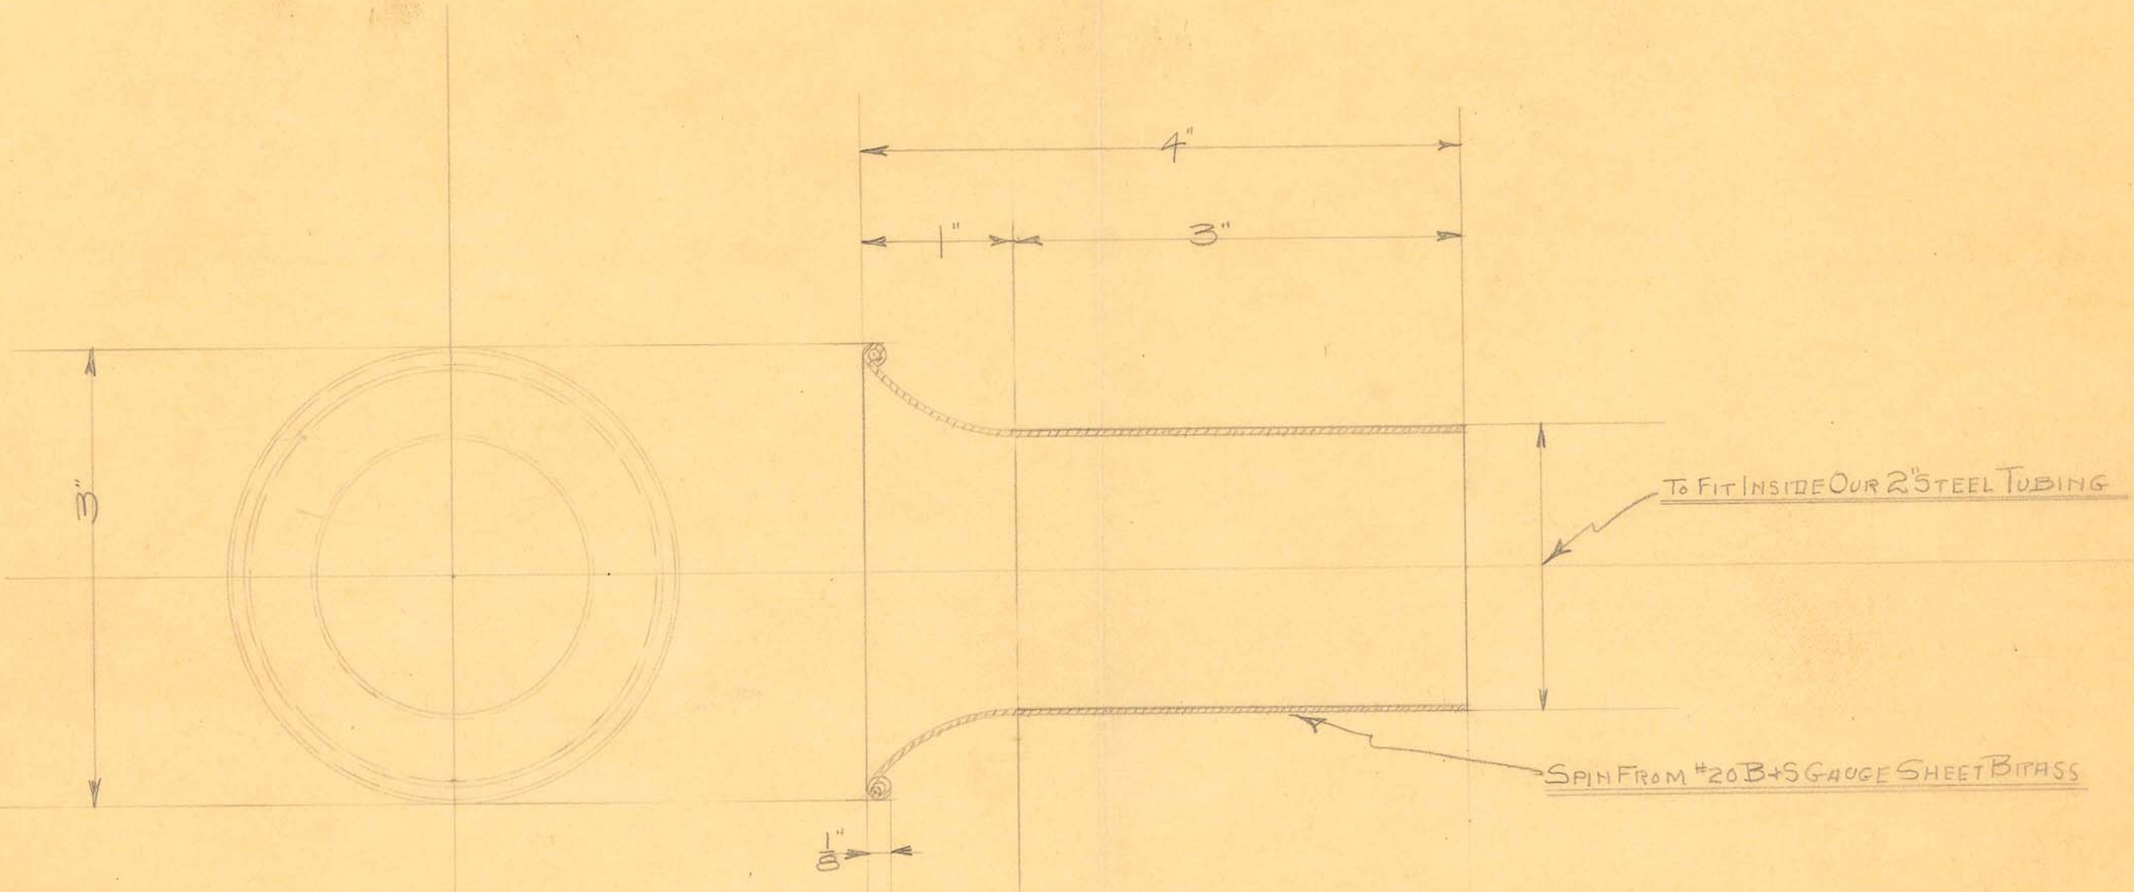

OBSOLETE

SIZE		ISSUE	
KIND		CHANGED	
SHAPE		" "	
FINISH		" "	
TEMP.		" "	
PATT.		" "	

TITLE: UNIVERSAL "60-88" TUBE STAND
TUBE HEAD CABLE POT-HEAD

H. G. FISCHER & CO.
2335 WABANSIA AVE.
CHICAGO, ILL.

CAT. NO.

PART NO. 8259

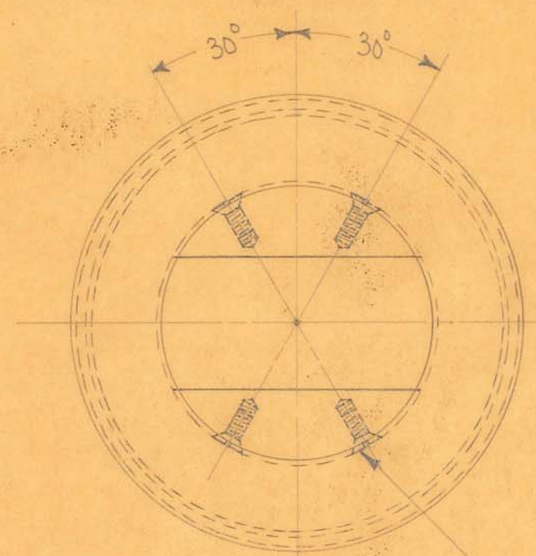

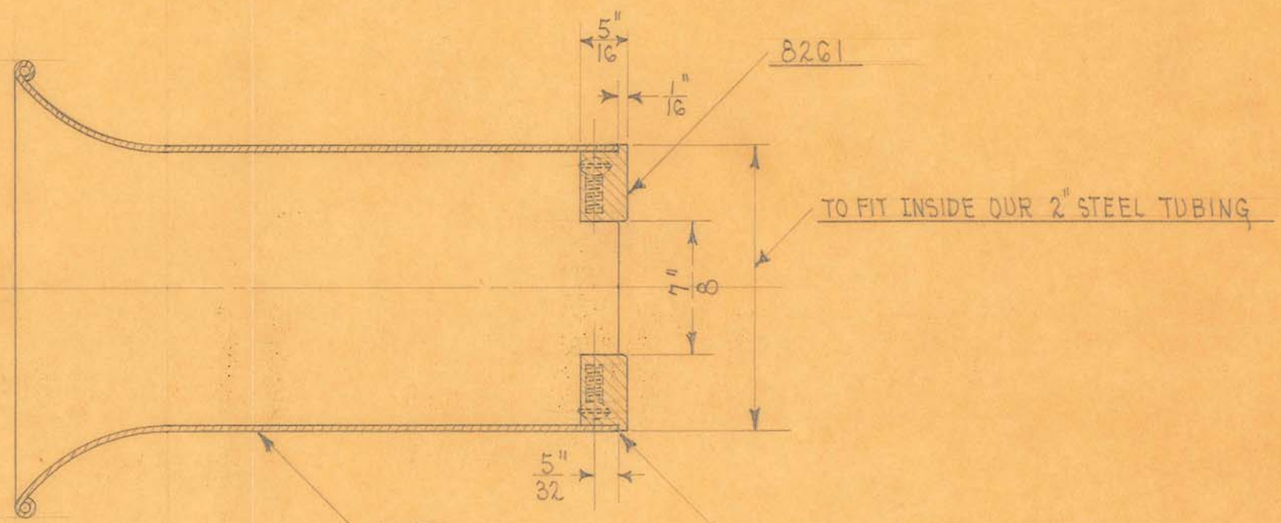

M414 F.H.I

SOLDERED

1 REQUIRED

OBSOLETE

SIZE		ISSUE 3-9-35	J.E.
KIND		CHANGED	
SHAPE		" "	
FINISH		" "	
TEMP.		" "	
PATT.		" "	

TITLE:
UNIVERSAL "60-88" TUBE STAND
TUBE HEAD CABLE POT-HEAD ASSEM.

H. G. FISCHER & CO.
2335 WABANSIA AVE.
CHICAGO, ILL.

CAT. NO.

PART NO. 8260G

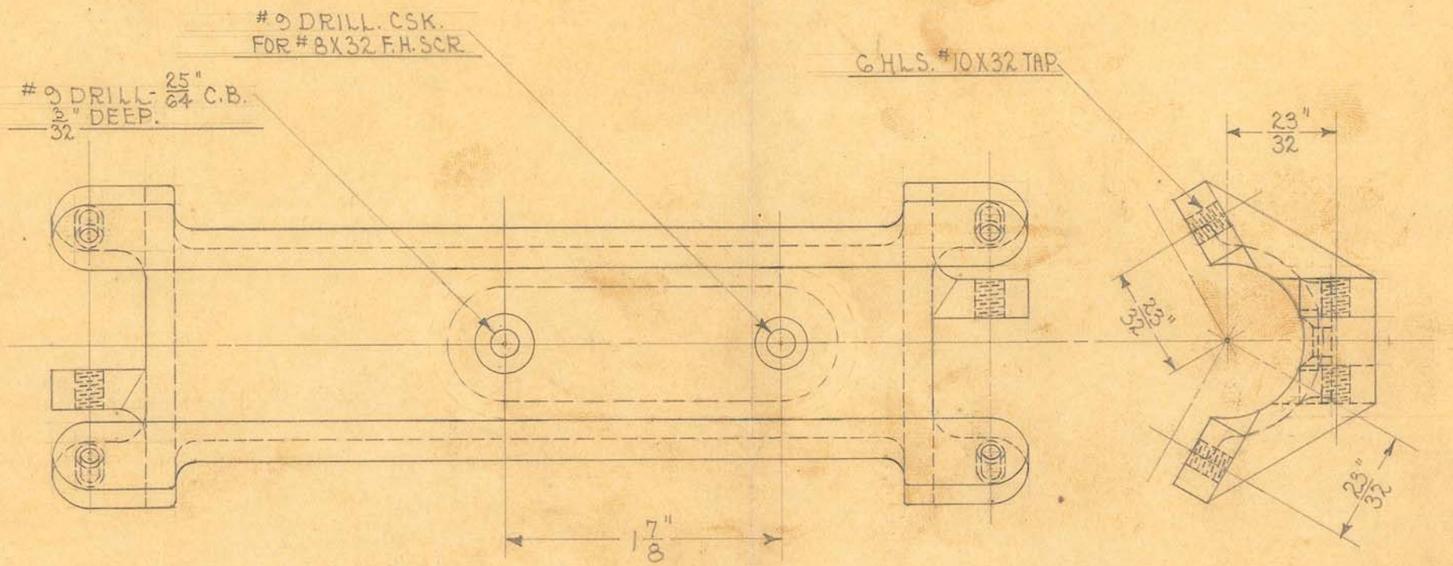

1 REQUIRED

OBSOLETE

SIZE		ISSUE 10-19-33	A.6	TITLE: UNIVERSAL "60-88" TUBE STAND HORIZ. TUBE BEARING
KIND	ALUM CASTING	CHANGED		
SHAPE		" "		
FINISH	BLK. LACQUER	" "		
TEMP.		" "		H. G. FISCHER & CO. 2335 WABANSIA AVE. CHICAGO, ILL. — CAT. NO. — PART NO. 8262F
PATT.	#2958-634	" "		

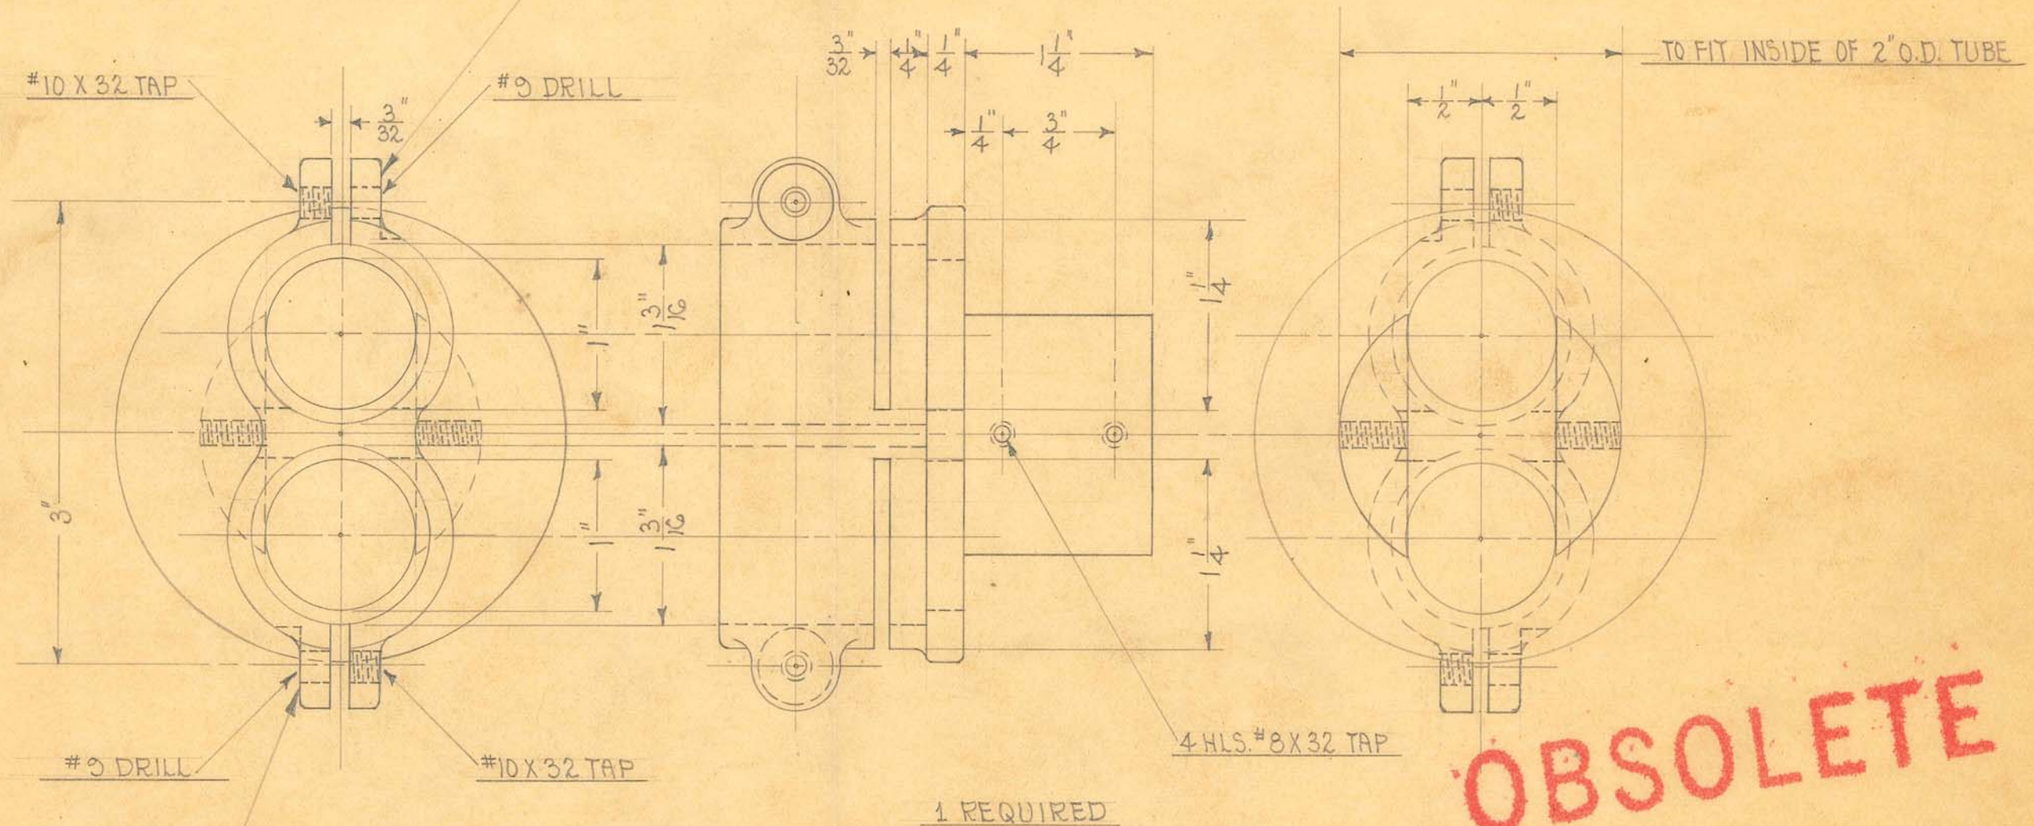

1 REQUIRED

FACE WITH 1/2" PILOT C'BORE.

OBSOLETE

SIZE		ISSUE 8-29-33	JE
KIND	ALUM. CASTING	CHANGED	
SHAPE		" "	
FINISH	BLK. LACQUER	" "	
TEMP.		" "	
PATT.	4243-G49	" "	

TITLE: UNIVERSAL "60-88" TUBE STAND CABLE COVER SUPPORT

H. G. FISCHER & CO.
2335 WABANSIA AVE.
CHICAGO, ILL.

CAT. NO.

PART NO. 8263F

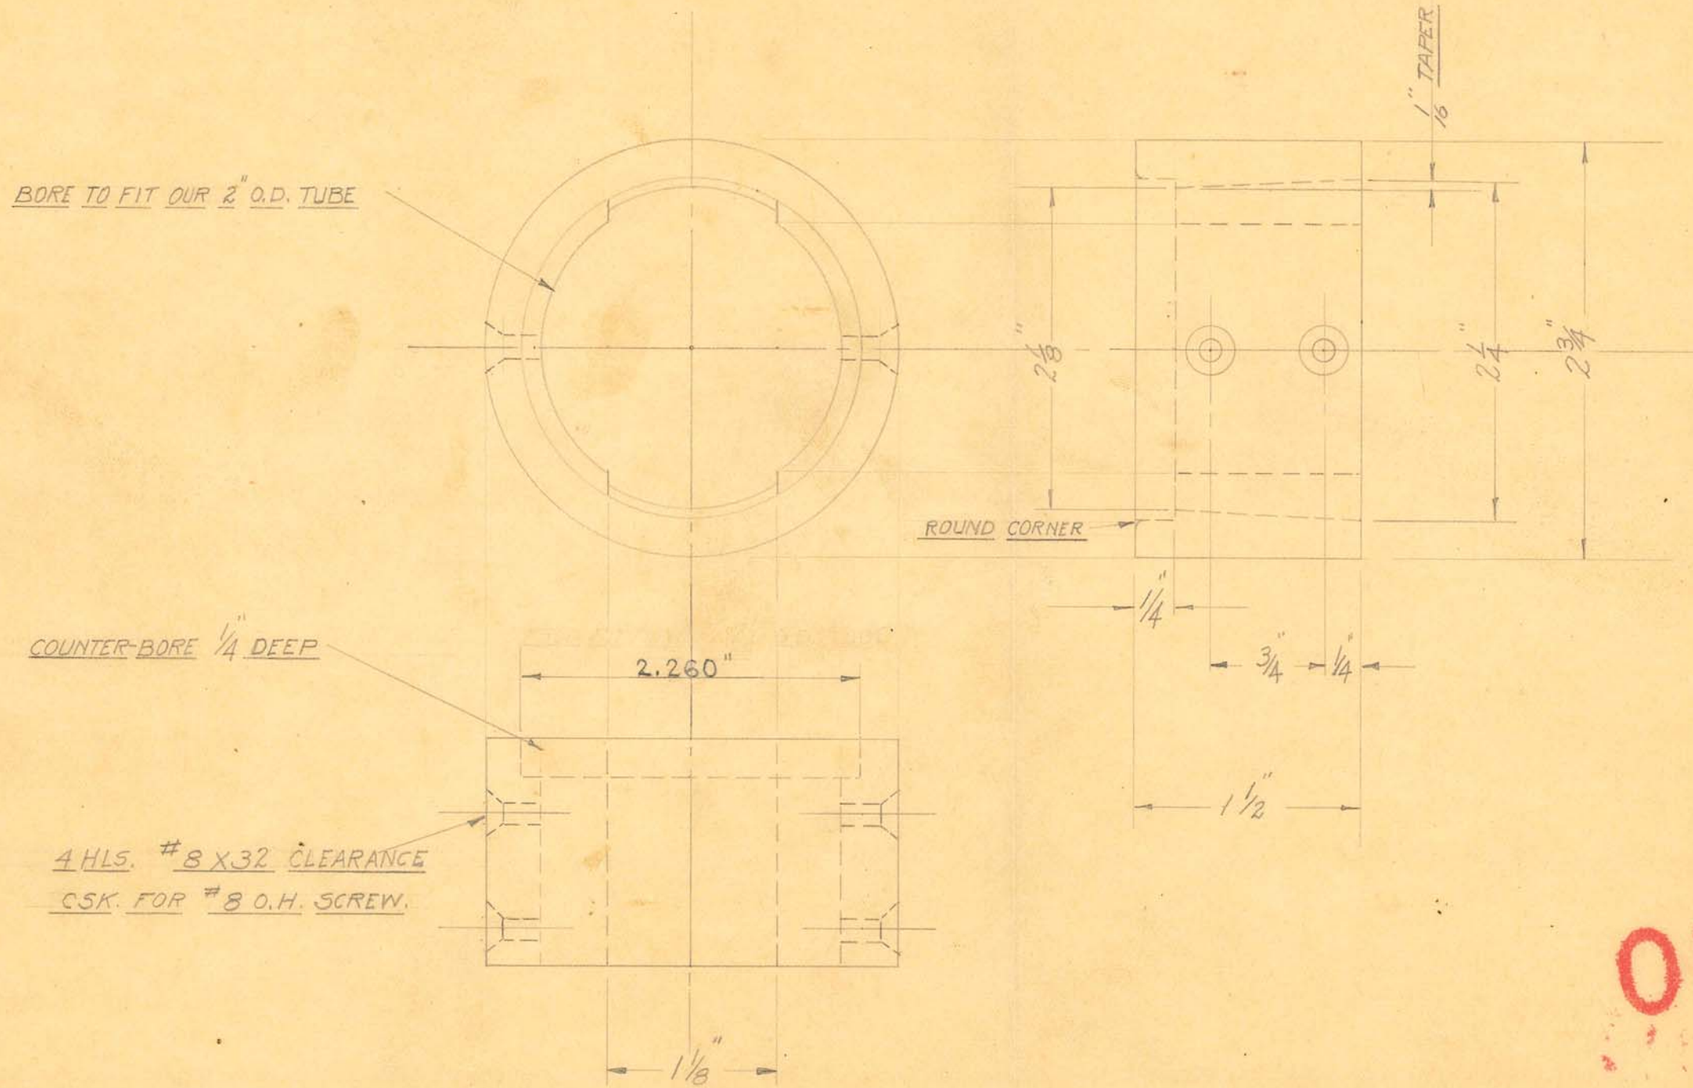

OBSOLETE

SIZE	2 3/4 O.D.	ISSUE	N.P.
KIND	ALUM. CASTING	CHANGED	
SHAPE		" "	
FINISH	BLK. LACQUER	" "	
TEMP.		" "	
PATT.	4244-650	" "	

TITLE: UNIVERSAL "60-88" TUBE STAND CABLE SUPPORT RING CASTING.

H. G. FISCHER & CO.
2335 WABANSIA AVE.
CHICAGO, ILL.

CAT. NO.

PART NO. 8264F

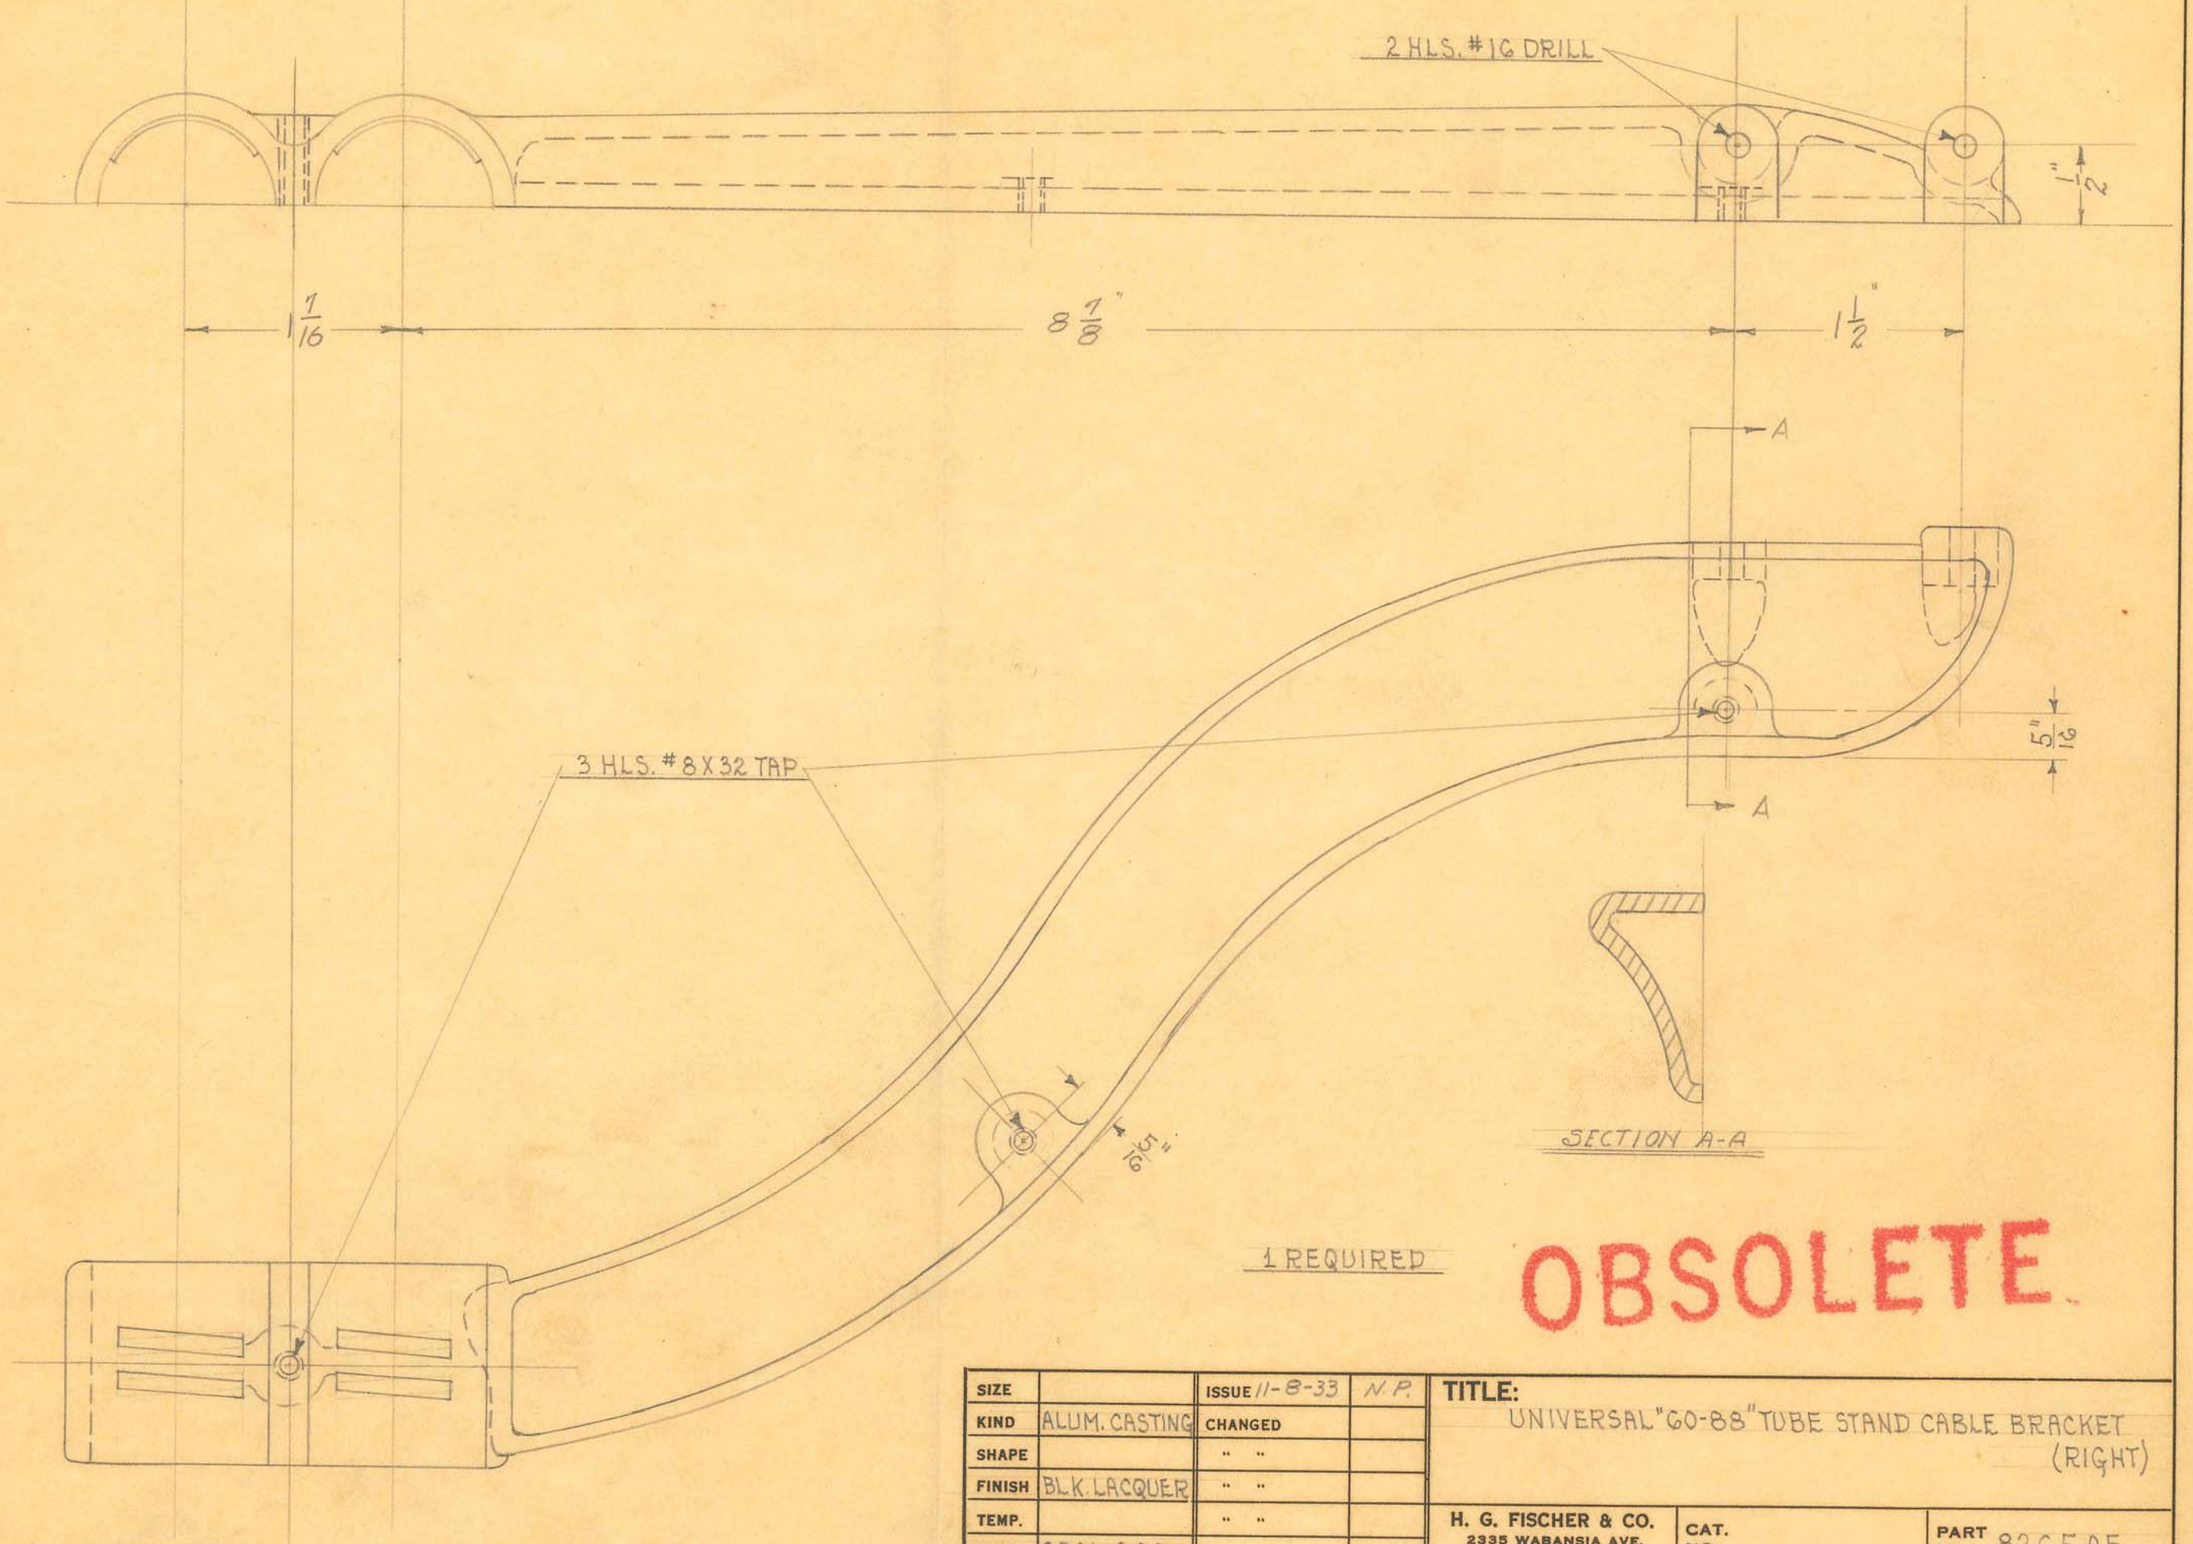

1 REQUIRED

OBSOLETE

SIZE		ISSUE 11-8-33	N.P.
KIND	ALUM. CASTING	CHANGED	
SHAPE		" "	
FINISH	BLK. LACQUER	" "	
TEMP.		" "	
PATT.	6261-6609	" "	

TITLE: UNIVERSAL "60-88" TUBE STAND CABLE BRACKET (RIGHT)

H. G. FISCHER & CO.
2335 WABANSIA AVE.
CHICAGO, ILL.

CAT. NO.

PART NO. 8265 AF

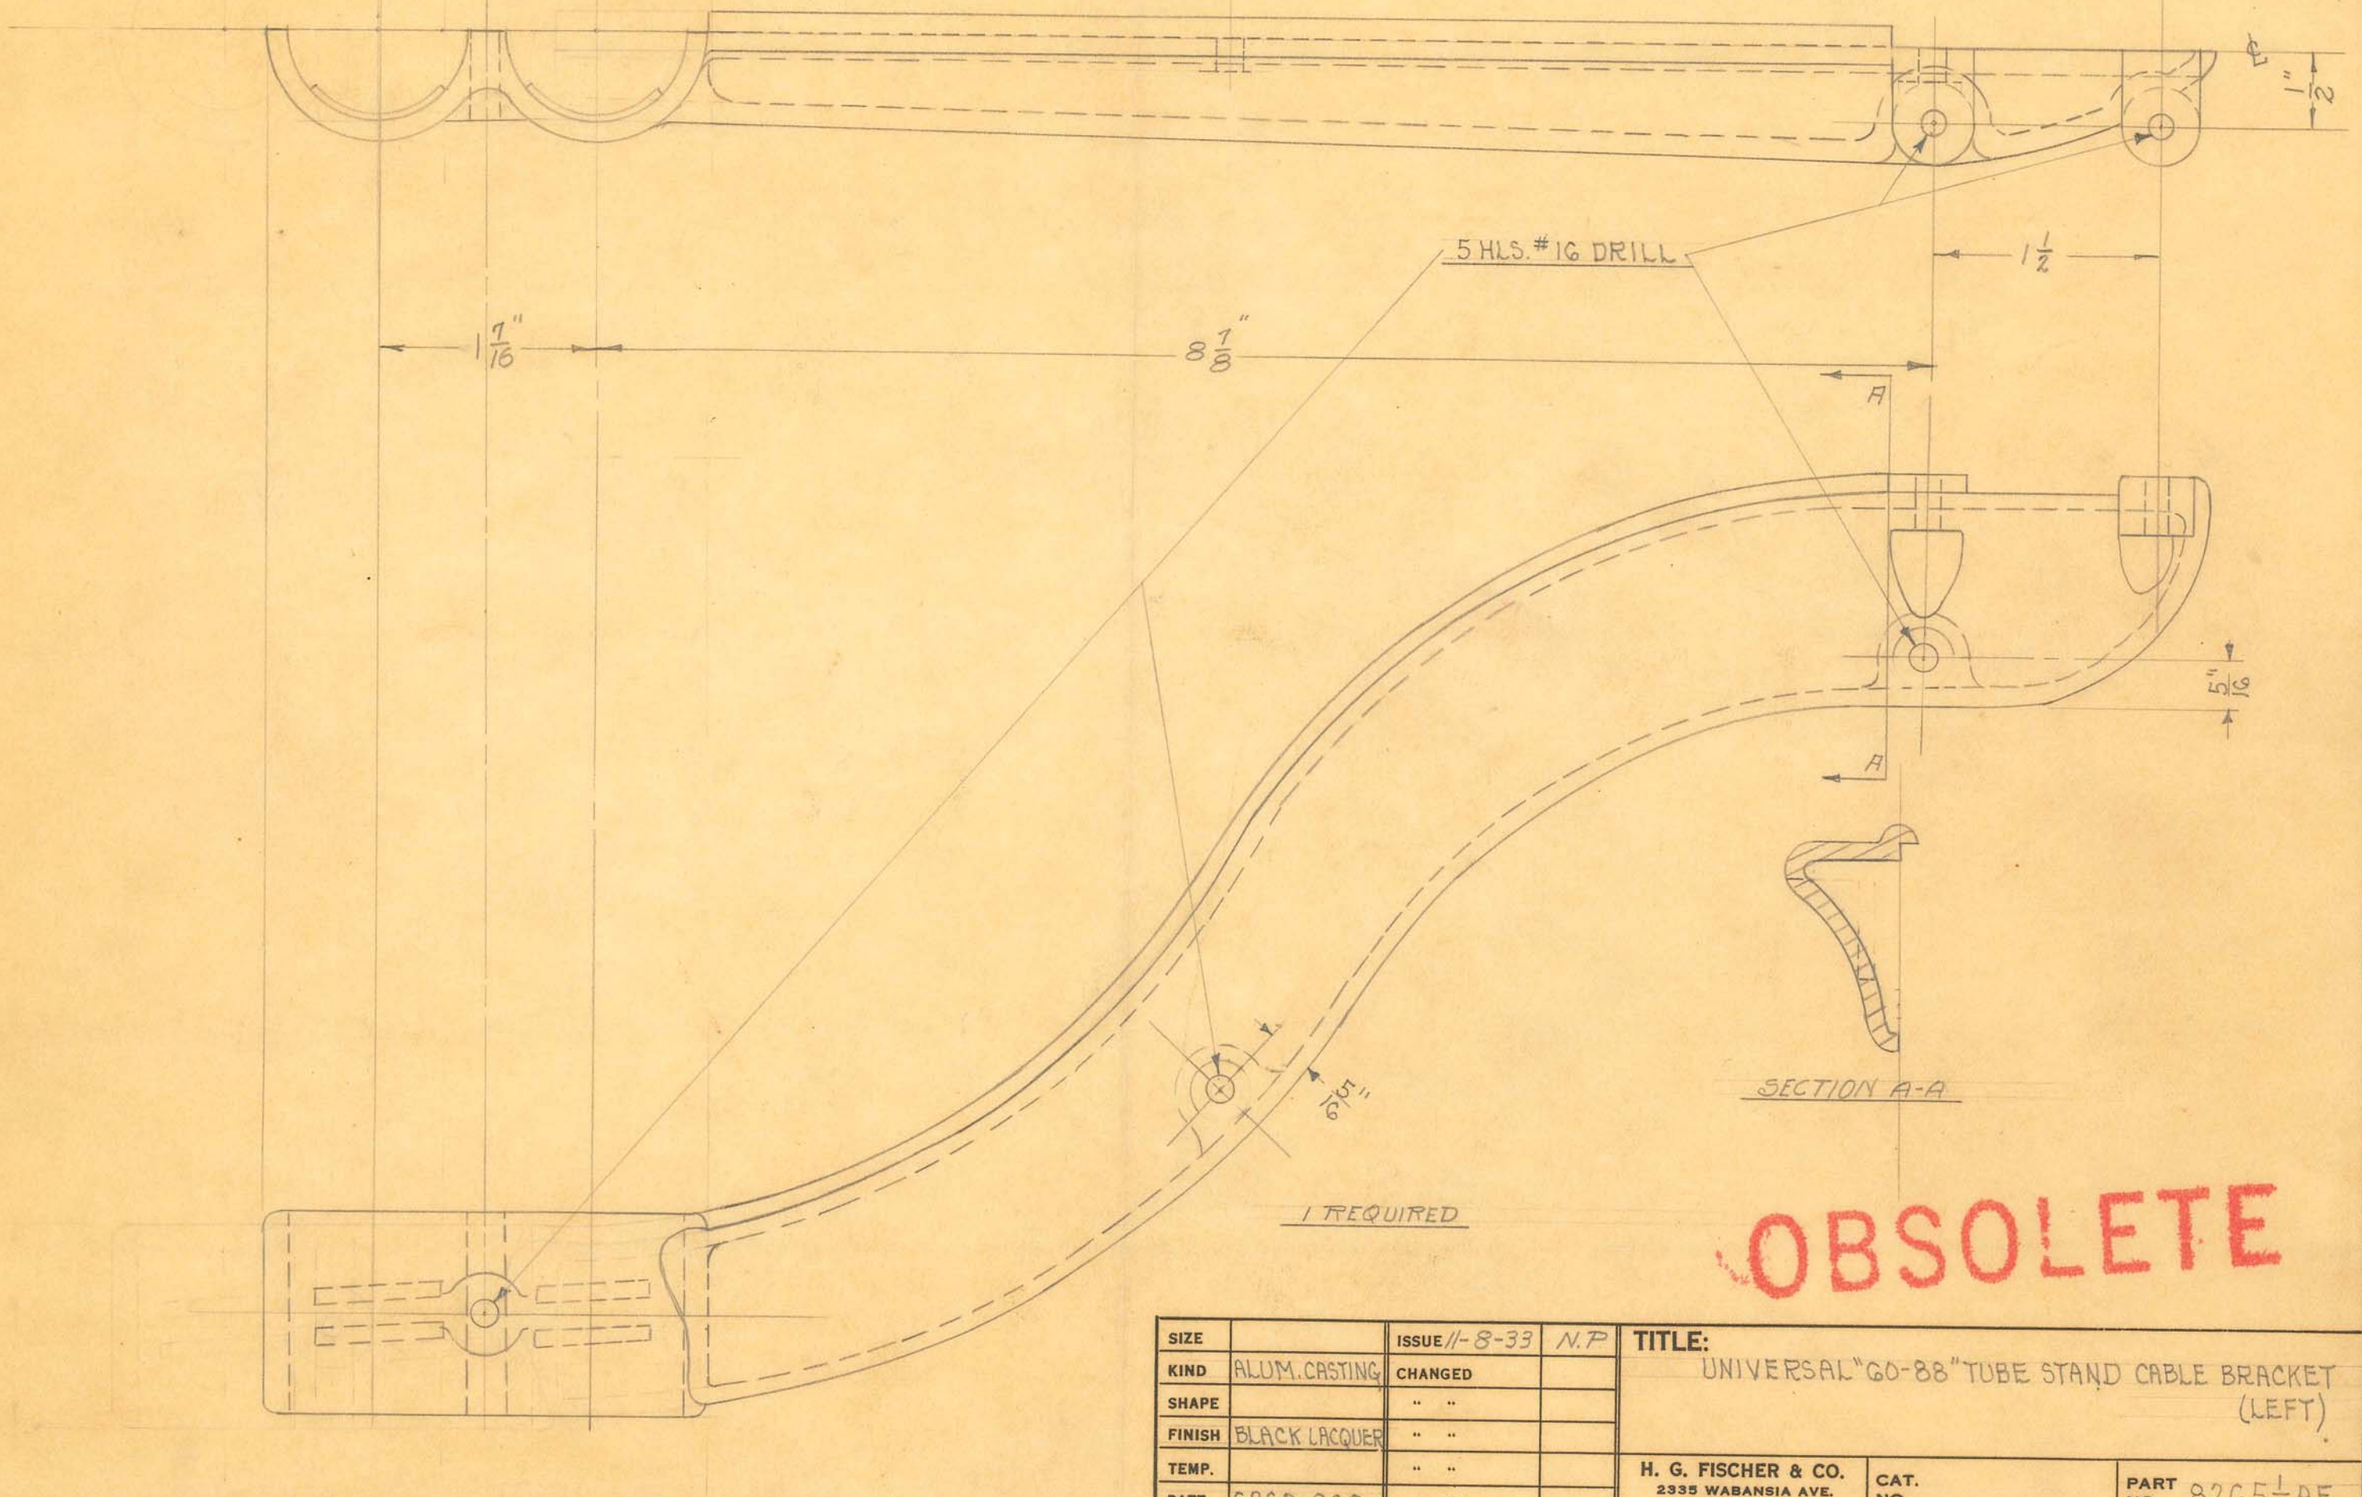

1 REQUIRED

OBSOLETE

SIZE		ISSUE 11-8-33	N.P.
KIND	ALUM. CASTING	CHANGED	
SHAPE		" "	
FINISH	BLACK LACQUER	" "	
TEMP.		" "	
PATT.	6260-668	" "	

TITLE: UNIVERSAL "60-88" TUBE STAND CABLE BRACKET (LEFT)

H. G. FISCHER & CO.
2335 WABANSIA AVE.
CHICAGO, ILL.

CAT. NO.

PART NO. 8265 1/2 AF

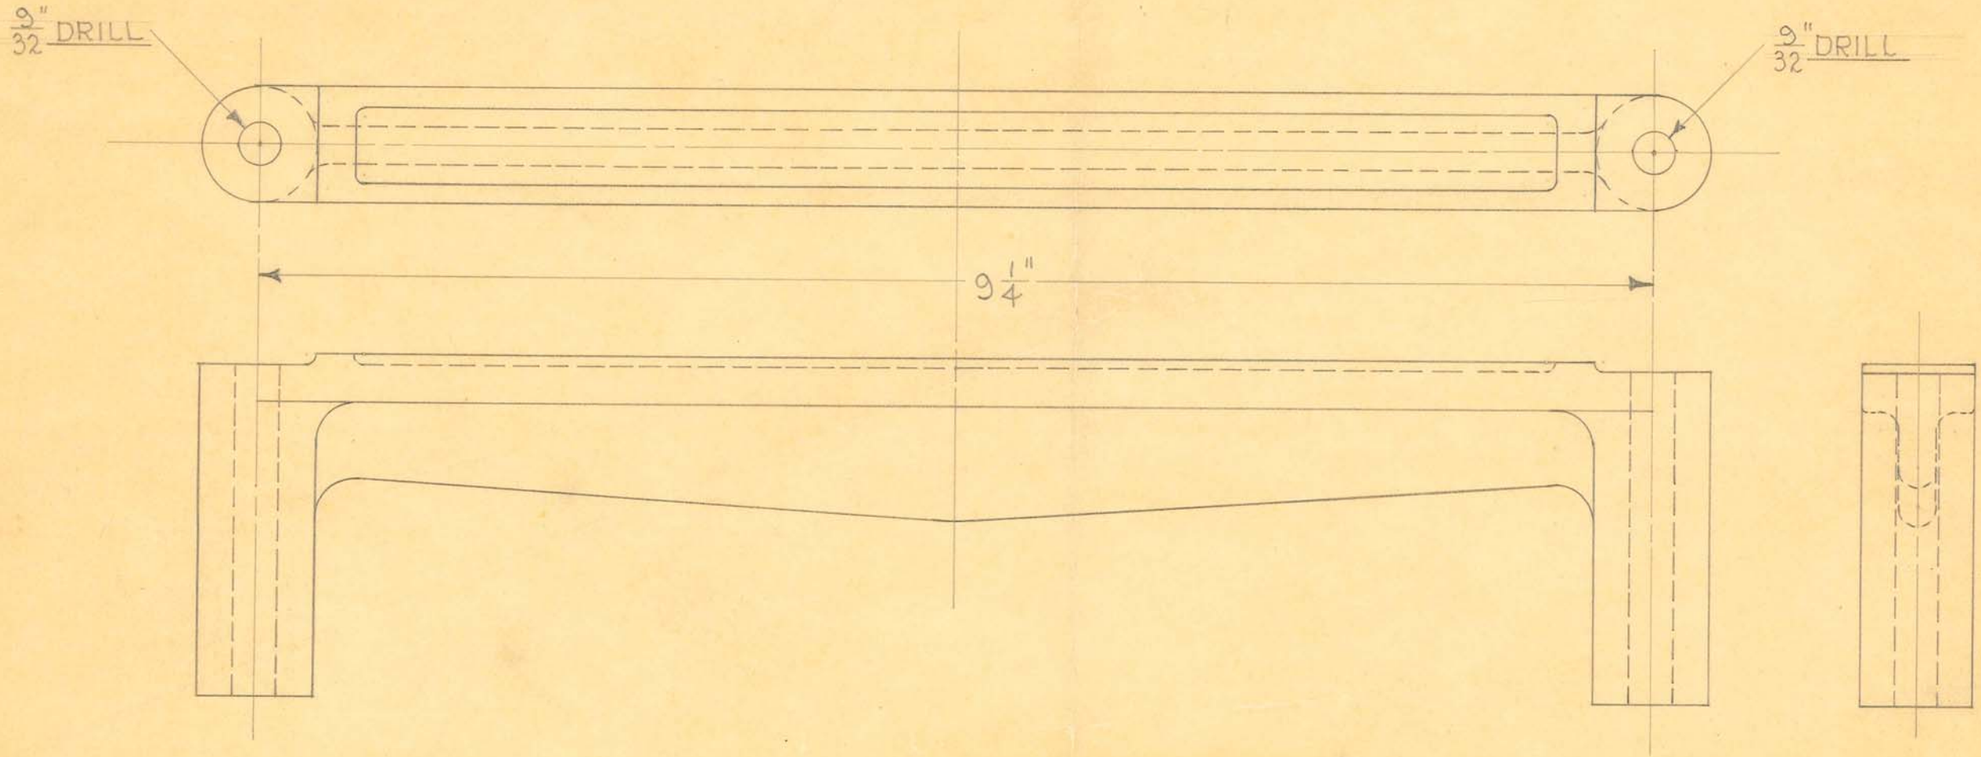

1 REQUIRED

OBSOLETE

SIZE		ISSUE 6-2-36	A.E.	TITLE: SHORT WAVE-25 CYCLE-H.F. OUTFIT TRANSFORMER SUPPORT-UPPER
KIND	IRON CASTING	CHANGED		
SHAPE		" "		
FINISH	BLACK #80	" "		
TEMP.		" "		H. G. FISCHER & CO. 2335 WABANSIA AVE. CHICAGO, ILL. — CAT. NO. — PART NO. 8756 1/4 F
PATT.	8619-836	" "		

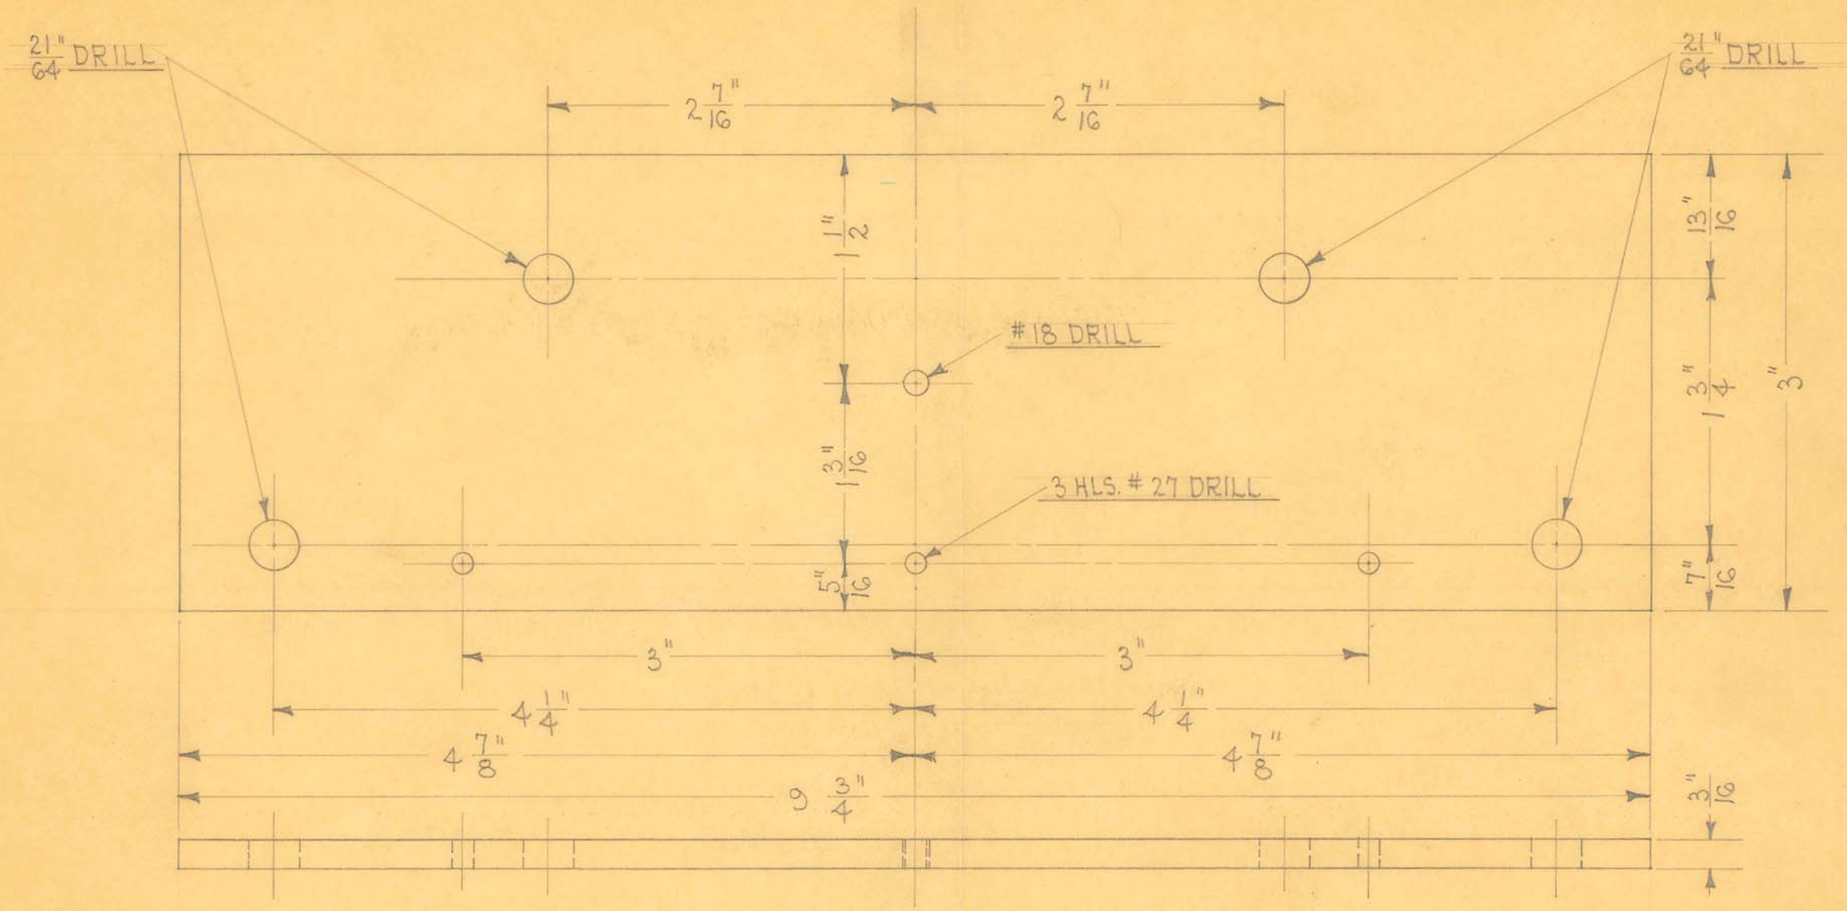

FROM 9434

OBSOLETE

SIZE		ISSUE 11-5-35	D/E
KIND		CHANGED	
SHAPE		" "	
FINISH		" "	
TEMP.		" "	
PATT.		" "	

TITLE: FISCHER "SWD-12-18-24" SHORT WAVE OSCIL. UNIT TREATMENT CORD SOCKET MTG. BOARD

H. G. FISCHER & CO.
2335 WABANSIA AVE.
CHICAGO, ILL.

CAT. NO.

PART NO. 9762

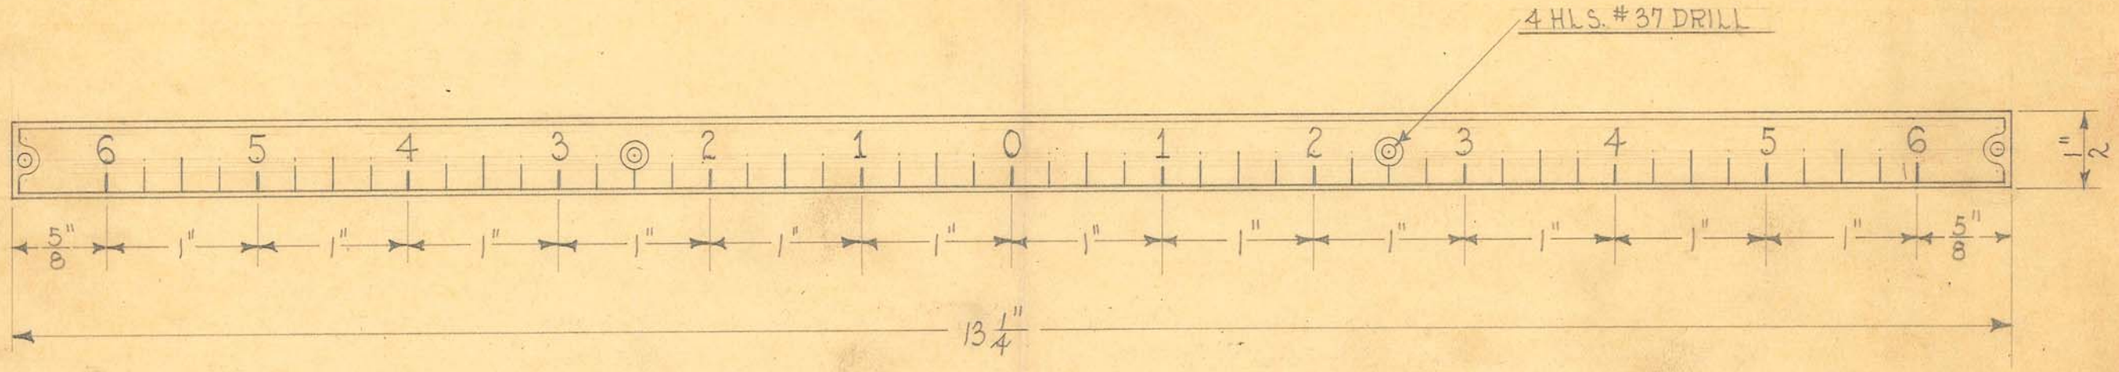

OBSOLETE

Obsolete

SIZE		ISSUE 4-28-33	H.E.	TITLE: UNIVERSAL "CO-88" TUBE STAND HORIZONTAL SCALE
KIND		CHANGED		
SHAPE		" "		
FINISH		" "		
TEMP.		" "		H. G. FISCHER & CO. 2335 WABANSIA AVE. CHICAGO, ILL. — CAT. NO. — PART NO. 8291
PATT.		" "		

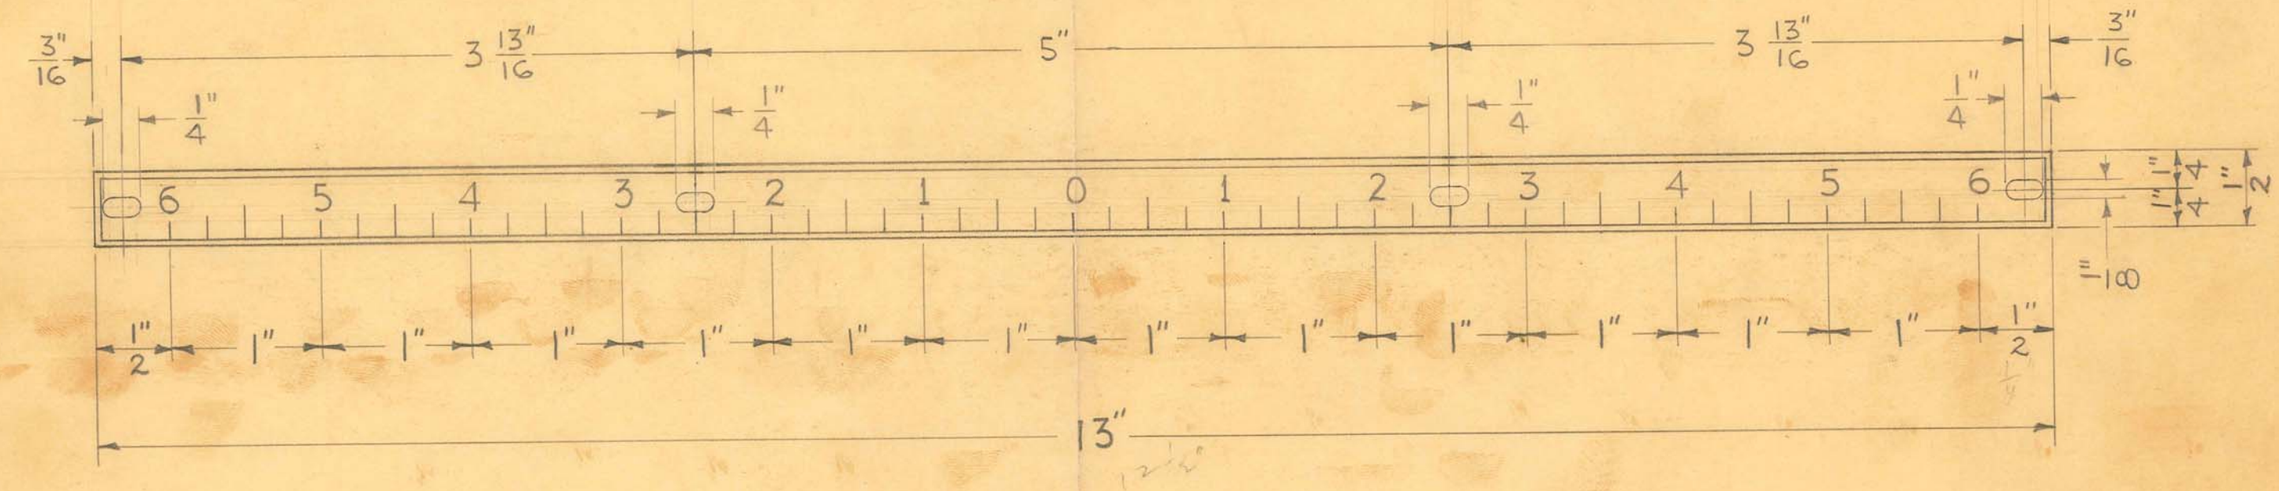

OBSOLETE

REVISION		DATE	BY
A	SLOTS WERE 7/8" X 3/16"	9-11-50	W.J.

SIZE		ISSUE 3-18-46	J.V.W.
KIND		CHANGED	
SHAPE		"	
FINISH		"	
TEMP.		"	
PATT.		"	

TITLE: UNIVERSAL "60-88" TUBE STAND
HORIZONTAL SCALE

H. G. FISCHER & CO.
2338 WABANSIA AVE.
CHICAGO, ILL.

CAT. NO.

PART NO. 8291A

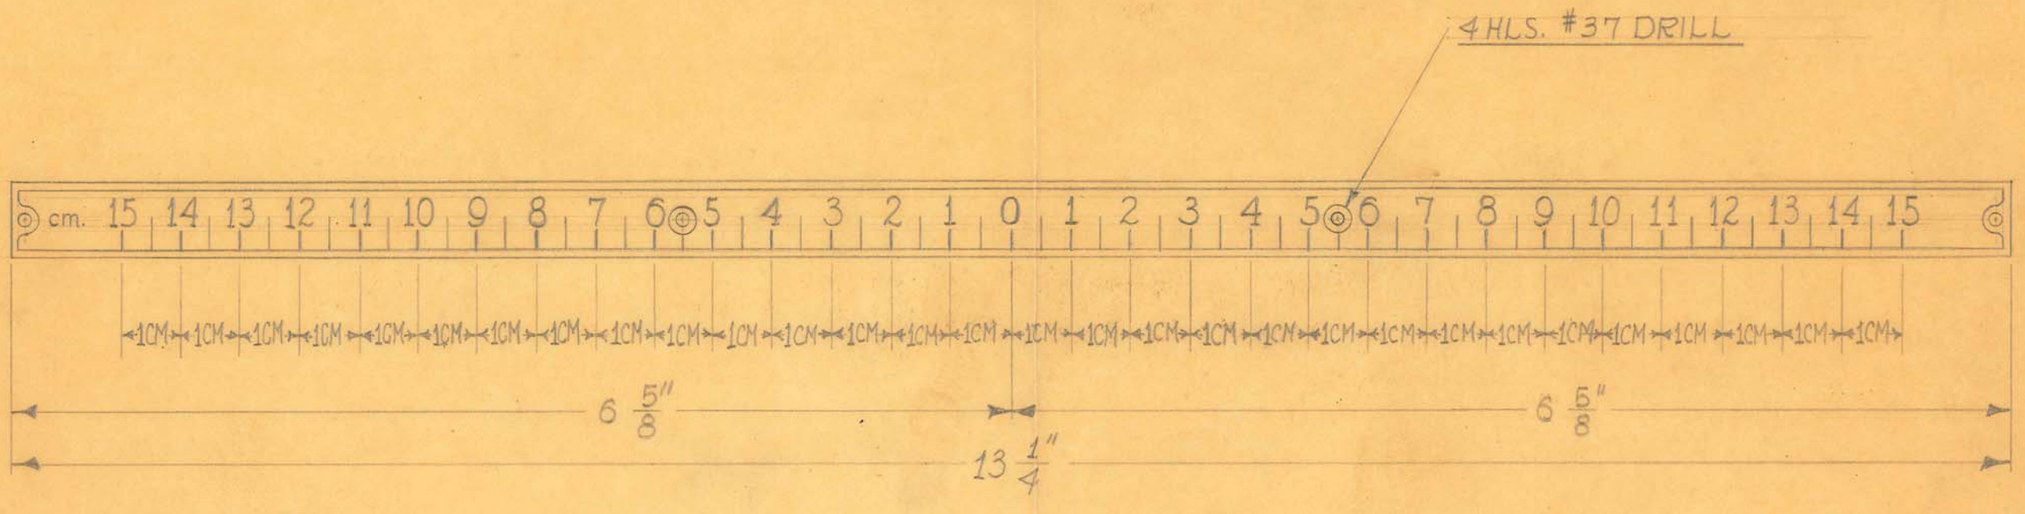

OBSOLETE

SIZE		ISSUE 11-14-35	J.W.	TITLE: UNIVERSAL "60-88" TUBE STAND HORIZONTAL METRIC SCALE
KIND		CHANGED		
SHAPE		" "		
FINISH		" "		
TEMP.		" "		H. G. FISCHER & CO. 2335 WABANSIA AVE. CHICAGO, ILL. — CAT. NO. — PART NO. 8291 1/2
PATT.		" "		

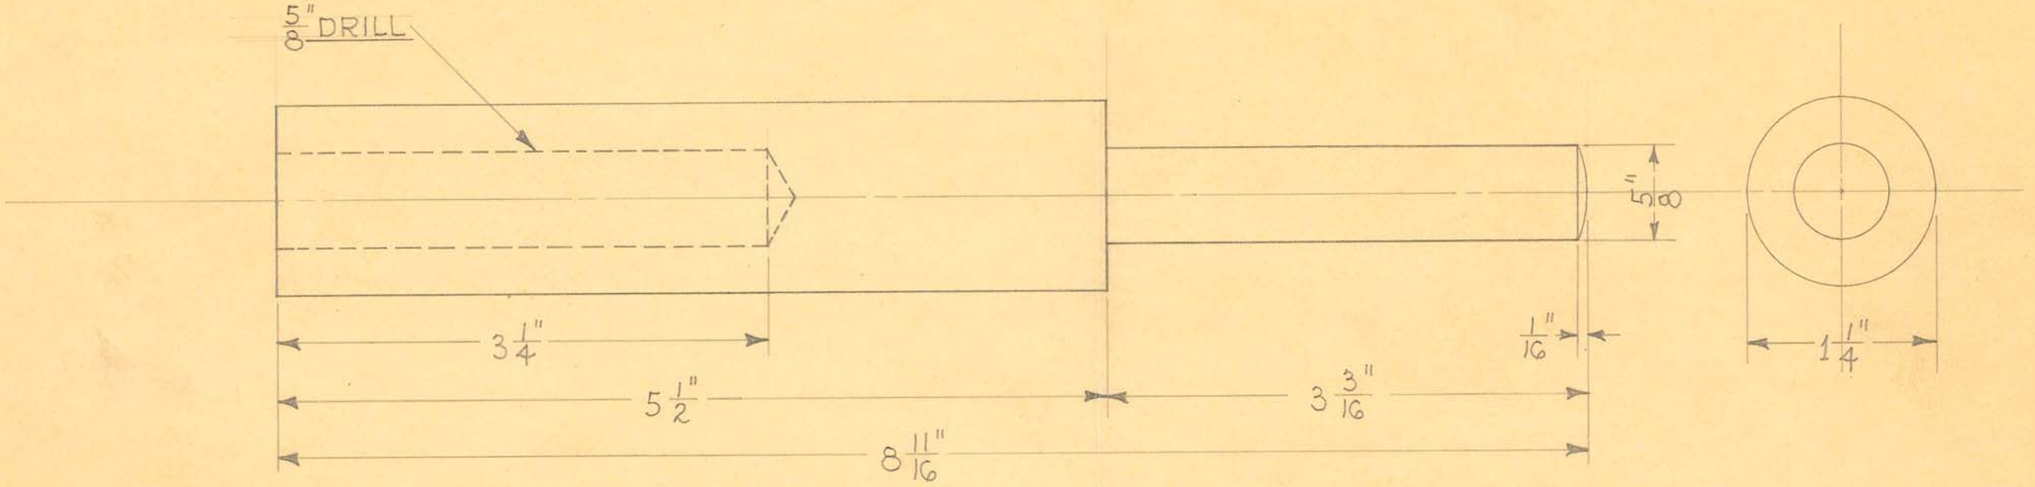

1 REQUIRED

OBSOLETE

SIZE	1¼" DIAM.	ISSUE 10-30-36	A.E.	TITLE: 25 CYCLE "GO-88" CONTROL BOX CENTER SUPPORT SHAFT EXTENSION
KIND	C.R. STEEL	CHANGED		
SHAPE		"		
FINISH	CAD. #23	"		
TEMP.		"		
PATT.		"		

H. G. FISCHER & CO.
2335 WABANSIA AVE.
CHICAGO, ILL.

CAT. NO.

PART NO. 8306 5/8

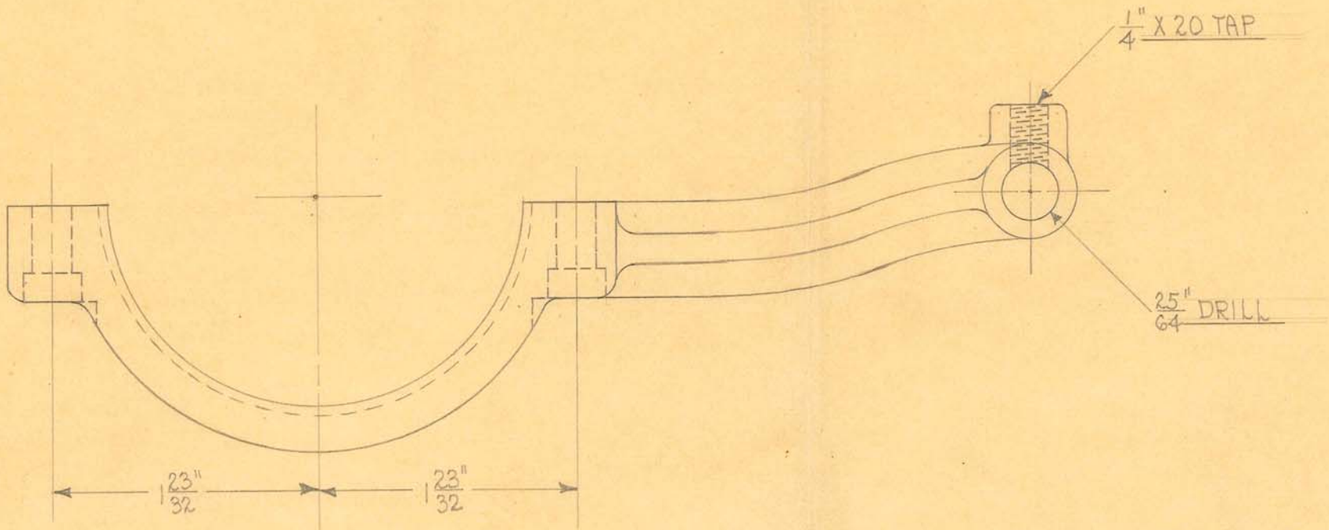

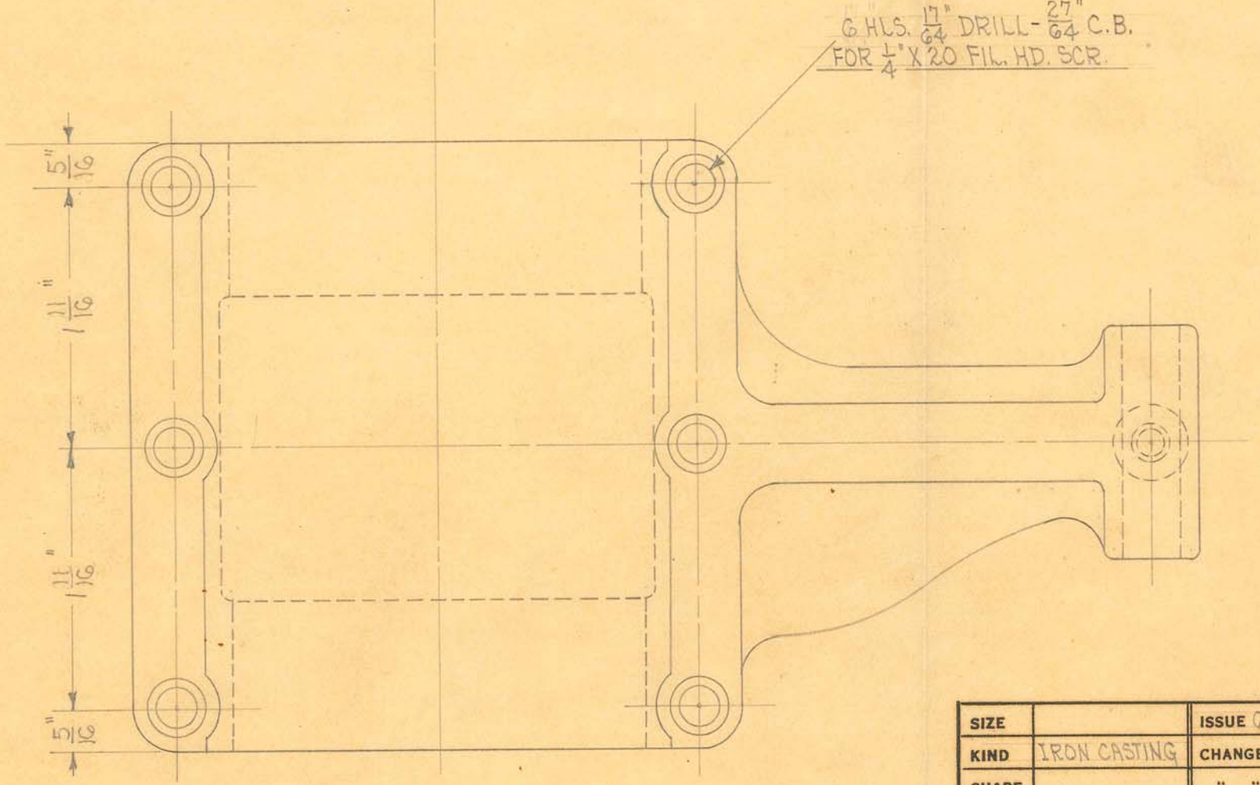

1 REQUIRED

OBSOLETE

SIZE		ISSUE 6-24-33	JE
KIND	IRON CASTING	CHANGED	
SHAPE		" "	
FINISH	BLK. LACQUER	" "	
TEMP.		" "	
PATT.	3052-638	" "	

TITLE: UNIVERSAL "GO-88" CONTROL BOX
IMPROVED SUPPORT ARM CAP

H. G. FISCHER & CO.
2335 WABANSIA AVE.
CHICAGO, ILL.

CAT. NO.

PART NO. 8311F

7 11 E P

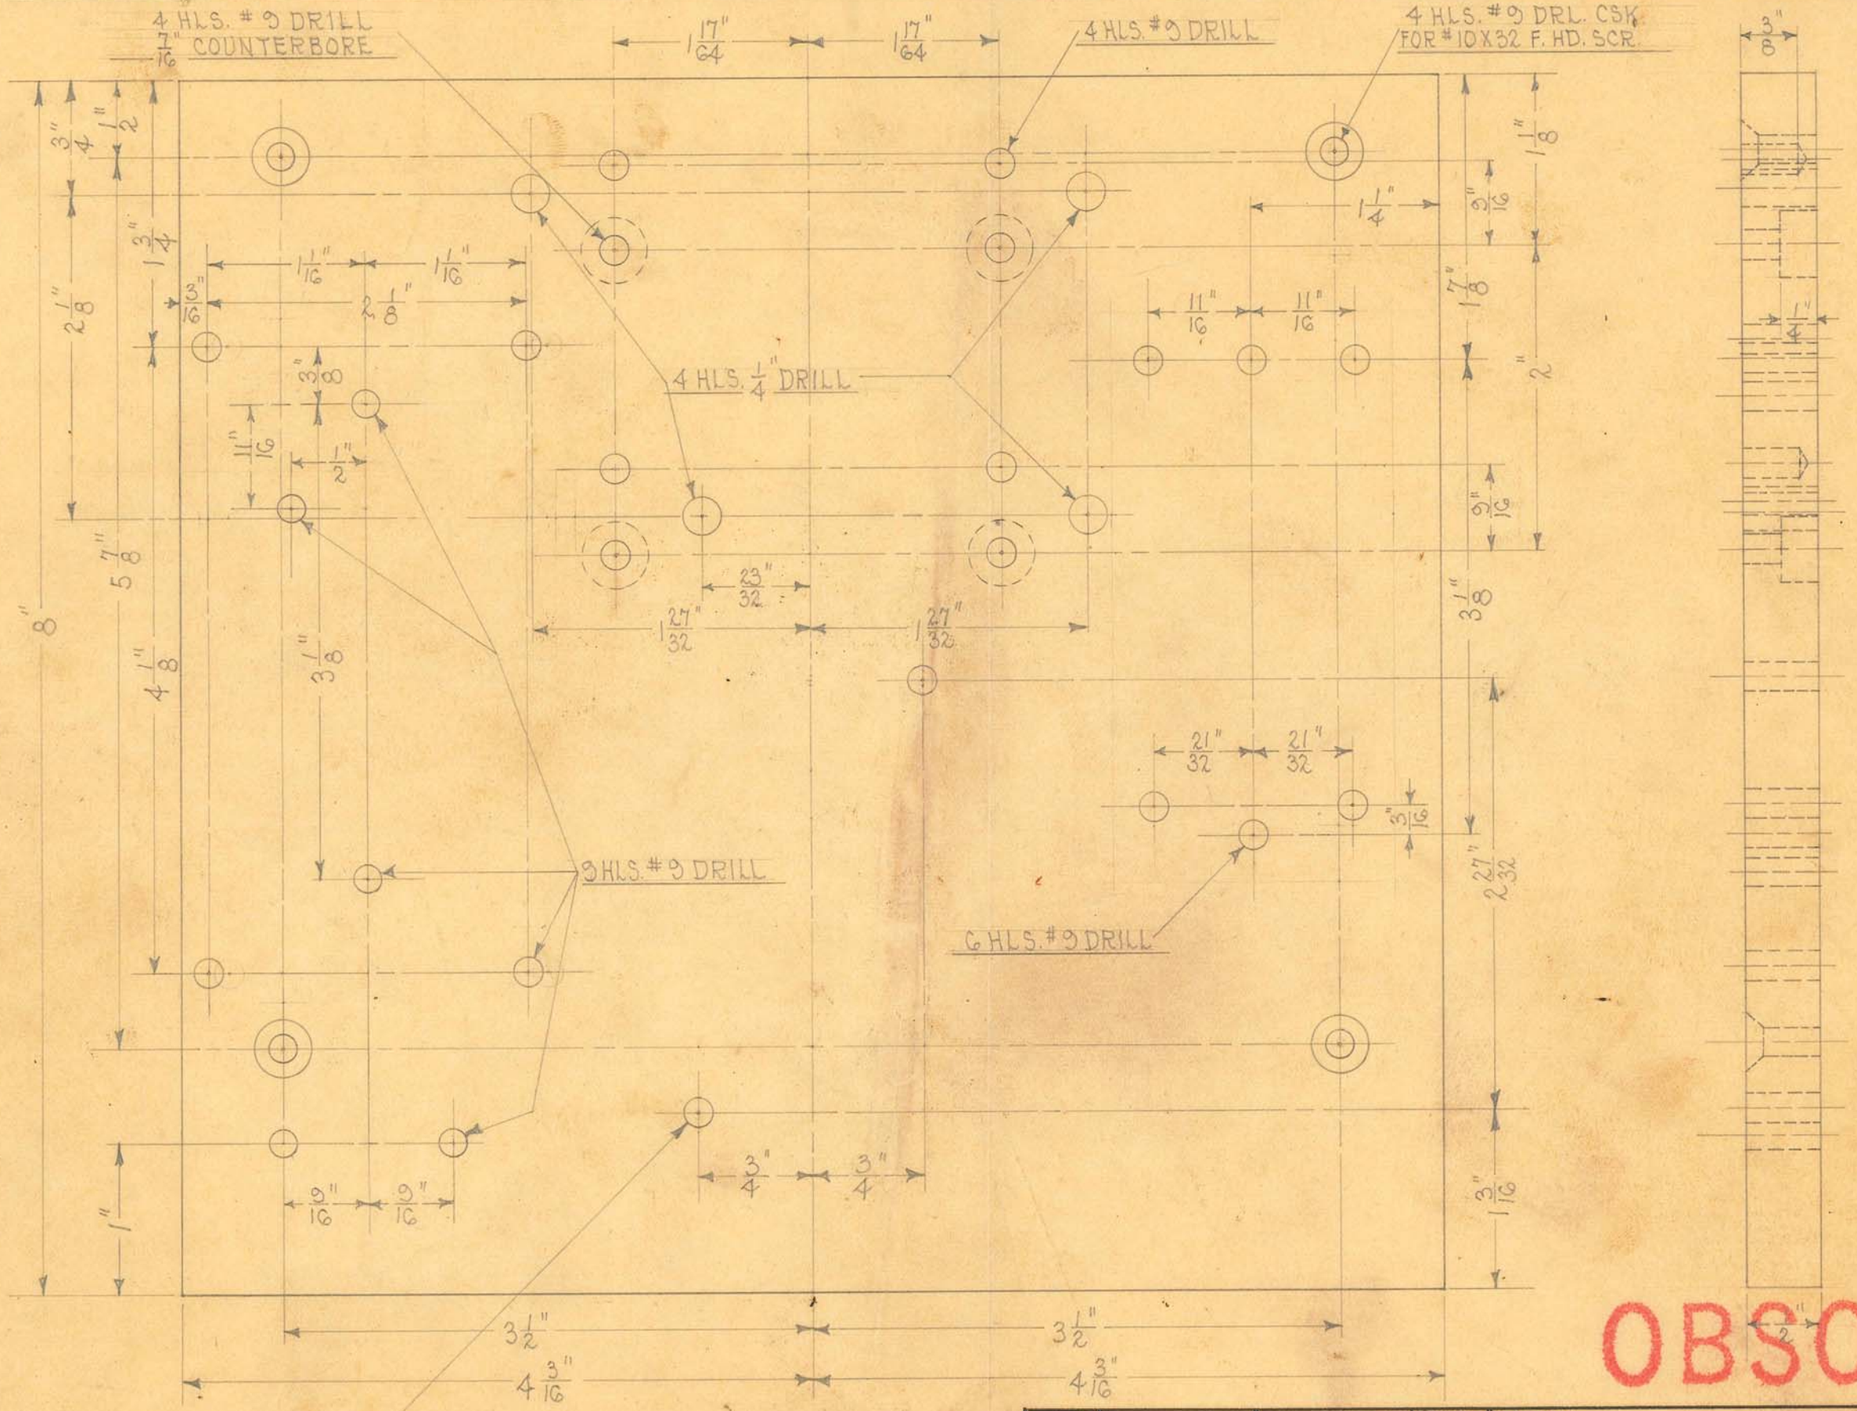

SIZE		ISSUE 6-27-33	H.E.	TITLE: UNIVERSAL "60-88" CONTROL BOX CONTROL BOARD
KIND	EBONY ASBESTOS BOARD	CHANGED		
~~SHAPE~~		" "		
FINISH		" "		
TEMP.		" "		
PATT.		" "		

H. G. FISCHER & CO.
2335 WABANSIA AVE.
CHICAGO, ILL.

CAT. NO.

PART NO. 8312F

7-2168

4 HLS. # 9 DRILL
1/2" C.B. - 1/4" DEEP

4 HLS. # 9 DRILL

4 HLS. # 9 DRL. CSK.
FOR #10 X 32 F. HD. SCR.

CSK. TO 9/32" FACE

CSK. TO 5/16" FACE

8 HLS. # 1 DRILL

6 HLS. # 16 DRILL

CSK. TO 9/32" FACE

2 HLS # 1 DRILL

1 REQUIRED

OBSOLETE
Obsolete

SIZE	8" X 8 3/8" X 1/2"	ISSUE 3-28-34	A.E.	TITLE: UNIVERSAL "GO-88" CONTROL BOX CONTROL BOARD
KIND	EBONY ASBESTOS	CHANGED 3-10-37	J.W.	
~~SHAPE~~	BOARD	" " 8-4-37	A.E.	
FINISH		" "		H. G. FISCHER & CO. 2335 WABANSIA AVE. CHICAGO, ILL.
TEMP.		" "		CAT. NO.
PATT.		" "		PART NO. 8312FB

97 5168

4 HLS. #9 DRL. CSK. TO $\frac{5}{16}$" FACE.

4 HLS. #9 DRL. CSK. TO $\frac{5}{16}$" FACE. $\frac{1}{2}$" C.B. $\frac{1}{4}$" DEEP FROM OTHER SIDE.

#1 DRL. CSK. TO $\frac{9}{32}$" FACE.

4 HLS. #1 DRILL

4 HLS. #18 DRILL

4 HLS. #1 DRILL

#1 DRL. CSK. TO $\frac{9}{32}$" FACE.

4 HLS. #9 DRILL CSK. FOR #10 X 32 F. HD. SCR.

1 REQUIRED

OBSOLETE

SIZE	8½" X 9½" X ½"	ISSUE 10-12-36	2.E.
KIND	EBONY ASBESTOS	CHANGED	
SHAPE	BOARD	"	
FINISH		"	
TEMP.		"	
PATT.		"	

TITLE: 25 CYCLE UNIVERSAL "60-88" CONTROL BOX CONTROL BOARD

H. G. FISCHER & CO.
2335 WABANSIA AVE.
CHICAGO, ILL.

CAT. NO.

PART NO. 8312½F

4 HLS. #9 DRILL
1/2" C.B. - 1/4" DEEP

2 HLS. #9 DRILL

CSK. TO 5/16" FACE

2 HLS. #9 DRILL

10 HLS. #1 DRILL

2 HLS. #2 DRILL

4 HLS. #9 DRL.

2 HLS. #2 DRL.

9 HLS. #2 DRILL

4 HLS. #9 DRL.

4 HLS. #9 DRILL CSK. FOR #10 X 32 F. HD. SCR.

CSK. TO 9/32" FACE

OBSOLETE

SIZE	8"X8 3/8" X 1/2"	ISSUE 3-10-37	J.W.
KIND	EBONY ASBESTOS	CHANGED	
STAIN	BOARD	"	
FINISH		"	
TEMP.		"	
PATT.		"	

TITLE: UNIVERSAL "60-88" CONTROL BOX CONTROL BOARD (MINSKIER)

H. G. FISCHER & CO.
2335 WABANSIA AVE.
CHICAGO, ILL.

CAT. NO.

PART NO. 8312 3/4

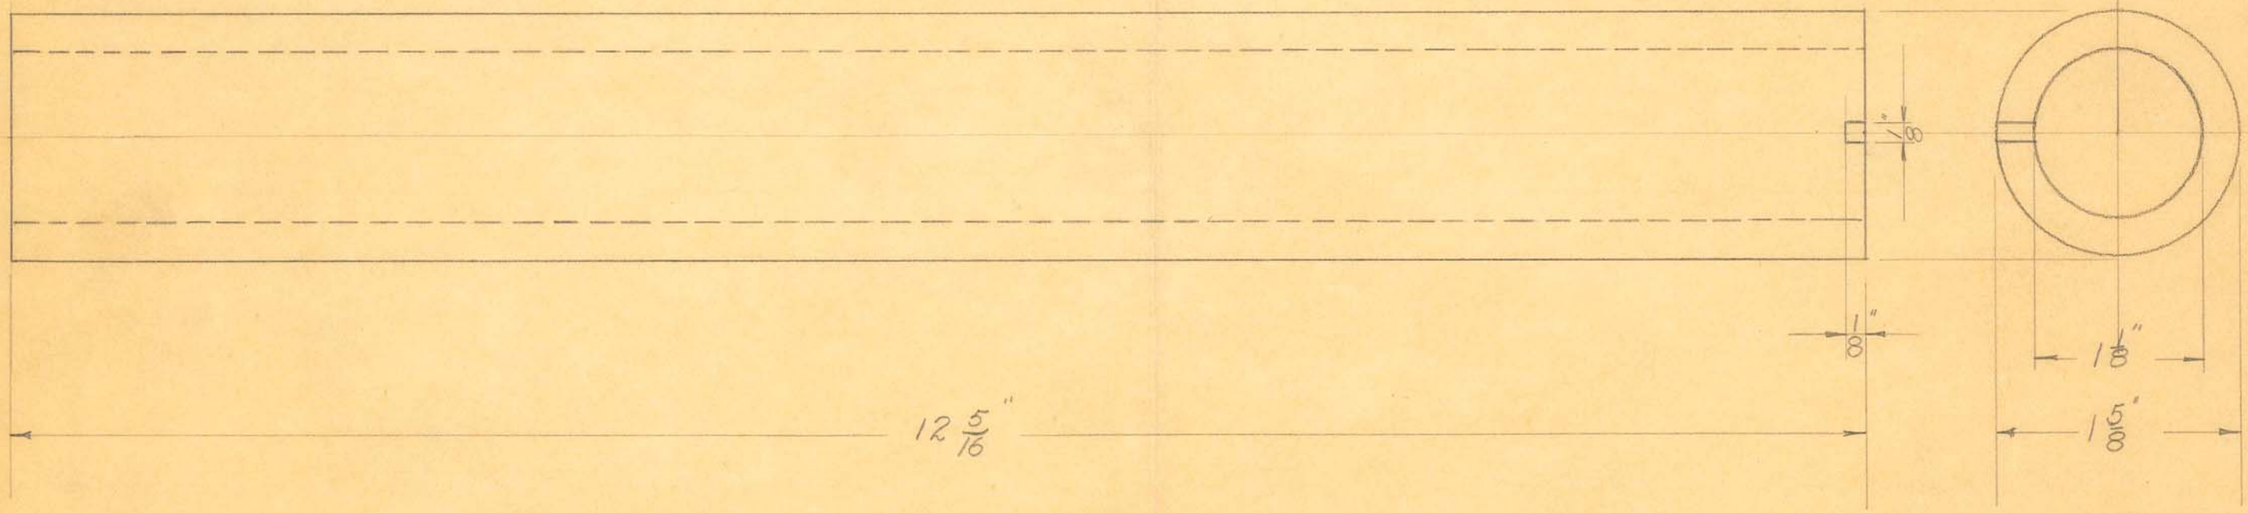

1 REQUIRED

OBSOLETE

SIZE	1/8 I.D - 1 5/8 O.D.	ISSUE 10-30-33	N.P.	TITLE: UNIVERSAL 60-88 FILAMENT TRANSFORMER SECONDARY RUBBER TUBE
KIND	#33 GROUND	CHANGED		
SHAPE	RUBBER TUBING	" "		
FINISH		" "		
TEMP.		" "		H. G. FISCHER & CO. 2335 WABANSIA AVE. CHICAGO, ILL. — CAT. NO. — PART NO. 8343A
PATT.		" "		

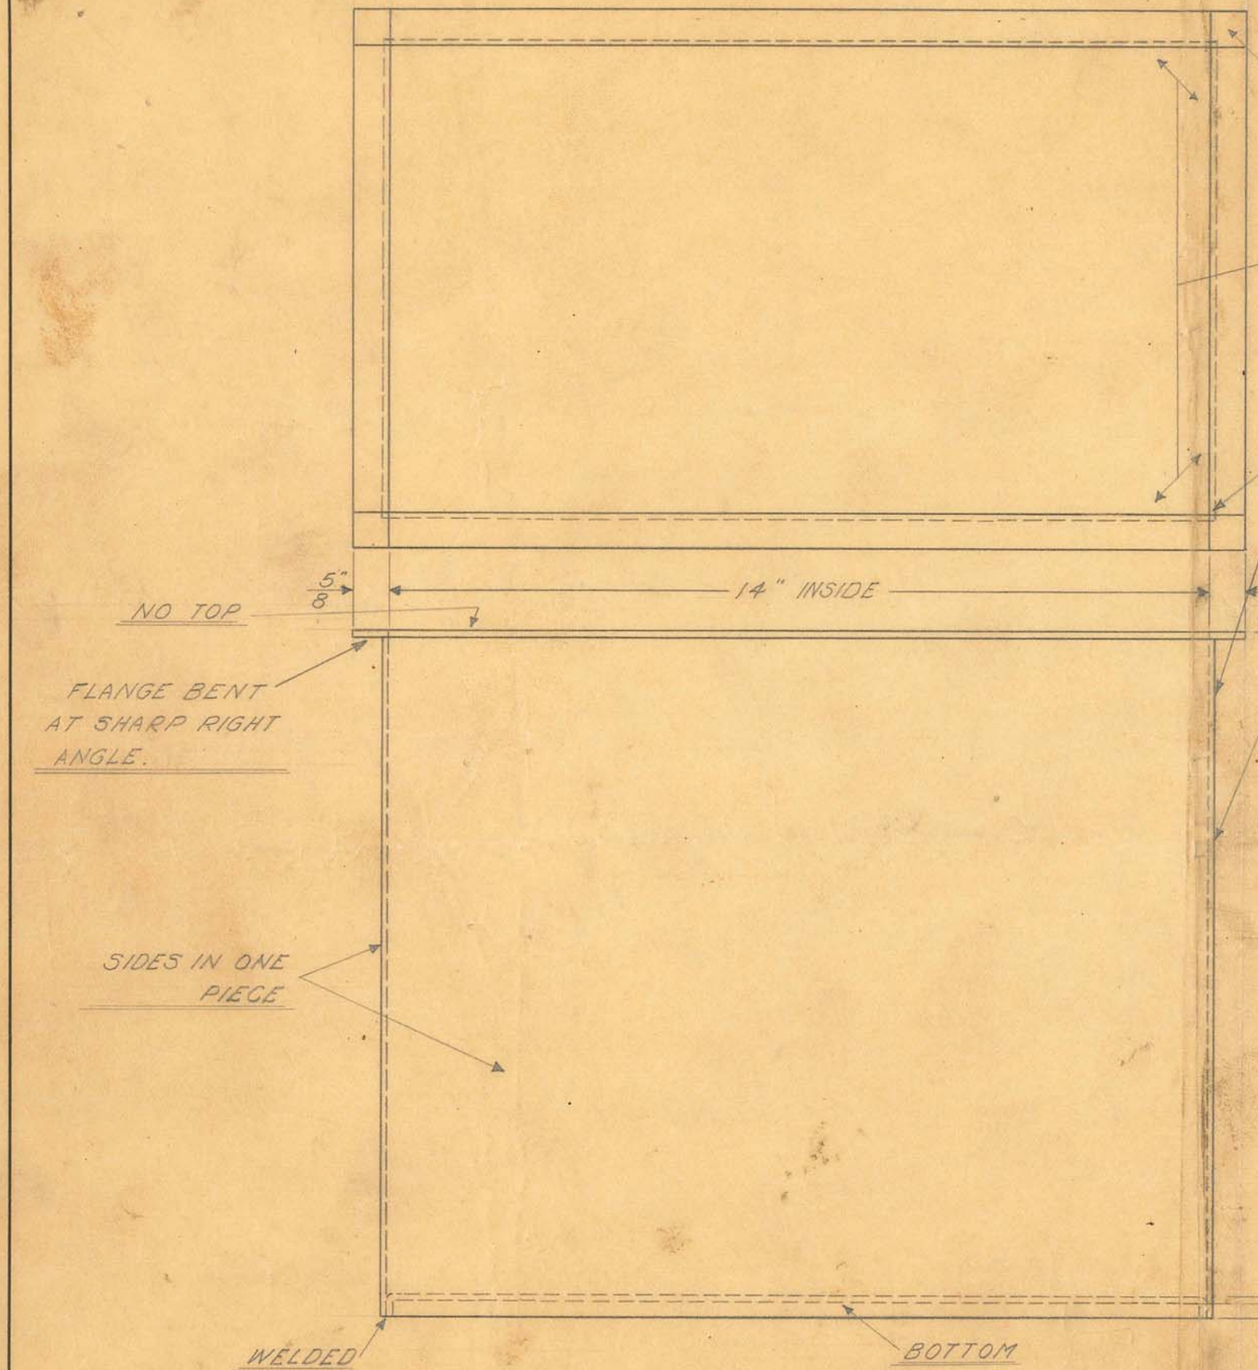

-NOTE:-
WELDING MUST BE OIL TIGHT.
TEST FOR LEAKS WITH KEROSENE.
GIVE OUTSIDE OF TANK KEROSENE BATH TO KEEP FROM RUSTING.

ENTIRE TOP SURFACE MUST BE LEVEL

SCALE ÷ 9/32" : 1"

OBSOLETE

SIZE	16 U.S.S. GA. (064)	ISSUE 2-7-33	F.T.M.	TITLE: UNIVERSAL "GO-88" TRANSFORMER TANK
KIND	FURNITURE STEEL	CHANGED		
SHAPE	STRIP	" "		
FINISH		" "		
TEMP.		" "		
PATT.		" "		

H. G. FISCHER & CO.
2335 WABANSIA AVE.
CHICAGO, ILL.

CAT. NO.

PART NO. 8346

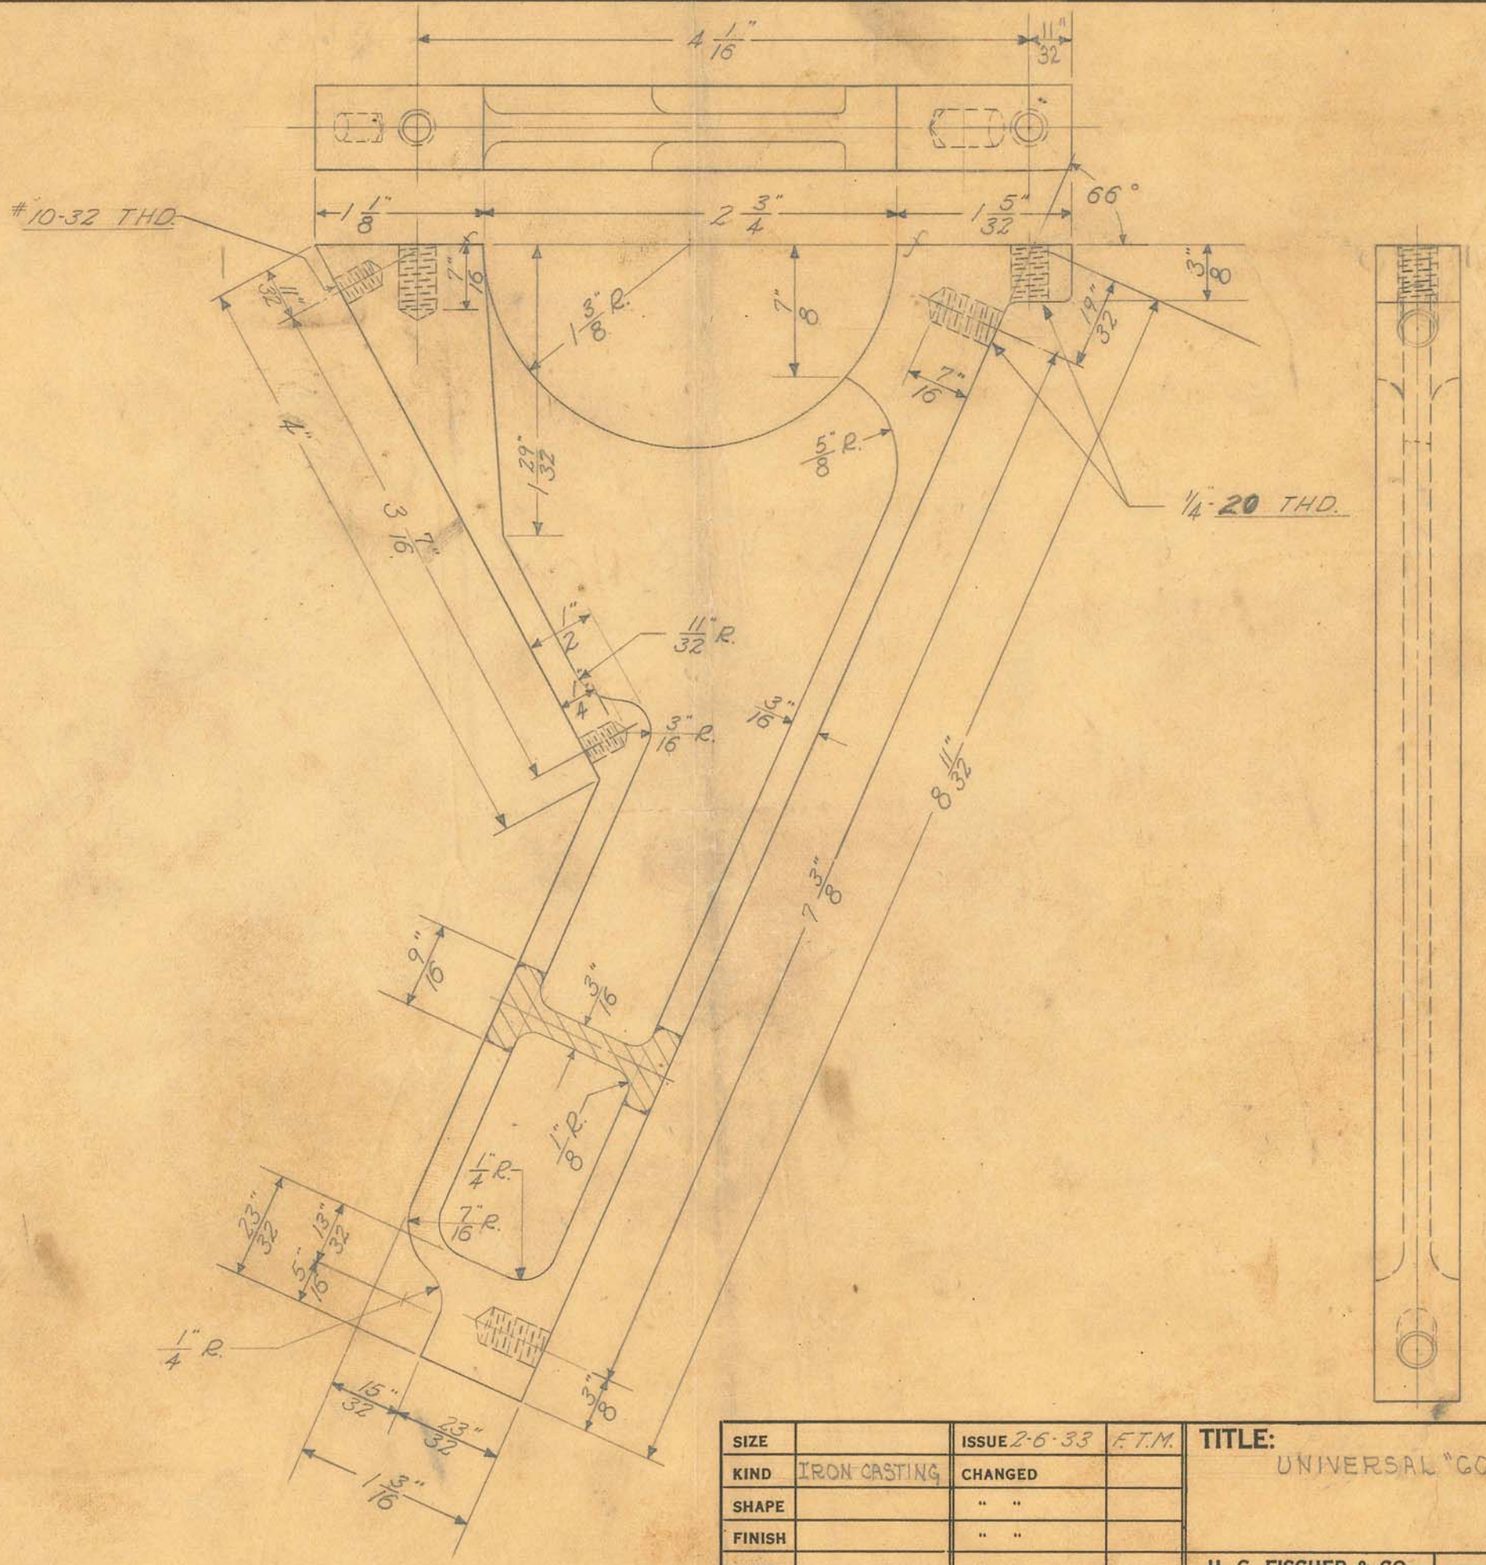

SCALE ÷ FULL SIZE
IRON CASTING - 2 REQD

OBSOLETE

SIZE		ISSUE 2-6-33	F.T.M.
KIND	IRON CASTING	CHANGED	
SHAPE		" "	
FINISH		" "	
TEMP.		" "	
PATT.	1742-589	" "	

TITLE: UNIVERSAL "GO-88" TRANSFORMER SUPPORT

H. G. FISCHER & CO.
2335 WABANSIA AVE.
CHICAGO, ILL.

CAT. NO.

PART NO. 8347F

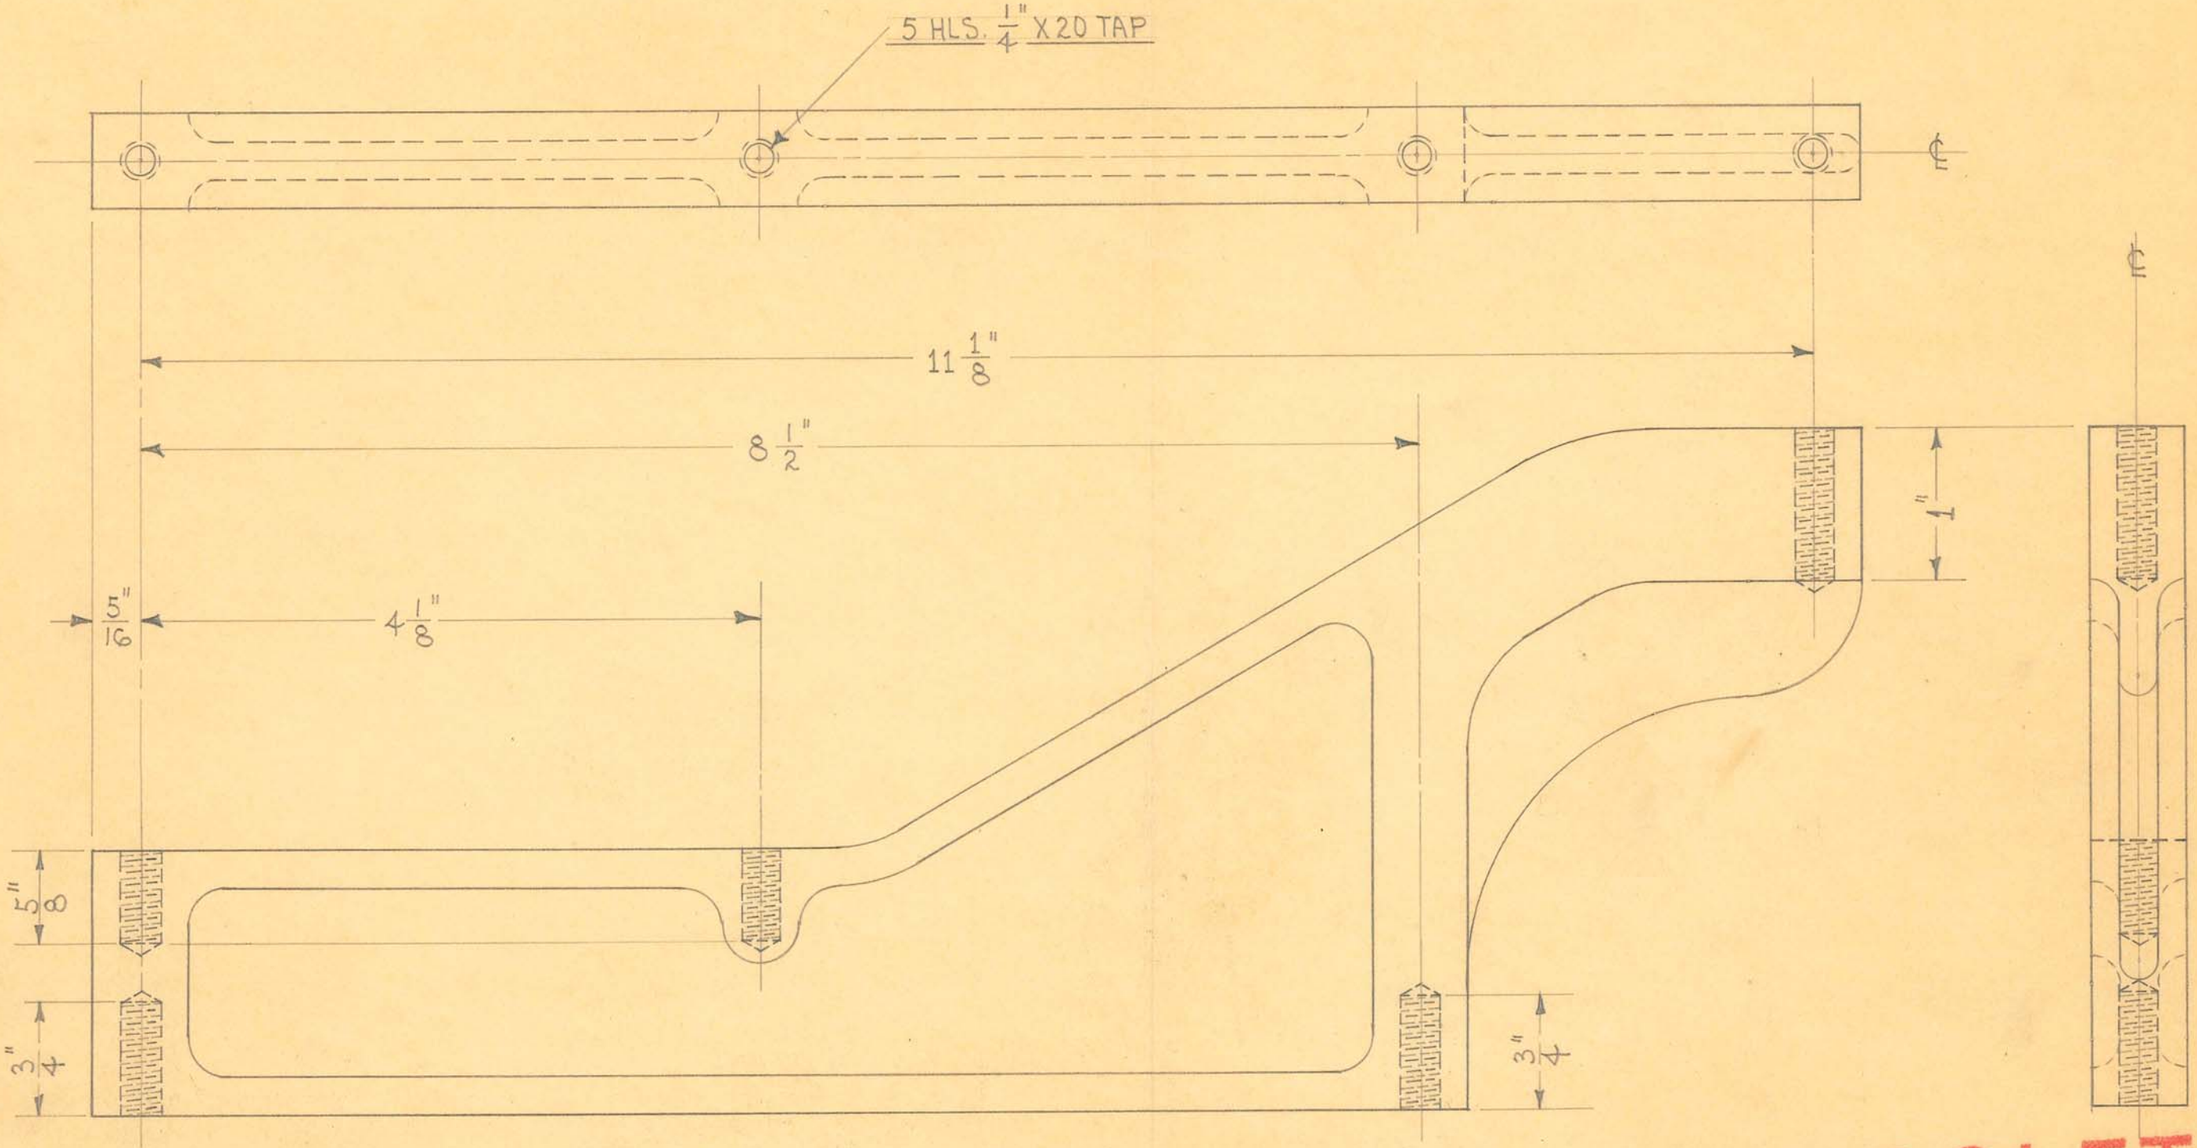

2 REQUIRED

OBSOLETE

SIZE		ISSUE 10-26-36	H.E.	TITLE: 25 CYCLE "GO-88" TRANSFORMER SUPPORT
KIND	ALUM. CASTING	CHANGED		
SHAPE		"		
FINISH		"		
TEMP.		"		
PATT.	3784-305	"		

H. G. FISCHER & CO.
2335 WABANSIA AVE.
CHICAGO, ILL.

CAT. NO.

PART NO. 8347 3/4 F

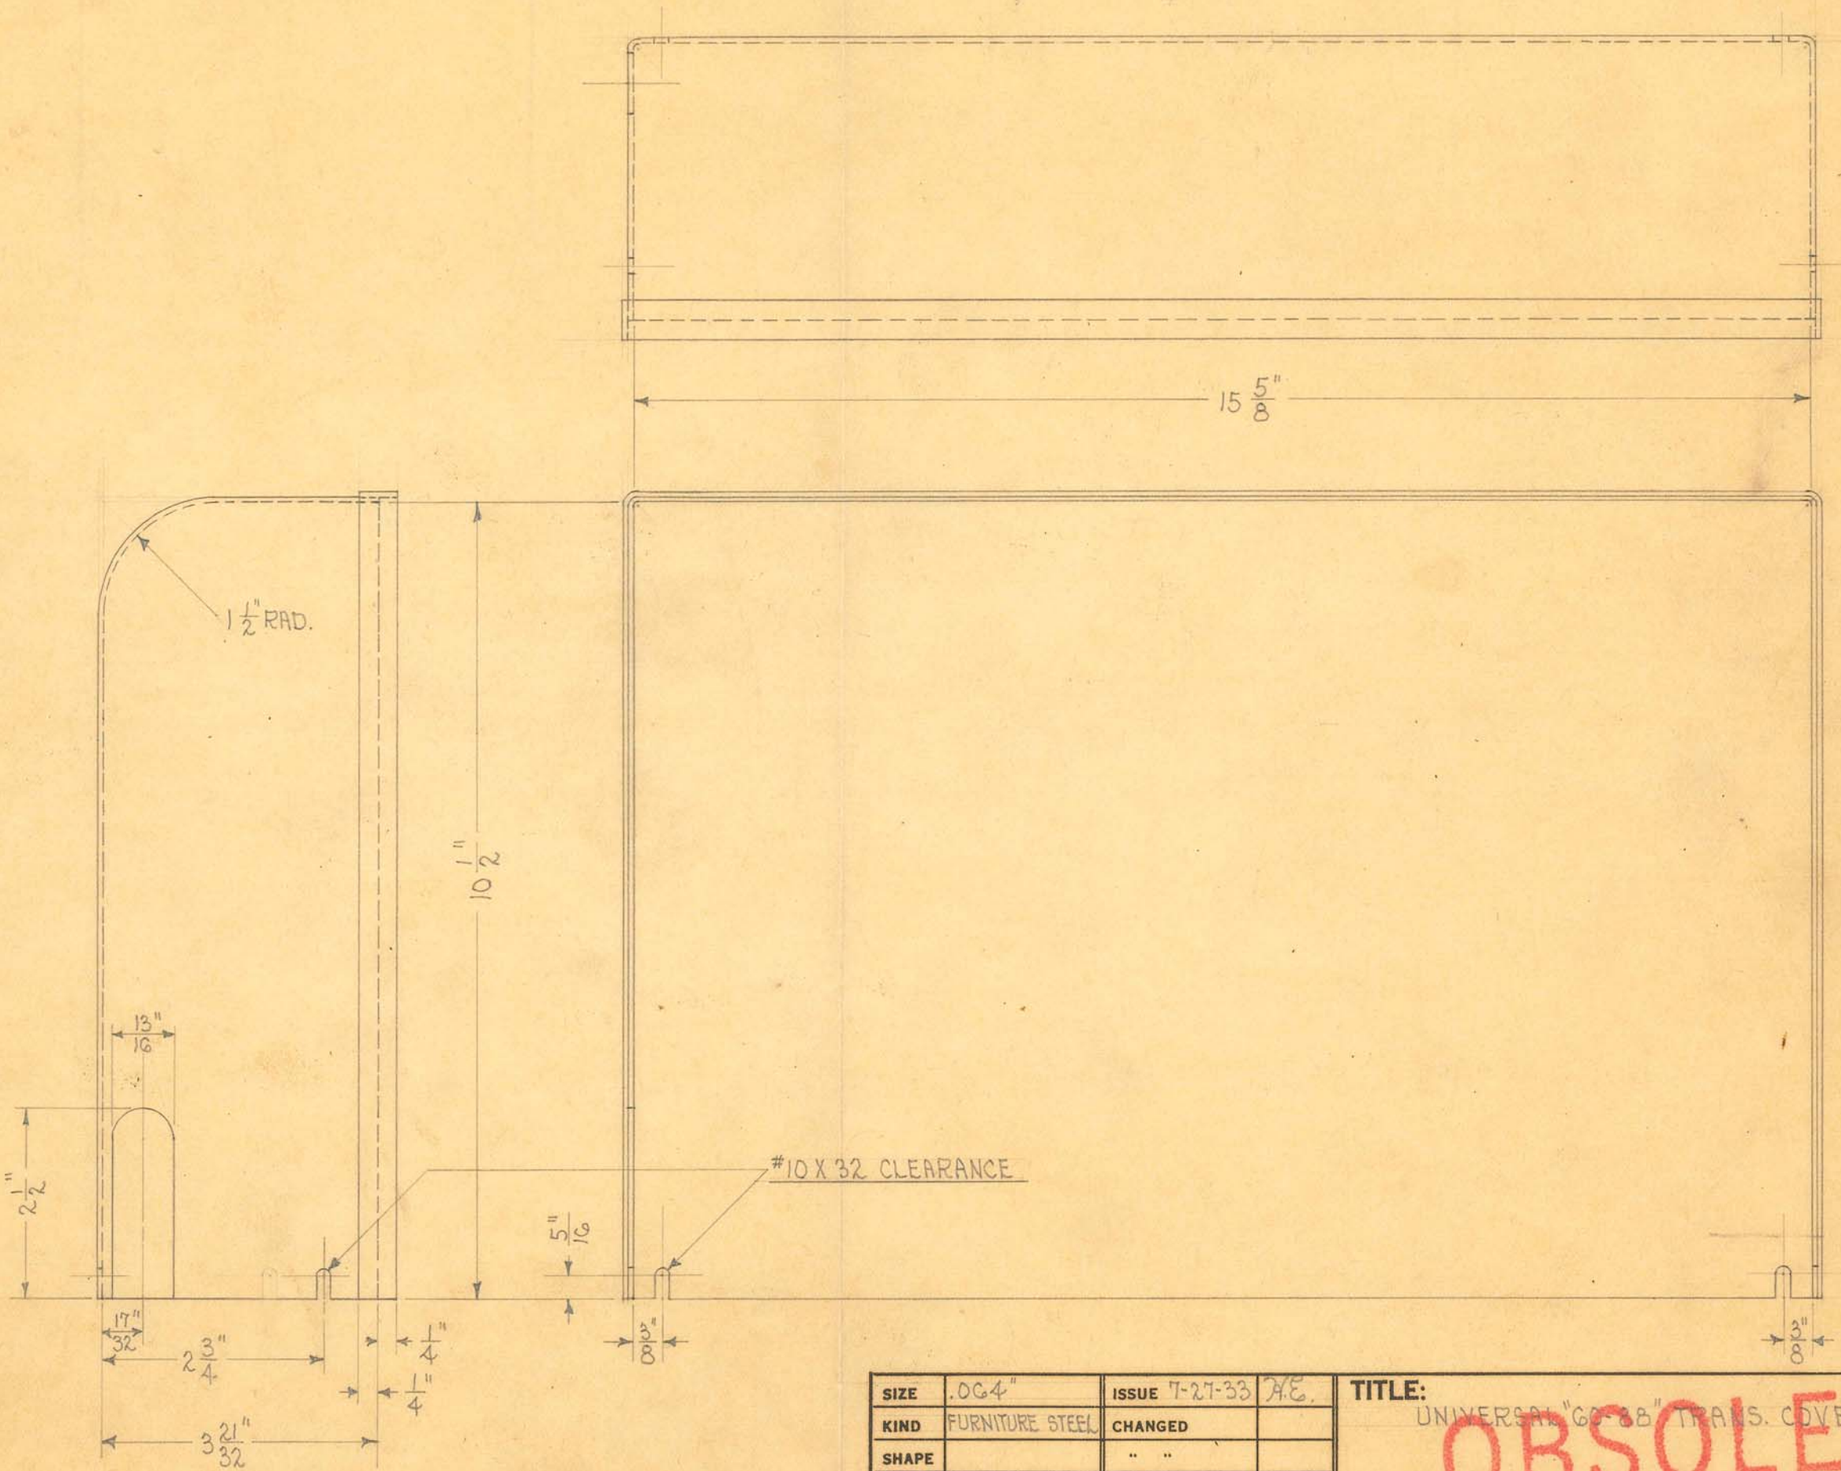

1 REQUIRED

SCALE ≈ 1/2" = 1"

SIZE	.064"	ISSUE 7-27-33	A.E.	TITLE: UNIVERSAL "60-88" TRANS. COVER FRONT
KIND	FURNITURE STEEL	CHANGED		
SHAPE		" "		
FINISH	BLK. LACQUER	" "		
TEMP.		" "		
PATT.		" "		

OBSOLETE

H. G. FISCHER & CO.
2335 WABANSIA AVE.
CHICAGO, ILL.

CAT. NO.

PART NO. 8348F

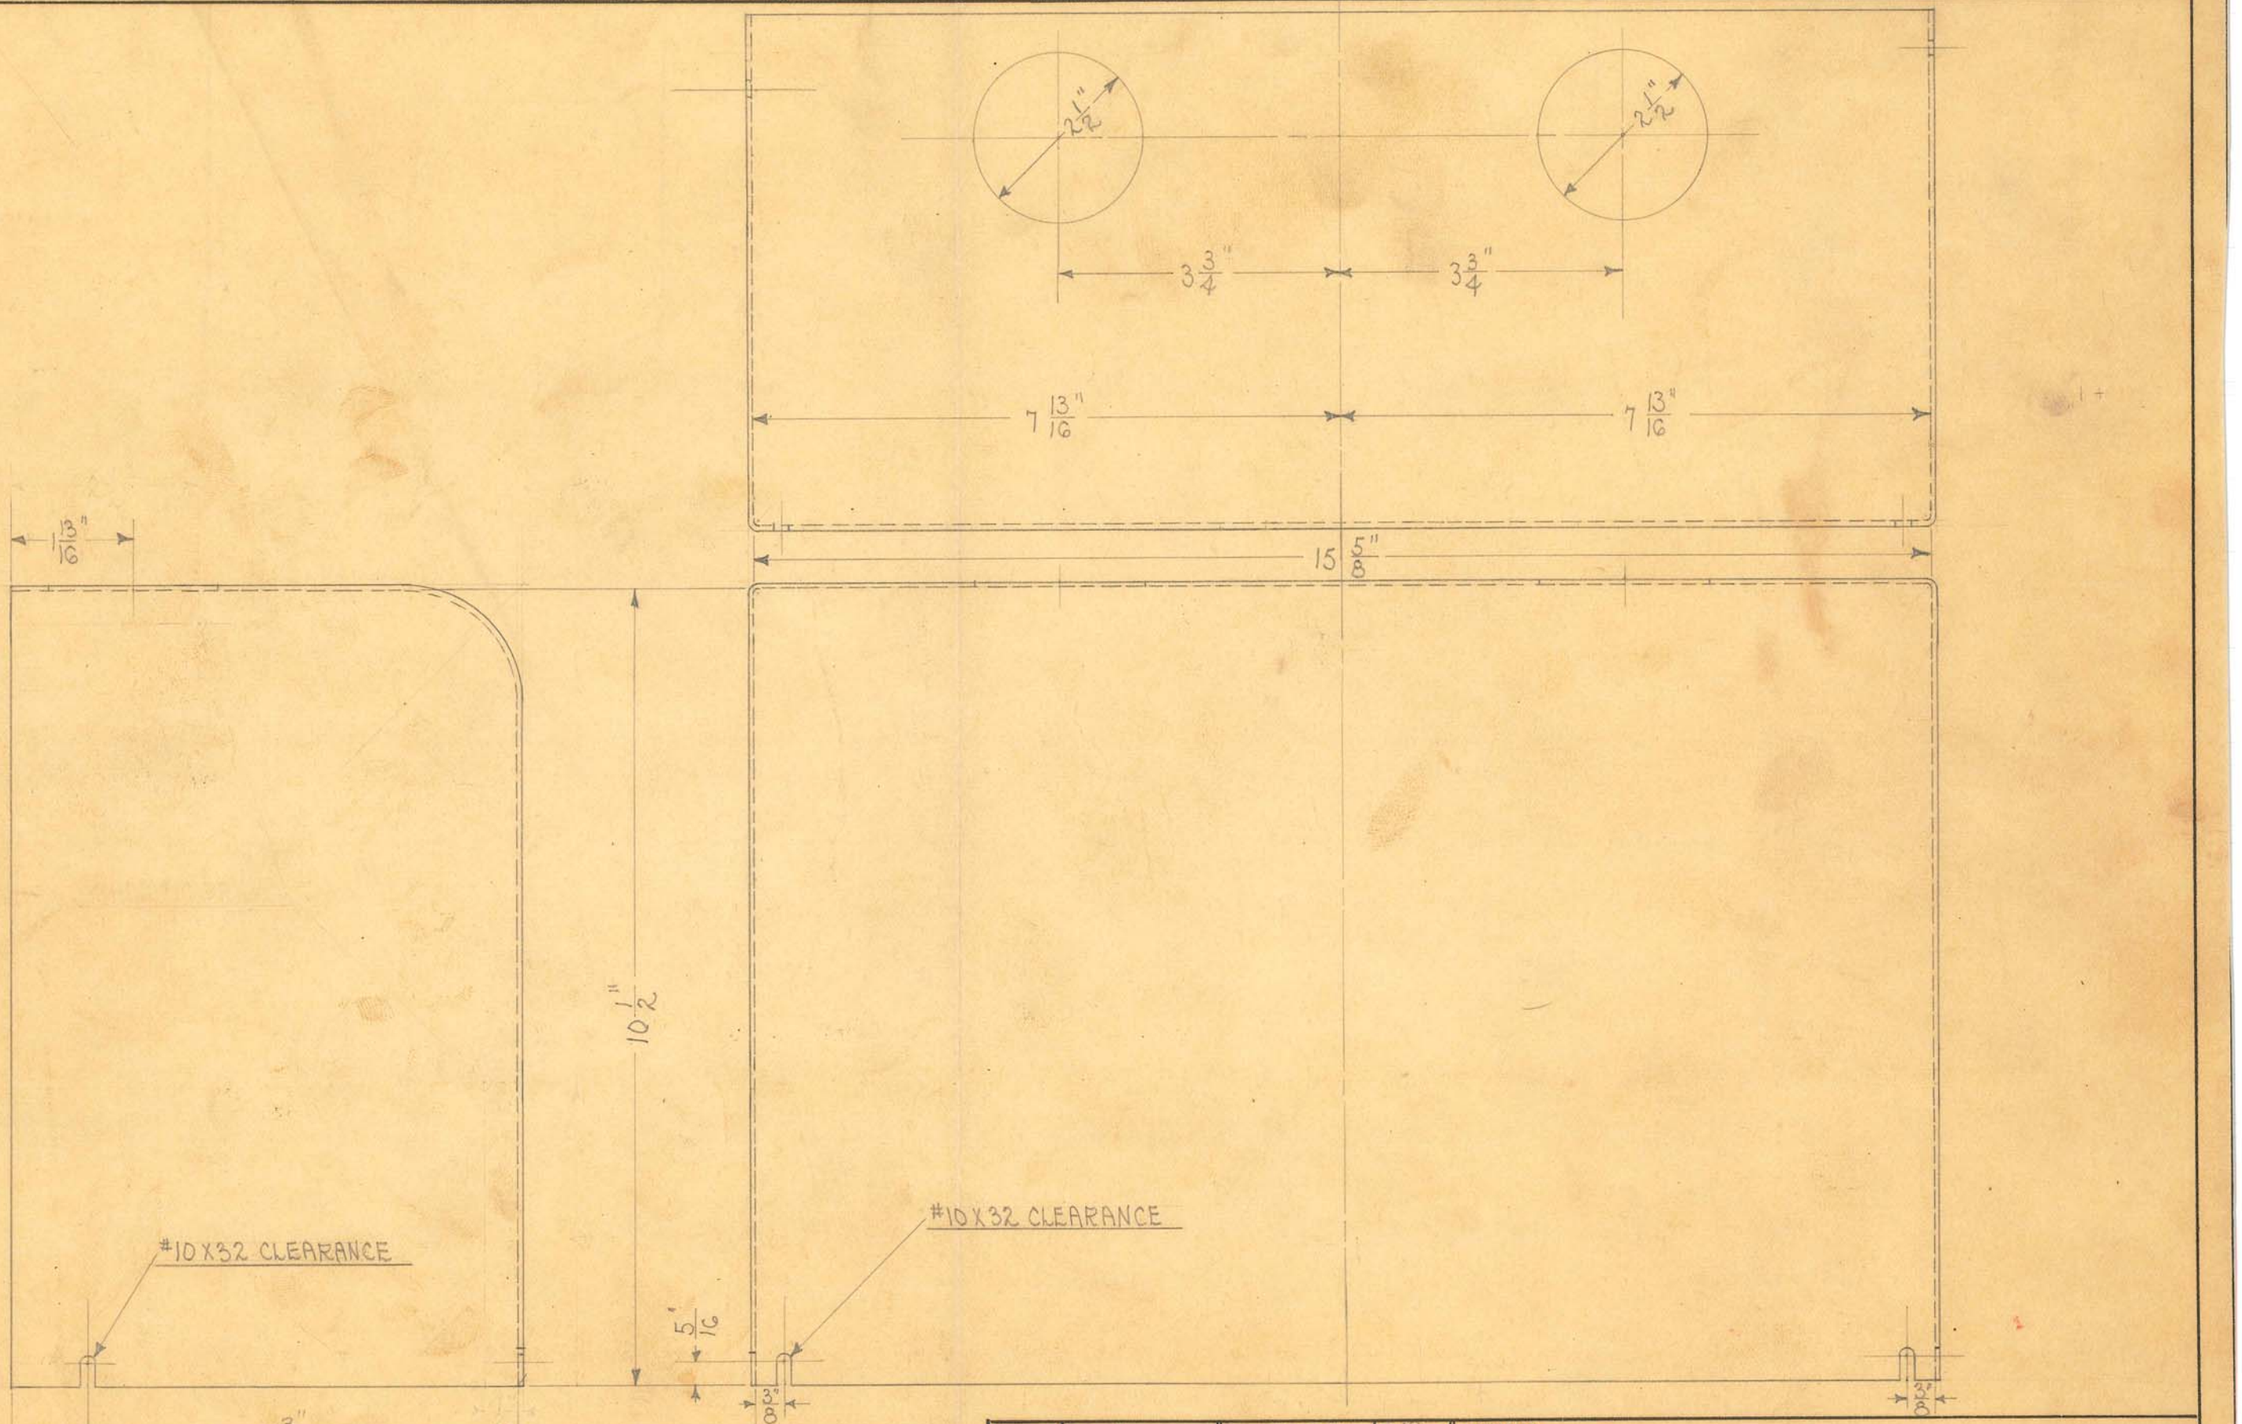

1 REQUIRED

SCALE = 1/2" = 1"

SIZE	.064"	ISSUE 7-27-33	A.E.
KIND	FURNITURE STEEL	CHANGED 8-30-33	N.P.
SHAPE		" "	
FINISH	BLK. LACQUER	" "	
TEMP.		" "	
PATT.		" "	

TITLE: UNIVERSAL "60-88" TRANS. COVER-REAR

OBSOLETE

H. G. FISCHER & CO.
2335 WABANSIA AVE.
CHICAGO, ILL.

CAT. NO.

PART NO. 8349F

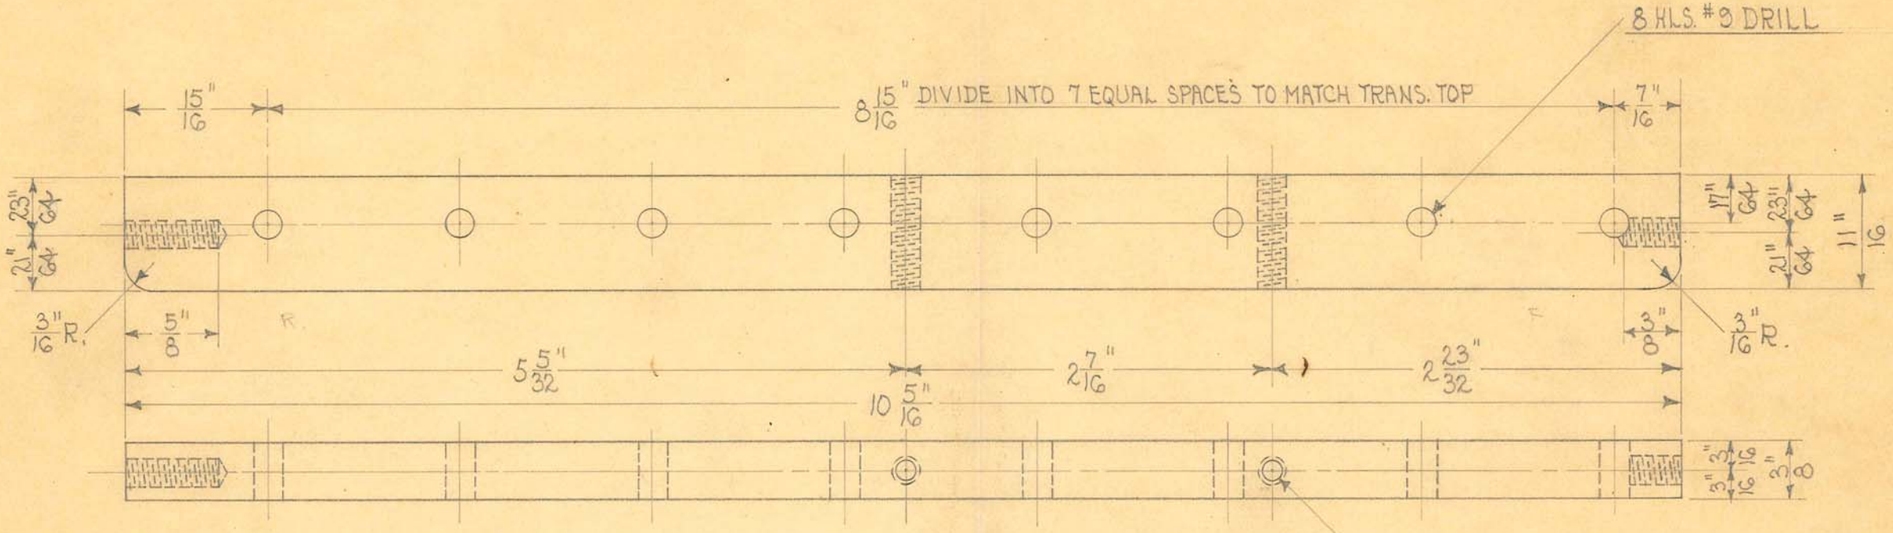

2 REQUIRED

OBSOLETE

SIZE		ISSUED 9-15-33	A.E.
KIND	C.R. STEEL	CHANGED	
SHAPE	"	" "	
FINISH		" "	
TEMP.		" "	
PATT.		" "	

TITLE: UNIVERSAL "60-88" TRANS. COVER SUPPORT STRIP

H. G. FISCHER & CO.
2335 WABANSIA AVE.
CHICAGO, ILL.

CAT. NO.

PART NO. 8350

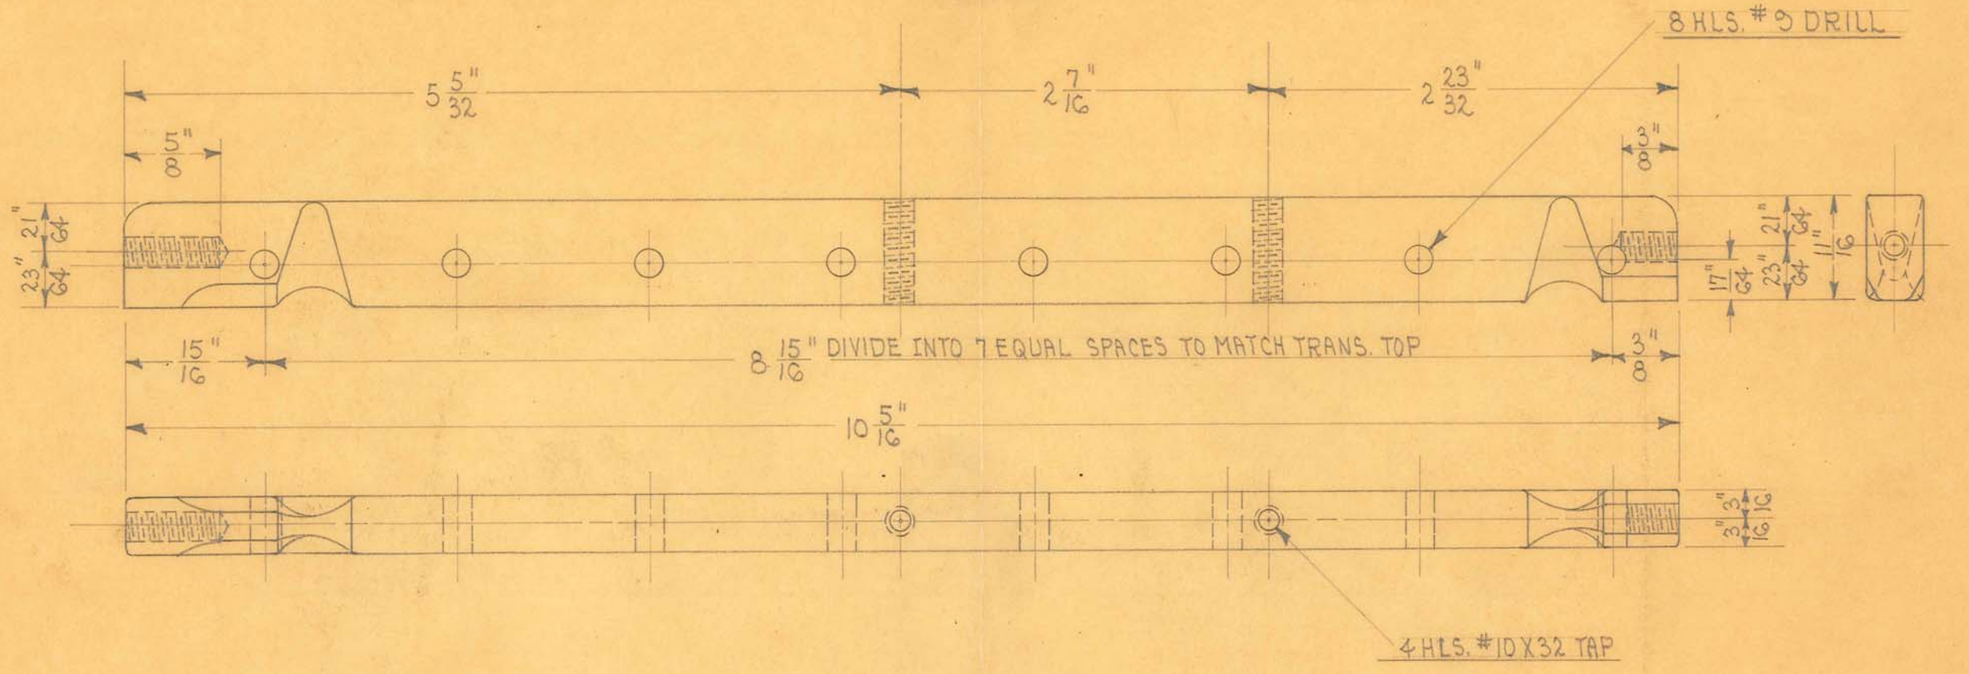

2 REQUIRED

OBSOLETE

SIZE		ISSUE 12-6-35	JAE	TITLE: UNIVERSAL "60-88" TRANS. COVER SUPPORT STRIP
KIND	ALUM. CASTING	CHANGED		
SHAPE		" "		
FINISH		" "		
TEMP.		" "		H. G. FISCHER & CO. 2335 WABANSIA AVE. CHICAGO, ILL. — CAT. NO. — PART NO. 8350AF
PATT.	4597-923	" "		

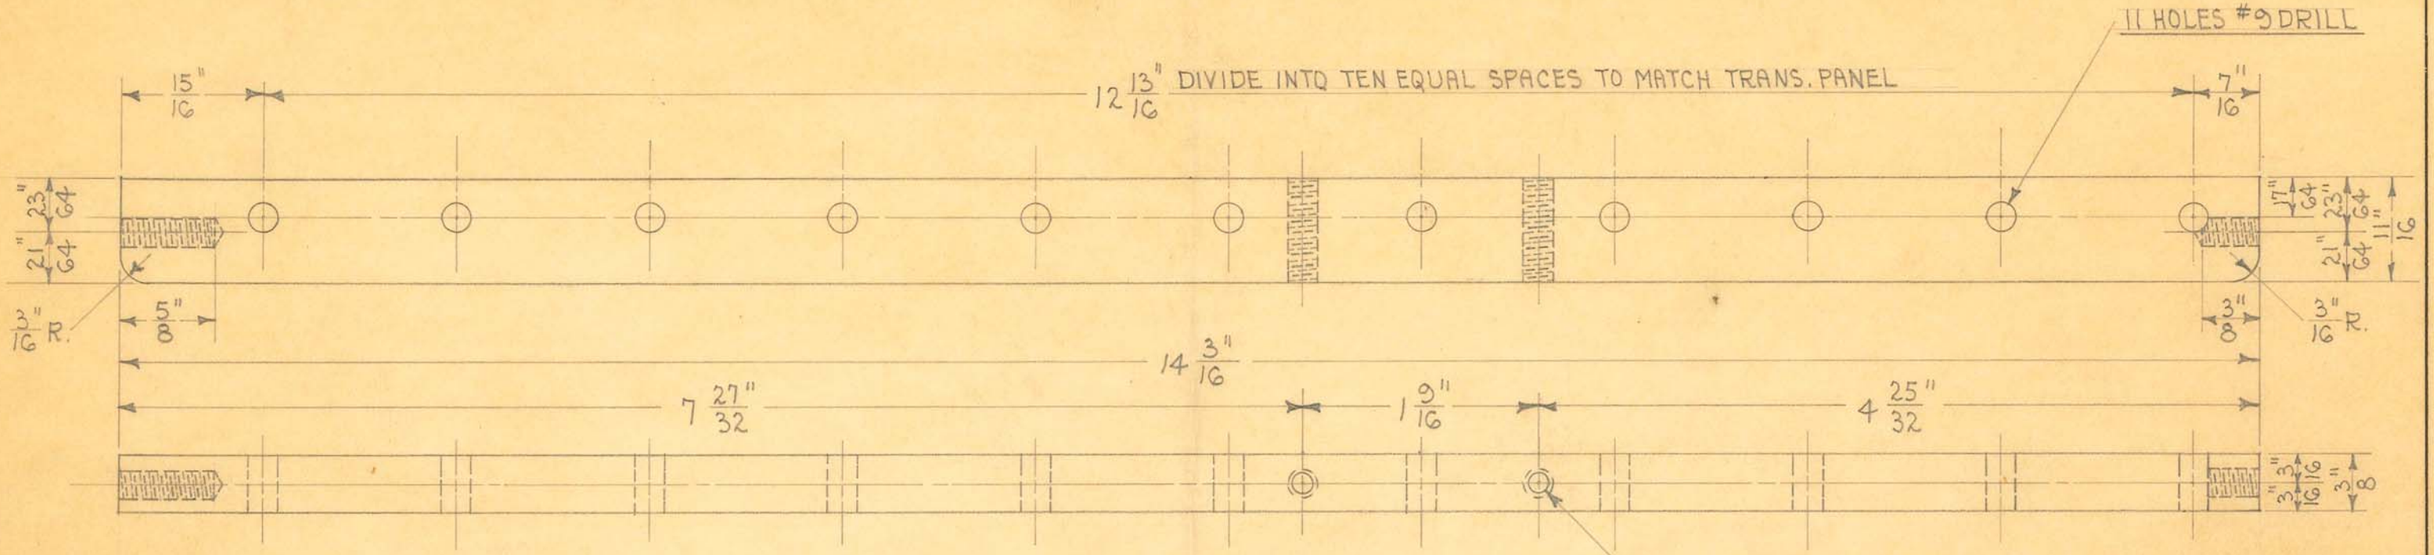

2 REQUIRED

OBSOLETE

SIZE	1/16" X 3/8"	ISSUE 4-3-36	J.E.	TITLE: 25 CYCLE "GO-88" TRANSFORMER COVER SUPPORT STRIP
KIND	C.R. STEEL	CHANGED		
SHAPE		" "		
FINISH		" "		
TEMP.		" "		
PATT.		" "		

H. G. FISCHER & CO.
2335 WABANSIA AVE.
CHICAGO, ILL.

CAT. NO.

PART NO. 8350 1/2

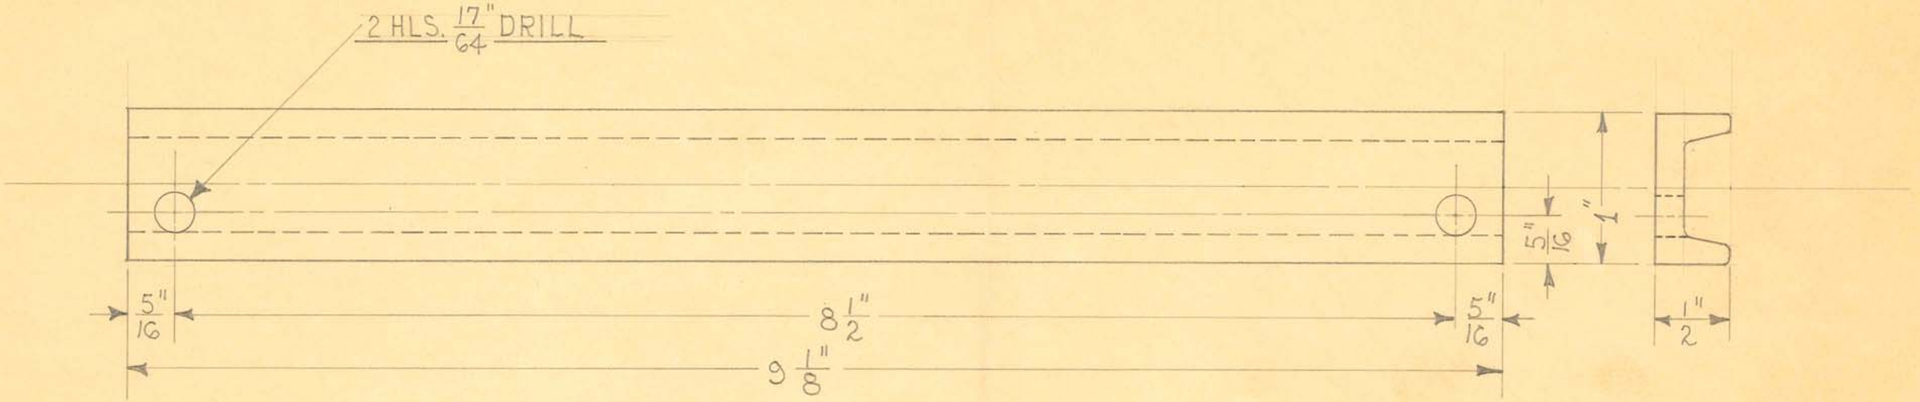

2 REQUIRED

OBSOLETE

SIZE	1"X 1/2"	ISSUE 10-29-36	A.E.	TITLE: 25 CYCLE "60-88" H.T. TRANSFORMER STRAP
KIND	CHANNEL IRON	CHANGED		
SHAPE		"		
FINISH		"		
TEMP.		"		
PATT.		"		

H. G. FISCHER & CO.
2335 WABANSIA AVE.
CHICAGO, ILL.

CAT. NO.

PART NO. 8351 1/2

11½ x 17

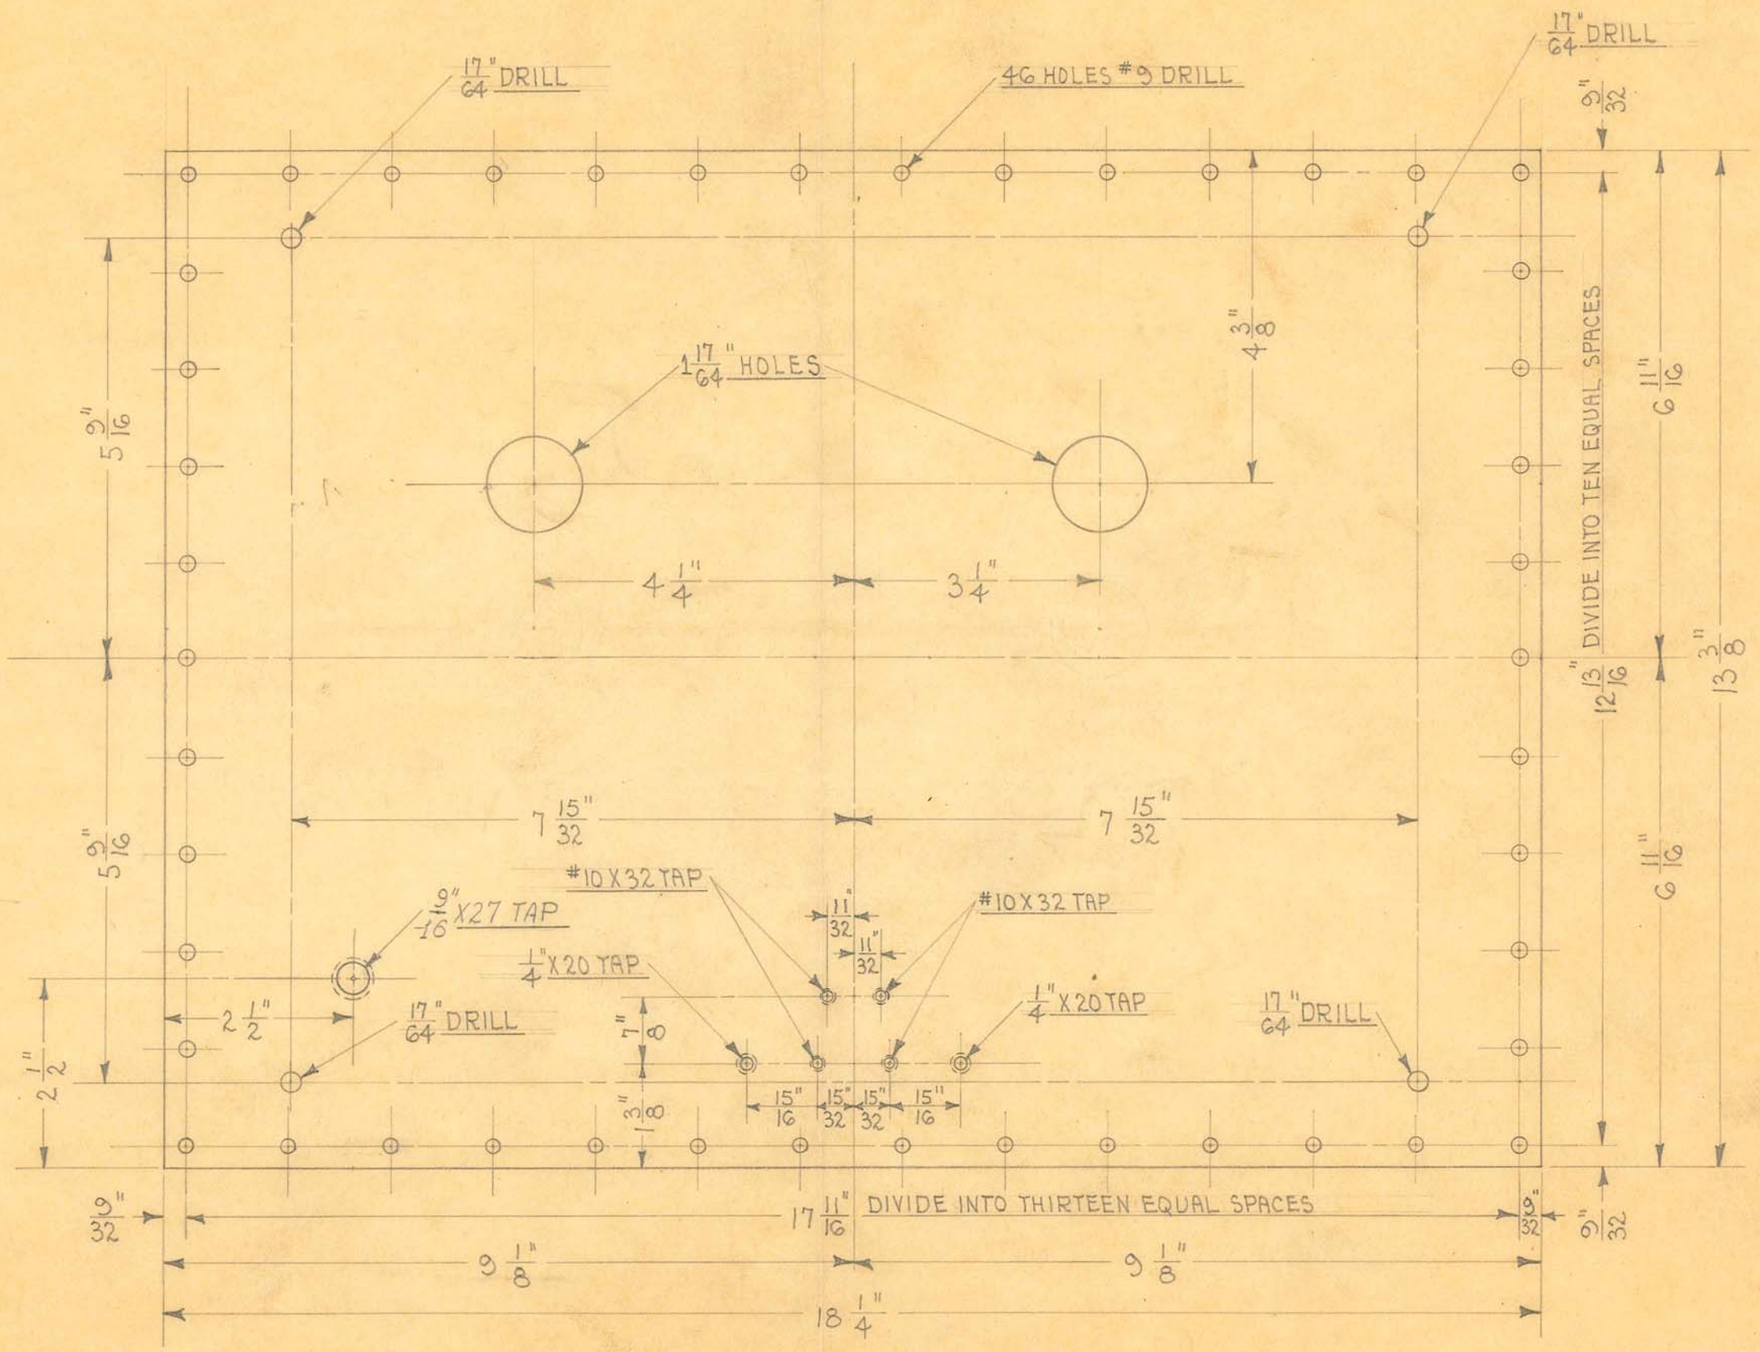

3/8" SHEET BAKELITE
SCALE ~ 1/2" = 1"

SIZE	18¼" X 13 3/8" X 3/8"	ISSUE 4-3-36	A.E.	TITLE: 25 CYCLE "60-88" TRANSFORMER PANEL
KIND	BAKELITE SHEET	CHANGED 4-9-37	J.W.	
SHAPE		" "		
FINISH		" "		
TEMP.		" "		
PATT.		" "		

H. G. FISCHER & CO.
2335 WABANSIA AVE.
CHICAGO, ILL.

CAT. NO.

PART NO. 8355½A

OBSOLETE

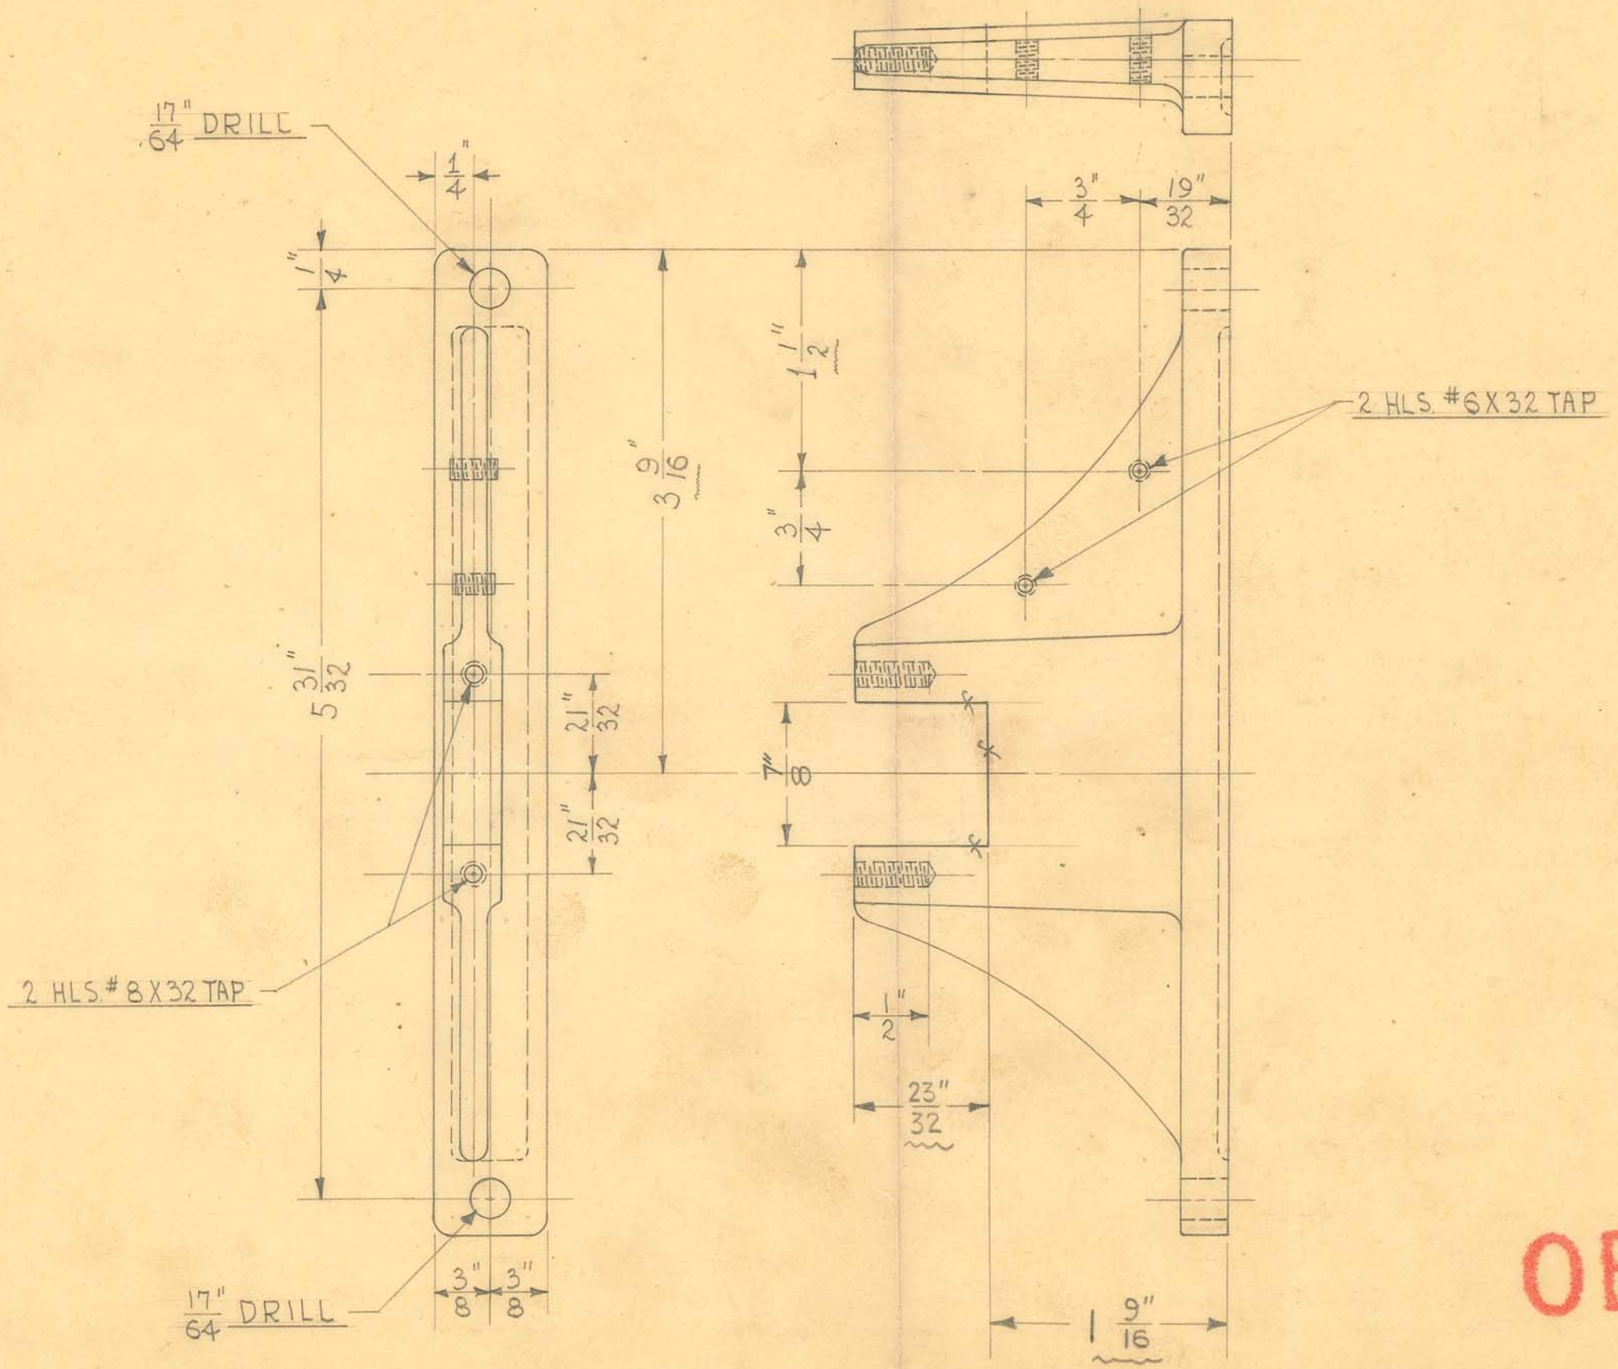

1 REQUIRED

OBSOLETE

SIZE		ISSUE 6-22-39	HE.	TITLE: "TM-30-96" FISCHER MOD "~~GM-30~~" MOBILE SHOCKPROOF X-RAY UNIT- TRANSF. CLAMP & FIL. TRANSF. SUPP. -LEFT
KIND	IRON CASTING	CHANGED 6-2-42	J.V.W.	
SHAPE		"		
FINISH		"		
TEMP.		"		
PATT.	1364	"		

H. G. FISCHER & CO.
2335 WABANSIA AVE.
CHICAGO, ILL.

CAT. NO.

PART NO. 12614FA

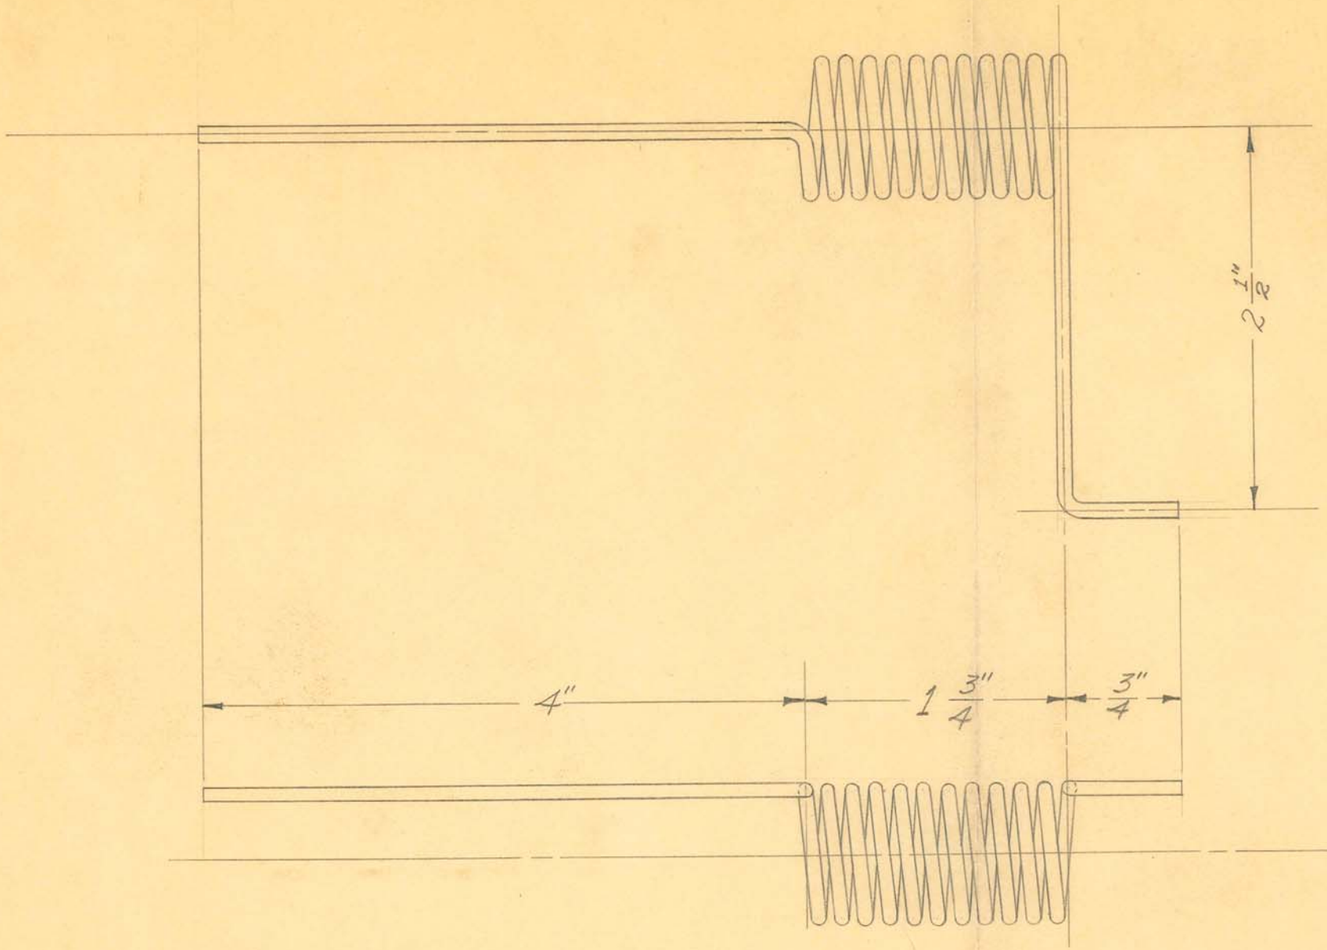

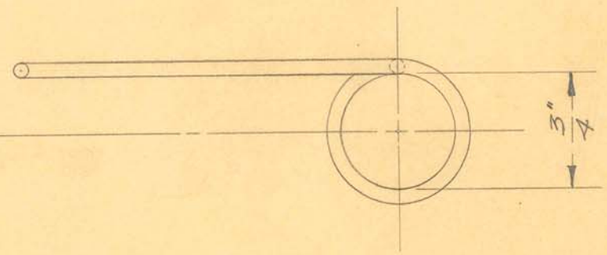

11 TURNS

1 REQUIRED

OBSOLETE

SIZE	#10 TINNED	ISSUE 3-16-39	J.W.
KIND	COPPER WIRE	CHANGED	
SHAPE		"	
FINISH		"	
TEMP.		"	
PATT.		"	

TITLE: FISCHER MOD. PORT. "5" 6 METER SHORT WAVE PATIENT'S TUNING COIL-RIGHT

H. G. FISCHER & CO.
2335 WABANSIA AVE.
CHICAGO, ILL.

CAT. NO.

PART NO. 12558

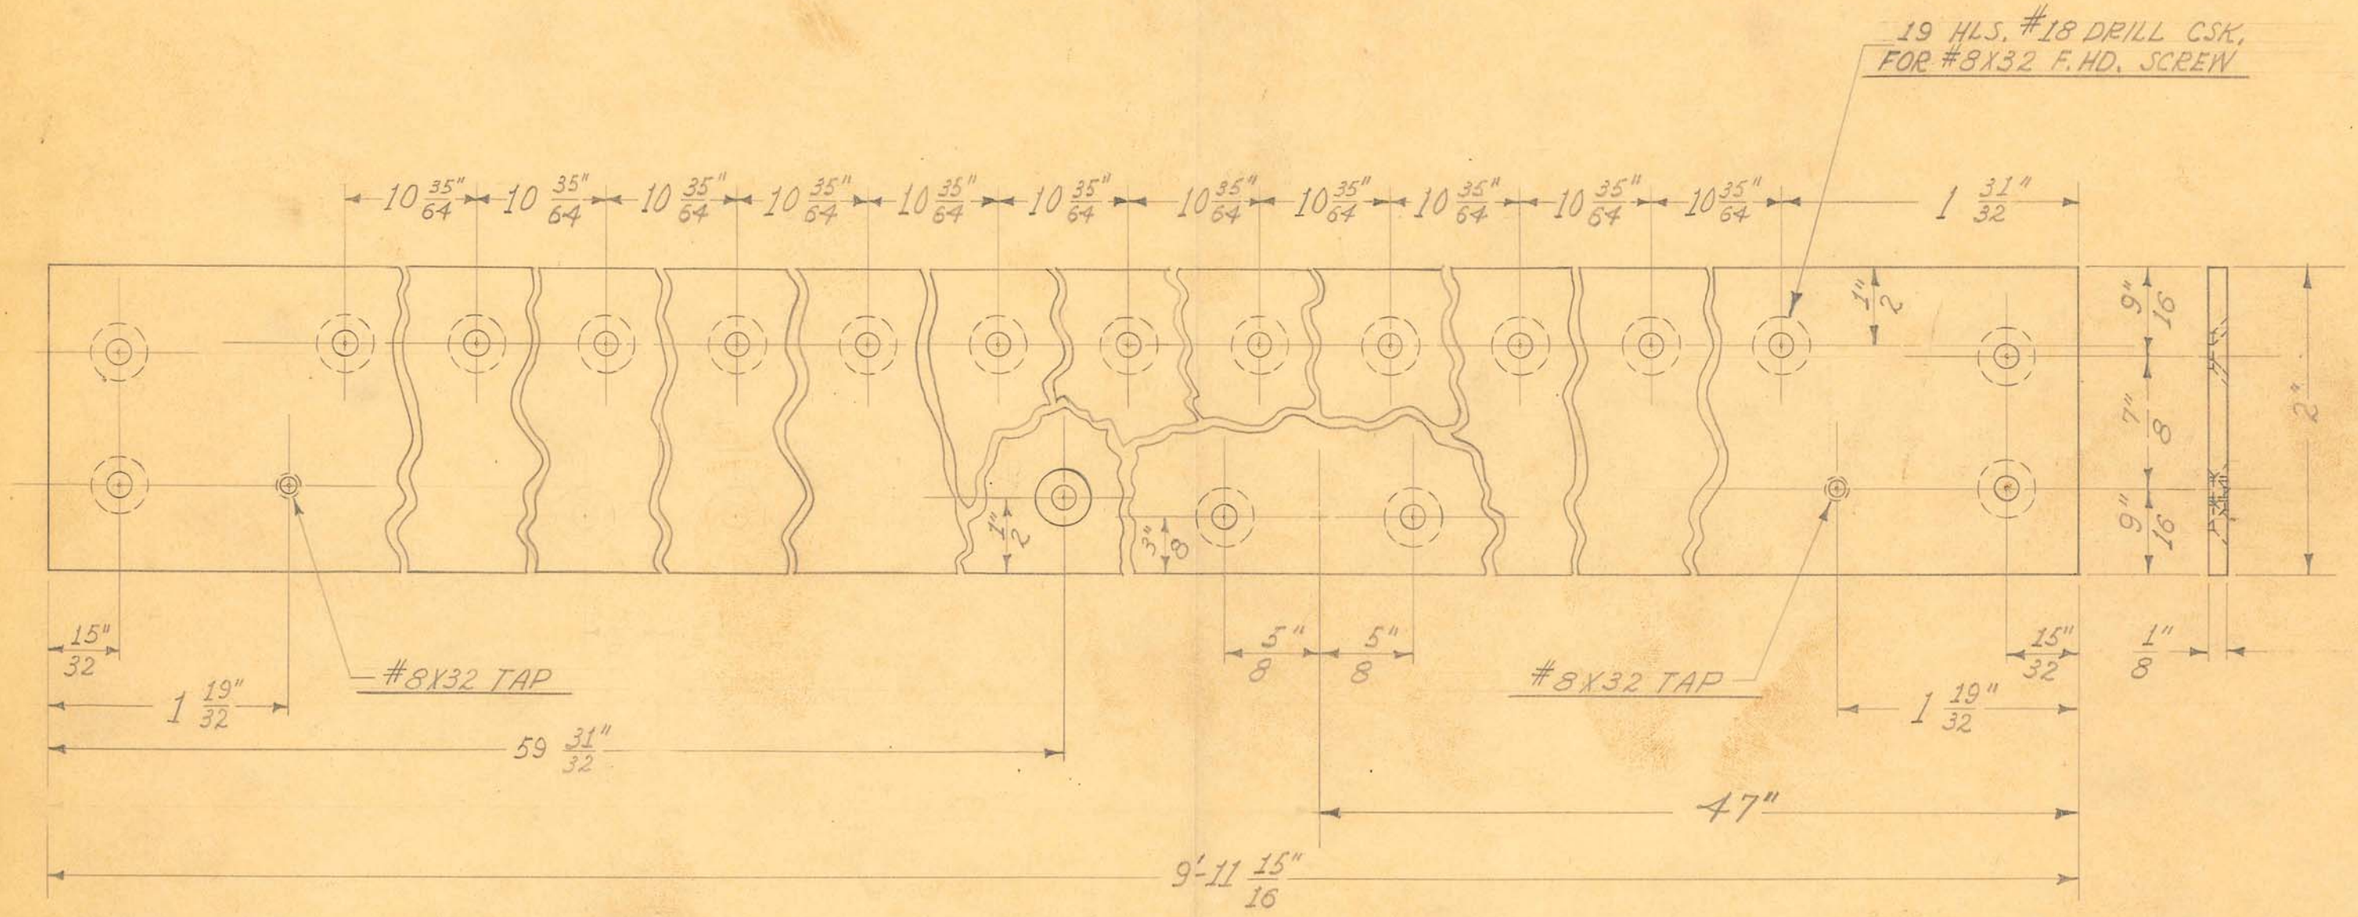

1 REQUIRED

OBSOLETE

SIZE	1/8" X 2"	ISSUE 8-30-37	J.W.	TITLE: "60-88" & TILT TABLE -10' RAIL RAIL PLATE
KIND	C.R. STEEL	CHANGED 9-14-37	J.W.	
SHAPE	STRIP	"		
FINISH	CAD. & LAC.	"		
TEMP.	#26	"		
PATT.		"		

H. G. FISCHER & CO.
2335 WABANSIA AVE.
CHICAGO, ILL.

CAT. NO.

PART NO. 10338

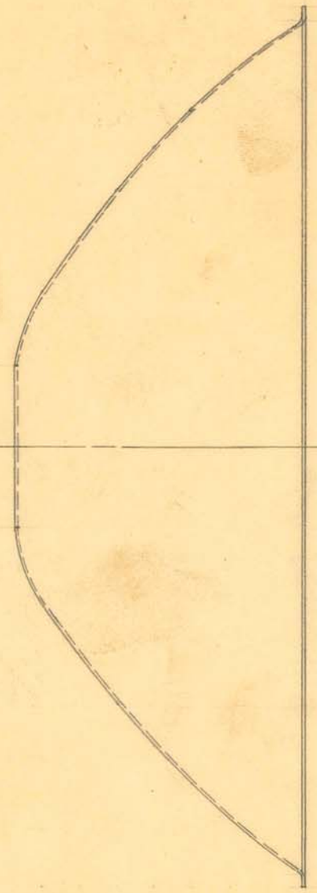

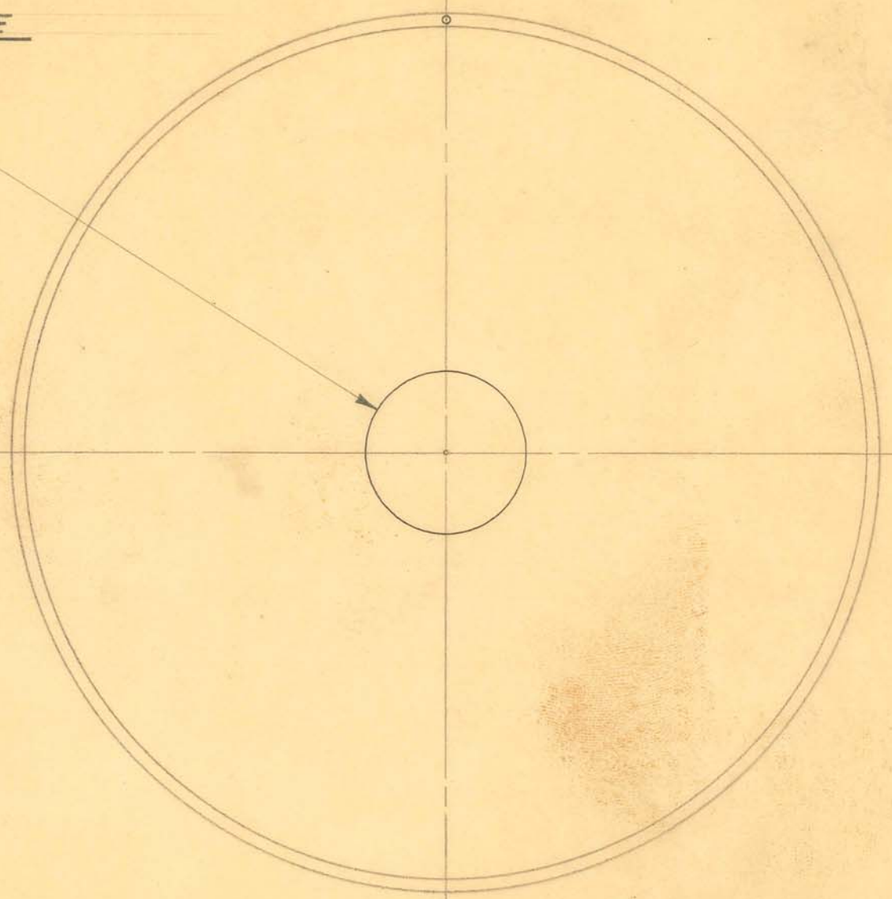

SCALE ÷ 1/2 = 1"

1 REQUIRED

OBSOLETE

SIZE	FROM 10339	ISSUE ~~4-27-39~~	J.W.	TITLE: FISCHER INFRA RED LAMP APLANATIC REFLECTOR -DRILLED
KIND		CHANGED		
SHAPE		"		
FINISH		"		
TEMP.		"		
PATT.		"		

H. G. FISCHER & CO.
2335 WABANSIA AVE.
CHICAGO, ILL.

CAT. NO.

PART NO. 10339F

#30 DRILL C'SUNK.
AS SHOWN FOR RIVETING

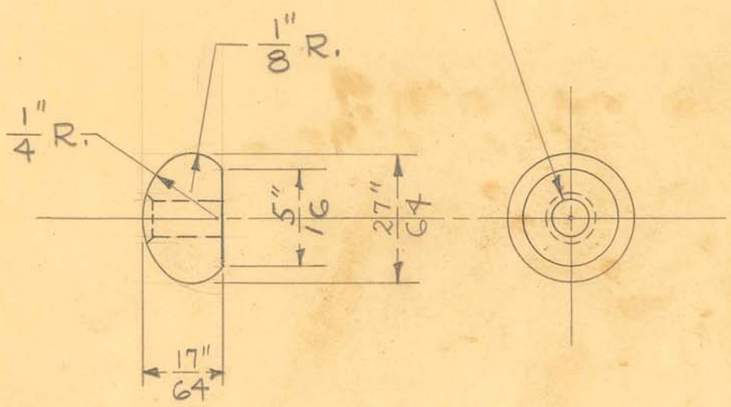

SCALE ~ DOUBLE SIZE

7/16" DIA. BRASS ROD

2 REQUIRED

SPOT FOR RIVETING

1/32" X 45° CHAMFER

#10X32 THREAD

UNDERCUT THREAD

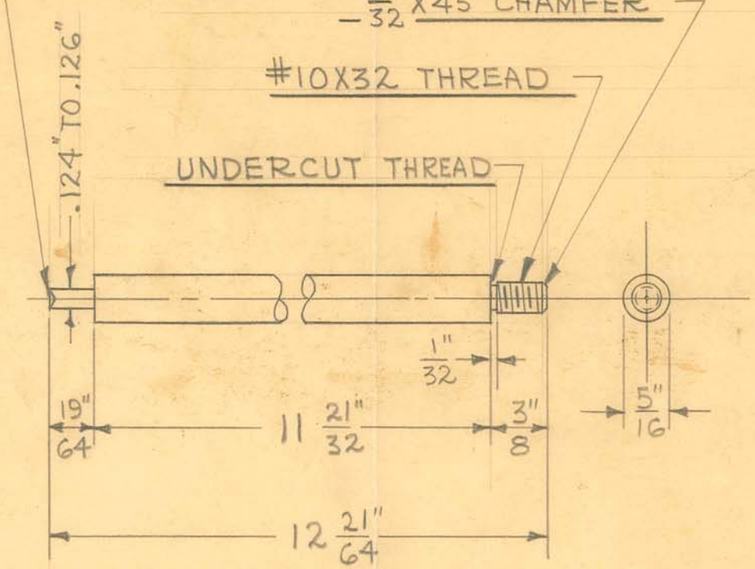

5/16" DIA. C.R. STEEL ROD

2 REQUIRED

RIVET & SMOOTHEN TO
CONTOUR OF BALL

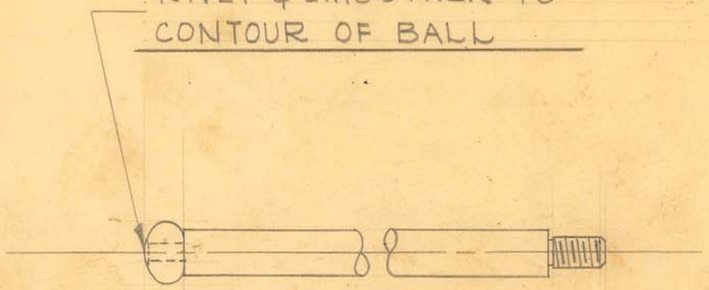

2 REQUIRED

OBSOLETE

SIZE		ISSUE	11-12-45	J.V.W.
KIND		CHANGED		
SHAPE		"		
FINISH	CAD, #23	"		
TEMP.		"		
PATT.		"		

TITLE: FISCHER RAD. & FLUO. TILT TABLE HEAD & HIP SUPP. - BEARING ROD ASSEM.

H. G. FISCHER & CO.
2335 WABANSIA AVE.
CHICAGO, ILL.

CAT. NO.

PART NO. 10342G

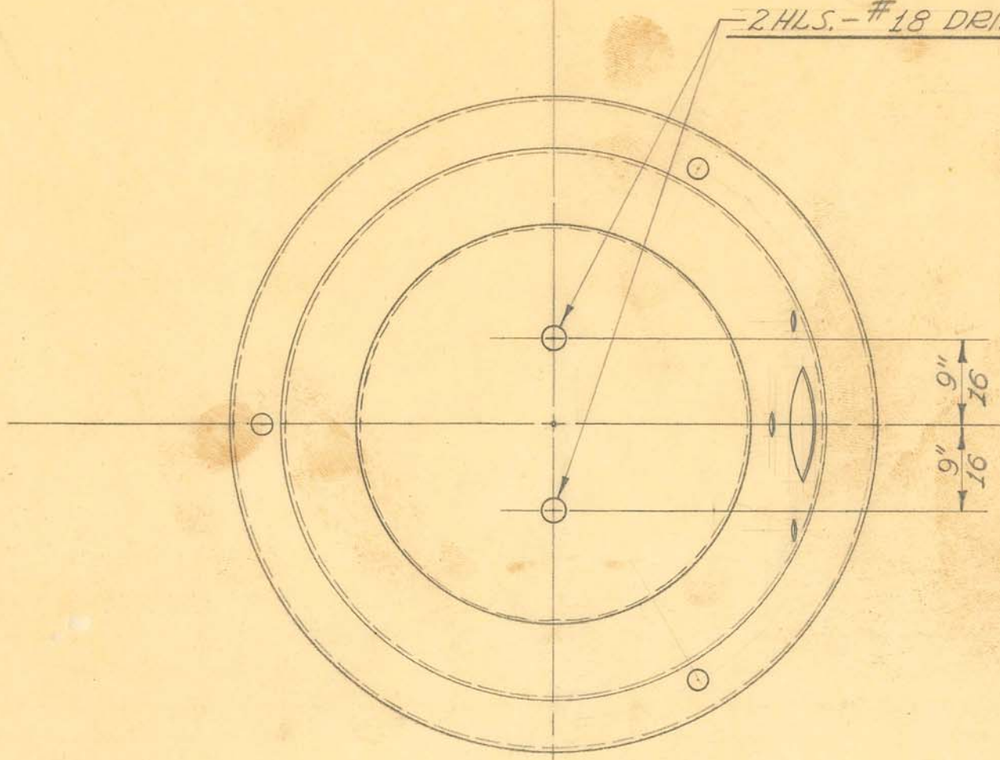

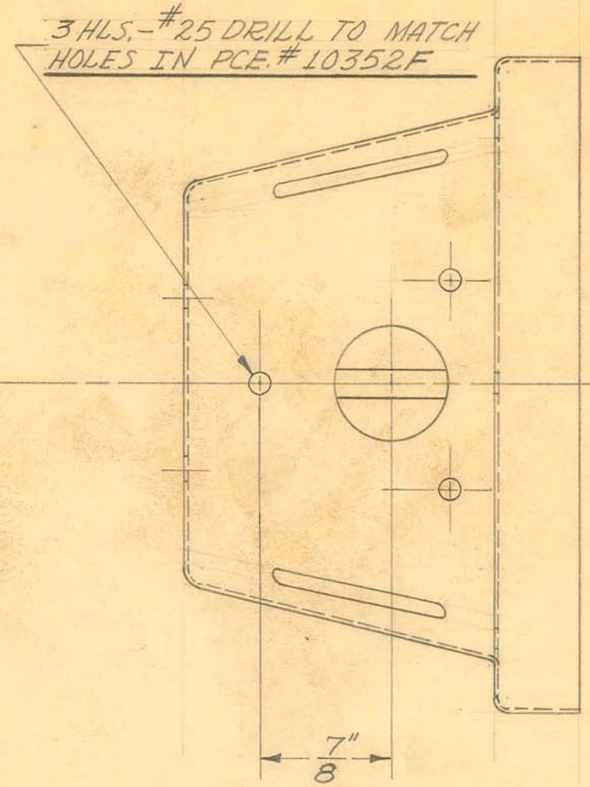

1 REQUIRED

OBSOLETE

SIZE		ISSUE 4-27-39 J.W.	TITLE: FISCHER INFRA RED LAMP OUTER HOOD CAP	
KIND		CHANGED		
SHAPE		"		
FINISH		"		
TEMP.		"	H. G. FISCHER & CO. 2335 WABANSIA AVE. CHICAGO, ILL.	CAT. NO.
PATT.		"		PART NO. 10364F

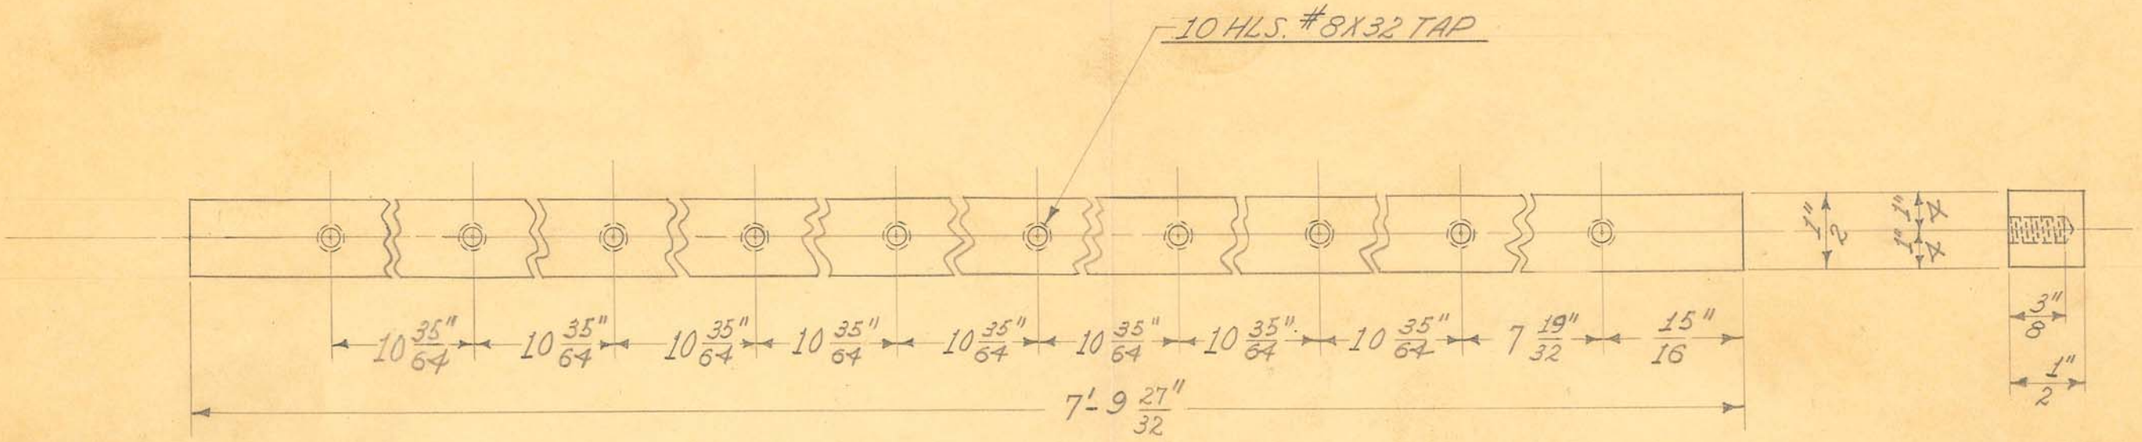

1 REQUIRED

OBSOLETE

SIZE	1/2" SQUARE	ISSUE 8-10-37	J. W.	TITLE: "SP-60" & HORIZONTAL TABLE 8 FT. RAIL - RAIL
KIND	C.R. STEEL	CHANGED		
SHAPE		"		
FINISH	CAD. #23	"		
TEMP.		"		
PATT.		"		

H. G. FISCHER & CO.
2335 WABANSIA AVE.
CHICAGO, ILL.

CAT. NO.

PART NO. 10380 1/2

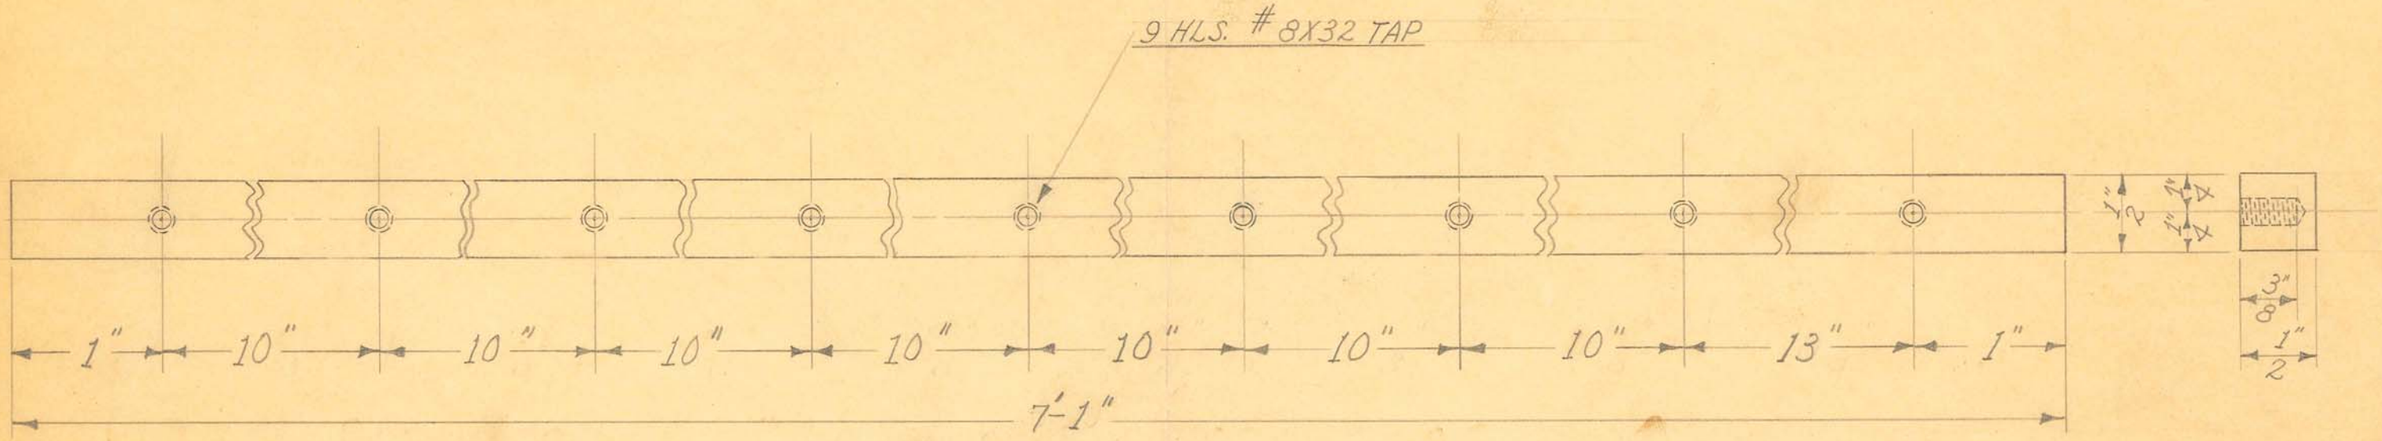

1 REQUIRED

OBSOLETE

OBSOLETE

SIZE	1/2" SQUARE	ISSUE 2-10-37	J.W.	
KIND	C.R. STEEL	CHANGED		
SHAPE		"		
FINISH	CAD. #23	"		
TEMP.		"		
PATT.		"		

TITLE: "SP-60" - "DSP-20" & TILT TABLE 7'3" RAIL-RAIL

H. G. FISCHER & CO.
2335 WABANSIA AVE.
CHICAGO, ILL.

CAT. NO.

PART NO. 10381A

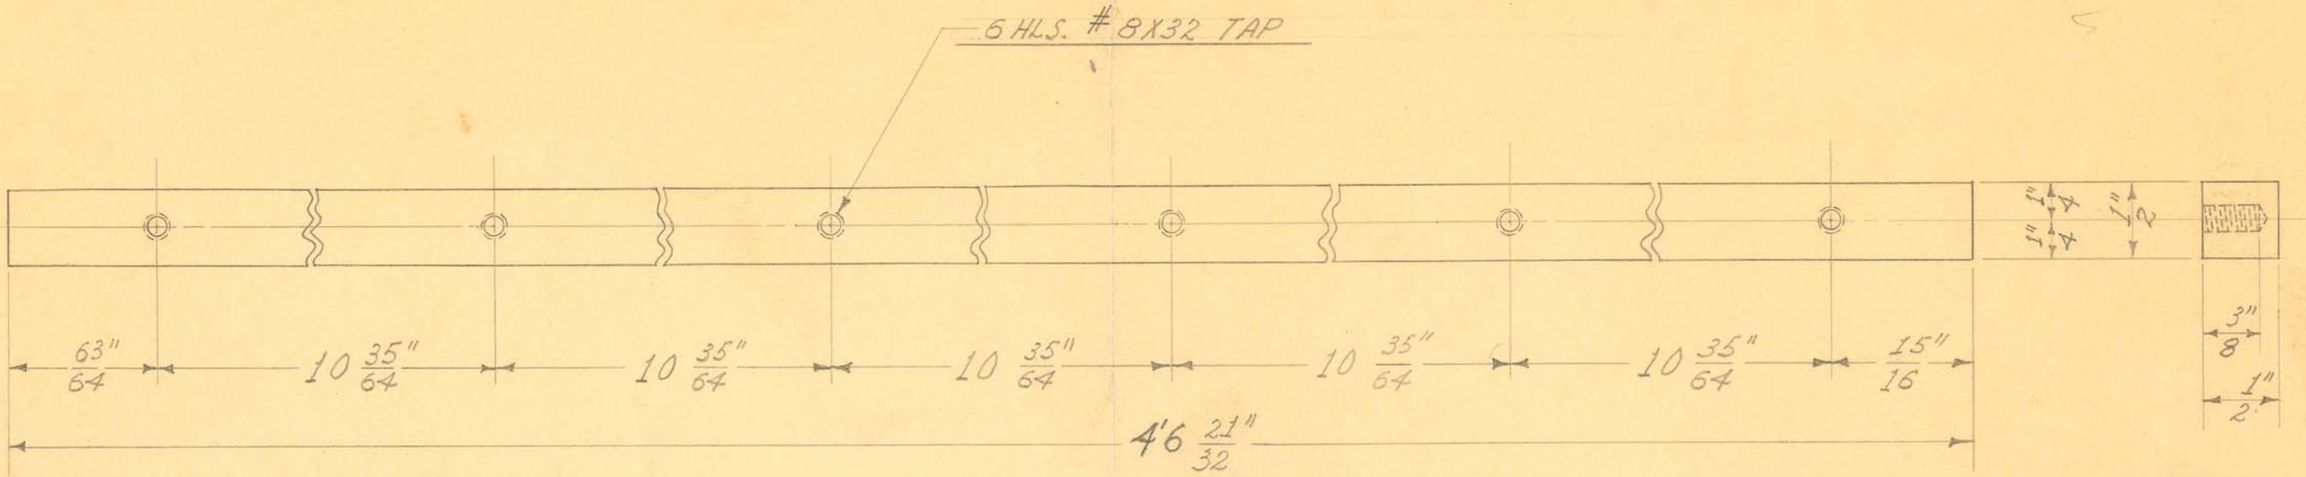

1 REQUIRED

OBSOLETE

SIZE	1/2" SQUARE	ISSUE 9-23-37	J.W.	TITLE: "60-88" & TILT TABLE 12'6" RAIL EXTENSION RAIL
KIND	C.R. STEEL	CHANGED		
SHAPE		"		
FINISH	CAD. #23	"		
TEMP.		"		
PATT.		"		

H. G. FISCHER & CO. 2338 WABANSIA AVE. CHICAGO, ILL.	CAT. NO.	PART NO. 10381B

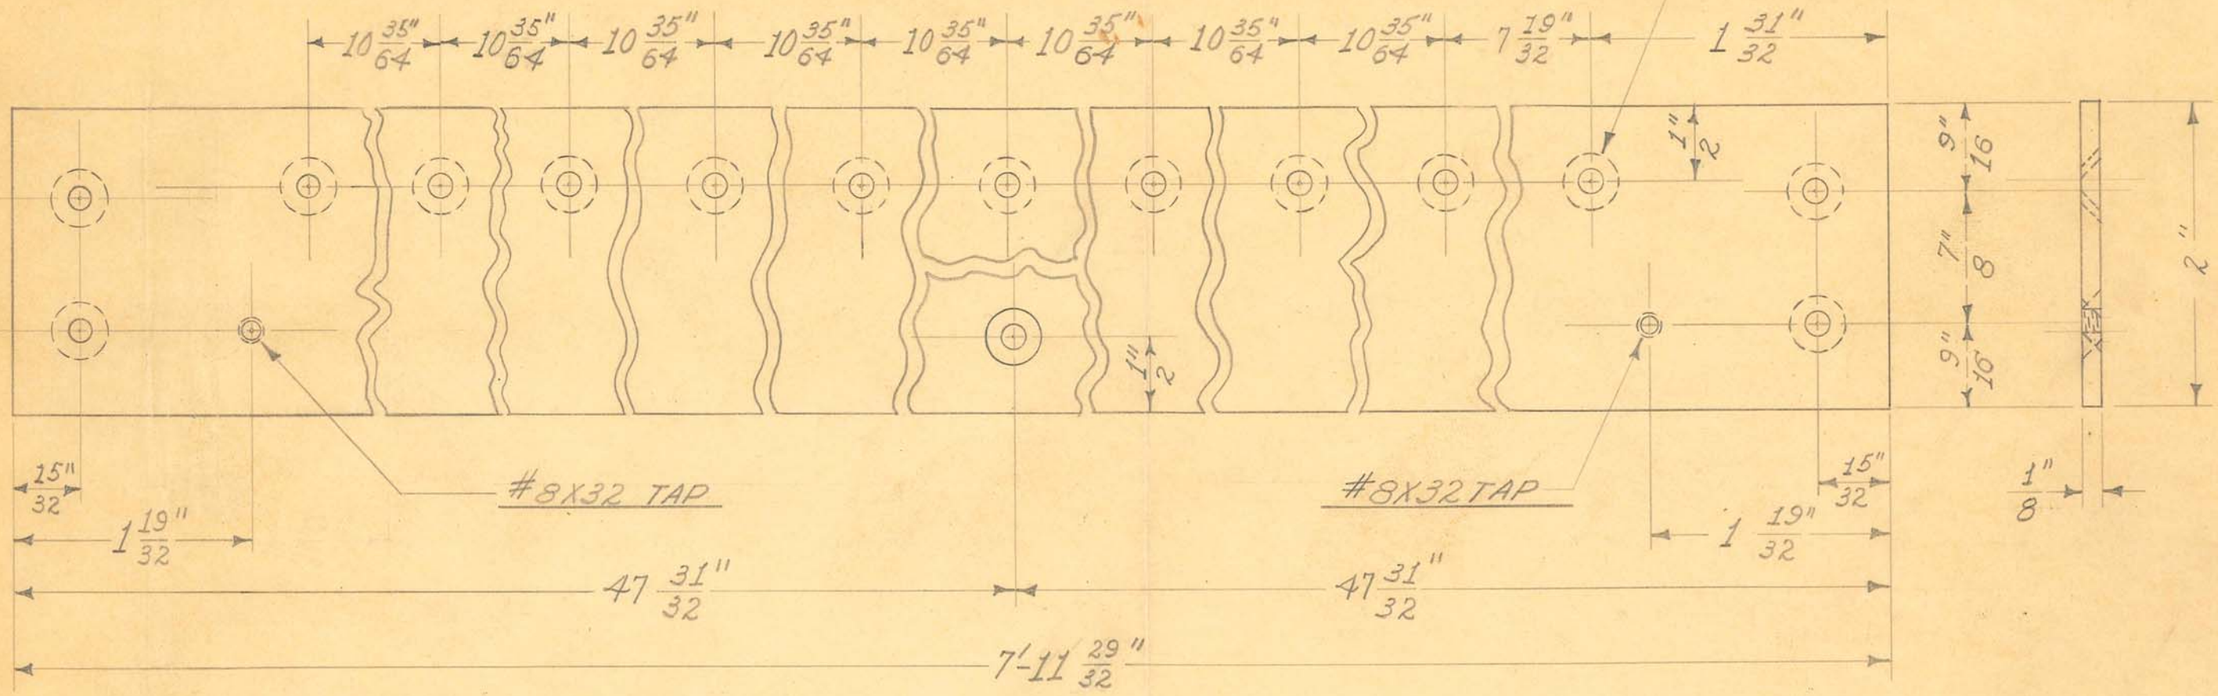

1 REQUIRED

OBSOLETE

SIZE	1/8" X 2"	ISSUE 8-10-37	J.W.	TITLE: "SP-60" & HORIZONTAL TABLE 8 FT. RAIL - RAIL PLATE
KIND	C.R. STEEL	CHANGED		
SHAPE		"		
FINISH	CAD. & LAC.	"		
TEMP.	#26	"		
PATT.		"		

H. G. FISCHER & CO.
2335 WABANSIA AVE.
CHICAGO, ILL.

CAT. NO.

PART NO. 10381 1/2

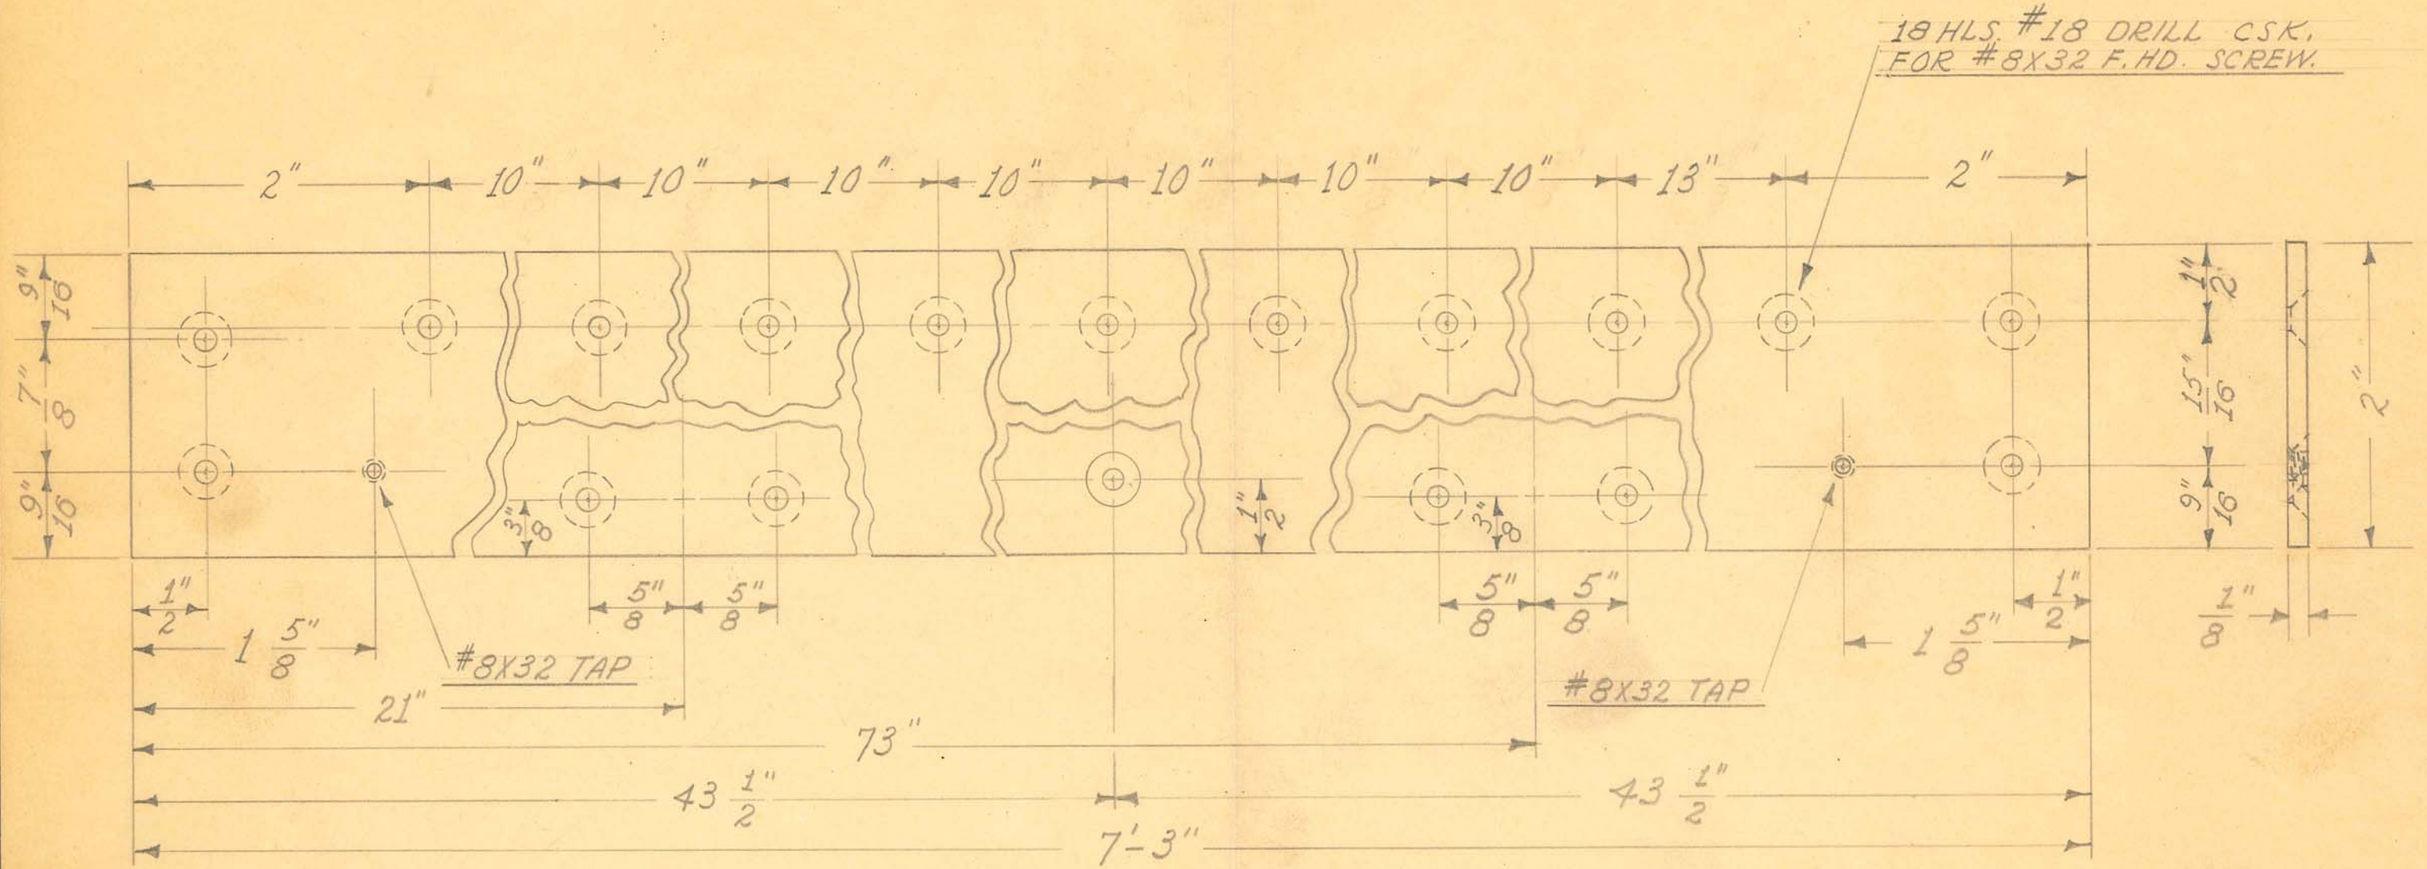

1 REQUIRED.

OBSOLETE

OBSOLETE

SIZE	1/8"X 2"	ISSUE 2-11-37	J.W.	
KIND	C.R. STEEL	CHANGED		
SHAPE		"		
FINISH	CAD. & LAC.	"		
TEMP.	#26	"		
PATT.		"		

TITLE: "SP-60"-"DSP-20"-TILT TABLE-7'3" RAIL
RAIL PLATE

H. G. FISCHER & CO.
2335 WABANSIA AVE.
CHICAGO, ILL.

CAT. NO.

PART NO. 10382A

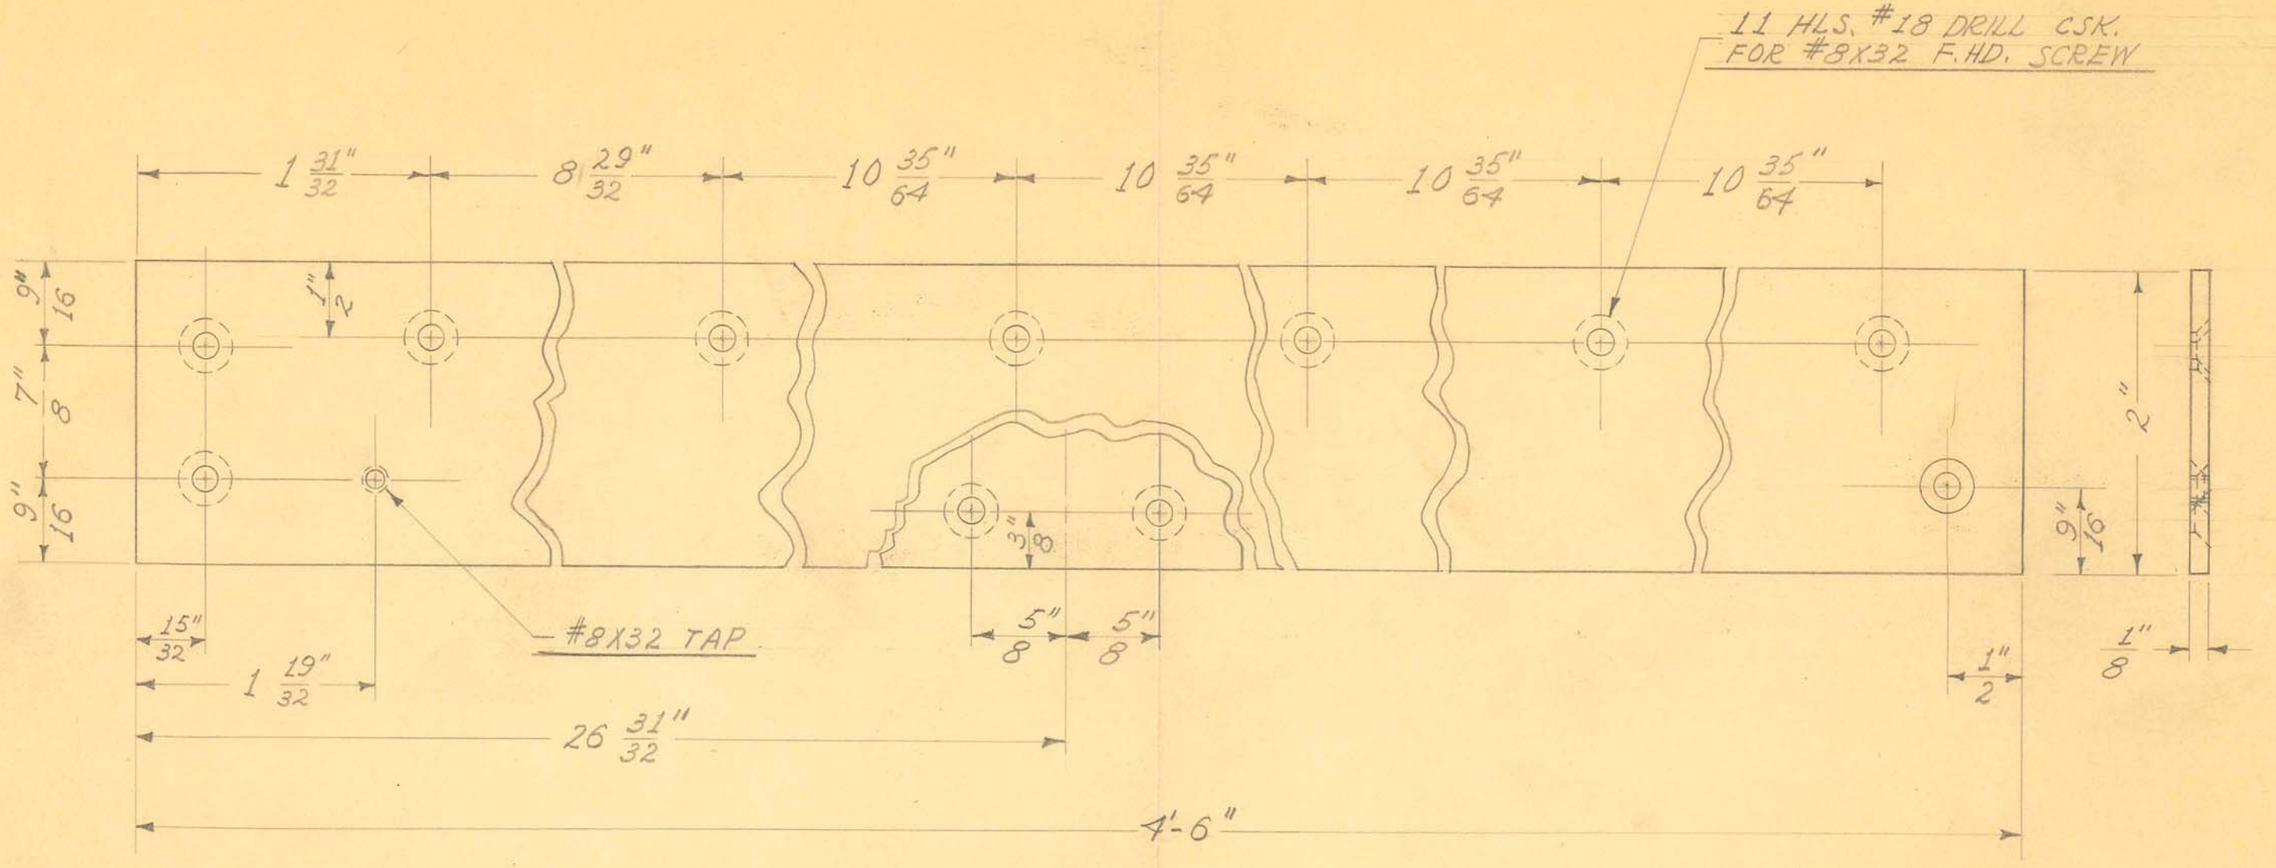

1 REQUIRED

OBSOLETE

SIZE	1/8" X 2"	ISSUE 9-22-37	J.W.
KIND	C.R. STEEL	CHANGED	
SHAPE		"	
FINISH	CAD. & LAC.	"	
~~TEMP.~~	#26	"	
PATT.		"	

TITLE: "60-88" & TILT TABLE 12'-6" RAIL EXTENSION RAIL PLATE

H. G. FISCHER & CO.
2335 WABANSIA AVE.
CHICAGO, ILL.

CAT. NO.

PART NO. 10382B

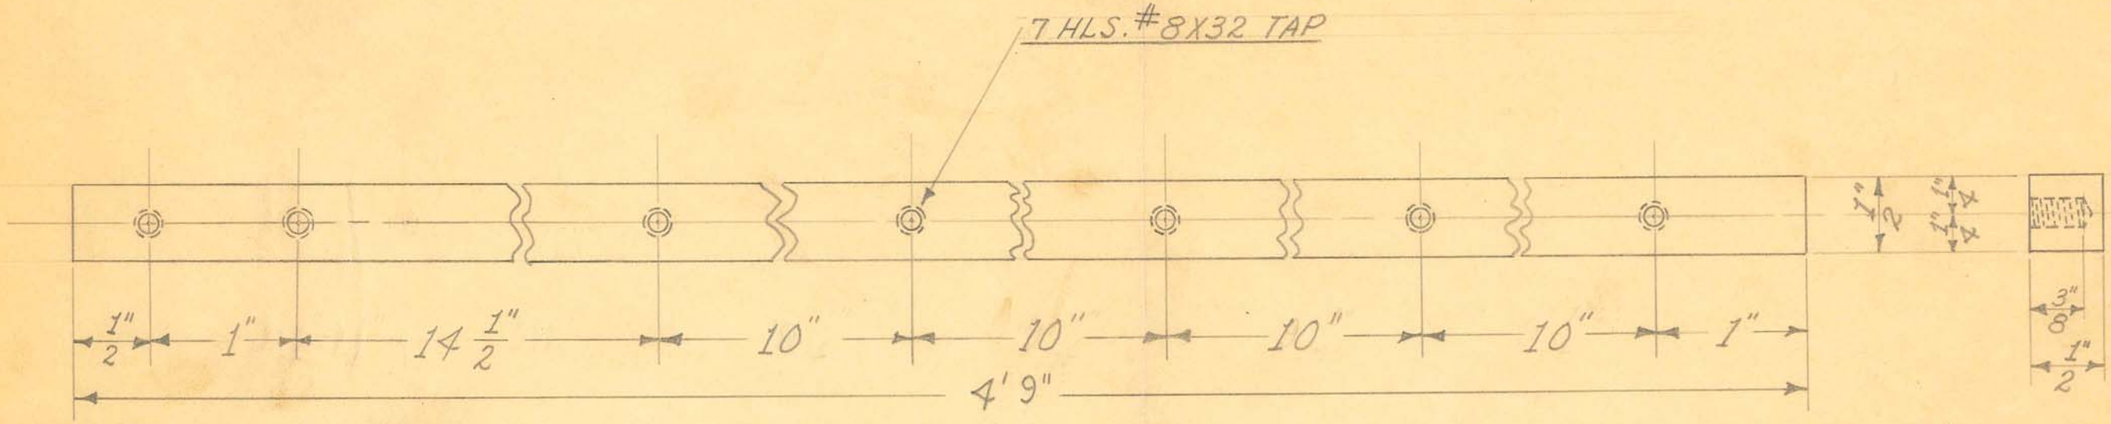

1 REQUIRED

OBSOLETE

OBSOLETE

SIZE	1/2" SQUARE	ISSUE 2-11-37	J. W.
KIND	C.R. STEEL	CHANGED	
SHAPE		"	
FINISH	CAD. #23	"	
TEMP.		"	
PATT.		"	

TITLE:
"60-88-SP-60" FOR TILT TABLE-12' RAIL
4'-9" EXTENSION - RAIL

H. G. FISCHER & CO.
2335 WABANSIA AVE.
CHICAGO, ILL.

CAT. NO.

PART NO. 10386

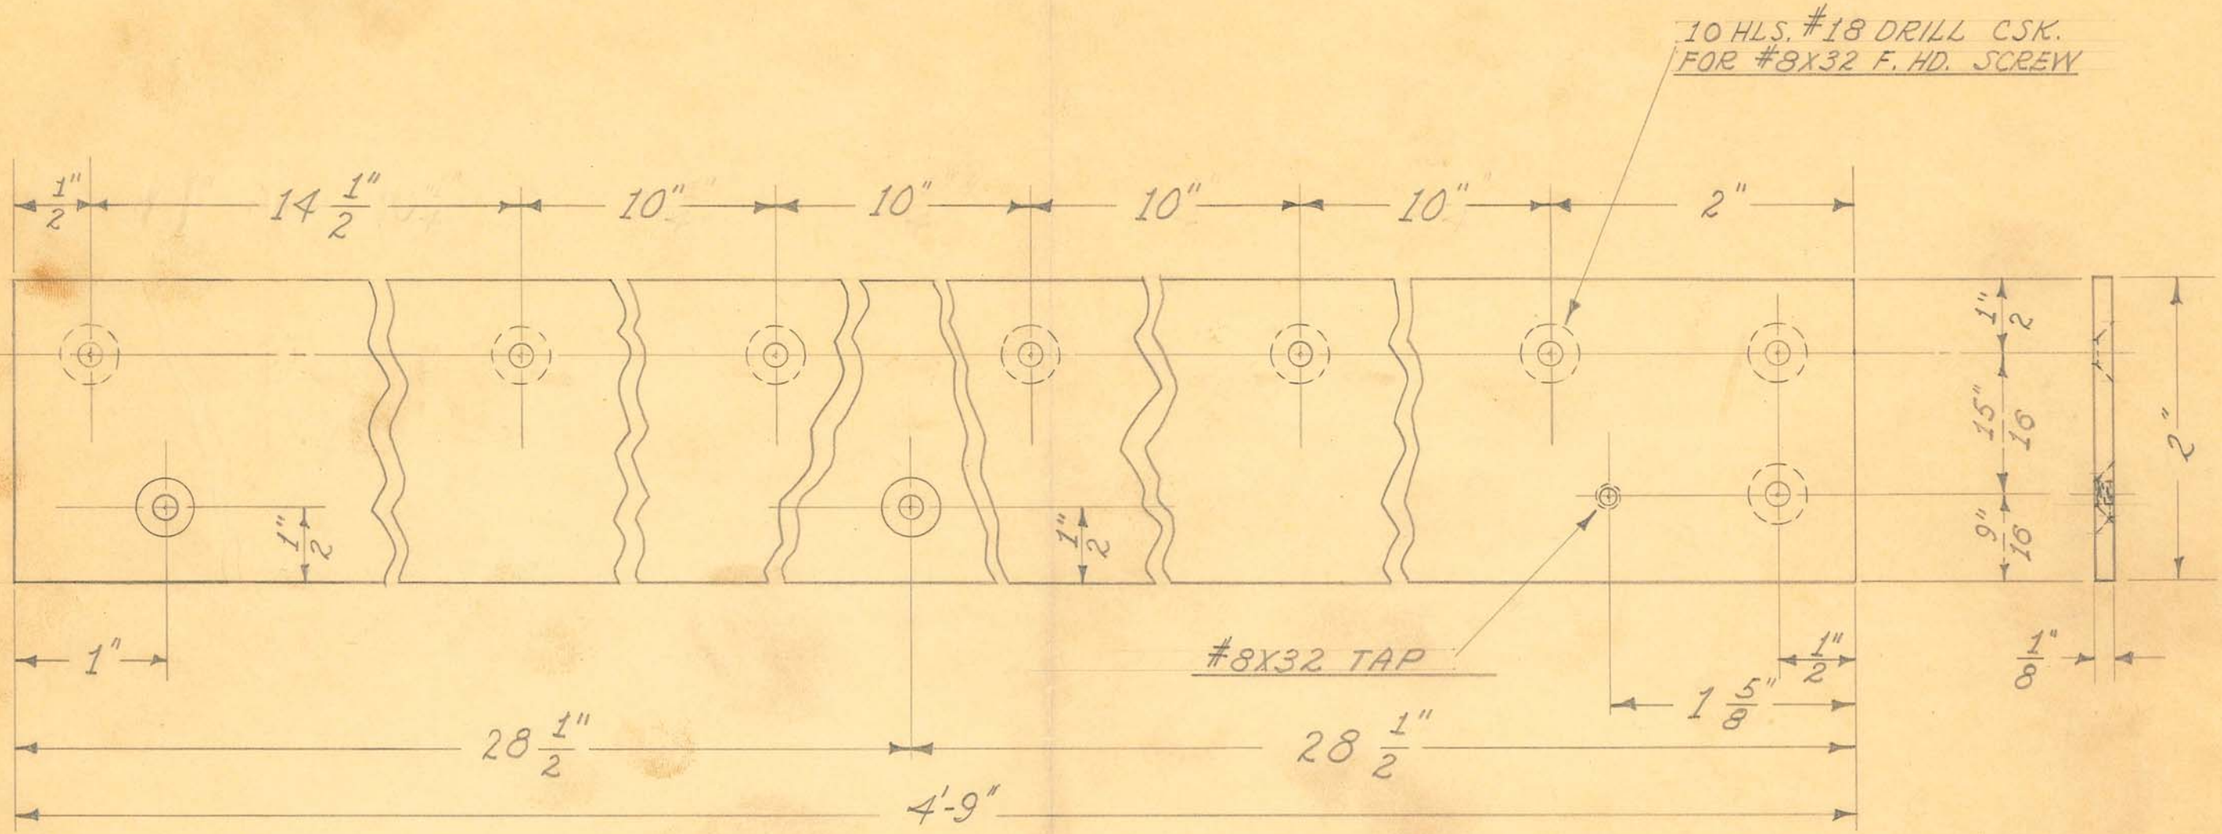

1 REQUIRED

OBSOLETE

OBSOLETE

SIZE	1/8"X2"	ISSUE 2-11-37	J.W.	
KIND	C.R. STEEL	CHANGED		
SHAPE		"		
FINISH	CAD. & LAC.	"		
FINISH	#26	"		
PATT.		"		

TITLE:
"60-88"-"SP-60" FOR TILT TABLE 12' RAIL
4'9" EXTENSION – RAIL PLATE

H. G. FISCHER & CO.
2335 WABANSIA AVE.
CHICAGO, ILL.

CAT. NO.

PART NO. 10387

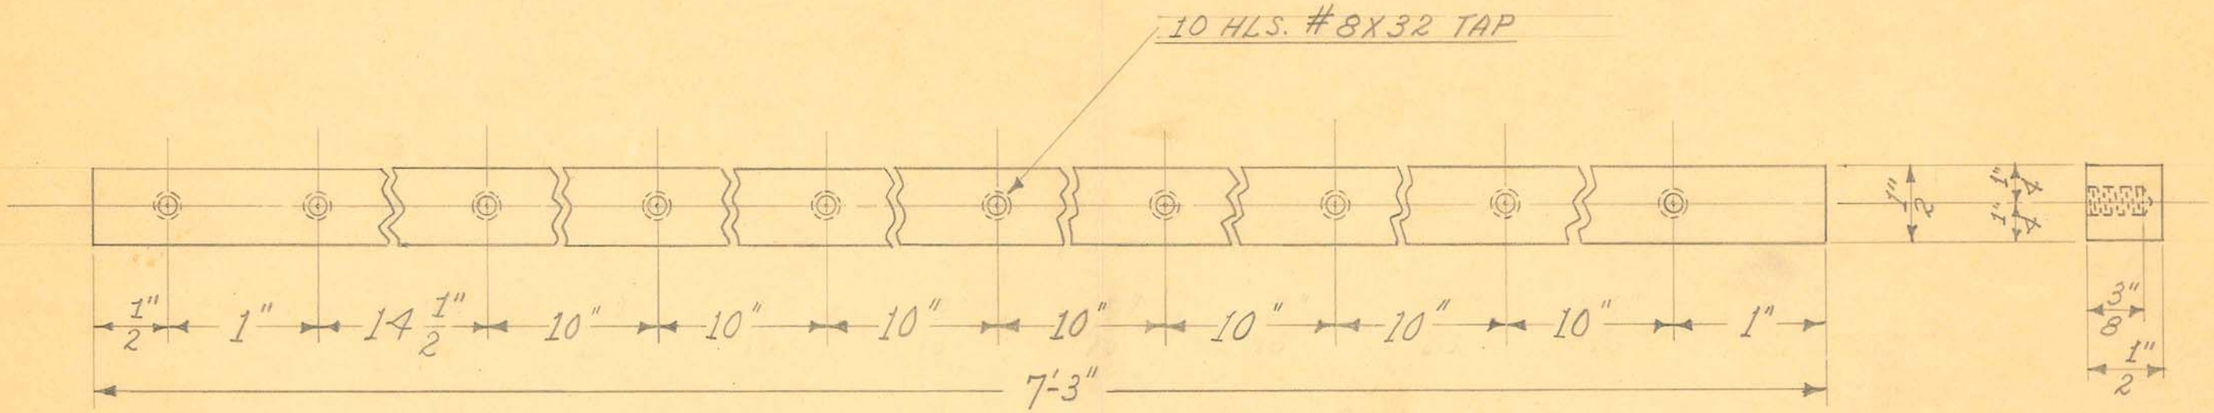

1 REQUIRED

OBSOLETE

OBSOLETE

SIZE	1/2" SQUARE	ISSUE 2-11-37	J. W.	TITLE: "60-88" SP-60 & TILT TABLE 14'-6" RAIL 7'-3" EXTENSION - RAIL
KIND	C.R. STEEL	CHANGED		
SHAPE		"		
FINISH	CAD. #23	"		
TEMP.		"		
PATT.		"		

H. G. FISCHER & CO.
2335 WABANSIA AVE.
CHICAGO, ILL.

CAT. NO.

PART NO. 10389

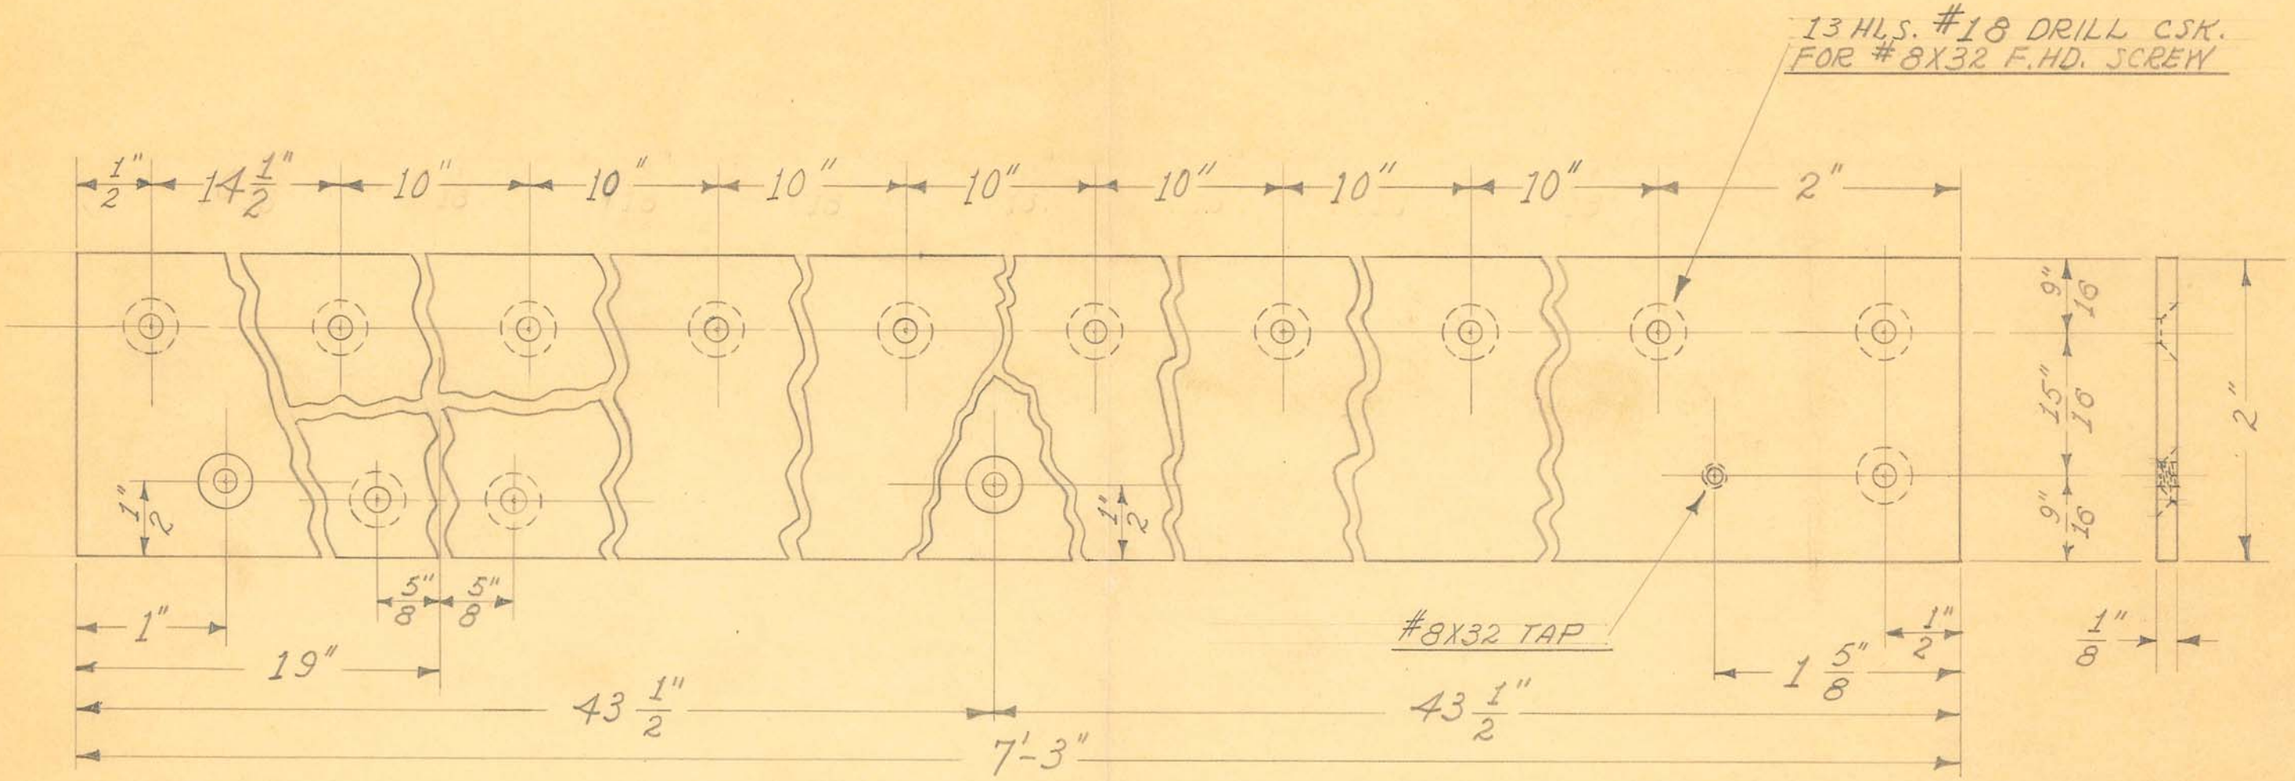

1 REQUIRED

OBSOLETE

OBSOLETE

SIZE	1/8"X2"	ISSUE 2-11-37	J.W.	TITLE: "60-88"-"SP-60" & TILT TABLE 14'-6" RAIL 7'-3" EXTENSION-RAIL PLATE
KIND	C.R. STEEL	CHANGED		
SHAPE		"		
FINISH	CAD. & LAC.	"		
FINISH TEMP.	# 26	"		
PATT.		"		

H. G. FISCHER & CO.
2335 WABANSIA AVE.
CHICAGO, ILL.

CAT. NO.

PART NO. 10391

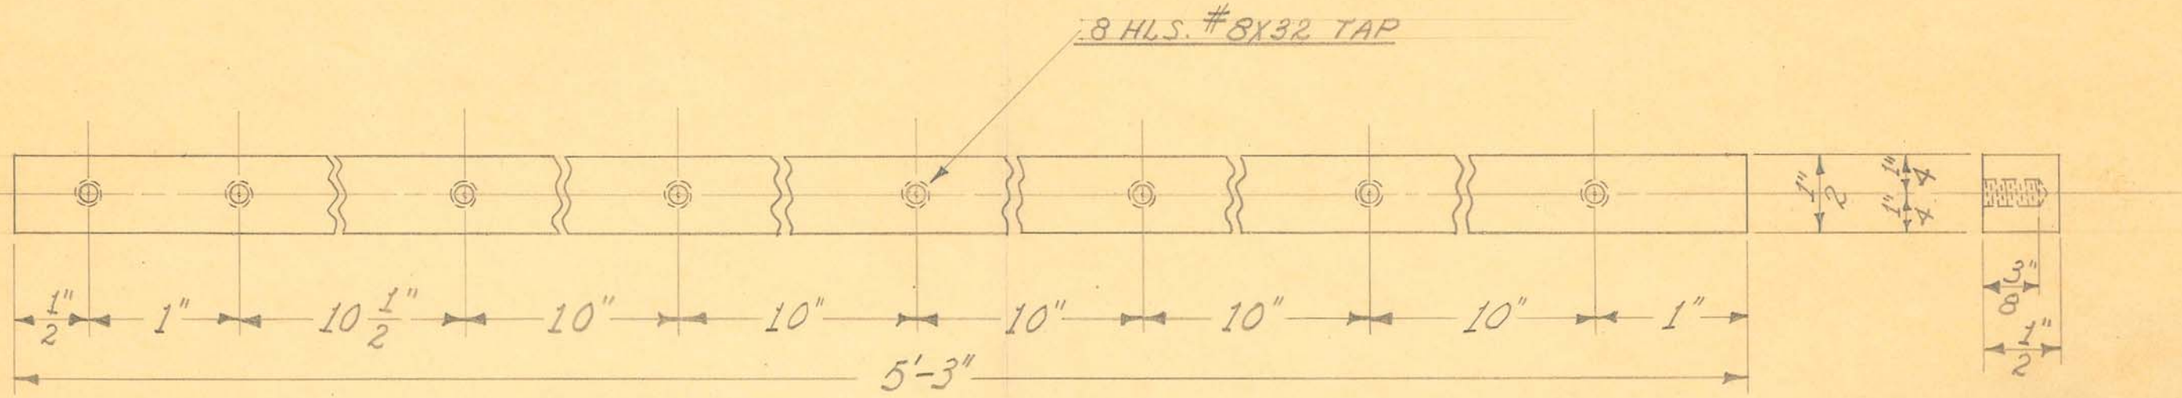

1 REQUIRED

OBSOLETE

OBSOLETE

SIZE	1/2" SQUARE	ISSUE 2-11-37	J.W.
KIND	C.R. STEEL	CHANGED	
SHAPE		"	
FINISH	CAD. #23	"	
TEMP.		"	
PATT.		"	

TITLE:
"60-88" & TILT TABLE - 12'-6" RAIL
5'-3" EXTENSION - RAIL

H. G. FISCHER & CO.
2335 WABANSIA AVE.
CHICAGO, ILL.

CAT. NO.

PART NO. 10393

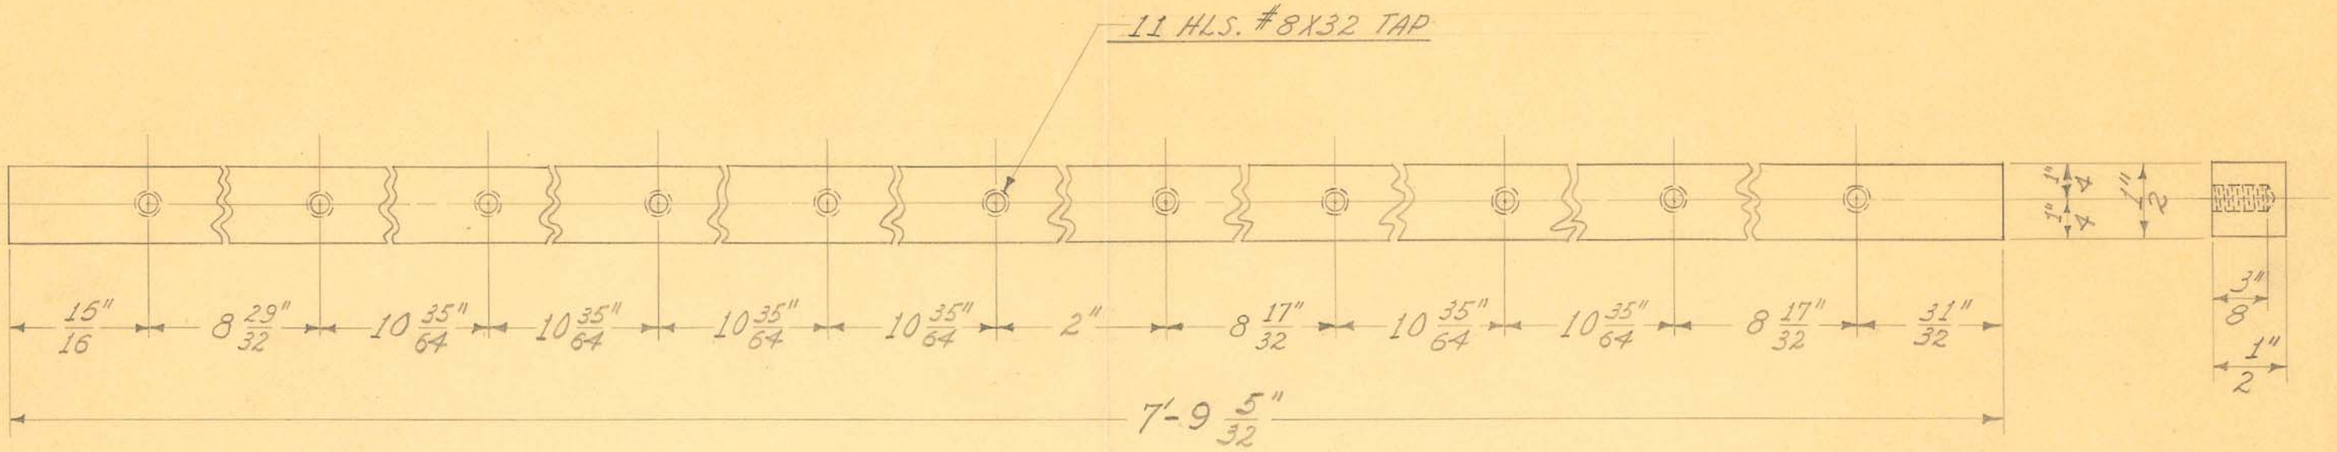

1 REQUIRED

OBSOLETE

SIZE	1/2" SQUARE	ISSUE 9-23-37	J.W.	TITLE: "60-88" & TILT TABLE 12'-6" RAIL RAIL
KIND	C.R. STEEL	CHANGED		
SHAPE		"		
FINISH	CAD. #23	"		
TEMP.		"		
PATT.		"		

H. G. FISCHER & CO.
2335 WABANSIA AVE.
CHICAGO, ILL.

CAT. NO.

PART NO. 10393A

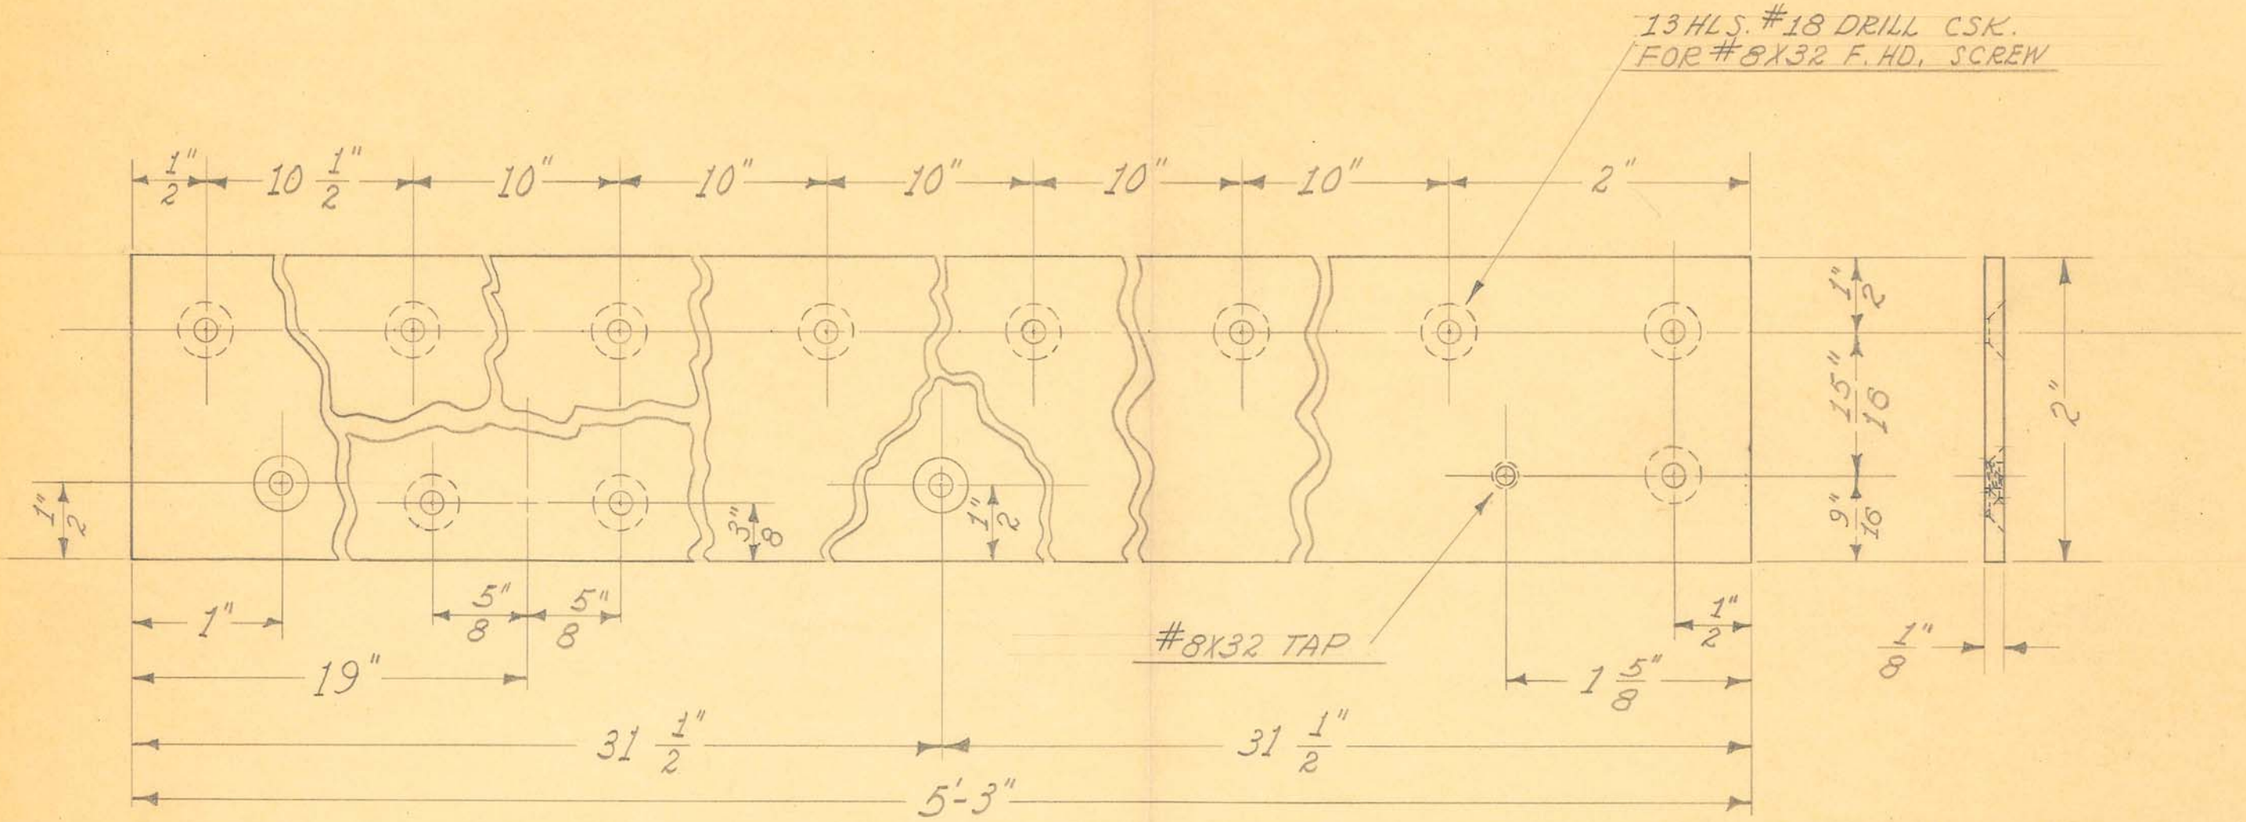

1 REQUIRED

OBSOLETE

OBSOLETE

SIZE	1/8"X2"	ISSUE 2-12-37	J.W.	TITLE: "60-88" & TILT TABLE -12'-6" RAIL 5'-3" EXTENSION - RAIL PLATE
KIND	C.R. STEEL	CHANGED		
SHAPE		"		
FINISH	CAD. & LAC.	"		
FINISH TEMP.	#26	"		
PATT.		"		

H. G. FISCHER & CO.
2335 WABANSIA AVE.
CHICAGO, ILL.

CAT. NO.

PART NO. 10394

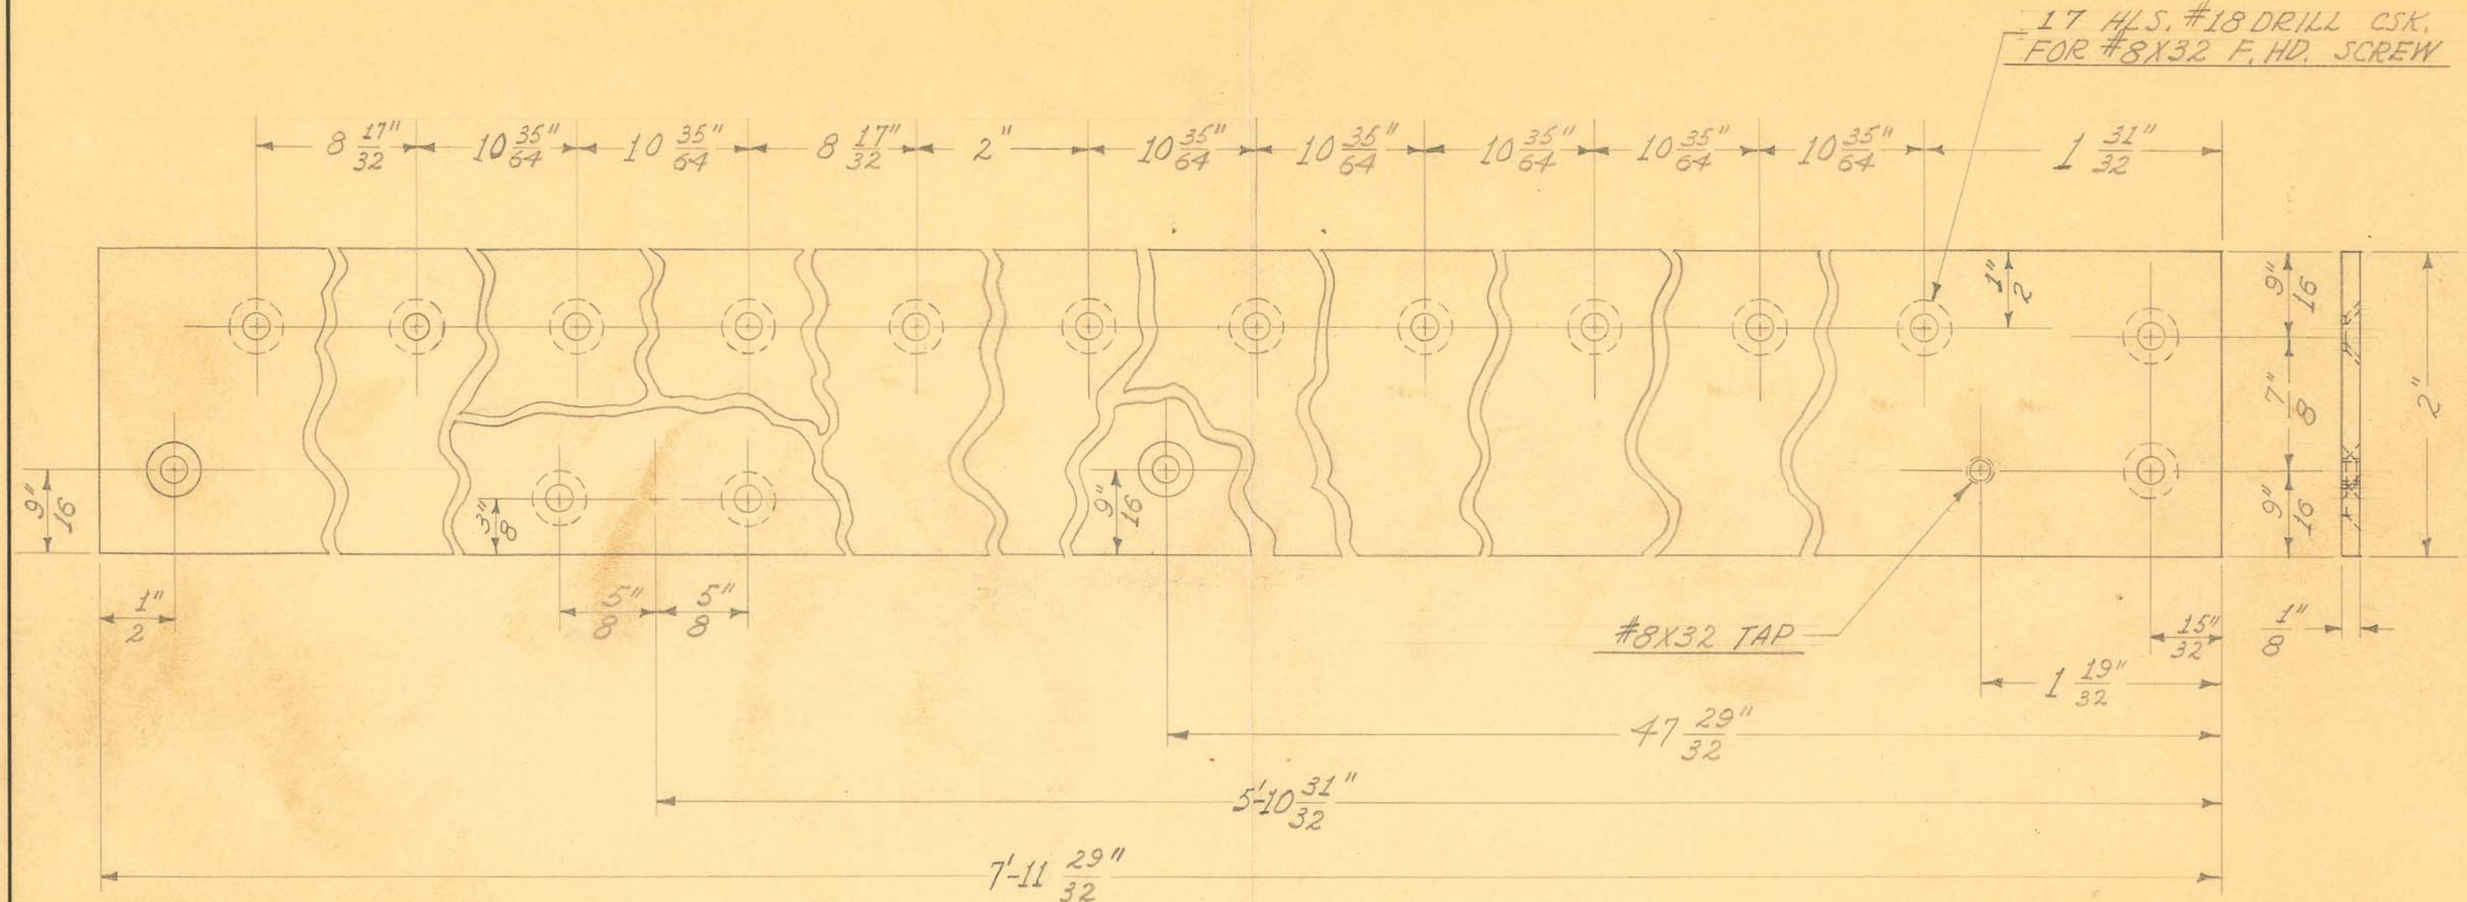

1 REQUIRED

OBSOLETE

SIZE	1/8" X 2"	ISSUE 9-23-37	J.W.
KIND	C.R. STEEL	CHANGED	
SHAPE		"	
FINISH	CAD. & LAC.	"	
TEMP.	#26	"	
PATT.		"	

TITLE: "60-88" & TILT TABLE 12'-6" RAIL RAIL PLATE

H. G. FISCHER & CO.
2335 WABANSIA AVE.
CHICAGO, ILL.

CAT. NO.

PART NO. 10394A

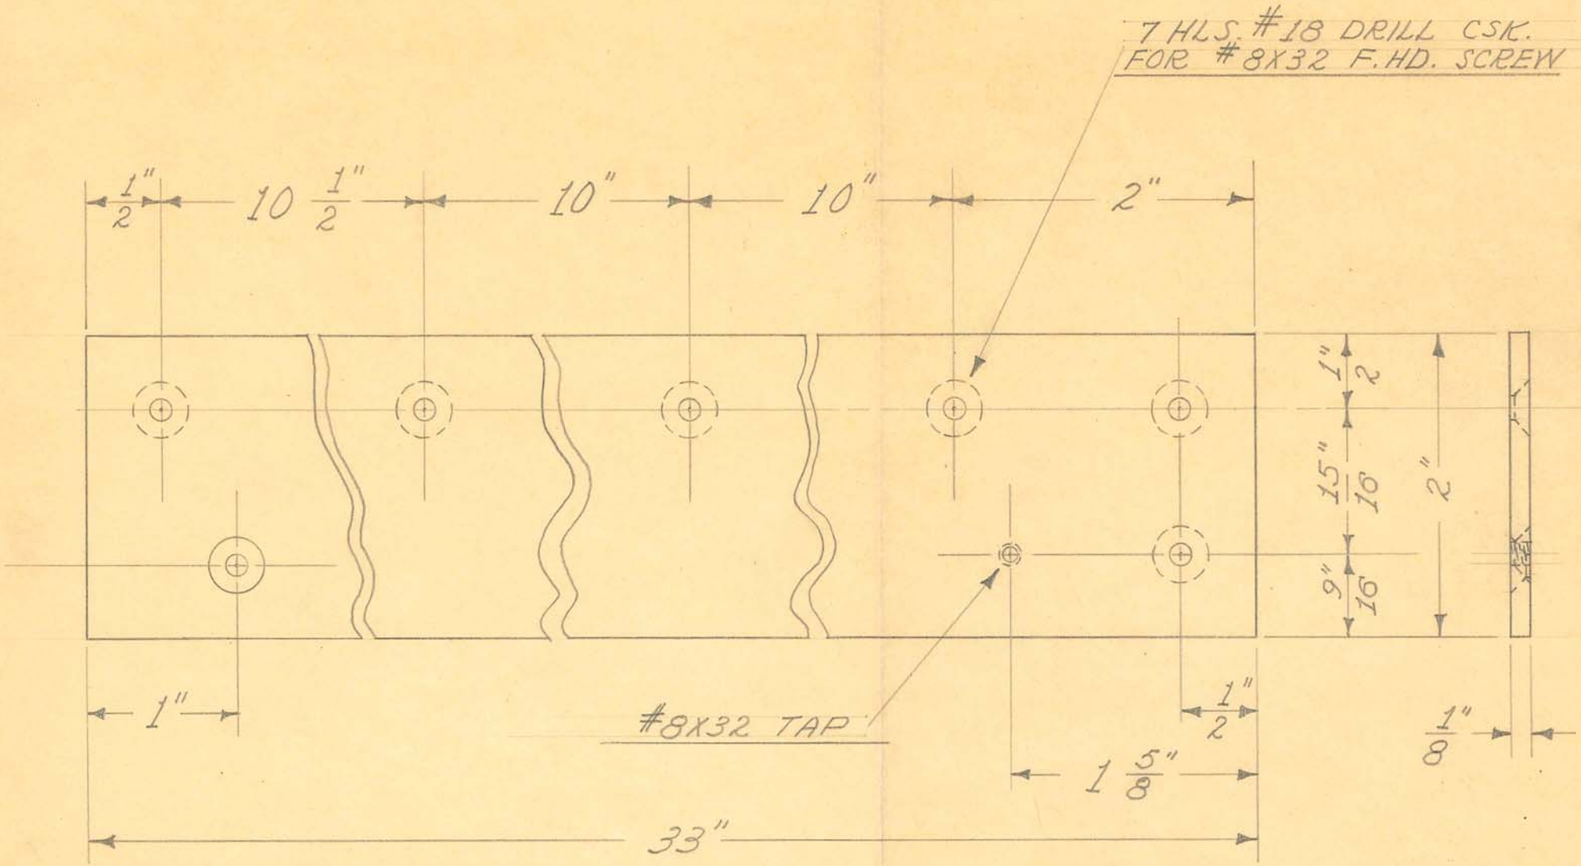

1 REQUIRED

OBSOLETE

OBSOLETE

SIZE	1/8"X 2"	ISSUE 2-24-37	J.W.	
KIND	C.R. STEEL	CHANGED		
SHAPE		"		
FINISH	CAD. & LAC.	"		
~~FINISH~~ TEMP.	#26	"		
PATT.		"		

TITLE: "60-88" & TILT TABLE - 10' RAIL
2'-9" EXTENSION - RAIL PLATE

H. G. FISCHER & CO.
2335 WABANSIA AVE.
CHICAGO, ILL.

CAT. NO.

PART NO. 10397

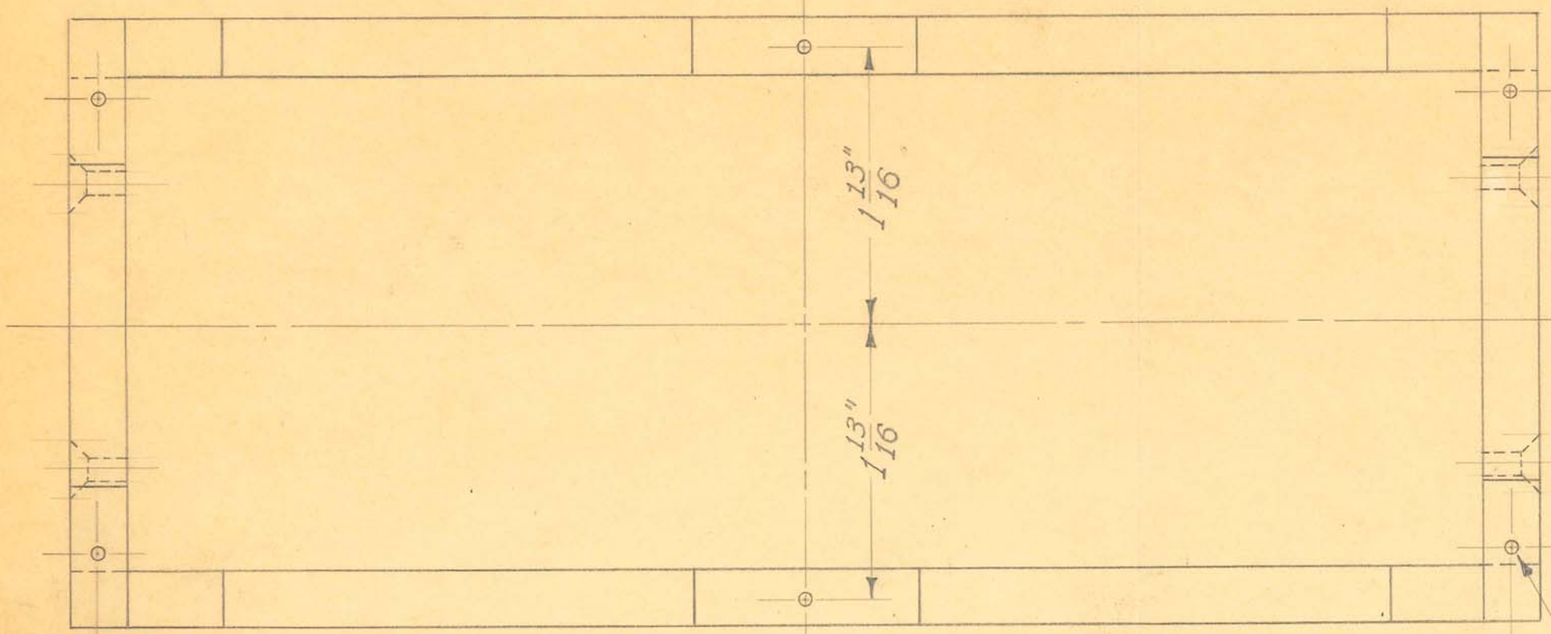

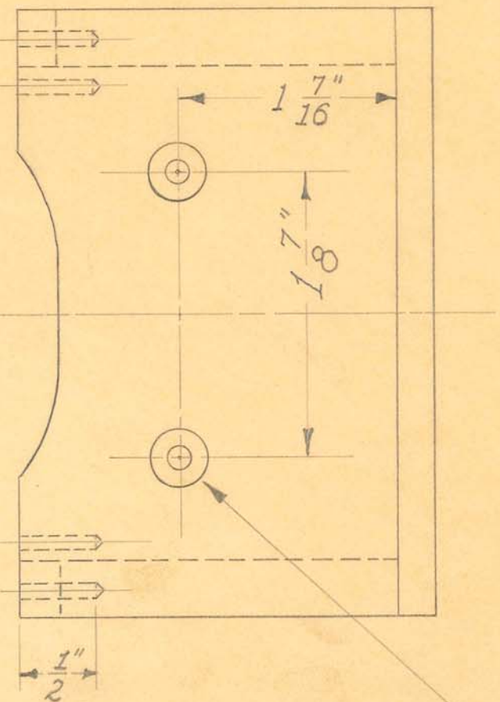

4 HLS. #18 DRILL CSK.
FOR #8X32 O.HD. SCREW

6 HLS. #43 DRILL

OBSOLETE

SIZE		ISSUE 1-20-37	J.W.	TITLE: SHORT WAVE LINE PROTECTOR BOX
KIND		CHANGED		
SHAPE		"		
FINISH		"		
TEMP.		"		
PATT.		"		

H. G. FISCHER & CO.
2335 WABANSIA AVE.
CHICAGO, ILL.

CAT. NO.

PART NO. 10402

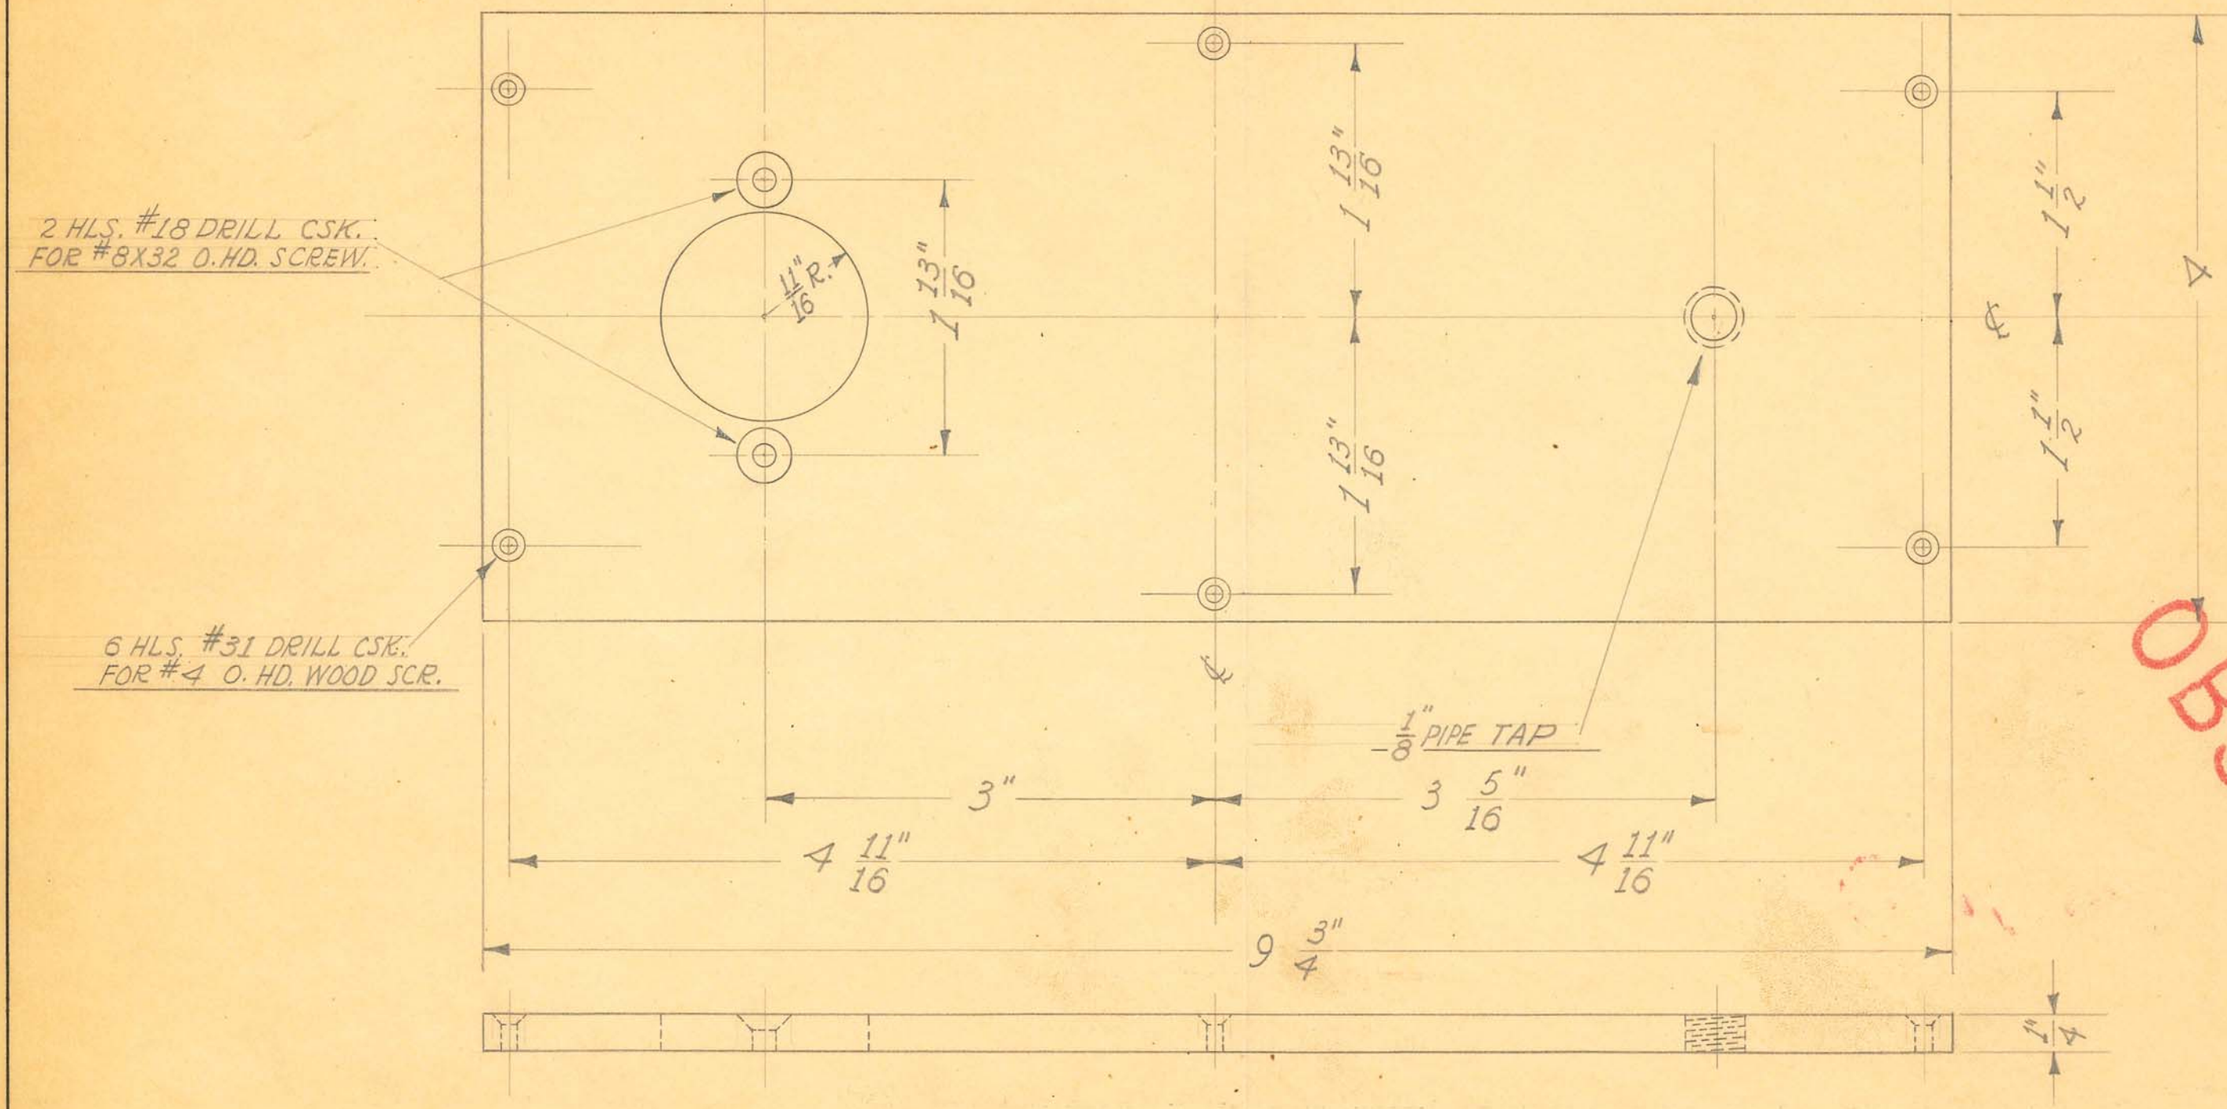

OBSOLETE

SIZE		ISSUE 1-20-37	J.W.
KIND	PLYWOOD	CHANGED	
SHAPE		"	
FINISH	BLACK	"	
TEMP.		"	
PATT.		"	

TITLE: SHORT WAVE LINE PROTECTOR BOX COVER

H. G. FISCHER & CO.
2335 WABANSIA AVE.
CHICAGO, ILL.

CAT. NO.

PART NO. 10403F

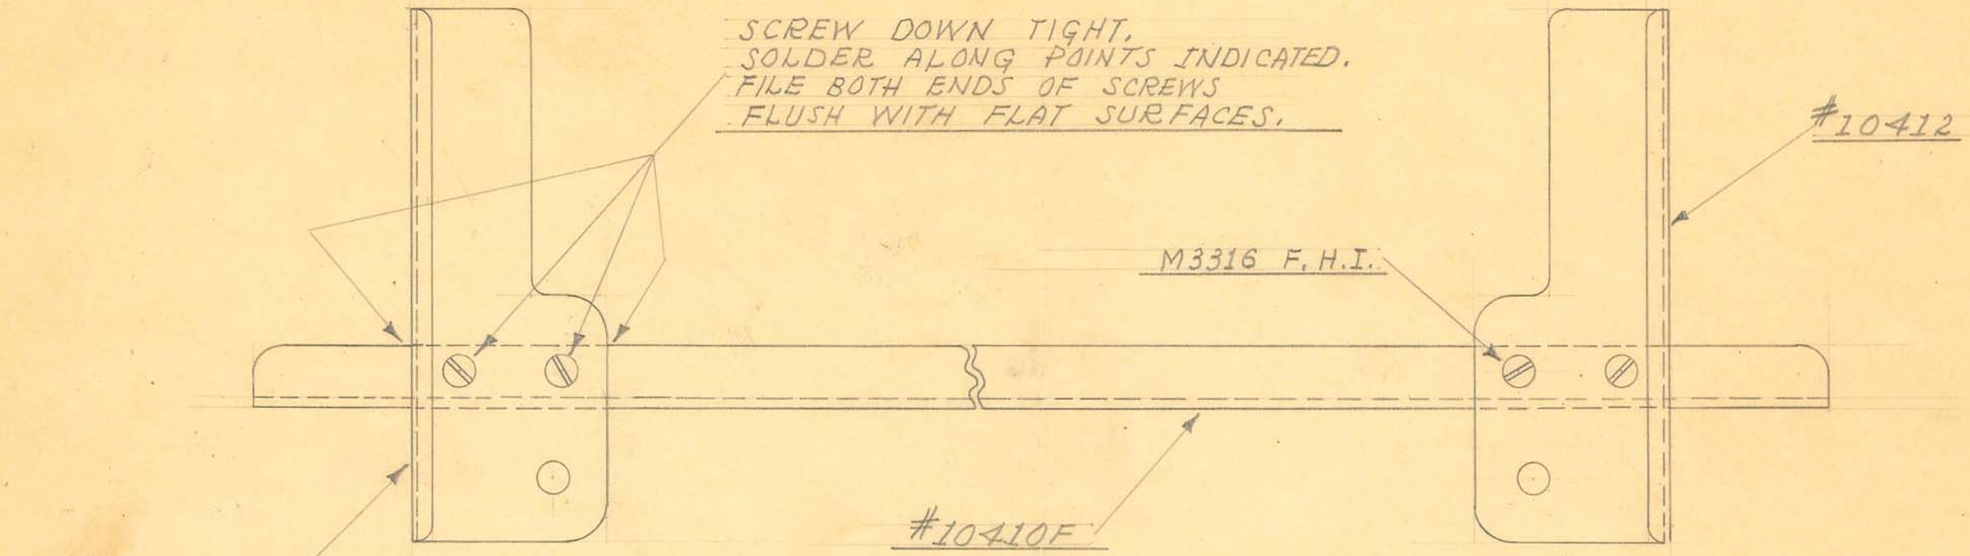

2 REQUIRED

OBSOLETE

Obsolete

SIZE		ISSUE 3-4-37	J.W.
KIND		CHANGED	
SHAPE		"	
FINISH	CAD.#23	"	
TEMP.		"	
PATT.		"	

TITLE: ADJUSTABLE CASSETTE HOLDER CHANNEL SLIDE ASSEM.

H. G. FISCHER & CO.
2335 WABANSIA AVE.
CHICAGO, ILL.

CAT. NO.

PART NO. 10413G

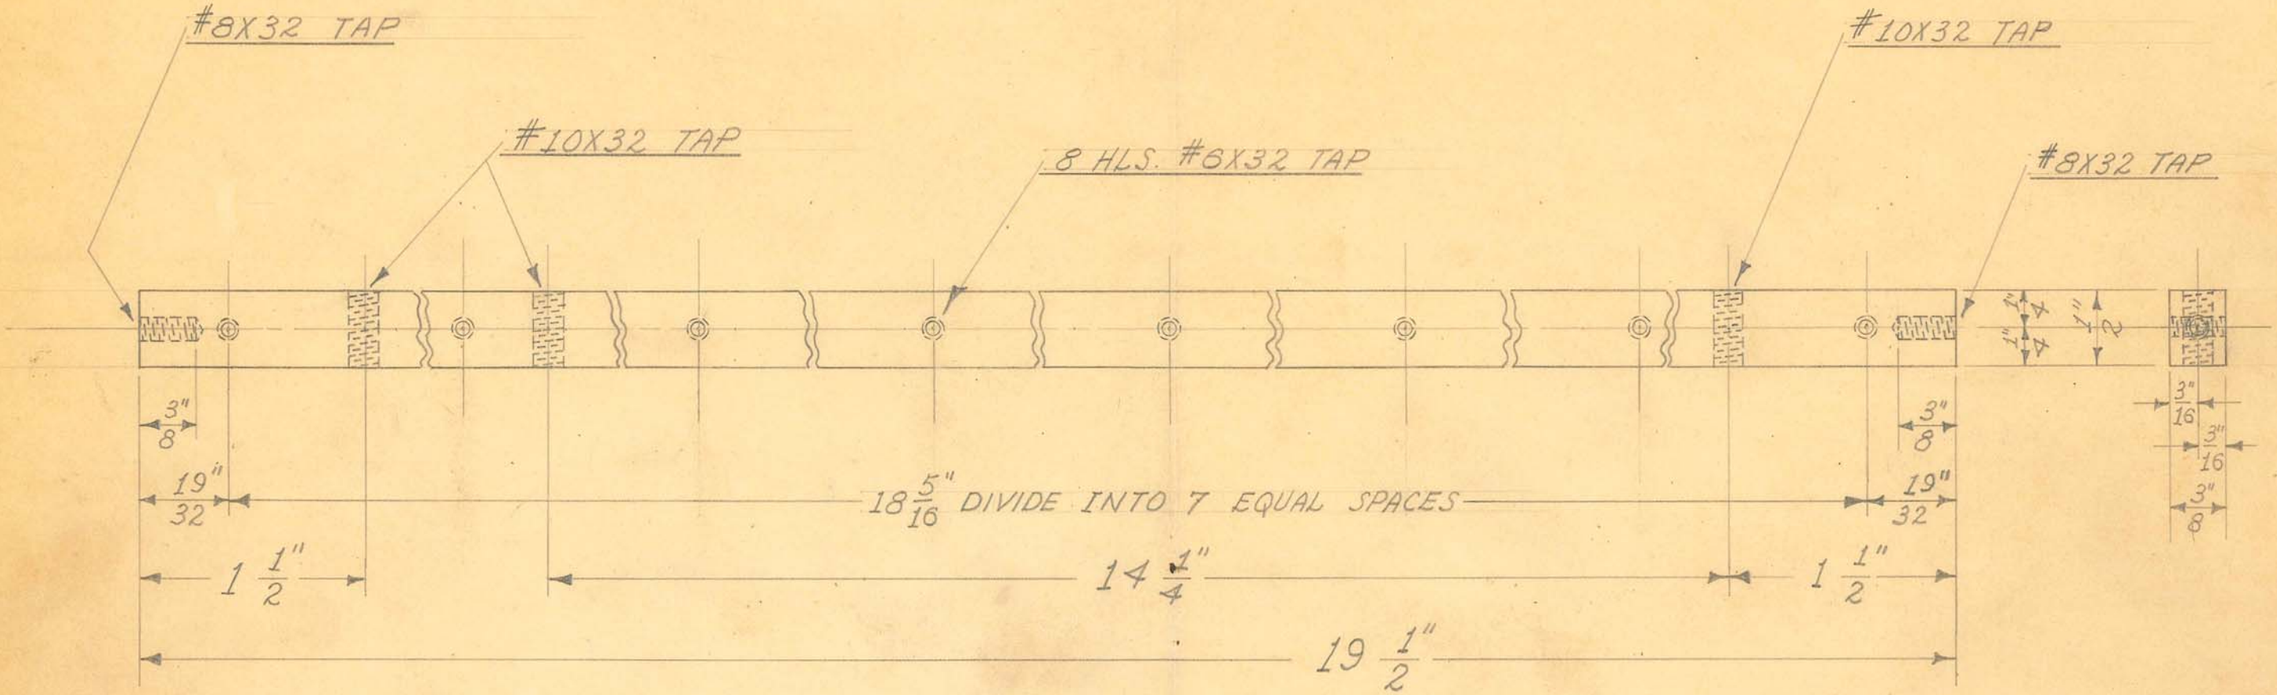

2 REQUIRED

OBSOLETE

3/8" X 1/2" ALUMINUM BAR

SIZE	~~3/8" X 1/2"~~	ISSUE 2-19-37	J.W.	TITLE: FISCHER SYNCHROTIMED BUCKY GRID FRAME END BAR
KIND	~~C.R. STEEL~~	CHANGED		
SHAPE	~~BAR~~	" 9-18-43	H.E.	
FINISH	~~CAD. #25~~	"		
TEMP.		"		
PATT.		"		

H. G. FISCHER & CO.
2335 WABANSIA AVE.
CHICAGO, ILL.

CAT. NO.

PART NO. 10456

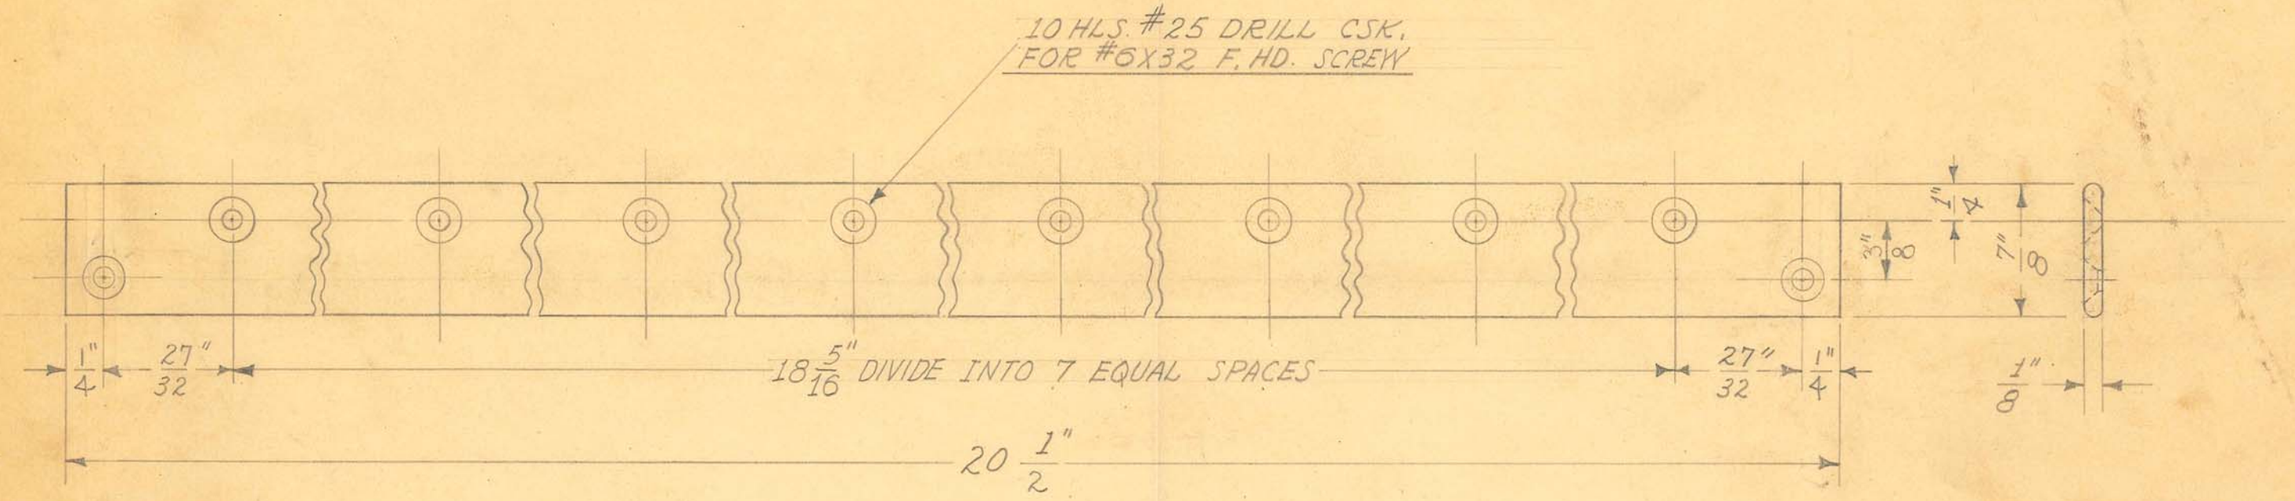

2 REQUIRED

OBSOLETE

SIZE	1/8" X 7/8"	ISSUE 2-19-36	J.W.	TITLE: FISCHER SYNCHROTIMED BUCKY GRID-BOTTOM CLAMPING STRIP
KIND	FLAT WIRE	CHANGED		
SHAPE		"		
FINISH	DULITE #8	"		
TEMP.		"		
PATT.		"		

H. G. FISCHER & CO.
2335 WABANSIA AVE.
CHICAGO, ILL.

CAT. NO.

PART NO. 10457

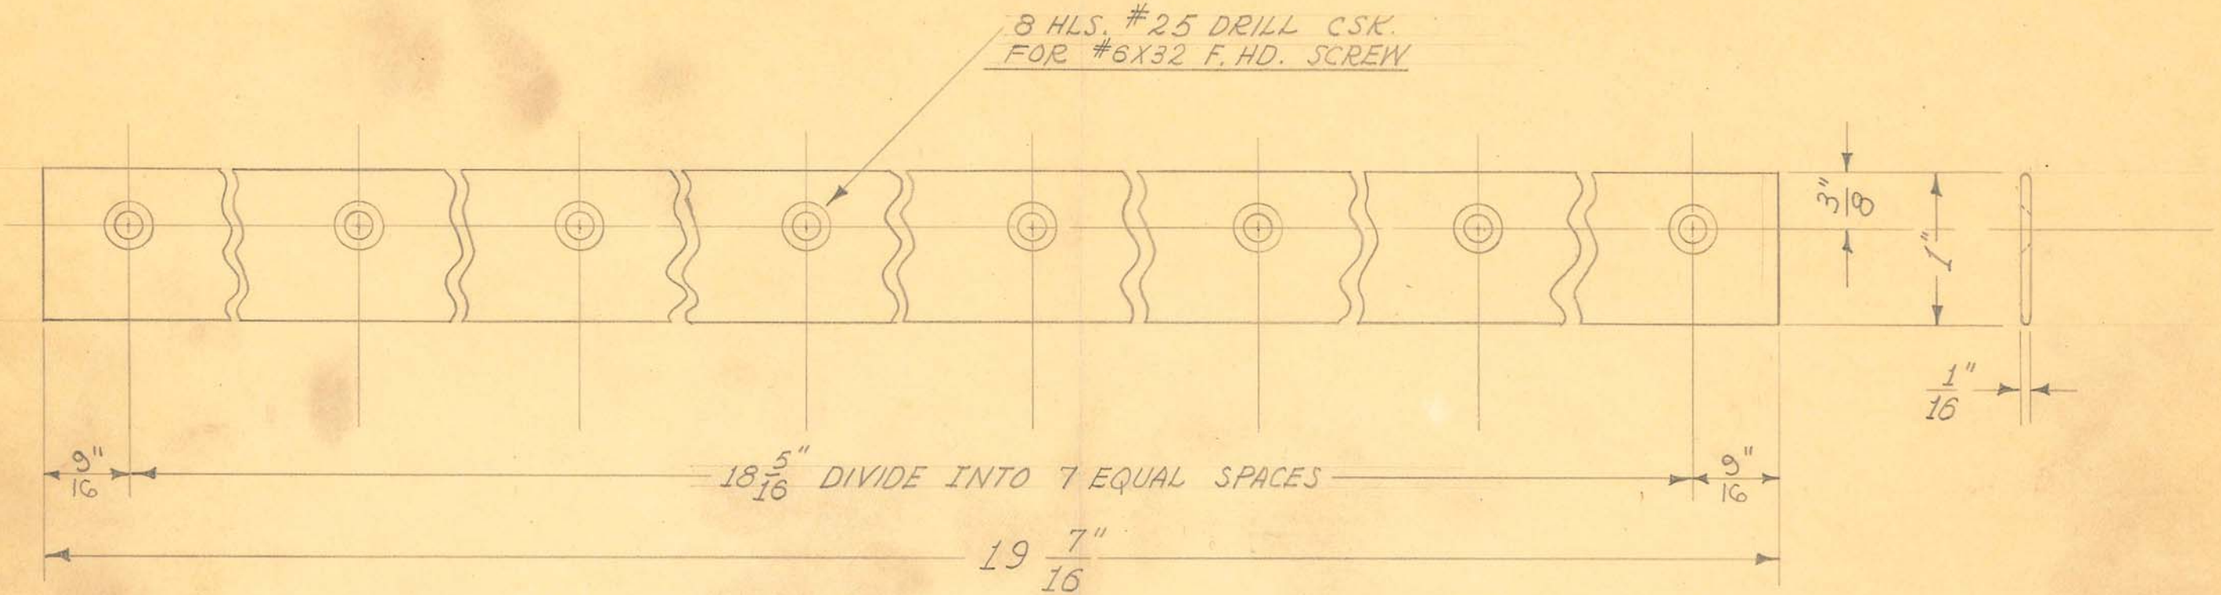

2 REQUIRED

OBSOLETE

SIZE	1/16"X1"	ISSUE 2-19-37	J.W.	TITLE: FISCHER SYNCHROTIMED BUCKY GRID-TOP CLAMPING STRIP
KIND	FLAT WIRE	CHANGED		
SHAPE		"		
FINISH	CAD. #23	"		
TEMP.		"		
PATT.		"		

H. G. FISCHER & CO.
2335 WABANSIA AVE.
CHICAGO. ILL.

CAT. NO.

PART NO. 10458

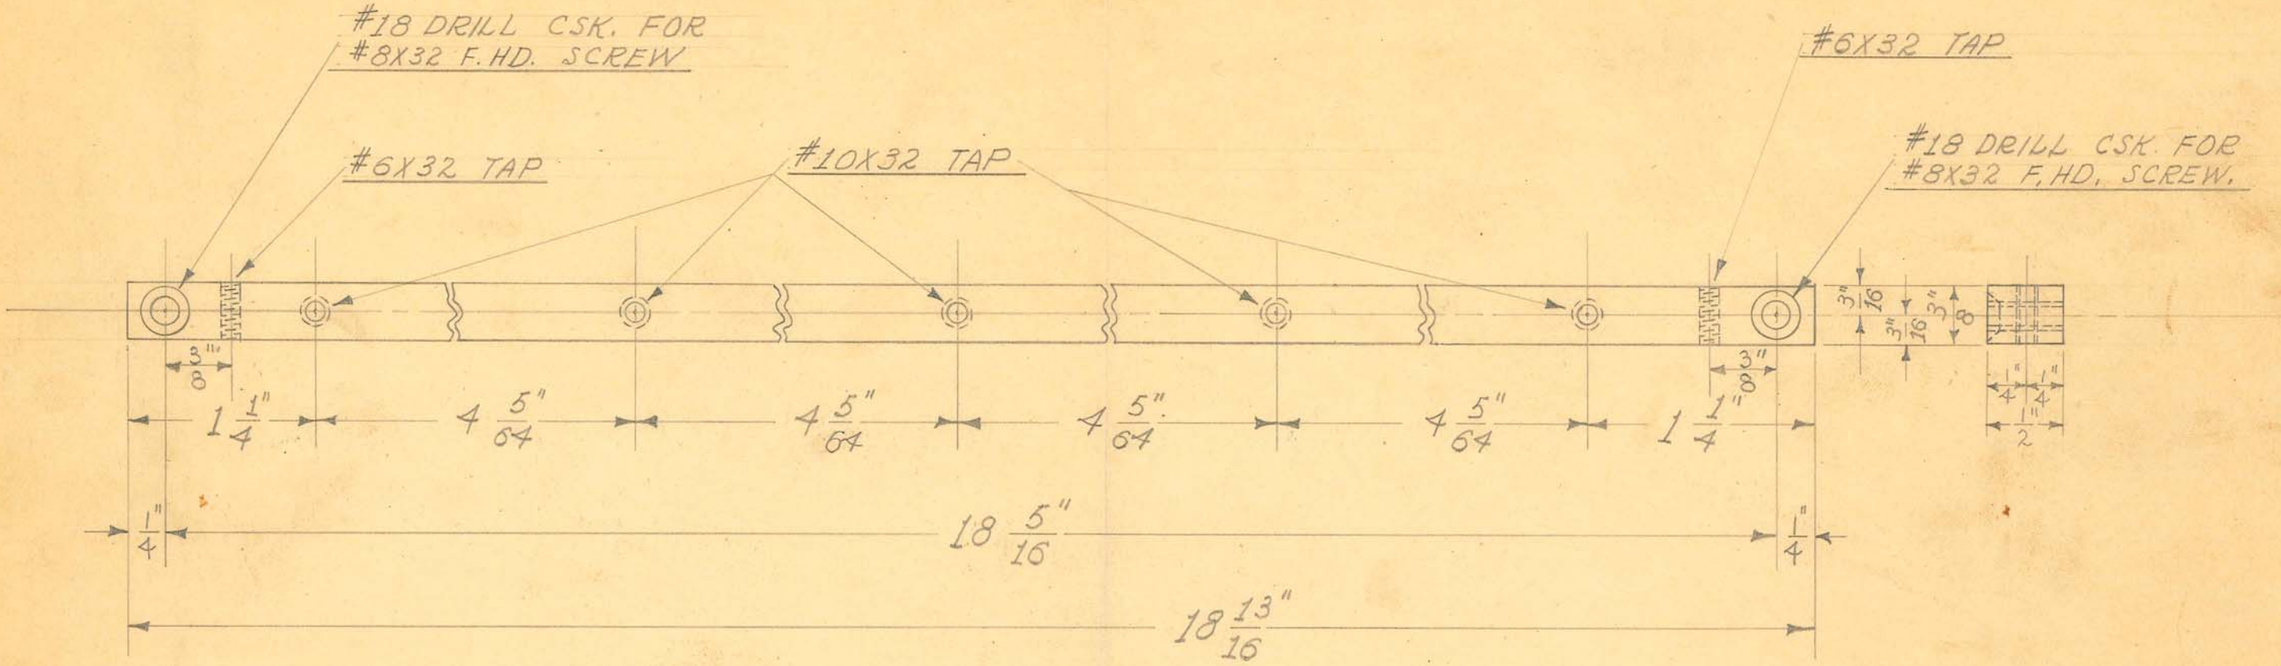

2 REQUIRED

OBSOLETE

SIZE	3/8" X 1/2"	ISSUE 2-19-37	J.W.	TITLE: FISCHER SYNCHROTIMED BUCKY GRID FRAME TIE ROD
KIND	C.R. STEEL	CHANGED		
SHAPE		"		
FINISH		"		
TEMP.		"		
PATT.		"		

H. G. FISCHER & CO.
2335 WABANSIA AVE.
CHICAGO, ILL.

CAT. NO.

PART NO. 10459

TRIM BOTH SIDES

BREAK EDGES INSIDE & OUT ON BOTH ENDS

2 HOLES. – $\frac{3}{16}$" DRILL 'C'SUNK FOR RIVETING

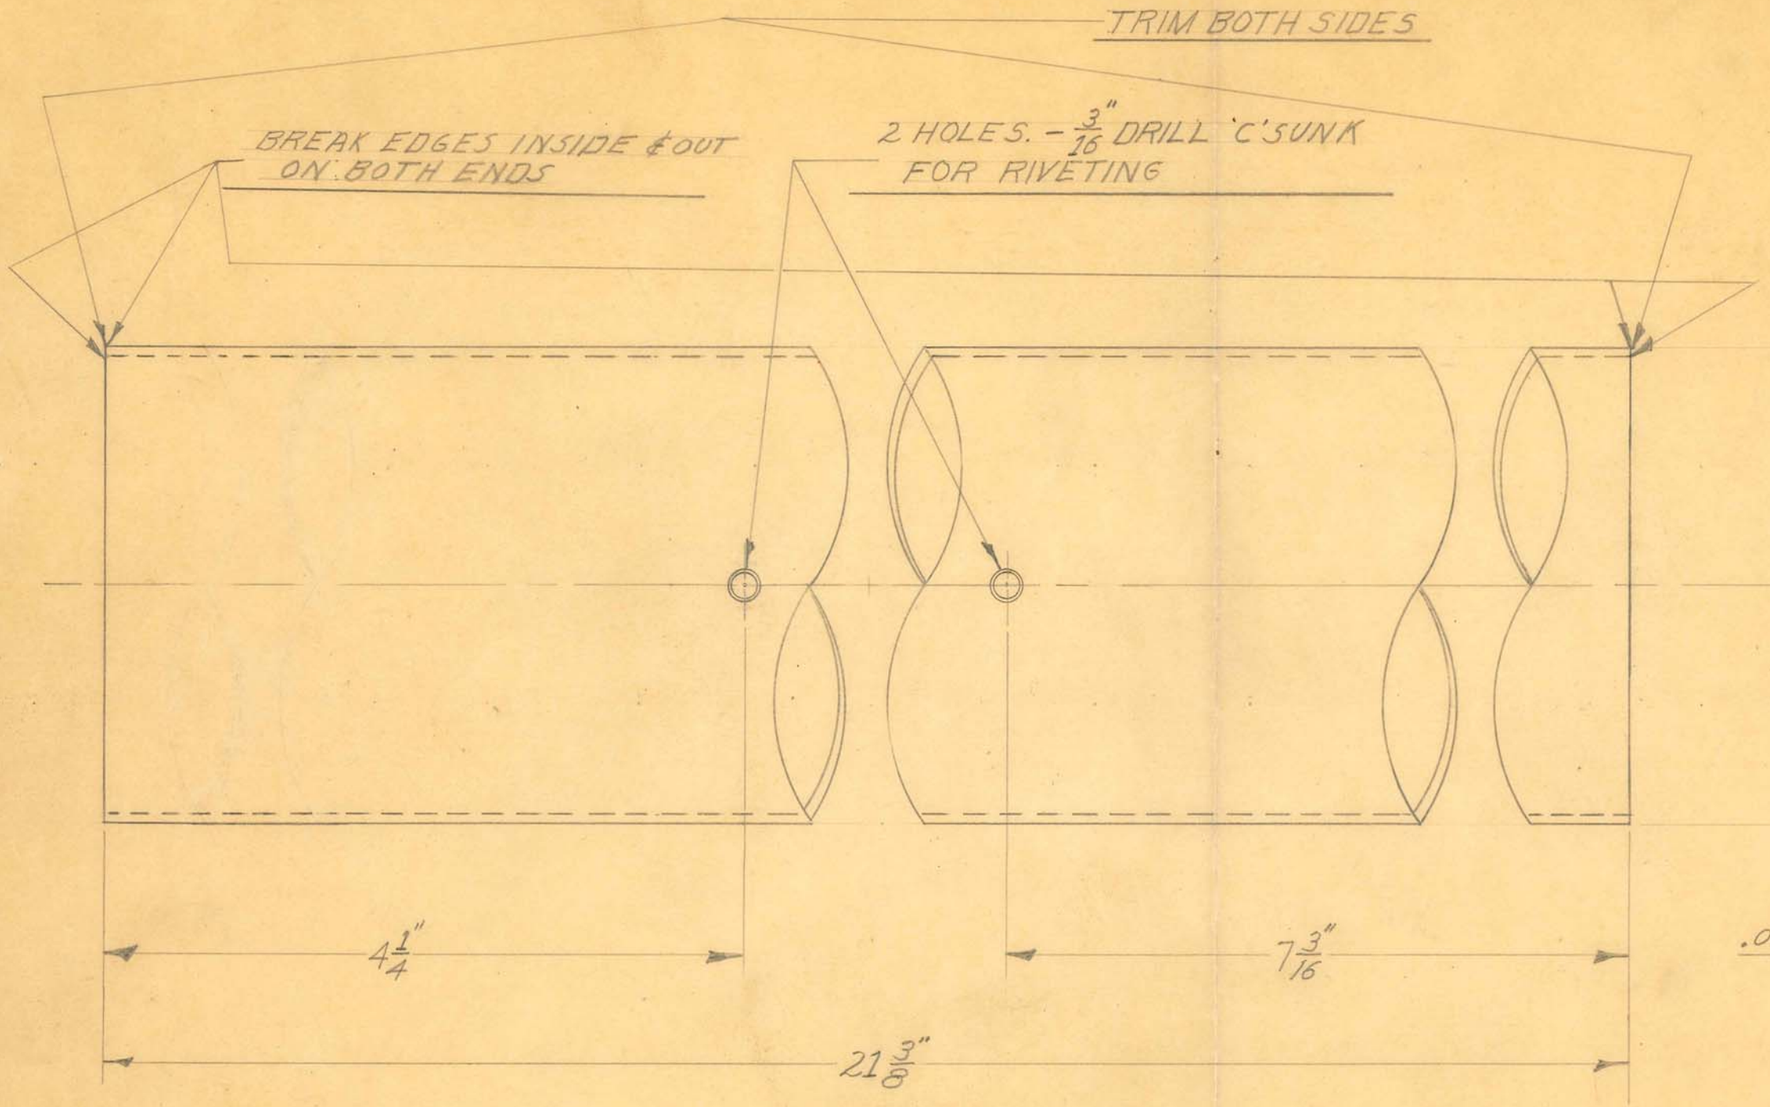

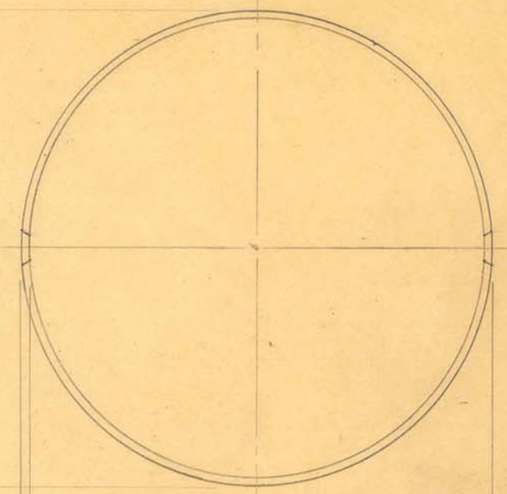

3 1/8" O.D. X #16GA. (.065) WALL SEAMLESS STEEL TUBING

OBSOLETE

1 REQUIRED

DRILL JIG TOOL #9404

SIZE	FROM	ISSUE 7-21-47	J.M.F
KIND	16860	CHANGED	
SHAPE		"	
FINISH		"	
TEMP.		"	
PATT.		"	

TITLE: FISCHER "PRECISION 200" X RAY UNIT COUNTERWEIGHT TUBE

H. G. FISCHER & CO.
2338 WABANSIA AVE.
CHICAGO, ILL.

CAT. NO.

PART NO. 16860F

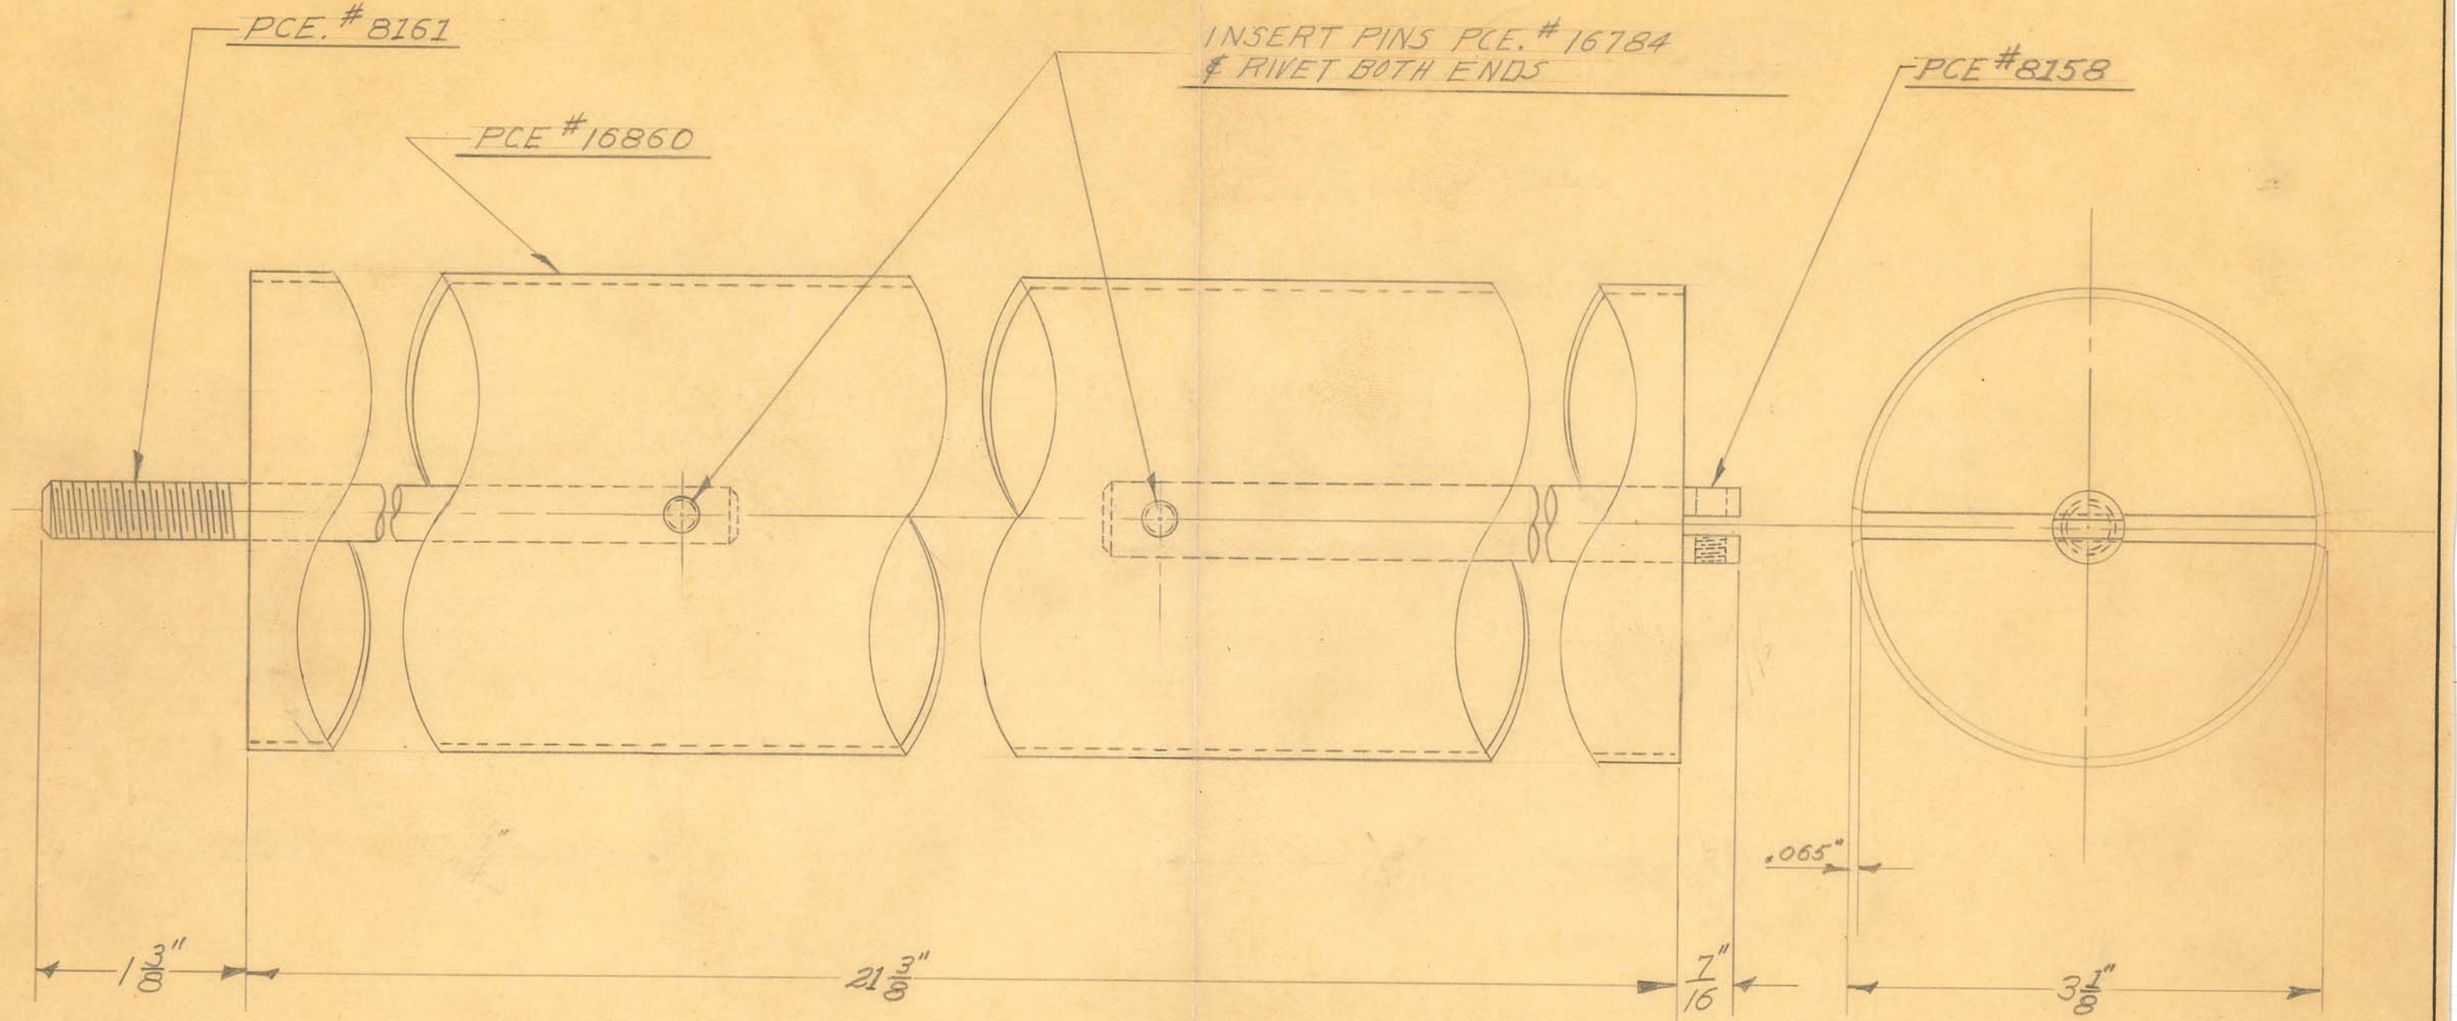

FILL TUBE WITH LEAD TO BRING TOTAL WEIGHT UP TO 62 LB. + 1/2 LB. = 1/2 LB

OBSOLETE

1 REQUIRED

SIZE		ISSUE 7-21-47	J.M.F
KIND		CHANGED	
SHAPE		"	
FINISH		"	
TEMP.		"	
PATT.		"	

TITLE: FISCHER "PRECISION 200" X RAY UNIT COUNTERWEIGHT TUBE ASSEMBLY

H. G. FISCHER & CO.
2335 WABANSIA AVE.
CHICAGO, ILL.

CAT. NO.

PART NO. 16861G

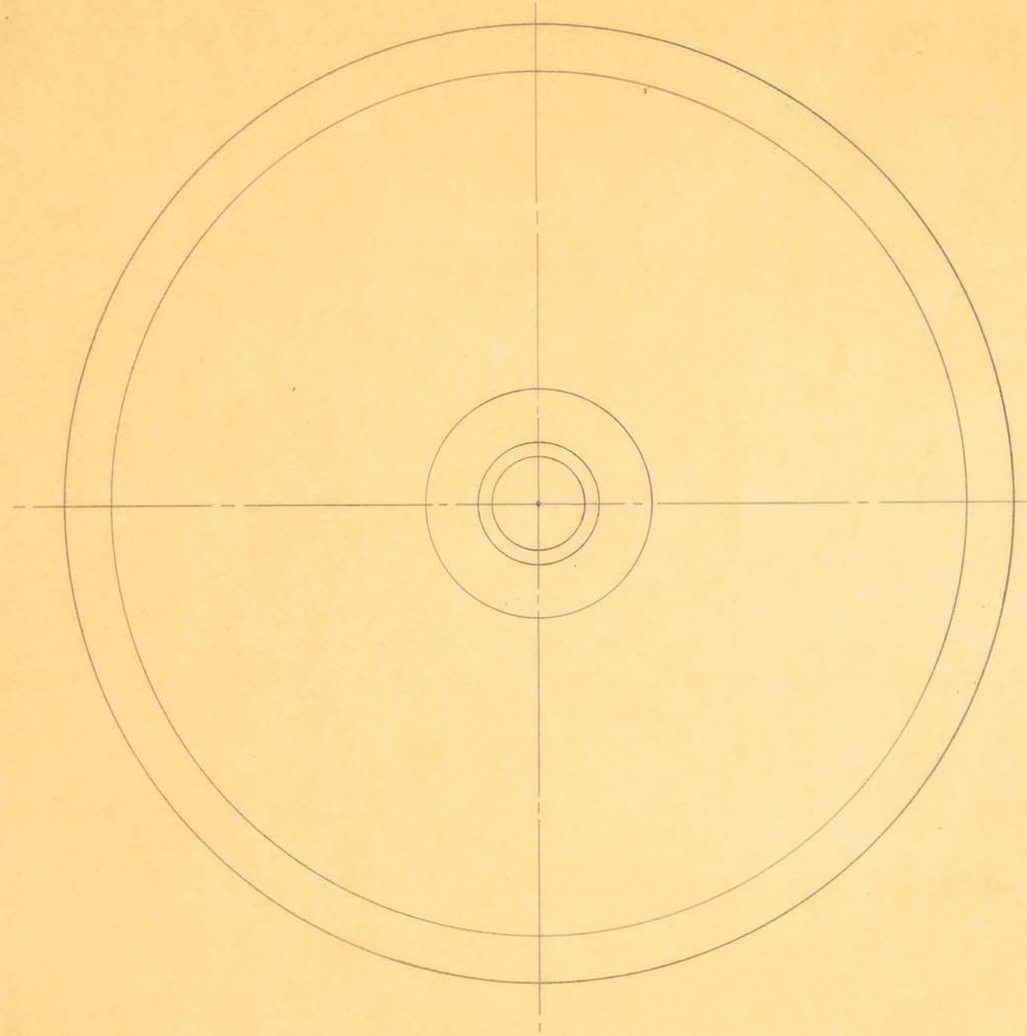

1 REQUIRED

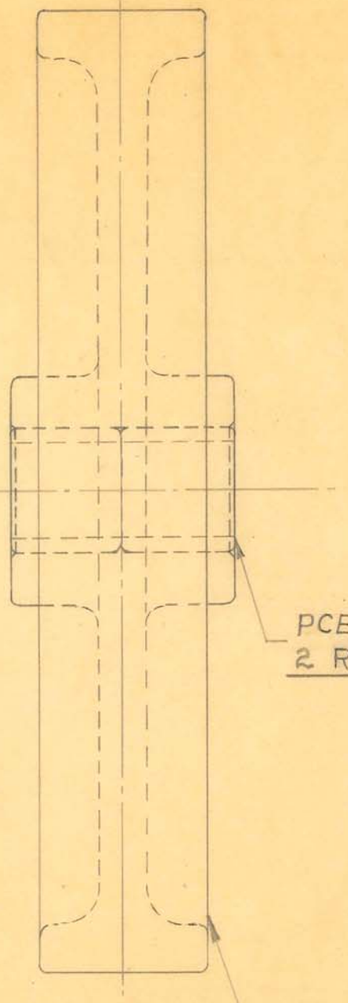

PCE. # 16846 NEEDLE BEARING
2 REQUIRED

PCE. # 16803 F

OBSOLETE

SIZE		ISSUE 7-17-47	W. J.	TITLE: FISCHER "PRECISION 200" X-RAY UNIT BASE ROLLER ~ PLAIN ~ ASSEMBLY
KIND		CHANGED		
SHAPE		"		
FINISH		"		
TEMP.		"		H. G. FISCHER & CO. 2338 WABANSIA AVE. CHICAGO, ILL. — CAT. NO. — PART NO. 16866G
PATT.		"		

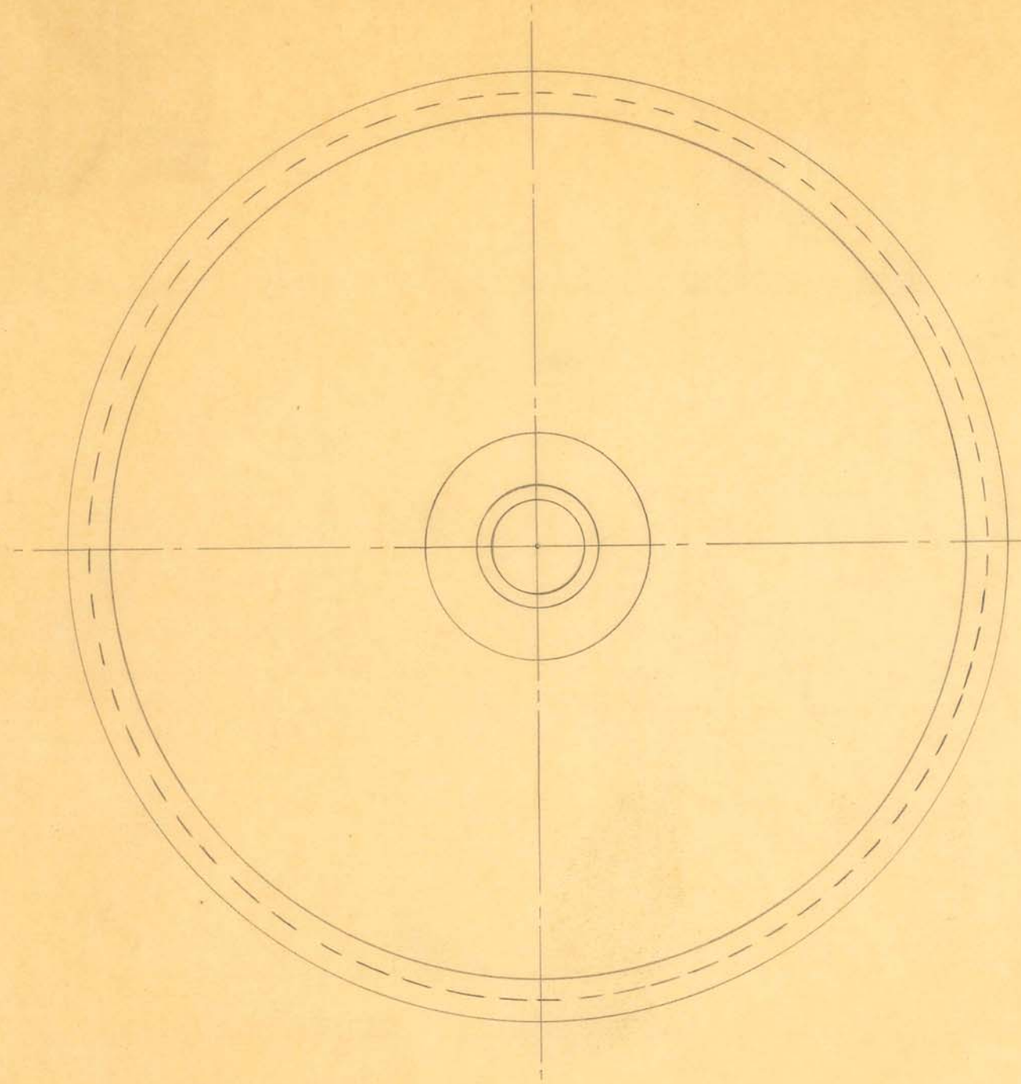

2 REQUIRED

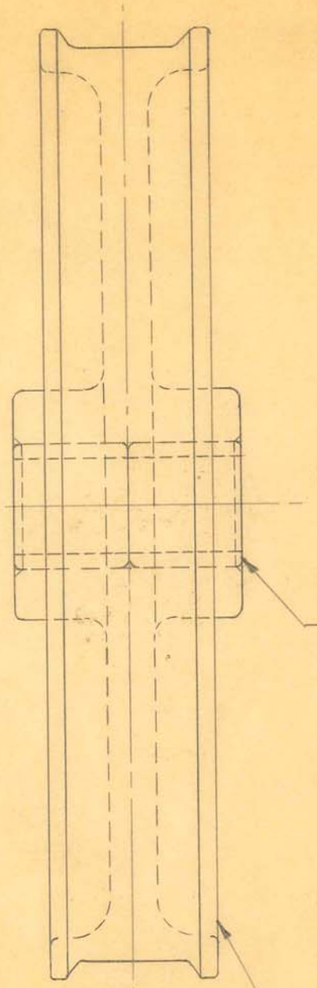

PCE. # 16846 NEEDLE BEARING
2 REQUIRED

PCE. # 16804

OBSOLETE

SIZE		ISSUE 7-16-47	W.J.
KIND		CHANGED	
SHAPE		"	
FINISH		"	
TEMP.		"	
PATT.		"	

TITLE:
FISCHER "PRECISION 2.00" X-RAY UNIT
BASE ROLLER ~ GROOVED ~ ASSEMBLY

H. G. FISCHER & CO.
2338 WABANSIA AVE.
CHICAGO, ILL.

CAT. NO.

PART NO. 16867G

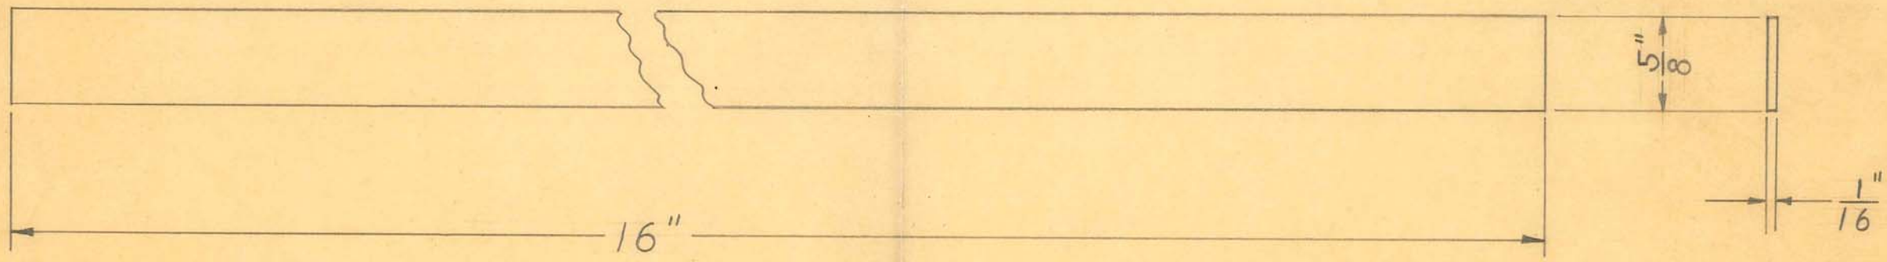

4 REQUIRED

OBSOLETE

1/16" SHEET ~HY-CAR CORK

SIZE		ISSUE 7-7-47	W.J.
KIND		CHANGED	
SHAPE		"	
FINISH		"	
TEMP.		"	
PATT.		"	

DIMENSIONS
FRACTIONAL ± .015
DECIMAL ± .005
ANGULAR ± ½°
UNLESS OTHERWISE SPECIFIED

TITLE:
FISCHER "PRECISION 200" X-RAY UNIT
H.T. TRANSF. PANEL GASKET STRIP

H. G. FISCHER & CO.
2338 WABANSIA AVE.
CHICAGO, ILL.

CAT. NO.

PART NO. 16882

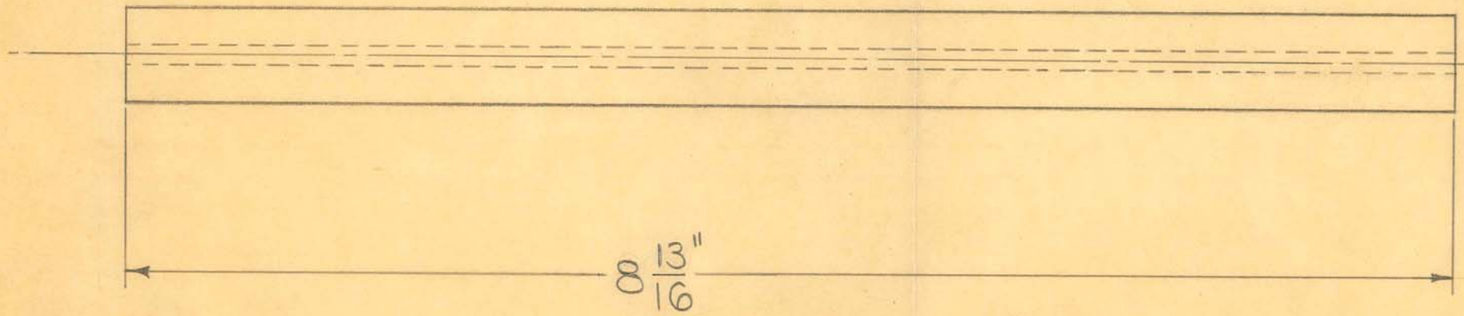

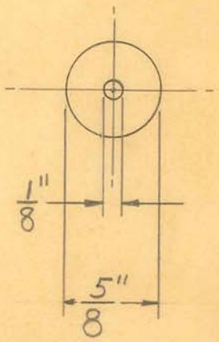

1 REQUIRED

OBSOLETE

5/8" O.D. X 1/8" I.D. HARD RUBBER TUBING

SIZE		ISSUE 6-20-47	W.J.	TITLE: FISCHER "PRECISION 200" X-RAY UNIT SOCKET CONNECTION INSULATOR
KIND		CHANGED		
SHAPE		"		
FINISH		"		
TEMP.		"		
PATT.		"		

H. G. FISCHER & CO.
2335 WABANSIA AVE.
CHICAGO, ILL.

CAT. NO.

PART NO. 16885

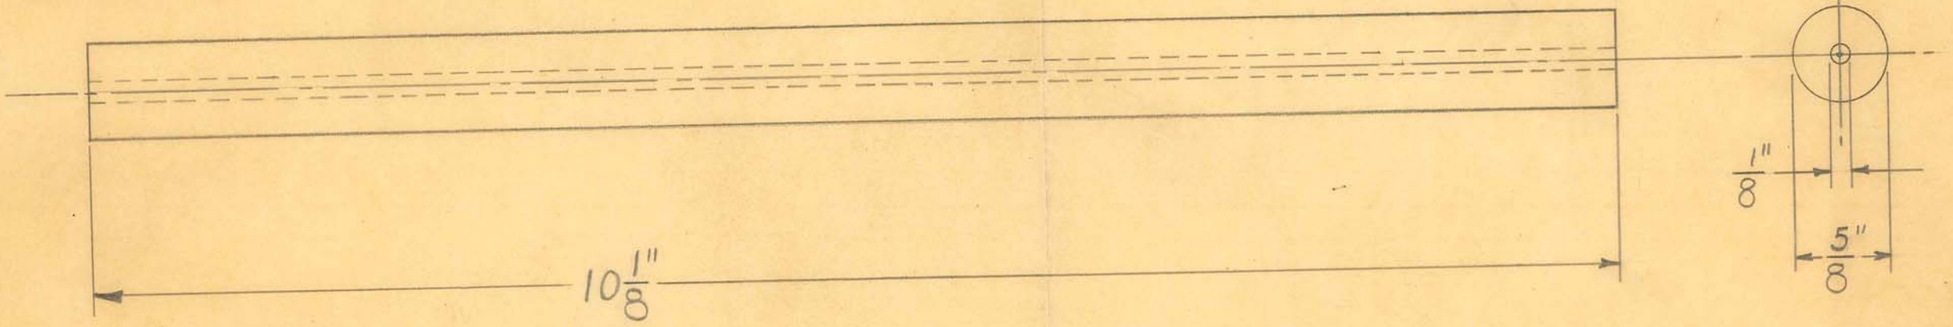

2 REQUIRED

OBSOLETE

5/8" O.D. X 1/8" I.D. HARD RUBBER TUBING

SIZE		ISSUE 6-20-47	W.J.
KIND		CHANGED	RS.
SHAPE		"	
FINISH		"	
TEMP.		"	
PATT.		"	

TITLE: FISCHER "PRECISION 200" X-RAY UNIT
VALVE TUBE CONNECTION INSULATOR

H. G. FISCHER & CO.
2338 WABANSIA AVE.
CHICAGO, ILL.

CAT. NO.

PART NO. 16886

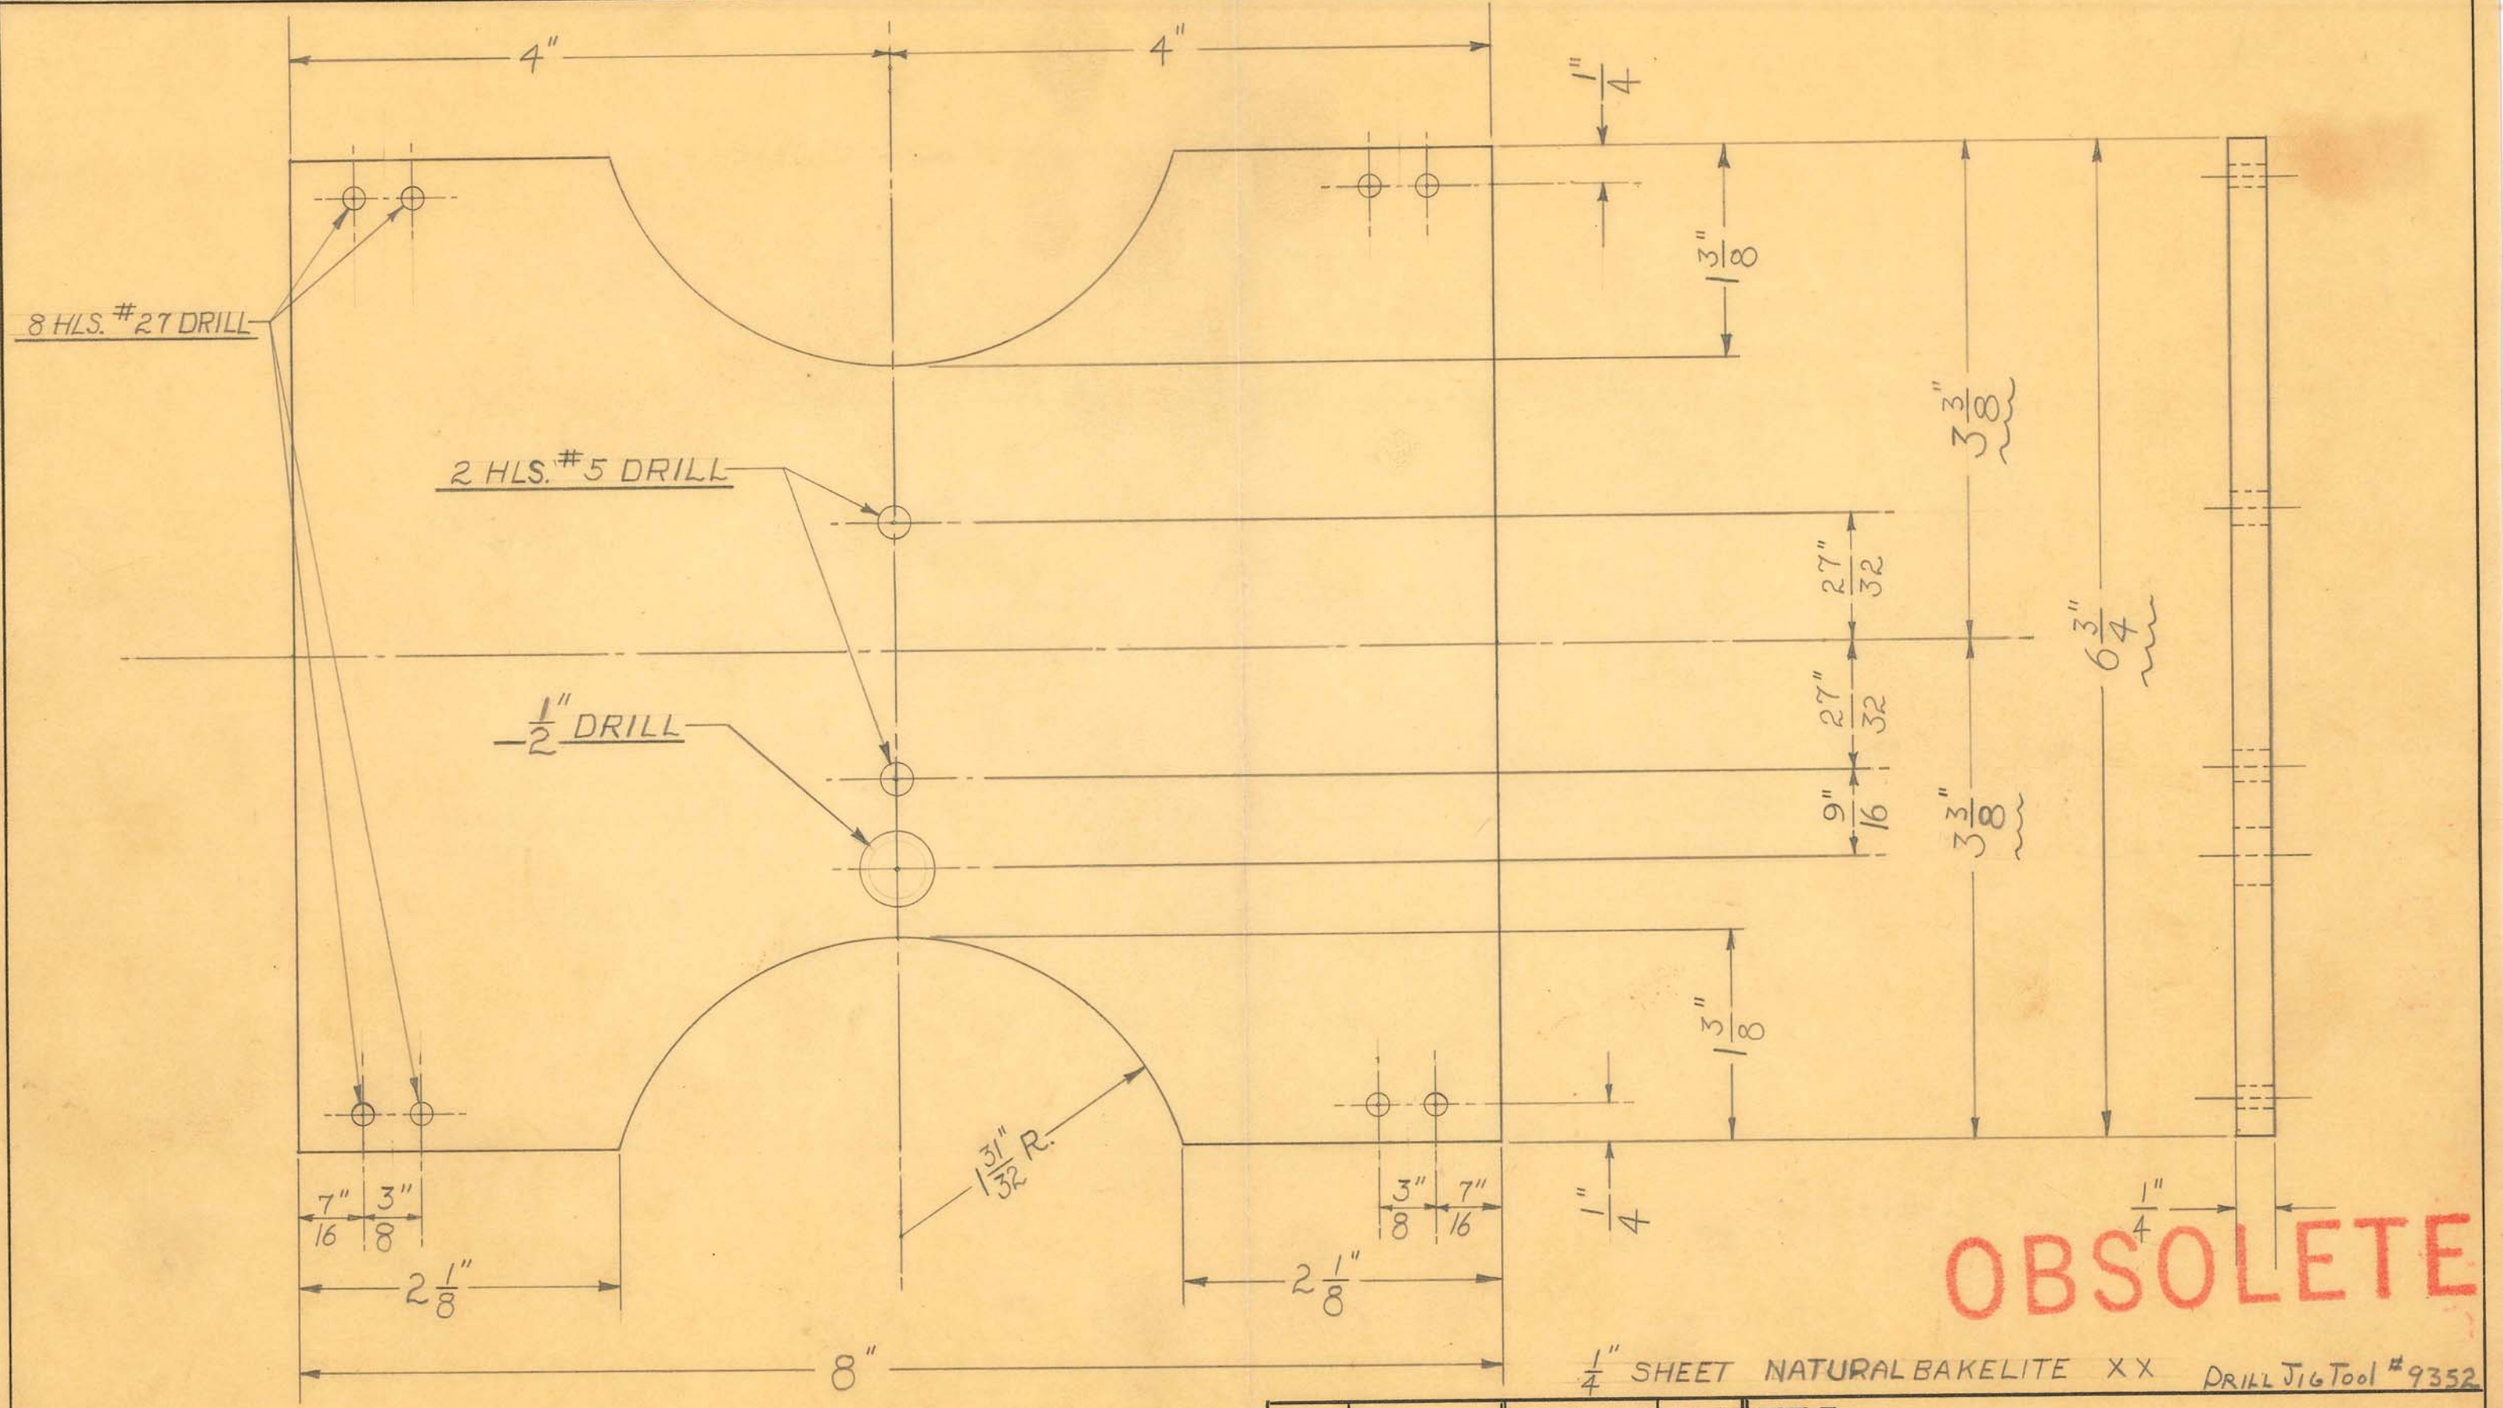

1 REQUIRED

1/4" SHEET NATURAL BAKELITE XX DRILL JIG TOOL #9352

OBSOLETE

SIZE		ISSUE 6-11-47	W.J.
KIND		CHANGED	
SHAPE		"	
FINISH		"	
TEMP.		"	
PATT.		"	

TITLE:
FISCHER "PRECISION 200" X-RAY UNIT
VALVE TUBE CLIP MOUNTING BOARD

H. G. FISCHER & CO.
2335 WABANSIA AVE.
CHICAGO, ILL.

CAT. NO.

PART NO. 16888F

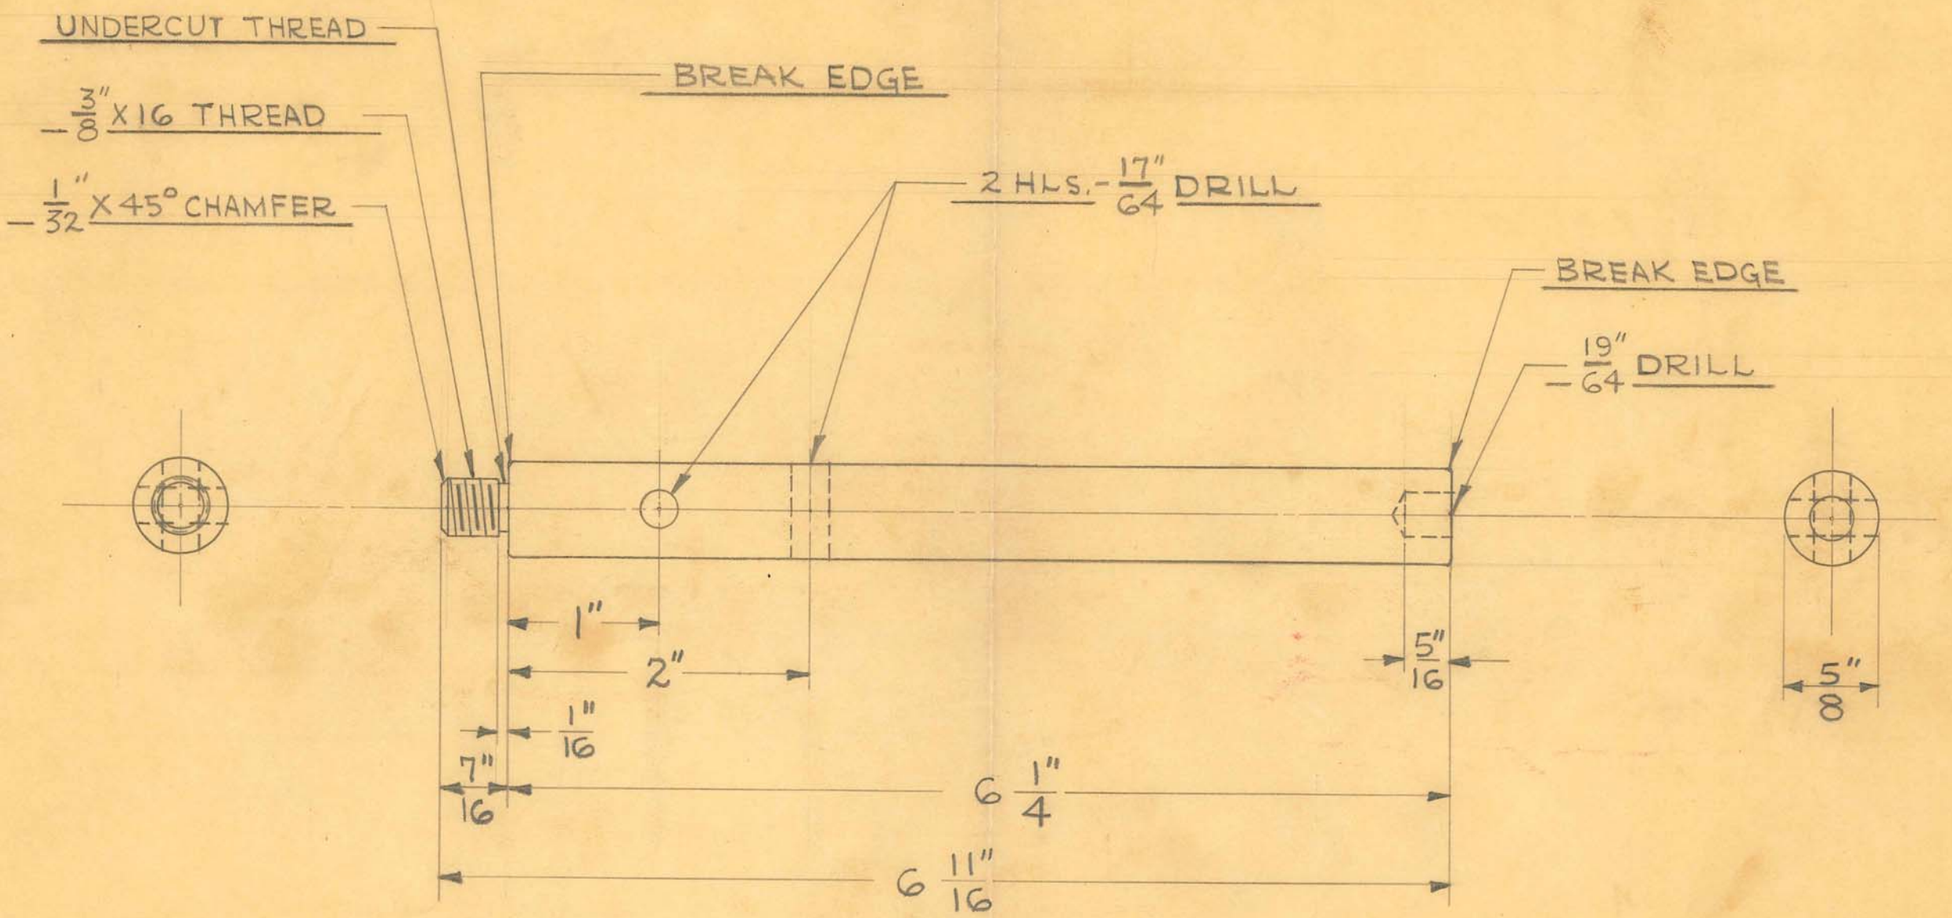

1 REQUIRED

OBSOLETE

SIZE	5/8" DIA.	ISSUE 11-19-46	J.V.W.	TITLE: FISCHER "TV-30-96" RAD. & FLUO. UNIT VERTICAL SLIDE BUMPER ROD
KIND	C.R. STEEL	CHANGED		
SHAPE	"	"		
FINISH	CAD. #23	"		
TEMP.		"		
PATT.		"		

H. G. FISCHER & CO.
2335 WABANSIA AVE.
CHICAGO, ILL.

CAT. NO.

PART NO. 14582-L

2 HLS. - #9 DRILL (.196") - $\frac{33}{64}$" C'BORE. $\frac{1}{16}$" DEEP FROM BOTTOM SIDE - SLOT AS SHOWN

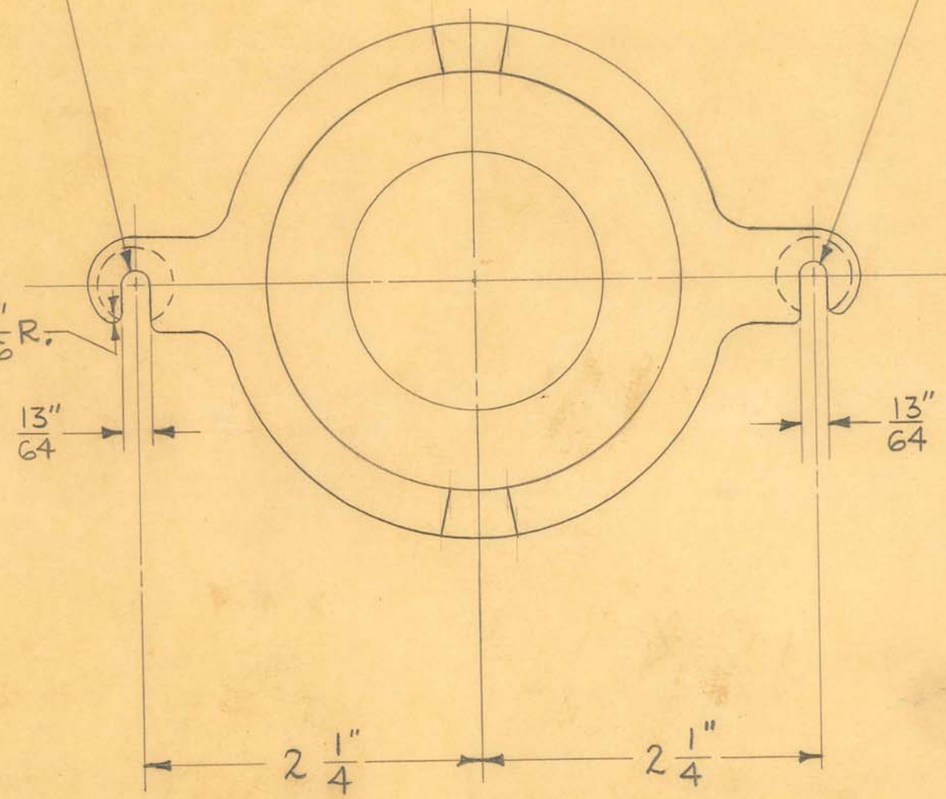

ROUND EDGE AFTER FACING OPERATION

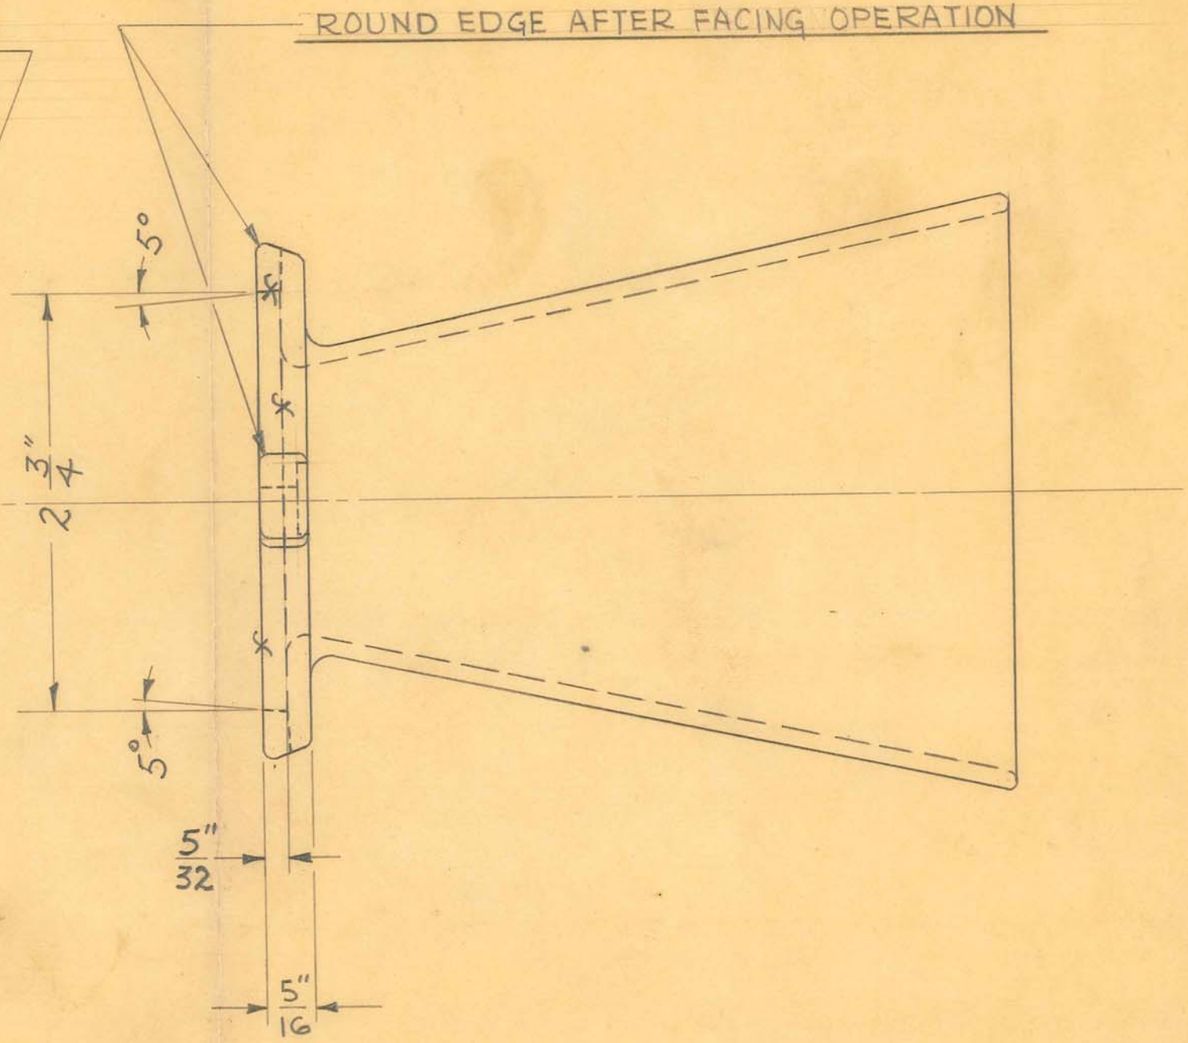

1 REQUIRED

OBSOLETE

SIZE	#12	ISSUE 10-15-46	J.V.W.	TITLE: FISCHER "TV-30-96" X-RAY UNIT RADIOGRAPHIC CONE (7"-30")
KIND	ALUMINUM	CHANGED		
SHAPE		"		
FINISH		"		
TEMP.		"		
PATT.	2067	"		

H. G. FISCHER & CO.
2335 WABANSIA AVE.
CHICAGO, ILL.

CAT. NO.

PART NO. 14586F

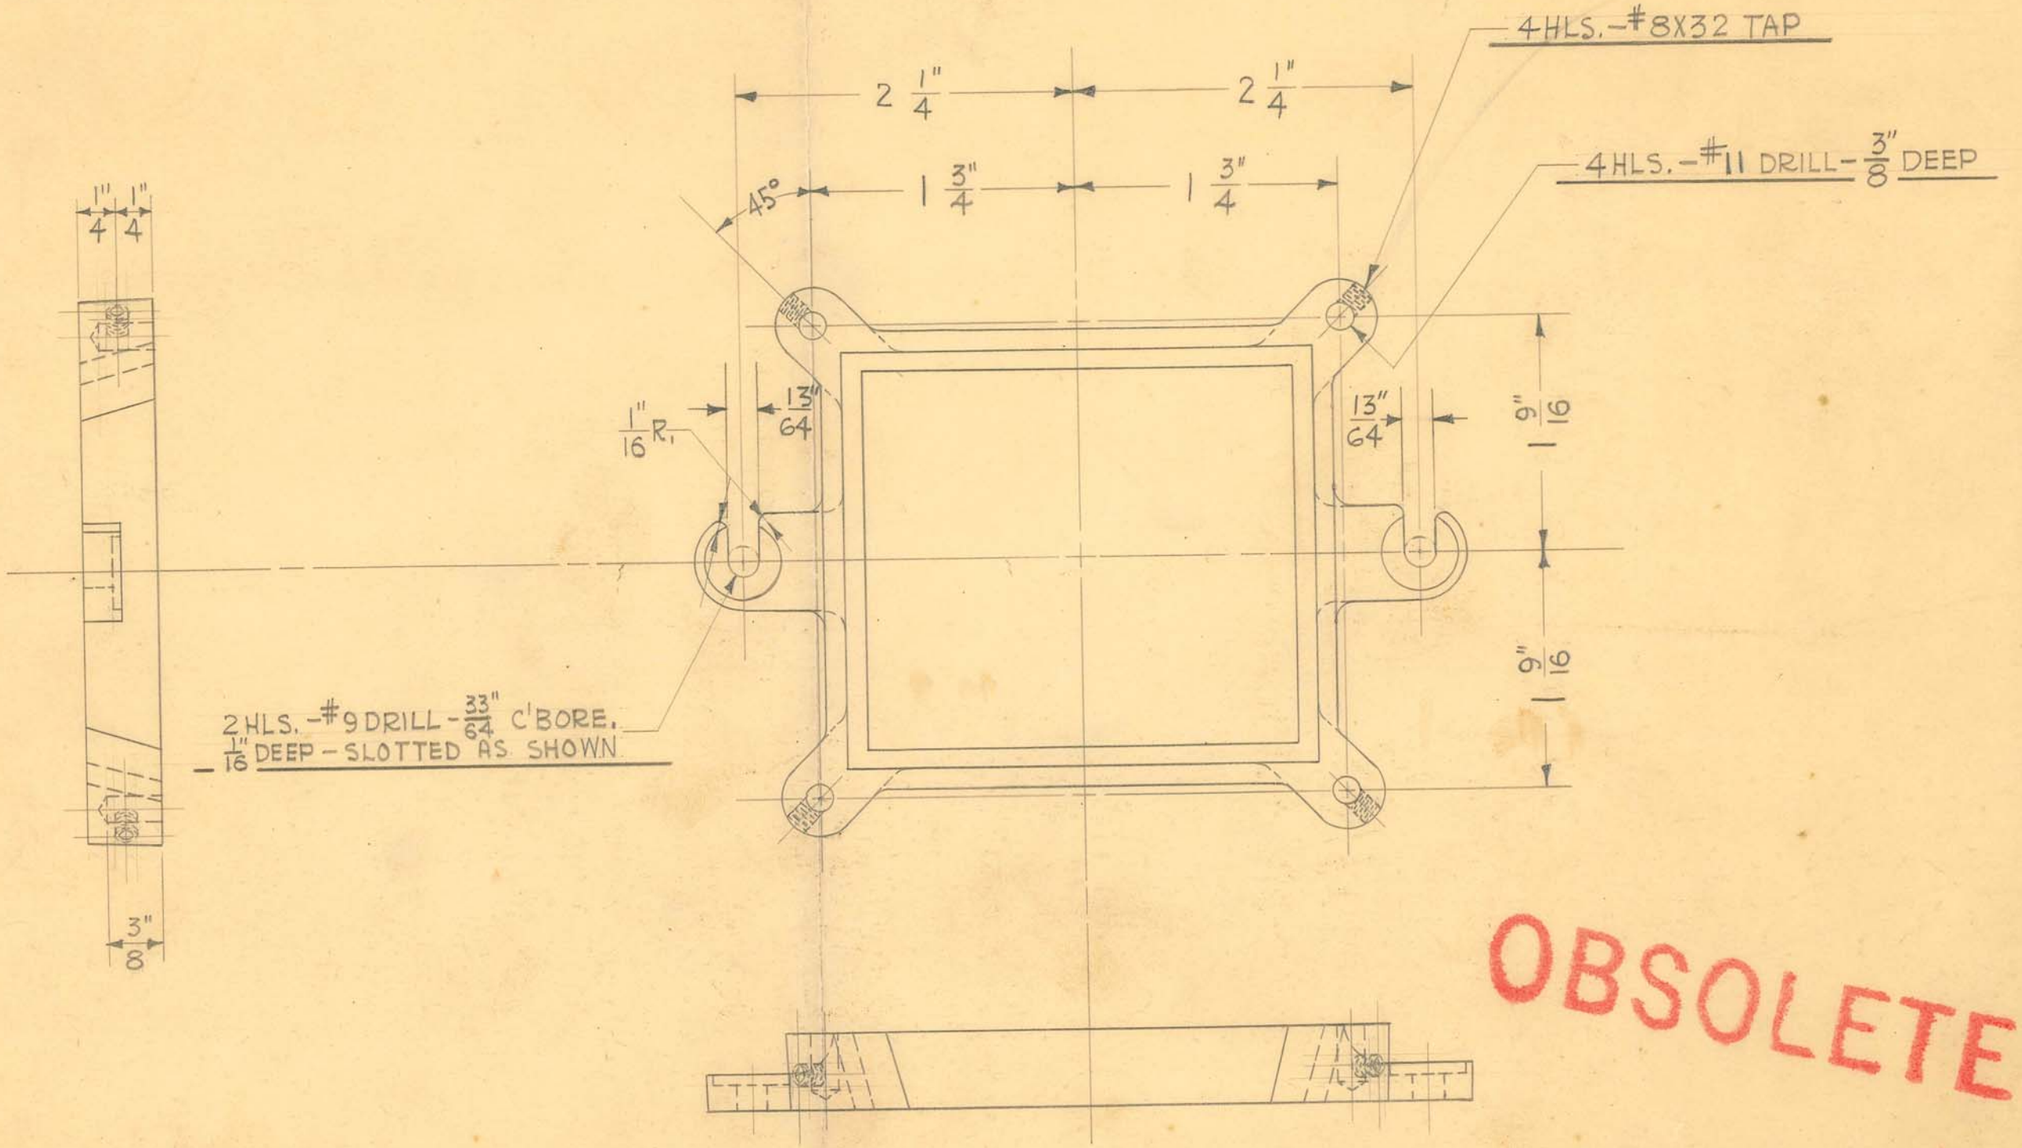

OBSOLETE

1 REQUIRED

SIZE	#12	ISSUE 5-6-41	J.Y.W.
KIND	ALUMINUM	CHANGED	
SHAPE		"	
FINISH	PAINTED	"	
TEMP.		"	
PATT.	1744	"	

TITLE: U.S. NAVY X-RAY UNIT
FLUOROSCOPIC DISTANCE SPACER BASE

H. G. FISCHER & CO.
2335 WABANSIA AVE.
CHICAGO, ILL.

CAT. NO.

PART NO. 14000F

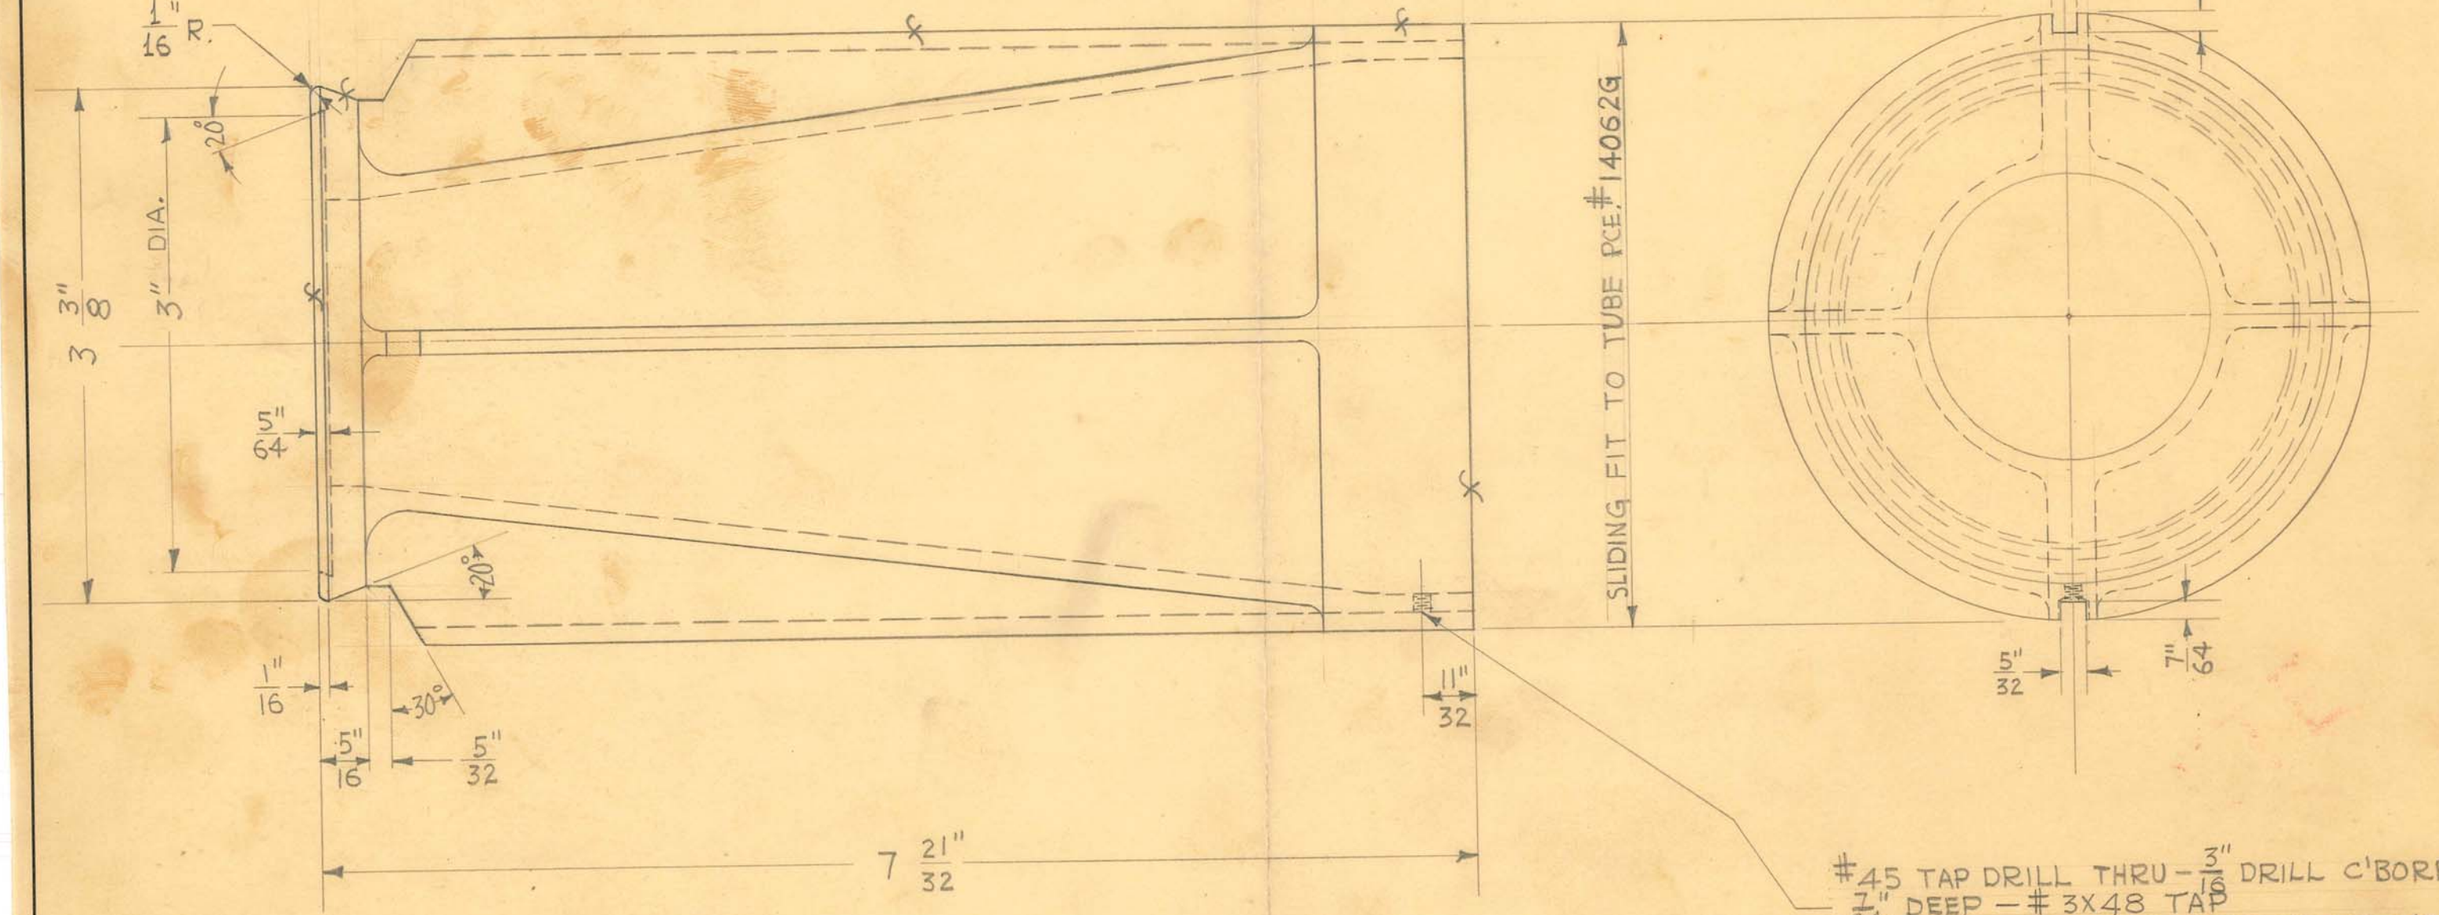

#45 TAP DRILL THRU – 3/16 DRILL C'BORE, 7/64" DEEP – #3X48 TAP
THIS IS DONE BEFORE SLOTTING.

OBSOLETE

SIZE	#12	ISSUE 3-27-41	J.V.W.
KIND	ALUMINUM	CHANGED	
SHAPE		"	
FINISH	PAINTED	"	
TEMP.		"	
PATT.	1729	"	

TITLE: U.S. NAVY X-RAY UNIT
RADIOGRAPHIC CONE

H. G. FISCHER & CO.
2338 WABANSIA AVE.
CHICAGO, ILL.

CAT. NO.

PART NO. 14002F

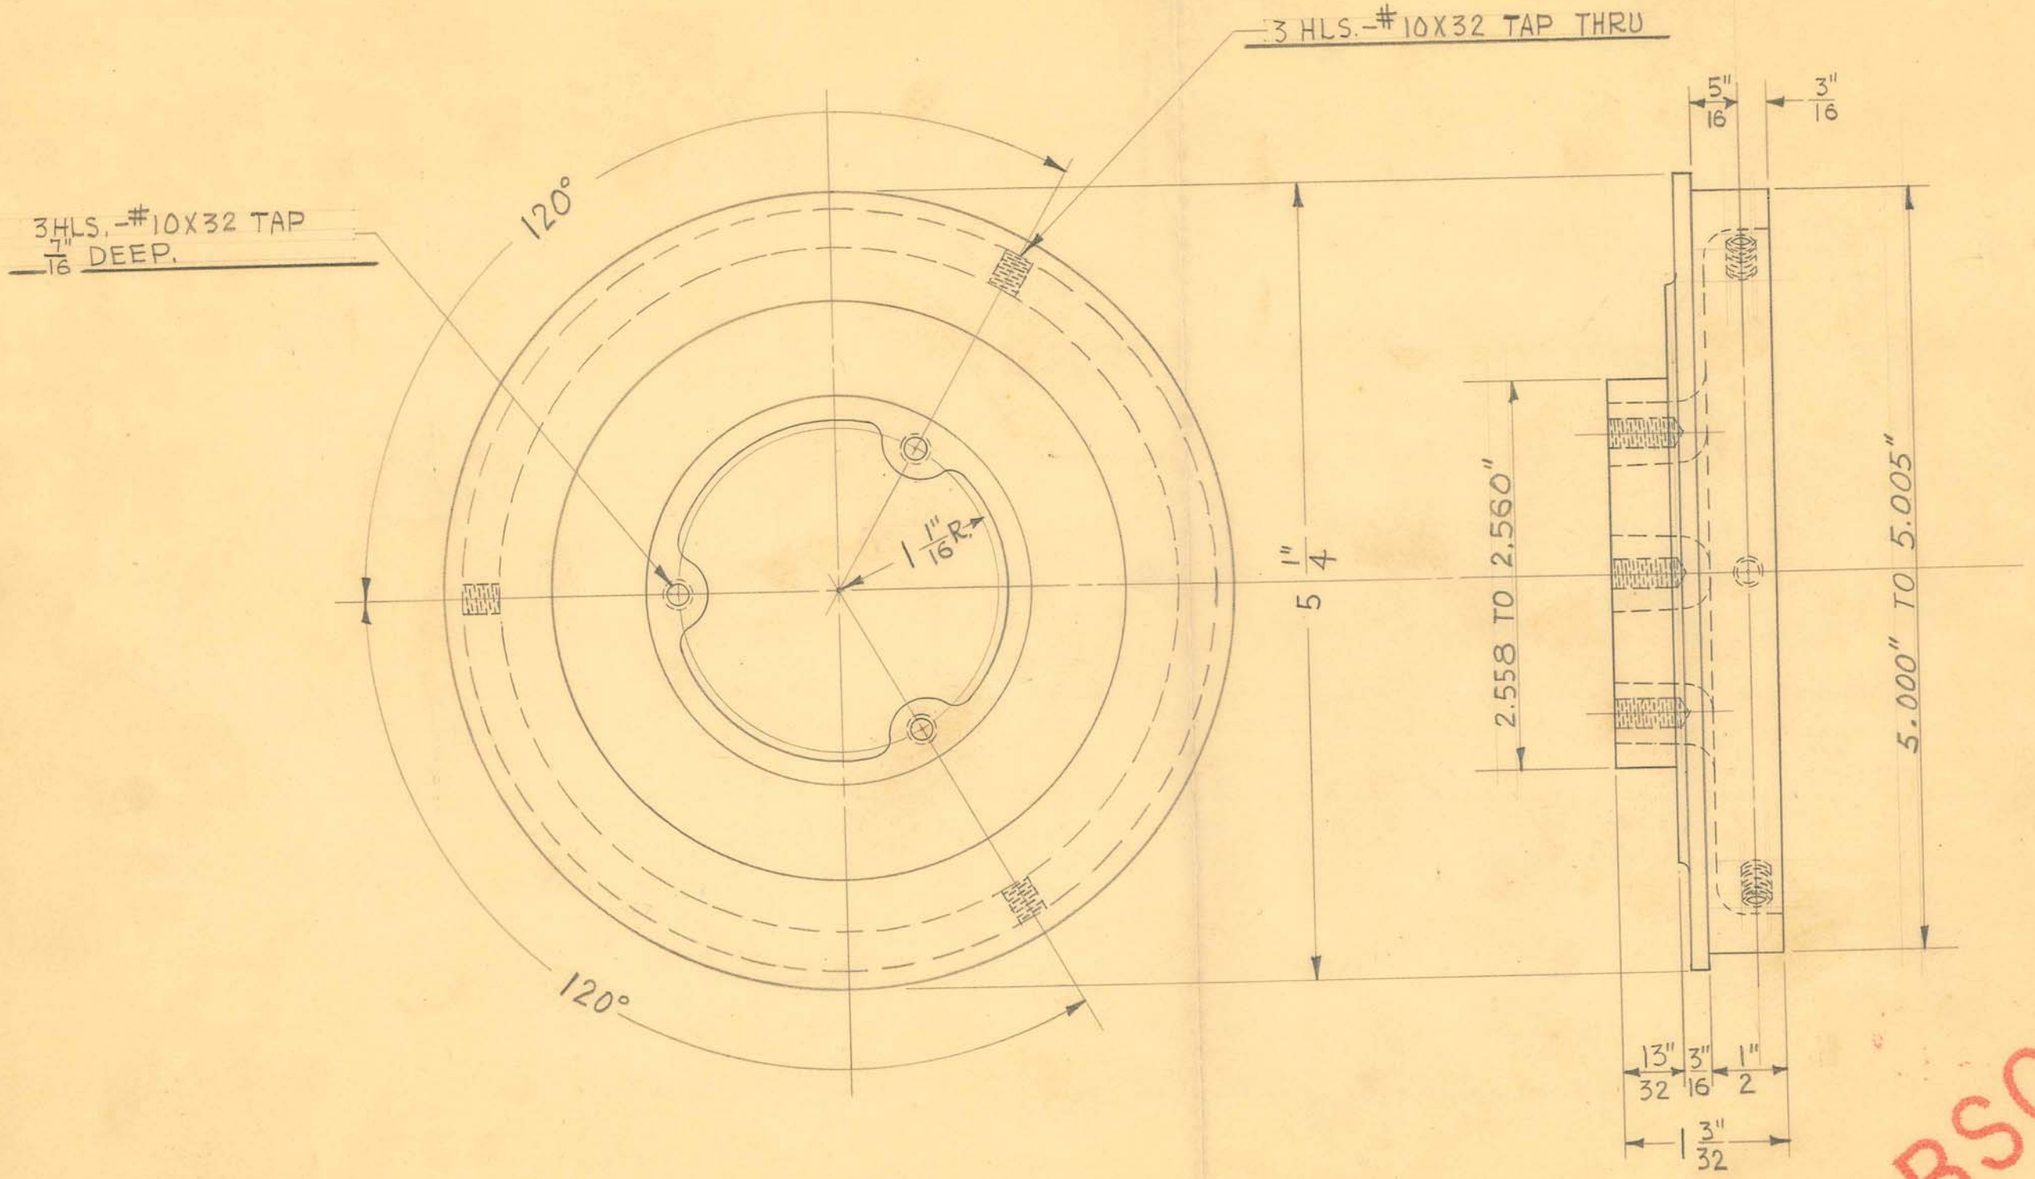

OBSOLETE

Obsolete

SIZE	80-10-10	ISSUE 4-22-41	J.V.W.
KIND	BRONZE CASTING	CHANGED	
SHAPE		"	
FINISH		"	
TEMP.		"	
PATT.	1723	"	

TITLE: U.S. NAVY X-RAY UNIT- INNER TUBE CAP & BEARING

H. G. FISCHER & CO.
2335 WABANSIA AVE.
CHICAGO. ILL.

CAT. NO.

PART NO. 14004F

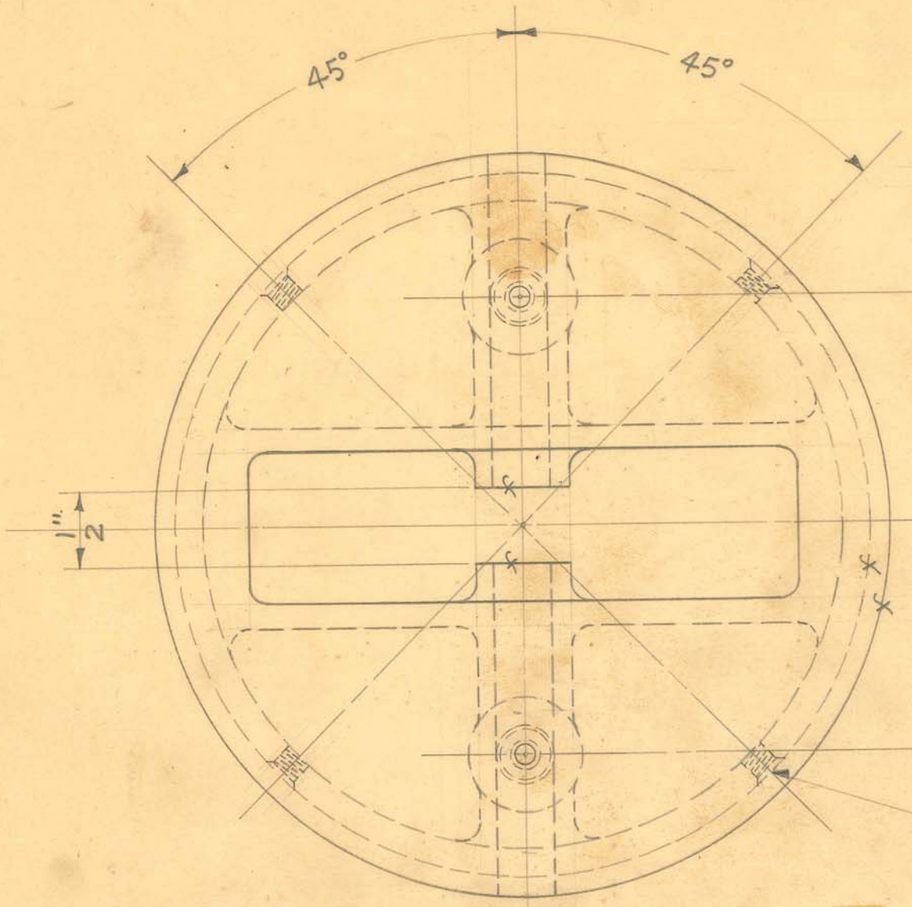

2 HLS.-#10X32 TAP

4 HLS.-#10X32 TAP
C'SUNK. TO 1/4" FACE

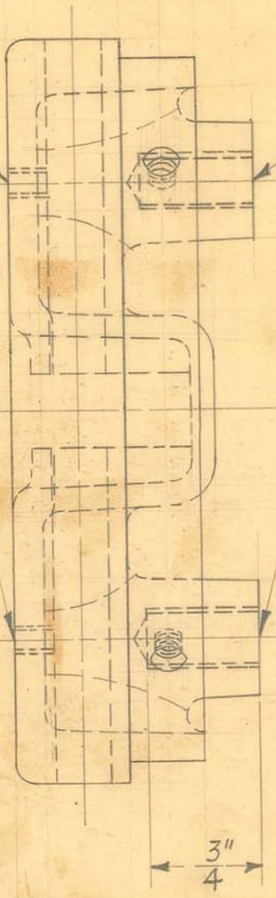

2 HLS.- 3/8" X 16 TAP

3/4"

3/8" DRILL

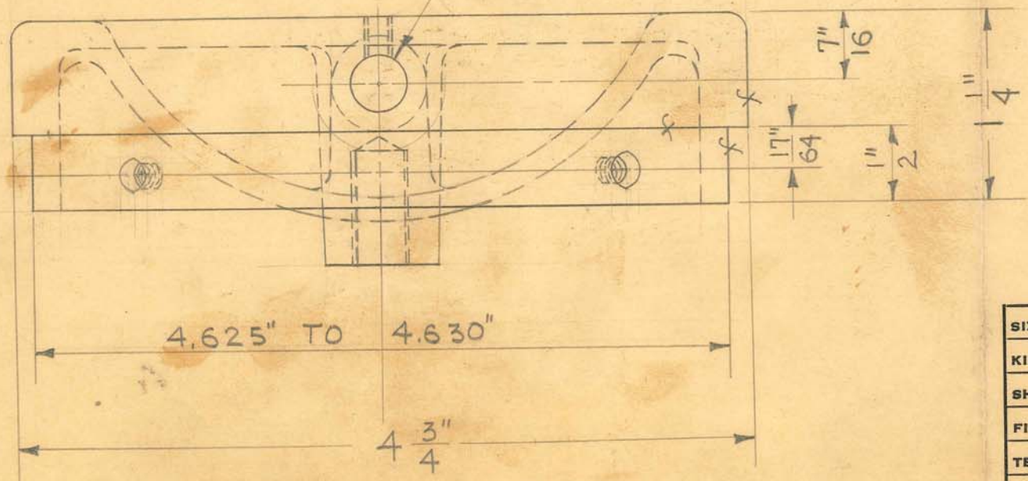

OBSOLETE

1 REQUIRED

Obsolete

SIZE	BRASS	ISSUE 5-1-41	J.V.W.	
KIND	CASTING	CHANGED		
SHAPE		"		
FINISH		"		
TEMP.		"		
PATT.	1727	"		

TITLE:
U.S. NAVY X-RAY UNIT
COUNTERWEIGHT TOP CAP

H. G. FISCHER & CO.
2335 WABANSIA AVE.
CHICAGO, ILL.

CAT. NO.

PART NO. 14007F

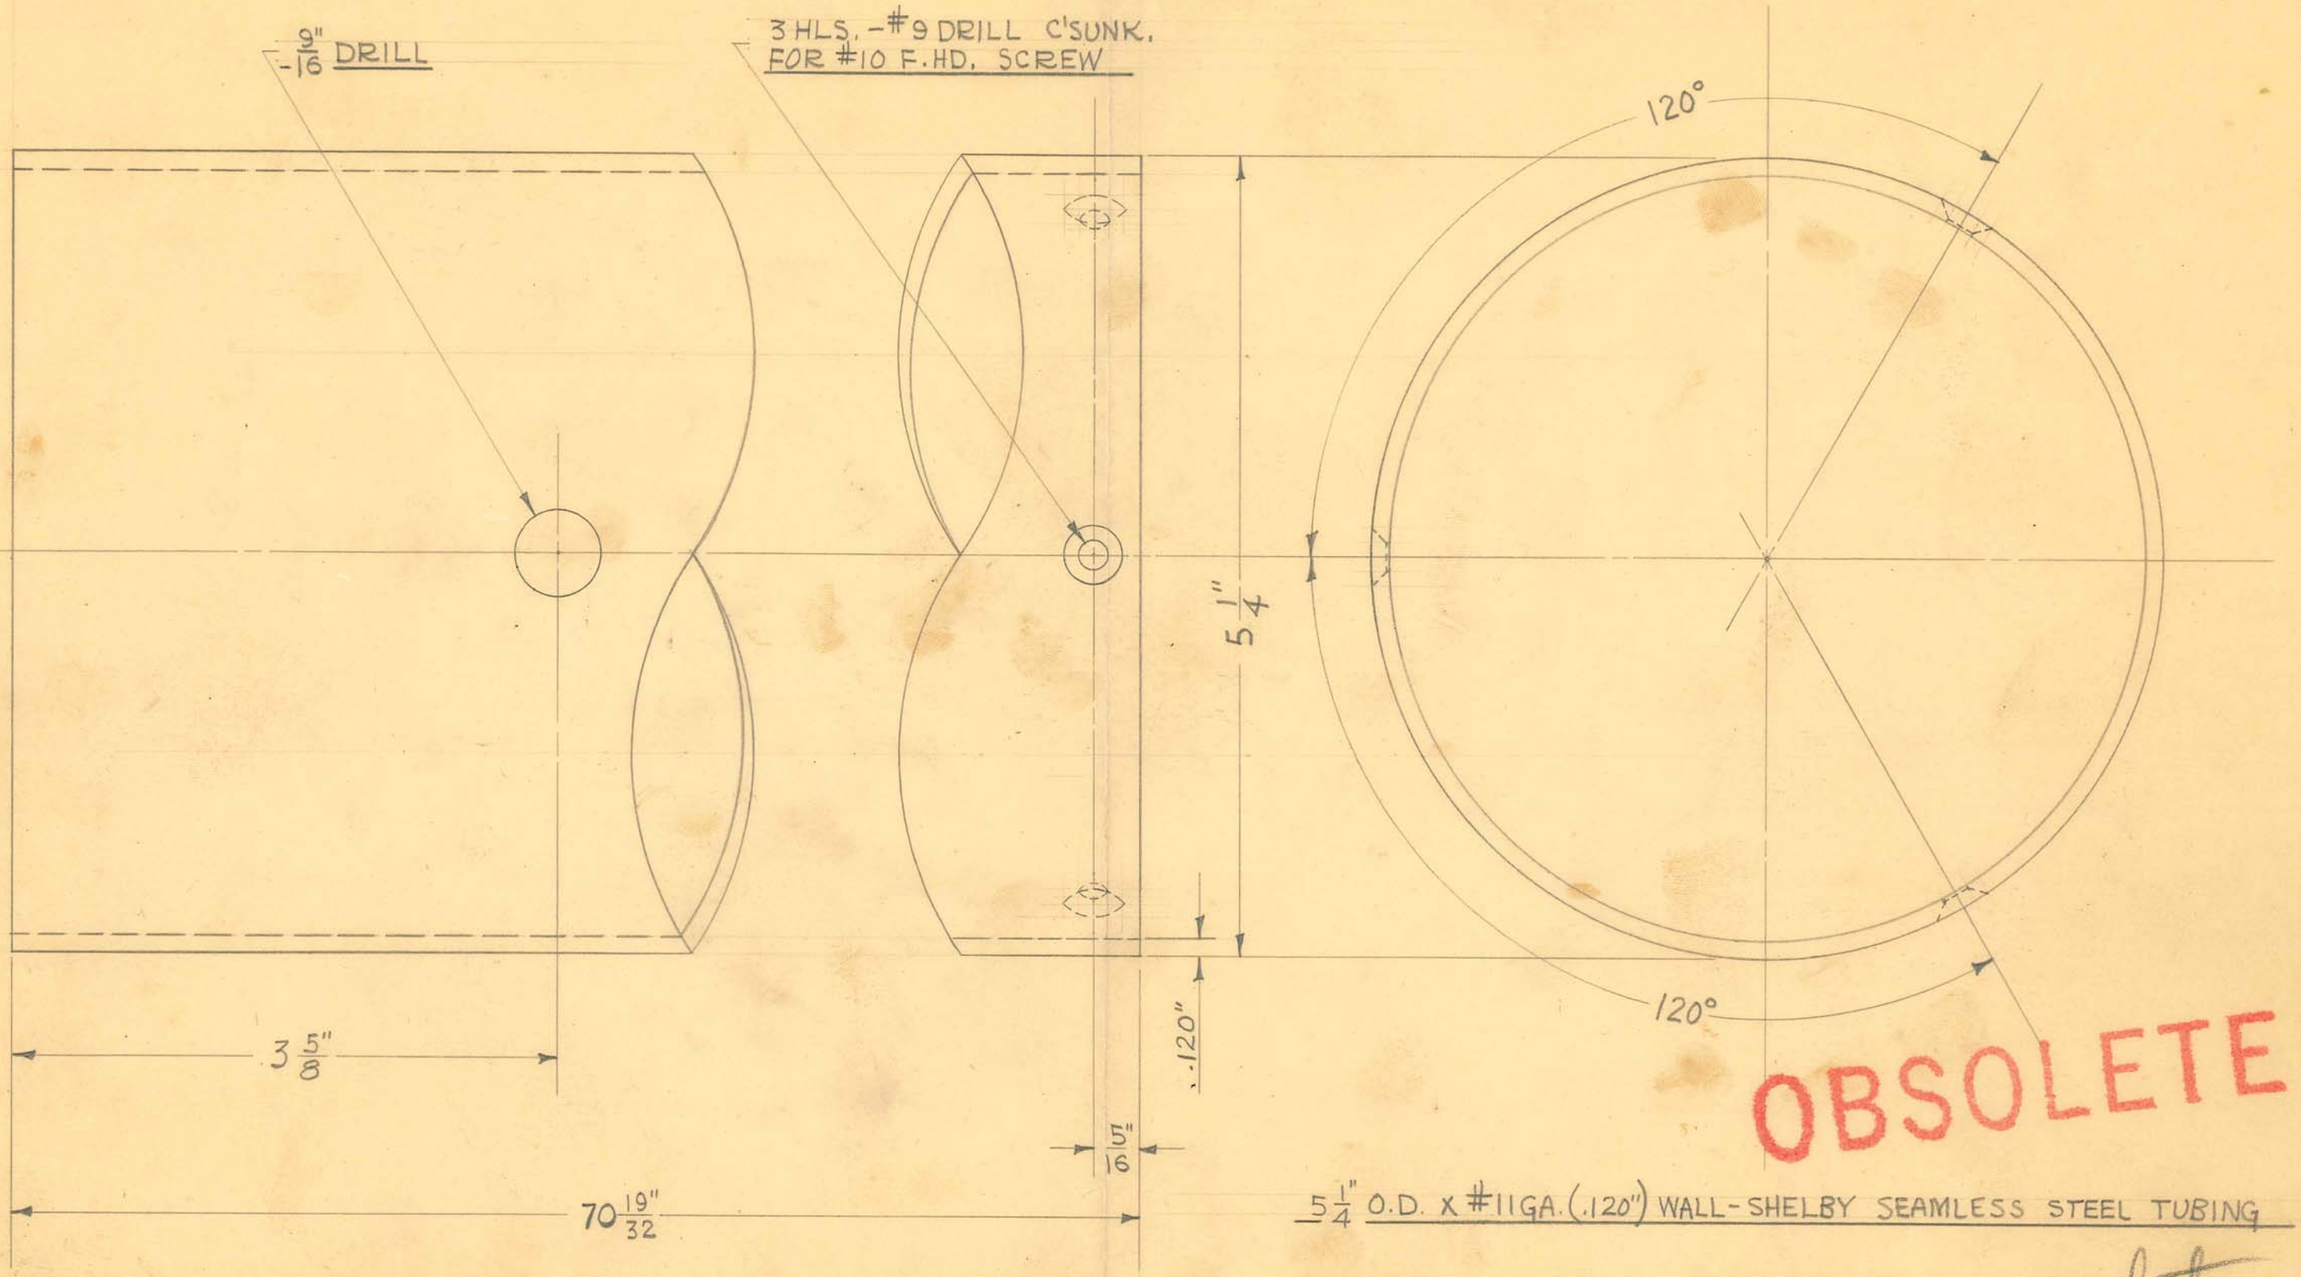

OBSOLETE

5 1/4" O.D. x #11GA. (.120") WALL - SHELBY SEAMLESS STEEL TUBING

1 REQUIRED

obsolete

SIZE		ISSUE 4-29-41	J.V.W.	TITLE: U.S. NAVY X-RAY UNIT INNER UPRIGHT TUBE
KIND		CHANGED		
SHAPE		"		
FINISH	BLACK #80	"		
TEMP.		"		
PATT.		"		

H. G. FISCHER & CO. 2335 WABANSIA AVE. CHICAGO, ILL. | CAT. NO. | PART NO. 14009F

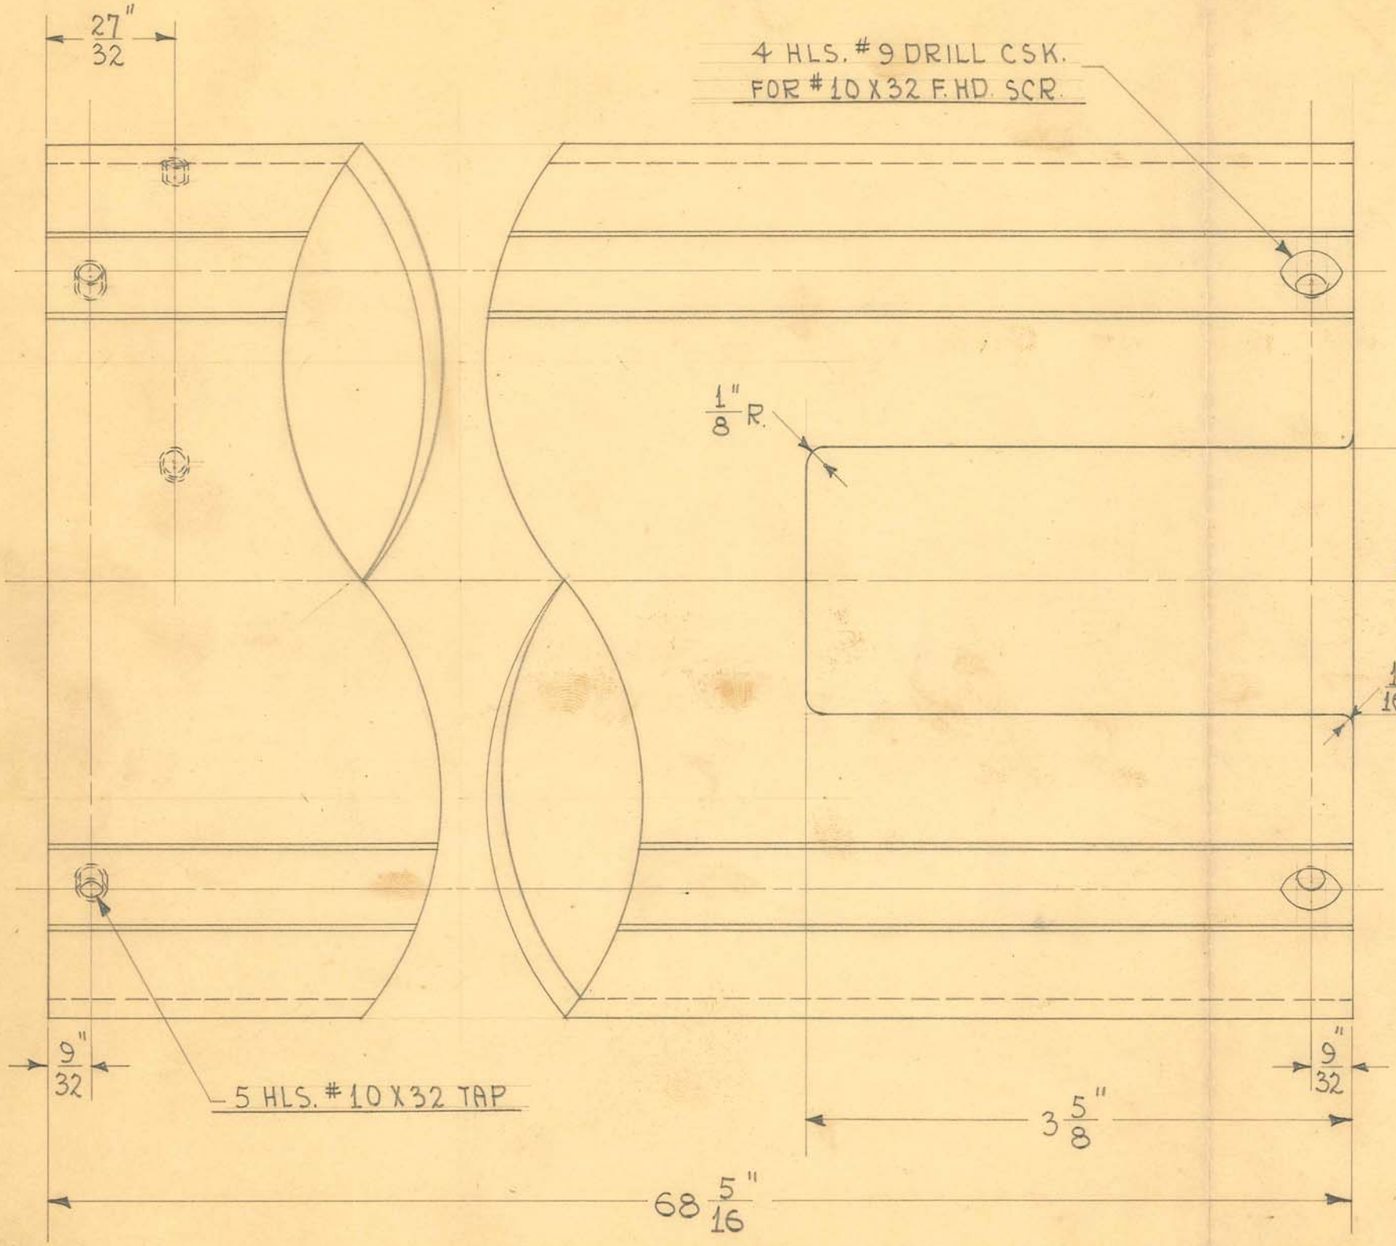

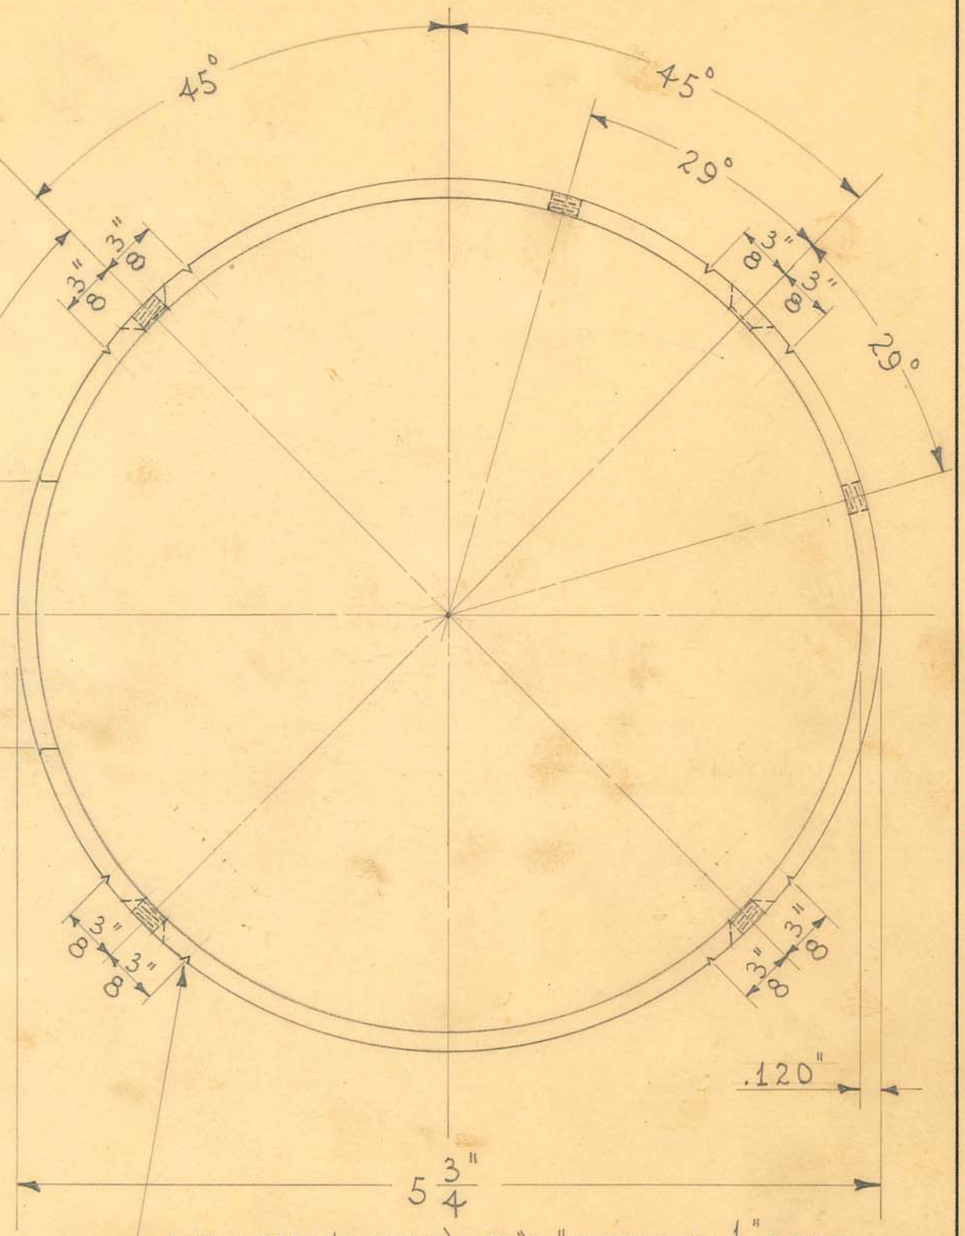

CUT 4 SETS (2 EACH) OF "V" GROOVES 1/32" DEEP - WITH SPECIAL TOOL, 3/8" EITHER SIDE OF CENTER OF CSK. HOLES AS SHOWN.

1 REQUIRED

5 3/4" O.D. X #11 GA. (.120") SHELBY SEAMLESS STEEL TUBING

SIZE		ISSUE 4-29-41	HE.	TITLE: U.S. NAVY X-RAY UNIT - OUTER UPRIGHT TUBE
KIND		CHANGED		
SHAPE		"		
FINISH		"		
TEMP.		"		
PATT.		"		

H. G. FISCHER & CO. 2338 WABANSIA AVE. CHICAGO, ILL. | CAT. NO. | PART NO. 14010F

Obsolete

OBSOLETE

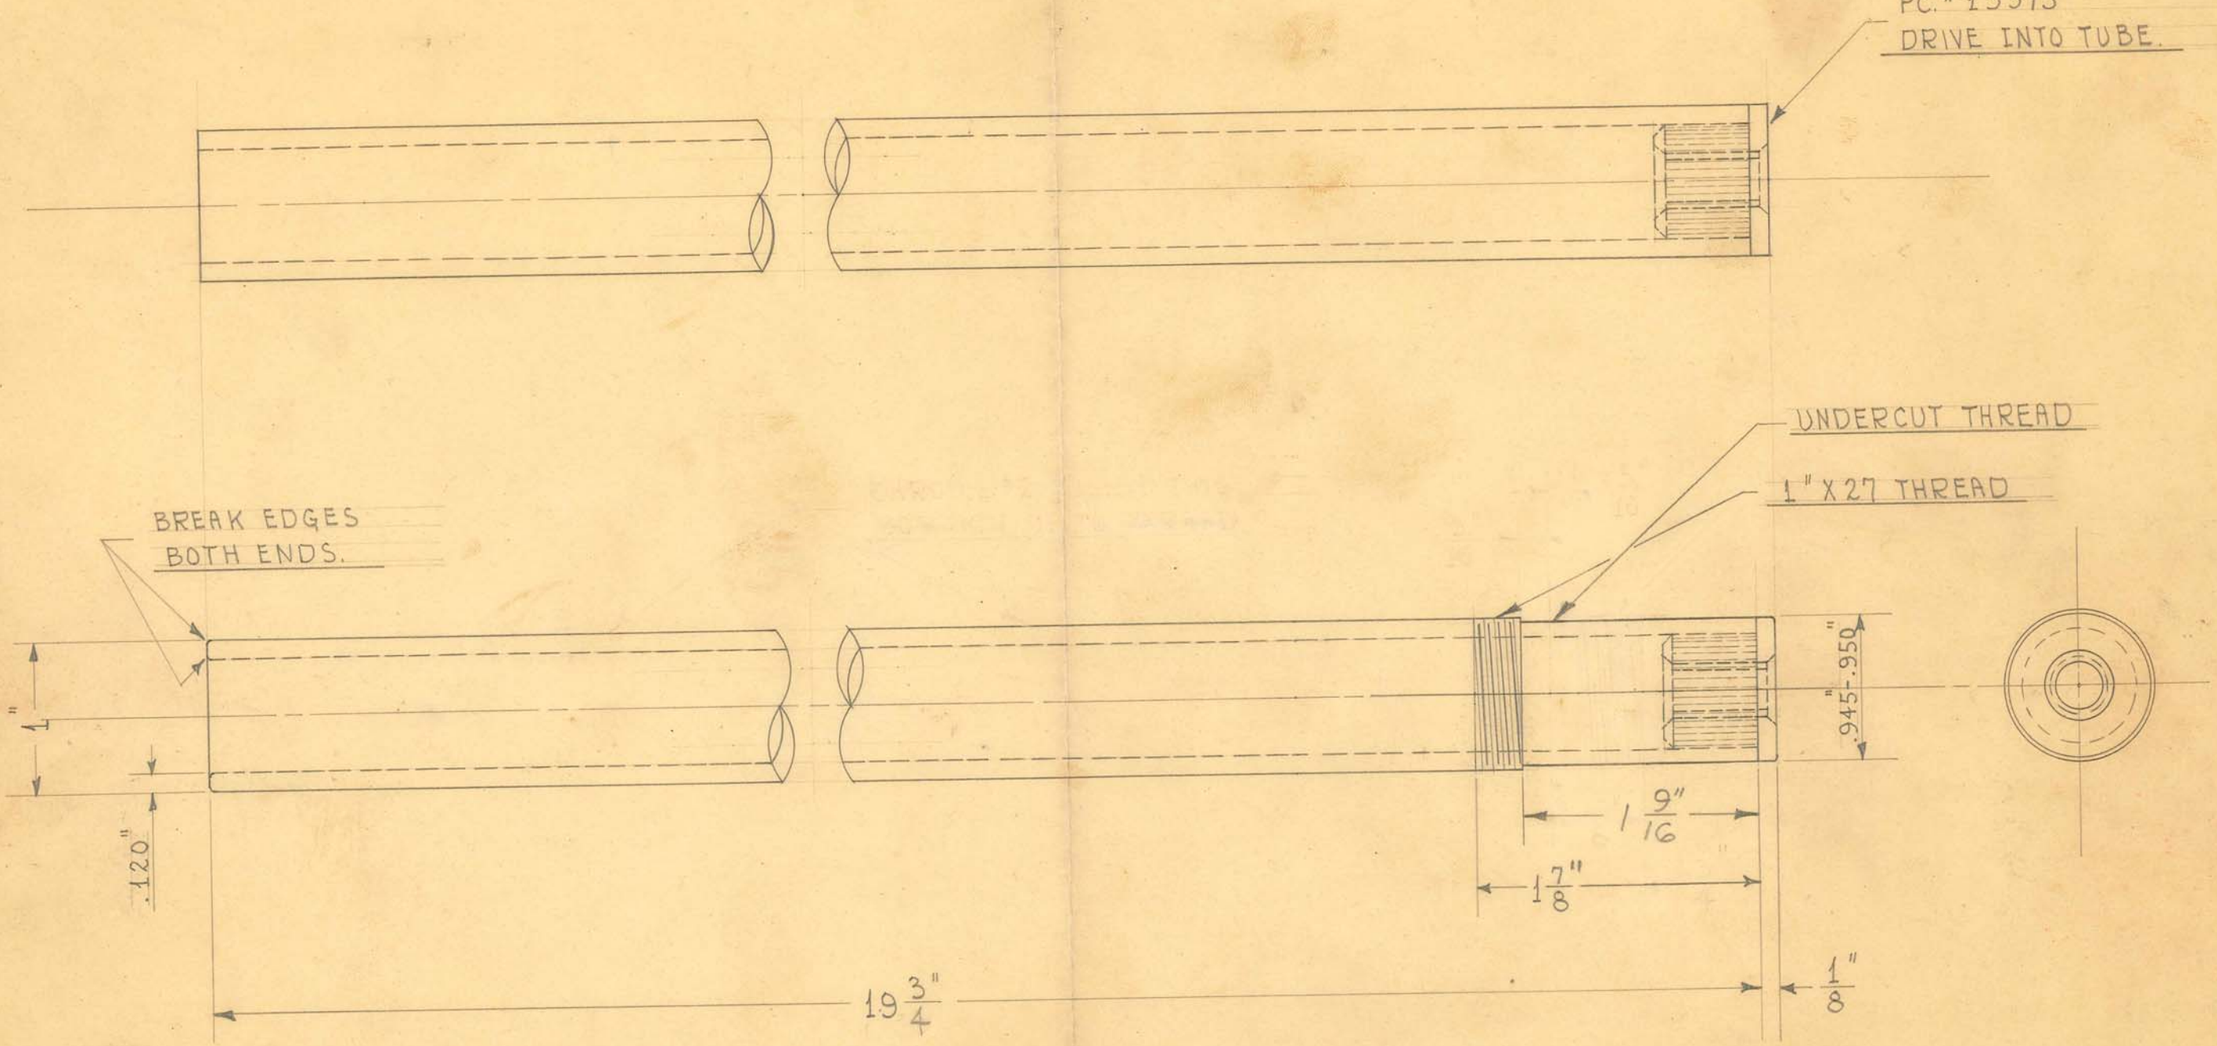

1" O.D. X #11 GA. (.120") WALL SEAMLESS STEEL TUBING

1 REQUIRED

OBSOLETE

SIZE		ISSUE 4-10-41	HE.
KIND		CHANGED	
SHAPE		" 6-19-46	J.V.W.
FINISH	PAINTED	"	
TEMP.		"	
PATT.		"	

TITLE: U.S. NAVY X-RAY UNIT-
VERTICAL COLUMN ROTATION LOCK-TUBE

H. G. FISCHER & CO.
2338 WABANSIA AVE.
CHICAGO, ILL.

CAT. NO.

PART NO. 14015G

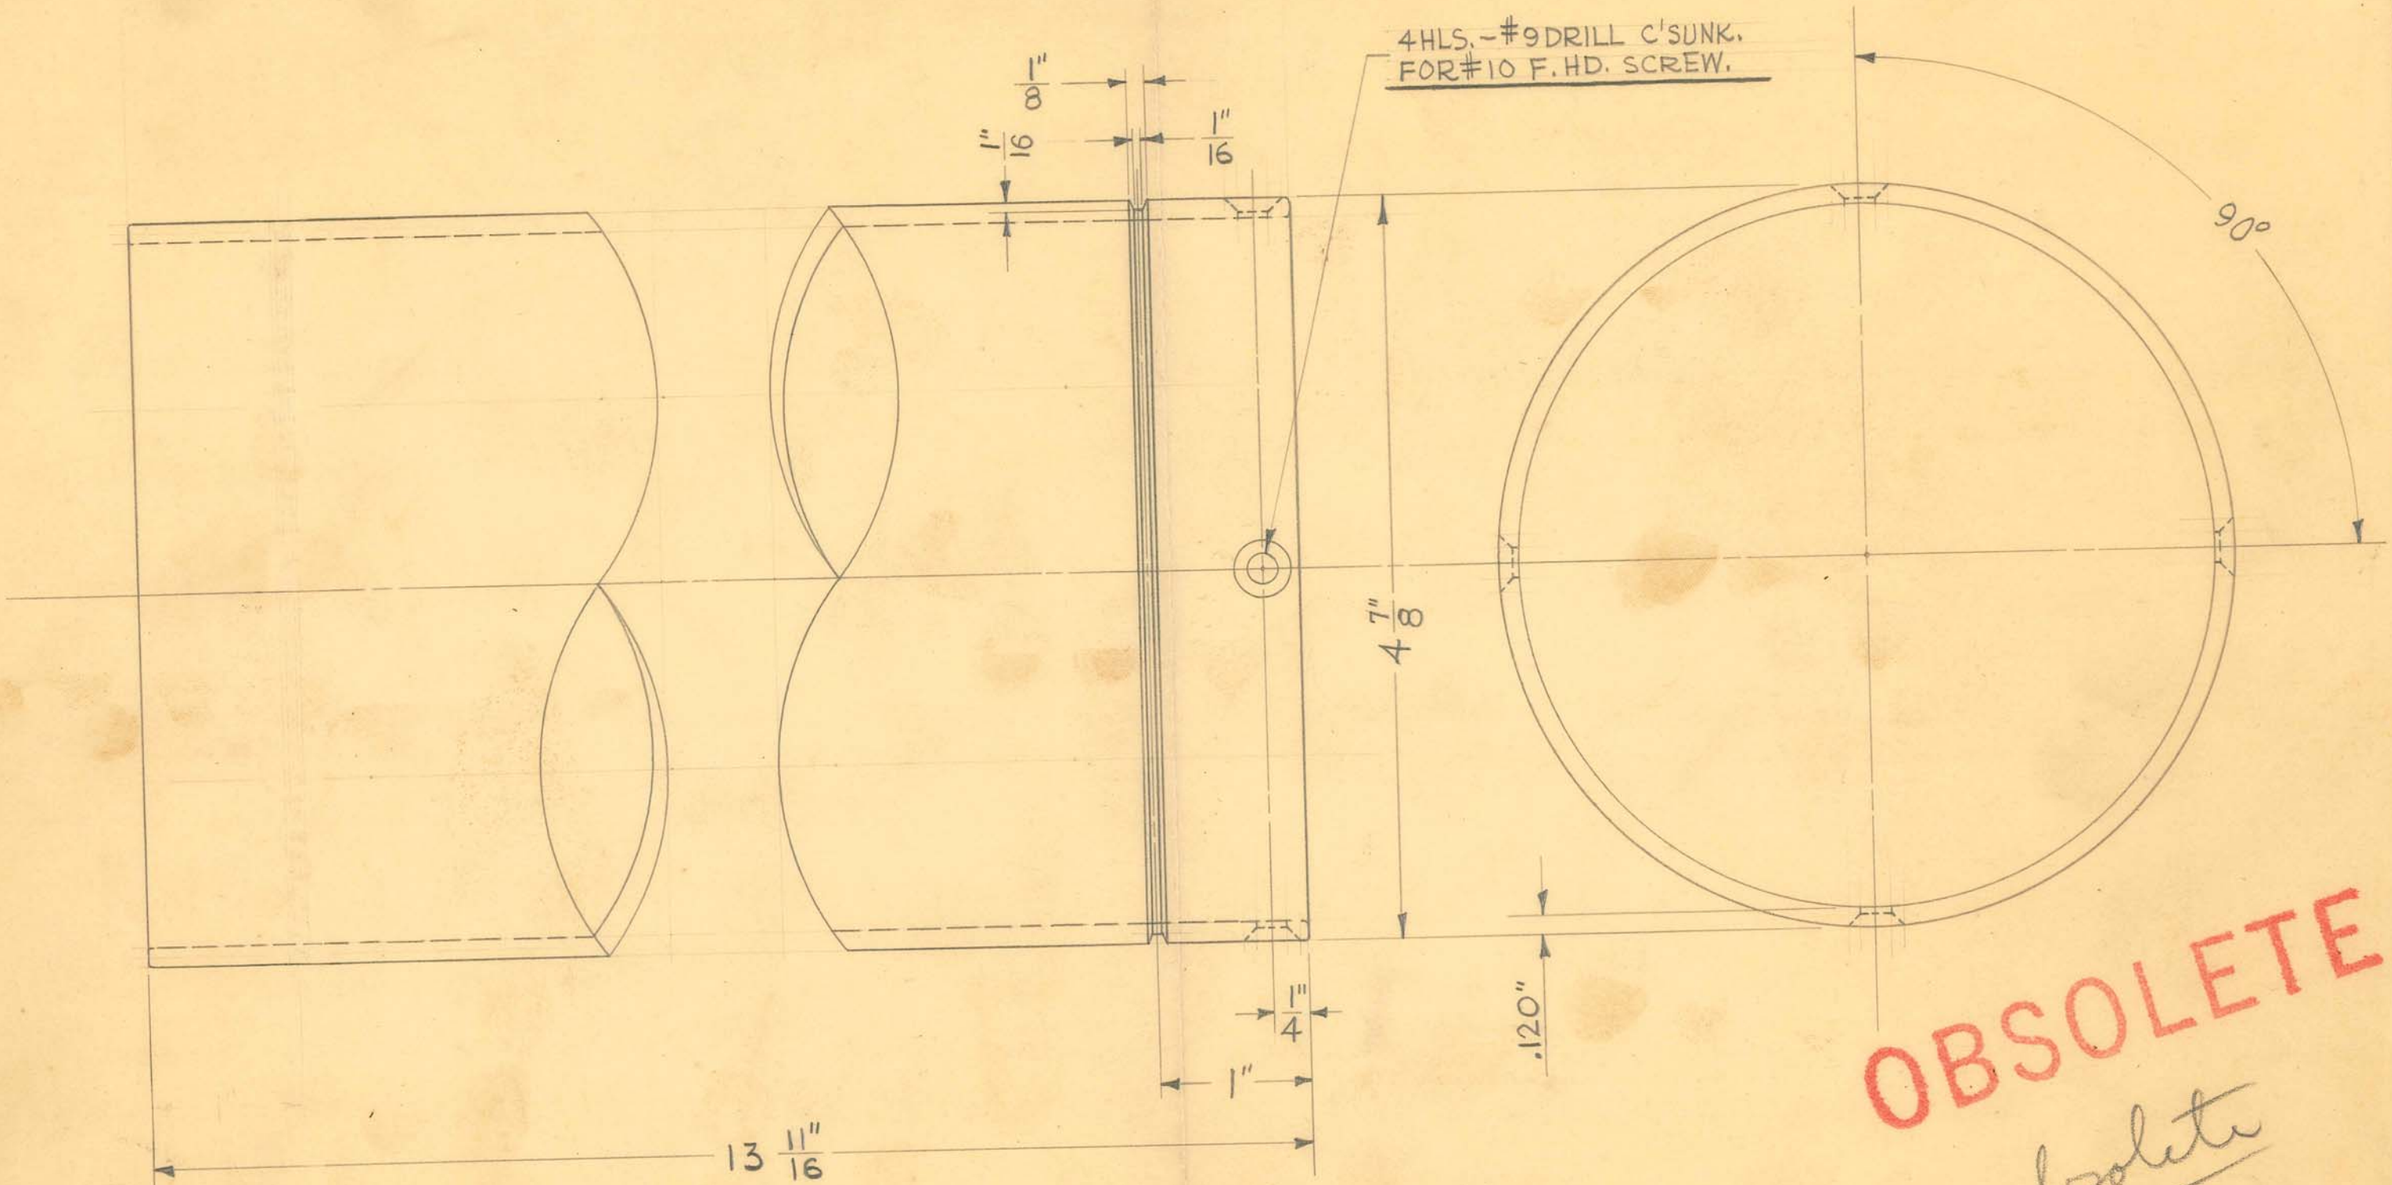

OBSOLETE

obsolete

4 7/8" O.D. X #11GA. (.120") SHELBY SEAMLESS STEEL TUBING

1 REQUIRED

SIZE		ISSUE 5-7-41	J.V.W.	TITLE: U.S. NAVY X-RAY UNIT COUNTERWEIGHT TUBE
KIND		CHANGED		
SHAPE		"		
FINISH		"		
TEMP.		"		
PATT.		"		

H. G. FISCHER & CO.
2338 WABANSIA AVE.
CHICAGO, ILL.

CAT. NO.

PART NO. 14018F

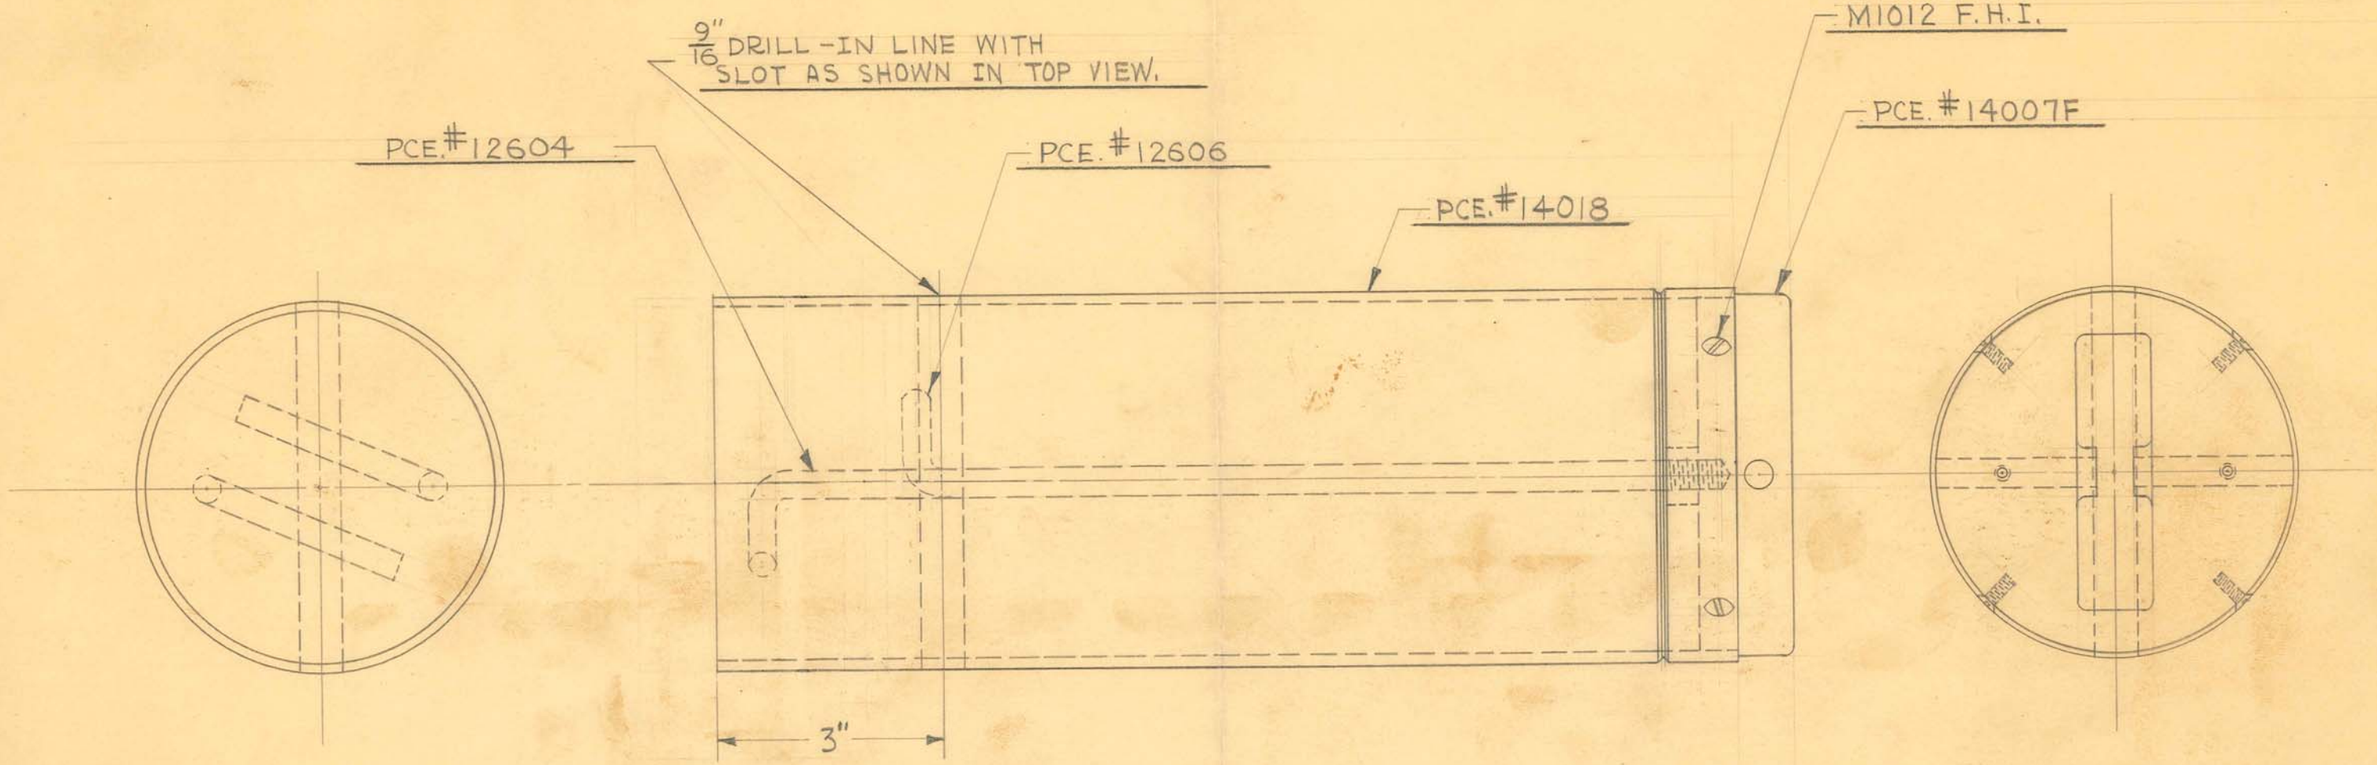

SCREW RODS INTO TOP CAP AS SHOWN.
FASTEN TUBE TO TOP CAP WITH #10X32 SCREWS.
FILL WITH LEAD TO TOP OF TUBE.

TOTAL WEIGHT AFTER DRILLING 9/16 HOLE — 102 3/4 LBS.

1 REQUIRED

OBSOLETE

obsolete

SIZE		ISSUE 5-9-41	J.V.W.	TITLE: U.S. NAVY X-RAY UNIT COUNTERWEIGHT ASSEMBLY
KIND		CHANGED		
SHAPE		"		
FINISH		"		
TEMP.		"		
PATT.		"		

H. G. FISCHER & CO. 2333 WABANSIA AVE. CHICAGO. ILL. | CAT. NO. | PART NO. 14020G

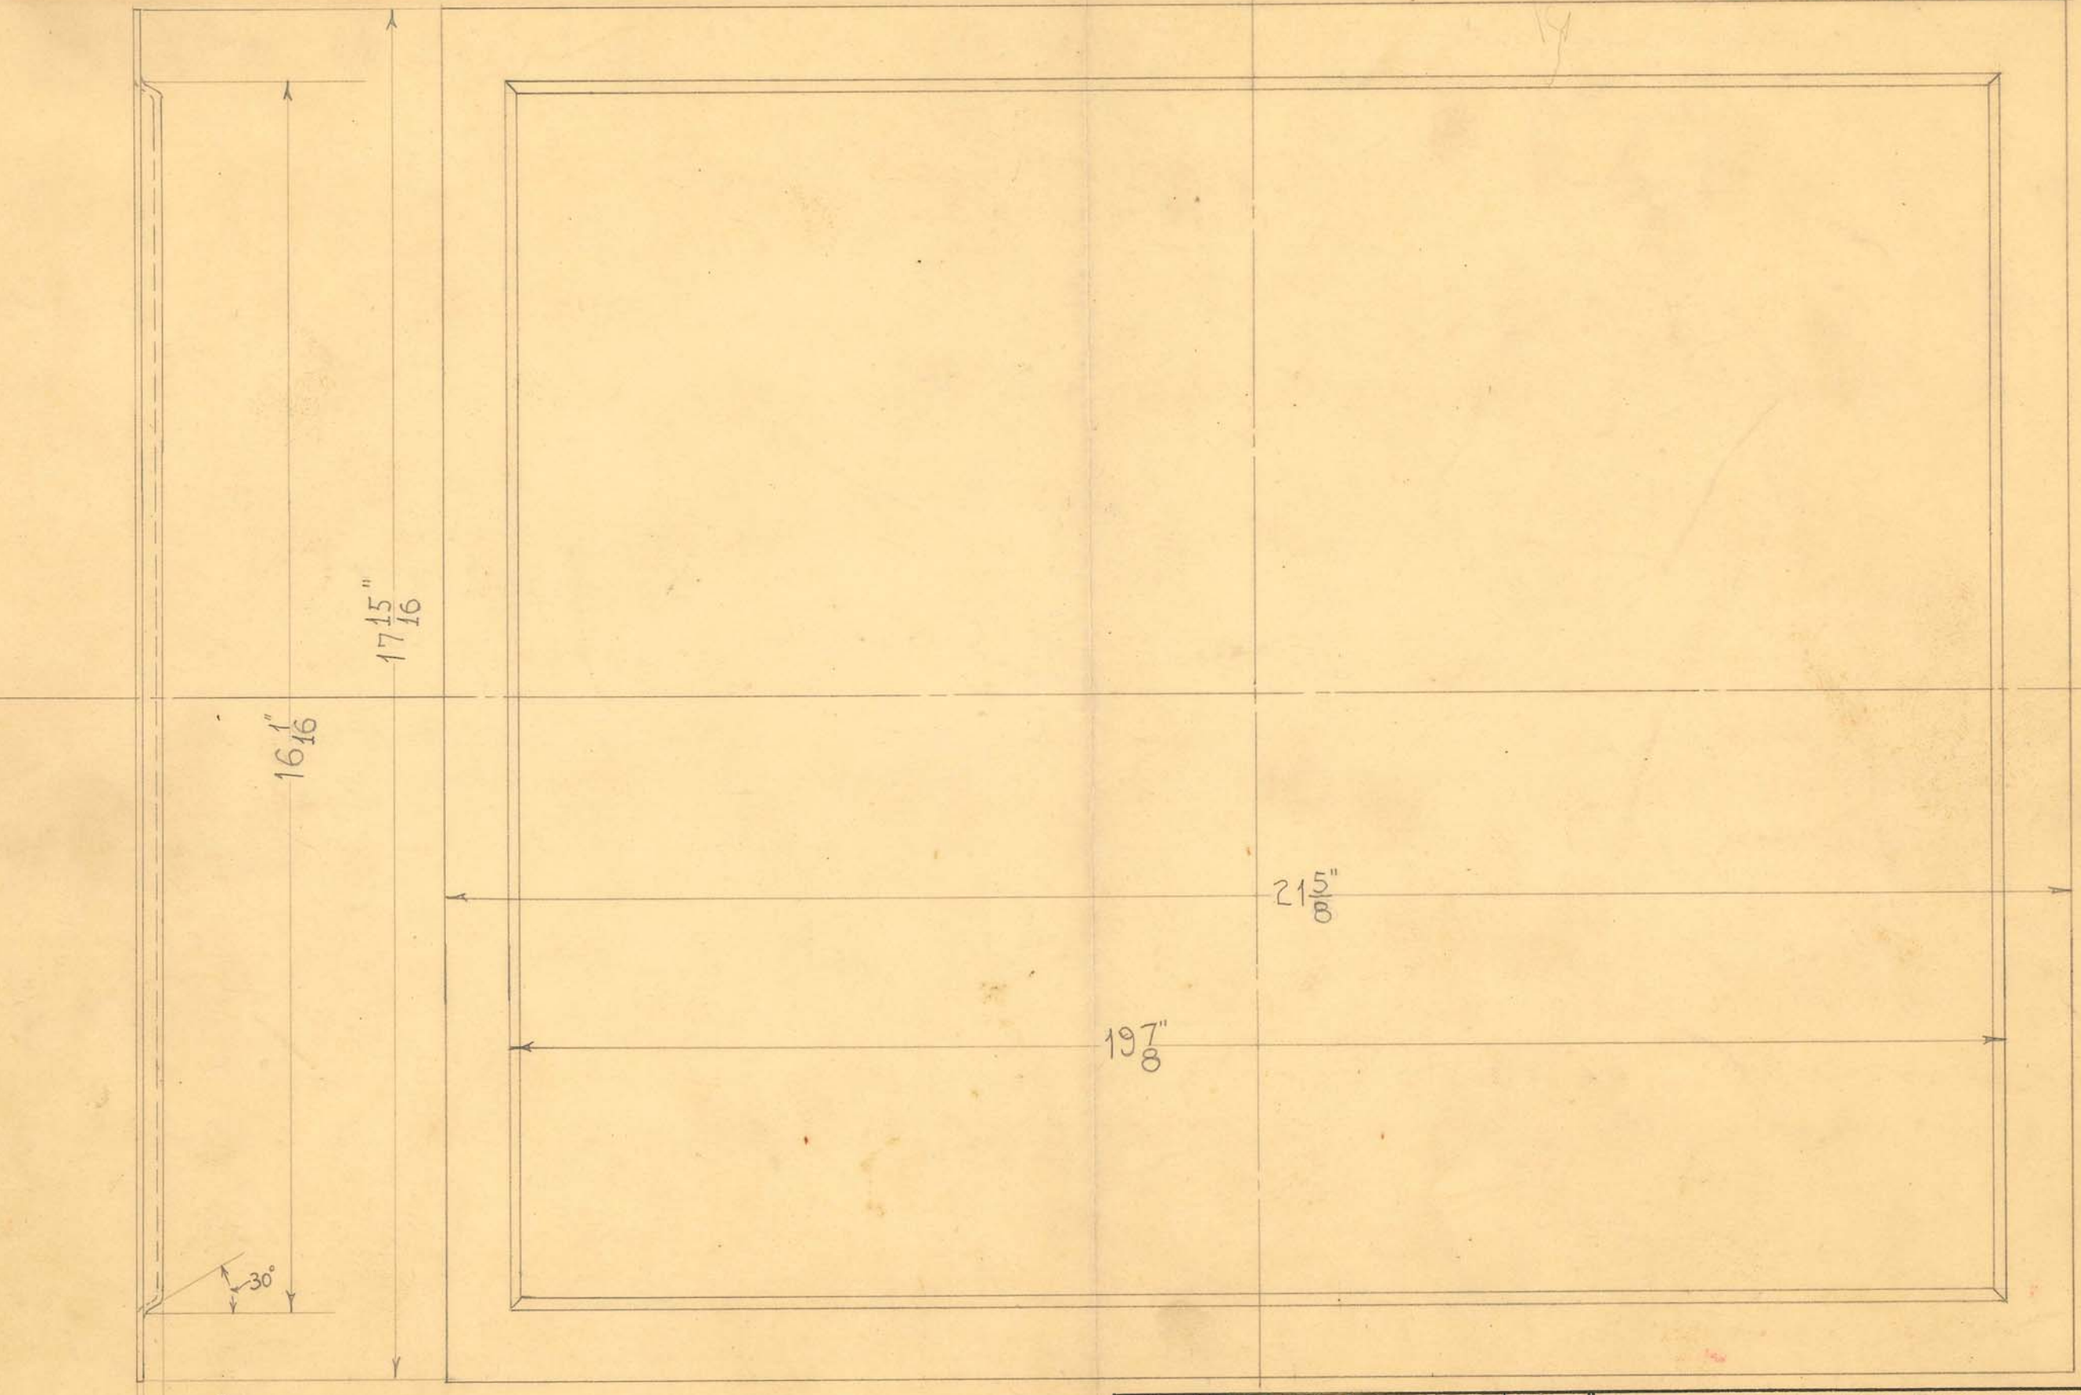

SIZE	.040"	ISSUE 4-15-41	664
KIND	SHEET LEAD	CHANGED	
SHAPE		"	
FINISH		"	
TEMP.		"	
PATT.		"	

TITLE: U.S. NAVY X-RAY UNIT-
CABINET DOOR - LEAD PAN-

OBSOLETE

H. G. FISCHER & CO.
2338 WABANSIA AVE.
CHICAGO. ILL.

CAT. NO.

PART NO. 14027F

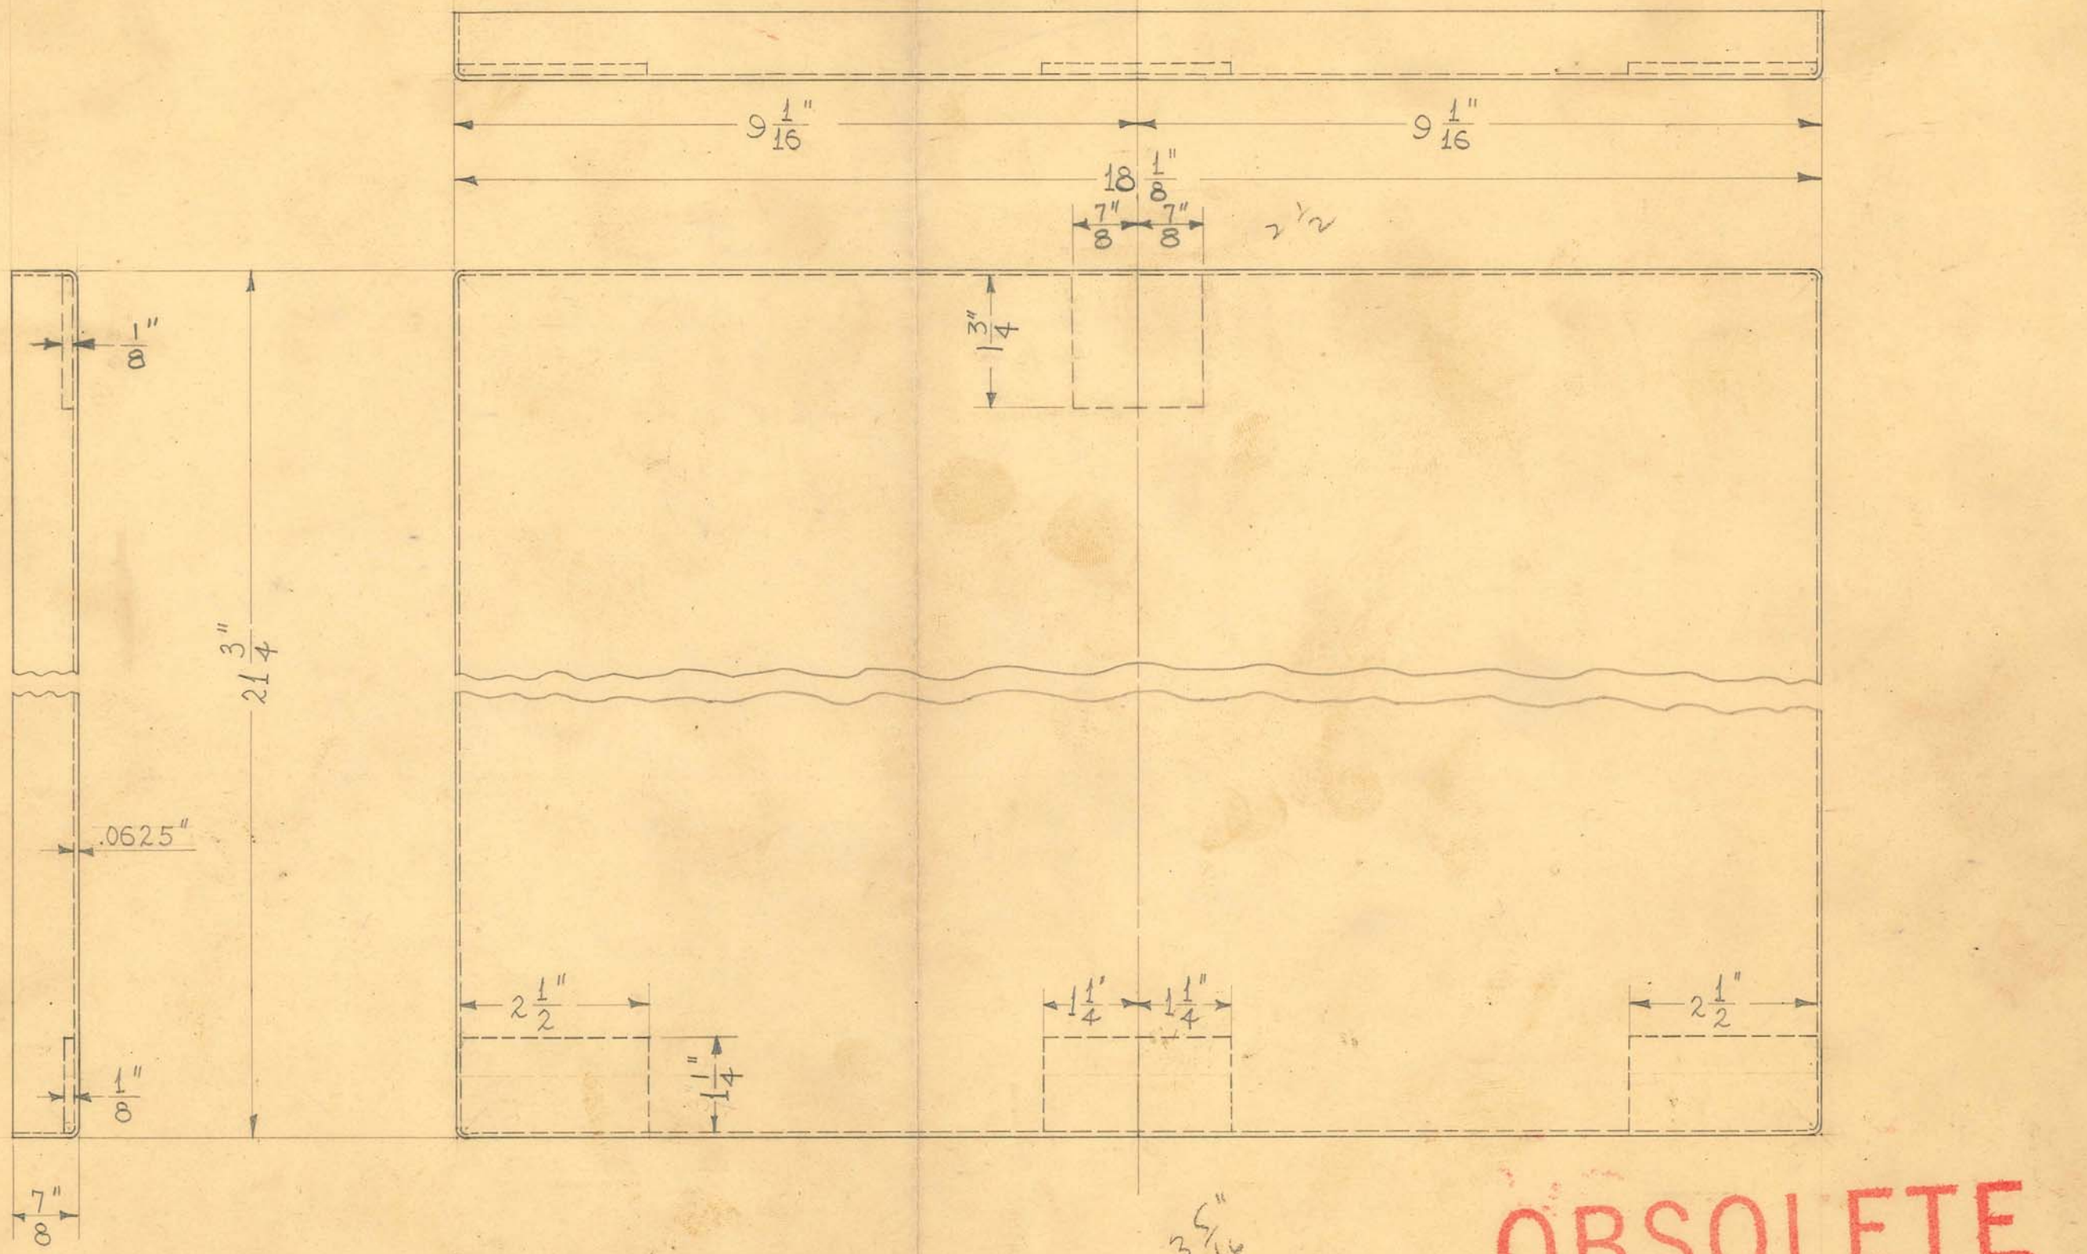

SCALE ~ 1/2" = 1"

1 REQUIRED

OBSOLETE

SIZE	.0625" SHEET	ISSUE 5-28-41	HE.
KIND	C.R. STEEL	CHANGED	
SHAPE		" 7-20-45	HE.
FINISH		"	
TEMP.		"	
PATT.		"	

TITLE: U.S. NAVY X-RAY UNIT - CABINET - DOOR

H. G. FISCHER & CO.
2335 WABANSIA AVE.
CHICAGO, ILL.

CAT. NO.

PART NO. 14028A

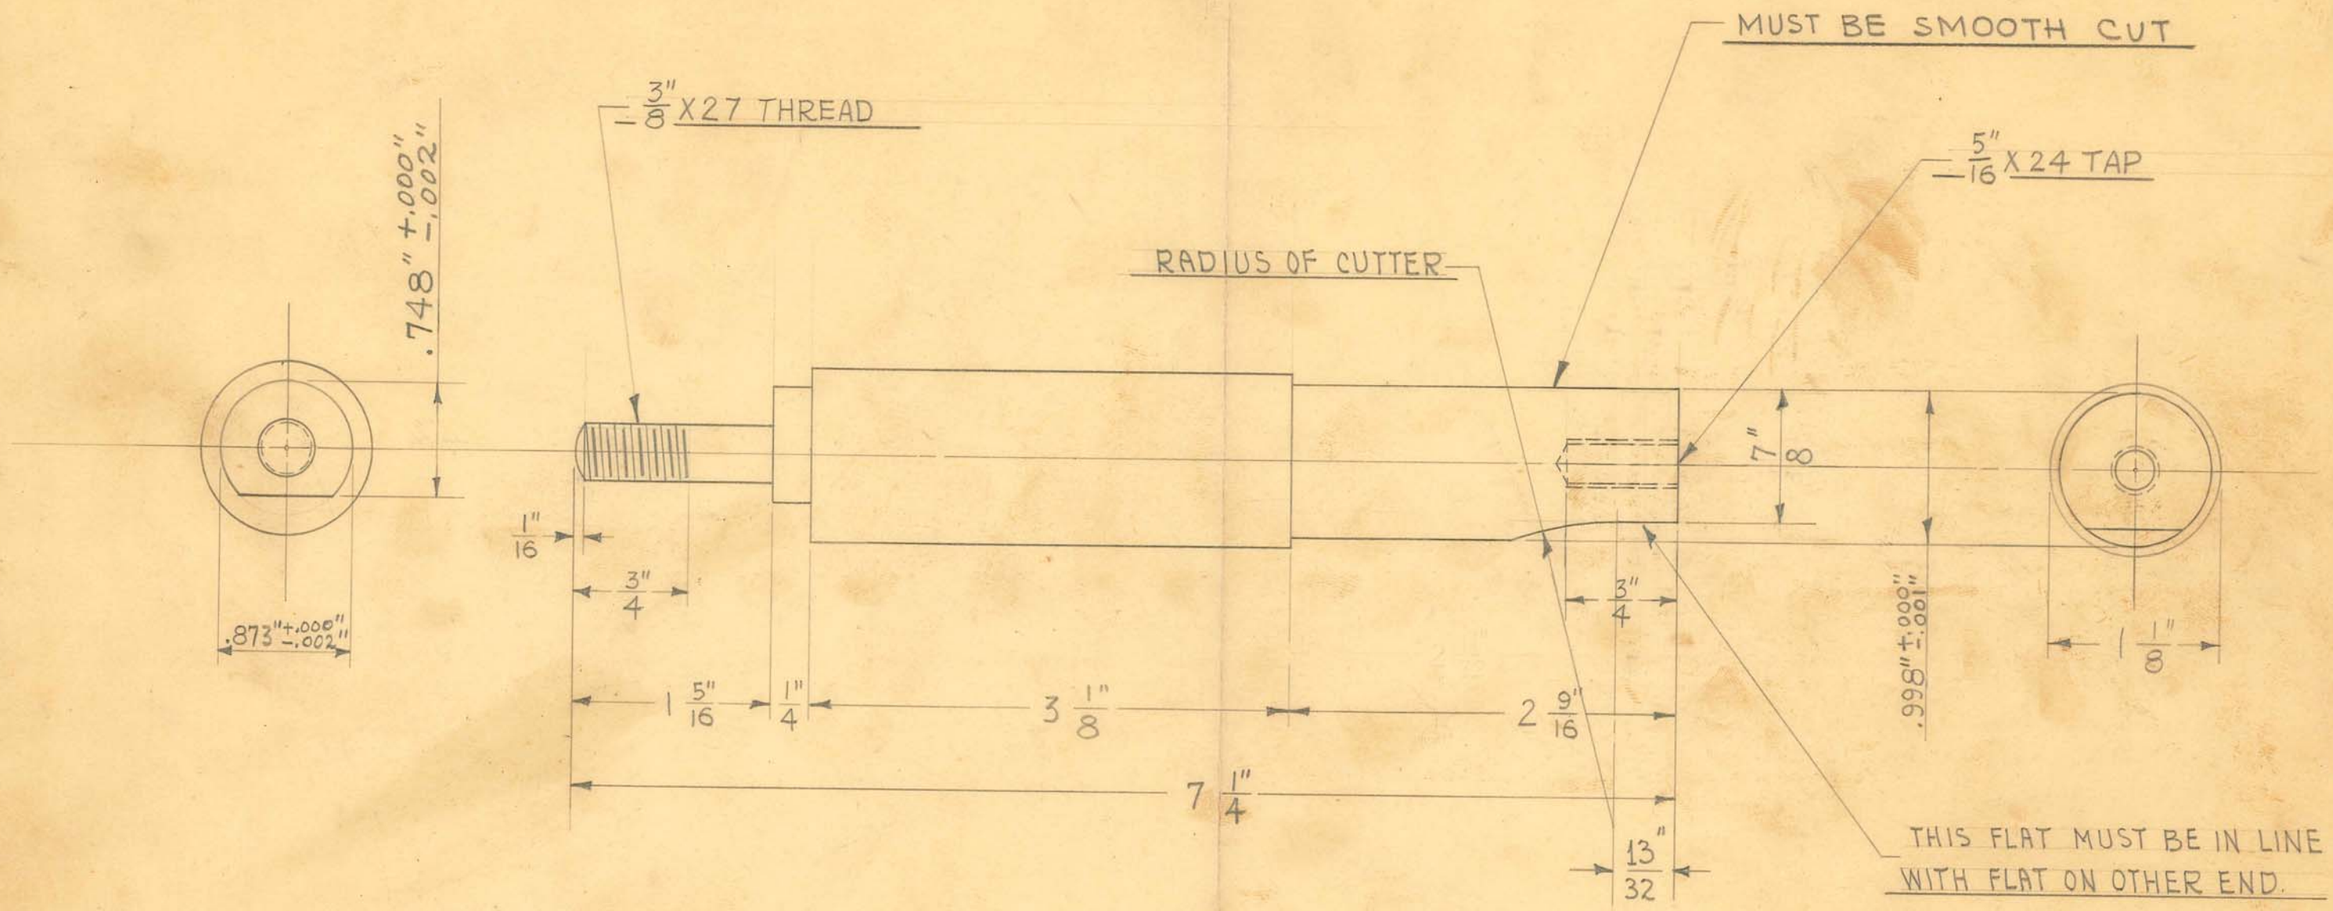

1 REQUIRED

OBSOLETE

RS.

SIZE	1⅛" DIA.	ISSUE 4-24-41	J.V.W.
KIND	JEWELERS	CHANGED	
SHAPE	ROD	" 5-23-51	J.V.W.
FINISH		"	
TEMP.		"	
PATT.		"	

TITLE: U.S. NAVY X-RAY UNIT
TRANSF. GUIDE RODS SWIVEL SUPP. STUD.

H. G. FISCHER & CO.
2333 WABANSIA AVE.
CHICAGO, ILL.

CAT. NO.

PART NO. 14039

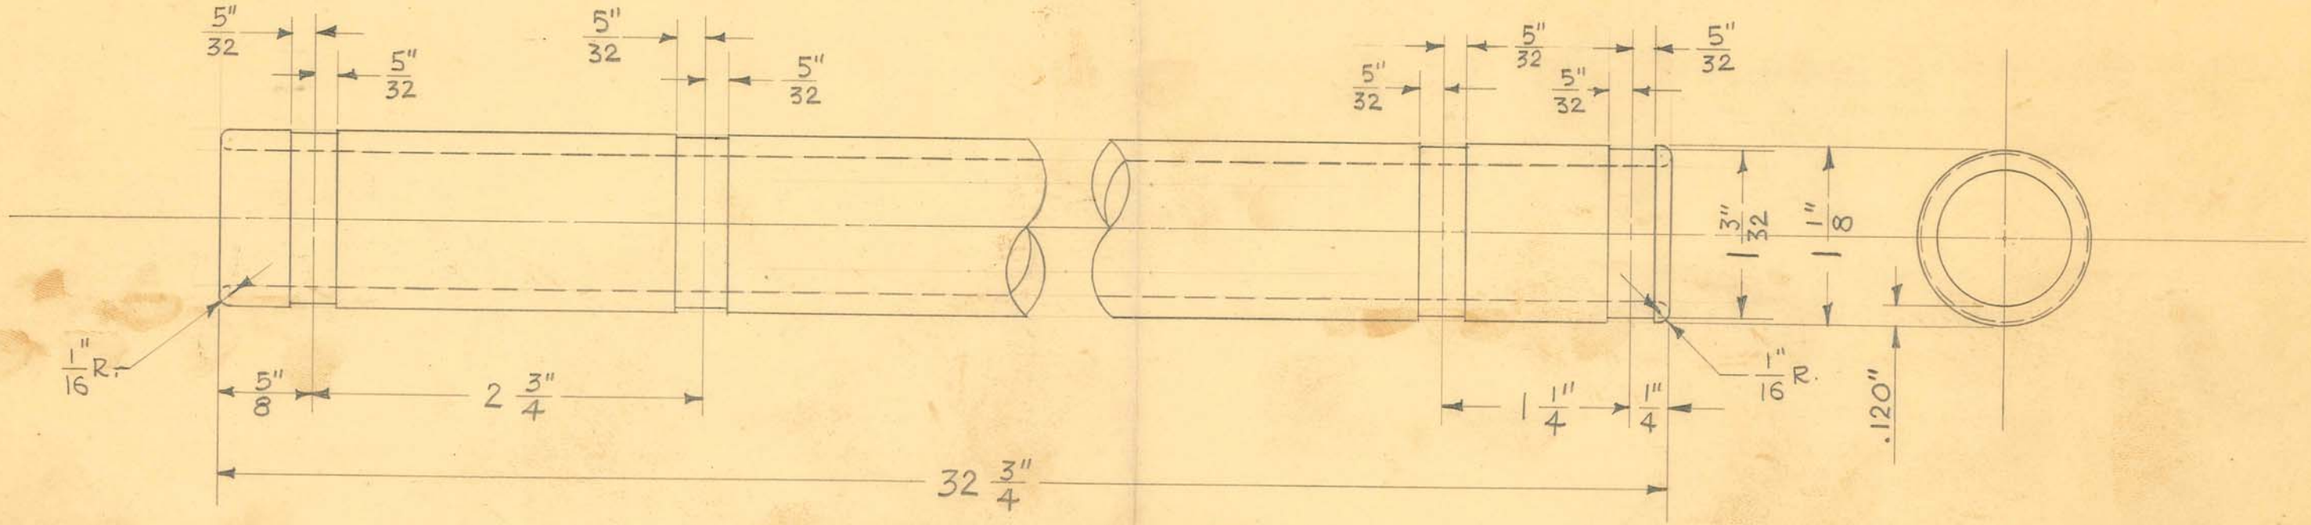

1 1/8 O.D. X #11 GA. (.120") SHELBY SEAMLESS STEEL TUBING

2 REQUIRED

OBSOLETE

SIZE	1 1/8 O.D.	ISSUE 4-30-41	J.Y.W.	TITLE: U.S. NAVY X-RAY UNIT TRANSFORMER GUIDE ROD
KIND		CHANGED		
SHAPE		"		
FINISH	SATIN CHR. #4	"		
TEMP.		"		
PATT.		"		

H. G. FISCHER & CO.
2335 WABANSIA AVE.
CHICAGO, ILL.

CAT. NO.

PART NO. 14042

FOLDER #110

FINISH:
LETTERS-NUMBERS-GRADUATIONS
AND BORDER-PLAIN ALUMINUM ANODIZED.
BACKGROUND-BLACK ANODIZED

OBSOLETE

3 ELONGATED HOLES $\frac{7}{64}$" X $\frac{9}{32}$"
CRONAME DIE # 11070

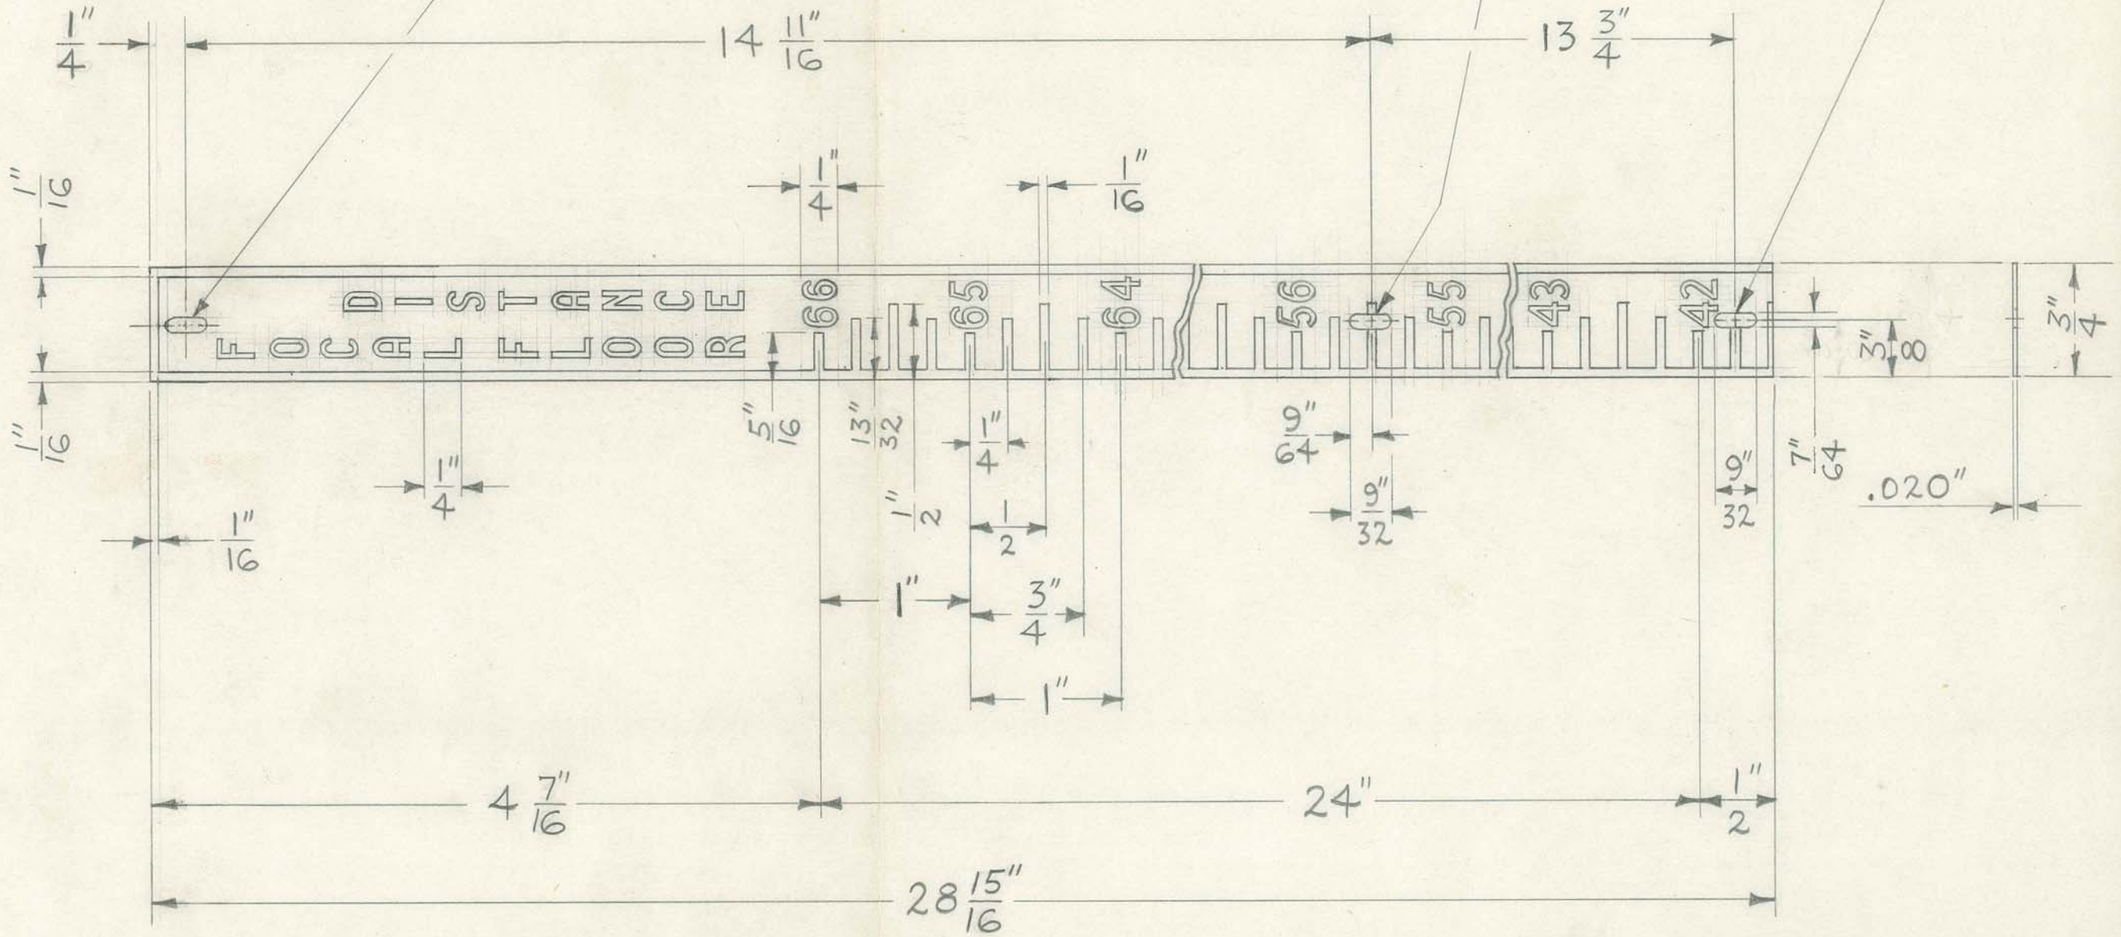

1 REQUIRED

TITLE FISCHER MOBILE BEDSIDE UNIT
VERTICAL SCALE-UPPER

PART NO. 14047A

H. G. FISCHER & CO.
FRANKLIN PARK, ILLINOIS

DATE 6-4-51 DR. BY J.W.W. CH'K'D.

SCALE FULL

FINISH SEE NOTE

MATERIAL .020" SHEET ALUMINUM

PATTERN

TOOLS

DIMENSIONS
FRACTIONAL ±.015
DECIMAL ±.005
ANGULAR ±½°
UNLESS OTHERWISE SPECIFIED

REVISION | DATE | BY

TITLE: FISCHER MOBILE BEDSIDE UNIT
VERTICAL SCALE - LOWER

PATTERN | FINISH: SEE NOTE | SCALE: FULL
TOOLS | MATERIAL: .020" SHEET ALUMINUM

H. G. FISCHER & CO.
FRANKLIN PARK, ILLINOIS

DATE 6-5-51 | DR. BY J.W.W. | CH'K'D.

DIMENSIONS
FRACTIONAL ± .015
DECIMAL ± .003
ANGULAR ± ½°
UNLESS OTHERWISE SPECIFIED

PART NO. 14048A

REVISION	DATE	BY

1 REQUIRED

3 ELONGATED HOLES 7/64" X 9/32"
CRONAME DIE #11070

OBSOLETE

FINISH:
LETTERS - NUMBERS - GRADUATIONS
AND BORDER - PLAIN ALUMINUM ANODIZED.
BACKGROUND - BLACK ANODIZED

FOLDER #110

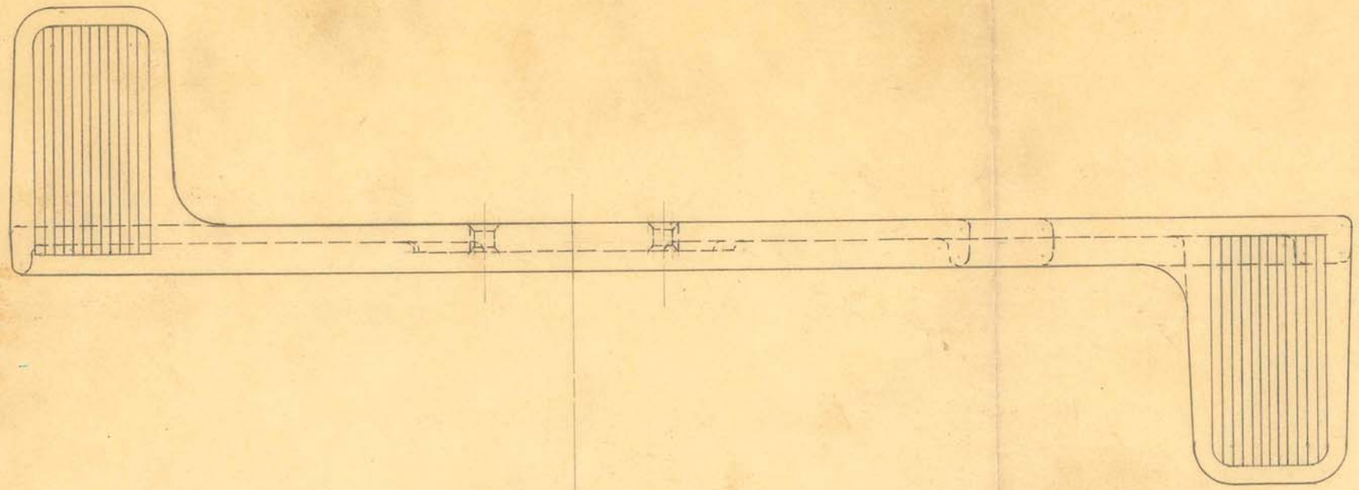

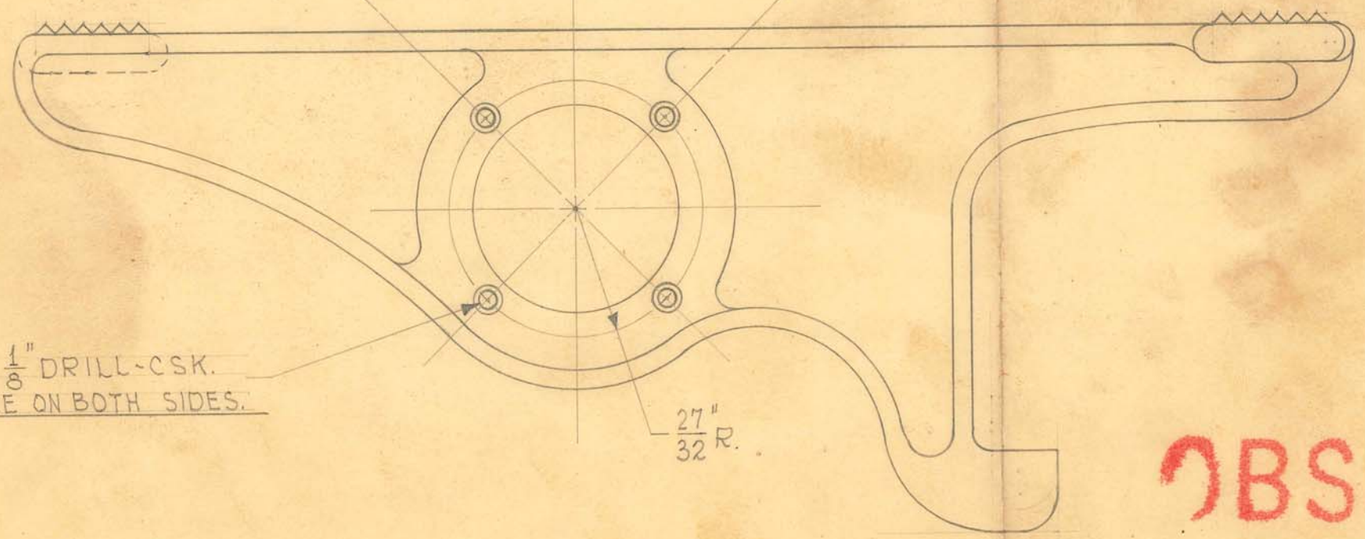

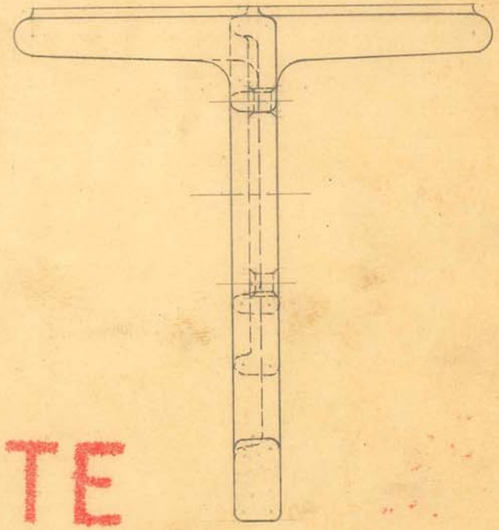

OBSOLETE

RIGHT LEVER SHOWN

RIGHT ~ PATT. # 1783
LEFT ~ PATT. # 1784

SIZE	#80-10-10	ISSUE 6-27-41	HE.
KIND	BRONZE CASTING	CHANGED	
SHAPE		"	
FINISH		"	
TEMP.		"	
PATT.		"	

TITLE: U.S. NAVY X-RAY UNIT ~ WHEEL LOCK LEVER - RIGHT & LEFT

H. G. FISCHER & CO.
2335 WABANSIA AVE.
CHICAGO, ILL.

CAT. NO.

PART NO. 14053E-RIGHT
14054F-LEFT

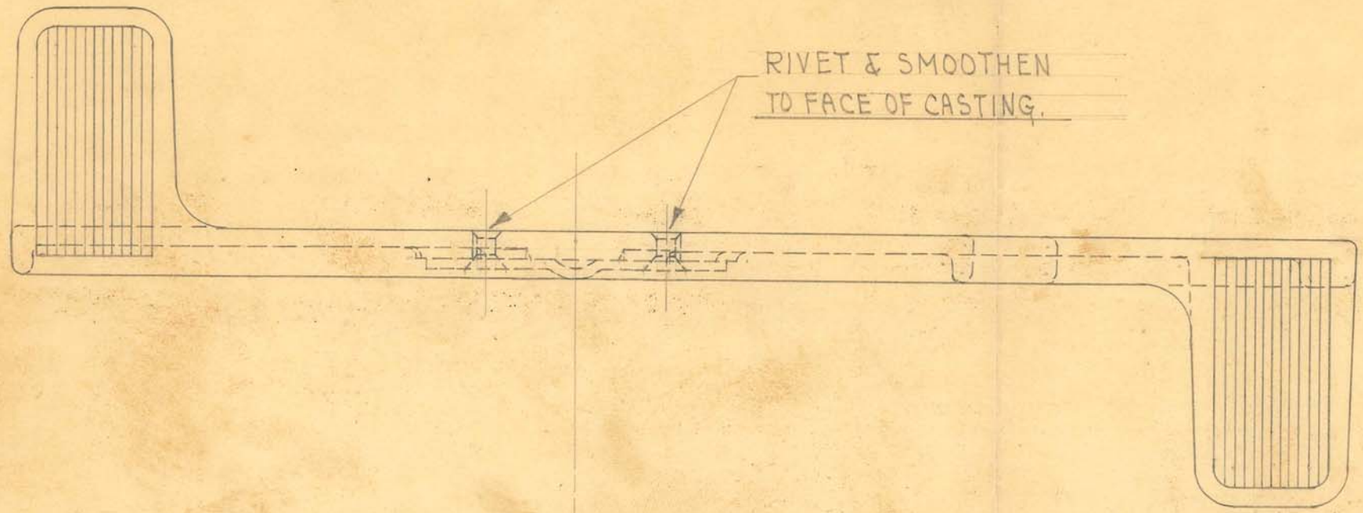

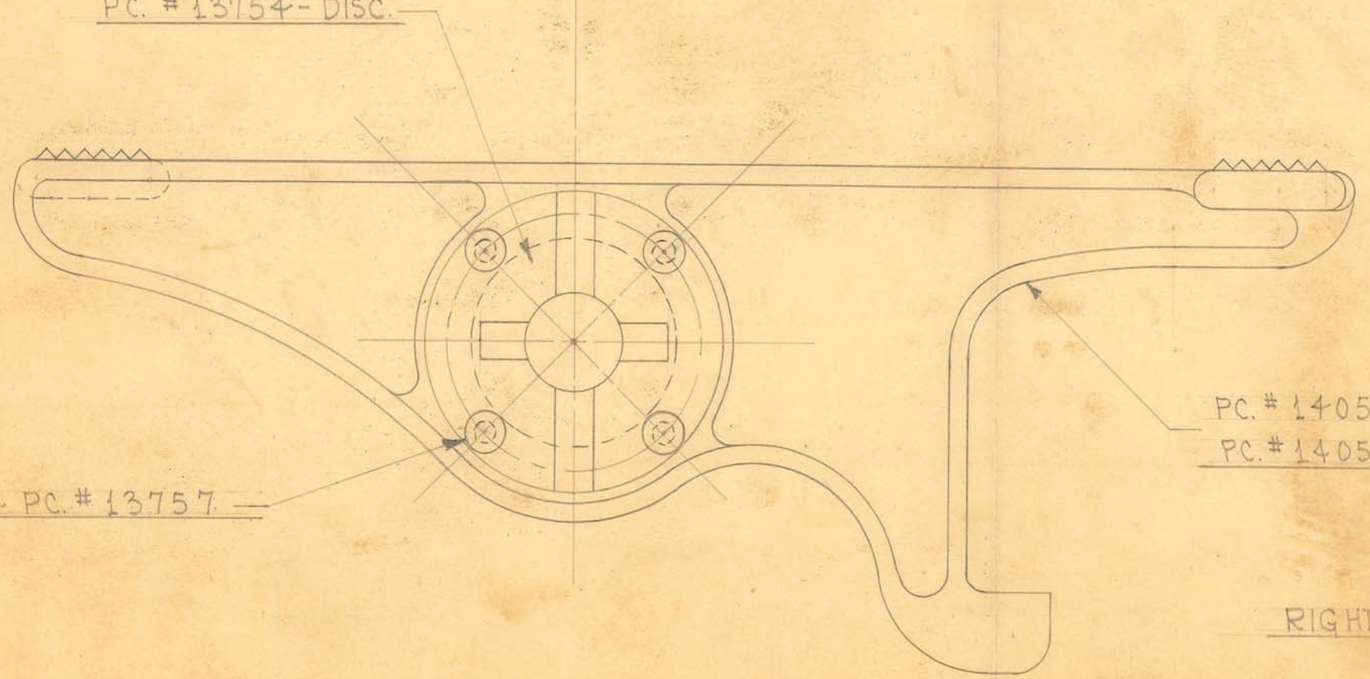

RIGHT LEVER SHOWN

1 OF EACH REQUIRED

OBSOLETE

SIZE		ISSUE 7-1-41	HE.
KIND		CHANGED	
SHAPE		"	
FINISH	WH. CHR. #3	"	
TEMP.		"	
PATT.		"	

TITLE:
U.S. NAVY X-RAY UNIT -
WHEEL LOCK LEVER - RIGHT & LEFT

H. G. FISCHER & CO.
2338 WABANSIA AVE.
CHICAGO, ILL.

CAT. NO.

PART NO. 14055G - RIGHT
14056G - LEFT

CLAMP CASTING IN LATHE
SET LEAD CONE INTO CASTING,
WITH ROUNDED TOOL - WORK
LEAD INTO ANGLE OF CASTING

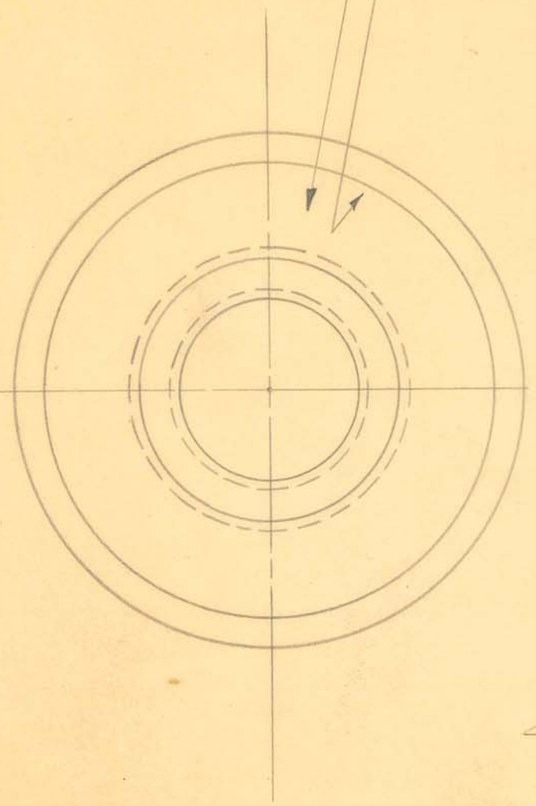

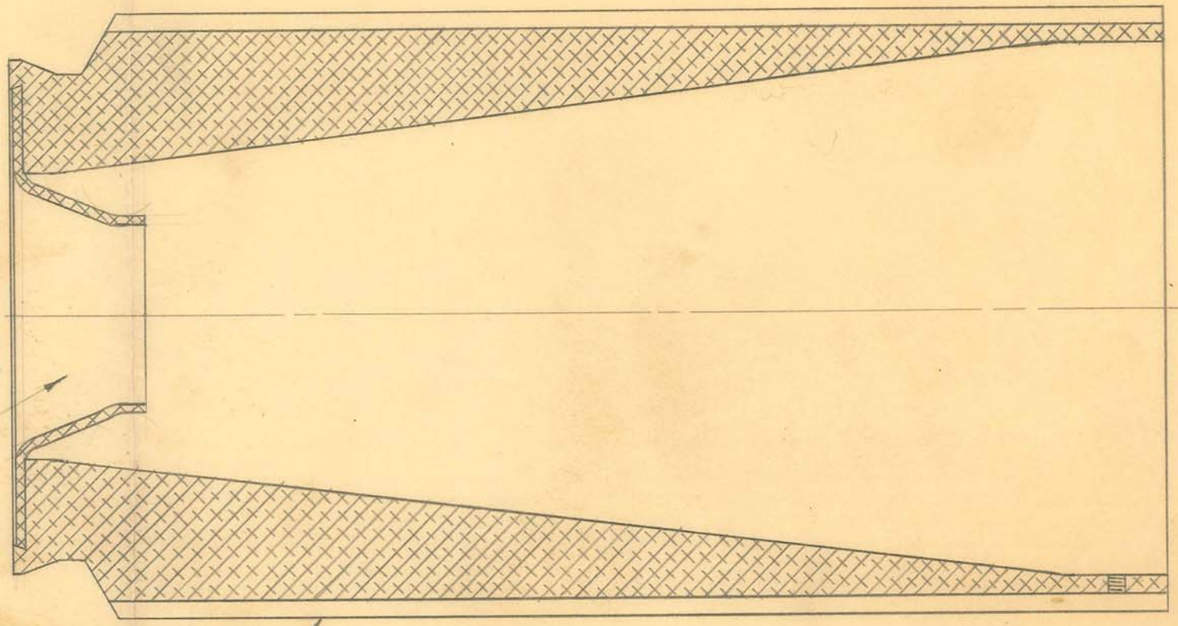

CONE PCE.# 14061F

PCE.# 14002F

OBSOLETE

SIZE		ISSUE 3-28-41	J.V.W.	TITLE: U.S. NAVY X-RAY UNIT RADIOGRAPHIC CONE ASSEMBLY
KIND		CHANGED		
SHAPE		"		
FINISH		"		
TEMP.		"		
PATT.		"		

H. G. FISCHER & CO.
2335 WABANSIA AVE.
CHICAGO, ILL.

CAT. NO.

PART NO. 14060G

PCE #14003F

#23 DRILL - DRIVE FIT FOR $\frac{5}{32}$" C.R. STEEL PIN. FILE TO CONTOUR OF CASTING

ROUND EDGE - BOTH ENDS

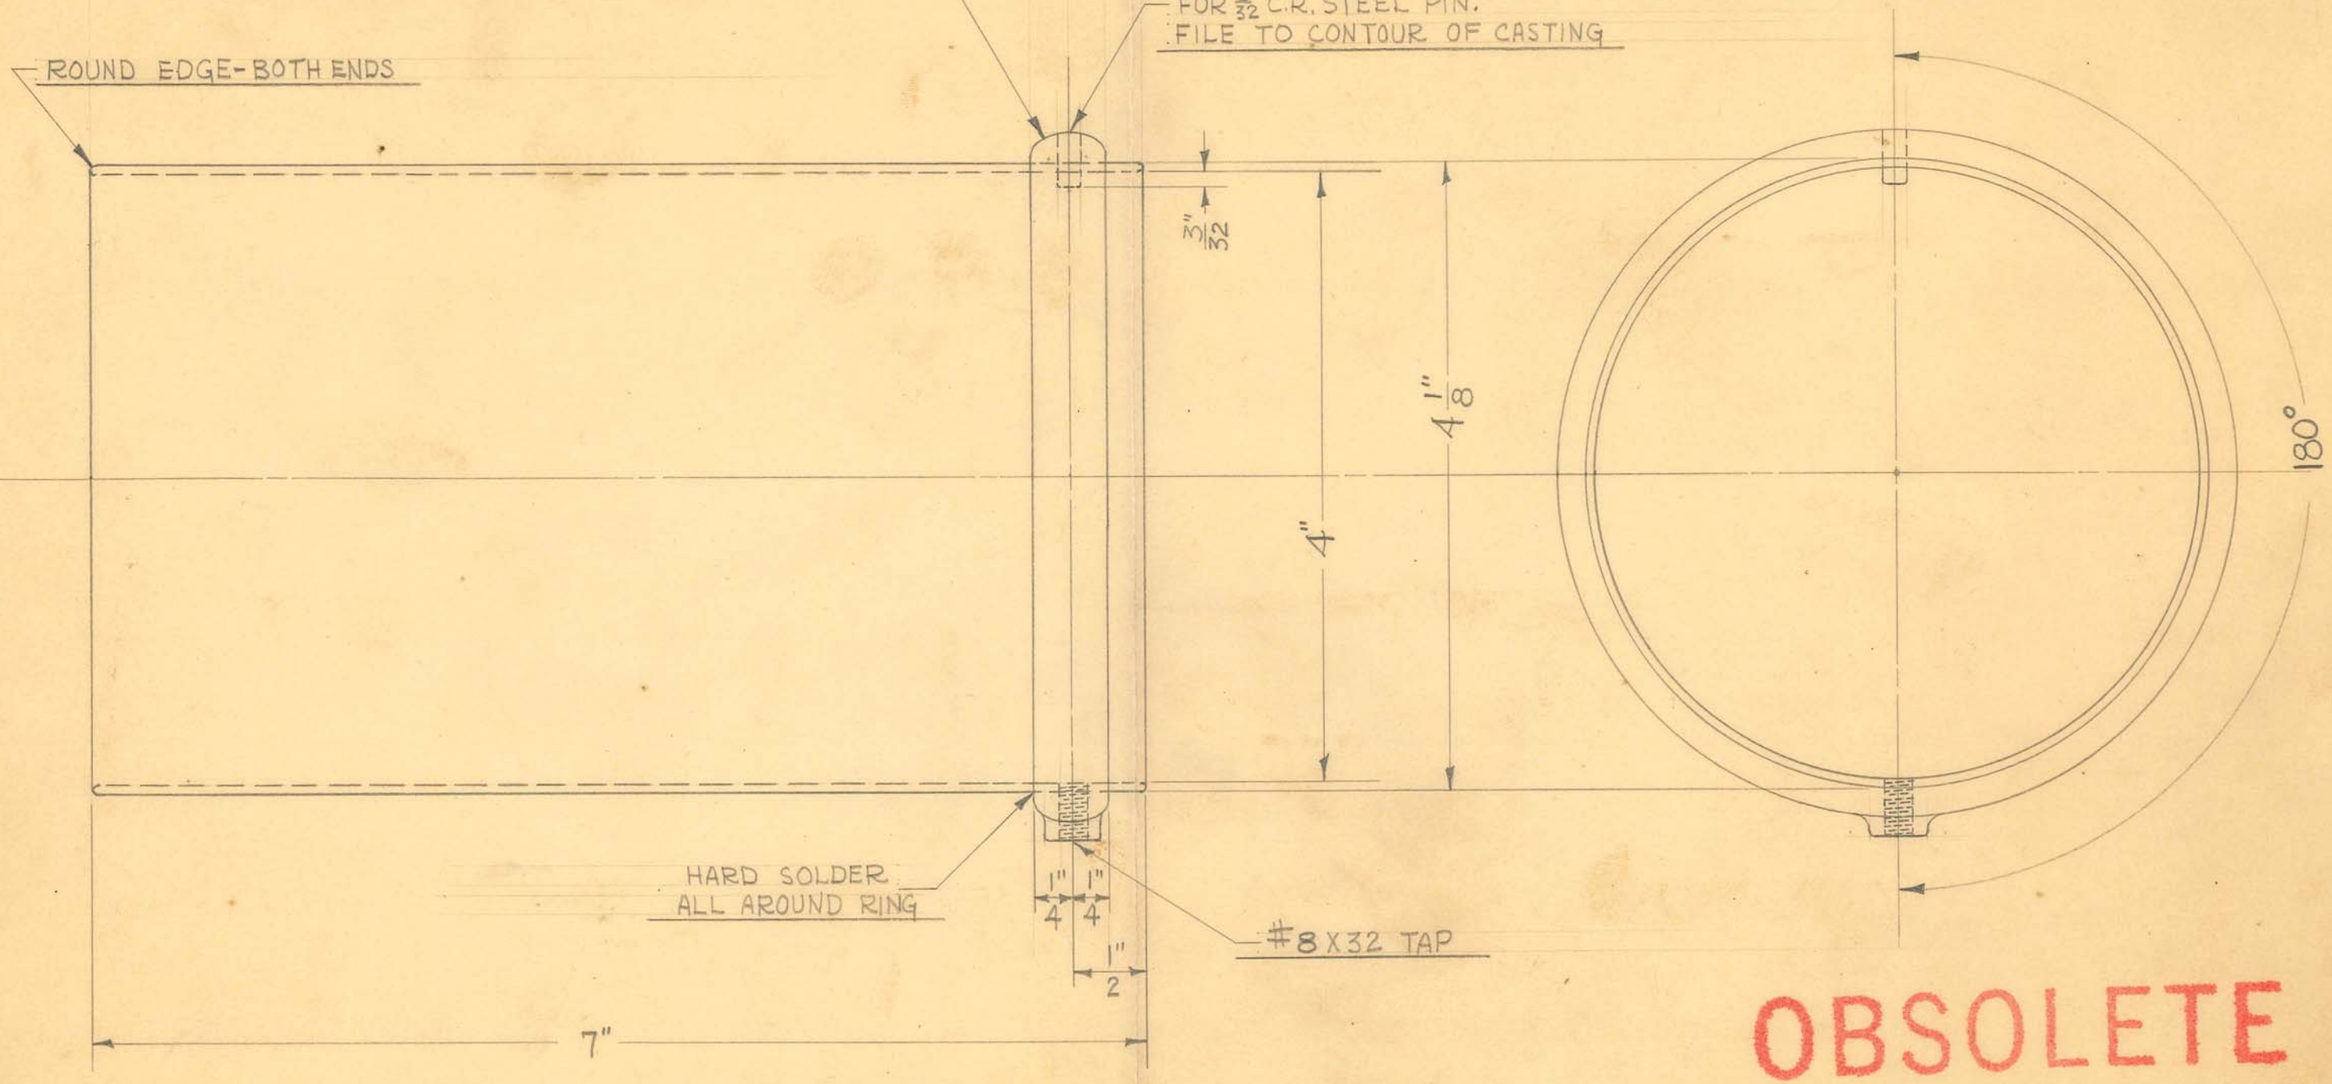

OBSOLETE

1 REQUIRED

ACID DIP #7 BEFORE PAINTING
DO NOT PAINT INSIDE OF CYLINDER

SIZE		ISSUE 3-27-41	J.Y.W.
KIND		CHANGED	
SHAPE		"	
FINISH	PAINTED	"	
TEMP.		"	
PATT.		"	

TITLE: U. S. NAVY X-RAY UNIT
RADIOGRAPHIC CONE ADJUSTABLE TUBE ASSEM.

H. G. FISCHER & CO.
2335 WABANSIA AVE.
CHICAGO, ILL.

CAT. NO.

PART NO. 14062G

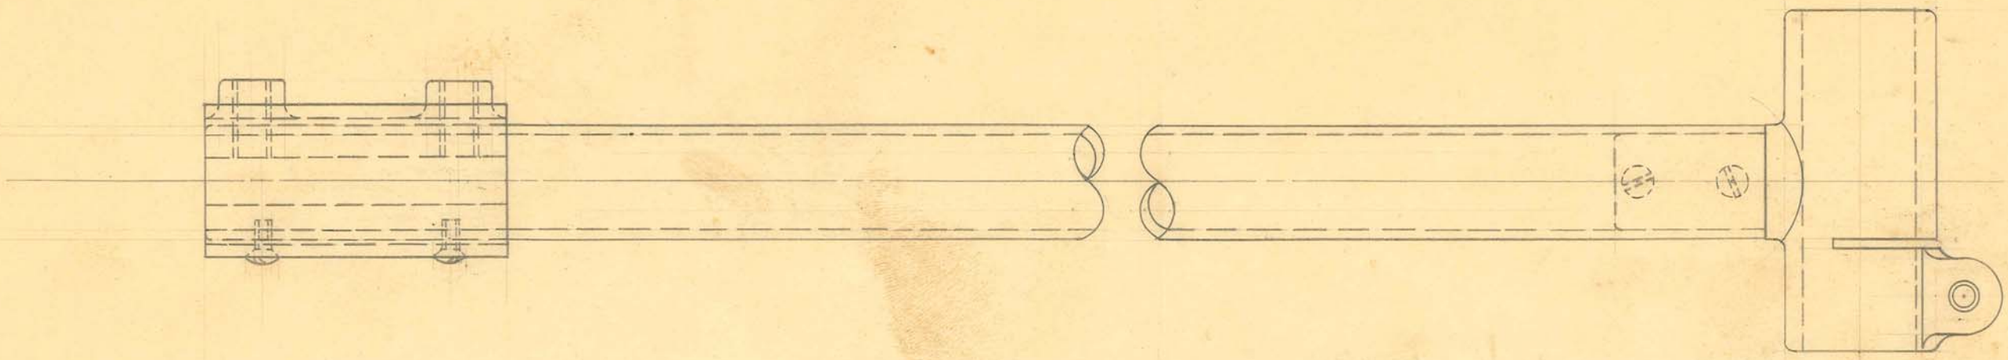

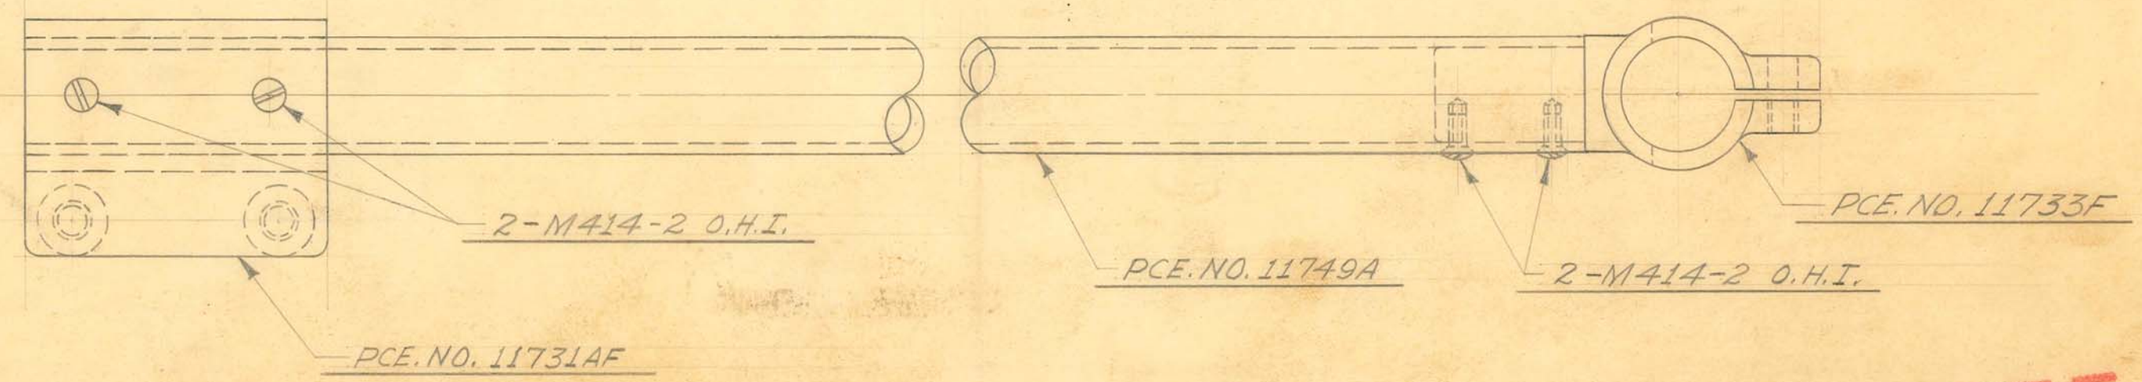

OBSOLETE

SIZE		ISSUE 7-26-40	J.V.W.	**TITLE:** FISCHER ORTHODIAGRAPHIC ATTACHMENT TRACING ARM ASSEMBLY
KIND		CHANGED		
SHAPE		"		
FINISH		"		
TEMP.		"		
PATT.		"		

H. G. FISCHER & CO.
2335 WABANSIA AVE.
CHICAGO. ILL.

CAT. NO.

PART NO. USED IN 11740GA

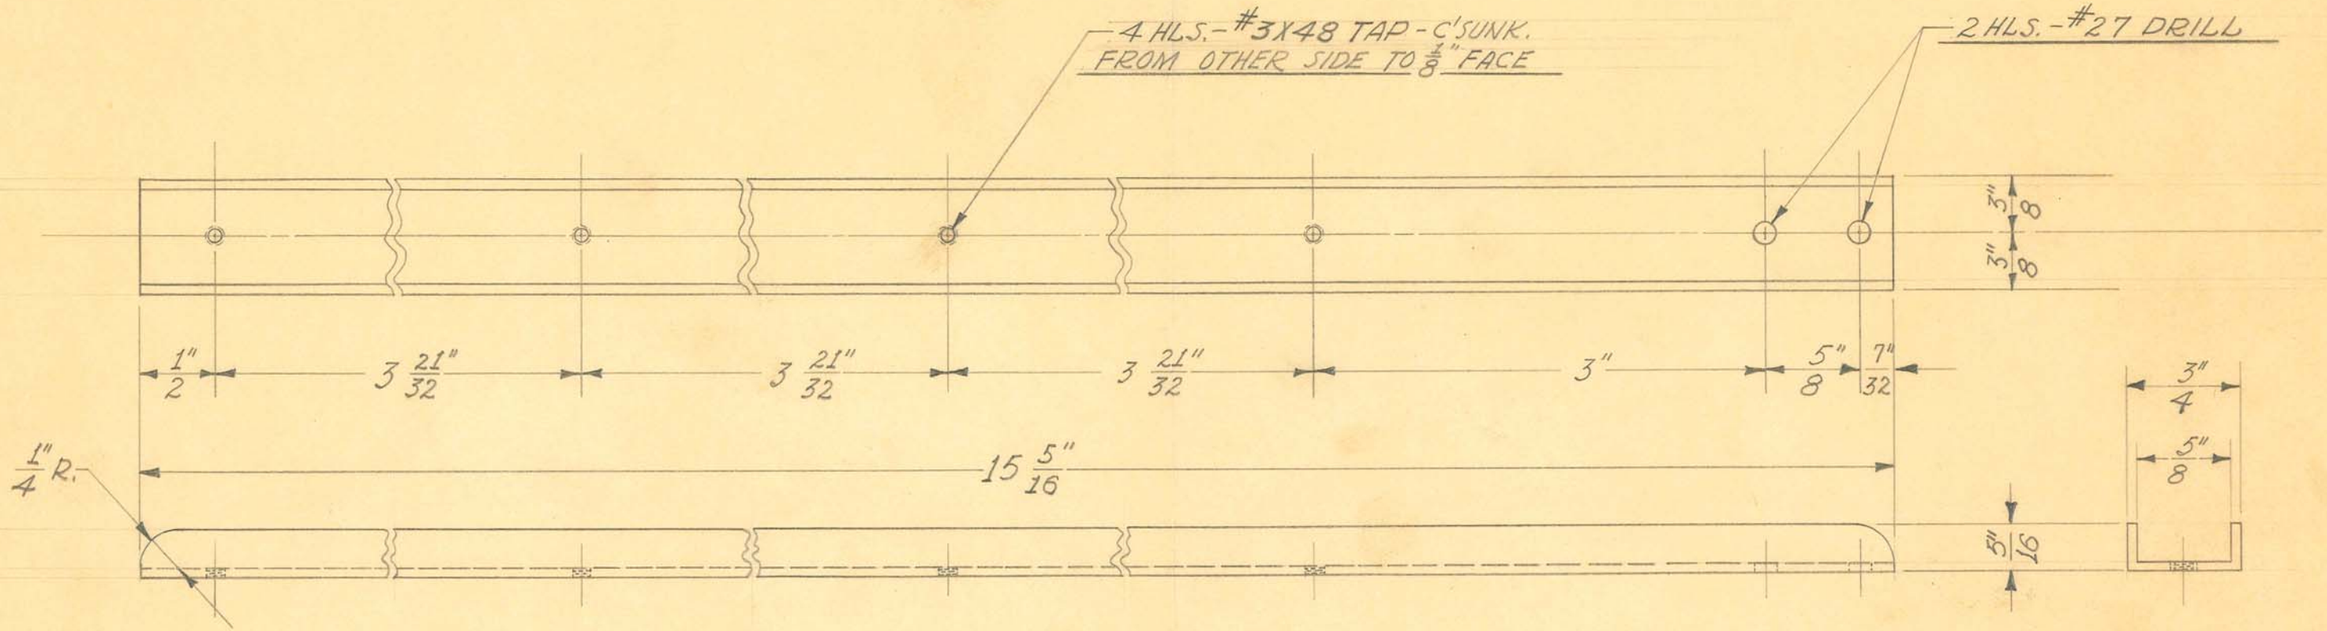

2 REQUIRED

OBSOLETE

SIZE	3/4" O.D. X 5/8" I.D.	ISSUE 11-16-38	J.W.	TITLE: FISCHER ORTHODIAGRAPHIC ATTACHMENT TRACING BOARD SUPPORT CHANNEL
KIND	ALUMINUM TUBING	CHANGED		
SHAPE	SQUARE	"		
FINISH		"		
TEMP.		"		
PATT.		"		

H. G. FISCHER & CO.
2335 WABANSIA AVE.
CHICAGO, ILL.

CAT. NO.

PART NO. 11756

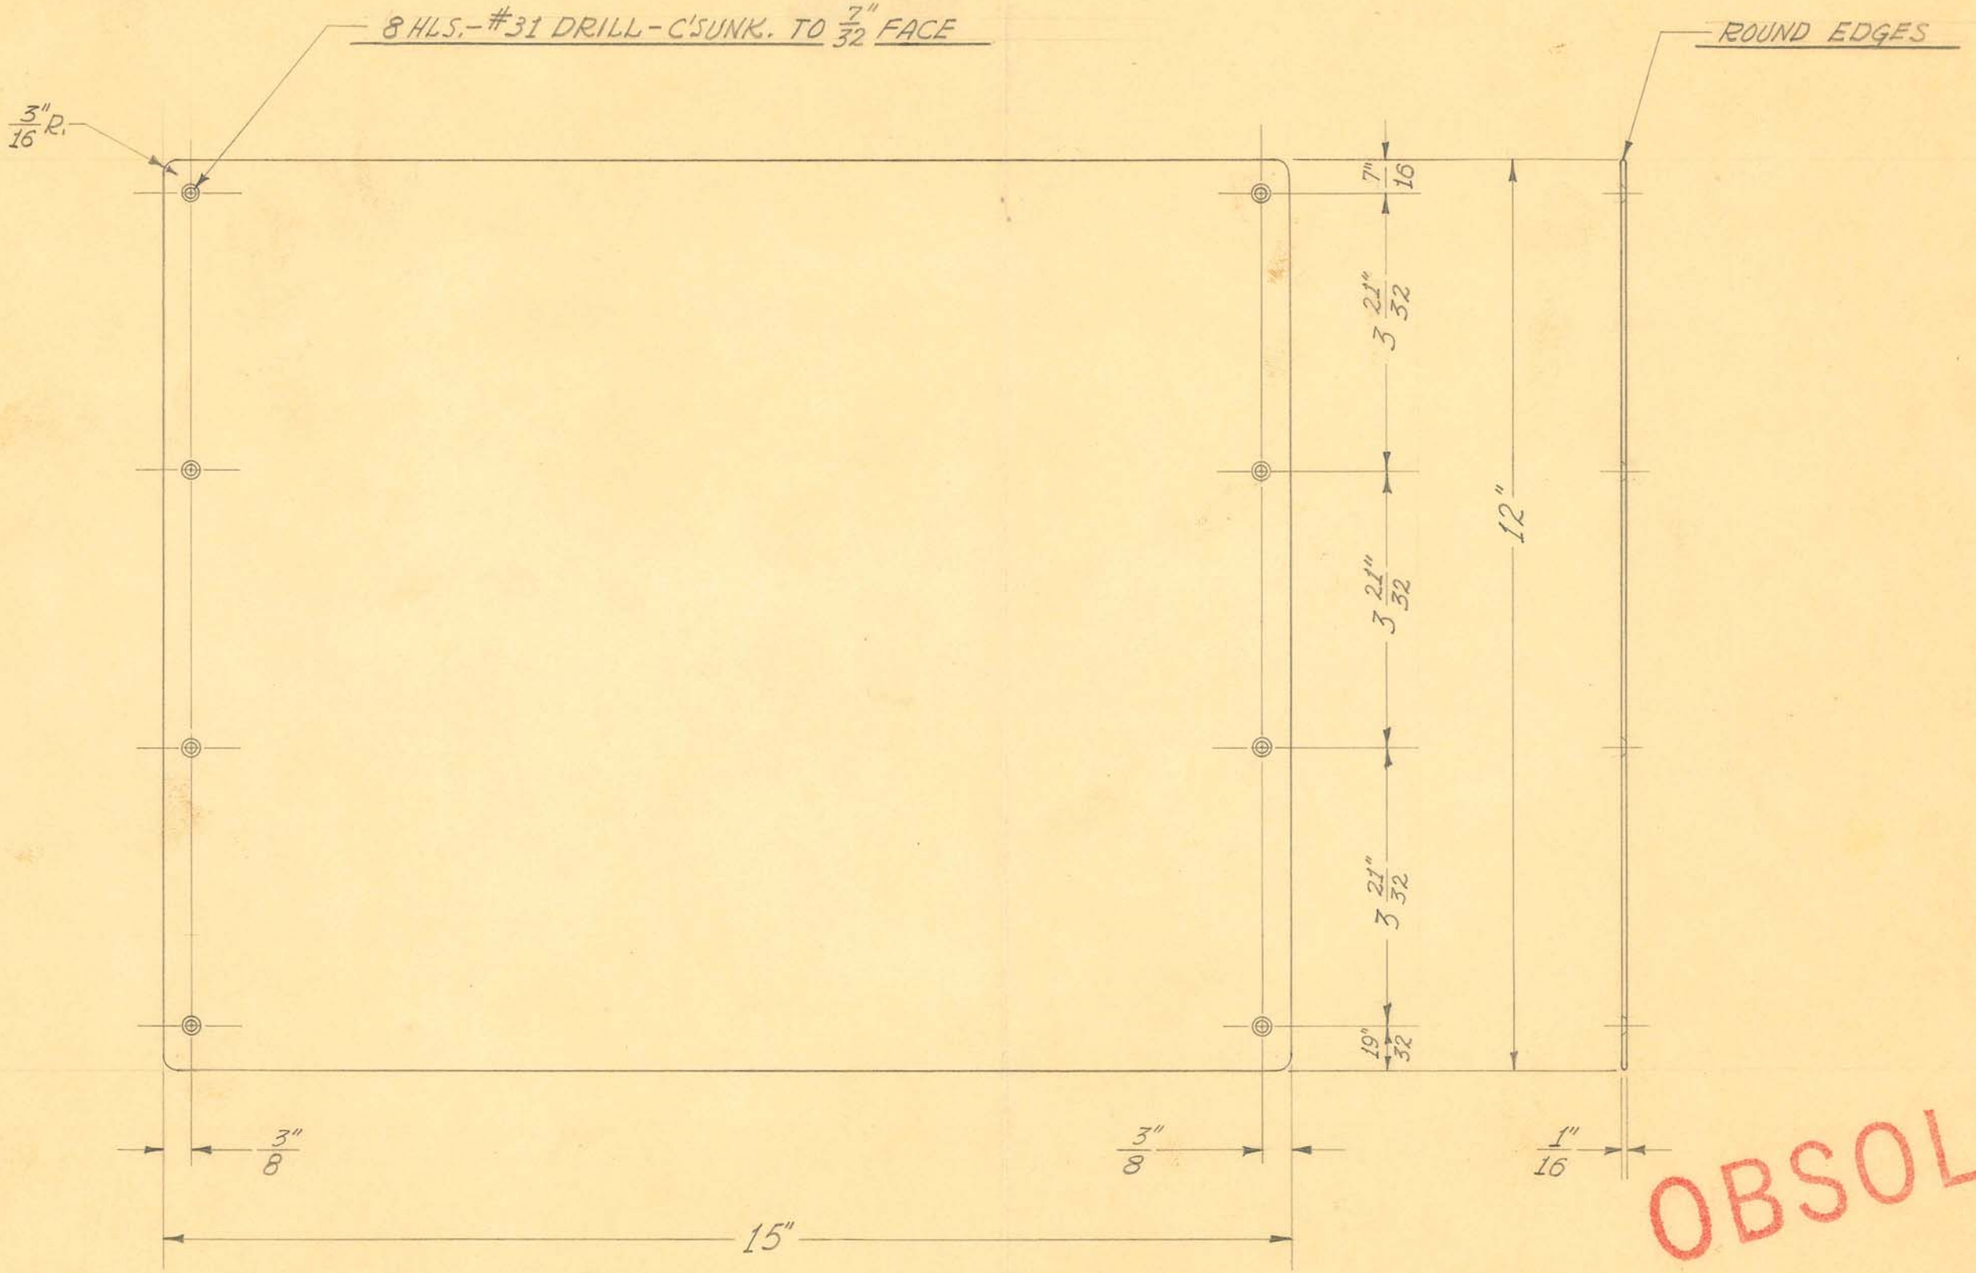

OBSOLETE

SCALE ÷ 1/2" = 1"

1 REQUIRED

SIZE	1/16" SHEET	ISSUE 11-16-38	J.W.
KIND	ALUMINUM	CHANGED	
SHAPE		"	
FINISH	POL. & BUFF	"	
TEMP.		"	
PATT.		"	

TITLE:
FISCHER ORTHODIAGRAPHIC ATTACHMENT
TRACING BOARD PANEL

H. G. FISCHER & CO.
2338 WABANSIA AVE.
CHICAGO, ILL.

CAT. NO.

PART NO. 11757

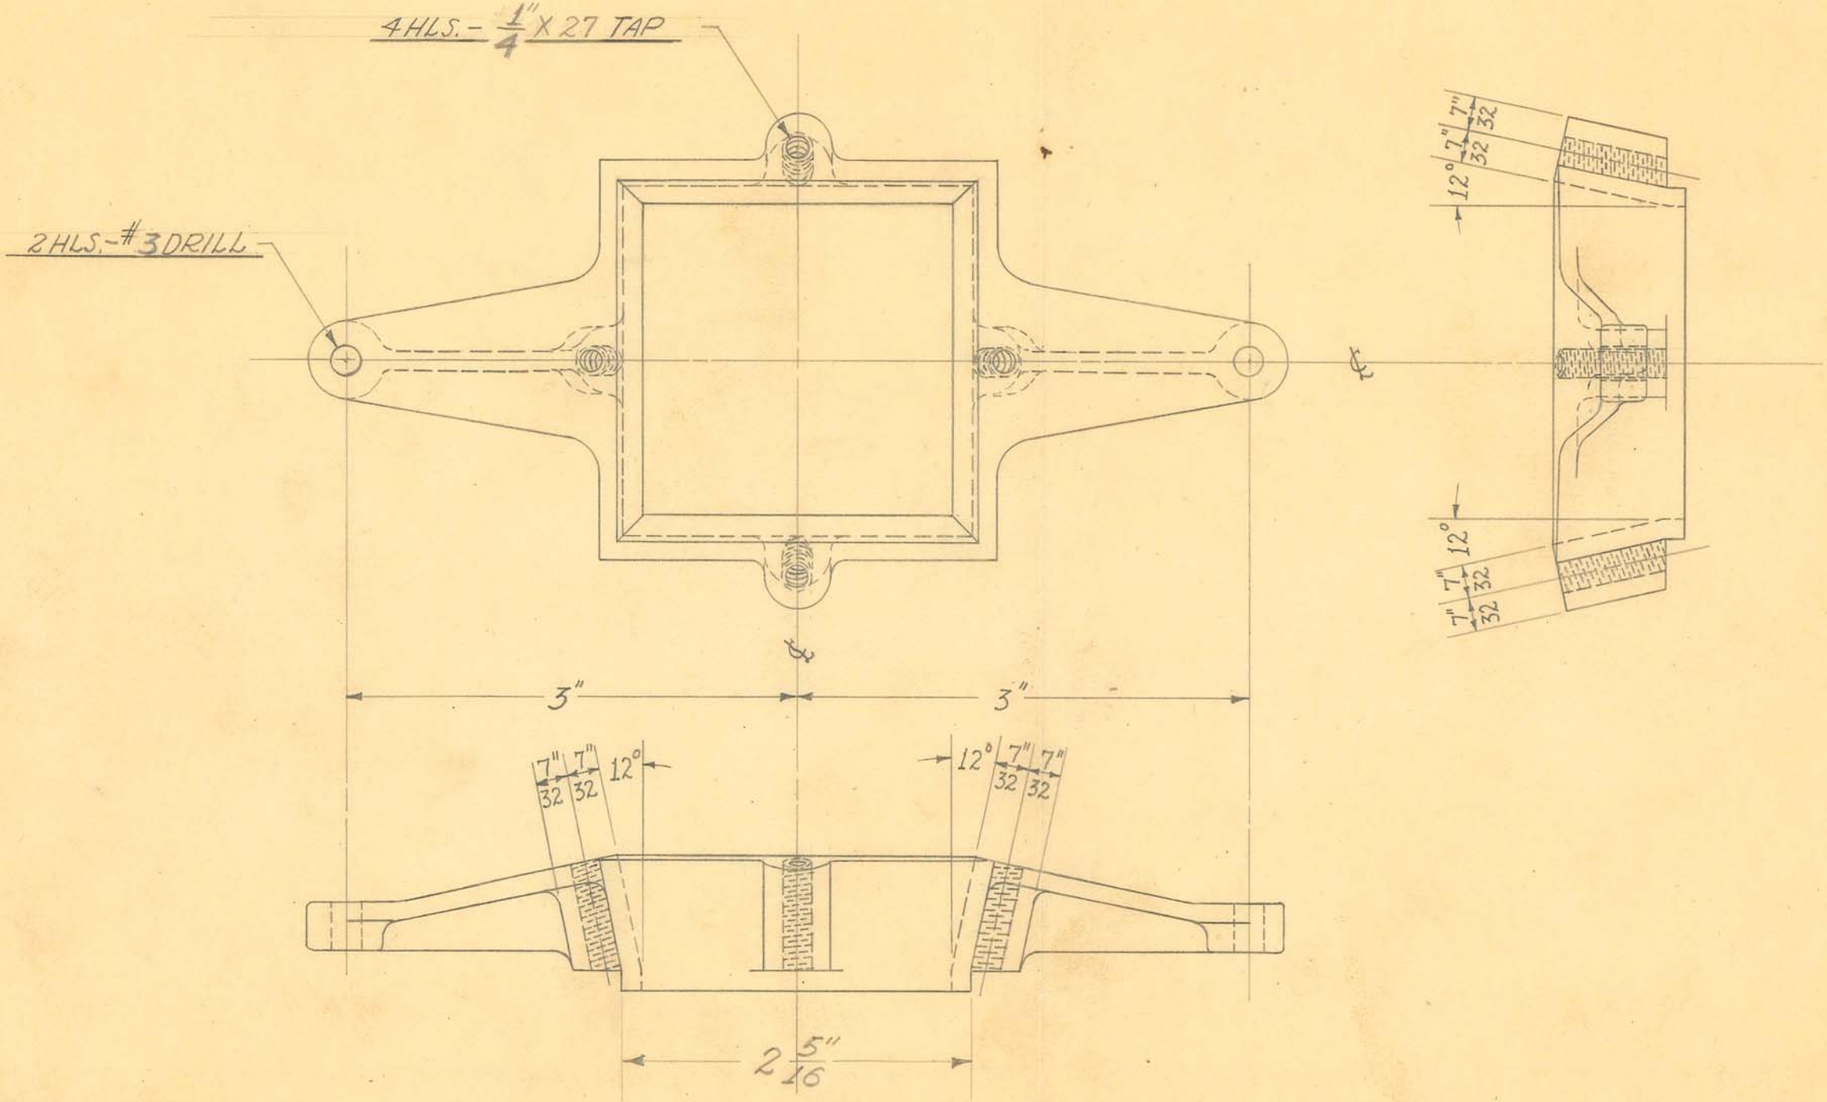

1 REQUIRED

OBSOLETE

SIZE	#12	ISSUE 11-14-38	J.W.	TITLE: FISCHER ORTHODIAGRAPHIC ATTACHMENT SIGHTING UNIT - CROSS WIRE SUPPORT
KIND	ALUM. CASTING	CHANGED		
SHAPE		"		
FINISH		"		
TEMP.		"		
PATT.	1290	"		

H. G. FISCHER & CO.
2338 WABANSIA AVE.
CHICAGO, ILL.

CAT. NO.

PART NO. 11758F

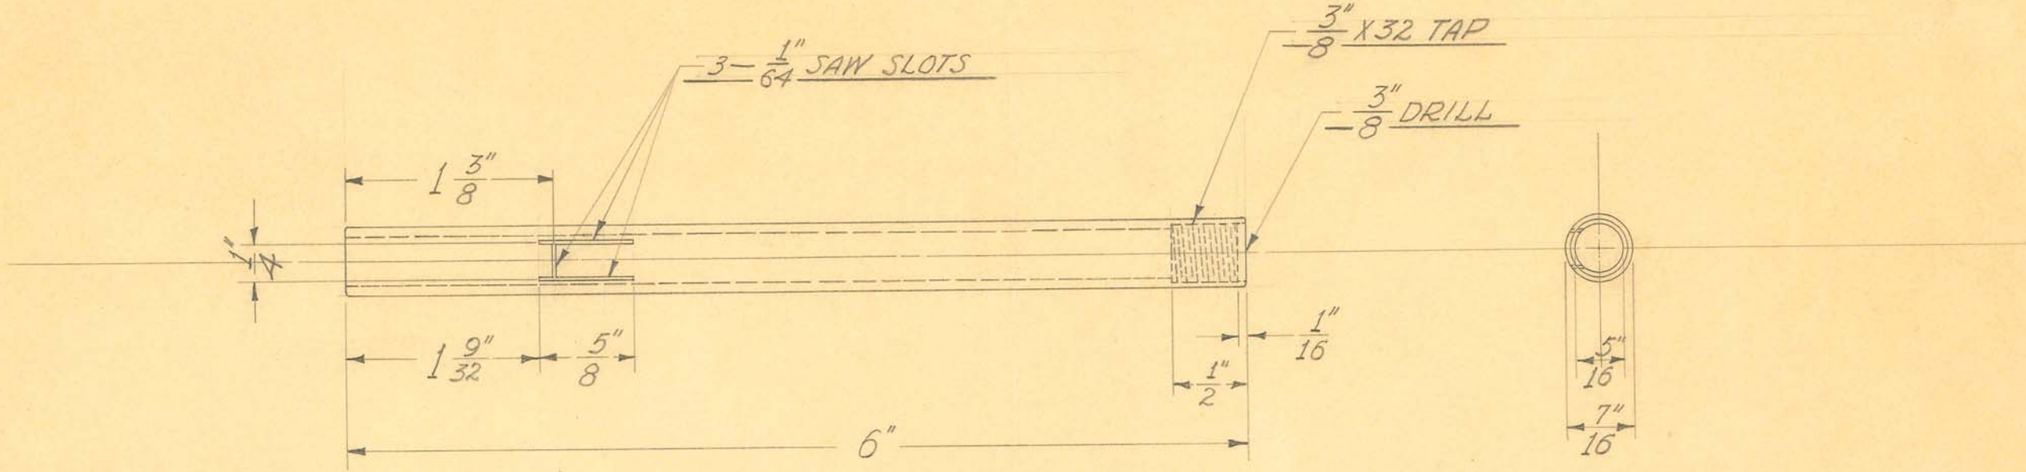

2 REQUIRED

OBSOLETE

SIZE	7/16 O.D. X 5/16 I.D.	ISSUE 10-24-38	J.W.	TITLE: DR. LOGAN PELVIC STABILIZER ADJUSTING SWIVEL TUBE
KIND	BRASS TUBING	CHANGED		
SHAPE		"		
FINISH		"		
TEMP.		"		
PATT.		"		

H. G. FISCHER & CO.
2335 WABANSIA AVE.
CHICAGO, ILL.

CAT. NO.

PART NO. 11781

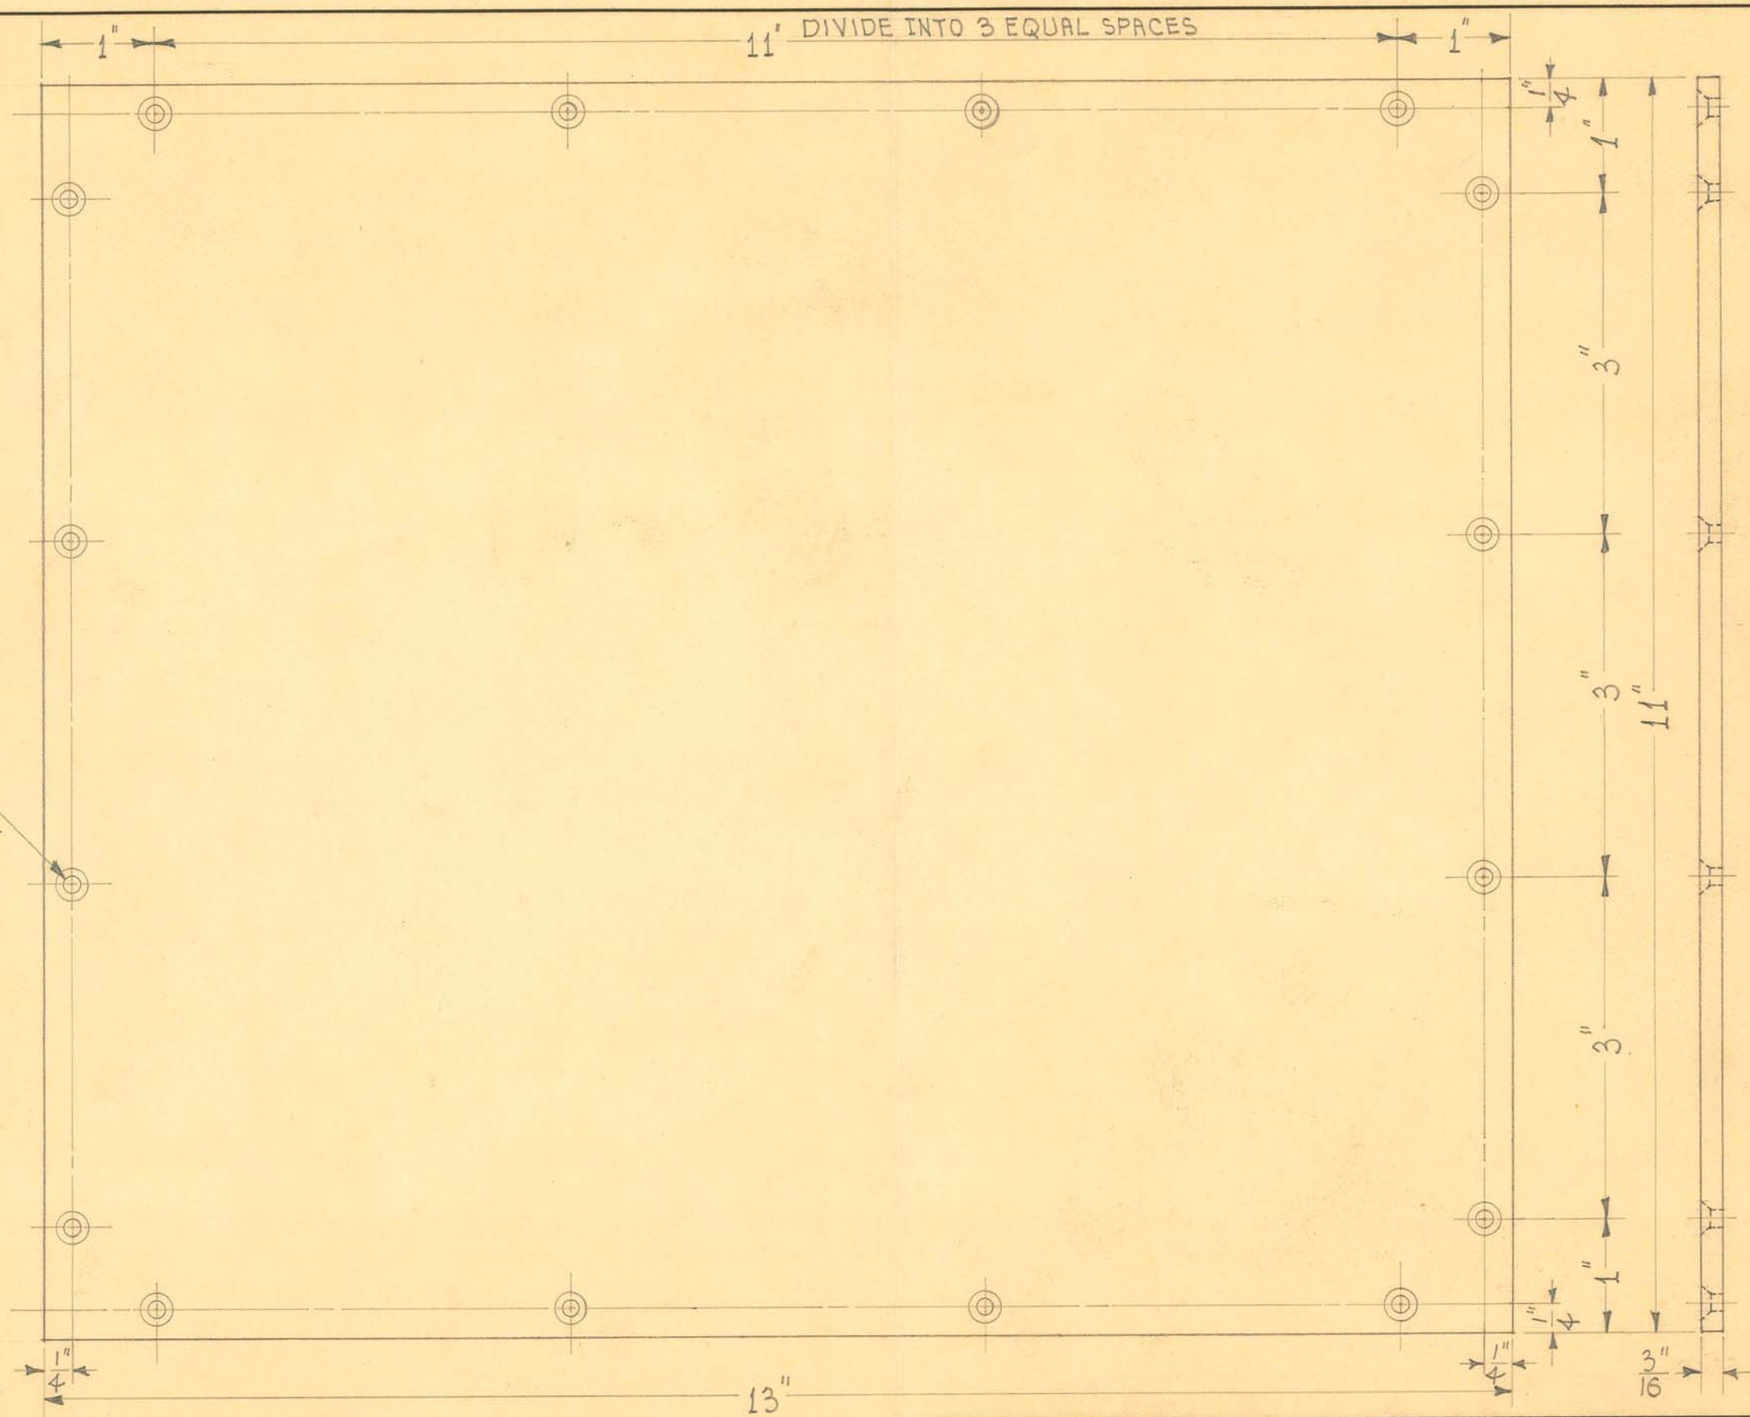

OBSOLETE

1 REQUIRED

SCALE ~ 3/4" = 1"

SIZE	11"X13"X3/16"	ISSUE 8-11-38	HE.	
KIND	BAKELITE	CHANGED		
SHAPE	SHEET	"		
FINISH		"		
TEMP.		"		
PATT.		"		

TITLE: FISCHER CHIROPODIST FLUOROSCOPE-PANEL

H. G. FISCHER & CO.
2335 WABANSIA AVE.
CHICAGO, ILL.

CAT. NO.

PART NO. 11801

10811

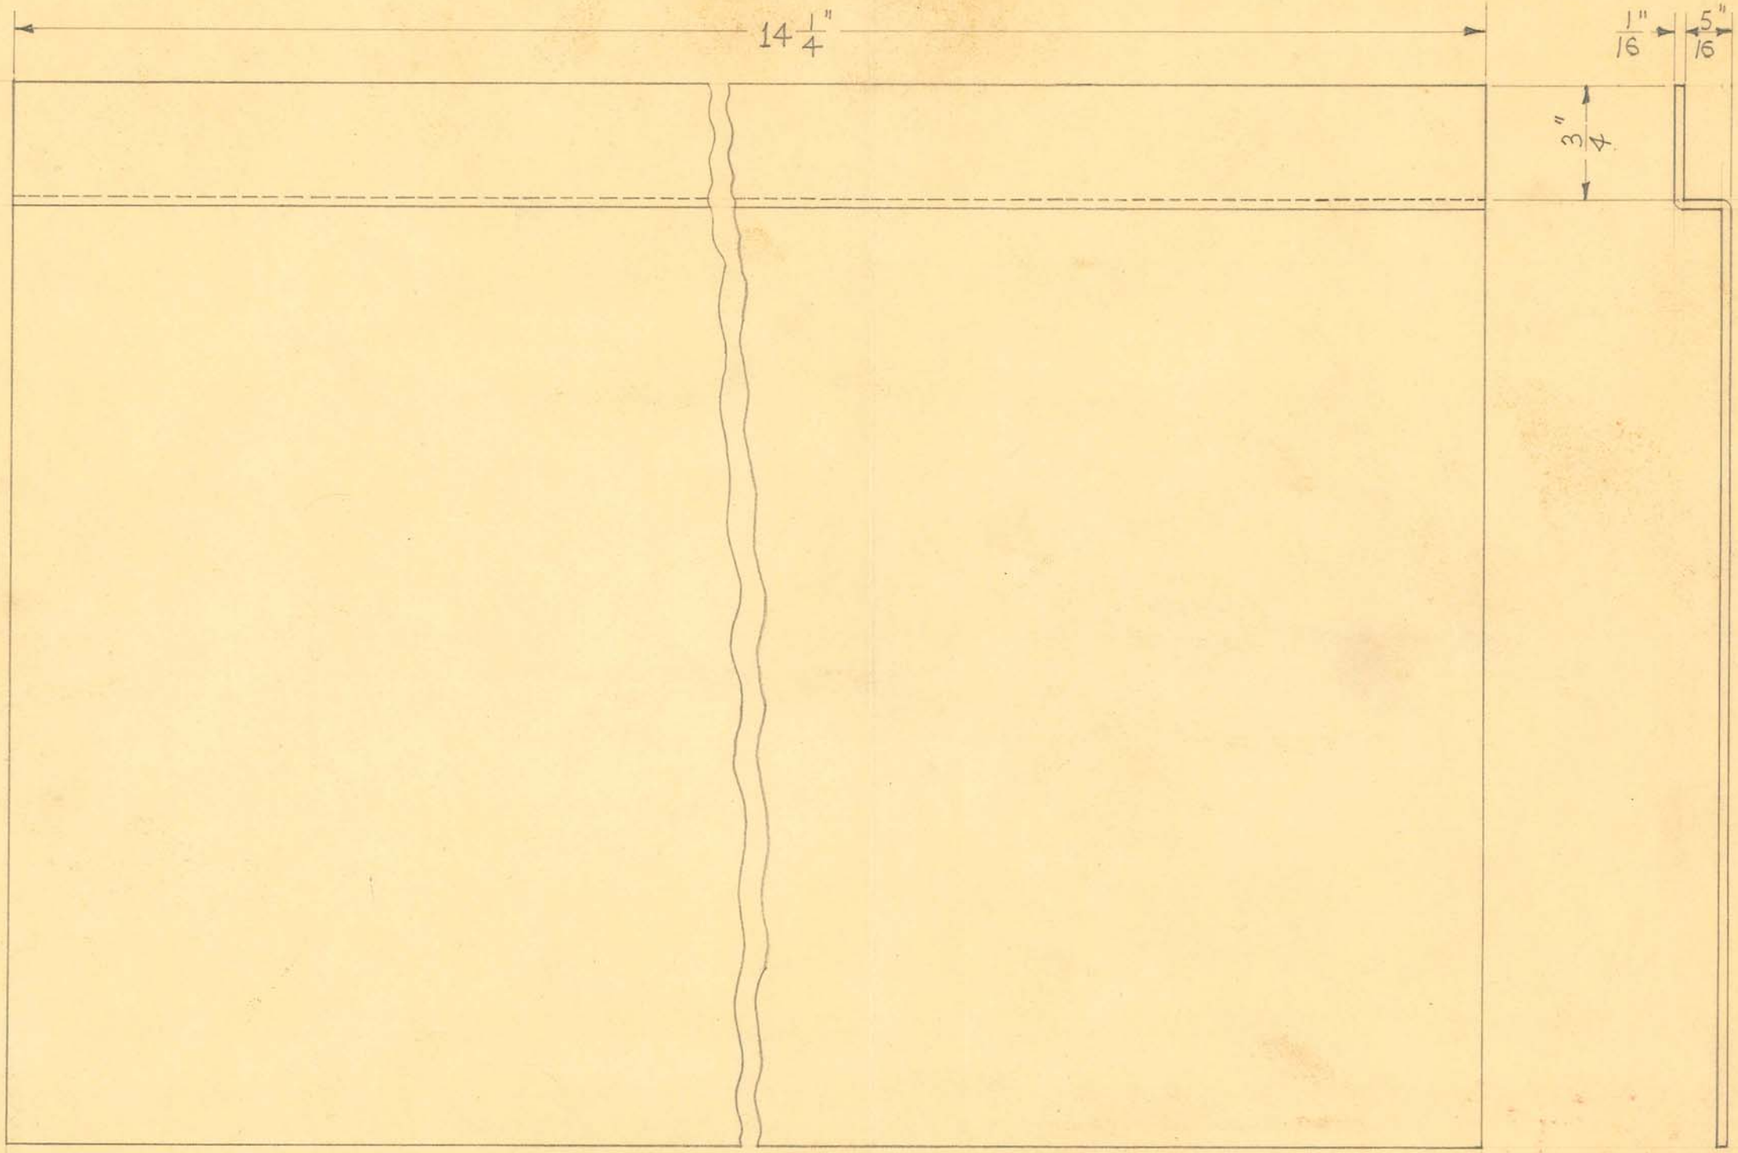

DEVELOPED LENGTH- 7 1/4"
1 REQUIRED

OBSOLETE

SIZE	14 1/4" X 7 1/4" X 1/16"	ISSUE 8-11-38	HE.
KIND	SHEET LEAD	CHANGED	
SHAPE		"	
FINISH		"	
TEMP.		"	
PATT.		"	

TITLE:
FISCHER CHIROPODIST FLUOROSCOPE-
FILM PROTECTION PLATE

H. G. FISCHER & CO.
2335 WABANSIA AVE.
CHICAGO, ILL.

CAT. NO.

PART NO. 11807A

AT 0811

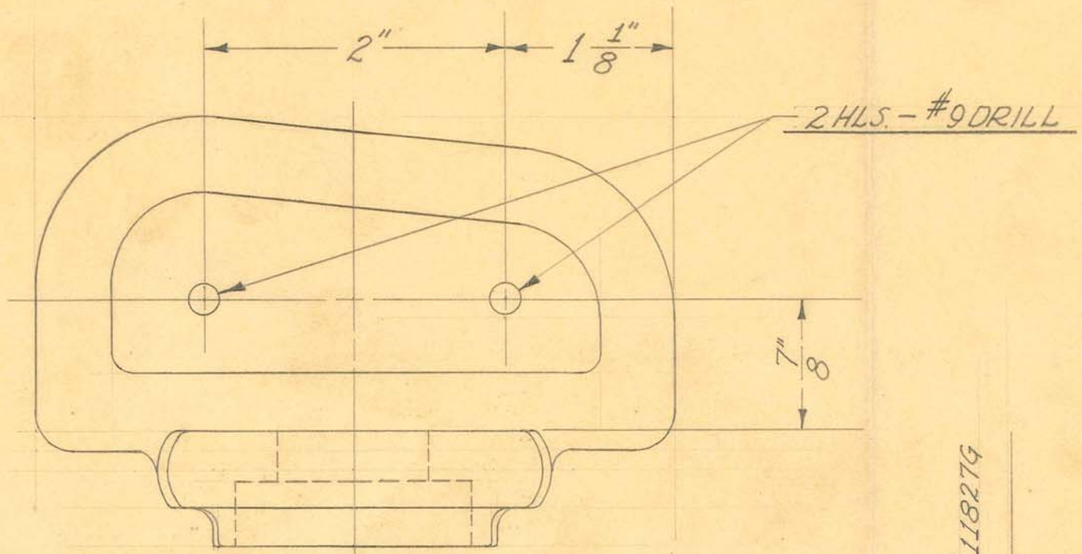

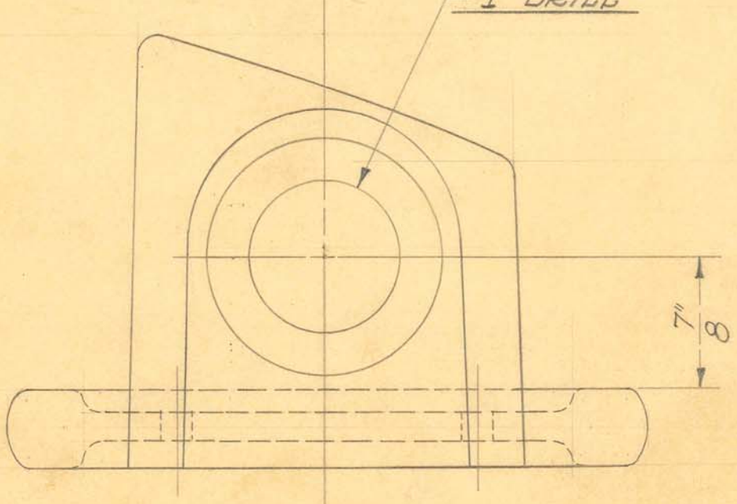

1 REQUIRED

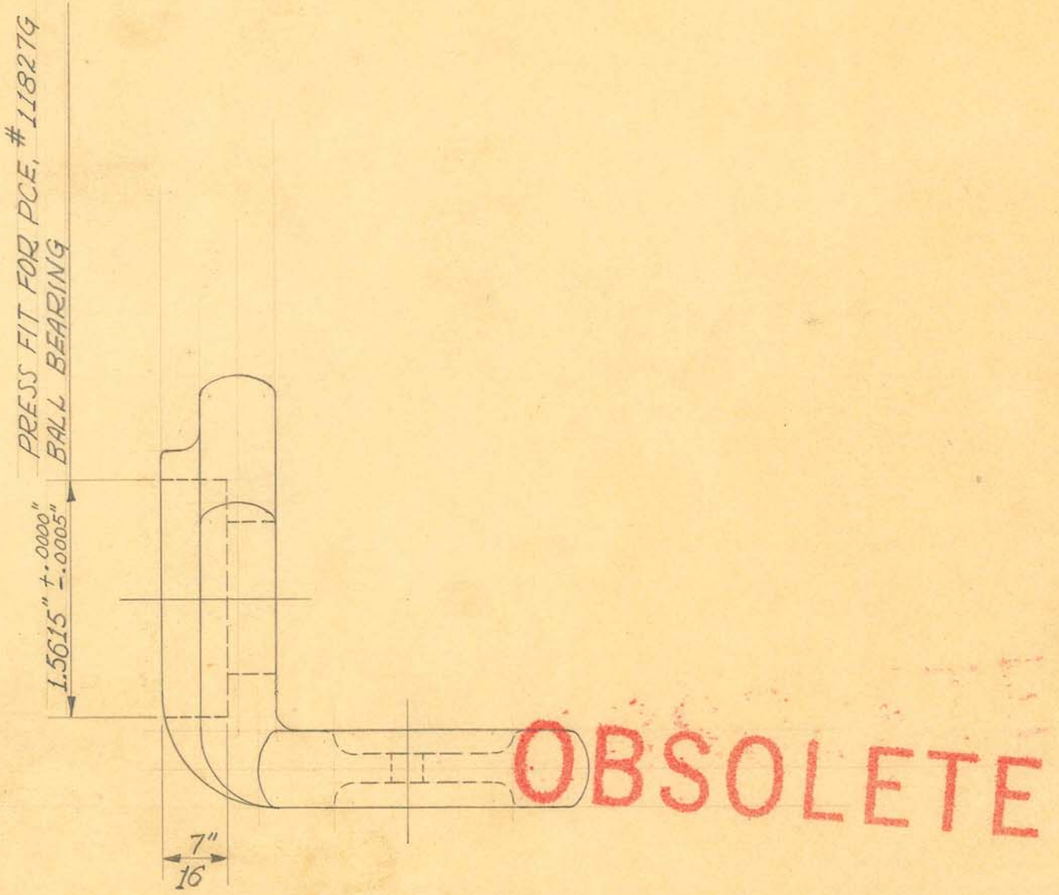

OBSOLETE

SIZE		ISSUE 11-4-38	J.W.	TITLE: FISCHER RAD. & FLUOROSCOPIC TILT TABLE SIDE FRAME ROLLER SUPP. - REAR - LEFT
KIND	IRON CASTING	CHANGED		
SHAPE		"		
FINISH	CAD. #23	"		
TEMP.		"		H. G. FISCHER & CO. 2335 WABANSIA AVE. CHICAGO, ILL. — CAT. NO. — PART NO. 11821F
PATT.	1168	"		

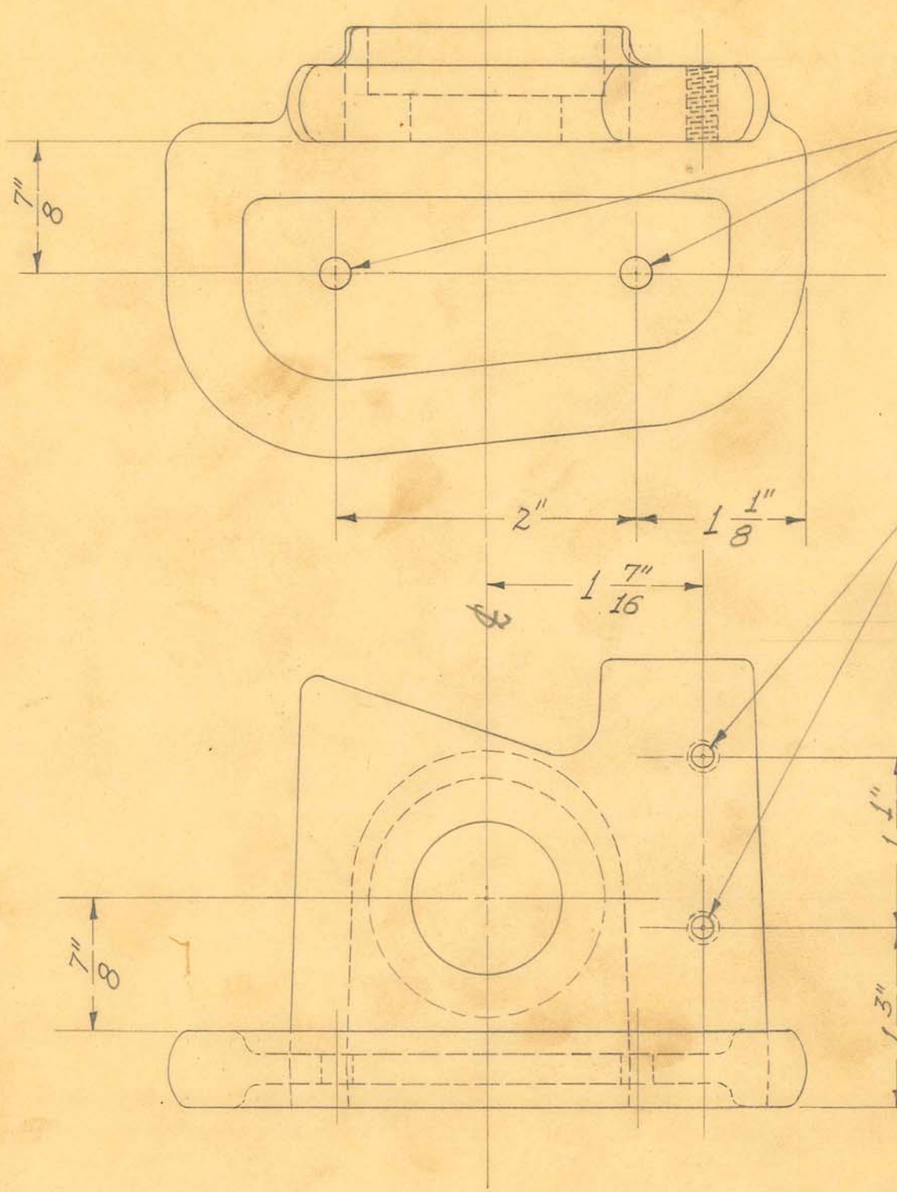

1 REQUIRED

OBSOLETE

Obsolete

SIZE		ISSUE 11-3-38	J.W.
KIND	IRON CASTING	CHANGED	
SHAPE		"	
FINISH	CAD. #23	"	
TEMP.		"	
PATT.	1169	"	

TITLE: FISCHER RAD. & FLUOROSCOPIC TILT TABLE SIDE FRAME ROLLER SUPP. – REAR – RIGHT

H. G. FISCHER & CO.
2335 WABANSIA AVE.
CHICAGO, ILL.

CAT. NO.

PART NO. 11822F

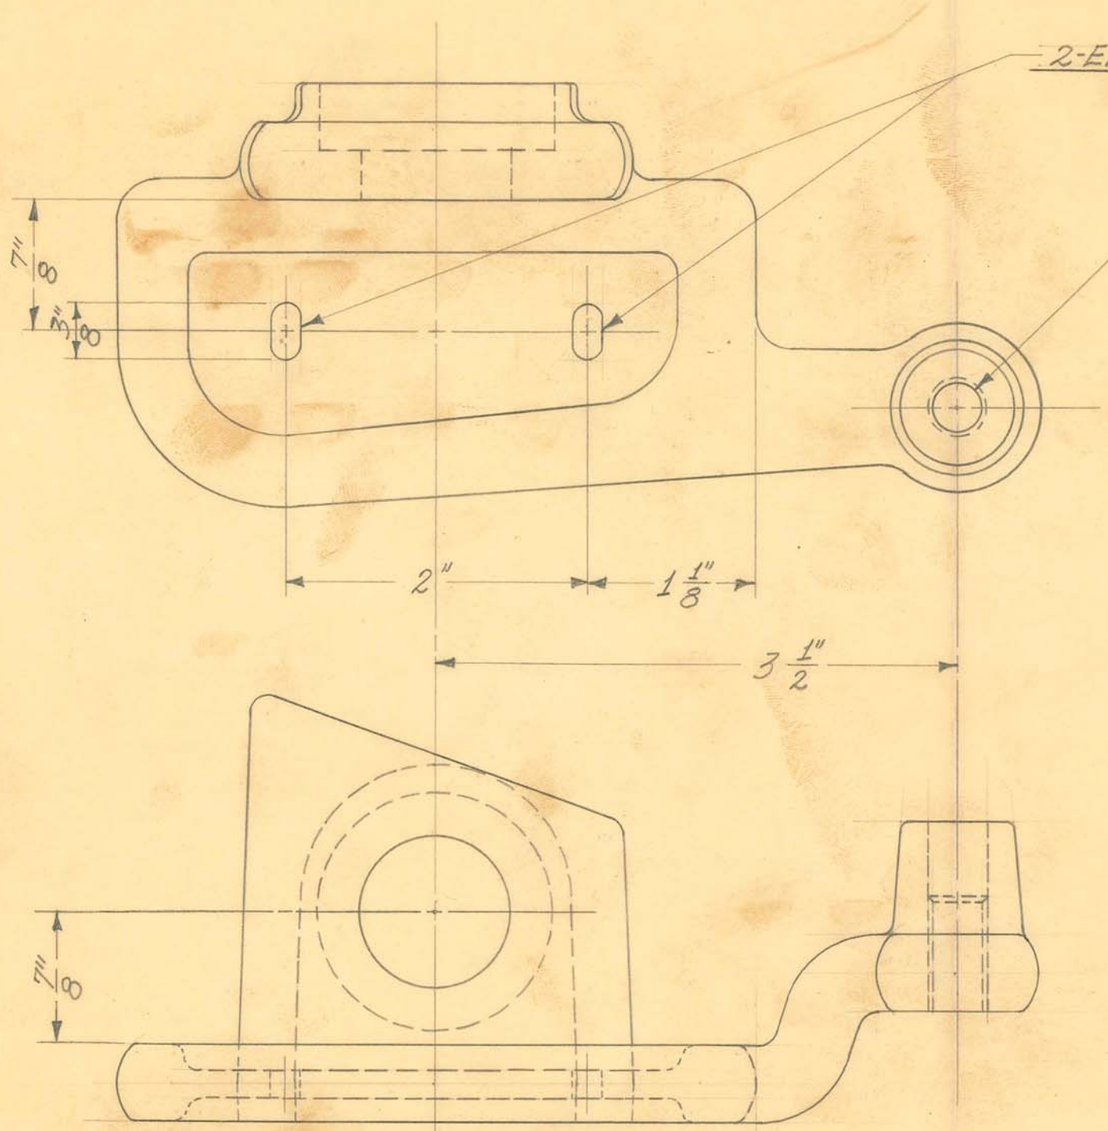

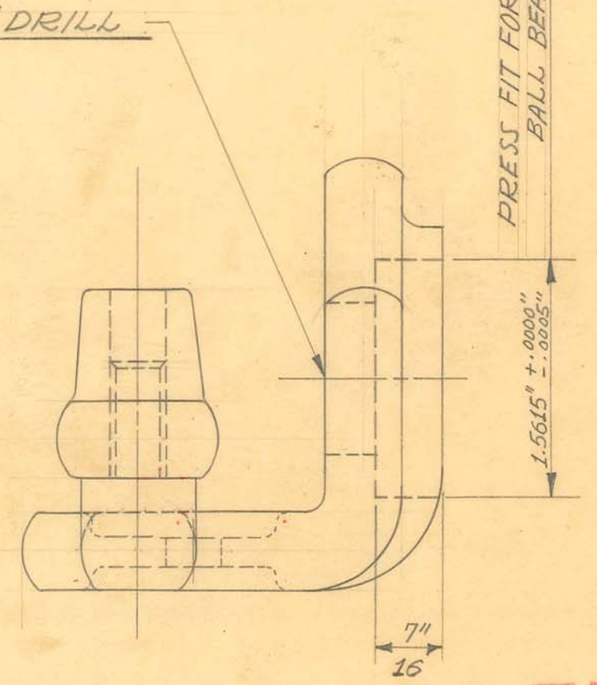

1 REQUIRED

OBSOLETE

SIZE		ISSUE 4-9-40	J.W.
KIND	IRON CASTING	CHANGED	
SHAPE		"	
FINISH	CAD. #23	"	
TEMP.		"	
PATT.	1169	"	

TITLE: FISCHER RAD. & FLUOROSCOPIC TILT TABLE SIDE FRAME ROLLER SUPP. -REAR- RIGHT

H. G. FISCHER & CO.
2335 WABANSIA AVE.
CHICAGO, ILL.

CAT. NO.

PART NO. 11822AF

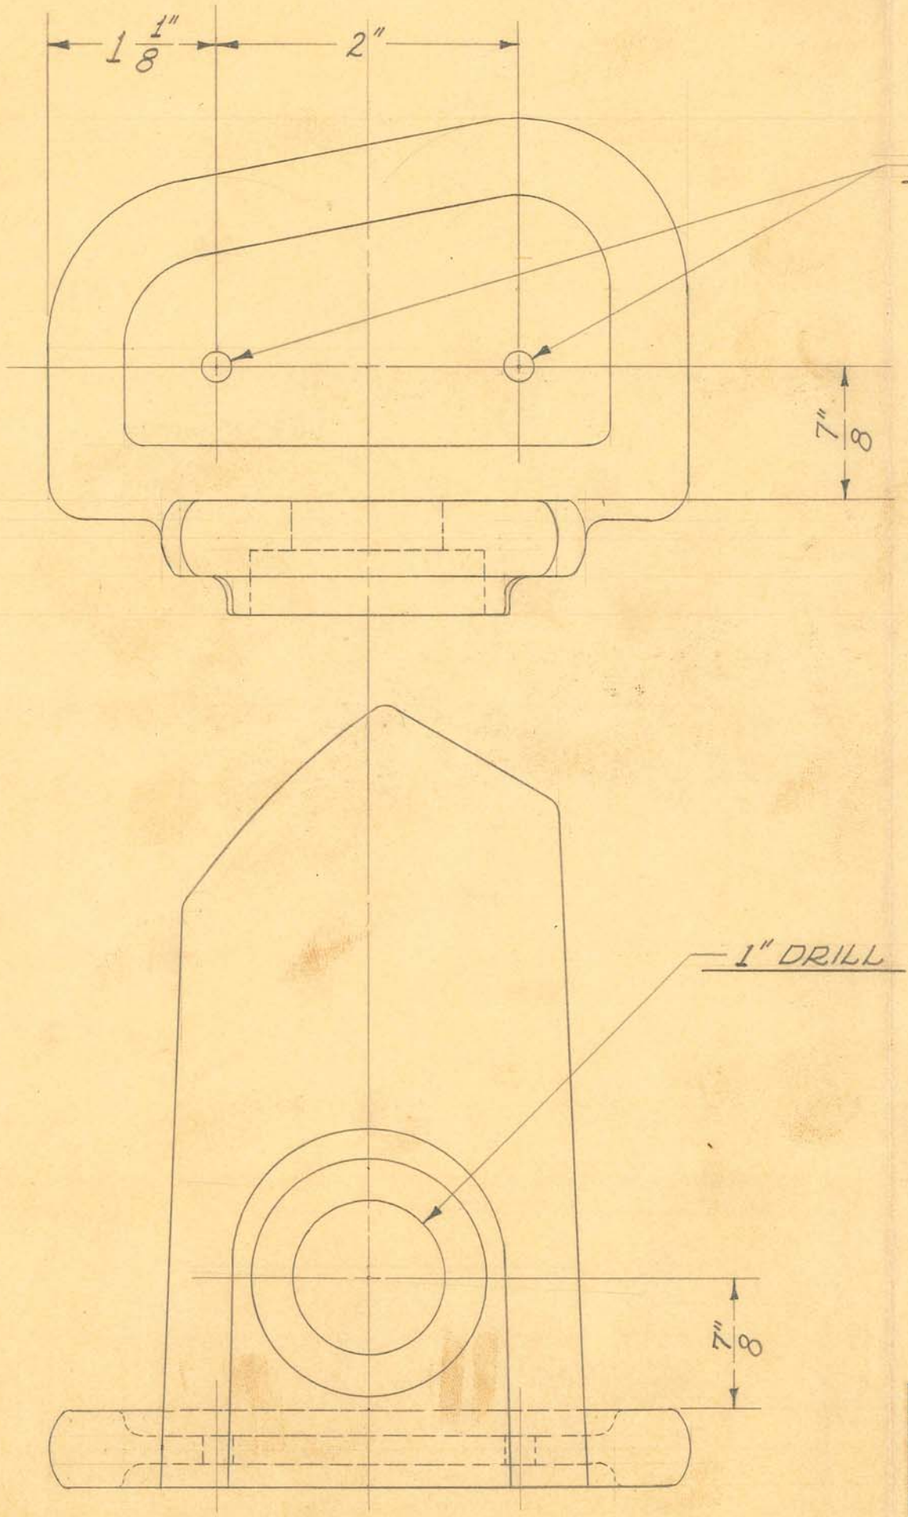

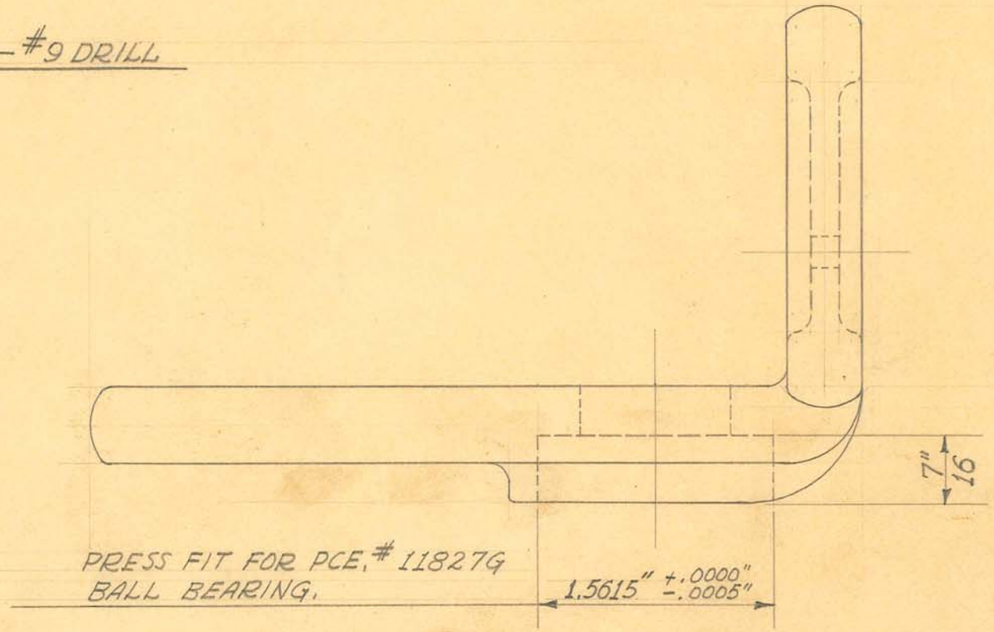

OBSOLETE

1 REQUIRED

Obsolete

SIZE		ISSUE	
KIND	IRON CASTING	CHANGED	
SHAPE		"	
FINISH	CAD. #23	"	
TEMP.		"	
PATT.	1170	"	

TITLE: FISCHER RAD. & FLUOROSCOPIC TILT TABLE SIDE FRAME ROLLER SUPP. - FRONT - LEFT

H. G. FISCHER & CO.
2335 WABANSIA AVE.
CHICAGO, ILL.

CAT. NO.

PART NO. 11823F

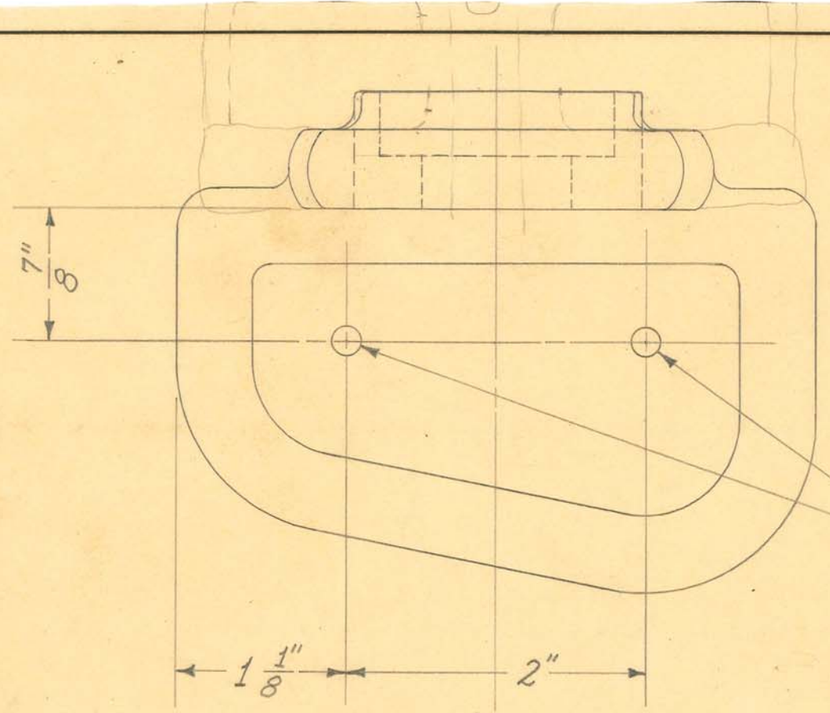

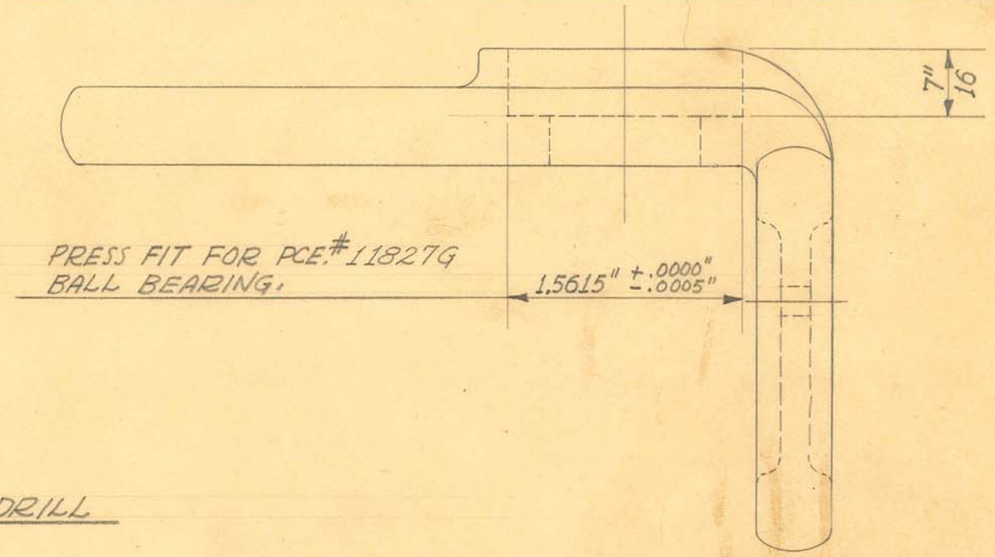

2 HLS. - #9 DRILL

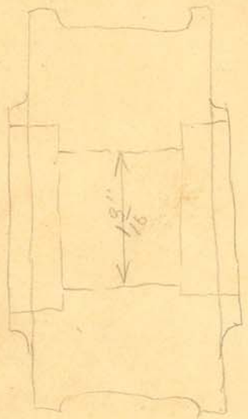

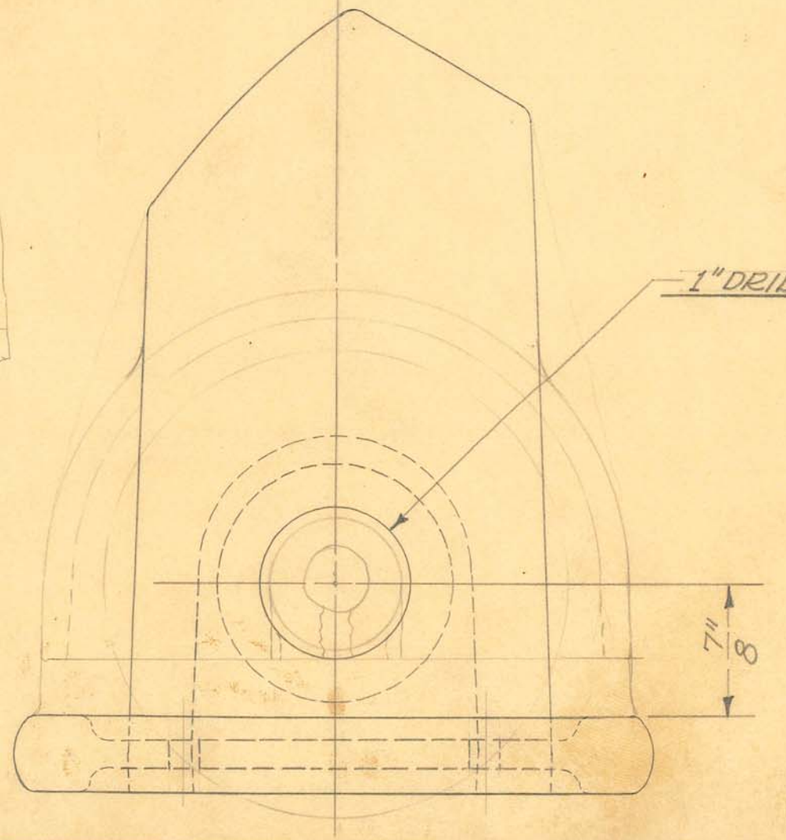

1" DRILL

1 REQUIRED

OBSOLETE

Obsolete

SIZE		ISSUE 11-3-38	J.W.
KIND	IRON CASTING	CHANGED	
SHAPE		"	
FINISH	CAD. #23	"	
TEMP.		"	
PATT.	1171	"	

TITLE: FISCHER RAD. & FLUOROSCOPIC TILT TABLE SIDE FRAME ROLLER SUPP. - FRONT - RIGHT

H. G. FISCHER & CO.
2335 WABANSIA AVE.
CHICAGO, ILL.

CAT. NO.

PART NO. 11824F

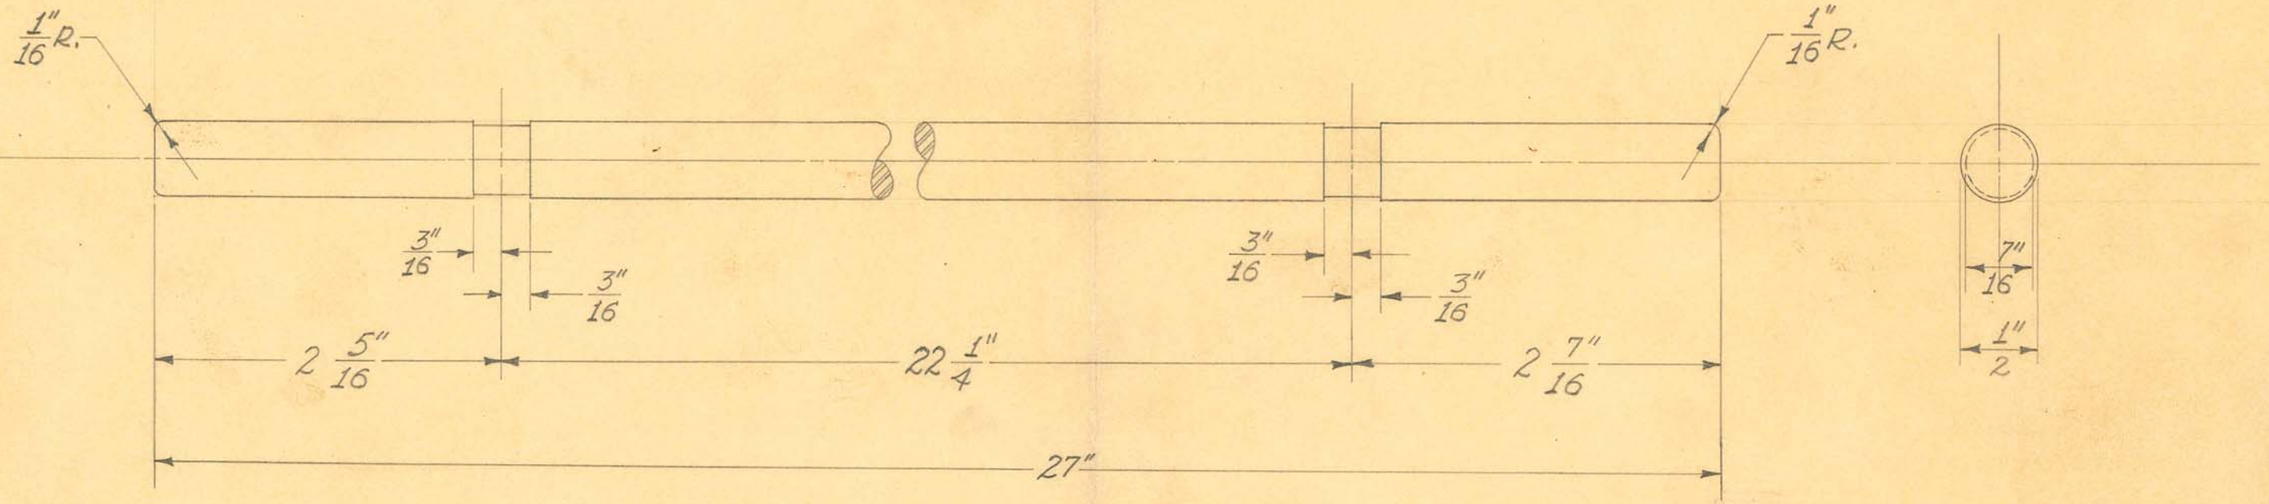

1 REQUIRED

OBSOLETE

SIZE	1/2" DIAM.	ISSUE 11-4-38	J.W.	TITLE: FISCHER RAD. & FLUOROSCOPIC TILT TABLE SIDE FRAME ROLLER SHAFT - REAR
KIND	C.R. STEEL	CHANGED		
SHAPE	ROD	"		
FINISH	CAD. #23	"		
TEMP.		"		
PATT.		"		

H. G. FISCHER & CO.
2335 WABANSIA AVE.
CHICAGO, ILL.

CAT. NO.

PART NO. 11828

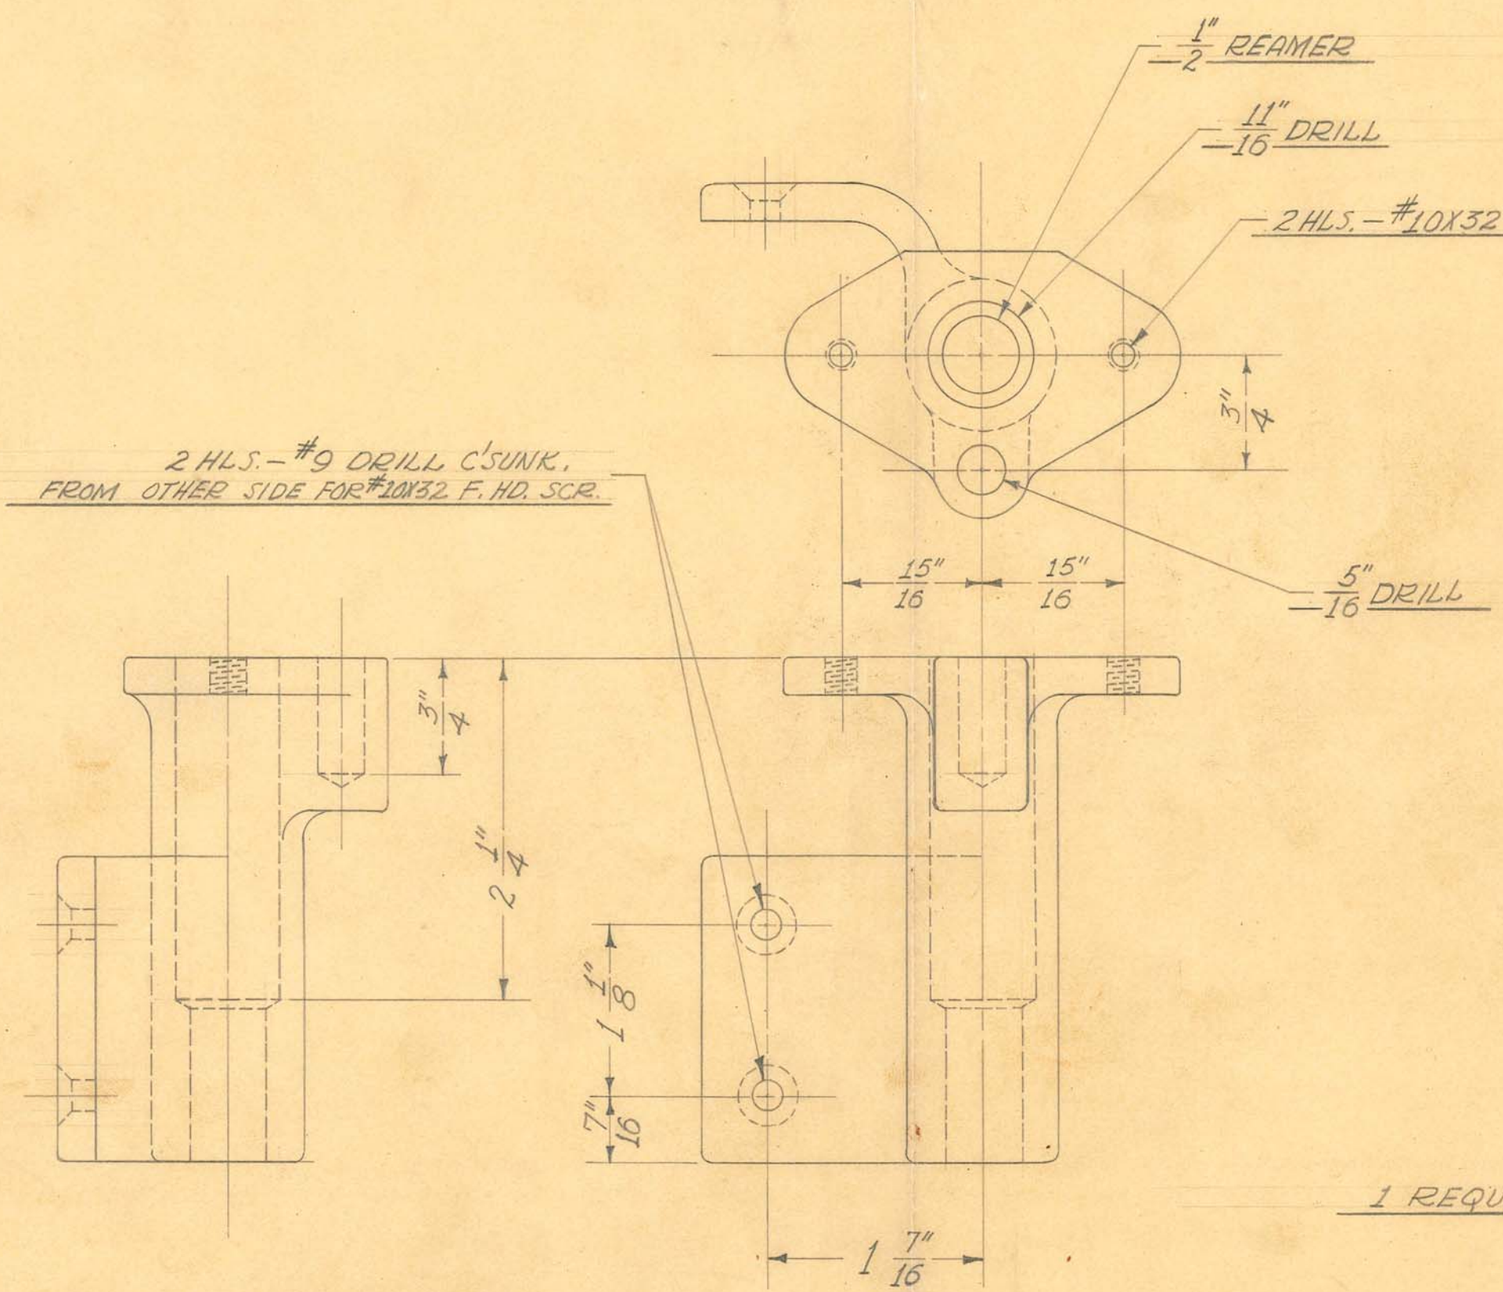

OBSOLETE

1 REQUIRED

SIZE		ISSUE 11-3-38	J.W.	TITLE: FISCHER RAD. & FLUOROSCOPIC TILT TABLE SIDE FRAME - STOP SUPPORT
KIND	IRON CASTING	CHANGED		
SHAPE		"		
FINISH	CAD. #23	"		
TEMP.		"		
PATT.	1285	"		

H. G. FISCHER & CO. 2335 WABANSIA AVE. CHICAGO, ILL. | CAT. NO. | PART NO. 11829F

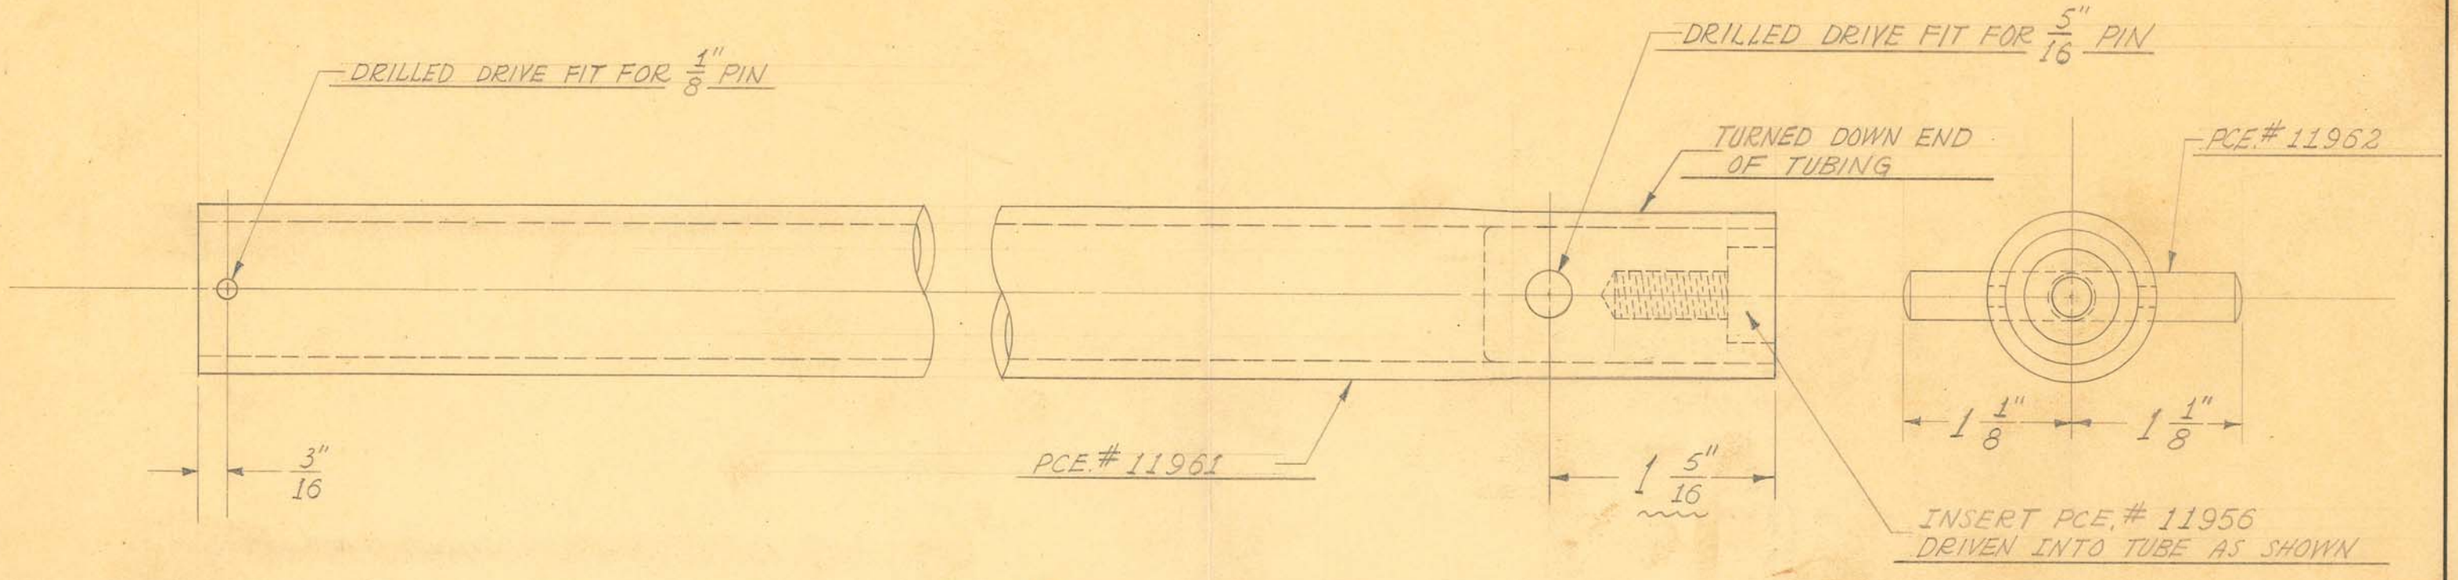

1 REQUIRED

OBSOLETE
Obsolete

SIZE		ISSUE 6-20-38	J.W.	TITLE: AUXILIARY TABLE STAND FOR MOD. "G" X-RAY HEAD -HORIZONTAL SLIDE TUBE ASSEM.
KIND		CHANGED		
SHAPE		per M.O. " 9-19-38	J.W.	
FINISH	CAD. #23	"		
TEMP.		"		
PATT.		"		

H. G. FISCHER & CO.
2335 WABANSIA AVE.
CHICAGO, ILL.

CAT. NO.

PART NO. 11960G

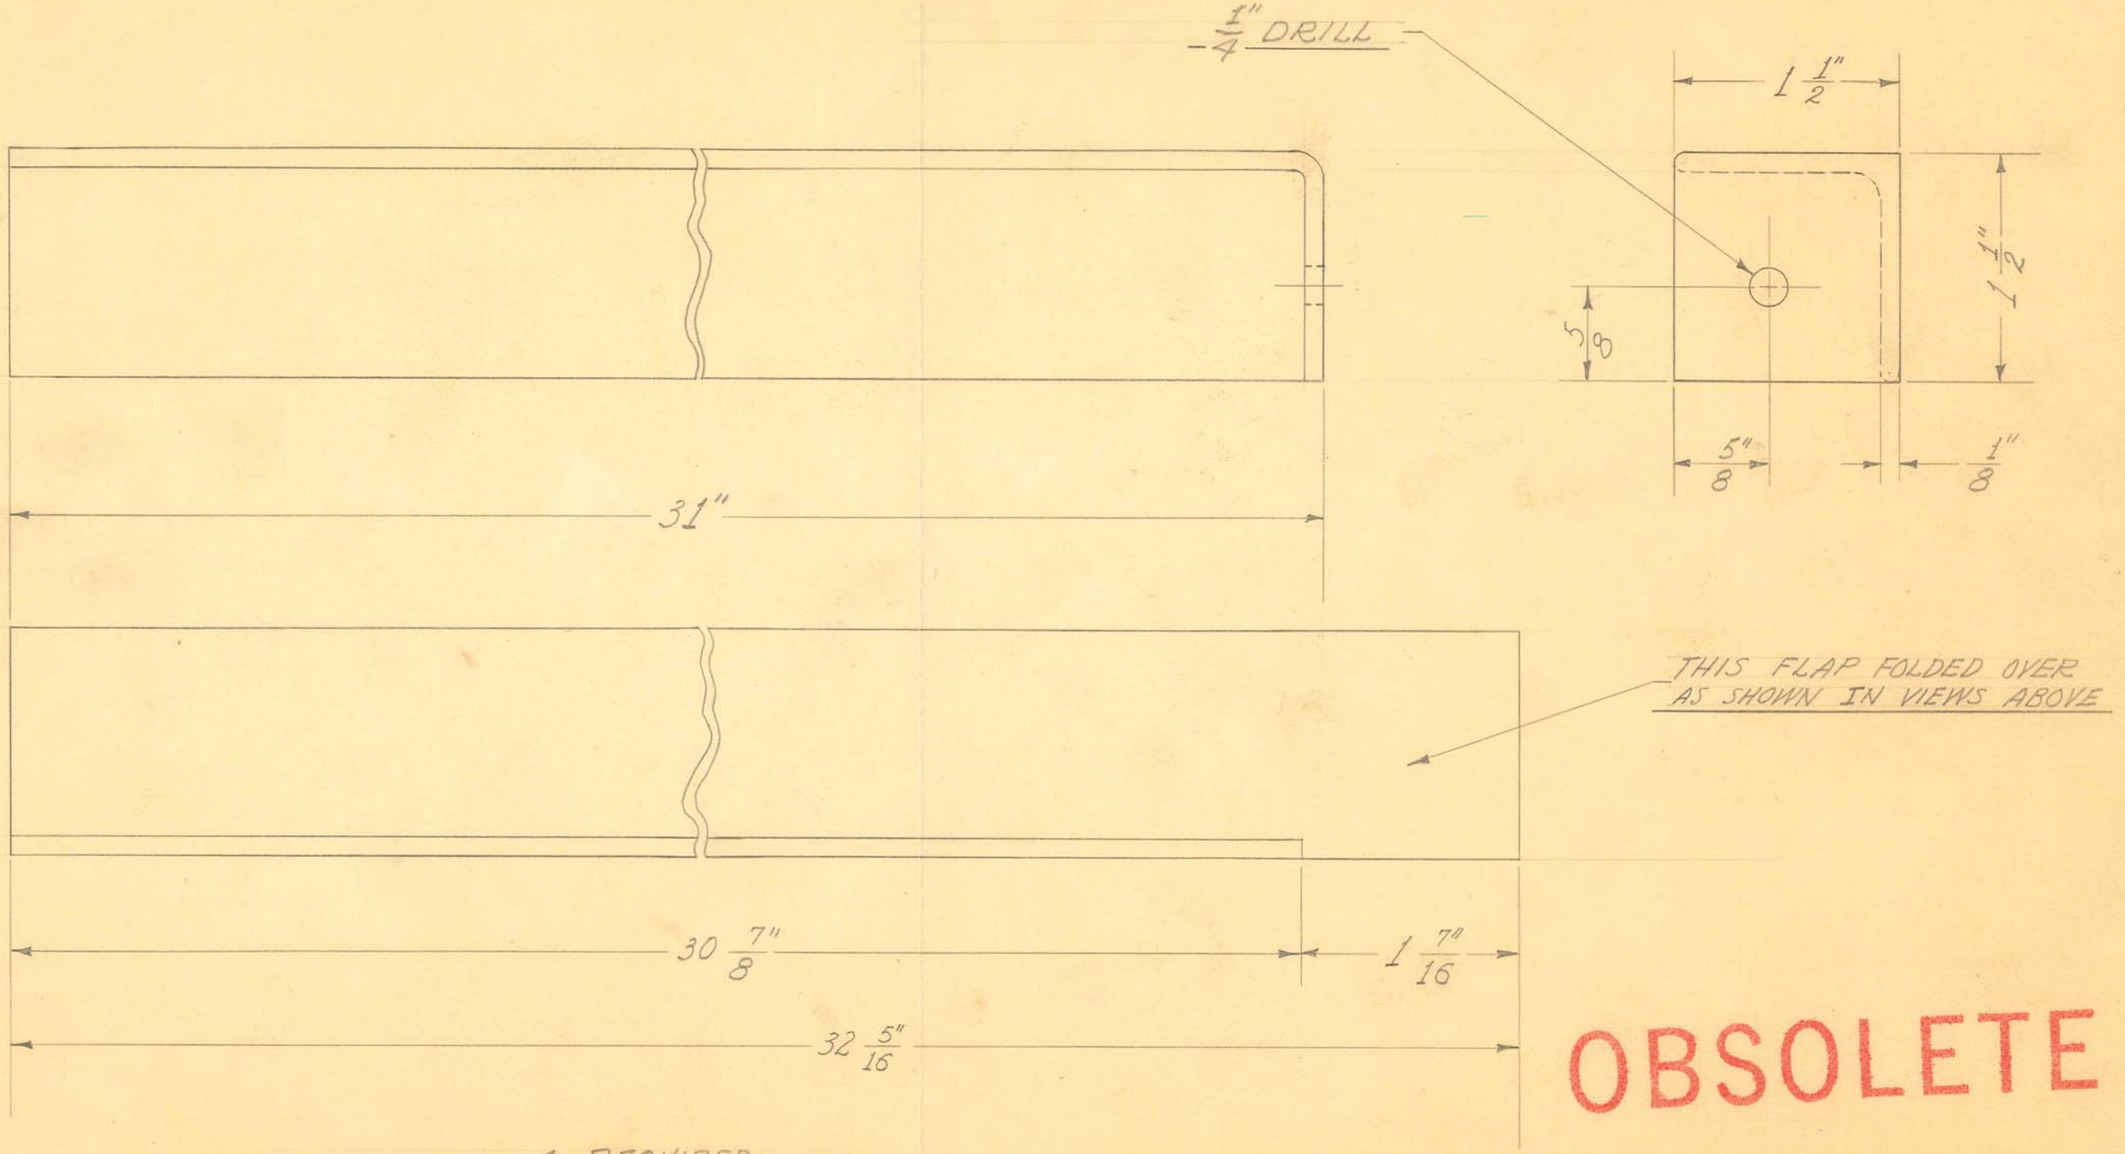

4 REQUIRED

OBSOLETE

SIZE	1½"X1½"X⅛"	ISSUE 4-15-38	J.W.
KIND	ANGLE IRON	CHANGED	
SHAPE		"	
FINISH		"	
TEMP.		"	
PATT.		"	

TITLE: FISCHER 14"X36" 3-COMPARTMENT TANK STAND – LEG

H. G. FISCHER & CO.
2335 WABANSIA AVE.
CHICAGO, ILL.

CAT. NO.

PART NO. 7893

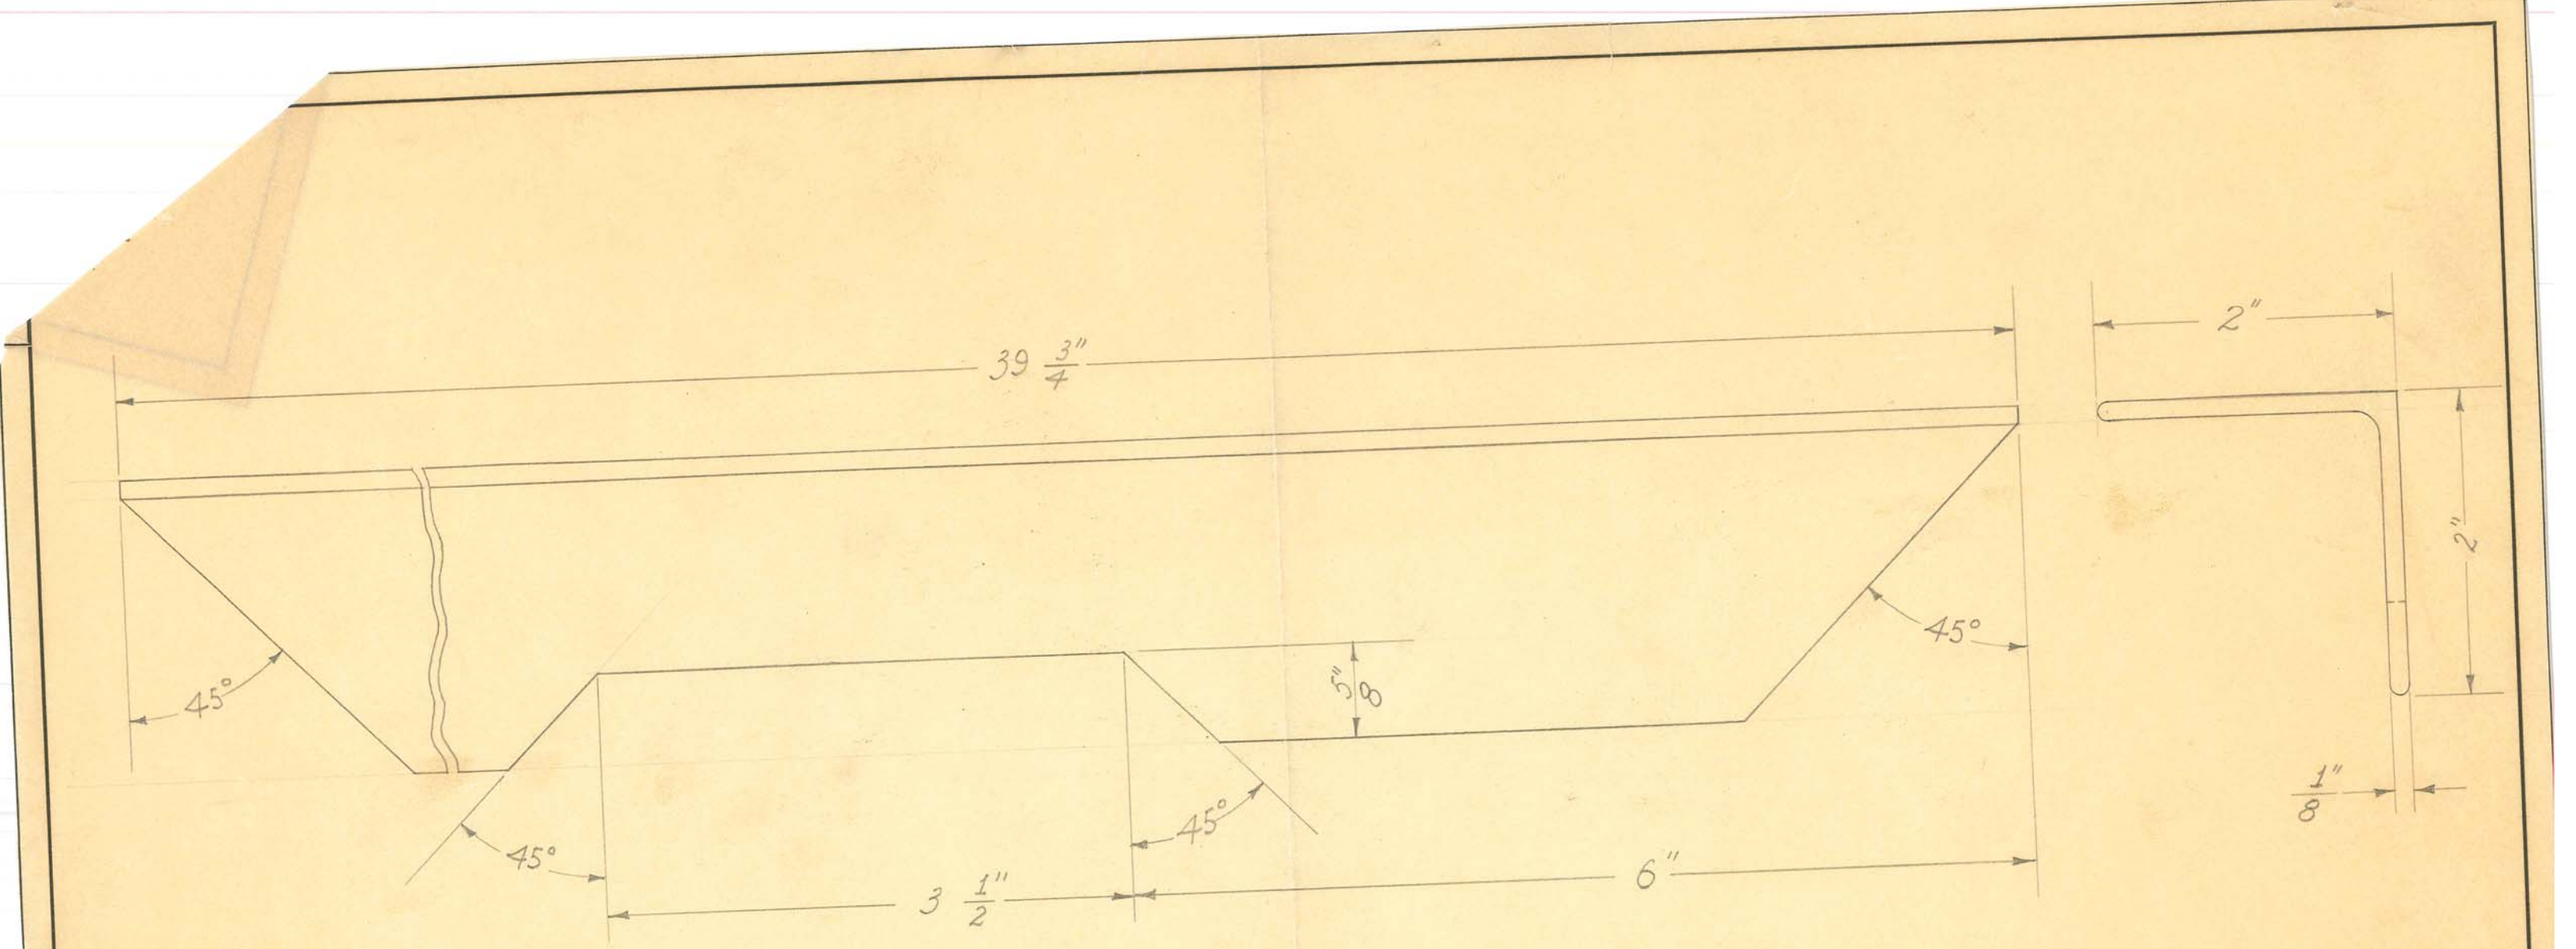

1 REQUIRED

OBSOLETE

SIZE	2"X2"X1/8"	ISSUE 4-15-38	J.W.	TITLE: FISCHER 14"X36" 3-COMPARTMENT TANK STAND - BOTTOM ANGLE - SIDE - RIGHT
KIND	ANGLE IRON	CHANGED		
SHAPE		"		
FINISH		"		
TEMP.		"		

H. G. FISCHER & CO.
2335 WABANSIA AVE.
CHICAGO, ILL.

CAT. NO.

PART NO. 7894

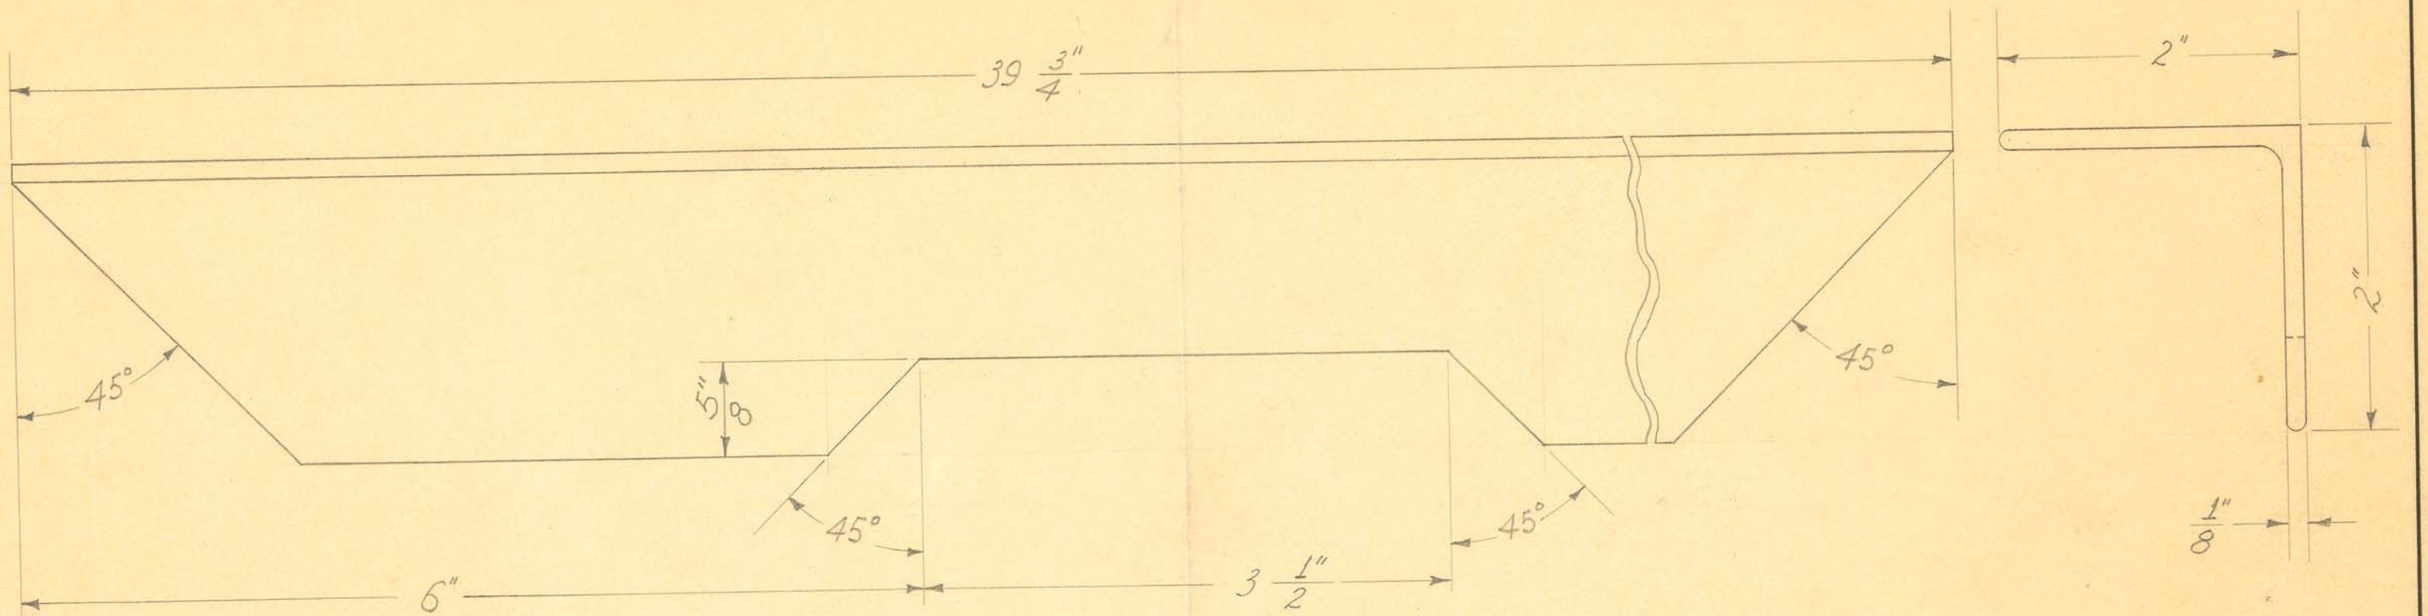

1 REQUIRED

OBSOLETE

SIZE	2"X2"X 1/8"	ISSUE ~~4-15-38~~	J.W.	TITLE: FISCHER 14"X36" 3 COMPARTMENT TANK STAND - BOTTOM ANGLE - SIDE - LEFT
KIND	ANGLE	CHANGED		
~~SHAPE~~	IRON	"		
FINISH		"		
TEMP.		"		
PATT.		"		

H. G. FISCHER & CO.
2335 WABANSIA AVE.
CHICAGO, ILL.

CAT. NO.

PART NO. 7895

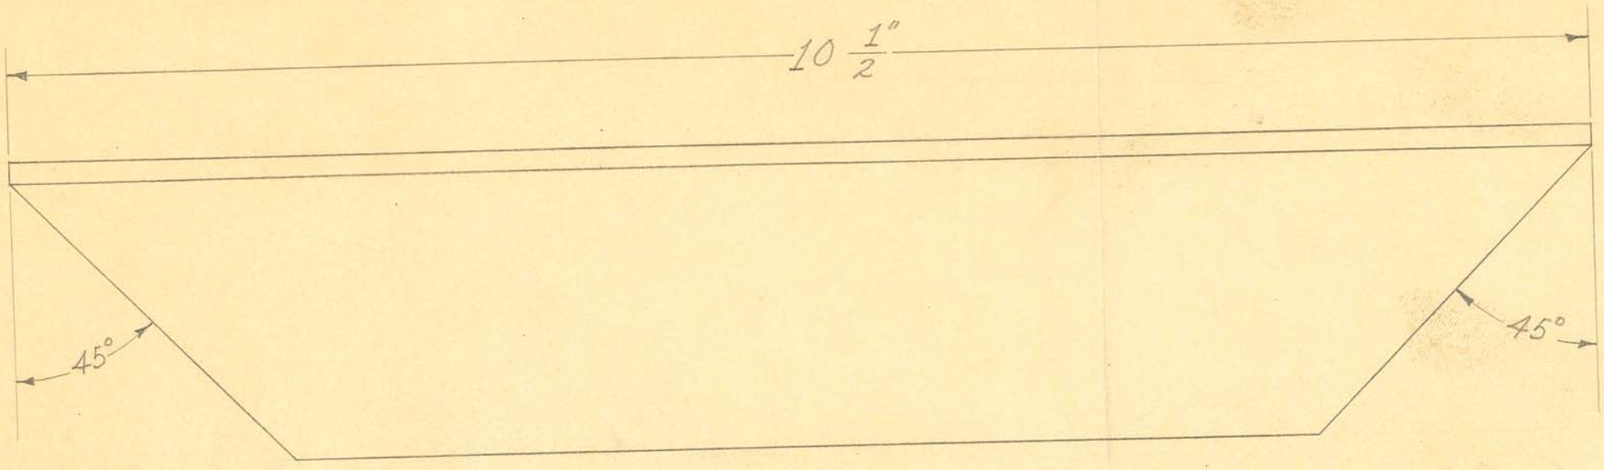

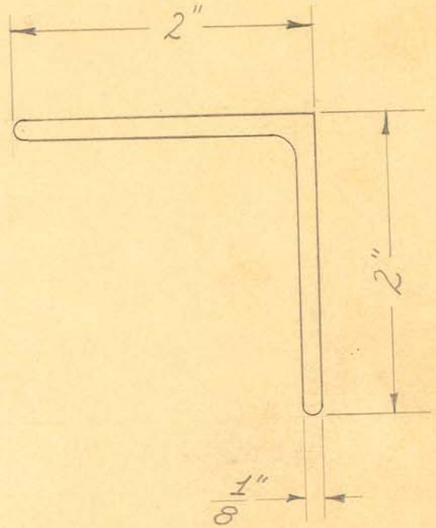

2 REQUIRED

OBSOLETE

SIZE	2"X2"X 3/8"	ISSUE 4-15-38	J.W.	TITLE: FISCHER 14"X36" 3-COMPARTMENT TANK STAND—BOTTOM ANGLE—END
KIND	ANGLE	CHANGED		
SHAPE	IRON	"		
FINISH		"		
TEMP.		"		
PART		"		

H. G. FISCHER & CO.
2335 WABANSIA AVE.
CHICAGO, ILL.

CAT. NO.

PART NO. 7896

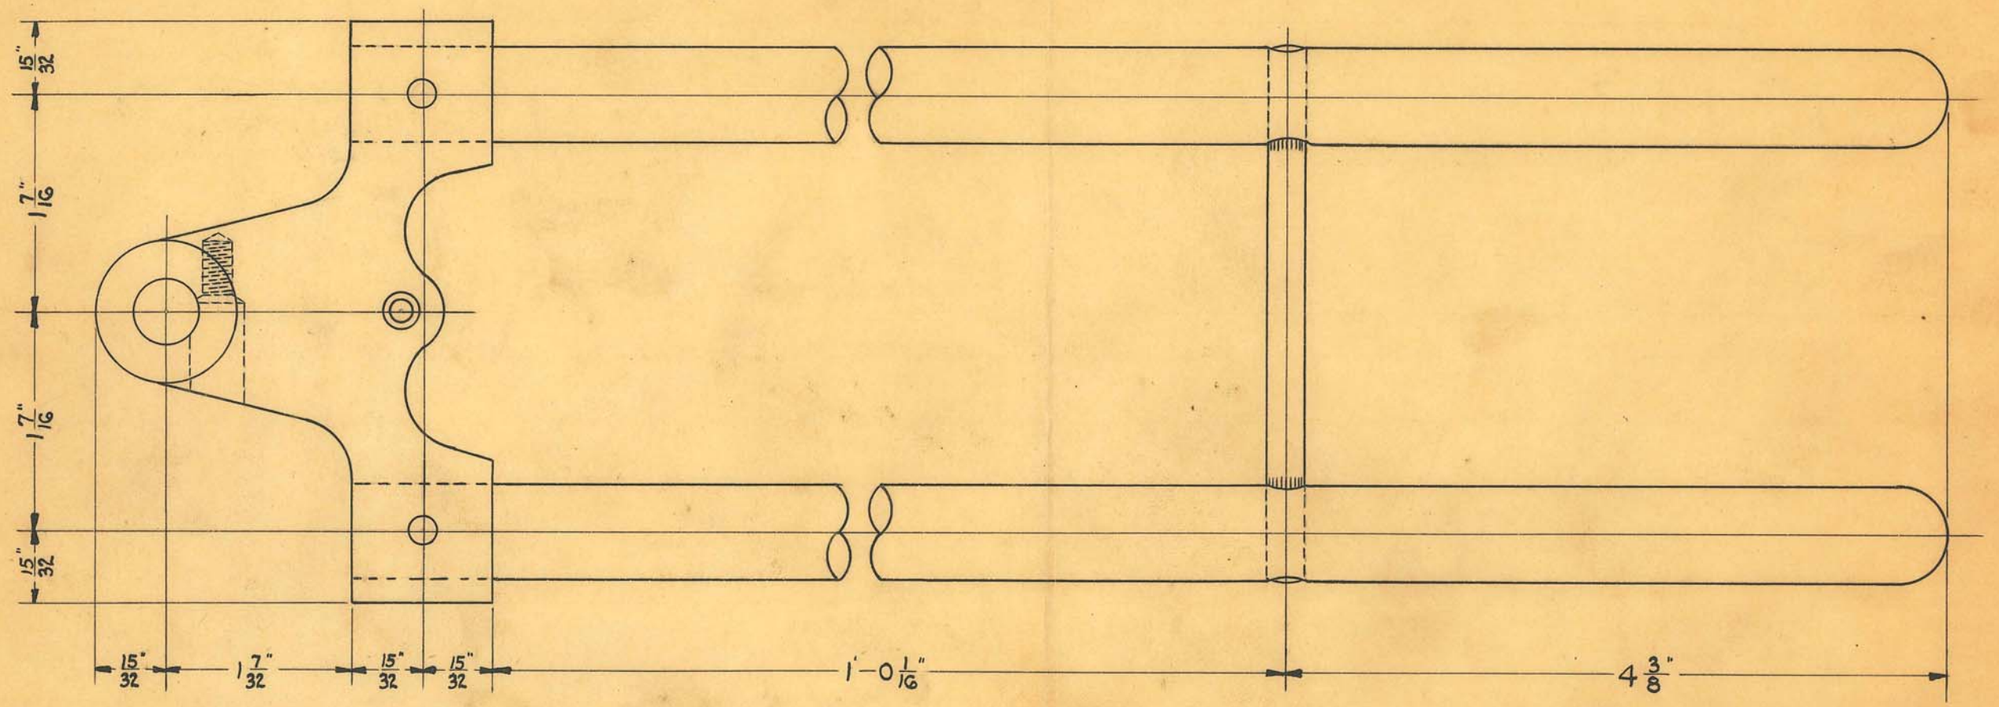

OBSOLETE

SIZE		ISSUE H.E.	11-14-29	TITLE: "DENTAL X" TUBE SLIDE COMPLETE
KIND		CHANGED		
SHAPE		" "		
FINISH		" "		
TEMP.		" "		
PATT.		" "		

H. G. FISCHER & CO.
2335 WABANSIA AVE.
CHICAGO, ILL.

CAT. NO.

PART NO. 6100(

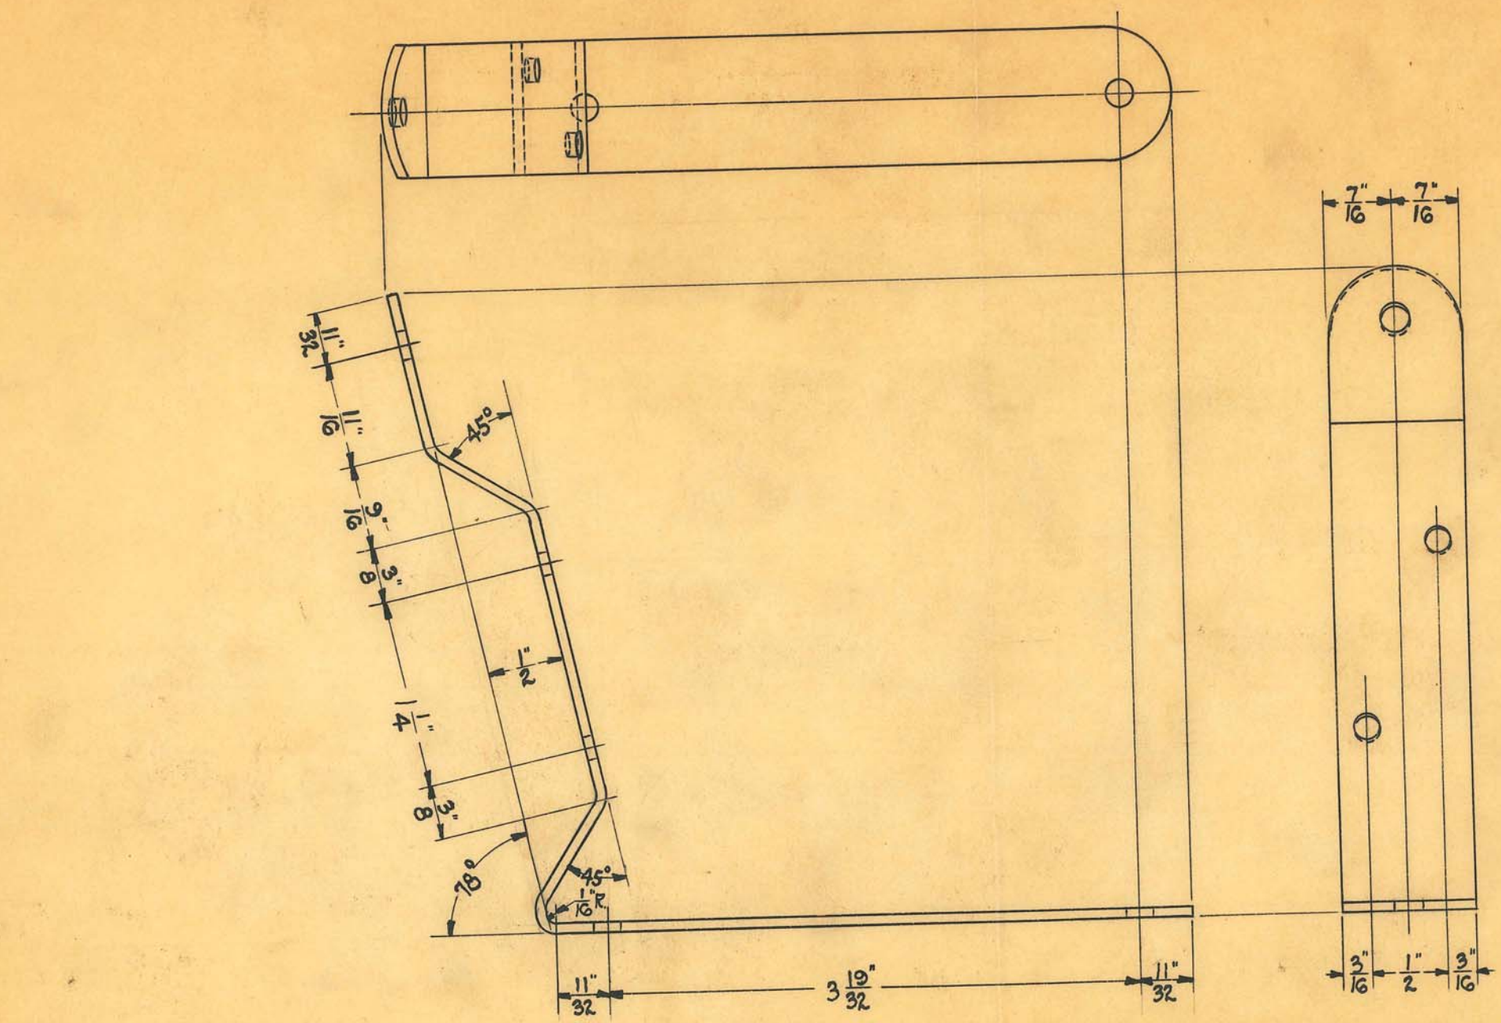

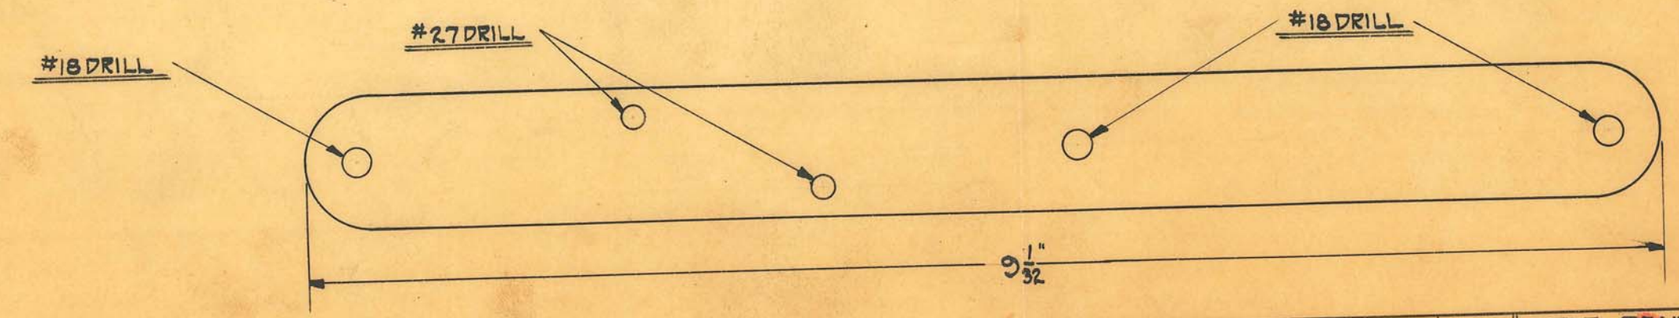

SIZE		ISSUE	H.E.	2-27-30
KIND		CHANGED		
SHAPE		" "		
FINISH	MAG. GRAIN	" "		
TEMP.		" "		
PATT.		" "		

TITLE: DENTAL ILLUMINATOR SUPPORTS

OBSOLETE

H. G. FISCHER & CO.
2335 WABANSIA AVE.
CHICAGO, ILL.

CAT. NO.

PART NO. 6453

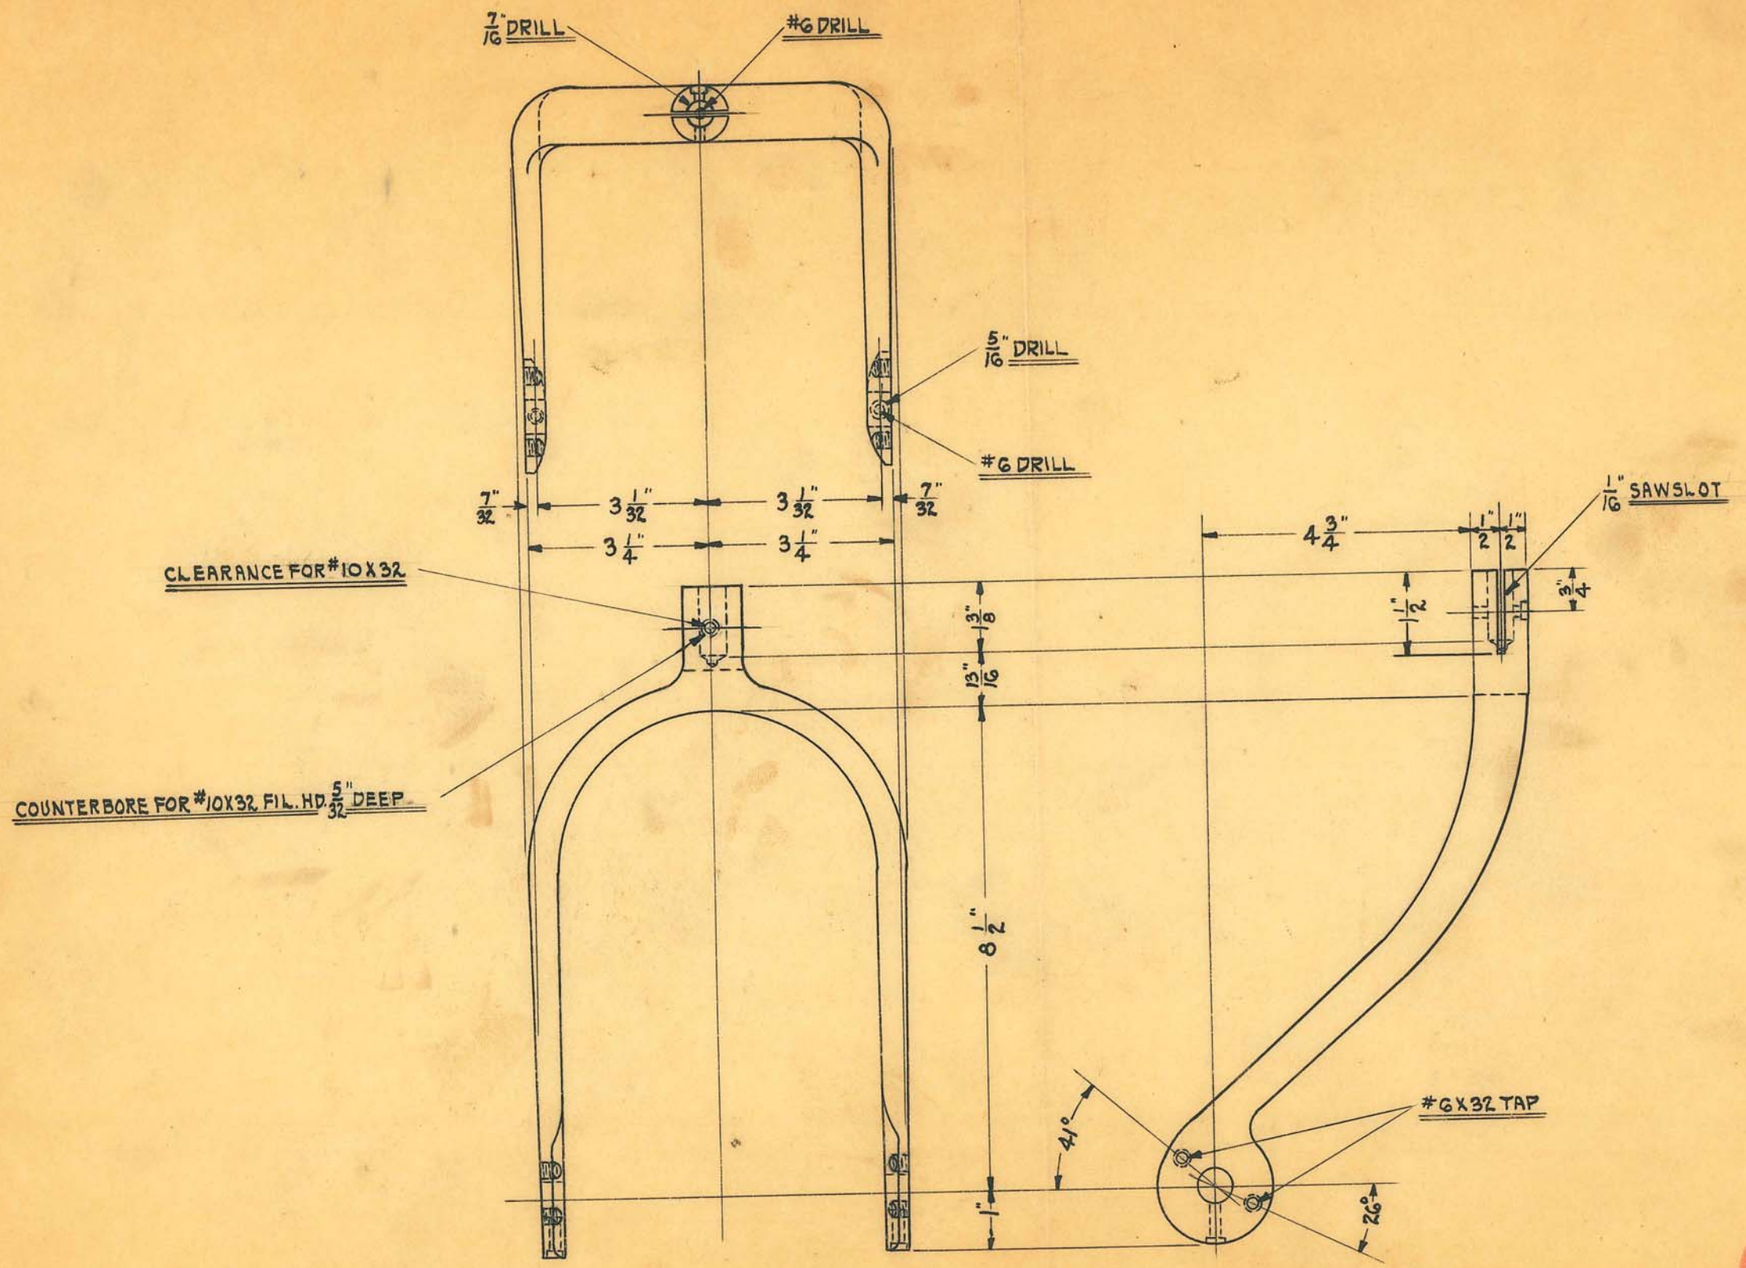

OBSOLETE

SIZE		ISSUE H.E.	12-27-29
KIND	ALUMINUM CASTING	CHANGED 3-1930	H.E.
SHAPE		" "	
FINISH	BUFFED	" "	
TEMP.		" "	
PART		" "	

TITLE: "DENTAL X" TUBE HEAD FORK

H. G. FISCHER & CO.
2335 WABANSIA AVE.
CHICAGO, ILL.

CAT. NO.

PART NO. 6115 FA

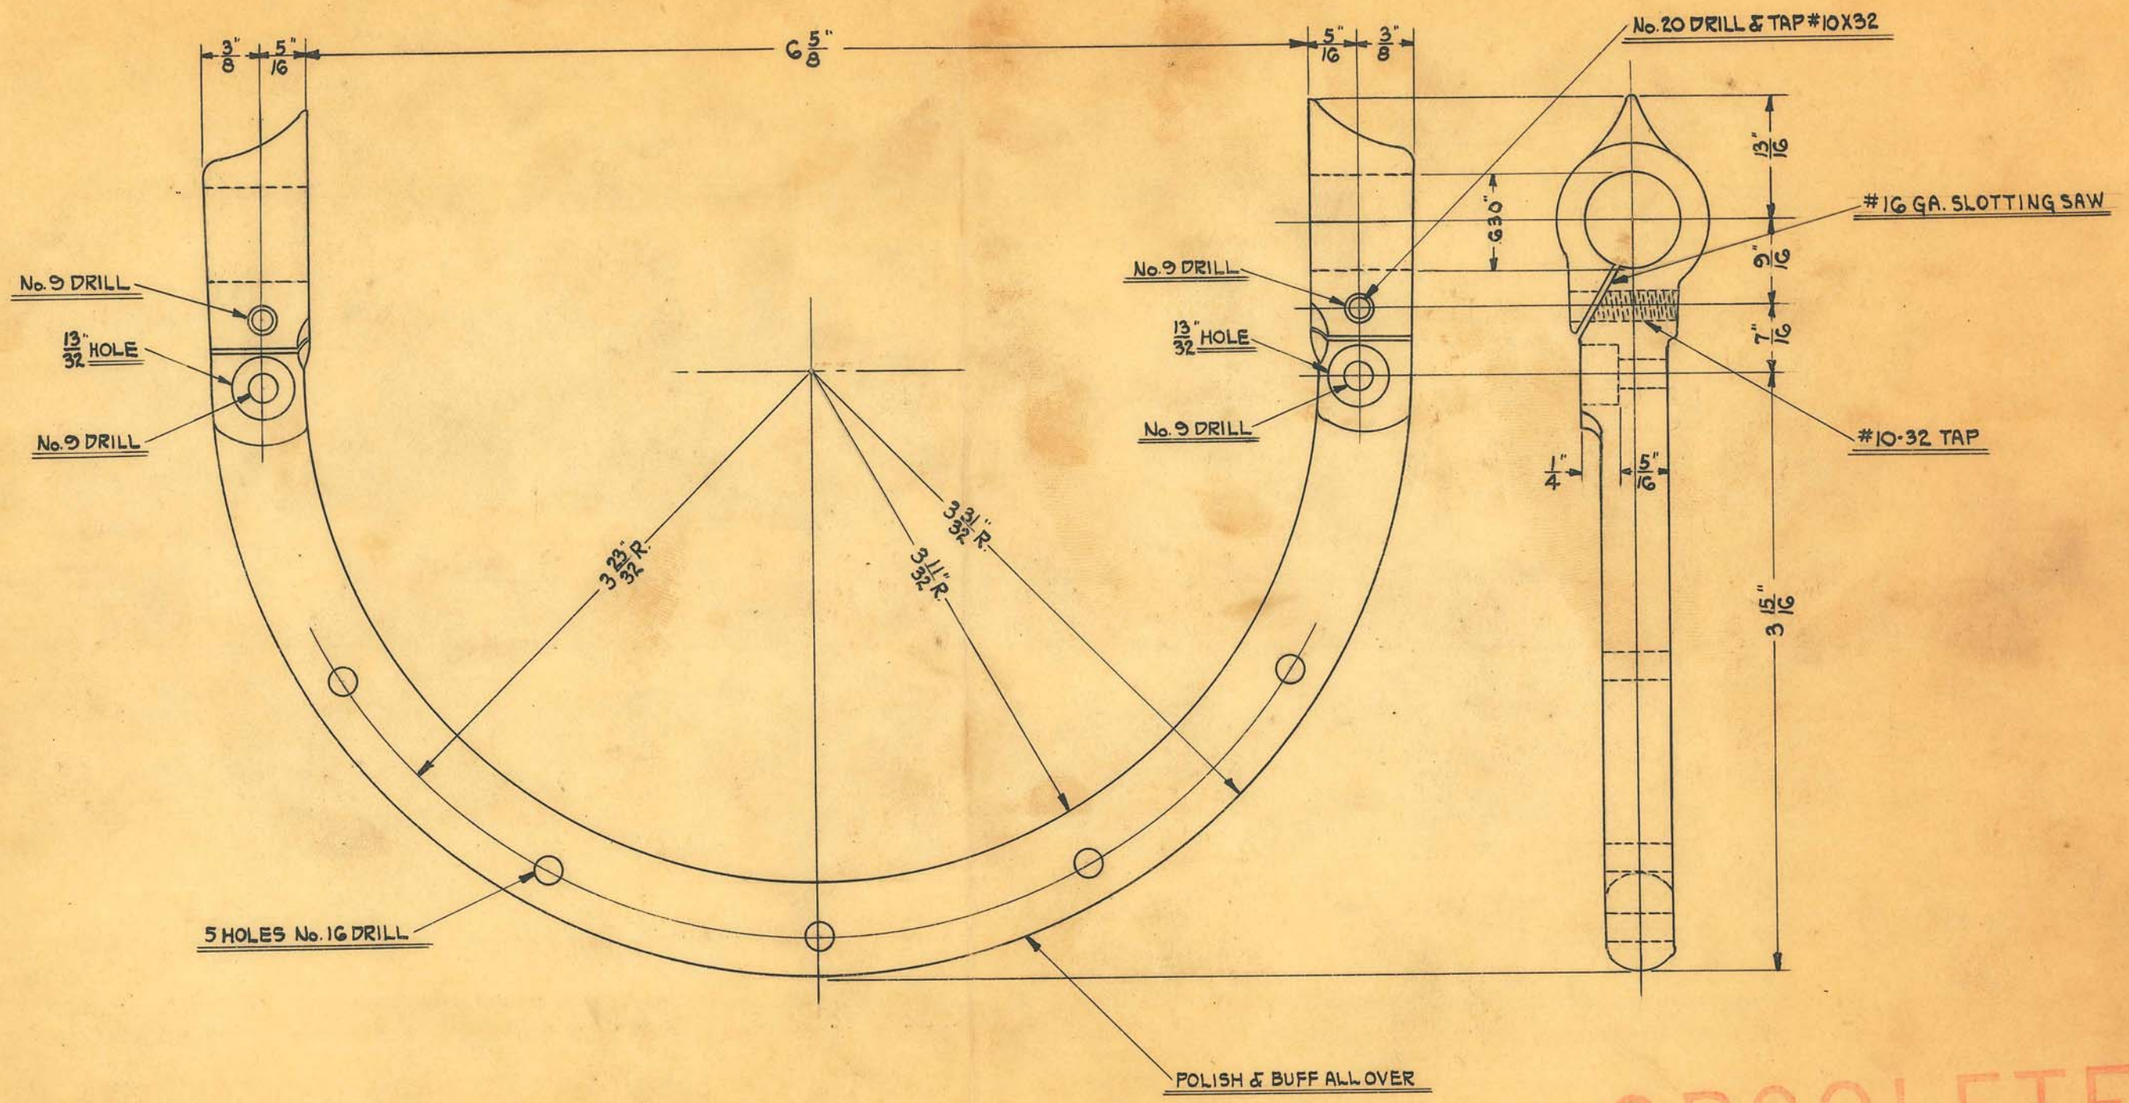

OBSOLETE

SIZE		ISSUE H.E.	11-23-29
KIND	ALUMINUM CASTING	CHANGED	
SHAPE		" "	
FINISH	BUFFED	" "	
TEMP.		" "	
DATE		" "	

TITLE: "DENTAL X" GAURD SUPPORT

H. G. FISCHER & CO.
2335 WABANSIA AVE.
CHICAGO, ILL.

CAT. NO.

PART NO. 6118FA

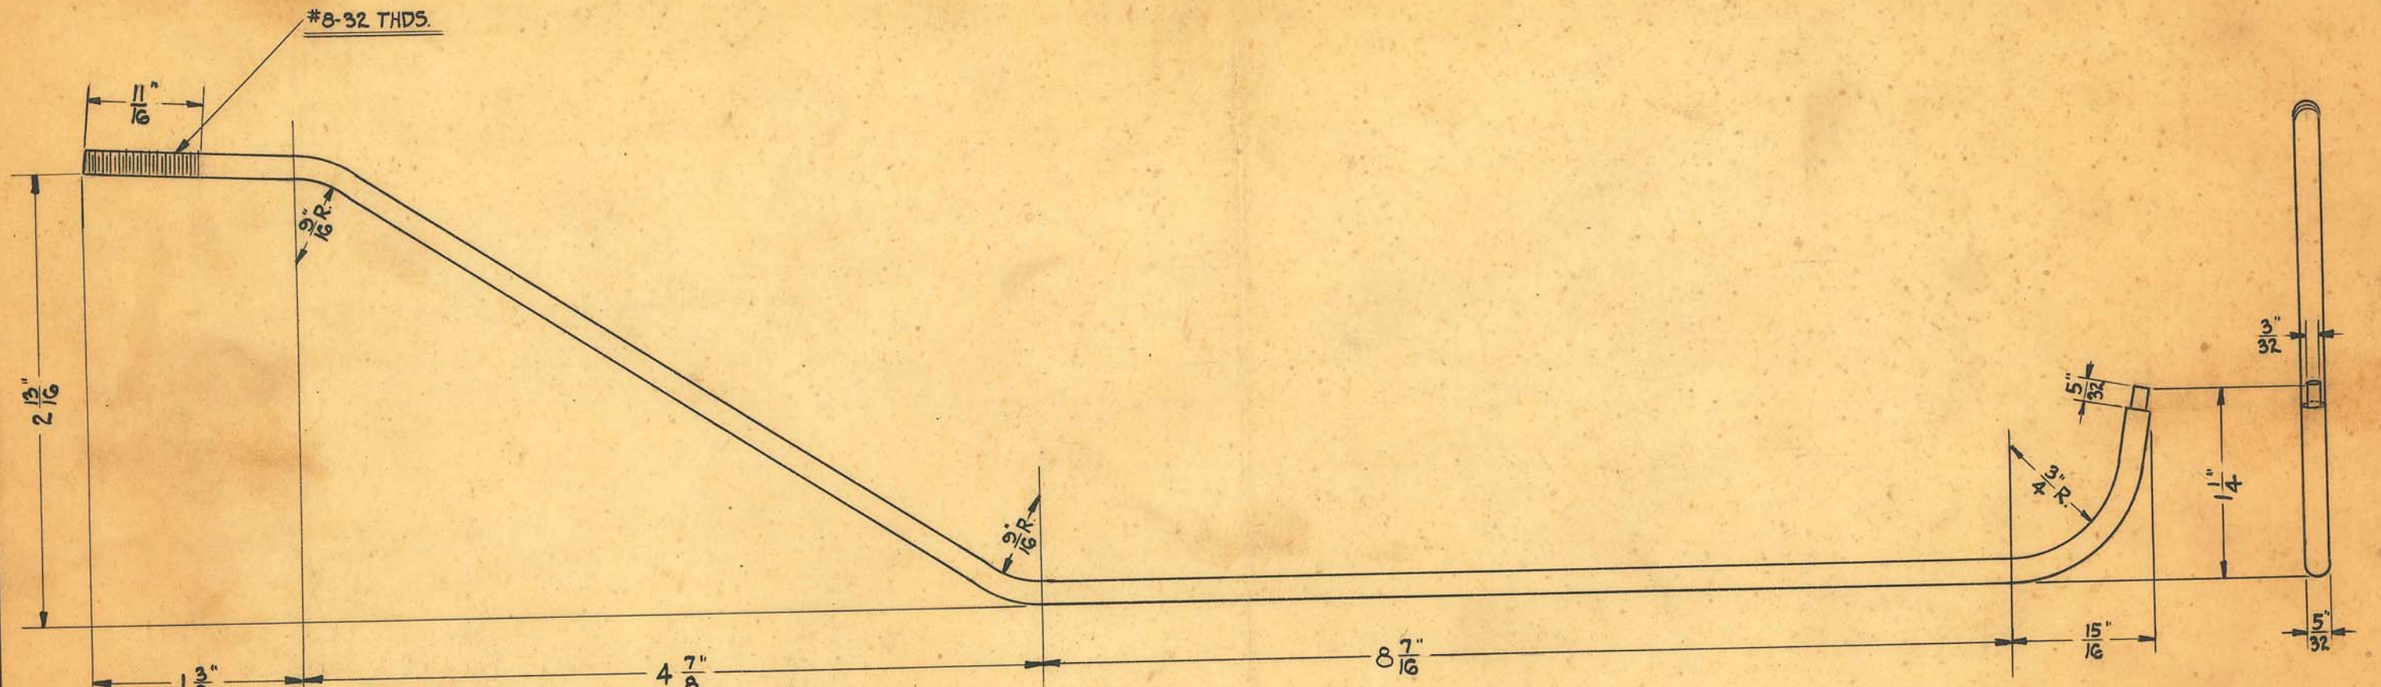

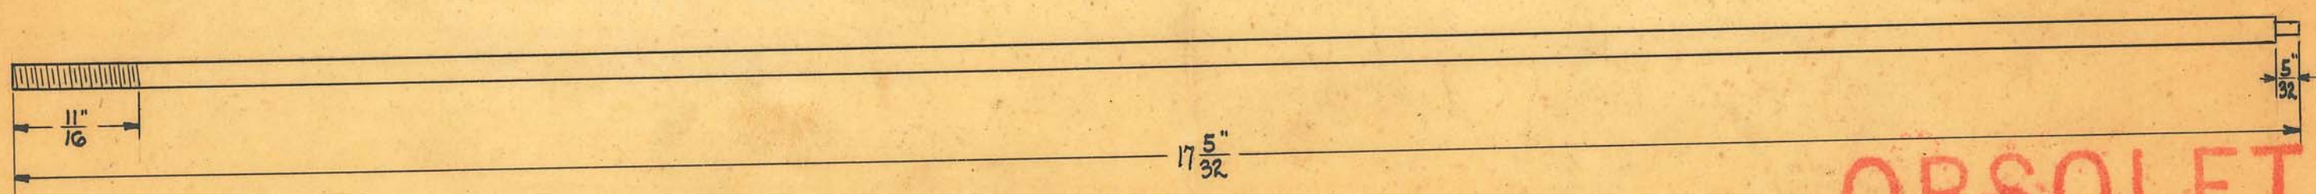

OBSOLETE

SIZE	5/32"	ISSUE H.E.	12-2-29
KIND	C.R. ROD	CHANGED	
SHAPE	ROUND	" "	
FINISH		" "	
TEMP.		" "	
PART		" "	

TITLE: "DENTAL X" GUARD ROD

H. G. FISCHER & CO.
2335 WABANSIA AVE.
CHICAGO, ILL.

CAT. NO.

PART NO. 6120A

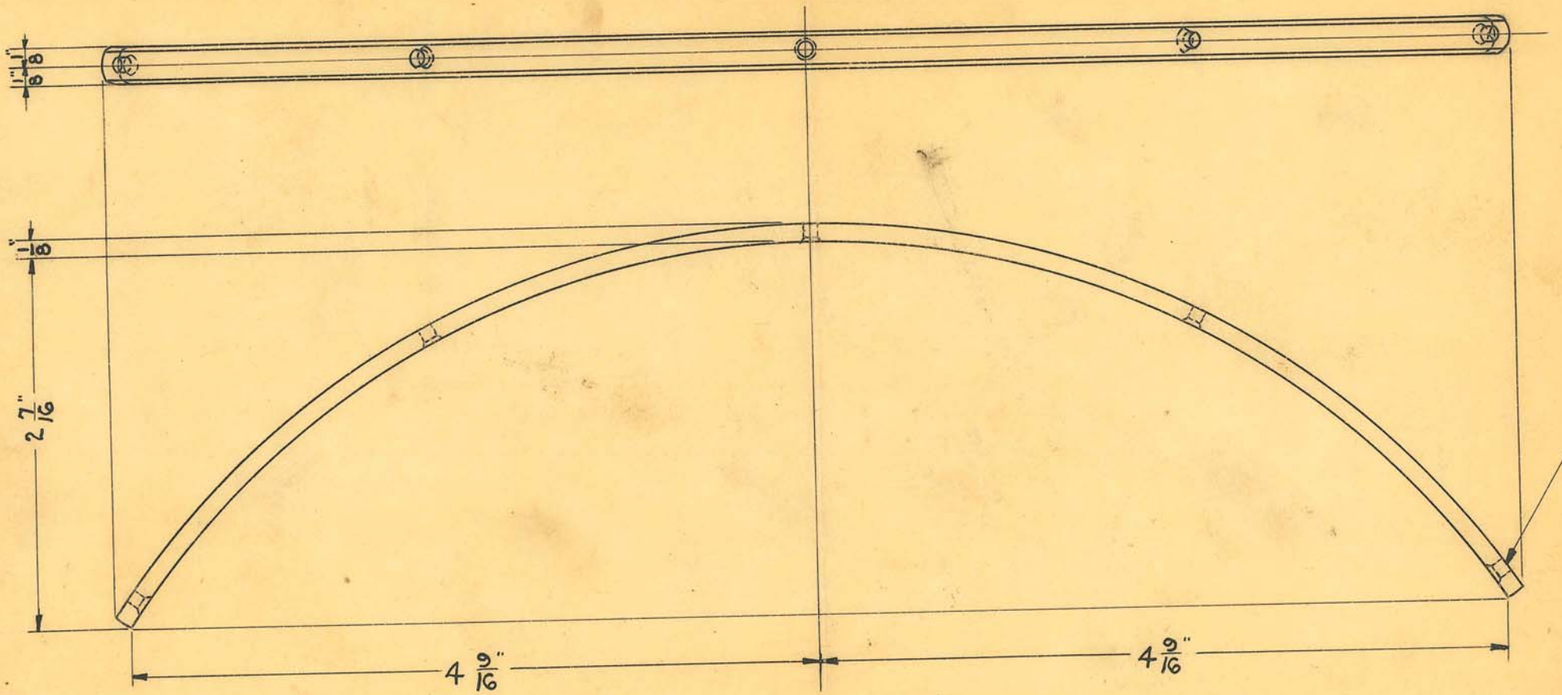

DRILL JIG No.2724
FORMING FIXTURE No.2723

OBSOLETE

SIZE	1/8" X 1/4"	ISSUE	H.E.	11-27-29
KIND	R.E.C.R.	CHANGED		
SHAPE	STRIP	"	"	
FINISH		"	"	
TEMP.		"	"	
PATT.		"	"	

TITLE: "DENTAL X" SMALL CURVED STRIP

H. G. FISCHER & CO.
2335 WABANSIA AVE.
CHICAGO, ILL.

CAT. NO.

PART NO. 6121

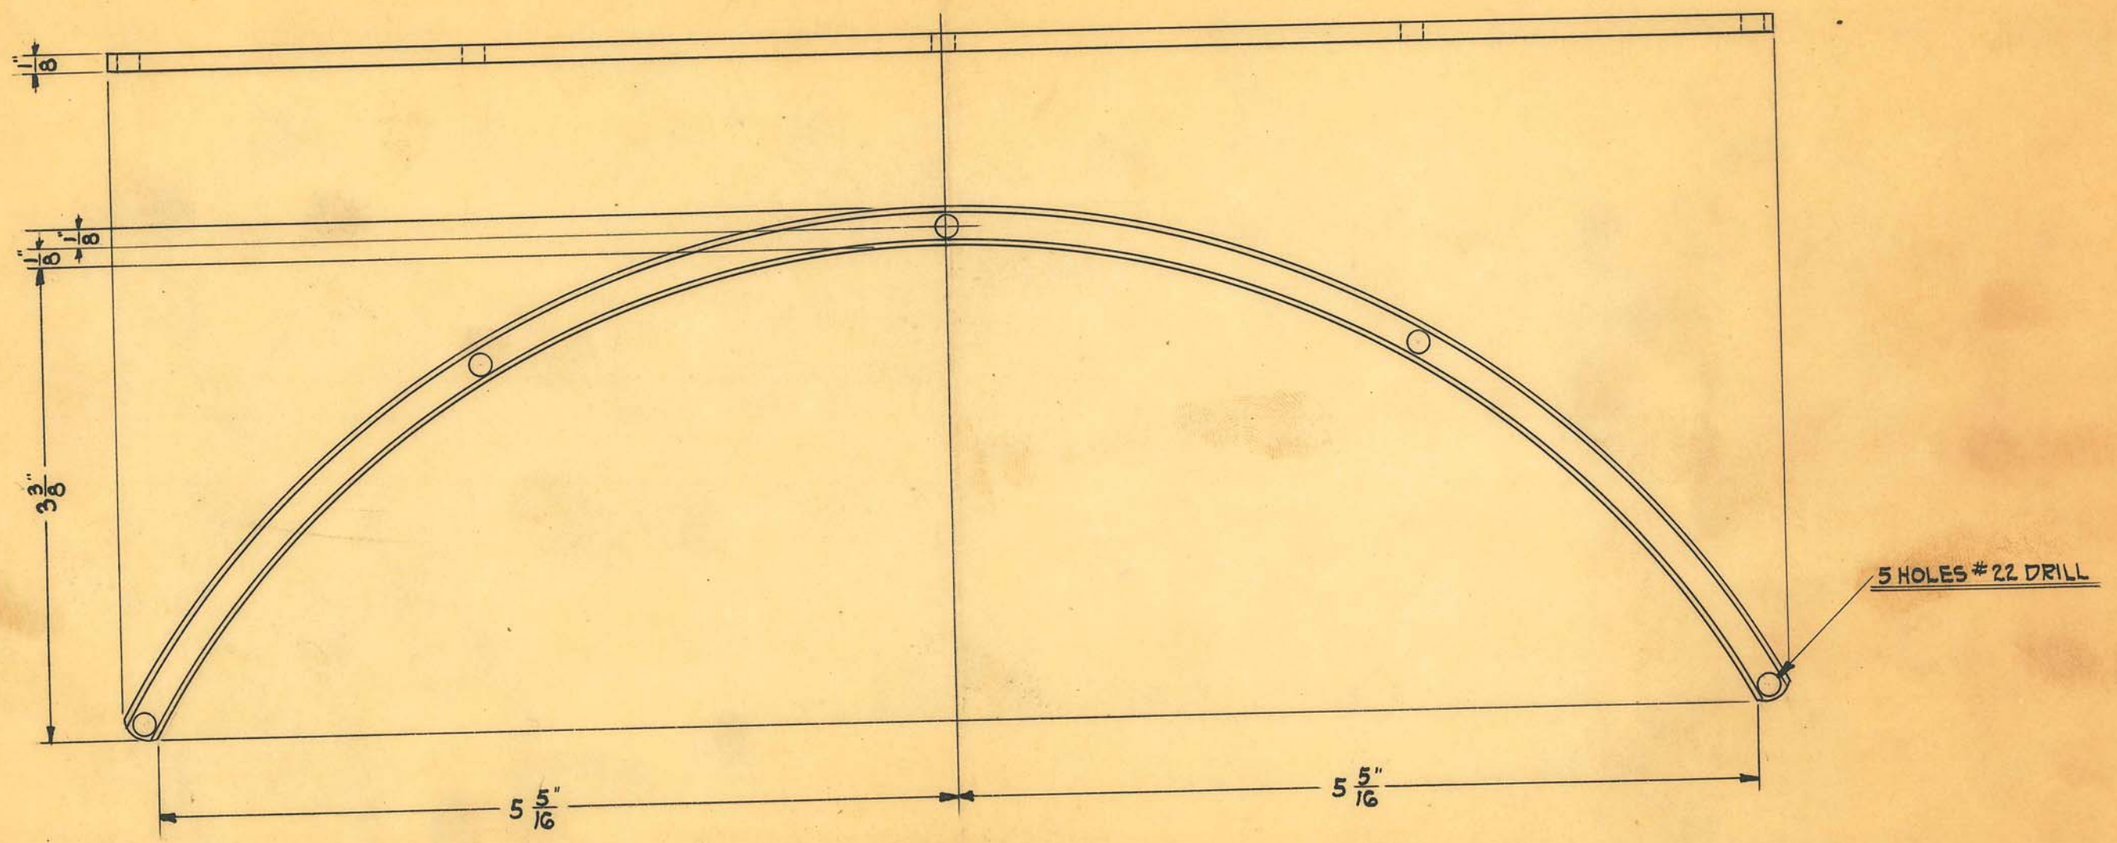

FORMING DIE #2723
DRILL JIG #2722

OBSOLETE

SIZE	1/8 X 1/4	ISSUE	H.E.	1-30-30
KIND	R.E. COLD ROLLED	CHANGED		
SHAPE	STRIP	"	"	
FINISH		"	"	
TEMP.		"	"	
PATT.		"	"	

TITLE: "DENTAL X" LARGE CURVED STRIP

H. G. FISCHER & CO.
2335 WABANSIA AVE.
CHICAGO, ILL.

CAT. NO.

PART NO. 6122

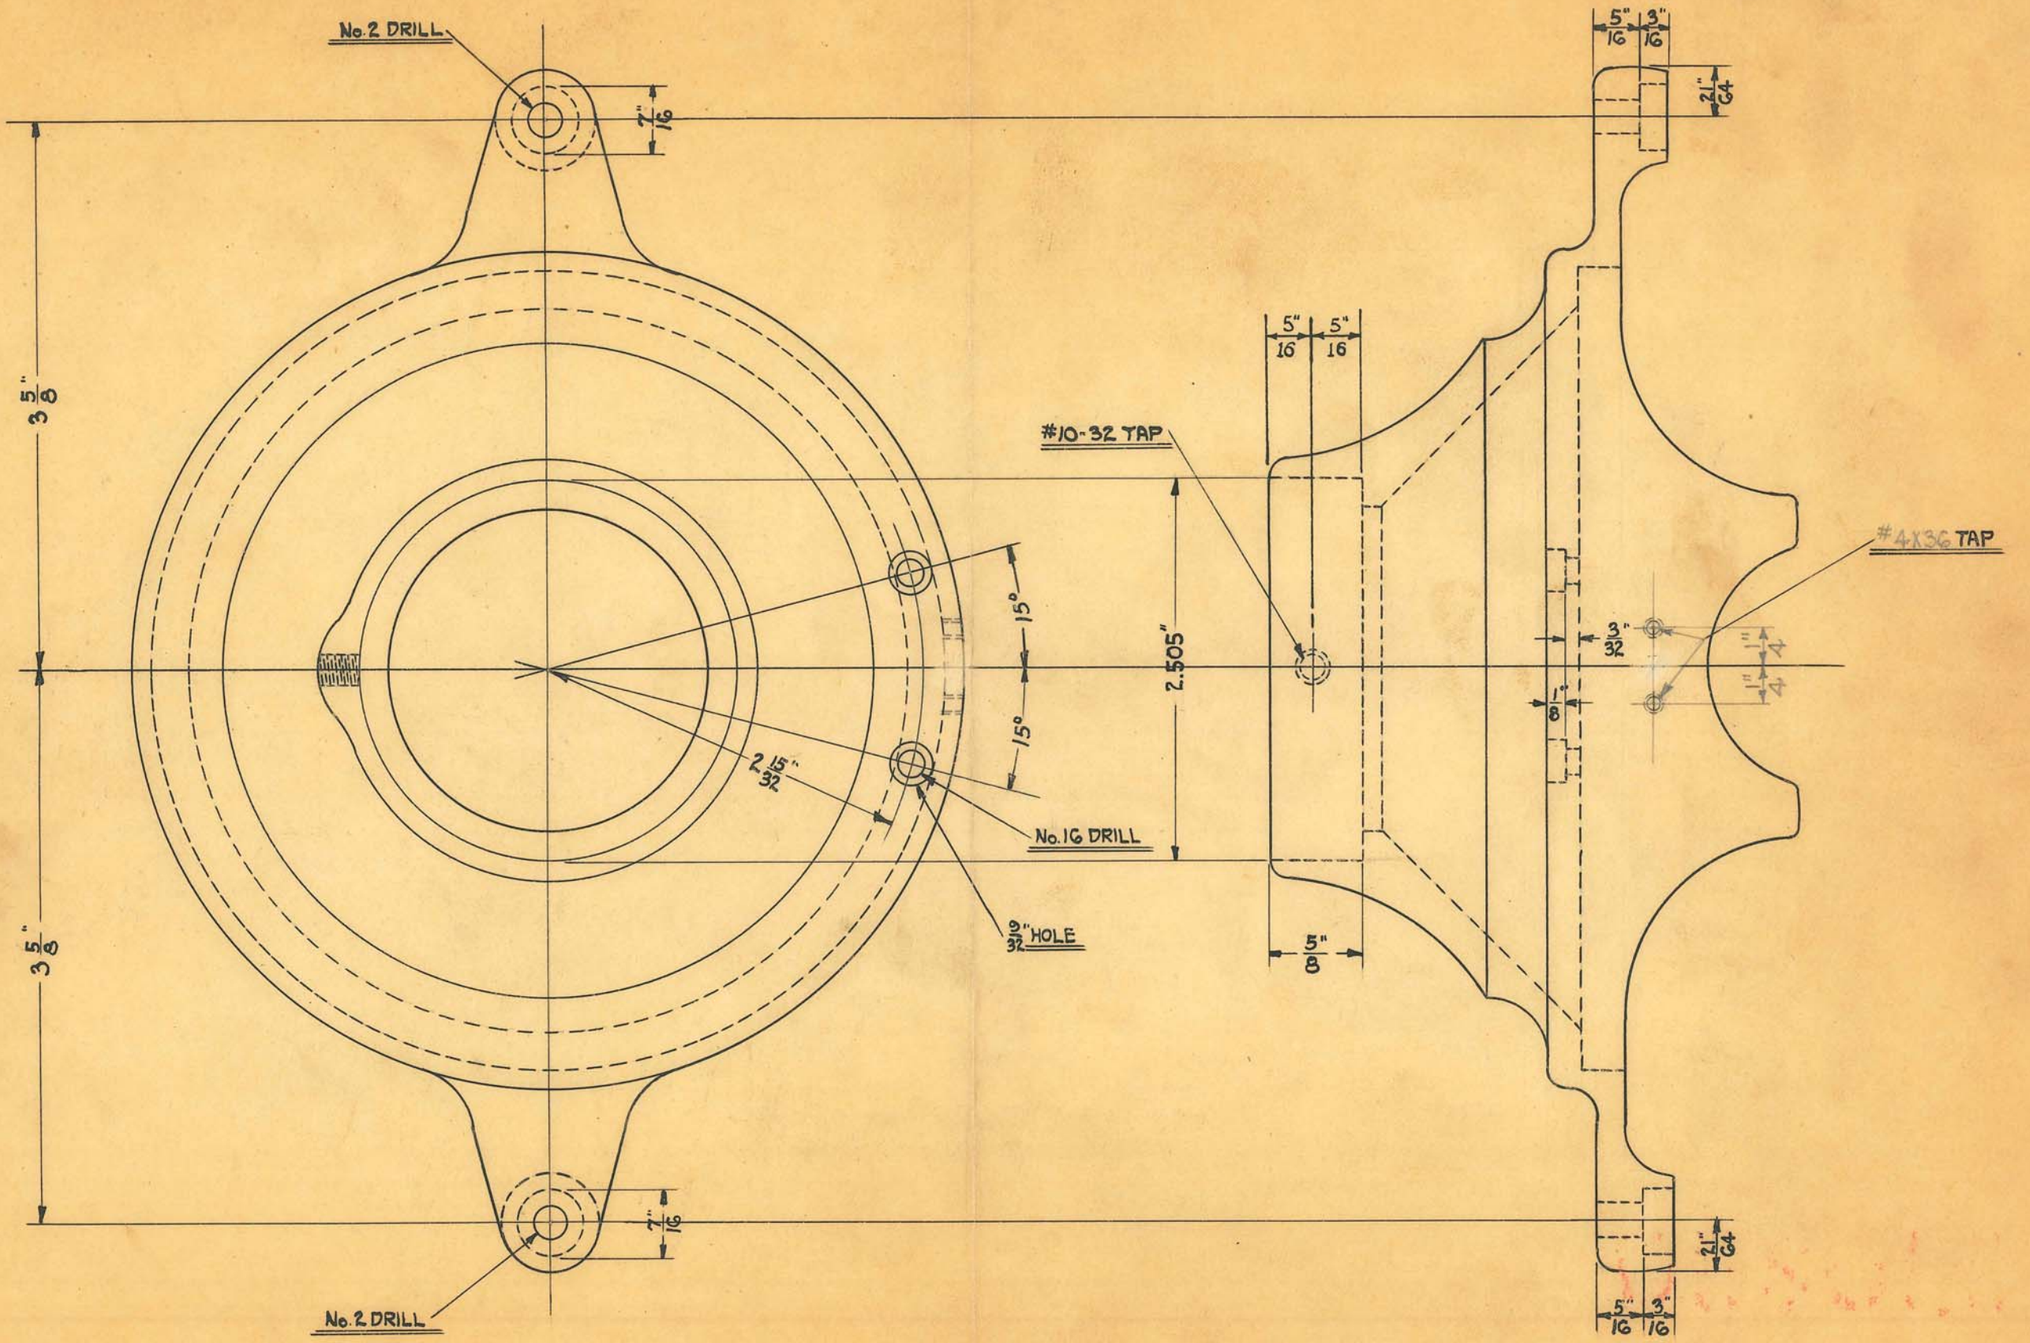

SIZE		ISSUE H.E.	12-3-29	TITLE: "DENTAL X" TUBE SHIELD FLANGE
KIND	ALUMINUM CASTING	CHANGED		OBSOLETE
SHAPE		" "		
FINISH	BUFFED	" "		H. G. FISCHER & CO. 2335 WABANSIA AVE. CHICAGO, ILL. — CAT. NO. — PART NO. 6123F
TEMP.		" "		
PATT.		" "		

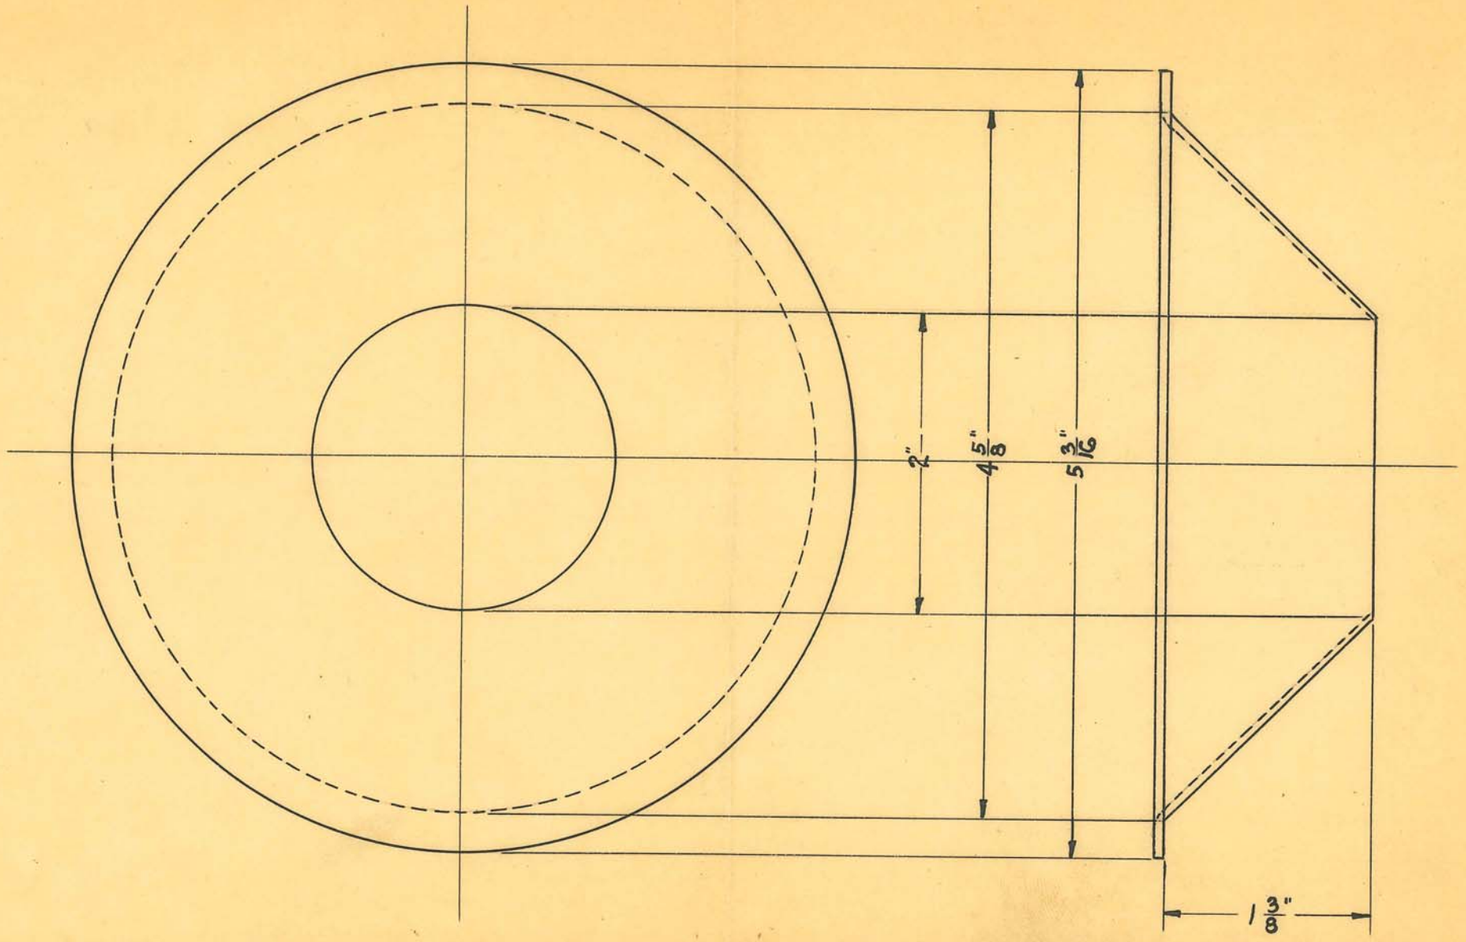

FORMING DIE No. 2929

OBSOLETE

SIZE	1/16"	ISSUE	H.E.	12-3-29
KIND	SHEET LEAD	CHANGED		
SHAPE	SHEET	" "		
FINISH		" "		
TEMP.		" "		
PATT.		" "		

TITLE: "DENTAL X" TUBE SHIELD FLANGE LEAD LINNER.

H. G. FISCHER & CO.
2335 WABANSIA AVE.
CHICAGO, ILL.

CAT. NO.

PART NO. 6124

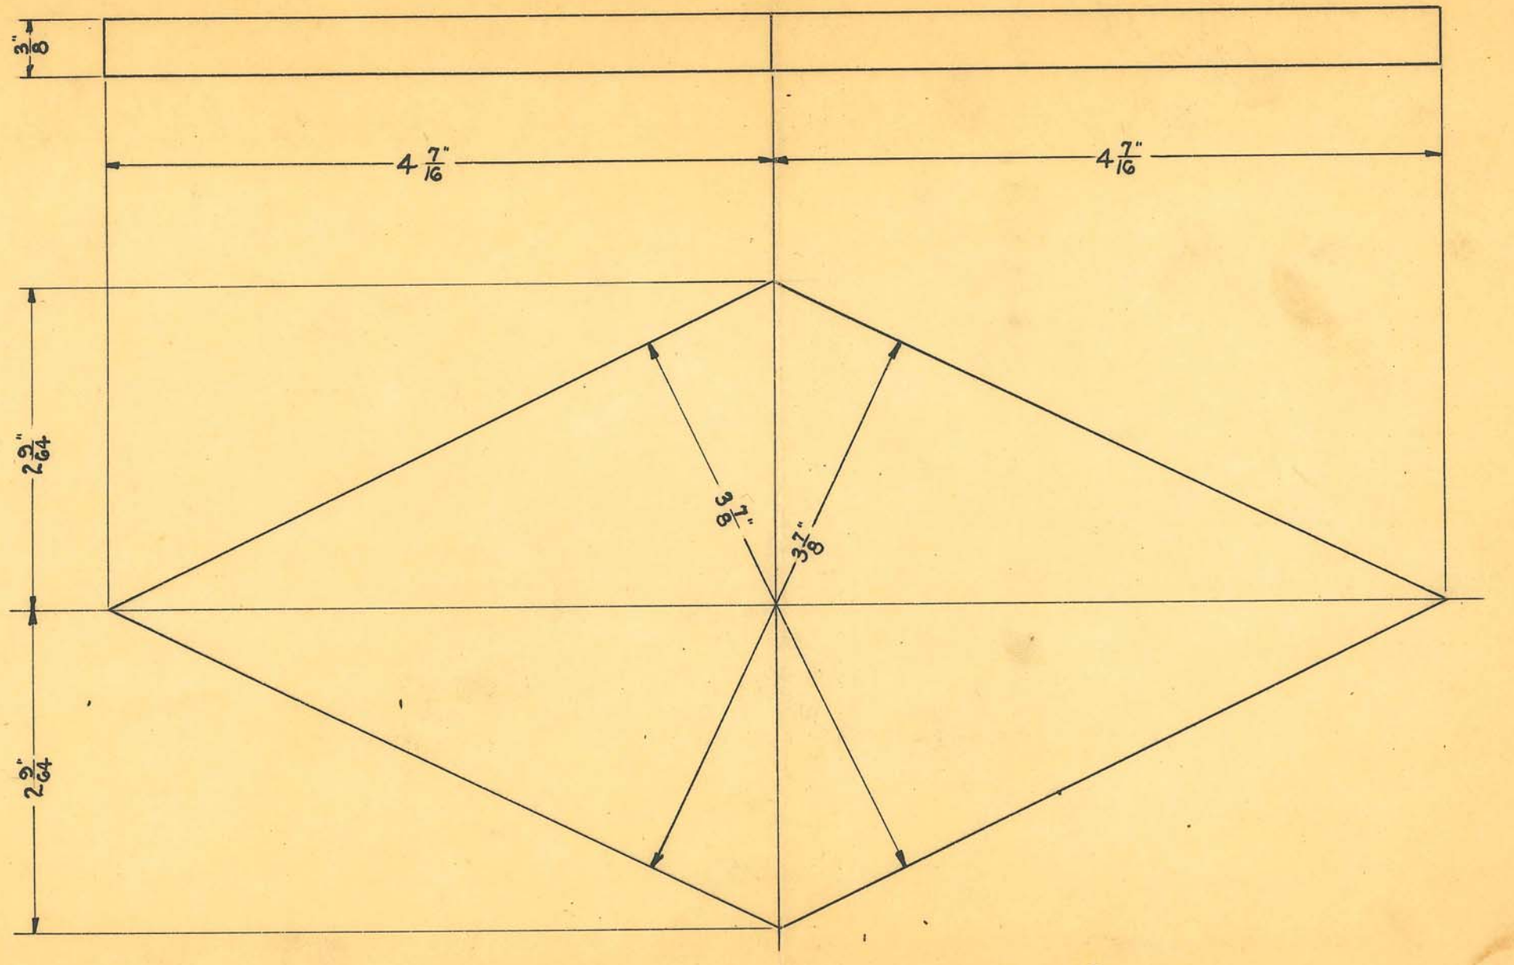

OBSOLETE

SIZE	3/8"	ISSUE H.E.	12-10-29	TITLE: "DENTAL X "SHIELD CLAMP
KIND	BLACK FIBRE	CHANGED		
SHAPE		" "		
FINISH		" "		
TEMP.		" "		H. G. FISCHER & CO. 2335 WABANSIA AVE. CHICAGO, ILL. — CAT. NO. — PART NO. 6131
PATT.		" "		

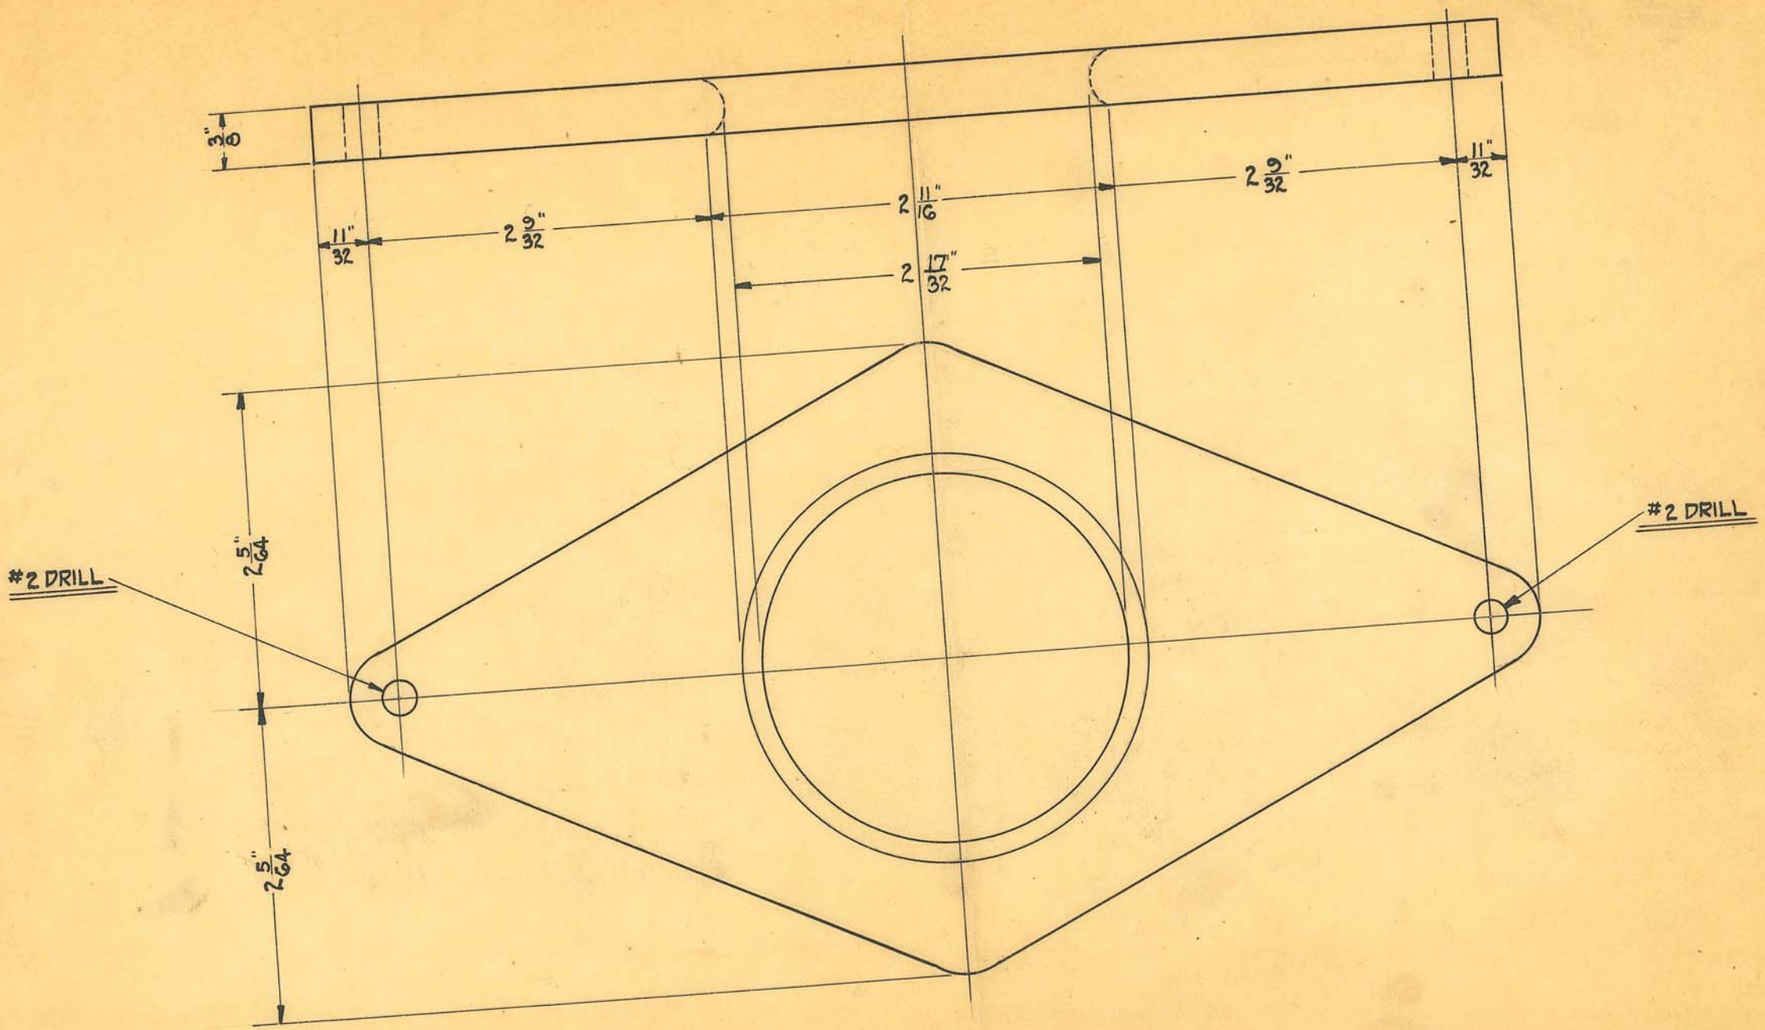

OBSOLETE

SIZE	3/8"	ISSUE	H.E.	12-9-29
KIND	BLACK FIBRE	CHANGED		
SHAPE		" "		
FINISH	EMERY FIN.	" "		
TEMP.		" "		
PATT.		" "		

TITLE: "DENTAL X" FIBRE SHIELD CLAMP FINISHED

H. G. FISCHER & CO.
2335 WABANSIA AVE.
CHICAGO, ILL.

CAT. NO.

PART NO. 6131F

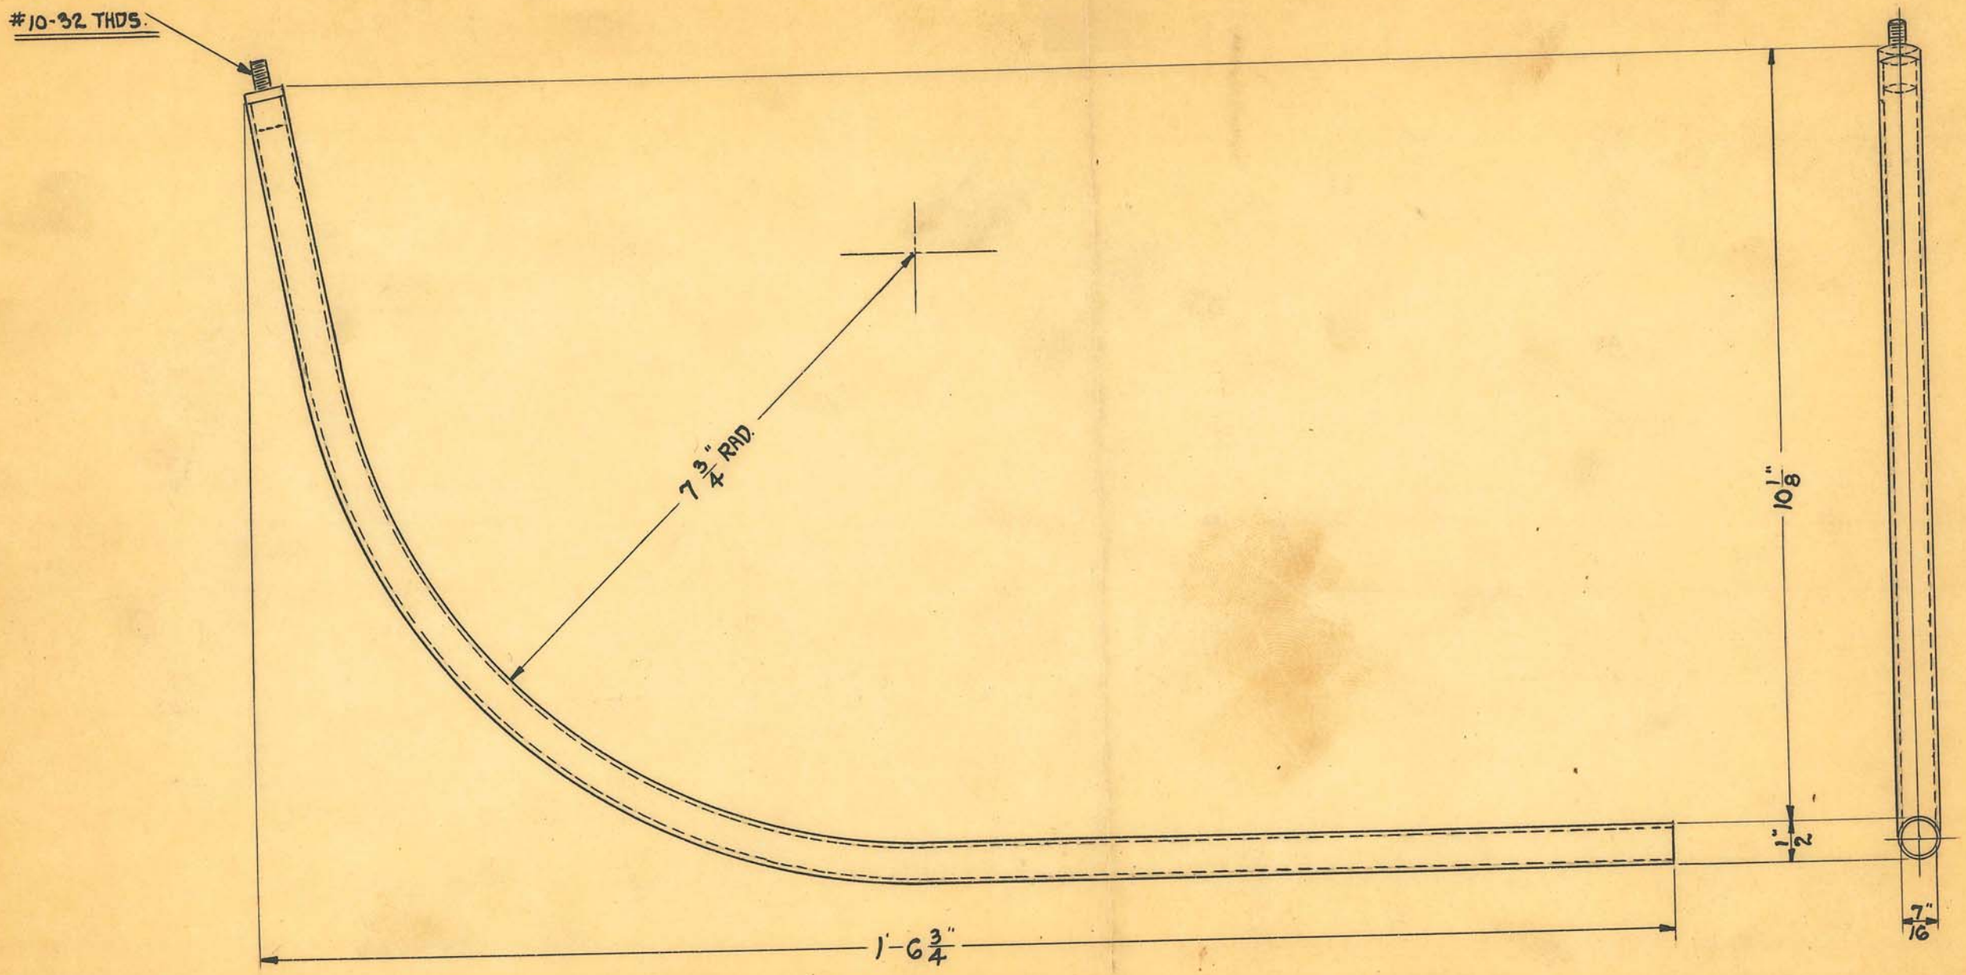

SCALE ~ 1/2 SIZE

OBSOLETE

SIZE		ISSUE H.E.	12-12-29	TITLE: "DENTAL X" CORD REEL SUPPORT COMPLETE
KIND		CHANGED		
SHAPE		" "		
FINISH	~~POLISHED & PLATED~~	" "		
~~TEMP.~~	CHROME #2	" "		H. G. FISCHER & CO. 2335 WABANSIA AVE. CHICAGO, ILL.
PATT. #		" "		CAT. NO.
				PART NO. 6135G

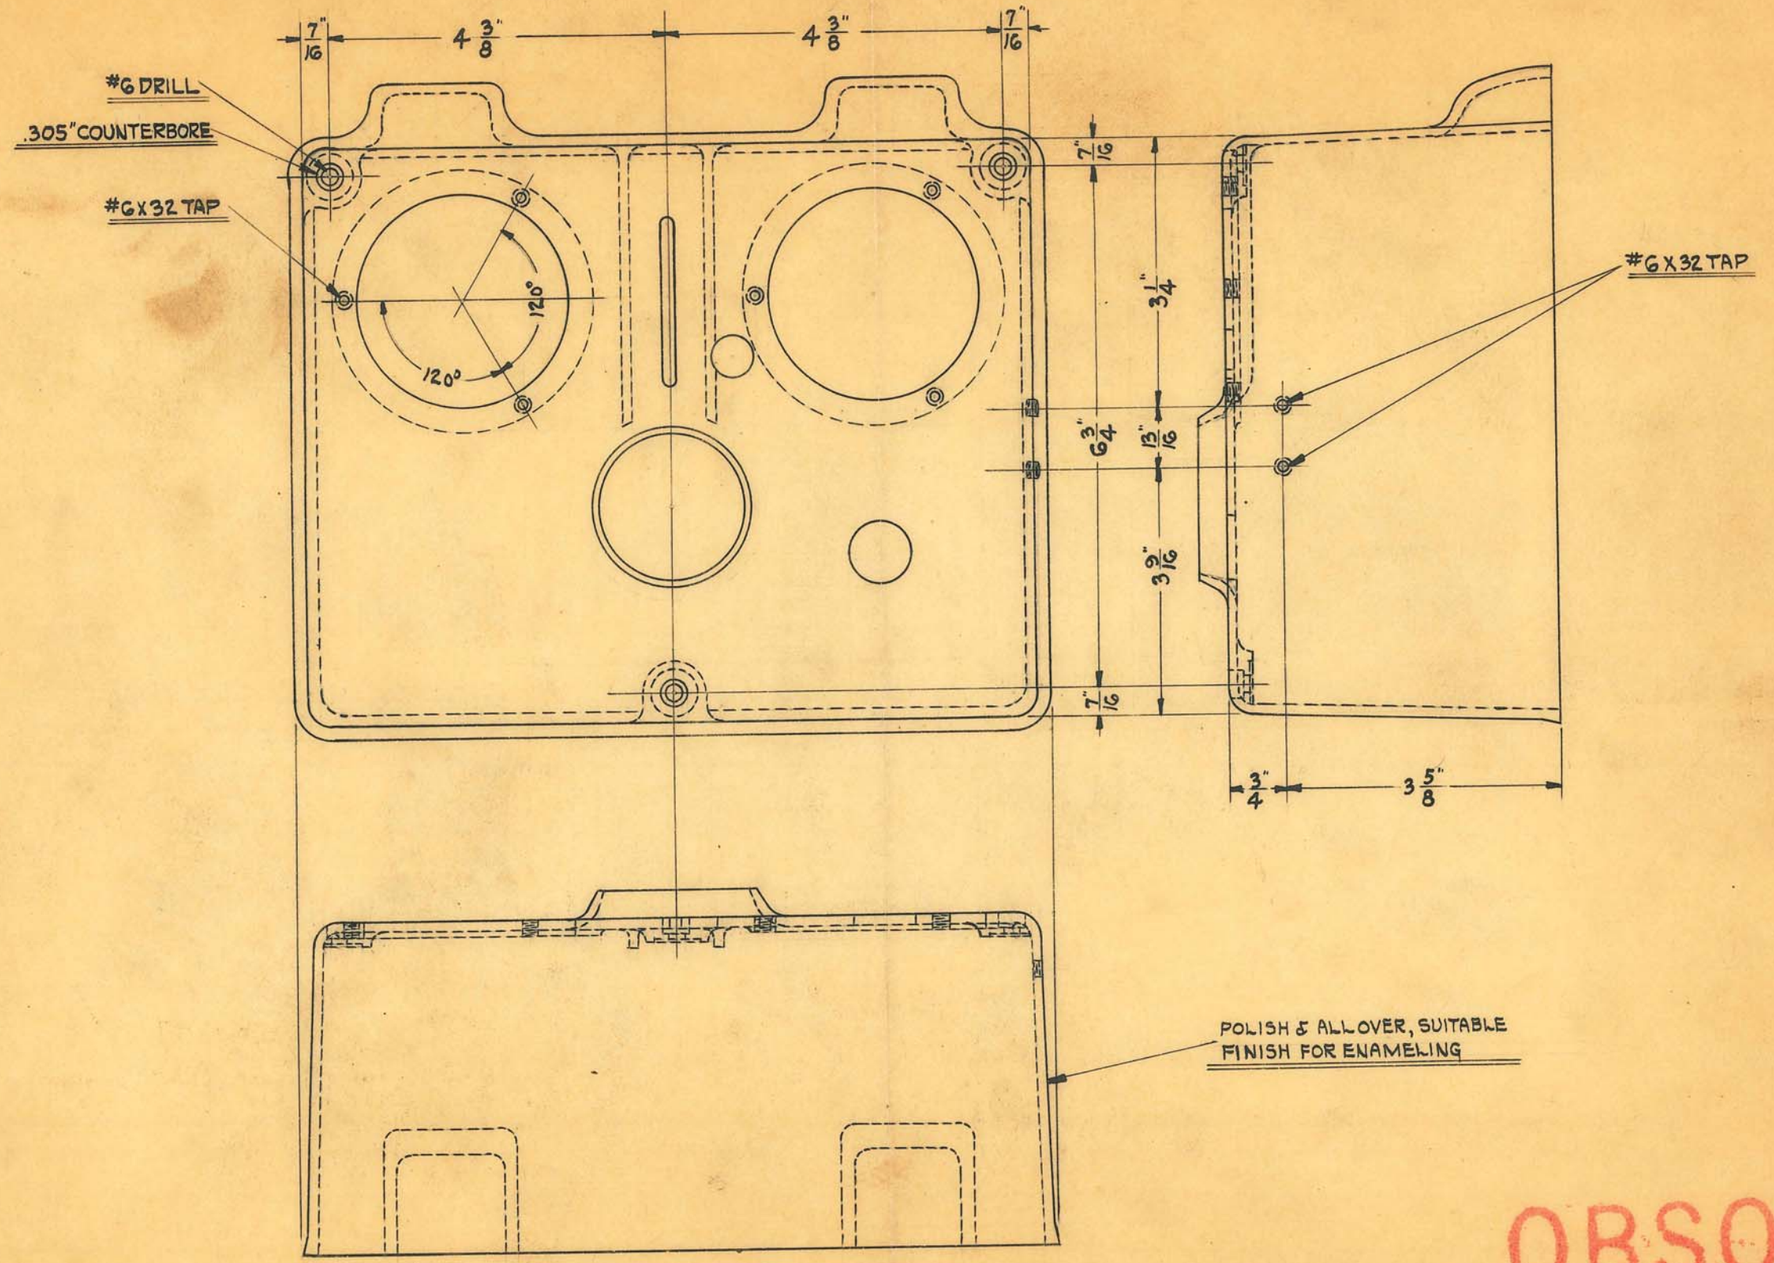

OBSOLETE

SCALE ~ 1/2 SIZE

SIZE		ISSUE H.E.	12-23-29
KIND	ALUMINUM CASTING	CHANGED	
SHAPE		" "	
FINISH	MAH. GRAIN	" "	
TEMP.		" "	
PATT.		" "	

TITLE: "DENTAL X" HOUSING

H. G. FISCHER & CO.
2335 WABANSIA AVE.
CHICAGO, ILL.

CAT. NO.

PART NO. 6150F

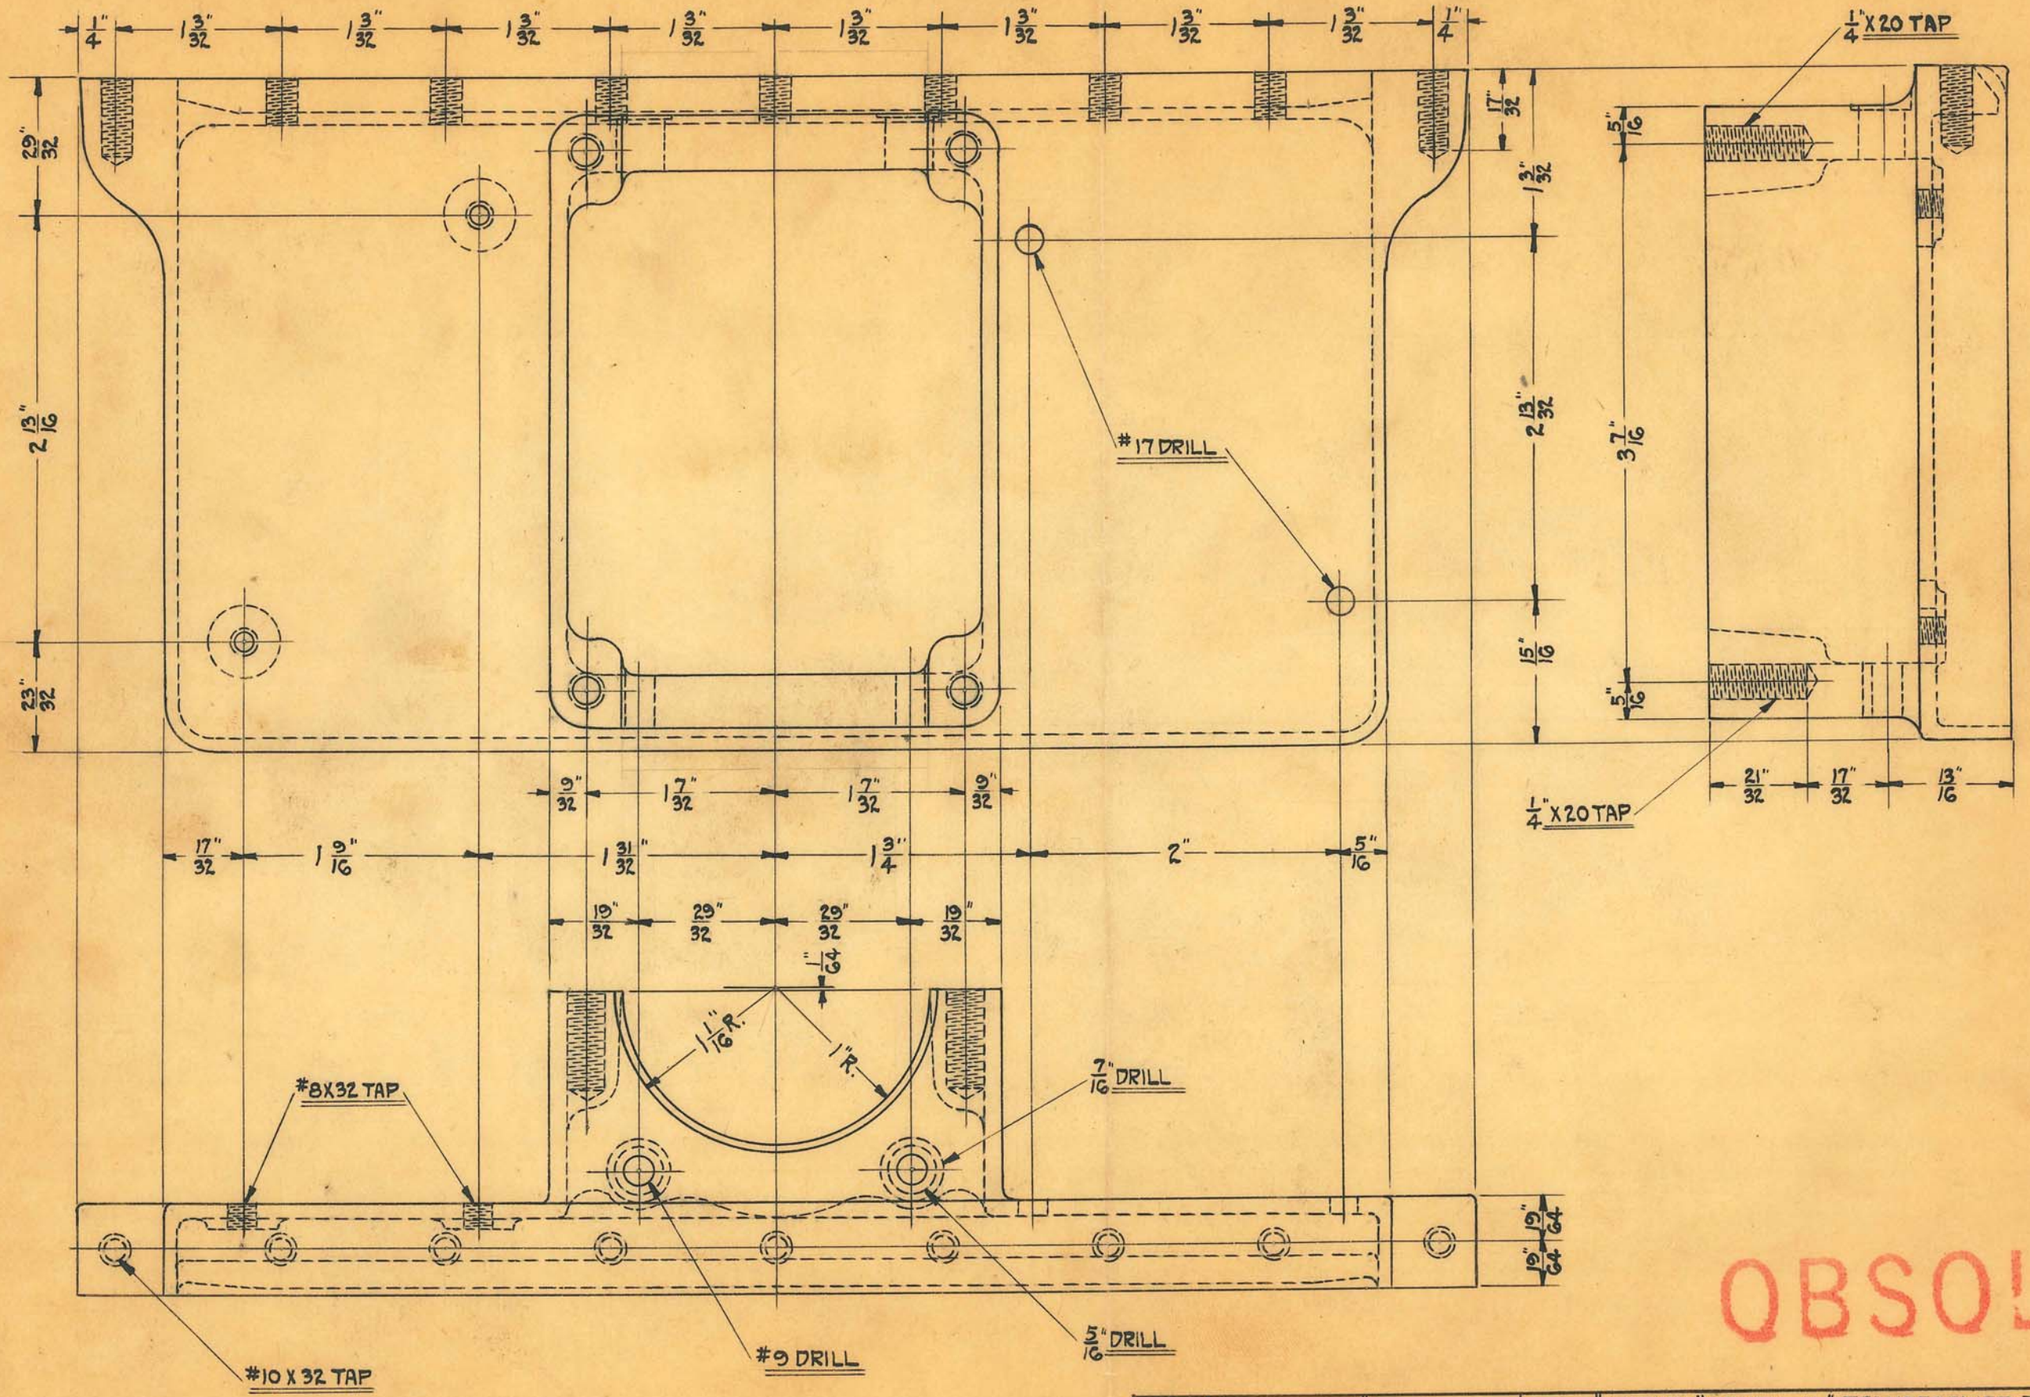

OBSOLETE

SIZE		ISSUE H.E.	12-20-29
KIND	ALUMINUM CASTING	CHANGED H.E.	9-11-30
SHAPE		" "	
FINISH	MAH. GRAIN	" "	
TEMP.		" "	

TITLE: "DENTAL X" TRANSFORMER TANK SUPPORT

H. G. FISCHER & CO.
2335 WABANSIA AVE.
CHICAGO, ILL.

CAT. NO.

PART NO. 6151 FAB

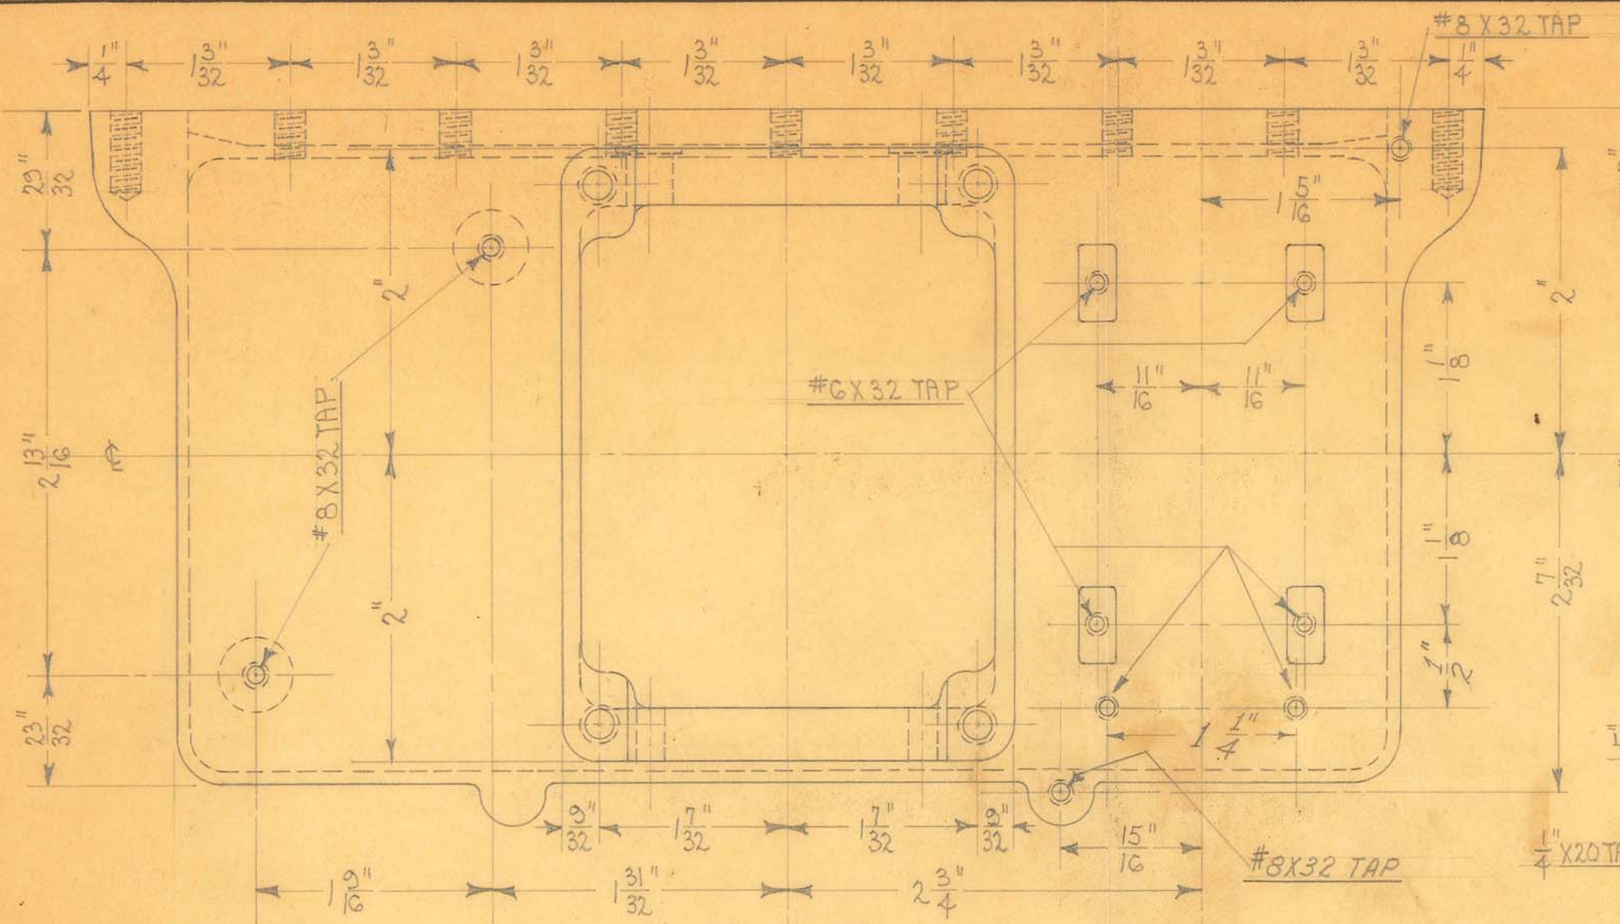

OBSOLETE

SIZE		ISSUE 8-26-35	A.E.
KIND	ALUM. CASTING	CHANGED 1-19-37	J.W.
SHAPE		" "	
FINISH	MAH. GRAIN	" "	
TEMP.		" "	

TITLE: DENTAL "X" TRANSFORMER TANK SUPPORT

H. G. FISCHER & CO.
2335 WABANSIA AVE.

CAT. NO.

PART NO. G151DEA

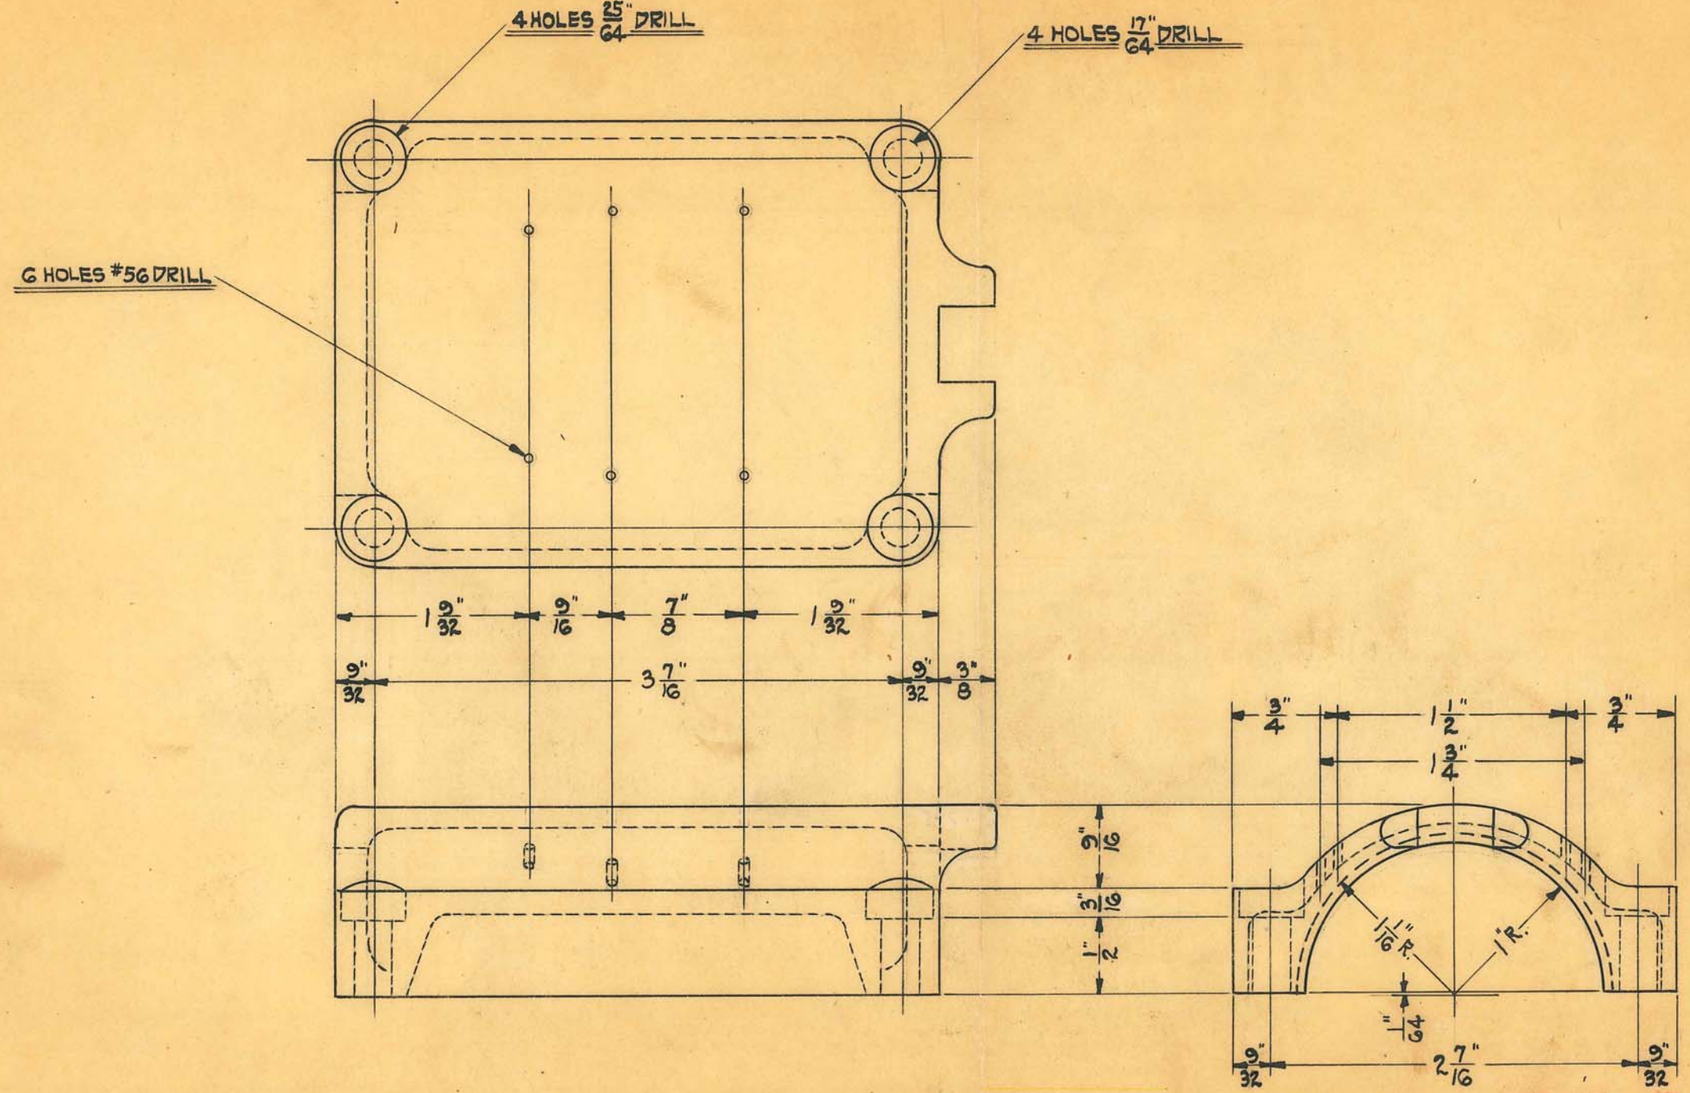

OBSOLETE

SIZE		ISSUE H.E.	1-28-30	TITLE: "DENTAL X" TRANSFORMER TANK SUPPORT CLAMP
KIND	ALUM. CASTING	CHANGED A. B	9-11-30	
SHAPE		" "		
FINISH	POL & MAH. GRAIN	" "		
TEMP.		" "		

H. G. FISCHER & CO.
2335 WABANSIA AVE.

CAT. NO.

PART NO. G152FAB

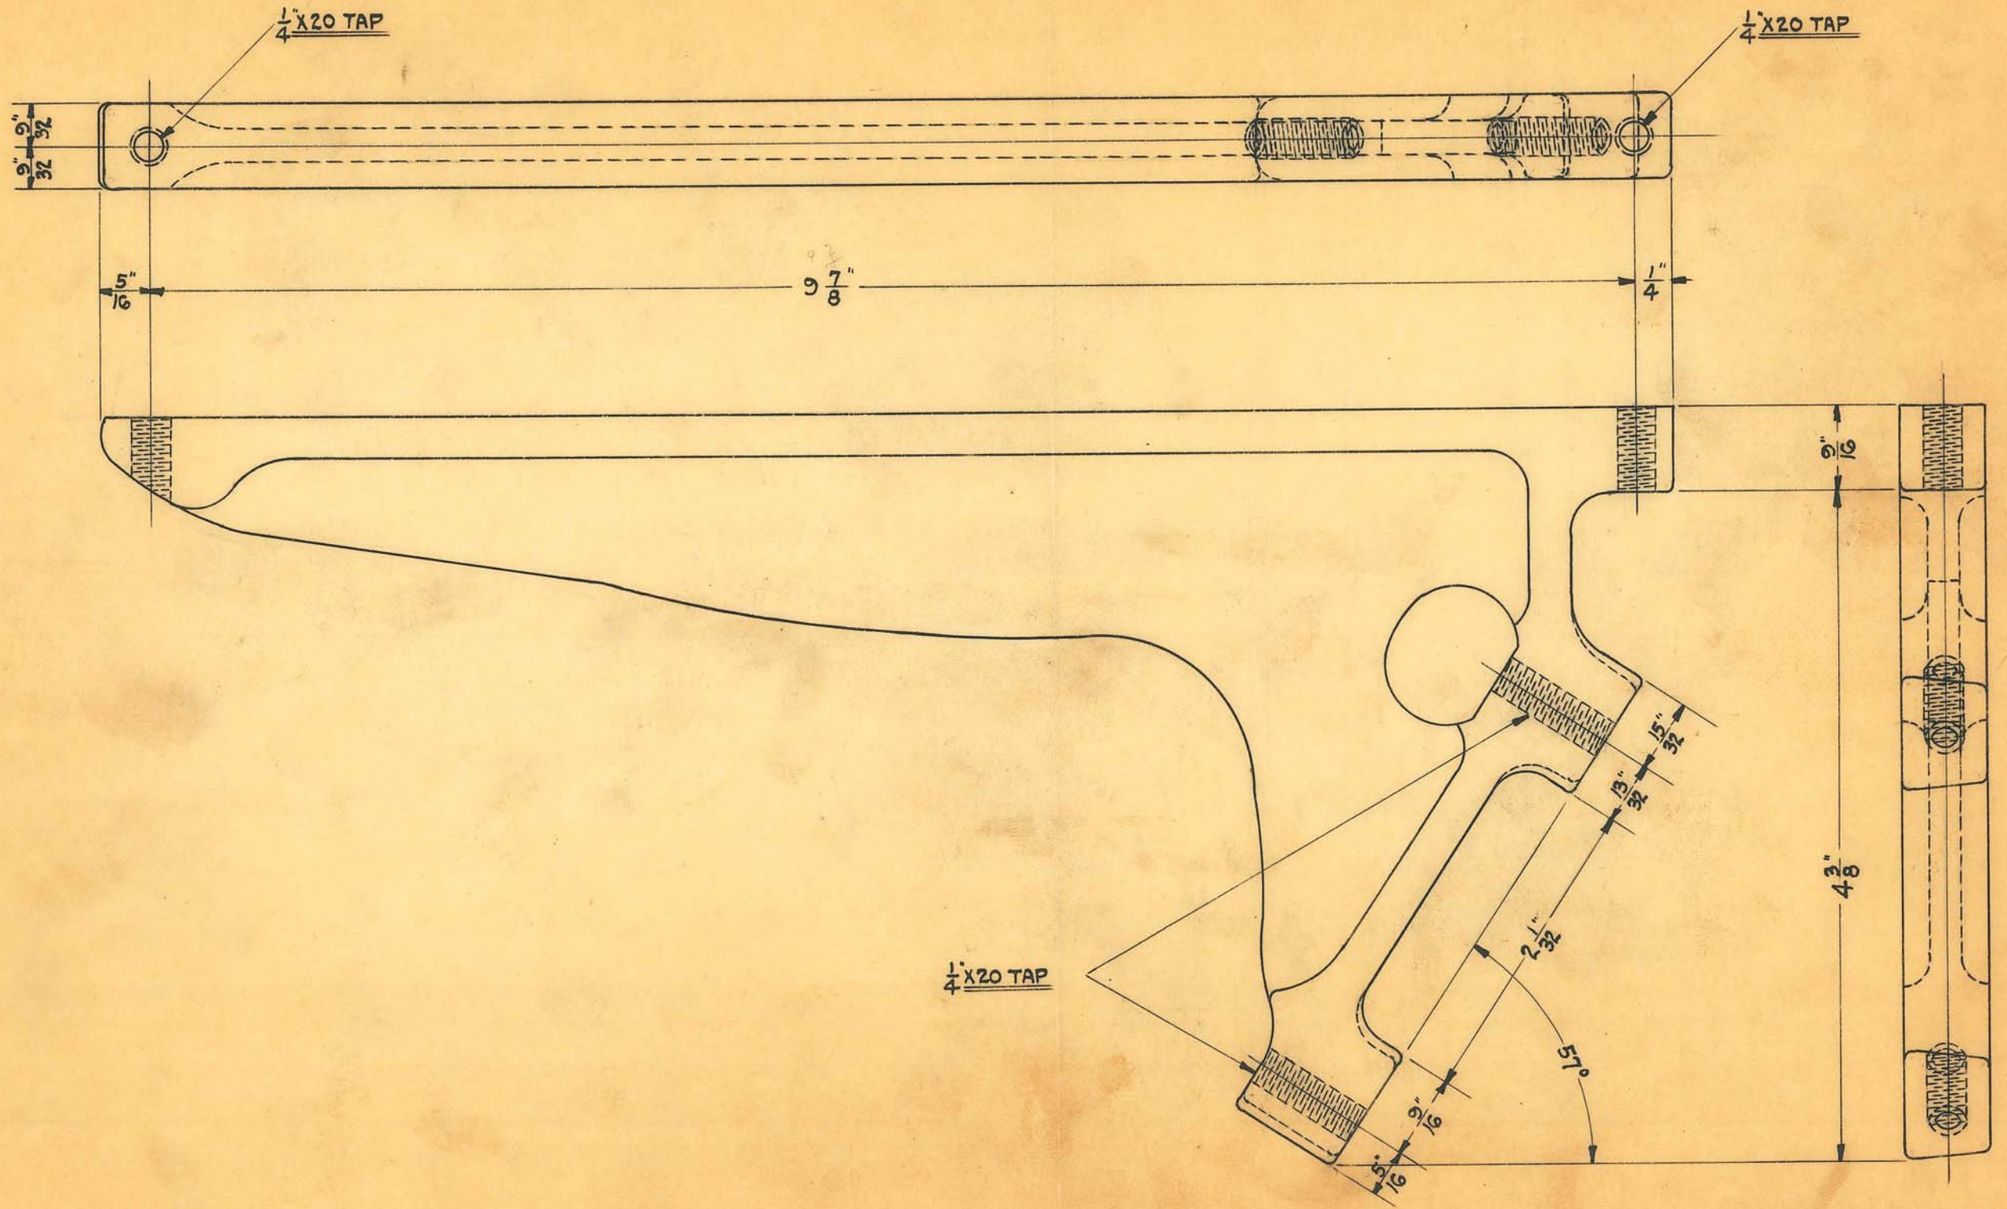

SIZE		ISSUE	H.E.	12-26-29
KIND	IRON CASTING	CHANGED		
SHAPE		" "		
FINISH		" "		
TEMP.		" "		

TITLE: "DENTAL X" CORE CLAMP

OBSOLETE

H. G. FISCHER & CO.
2335 WABANSIA AVE.
CHICAGO, ILL.

CAT. NO.

PART NO. 6153F

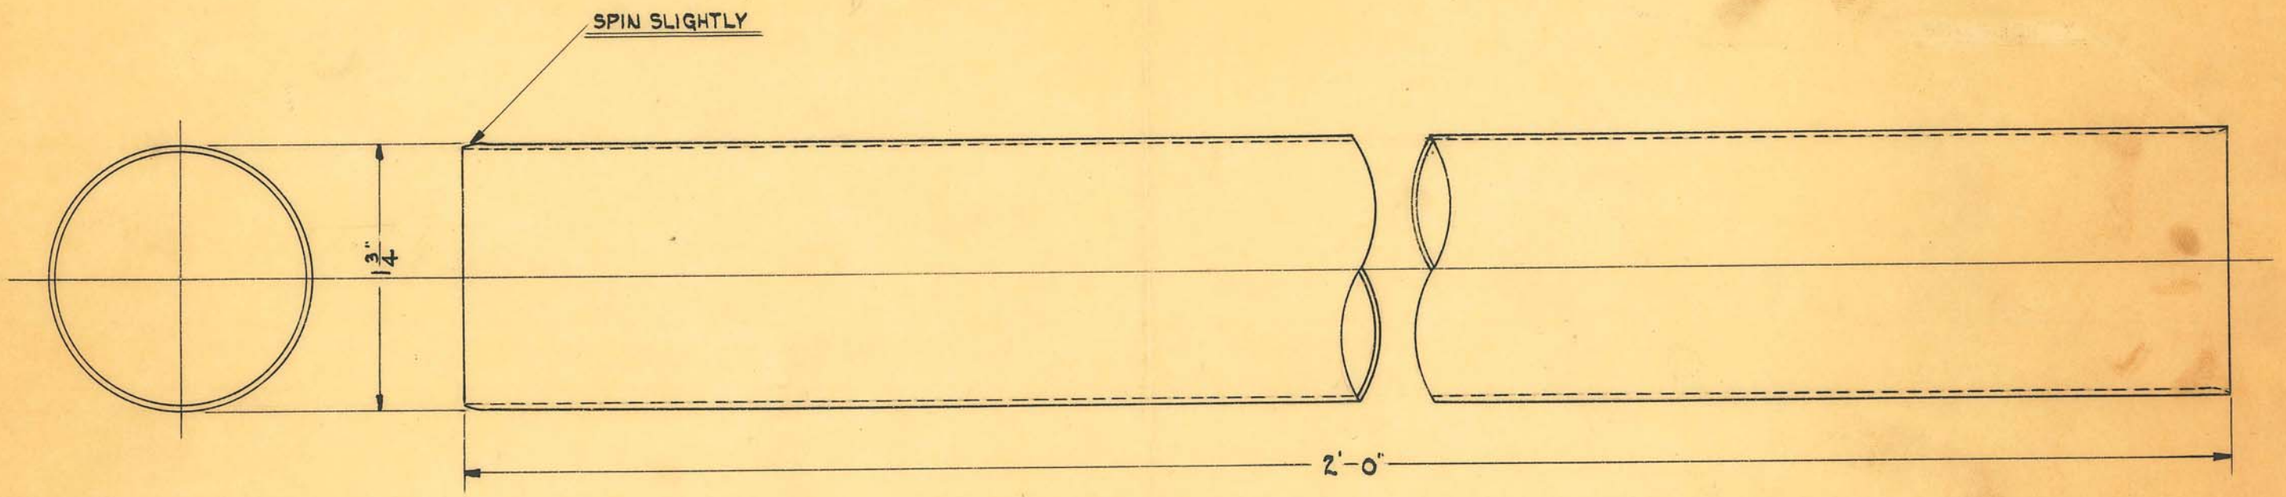

OBSOLETE

SIZE	1¾" O.D. X .050" WALL	ISSUE	H.E.	1-6-30
KIND	BRASS TUBING	CHANGED		
SHAPE		"	"	
FINISH		"	"	
TEMP.		"	"	
PATT.		"	"	

TITLE: "DENTAL X" HIGH TENSION TUBE

H. G. FISCHER & CO.
2335 WABANSIA AVE.
CHICAGO, ILL.

CAT. NO.

PART NO. 6160

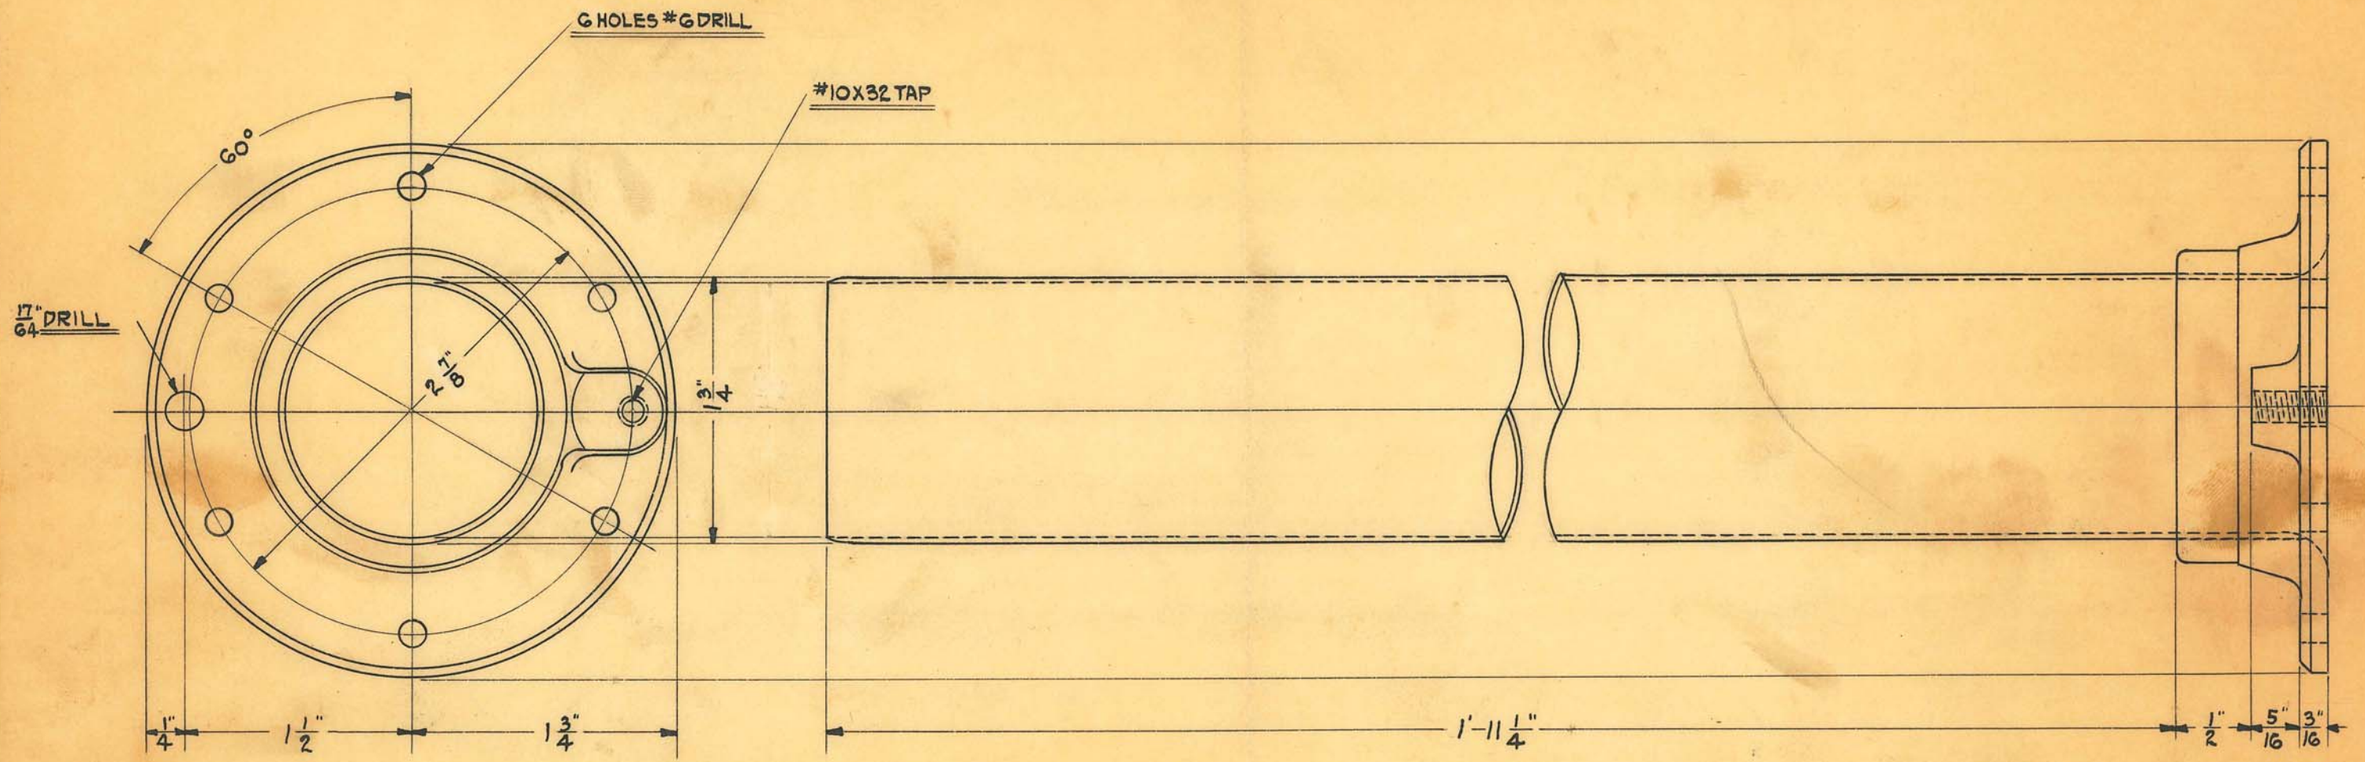

OBSOLETE

SIZE		ISSUE H.E.	1-6-30
KIND		CHANGED	
SHAPE		" "	
FINISH	POLISH & PLATE TUBE ONLY	" "	
TEMP.	CHROME #2	" "	
PATT.		" "	

TITLE: "DENTAL X" HIGH TENSION TUBE COMPLETE

H. G. FISCHER & CO.
2335 WABANSIA AVE.
CHICAGO, ILL.

CAT. NO.

PART NO. 6160G

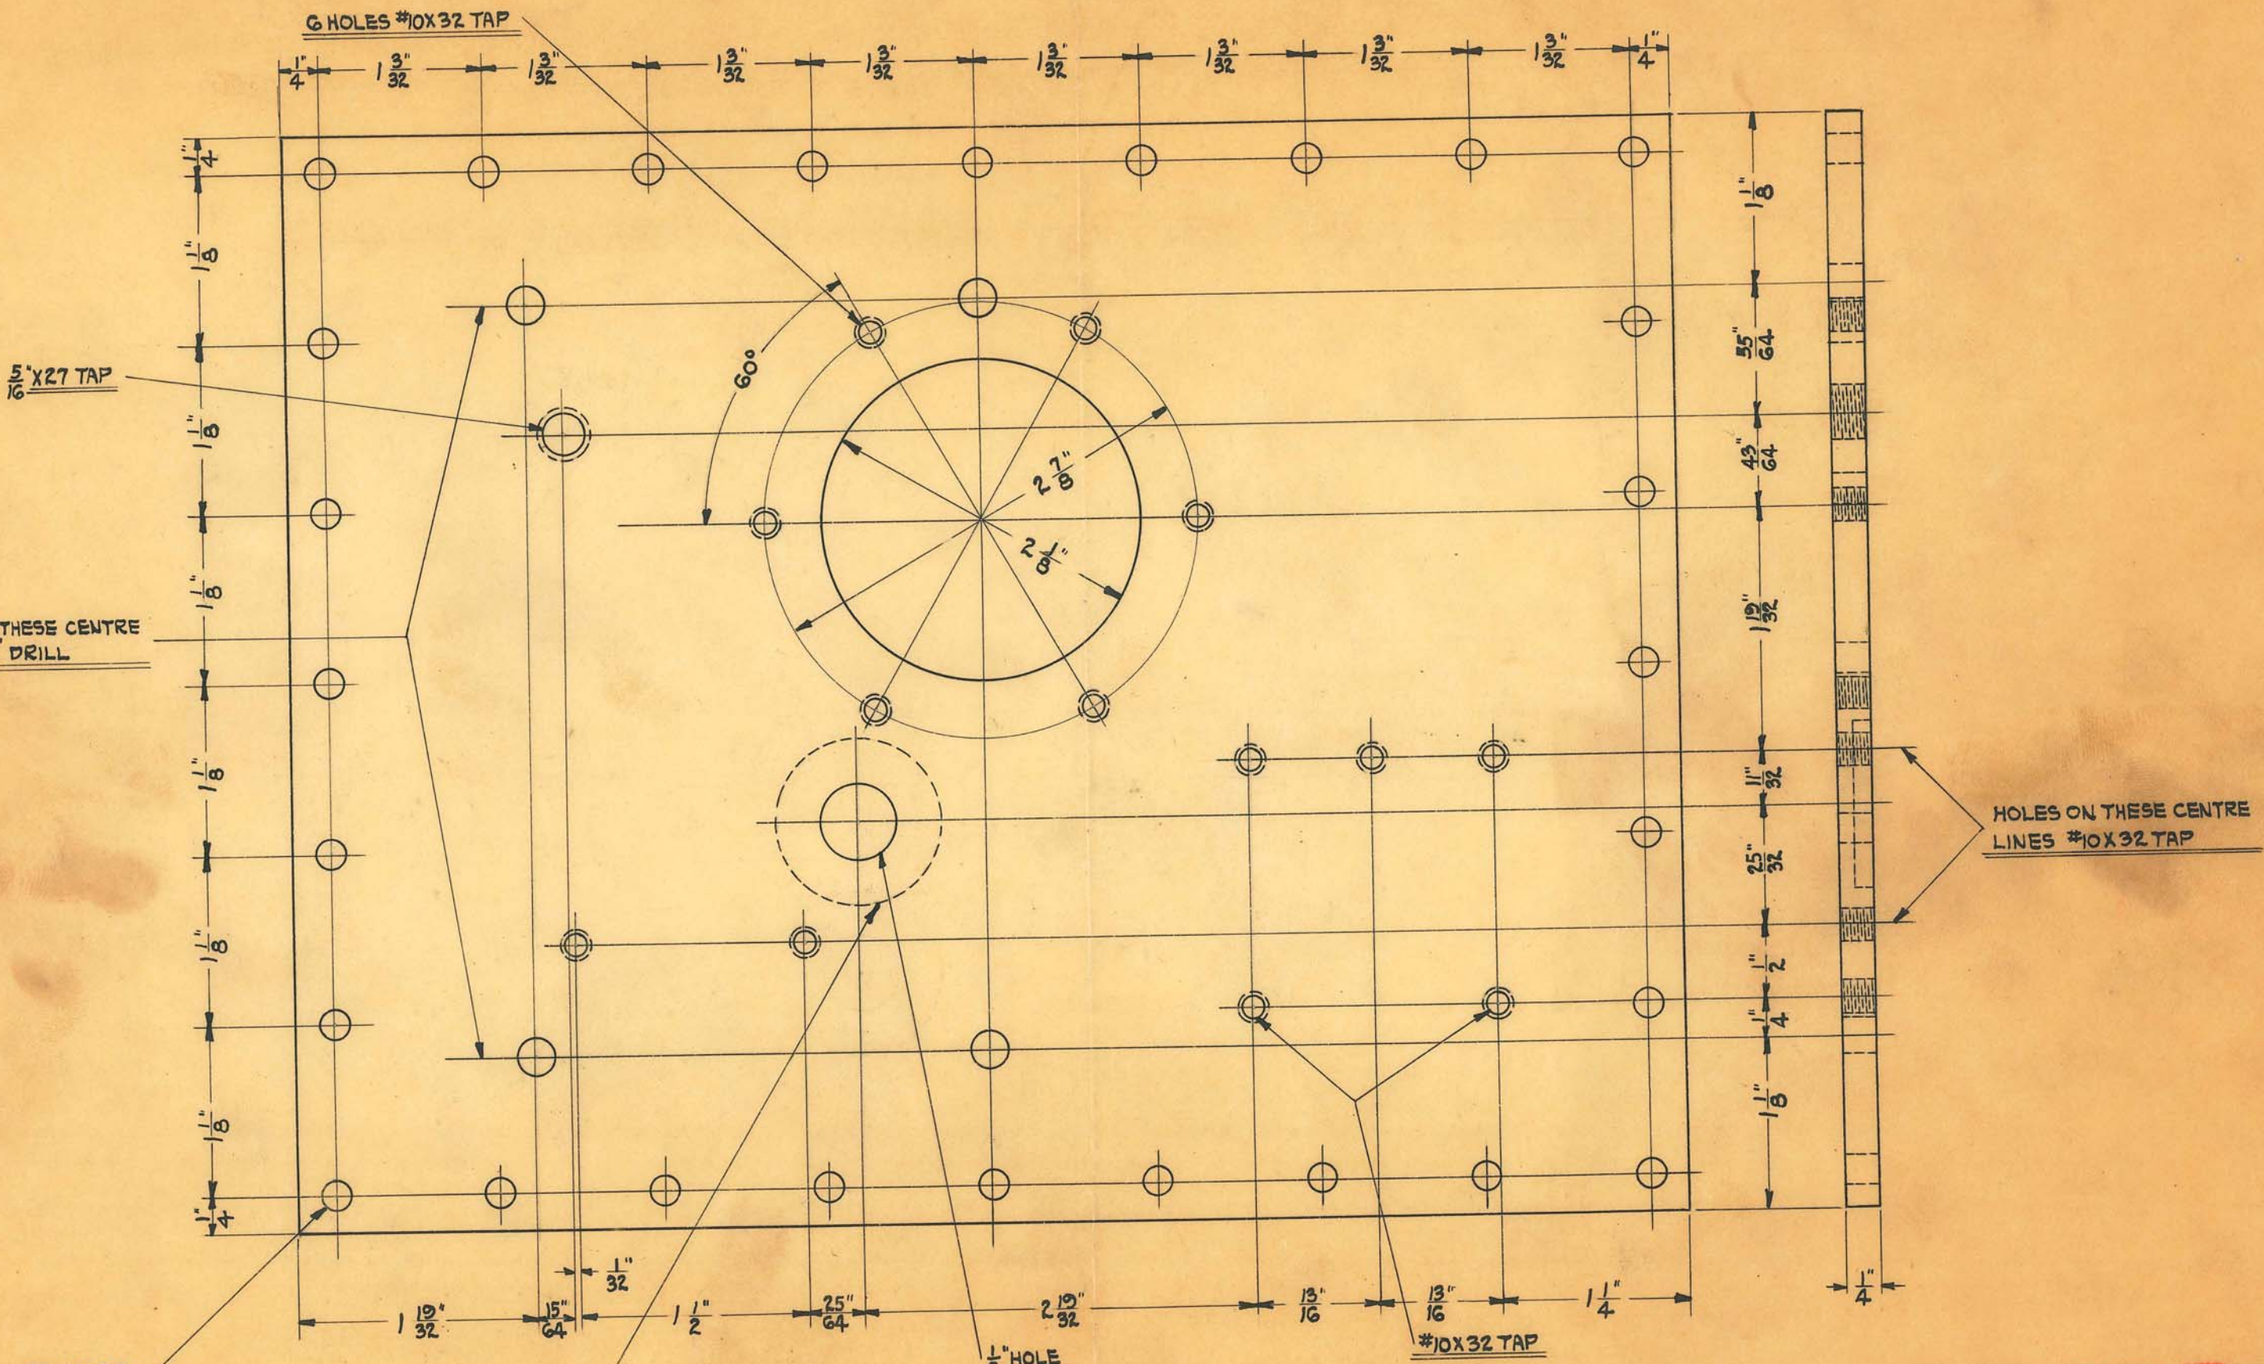

BOUGHT OUTSIDE

SIZE		ISSUE H.E.	1-3-30
KIND		CHANGED	
SHAPE		" "	
FINISH		" "	
TEMP.		" "	

TITLE: "DENTAL X" TRANSFORMER TANK COVER

OBSOLETE

H. G. FISCHER & CO.
2335 WABANSIA AVE.

CAT. NO.

PART NO. 6187F

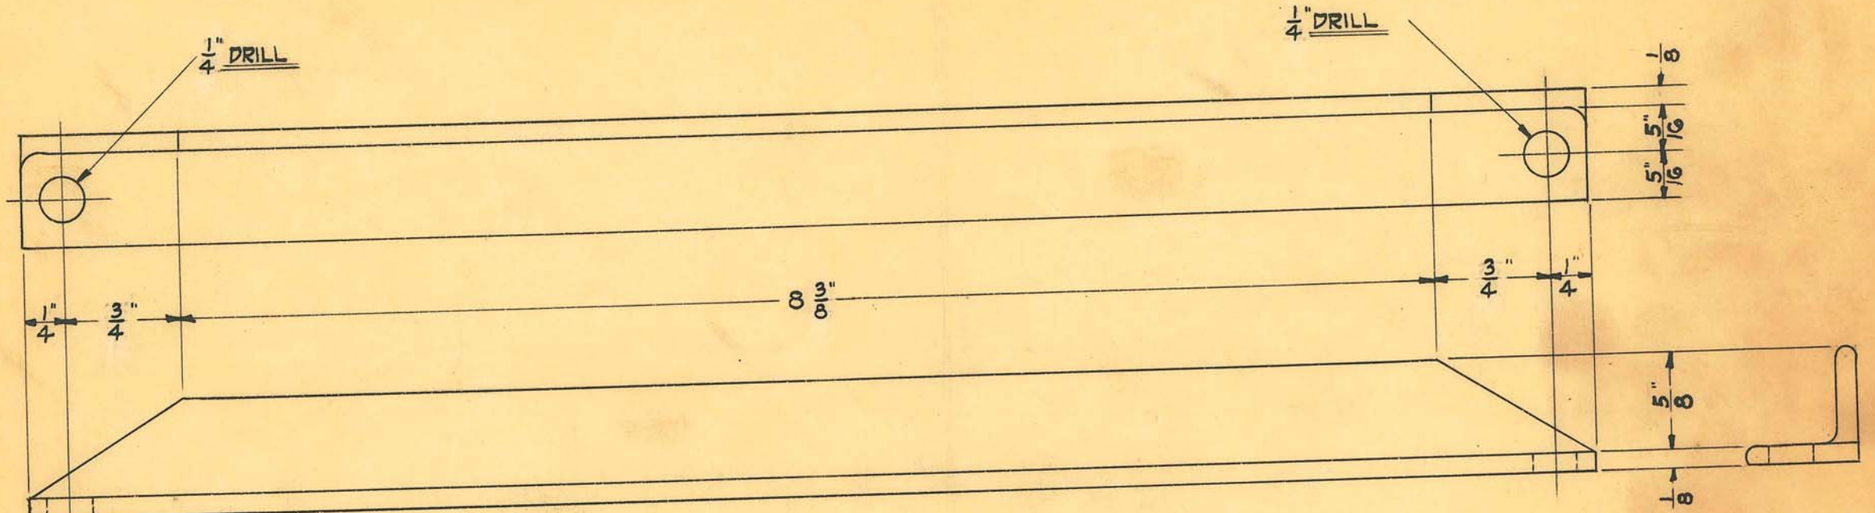

SIZE	3/4" X 3/4" X 1/8"	ISSUE H.E.	1-8-30	TITLE: "DENTAL X" TRANSF. CORE CLAMP ANGLE IRON
KIND	ANGLE IRON	CHANGED		
SHAPE		" "		
FINISH		" "		
TEMP.		" "		
PATT.		" "		

OBSOLETE

H. G. FISCHER & CO.
2335 WABANSIA AVE.
CHICAGO, ILL.

CAT. NO.

PART NO. 6188

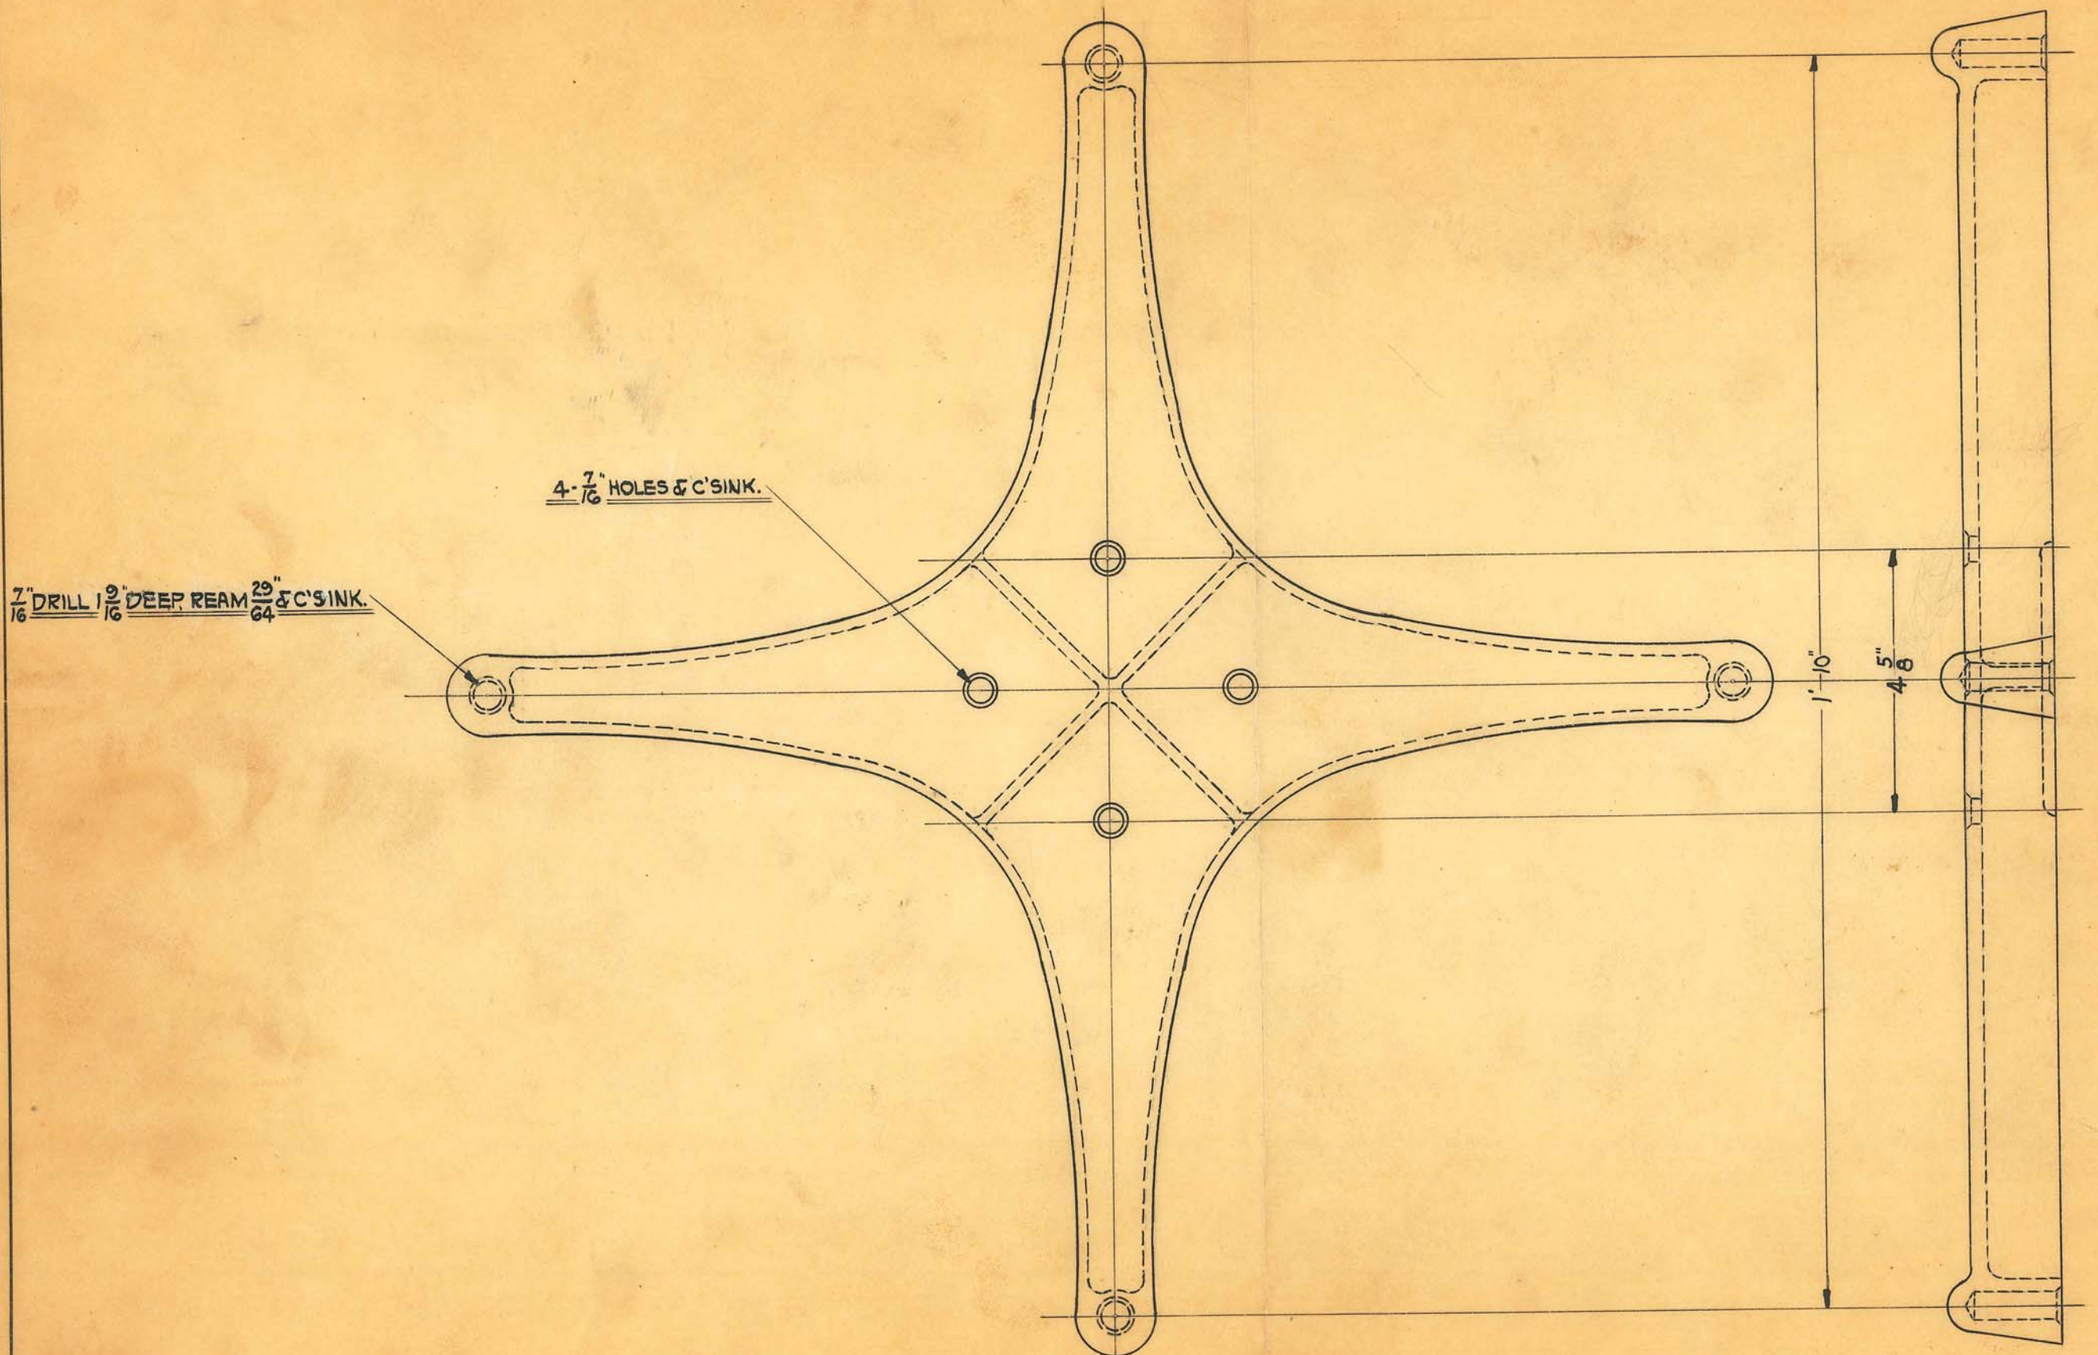

SCALE ~ 3/8" = 1"

SIZE		ISSUE H.E.	1-9-29
KIND	IRON CASTING	CHANGED	
SHAPE		" "	
FINISH	MAH. GRAIN	" "	
TEMP.		" "	

TITLE: "DENTAL X" BASE

OBSOLETE

H. G. FISCHER & CO.
2335 WABANSIA AVE.
CHICAGO, ILL.

CAT. NO.

PART NO. 6190F

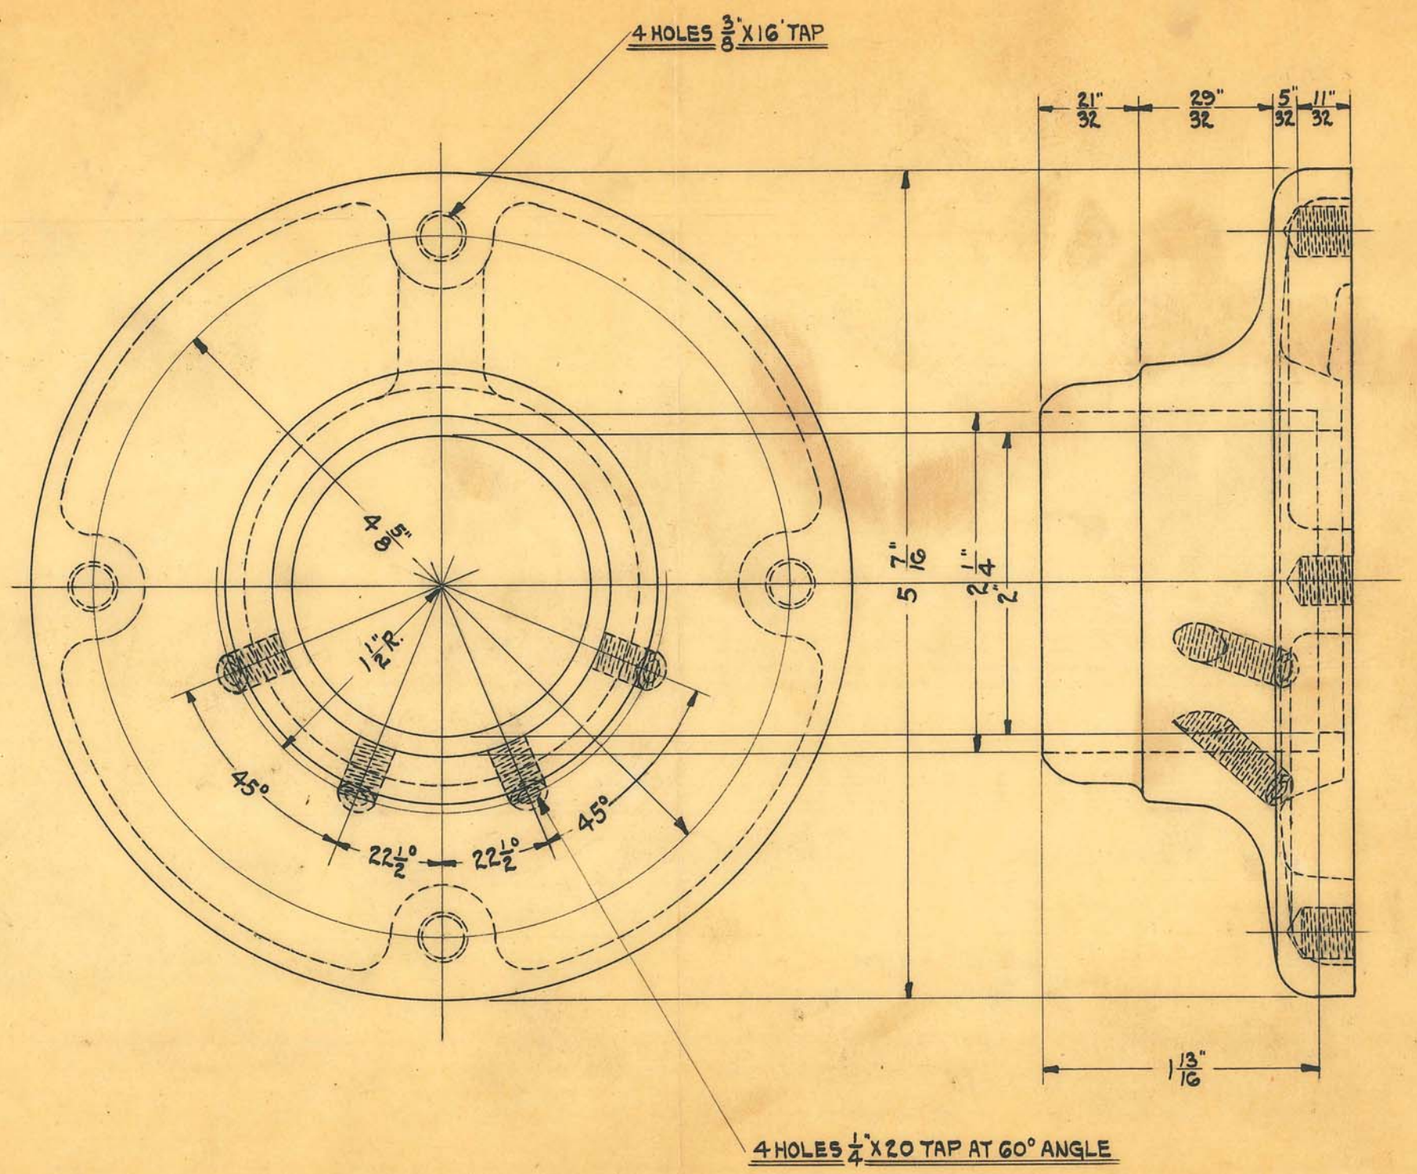

SIZE		ISSUE	H.E.	1-17-30
KIND	ALUM. CASTING	CHANGED		
SHAPE		"	"	
FINISH	BUFFED	"	"	
TEMP.		"	"	

TITLE: "DENTAL X" UPRIGHT FLANGE

OBSOLETE

H. G. FISCHER & CO.
2335 WABANSIA AVE.

CAT. NO.

PART NO. 6191F

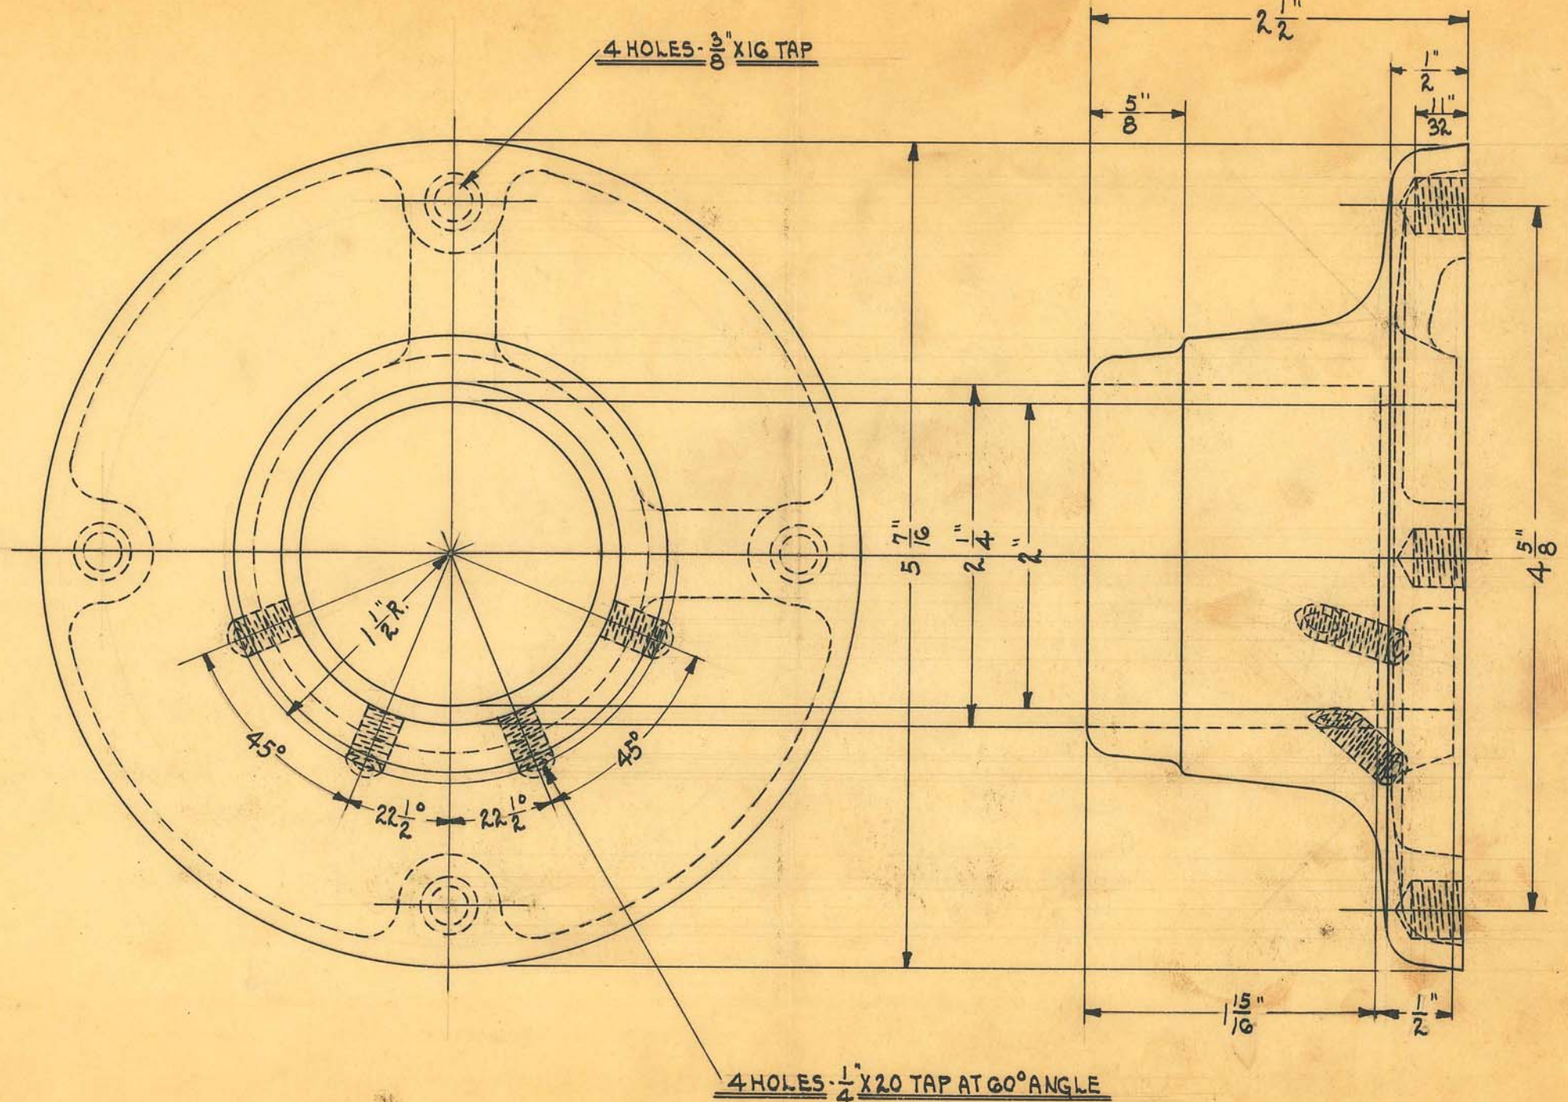

SIZE		ISSUE 10-8-30	H.E.
KIND	ALUM. CASTING	CHANGED	
SHAPE		" "	
FINISH	POL. & BUFFED	" "	
TEMP.		" "	

TITLE: DENTAL X UPRIGHT FLANGE

OBSOLETE

H. G. FISCHER & CO. 2335 WABANSIA AVE.

CAT.

PART C-1915A

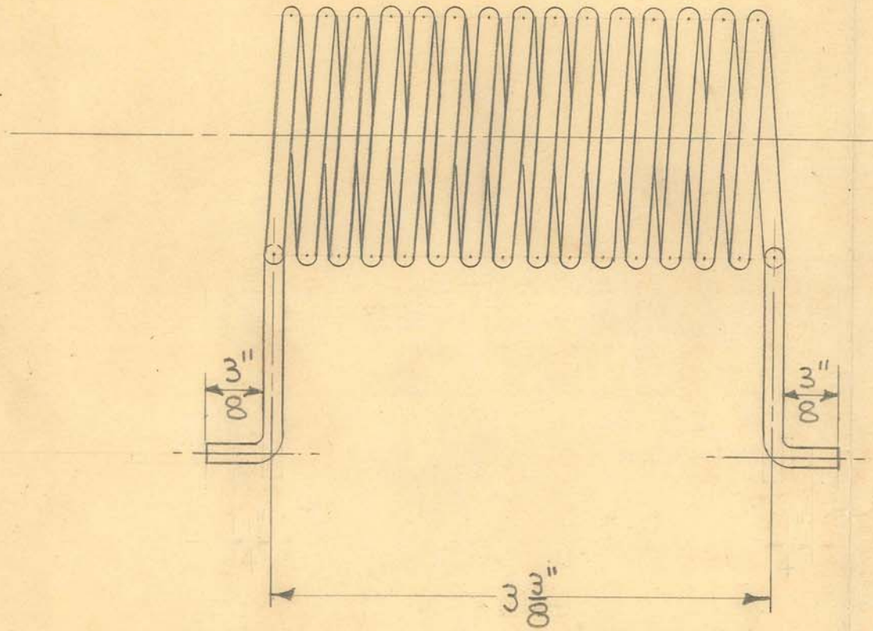

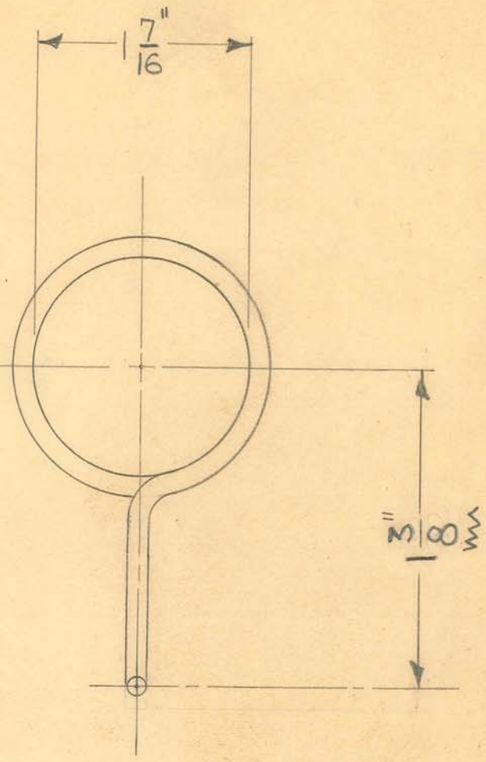

15 TURNS

1-REQUIRED

DEVELOPED LENGTH 77 9/32" LONG

10-13-52

FORMING FIX. TOOL # 9999

MANDRELL TOOL # 9023

OBSOLETE

SIZE	#8 BARE	ISSUE 1-30-47	J.M.F	TITLE: MODEL 400 FISCHER DELUXE DIATHERMY PARALLEL TUNING COIL
KIND	COPPER WIRE	CHANGED		
SHAPE		" 7-19-48	W.J.	
FINISH		"		
TEMP.		"		
PATT.		"		

DIMENSIONS	
FRACTIONAL	± .015
DECIMAL	± .005
ANGULAR	± 1/2°
UNLESS OTHERWISE SPECIFIED	

H. G. FISCHER & CO.
2335 WABANSIA AVE.
CHICAGO, ILL.

CAT. NO.

PART NO. 16357 A

16329 — 2 Pcs. $\frac{1}{4}$" Tubing - $5\frac{1}{2}$" LONG EACH
16234 — BEADS - 76
#16 GA. WIRE = 20"

16334 — SLEEVE

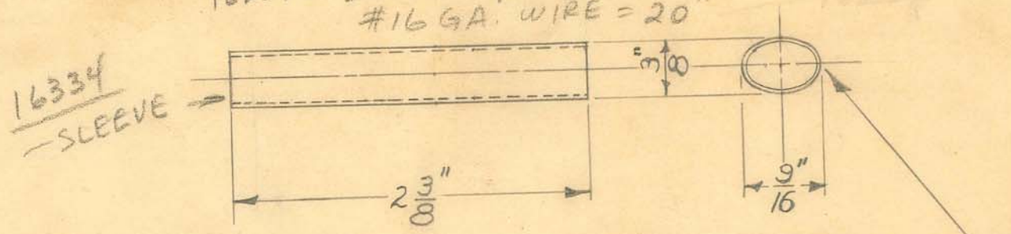

FLATTEN TO THIS SHAPE

ASSEMBLY

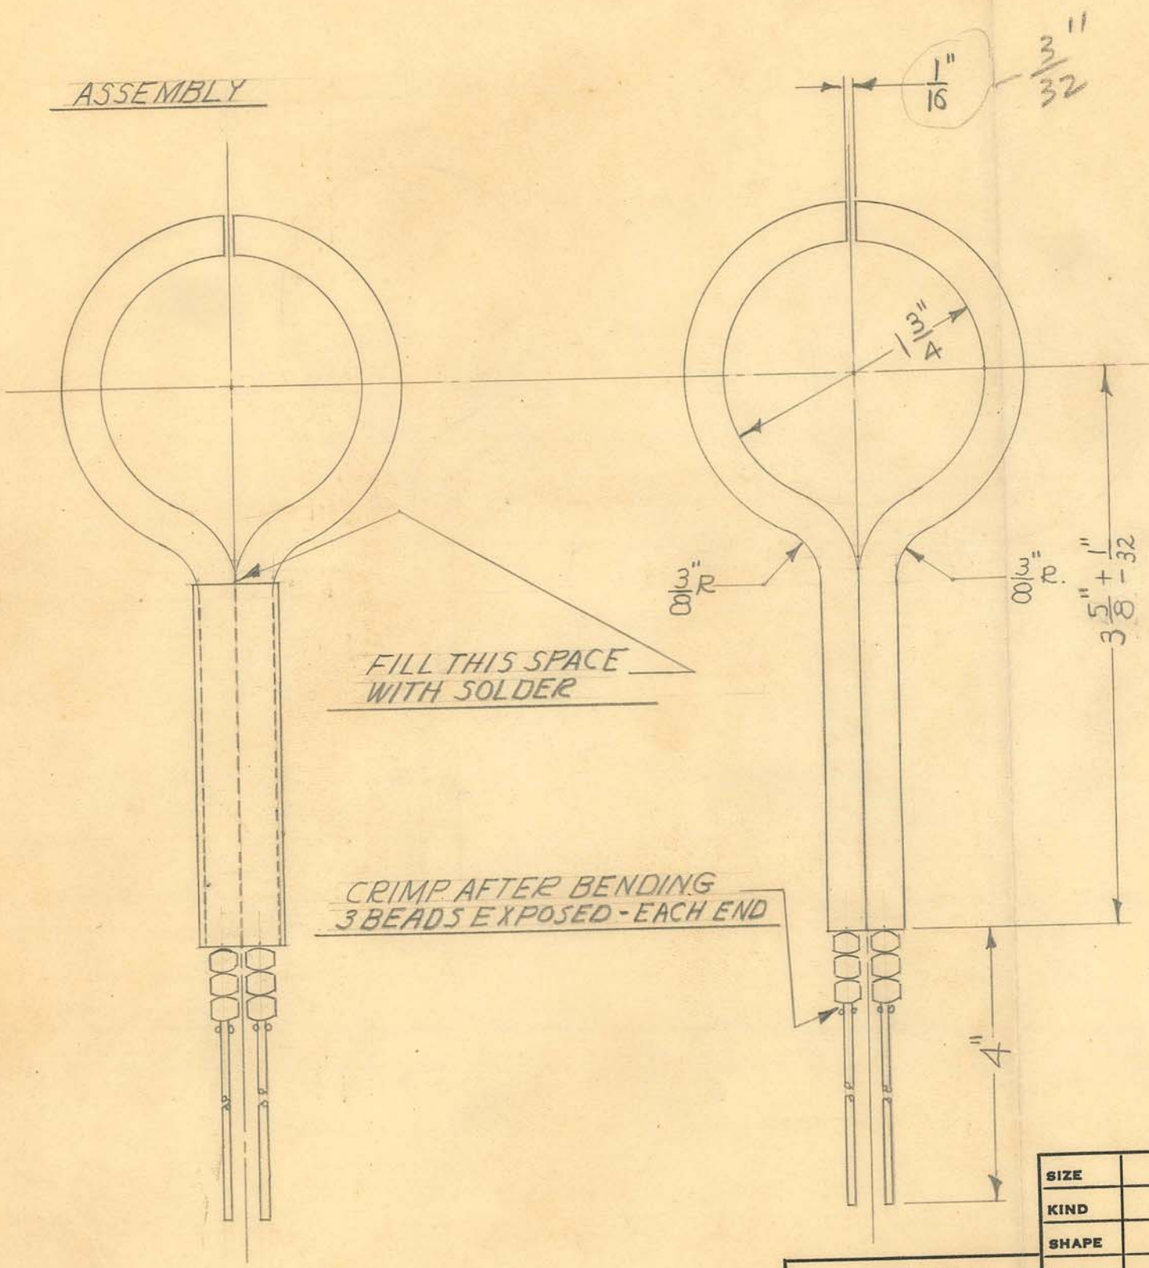

FILL THIS SPACE WITH SOLDER

CRIMP AFTER BENDING
3 BEADS EXPOSED - EACH END

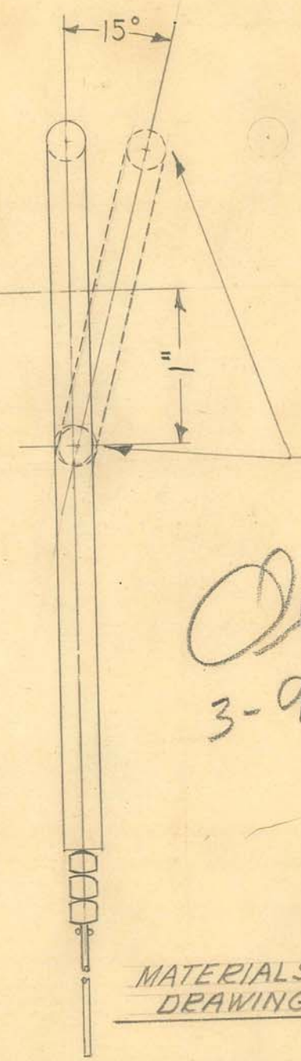

BEND THIS SECTION AFTER ASSEMBLING, TO DIMENSION SHOWN

Obsolete
3-9-49

1-REQUIRED

OBSOLETE

MATERIALS TO BE USED AS SPECIFIED ON YOUR DRAWING NO. L-11722

SIZE		ISSUE	12-4-47	J.M.F
KIND		CHANGED		
SHAPE		"		
FINISH		"		
TEMP.		"		

DIMENSIONS
FRACTIONAL ± .015
DECIMAL ± .005

TITLE: MODEL "400" FISCHER DELUXE DIATHERMY FARRADAY PICK UP LOOP - LONG

H. G. FISCHER & CO.
2335 WABANSIA AVE.
CHICAGO, ILL.

CAT. NO.

PART NO. 16358

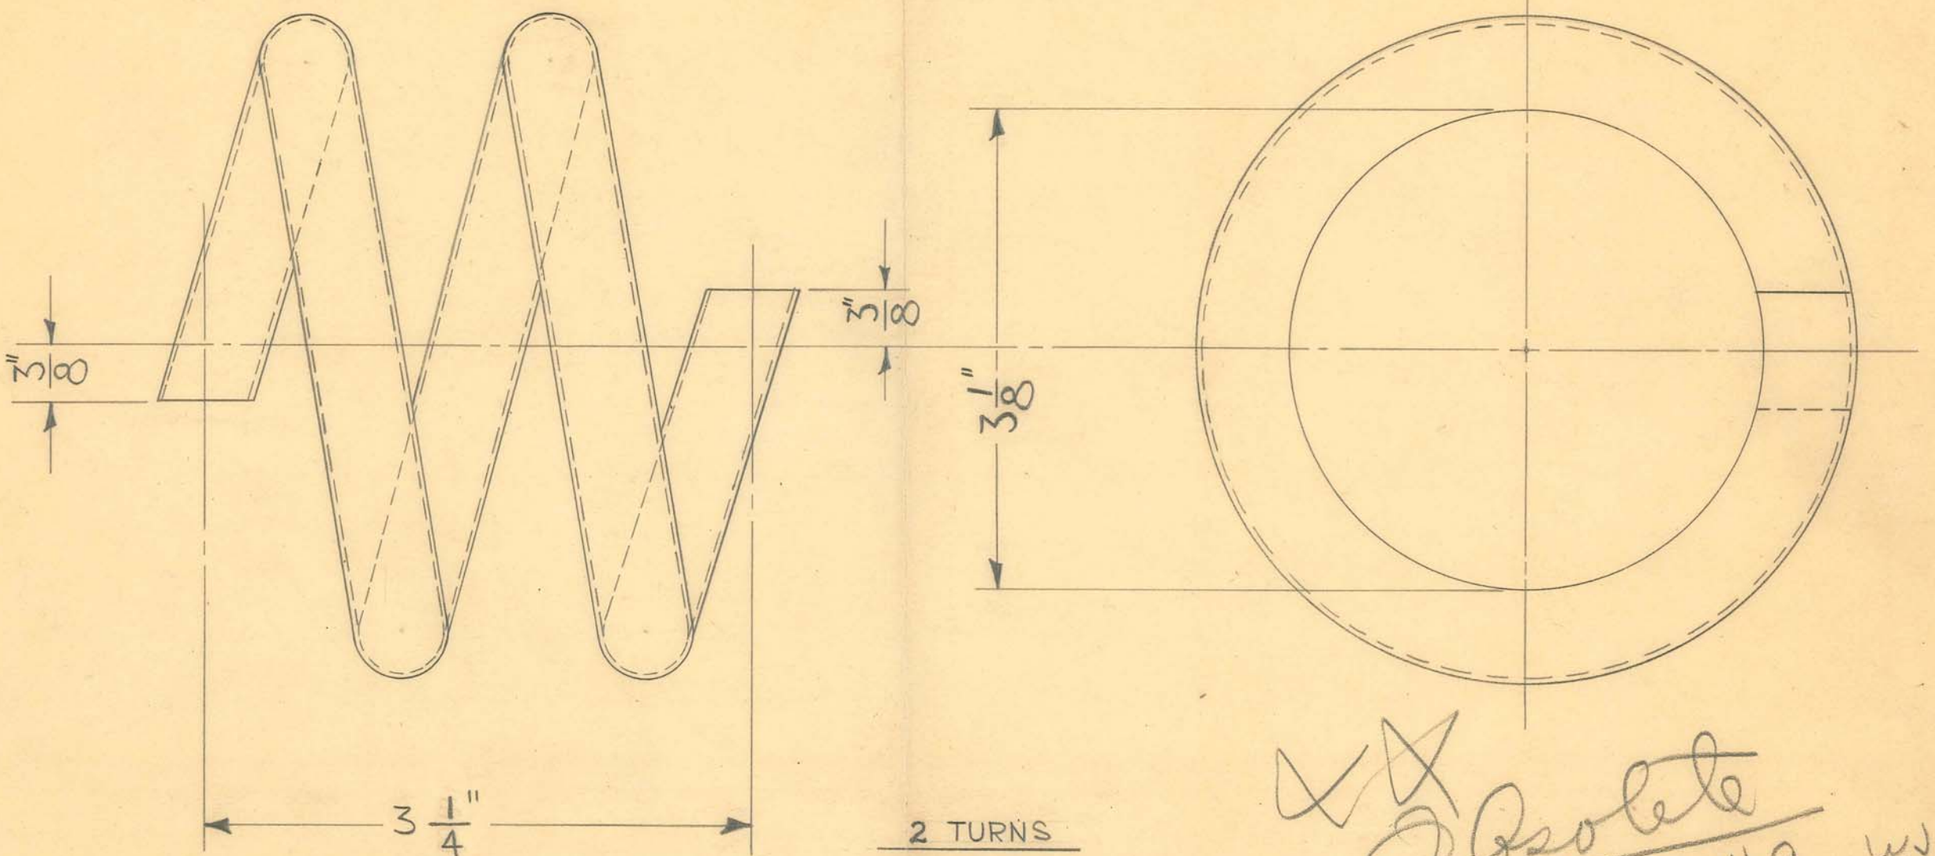

2 TURNS

1 REQUIRED

5/8" O.D. X 21 GA. (.032") WALL ~ COPPER TUBING

COIL WINDING FIXTURE TOOL # 10081

FORMING ARBOR TOOL # 10082

CHANGED PER J.K.

SIZE		ISSUE 6-14-48	W.J.
KIND		CHANGED	
SHAPE		" 2-17-49	W.J.
FINISH		"	
TEMP.		"	

DIMENSIONS	
FRACTIONAL	± .015
DECIMAL	± .005

TITLE: MODEL "400" FISCHER DELUXE DIATHERMY OSCILLATING COIL

H. G. FISCHER & CO. | CAT. | PART 10760

Obsolete 4-12-49 W.J.

OBSOLETE

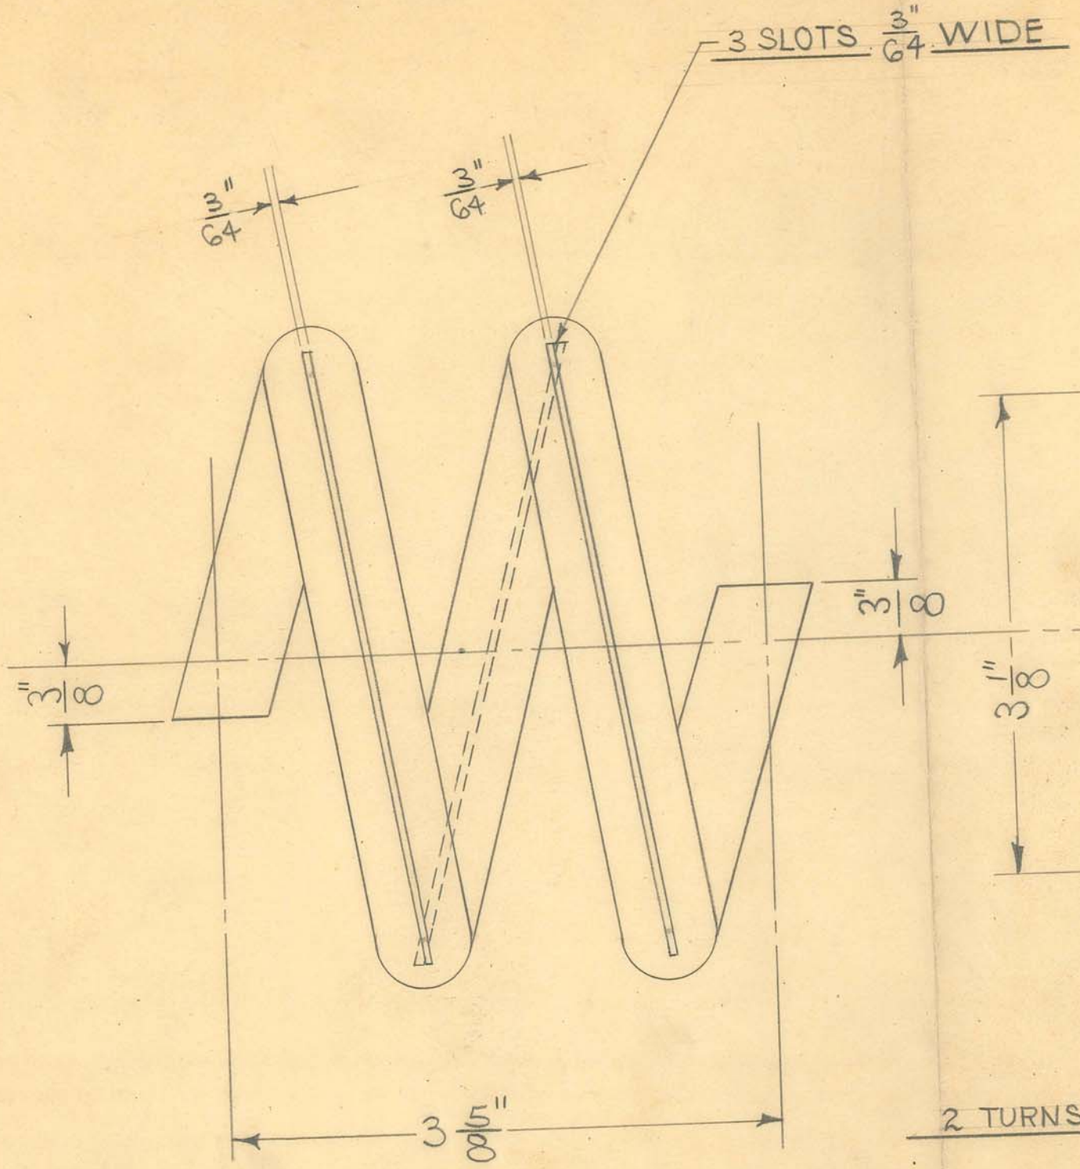

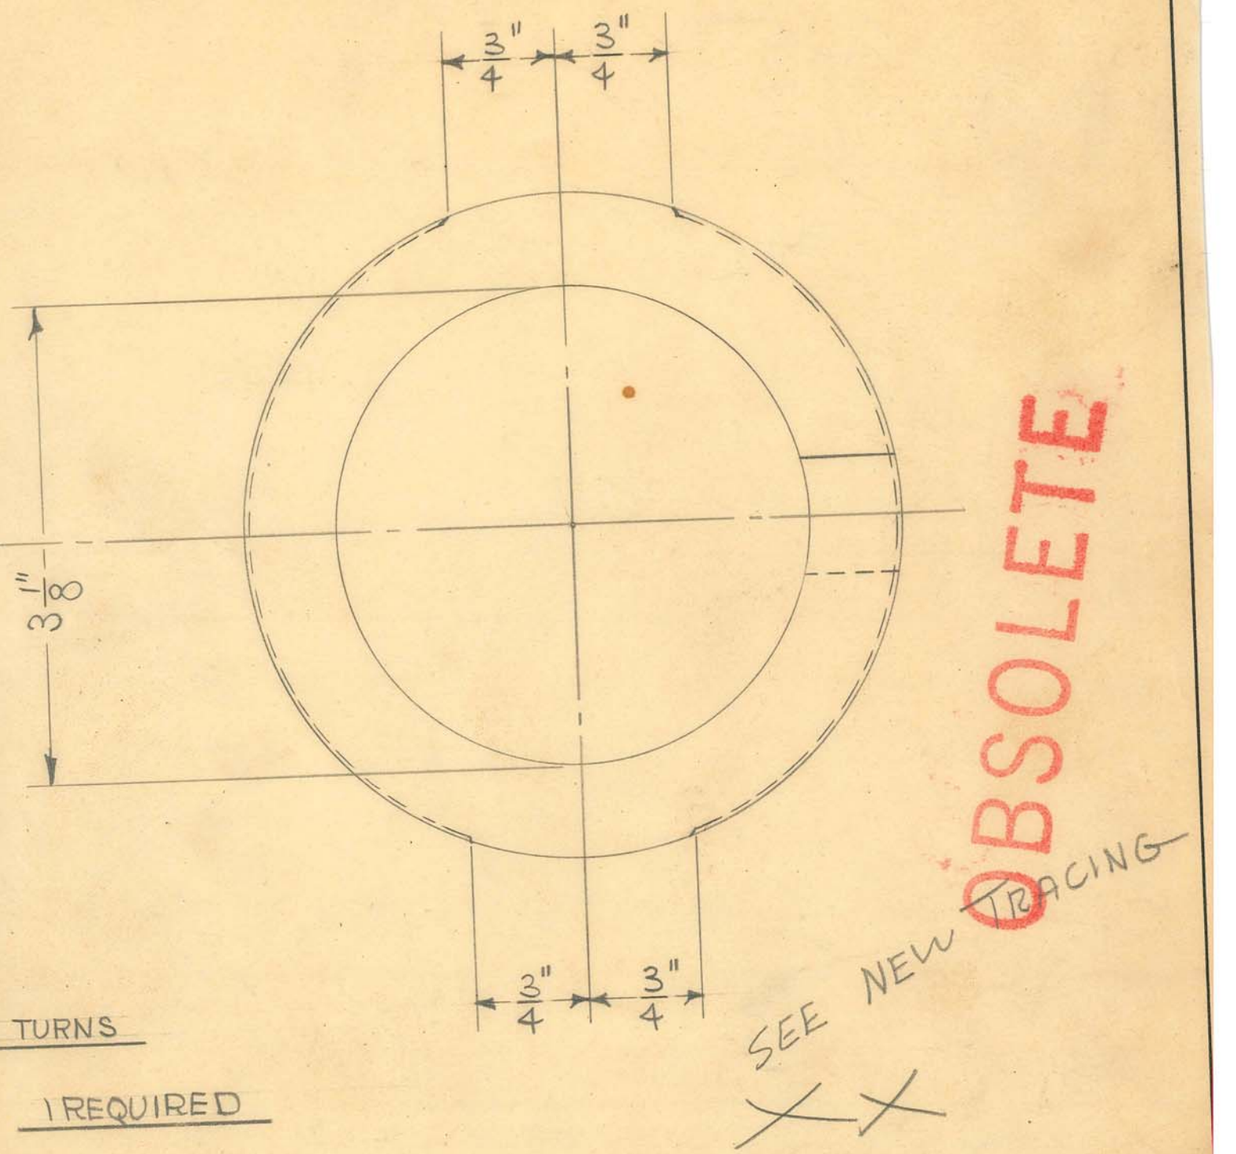

2 TURNS

1 REQUIRED

5/8" O.D. X 21 GA. (.032") WALL ~ COPPER TUBING

SEE NEW ~~TRACING~~ OBSOLETE

XX

DIMENSIONS	
FRACTIONAL	± .015
DECIMAL	± .005
ANGULAR	± 1/2°

SIZE		ISSUE 12-4-47	W.J.
KIND		CHANGED	
SHAPE		"	
FINISH		"	
TEMP.		"	
		"	

TITLE: MODEL "400" FISCHER DELUXE DIATHERMY OSCILLATING COIL

H. G. FISCHER & CO.
2335 WABANSIA AVE.
CHICAGO, ILL.

CAT. NO.

PART NO. 16360

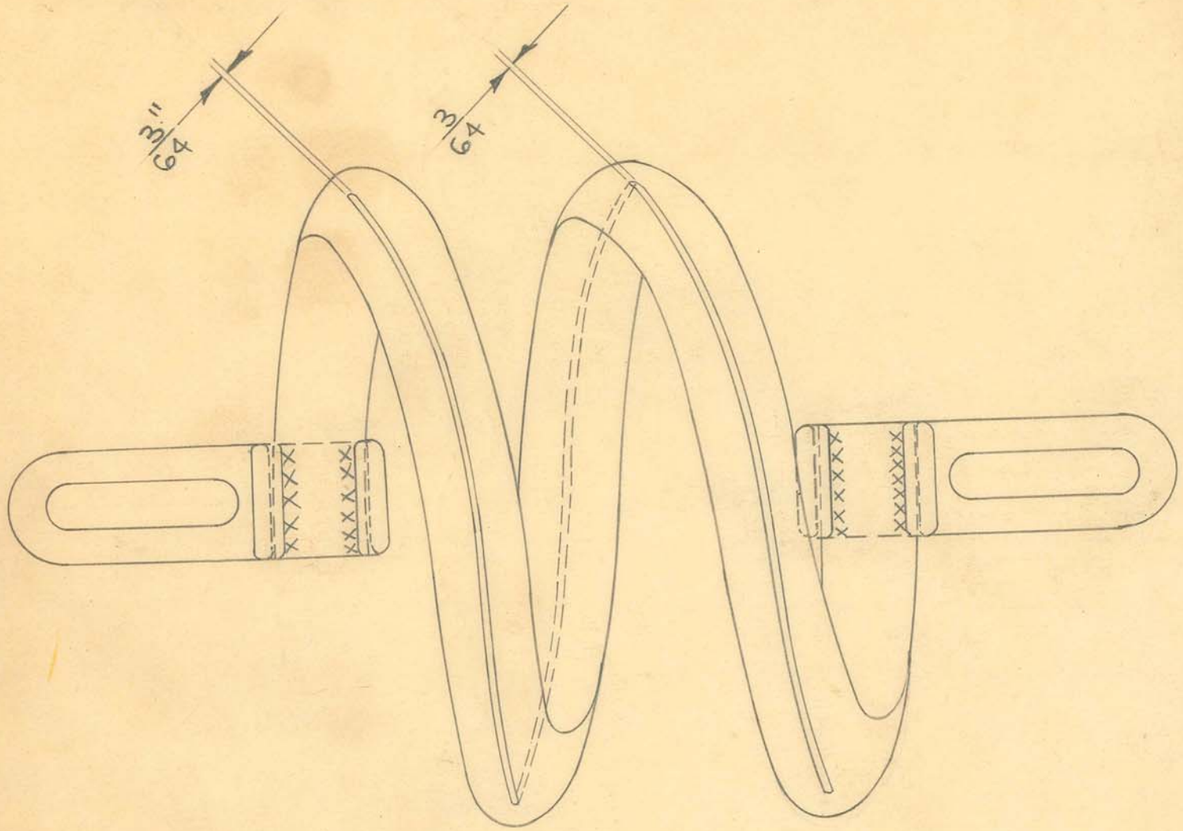

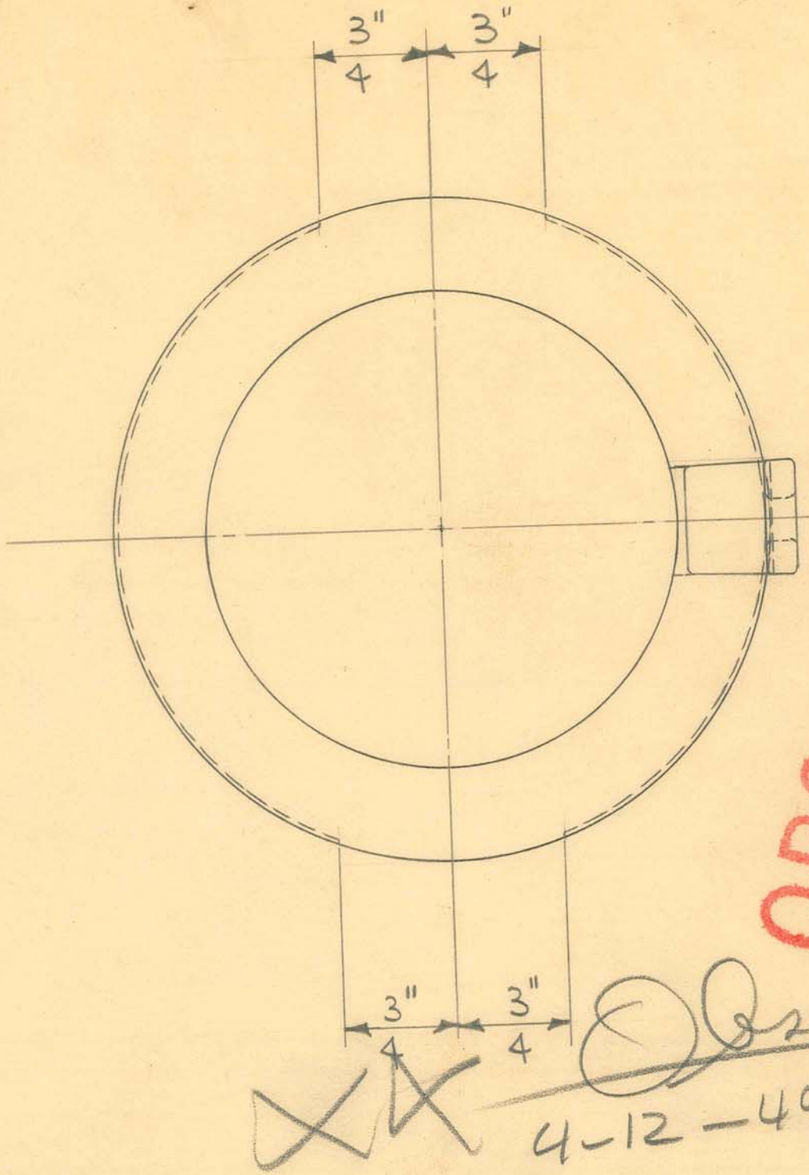

OBSOLETE

Obsolete
4-12-49 W.J.

1 REQUIRED

SLOTTING TOOL # 9748

SIZE		ISSUE 7-27-48	W.J.
KIND		CHANGED	
SHAPE		"	
FINISH		"	
TEMP.		"	
		"	

DIMENSIONS
FRACTIONAL ± .015
DECIMAL ± .005
ANGULAR ± 1/2°

TITLE:
MODEL "400" FISCHER DELUXE DIA.
OSCILLATING COIL FINISHED

H. G. FISCHER & CO.
2335 WABANSIA AVE.
CHICAGO, ILL.

CAT. NO.

PART NO. 16362F

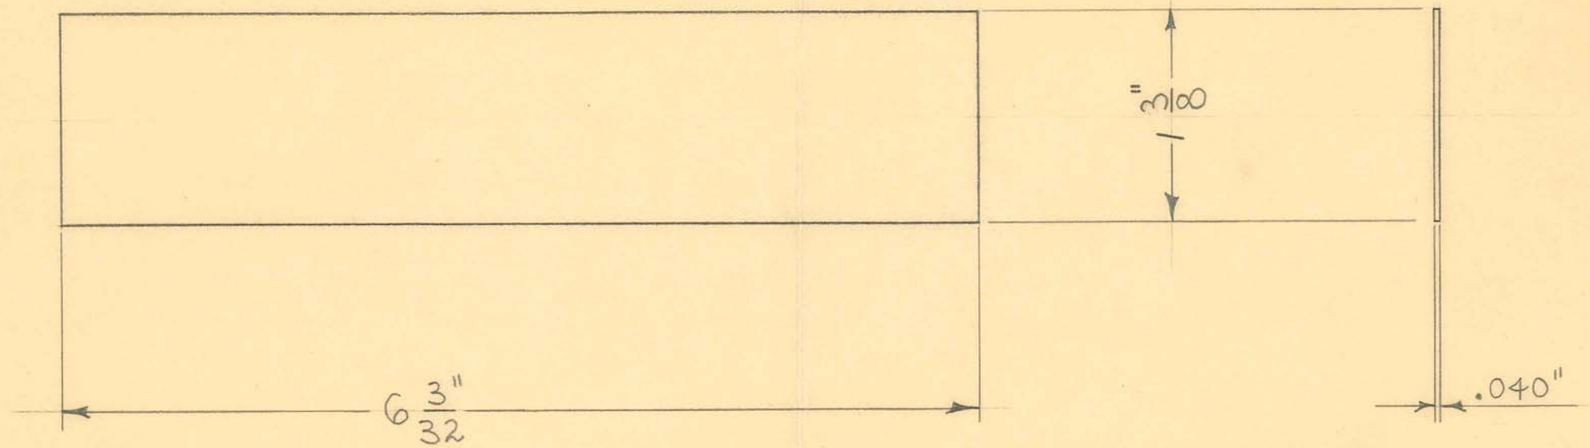

2 REQUIRED

X X
Obsolete
2-7-49

OBSOLETE

.040" ~ #2400 CHACE THERMOSTATIC BIMETAL

SIZE		ISSUE 1-22-48	W.J.
KIND		CHANGED	
SHAPE		"	
FINISH		"	
TEMP.		"	
PATT.		"	

DIMENSIONS
FRACTIONAL ± .015
DECIMAL ± .005
ANGULAR ± 1/2°
UNLESS OTHERWISE SPECIFIED

TITLE:
MODEL "400" FISCHER DELUXE DIATHERMY
BIMETAL COMPENSATOR

H. G. FISCHER & CO.
2335 WABANSIA AVE.
CHICAGO, ILL.

CAT. NO.

PART NO. 16389

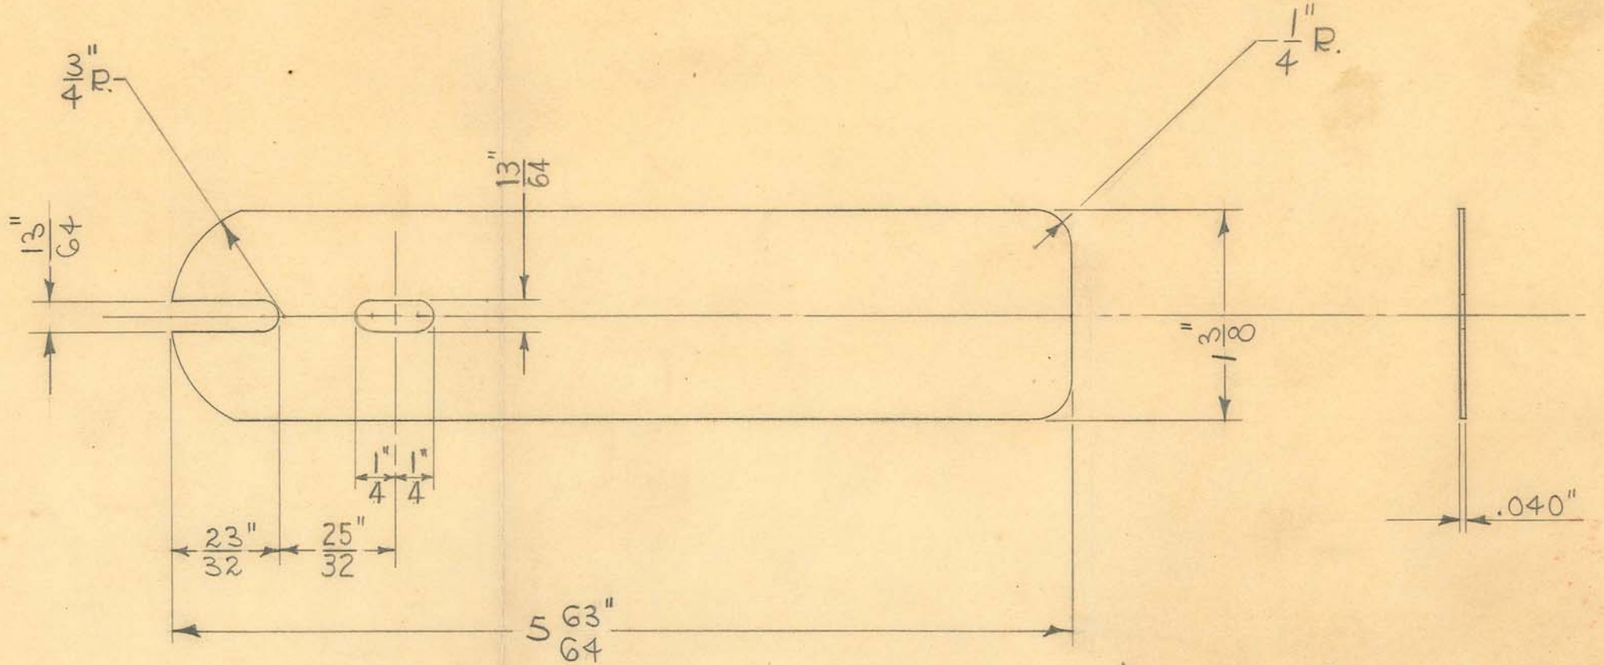

DEVELOPMENT

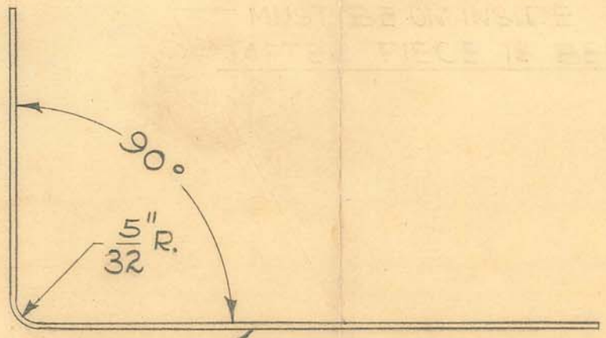

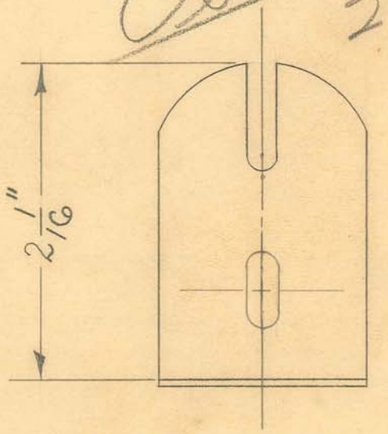

XX Obsolete 2-7-49

OBSOLETE

NOTE:
AFTER PIECE IS COMPLETE SEND OUT FOR HEAT TREATMENT. 700° F. FOR 3 HOURS

LETTER "S" STAMPED ON BIMETAL MUST BE ON THIS SIDE AFTER PIECE IS BENT

2-REQUIRED

BENDING TOOL # 9717.
RADIUS & NOTCHING DIE TOOL # 9662
SLOTTING DIE TOOL # 9827.

DIMENSIONS	
FRACTIONAL	± .015
DECIMAL	± .005
ANGULAR	± 1/2°
UNLESS OTHERWISE SPECIFIED	

SIZE	FROM 16389	ISSUE 1-22-48	W.J.
KIND		CHANGED	
SHAPE		" 5-24-48	J.B.G.
FINISH		"	
TEMP.		"	
PATT.		"	

TITLE:
MODEL "400" FISCHER DELUXE DIATHERMY
BIMETAL COMPENSATOR

H. G. FISCHER & CO.
2335 WABANSIA AVE.
CHICAGO, ILL.

CAT. NO.

PART NO. 16389F

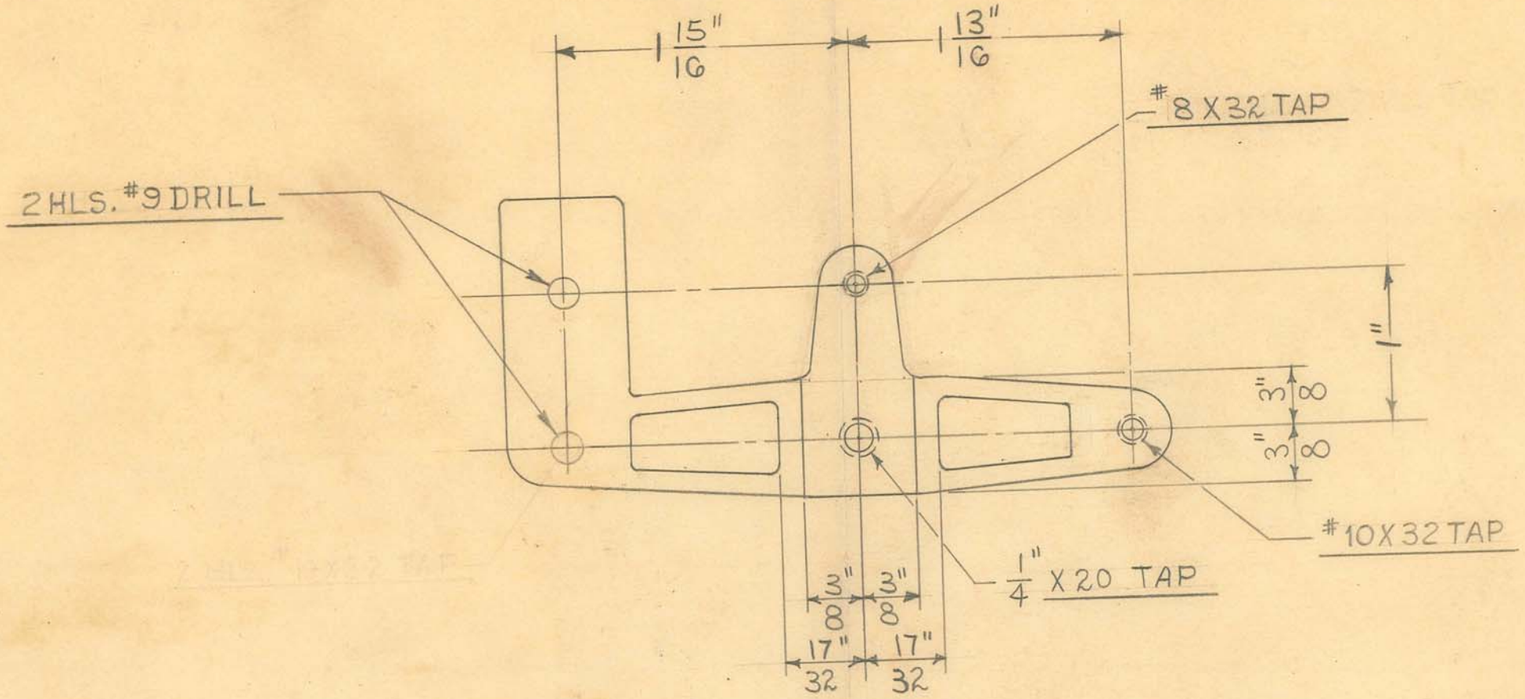

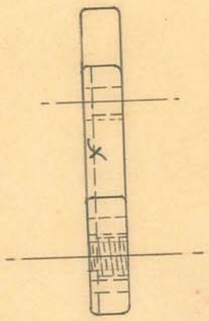

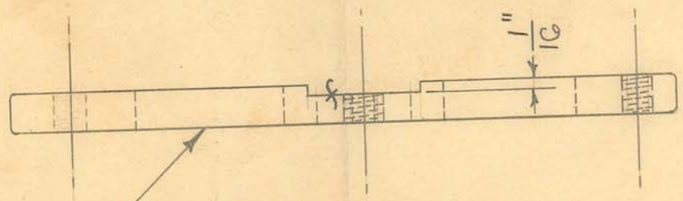

SAND THIS SURFACE FLAT ON SANDING DISC & REMOVE SHARP EDGES AFTER SANDING

XX Obsolete 2-7-49

OBSOLETE

GRIND OFF PROMINENT ROUGH SPOTS ONLY

1-REQUIRED

DRILL JIG TOOL #9691
MILLING FIXTURE TOOL #9692

SIZE	CAST IN	ISSUE 12-6-47	W.J.
KIND	BRASS	CHANGED	
SHAPE		"	
FINISH		"	
TEMP.		"	
	3291-	"	

DIMENSIONS
FRACTIONAL ± .015
DECIMAL ± .005
ANGULAR ± 1/2°

TITLE:
MODEL "400" FISCHER DELUXE DIATHERMY VACUUM CONDENSER SUPP. ~ RIGHT

H. G. FISCHER & CO.
2335 WABANSIA AVE.
CHICAGO, ILL.

CAT. NO.

PART NO. 16390F

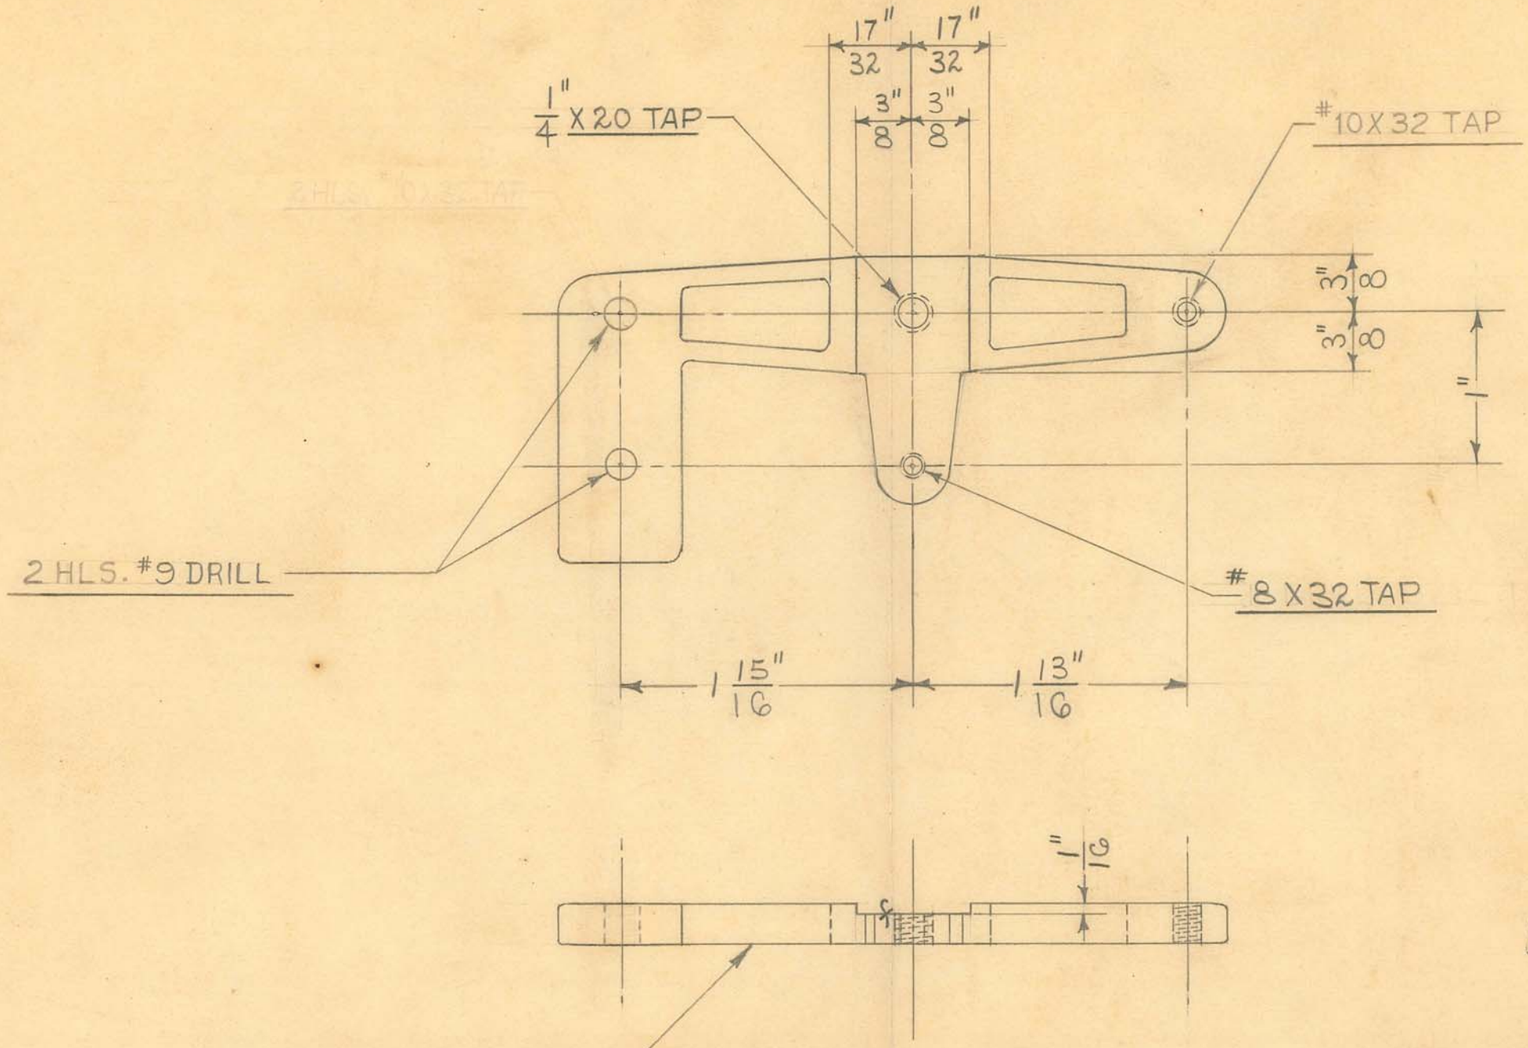

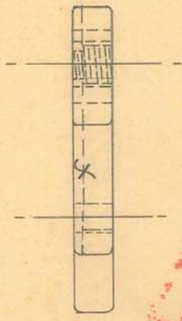

OBSOLETE

XX Absolete 2-7-49

GRIND OFF PROMINENT ROUGH SPOTS ONLY

SAND THIS SURFACE FLAT ON SANDING DISC & REMOVE SHARP EDGES AFTER SANDING

1 REQUIRED

MILLING FIXTURE TOOL # 9692
DRILL JIG TOOL # 9691

SIZE	CAST IN	ISSUE 12-6-47	W.J.
KIND	BRASS	CHANGED	
SHAPE		"	
FINISH		"	
TEMP.		"	

DIMENSIONS
FRACTIONAL ± .015
DECIMAL ± .005
ANGULAR ± 1/2°

TITLE:
MODEL "400" FISCHER DELUXE DIATHERMY VACUUM CONDENSER SUPP. ~ LEFT

H. G. FISCHER & CO.
2335 WABANSIA AVE.

CAT. NO.

PART NO. 10391

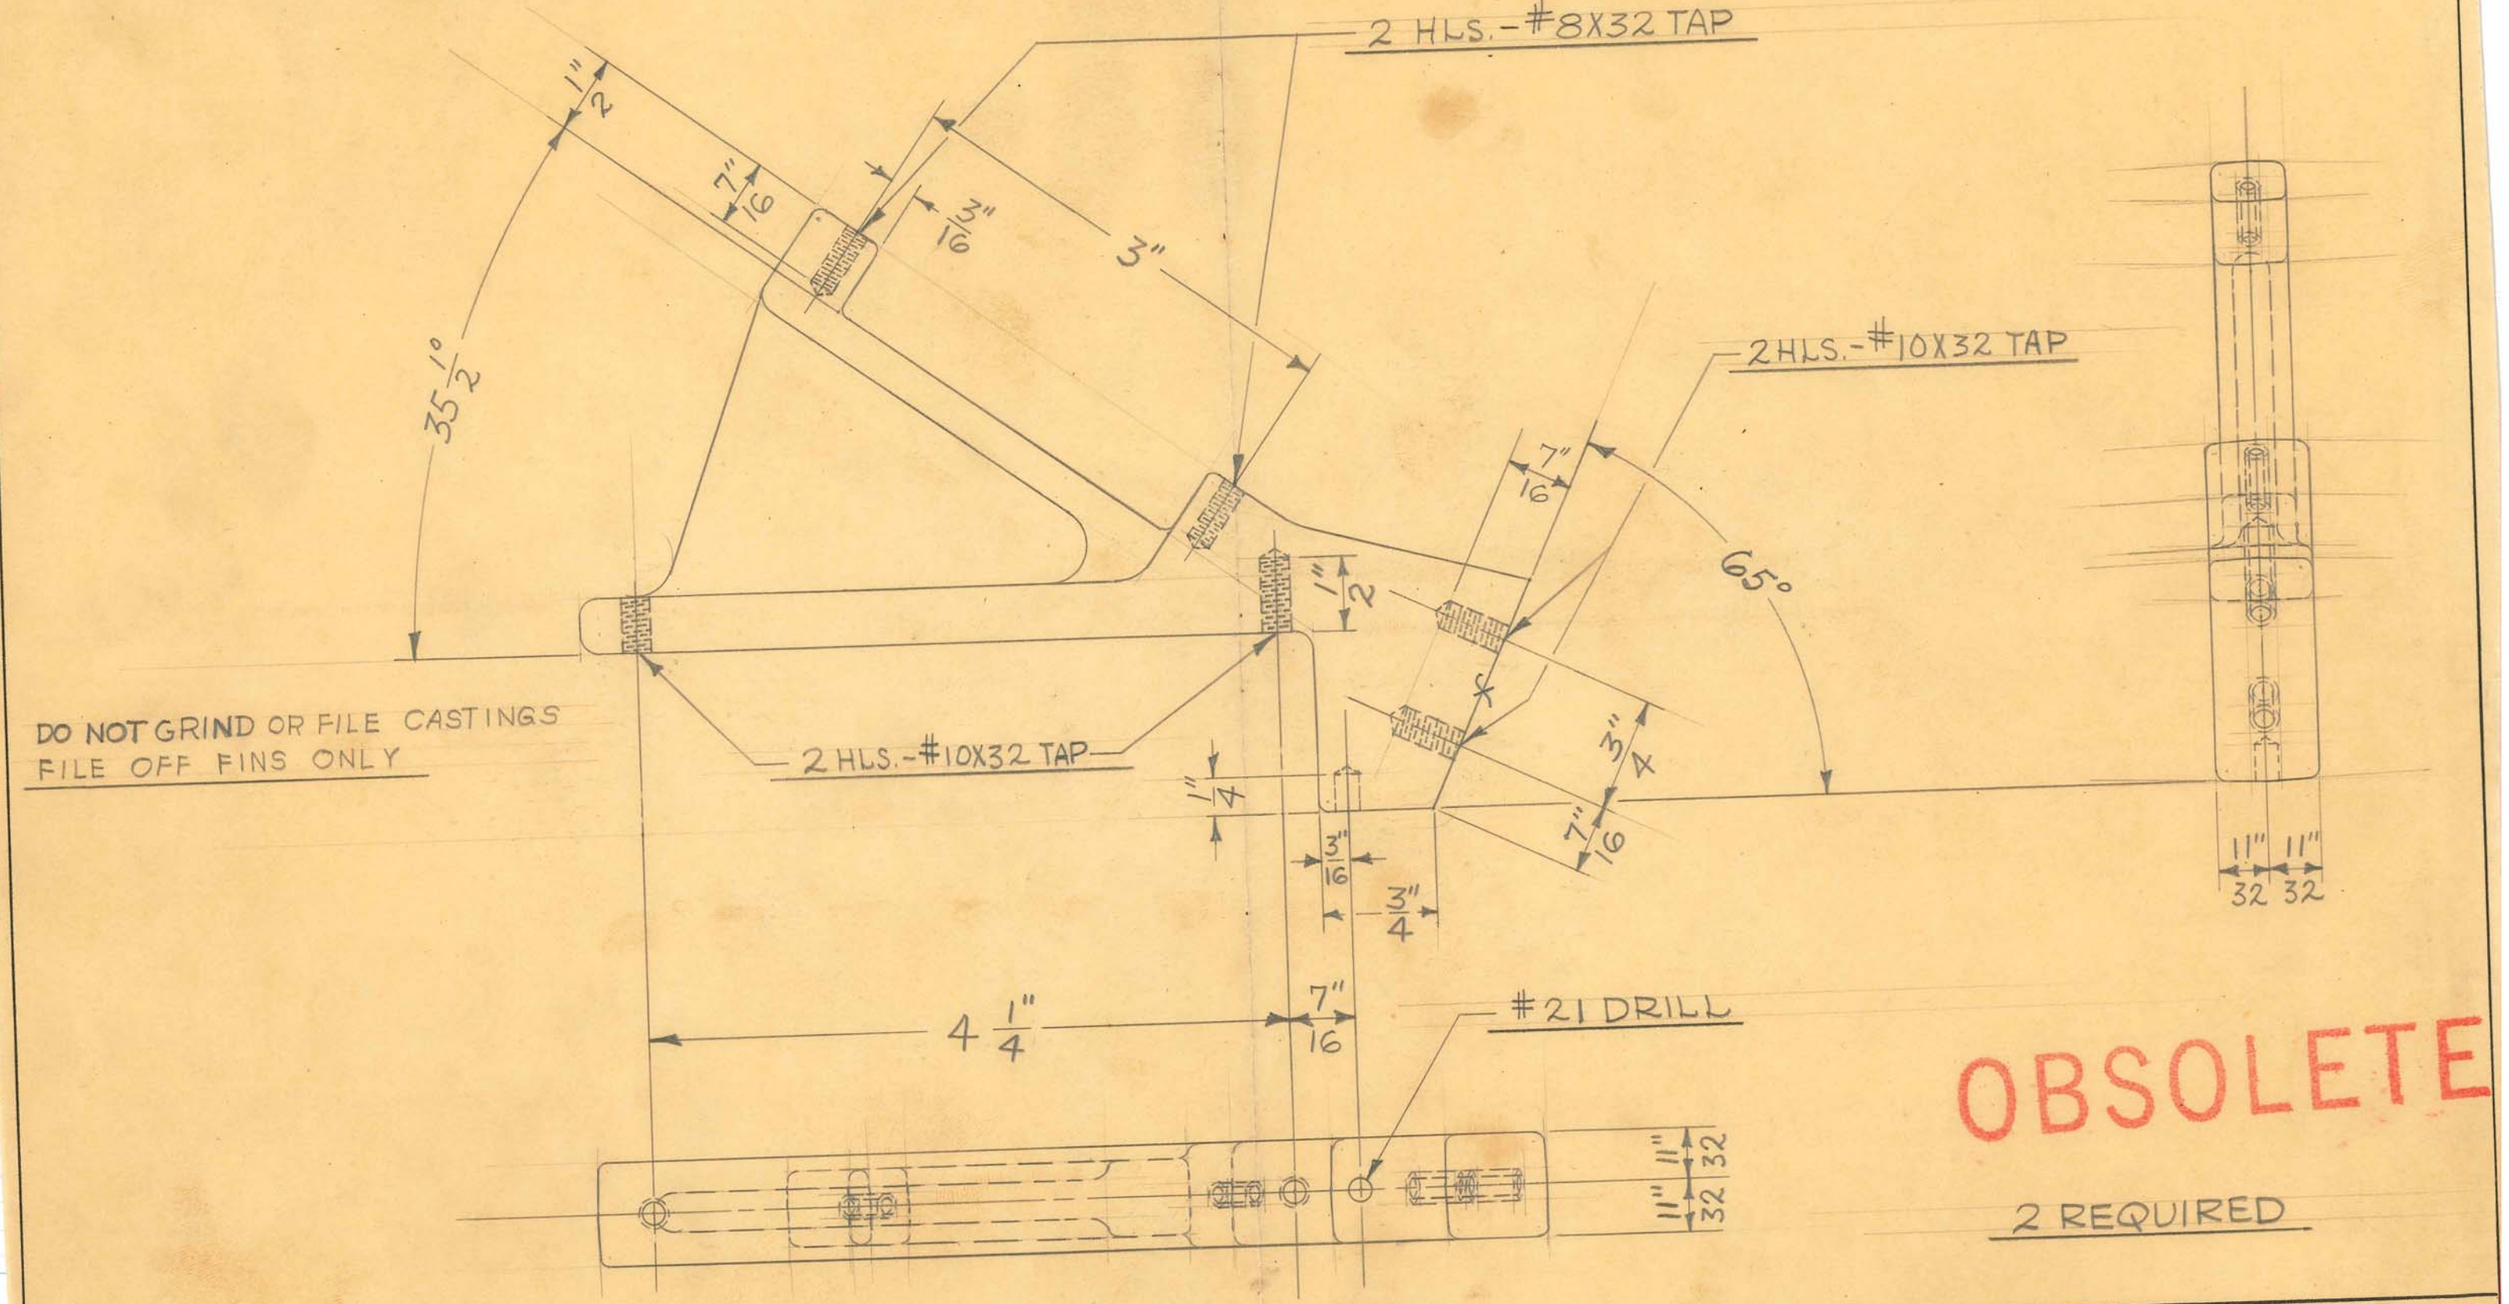

DO NOT GRIND OR FILE CASTINGS
FILE OFF FINS ONLY

OBSOLETE

2 REQUIRED

SIZE	#12	ISSUE 4-1-47	J.V.W.
KIND	ALUMINUM	CHANGED 7-16-47	W.J.
SHAPE		"	
FINISH		"	
TEMP.		"	
PATT.	2193	"	

TITLE: FISCHER "MP-20" X-RAY UNIT
TRANSF. SUPPORT

H. G. FISCHER & CO.
2335 WABANSIA AVE.
CHICAGO, ILL.

CAT. NO.

PART NO. 16586F

MILLING FIXTURE TOOL #9264 6-6-47 F.O. 172

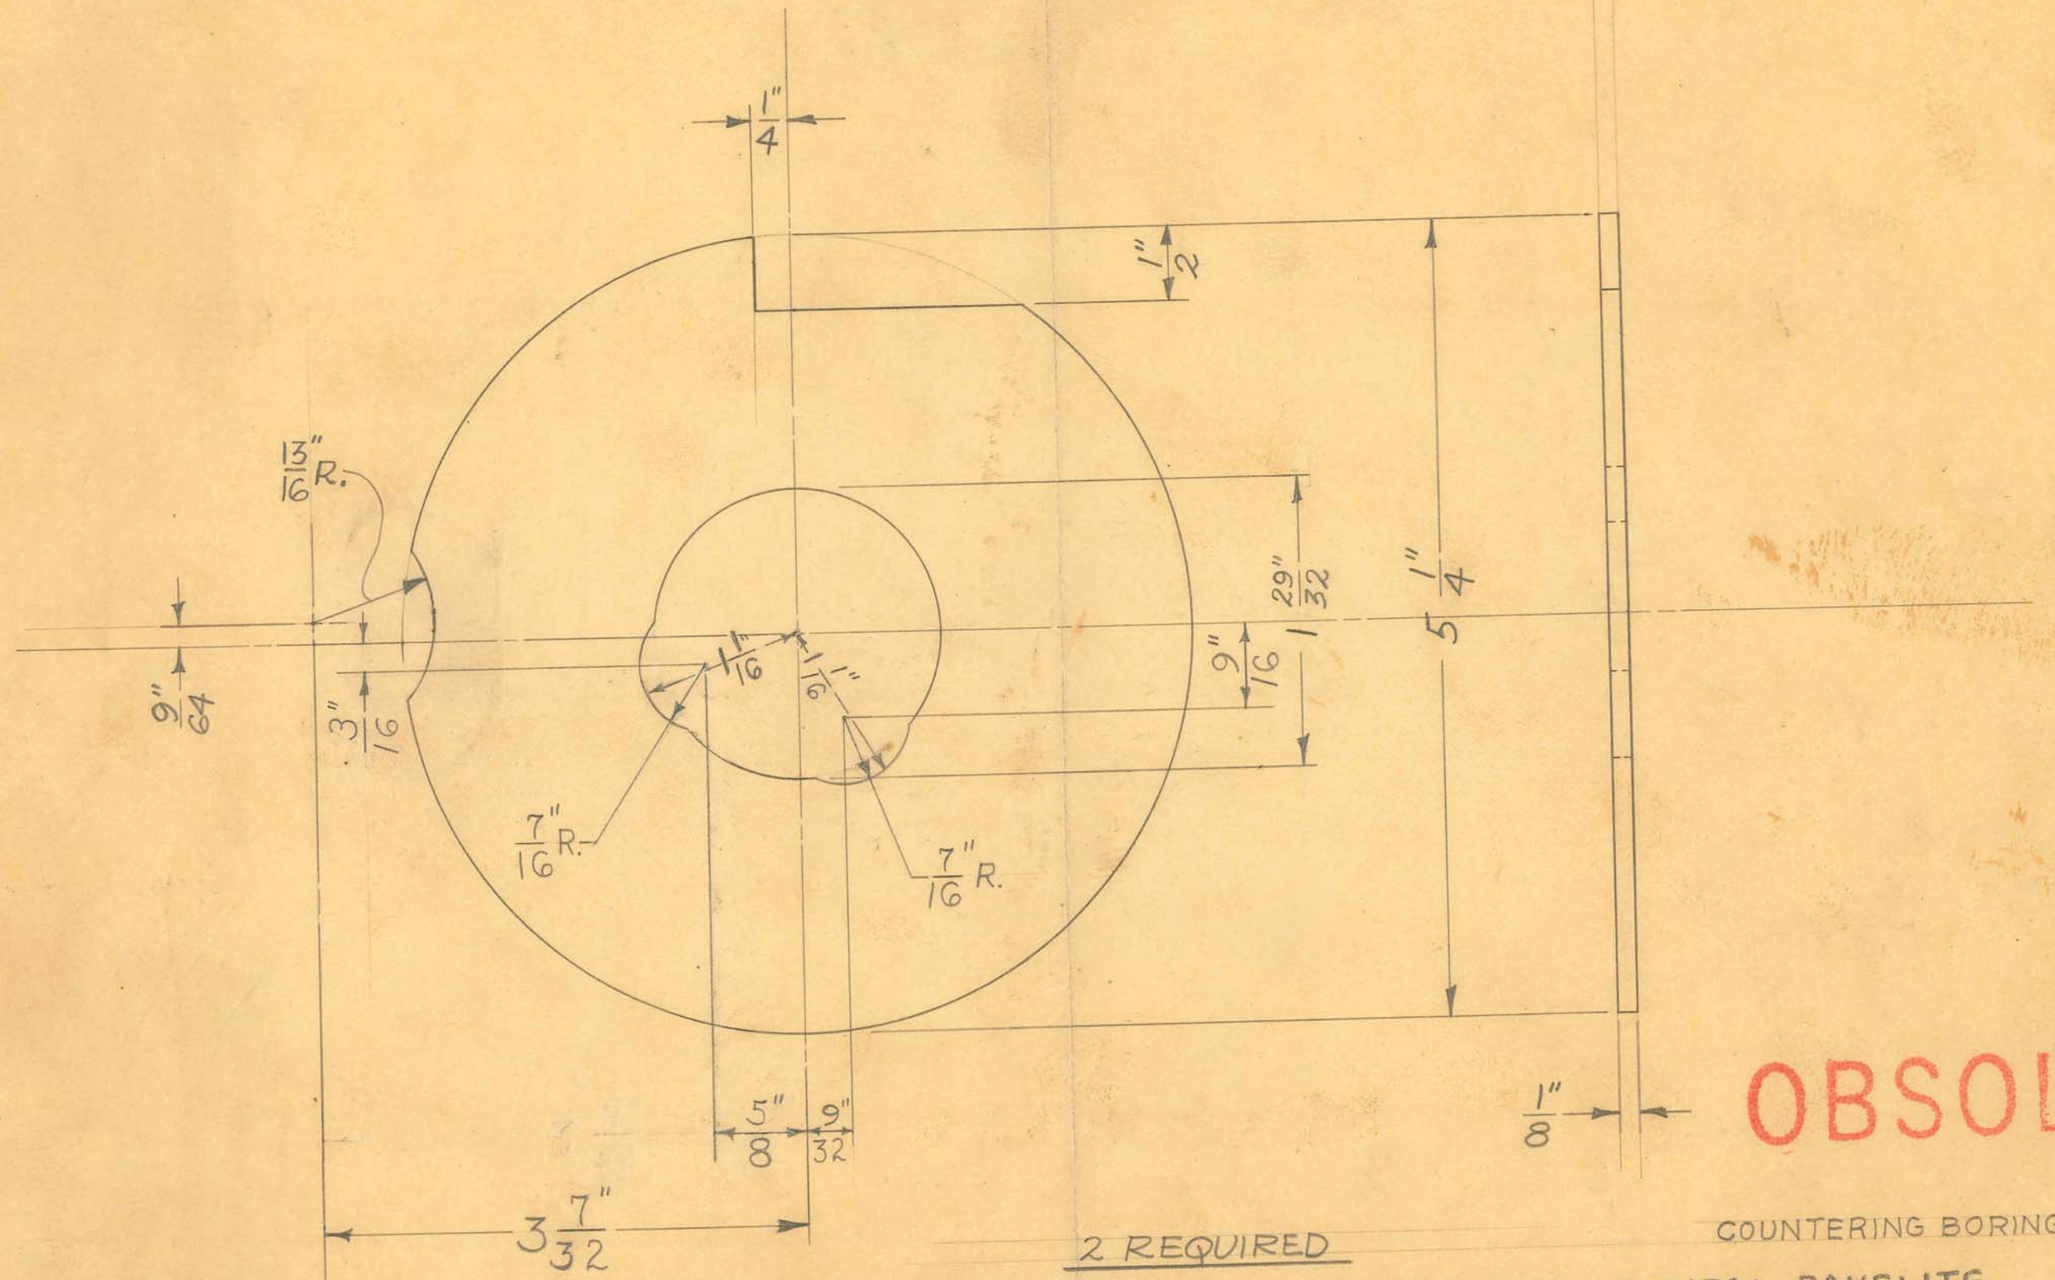

OBSOLETE

2 REQUIRED

COUNTERING BORING TOOL # 9741.

1/8" SHEET CANVAS BASE NATURAL BAKELITE

SIZE	~~1/8" SHEET~~	ISSUE 4-1-47	J.Y.W.	TITLE: FISCHER "MP-20" X-RAY UNIT TRANSFORMER SHIELD-END
KIND	~~CANVAS BASE~~	CHANGED 9-5-47	W.J.	
SHAPE	~~BLK. BAKELITE~~	"		
FINISH		"		
TEMP.		"		
PATT.		"		

H. G. FISCHER & CO.
2338 WABANSIA AVE.
CHICAGO, ILL.

CAT. NO.

PART NO. 16591

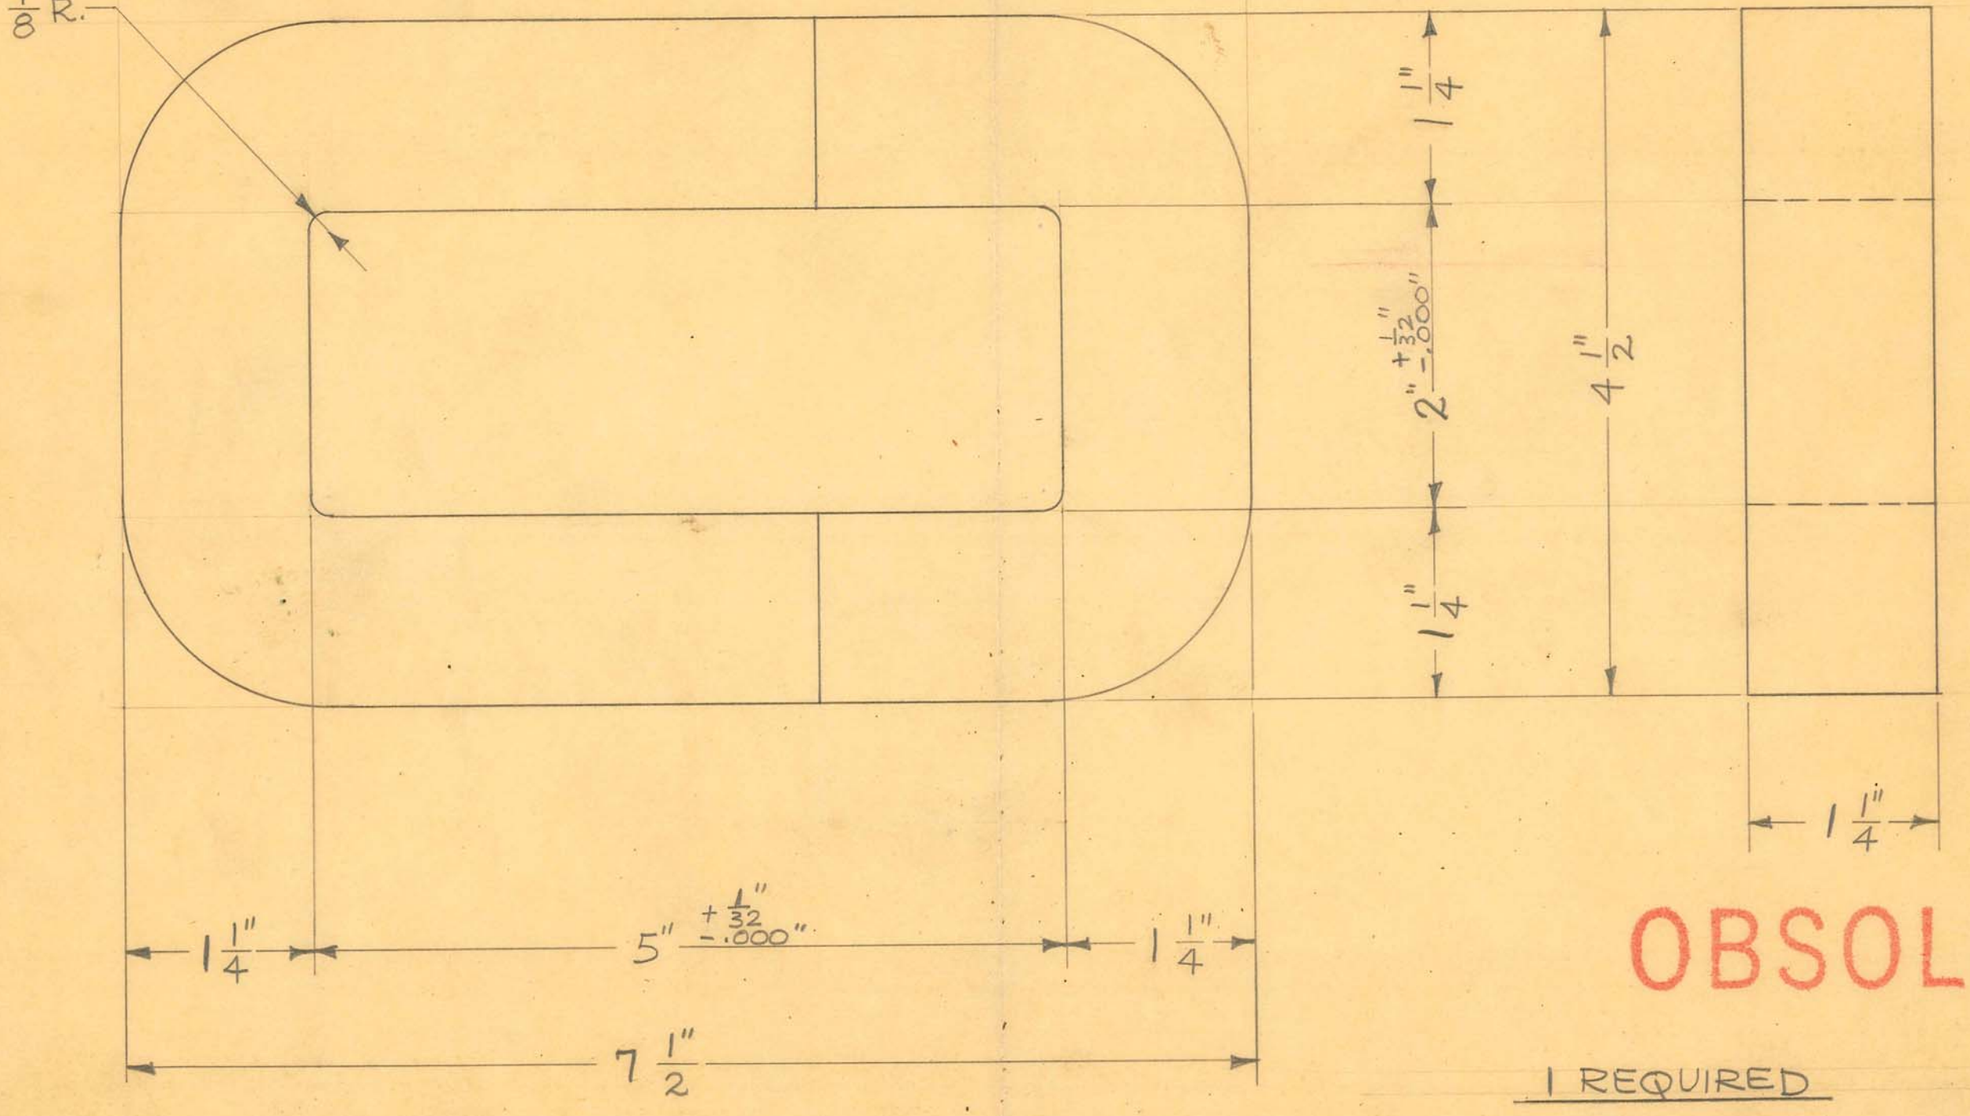

OBSOLETE

1 REQUIRED

SIZE		ISSUE 4-30-47	J.V.W.
KIND	HYPERSIL	CHANGED	
SHAPE		"	
FINISH		"	
TEMP.		"	
PATT.		"	

TITLE: FISCHER "MP-20" X-RAY UNIT
HYPERSIL CORE

H. G. FISCHER & CO.
2335 WABANSIA AVE.
CHICAGO, ILL.

CAT. NO.

PART NO. 16603

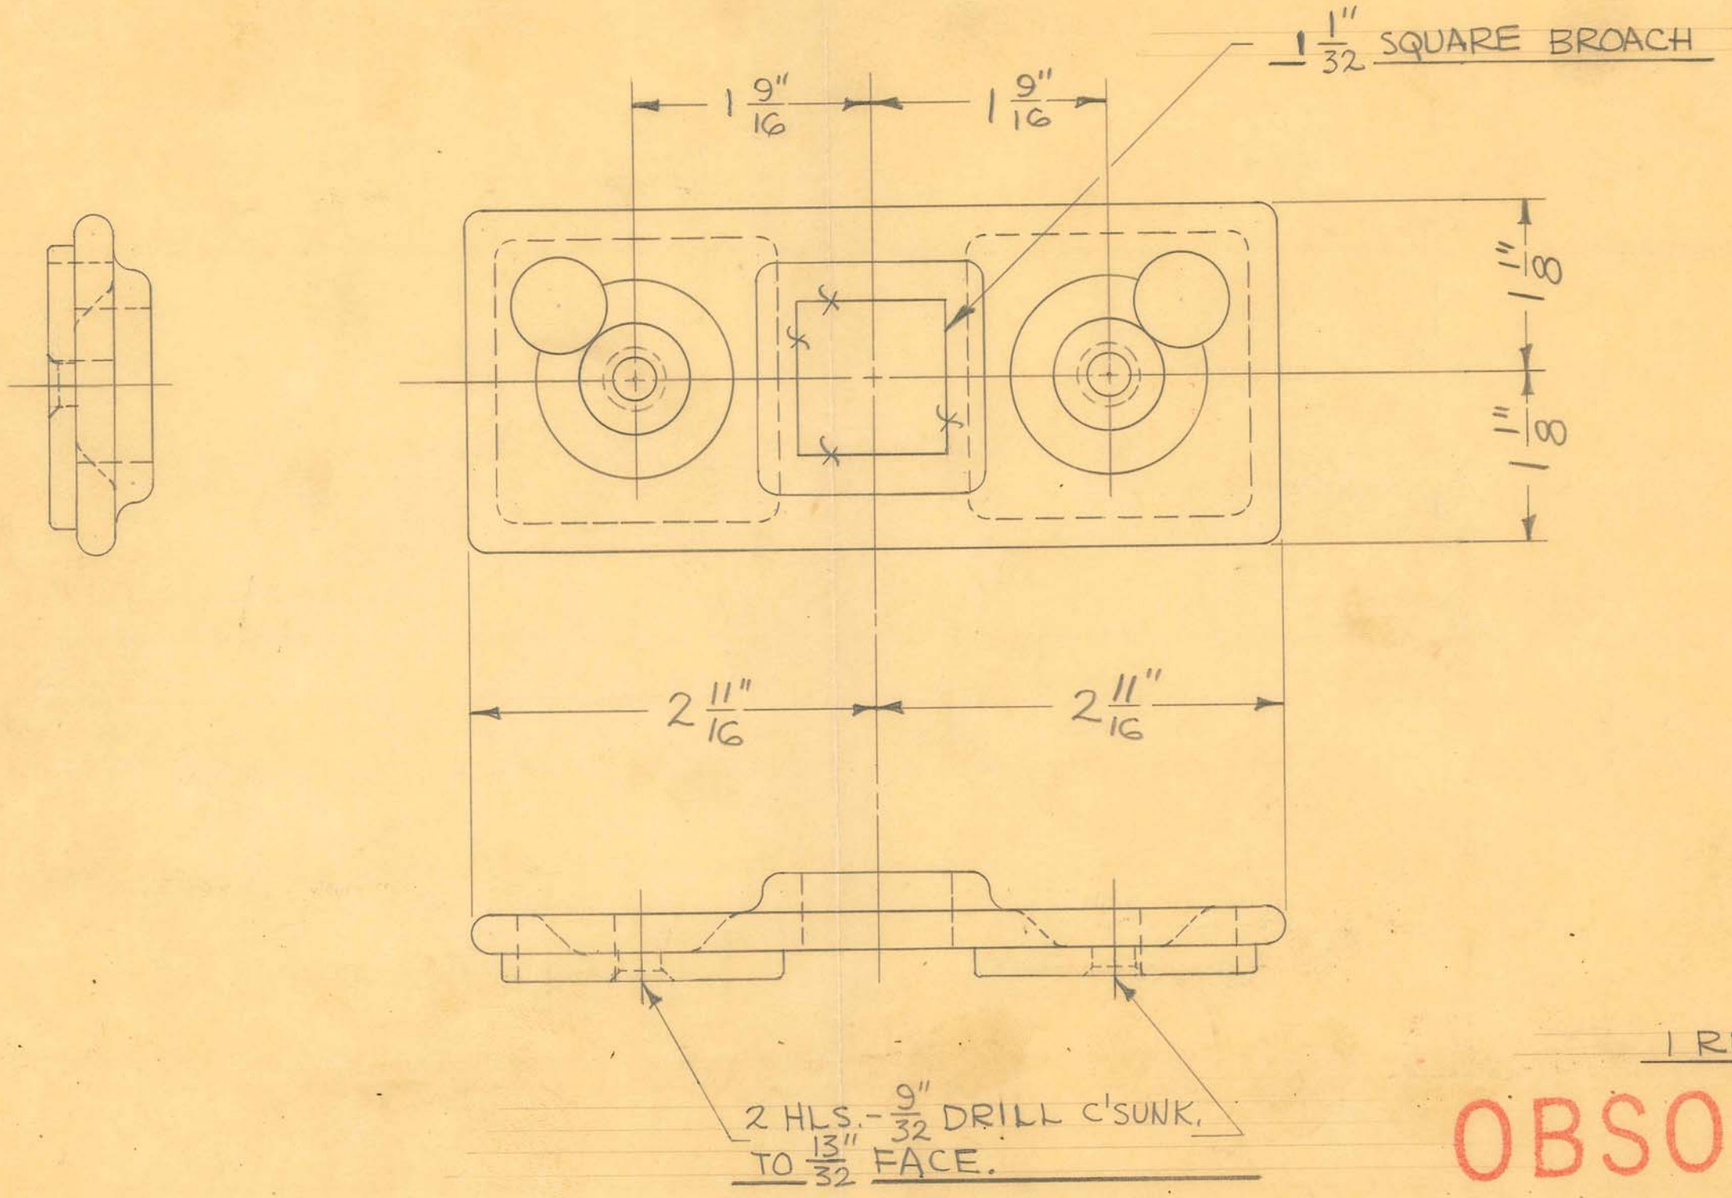

1 REQUIRED

OBSOLETE

6-2-47 F.O. 9973 BROACHING FIXTURE & BROACH TOOL #9255
DRILL JIG TOOL #9236

SIZE	BRASS	ISSUE 5-17-47	J.V.W.
KIND	CASTING	CHANGED	
SHAPE		"	
FINISH		"	
TEMP.		"	

TITLE: FISCHER "MP-10" X-RAY UNIT CWT. BOTTOM CAP

H. G. FISCHER & CO.
2338 WABANSIA AVE.

CAT. NO.

PART NO. 16631F

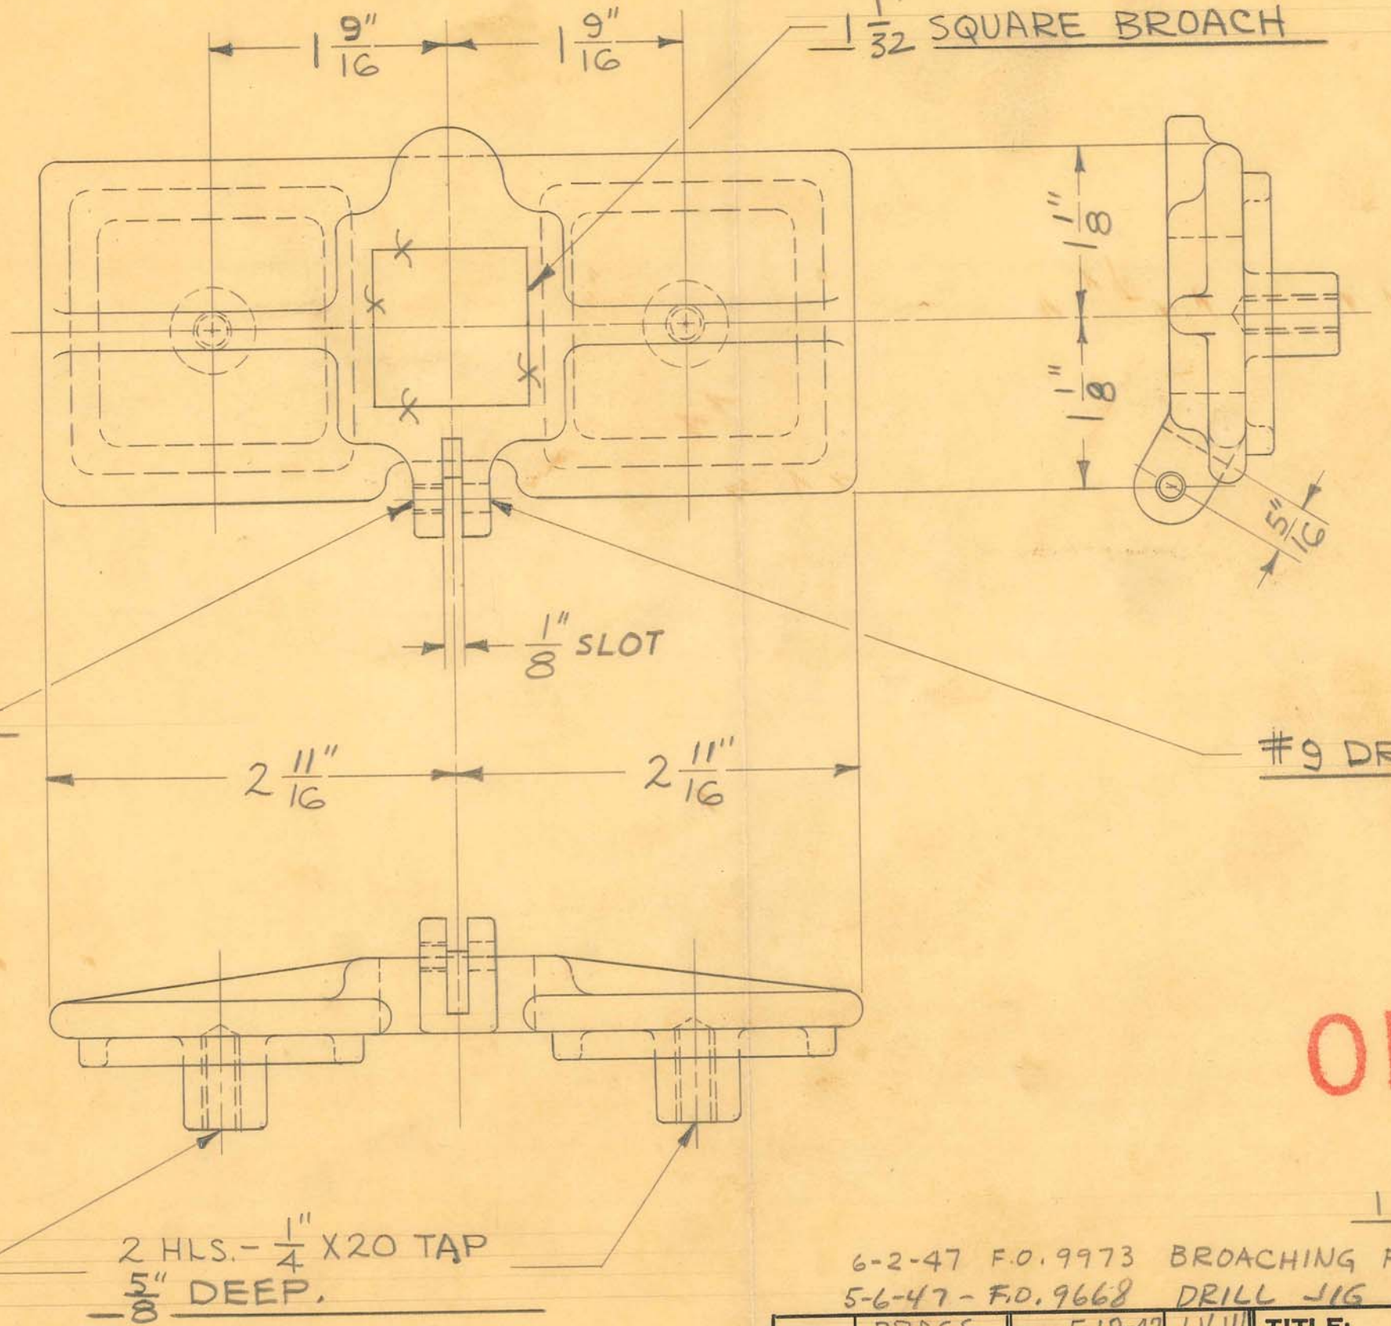

5-6-47 F.O. 9668 MILL. FIX. TOOL #9259

OBSOLETE

1 REQUIRED

6-2-47 F.O. 9973 BROACHING FIXTURE & BROACH TOOL #9255
5-6-47 - F.O. 9668 DRILL JIG TOOL #9236

SIZE	BRASS	ISSUE 5-19-47	J.V.W.
KIND	CASTING	CHANGED	
SHAPE		"	
FINISH		"	
TEMP.		"	
	2081	"	

TITLE: FISCHER "MP-10" X-RAY UNIT CWT. TOP CAP

H. G. FISCHER & CO.
2335 WABANSIA AVE.
CHICAGO, ILL.

CAT. NO.

PART NO. 16632F

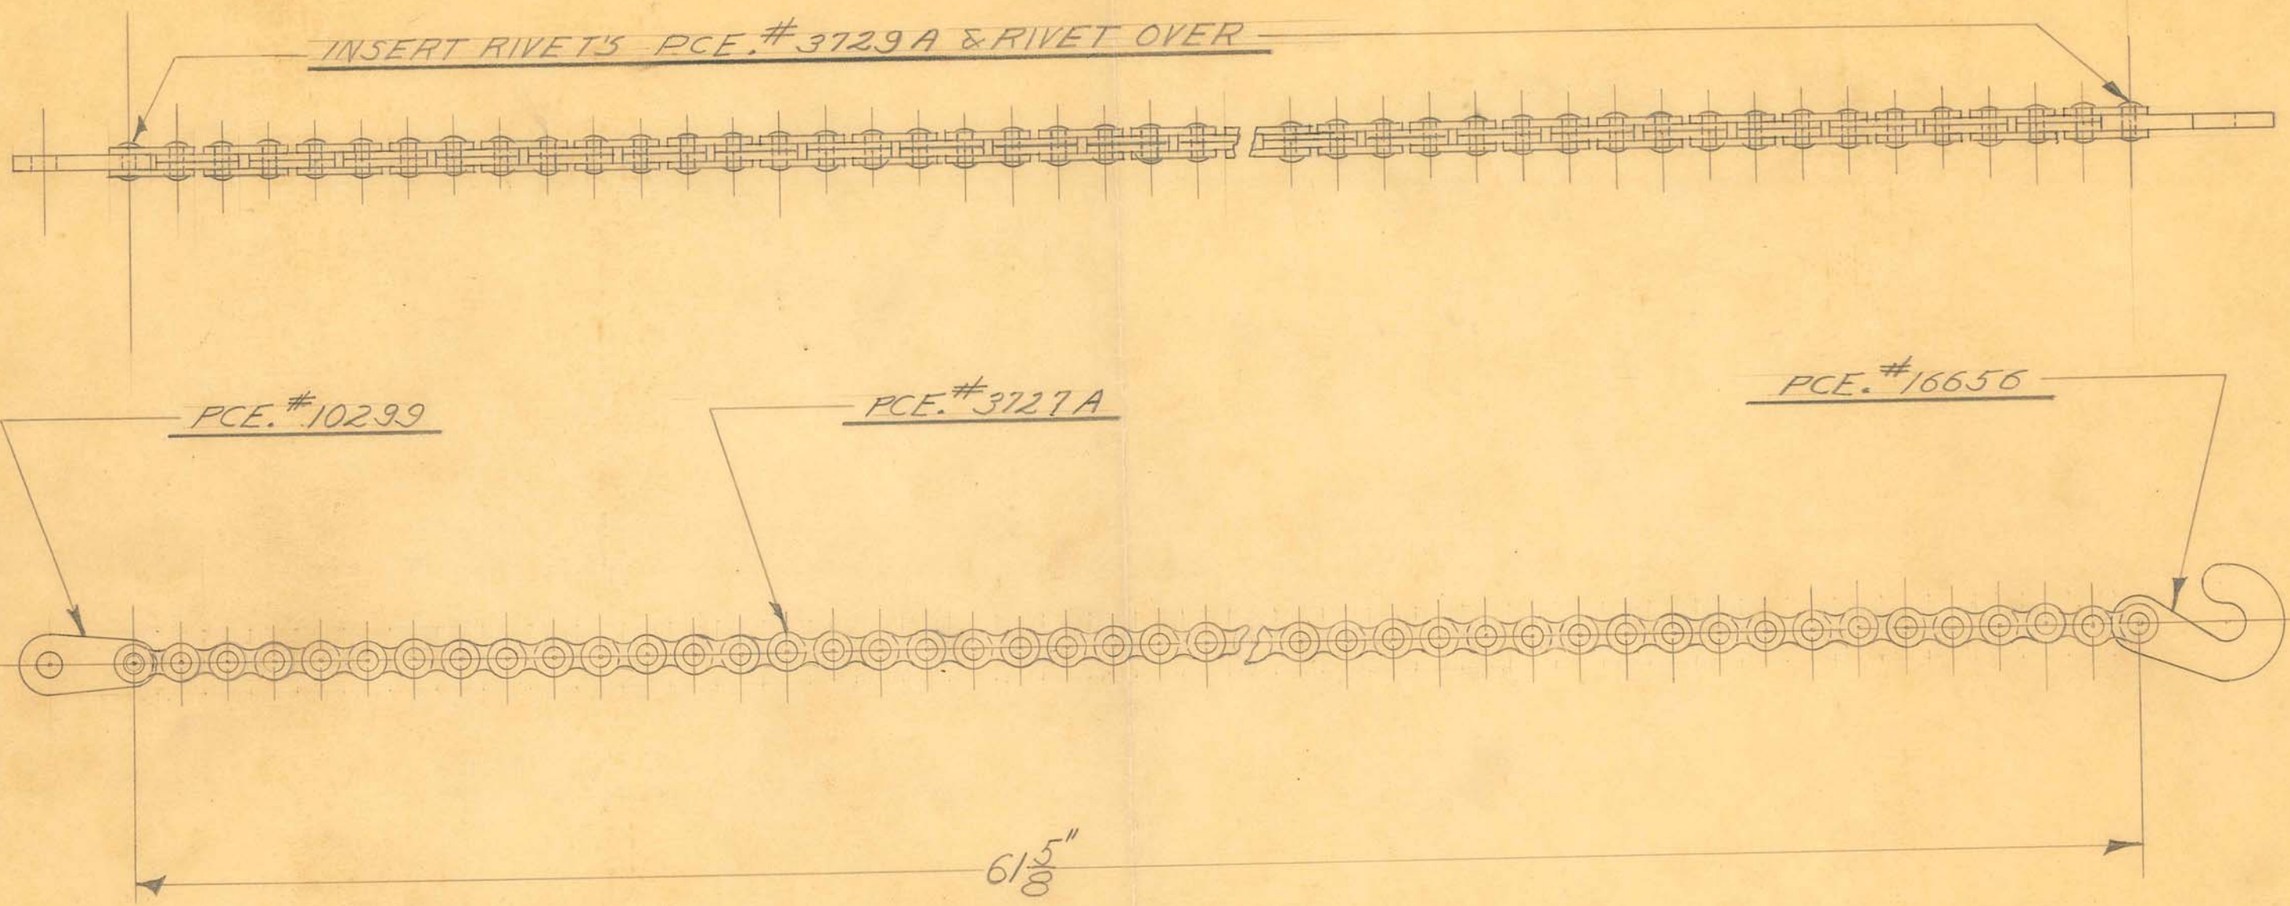

1-REQUIRED

OBSOLETE

SIZE		ISSUE 9-2-47	J.M.F	TITLE: FISCHER "MP-10" X RAY UNIT CWT. CHAIN ASSEM.
KIND		CHANGED		
SHAPE		"		
FINISH	CAD. #23	"		
TEMP.		"		
PATT.		"		

H. G. FISCHER & CO.
2335 WABANSIA AVE.
CHICAGO. ILL.

CAT. NO.

PART NO. 16671G

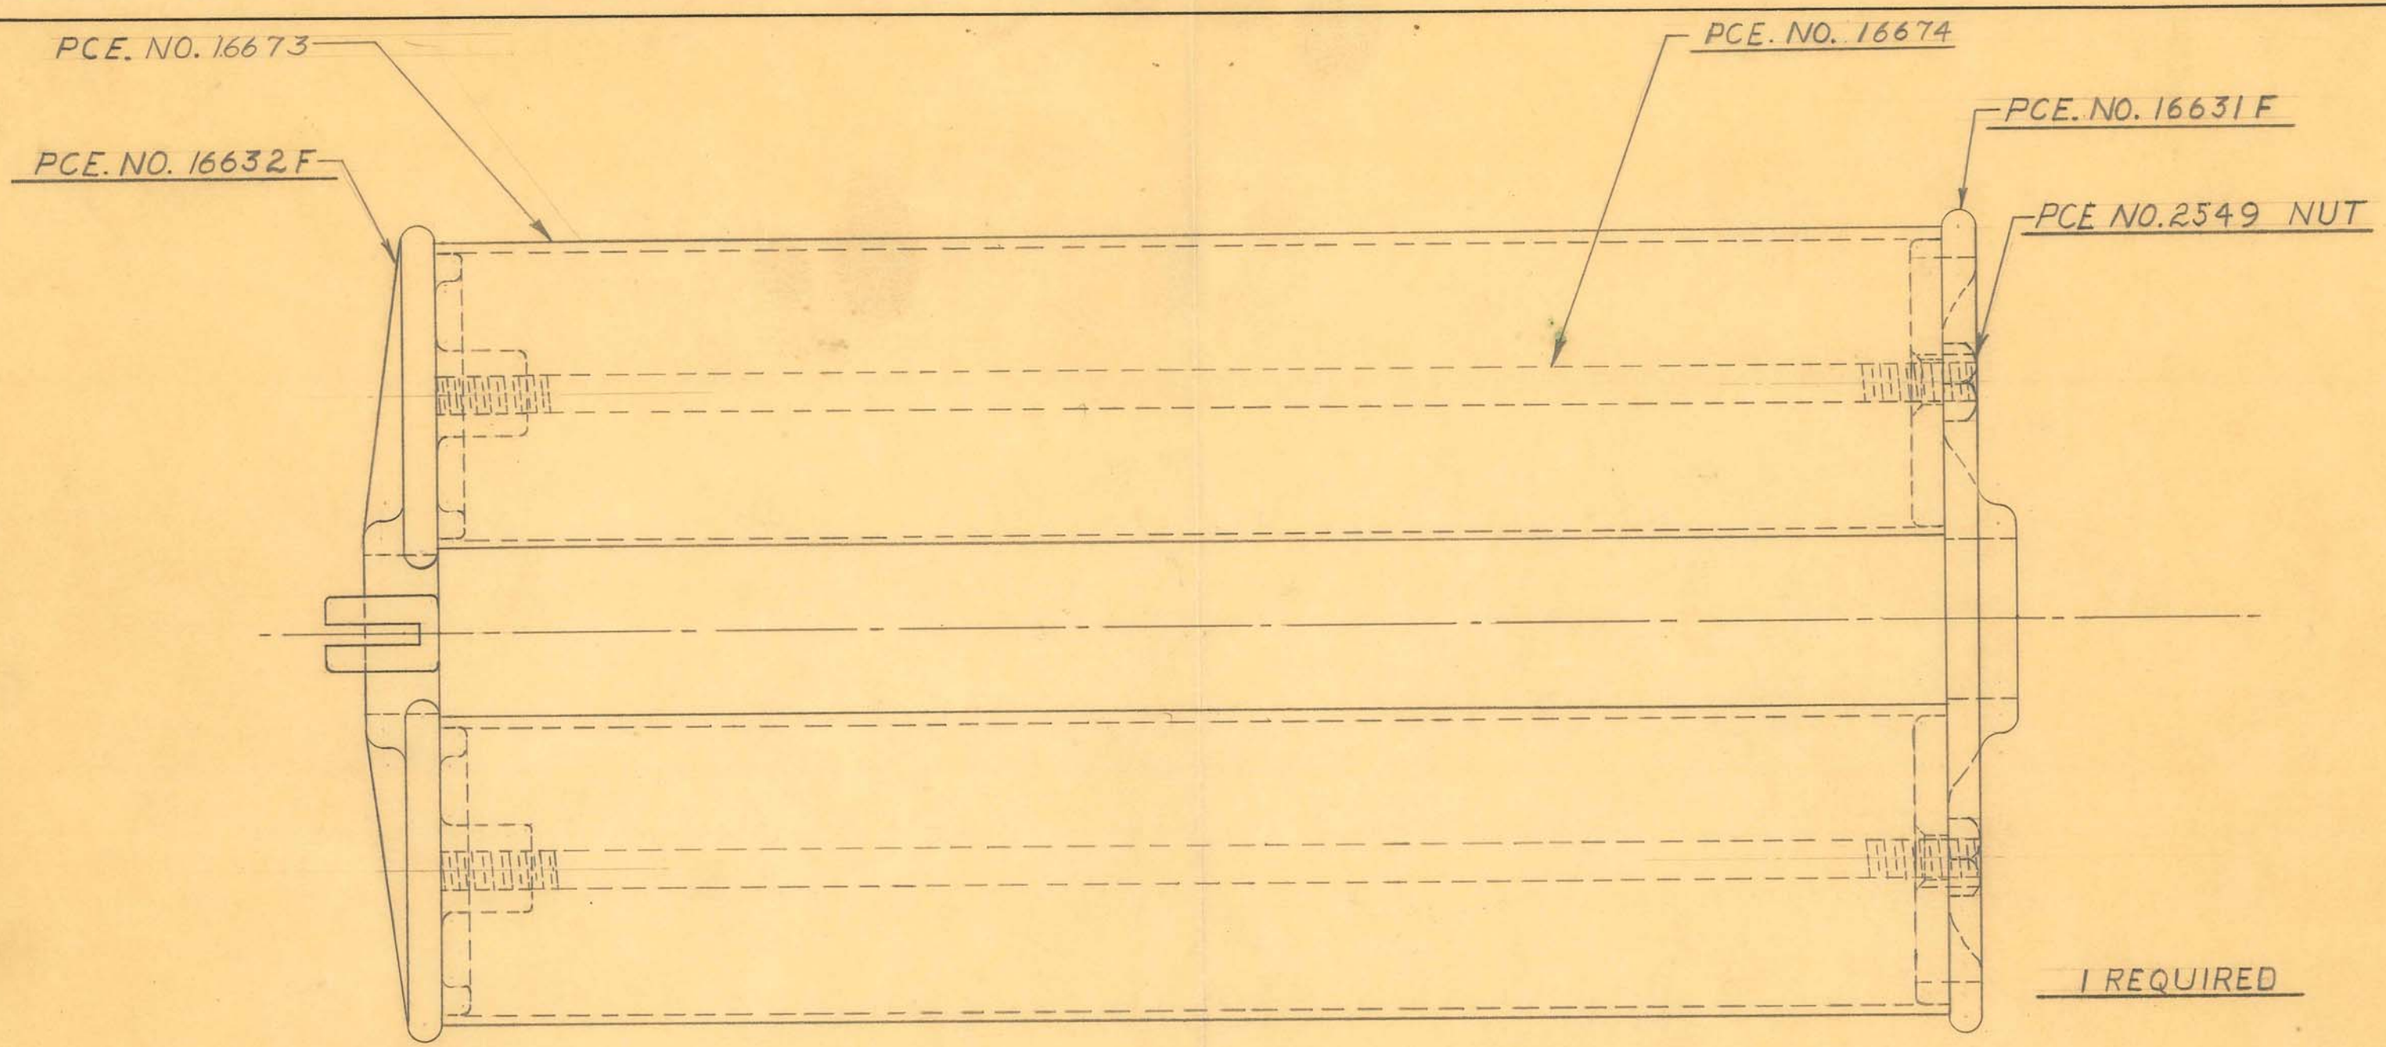

1 REQUIRED

FILL BOTH TUBES WITH LEAD TO BRING TOTAL WEIGHT UP TO 33 LBS. $^{+1\,LB.}_{-0\,LBS.}$

OBSOLETE

SIZE		ISSUE 6-3-47	W.J.	TITLE: FISCHER "MP-10" X-RAY UNIT COUNTERWEIGHT ASSEMBLY
KIND		CHANGED		
SHAPE		"		
FINISH	PAINTED	"		
TEMP.		"		
PATT.		"		

H. G. FISCHER & CO. 2335 WABANSIA AVE. CHICAGO, ILL.	CAT. NO.	PART NO. 166726

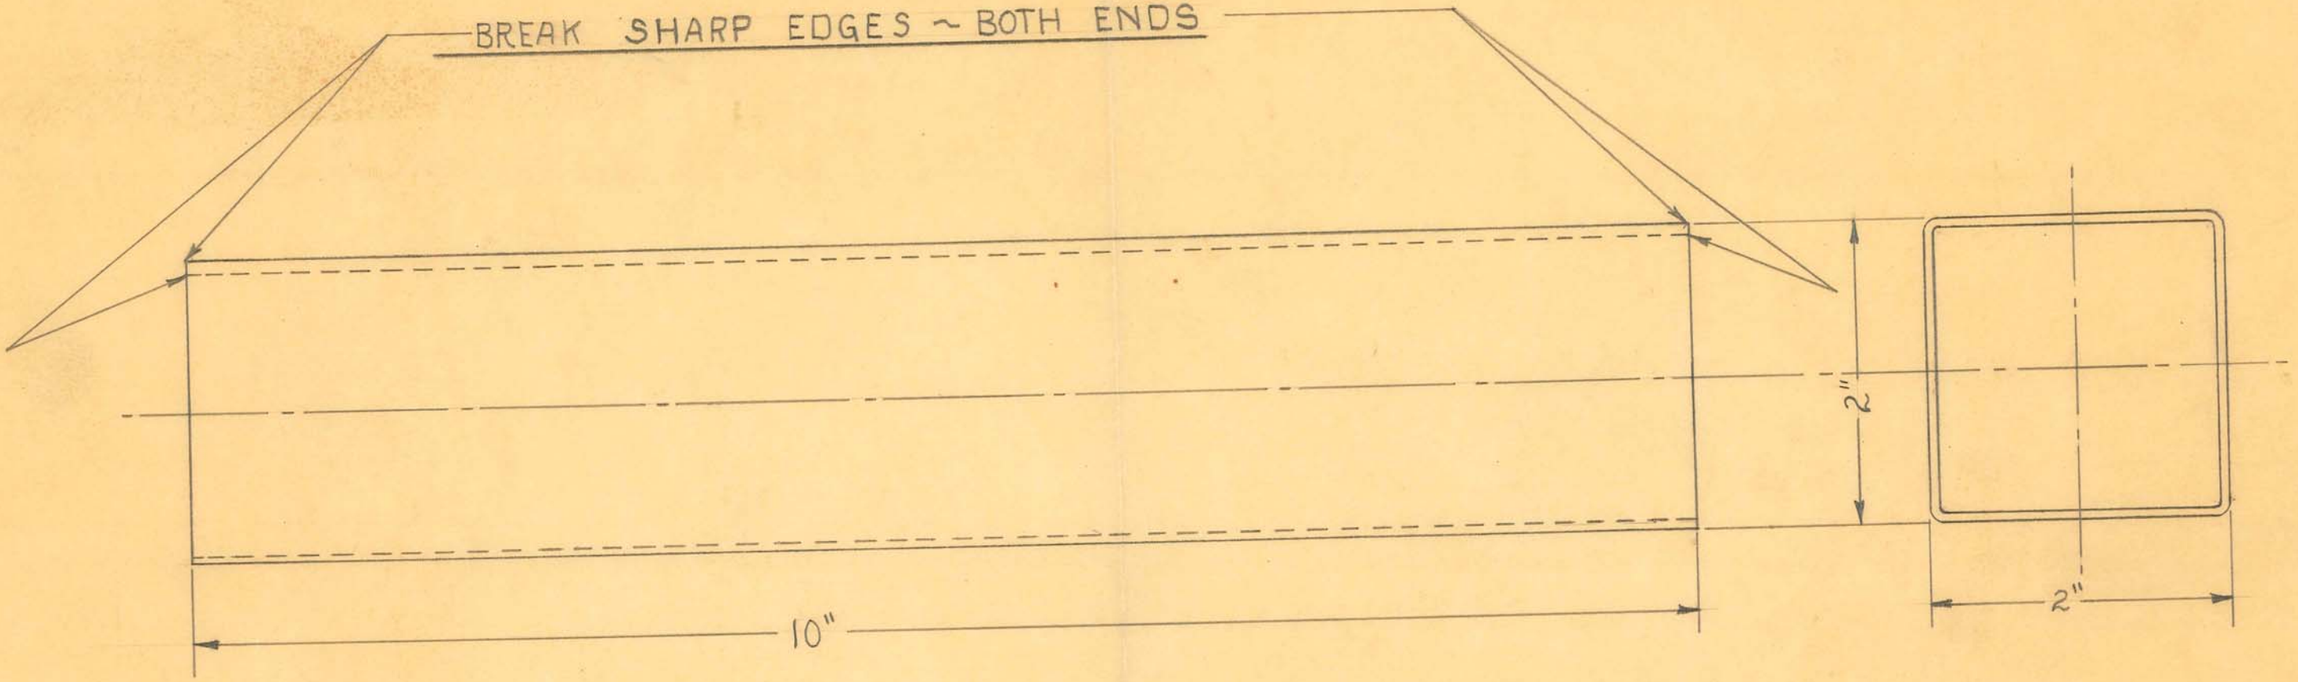

2 REQUIRED

2"X2"X#16 GA.(.065") WALL. WELDED SQUARE TUBING

OBSOLETE

SIZE		ISSUE 6-2-47	W.J.
KIND		CHANGED	
SHAPE		"	"
FINISH		"	
TEMP.		"	
PATT.		"	

TITLE: FISCHER "MP-10" X-RAY UNIT
CWT. TUBE

H. G. FISCHER & CO.
2335 WABANSIA AVE.
CHICAGO, ILL.

CAT. NO.

PART NO. 16673

DO NOT GRIND OR FILE CASTING
FILE OFF FINS ONLY

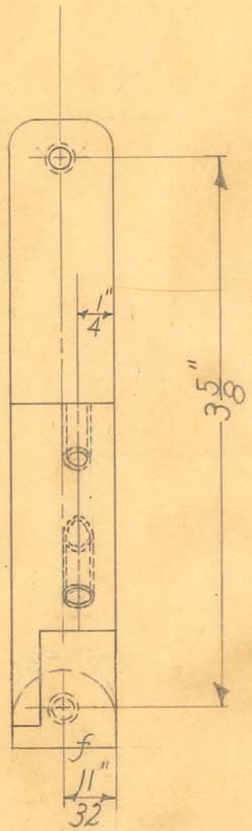

#10 X 32 TAP
3 HOLES

PCE. # 16706

INSERT STUDS ON BOTTOM SIDE
AND PLACE IN MILLING JAW
AND MACHINE THIS SURFACE

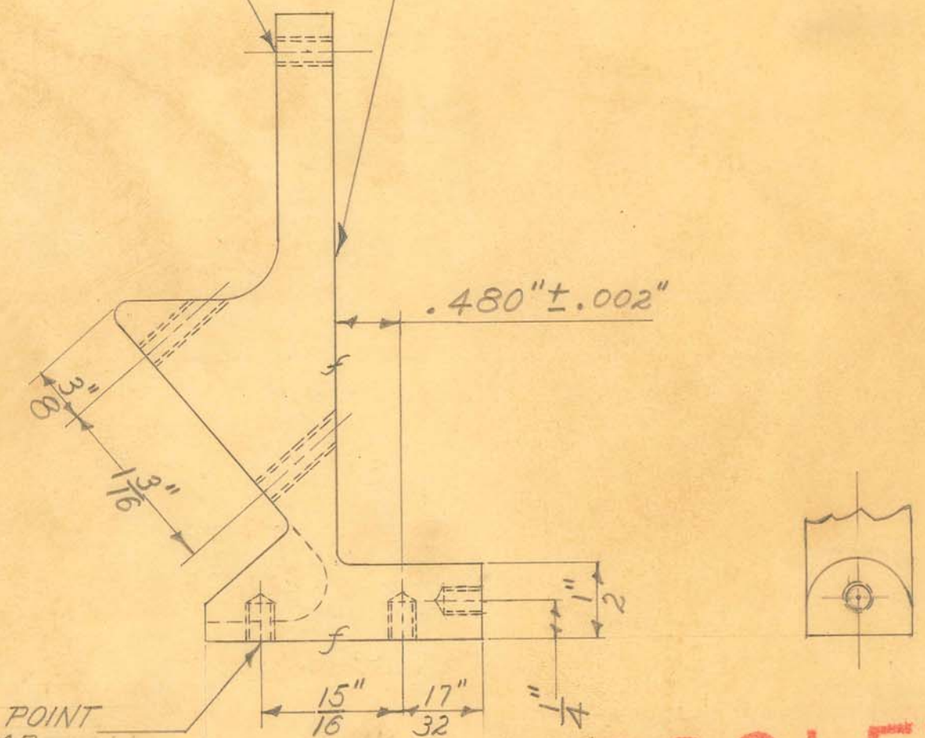

#20 DRILL, 5/16" DEEP TO POINT
#10 X 32 BOTTOM TAP
3 HOLES

OBSOLETE

1 - REQUIRED

MILLING GAUGE .480" ± .002" TOOL # 9474
MILLING JAWS TOOL # 9466
MILLING FIXTURE TOOL # 9303
DRILL JIG TOOL # 9302

DIMENSIONS	
FRACTIONAL	± 1/64
DECIMAL	± .005
ANGULAR	± 1/2°
UNLESS OTHERWISE SPECIFIED	

SIZE		ISSUE 10-6-47	J.M.F
KIND	AL. CASTING	CHANGED	
SHAPE		"	
FINISH		"	
TEMP.		"	
PATT.	2039	"	

TITLE:
FISCHER "MP-10" X-RAY UNIT
TRANSFORMER SUPPORT - LEFT

H. G. FISCHER & CO.
2338 WABANSIA AVE.
CHICAGO, ILL.

CAT. NO.

PART NO. 16683F

DO NOT GRIND OR FILE CASTING
FILE OFF FINS ONLY

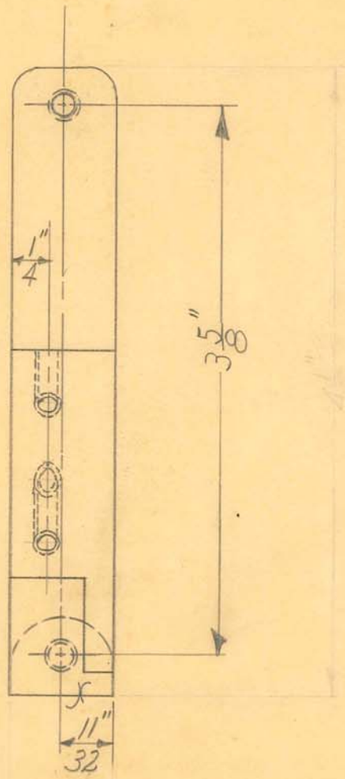

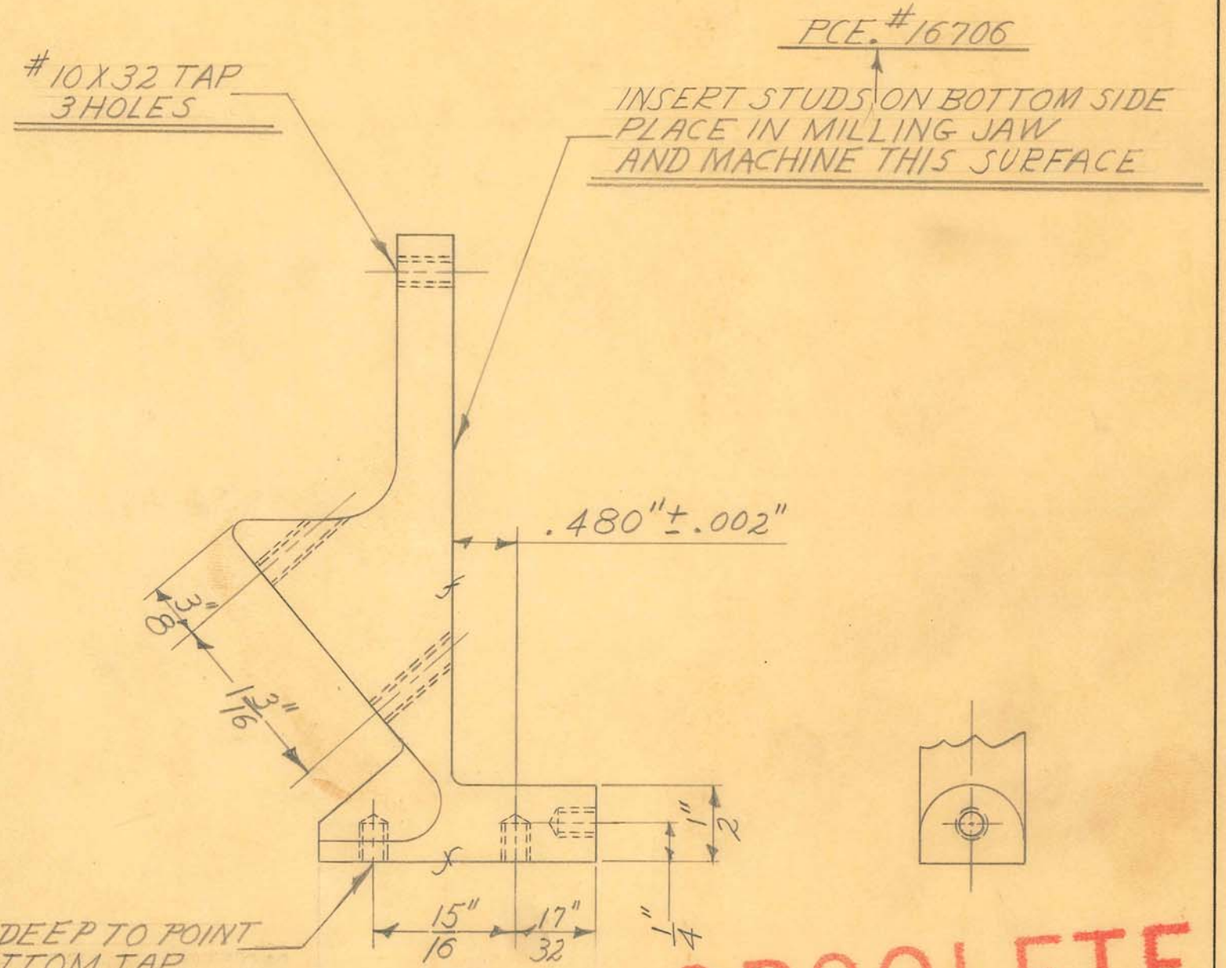

OBSOLETE

1-REQUIRED

MILLING GAUGE .480" ± .002" TOOL # 9474
MILLING JAWS TOOL # 9466
MILLING FIXTURE TOOL # 9303
DRILL JIG TOOL # 9302

DIMENSIONS	
FRACTIONAL	± .015
DECIMAL	± .005
ANGULAR	± 1/2°

UNLESS OTHERWISE SPECIFIED

SIZE		ISSUE 10-7-47	J.M.F
KIND	AL. CASTING	CHANGED	
SHAPE		"	
FINISH		"	
TEMP.		"	
PATT.	2040	"	

TITLE: FISCHER "MP-10" X RAY UNIT
TRANSFORMER SUPPORT - RIGHT

H. G. FISCHER & CO.
2335 WABANSIA AVE.
CHICAGO, ILL.

CAT. NO.

PART NO. 16684F

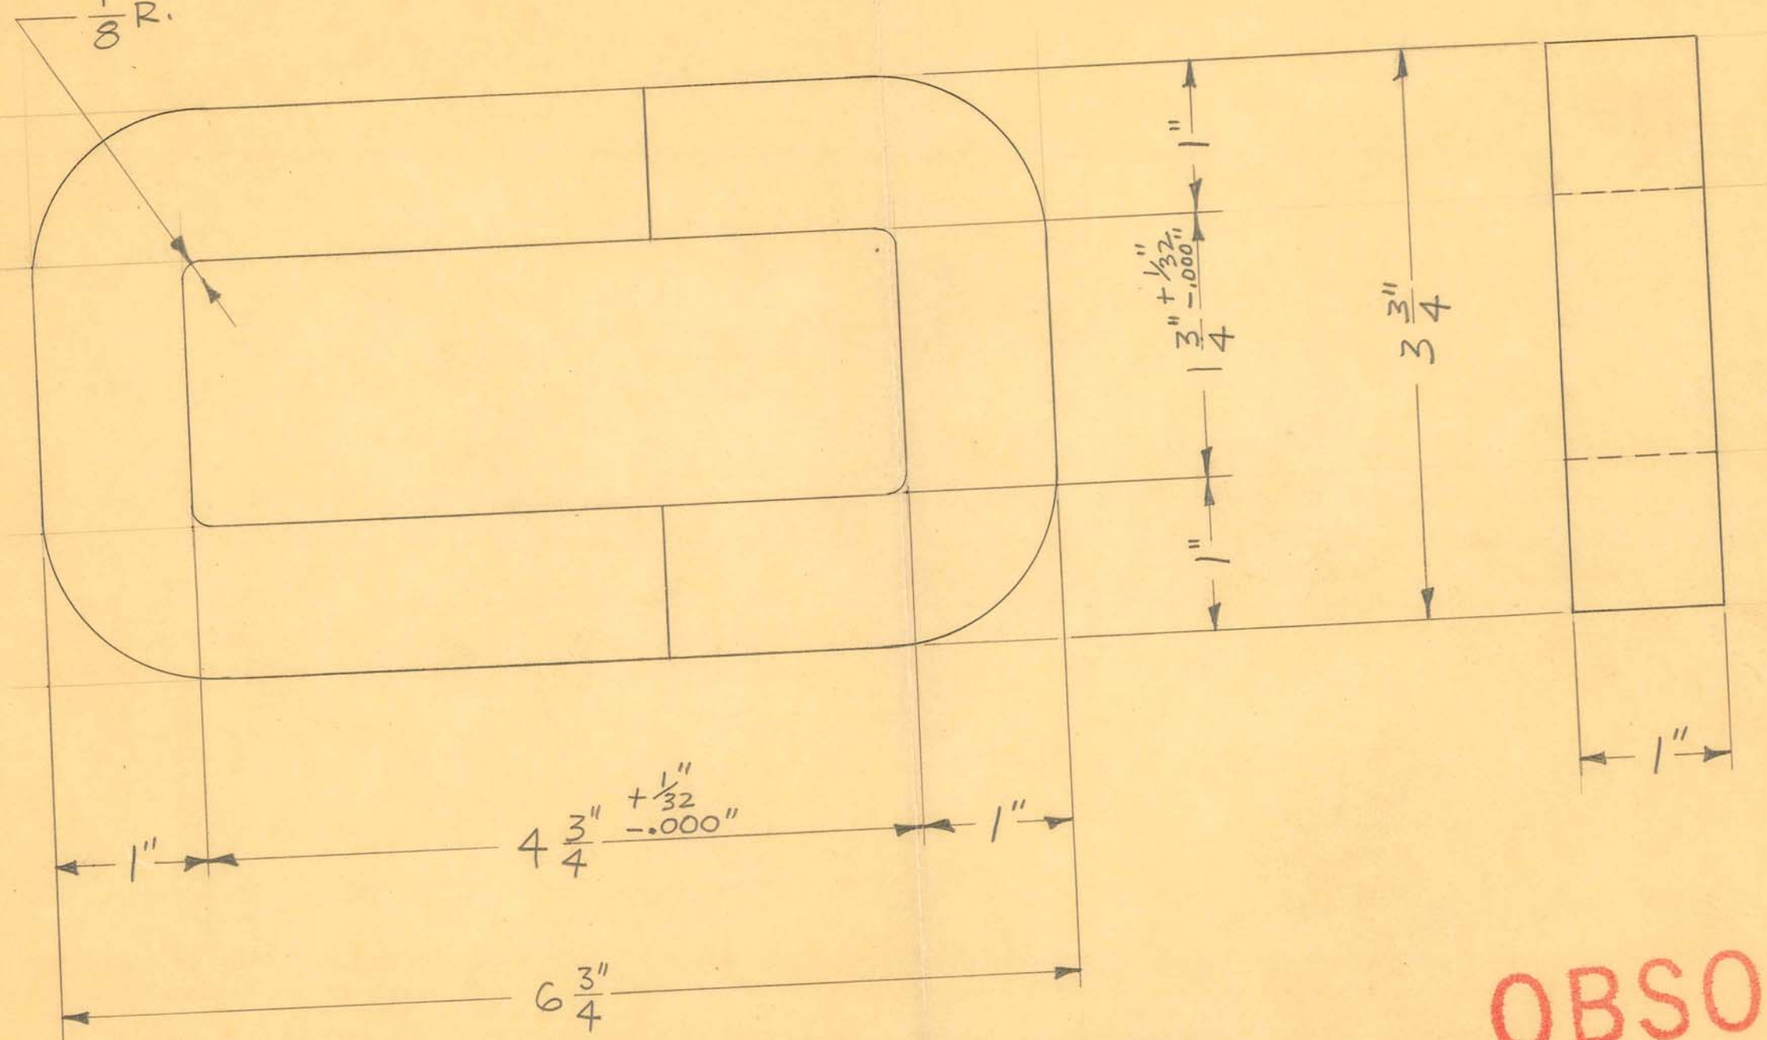

OBSOLETE

1 REQUIRED

SIZE		ISSUE 4-30-47	J.V.W.
KIND	HYPERSIL	CHANGED	
SHAPE		"	
FINISH		"	
TEMP.		"	
PATT.		"	

TITLE: FISCHER "MP-10" X-RAY UNIT
HYPERSIL CORE

H. G. FISCHER & CO.
2335 WABANSIA AVE.
CHICAGO, ILL.

CAT. NO.

PART NO. 16685

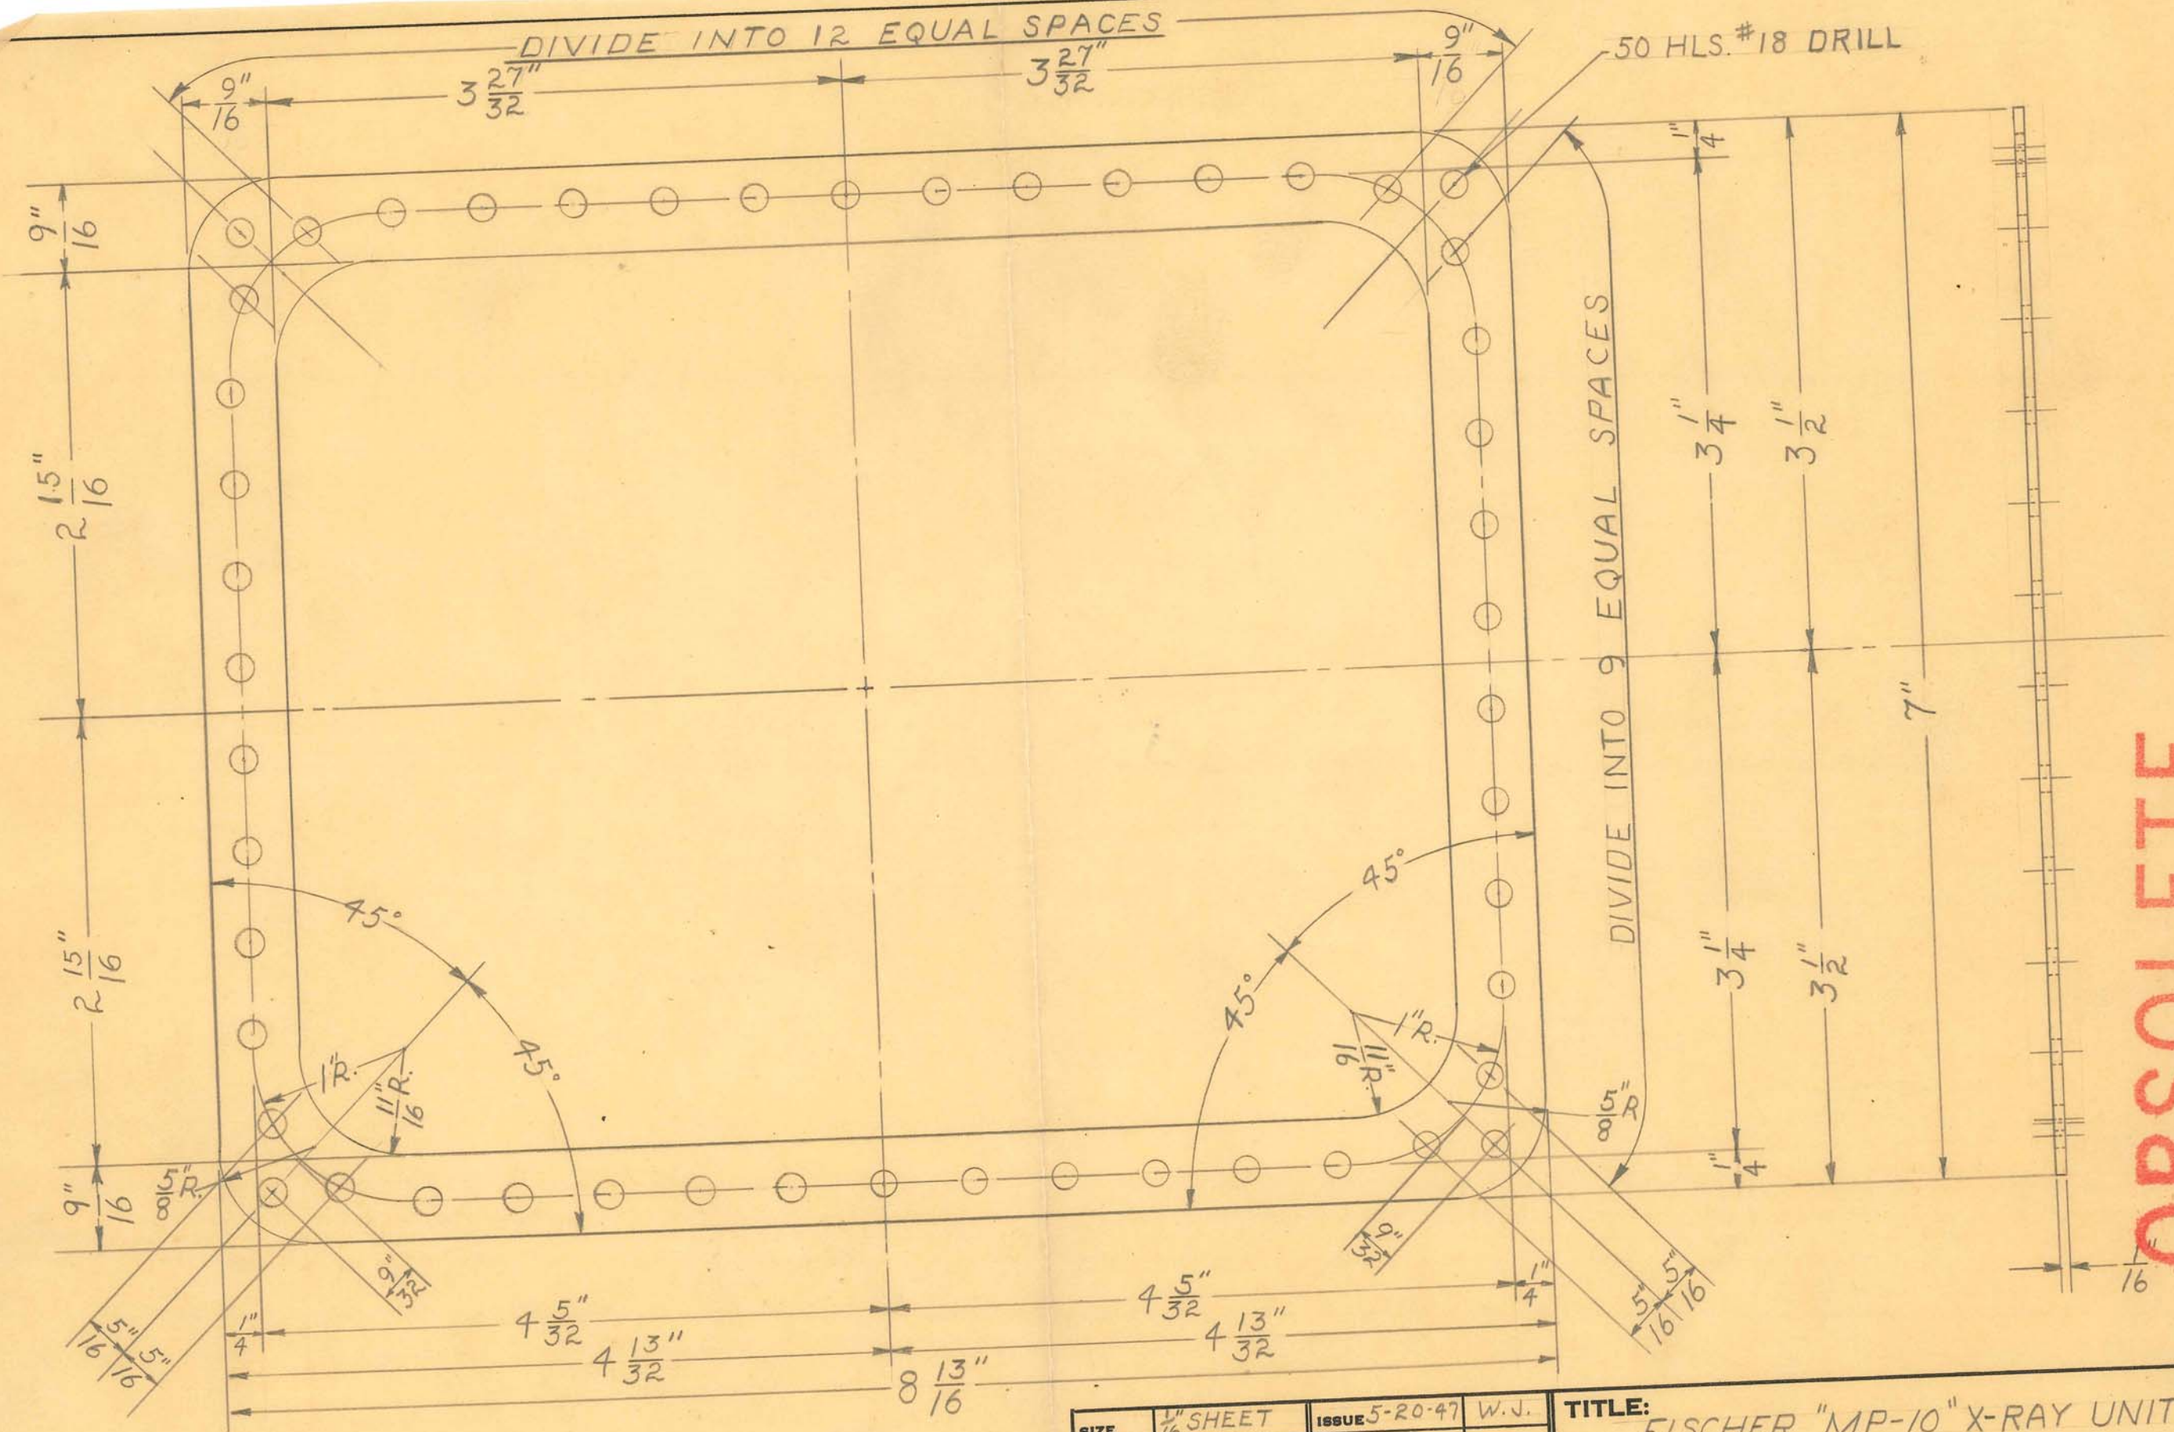

OBSOLETE

SIZE	1/16" SHEET	ISSUE 5-20-47	W.J.
KIND	HY-CAR	CHANGED	
SHAPE	CORK	"	
FINISH		"	
TEMP.		"	
PATT.		"	

TITLE: FISCHER "MP-10" X-RAY UNIT
TRANSFORMER TANK PANEL GASKET

H. G. FISCHER & CO.
2338 WABANSIA AVE.
CHICAGO, ILL.

CAT. NO.

PART NO. 16687

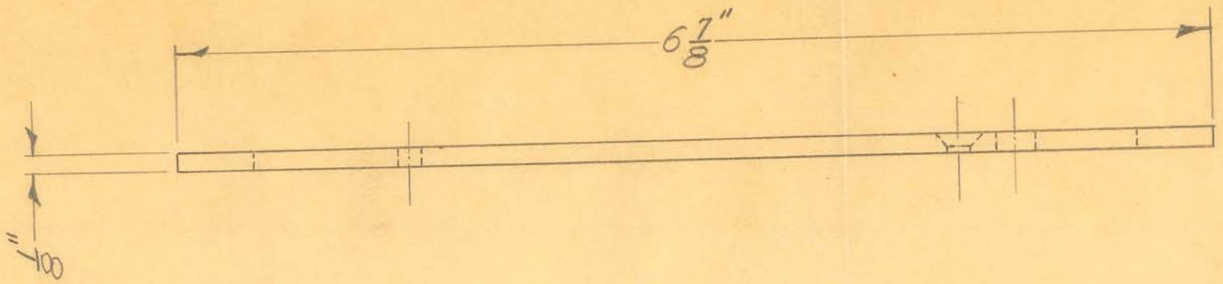

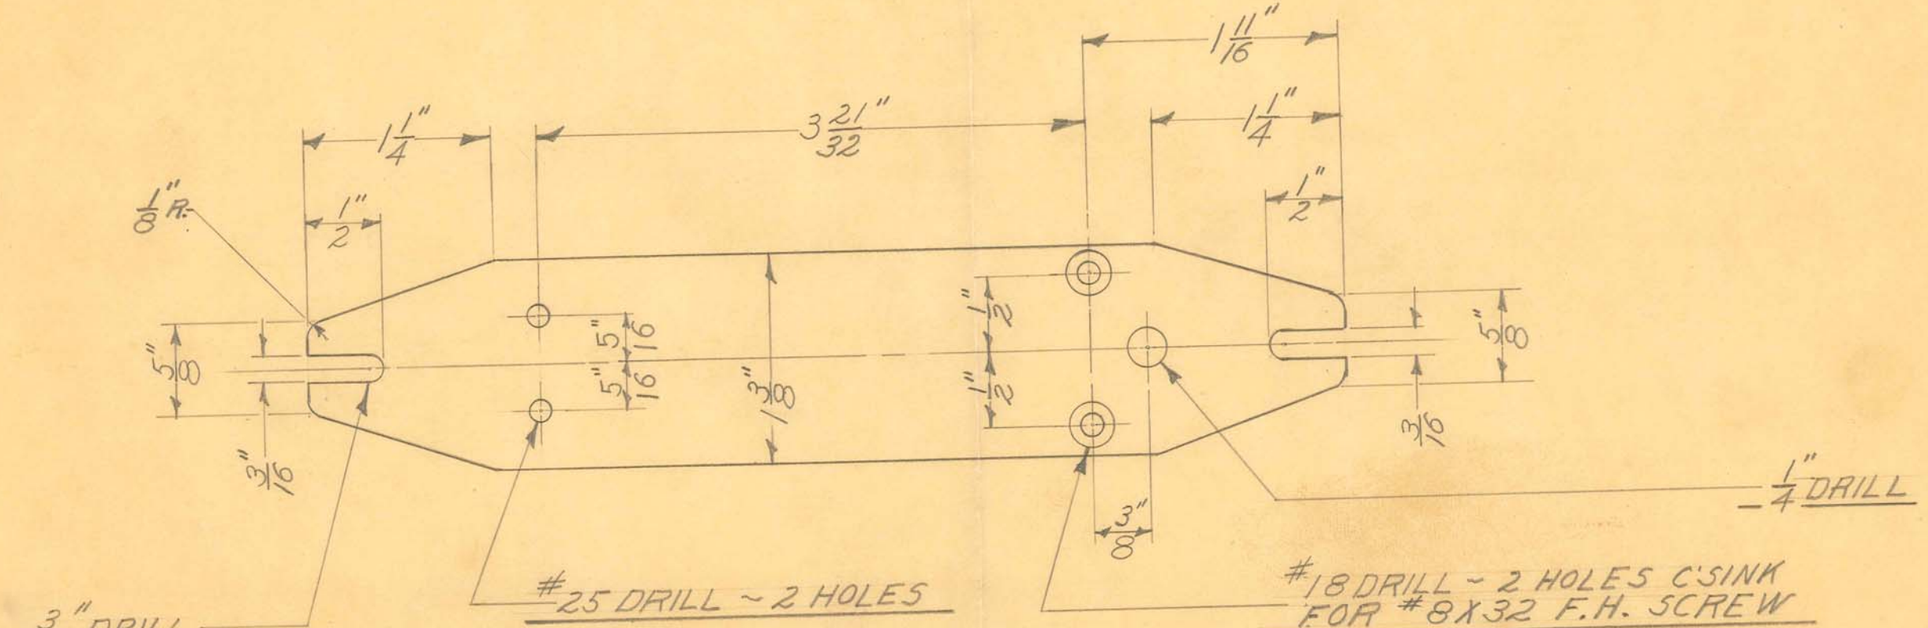

DRILL JIG TOOL # 9319
MILLING FIXTURE TOOL # 9325

1-REQUIRED

1/8" SHEET. NATURAL BAKELITE XX

SIZE		ISSUE 9-15-47	J.M.F	TITLE: FISCHER "MP-10" X-RAY UNIT TUBE MOUNTING PLATE
KIND		CHANGED		
SHAPE		"		
FINISH		"		
TEMP.		"		
PATT.		"		

H. G. FISCHER & CO. 2335 WABANSIA AVE. CHICAGO, ILL. | CAT. NO. | PART NO. 16691 F

OBSOLETE

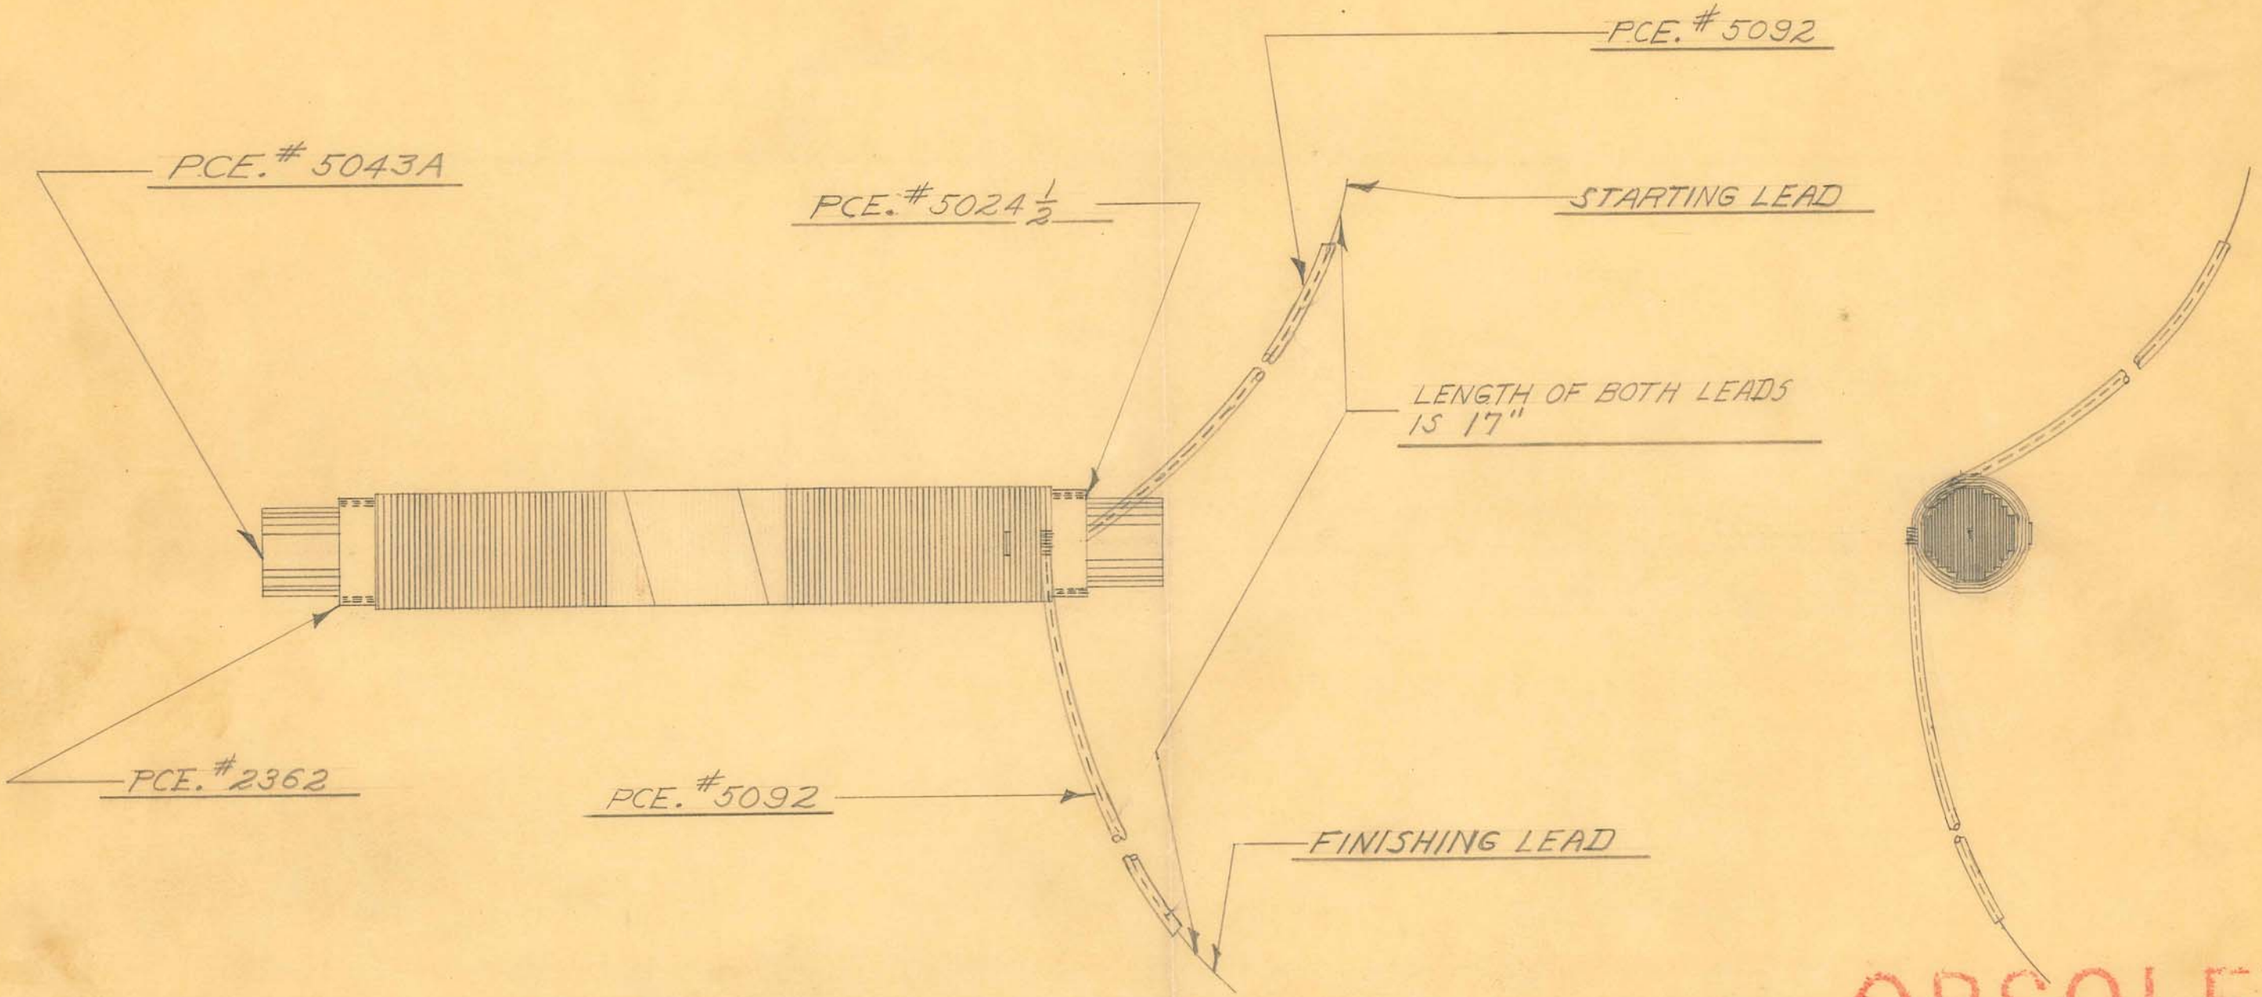

OBSOLETE

DATA

403 TURNS TO BE WOUND ON FIRST LAYER
1500 = TOTAL NUMBER OF TURNS
4 = TOTAL NUMBER OF LAYERS
START WINDING 1/4" FROM INSERTING ENDS AND
FINISH WINDING 1/4" FROM INSERTING END

1 REQUIRED

SIZE		ISSUE 9-22-47	J.M.F
KIND		CHANGED	
SHAPE		"	
FINISH		"	
TEMP.		"	
PATT.		"	

TITLE: FISCHER MP-10 X RAY UNIT
FIL. TRANSF. PRIMARY WINDING
ASSEMBLY PART OF

H. G. FISCHER & CO. 2338 WABANSIA AVE. CHICAGO, ILL.	CAT. NO.	PART NO. 16710 G

4 HOLES #24 DRILL - CSK. TO $\frac{9}{32}$" FACE

BREAK SHARP EDGES & CORNERS

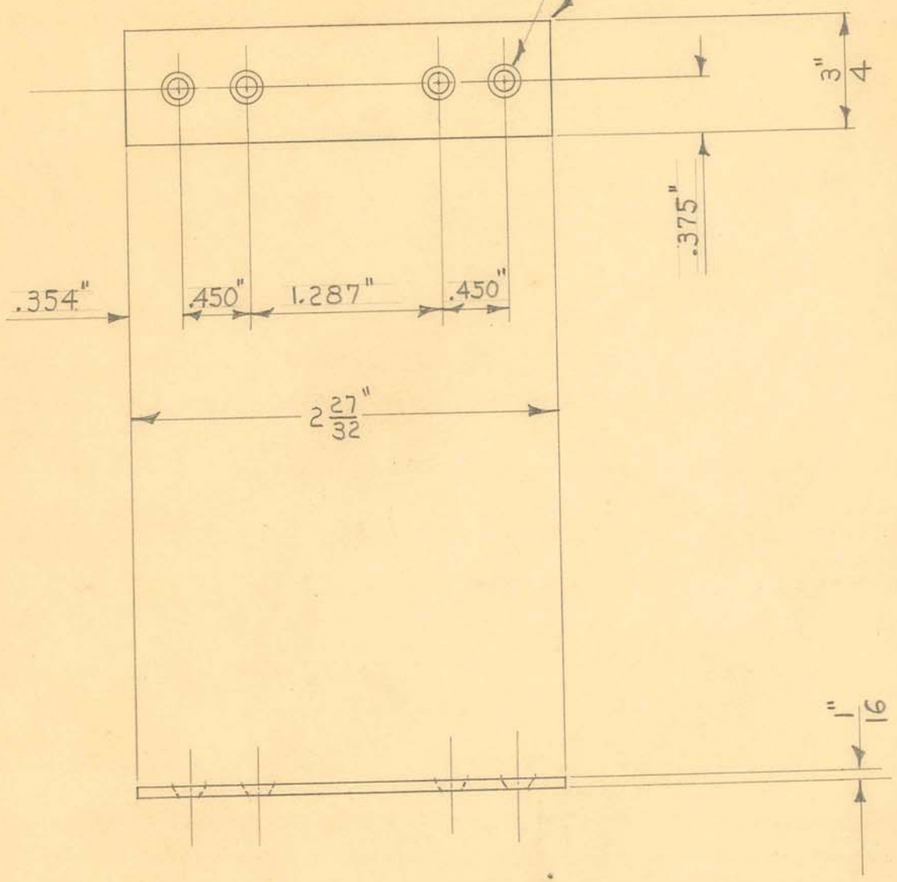

DEVELOPED LENGTH

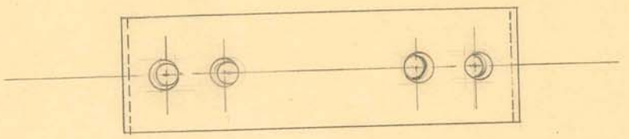

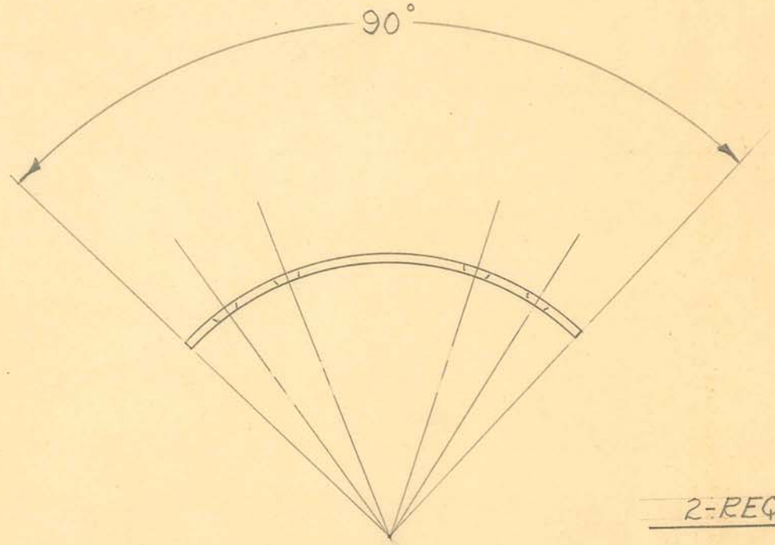

2-REQUIRED

FORMING FIXTURE TOOL #9597
DRILL JIG TOOL # 9596

OBSOLETE

DIMENSIONS	
FRACTIONAL	± .015
DECIMAL	± .005
ANGULAR	± 1/2°

UNLESS OTHERWISE SPECIFIED

SIZE	3/4" X 1/16"	ISSUE 12-24-47	J.M.F	TITLE: FISCHER "PRECISION" 200 X-RAY UNIT STEREOSCOPIC SLIDE LOCK GAP PLATE
KIND	FLAT WIRE	CHANGED		
SHAPE		"		
FINISH	CAD #23	"		
TEMP.		"		
PATT.		"		

H. G. FISCHER & CO.
2335 WABANSIA AVE.
CHICAGO, ILL.

CAT. NO.

PART NO. 16758

PCE.# 16761 F

PCE.# 16759

INSERT RIVETS PCE# 16757 F
WITH HEADS ON INSIDE.
RIVET OVER ON OUTSIDE &
FILE FLUSH WITH CASTING

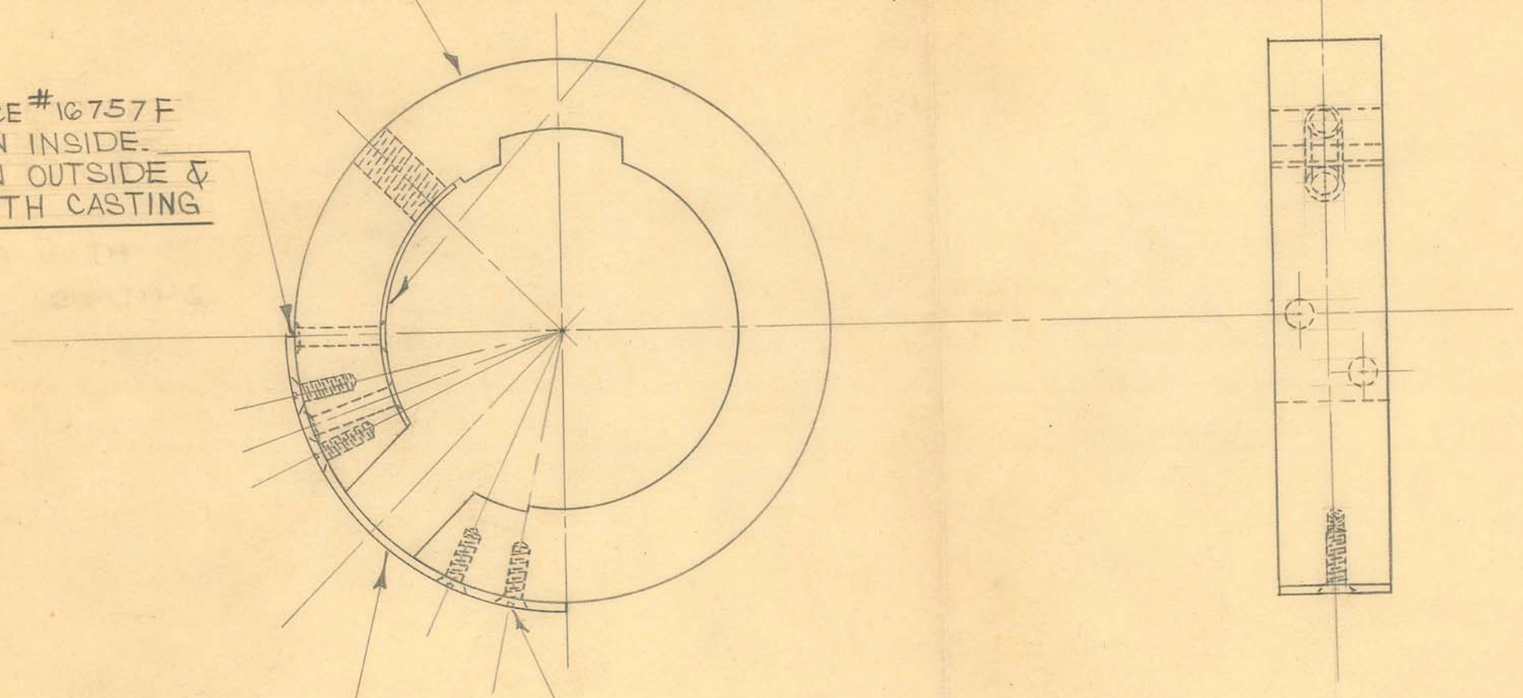

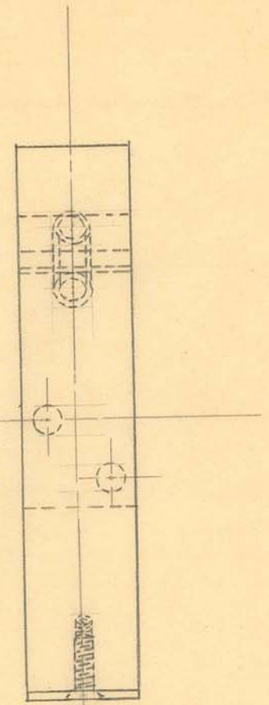

PCE.# 16758

PCE.# M 638 FHI

2-REQUIRED

OBSOLETE

SIZE		ISSUE 12-10-47	J.M.F
KIND		CHANGED	
SHAPE		"	
FINISH		"	
TEMP.		"	
PATT.		"	

DIMENSIONS
FRACTIONAL ± .015
DECIMAL ± .005
ANGULAR ± 1/2°
UNLESS OTHERWISE SPECIFIED

TITLE: FISCHER "PRECISION" 200 X-RAY UNIT
STEREOSCOPIC SLIDE LOCK ASSEM.

H. G. FISCHER & CO.
2335 WABANSIA AVE.
CHICAGO. ILL.

CAT. NO.

PART NO. 16760G

2 HLS. $\frac{1}{8}$" DRILL CSK. FOR RIVETING

45°

$\frac{5}{16}$"X18 TAP

FILE OUT HUMPS AS INDICATED

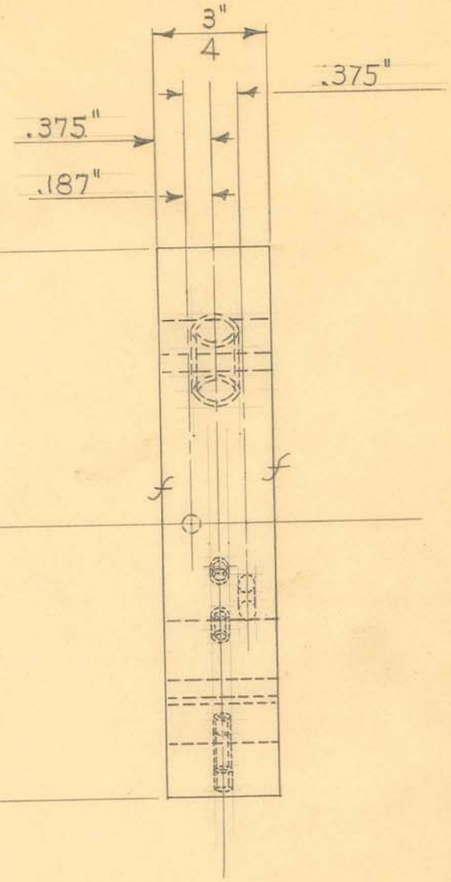

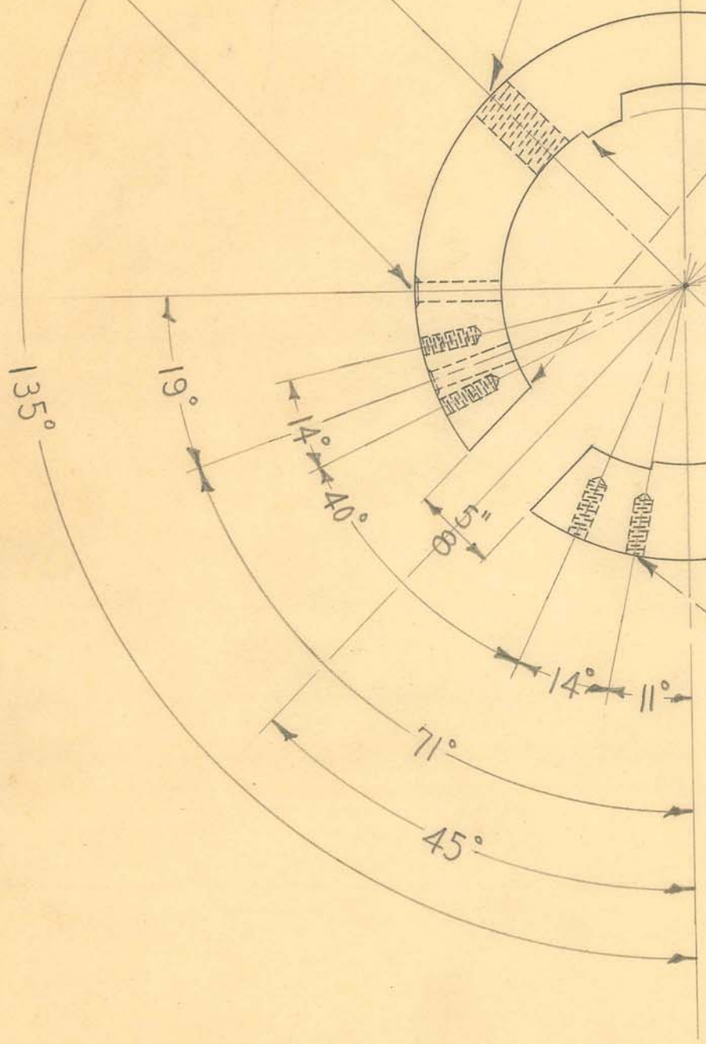

2.281" +.002" -.000"

3.562"

4 HLS. #6X32 TAP 3"DEEP

2 REQUIRED

OBSOLETE

MILLING FIXTURE TOOL # 9603
DRILL JIG TOOL # 9602

SIZE	#12	ISSUE 12-29-47	J.M.F	
KIND	ALUMINUM	CHANGED		
SHAPE	CASTING	"		
FINISH		"		
TEMP.		"		
PATT.	#2290	"		

DIMENSIONS
FRACTIONAL ± .015
DECIMAL ± .005
ANGULAR ± 1/2°
UNLESS OTHERWISE SPECIFIED

TITLE: FISCHER PRECISION 200 X-RAY UNIT STEREOSCOPIC SLIDE LOCK

H. G. FISCHER & CO.
2335 WABANSIA AVE.
CHICAGO, ILL.

CAT. NO.

PART NO. 16761F

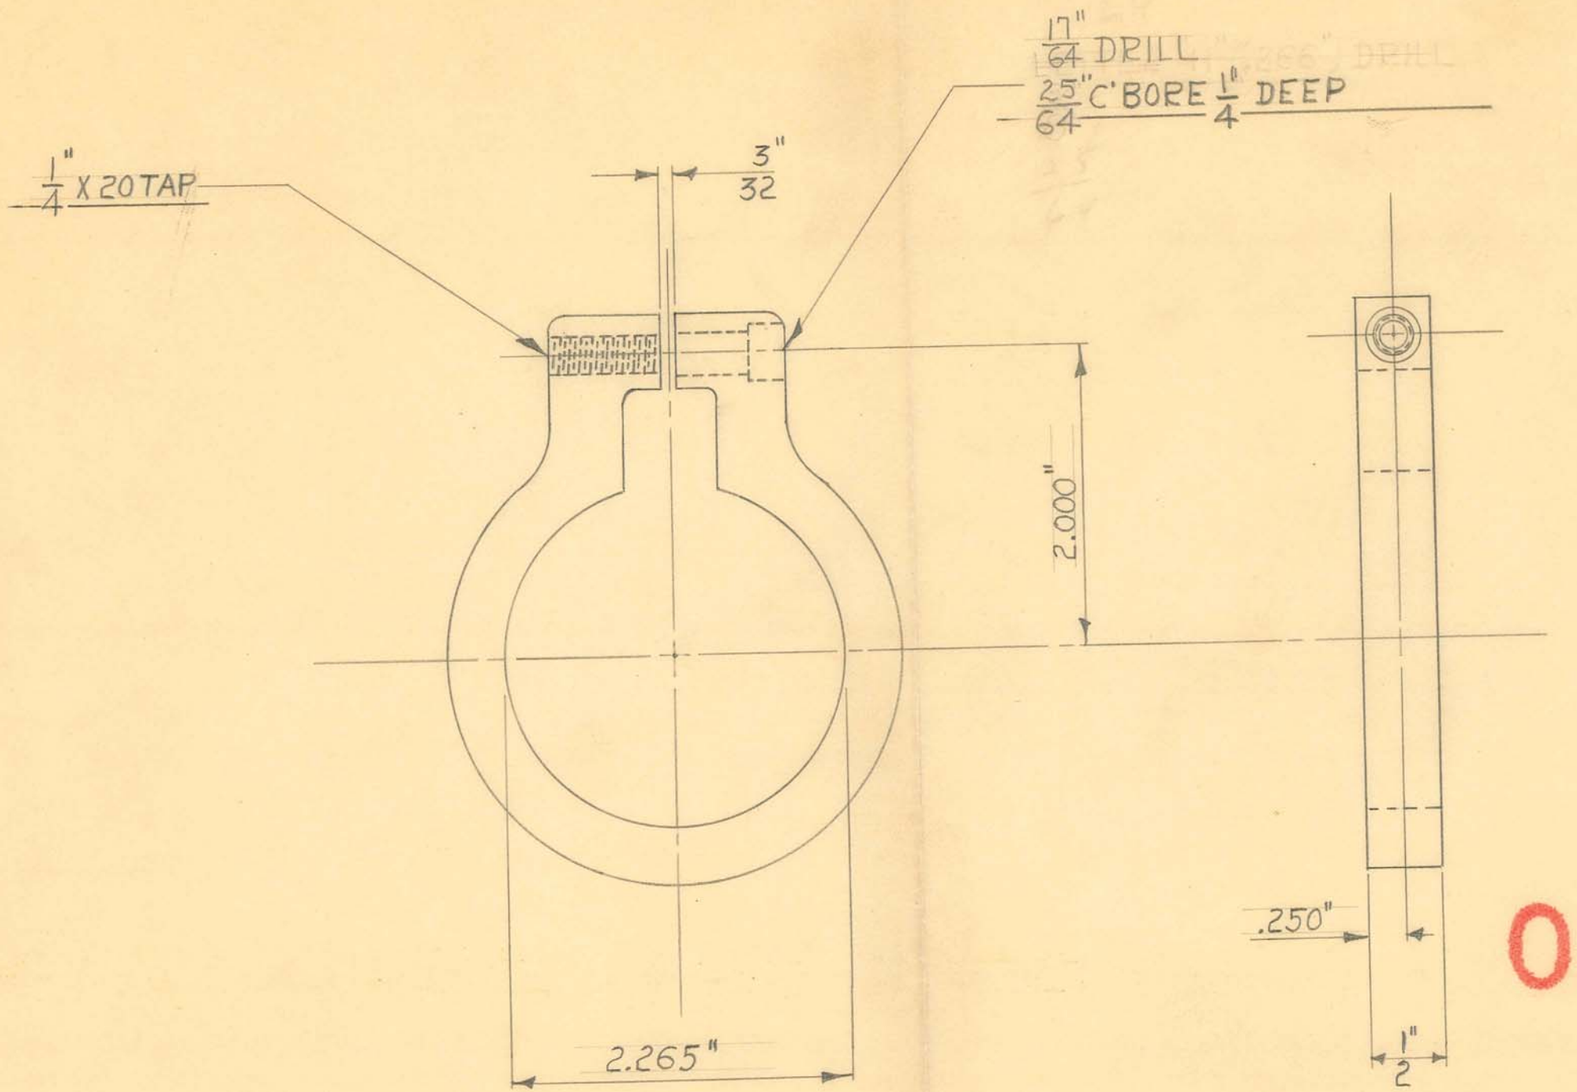

OBSOLETE

1-REQUIRED

MILLING FIXTURE TOOL # 9601
DRILL JIG TOOL # 9600

SIZE	#12	ISSUE 12-8-47	J.M.F	
KIND	ALUMINUM	CHANGED		
SHAPE	CASTING	"		
FINISH	POLISH & BUFF	"		
TEMP.		"		
PATT.	#2291	"		

DIMENSIONS
FRACTIONAL ± .015
DECIMAL ± .005
ANGULAR ± 1/2°
UNLESS OTHERWISE SPECIFIED

TITLE: FISCHER "PRECISION" 200 X-RAY
LATERAL - SLIDE STOP

H. G. FISCHER & CO.
2335 WABANSIA AVE.
CHICAGO. ILL.

CAT. NO.

PART NO. 16762F

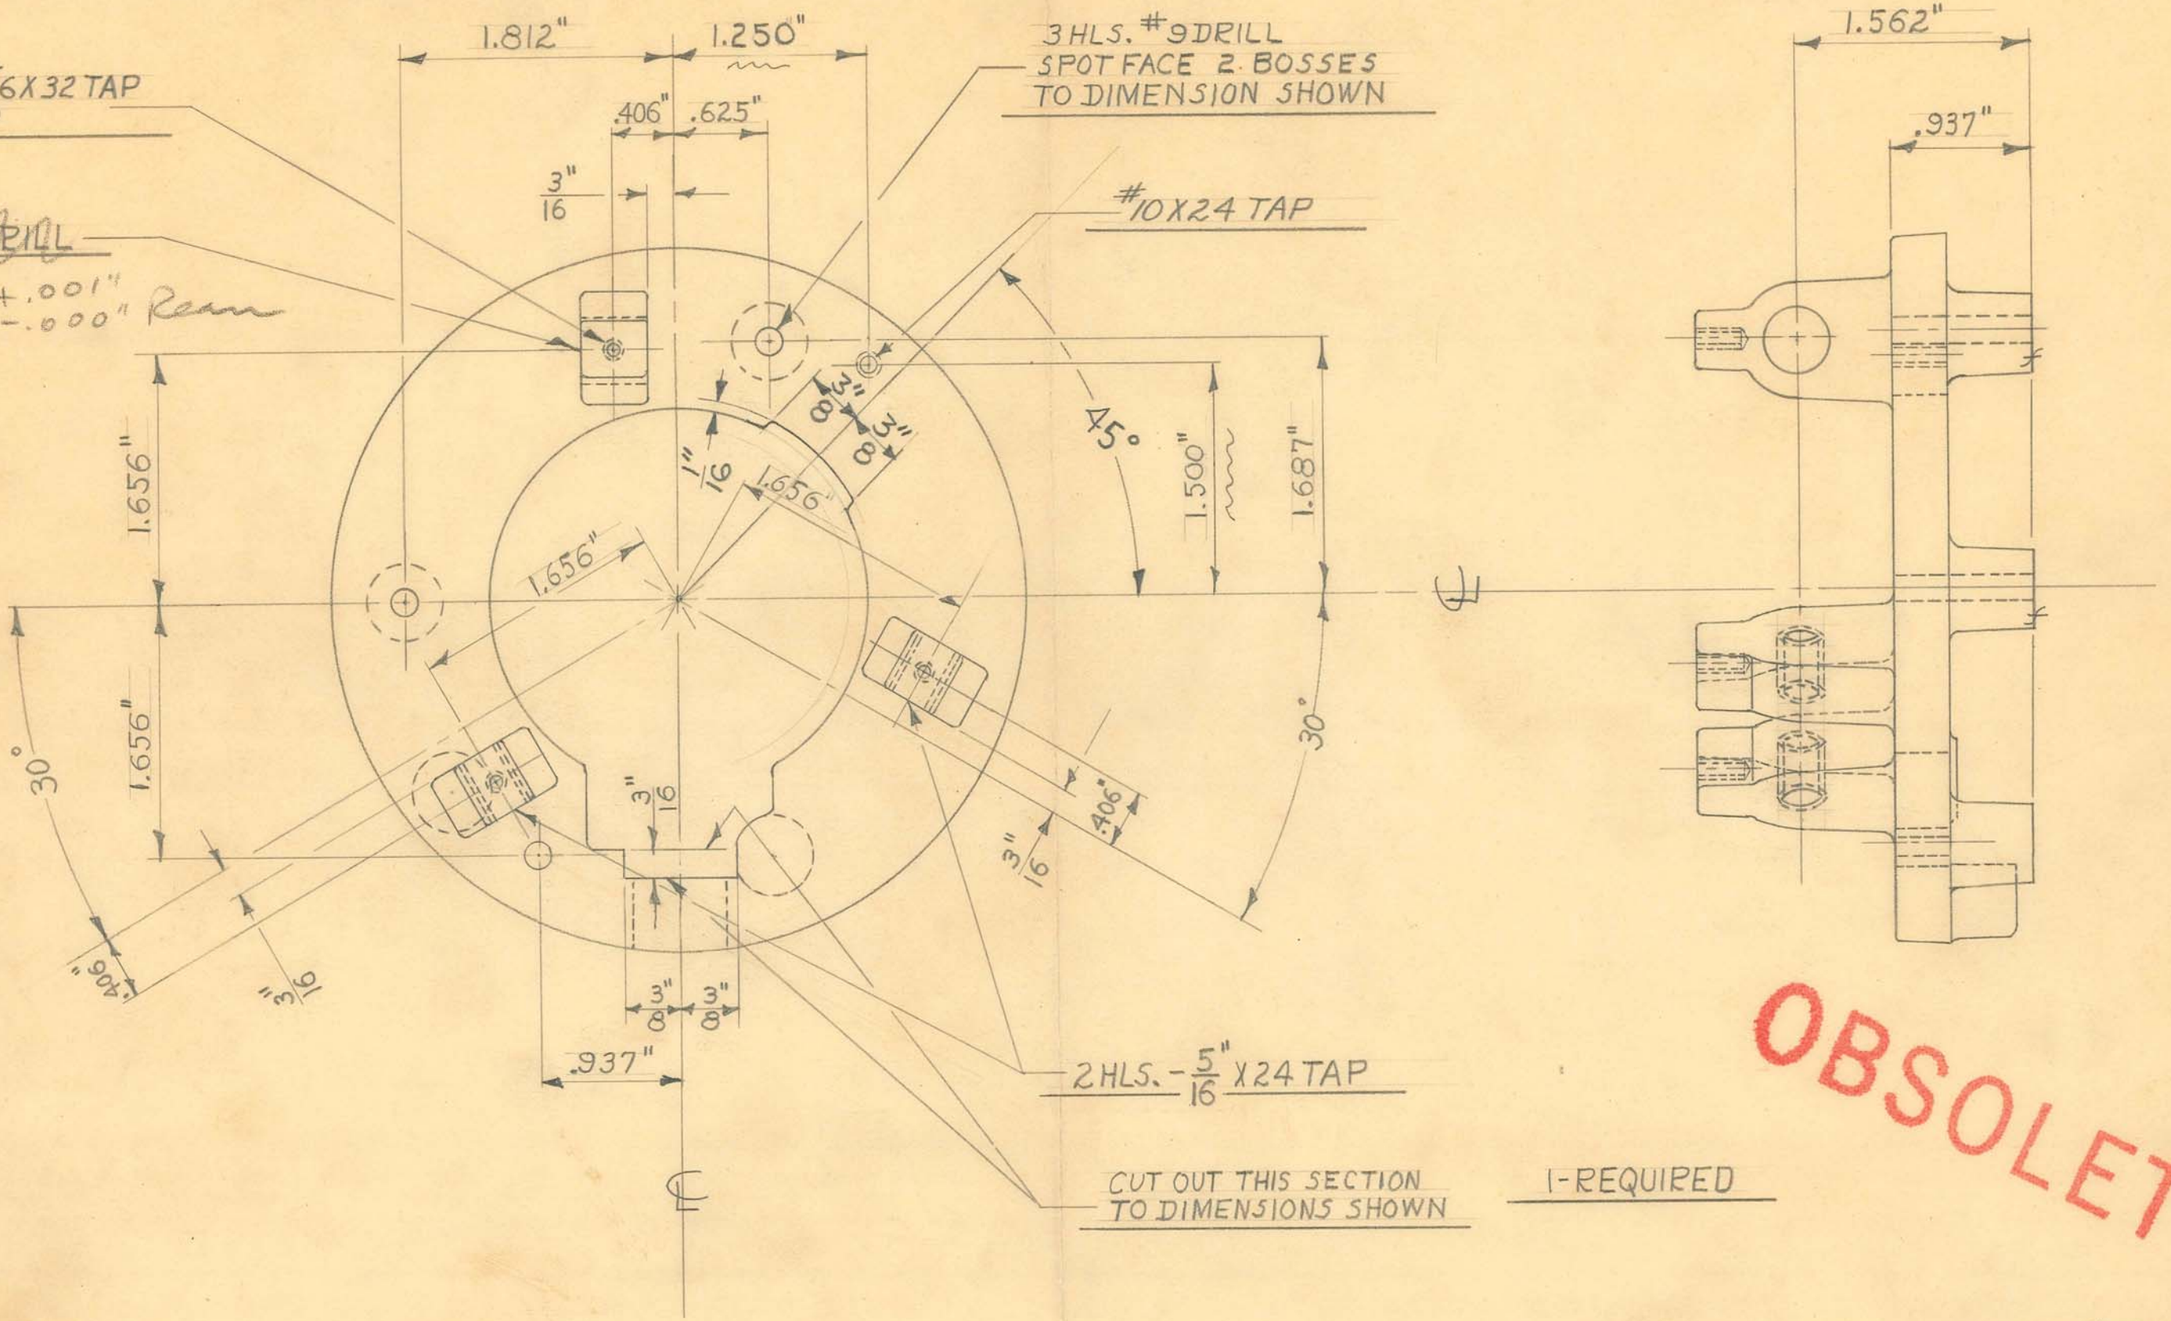

OBSOLETE

DRILL JIG TOOL # 9593

DIMENSIONS	
FRACTIONAL	± .015
DECIMAL	± .005
ANGULAR	± 1/2°

SIZE	#12	ISSUE 12-6-47	J.M.F
KIND	ALUMINUM	CHANGED	
SHAPE		"	
FINISH	PAINTED	"	
TEMP.		"	
PATT.	2047	"	

TITLE: FISCHER "PRECISION" 200 X-RAY
HORIZ. SLIDE BEARING SUPP. - FRONT

H. G. FISCHER & CO.
2335 WABANSIA AVE.
CHICAGO, ILL.

CAT. NO.

PART NO. 16764

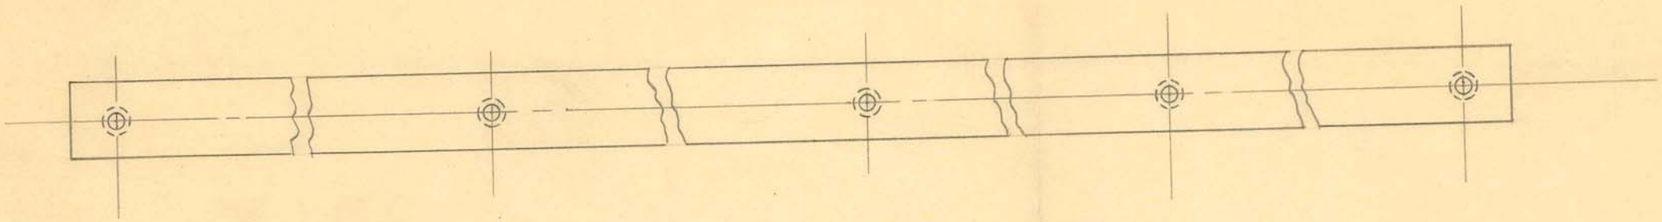

BREAK SHARP EDGES - BOTH ENDS

5 HLS. #10 X 32 TAP

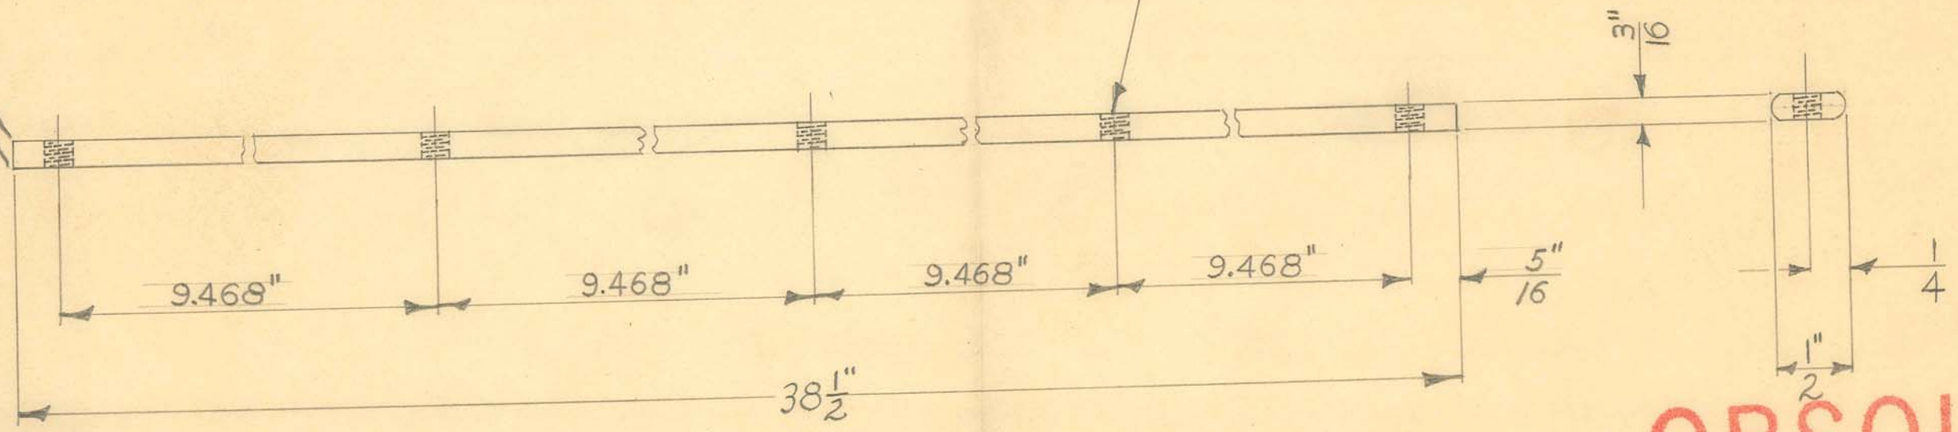

1-REQUIRED

OBSOLETE

DRILL JIG TOOL # 9592

SIZE	3/16" X 1/2"	ISSUE 12-5-47	J.M.F
KIND	FLAT WIRE	CHANGED	
SHAPE		"	
FINISH	CAD# 23	"	
TEMP.		"	
PATT.		"	

DIMENSIONS
FRACTIONAL ± .015
DECIMAL ± .005
ANGULAR ± 1/2°

TITLE:
FISCHER "PRECISION" 200 X-RAY UNIT
OUTER TUBE HEAD SUPP. HORIZ. TUBE
GUIDE ROD CLAMP

H. G. FISCHER & CO.
2335 WABANSIA AVE.
CHICAGO, ILL.

CAT. NO.

PART NO. 16766

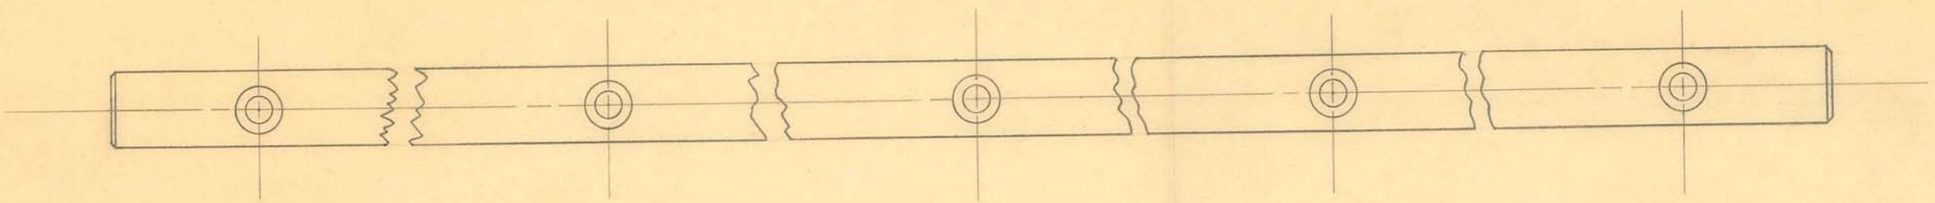

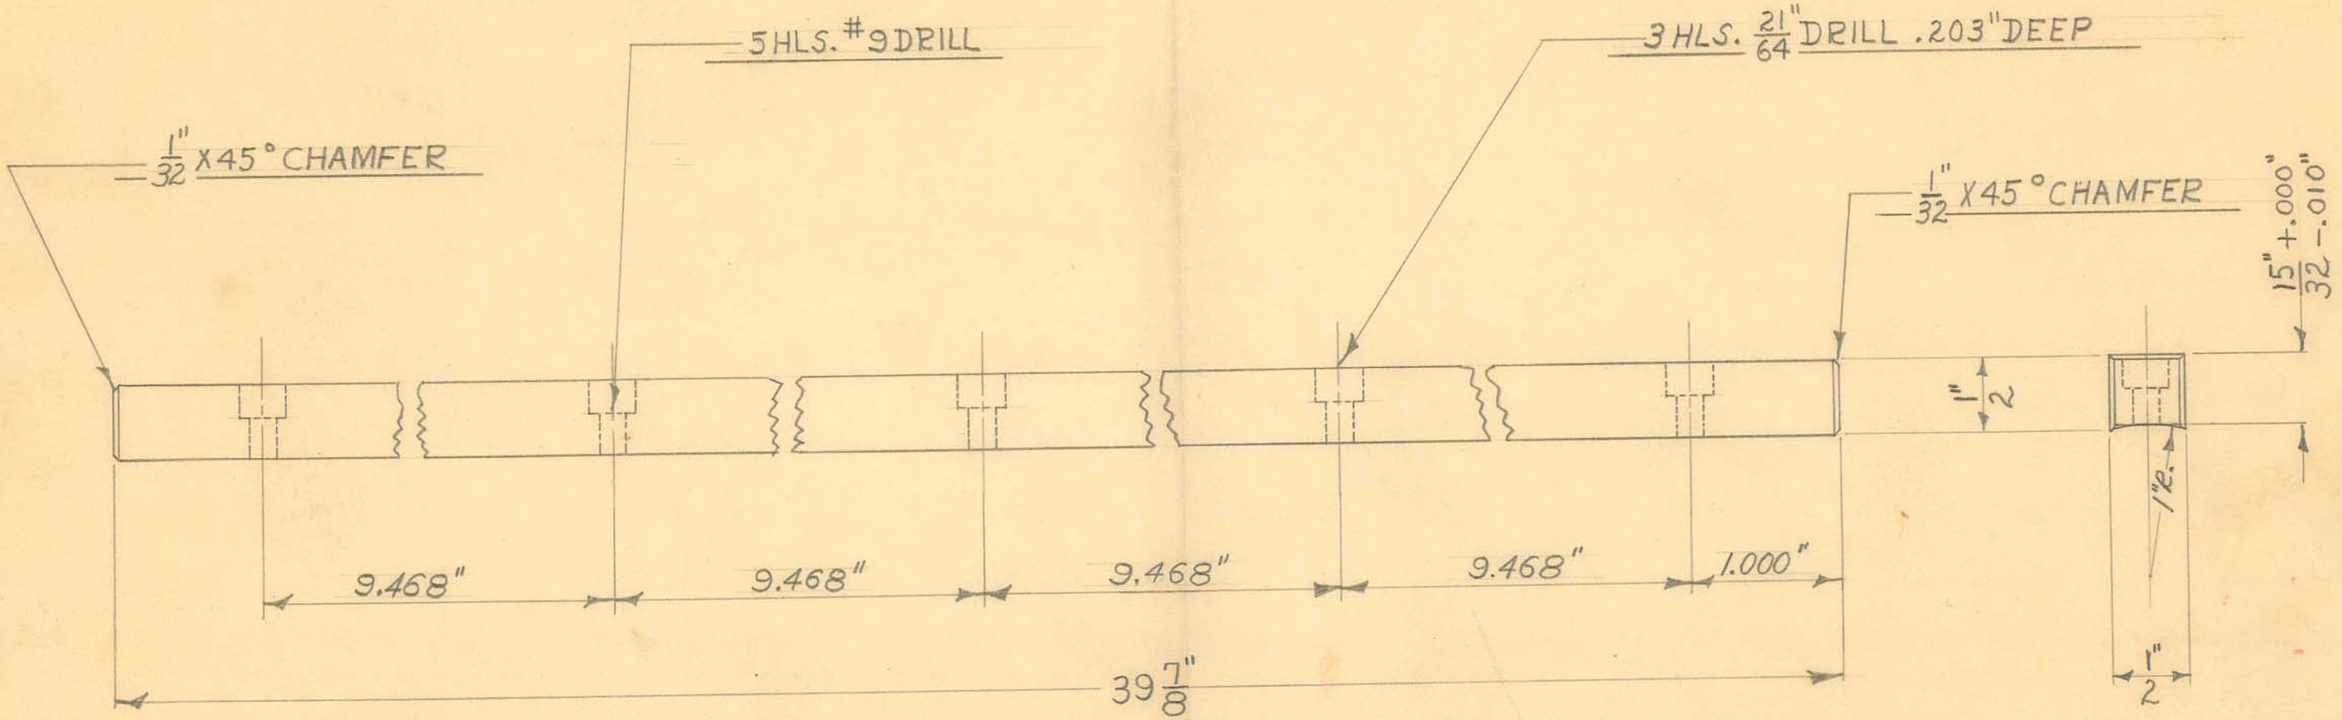

1-REQUIRED

OBSOLETE

DRILL JIG TOOL # 9592
MILLING FIXTURE TOOL # 9370

SIZE	1/2" SQUARE	ISSUE 12-5-47	J.M.F	
KIND	C.R. STEEL	CHANGED		
SHAPE		"		
FINISH	CHROME #2	"		
TEMP.		"		
PATT.		"		

DIMENSIONS
FRACTIONAL ± .015
DECIMAL ± .005
ANGULAR ± 1/2°
UNLESS OTHERWISE SPECIFIED

TITLE:
FISCHER "PRECISION" 200 X-RAY UNIT
OUTER TUBE HEAD SUPP. HORIZ. TUBE GUIDE ROD

H. G. FISCHER & CO.
2335 WABANSIA AVE.
CHICAGO, ILL.

CAT. NO.

PART NO. 16767

REVISION		DATE	BY
A	.760" REAM	3-7-49	J.V.W.

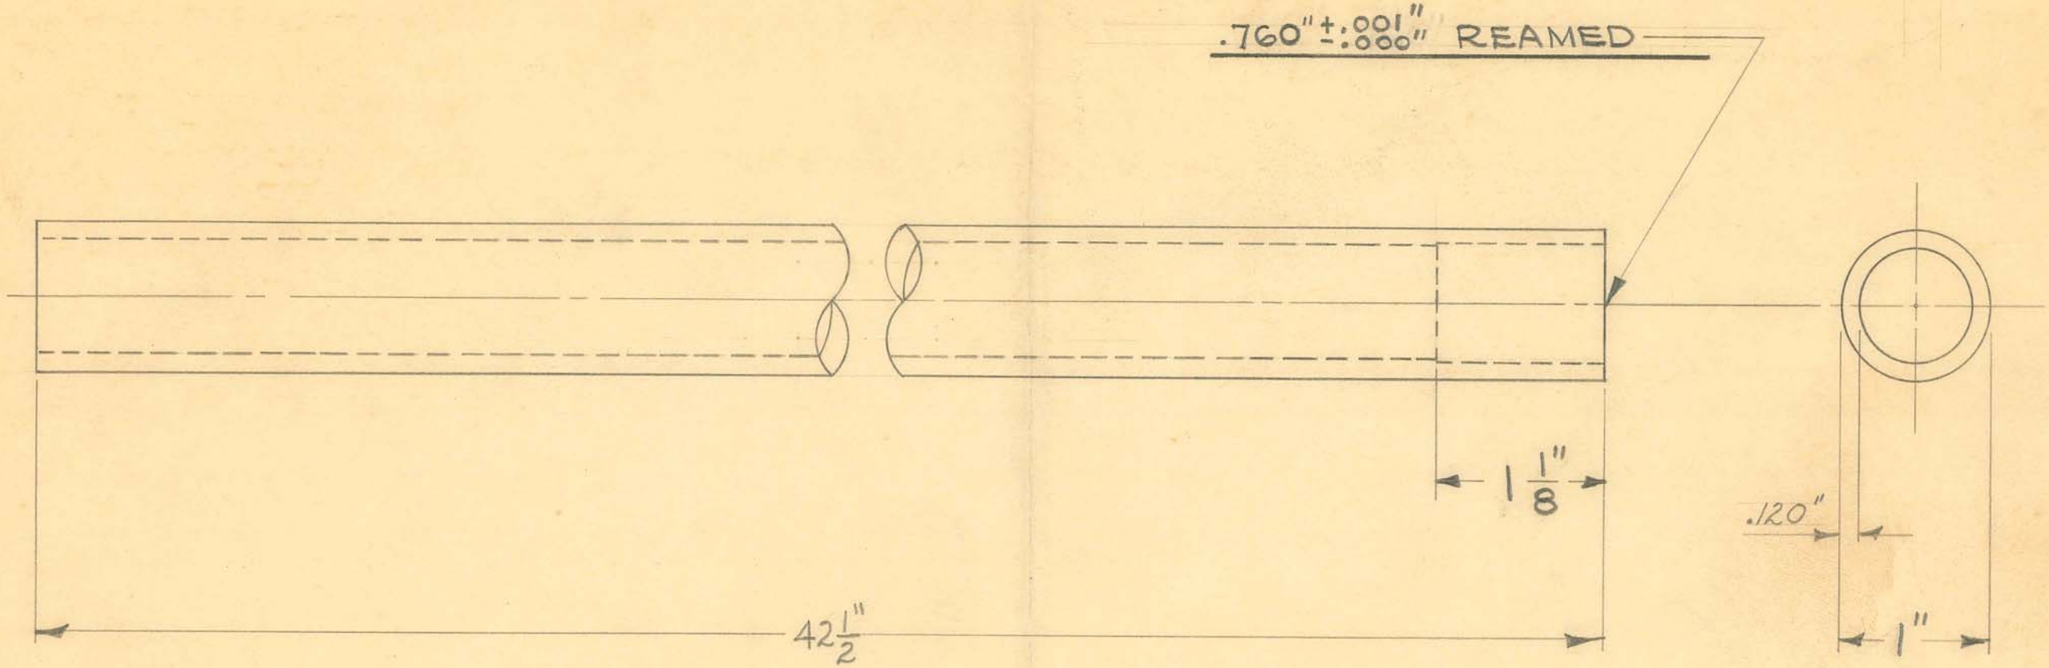

OBSOLETE

1" O.D. X 11GA (.120") WALL ~ SEAMLESS STEEL TUBING

DIMENSIONS	
FRACTIONAL	± .015
DECIMAL	± .005
ANGULAR	± 1/2°

SIZE		ISSUE 12-6-47	J.M.F
KIND		CHANGED	
SHAPE		" 3-7-49	J.V.W.
FINISH		"	
TEMP.		"	
BATT.		"	

TITLE: FISCHER "PRECISION" 200 X-RAY UNIT
INNER TUBE HEAD SUPP. HORIZ. TUBE

H. G. FISCHER & CO.
2335 WABANSIA AVE.
CHICAGO, ILL.

CAT. NO.

PART NO. 16768

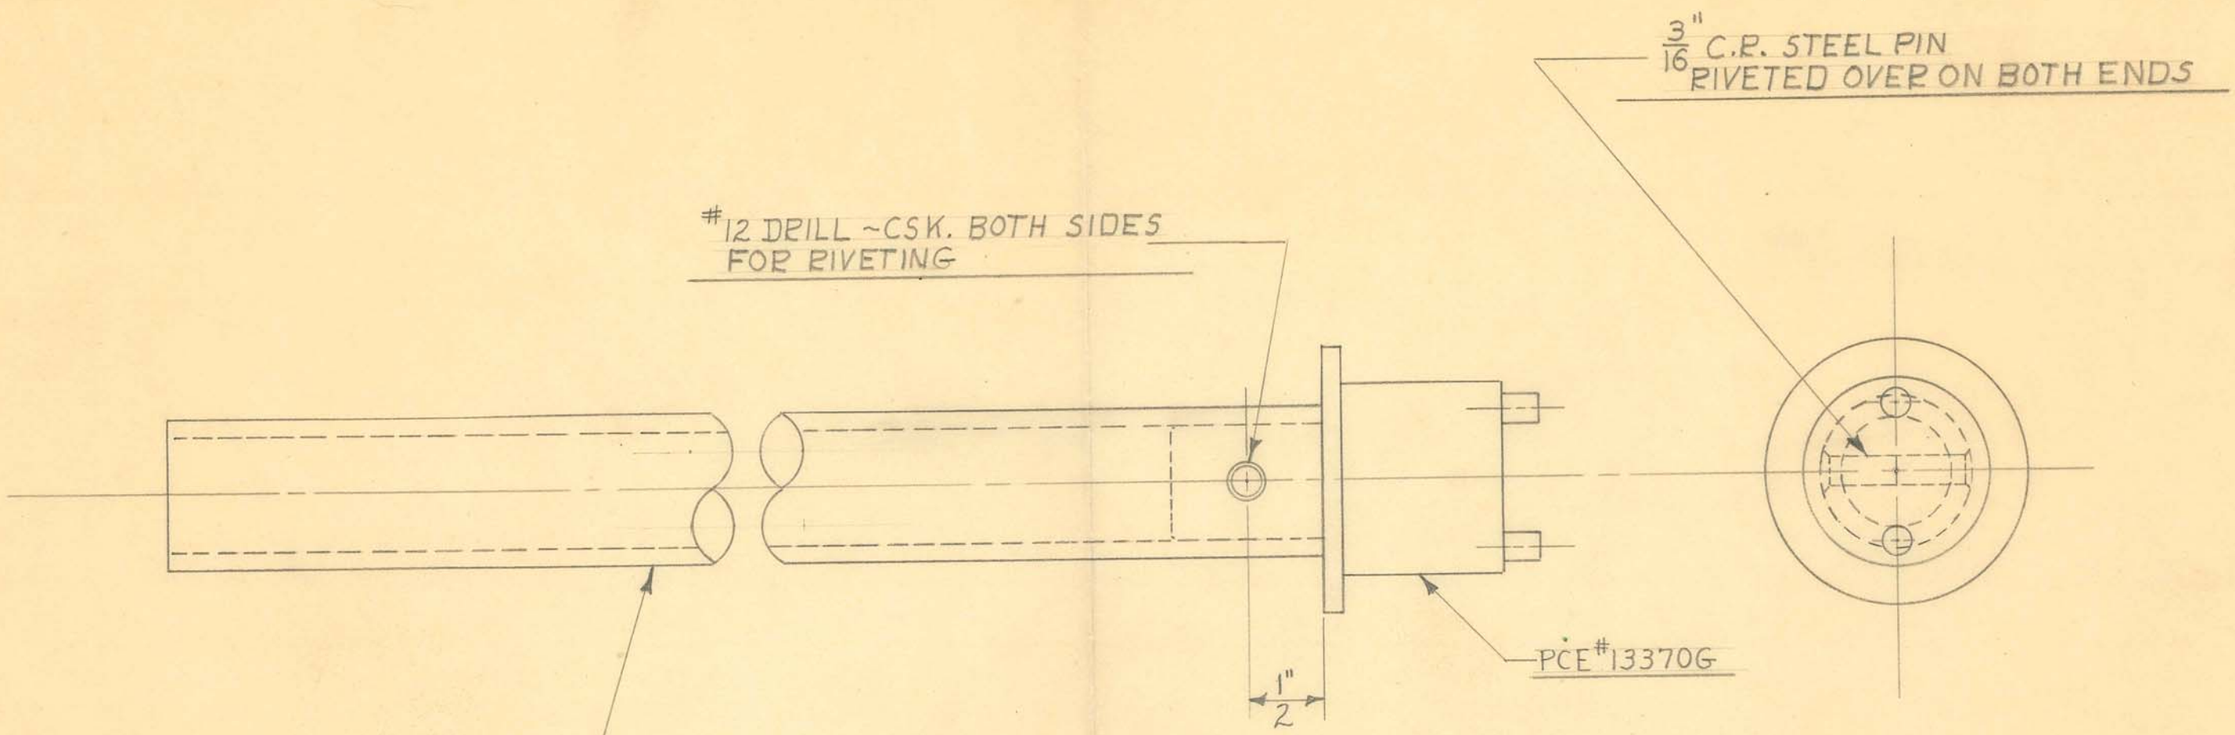

1-REQUIRED

OBSOLETE

obsolete

SIZE		ISSUE 12-6-47	J.M.F
KIND		CHANGED	
SHAPE		"	
FINISH	CAD#23	"	
TEMP.		"	
PATT.		"	

DIMENSIONS
FRACTIONAL ± .015
DECIMAL ± .005
ANGULAR ± 1/2°
UNLESS OTHERWISE SPECIFIED

TITLE: FISCHER "PRECISION" 200 X-RAY UNIT
INNER TUBE HEAD SUPP. HORIZ. TUBE ASSEM

H. G. FISCHER & CO.
2338 WABANSIA AVE.
CHICAGO. ILL.

CAT. NO.

PART NO. 16769G

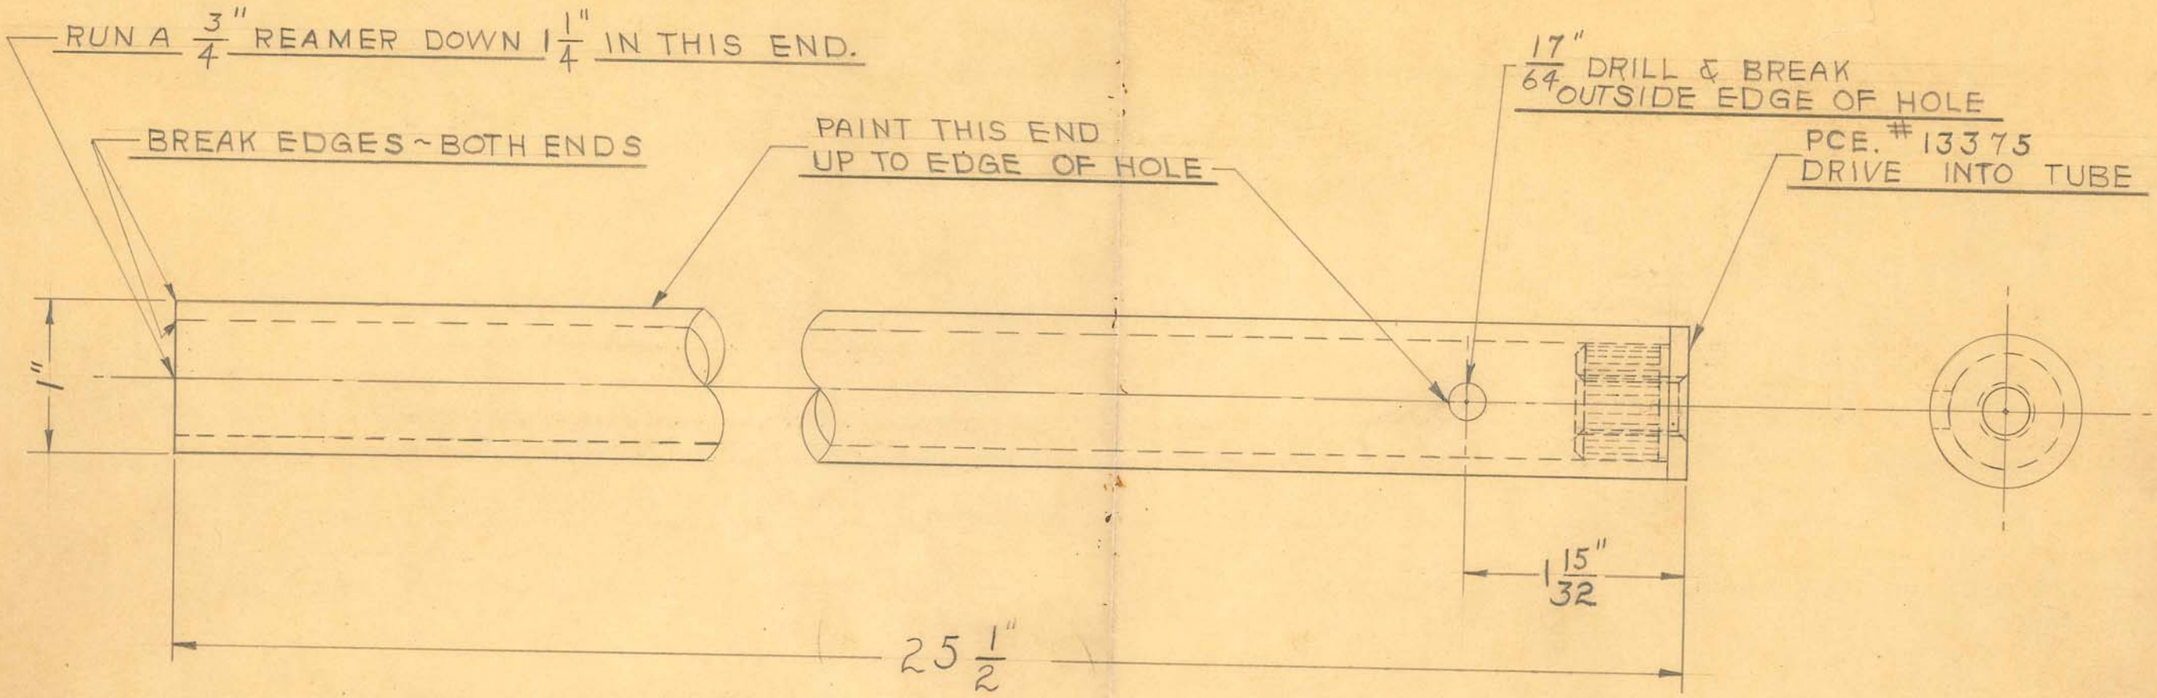

1" O.D. X #11 GA. (.120") WALL SHELBY SEAMLESS STEEL TUBING

1 REQUIRED

OBSOLETE

Drill Jig Tool #9457

DIMENSIONS	
FRACTIONAL	± .015
DECIMAL	± .005
ANGULAR	± ½°
UNLESS OTHERWISE SPECIFIED	

SIZE		ISSUE 7-18-47	W.J.
KIND		CHANGED	
SHAPE		"	
FINISH	PAINTED	"	
TEMP.	SEE NOTE	"	
PATT.		"	

TITLE: FISCHER "PRECISION 200" X-RAY UNIT
BASE STOP VERTICAL TUBE

H. G. FISCHER & CO.
2335 WABANSIA AVE.
CHICAGO, ILL.

CAT. NO.

PART NO. 16780G

RUN A $\frac{3}{4}$" REAMER DOWN $1\frac{1}{4}$" IN THIS END.

BREAK EDGES ~ BOTH ENDS

$\frac{17}{64}$" DRILL & BREAK OUTSIDE EDGE OF HOLE

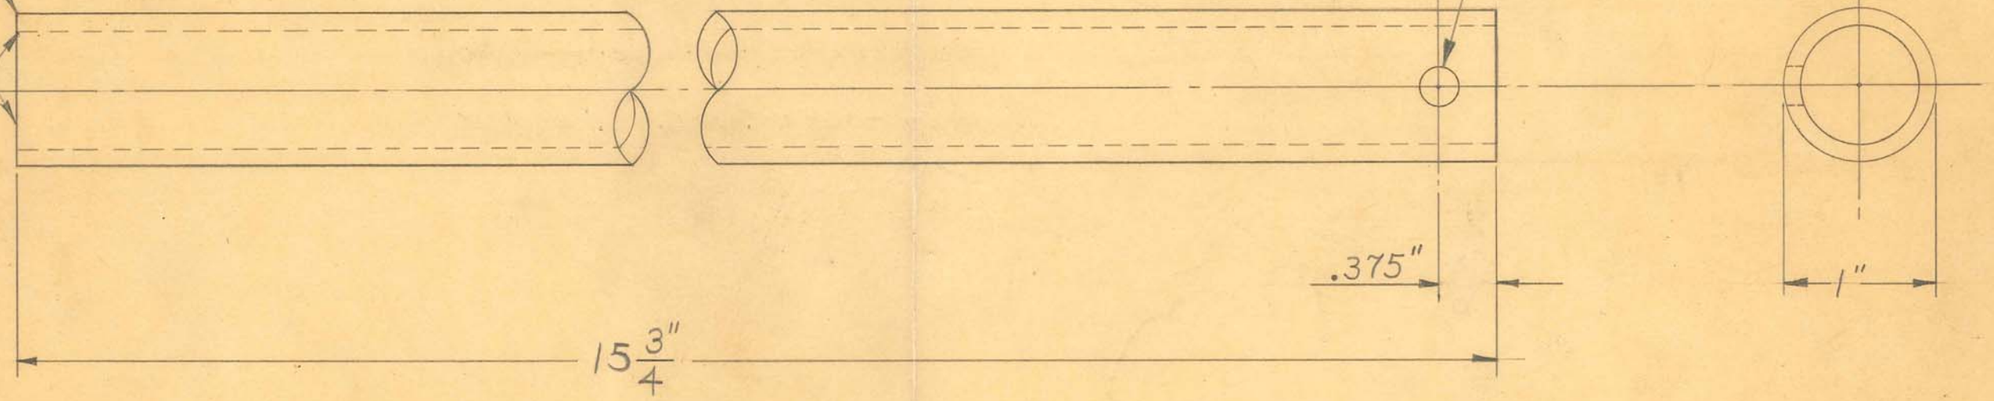

1" O.D. X #11 GA. (.120") WALL SHELBY SEAMLESS STEEL TUBING

1 REQUIRED

OBSOLETE

Drill Jig Tool #9458

DIMENSIONS	
FRACTIONAL	± .015
DECIMAL	± .005

SIZE		ISSUE 7-22-47	W.J.
KIND		CHANGED	
SHAPE		"	
FINISH	PAINTED	"	
TEMP.		"	

TITLE:
FISCHER "PRECISION 200" X-RAY UNIT
TUBE STAND BASE LEVELING TUBE

H. G. FISCHER & CO. | CAT. | PART

OBSOLETE

GRADUATION, STYLE OF NUMBERS AND ETC. MUST MATCH FOILCAL SCALE FISCHER PART NO. 19021A PREVIOUSLY ORDERED.

NOTE: THIS SCALE WILL BE USED (IN SOME CASES) AS AN EXTENSION OF SCALE FISCHER PART NO. 19021A

NUMBERS-BORDER AND GRADUATION MARKS PLAIN ALUMINUM-COATED TO PREVENT OXIDIZING. BACKGROUND-BLACK.

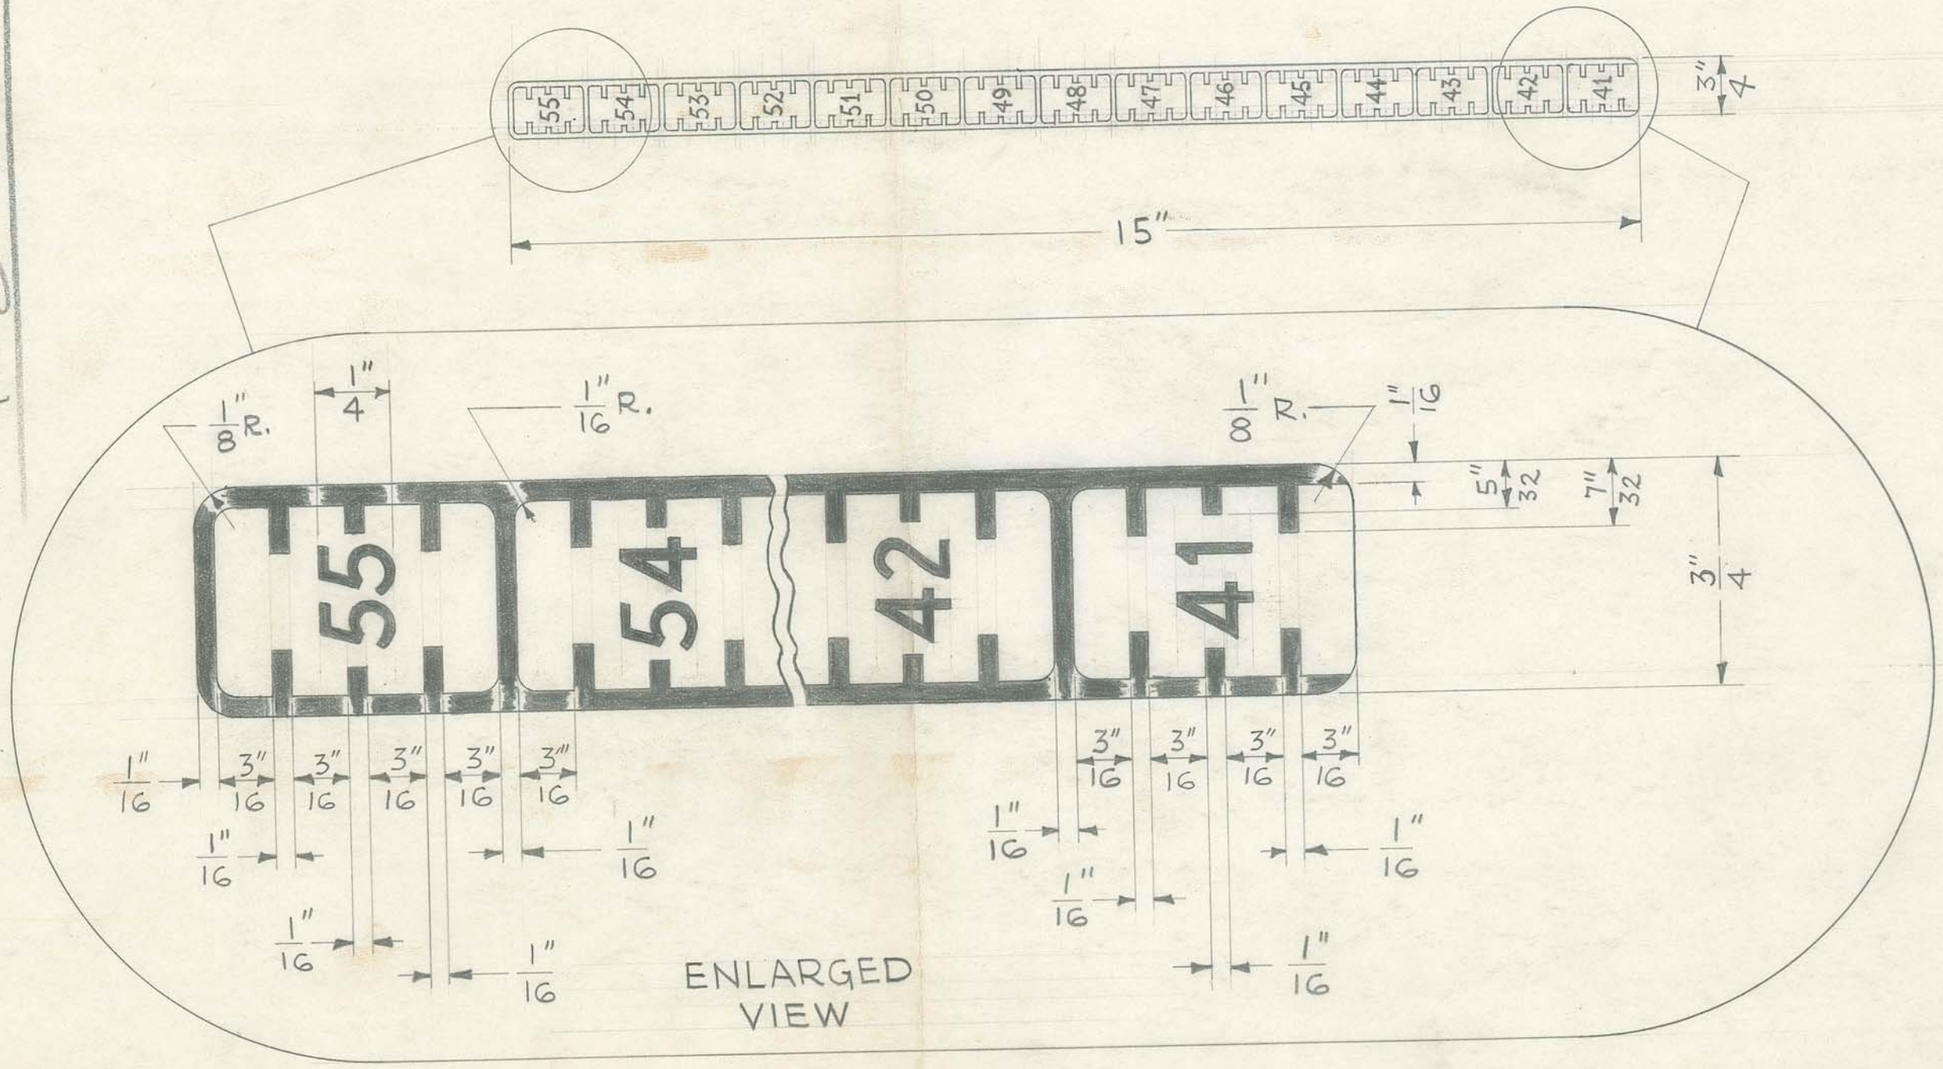

TITLE 41" TO 55" VERTICAL SCALE

PART NO. 16792

H. G. FISCHER & CO. FRANKLIN PARK, ILLINOIS

DATE 3-26-51 DR. BY J.V.W. CHK'D.

SCALE HALF SIZE

DIMENSIONS FRACTIONAL ±.015 DECIMAL ±.005 ANGULAR ±½° UNLESS OTHERWISE SPECIFIED

MATERIAL FOILCAL

FINISH

PATTERN

TOOLS 2" DIA. BENDING #11587
4" DIA. BENDING #11588

REVISION | DATE | BY

FOLDER #126

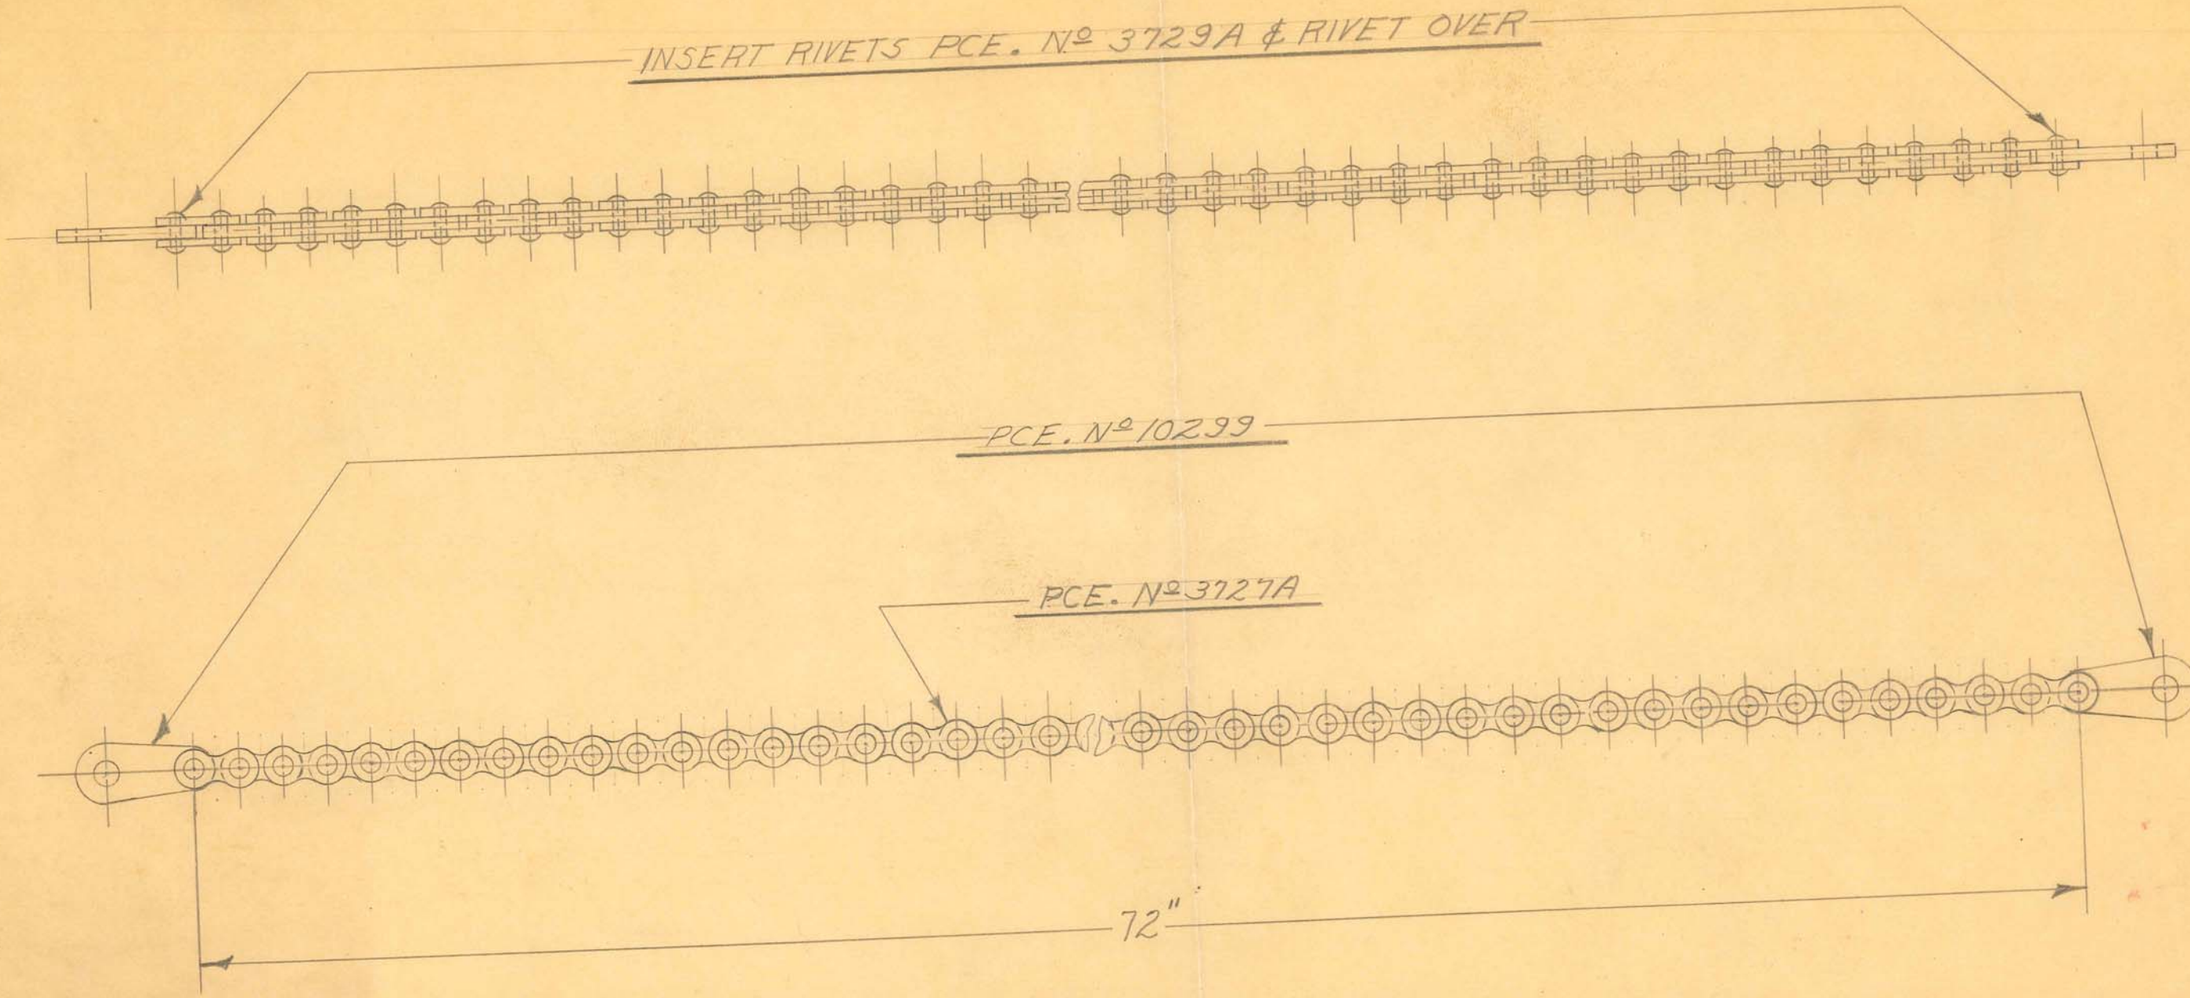

1-REQUIRED

OBSOLETE

SIZE		ISSUE 9-16-47	J.M.F	TITLE: FISCHER "PRECISION 200" X-RAY CWT. CHAIN ASSEM
KIND		CHANGED		
SHAPE		"		
FINISH		"		
TEMP.		"		
PATT.		"		

H. G. FISCHER & CO.
2335 WABANSIA AVE.
CHICAGO, ILL.

CAT. NO.

PART NO. 16793G

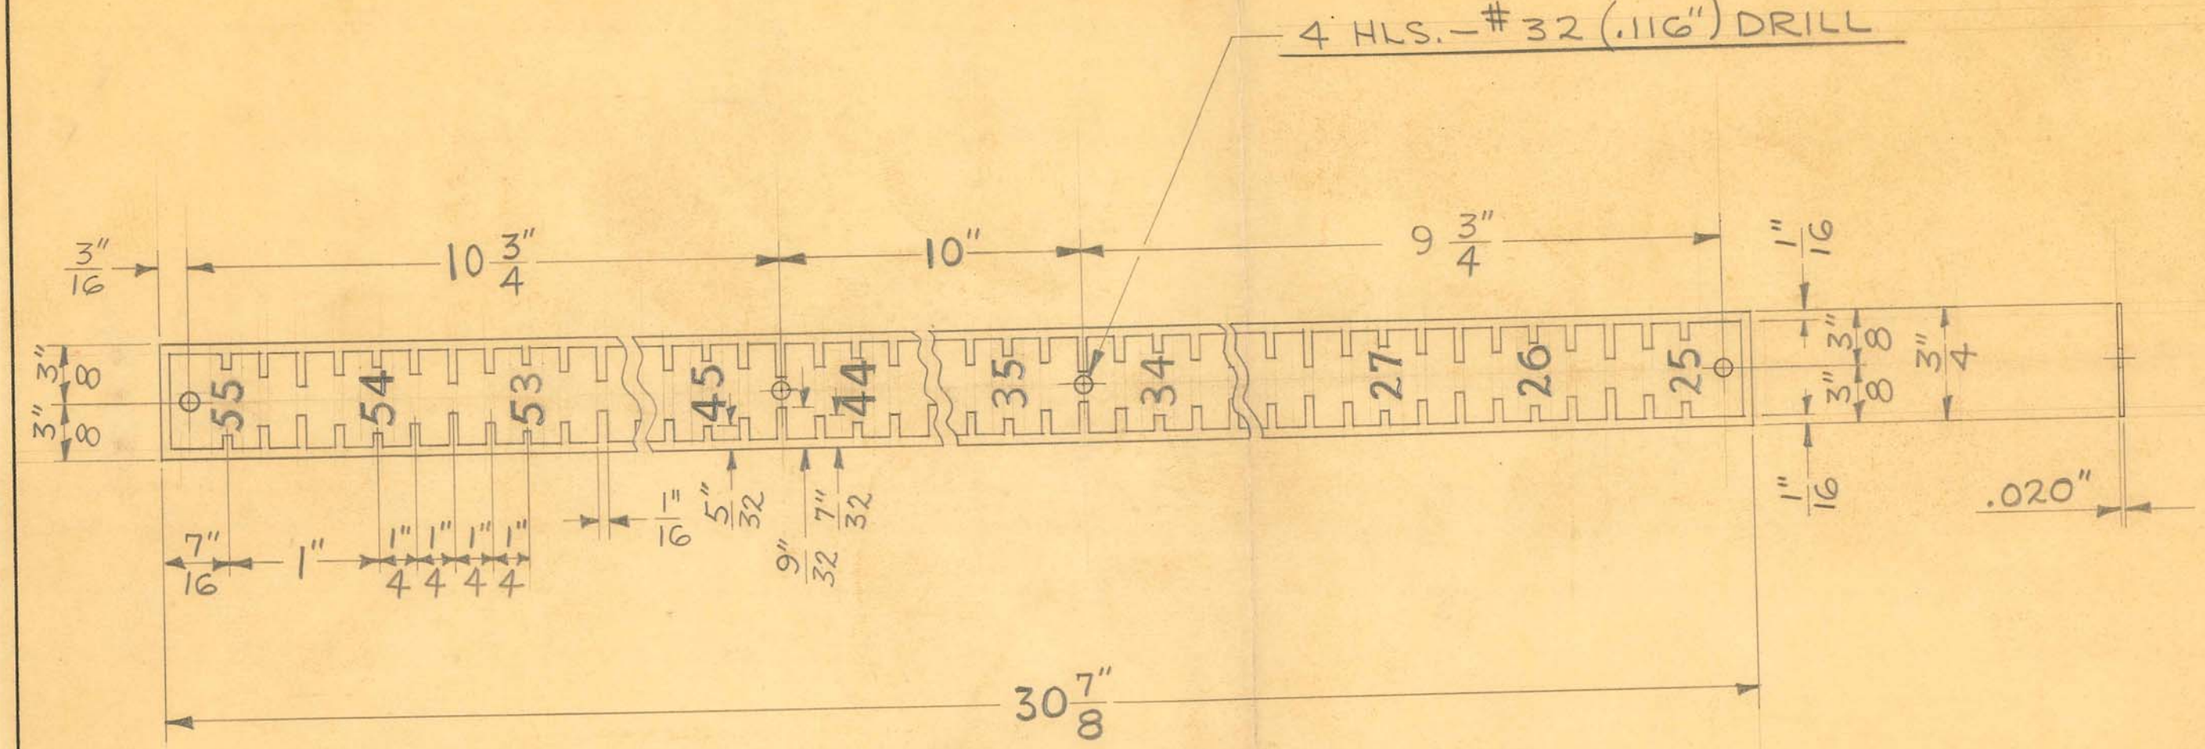

2 REQUIRED

OBSOLETE

obsolete
3-26-51
gs

SIZE		ISSUE 8-14-47	J.V.W.	TITLE: FISCHER "PRECISION 200" X-RAY VERTICAL SCALE
KIND		CHANGED		
SHAPE		"		
FINISH		"		
TEMP.		"		
PATT.		"		

H. G. FISCHER & CO. 2335 WABANSIA AVE. CHICAGO, ILL.	CAT. NO.	PART NO. 16799

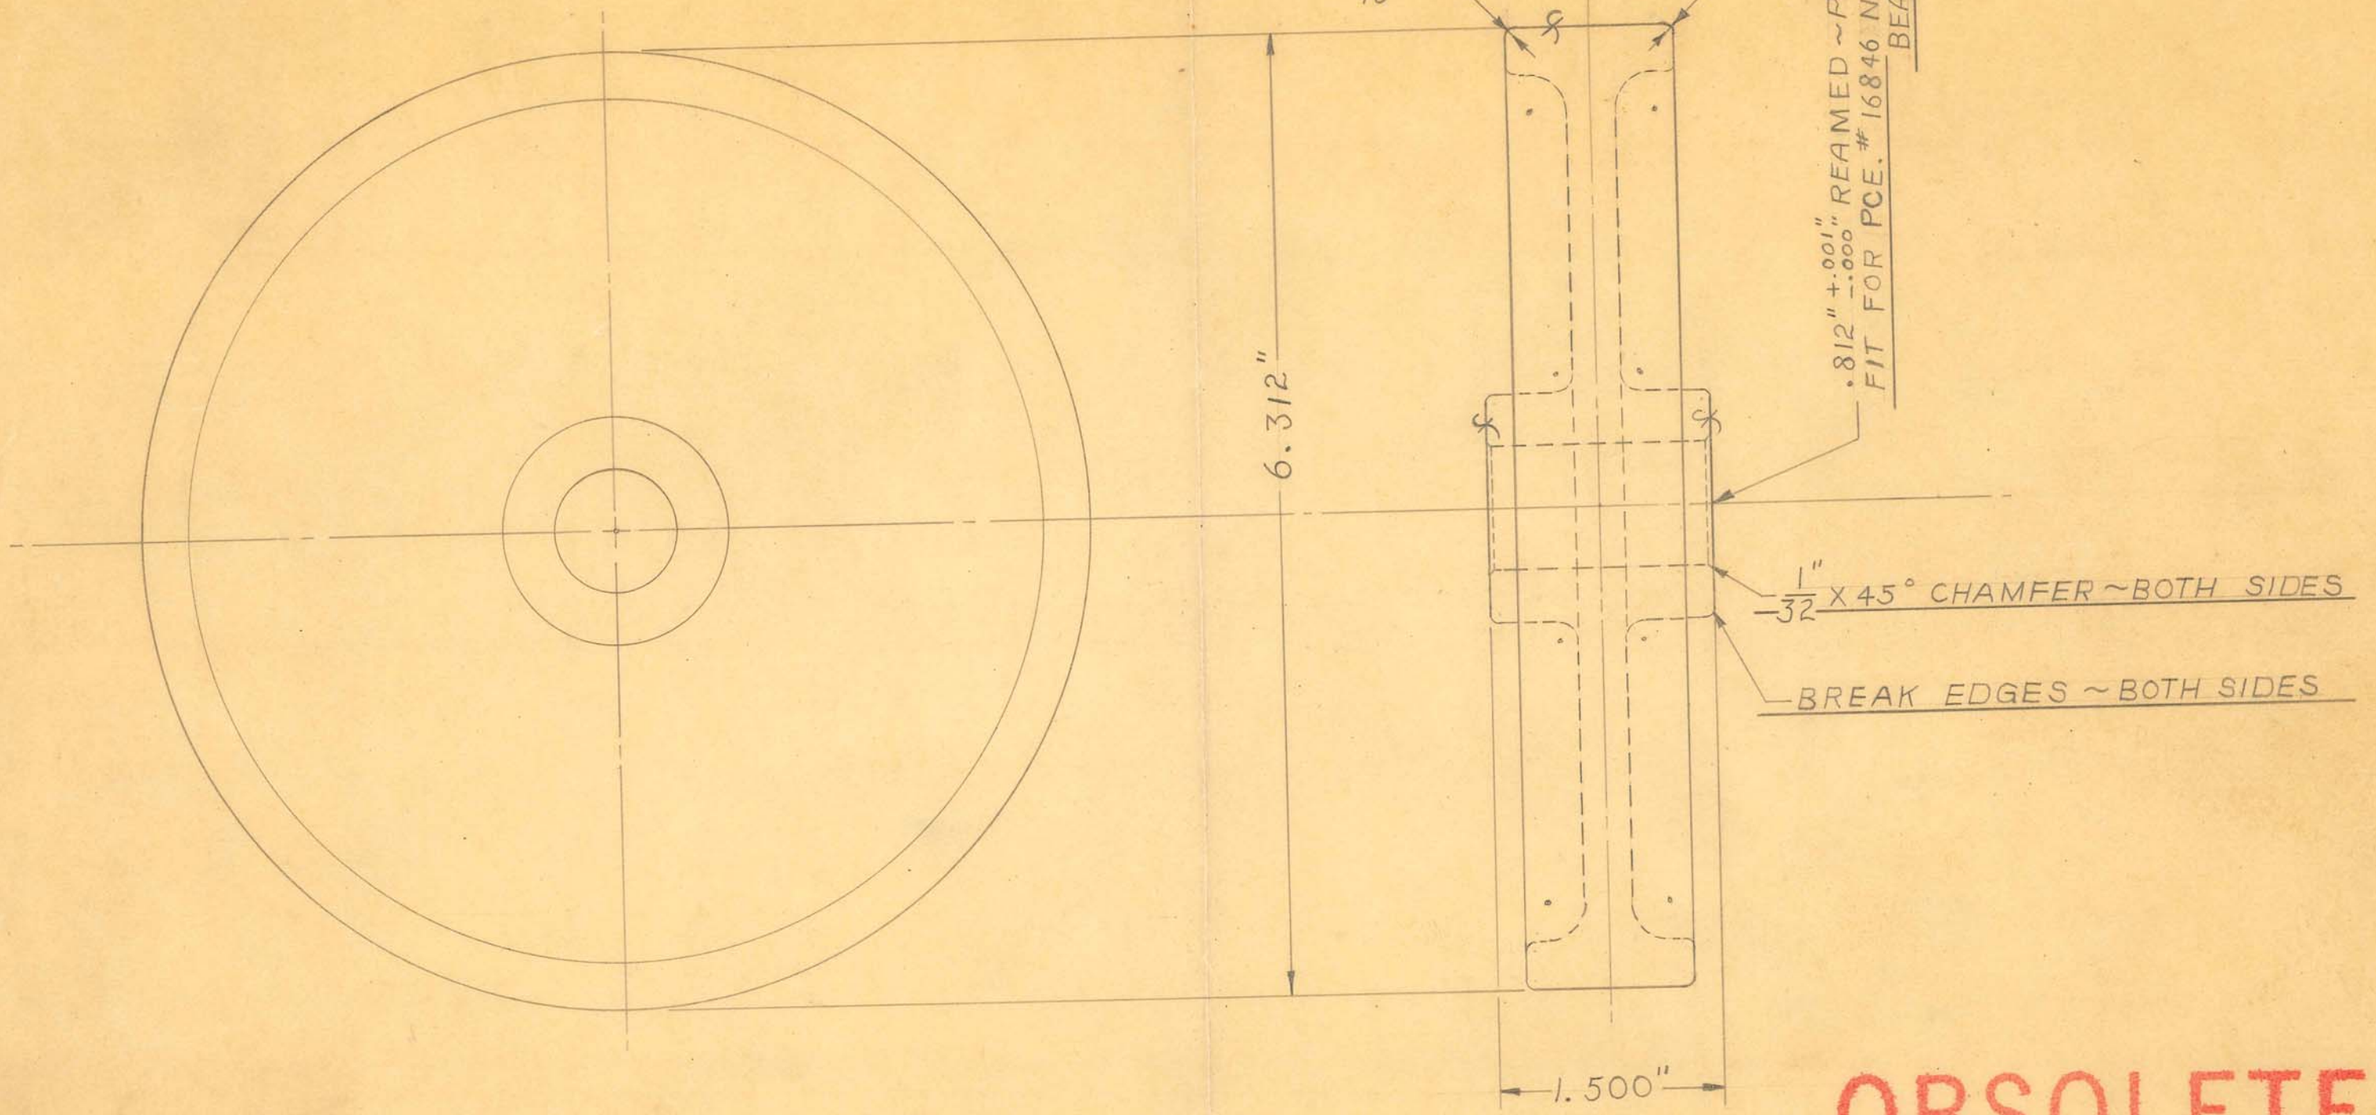

OBSOLETE

1 REQUIRED

DIMENSIONS	
FRACTIONAL	± .015
DECIMAL	± .005
ANGULAR	± ½°
UNLESS OTHERWISE SPECIFIED	

SIZE	CAST IN	ISSUE 7-14-47	W.J.
KIND	GRAY IRON	CHANGED	
SHAPE		"	
FINISH	CAD. #23	"	
TEMP.		"	
PATT.	2070	"	

TITLE:
FISCHER "PRECISION 200" X-RAY UNIT
BASE ROLLER ~ PLAIN

H. G. FISCHER & CO. 2335 WABANSIA AVE. CHICAGO, ILL.	CAT. NO.	PART NO. 16803F

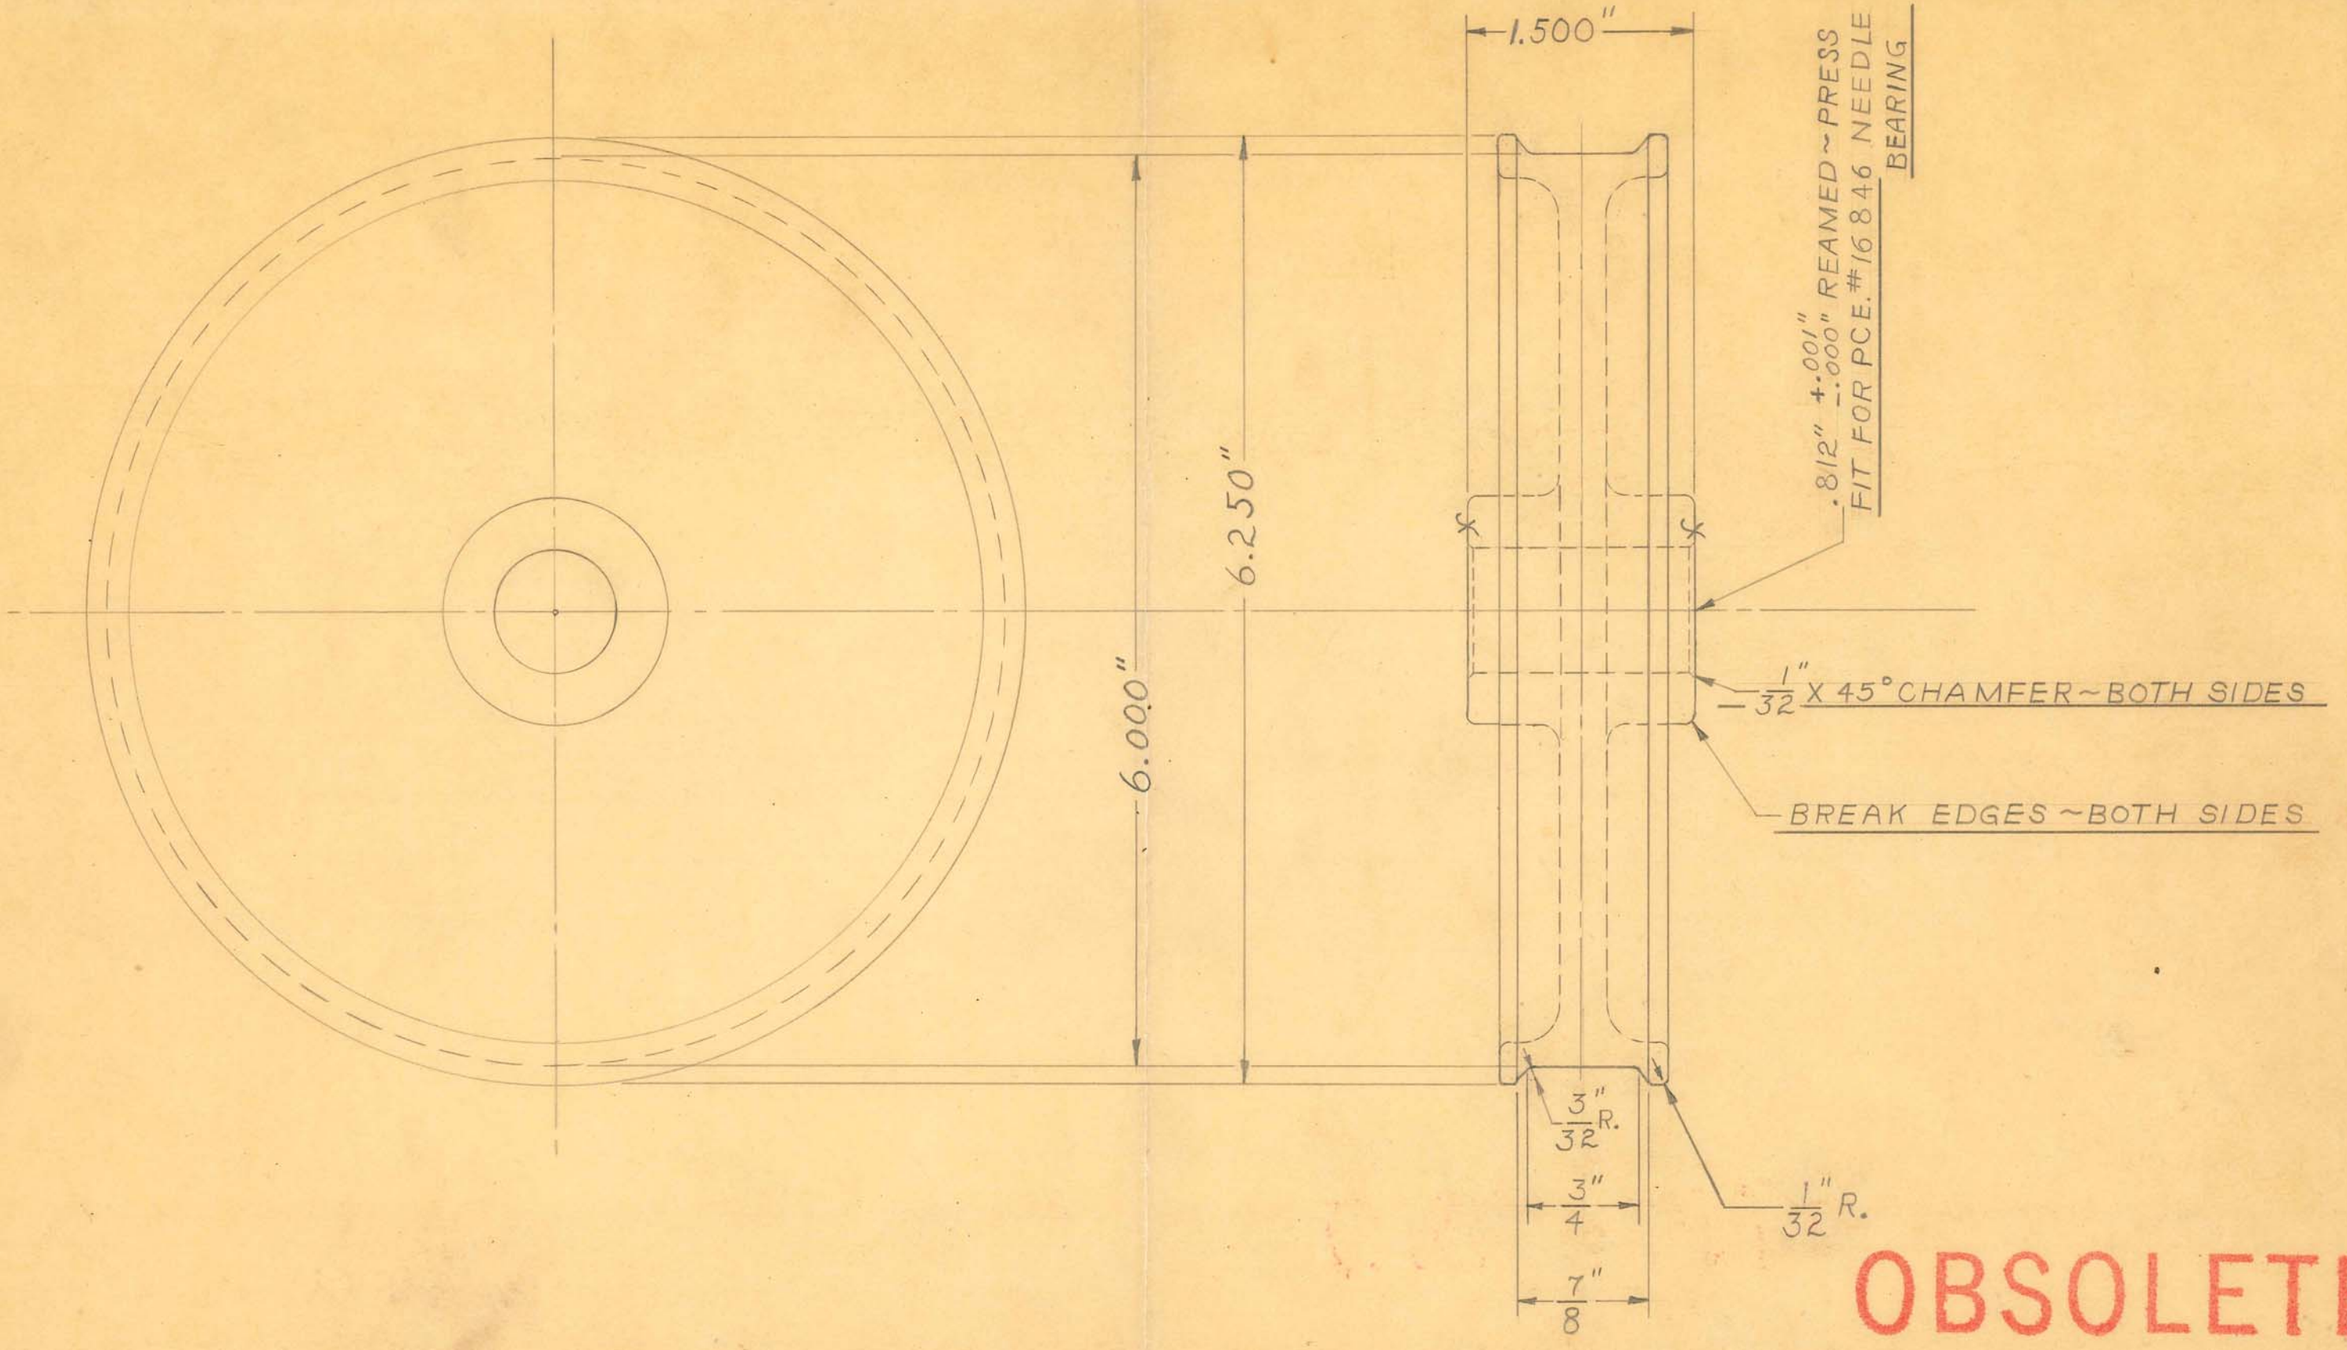

OBSOLETE

2 REQUIRED

DIMENSIONS	
FRACTIONAL	± .015
DECIMAL	± .005
ANGULAR	± ½°
UNLESS OTHERWISE SPECIFIED	

SIZE	CAST IN	ISSUE 7-15-47	W.J.
KIND	GRAY IRON	CHANGED	
SHAPE		"	
FINISH	CAD. #23	"	
TEMP.		"	
PATT.	2070	"	

TITLE: FISCHER "PRECISION 200" X-RAY UNIT
BASE ROLLER ~ GROOVED

H. G. FISCHER & CO. 2335 WABANSIA AVE. CHICAGO. ILL.	CAT. NO.	PART NO. 16804

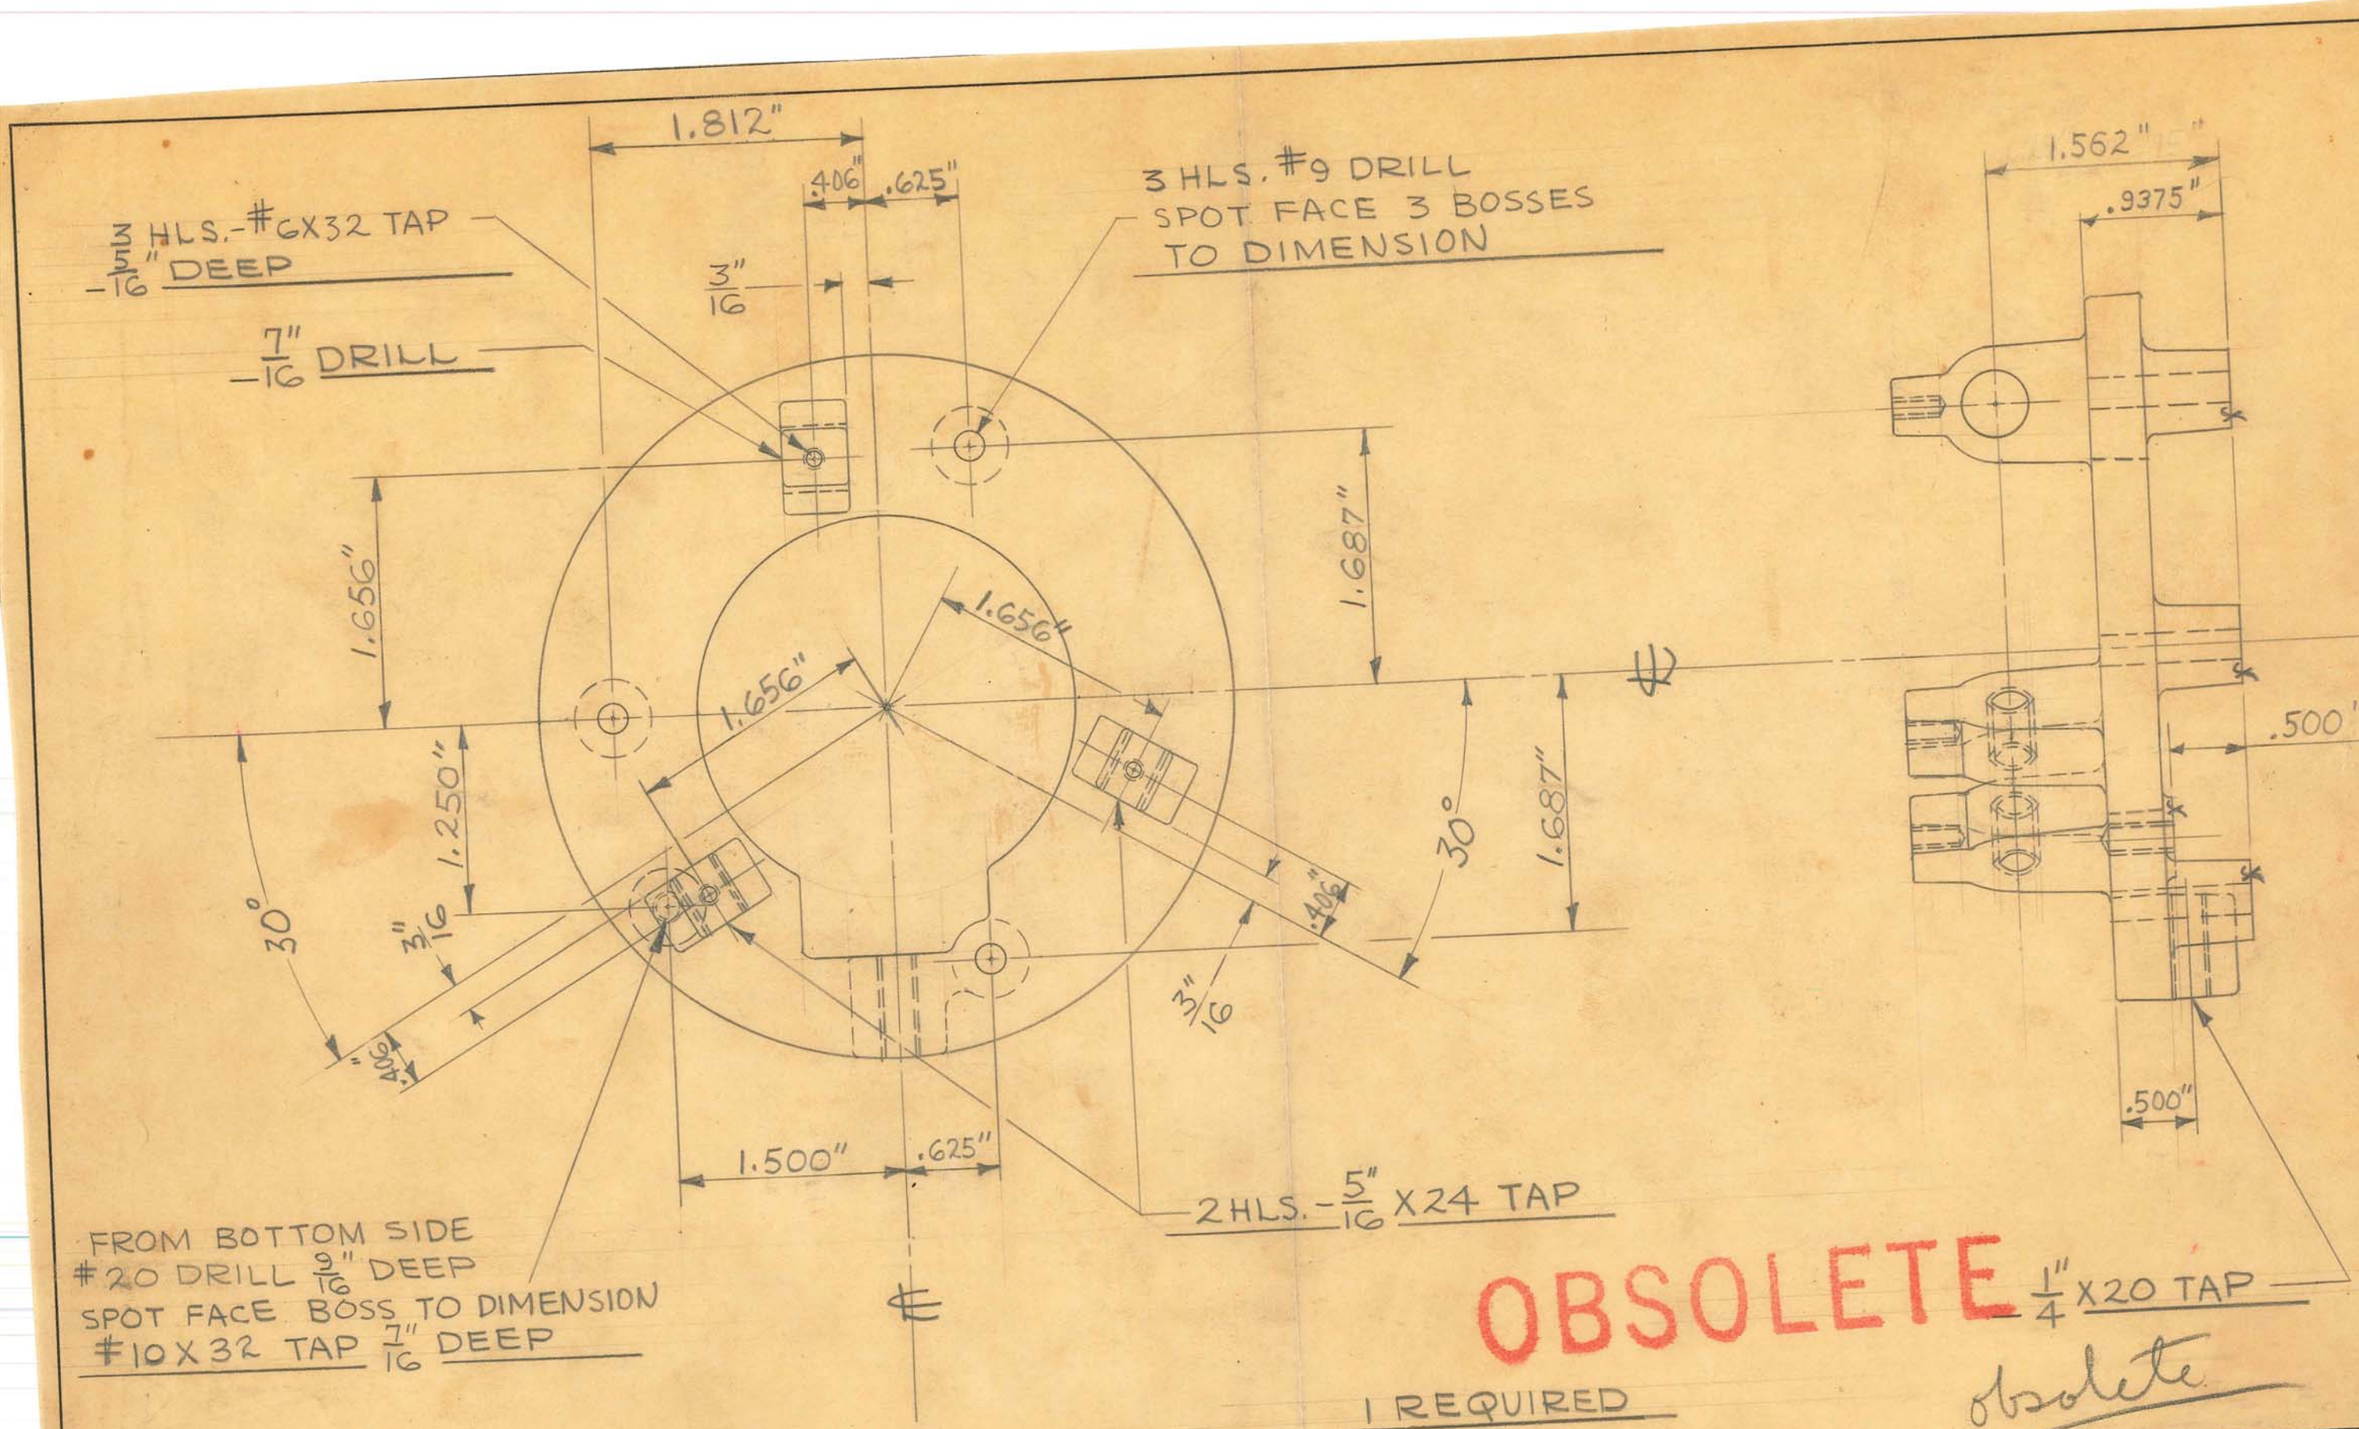

OBSOLETE

Obsolete

1 REQUIRED

FIRST OPERATION DRILL JIG TOOL #9342
" " " #9343
SECOND " "

DIMENSIONS
FRACTIONAL ±.015
DECIMAL ±.005
ANGULAR ±½°

SIZE	#12	ISSUE 6-21-47	J.V.W.	TITLE: FISCHER "PRECISION 200" X-RAY HORIZ. SLIDE BEARING SUPP.-FRONT
KIND	ALUMINUM	CHANGED		
SHAPE		"		
FINISH	PAINTED	"		
TEMP.		"		
WT.	3047	"		

H. G. FISCHER & CO.
2335 WABANSIA AVE.
CHICAGO, ILL.

CAT. NO.

PART NO. 16813F

FIRST OPERATION 1.505" MILL
SECOND " DRILL HOLES

$\frac{1}{4}$" X20 TAP

1.505" +.005" -.000"

.375"

3 HLS. $\frac{5}{16}$" X18 TAP

4.000"

3.520" DIA.

2 HLS. - $\frac{1}{4}$" X20 TAP

1.468"

1.468"

120°

120°

.437"

.875"

1 REQUIRED

MILLING FIXTURE TOOL #9366 DRILL JIG TOOL #9405

OBSOLETE

DIMENSIONS	
FRACTIONAL	± .015
DECIMAL	± .005
ANGULAR	± ½°
UNLESS OTHERWISE SPECIFIED	

SIZE	#12 ALUM.	ISSUE 7-2-47	J.V.W.
KIND	CASTING	CHANGED	
SHAPE		"	
FINISH	PAINTED	"	
TEMP.		"	
PATT.	2053	"	

TITLE:
FISCHER "PRECISION 200" X-RAY
PULLEY SUPPORT BRACKET

H. G. FISCHER & CO.
2335 WABANSIA AVE.
CHICAGO, ILL.

CAT. NO.

PART NO. 16817F

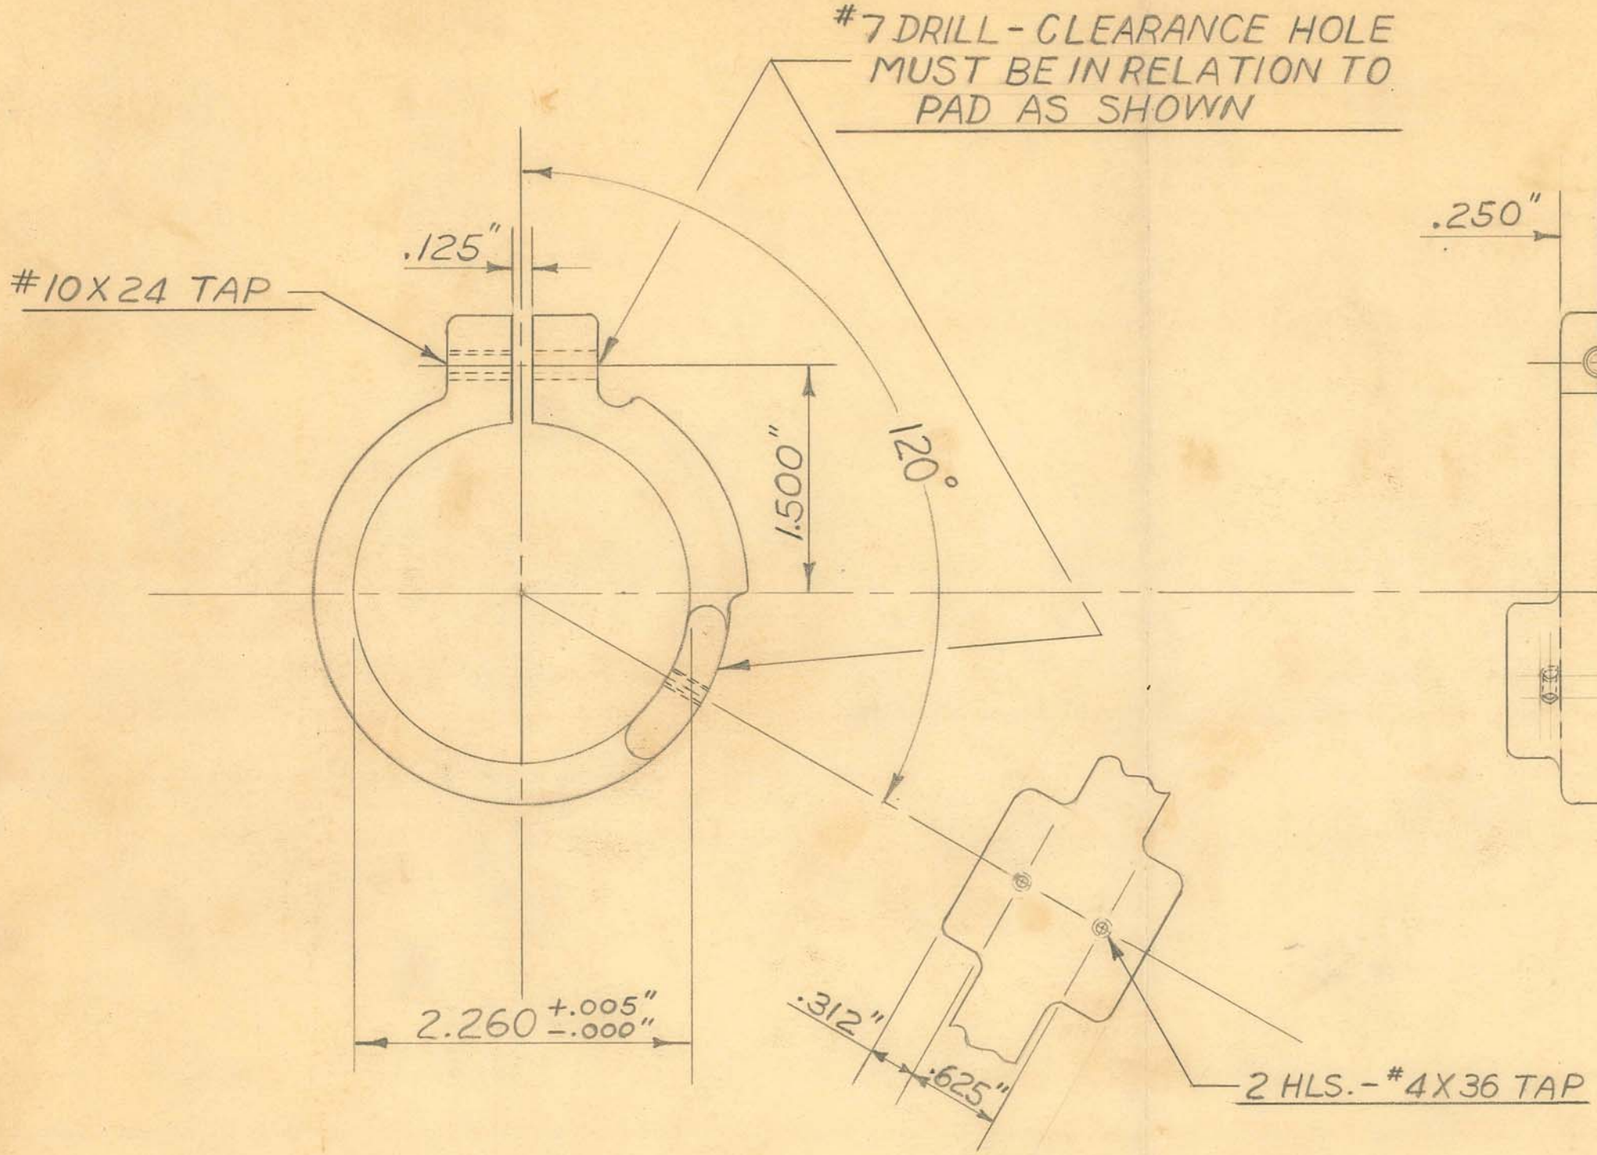

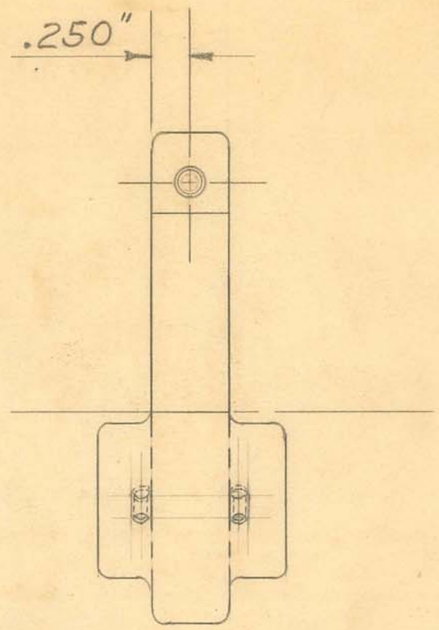

OBSOLETE

Obsolete

1-REQUIRED

TURNING JAWS TOOL # 9718
MILLING FIXTURE TOOL #9373
DRILL JIG TOOL #9376

SIZE	#12 ALUM.	ISSUE 7-3-47	J.V.W.
KIND	CASTING	CHANGED 1-23-48	J.B.G.
SHAPE		"	
FINISH	PAINTED	"	
TEMP.		"	
PATT.	#2319	"	

DIMENSIONS	
FRACTIONAL	± .015
DECIMAL	± .005
ANGULAR	± 1/2°
UNLESS OTHERWISE SPECIFIED	

TITLE: FISCHER "PRECISION 200" X-RAY HORIZONTAL SLIDE STOP

H. G. FISCHER & CO.
2335 WABANSIA AVE.
CHICAGO, ILL.

CAT. NO.

PART NO. 16818AF

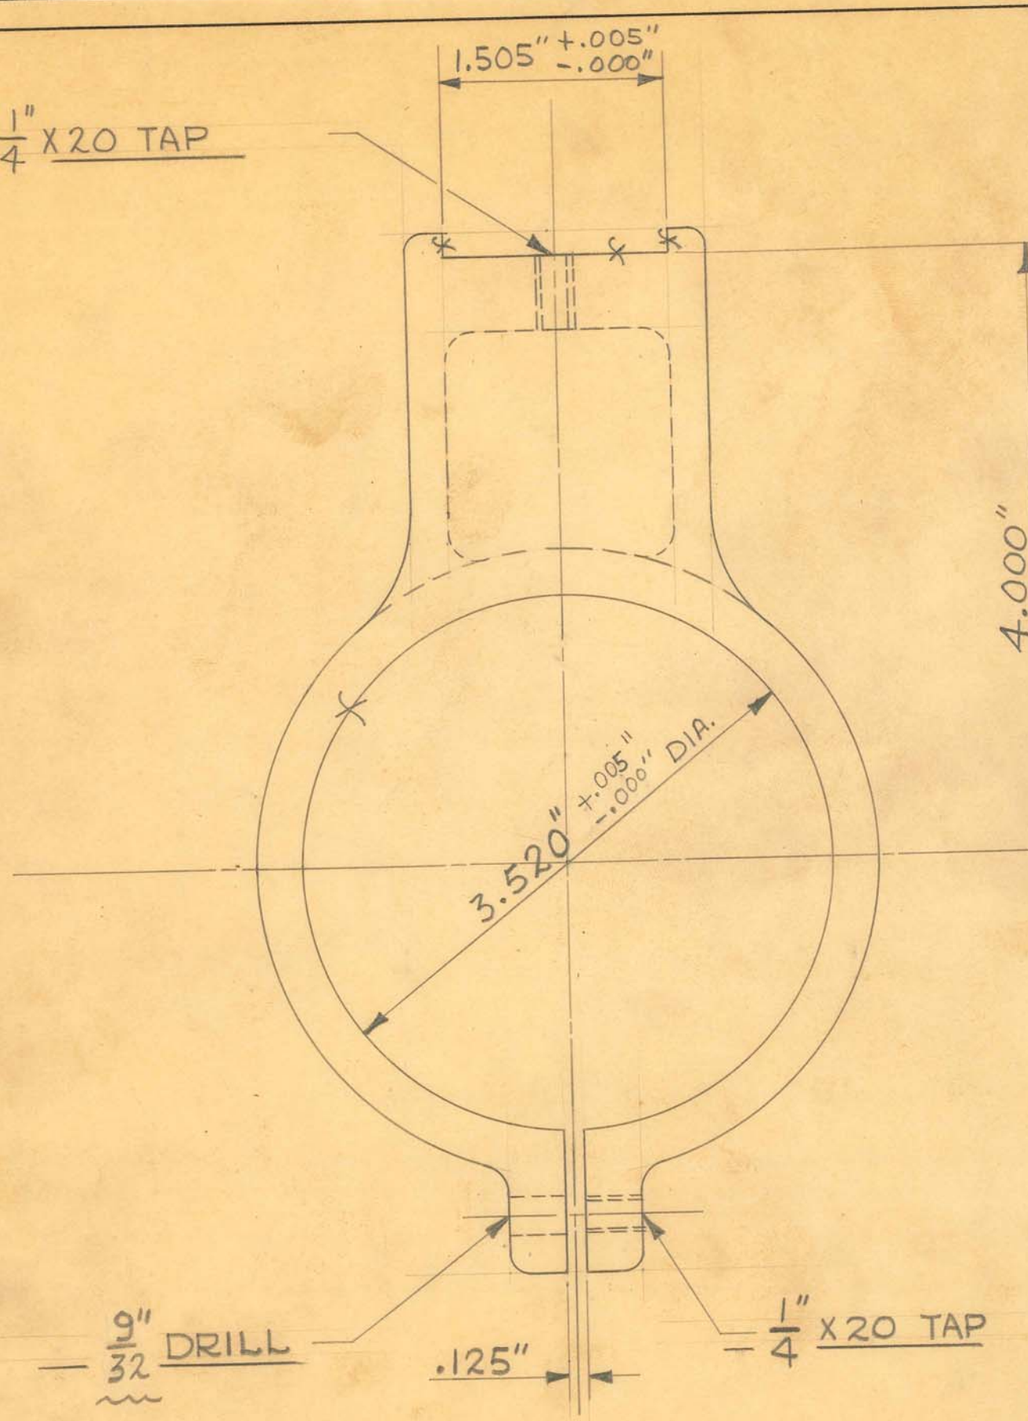

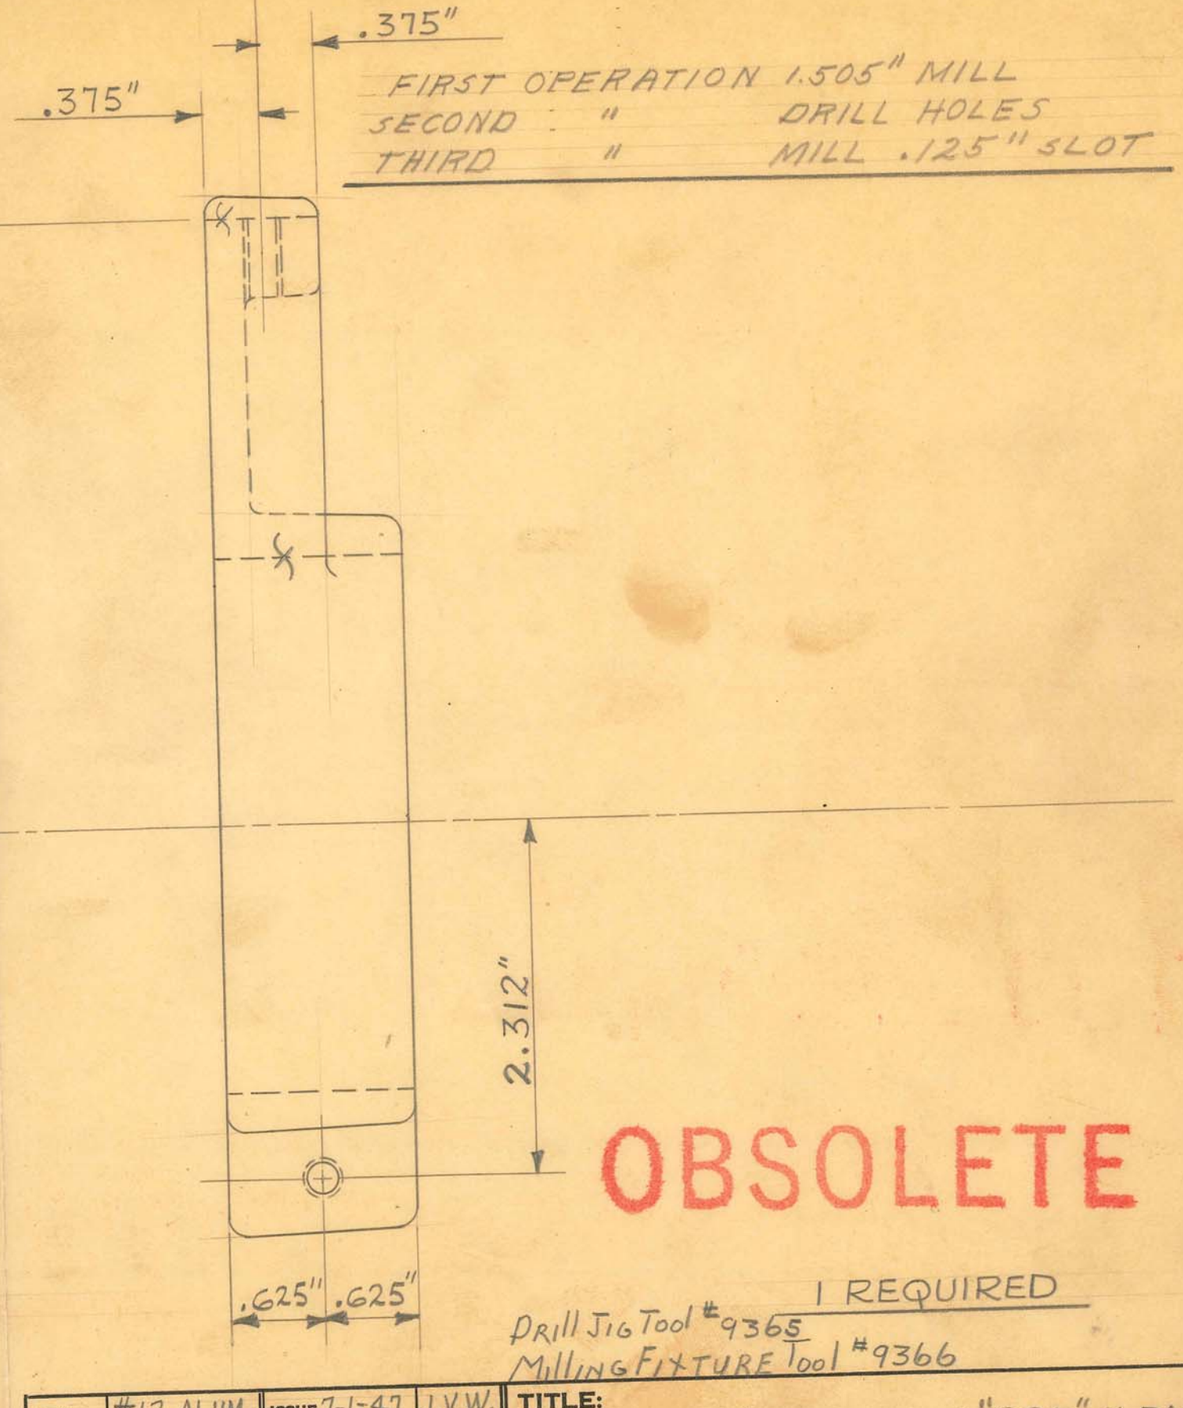

FIRST OPERATION 1.505" MILL
SECOND " DRILL HOLES
THIRD " MILL .125" SLOT

OBSOLETE

1 REQUIRED

DRILL JIG TOOL # 9365
MILLING FIXTURE TOOL # 9366

DIMENSIONS	
FRACTIONAL	± .015
DECIMAL	± .005
ANGULAR	± ½°

DIMENSIONS	
FRACTIONAL	± .015
DECIMAL	± .005
ANGULAR	± ½°

SIZE	#12 ALUM.	ISSUE 7-1-47	J.V.W.
KIND	CASTING	CHANGED	
SHAPE		"	
FINISH	PAINTED	"	
TEMP.		"	

TITLE:
FISCHER "PRECISION" 200" X-RAY
VERT. SLIDE GUIDE BAR SUPPORT

H. G. FISCHER & CO.
2335 WABANSIA AVE.
CHICAGO, ILL.

CAT. NO.

PART NO. 16819F

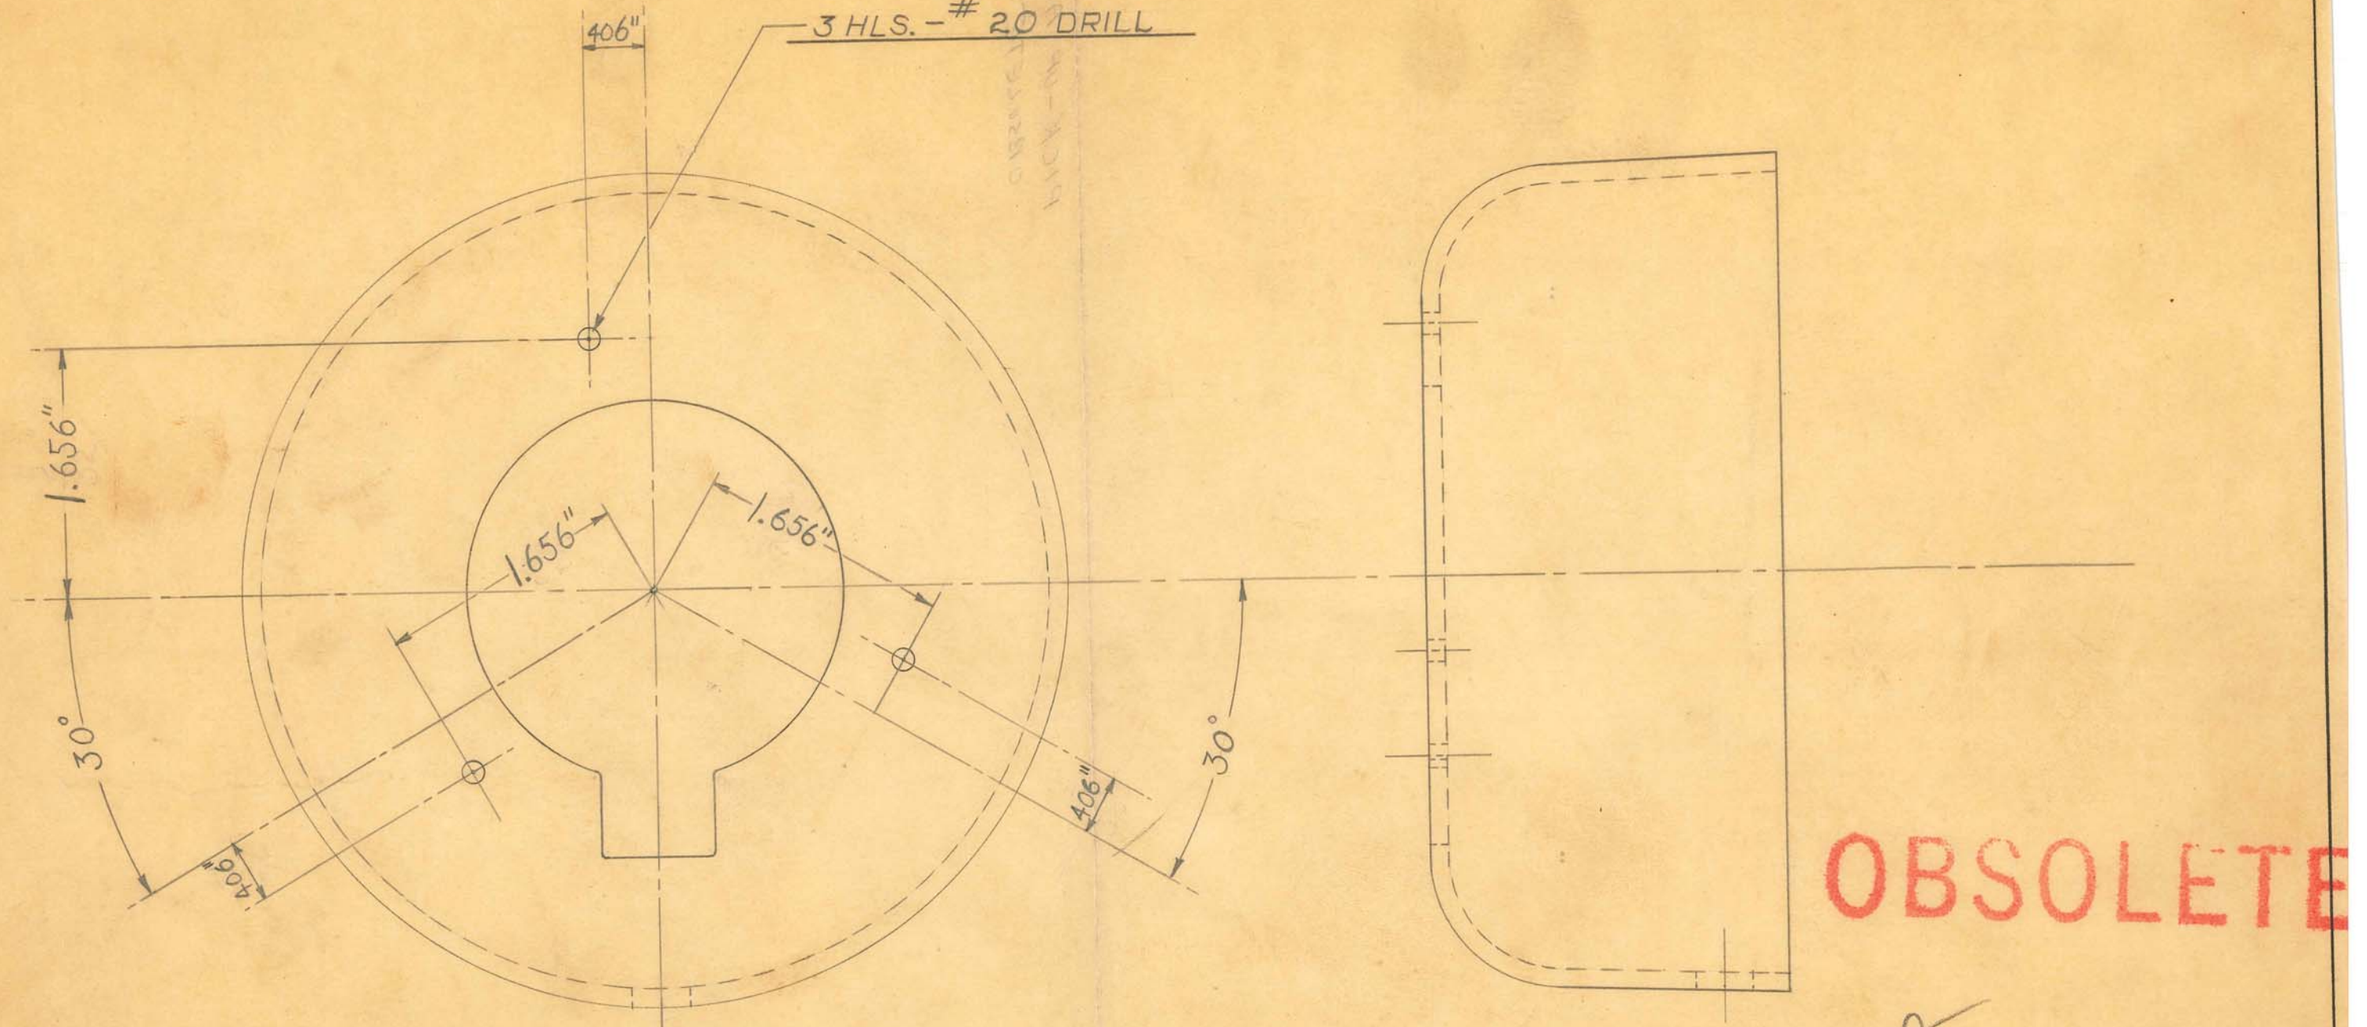

OBSOLETE

Obsolete

DRILL JIG TOOL #9345

DIMENSIONS	
FRACTIONAL	± .015
DECIMAL	± .005
ANGULAR	± ½°
UNLESS OTHERWISE SPECIFIED	

SIZE	#12	ISSUE 6-23-47	W.J.
KIND	ALUMINUM	CHANGED	
SHAPE	CASTING	"	
FINISH	PAINTED	"	
TEMP.		"	
PATT.	2049	"	

TITLE: FISCHER "PRECISION 200" X-RAY UNIT
HORIZ. SLIDE BEARING SUPP. COVER-FRONT

H. G. FISCHER & CO.
2335 WABANSIA AVE.
CHICAGO, ILL.

CAT. NO.

PART NO. 16835

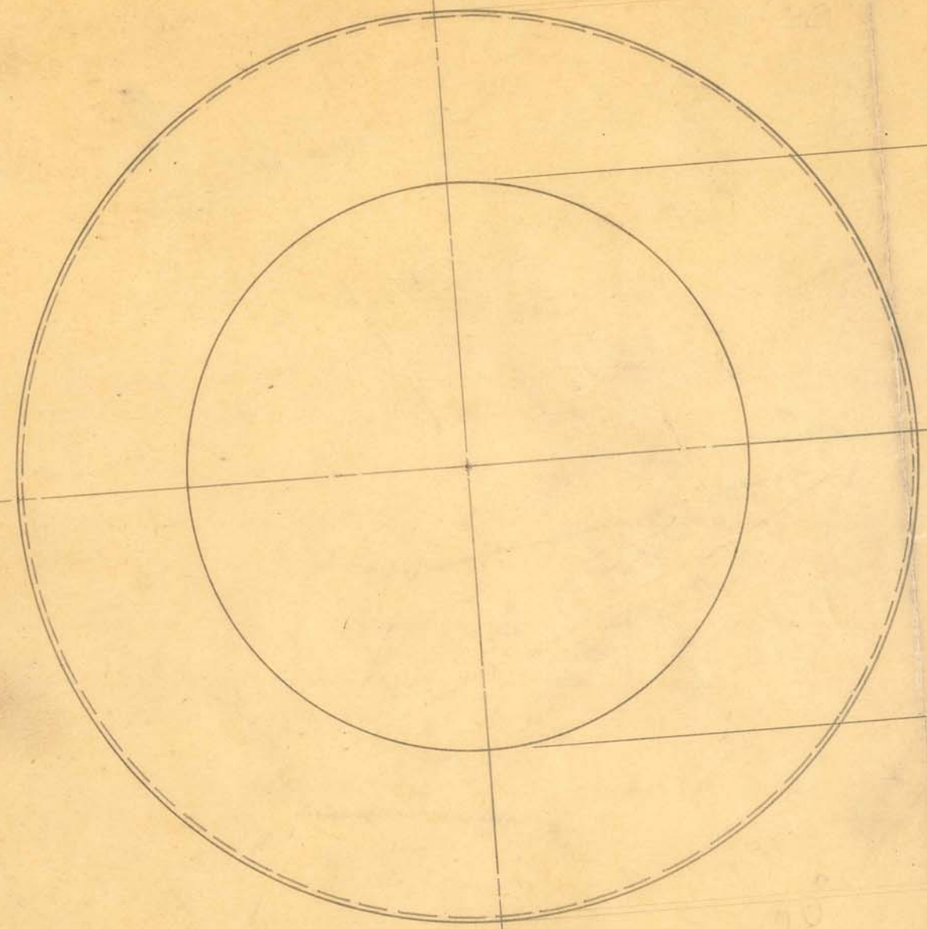

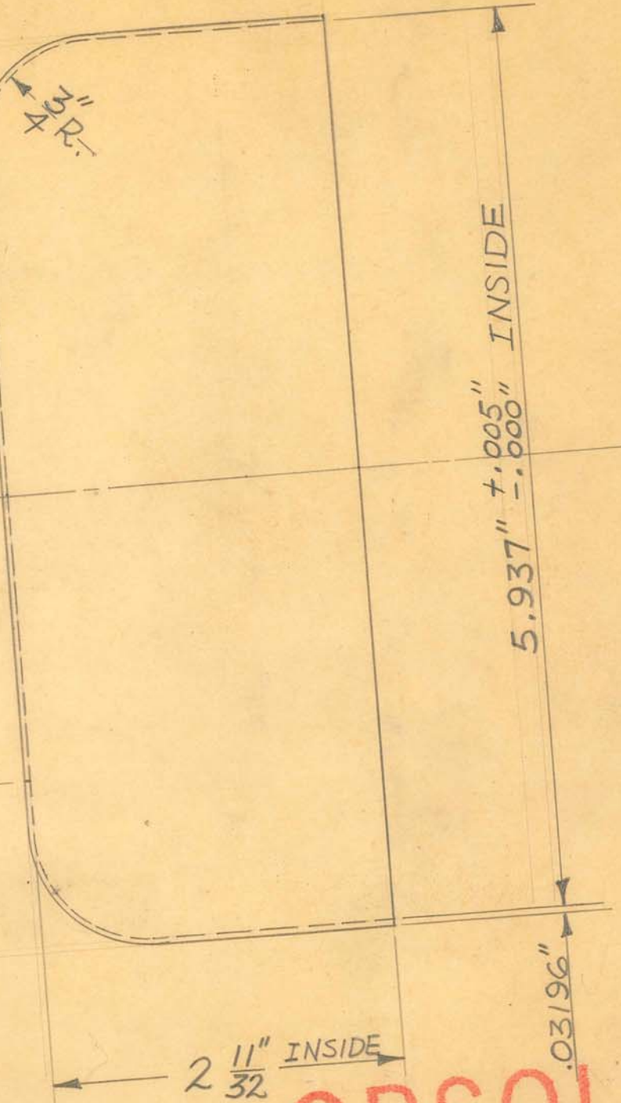

OBSOLETE

#20 GA. (.03196") SHEET ALUMINUM

SIZE		ISSUE 6-28-47	J.V.W.
KIND		CHANGED	
SHAPE		"	
FINISH		"	
TEMP.		"	
PATT.		"	

TITLE:
FISCHER "PRECISION 200" X-RAY
VERTICAL SLIDE BEARING COVER

H. G. FISCHER & CO.
2335 WABANSIA AVE.
CHICAGO, ILL.

CAT. NO.

PART NO. 16837

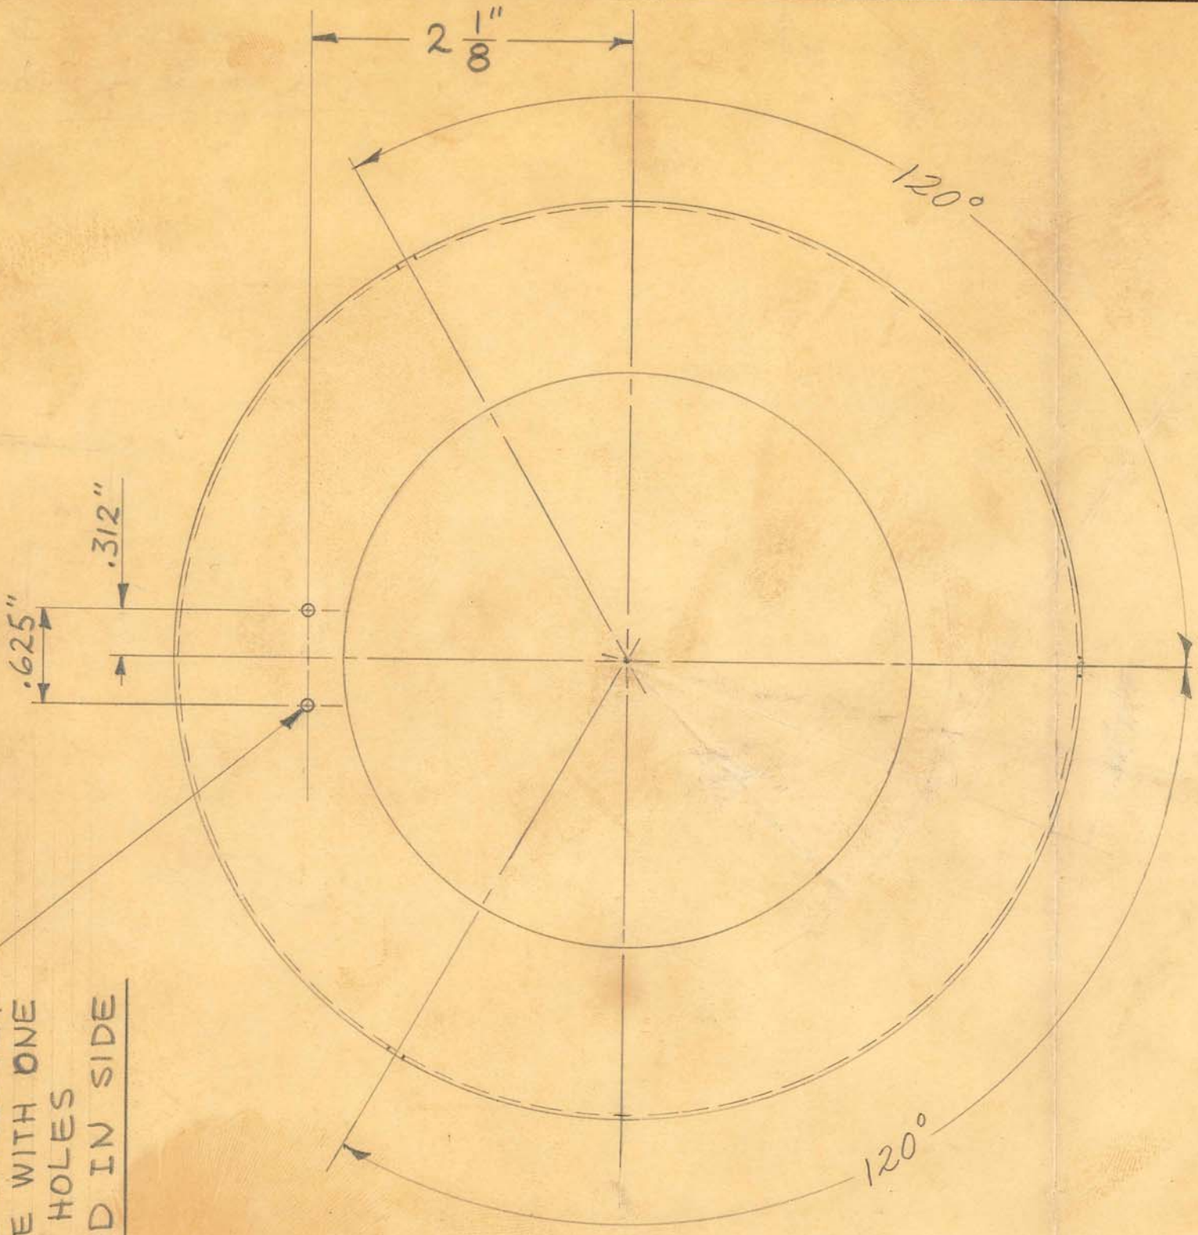

2 HLS.-#42 DRILL
MUST BE DIRECTLY
IN LINE WITH ONE
OF THE HOLES
DRILLED IN SIDE

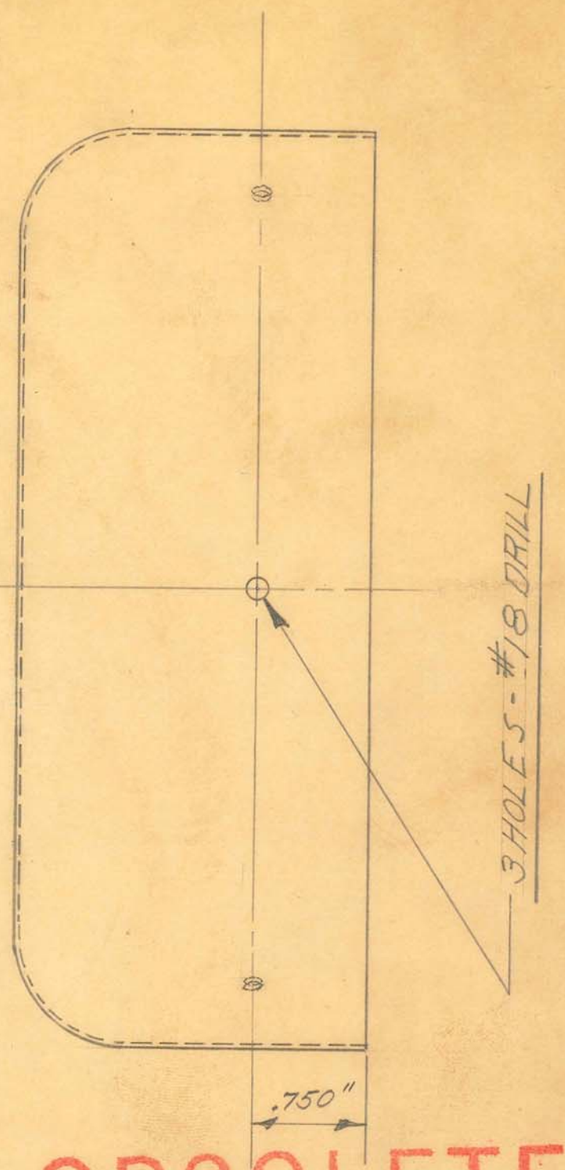

1-REQUIRED

OBSOLETE

DRILL JIG TOOL #9353

SIZE	FROM 16837	ISSUE 8-20-41 NF	
KIND		CHANGED	
SHAPE		"	
FINISH	PAINTED	"	
TEMP.		"	
PATT.		"	

TITLE: FISCHER" PRECISION 200" X RAY VERTICAL SLIDE BEARING COVER TOP

H. G. FISCHER & CO.
2335 WABANSIA AVE.
CHICAGO, ILL.

CAT. NO.

PART NO. 16837F

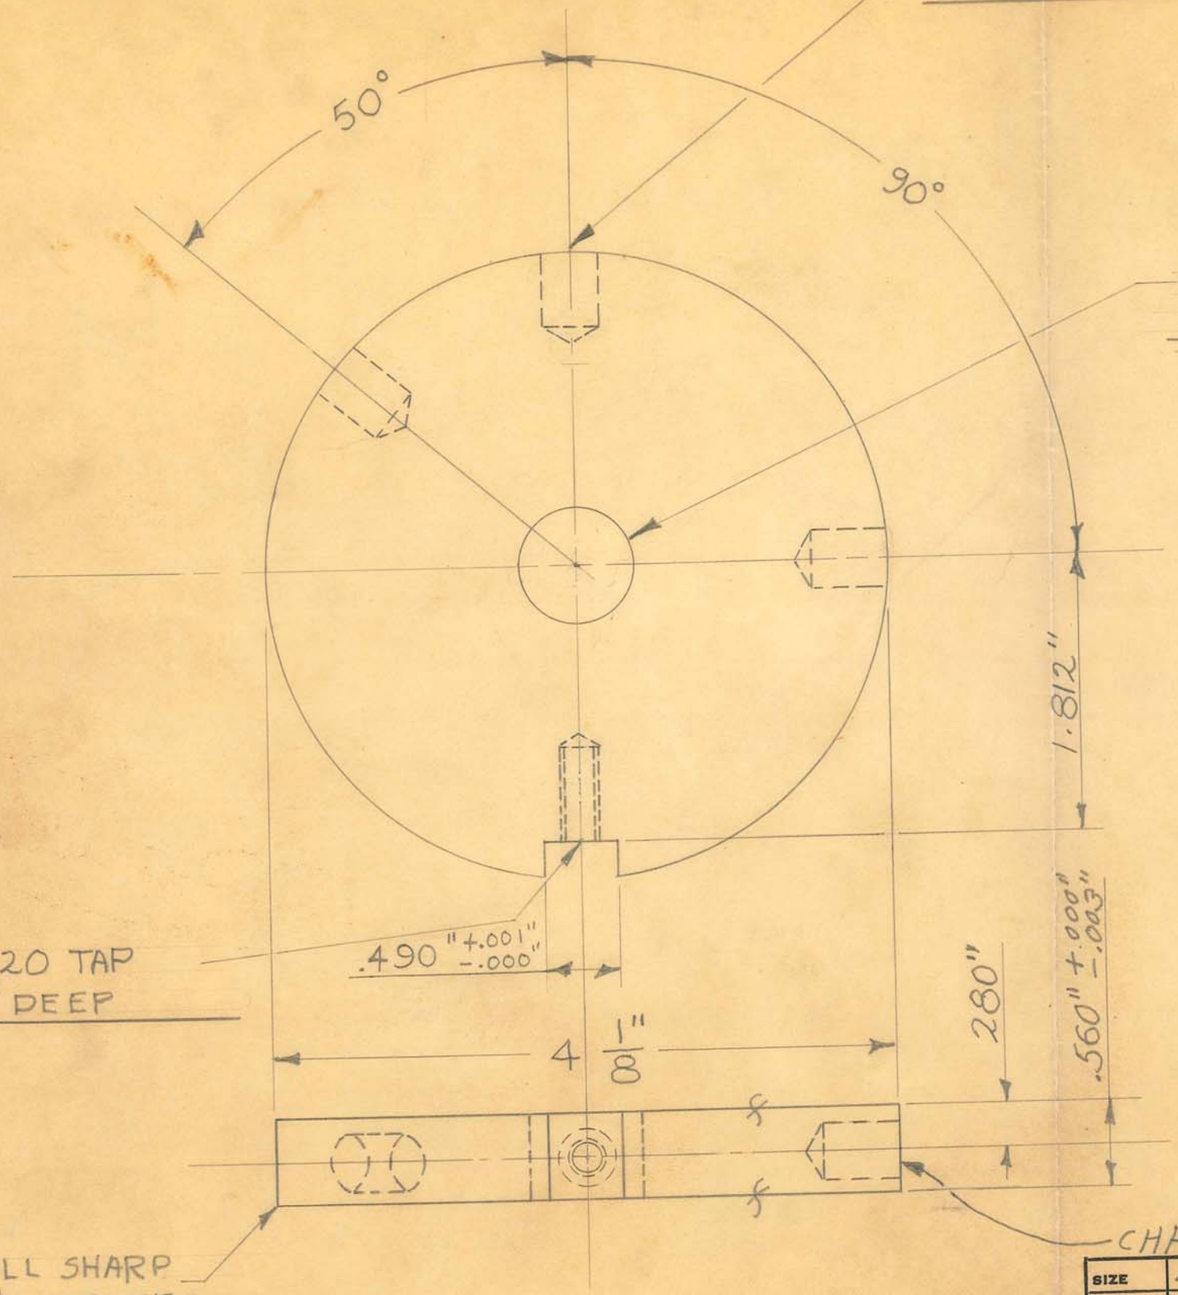

Absolete

CUT BLANK ON POWER HACKSAW
4 1/8" DIA. C.R. STEEL 5/8" +1/32" -.000" THICK

OBSOLETE

DRILL JIG Tool # 9367
MILLING FIXTURE Tool # 9368

CHROME #2 POLISH EDGE ONLY

.490" CUTTER TOOL # 9461

DIMENSIONS
FRACTIONAL ± .015
DECIMAL ± .005
ANGULAR ± 1/2°
UNLESS OTHERWISE SP...

SIZE	4⅛" DIA.	ISSUE 7-2-47	J.V.W.
KIND	C.R. STEEL	CHANGED	
SHAPE		"	
FINISH	SEE NOTE	"	
TEMP.		"	
		"	

TITLE:
FISCHER "PRECISION" 200" X-RAY
HORIZ. SLIDE SWIVEL PLATE

H. G. FISCHER & CO.
2335 WABANSIA AVE.
CHICAGO, ILL.

CAT. NO.

PART NO. 16839

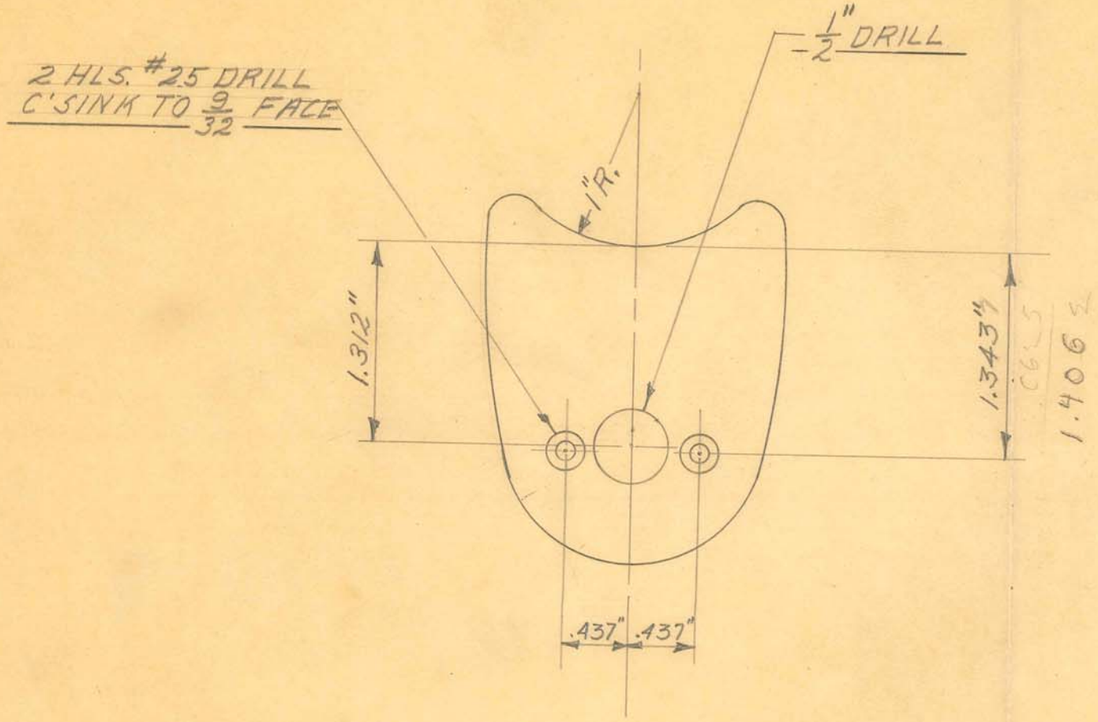

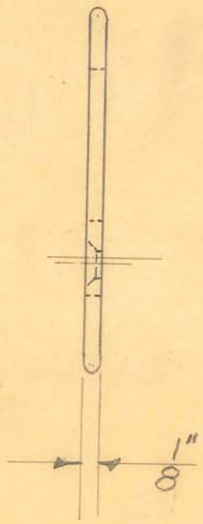

34375
0625
40 LL

2 REQUIRED

OBSOLETE

obsolete

DRILL JIG TOOL# 9393

SIZE		ISSUE 7-25-47	J.N.F.
KIND	#12 ALUM.	CHANGED	
SHAPE	CASTING	"	
FINISH	PAINTED	"	
TEMP.		"	
PATT.	2235	"	

DIMENSIONS
FRACTIONAL ± .015
DECIMAL ± .005
ANGULAR ± ½°
UNLESS OTHERWISE SPECIFIED

TITLE:
FISCHER "PRECISION 200" X-RAY UNIT
POLLEY SUPP. COVER PLATE

H. G. FISCHER & CO.
2335 WABANSIA AVE.
CHICAGO, ILL.

CAT. NO.

PART NO. 16848F

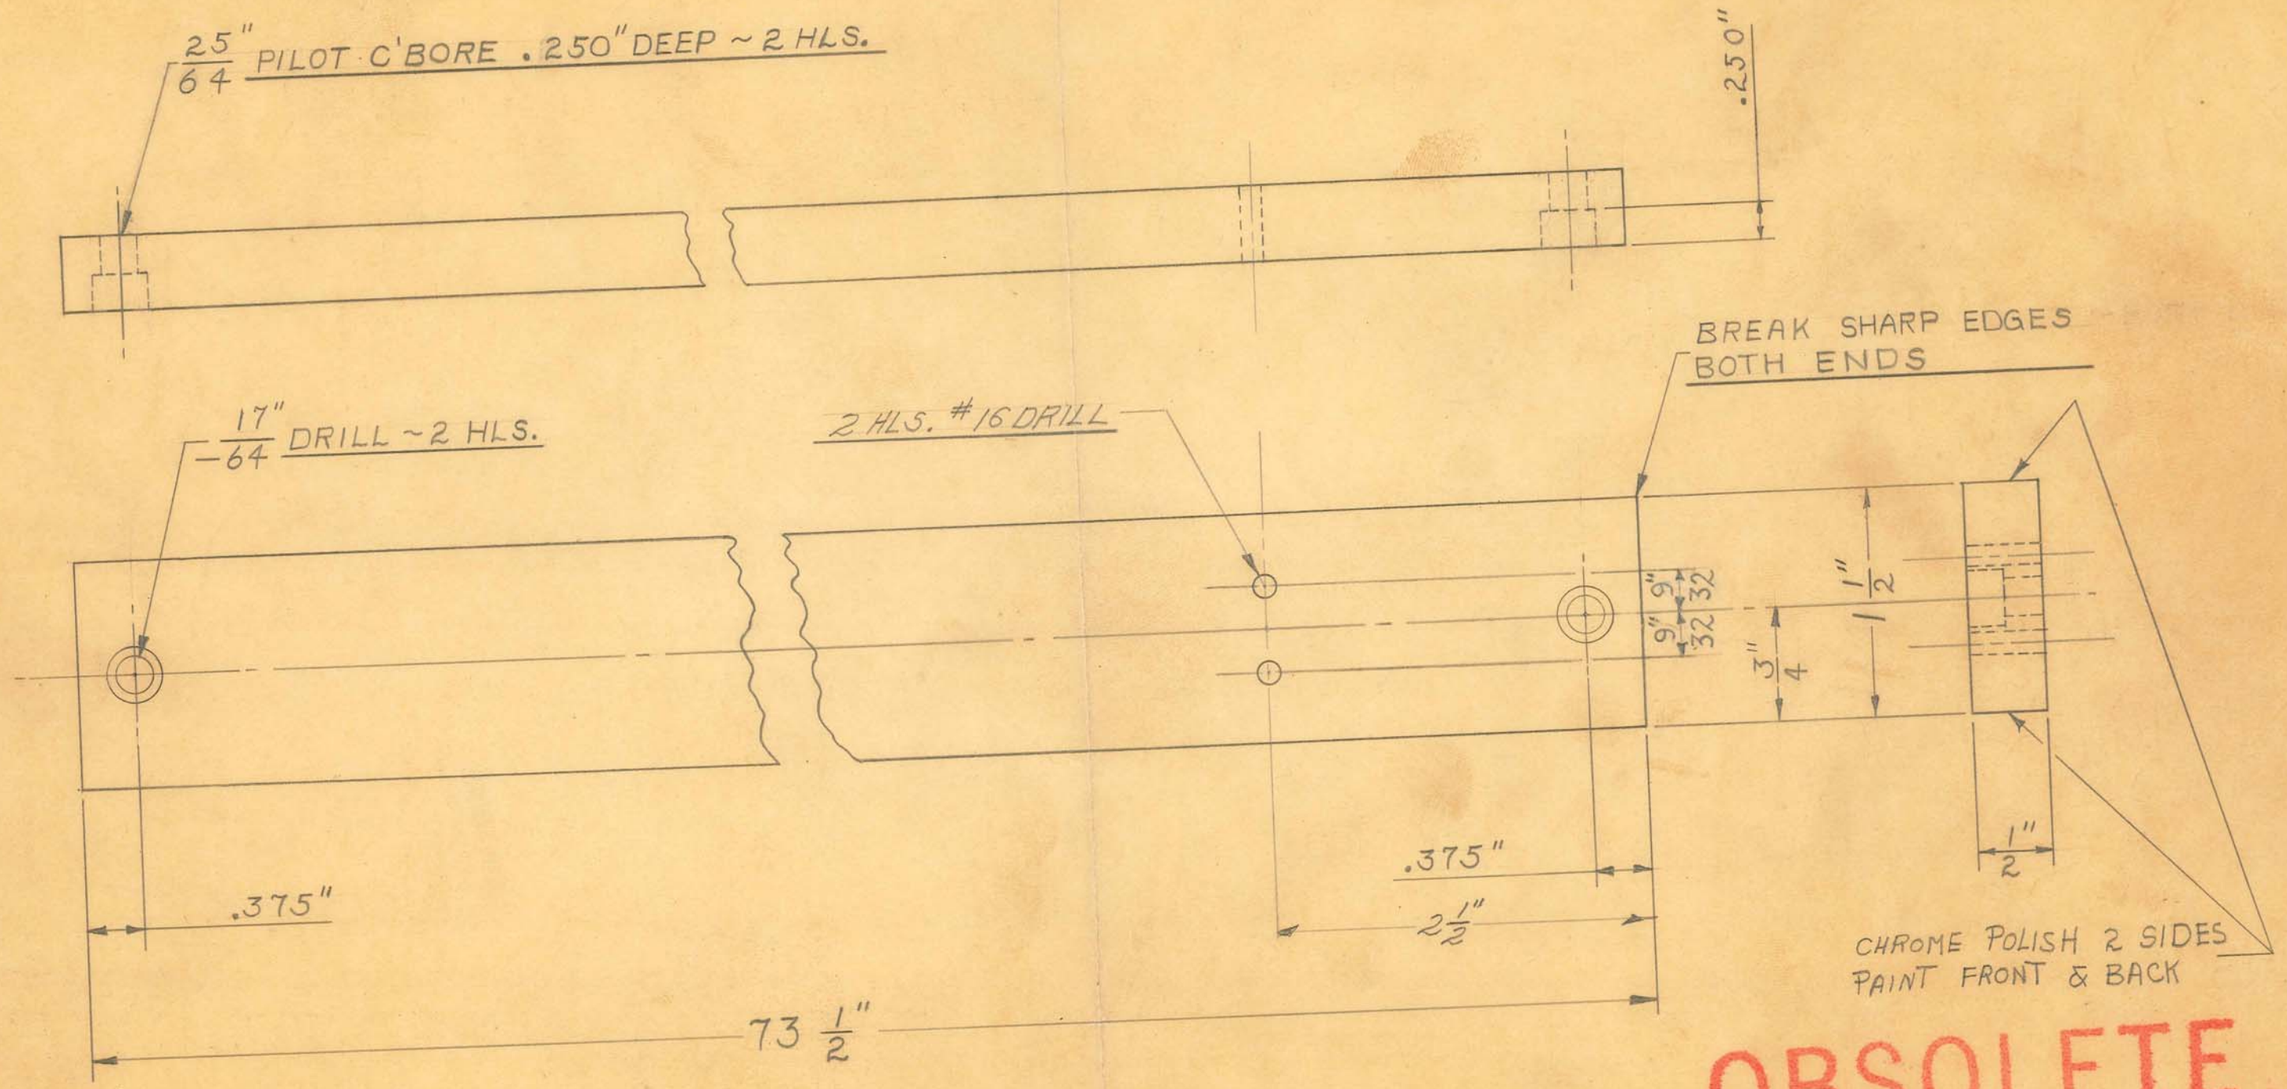

OBSOLETE

~~CHROME #2 - ALL 4 SIDE & ENDS~~ Drill Jig Tool #9402

1 REQUIRED

DIMENSIONS	
FRACTIONAL	± .015
DECIMAL	± .005
ANGULAR	± ½°

UNLESS OTHERWISE SPECIFIED

SIZE	½" X 1½"	ISSUE 7-8-47	W.J.
KIND	C.R.STEEL	CHANGED	
SHAPE	BAR	"	
FINISH	SEE NOTE	"	
TEMP.		"	

TITLE:
FISCHER "PRECISION 200" X-RAY UNIT
VERTICAL GUIDE BAR

H. G. FISCHER & CO.
2335 WABANSIA AVE.
CHICAGO, ILL.

CAT. NO.

PART NO. 16857

REMOVE ALL SHARP EDGES AND CORNERS

$\frac{3}{8}$" X-16 THD.

.377" REAMED HOLE

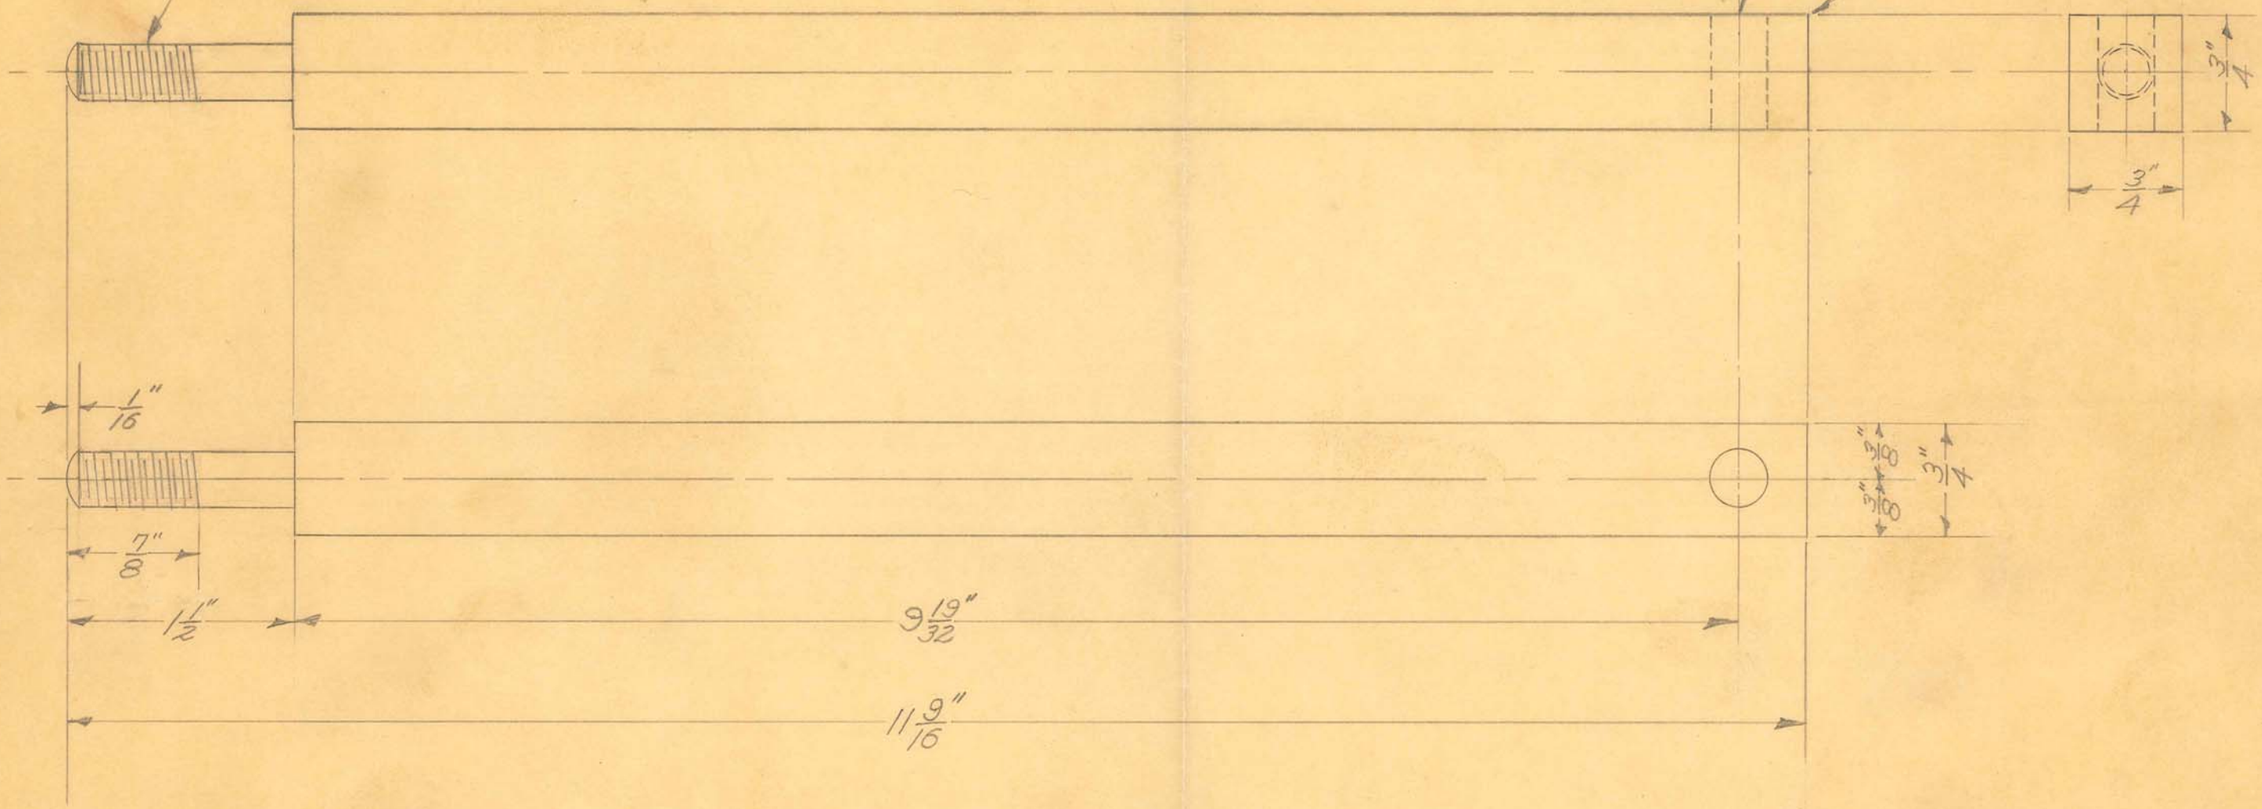

2 - REQUIRED

OBSOLETE

Drill Jig Tool #9399

SIZE	3/4" X 3/4"	ISSUE 7/15/49	J.M.F.	TITLE: FISCHER "PRECISION 200" X RAY UNIT TUBE STAND BASE CARRIAGE TIE ROD
KIND	C.R. STEEL	CHANGED		
SHAPE	BAR	"		
FINISH	CAD. #23	"		
TEMP.		"		
PATT.		"		

H. G. FISCHER & CO.
2335 WABANSIA AVE.
CHICAGO, ILL.

CAT. NO.

PART NO. 16858

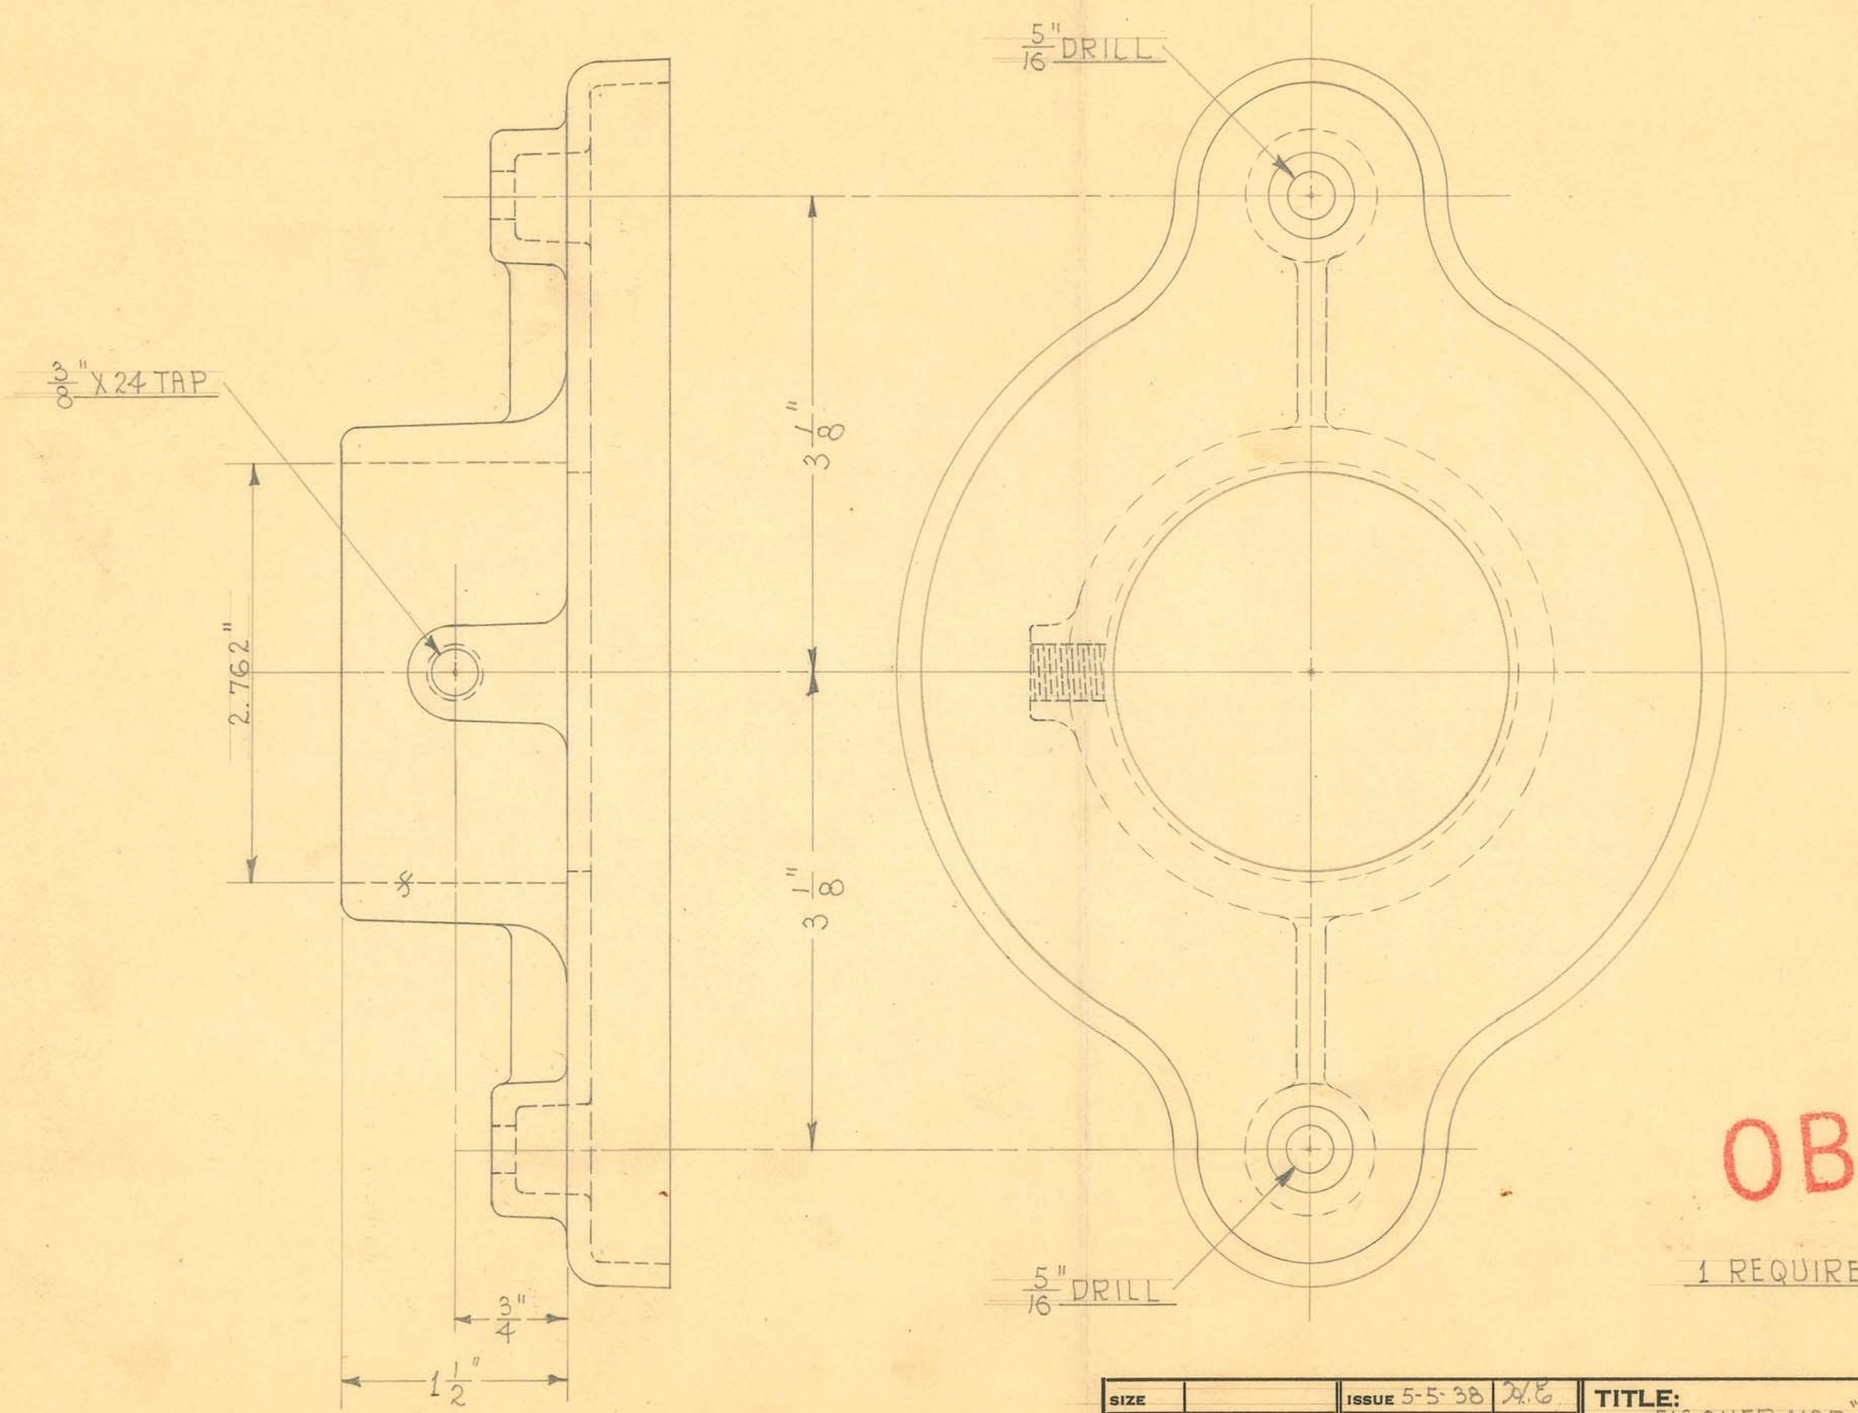

OBSOLETE

1 REQUIRED

SIZE		ISSUE 5-5-38	A.E.
KIND	ALUM. CASTING	CHANGED	
SHAPE		"	
FINISH	PAINTED	"	
TEMP.		"	
PATT.	1231	"	

TITLE: FISCHER MOD. "G" SHOCKPROOF FLUOROSCOPE-REMOTE CONTROL TUBE FLANGE

H. G. FISCHER & CO.
2335 WABANSIA AVE.
CHICAGO, ILL.

CAT. NO.

PART NO. 11453F

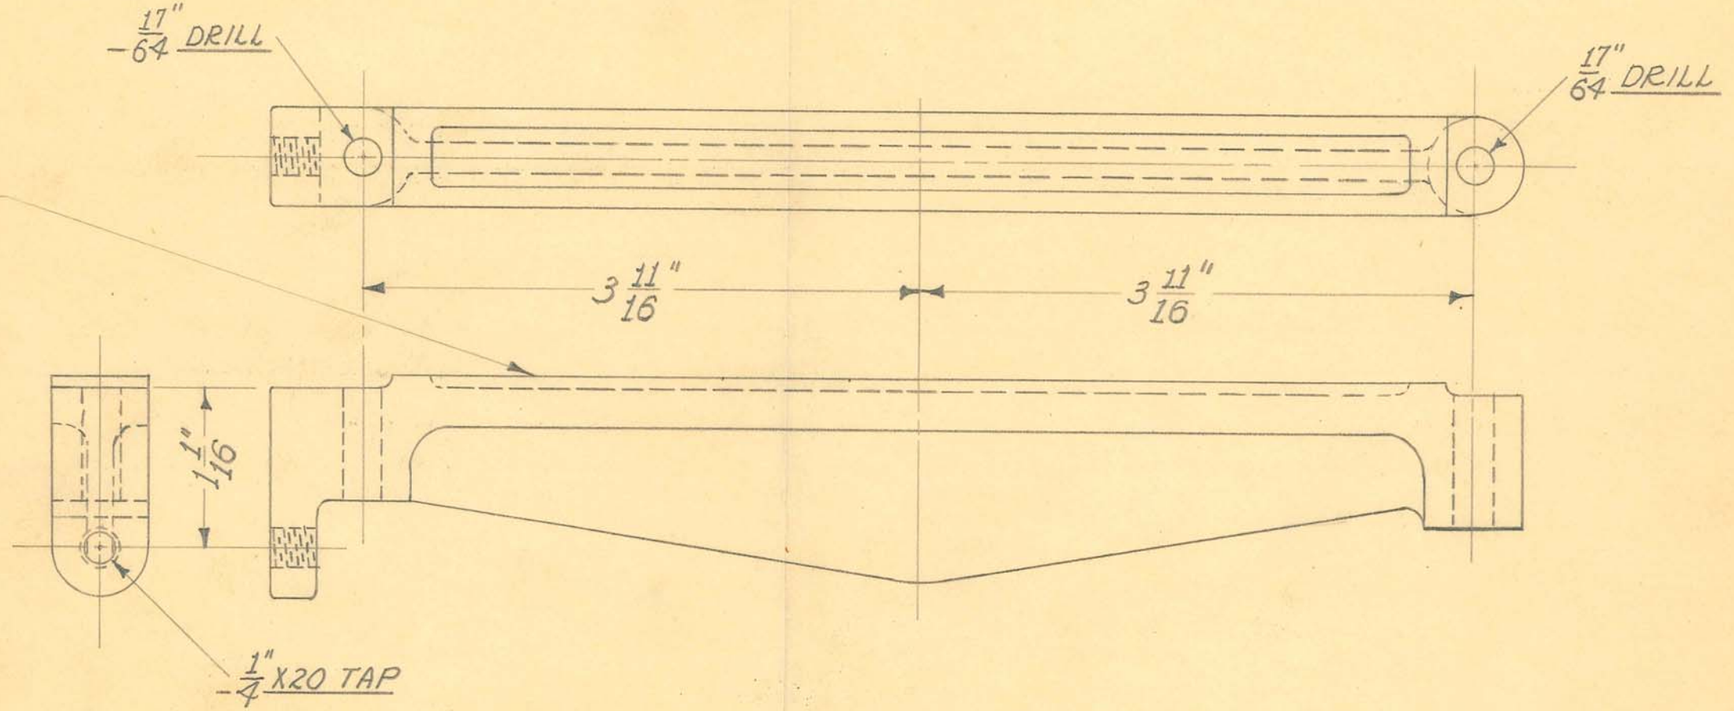

2 REQUIRED

OBSOLETE

SIZE		ISSUE	3-11-37	J.W.
KIND	IRON CASTING	CHANGED		
SHAPE		"		
FINISH	BLACK #80	"		
TEMP.		"		
PATT.	4291-917	"		

TITLE: MODEL "C" SHORT WAVE H.T. TRANSF. SUPP.- REAR

H. G. FISCHER & CO.
2335 WABANSIA AVE.
CHICAGO, ILL.

CAT. NO.

PART NO. 9688

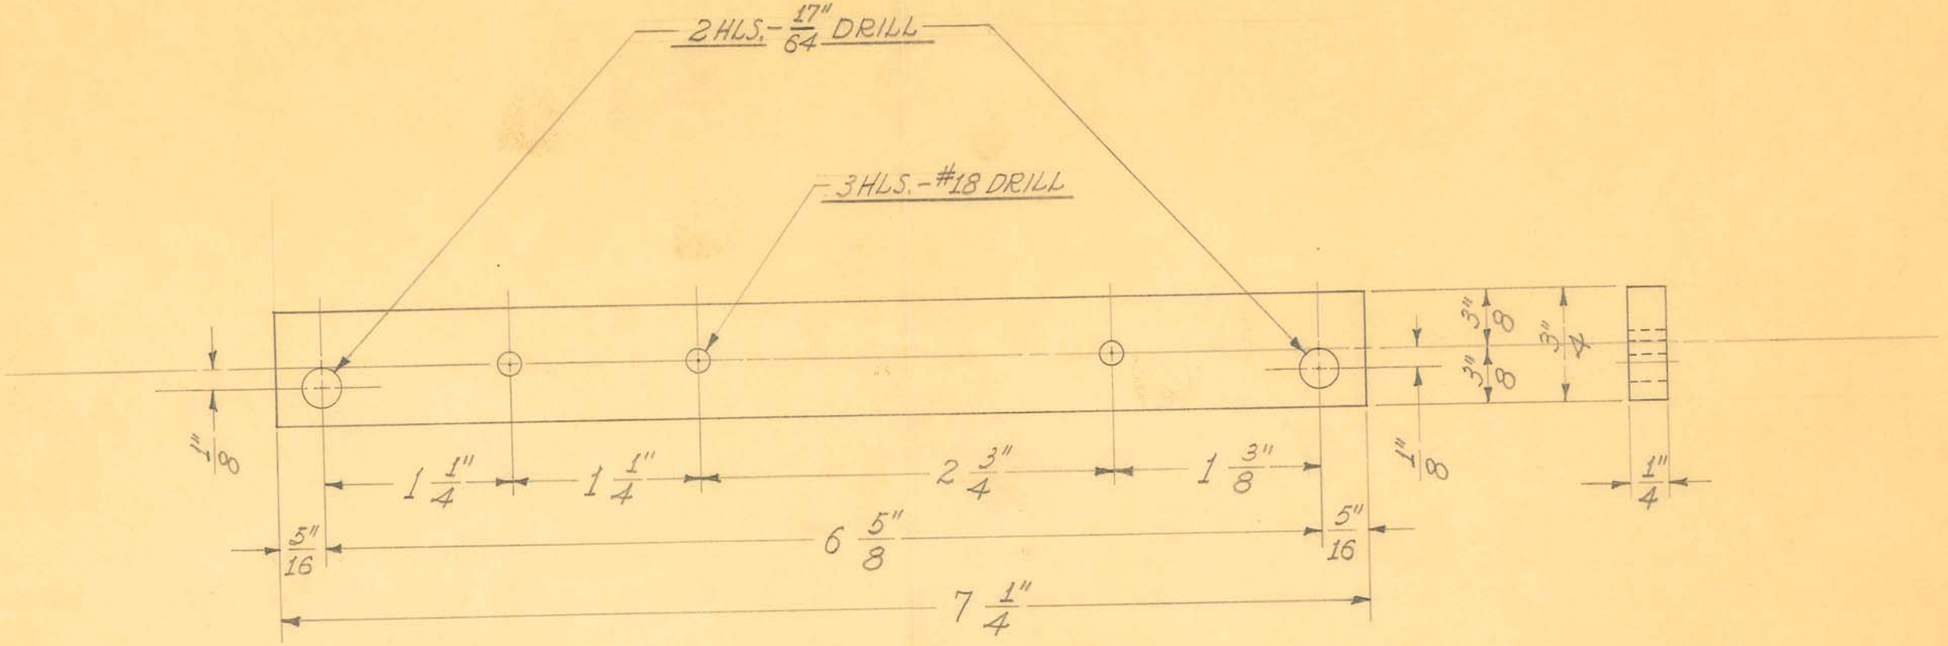

1 REQUIRED

OBSOLETE

SIZE	1/4" SHEET	ISSUE 9-15-36	J.W.	TITLE: FISCHER MOD. "M" SHORT WAVE POWER TRANSFORMER TERMINAL STRIP-LOWER
KIND	BAKELITE	CHANGED		
SHAPE		"		
FINISH		"		
TEMP.		"		
PATT.		"		

H. G. FISCHER & CO.
2335 WABANSIA AVE.
CHICAGO, ILL.

CAT. NO.

PART NO. 12065

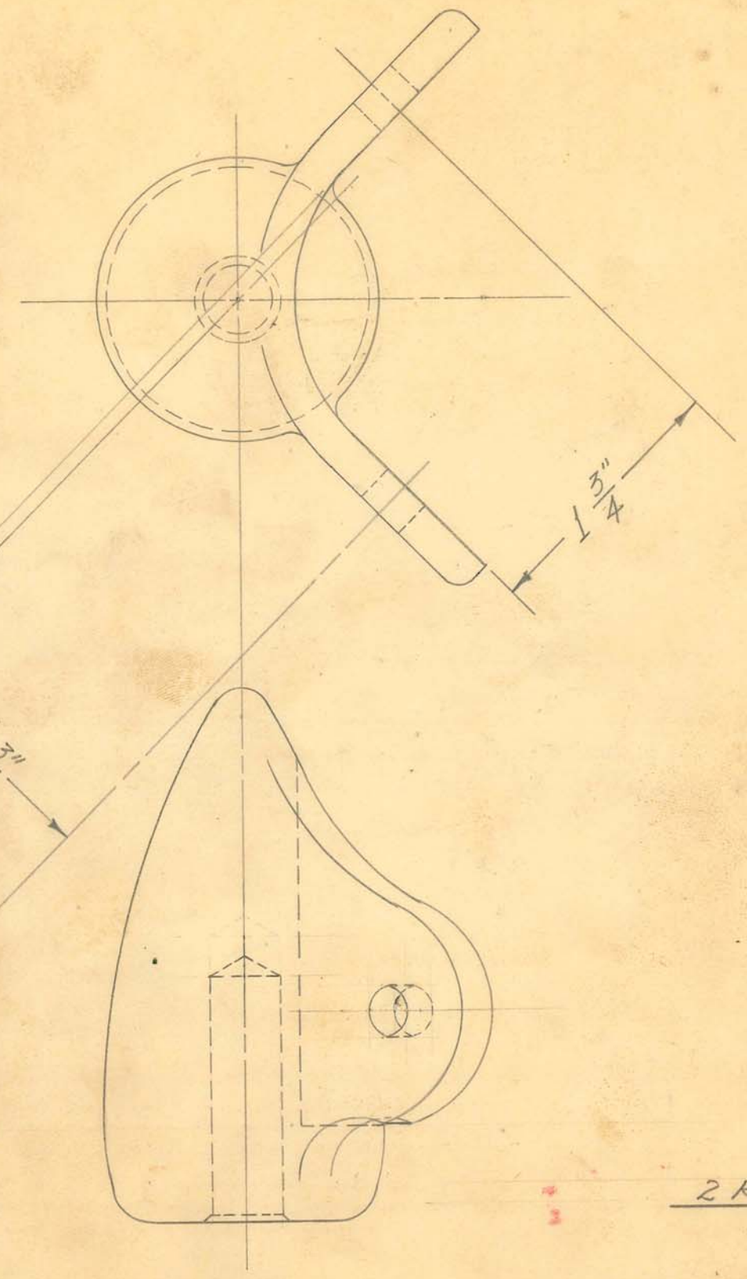

7/16" DRILL TO GAGE #8944 &
29/64" REAMED & C'SINK TO 9/16" FACE.

2 HLS. – 11/32" DRILL

2 REQUIRED

SIZE		ISSUE 7-6-39	J.W.
KIND	IRON CASTING	CHANGED	
SHAPE		"	
FINISH		"	
TEMP.		"	
PATT.	1385	"	

TITLE:
FISCHER MOD "M" SHORT WAVE OUTFIT
CABINET CASTER SUPPORT

OBSOLETE

H. G. FISCHER & CO.
2335 WABANSIA AVE.
CHICAGO, ILL.

CAT. NO.

PART NO. 12102F

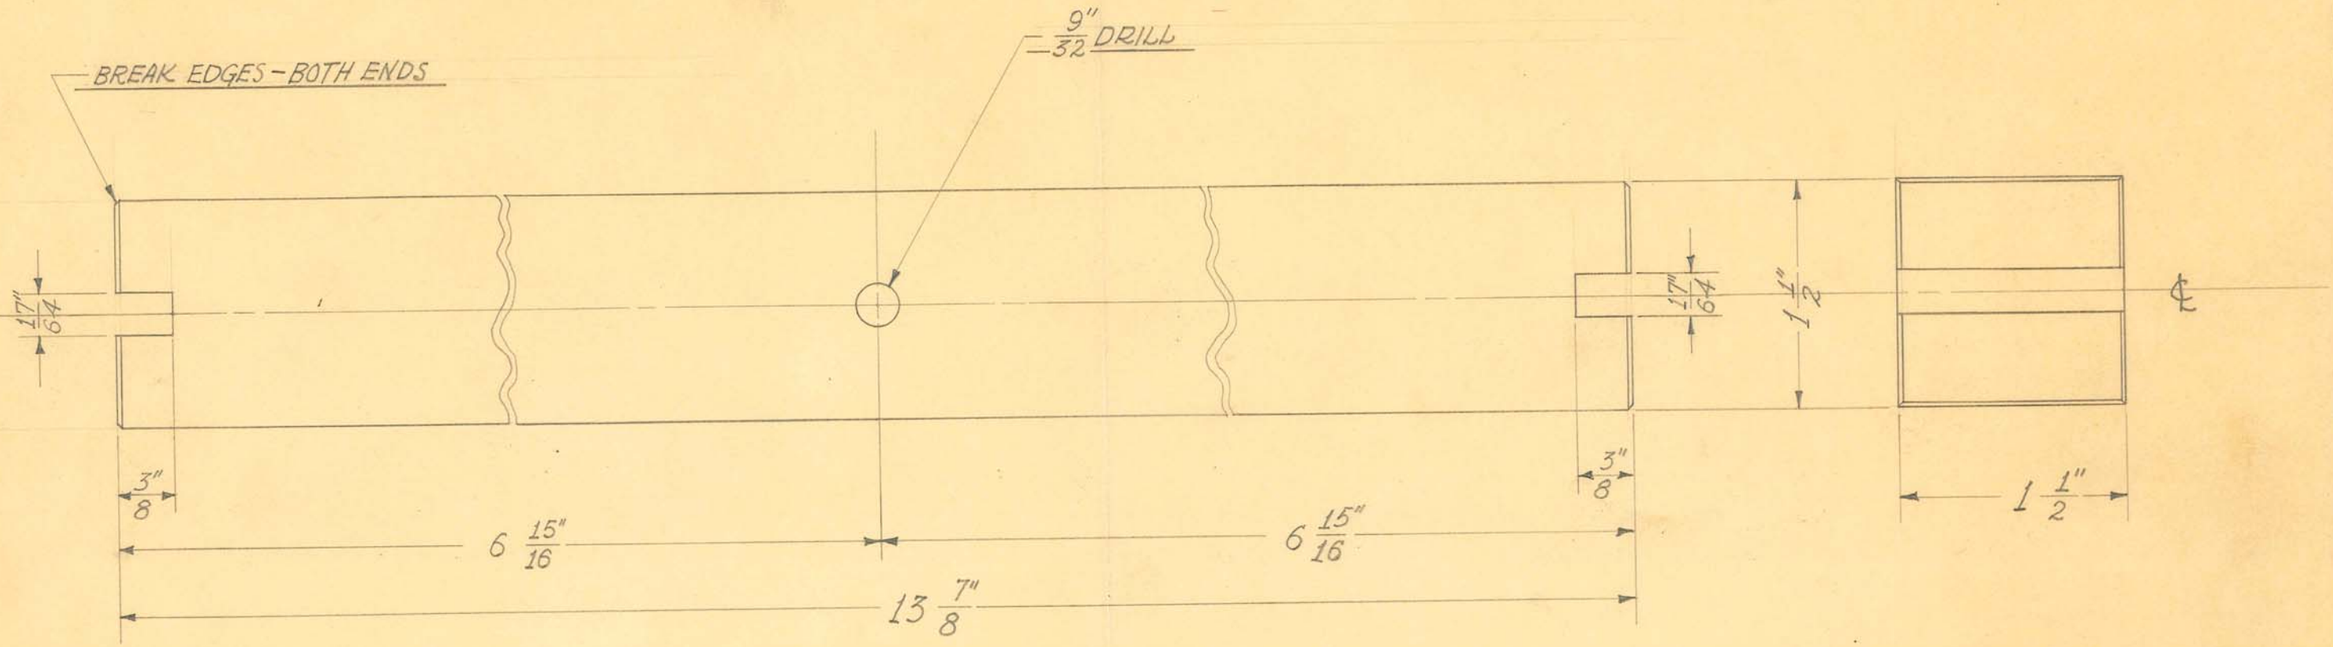

1 REQUIRED

OBSOLETE

SIZE	1½" SQUARE	ISSUE 10-3-38	J.W.	TITLE: FISCHER MOD. "R" SHORT WAVE CABINET ELECTRODE ARM COUNTERBALANCE WEIGHT
KIND	C.R. STEEL	CHANGED		
SHAPE	BAR	"		
FINISH		"		
TEMP.		"		
PATT.		"		

H. G. FISCHER & CO.
2335 WABANSIA AVE.
CHICAGO, ILL.

CAT. NO.

PART NO. 12157

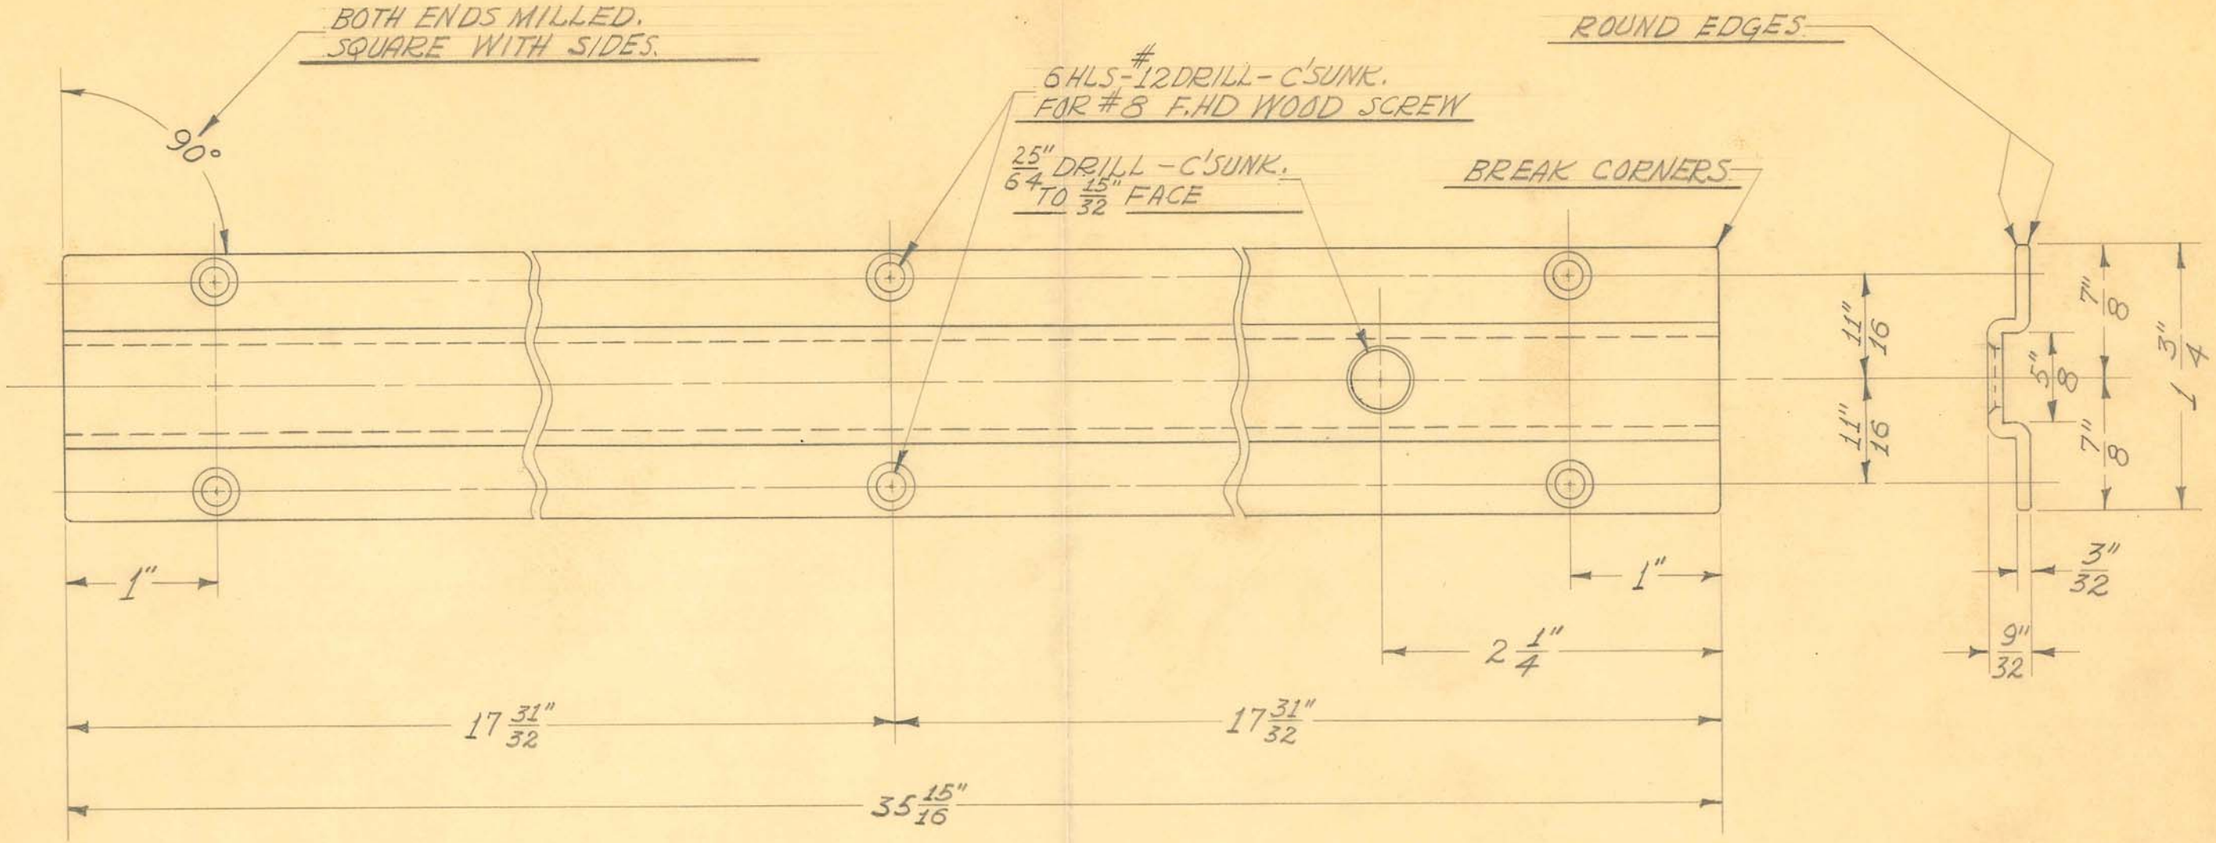

1 REQUIRED

OBSOLETE

SIZE	3/32" SHEET	ISSUE	
KIND	C.R. STEEL	CHANGED	
SHAPE		"	
FINISH	CAD. #23	"	
TEMP.		"	

TITLE: UNIVERSAL SECTIONAL GUIDE STOP RAIL 3 FT. LENGTH

H. G. FISCHER & CO. 2335 WABANSIA AVE.

CAT. NO.

PART NO. 12173

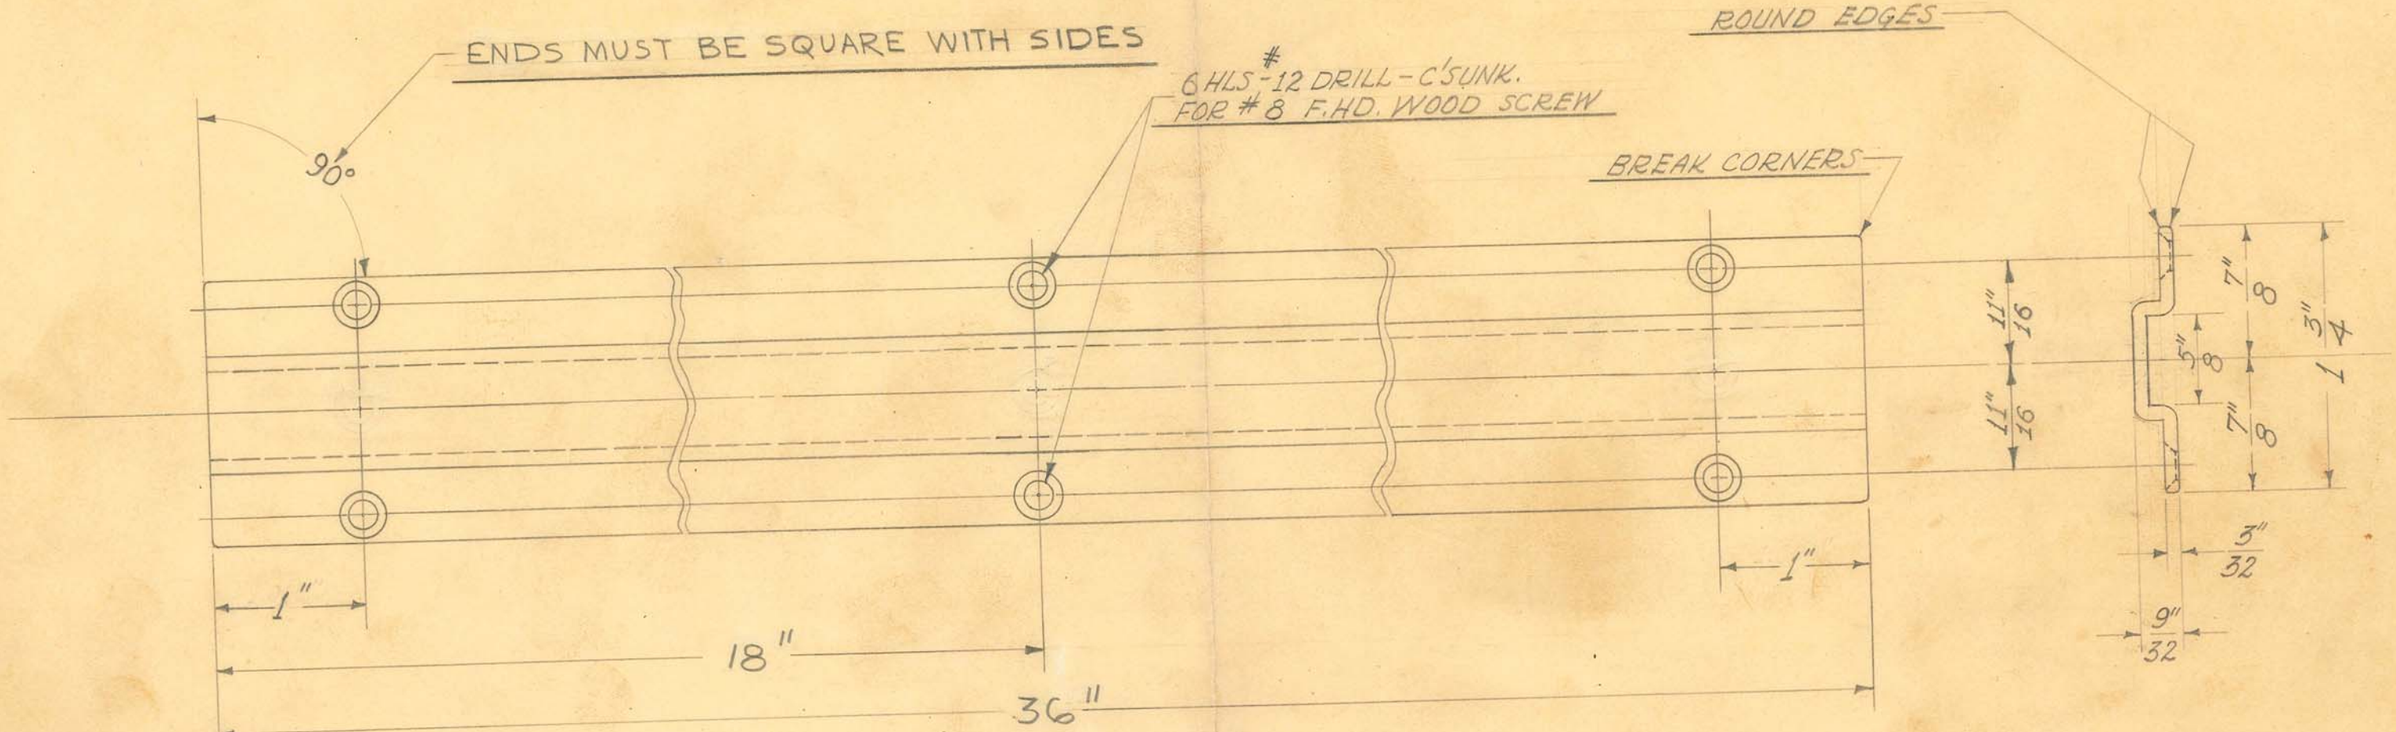

Obsolete

OBSOLETE

MASTER HOLE PUNCHING UNIT 972 X

SIZE	3/32" SHEET	ISSUE 10-5-38	J.W.	TITLE: UNIVERSAL SECTIONAL GUIDE RAIL 3 FT. LENGTH
KIND	C.R. STEEL	CHANGED 12-15-39	J.W.	
SHAPE		"		
FINISH	CAD. #23	"		
TEMP.		"		
PATT.		"		

H. G. FISCHER & CO.
2335 WABANSIA AVE.
CHICAGO, ILL.

CAT. NO.

PART NO. 12180FA

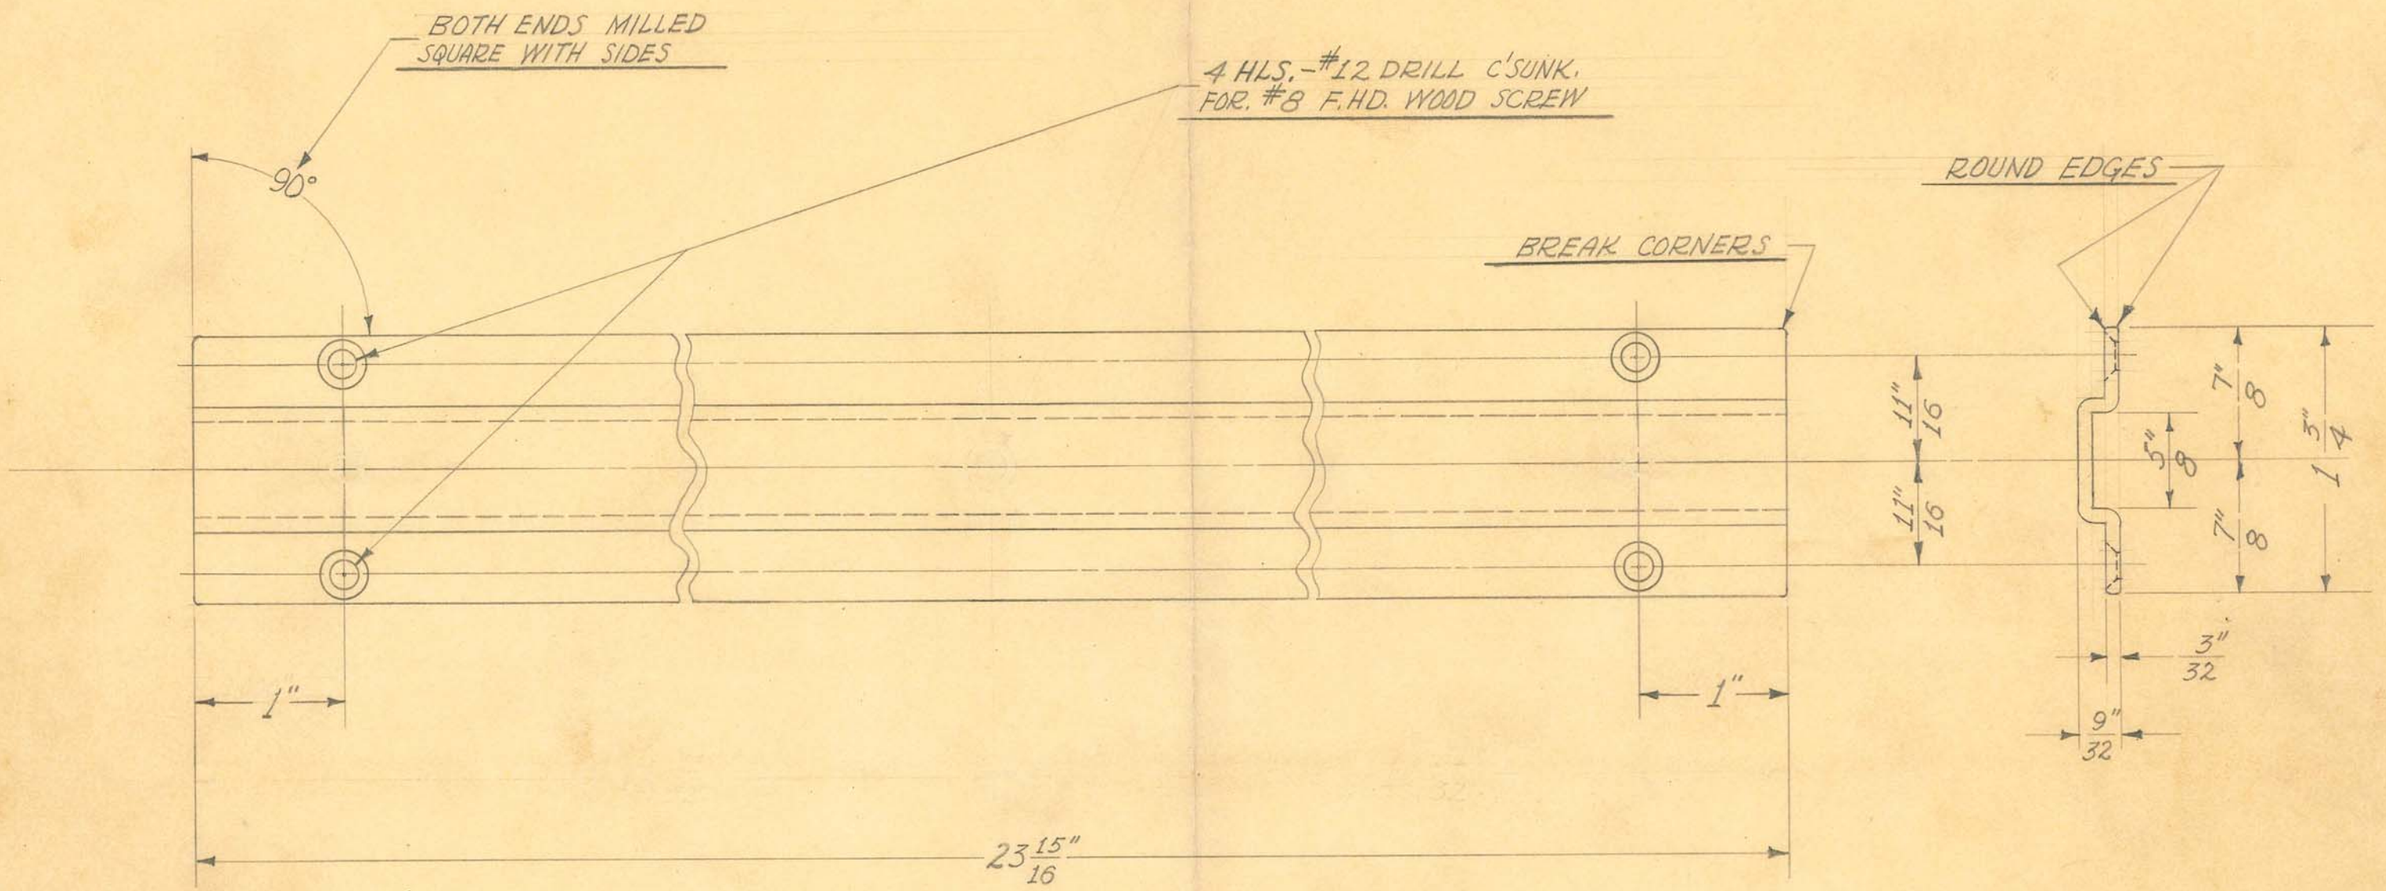

OBSOLETE

MASTER HOLE PUNCHING UNIT 972X

SIZE	3/32" SHEET	ISSUE 11-9-38	J.W.
KIND	C.R. STEEL	CHANGED 12-15-39	J.W.
SHAPE		"	
FINISH	CAD. #23	"	
TEMP.		"	

TITLE: UNIVERSAL SECTIONAL GUIDE RAIL 2 FT. LENGTH

H. G. FISCHER & CO.
2335 WABANSIA AVE.
CHICAGO, ILL.

CAT. NO.

PART NO. 12183FA

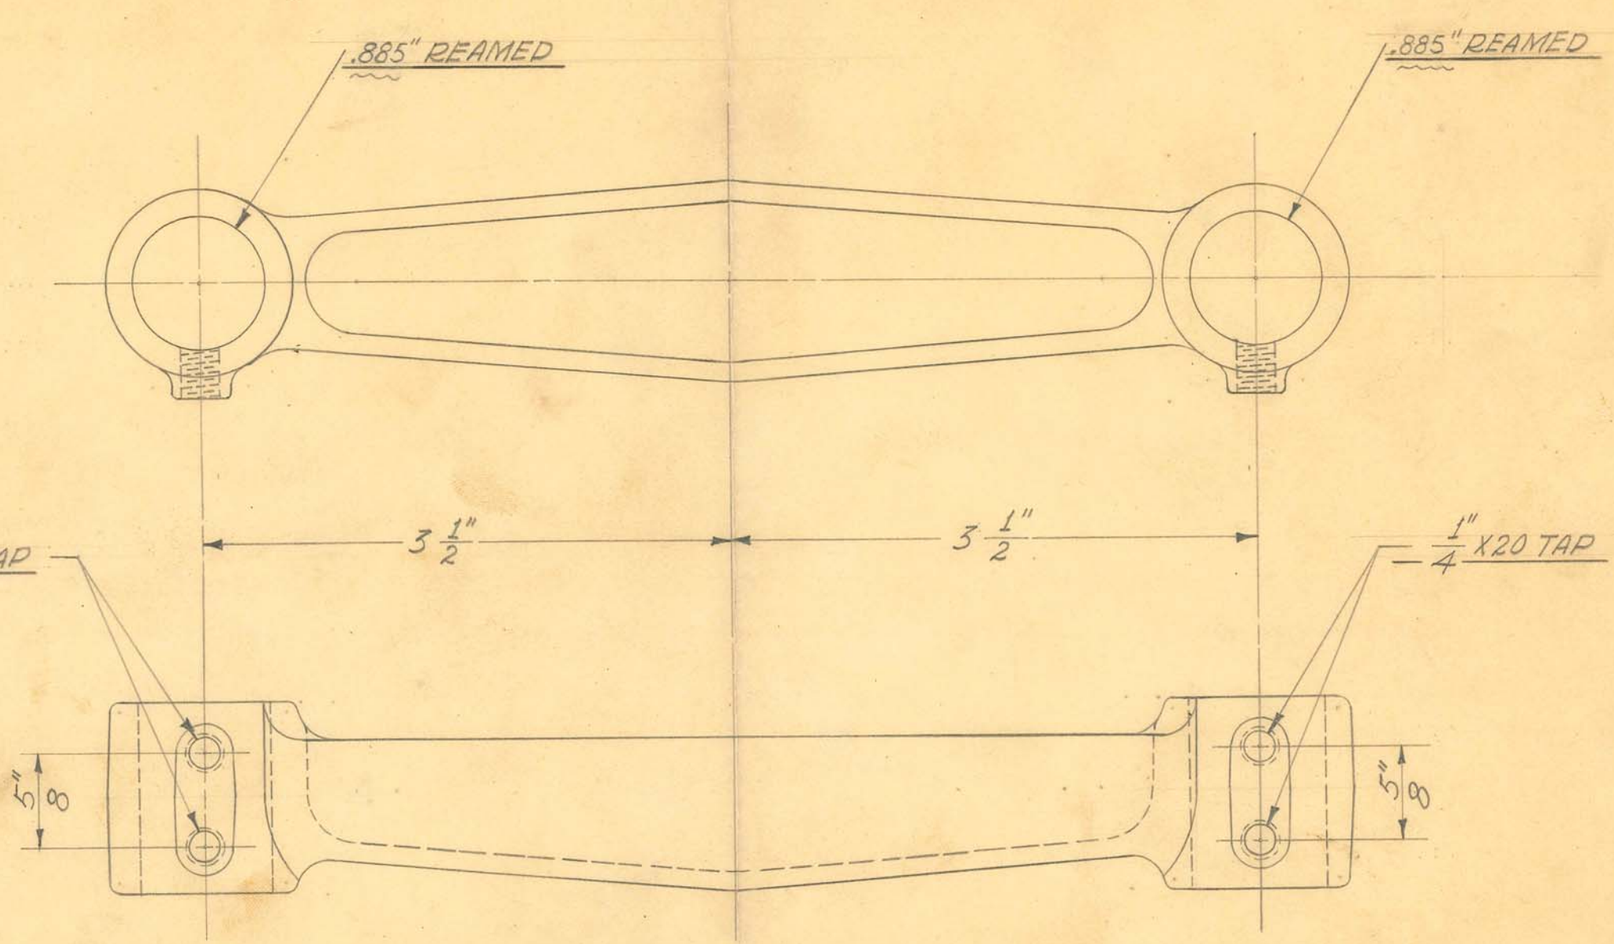

1 REQUIRED

OBSOLETE

SIZE	# 214	ISSUE 11-10-38	J.W.	TITLE: FISCHER MOD. "GM." MOBILE UNIT TRANSFORMER GUIDE RODS TIE
KIND	ALUM. CASTING	CHANGED 9-15-39	J.W.	
SHAPE		"		
FINISH		"		
TEMP.		"		
PATT.	1281	"		

H. G. FISCHER & CO.
2335 WABANSIA AVE.
CHICAGO, ILL.

CAT. NO.

PART NO. 12218F

BEND SCALES IN FIXTURE #6894
BEFORE PUNCHING SLOTS.

3 SLOTS - #37 DRILL SIZE

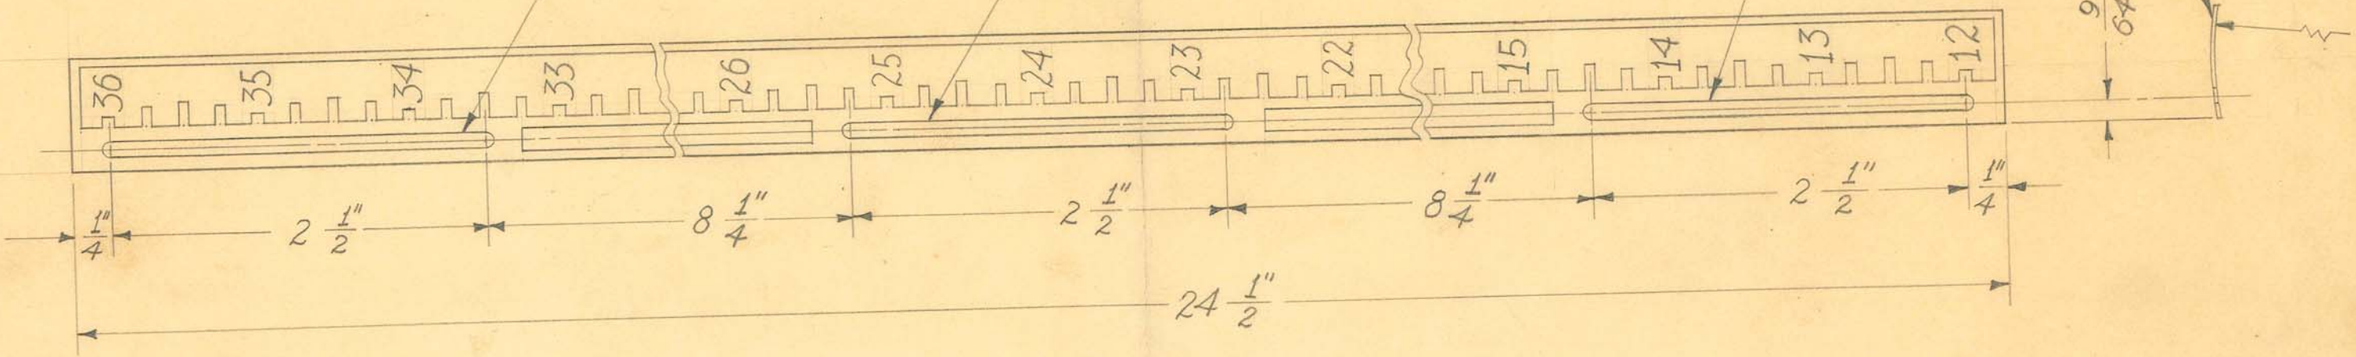

1 REQUIRED

OBSOLETE

SIZE		ISSUE 12-13-38	J.W.	TITLE: FISCHER MOD. "GM" MOBILE UNIT VERTICAL SCALE
KIND	FROM 12229	CHANGED		
SHAPE		"		
FINISH		"		
TEMP.		"		
PATT.		"		

H. G. FISCHER & CO.
2335 WABANSIA AVE.
CHICAGO, ILL.

CAT. NO.

PART NO. 12229F

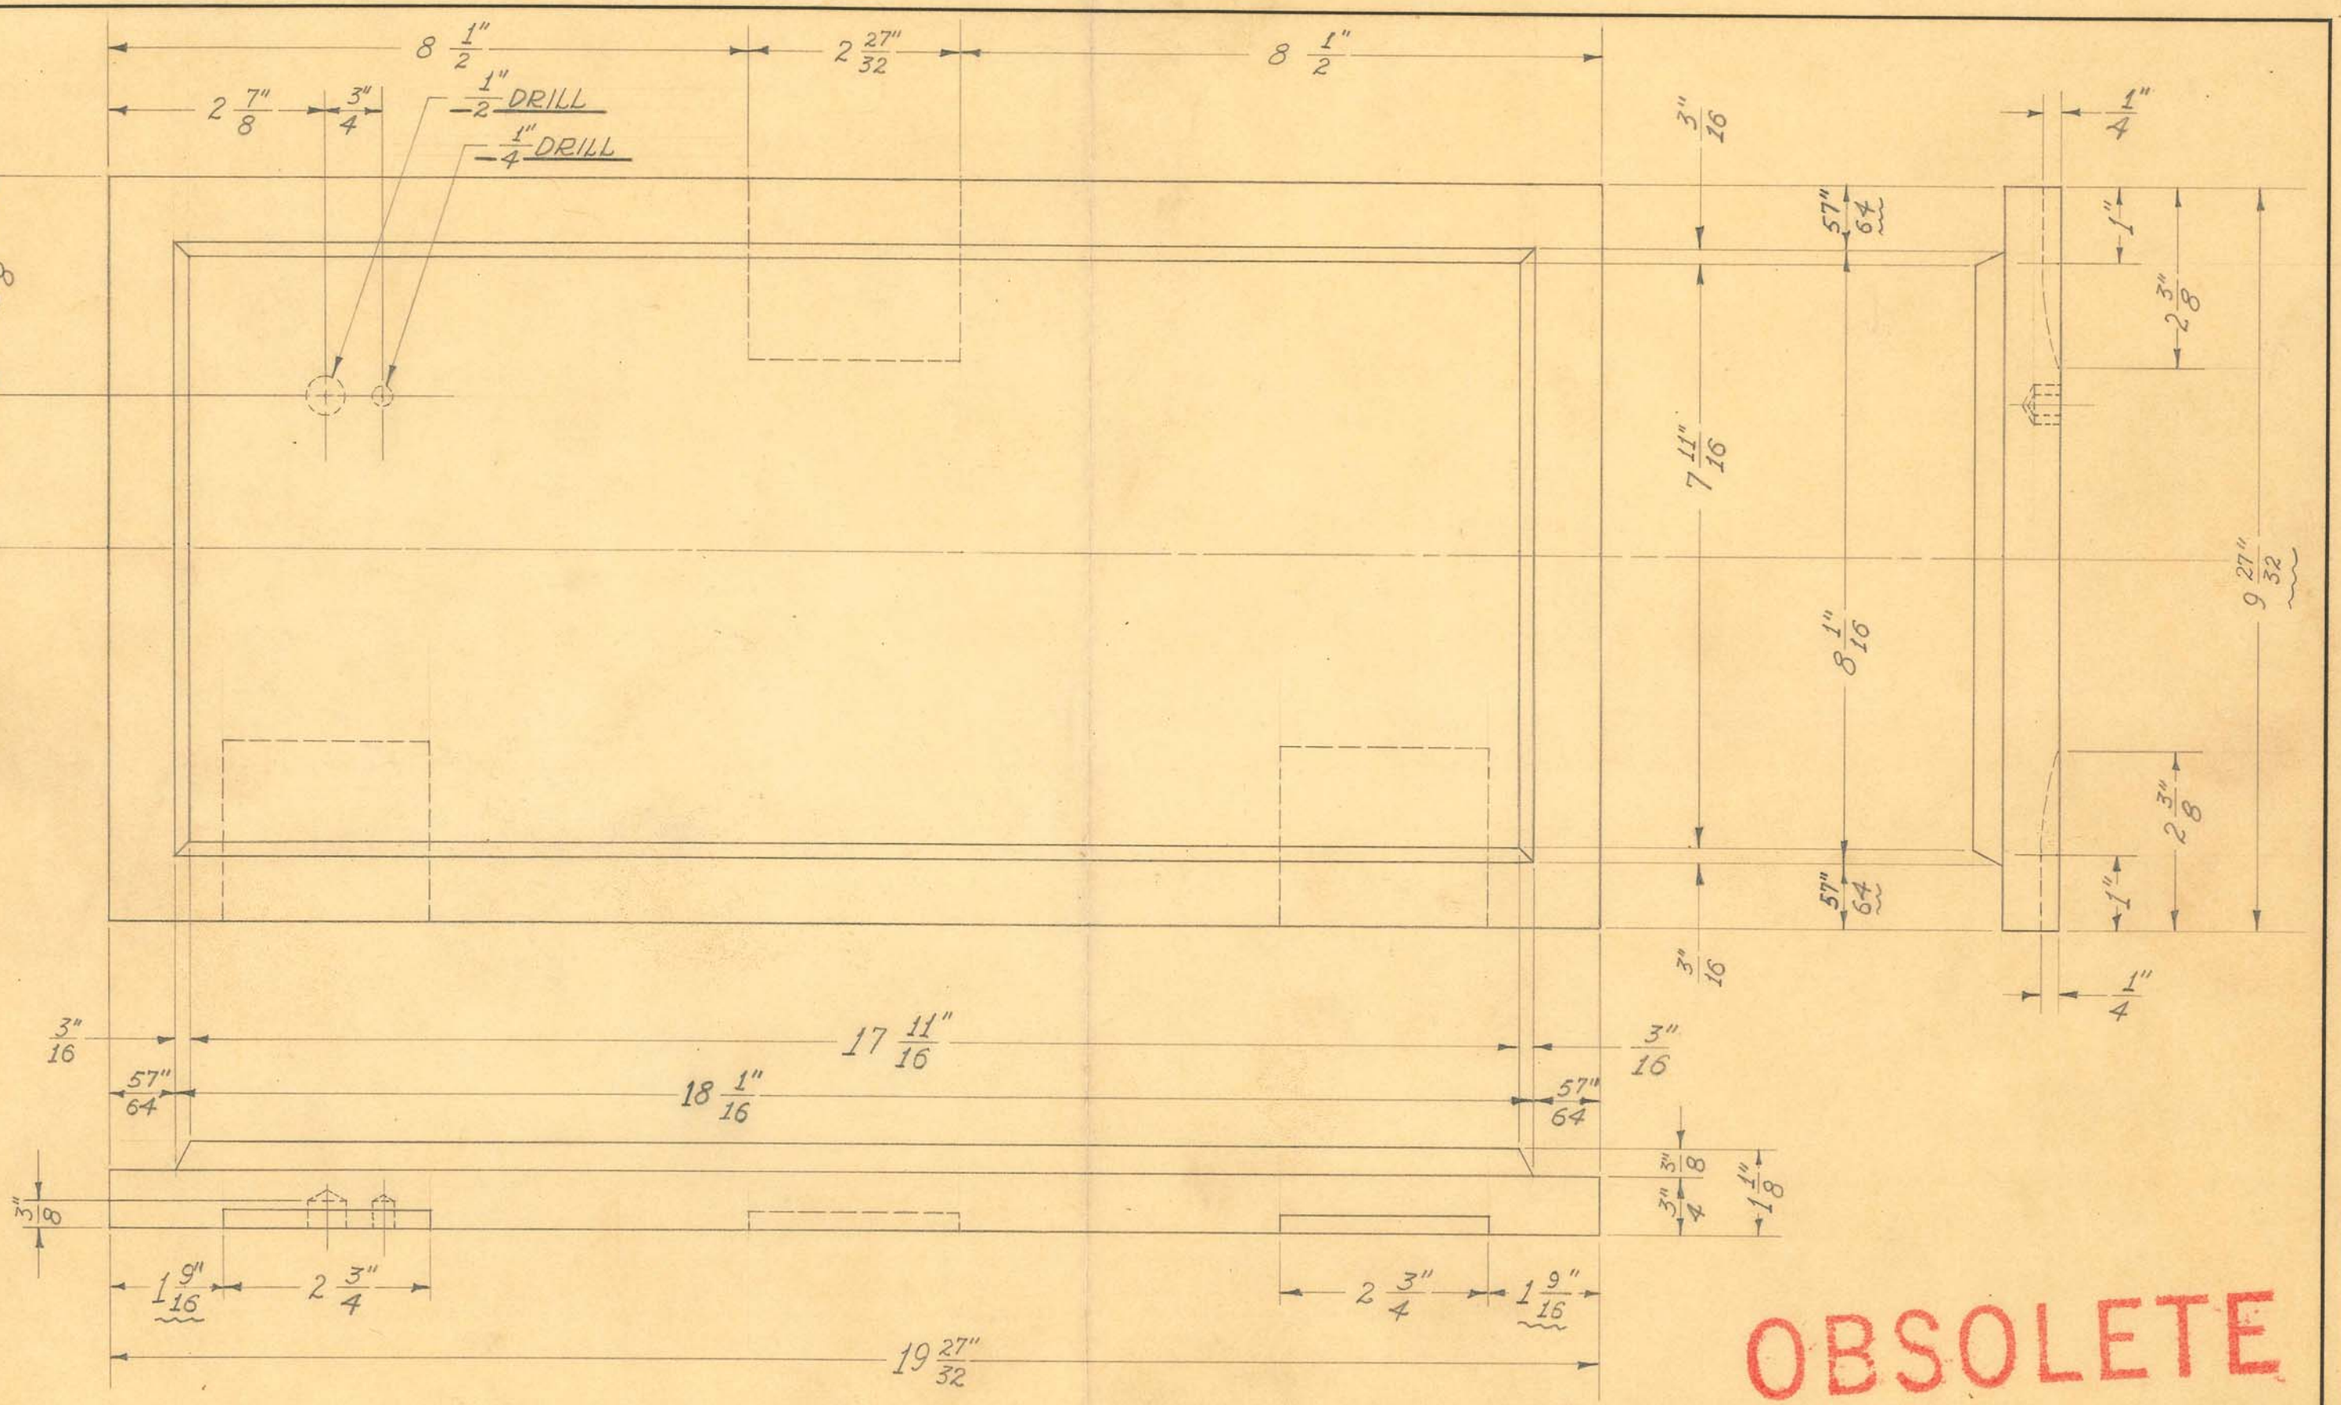

SCALE ÷ 1/2" = 1"

OBSOLETE

SIZE		ISSUE 1-30-39	J.W.
KIND	PLYWOOD	CHANGED	
SHAPE		"	
FINISH		"	
TEMP.		"	
PATT.		"	

TITLE:
FISCHER MOD. "GM" MOBILE UNIT
CABINET DOOR - LEAD - BOARD

H. G. FISCHER & CO.
2335 WABANSIA AVE.
CHICAGO, ILL.

CAT. NO.

PART NO. 12233

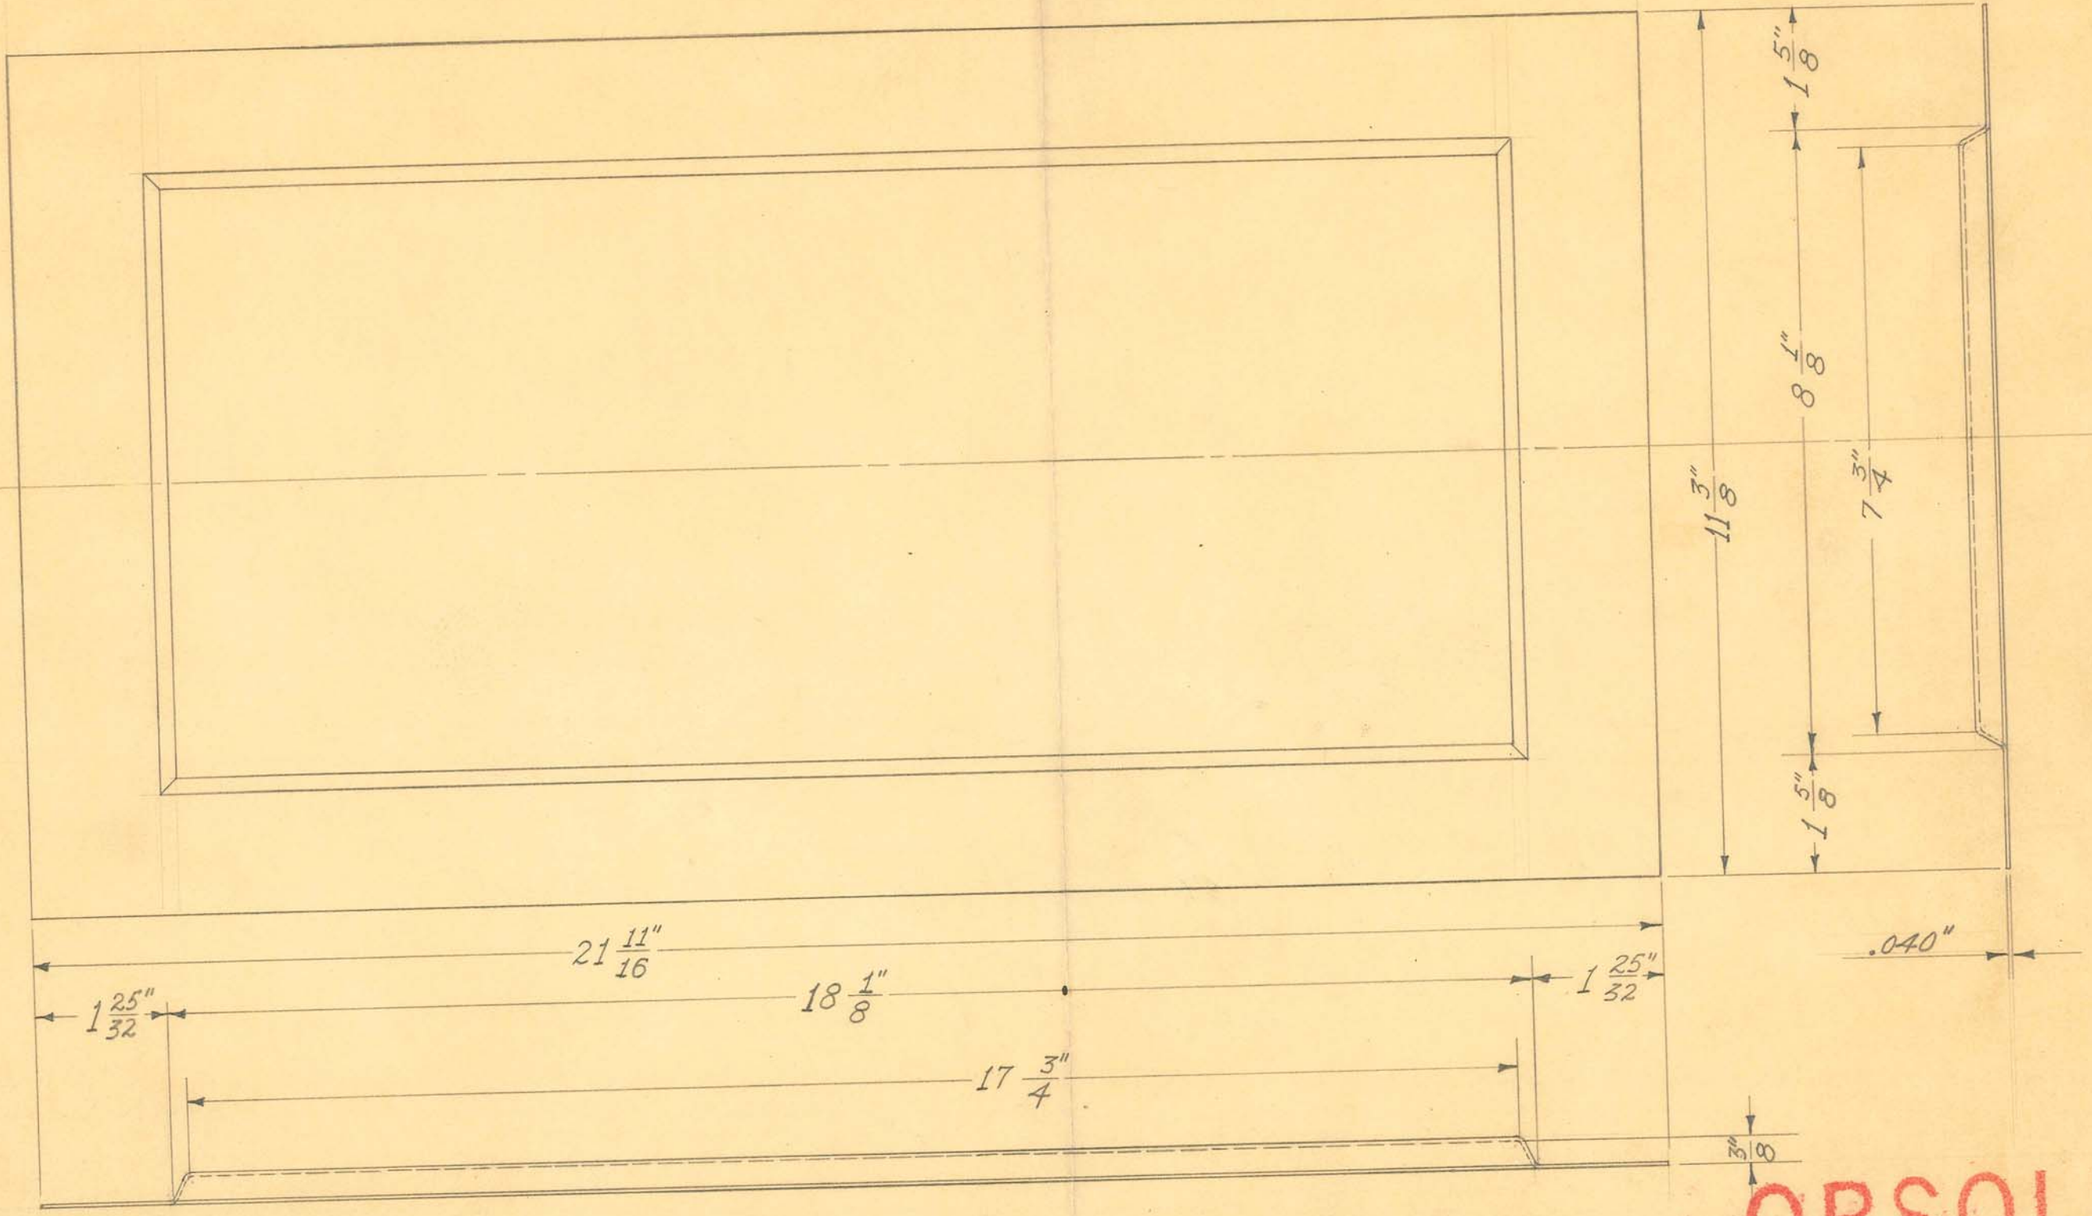

OBSOLETE

SCALE ÷ 1/2" = 1"

DEVELOPED LENGTH =

1 REQUIRED

SIZE	.040" SHEET	ISSUE 12-12-38	J.W.
KIND	LEAD	CHANGED	
SHAPE		"	
FINISH		"	
TEMP.		"	
PATT.		"	

TITLE: FISCHER MOD. "GM" MOBILE UNIT
CABINET DOOR - LEAD PAN

H. G. FISCHER & CO.
2335 WABANSIA AVE.
CHICAGO, ILL.

CAT. NO.

PART NO. 12234F

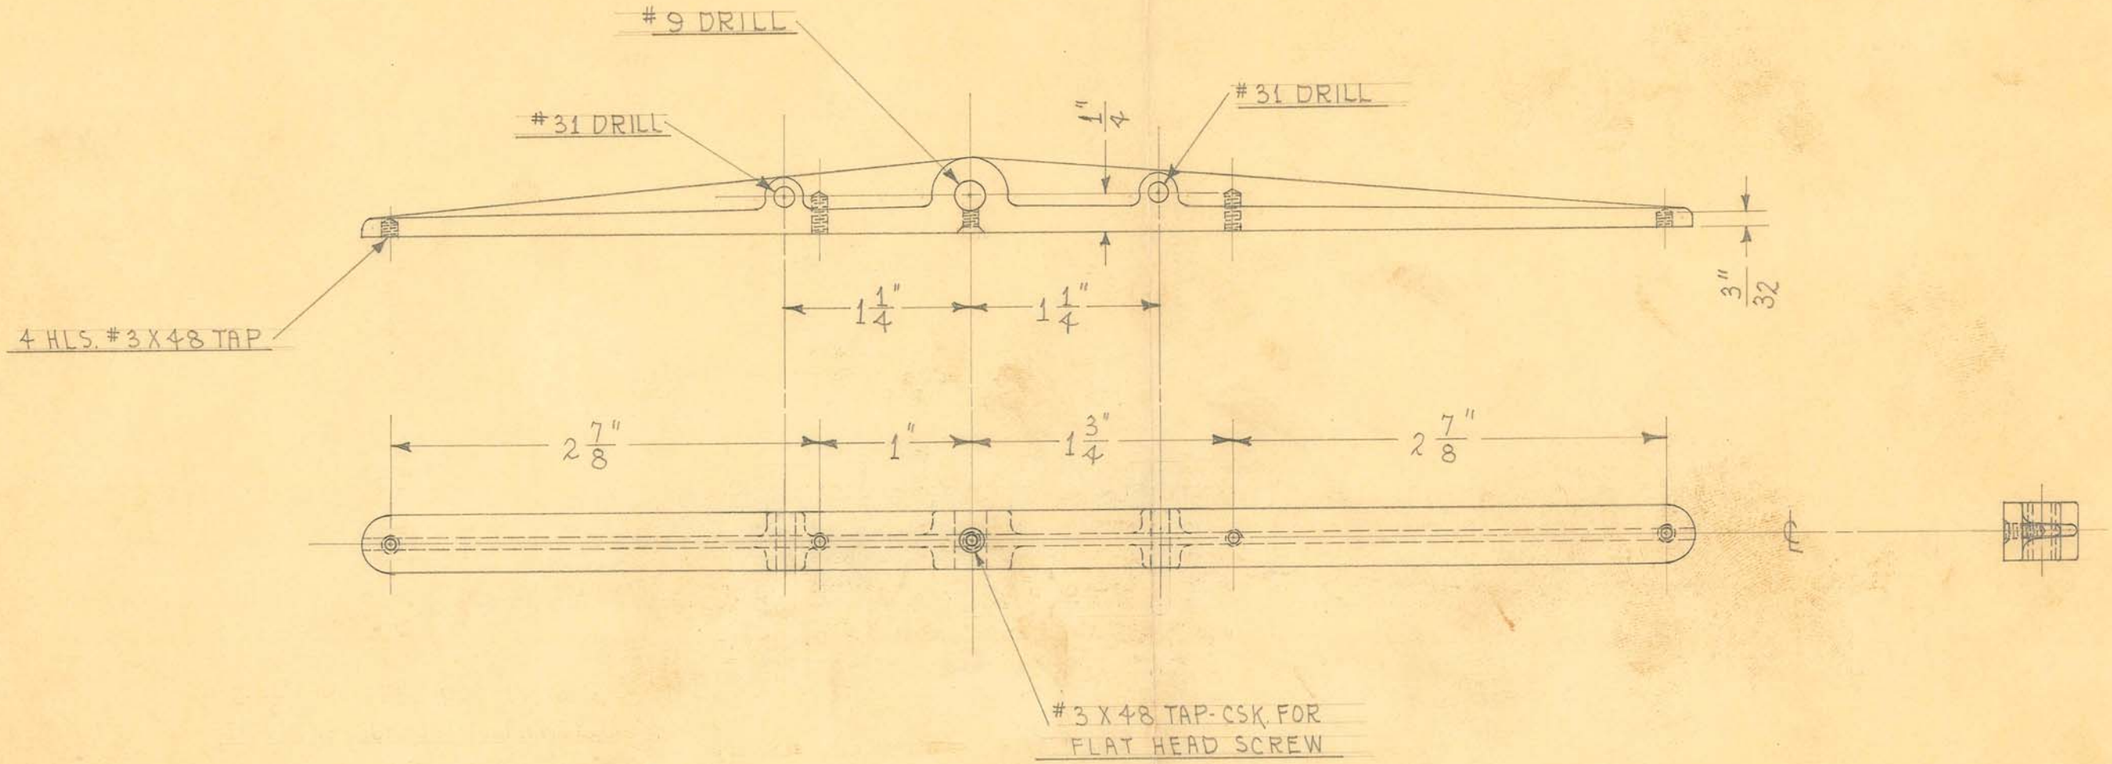

1 REQUIRED

OBSOLETE

SIZE	#12	ISSUE 12-1-38	HE.
KIND	ALUM. CASTING	CHANGED	
SHAPE		"	
FINISH		"	
TEMP.		"	
	1288	"	

TITLE: FISCHER MOD. "GM"
MOBILE UNIT- STEREOSCOPIC SHIFT
SCALE SUPPORT

H. G. FISCHER & CO.
2335 WABANSIA AVE.
CHICAGO, ILL.

CAT. NO.

PART NO. 12238F

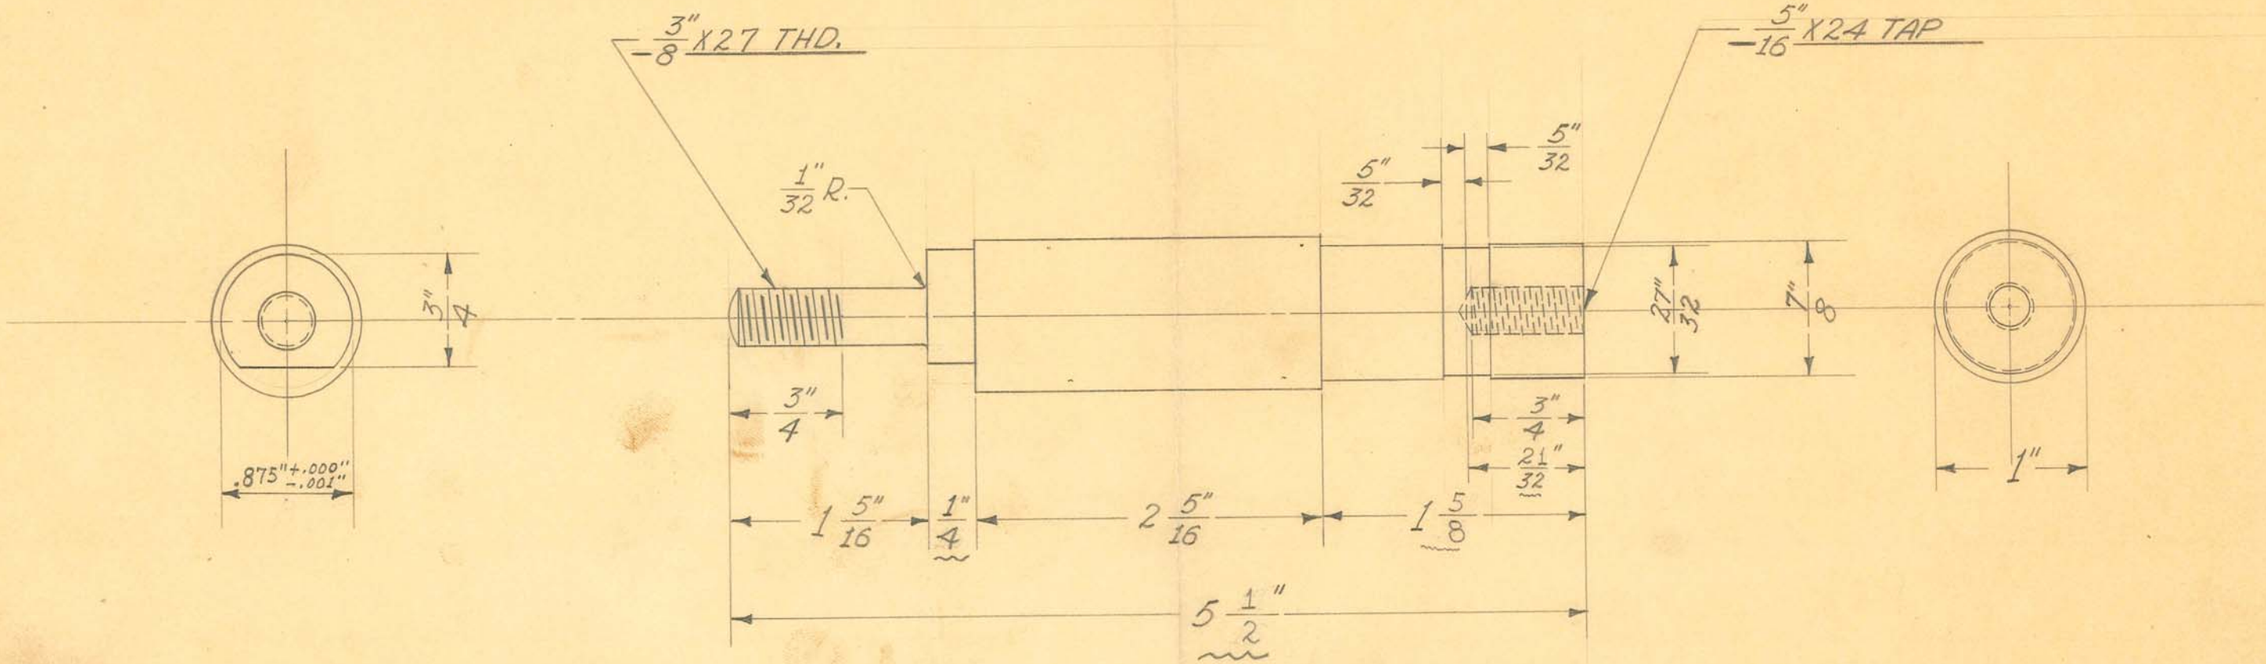

1 REQUIRED

OBSOLETE

SIZE	1" DIAM.	ISSUE 11-28-38	J.W.
KIND	C.R. STEEL	CHANGED	
SHAPE	ROD	"	
FINISH	CAD. #23	"	
TEMP.		"	
		"	

TITLE: FISCHER MOD. "GM" MOBILE UNIT TRANSF. GUIDE RODS SWIVEL SUPPORT STUD

H. G. FISCHER & CO.
2335 WABANSIA AVE.
CHICAGO, ILL.

CAT. NO.

PART NO. 12255

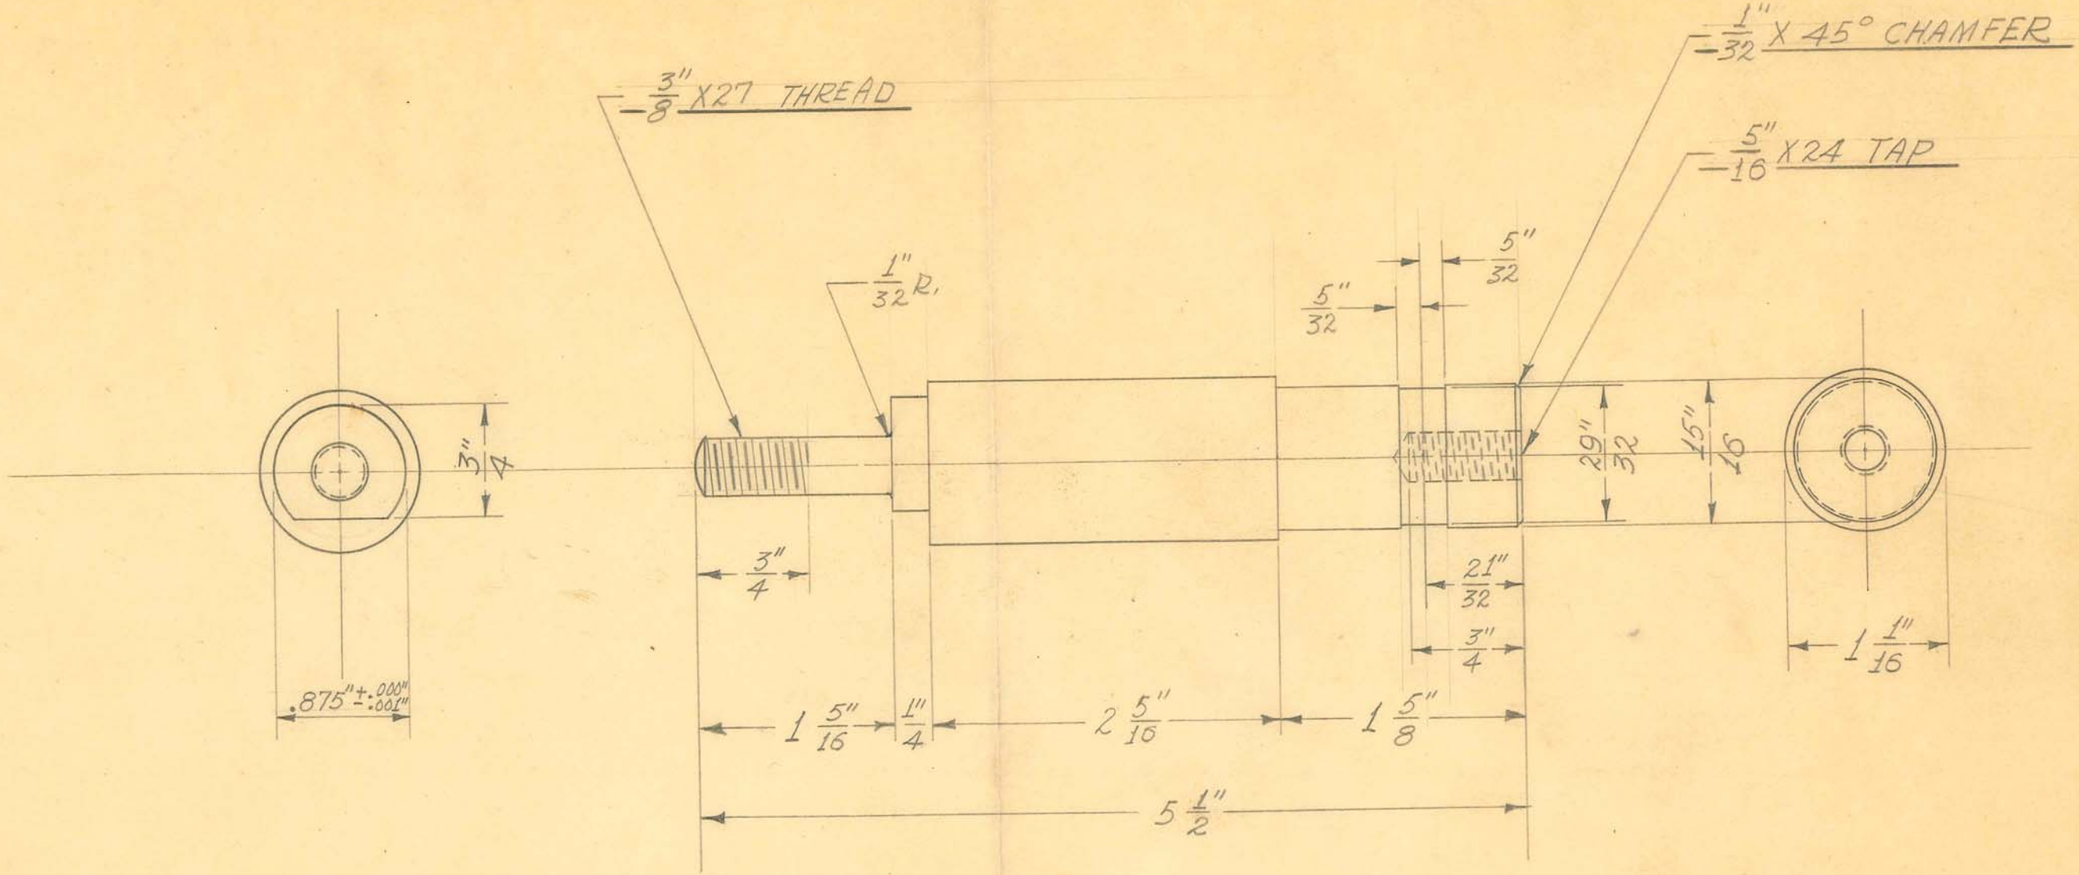

1 REQUIRED

OBSOLETE

SIZE	1 1/16" DIAM.	ISSUE 8-24-39	J.W.
KIND	C.R. STEEL	CHANGED	
SHAPE	ROD	"	
FINISH	CAD. #23	"	
TEMP.		"	
PART		"	

TITLE: FISCHER MOD. "GM" MOBILE SHOCKPROOF X-RAY UNIT - TRANSF. GUIDE RODS SWIVEL SUPPORT STUD

H. G. FISCHER & CO.
2335 WABANSIA AVE.
CHICAGO, ILL.

CAT. NO.

PART NO. 12255A

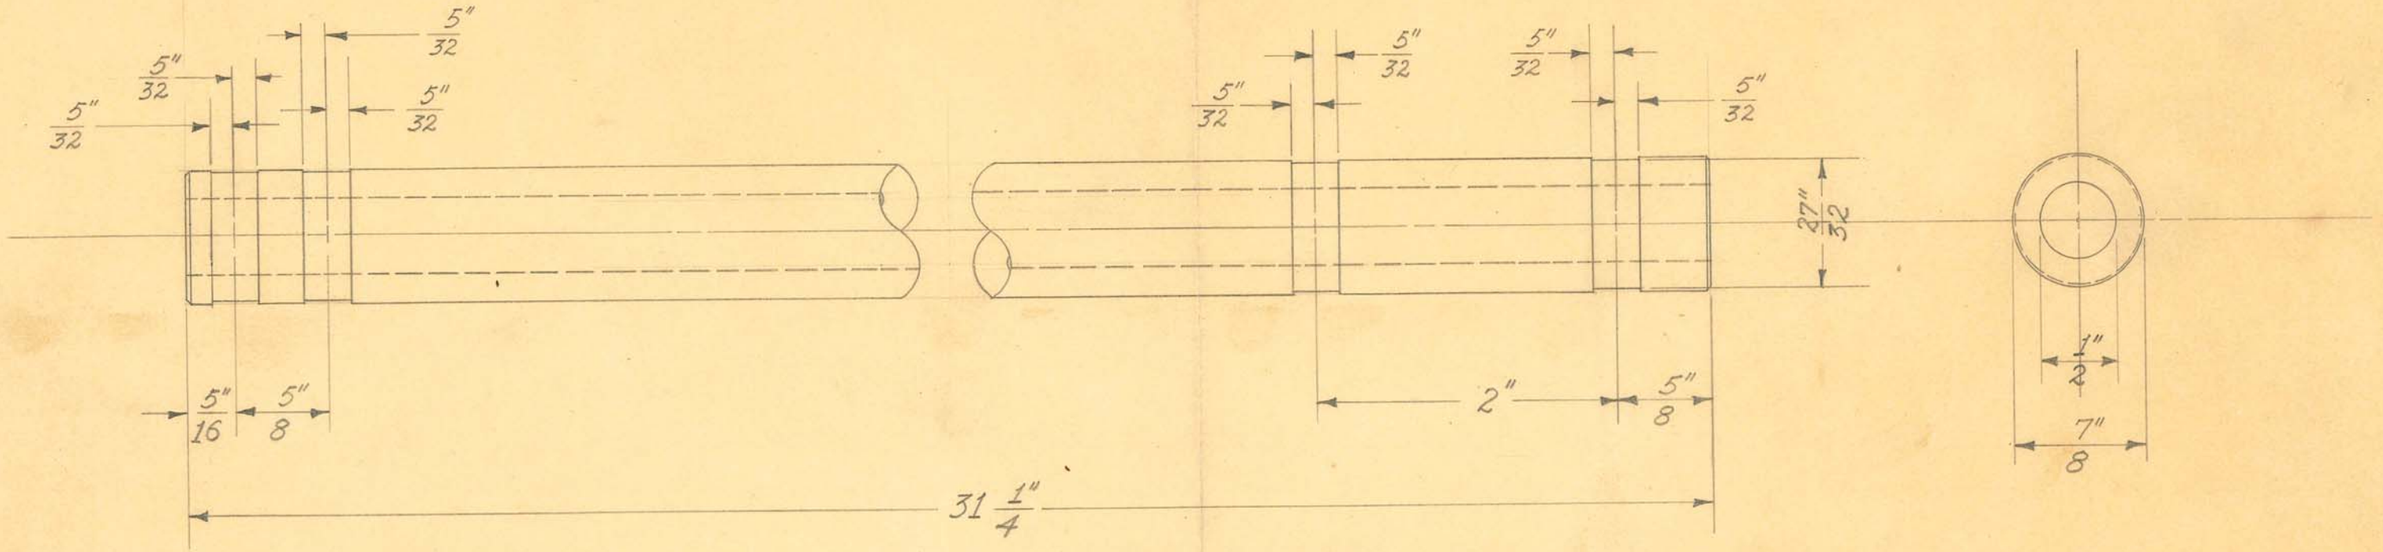

2 REQUIRED

OBSOLETE

SIZE	7/8" O.D.X 1/2" I.D	ISSUE 12-2-38	J.W.
KIND	SHELBY STEEL	CHANGED	
SHAPE	TUBING	"	
FINISH	CHROME #2	"	
TEMP.		"	

TITLE: FISCHER MOD. "GM" MOBILE UNIT - TRANSFORMER GUIDE ROD

H. G. FISCHER & CO.
2335 WABANSIA AVE.

CAT. NO.

PART NO. 12256

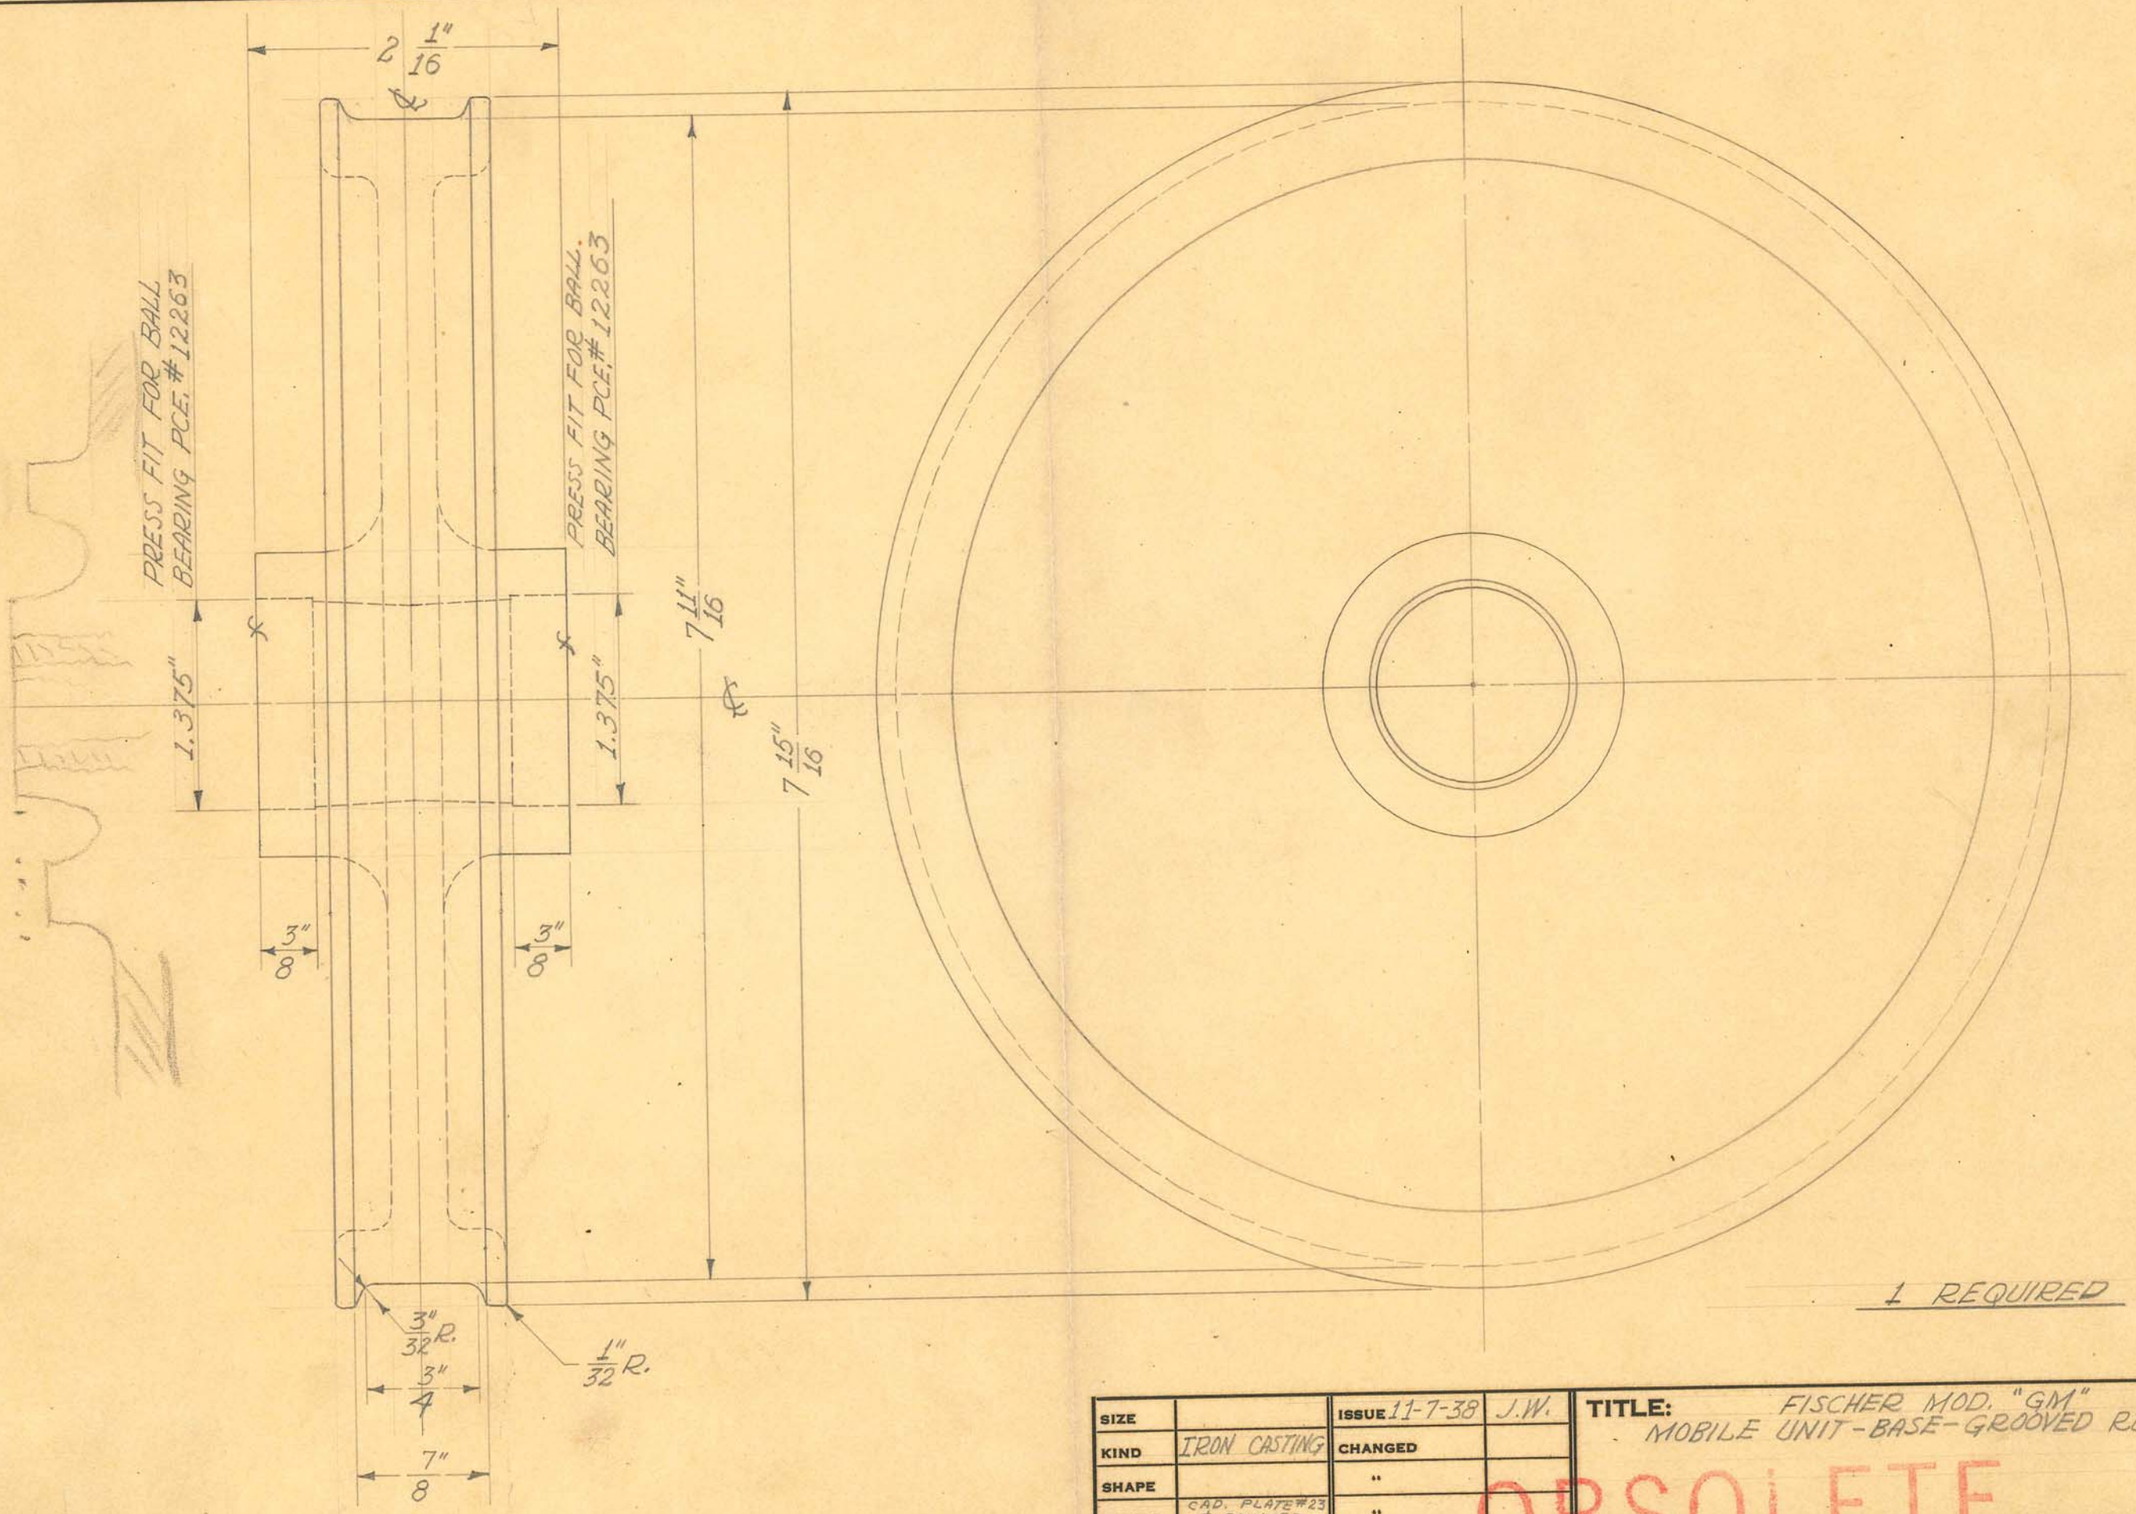

1 REQUIRED

SIZE		ISSUE 11-7-38	J.W.	TITLE: FISCHER MOD. "GM" MOBILE UNIT-BASE-GROOVED ROLLER -LARGE
KIND	IRON CASTING	CHANGED		
SHAPE		"		
FINISH	CAD. PLATE #23 & PAINTED	"		OBSOLETE
TEMP.		"		H. G. FISCHER & CO. 2335 WABANSIA AVE. CHICAGO, ILL. — CAT. NO. — PART NO. 12261F
PATT.	1296	"		

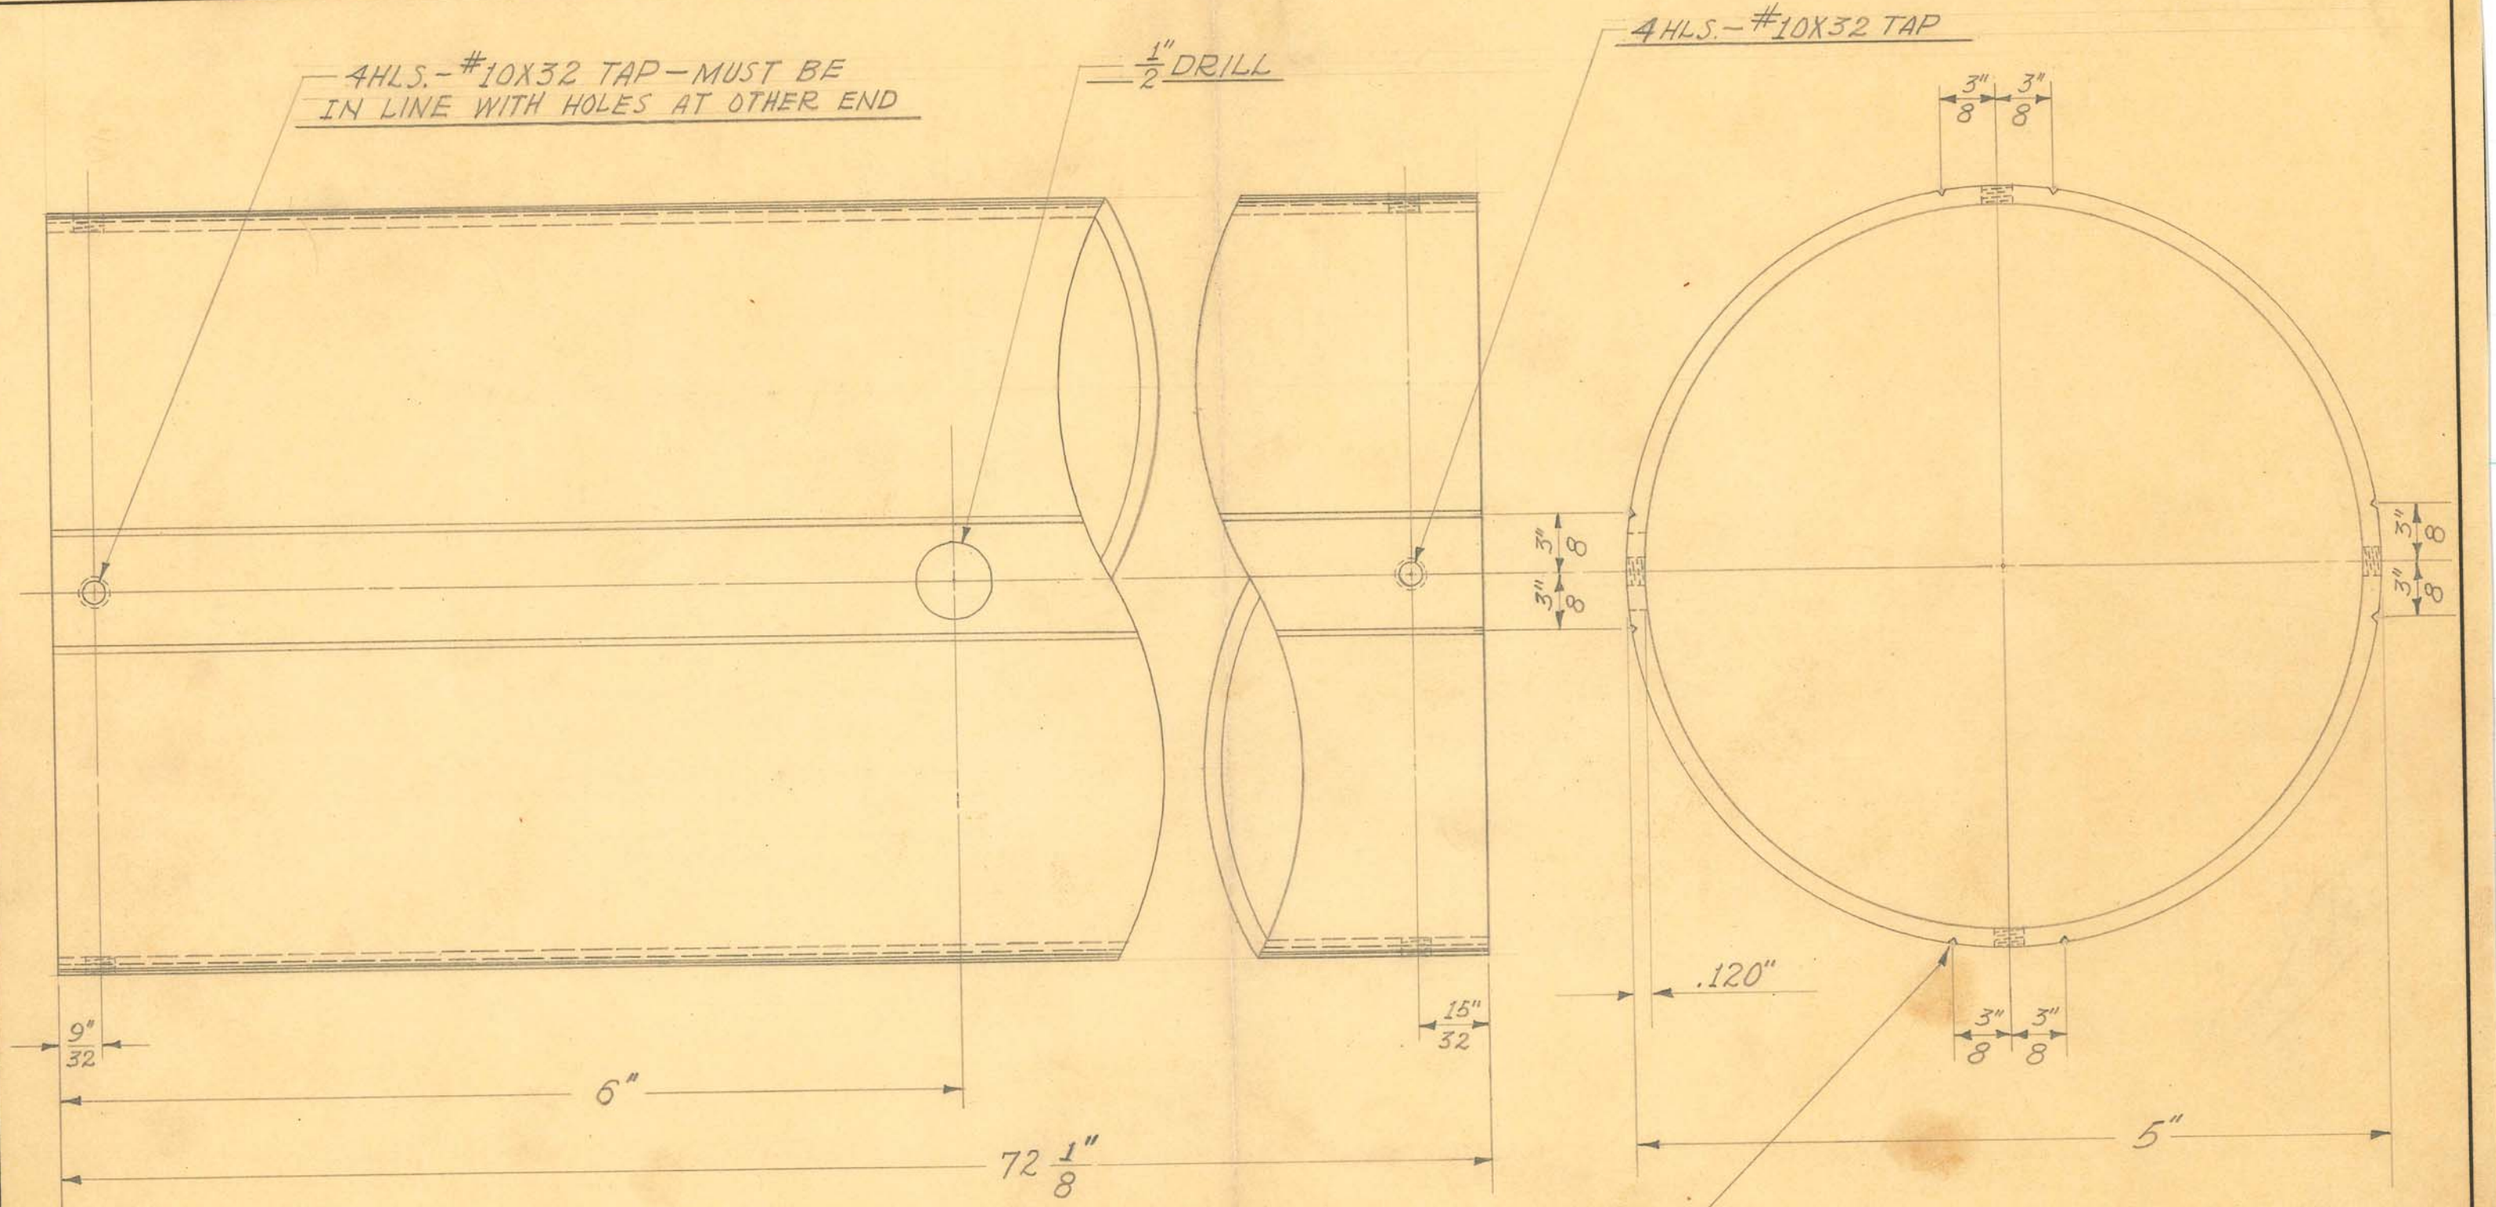

5" O.D. X #11 GAUGE SHELBY SEAMLESS STEEL TUBING

1 REQUIRED

SIZE		ISSUE 11-18-38	J.W.
KIND		CHANGED 10-5-39	J.W.
SHAPE		"	
FINISH		"	
TEMP.		"	
PATT.		"	

TITLE: FISCHER MOD. "GM" MOBILE UNIT - OUTER UPRIGHT TUBE - LONG

OBSOLETE

H. G. FISCHER & CO. 2335 WABANSIA AVE. CHICAGO, ILL.

CAT. NO.

PART NO. 12267F

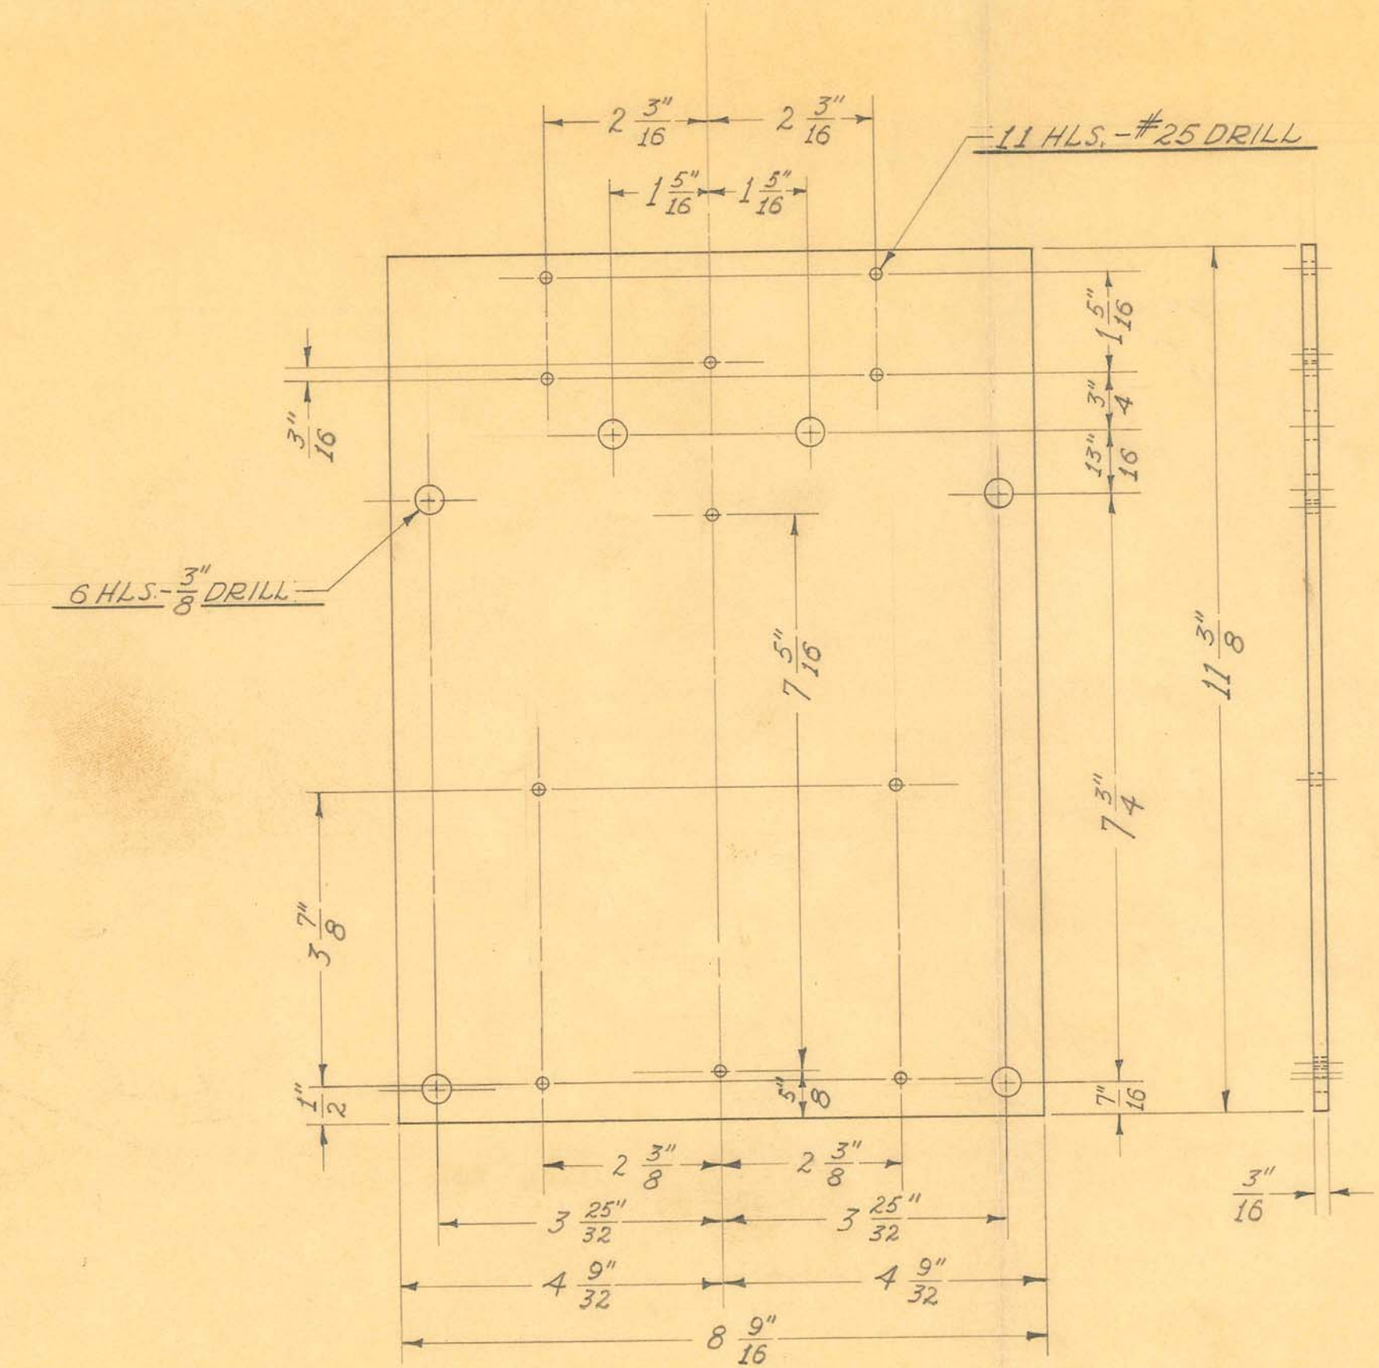

OBSOLETE

Obsolete

SCALE ~ 1/2" = 1"

1 REQUIRED

SIZE	3/16" SHEET	ISSUE 1-25-39	J.W.
KIND	TRANSITE	CHANGED	
SHAPE		"	
FINISH		"	
TEMP.		"	
PATT.		"	

TITLE: FISCHER MOD. PORT. "S" S.W. TRANSFORMER HEAT BARRIER

H. G. FISCHER & CO.
2335 WABANSIA AVE.
CHICAGO, ILL.

CAT. NO.

PART NO. 12451

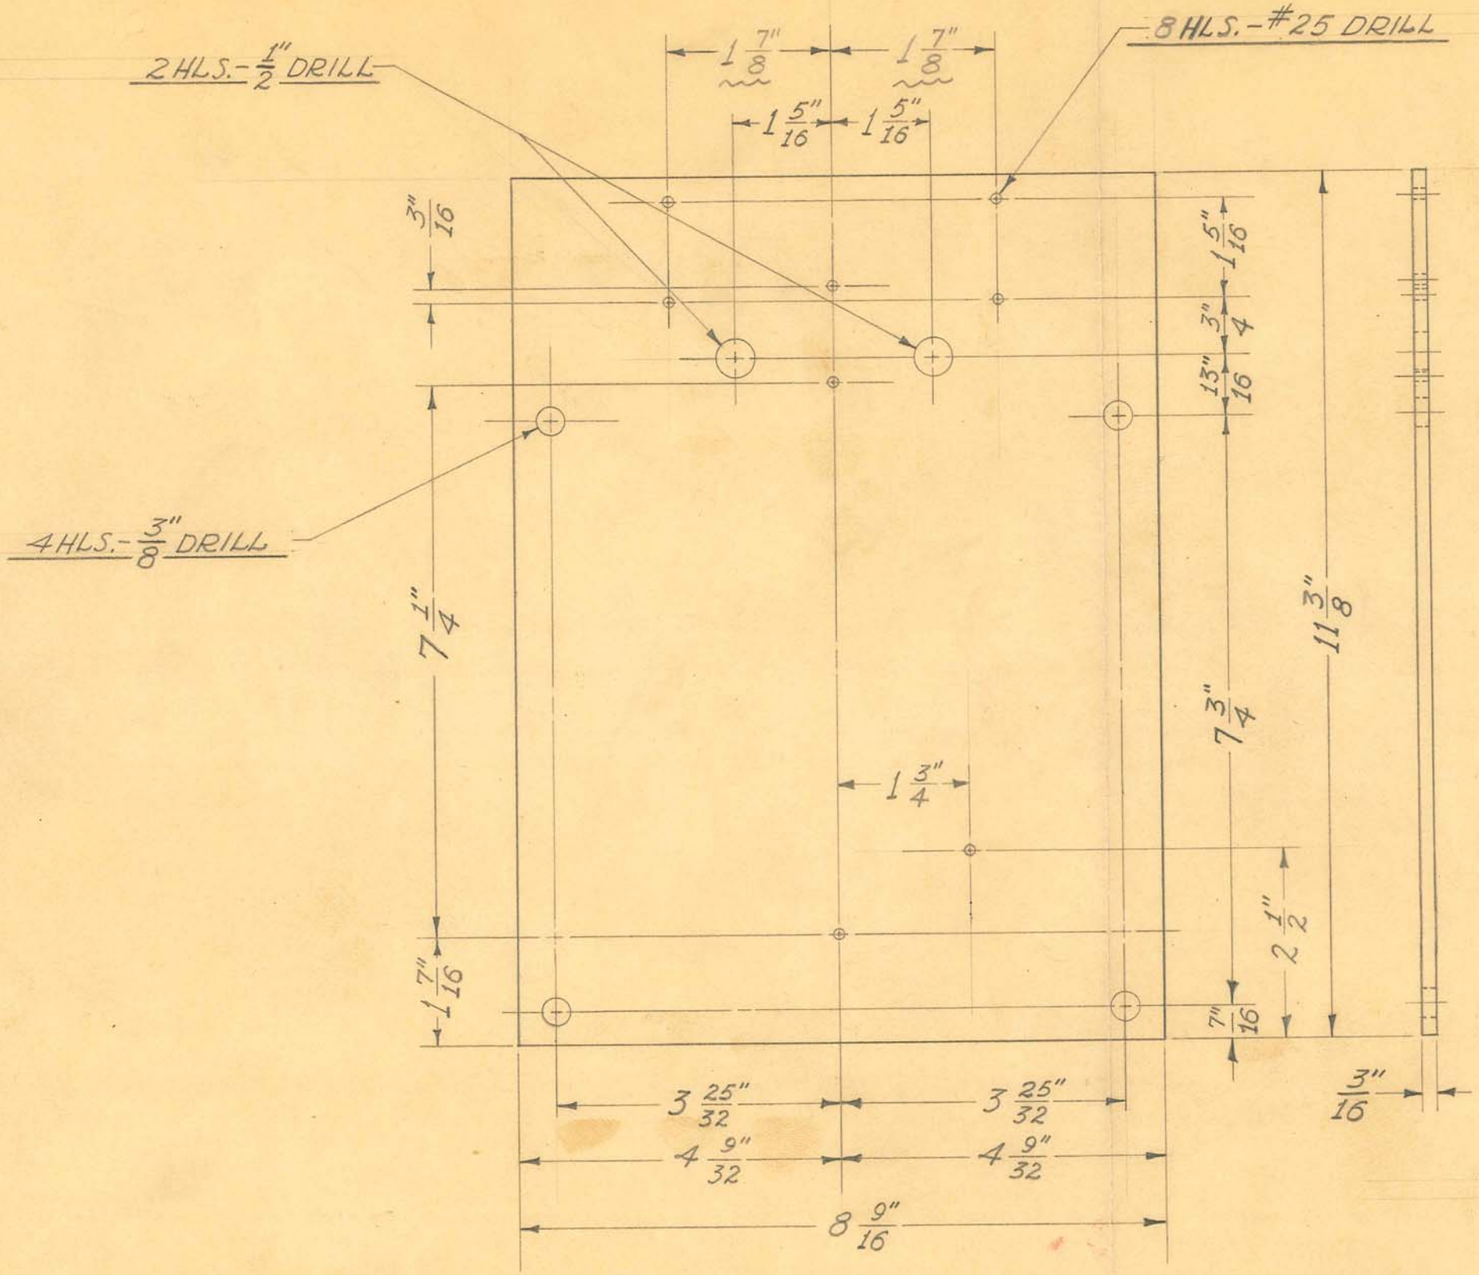

SCALE :- 1/2" = 1"

1 REQUIRED

OBSOLETE

SIZE	3/16" SHEET	ISSUE 3-9-39	J.W.
KIND	TRANSITE	CHANGED 11-6-40	J.W.
SHAPE		" 12-31-40	J.W.
FINISH		"	
TEMP.		"	
PATT.		"	

TITLE: FISCHER MOD. PORT. "S" SHORT WAVE TRANSFORMER HEAT BARRIER

H. G. FISCHER & CO.
2335 WABANSIA AVE.
CHICAGO, ILL.

CAT. NO.

PART NO. 12451FB

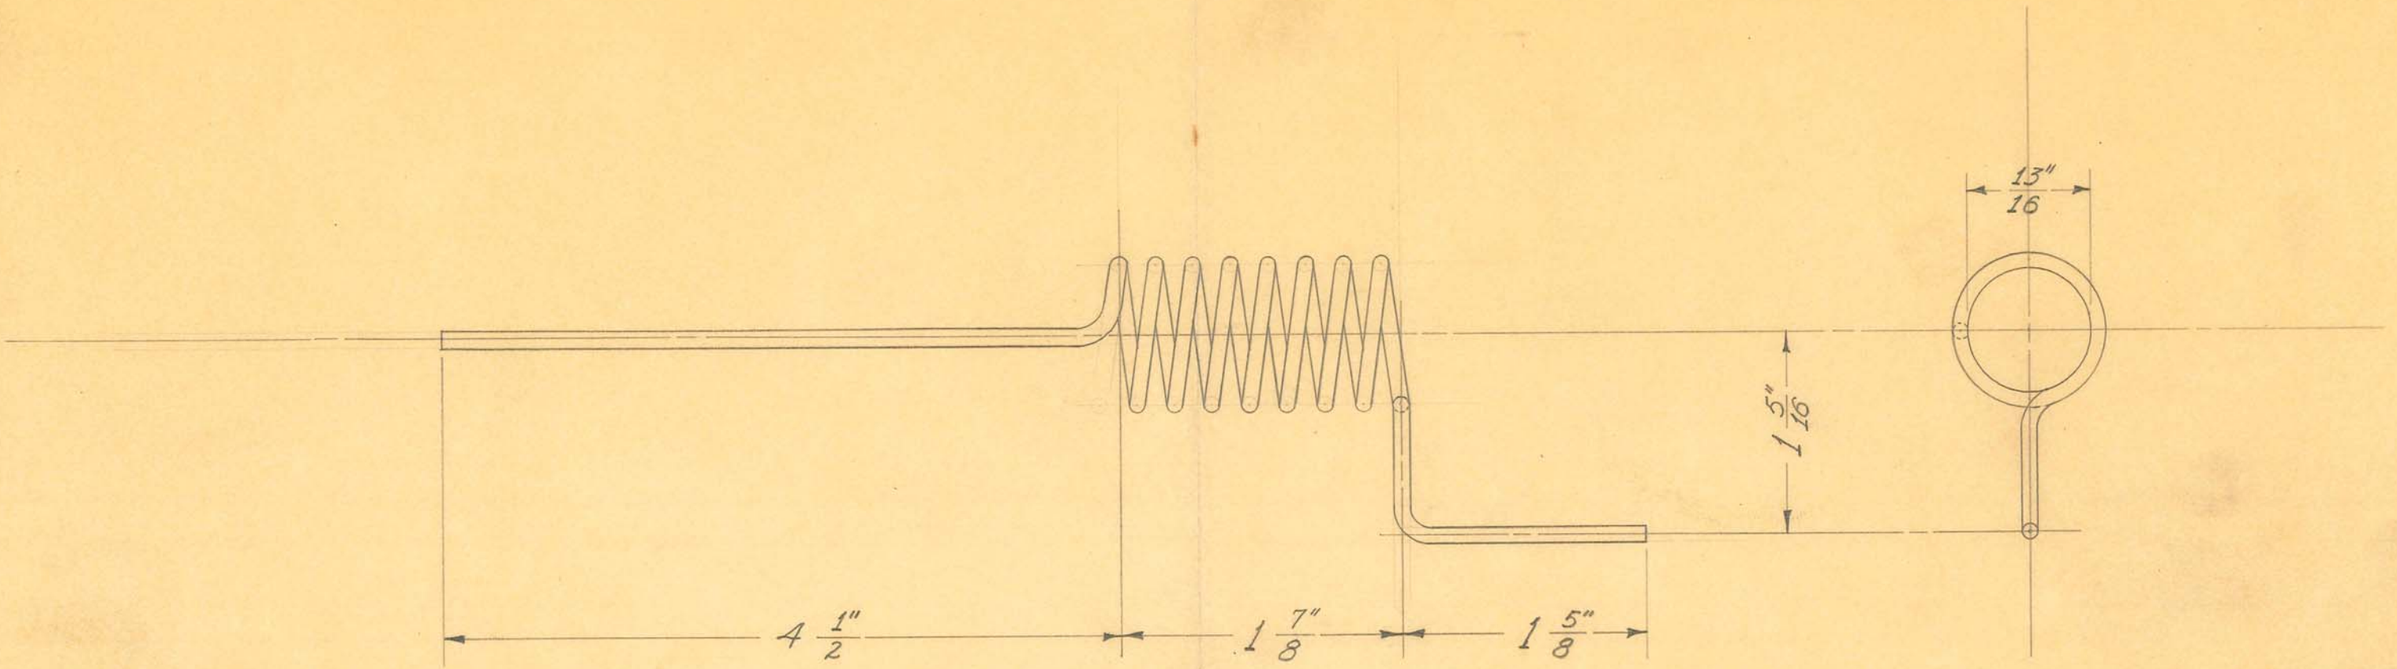

7 3/4 TURNS

1 REQUIRED

OBSOLETE

SIZE	#10 TINNED	ISSUE 1-26-39	J.W.
KIND	COPPER WIRE	CHANGED	
SHAPE		"	
FINISH		"	
TEMP.		"	
PATT.		"	

TITLE: FISCHER MOD. PORT. "S" S.W. PATIENT'S TUNING COIL - RIGHT

H. G. FISCHER & CO.
2335 WABANSIA AVE.
CHICAGO, ILL.

CAT. NO.

PART NO. 12454

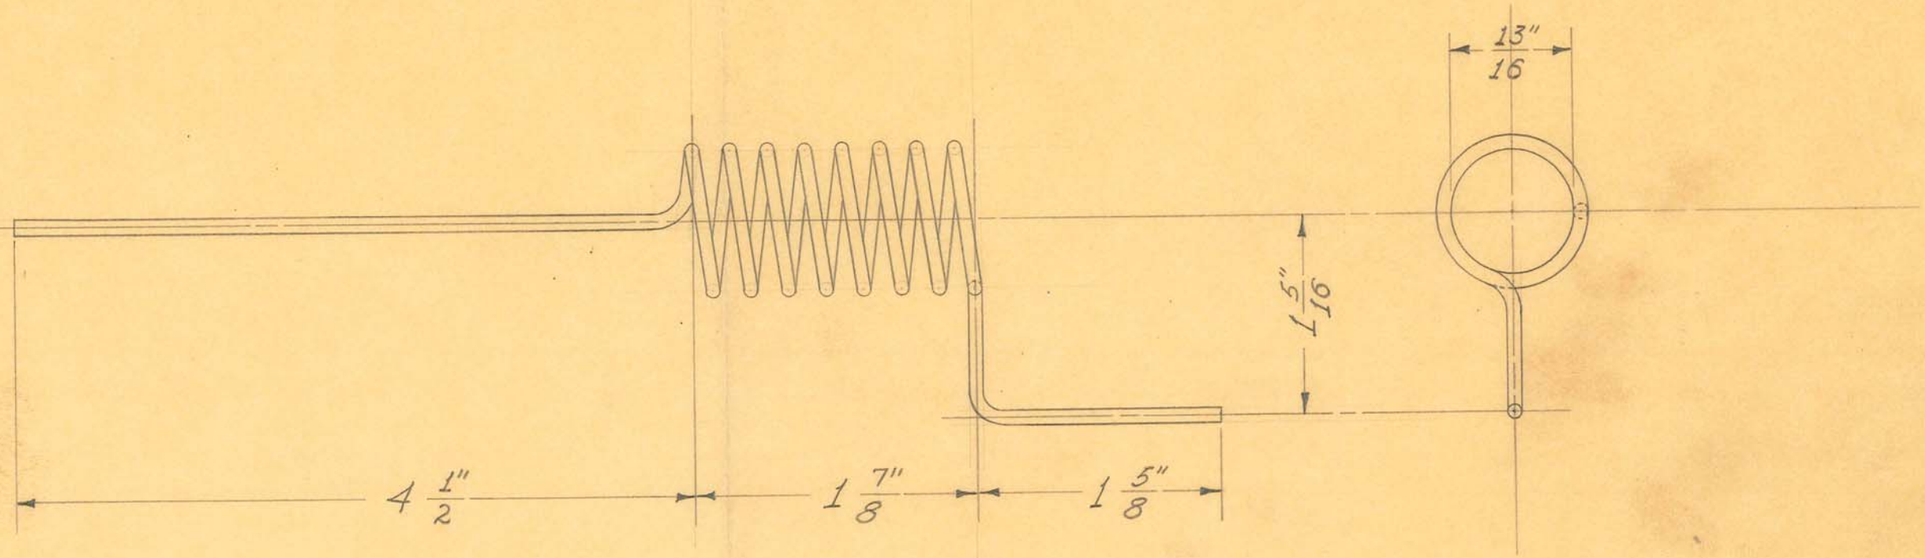

7 3/4 TURNS

1 REQUIRED

OBSOLETE

SIZE	#10 TINNED	ISSUE 1-25-39	J.W.
KIND	COPPER WIRE	CHANGED	
SHAPE		"	
FINISH		"	
TEMP.		"	
PATT.		"	

TITLE: FISCHER MOD. PORT. "S" S.W. PATIENT'S TUNING COIL - LEFT

H. G. FISCHER & CO.
2335 WABANSIA AVE.
CHICAGO, ILL.

CAT. NO.

PART NO. 12455

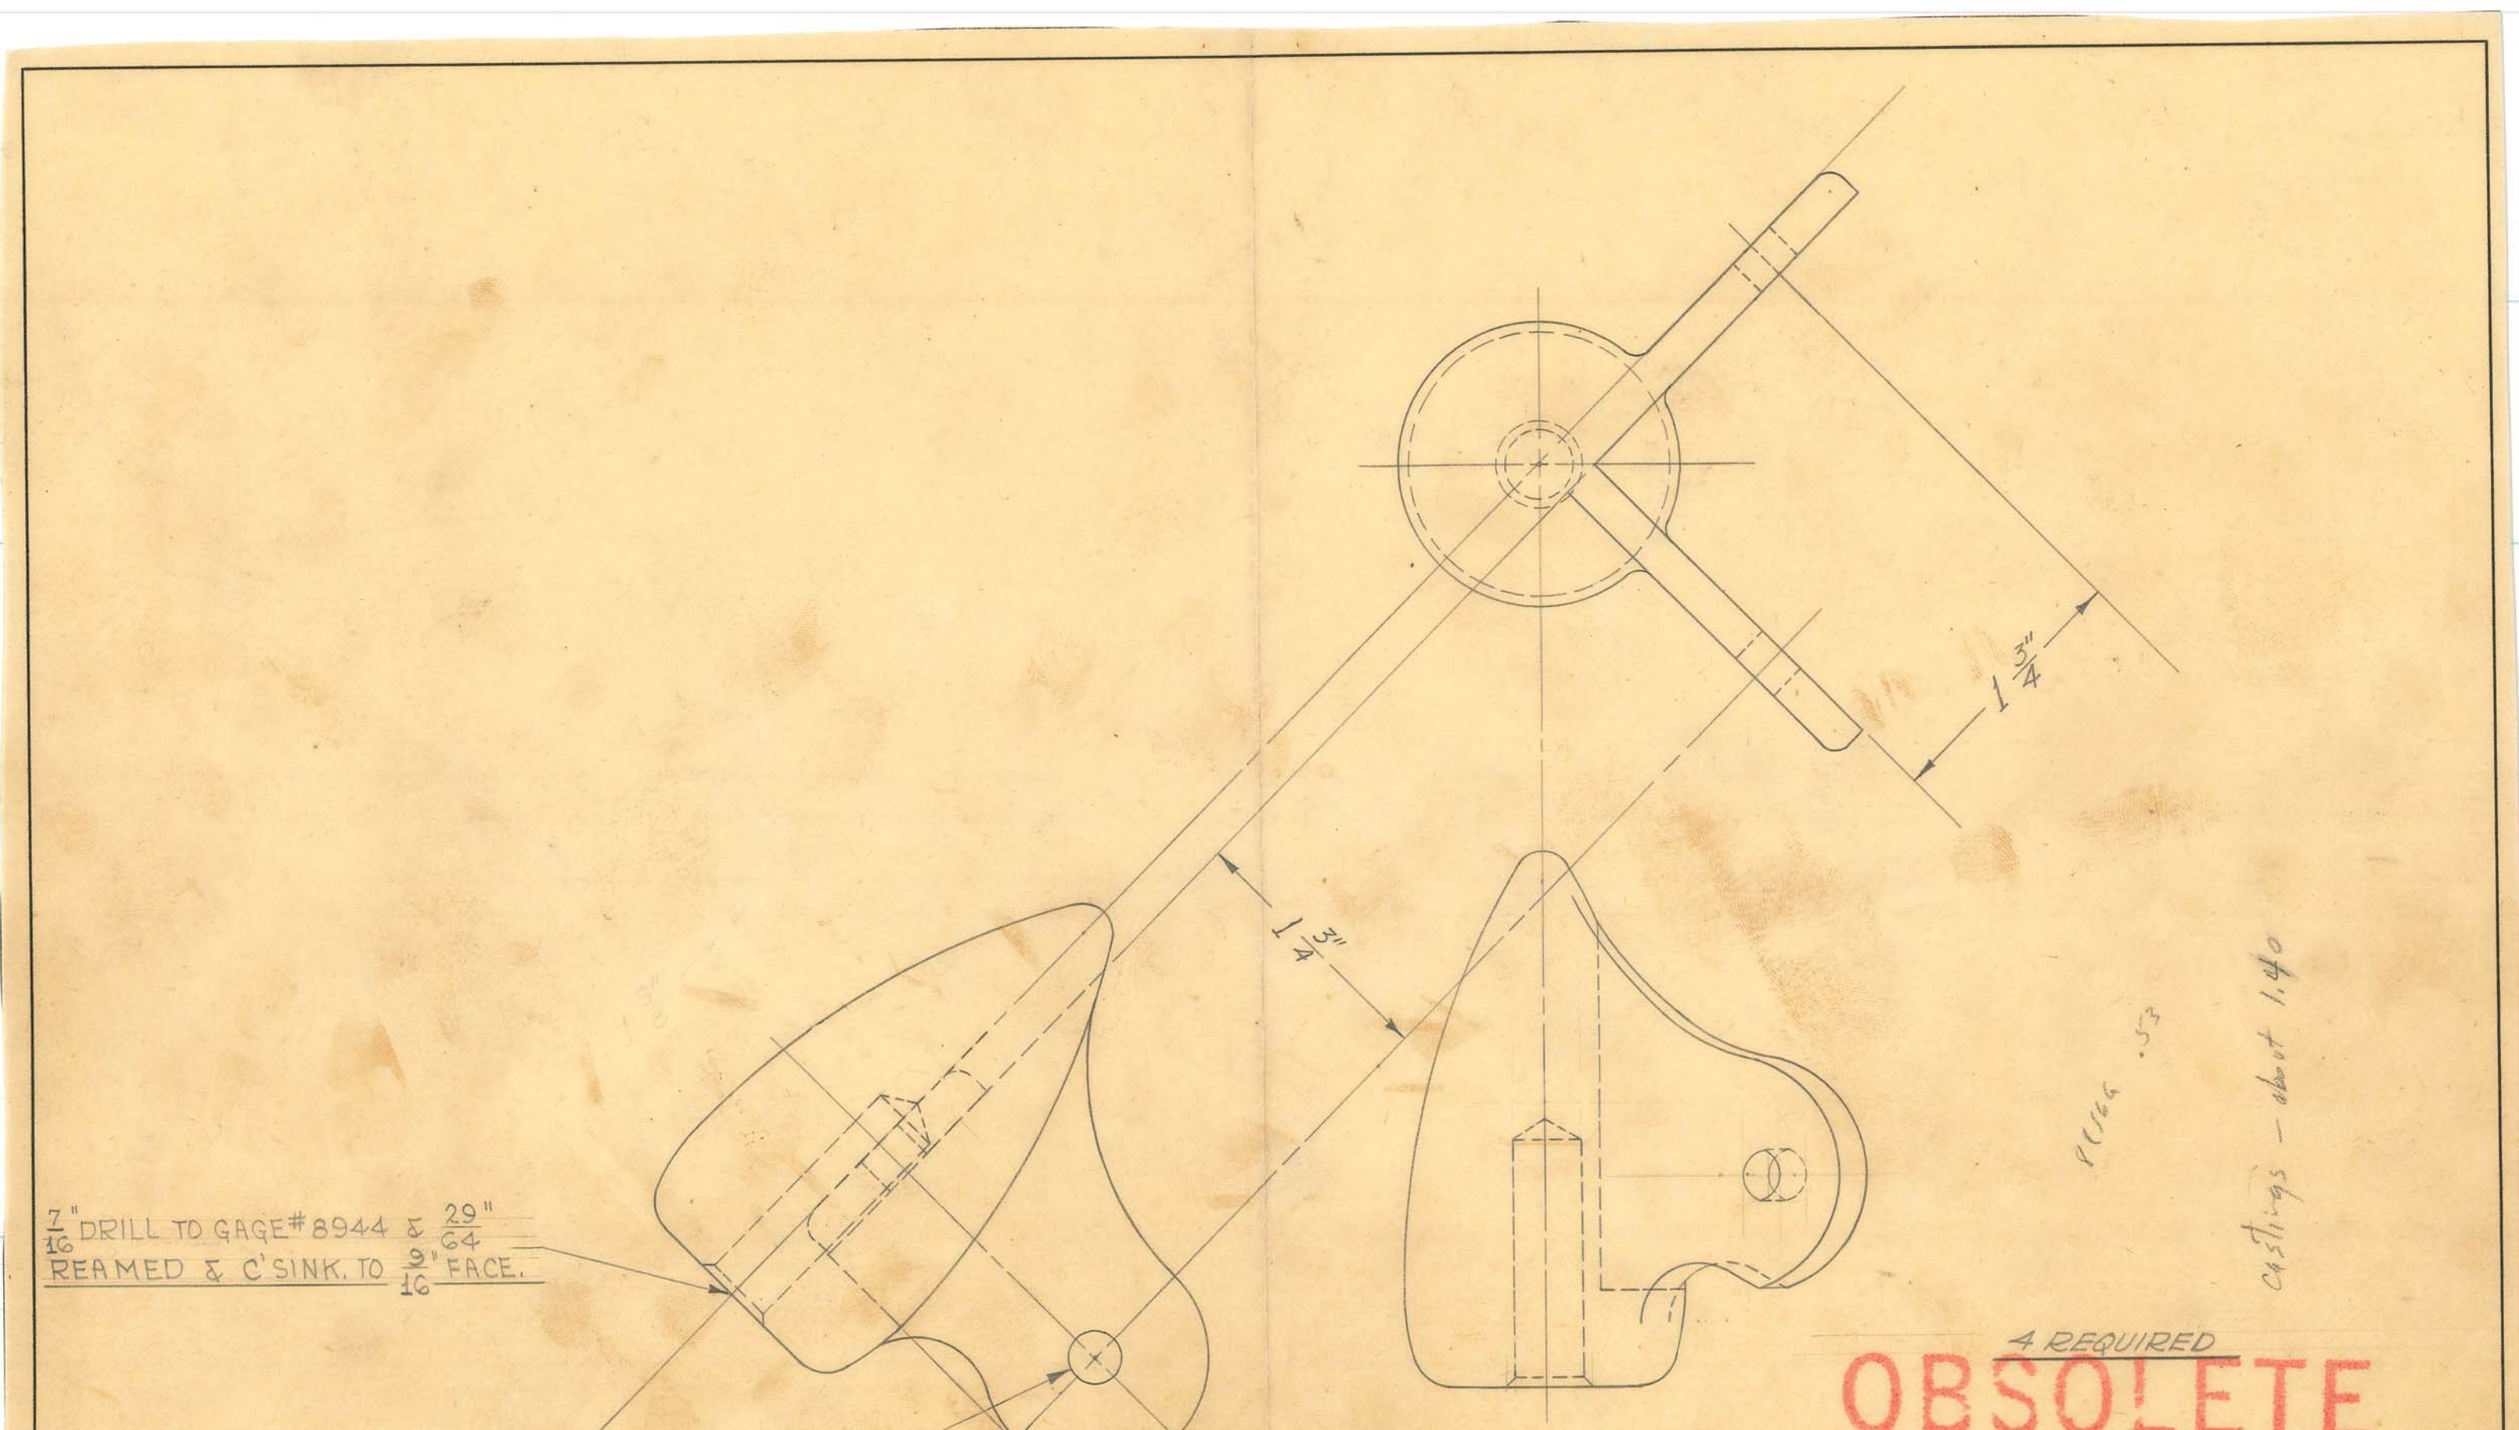

4 REQUIRED

OBSOLETE

CASTINGS - about 1.40

PLUG .53

SIZE		ISSUE 4-24-39	J.W.	
KIND	IRON CASTING	CHANGED		
SHAPE		"		
FINISH	BLK. KRIST. #55	"		
TEMP.		"		
PATT.	1354	"		

TITLE: FISCHER MOD "S" SHORT WAVE OUTFIT
CABINET CASTER SUPPORT

H. G. FISCHER & CO.
2335 WABANSIA AVE.
CHICAGO, ILL.

CAT. NO.

PART NO. 12458F

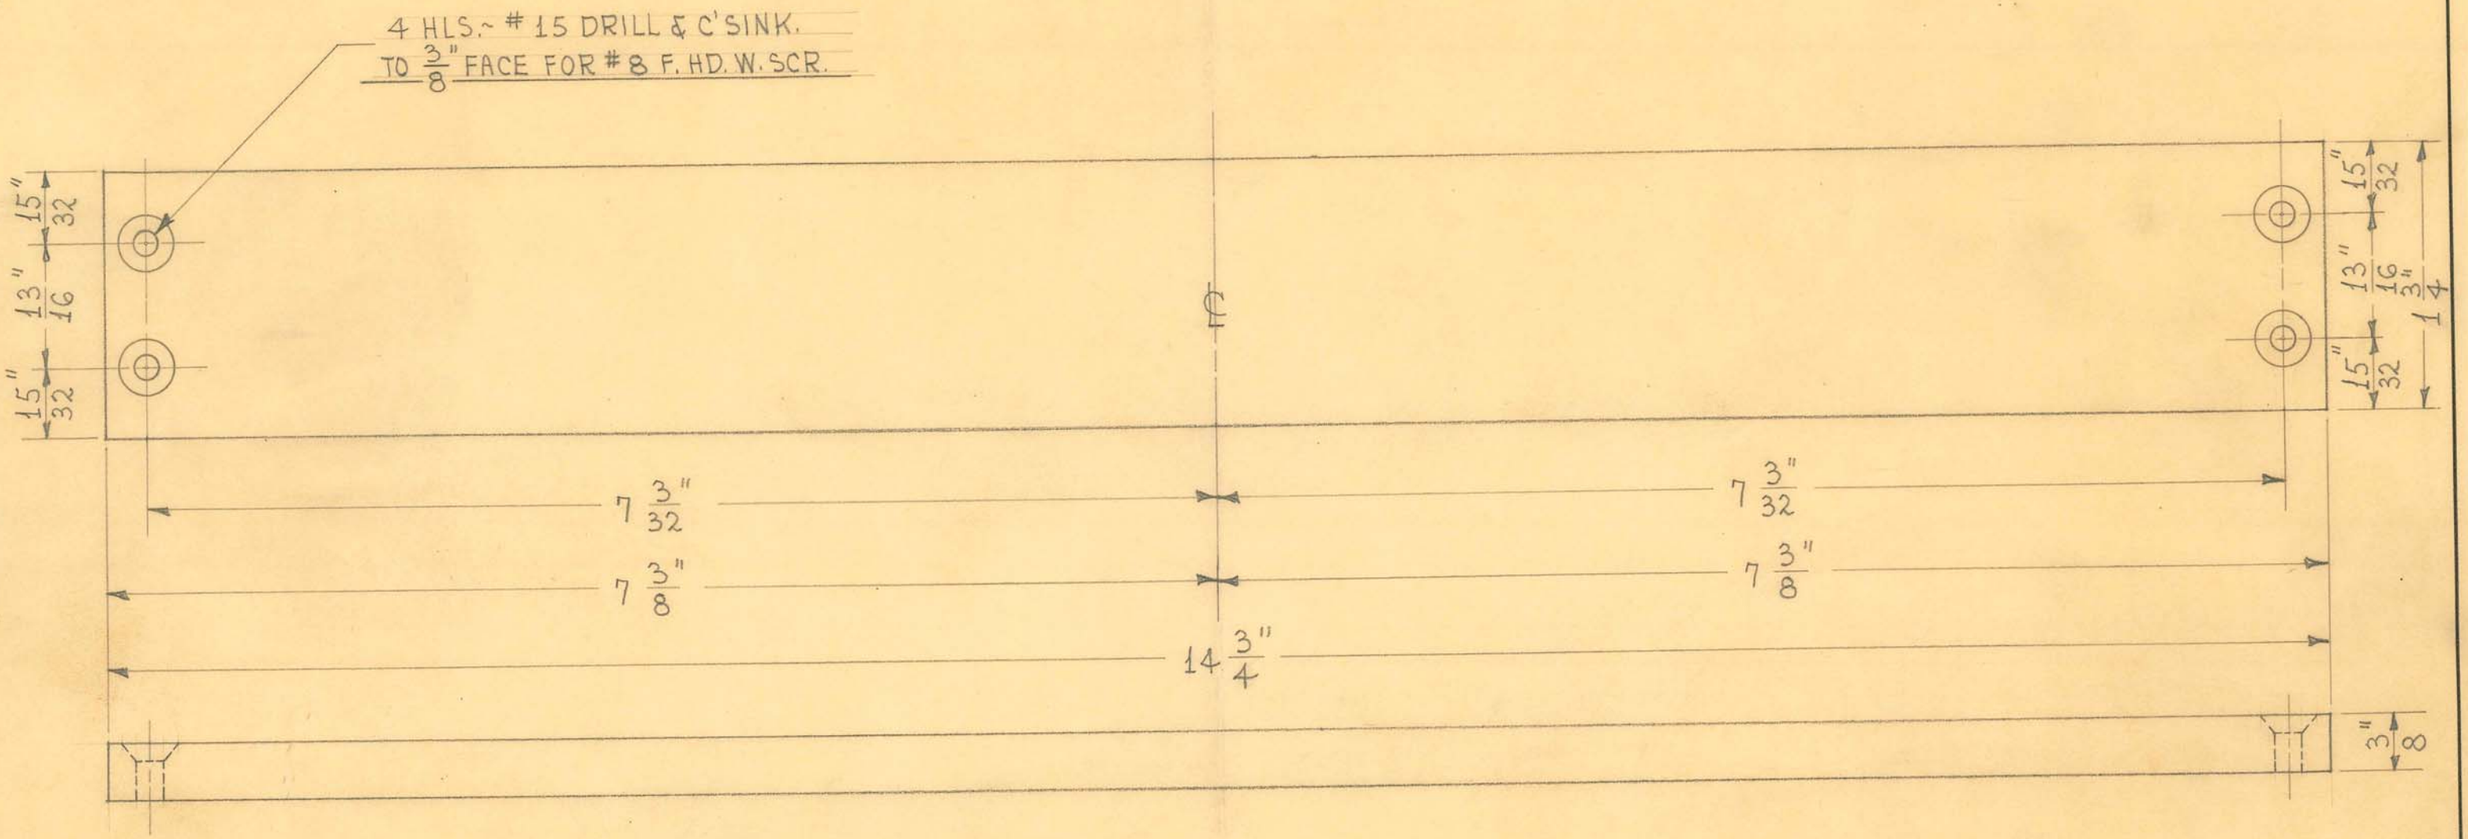

1 REQUIRED

OBSOLETE

SIZE		ISSUE 2-27-45	HE.
KIND	HARD WOOD	CHANGED	
SHAPE		"	
FINISH		"	
TEMP.		"	
PATT.		"	

TITLE: FISCHER MOD. "S" SHORT WAVE (12 METER) ELECT. UNIT RACK - STAND OFF INS. SUPP. STRIP

H. G. FISCHER & CO.
2338 WABANSIA AVE.
CHICAGO. ILL.

CAT. NO.

PART NO. 12459 1/2

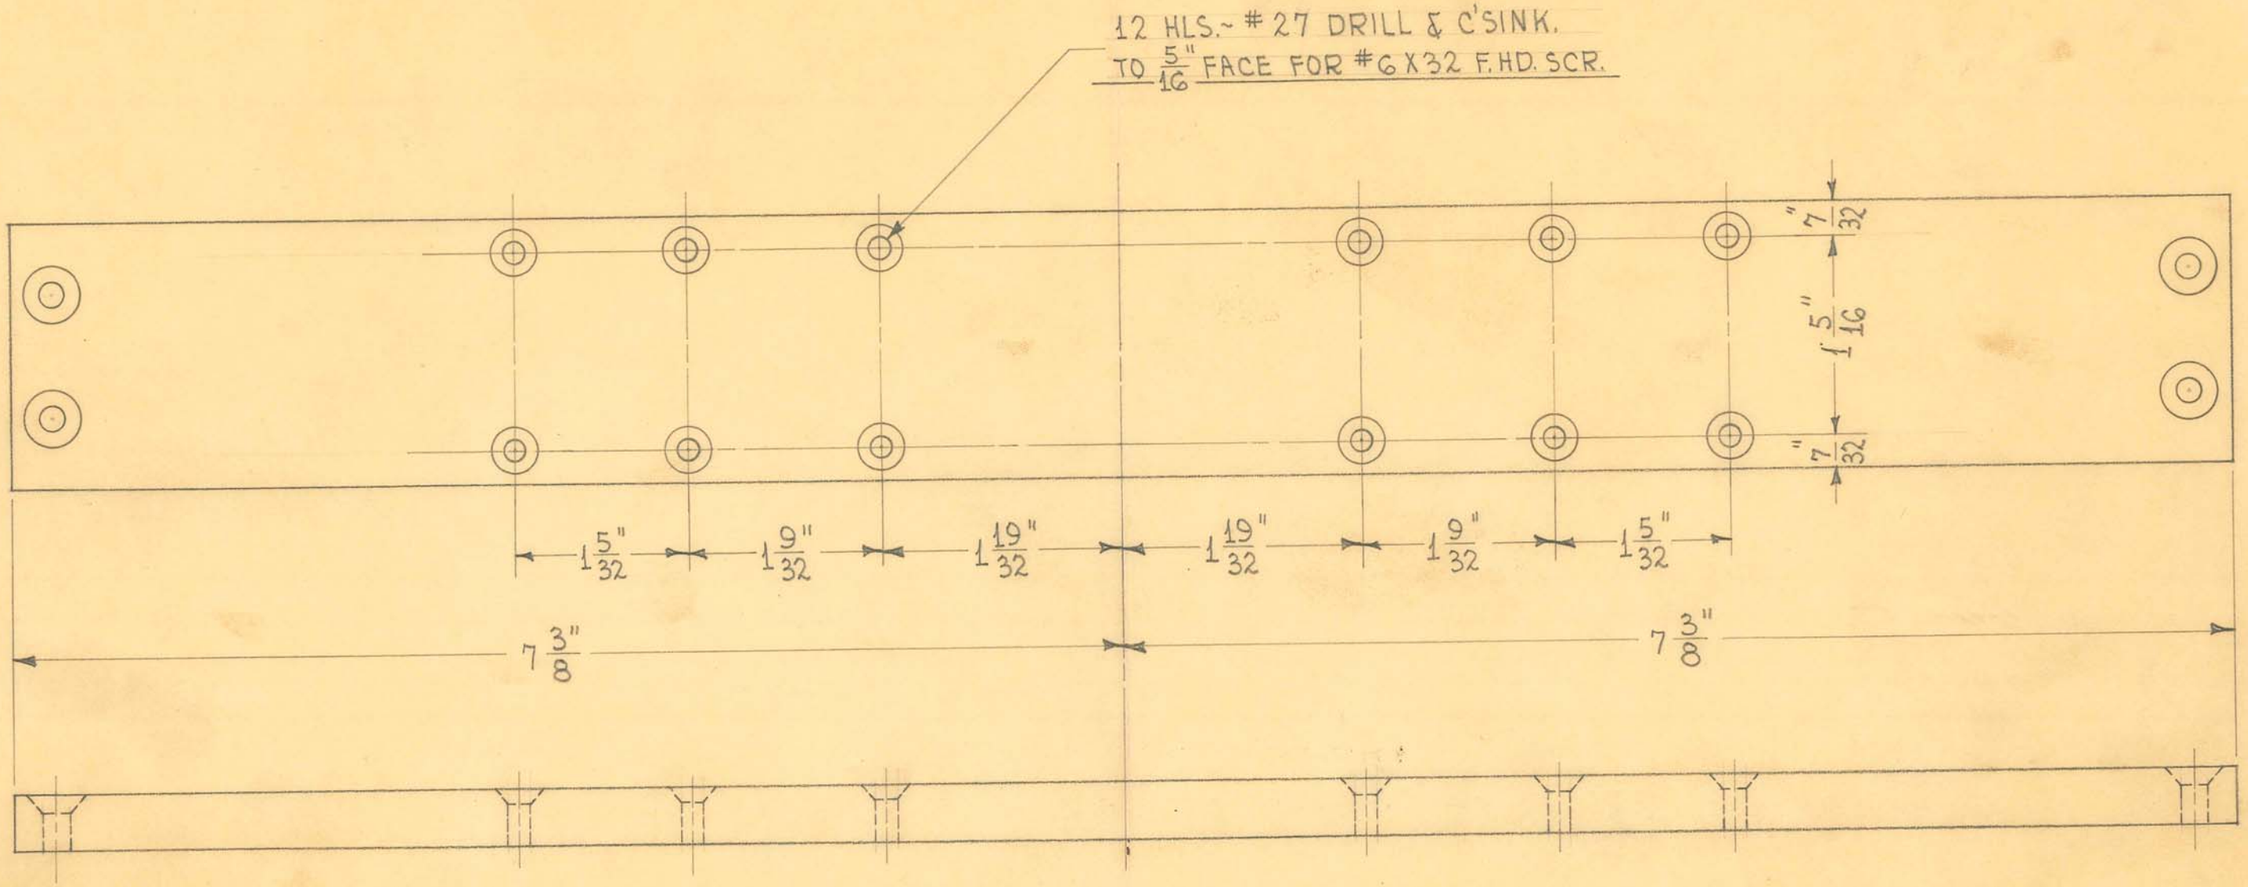

1 REQUIRED

OBSOLETE

SIZE		ISSUE 2-27-45	HE.
KIND		CHANGED	
SHAPE		"	
FINISH		"	
TEMP.		"	
PATT.		"	

TITLE: FISCHER MOD. "S" SHORT WAVE (12 METER) ELECT. UNIT RACK~STAND OFF INS. SUPP. STRIP (DRILLED)

H. G. FISCHER & CO.
2338 WABANSIA AVE.
CHICAGO, ILL.

CAT. NO.

PART NO. 12459 1/2 F

4 HLS.~ #15 DRILL & C'SINK.
TO $\frac{3}{8}$" FACE FOR #8 F.HD. W. SCR.

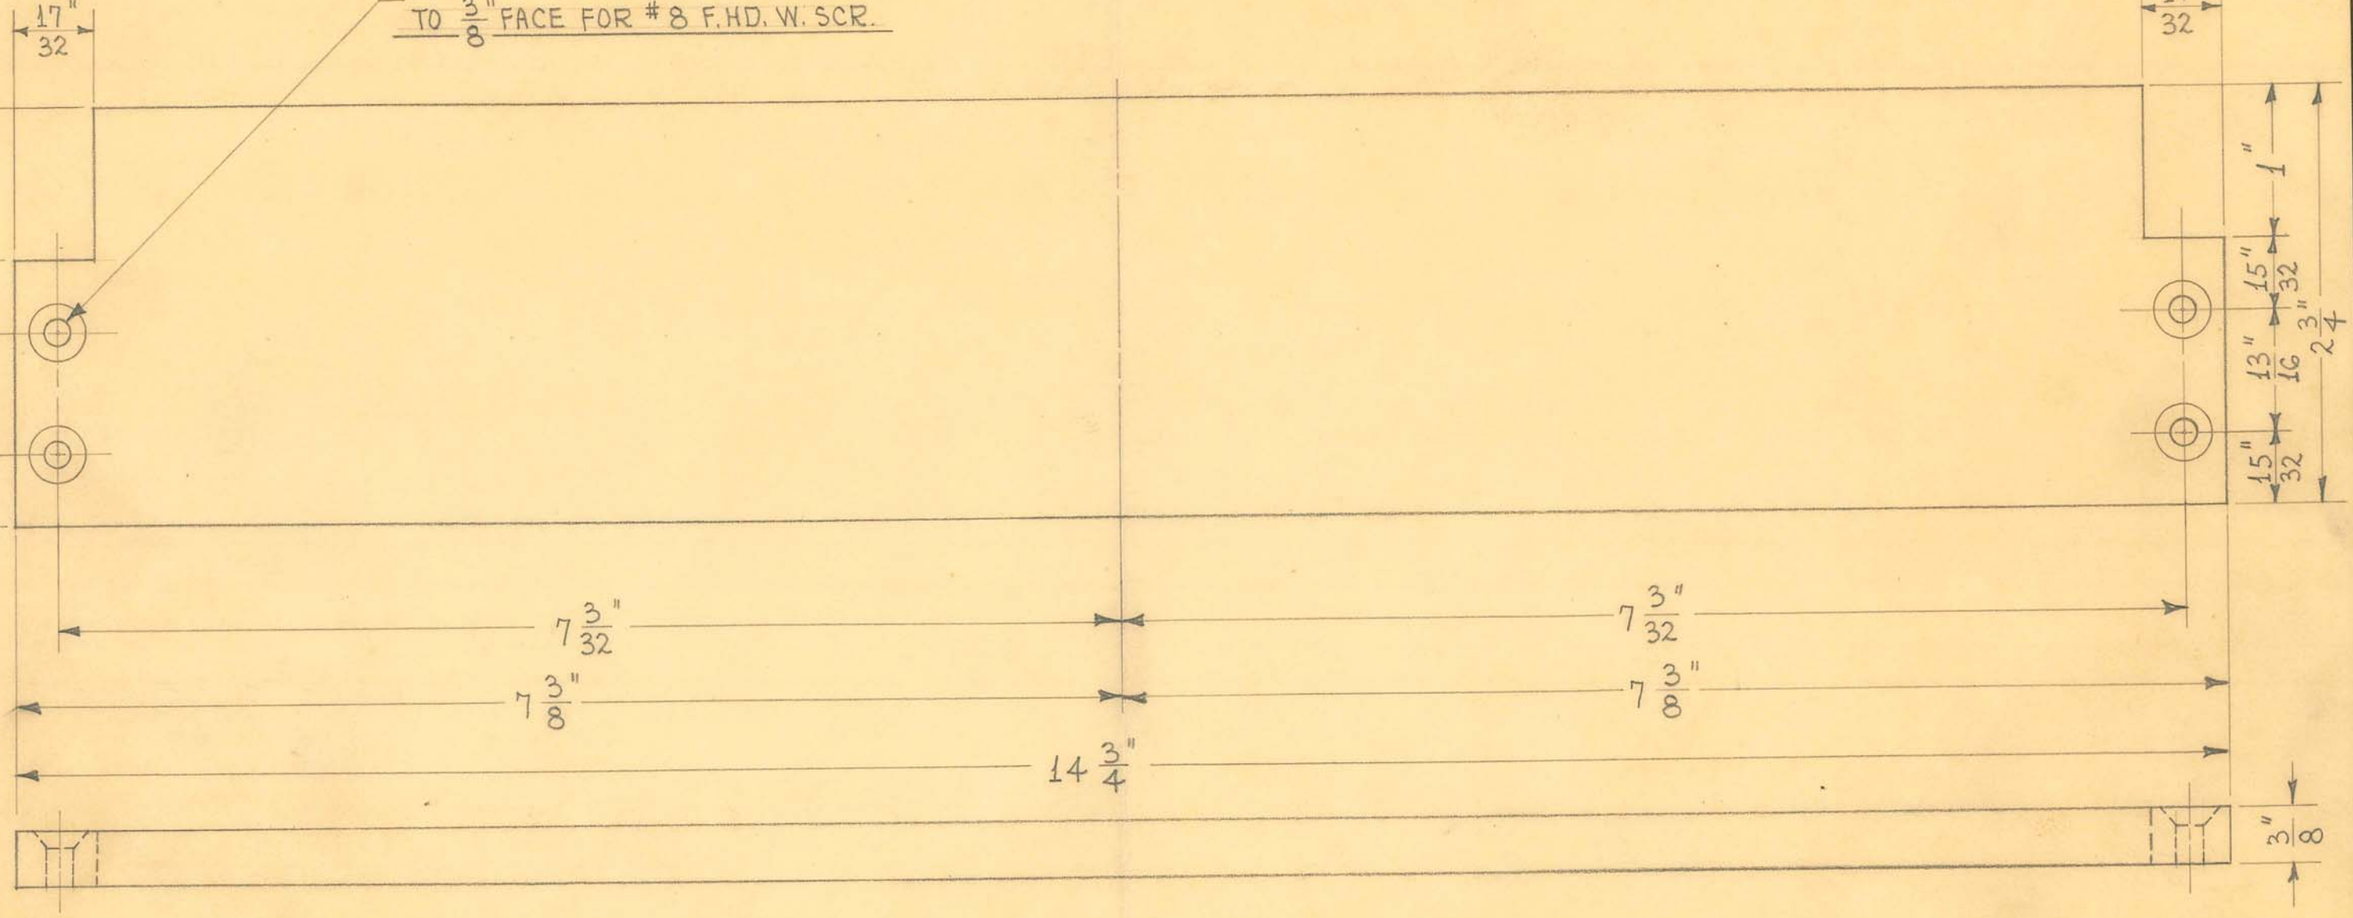

1 REQUIRED

OBSOLETE

SIZE		ISSUE 2-26-45	HE.
KIND	HARD WOOD	CHANGED	
SHAPE		"	
FINISH		"	
TEMP.		"	
PATT.		"	

TITLE: FISCHER MOD. "S" SHORT WAVE (G METER)
ELECT. UNIT RACK~STAND OFF INS. SUPP. STRIP

H. G. FISCHER & CO.
2335 WABANSIA AVE.
CHICAGO. ILL.

CAT. NO.

PART NO. 12461 1/2

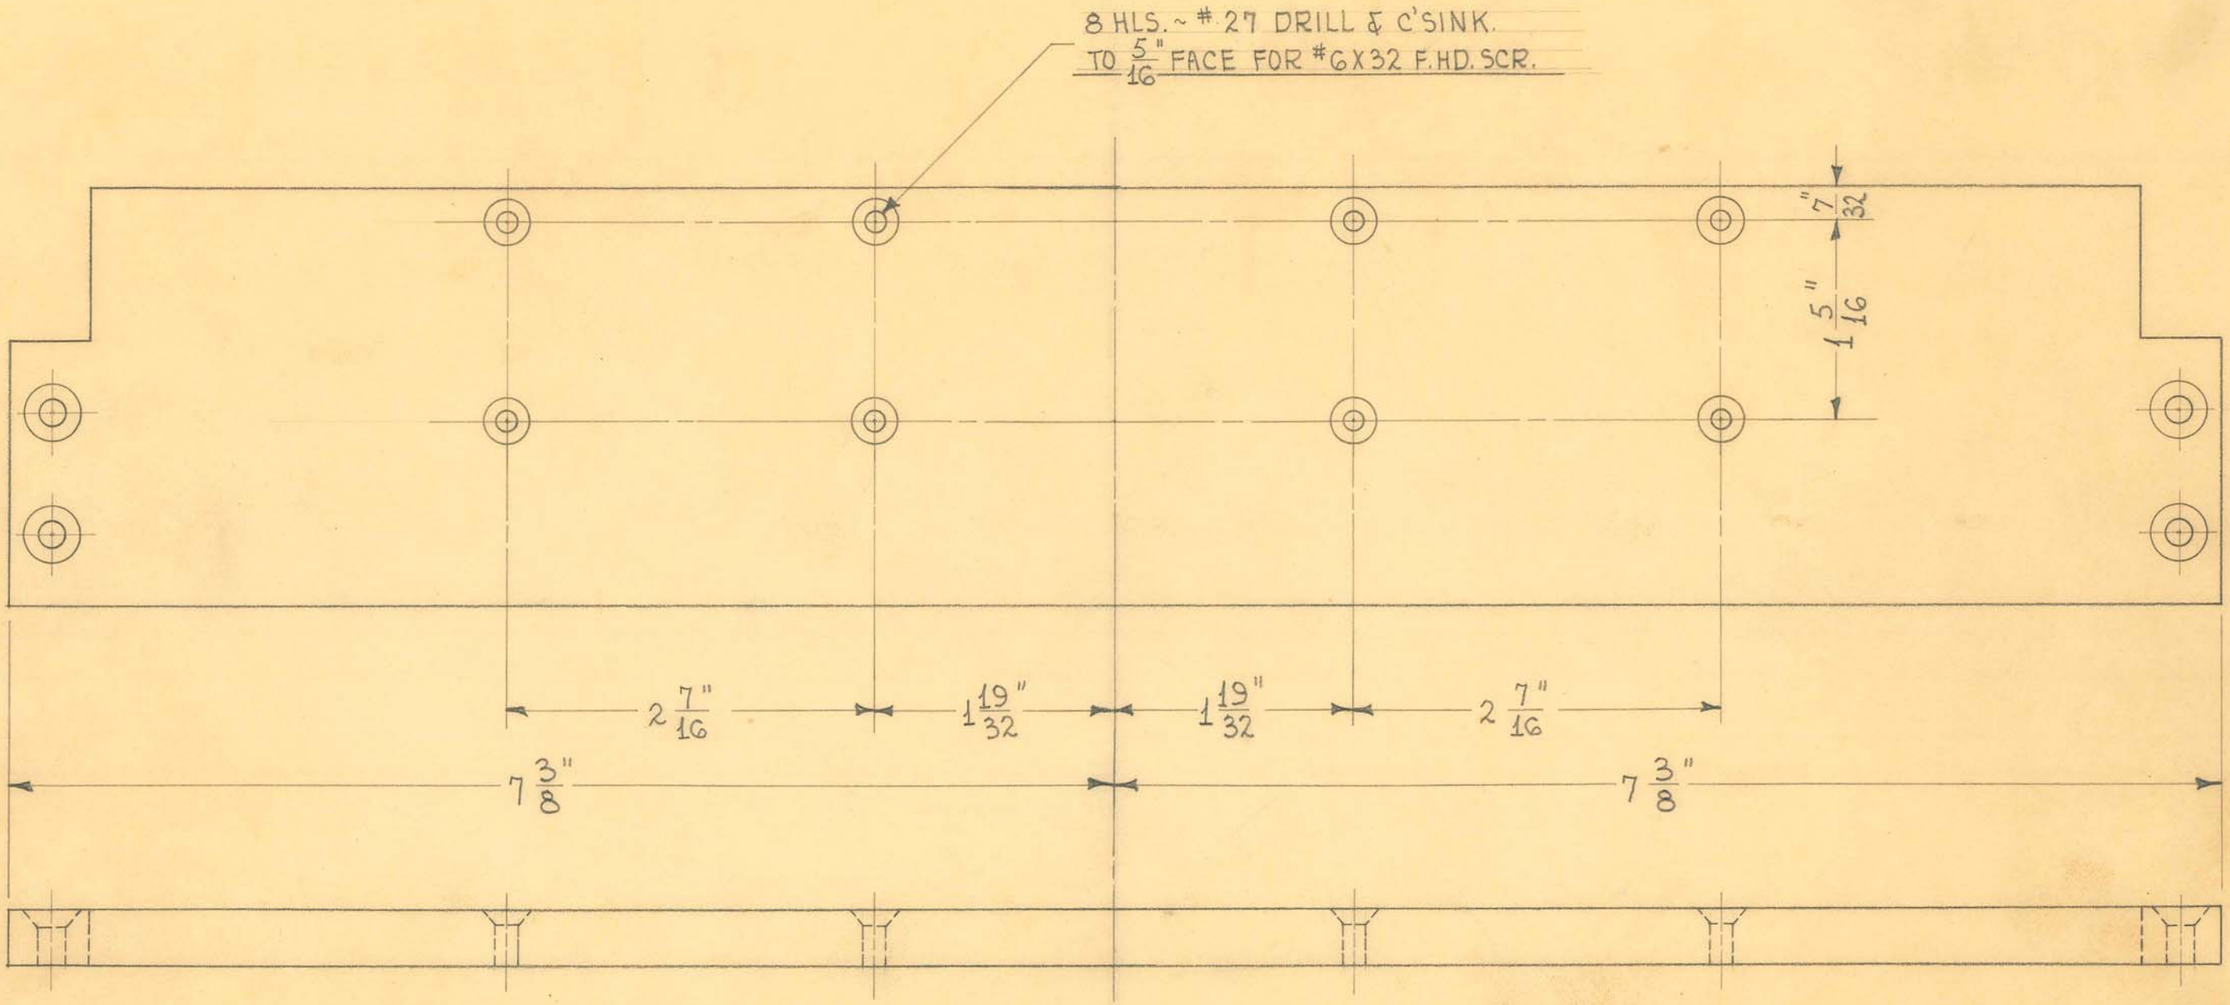

1 REQUIRED

OBSOLETE

SIZE		ISSUE 2-26-45	HE.	**TITLE:** FISCHER MOD. "S" SHORT WAVE (6 METER) ELECT. UNIT RACK ~ STAND OFF INS. SUPP. STRIP (DRILLED)
KIND		CHANGED		
SHAPE		"		
FINISH		"		
TEMP.		"		
PATT.		"		

H. G. FISCHER & CO.
2338 WABANSIA AVE.
CHICAGO. ILL.

CAT. NO.

PART NO. 12461 1/2 F

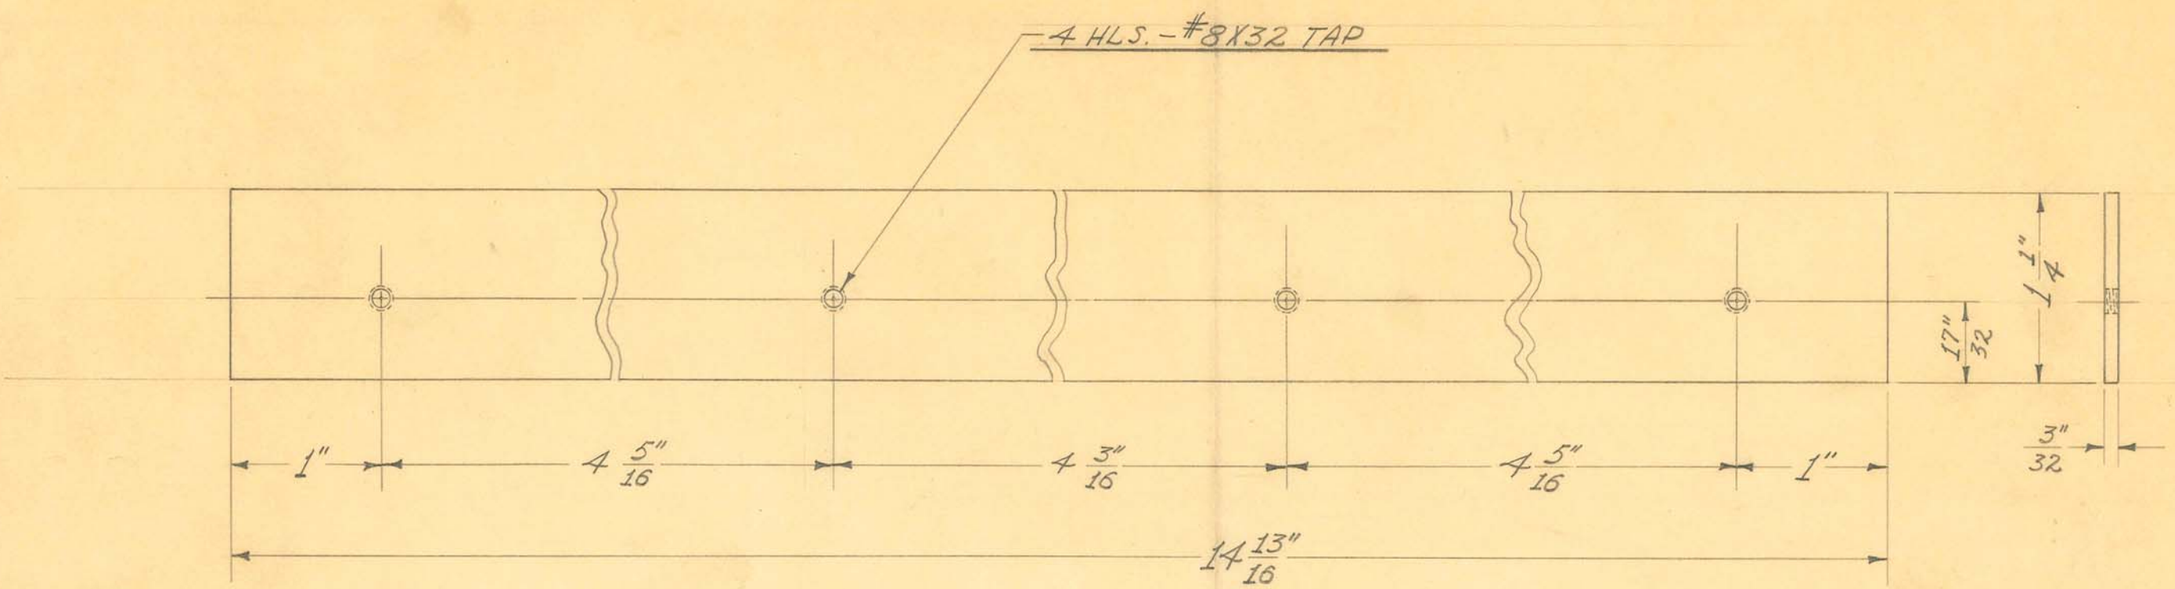

1 REQUIRED

OBSOLETE

SIZE	1¼" X 3/32"	ISSUE 2-2739	J.W.
KIND	C.R. STEEL	CHANGED	
SHAPE	STRIP	"	
FINISH		"	
TEMP.		"	
PATT.		"	

TITLE: FISCHER MOD. PORT. "S" SHORT WAVE CARRYING-CASE-BACK COVER GUIDE STRIP

H. G. FISCHER & CO.
2335 WABANSIA AVE.
CHICAGO, ILL.

CAT. NO.

PART NO. 12462

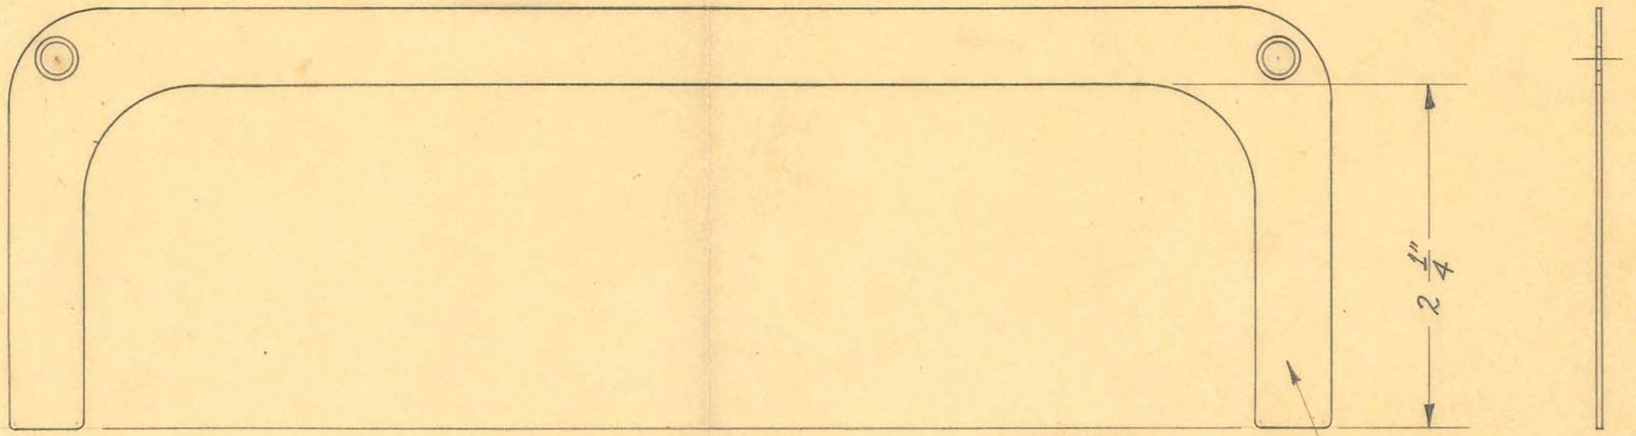

FROM PCE. NO. 12478

1 REQUIRED

CHROME #2 - POLISH ON C'SUNK. FACE OF HOLE ONLY.

OBSOLETE
DATE SEP 17 1975
REFER TO
FOR DEALC SEE E. O. O. #
ENGINEER
DRAFTSMAN

SIZE		ISSUE 2-14-40	J.W.
KIND		CHANGED	
SHAPE		"	
FINISH	CHROME #2 SEE NOTE	"	
TEMP.		"	
PATT.		"	

TITLE: FISCHER WALL MODEL DENTAL X-RAY UNIT - TANK SCREW SHIELD-SMALL

H. G. FISCHER & CO.
2335 WABANSIA AVE.
CHICAGO, ILL.

CAT. NO.

PART NO. 12477

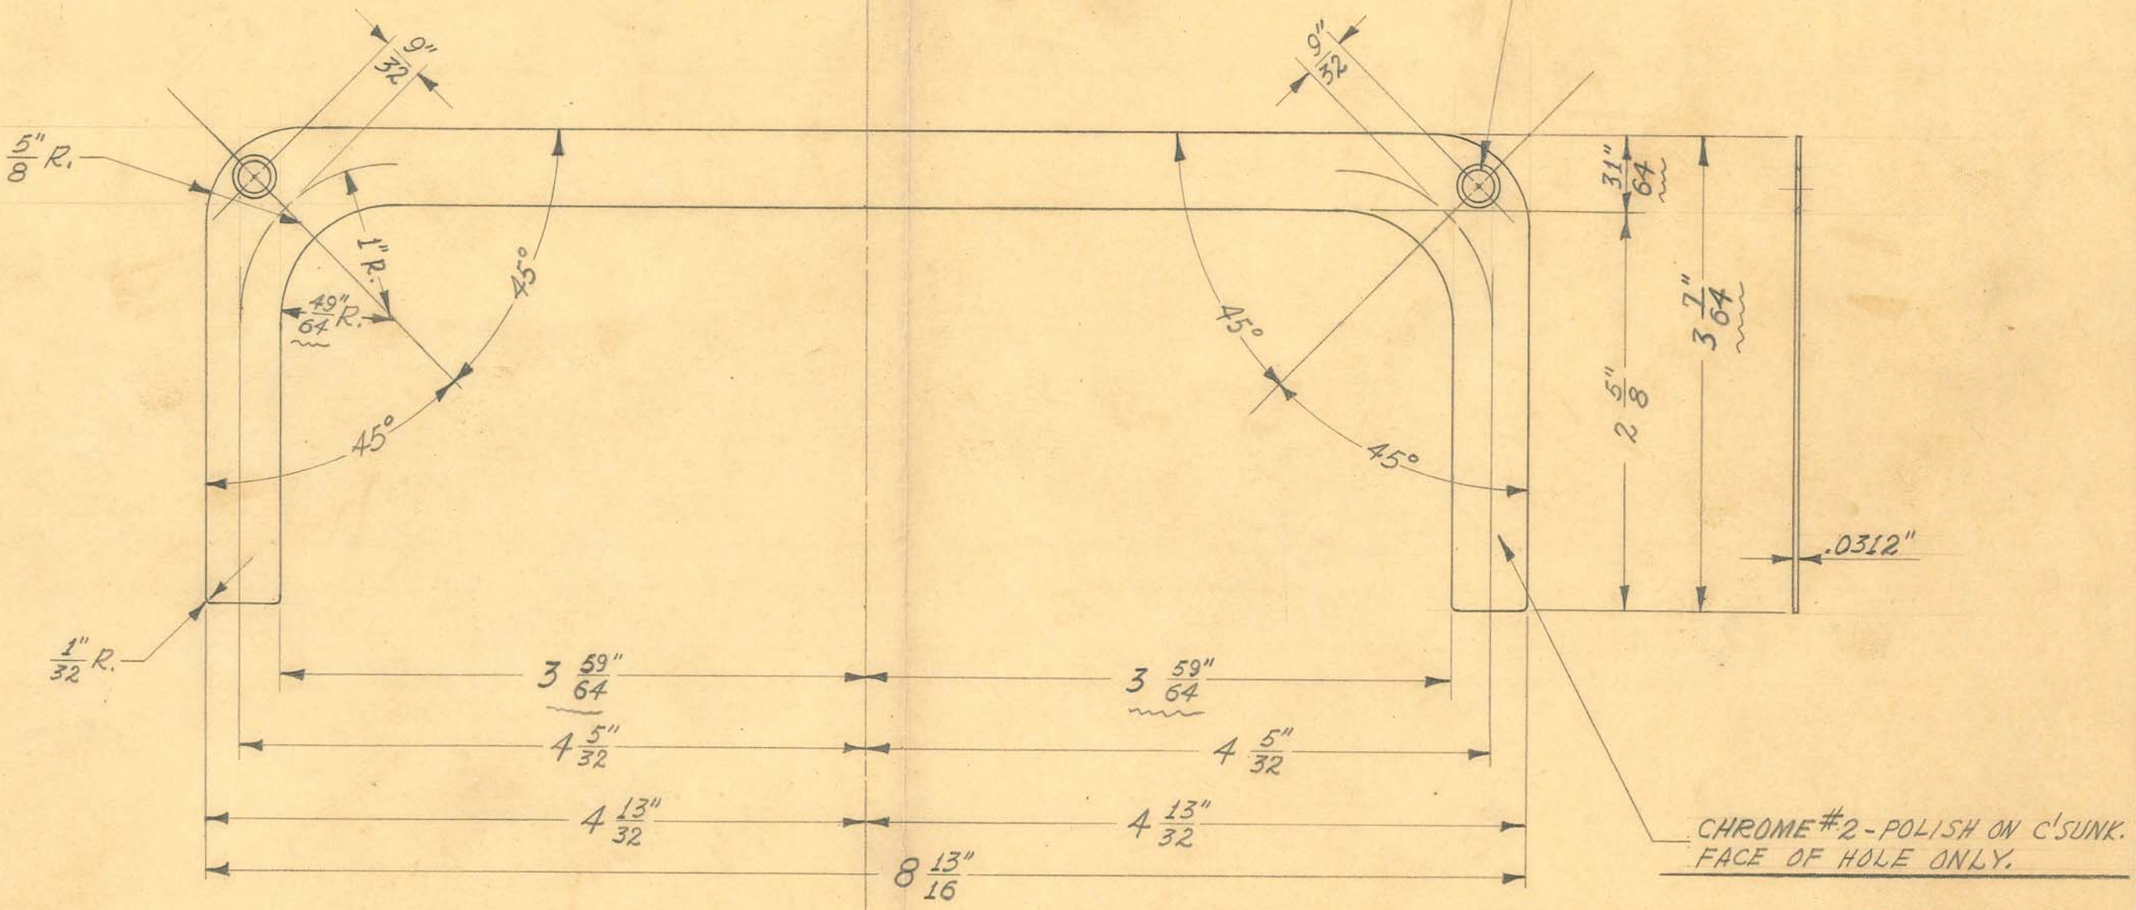

2 REQUIRED

SEP 17 1975
DATE
REFER TO
FOR DETAILS SEE E. C. O. #
ENGINEER
DRAFTSMAN

SIZE	#22GA (.031R")	ISSUE 2-14-40	J.W.
KIND	C.R. STEEL	CHANGED	
SHAPE	SHEET	"	
FINISH	CHROME #2 SEE NOTE.	"	
TEMP.		"	
PATT.		"	

TITLE: FISCHER WALL MODEL DENTAL X-RAY UNIT - TANK SCREW SHIELD-LARGE

H. G. FISCHER & CO.
2335 WABANSIA AVE.
CHICAGO, ILL.

CAT. NO.

PART NO. 12478

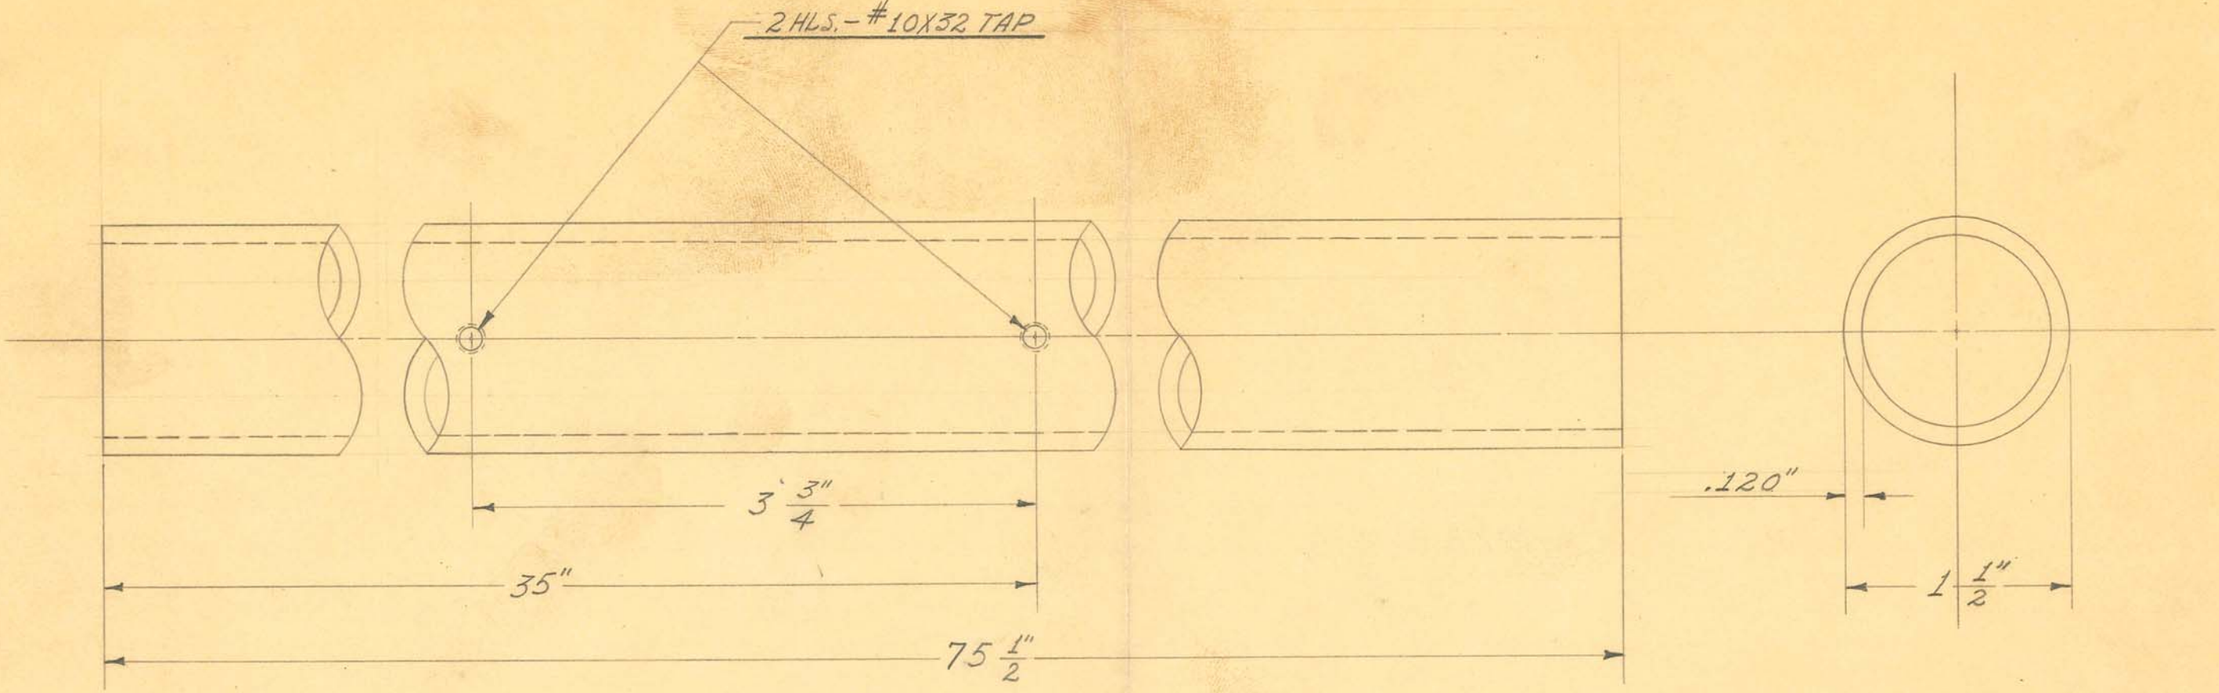

1 1/2" O.D. X #11 GA. SHELBY SEAMLESS STEEL TUBING

1 REQUIRED

OBSOLETE

SIZE		ISSUE 2-15-39	J.W.	TITLE: FISCHER LIGHT MOBILE STAND UPRIGHT TUBE - RIGHT
KIND		CHANGED		
SHAPE		"		
FINISH	CHROME #2	"		
TEMP.		"		H. G. FISCHER & CO. 2335 WABANSIA AVE. CHICAGO, ILL. — CAT. NO. — PART NO. 12486A
PATT.		"		

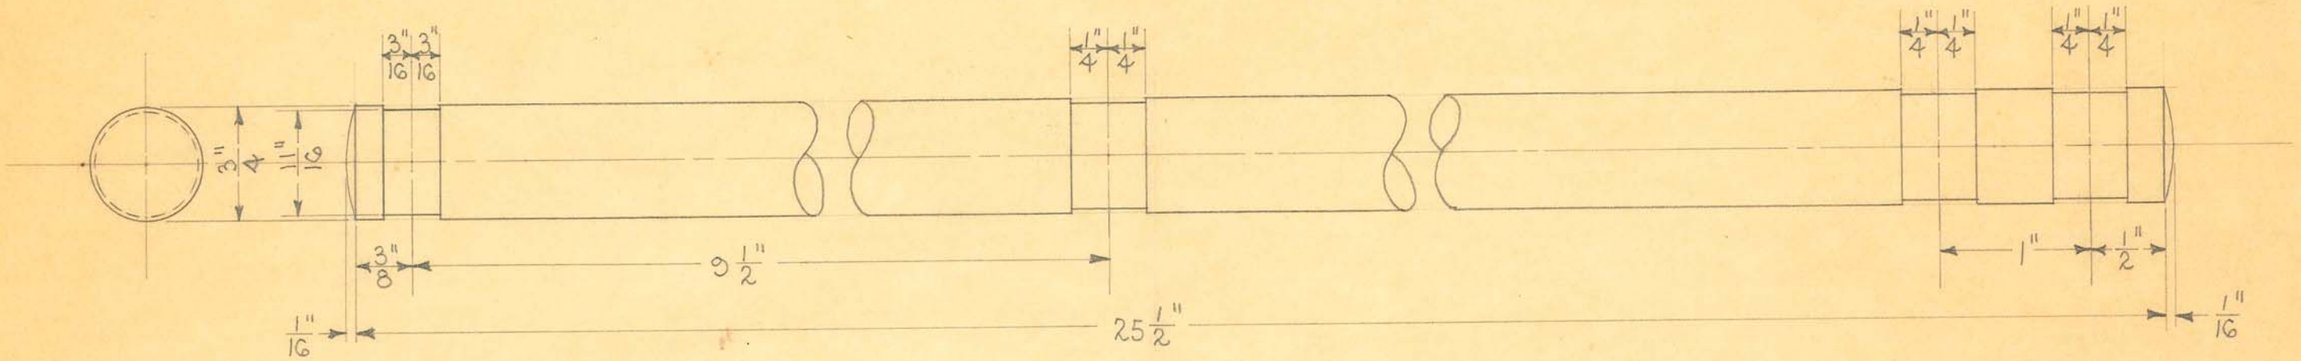

2 REQUIRED

OBSOLETE

SIZE	3/4" GROUND	ISSUE 3-21-34	A.E.
KIND	C.R. STEEL	CHANGED	
SHAPE		" "	
FINISH	CHROME POL.	" "	
TEMP.		" "	
PATT.		" "	

TITLE: FISCHER "D-S-GO" UNIT TUBE HEAD & SCREEN TIE ROD

H. G. FISCHER & CO.
2335 WABANSIA AVE.
CHICAGO, ILL.

CAT. NO.

PART NO. 8842

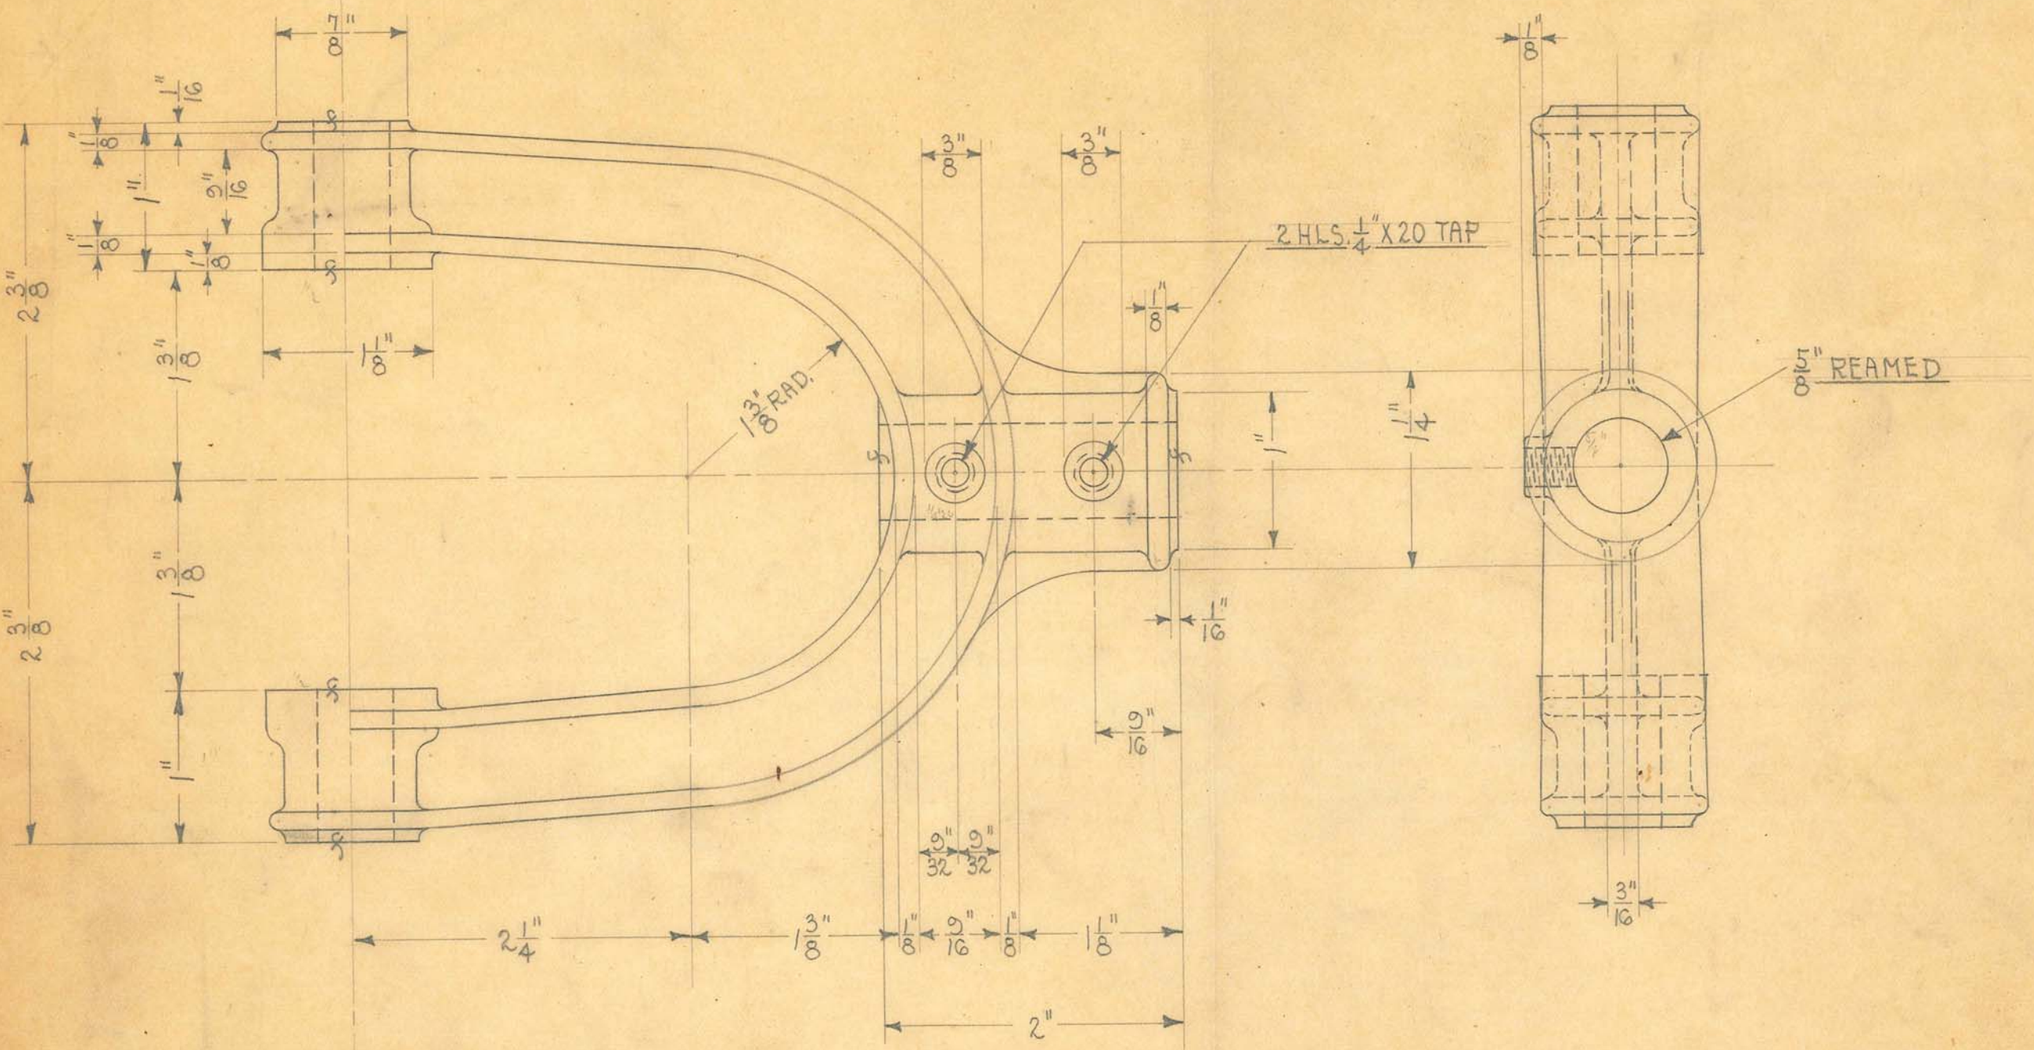

OBSOLETE

SIZE		ISSUE 12-27-33	W.E.
KIND	ALUM. CASTING	CHANGED	
SHAPE		" "	
FINISH	BLK. LACQUER	" "	
TEMP.		" "	
PATT.	7772-699	" "	

TITLE: FISCHER "D-S-GO" UNIT SCREEN FORK SWIVEL

H. G. FISCHER & CO.
2335 WABANSIA AVE.
CHICAGO, ILL.

CAT. NO.

PART NO. 8844F

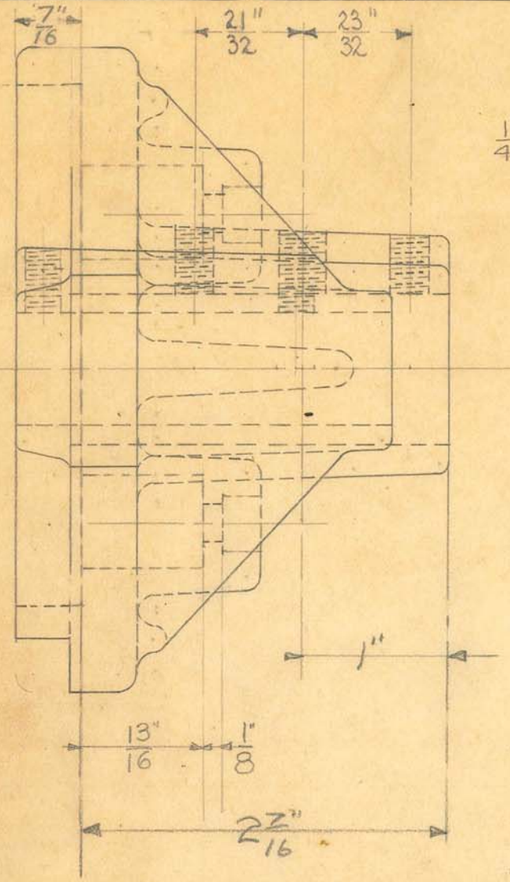

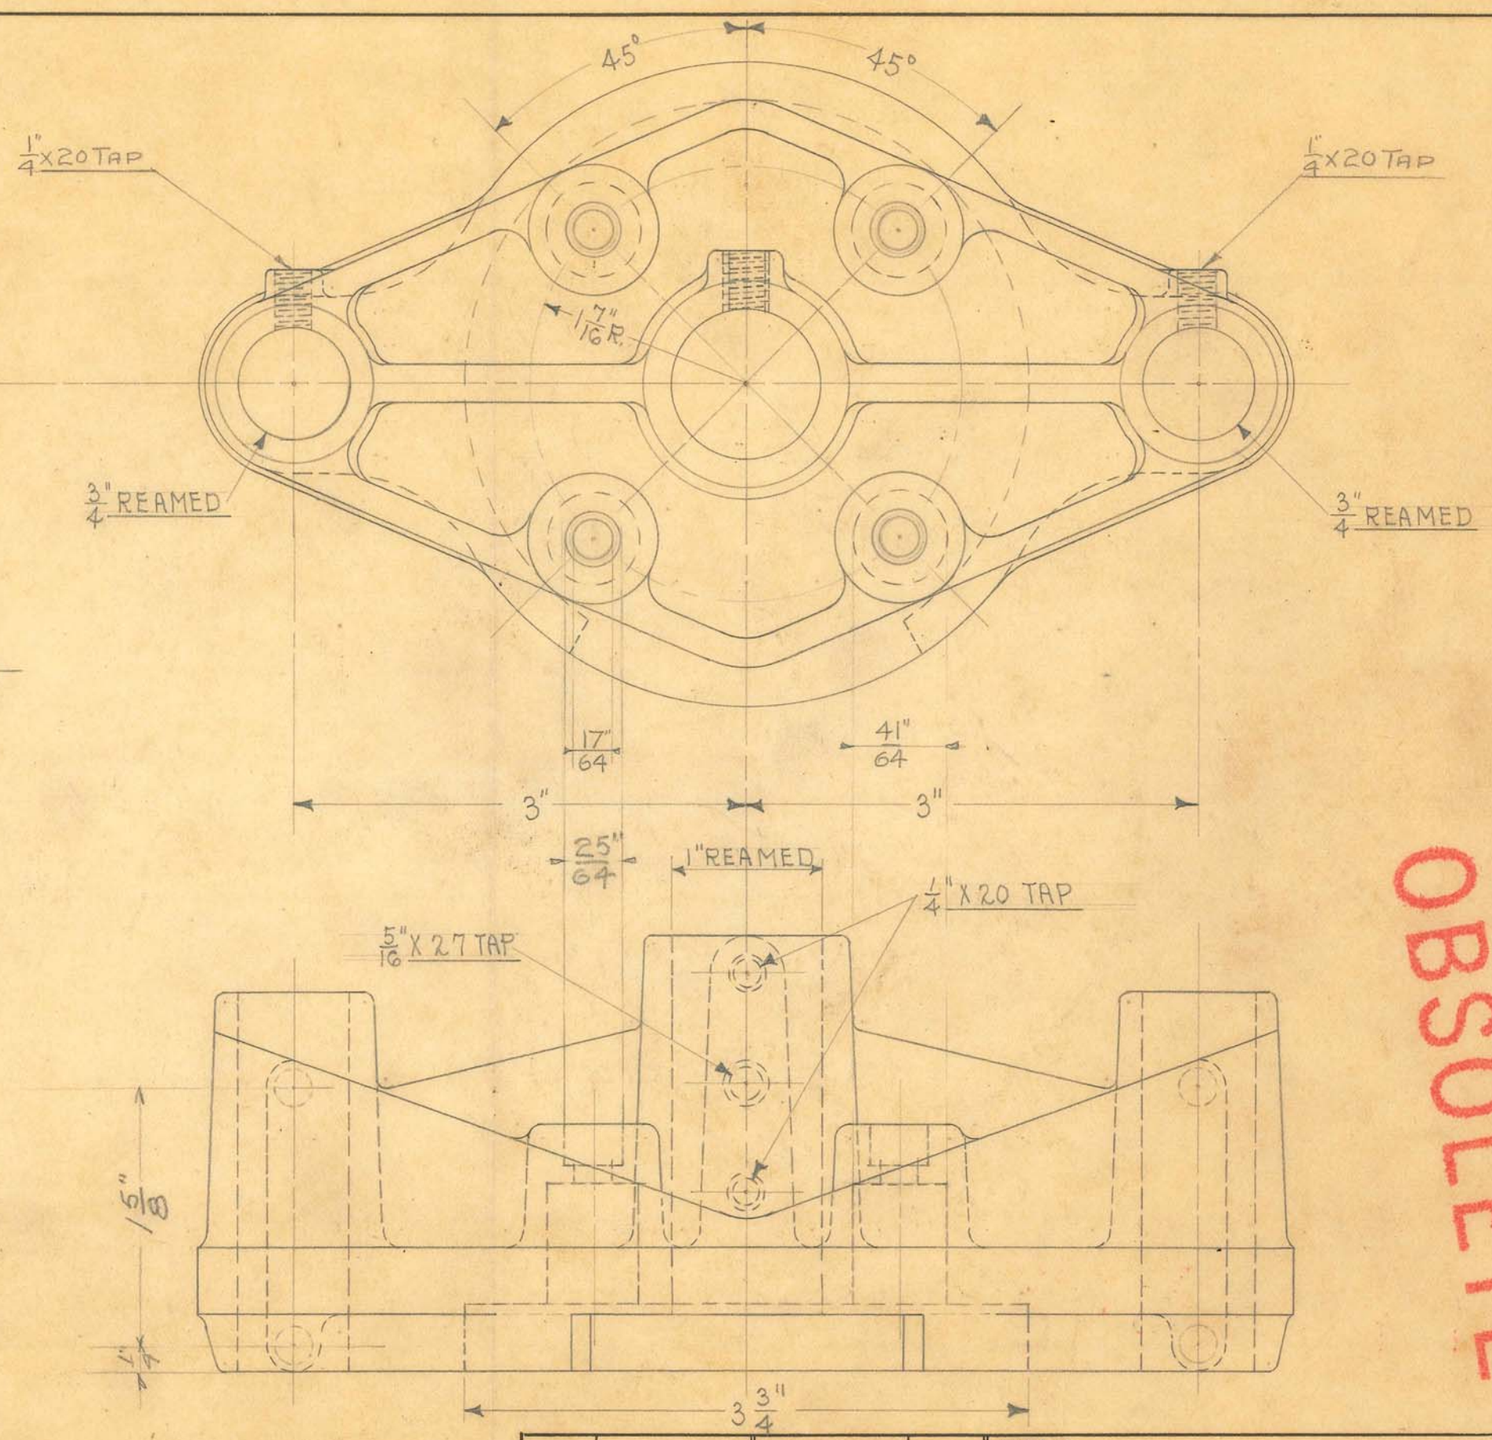

OBSOLETE

SIZE		ISSUE	
KIND	ALUM. CASTING	CHANGED	
SHAPE		" "	
FINISH		" "	
TEMP.		" "	
PATT.	8321-710	" "	

TITLE: FISCHER "D-S-GO" UNIT
TUBE HEAD SWIVEL

H. G. FISCHER & CO.
2335 WABANSIA AVE.
CHICAGO, ILL.

CAT. NO.

PART NO. 8857F

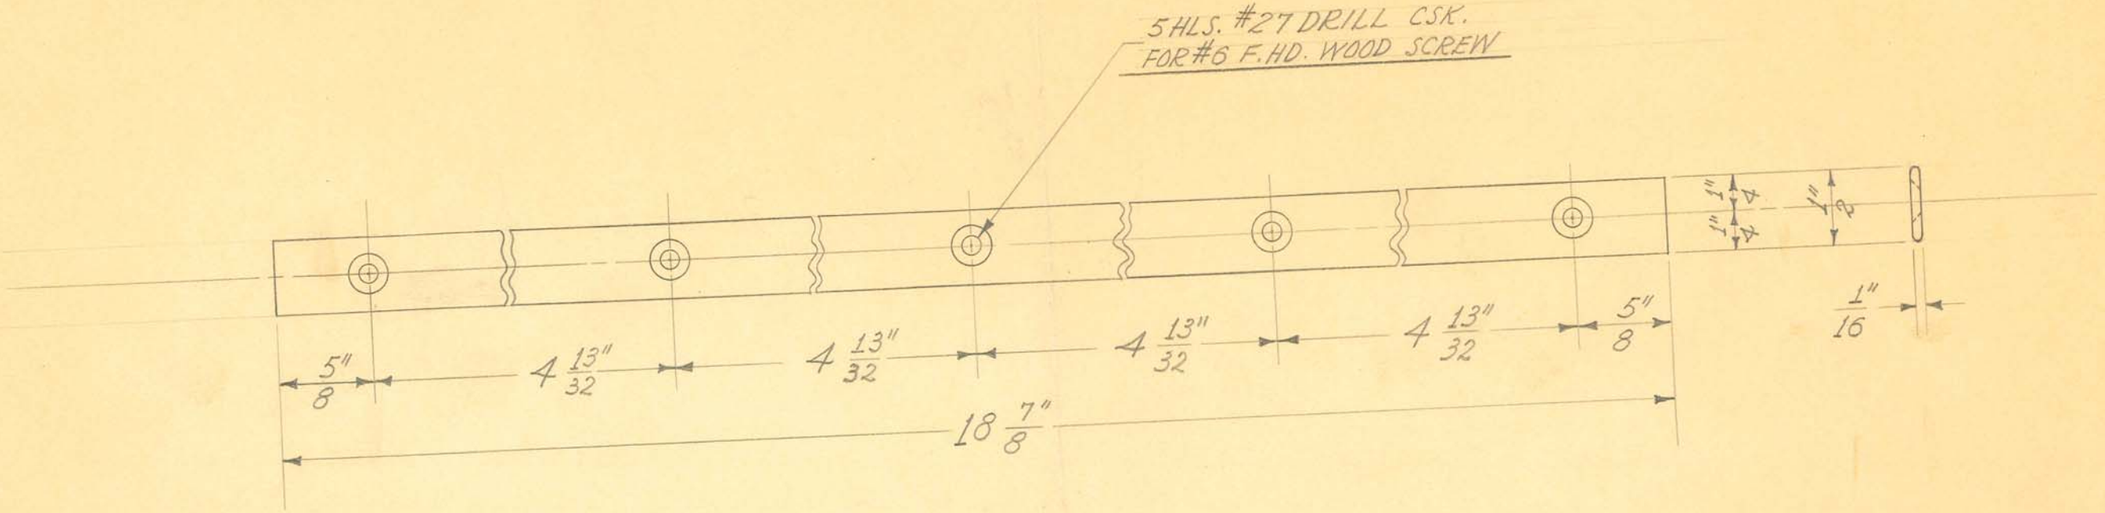

2 REQUIRED

OBSOLETE

SIZE	1/2" X 1/16"	ISSUE 12-14-37	J.W.	TITLE: FISCHER "14X17" FILM STORAGE CABINET -DOOR SIDE STRIP
KIND	FLAT WIRE	CHANGED		
SHAPE		"		
FINISH		"		
TEMP.		"		
PATT.		"		

H. G. FISCHER & CO.
2335 WABANSIA AVE.
CHICAGO, ILL.

CAT. NO.

PART NO. 1789

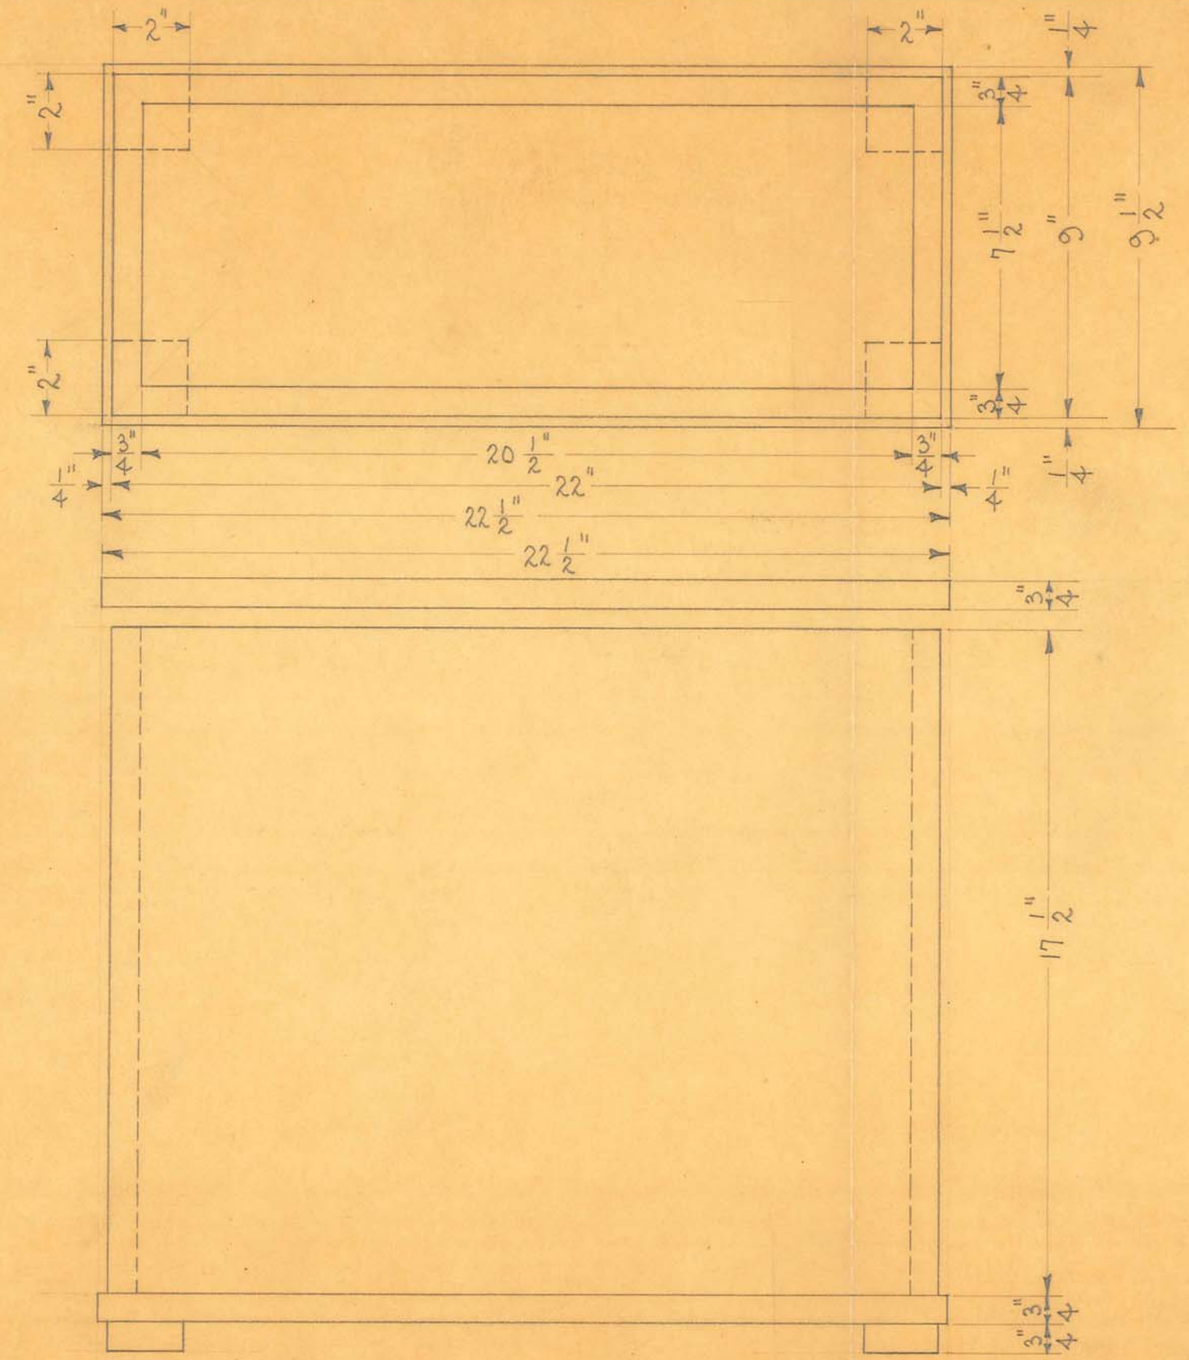

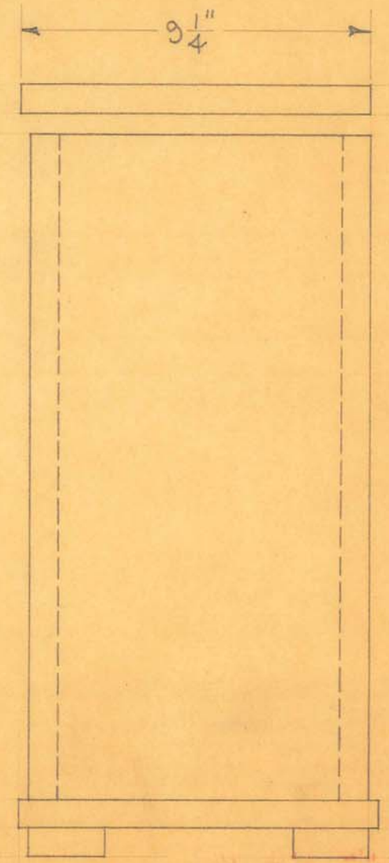

SCALE ~ 1/4" = 1"

SIZE		ISSUE 3-26-35	A.E.
KIND	BIRCH	CHANGED	
SHAPE		" "	
FINISH		" "	
TEMP.		" "	
PATT.		" "	

TITLE: 14" X 17" LEAD LINED BOX

OBSOLETE

H. G. FISCHER & CO.
2335 WABANSIA AVE.
CHICAGO, ILL.

CAT. NO.

PART NO. 1790A

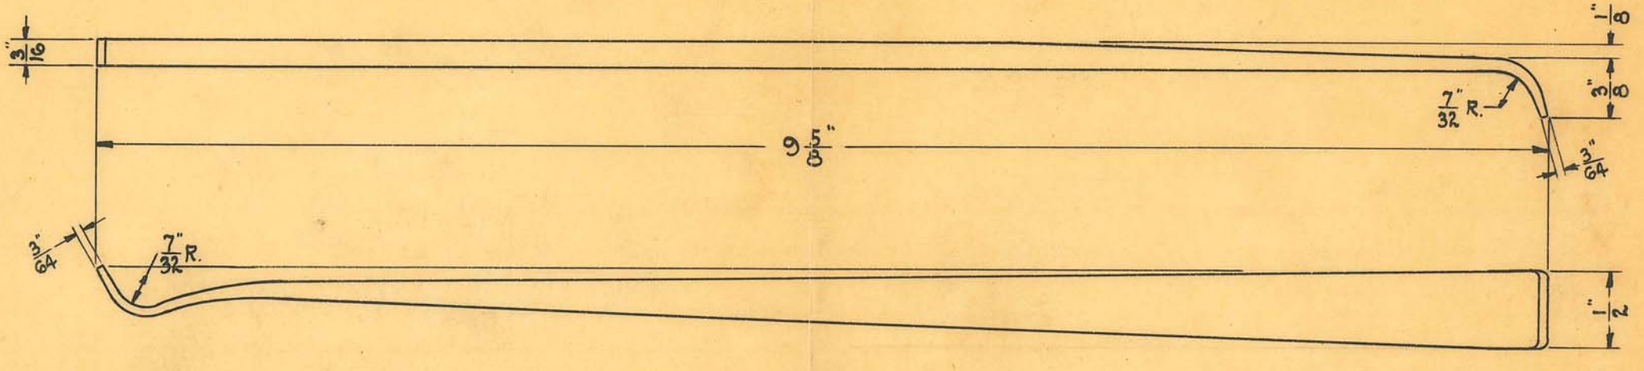

CUT 10 1/4" LONG

SIZE	3/16"	ISSUE	H.E.	4-22-30
KIND	POL. SHEET RUBBER	CHANGED		
SHAPE	SHEET	"	"	
FINISH		"	"	
TEMP.		"	"	
PATT.		"	"	

TITLE: BRADY PILLAR RETRACTOR

OBSOLETE

H. G. FISCHER & CO.
2335 WABANSIA AVE.
CHICAGO, ILL.

CAT. NO.

PART NO. 2789A

2789A

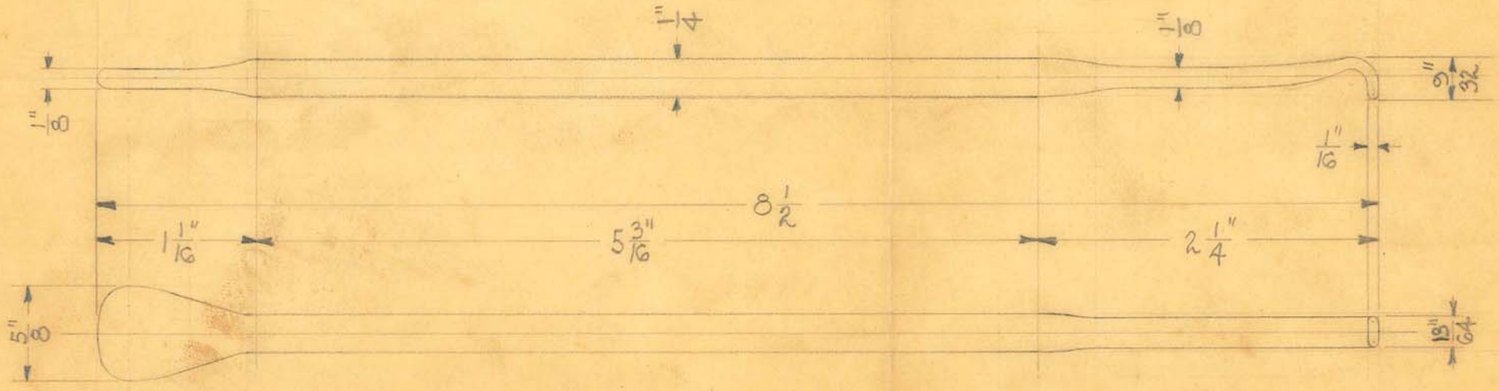

OBSOLETE

SIZE		ISSUE 10-29-30	A.E.	TITLE: PILLAR RETRACTOR
KIND	PYREX GLASS	CHANGED		
SHAPE		" "		
FINISH		" "		
TEMP.		" "		H. G. FISCHER & CO. 2335 WABANSIA AVE. CHICAGO, ILL. — CAT. NO. — PART NO. 2780 1/2
PATT.		" "		

1/2 2780 1/2

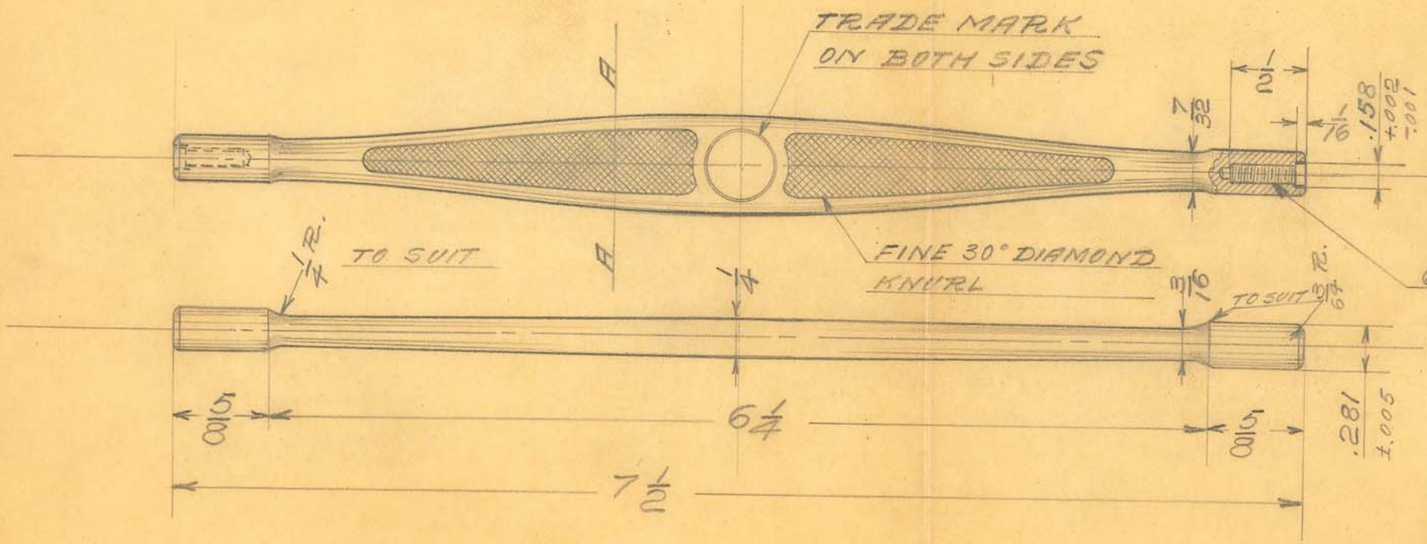

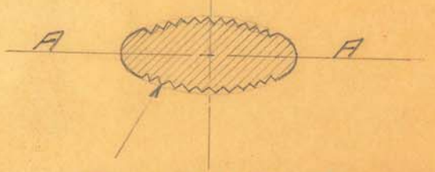

ENLARGED SECTIONAL VIEW SHOWING HOW THE TOP OF THE KNURL SHOULD BE EVEN WITH THE CONTOUR OF THE BODY

SIZE		ISSUE 3-4-31	E.H.	TITLE: PILLAR RETRACTOR HANDLE OBSOLETE
KIND		CHANGED		
SHAPE		" "		
FINISH		" "		
TEMP.		" "		H. G. FISCHER & CO. 2335 WABANSIA AVE. CHICAGO, ILL. — CAT. NO. — PART NO. 2789 3/4
PATT.		" "		

2789A

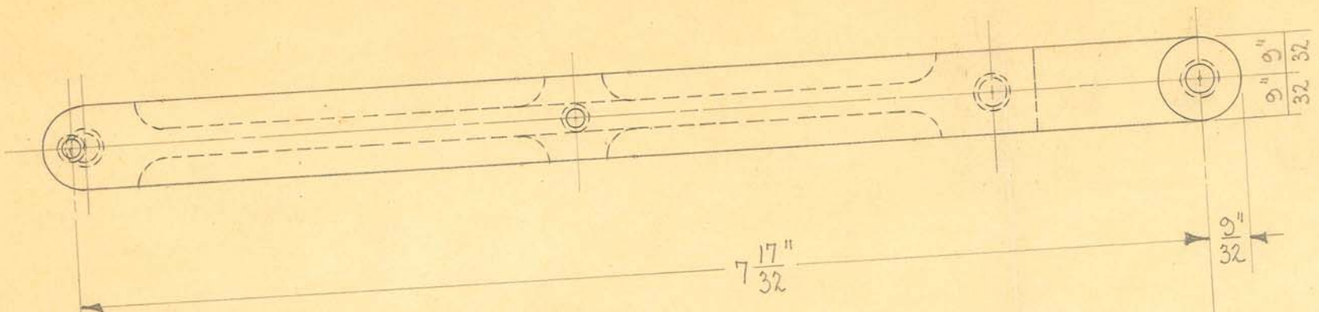

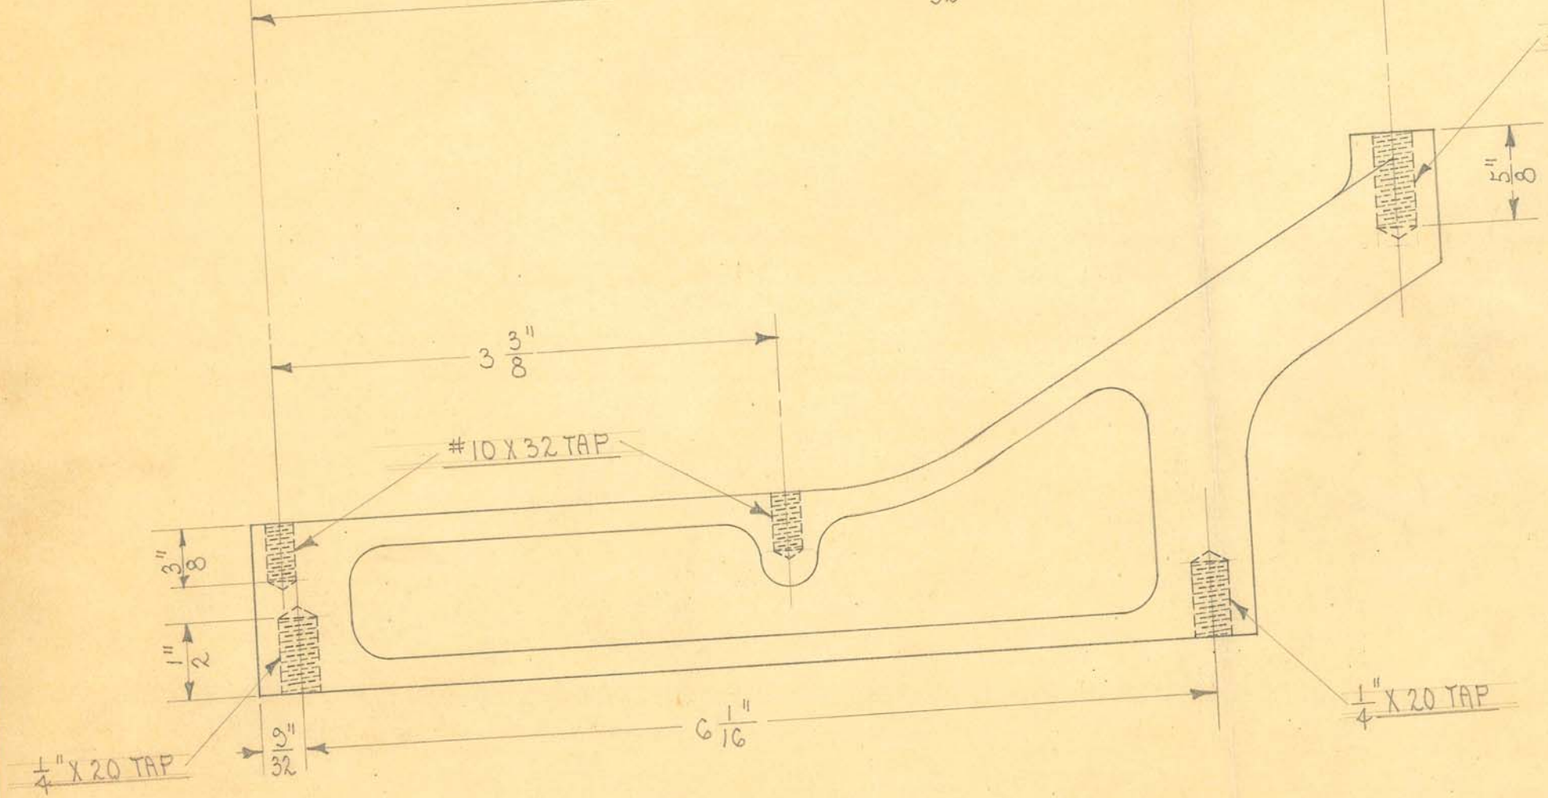

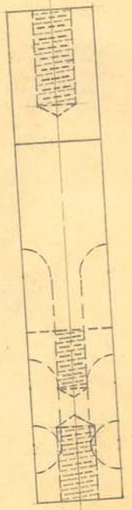

2 REQUIRED

OBSOLETE

SIZE		ISSUE 1-8-35	A.C.	TITLE: PORTABLE SHOCKPROOF X-RAY TRANSFORMER SUPPORT
KIND	ALUM. CASTING	CHANGED		
SHAPE		" "		
FINISH		" "		H. G. FISCHER & CO. 2335 WABANSIA AVE. CHICAGO, ILL. — CAT. NO. — PART NO. 9241F
TEMP.		" "		
PATT.	2967-758	" "		

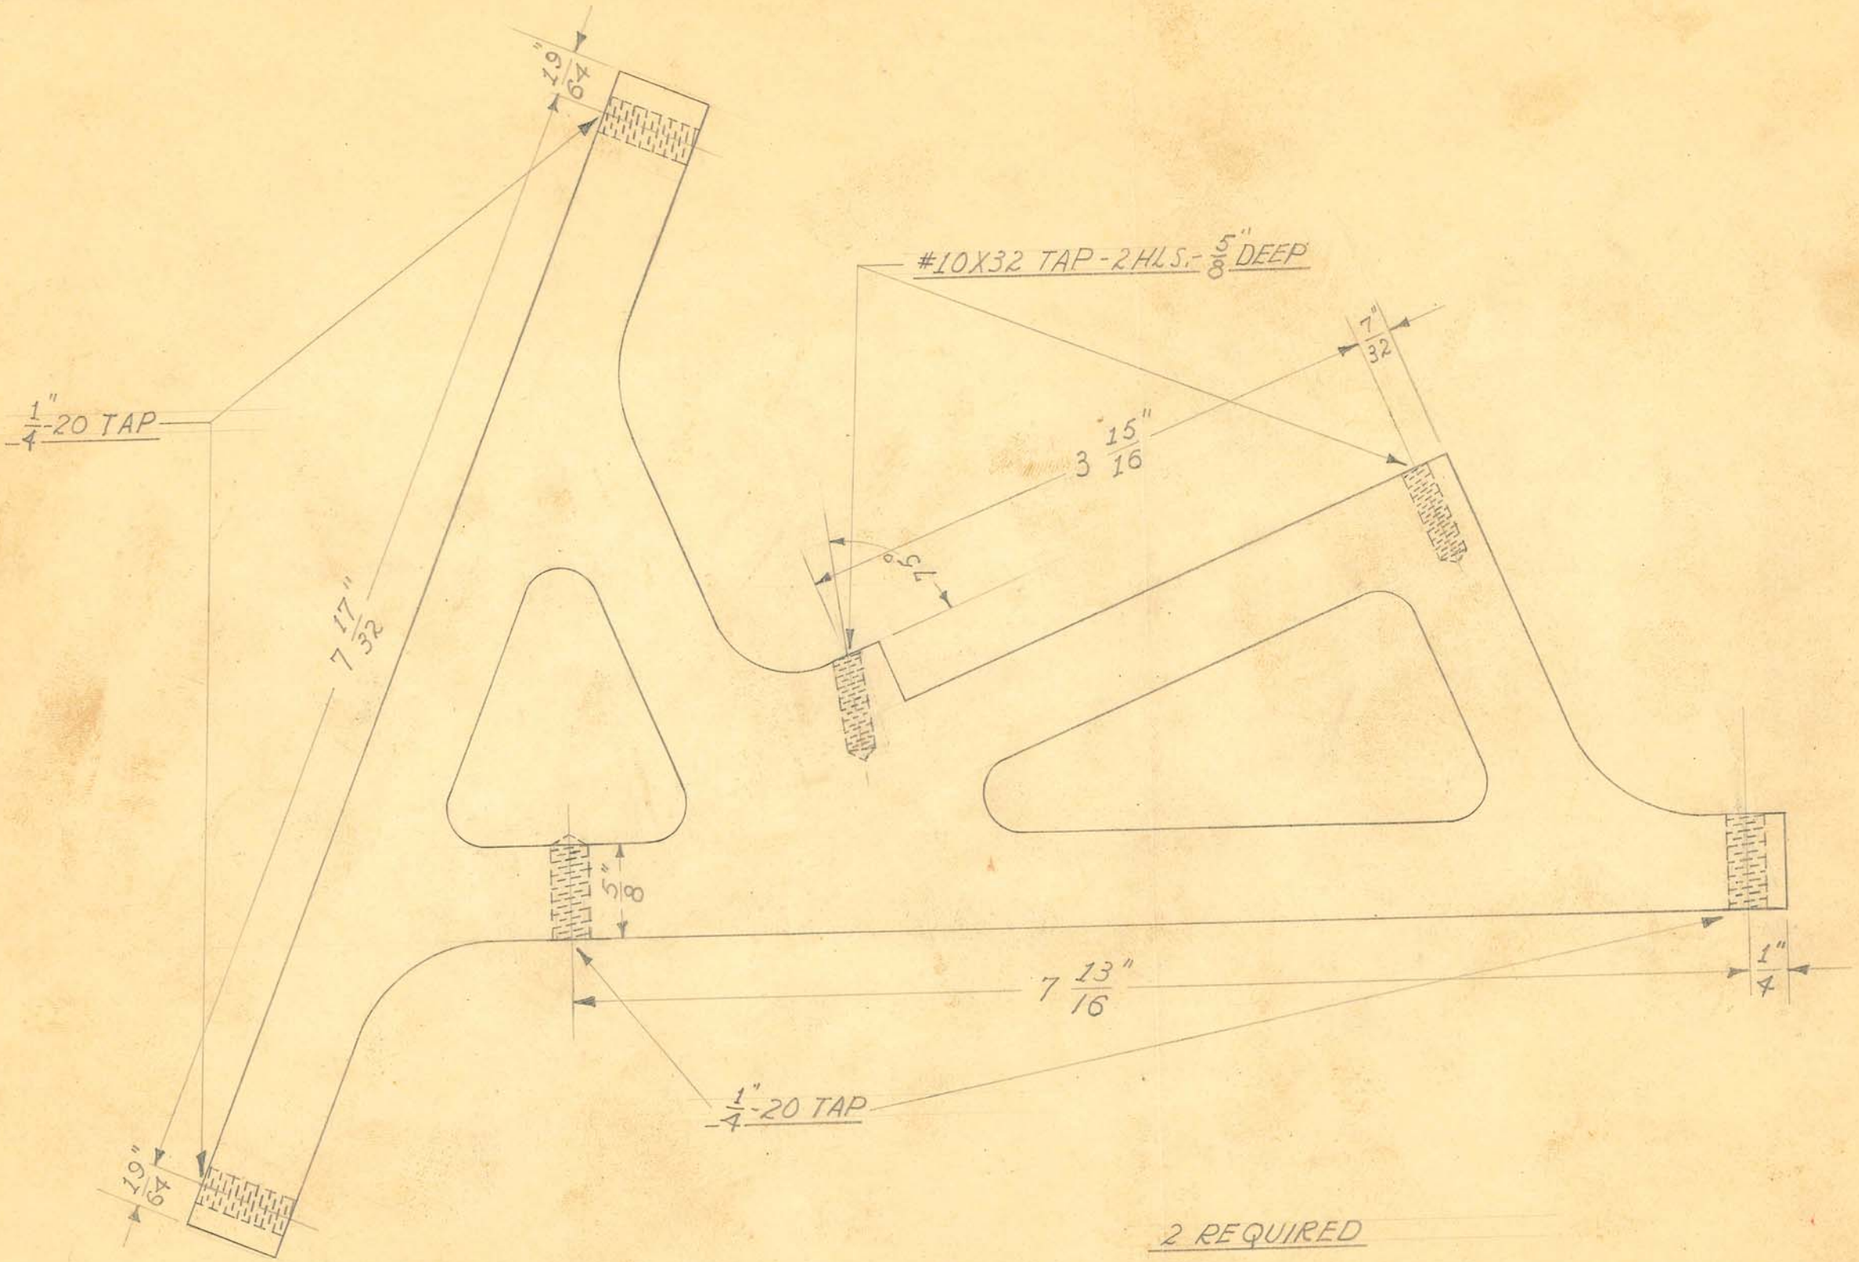

2 REQUIRED

SIZE		ISSUED 8-24-36	J.W.
KIND		CHANGED	
SHAPE		"	
FINISH		"	
TEMP.		"	
	1166-273	"	

TITLE: 25 CYCLE "DSP-20" HIGH TENSION TRANSFORMER SUPPORT

OBSOLETE

H. G. FISCHER & CO.
2335 WABANSIA AVE.
CHICAGO, ILL.

CAT. NO.

PART NO. 9241 1/2 F

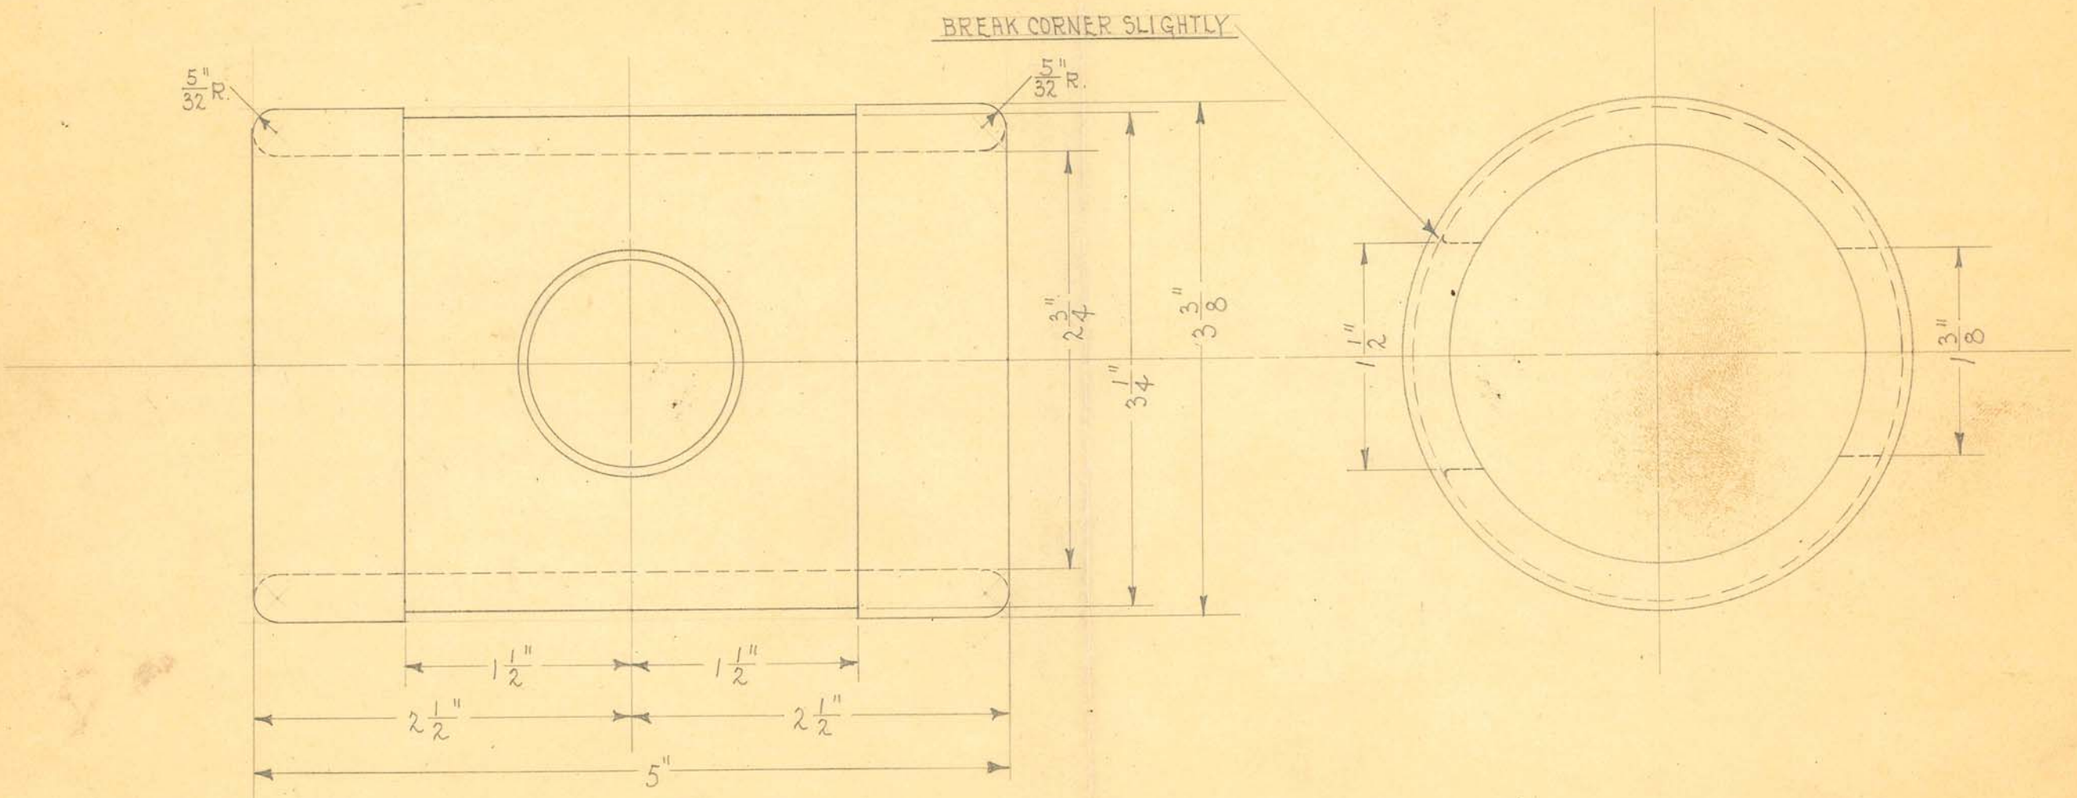

1 REQUIRED

OBSOLETE

SIZE	2 3/4" I.D X 3 3/8" O.D.	ISSUE 12-20-34	A.E.	TITLE: PORTABLE SHOCKPROOF X-RAY TUBE SHIELD TUBE
KIND	NAT. BAKELITE	CHANGED		
SHAPE	TUBING	" "		
FINISH		" "		
TEMP.		" "		
PATT.		" "		

H. G. FISCHER & CO.
2335 WABANSIA AVE.
CHICAGO, ILL.

CAT. NO.

PART NO. 9255

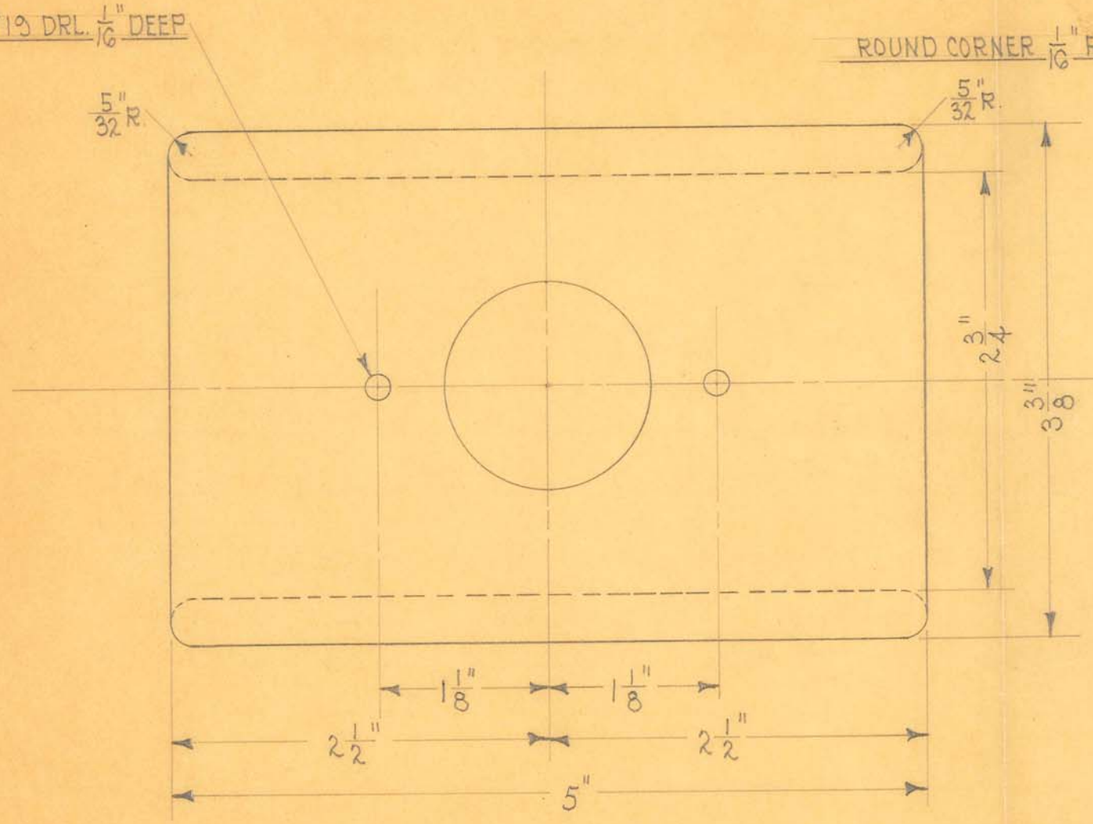

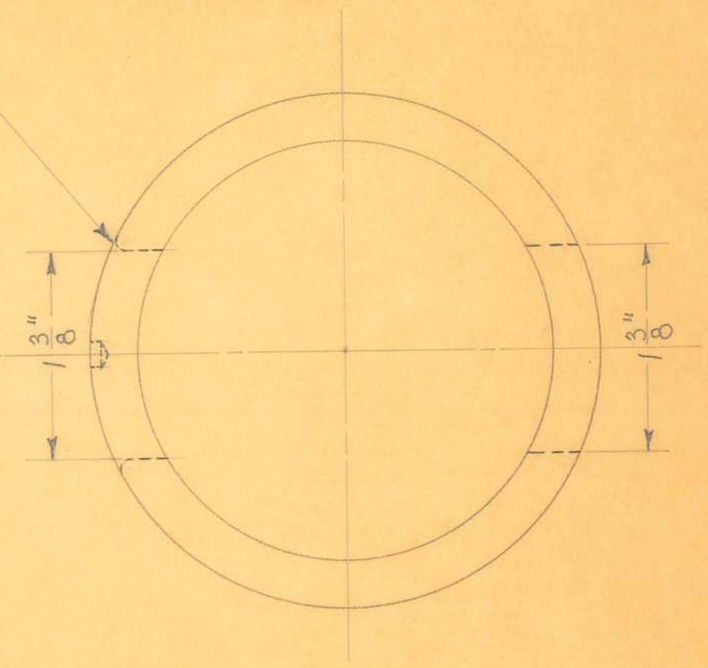

1 REQUIRED

OBSOLETE

SIZE	2 3/4" I.D X 3 3/8" OD	ISSUE 7-3-35	A.E.
KIND	LITHARGE IMP.	CHANGED	
SHAPE	BAKELITE TUBING	" "	
FINISH		" "	
TEMP.		" "	
PATT.		" "	

TITLE: FISCHER "DSP-20" TUBE SHIELD TUBE

H. G. FISCHER & CO.
2335 WABANSIA AVE.
CHICAGO, ILL.

CAT. NO.

PART NO. 9255A

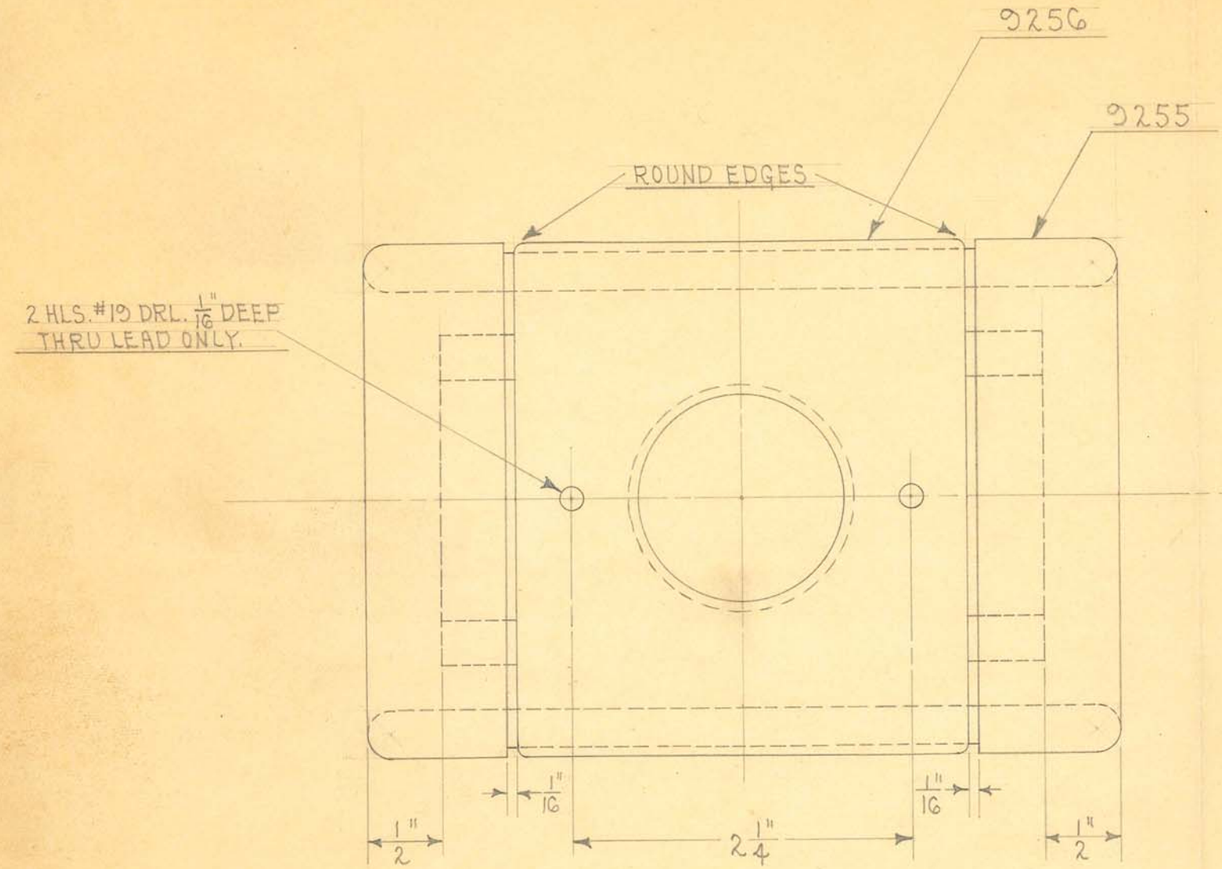

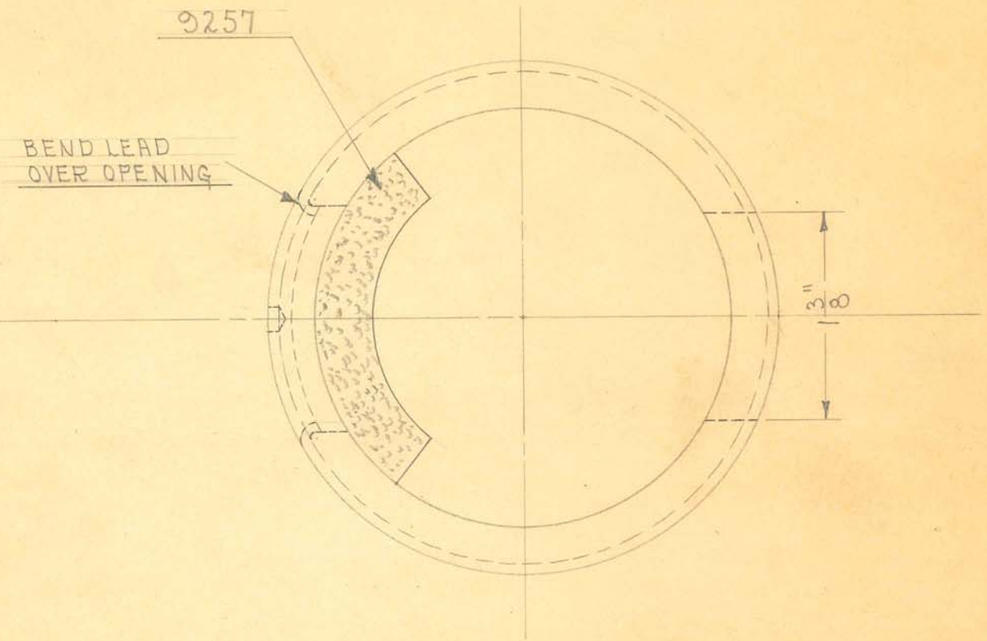

NOTES

PLACE LEAD STRIP WITH HOLE OVER 1½" HOLE & BEND LEAD OVER OPENING. SOLDER & THEN CUT OUT 1⅜" HOLE.
CUT A 1/16" GROOVE ON EACH SIDE OF LEAD 1/16" DEEP & ROUND EDGES OF LEAD. DRILL #19 DRL. HOLES AS SHOWN.
GLUE CORK STRIPS ½" FROM EACH END AS SHOWN.

1 REQUIRED

OBSOLETE

SIZE		ISSUE 12-20-34	J.E.	TITLE: PORTABLE SHOCK PROOF X-RAY TUBE SHIELD
KIND		CHANGED		
SHAPE		" "		
FINISH		" "		
TEMP.		" "		H. G. FISCHER & CO. 2335 WABANSIA AVE. CHICAGO, ILL. — CAT. NO. — PART NO. 9255G
PATT.		" "		

9255A

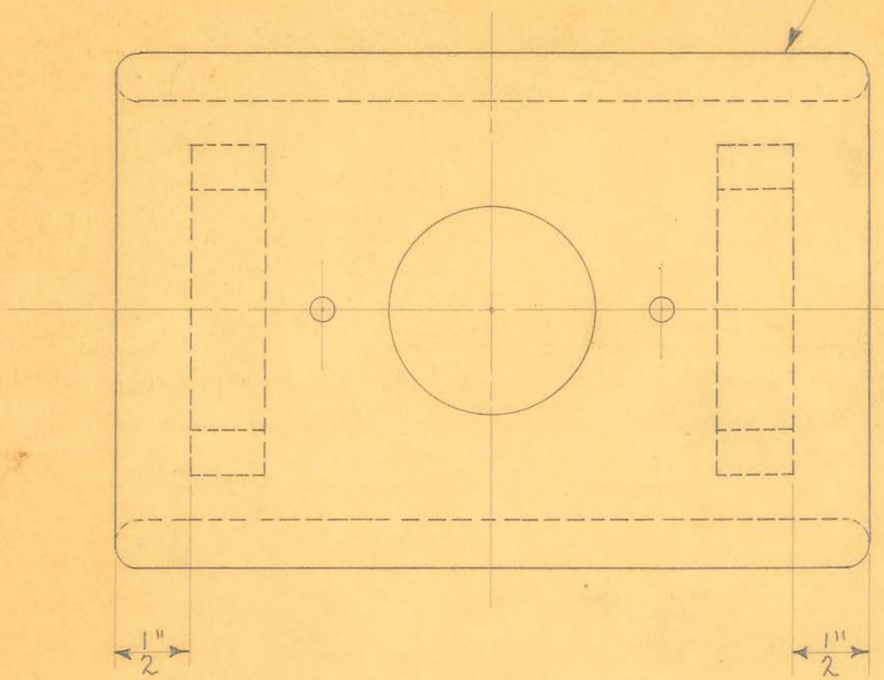

9257B

5030 $\frac{1}{2}$ – $\frac{1}{16}$" SHEET FELT GLUED TO BAKELITE STRIPS

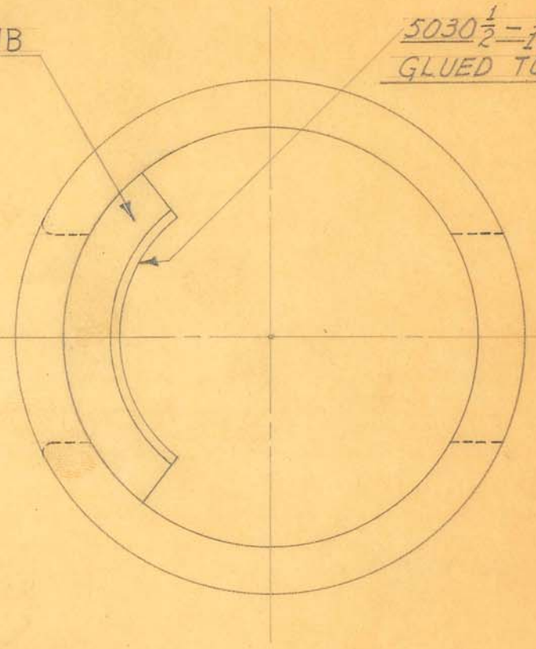

BAKELITE
GLUE ~~SUPER~~ STRIPS $\frac{1}{2}$" FROM EACH END AS SHOWN.

NOTE

1 REQUIRED

OBSOLETE

SIZE		ISSUE 7-3-35	J.E.	TITLE: FISCHER "DSP-20" TUBE SHIELD
KIND		CHANGED 12-29-36	J.W.	
SHAPE		" "		
FINISH		" "		
TEMP.		" "		H. G. FISCHER & CO. 2335 WABANSIA AVE. CHICAGO, ILL. — CAT. NO. — PART NO. 9255GB
PATT.		" "		

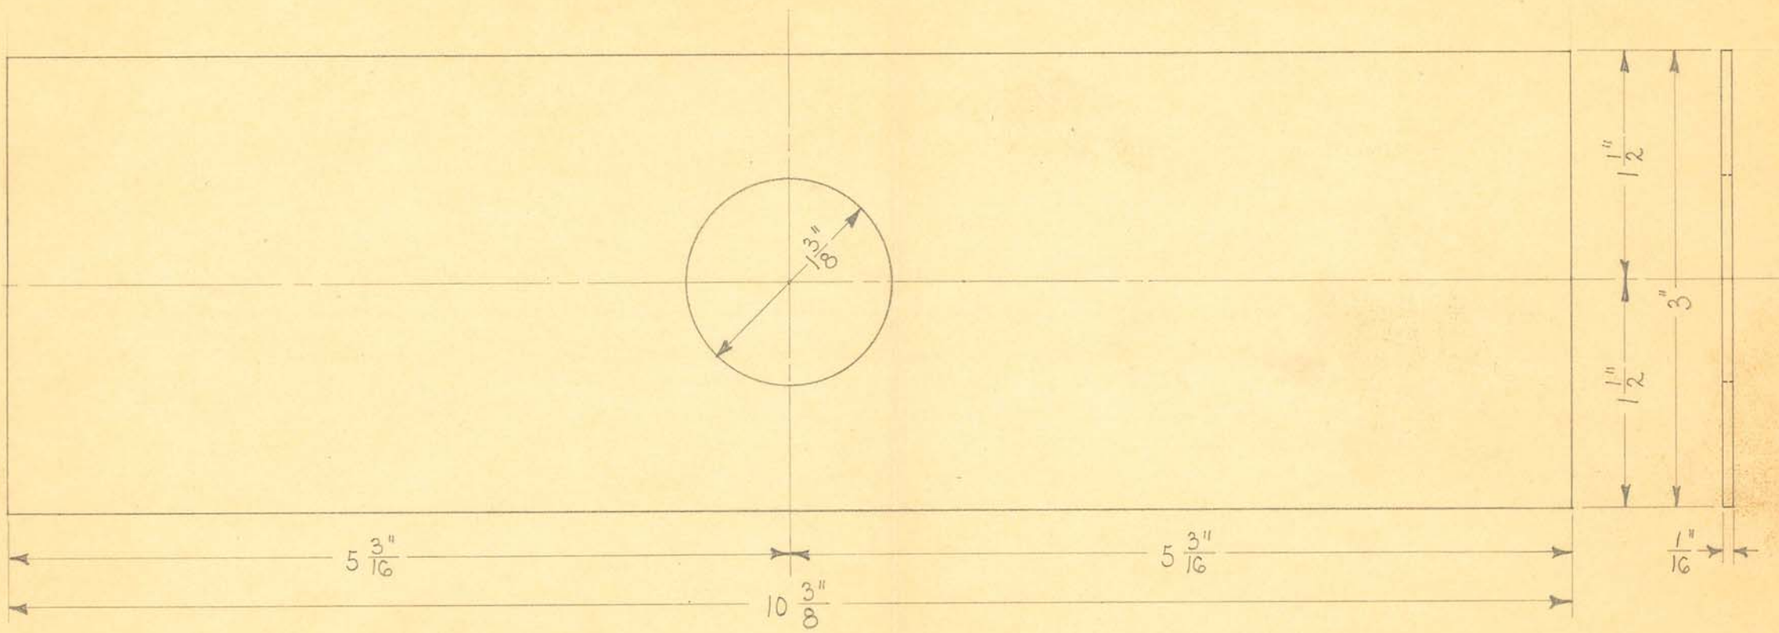

1 REQUIRED

OBSOLETE

SIZE	1/16"	ISSUE 12-20-34	J.E.	TITLE: PORTABLE SHOCKPROOF X-RAY TUBE SHIELD LEAD PROTECTOR
KIND	SHEET LEAD	CHANGED		
SHAPE		" "		
FINISH		" "		
TEMP.		" "		
PATT.		" "		

H. G. FISCHER & CO.
2335 WABANSIA AVE.
CHICAGO, ILL.

CAT. NO.

PART NO. 9256

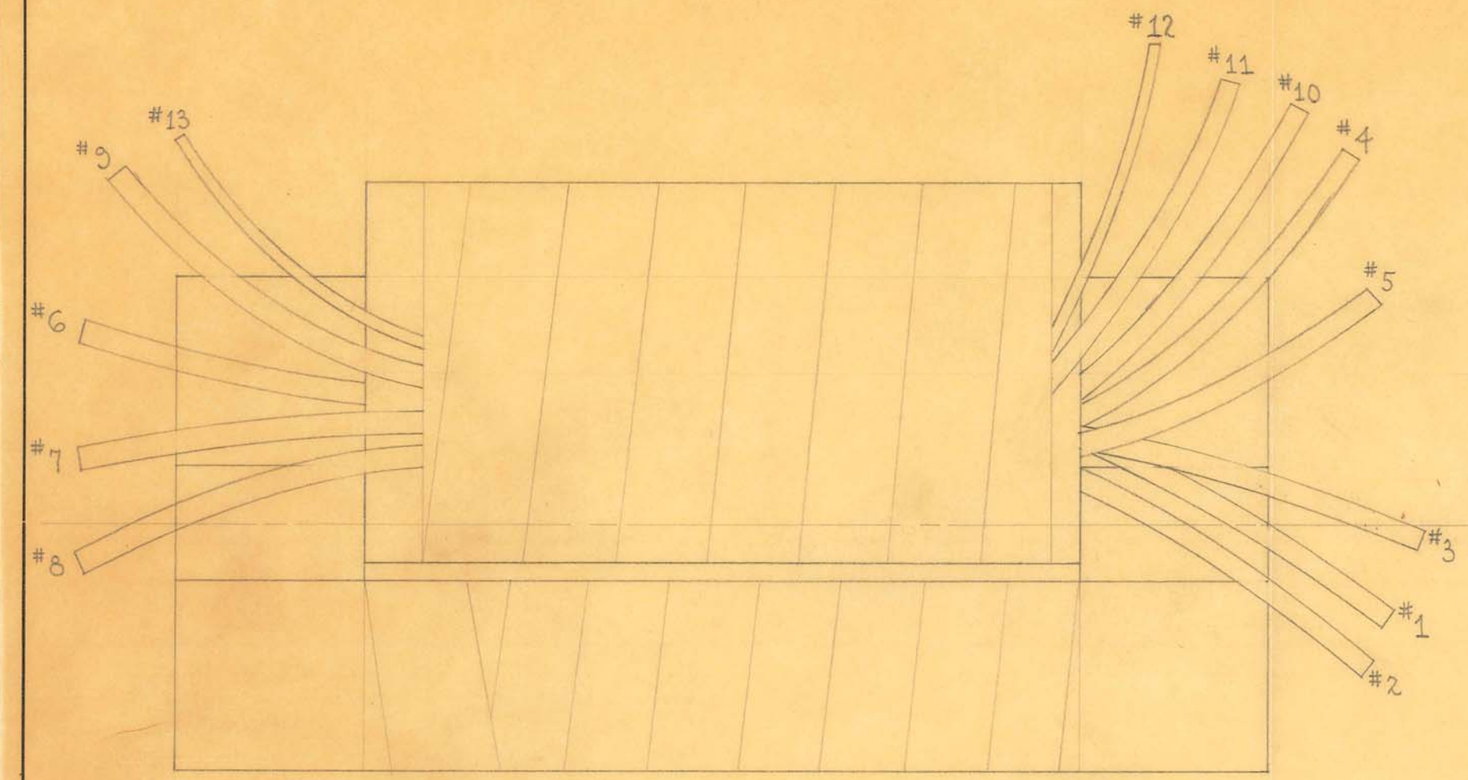

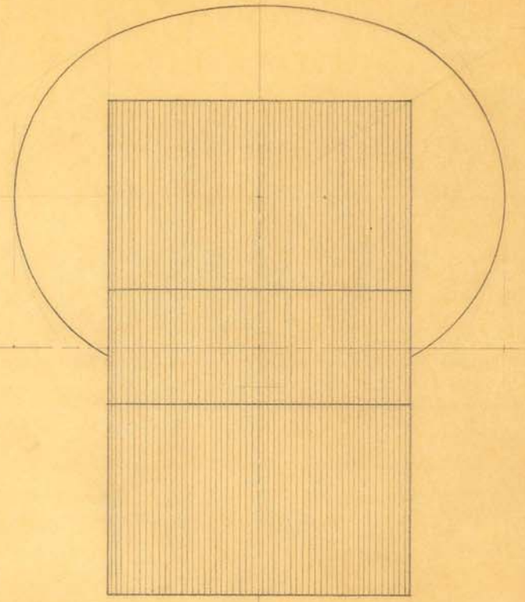

STEEL SIZES

PC. NO. 5043

2 □ CORES LAMS. CUT 6"X1¼" BUILT UP TO 2". END PIECES CUT 2"X1¼". BIND CORES WITH ¾" FRICTION TAPE.

WINDING DATA

WIND 3 LAYERS OF HEAVY WRAPPING PAPER ON ONE CORE. THEN PUT ON 3 LAYERS OF 502G¾ OILED CLOTH. USE #16 COTENAMEL WIRE. ANCHOR LEAD #1 WITH FRICTION TAPE (LEADS #1-#11 INCL. ARE EACH 18" OF 1671 ASBESTOS COVERED WIRE) AND WIND 116 TURNS, PLACING 1 LAYER OF 502G¾ OILED CLOTH BETWEEN EACH LAYER OF WIRE. USE #14 COTENAMEL WIRE. SPLICE START OF #14 C.E. WIRE TO END OF #16 C.E. WIRE AND BRING OUT TAP #2. WIND 15 TURNS & BRING OUT TAP #3.
WIND 15 TURNS & BRING OUT TAP #4.
" 15 " " " " " #5.
" 15 " " " " " #6.
" 15 " " " " " #7.
" 15 " " " " " #8.
" 15 " " " " " #9.
" 10 " " " " " #10.
" 10 " " ANCHOR END WITH FRICTION TAPE - LEAD #11. 1 LAYER OF 502G¾ BETWEEN EACH LAYER OF WIRE. USE #22 COTENAMEL WIRE. ANCHOR LEAD #12 WITH FRICTION TAPE ALONG SIDE OF LEAD #11 (LEADS #12 & 13 ARE 18" EACH OF 1648 WEATHERPROOF WIRE) AND WIND 36 TURNS AND ANCHOR END WITH FRICTION TAPE - LEAD #13. COVER WITH 5004¼ OILED TAPE & SHELLAC.

OBSOLETE

SIZE		ISSUE 12-16-35	J.E.
KIND		CHANGED	
SHAPE		" "	
FINISH		" "	
TEMP.		" "	
PATT.		" "	

TITLE: FISCHER "DSP-20" AUTO TRANSFORMER

H. G. FISCHER & CO.
2335 WABANSIA AVE.
CHICAGO, ILL.

CAT. NO.

PART NO. 9270G

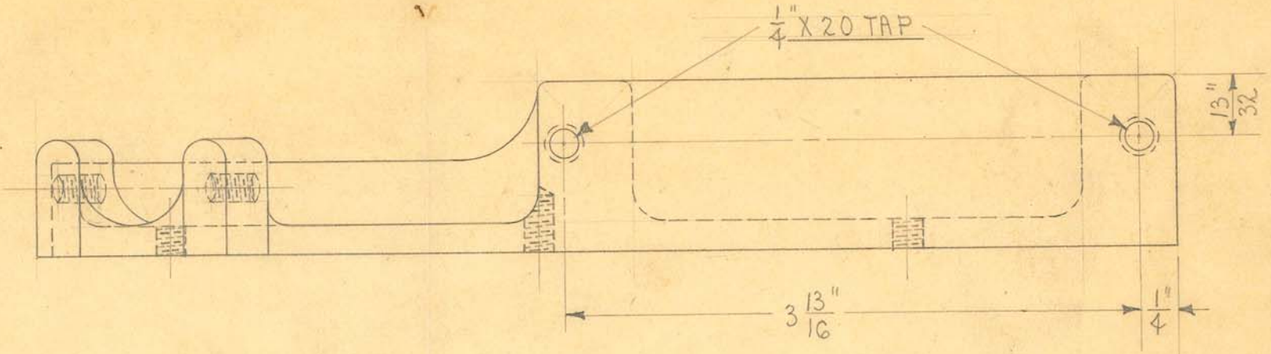

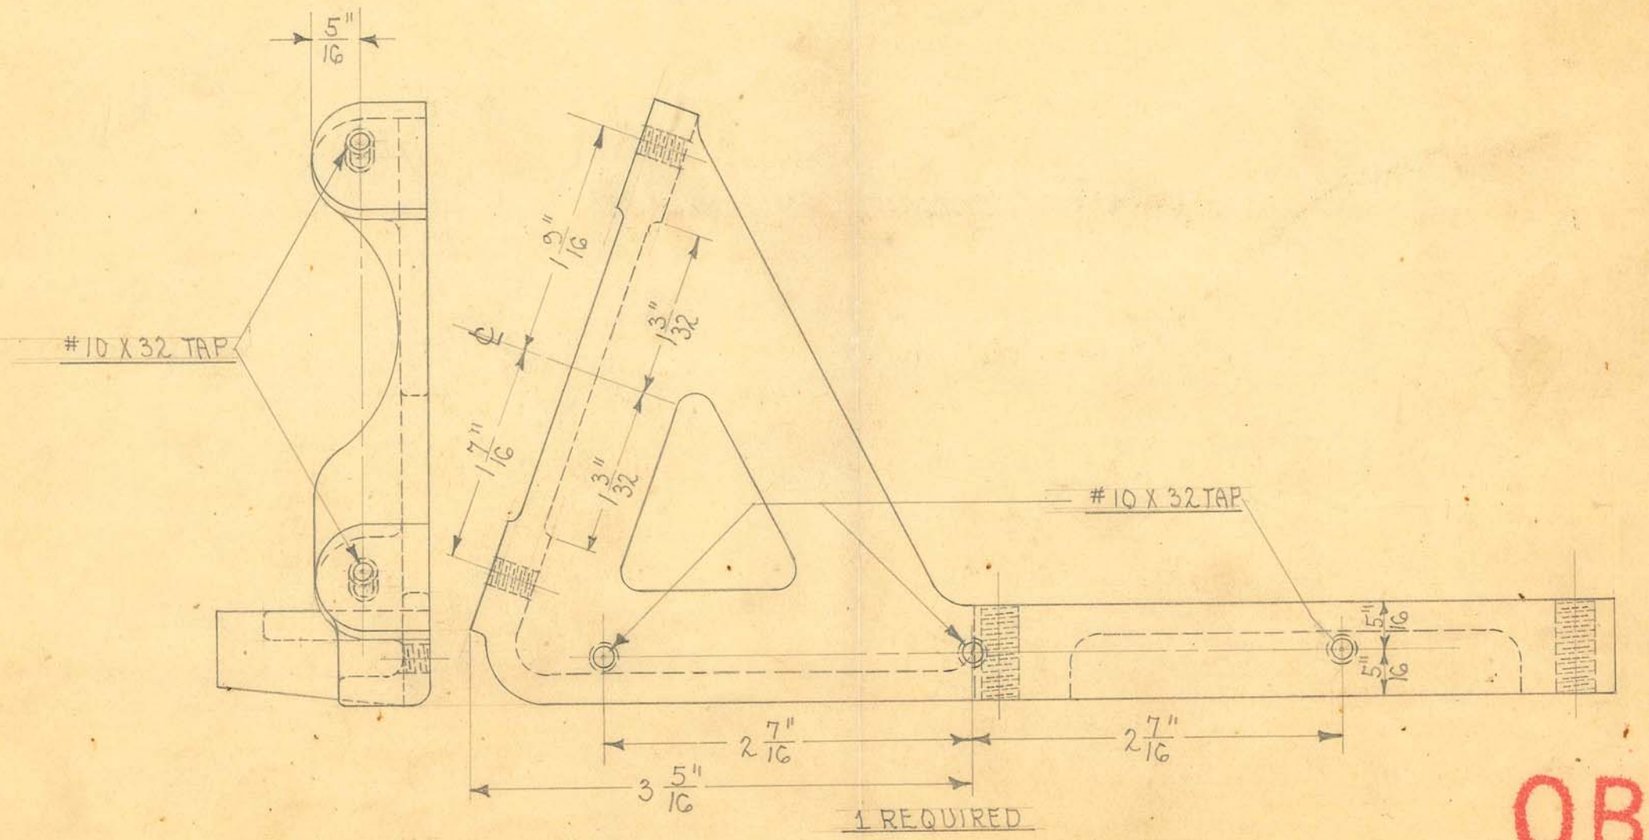

OBSOLETE

SIZE		ISSUE 12-1-34	D.E.
KIND	ALUM. CASTING	CHANGED	
SHAPE		" "	
FINISH		" "	
TEMP.		" "	
PATT.	4450-780	" "	

TITLE: PORTABLE SHOCKPROOF X-RAY AUTO TRANSFORMER SUPPORT - LEFT

H. G. FISCHER & CO.
2335 WABANSIA AVE.
CHICAGO, ILL.

CAT. NO.

PART NO. 9272F

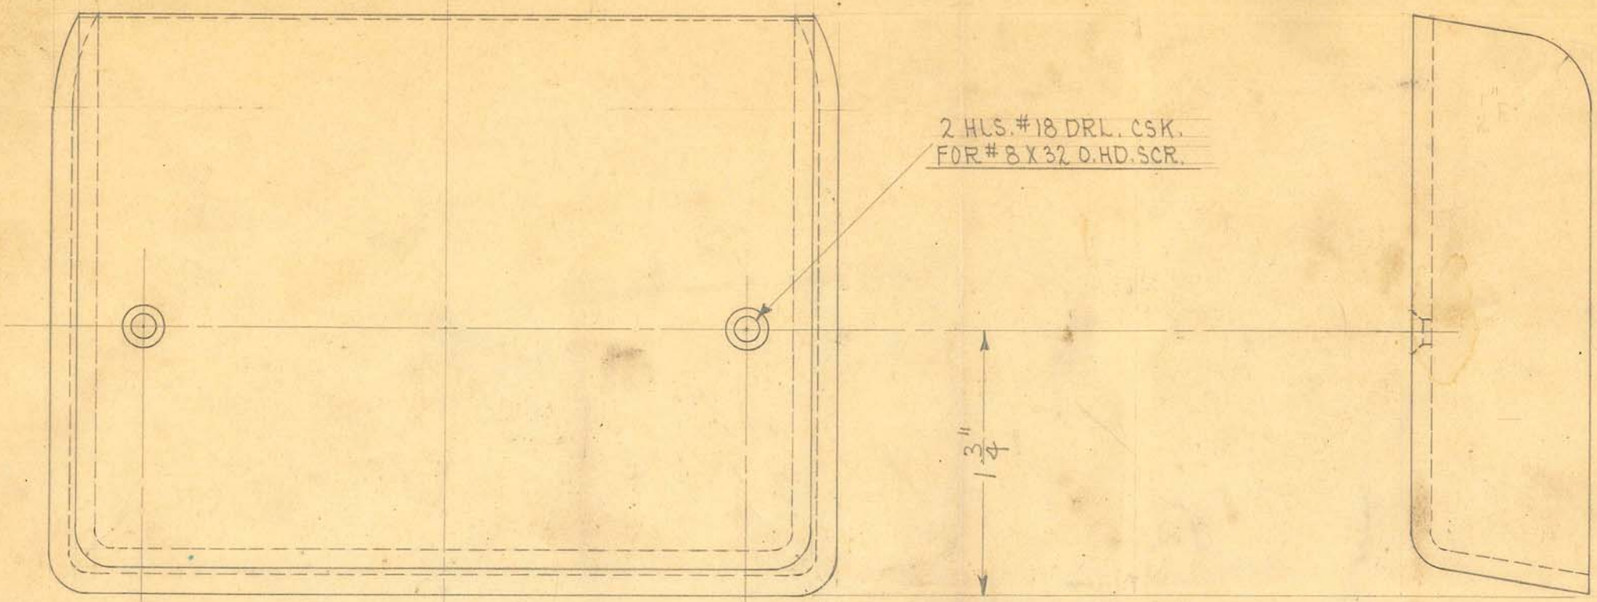

1 REQUIRED

OBSOLETE

SIZE		ISSUE 12-29-34	A.E.
KIND	ALUM. CASTING	CHANGED	
SHAPE		" "	
FINISH	BLACK # 60	" "	
TEMP.		" "	
PATT.	5851-293	" "	

TITLE: PORTABLE SHOCKPROOF X-RAY FUSE COVER

H. G. FISCHER & CO.
2335 WABANSIA AVE.
CHICAGO, ILL.

CAT. NO.

PART NO. 9283 1/2 F

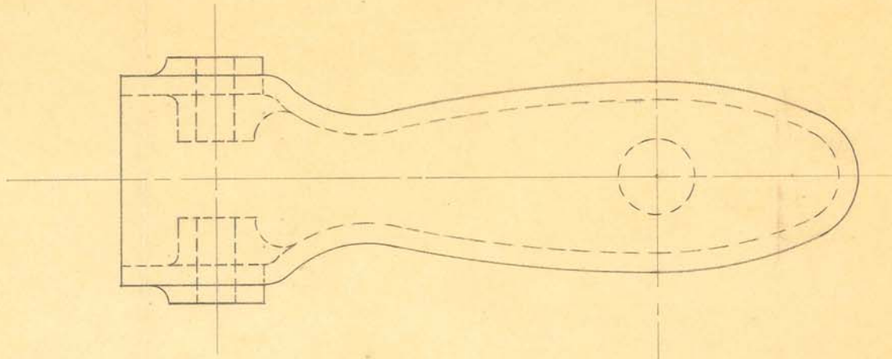

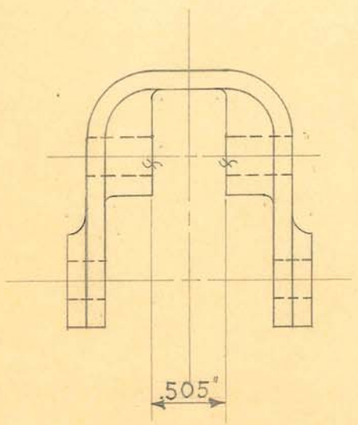

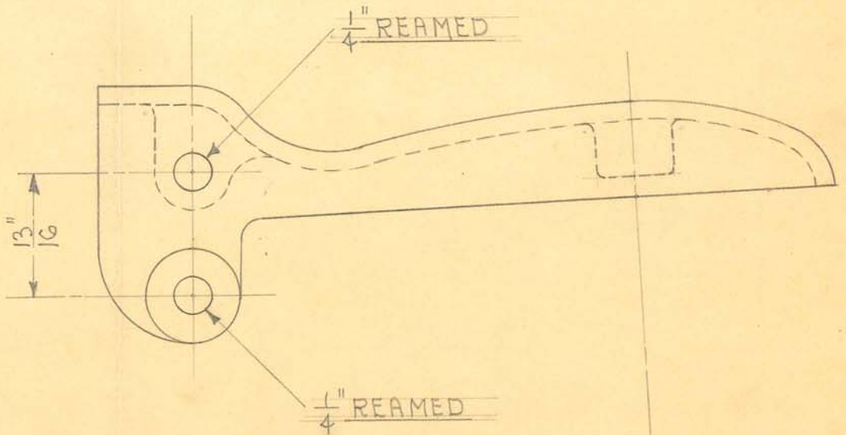

1 REQUIRED

OBSOLETE

SIZE		ISSUE 12-15-34	W.E.
KIND	ALUM. CASTING	CHANGED	
SHAPE		" "	
FINISH	BLACK #60	" "	
TEMP.		" "	
PATT.	4342-777	" "	

TITLE: PORTABLE SHOCKPROOF X-RAY UPRIGHT TUBE SLIDE LOCK HANDLE

H. G. FISCHER & CO.
2335 WABANSIA AVE.
CHICAGO, ILL.

CAT. NO.

PART NO. 9287F

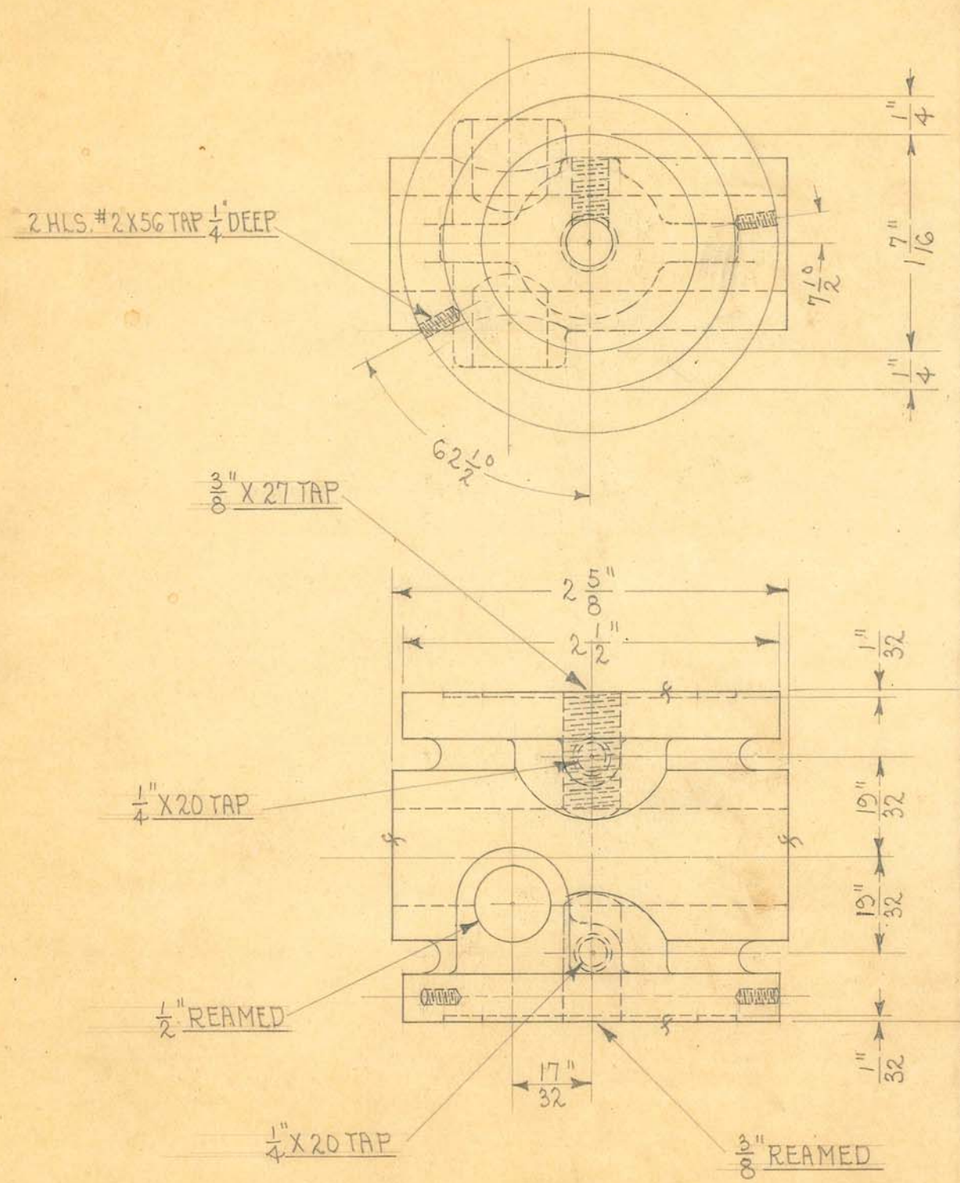

1 REQUIRED

OBSOLETE

SIZE		ISSUE 1-10-35	J.F.E.
KIND	ALUM. CASTING	CHANGED	
SHAPE		" "	
FINISH	BLACK #60	" "	
TEMP.		" "	

TITLE: PORTABLE SHOCKPROOF X-RAY TUBE HOUSING DOUBLE SWIVEL

H. G. FISCHER & CO.
2335 WABANSIA AVE.

CAT. NO.

PART NO. 9300E

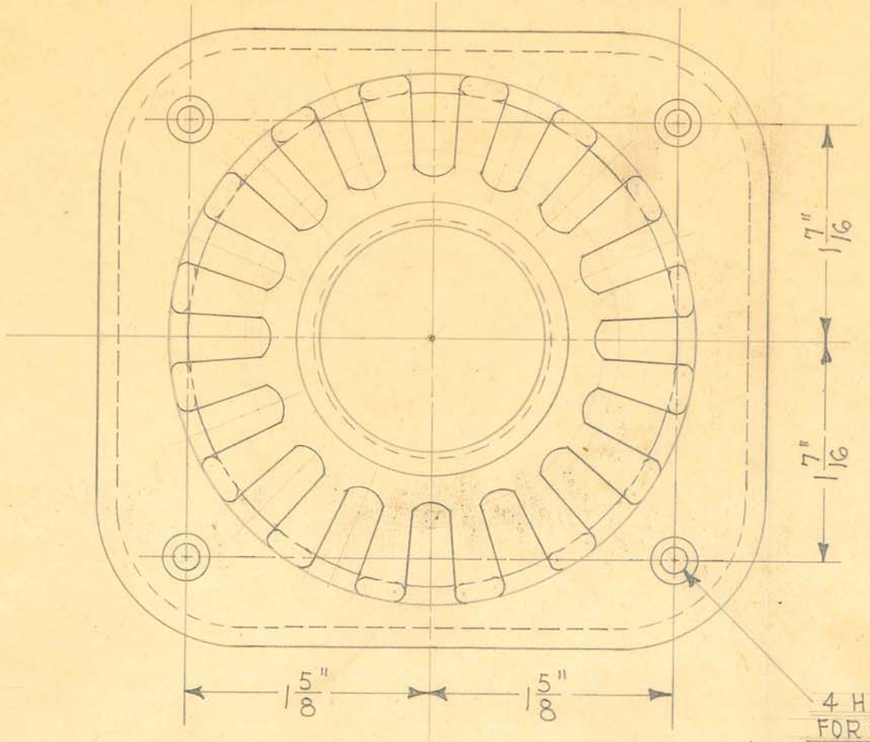

4 HLS. #16 DRILL CSK.
FOR #8 X 32 O. HD. SCR.

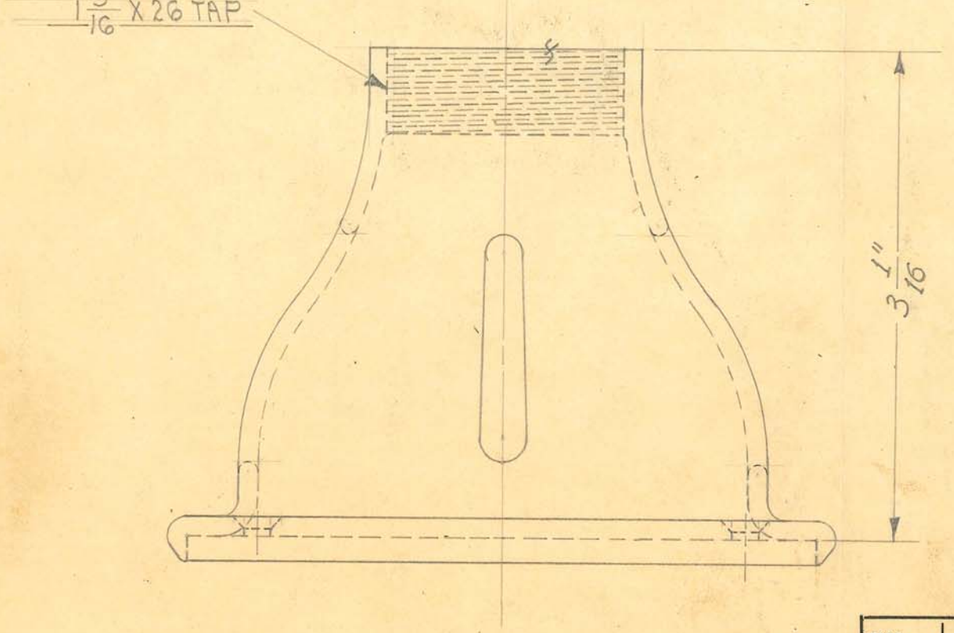

2 REQUIRED

OBSOLETE

SIZE		ISSUE 7-8-36	A.E.
KIND	ALUM. CASTING	CHANGED	
SHAPE		"	
FINISH	BLACK #60	"	
TEMP.		"	

TITLE:
FISCHER "DSP-20" TUBE HEAD H.T. CABLE
INSULATOR CAP

H. G. FISCHER & CO.
2335 WABANSIA AVE.

CAT. NO.

PART NO. 9329AF

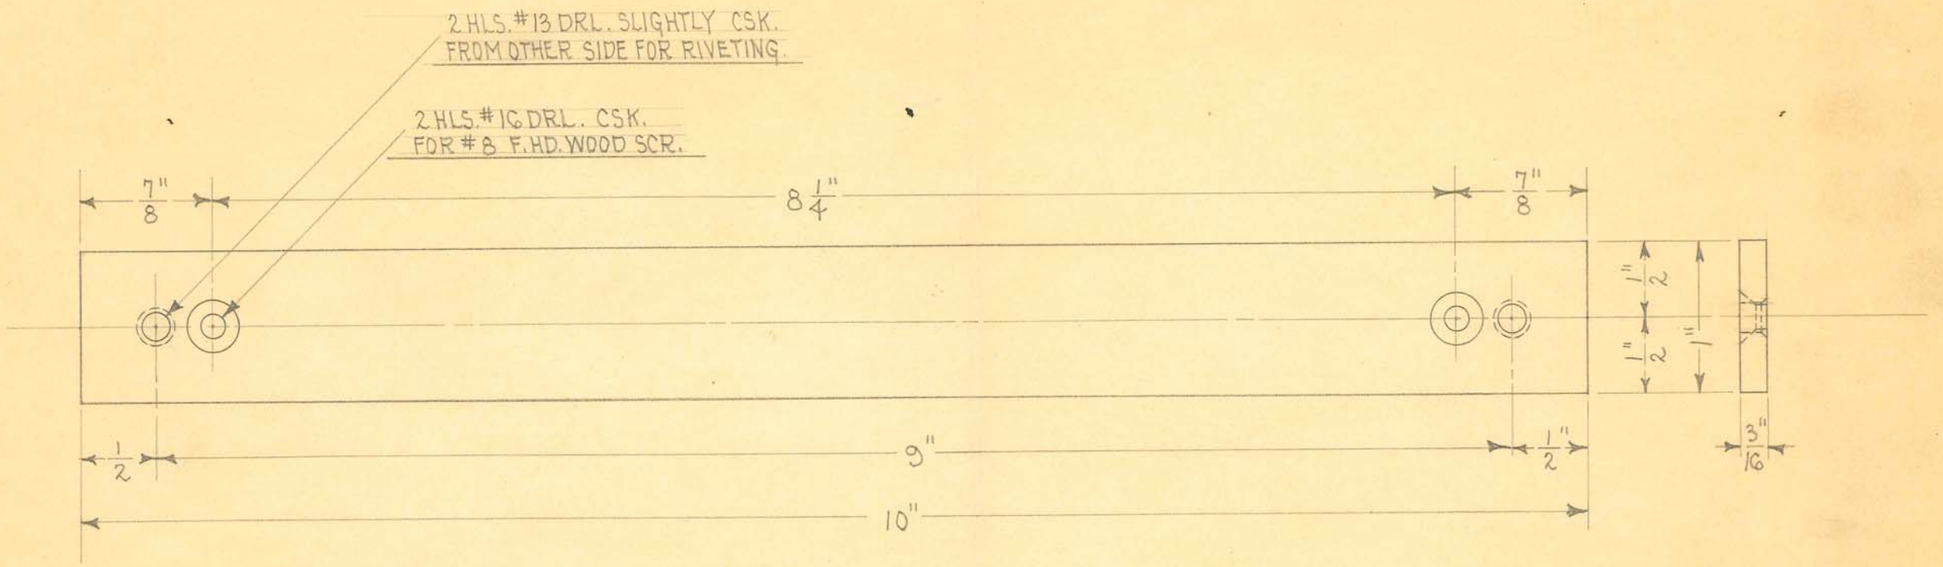

2 REQUIRED

OBSOLETE

SIZE	3/16" X 1"	ISSUE 1-14-35	J.E.	TITLE: PORTABLE SHOCKPROOF X-RAY CABINET CLAMP STRIP
KIND	C.R. STEEL	CHANGED		
SHAPE		" "		
FINISH		" "		
TEMP.		" "		
PATT.		" "		

H. G. FISCHER & CO.
2335 WABANSIA AVE.
CHICAGO, ILL.

CAT. NO.

PART NO. 9340

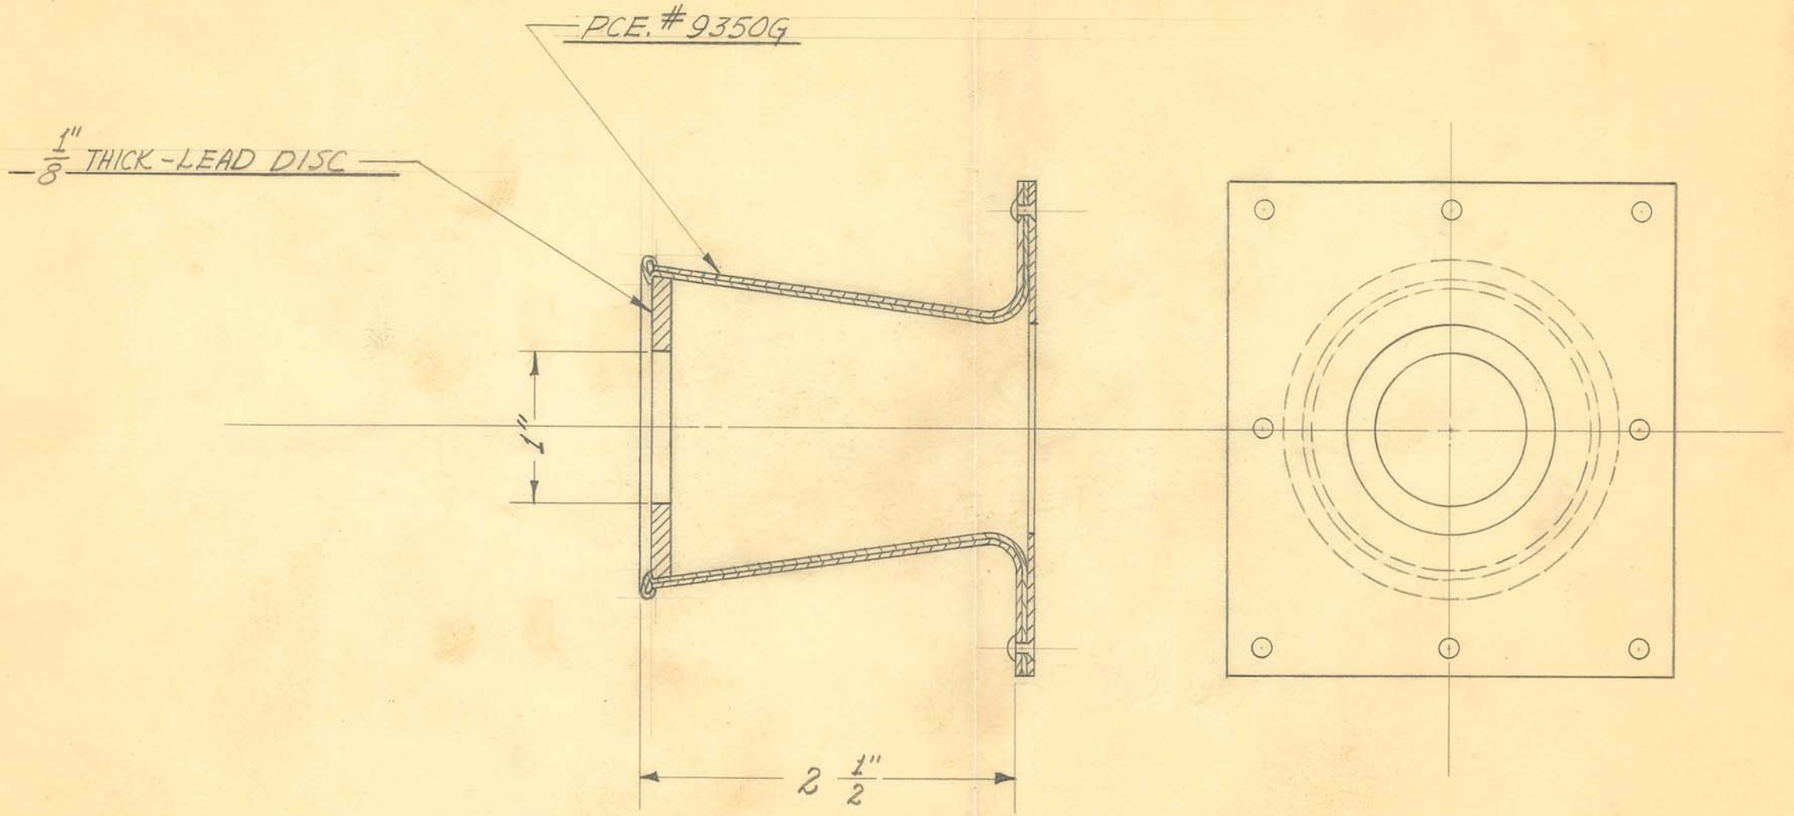

OBSOLETE

SIZE		ISSUE 11-28-39	J.W.	TITLE: SPECIAL "DSP-20" LEAD LINED CONE FOR GETTING A 6" DISTANCE FROM TUBE TARGET TO END OF CONE
KIND		CHANGED		
SHAPE		"		
FINISH		"		
TEMP.		"		
PATT.		"		

H. G. FISCHER & CO.
2335 WABANSIA AVE.
CHICAGO, ILL.

CAT. NO. 4741

PART NO. 9349G

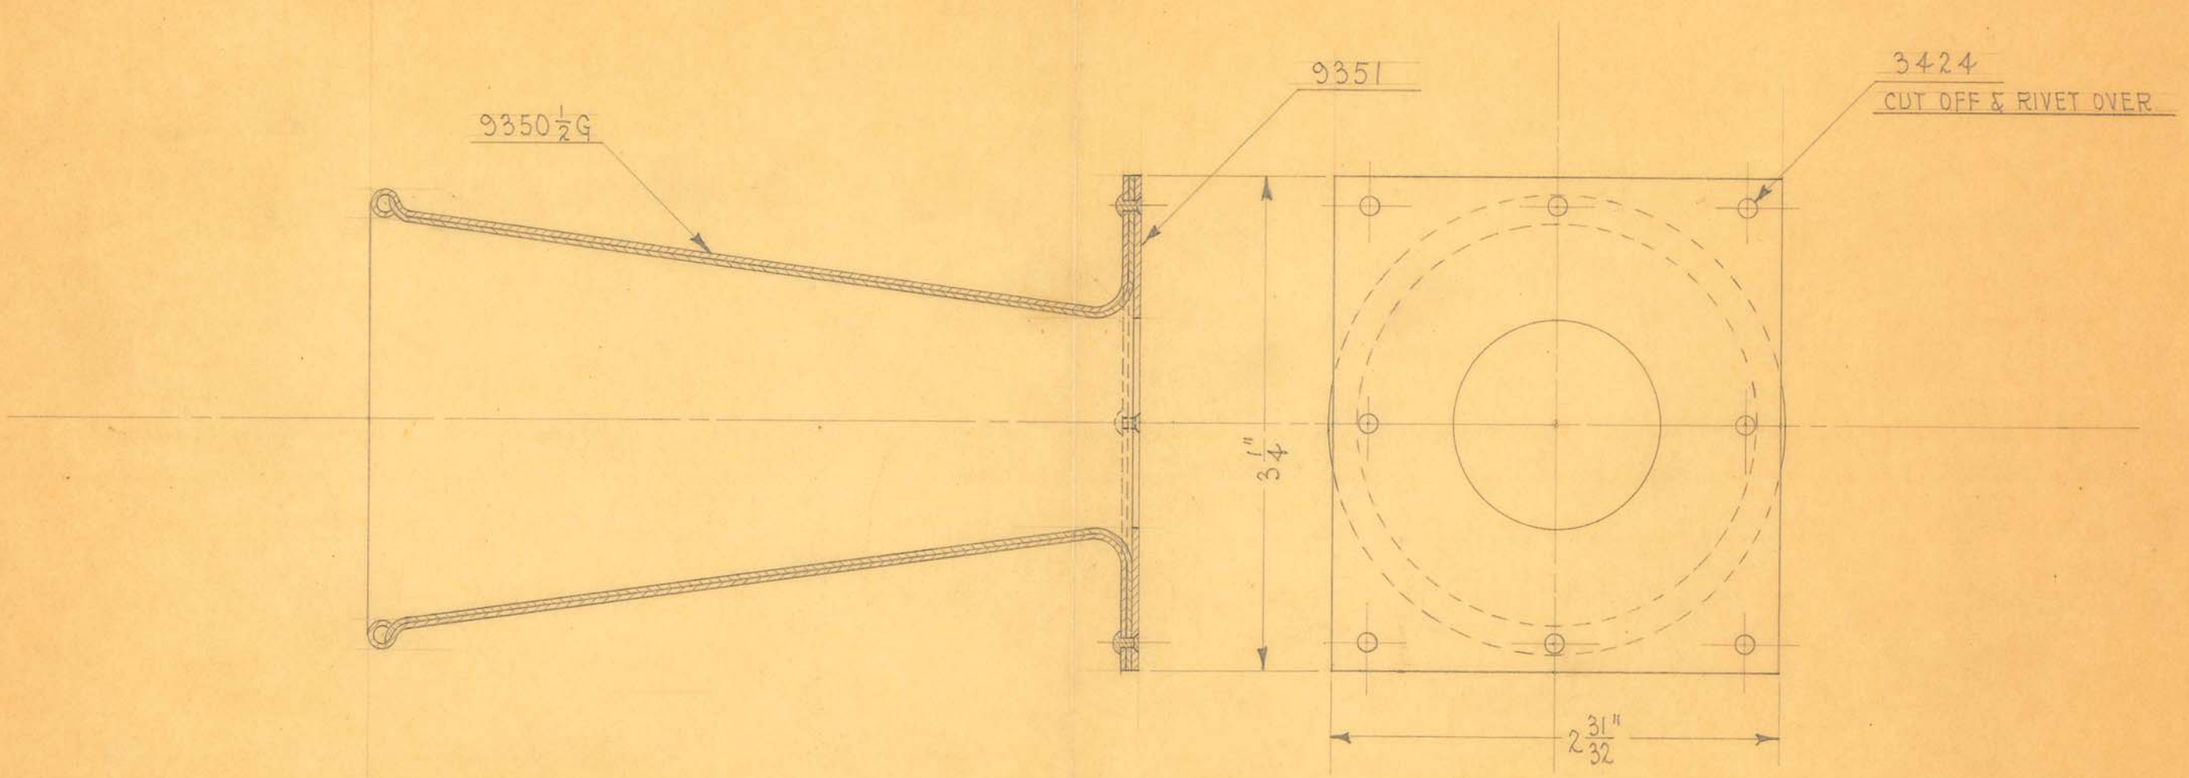

OBSOLETE

SIZE		ISSUE 9-26-35	A.E.	TITLE: FISCHER "DSP-20" LEAD LINED CONE ASSEMBLY
KIND		CHANGED		
SHAPE		" "		
FINISH	BLACK #85	" "		
TEMP.		" "		
PATT.		" "		

H. G. FISCHER & CO.
2335 WABANSIA AVE.
CHICAGO, ILL.

CAT. NO. 3638

PART NO. 9350G

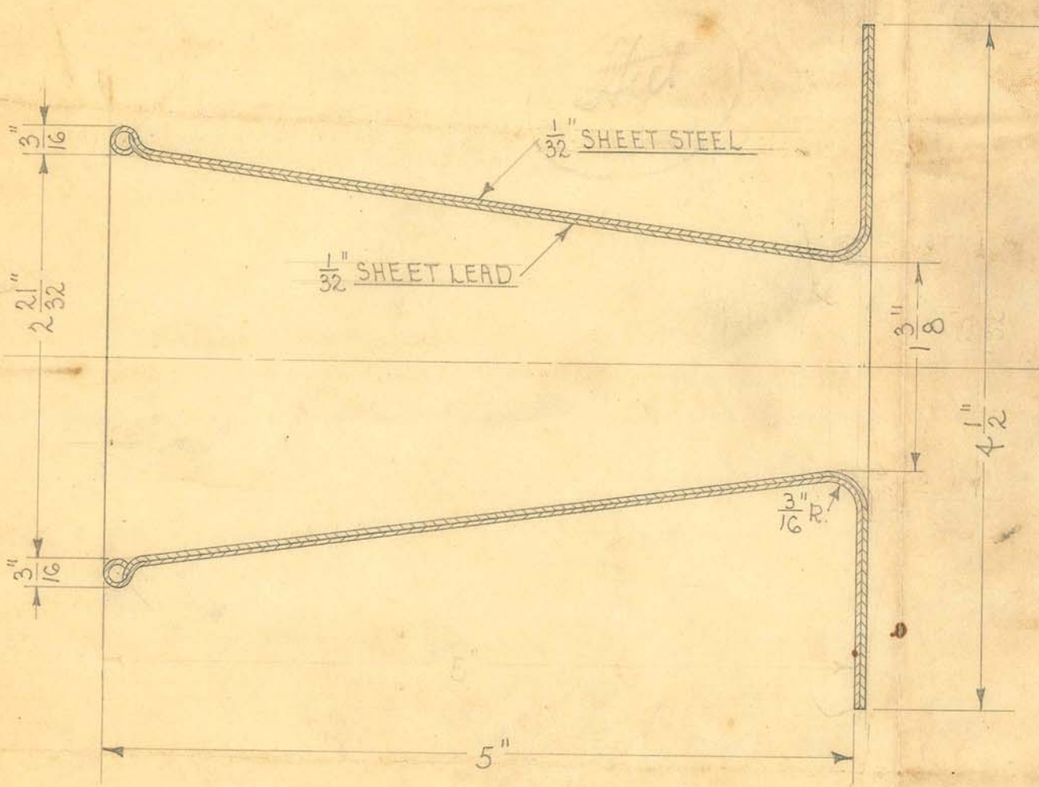

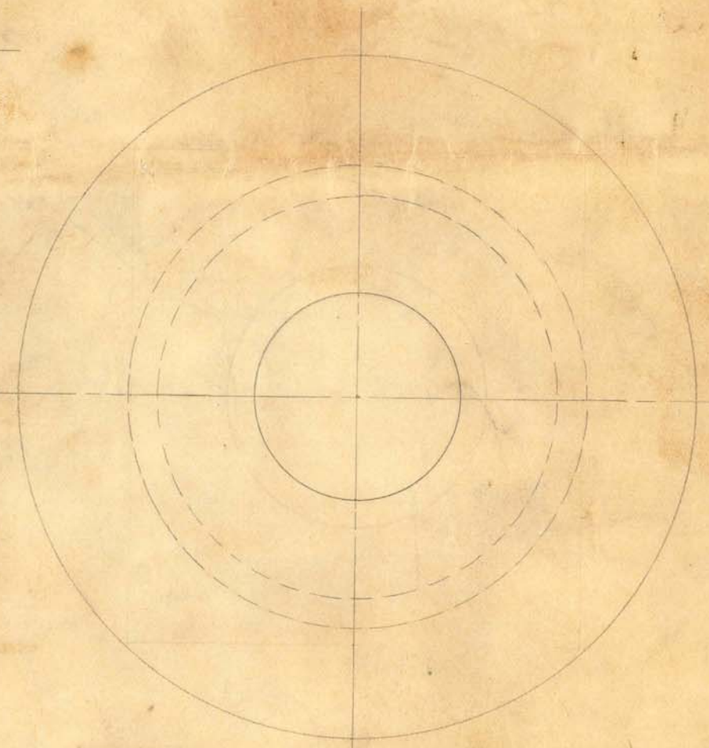

OBSOLETE

SIZE		ISSUE 1-17-35	A.E.	TITLE: FISCHER "DSP-20" LEAD LINED CONE
KIND		CHANGED		
SHAPE		" "		
FINISH		" "		
TEMP.		" "		
PATT.		" "		

H. G. FISCHER & CO.
2335 WABANSIA AVE.
CHICAGO

CAT. NO.

PART NO. 2350 1/2 G

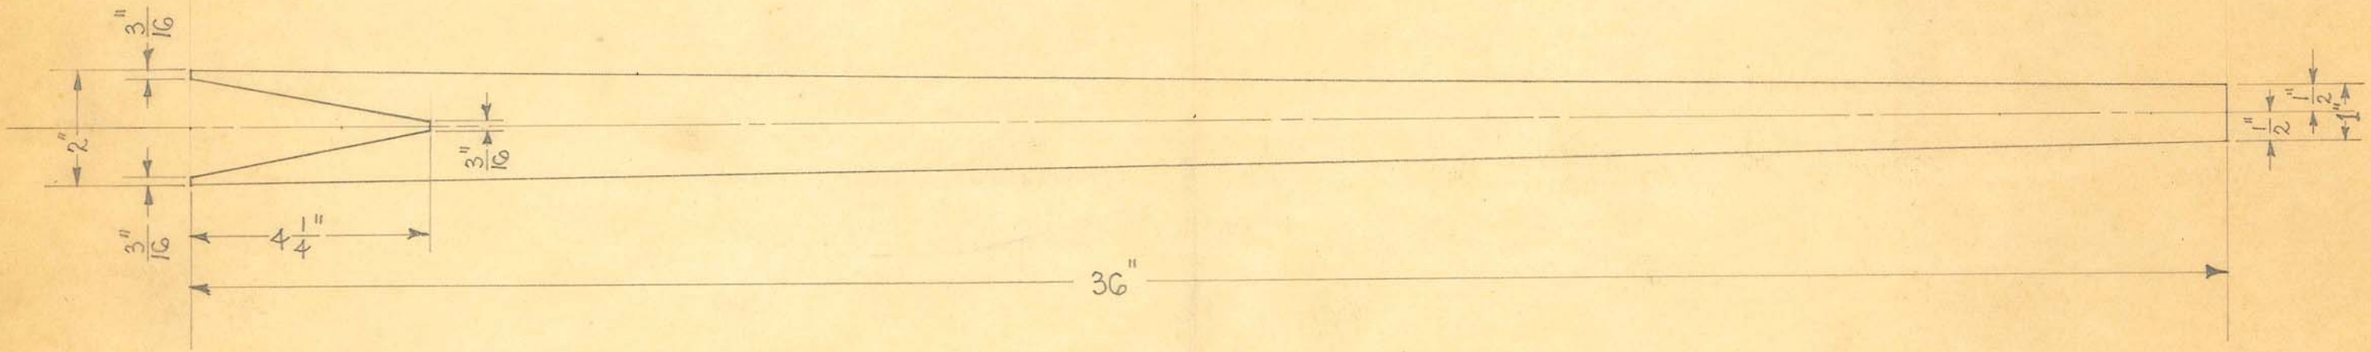

4 REQUIRED

SCALE ≈ 3/8" = 1"

OBSOLETE

SIZE	#5029	ISSUE 5-19-36	7/8
KIND	BALLOON CLOTH	CHANGED	
SHAPE		" "	
FINISH		" "	
TEMP.		" "	
PATT.		" "	

TITLE: FISCHER "DSP-20" HIGH TENSION CABLE STRESS CONE STRIP-NARROW

H. G. FISCHER & CO.
2335 WABANSIA AVE.
CHICAGO, ILL.

CAT. NO.

PART NO. 9358

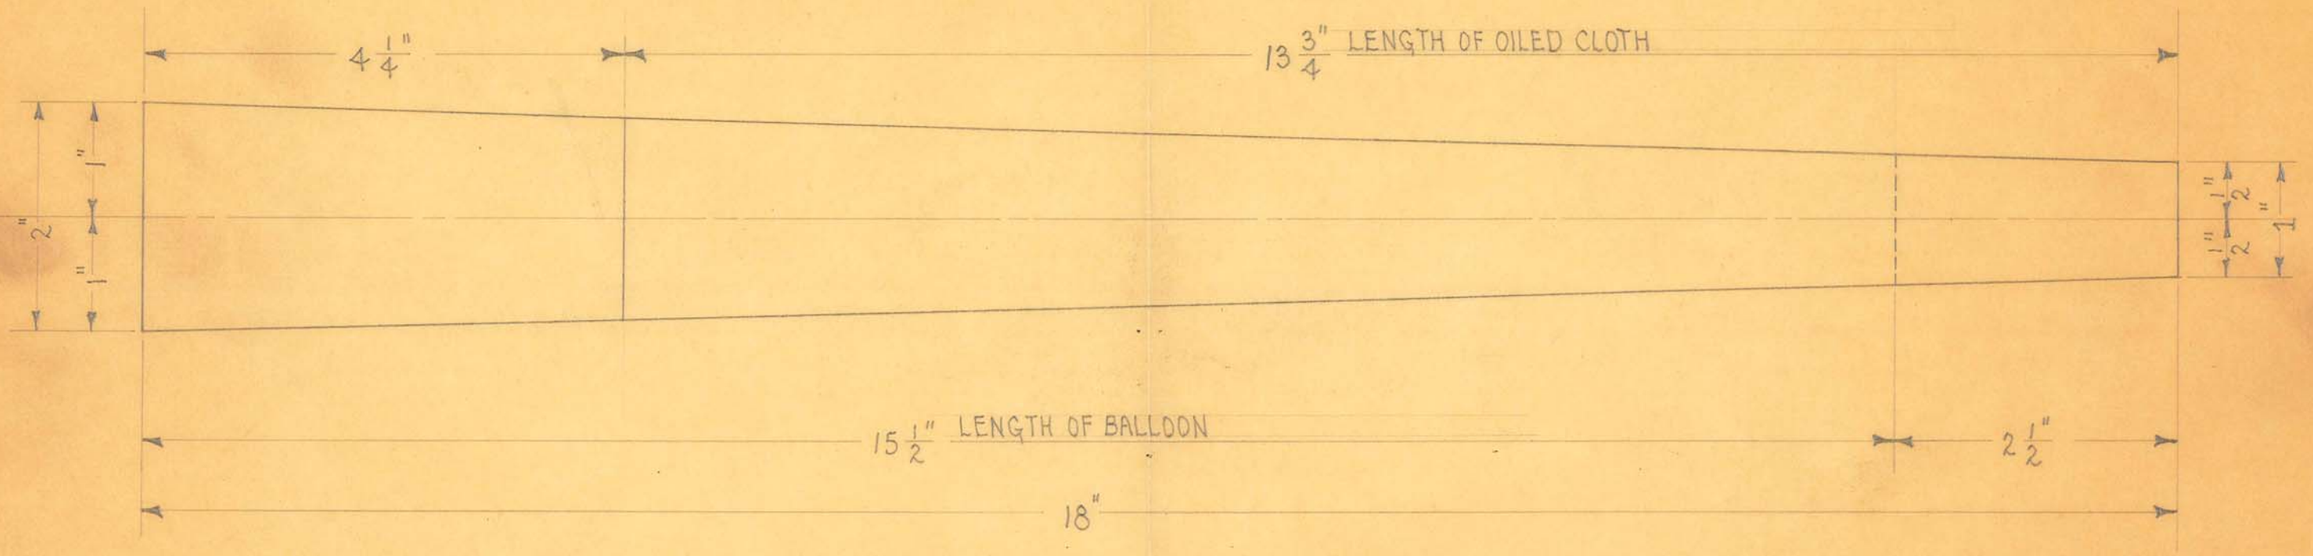

CUT 1 PIECE OF #5026 3/4 OILED CLOTH & 1 PIECE OF #5029 BALLOON CLOTH TO SIZES SHOWN.
SEW TOGETHER ON SIDES ONLY. DO NOT SEW ENDS.

4 REQUIRED

SCALE ÷ 3/4" = 1"

OBSOLETE

SIZE		ISSUE 7-26-35	J.E.
KIND		CHANGED	
SHAPE		" "	
FINISH		" "	
TEMP.		" "	
PATT.		" "	

TITLE: FISCHER "DSP-20" HIGH TENSION CABLE STRESS CONE STRIP ASSEM.

H. G. FISCHER & CO.
2335 WABANSIA AVE.
CHICAGO, ILL.

CAT. NO.

PART NO. 9358G

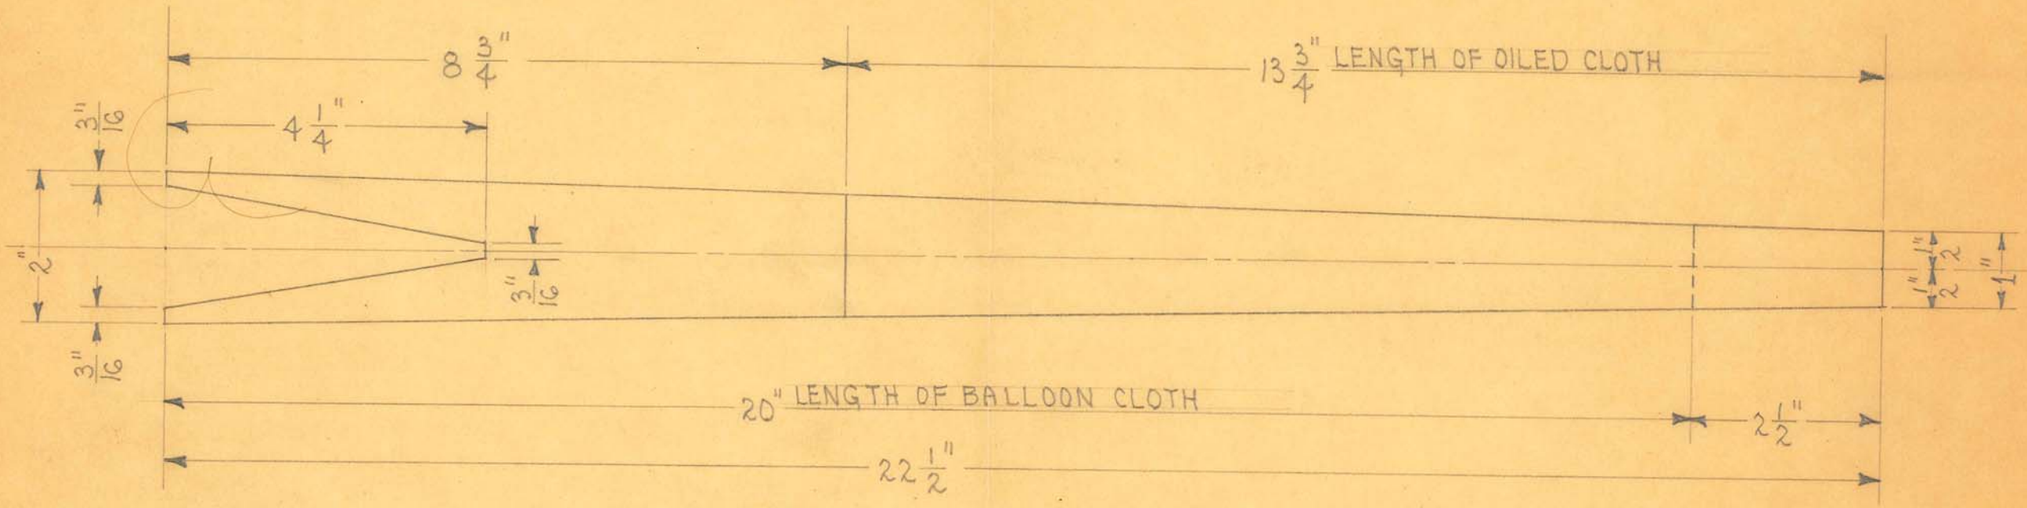

CUT 1 PIECE OF #5026 OILED CLOTH & 1 PIECE OF #5029 BALLOON CLOTH TO SIZES SHOWN.
SEW TOGETHER ON SIDES ONLY. DO NOT SEW ENDS.

4 REQUIRED

SCALE ~ 1/2" = 1"

OBSOLETE

SIZE		ISSUE 3-11-36	A.E.	TITLE: FISCHER "DSP-20" HIGH TENSION CABLE STRESS CONE STRIP ASSEM.
KIND		CHANGED		
SHAPE		" "		
FINISH		" "		
TEMP.		" "		
PATT.		" "		

H. G. FISCHER & CO.
2335 WABANSIA AVE.

CAT. NO.

PART NO. 9358GA

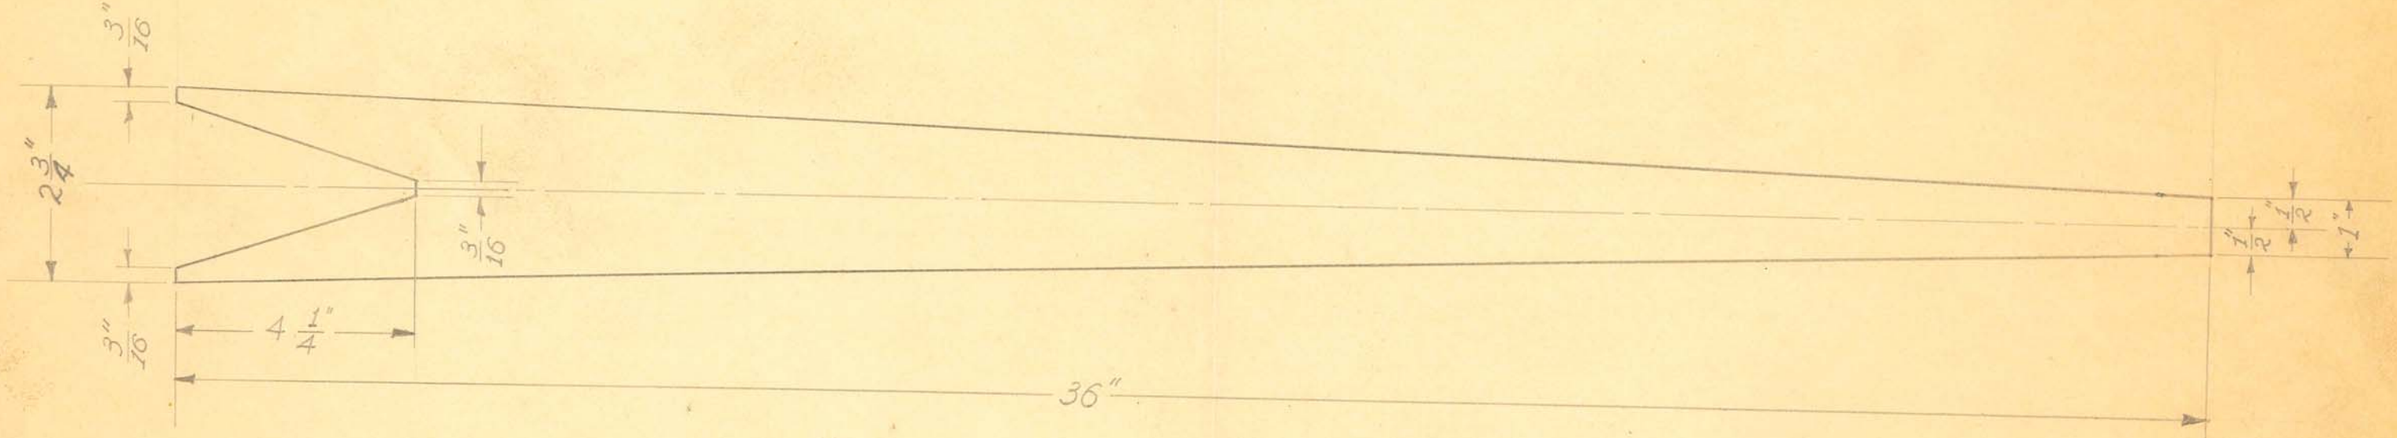

2 REQUIRED

SCALE - 3/8" = 1"

OBSOLETE

SIZE	#5029	ISSUE 8-19-36	J.W.	TITLE: FISCHER "DSP-20" HIGH TENSION CABLE STRESS CONE STRIP - WIDE
KIND	BALLOON CLOTH	CHANGED		
SHAPE		"		
FINISH		"		
TEMP.		"		
PATT.		"		

H. G. FISCHER & CO.
2335 WABANSIA AVE.

CAT. NO.

PART NO. 0258-1

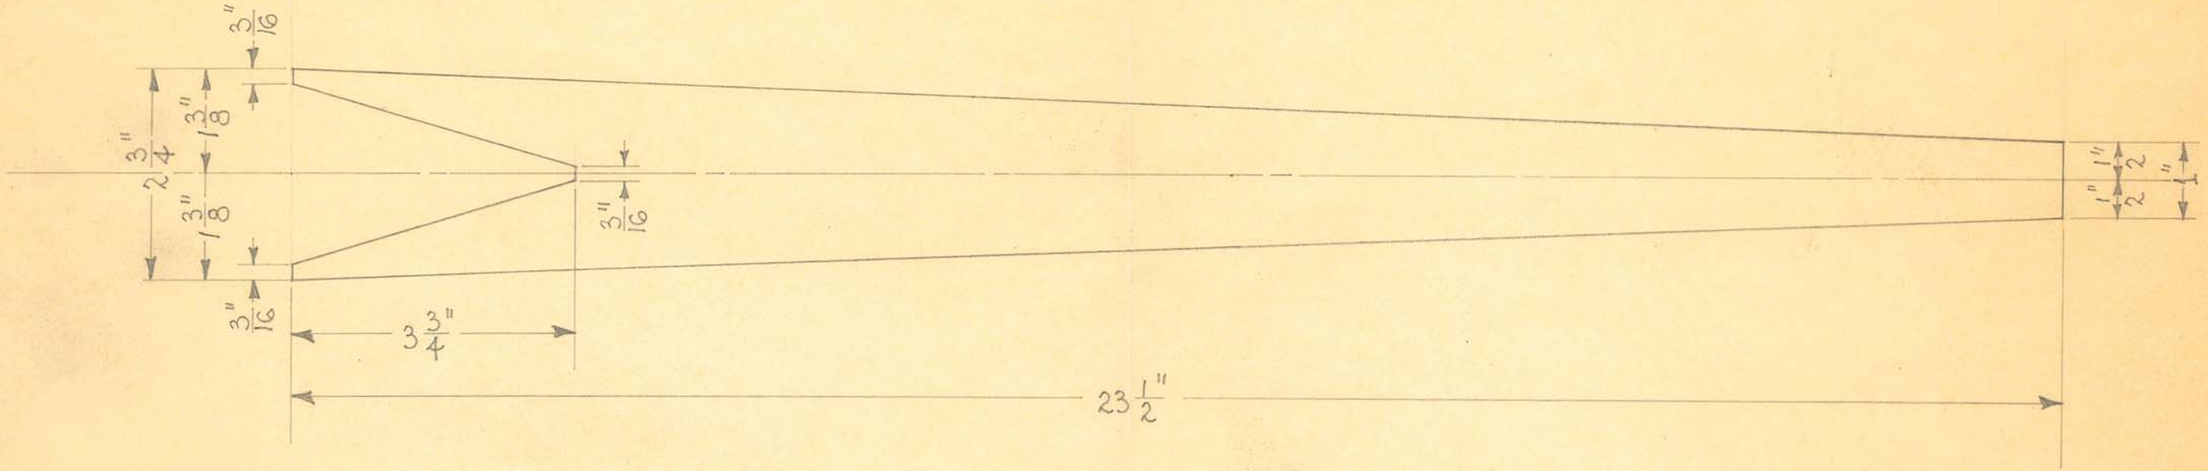

4 REQUIRED

SCALE ≈ 1/2" = 1"

OBSOLETE

SIZE	#5026 3/4	ISSUE 12-10-36	H.G.
KIND	OILED CLOTH	CHANGED	
SHAPE		"	
FINISH		"	
TEMP.		"	

TITLE: FISCHER "DSP-20" HIGH TENSION CABLE STRESS CONE STRIP-WIDE

H. G. FISCHER & CO. CAT. PART 5026 3

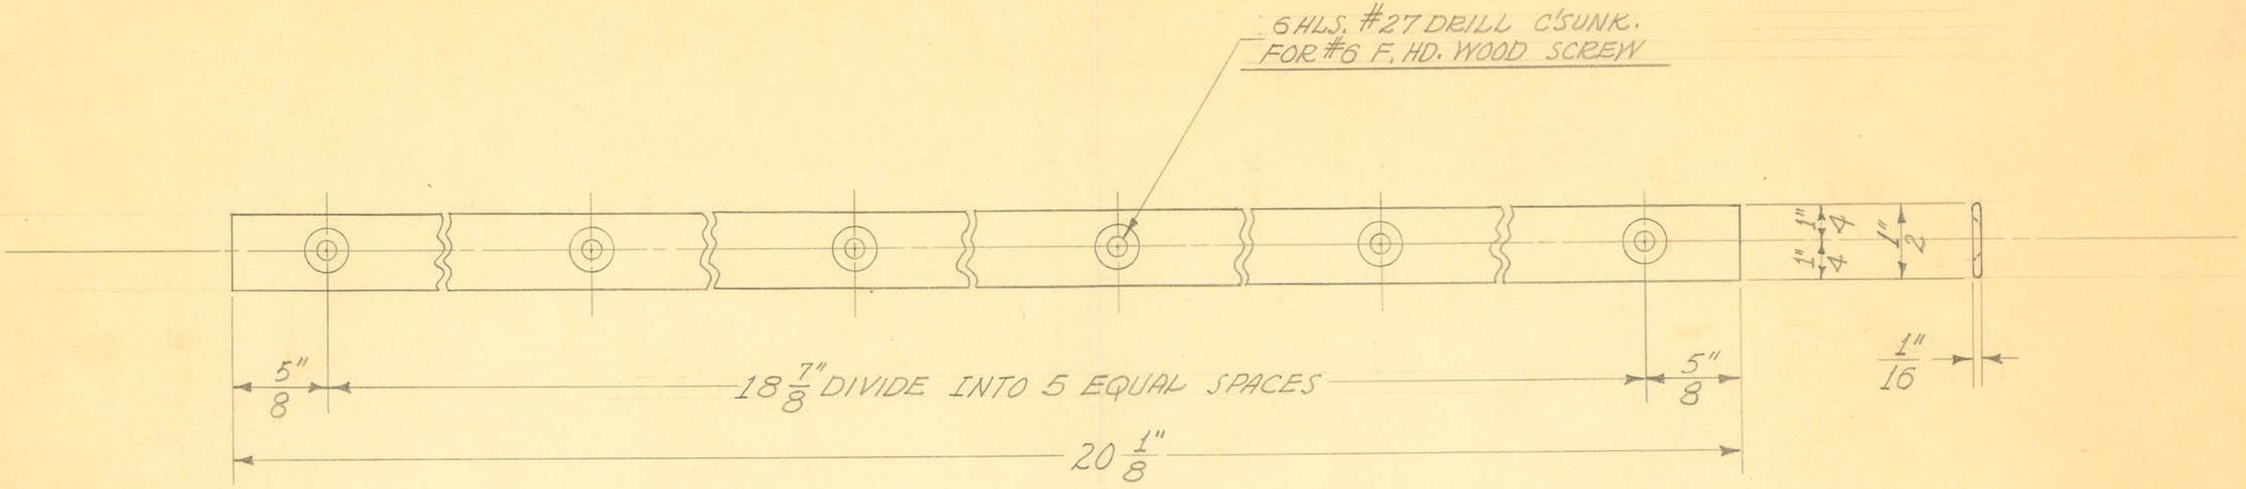

2 REQUIRED

OBSOLETE

SIZE	1/2" X 1/16"	ISSUE 3-2-38	J.W.	TITLE: FISCHER "DSP-20" LEAD LINED CABINET DOOR-LEAD PAN REINFORCING STRIP-SIDE
KIND	FLAT WIRE	CHANGED		
SHAPE		"		
FINISH		"		
TEMP.		"		
PATT.		"		

H. G. FISCHER & CO.
2335 WABANSIA AVE.
CHICAGO, ILL.

CAT. NO.

PART NO. 9388 1/2

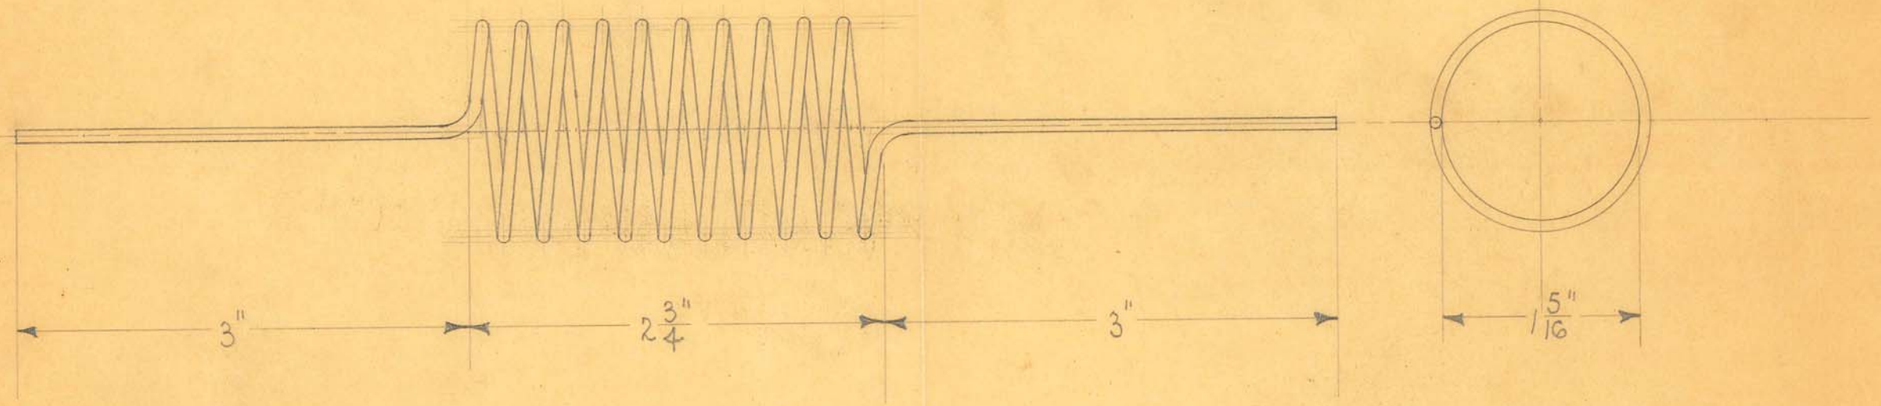

10 TURNS
1 REQUIRED

OBSOLETE

SIZE	#12 TINNED	ISSUE 7-18-35	AE
KIND	COPPER WIRE	CHANGED	
SHAPE		" "	
FINISH		" "	
TEMP.		" "	

TITLE: MODEL "SW17" SHORT WAVE HIGH FREQ. OUTFIT
GRID COIL

H. G. FISCHER & CO.
2335 WABANSIA AVE.

CAT. NO.

PART NO. 9409

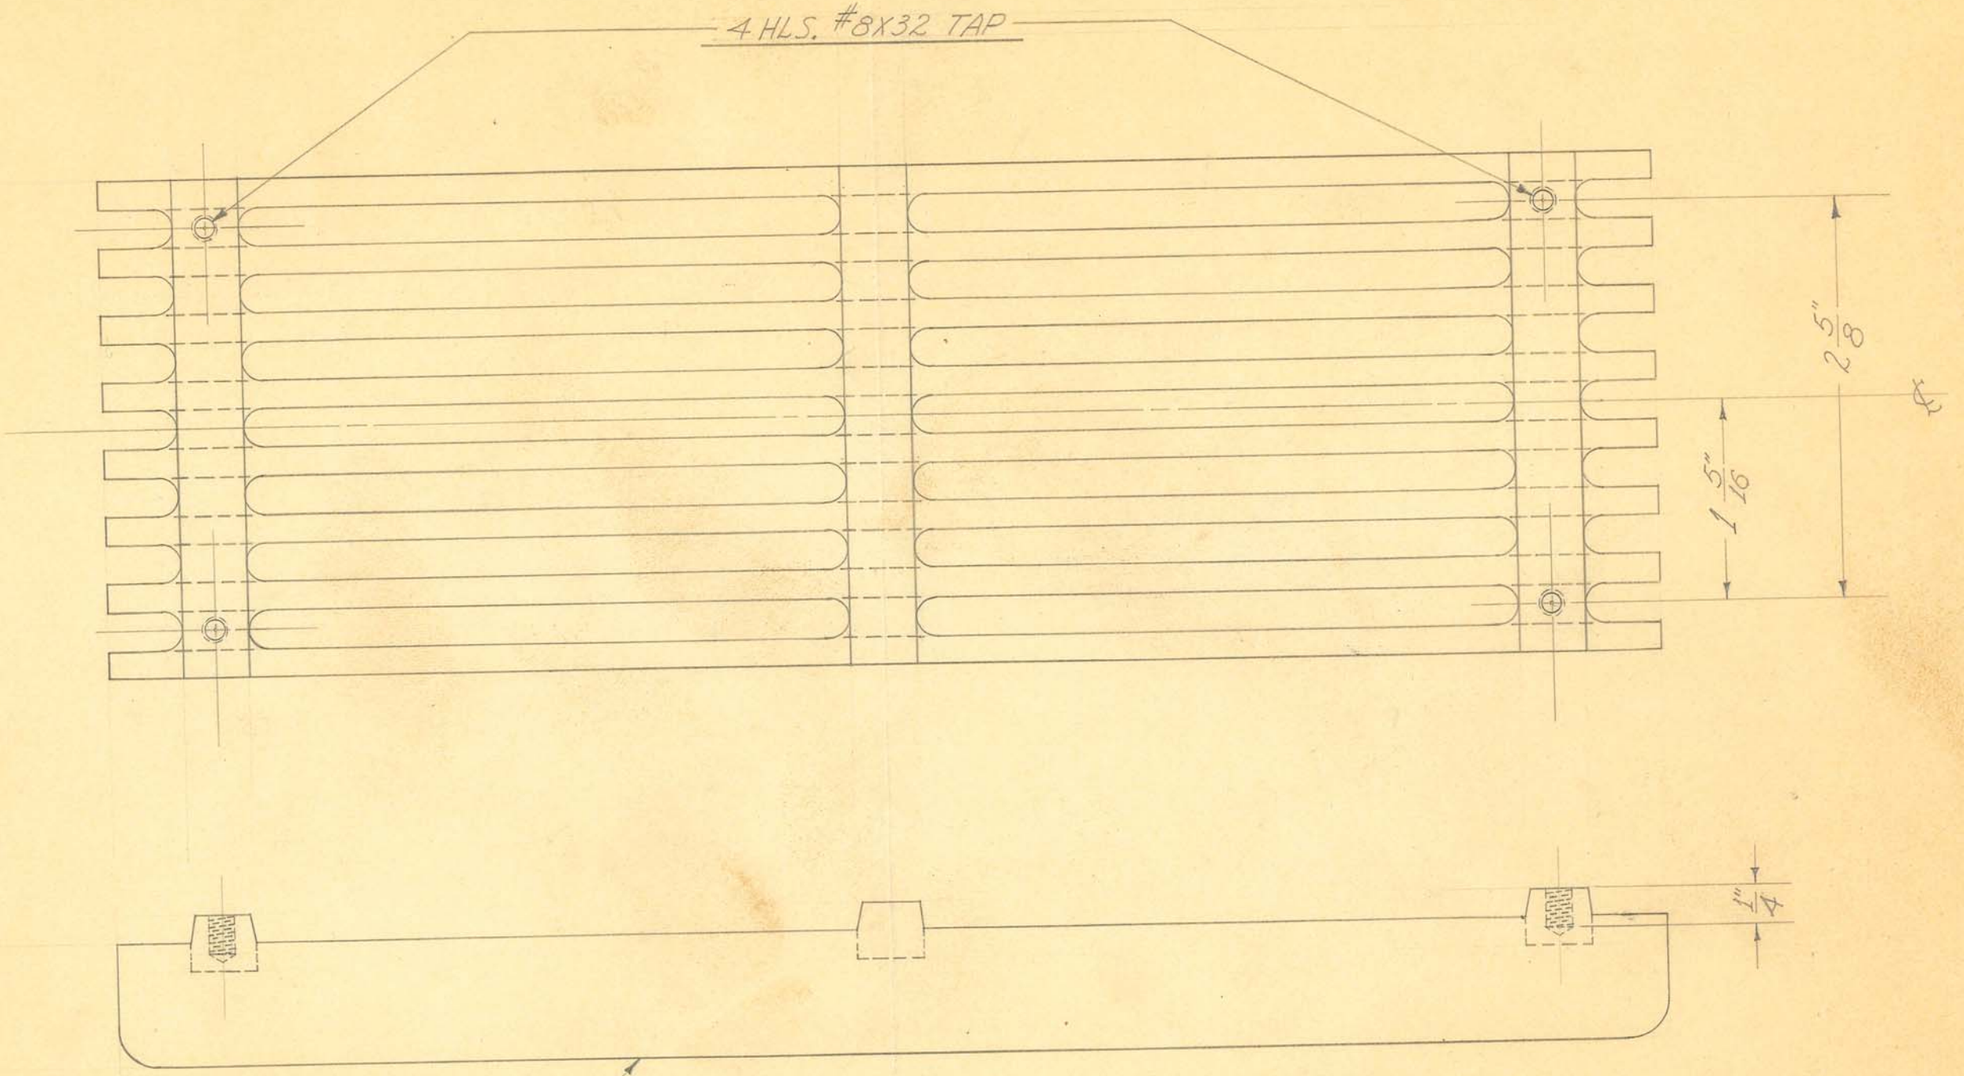

2 REQUIRED

OBSOLETE

SIZE		ISSUE 7-12-38	J.W.
KIND	ALUM. CASTING	CHANGED	
SHAPE		"	
FINISH	BLACK #80	"	
TEMP.		"	
DATE	7093-804	"	

TITLE: MOD. "SW-17" SHORT WAVE HIGH FREQ. OUTFIT VENTILATOR GRILL

H. G. FISCHER & CO.
2335 WABANSIA AVE.
CHICAGO, ILL.

CAT. NO.

PART NO. 9419AF

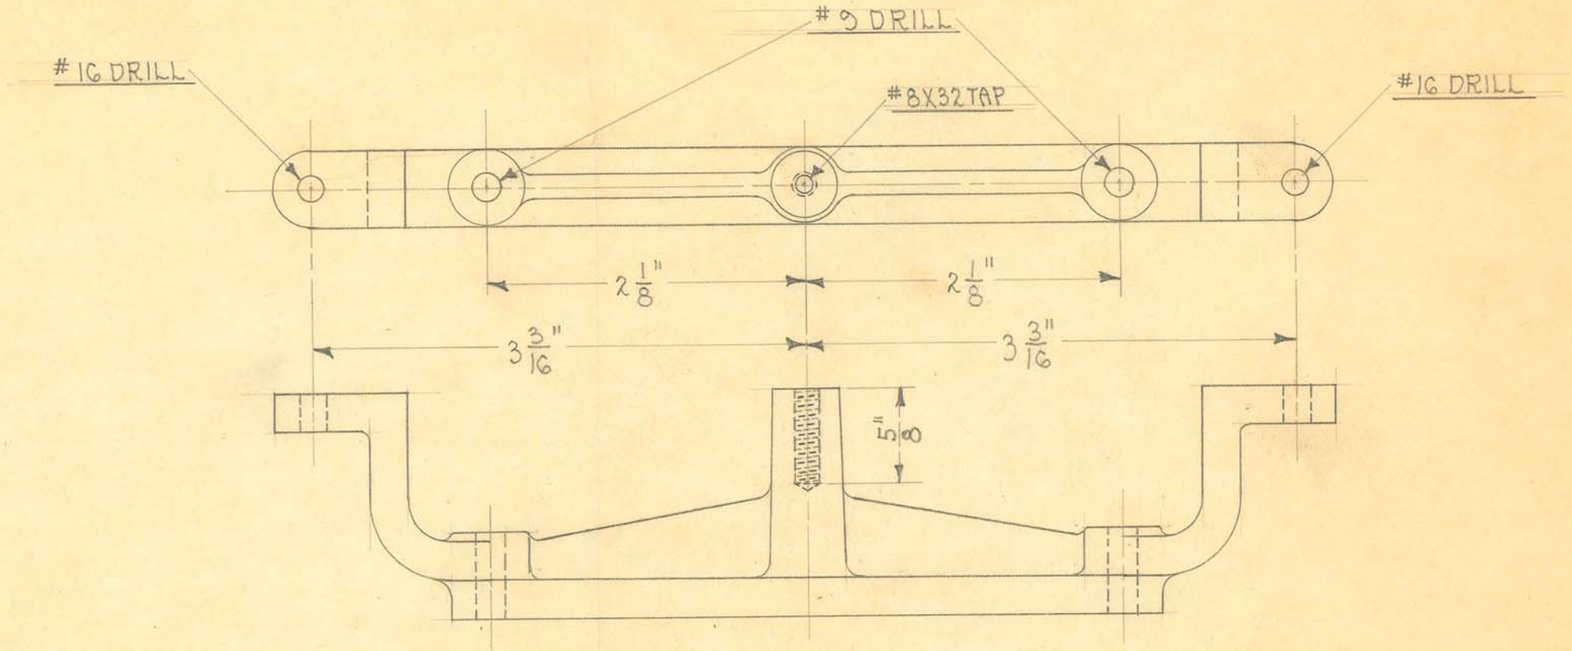

2 REQUIRED

OBSOLETE

SIZE		ISSUE 2-15-35	J.E.
KIND	IRON CASTING	CHANGED	
SHAPE		" "	
FINISH	BLACK #80	" "	
TEMP.		" "	
PATT.	C846-800	" "	

TITLE: MODEL "SW17" SHORT WAVE HIGH FREQ. OUTFIT
FILAMENT TRANS. SUPPORT (UPPER)

H. G. FISCHER & CO.
2335 WABANSIA AVE.
CHICAGO, ILL.

CAT. NO.

PART NO. 9420F

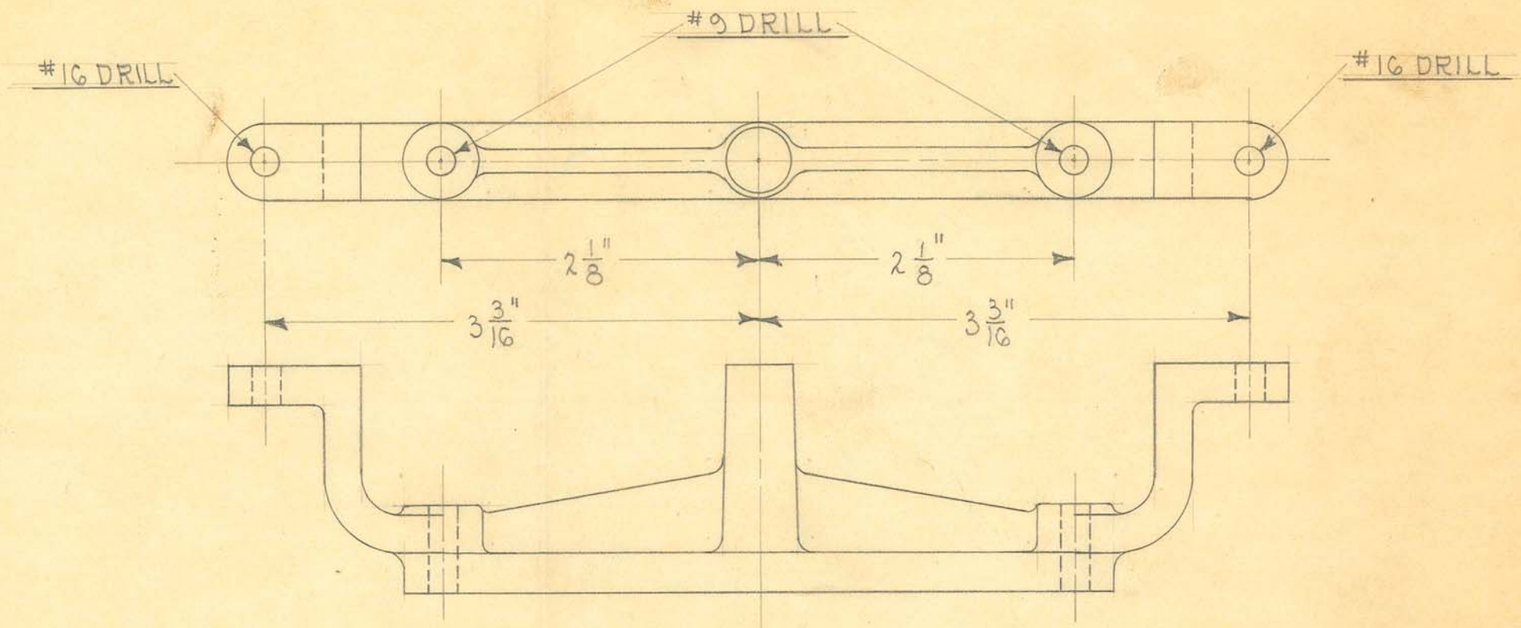

2 REQUIRED

OBSOLETE

SIZE		ISSUE 2-15-34	A.E.	TITLE: MODEL "SW17" SHORT WAVE HIGH FREQ. OUTFIT FILAMENT TRANS. SUPPORT (LOWER)
KIND	IRON CASTING	CHANGED		
SHAPE		" "		
FINISH	BLACK # 80	" "		
TEMP.		" "		H. G. FISCHER & CO. 2335 WABANSIA AVE. CHICAGO, ILL. — CAT. NO. — PART NO. 9420 1/2
PATT.	G846-800	" "		

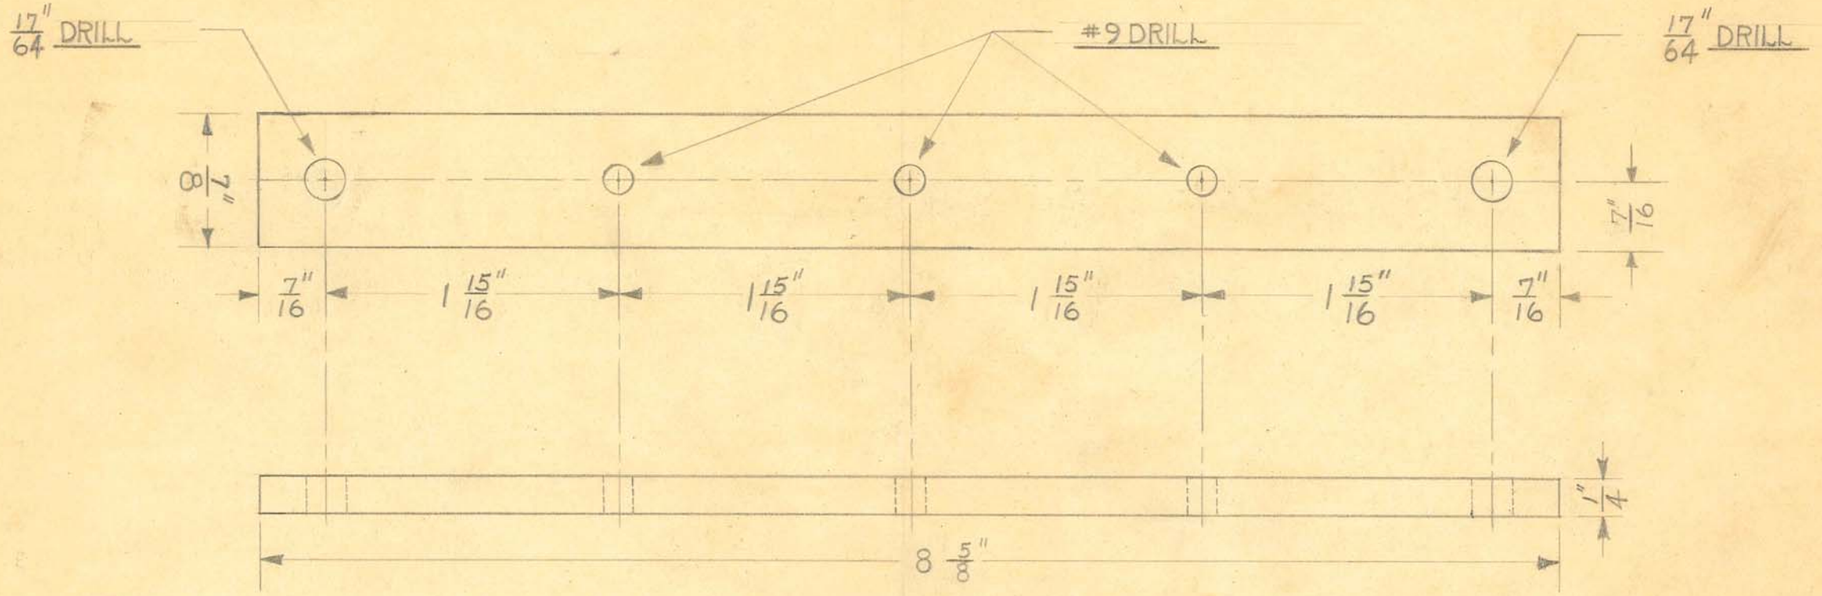

1 REQUIRED

OBSOLETE

SIZE	1/4" SHEET	ISSUE 2-18-35	J.W.	TITLE: MODEL "S.W.17." SHORT WAVE HIGH FREQUENCY OUTFIT H.T. TRANSF. TERMINAL STRIP - FRONT
KIND	RICHELAIN	CHANGED		
SHAPE	BAKELITE	" "		
FINISH		" "		
TEMP.		" "		
PATT.		" "		

H. G. FISCHER & CO.
2335 WABANSIA AVE.
CHICAGO, ILL.

CAT. NO.

PART NO. 9426

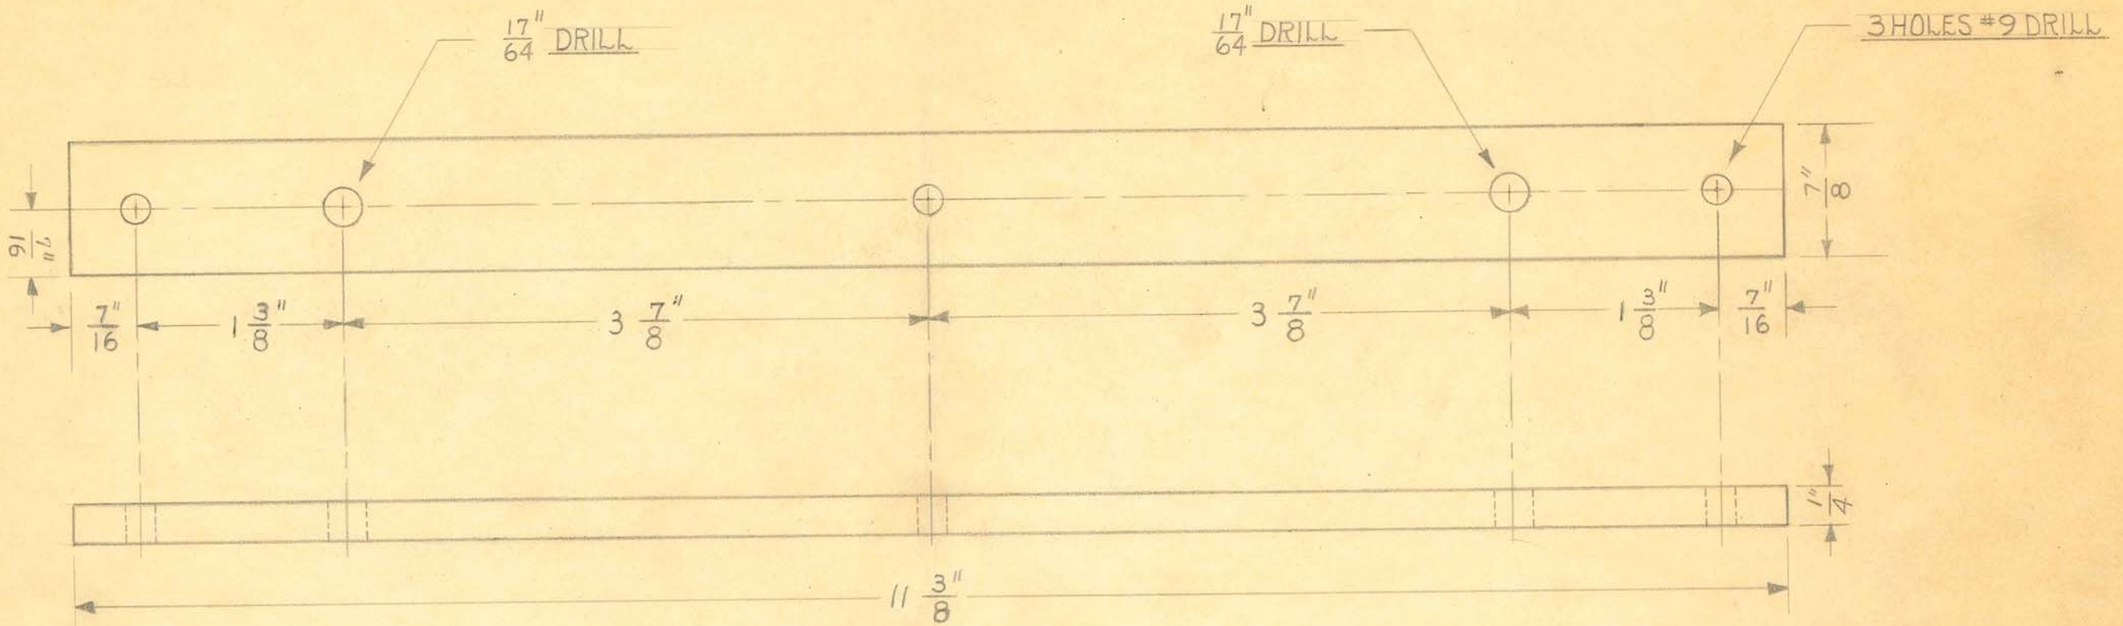

1 REQUIRED

OBSOLETE

SIZE	1/4" SHEET	ISSUE 2-18-35	J.W.	TITLE: MODEL "S.W.17" SHORT WAVE HIGH FREQUENCY OUTFIT H.T. TRANSF. TERMINAL STRIP - REAR.
KIND	RICHELAIN	CHANGED		
SHAPE	BAKELITE	" "		
FINISH		" "		
TEMP.		" "		
PATT.		" "		

H. G. FISCHER & CO.
2335 WABANSIA AVE.
CHICAGO, ILL.

CAT. NO.

PART NO. 9427

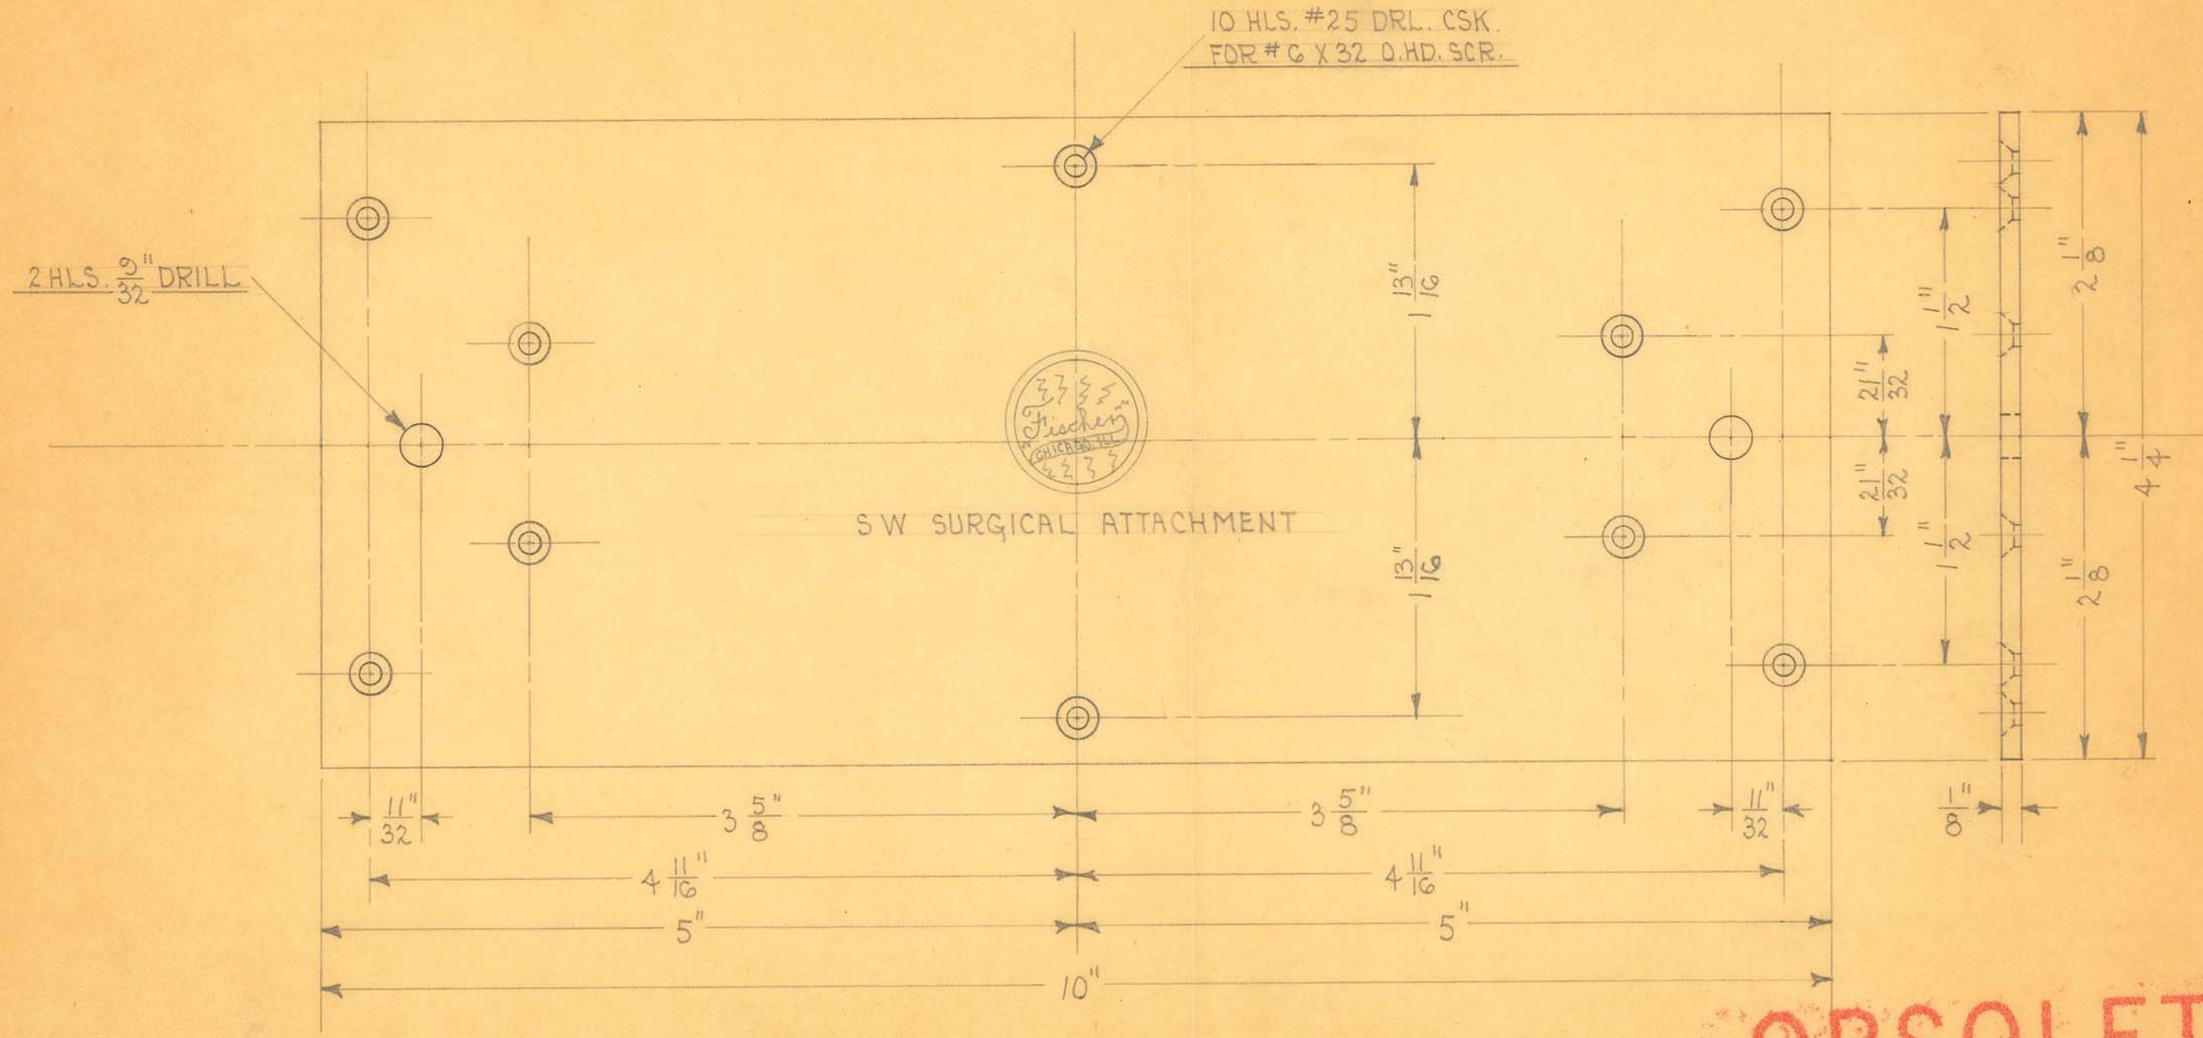

OBSOLETE

SIZE	1/8" SHEET	ISSUE 2-13-36	A.B.
KIND	LAMICOID	CHANGED	
SHAPE		" "	
FINISH		" "	
TEMP.		" "	
PATT.		" "	

TITLE: FIISCHER SHORT WAVE SURGICAL ATTACHMENT PANEL (DRILLED & ENGRAVED)

H. G. FISCHER & CO.
2335 WABANSIA AVE.
CHICAGO, ILL.

CAT. NO.

PART NO. 9453F

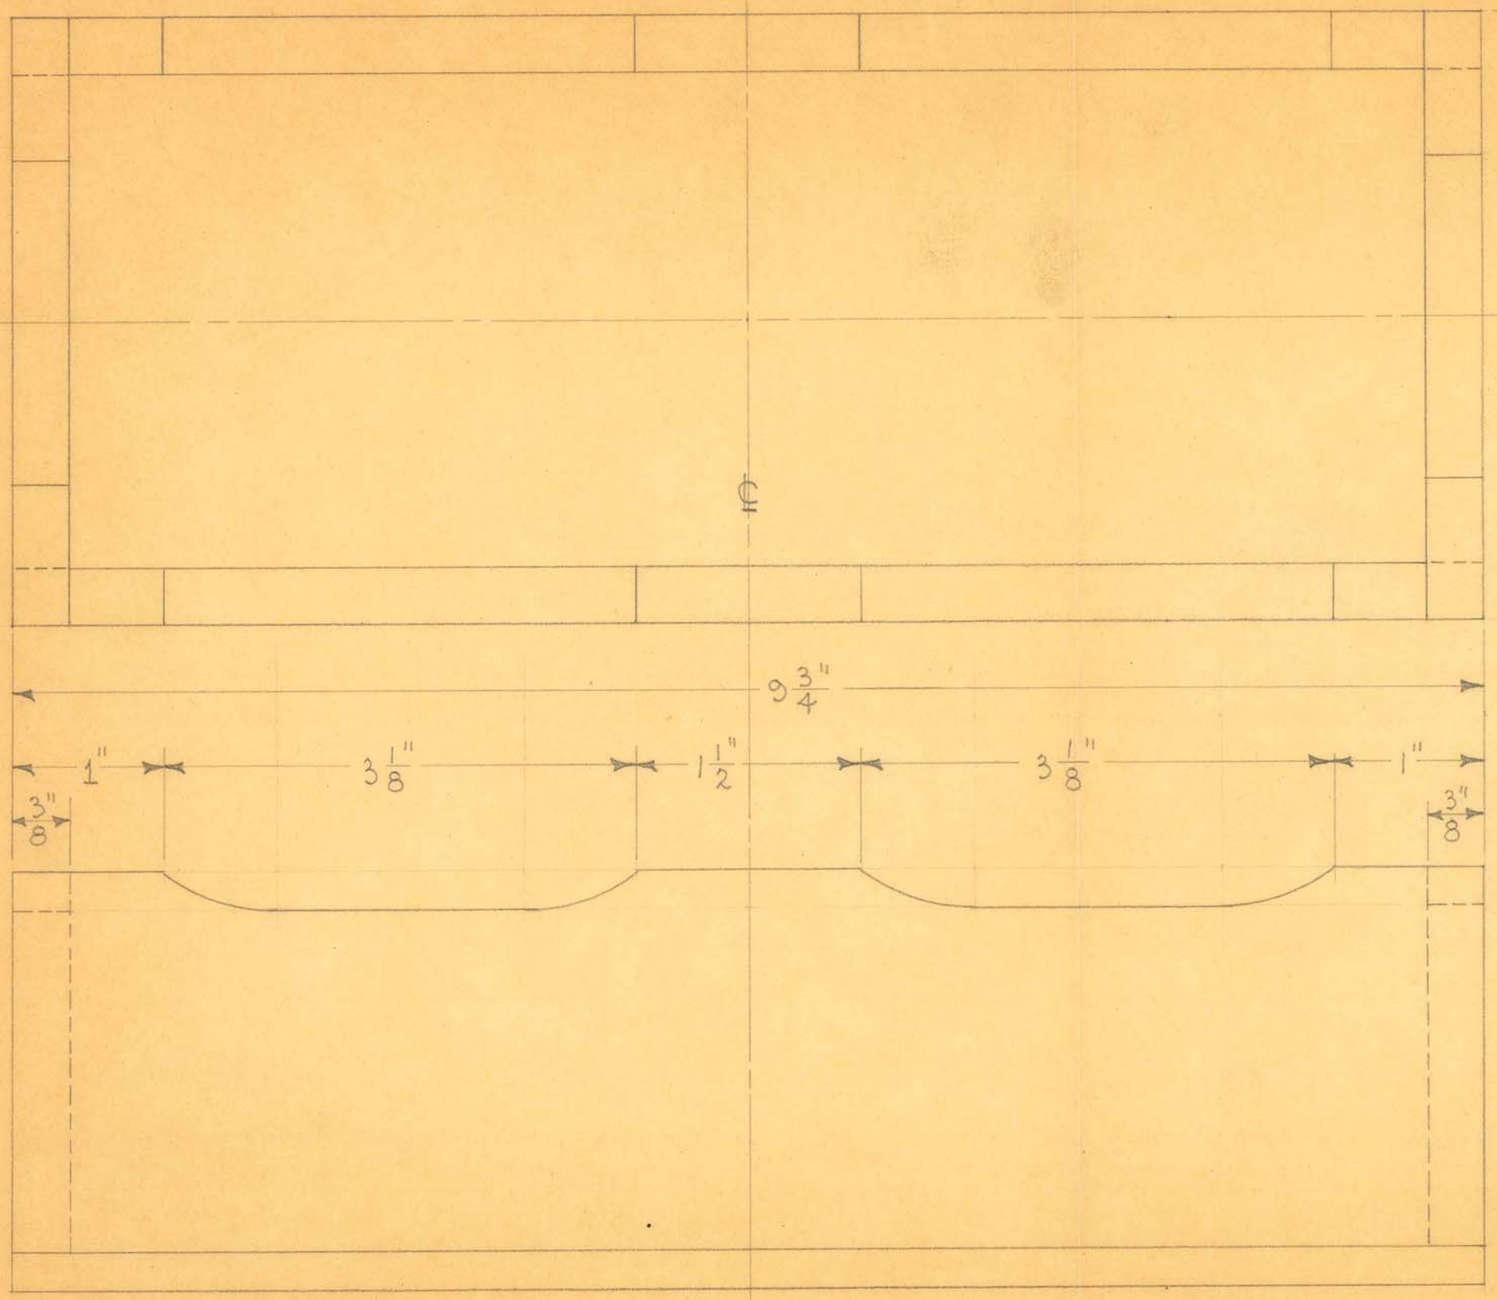

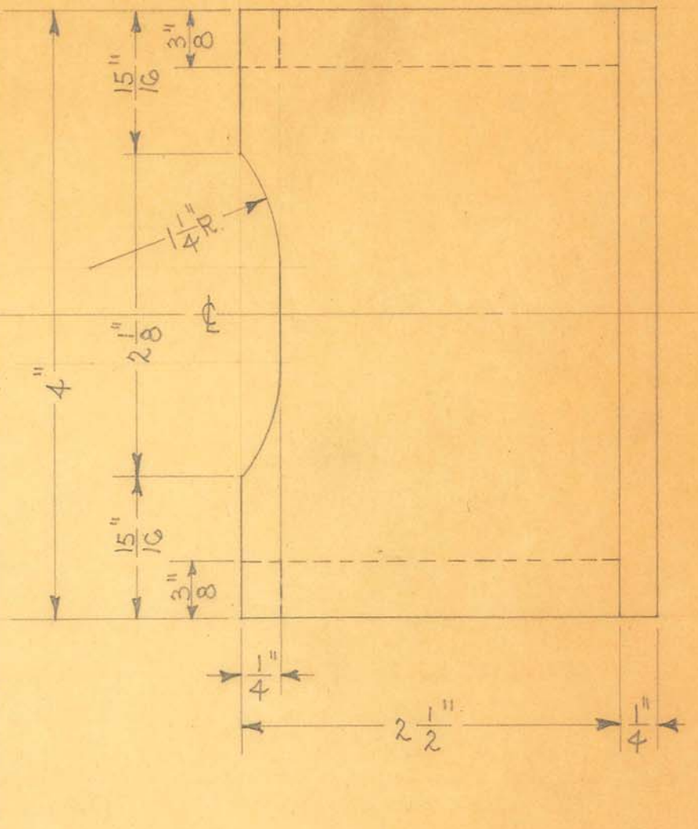

OBSOLETE

SIZE		ISSUE 2-13-36	D/8
KIND	H. WOOD	CHANGED	
SHAPE		" "	
FINISH		" "	
TEMP.		" "	
PATT.		" "	

TITLE: FISCHER SHORT WAVE SURGICAL ATTACHMENT BOX

H. G. FISCHER & CO.
2335 WABANSIA AVE.
CHICAGO, ILL.

CAT. NO.

PART NO. 9454

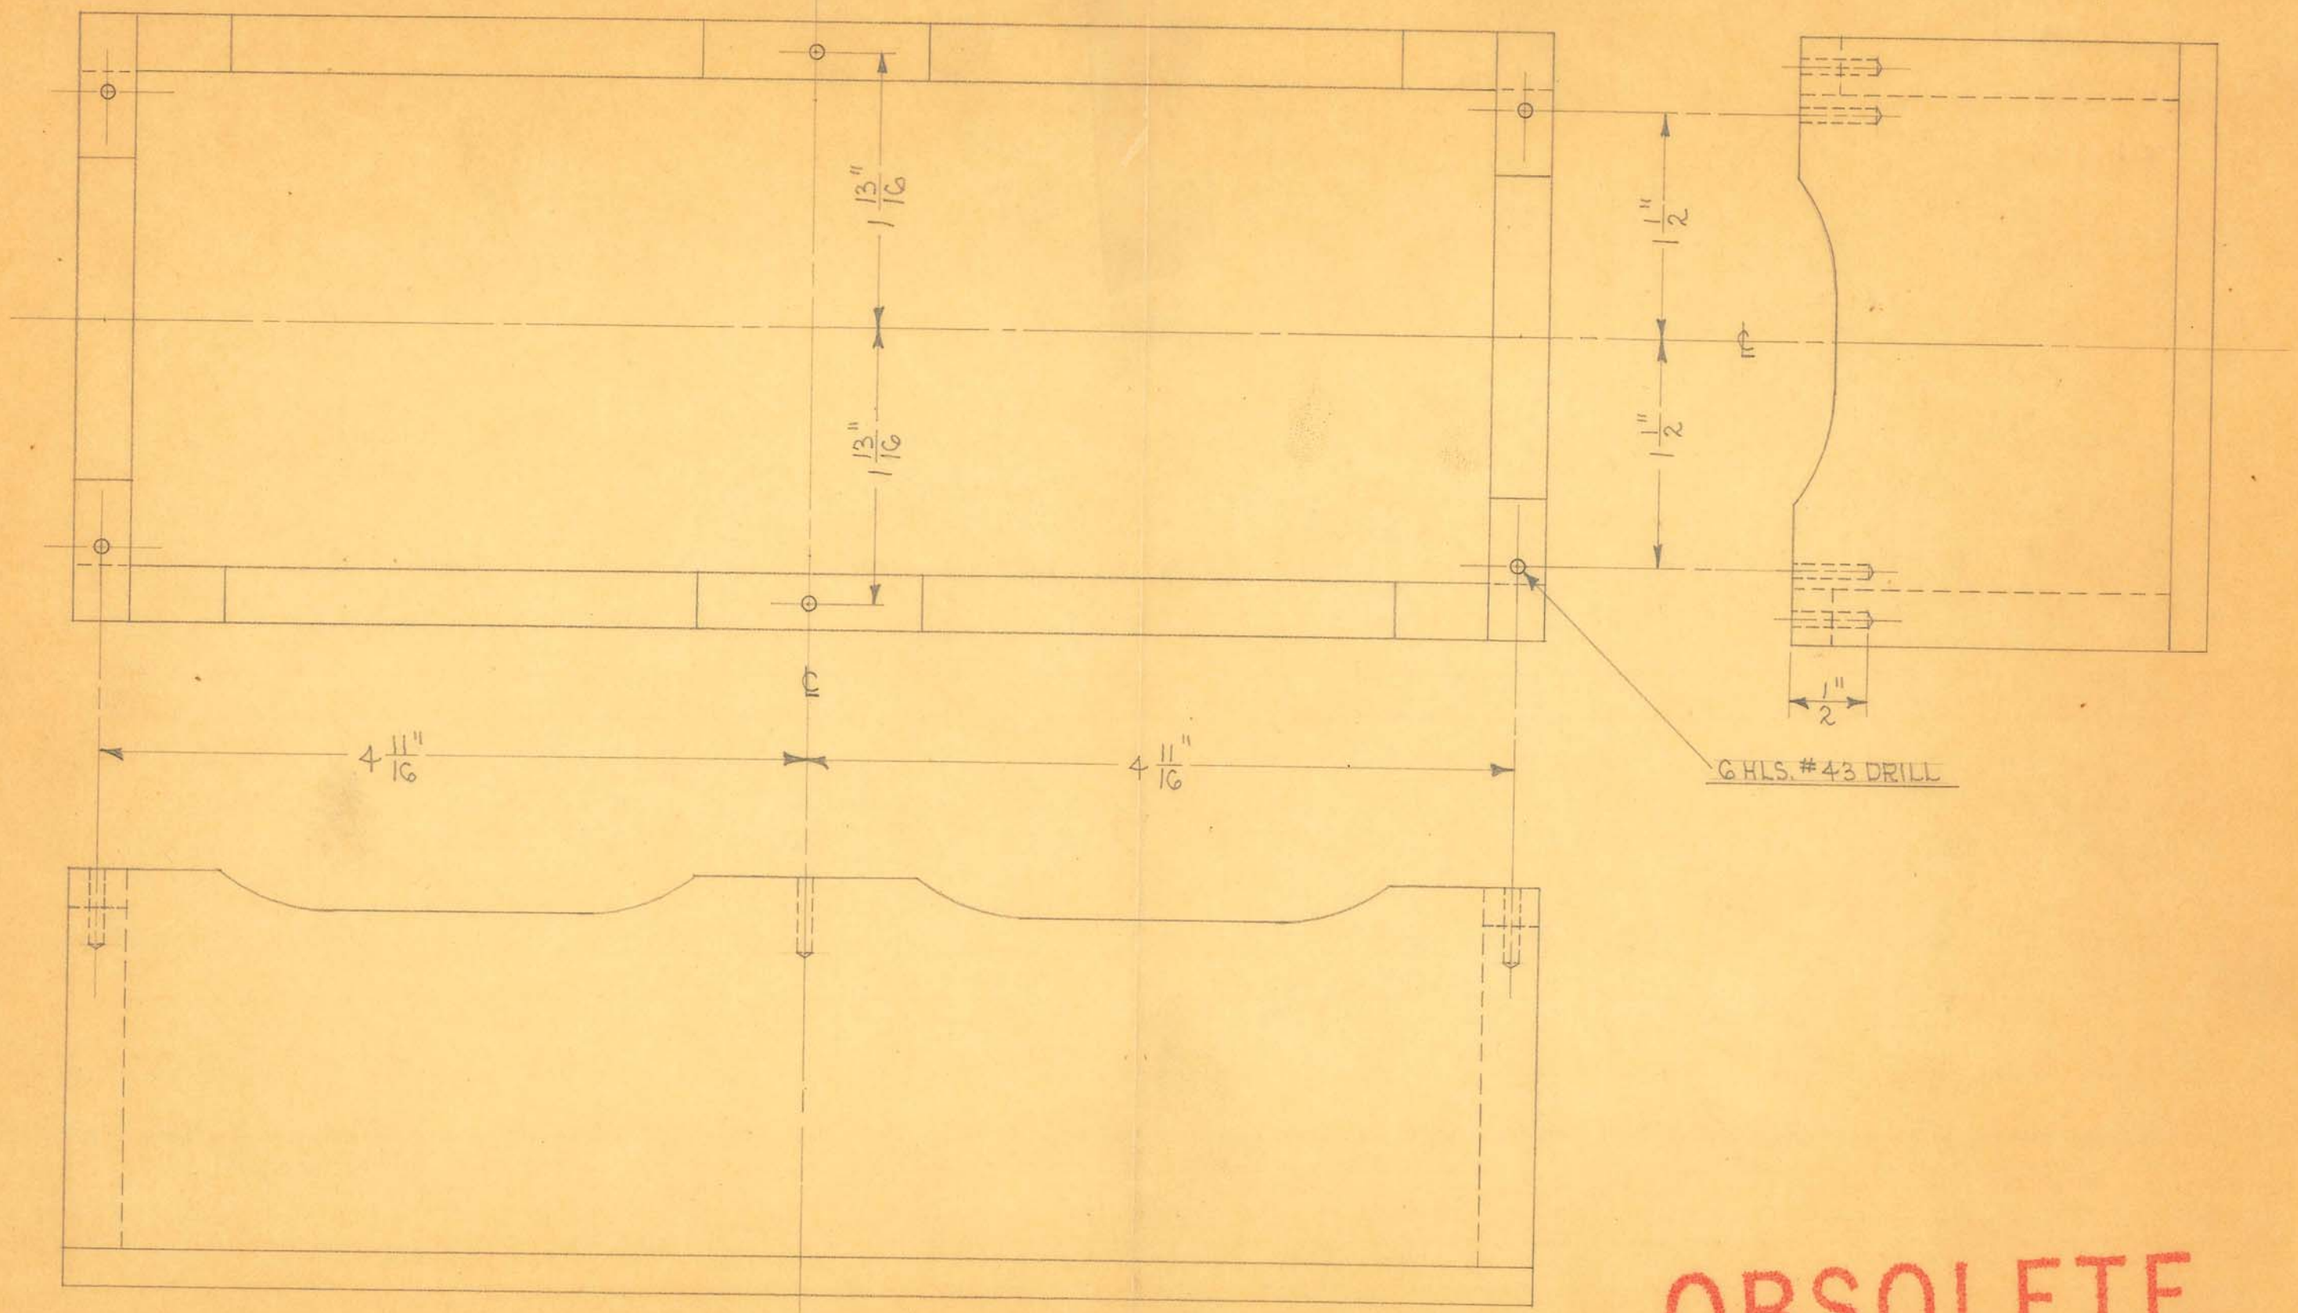

OBSOLETE

SIZE		ISSUE 2-13-36	A.E.
KIND		CHANGED	
SHAPE		" "	
FINISH		" "	
TEMP.		" "	
PATT.		" "	

TITLE: FISCHER SHORT WAVE SURGICAL ATTACHMENT BOX (DRILLED)

H. G. FISCHER & CO.
2335 WABANSIA AVE.

CAT. NO.

PART 94545

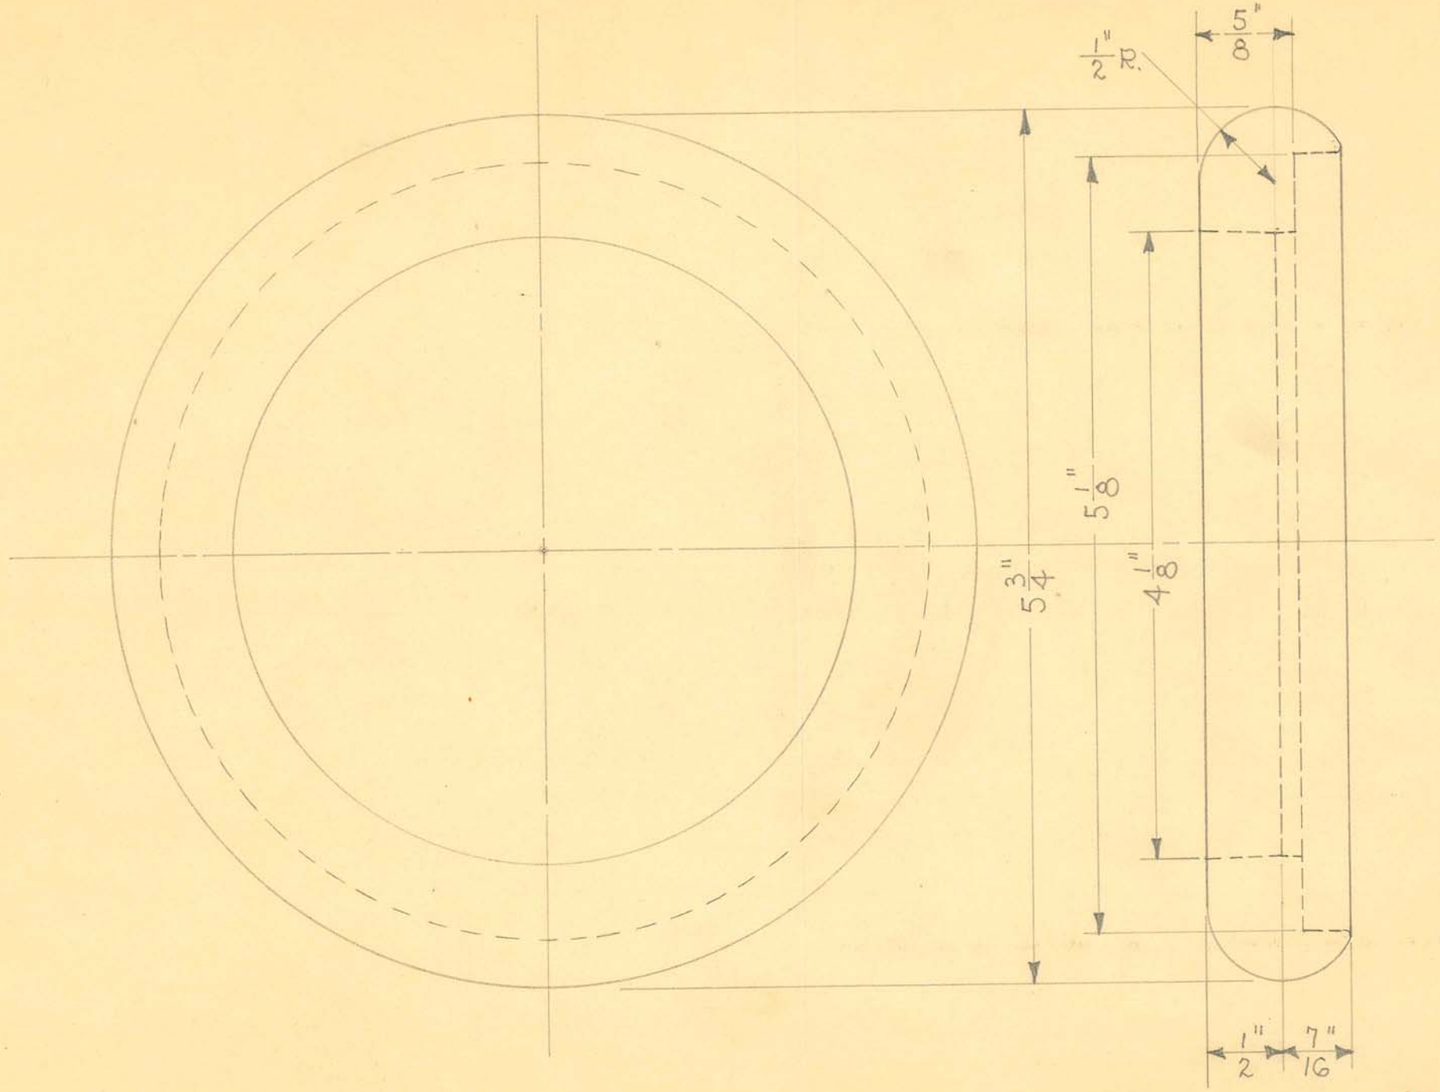

1 REQUIRED

OBSOLETE

SIZE		ISSUE 6-25-36	A.E.
KIND	IRON CASTING	CHANGED	
SHAPE		" "	
FINISH	CHROME #2	" "	
TEMP.		" "	
PATT.	297-259	" "	

TITLE: SHOCKPROOF DENTAL "X" CONTROL BOX SUPPORT RING

H. G. FISCHER & CO.
2335 WABANSIA AVE.
CHICAGO, ILL.

CAT. NO.

PART NO. 9503 1/2 F

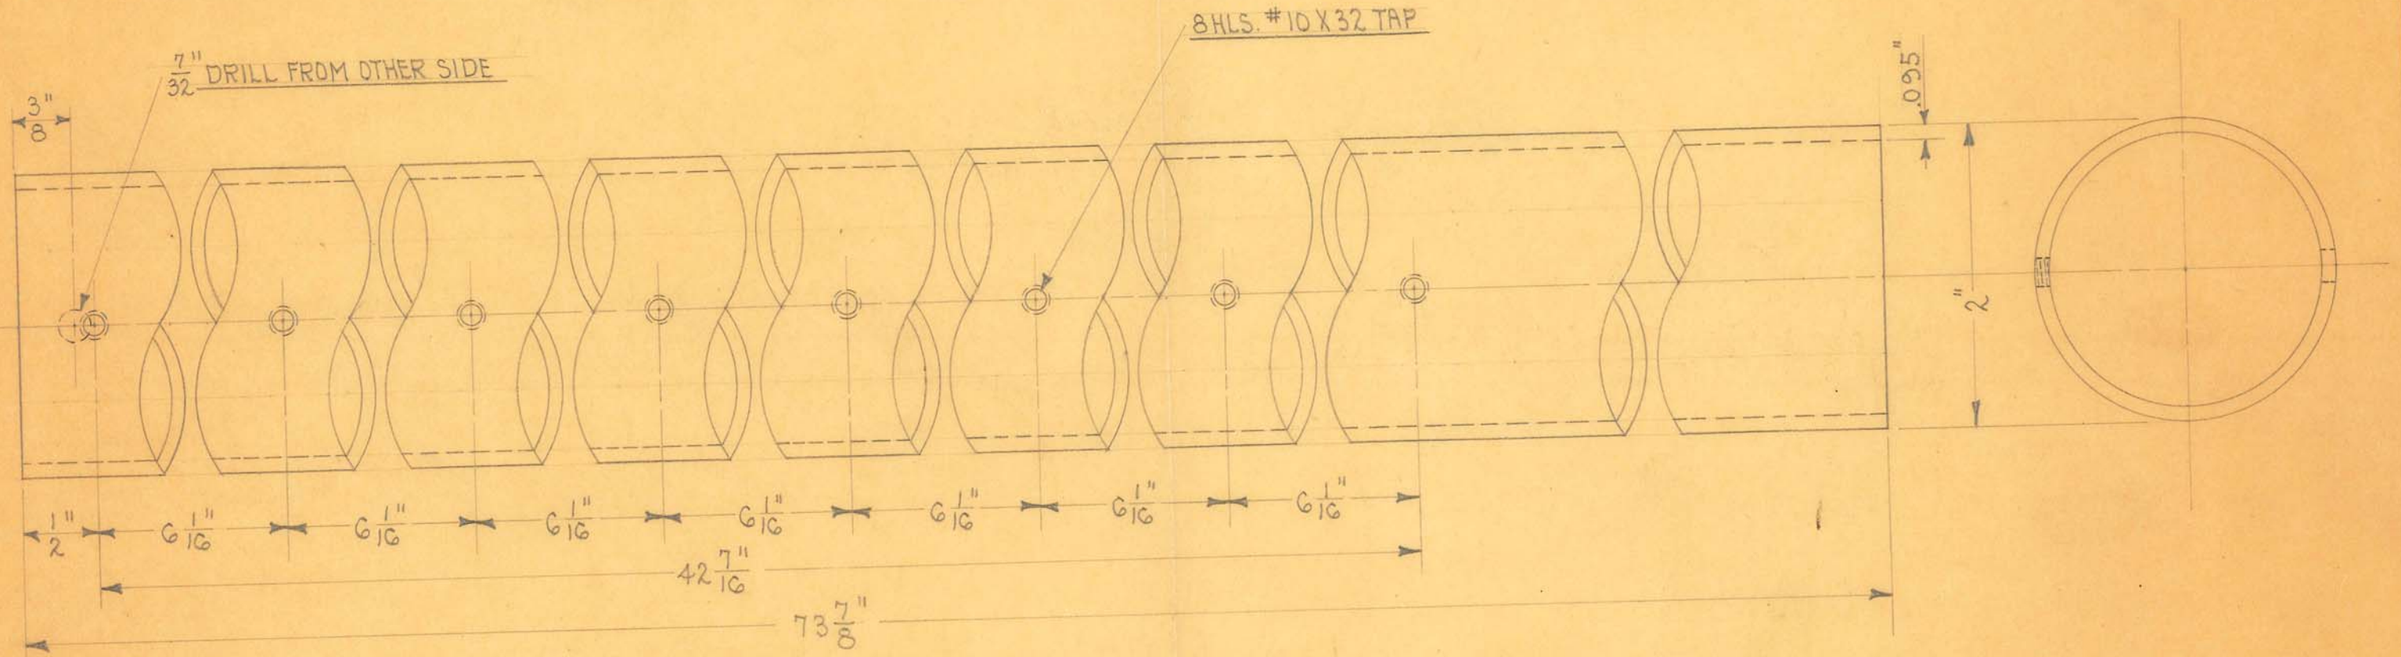

1 REQUIRED

OBSOLETE

SIZE	2" O.D. X #13 GA.	ISSUE 4-24-35	A.E.	TITLE: SHOCKPROOF DENTAL "X" COLUMN
KIND	SEAMLESS STEEL	CHANGED 12-11-35	A.E.	
SHAPE	TUBING	" "		
FINISH	CHROME #2	" "		
TEMP.		" "		
PATT.		" "		

H. G. FISCHER & CO.
2335 WABANSIA AVE.
CHICAGO, ILL.

CAT. NO.

PART NO. 9504AF

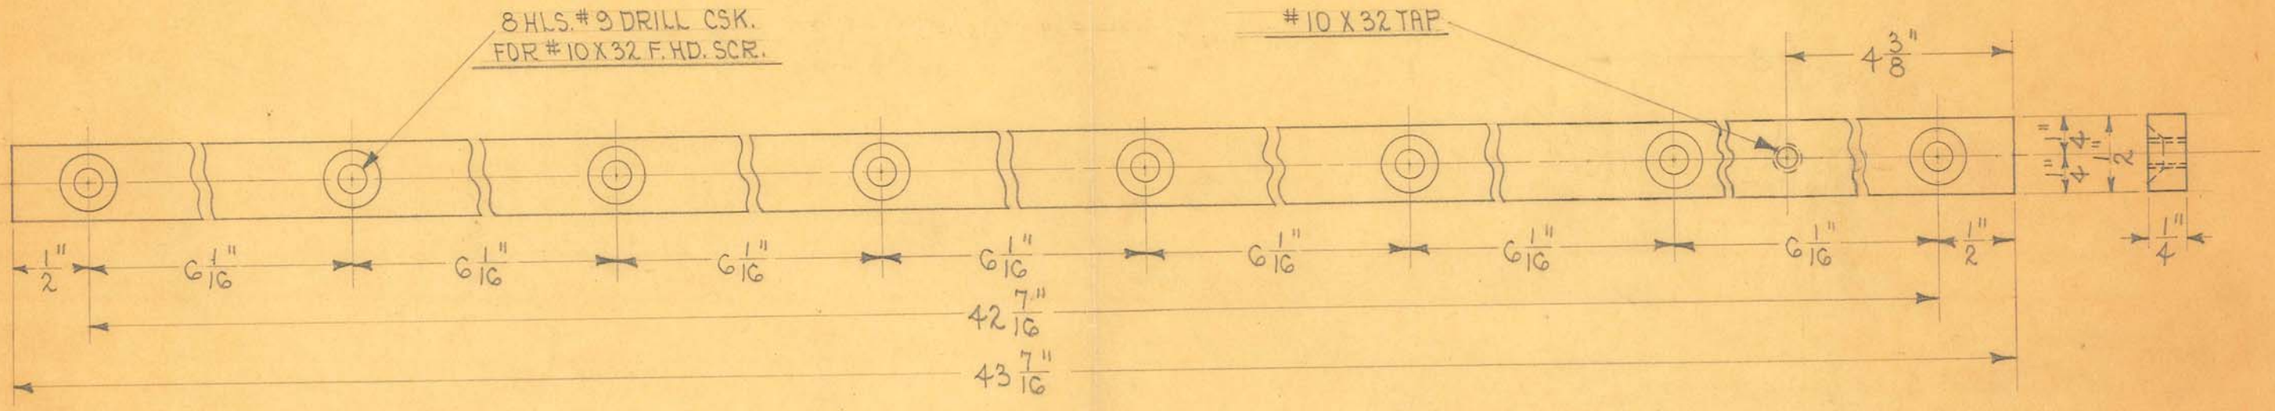

1 REQUIRED

OBSOLETE

SIZE	1/4" X 1/2"	ISSUE 4-24-35	H.E.	TITLE: SHOCKPROOF DENTAL "X" VERTICAL GUIDE STRIP
KIND	C.R. STEEL	CHANGED 2-10-36	H.E.	
SHAPE		" "		
FINISH	CAD. #23	" "		
TEMP.		" "		
DATE		" "		

H. G. FISCHER & CO.
2335 WABANSIA AVE.
CHICAGO, ILL.

CAT. NO.

PART NO. 9506A

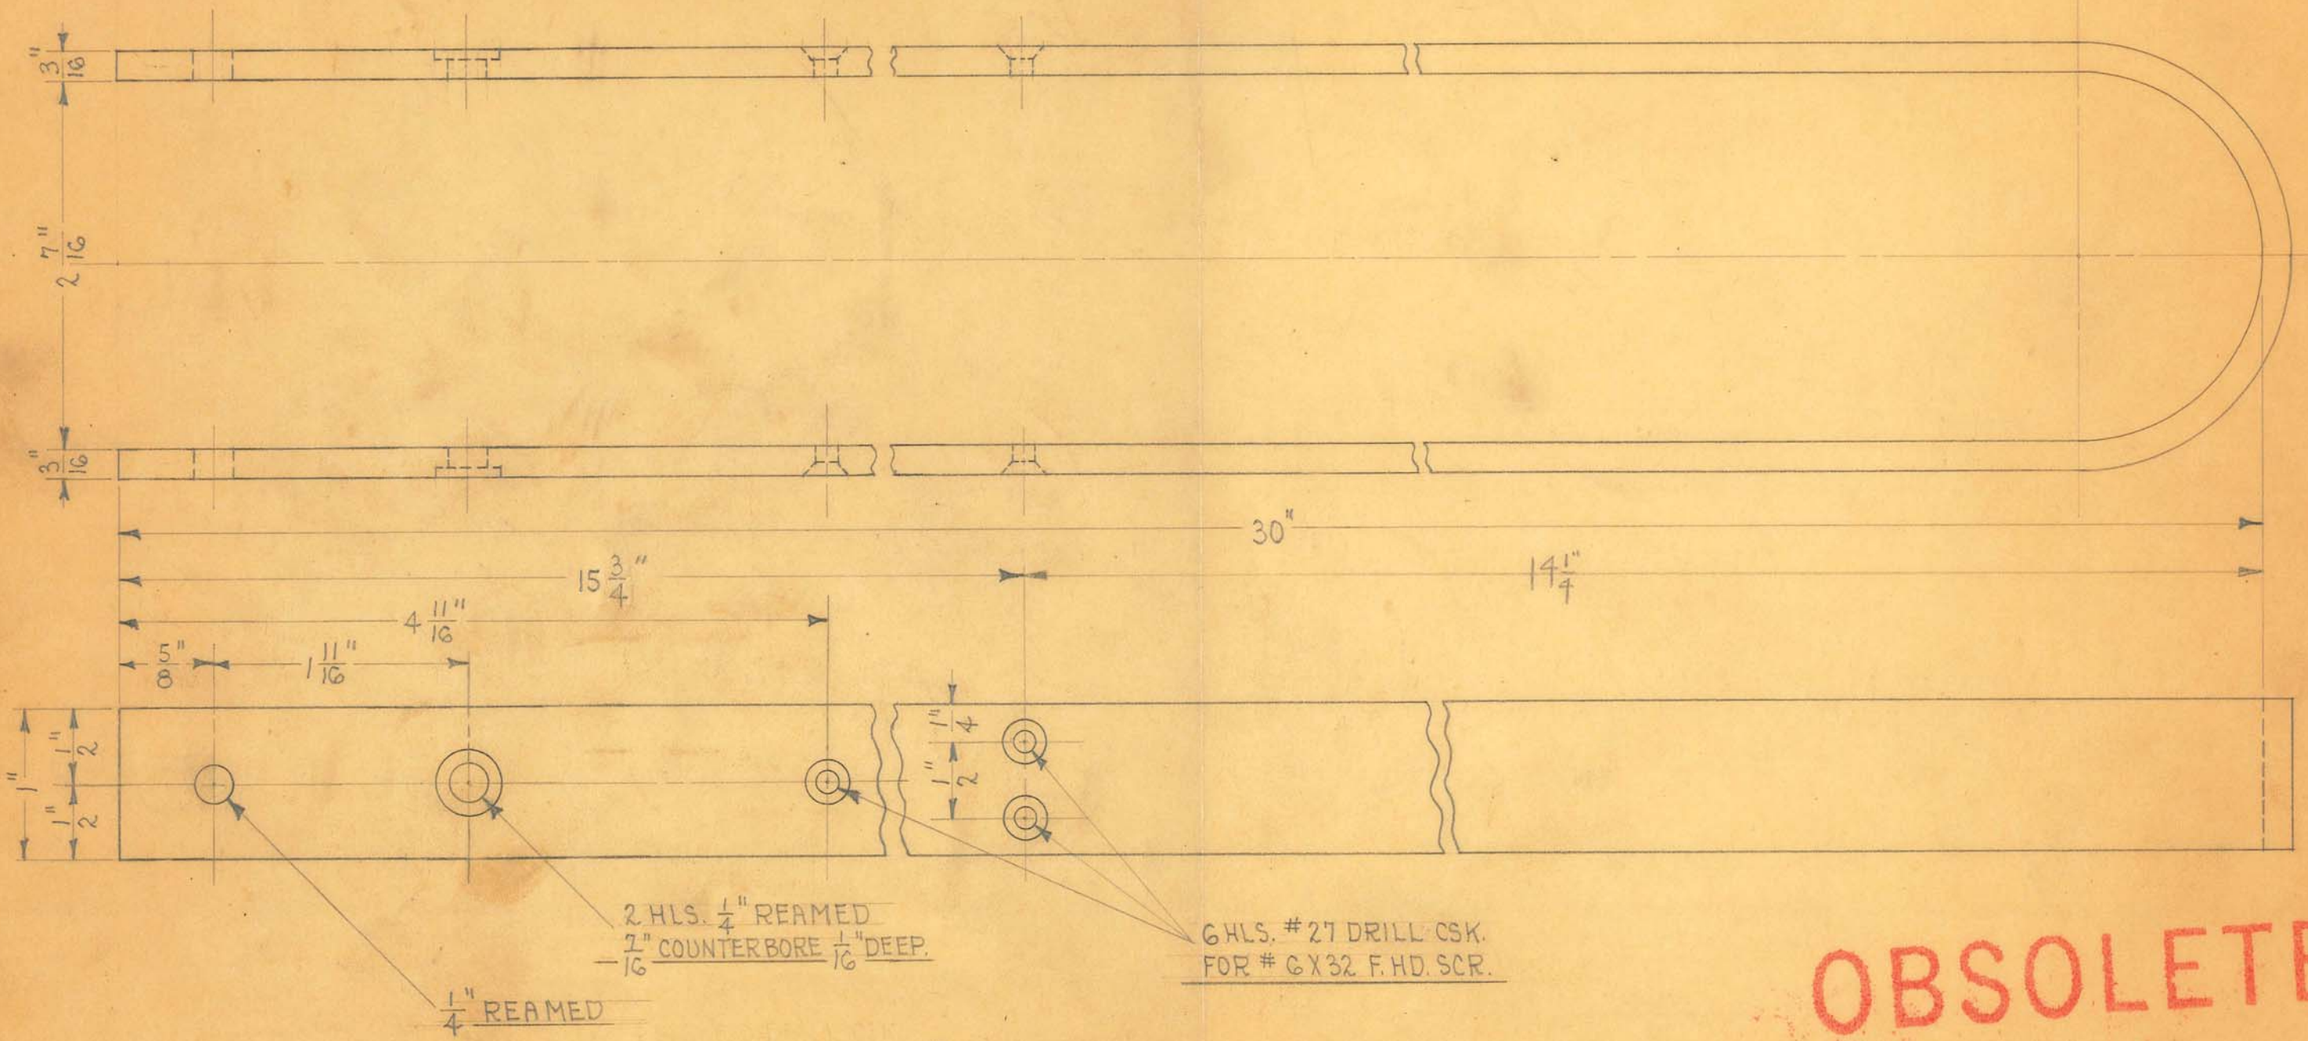

OBSOLETE

1 REQUIRED

DEVELOPED LENGTH - 62 3/8"

NOTES

SEND TO PLATERS IN THE FLAT FOR GRINDING.
1 SIDE - 3 WHEELS & EDGES. 1 SIDE - 2 WHEELS.
WHEN FORMING, FORM WITH BEST SIDE TO THE OUTSIDE.

SIZE	1" X 3/16"	ISSUE 5-21-35	J.E.
KIND	C.R. STEEL BAR	CHANGED 2-10-36	J.E.
SHAPE		" "	
FINISH	CHROME #2	" "	
TEMP.		" "	

TITLE: SHOCKPROOF DENTAL "X" HORIZONTAL SLIDE U-BAR

H. G. FISCHER & CO.
2335 WABANSIA AVE.

CAT. NO.

PART NO. 9508A

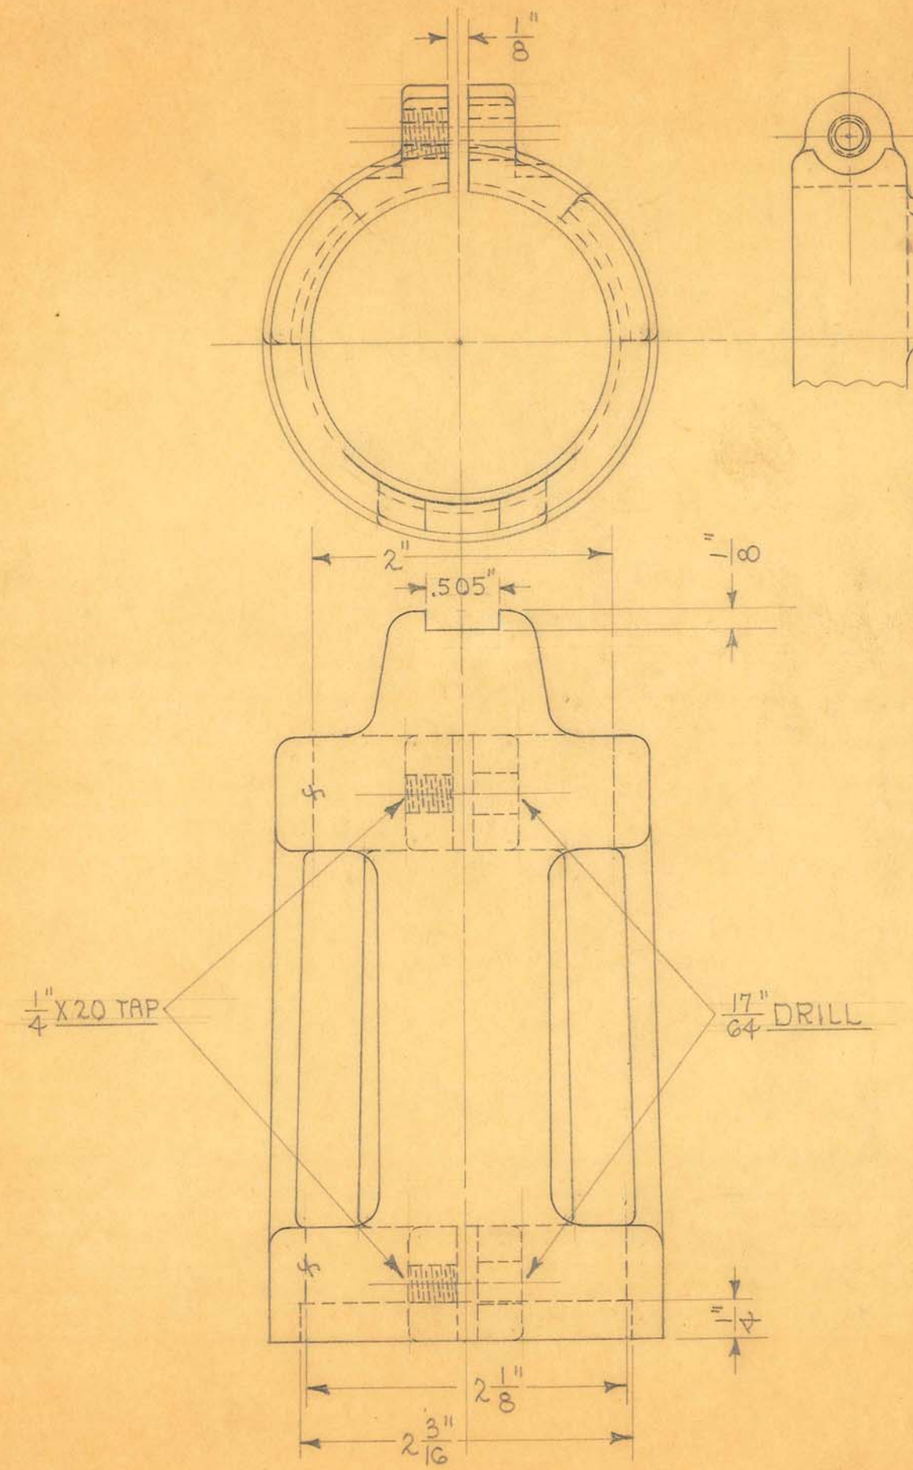

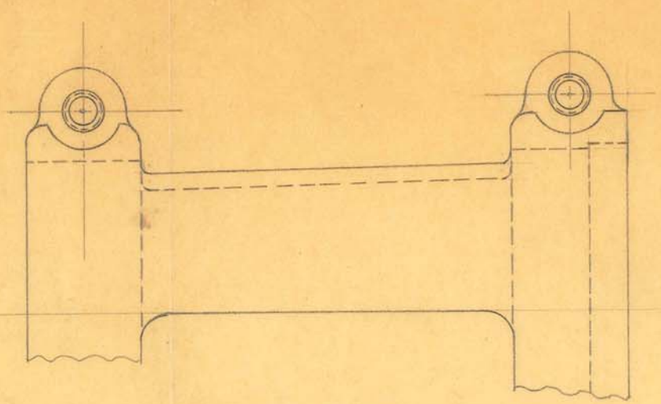

OBSOLETE

SIZE		ISSUE 2-12-36	2/8.
KIND	BRASS CASTING	CHANGED	
SHAPE		" "	
FINISH	MAH. #51	" "	
TEMP.		" "	
PATT.	4944-924	" "	

TITLE: SHOCKPROOF DENTAL "X" CONE BEARING CLAMP

H. G. FISCHER & CO.
2335 WABANSIA AVE.
CHICAGO, ILL.

CAT. NO.

PART NO. 9509AF

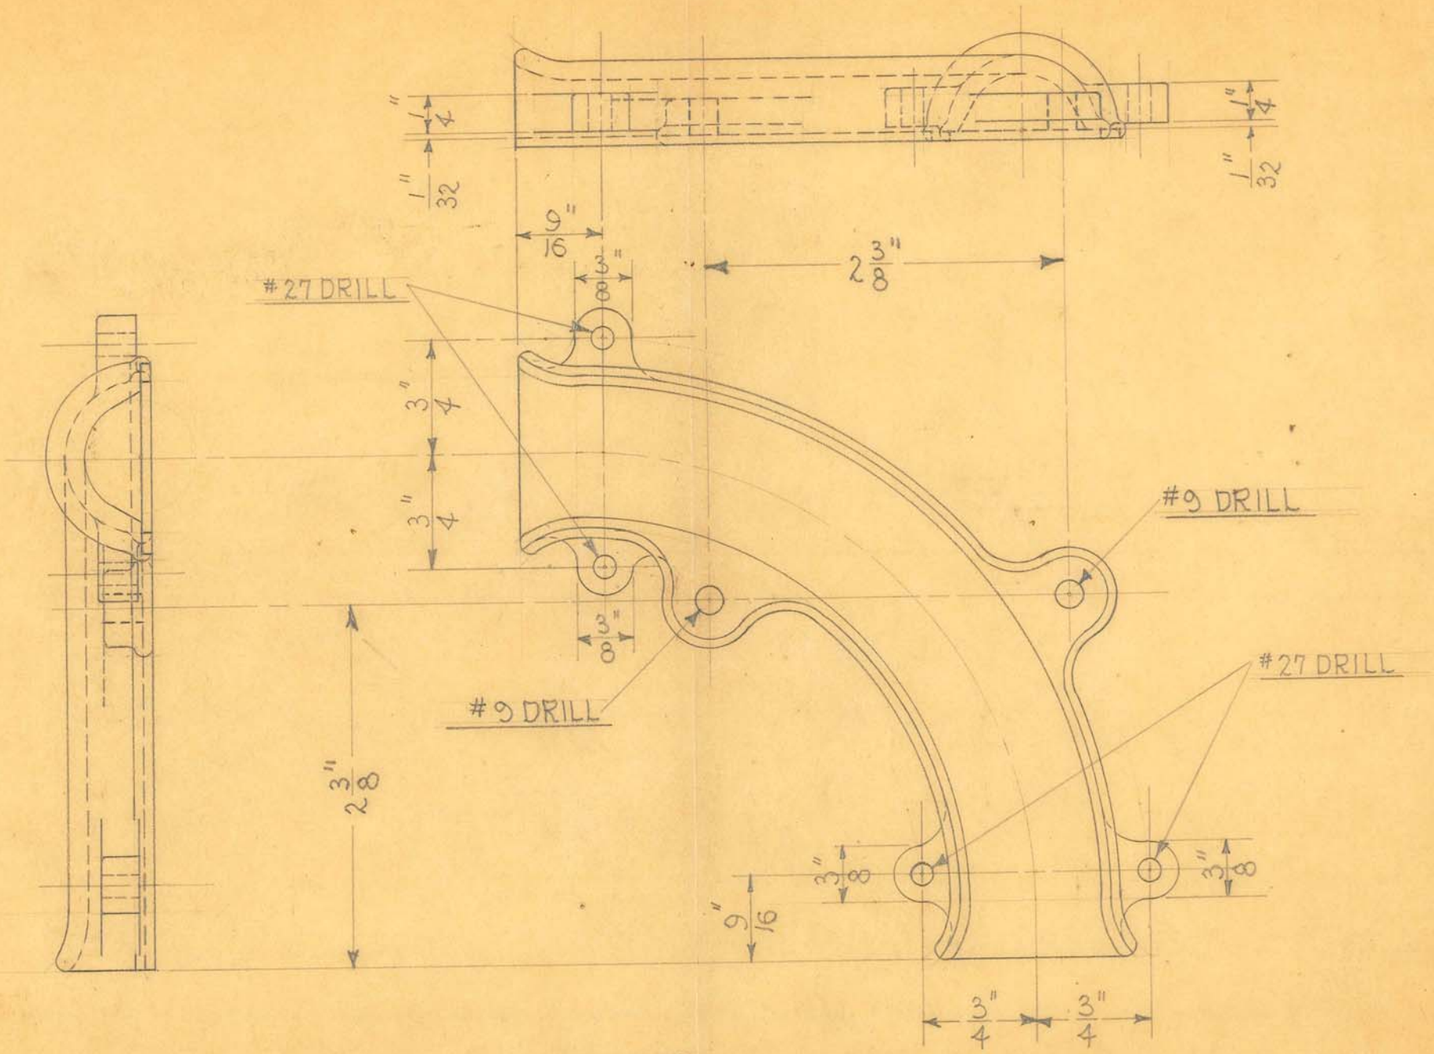

2 REQUIRED

OBSOLETE

SIZE		ISSUE 5-2-35	A.E.
KIND	ALUM. CASTING	CHANGED 5-18-38	A.E.
SHAPE		" "	
FINISH	MAH. #51	" "	
TEMP.		" "	
PATT.	7057-819	" "	

TITLE: SHOCKPROOF DENTAL "X" UPRIGHT TUBE SLIDE RADIUS CABLE SUPP. - RIGHT

H. G. FISCHER & CO.
2335 WABANSIA AVE.
CHICAGO, ILL.

CAT. NO.

PART NO. 9514 AF

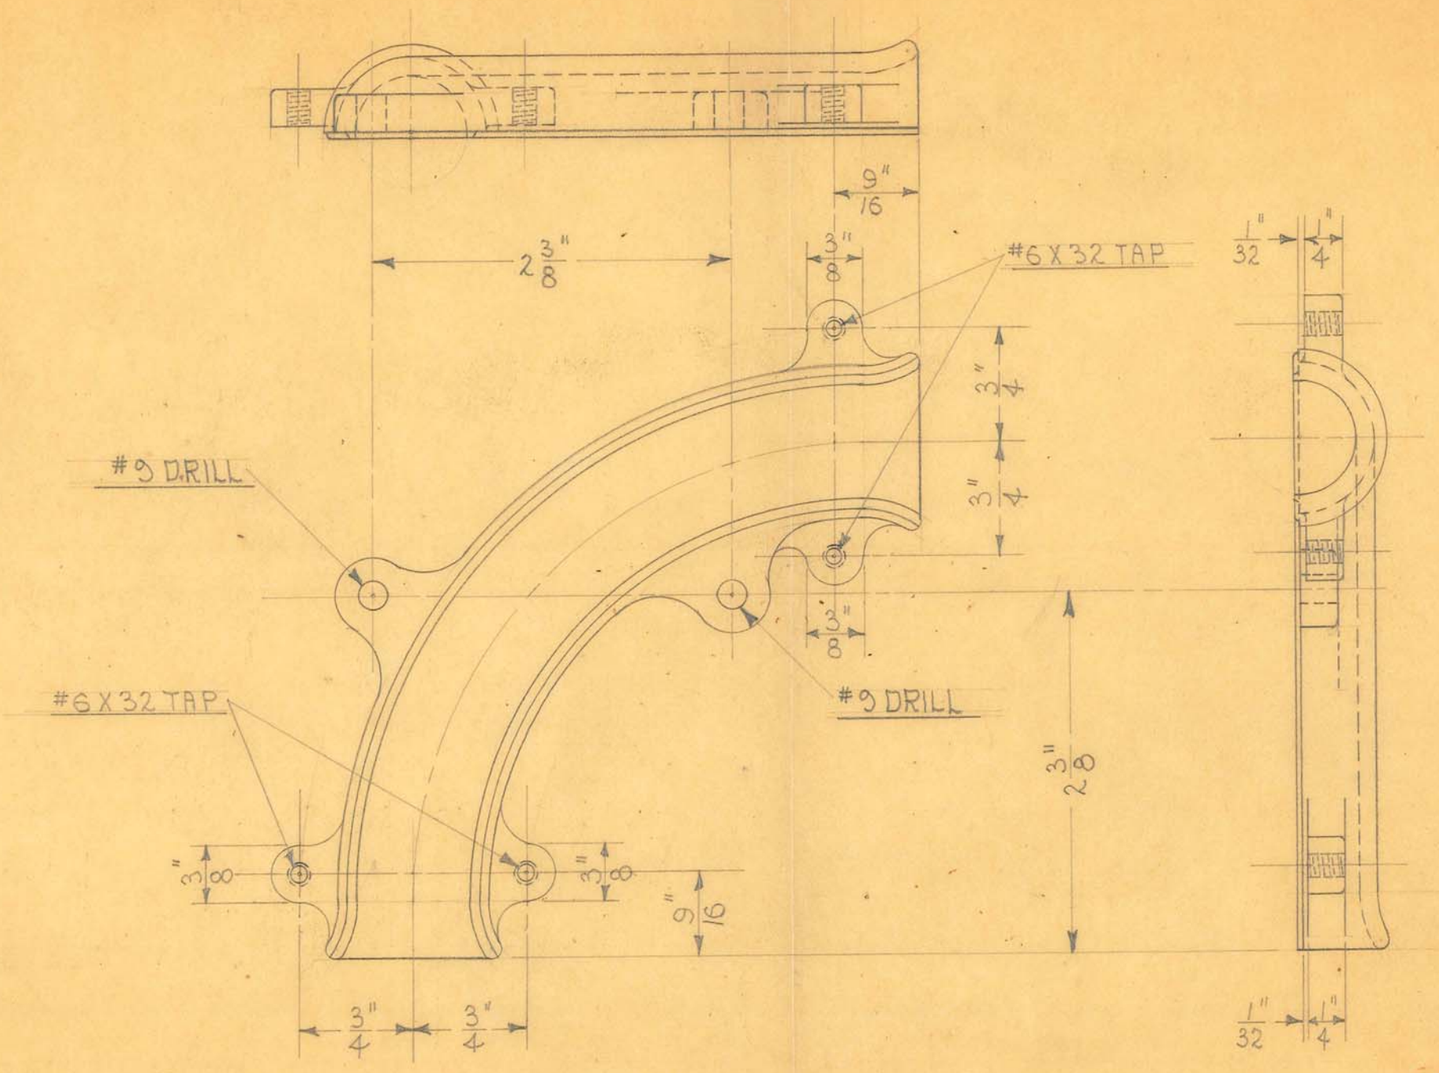

2 REQUIRED

OBSOLETE

SIZE		ISSUE 5-1-35	A.E.
KIND	ALUM. CASTING	CHANGED 5-18-38	A.E.
SHAPE		" "	
FINISH	MAH. #51	" "	
TEMP.		" "	

TITLE: SHOCKPROOF DENTAL "X" UPRIGHT TUBE SLIDE RADIUS CABLE SUPP. - LEFT

H. G. FISCHER & CO.
2335 WABANSIA AVE.
CHICAGO, ILL.

CAT. NO.

PART NO. 9515A F

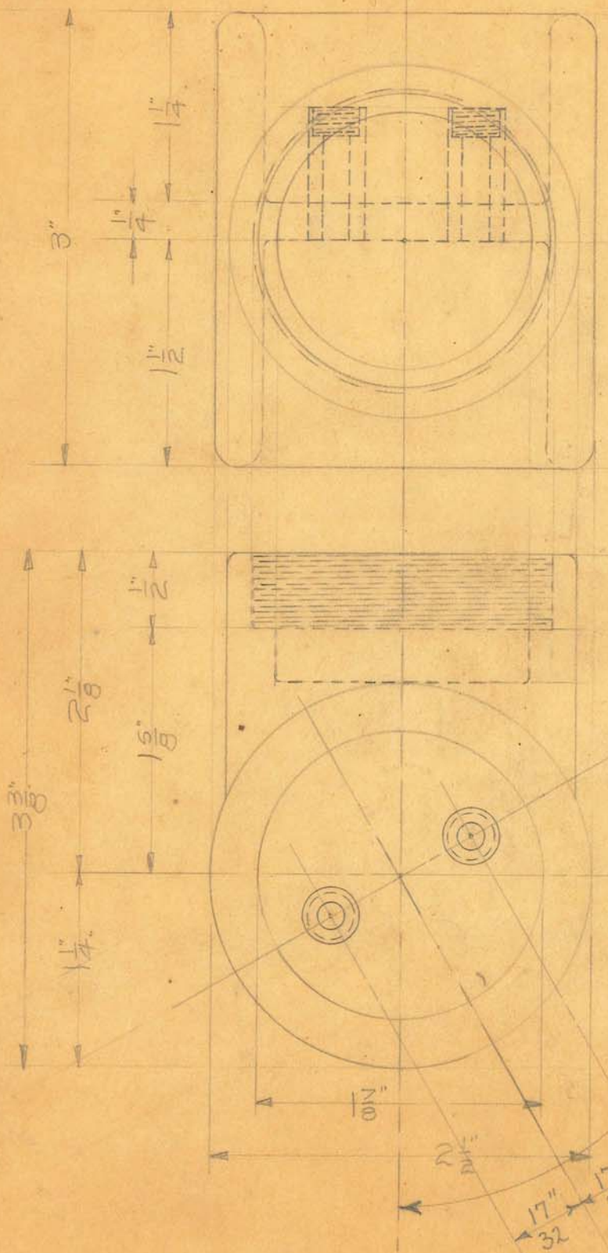

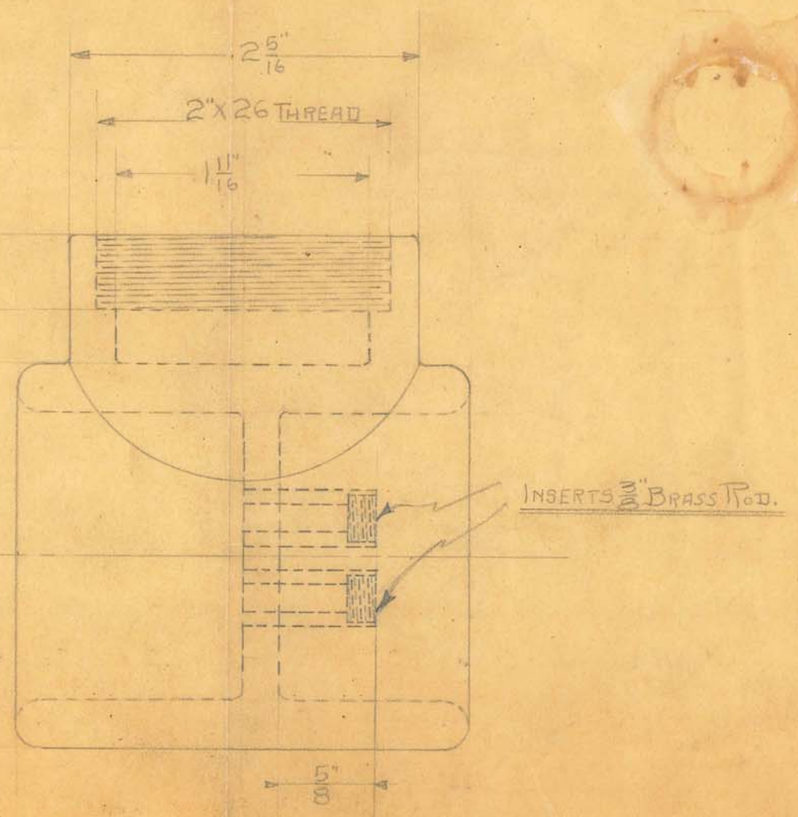

OBSOLETE

SIZE		ISSUE	
KIND		CHANGED	
SHAPE		" "	
FINISH		" "	
TEMP.		" "	
PATT.		" "	

TITLE: SHOCK-PROOF DENTAL X RAY CATHODE CONNECTION SUPPORT

H. G. FISCHER & CO.
2335 WABANSIA AVE.
CHICAGO, ILL.

CAT. NO.

PART NO. 95306

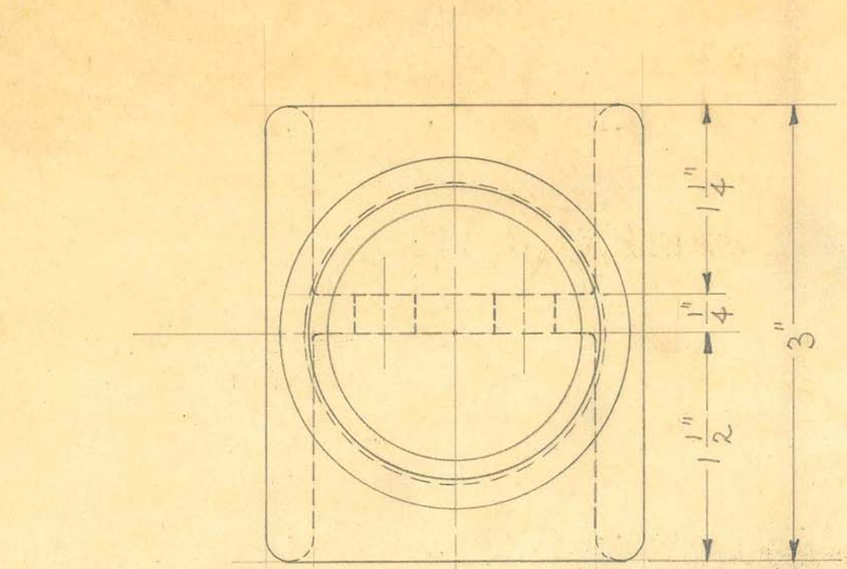

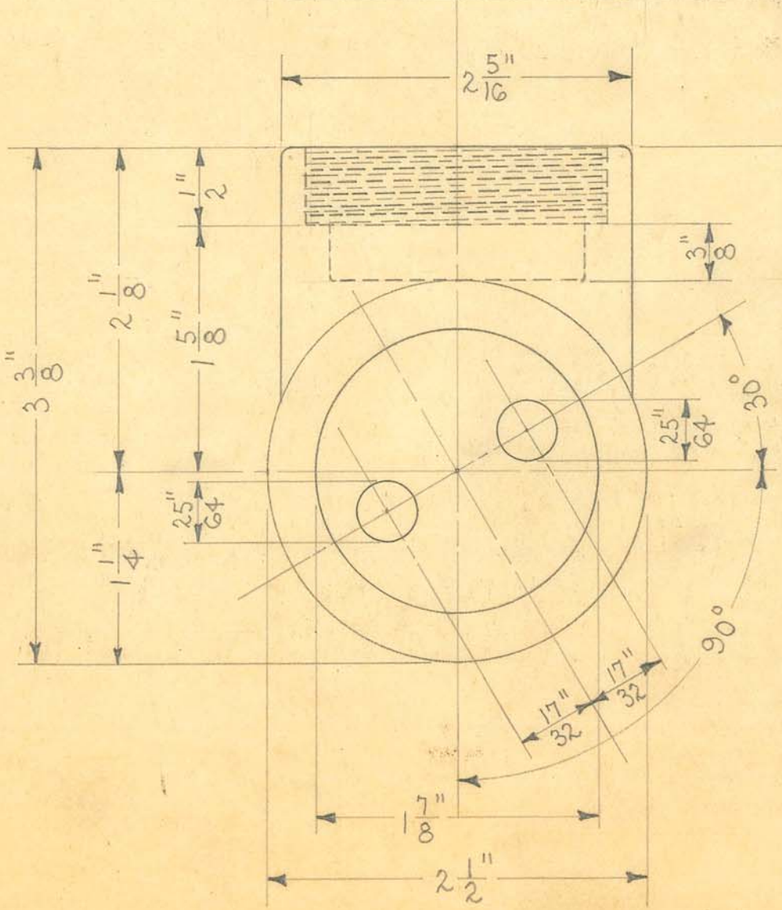

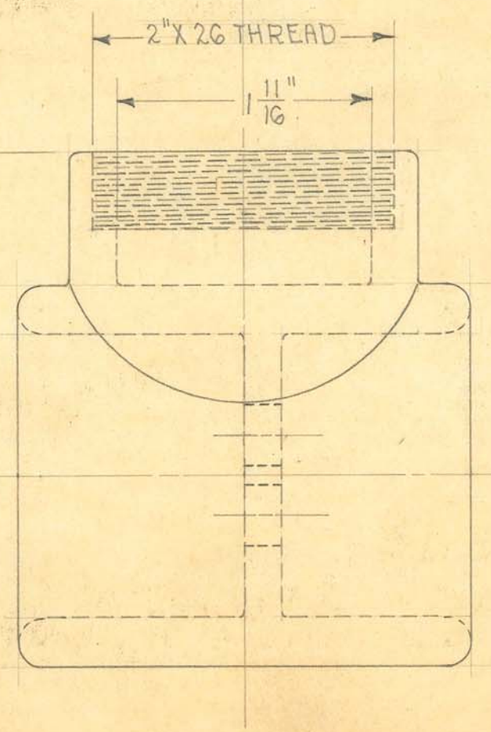

OBSOLETE

C.M.P.C. MOLD #1613

SIZE		ISSUE 3-18-36	H.E.
KIND	MOLDED BAKELITE	CHANGED	
[redacted]	MOLD #1767	" "	
FINISH		" "	
TEMP.		" "	

TITLE:
SHOCKPROOF DENTAL "X" CATHODE
CONNECTION SUPPORT

H. G. FISCHER & CO.
2335 WABANSIA AVE.

CAT. NO.

PART NO. 2530 1/2

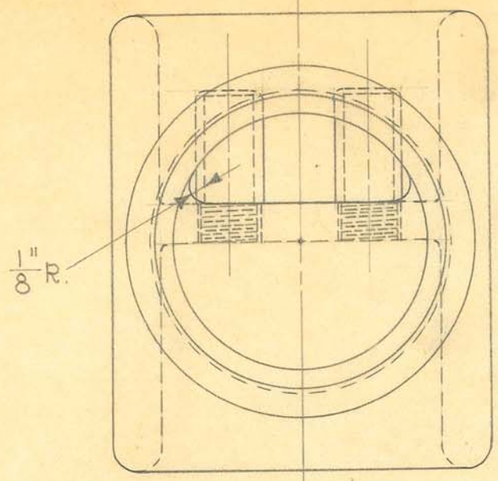

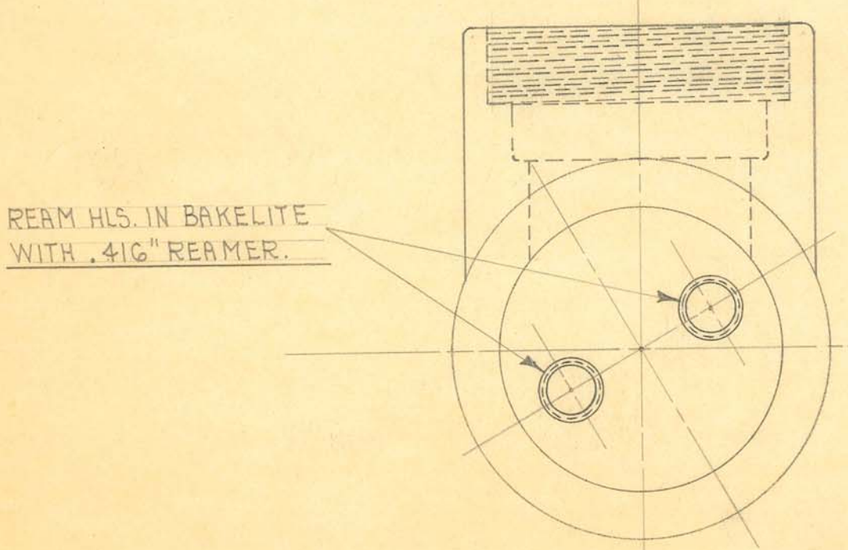

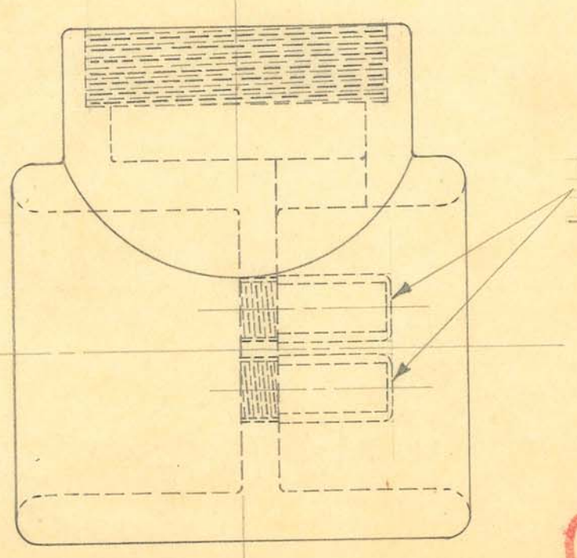

OBSOLETE

SIZE		ISSUE 3-18-36	A.E.
KIND	MOLDED BAKELITE	CHANGED	
SHAPE		" "	
FINISH		" "	
TEMP.		" "	
PATT.		" "	

TITLE: SHOCKPROOF DENTAL "X" CATHODE CONNECTION SUPPORT ASSEM.

H. G. FISCHER & CO.
2335 WABANSIA AVE.
CHICAGO, ILL.

CAT. NO.

PART NO. 9530 1/2 G

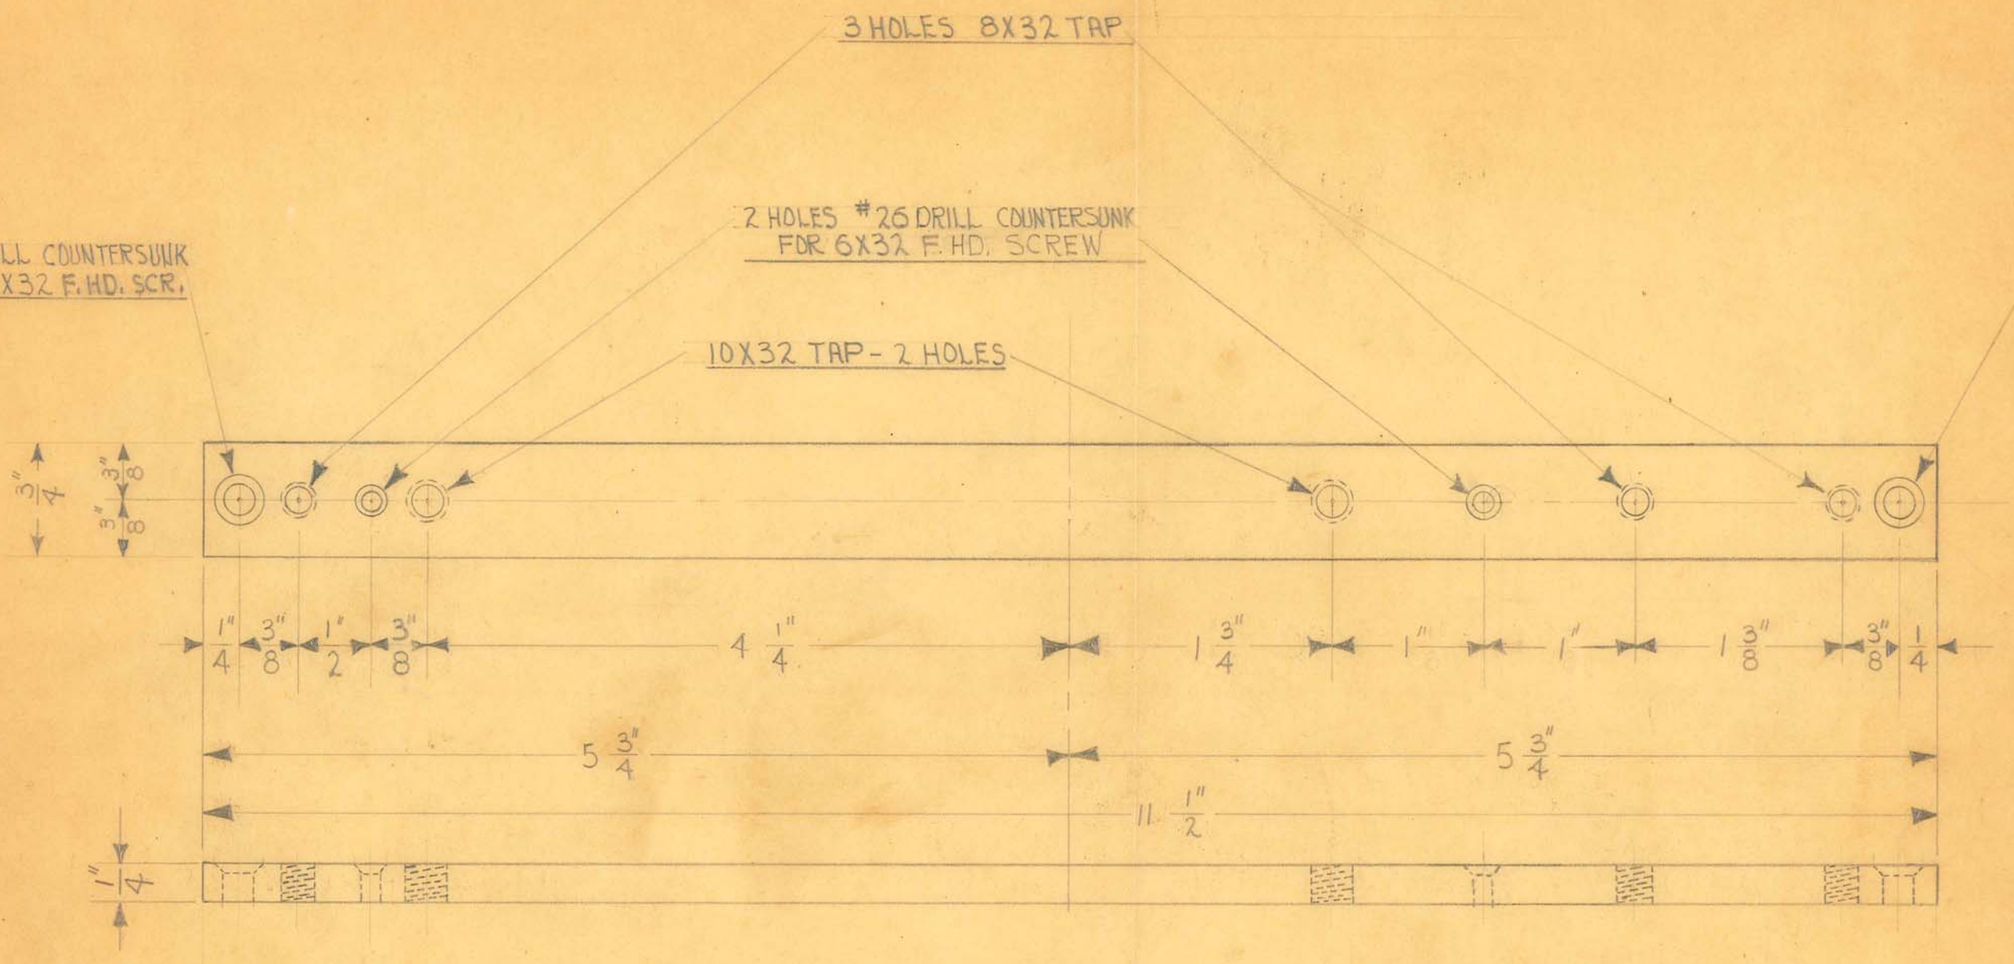

1 REQUIRED

OBSOLETE

SIZE	1/4" X 3/4" BAR	ISSUE 5-13-35	J.W.	TITLE: SHOCKPROOF DENTAL X AUTO TRANSF. SUPPORT - LOWER
KIND	C.R. STEEL	CHANGED		
SHAPE		" "		
FINISH	STD. BLK. #80	" "		
TEMP.		" "		
PATT.		" "		

H. G. FISCHER & CO.
2335 WABANSIA AVE.
CHICAGO, ILL.

CAT. NO.

PART NO. 9536

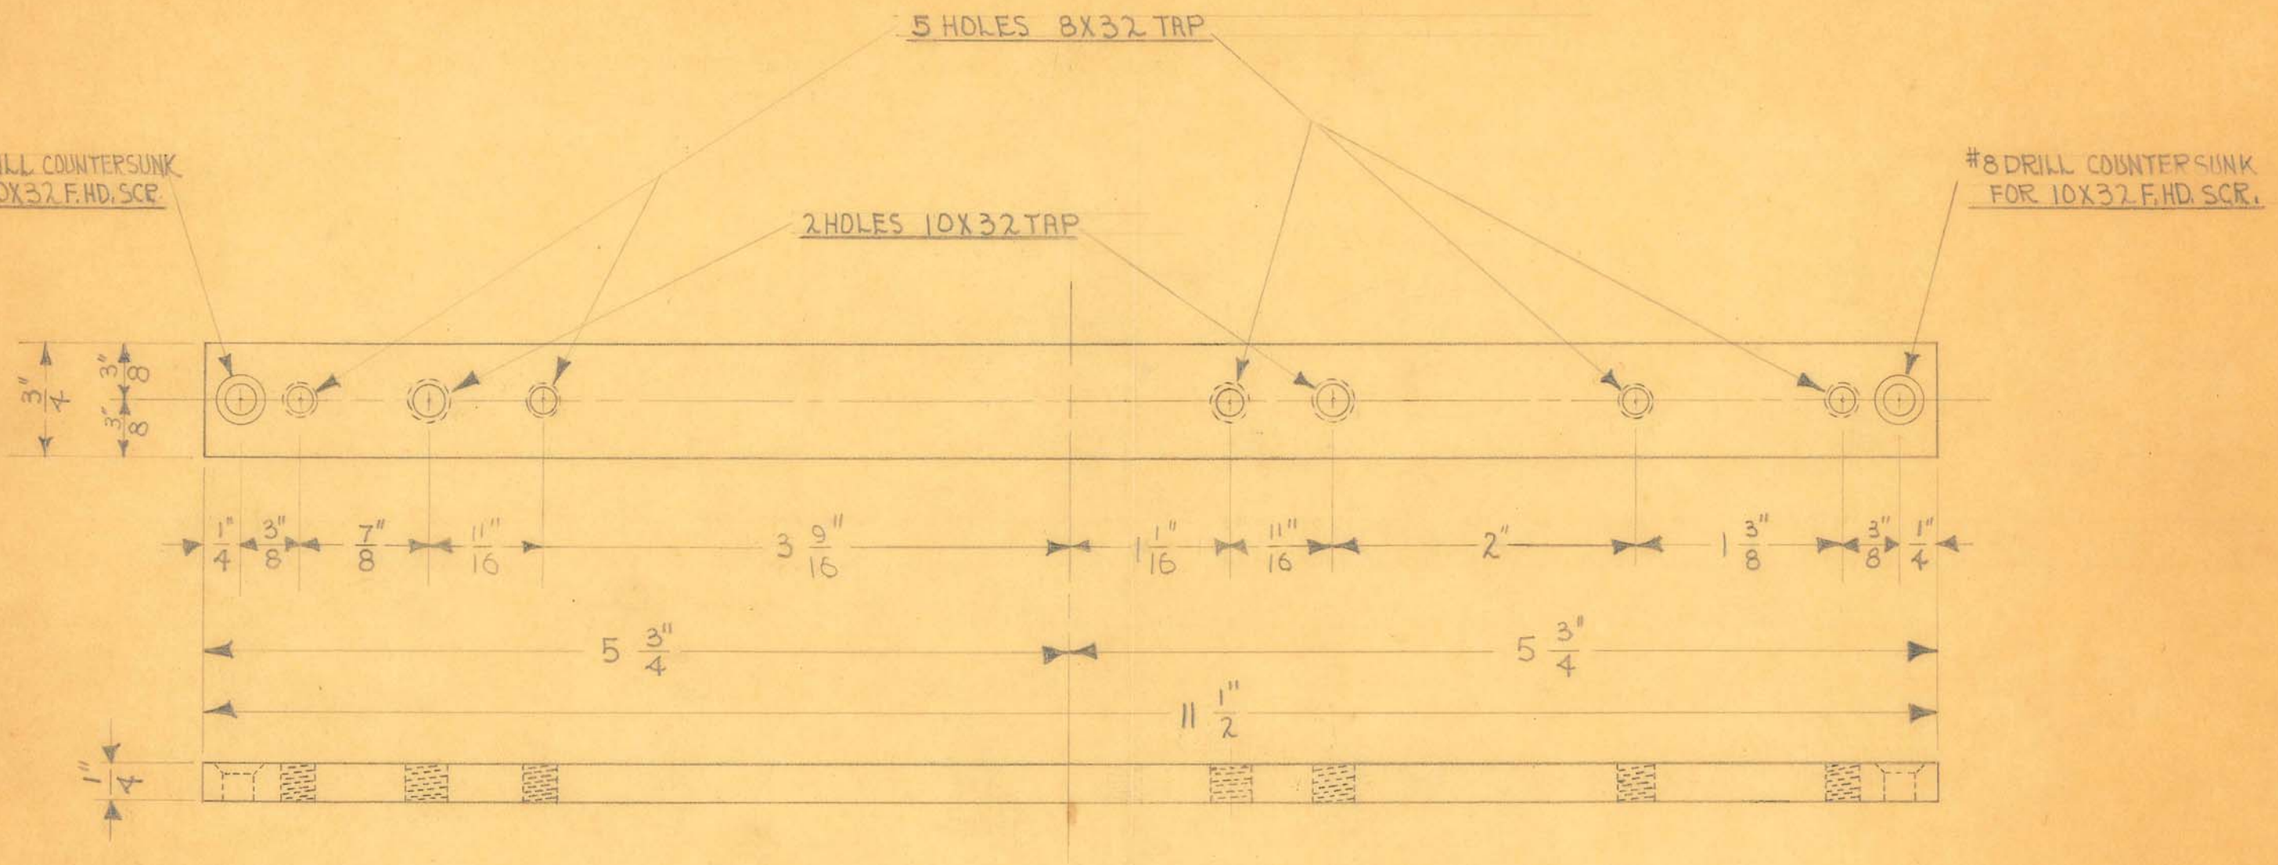

1 REQUIRED

OBSOLETE

SIZE	1/4" X 3/4" BAR	ISSUE 5-13-35	J.W	TITLE: SHOCKPROOF DENTAL X AUTO TRANSF. SUPPORT - UPPER
KIND	C.R. STEEL	CHANGED		
SHAPE		" "		
FINISH	STD. BLK. #80	" "		
TEMP.		" "		

H. G. FISCHER & CO.
2335 WABANSIA AVE.

CAT. NO.

PART NO. 9537

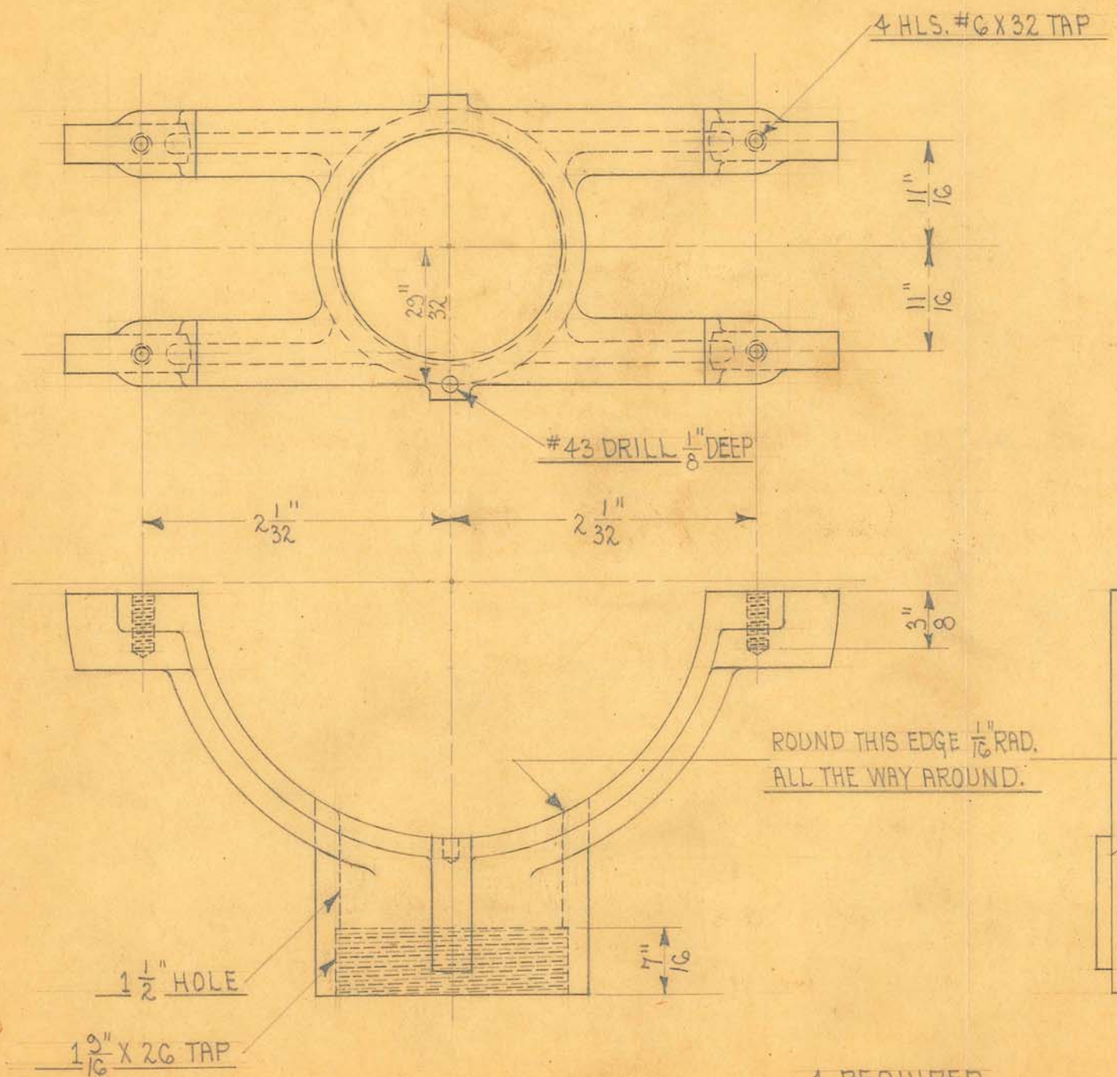

1 REQUIRED

OBSOLETE

SIZE		ISSUE 4-19-35	A.E.	TITLE: SHOCKPROOF DENTAL "X" - X-RAY TUBE HOLDER LOWER CLAMP
KIND	ALUM. CASTING	CHANGED		
SHAPE		" "		
FINISH	BLACK #60	" "		
TEMP.		" "		H. G. FISCHER & CO. 2335 WABANSIA AVE. CHICAGO, ILL. — CAT. NO. — PART NO. 9546F
PATT.	7756-814	" "		

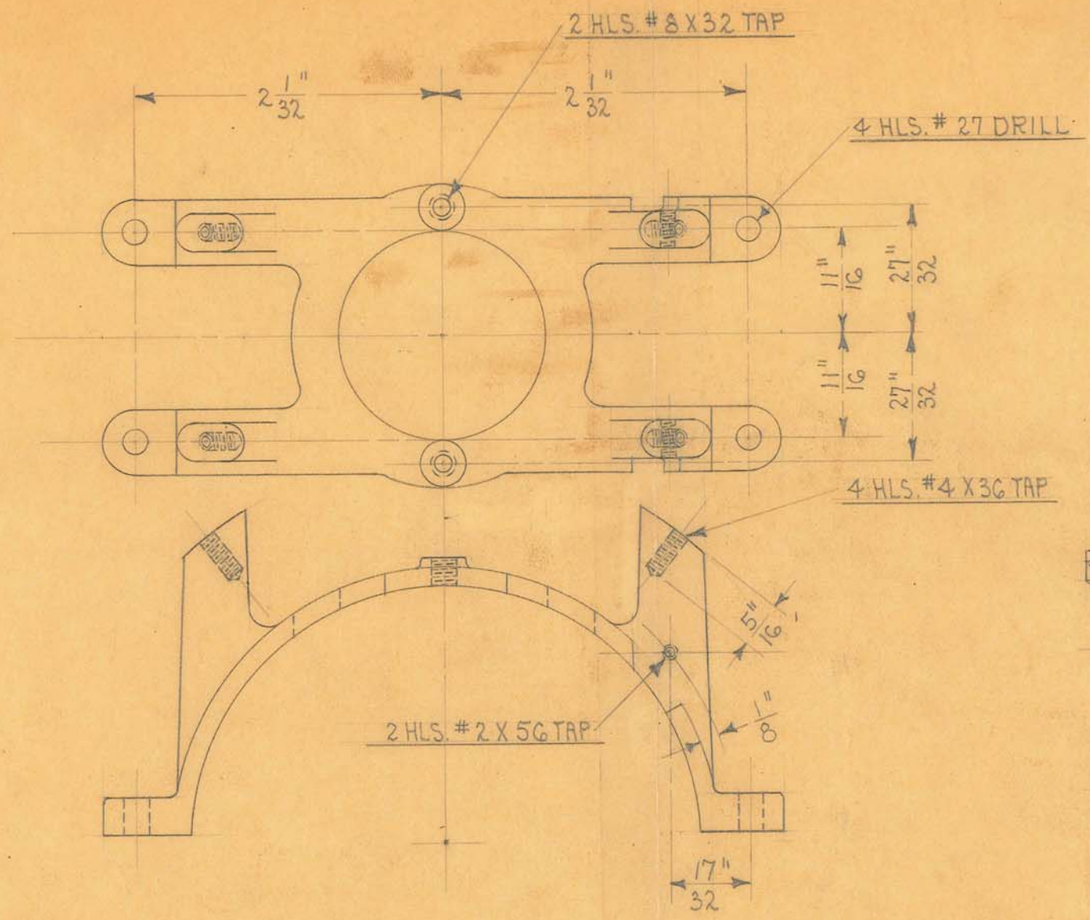

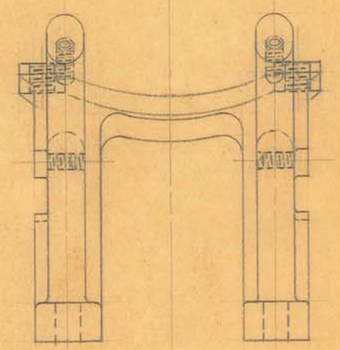

1 REQUIRED

OBSOLETE

SIZE		ISSUE 4-20-35	A.E.
KIND	ALUM. CASTING	CHANGED	
SHAPE		" "	
FINISH	BLACK # 80	" "	
TEMP.		" "	

TITLE: SHOCKPROOF DENTAL "X" X-RAY TUBE HOLDER UPPER CLAMP

H. G. FISCHER & CO.
2335 WABANSIA AVE.

CAT. NO.

PART NO. 9547F

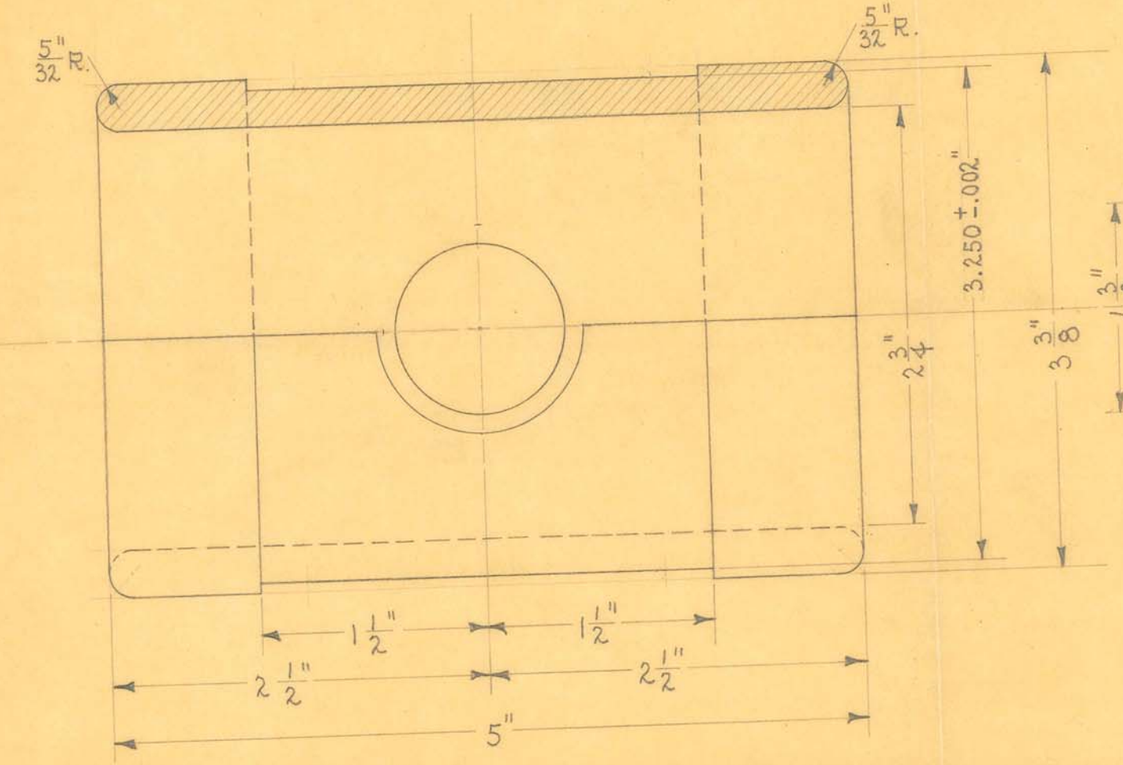

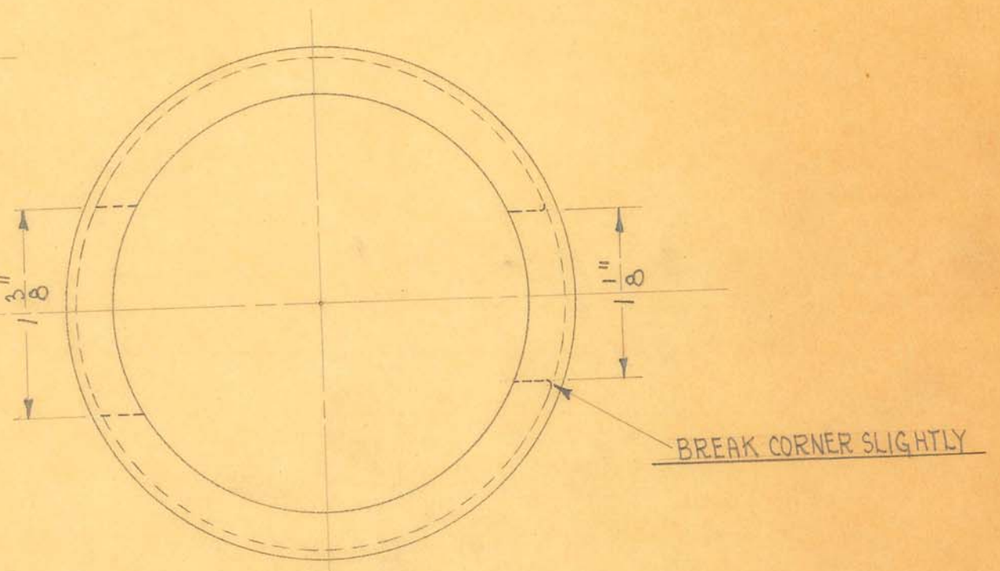

1 REQUIRED

OBSOLETE

SIZE	2 3/4" I.D. X 3 3/8" O.D.	ISSUE 4-18-35	A.E.
KIND	NAT. BAKELITE	CHANGED	
~~SHAPE~~	TUBING	" "	
FINISH		" "	
TEMP.		" "	

TITLE: SHOCKPROOF DENTAL "X" TUBE SHIELD TUBE

H. G. FISCHER & CO.
2335 WABANSIA AVE.
CHICAGO, ILL.

CAT. NO.

PART NO. 9549

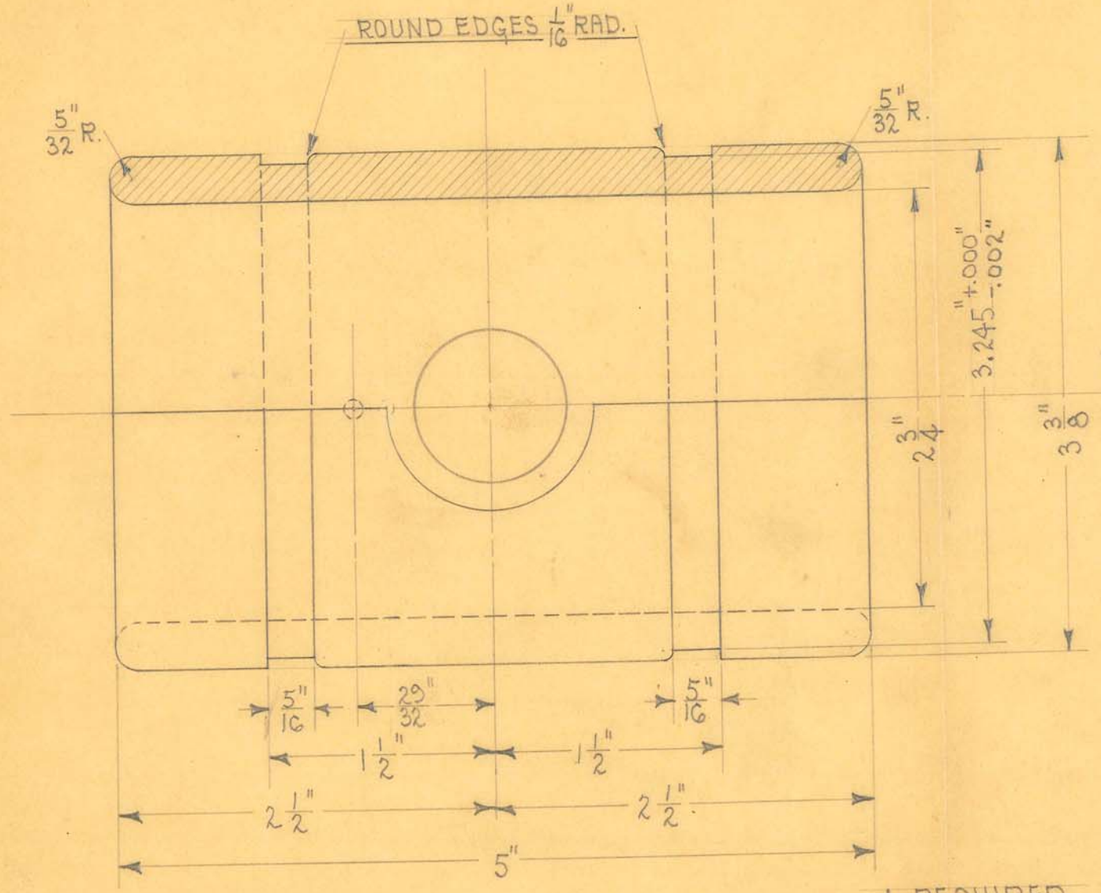

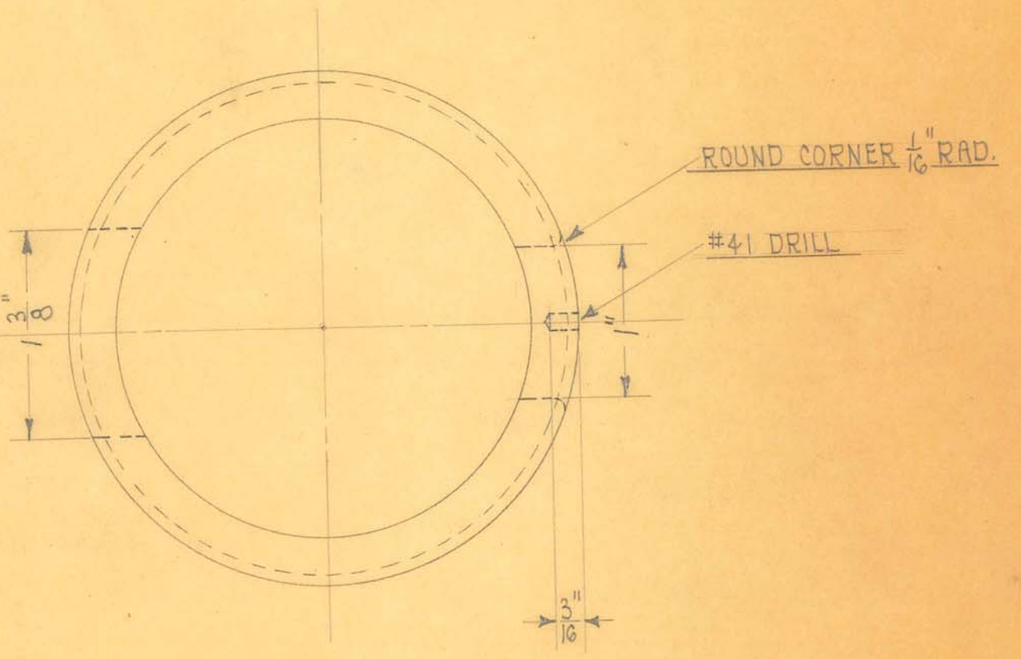

1 REQUIRED

OBSOLETE

SIZE	2 3/8" I.D. X 3 3/8" O.D.	ISSUE 7-2-35	A.E.	TITLE: SHOCKPROOF DENTAL "X" TUBE SHIELD TUBE
KIND	LITHARGE IMP.	CHANGED		
SHAPE	BAKELITE TUBING	" "		
FINISH		" "		H. G. FISCHER & CO. 2335 WABANSIA AVE. CAT. NO. PART NO. 9549A
TEMP.		" "		

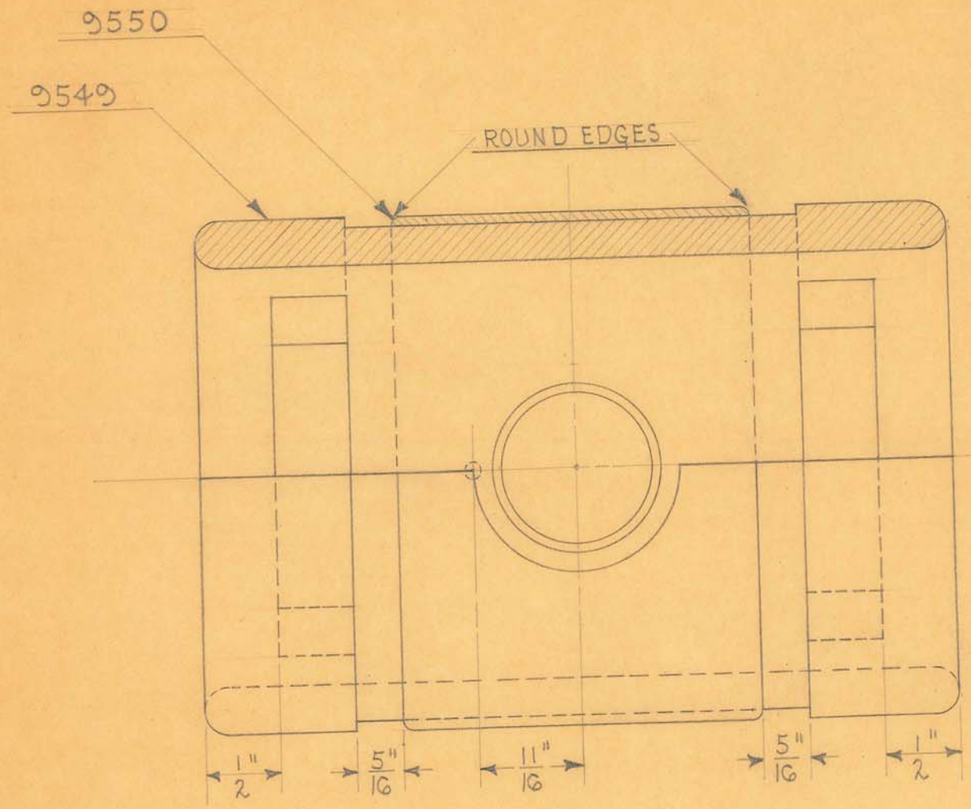

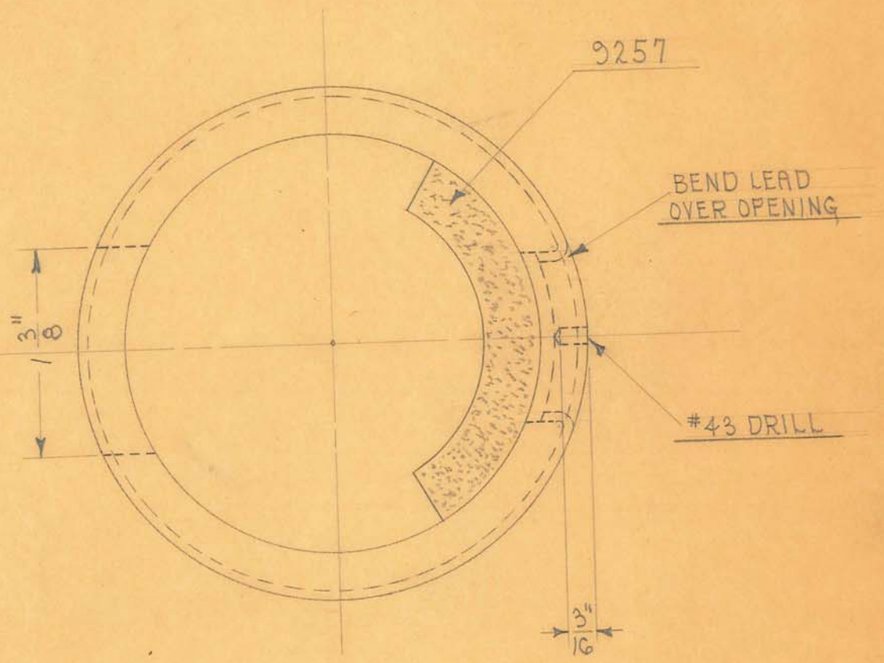

1 REQUIRED

NOTES

PLACE LEAD STRIP WITH HOLE OVER $1\frac{1}{8}$" HOLE & BEND LEAD OVER OPENING. SOLDER & THEN CUT OUT $1\frac{3}{8}$" HOLE. TRIM EDGES OF LEAD TO $\frac{5}{16}$" DIMENSIONS & ROUND. DRILL #43 DRL. HOLE AS SHOWN. GLUE CORK STRIPS $\frac{1}{2}$" FROM EACH END AS SHOWN.

OBSOLETE

SIZE		ISSUE 4-18-35	A.E.
KIND		CHANGED	
SHAPE		" "	
FINISH		" "	
TEMP.		" "	

TITLE: SHOCKPROOF DENTAL "X" TUBE SHIELD

H. G. FISCHER & CO.
2335 WABANSIA AVE.
CHICAGO, ILL.

CAT. NO.

PART NO. 9549G

9549A

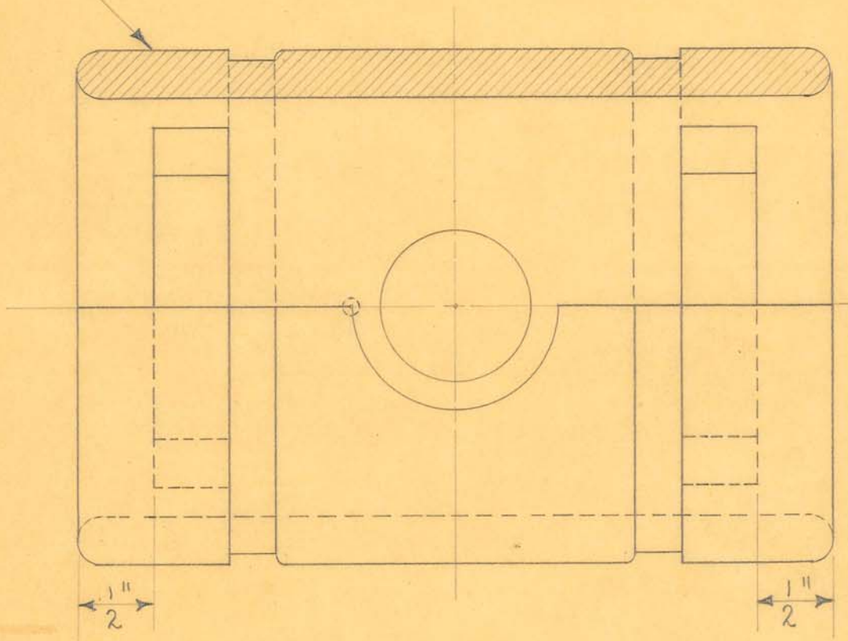

9257B

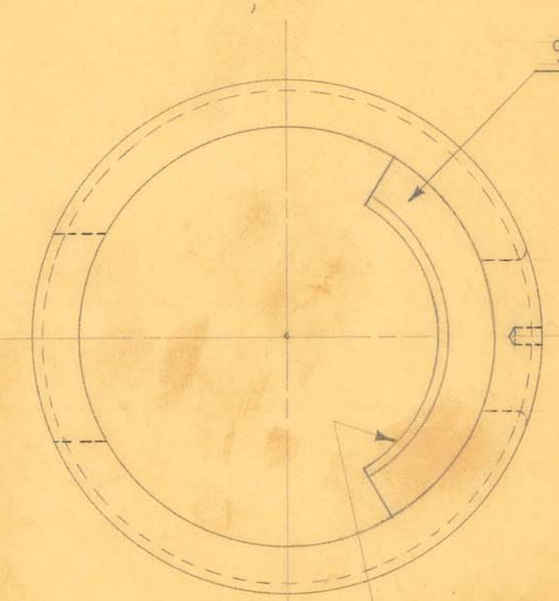

5030 $\frac{1}{2}$ — $\frac{1}{16}$" SHEET FELT
GLUED TO BAKELITE STRIPS

1 REQUIRED

NOTE

BAKELITE STRIPS GLUE ½" FROM EACH END AS SHOWN.

OBSOLETE

SIZE		ISSUE 7-2-35	J.W.	TITLE: SHOCKPROOF DENTAL "X" TUBE SHIELD
KIND		CHANGED 12-29-36	J.W.	
SHAPE		" "		
FINISH		" "		
		" "		H. G. FISCHER & CO.

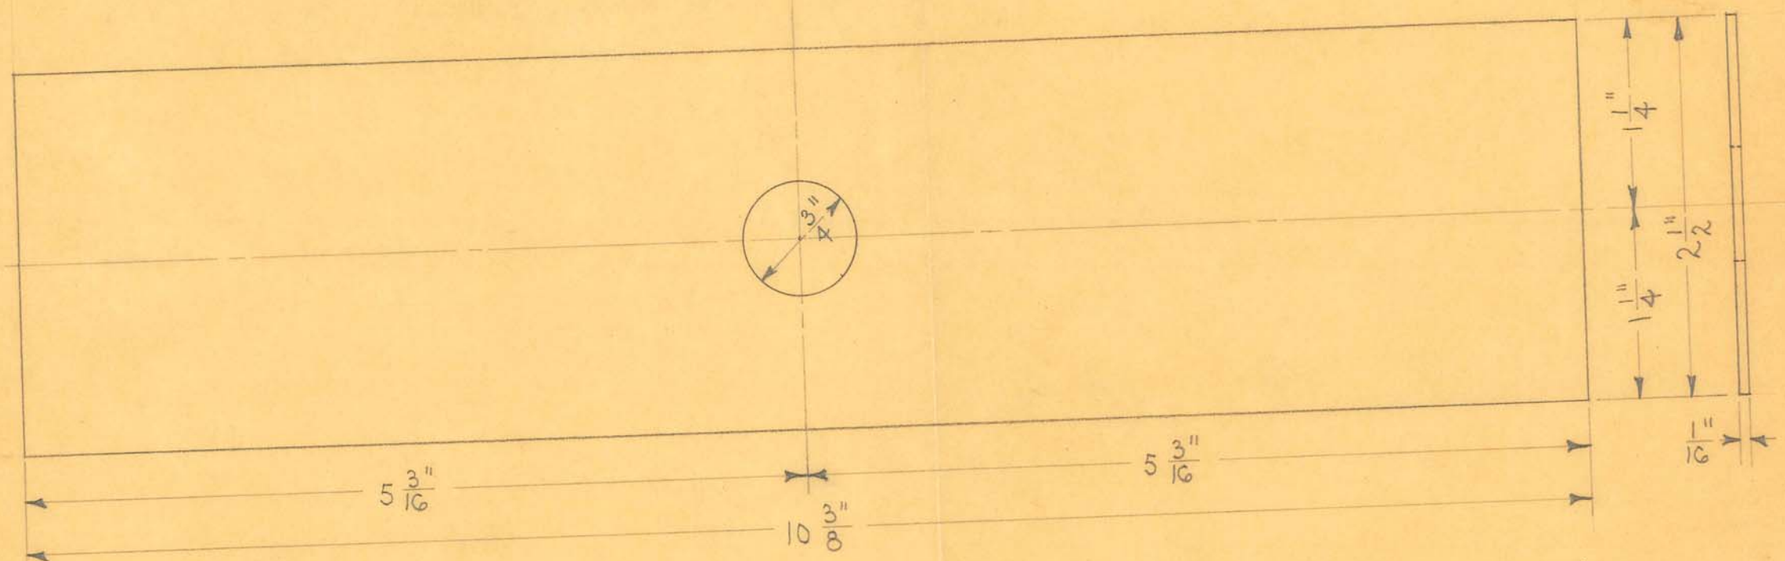

1 REQUIRED

OBSOLETE

SIZE	1/16"	ISSUE 4-18-35	A.E.
KIND	SHEET LEAD	CHANGED	
SHAPE		" "	
FINISH		" "	
TEMP.		" "	

TITLE: SHOCKPROOF DENTAL "X" TUBE SHIELD LEAD PROTECTOR

H. G. FISCHER & CO.
2335 WABANSIA AVE.
CHICAGO, ILL.

CAT. NO.

PART NO. 9550

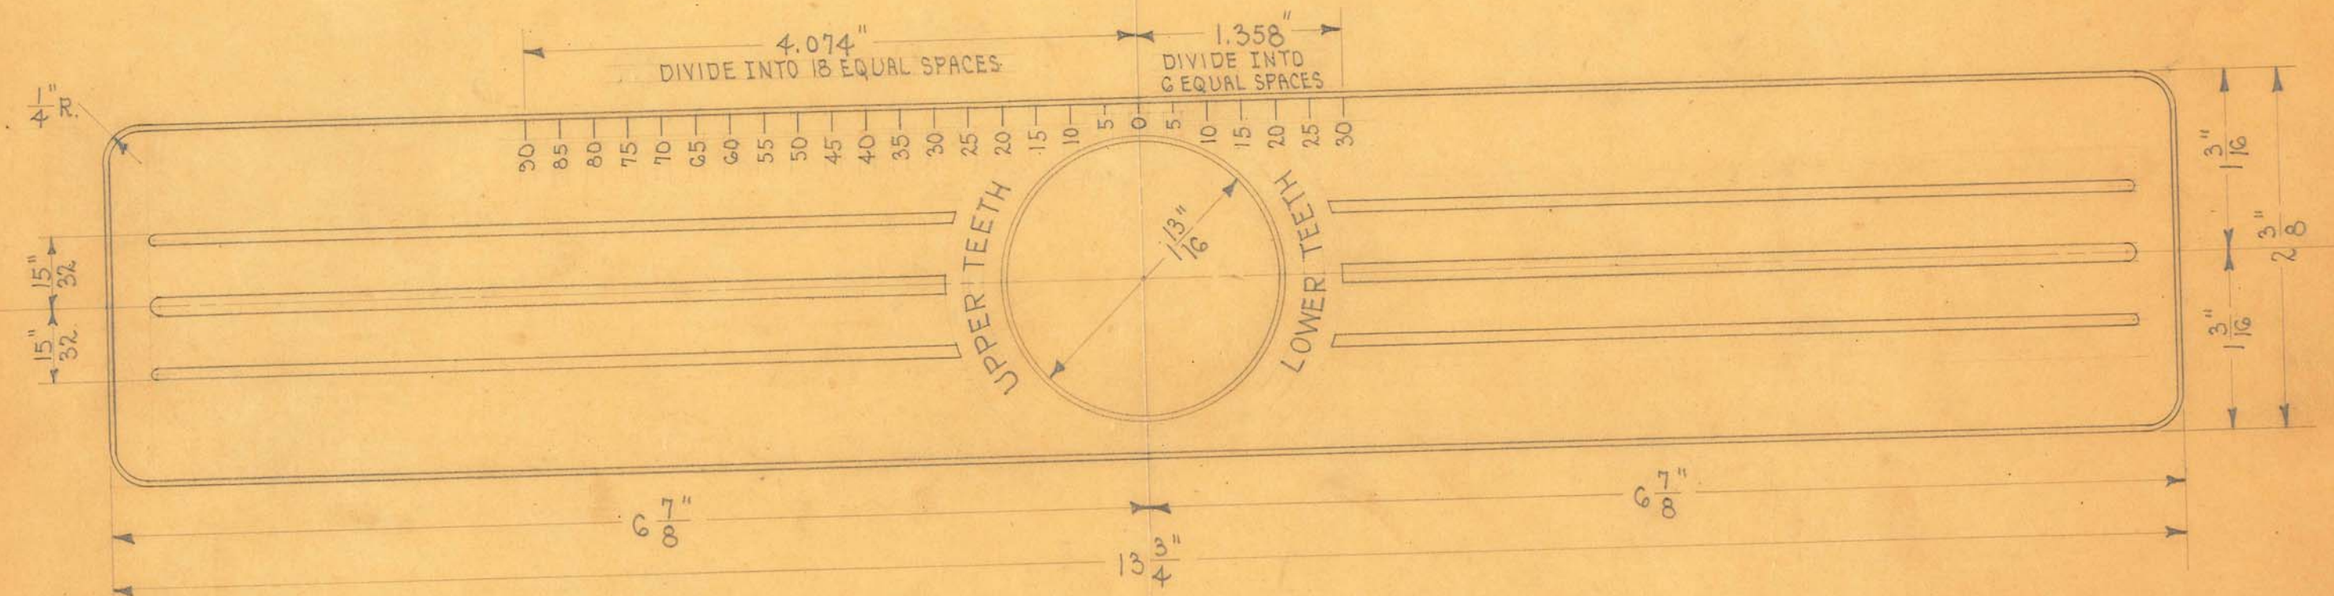

ROLLED 5 1/8" DIA INSIDE

OBSOLETE

SIZE		ISSUE		TITLE: SHOCKPROOF DENTAL "X" TUBE HEAD ANGLE PLATE
KIND		CHANGED		
SHAPE		" "		
FINISH		" "		
TEMP.		" "		H. G. FISCHER & CO. 2335 WABANSIA AVE. CHICAGO, ILL.
PATT.		" "		CAT. NO.
				PART NO. 9551

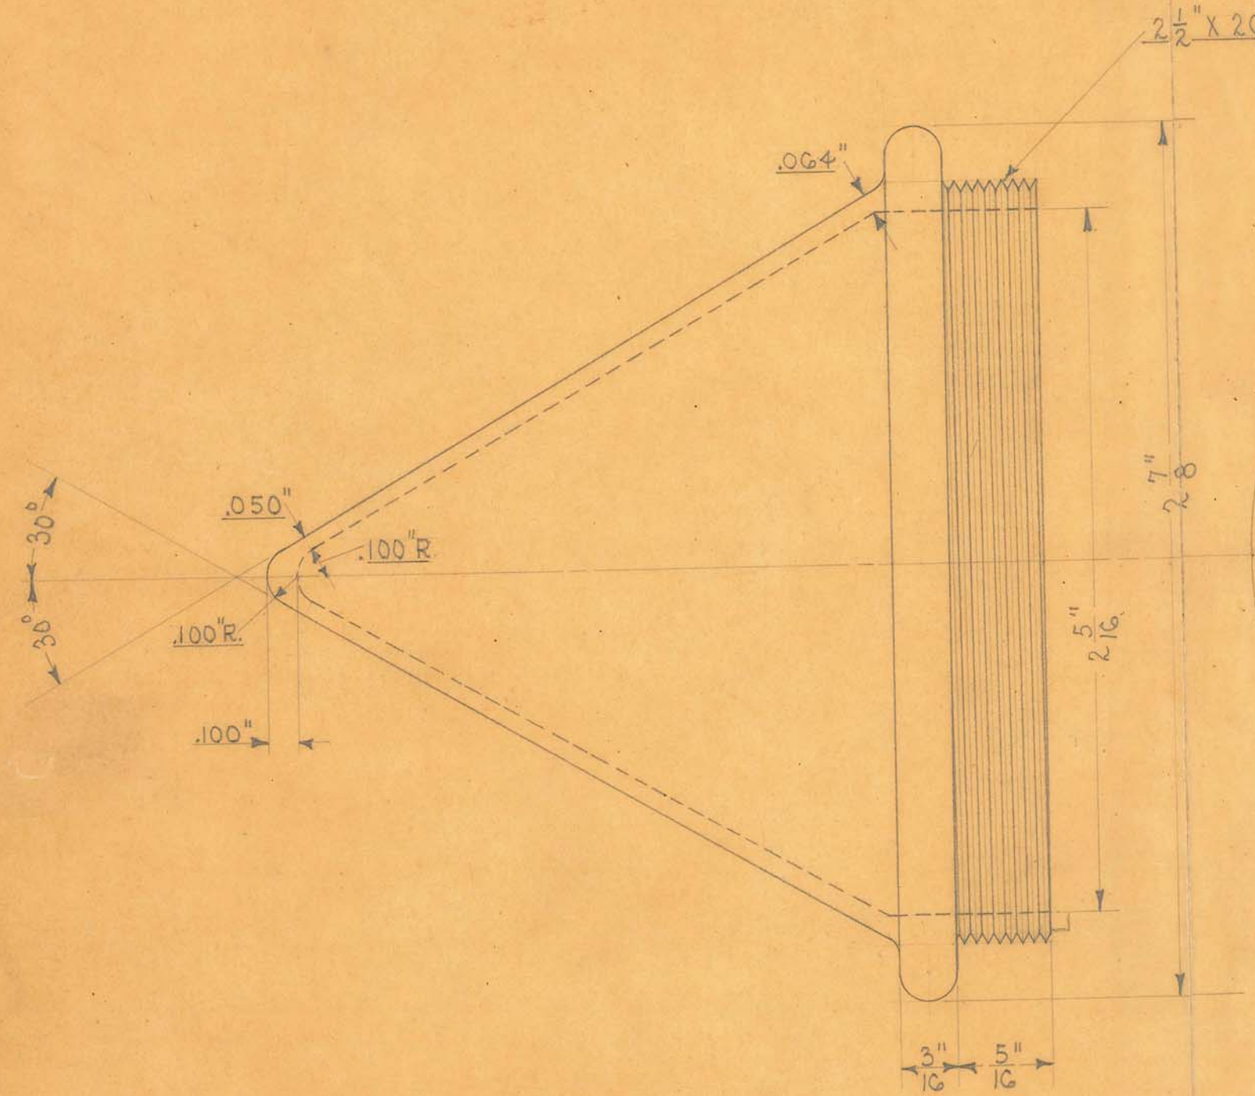

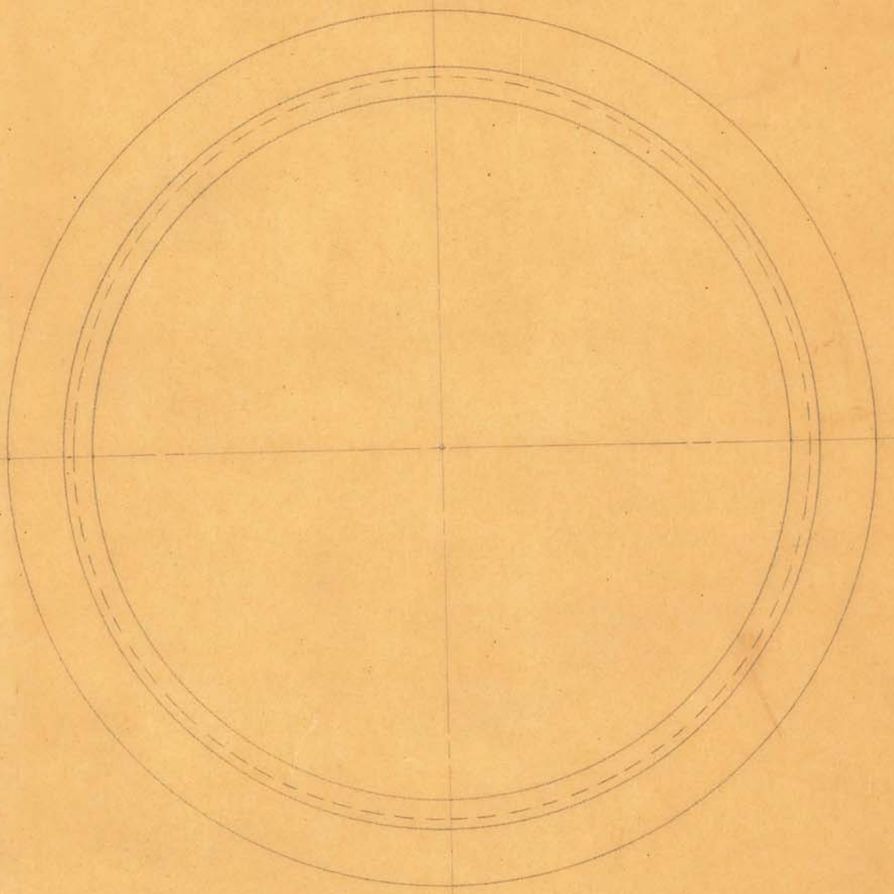

SCALE ~ 1" = ½"

OBSOLETE

SIZE		ISSUE 3-27-35	A.E.
KIND		CHANGED	
SHAPE		" "	
FINISH		" "	
TEMP.		" "	

TITLE: SHOCKPROOF DENTAL "X" CONE

H. G. FISCHER & CO.
2335 WABANSIA AVE.
CHICAGO, ILL.

CAT. NO. 3922

PART NO. 9553

TITLE	SHOCKPROOF DENTAL "X" CONE	H. G. FISCHER & CO. FRANKLIN PARK, ILLINOIS	PART NO. 9553
		DATE 2-29-52 DR. BY W. J. CH'K'D.	REVISION / DATE / BY
PATTERN	FINISH	SCALE 1" = ½"	DIMENSIONS: FRACTIONAL ± .015; DECIMAL ± .005; ANGULAR ± ½°; UNLESS OTHERWISE SPECIFIED
TOOLS	MATERIAL		

OBSOLETE

DUPLICATE

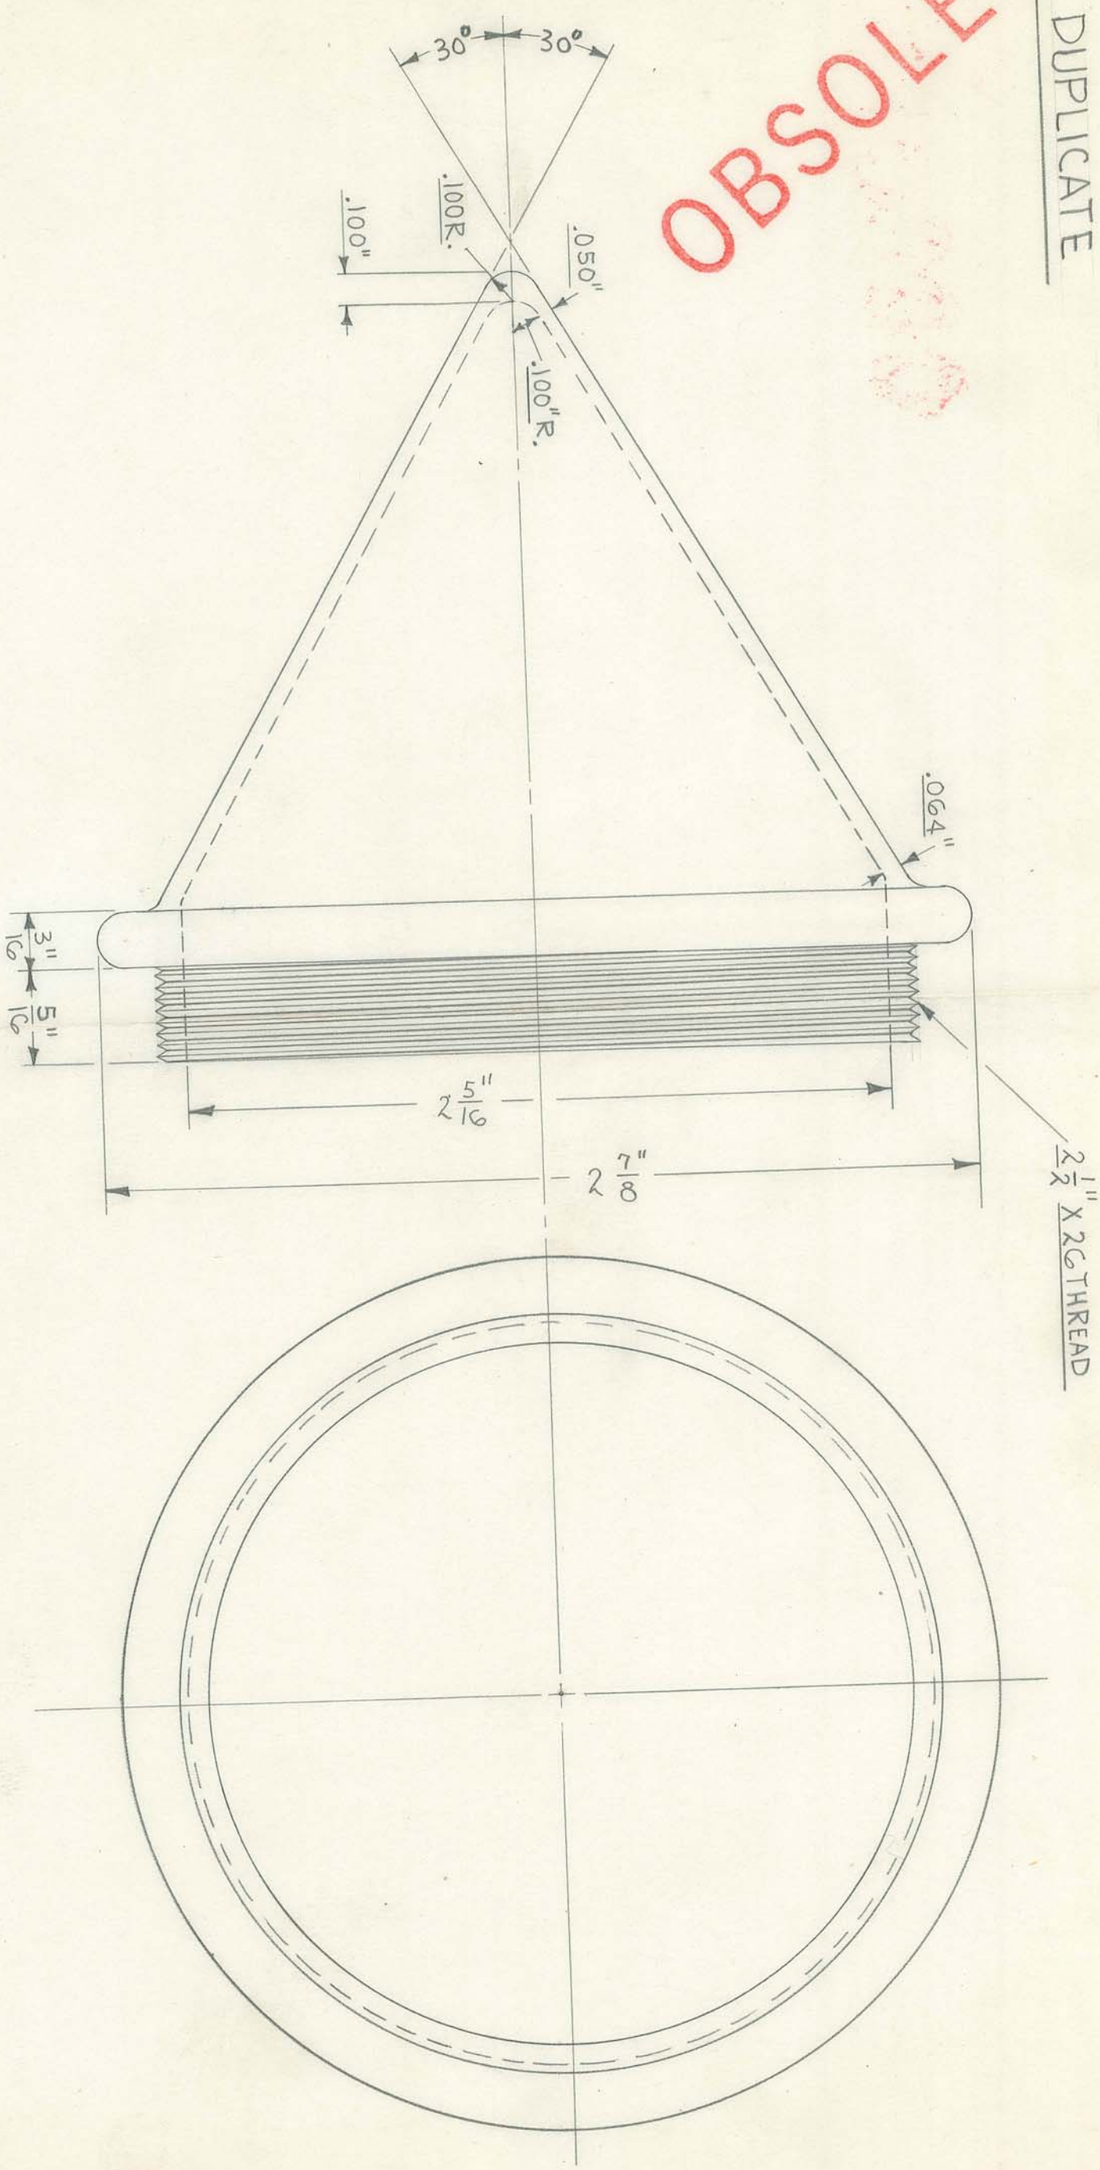

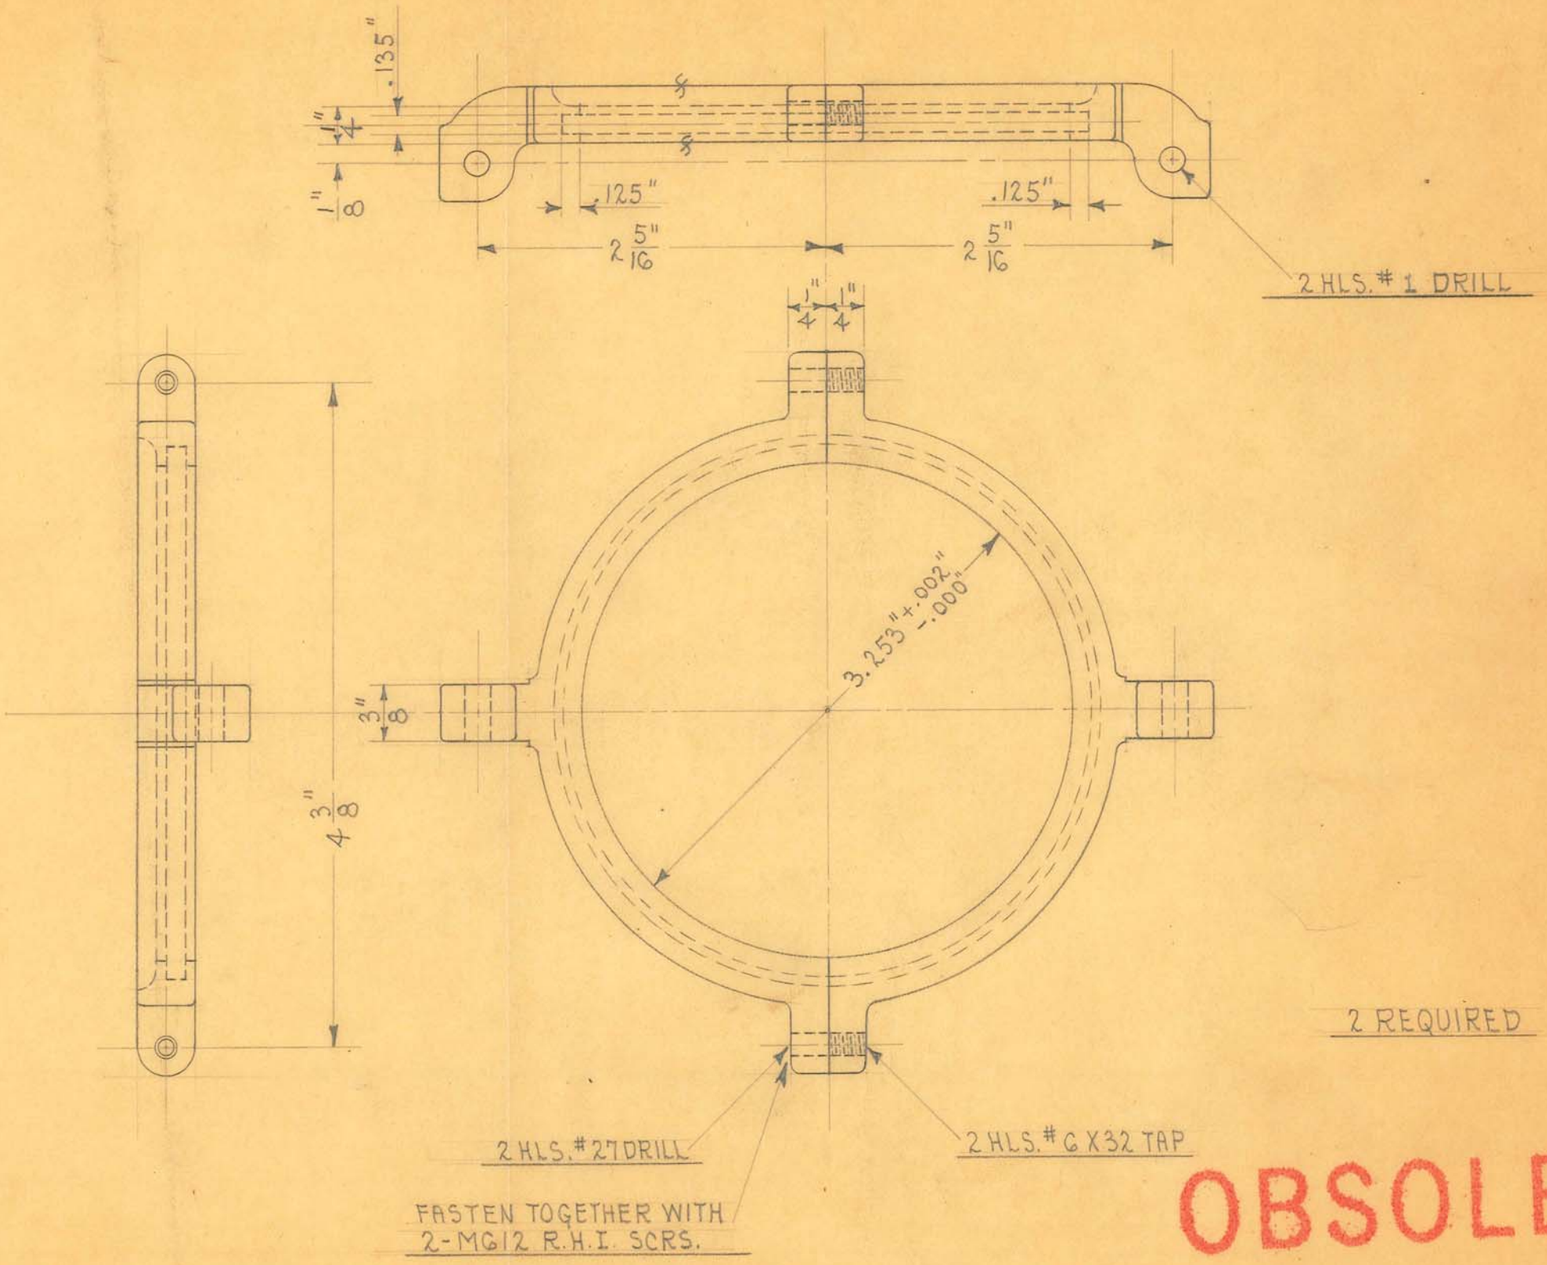

2 REQUIRED

OBSOLETE

SIZE		ISSUE 4-23-35	A.E.
KIND	BRASS CASTING	CHANGED	
SHAPE		" "	
FINISH	CAD. # 23	" "	
TEMP.		" "	
PATT.	7753-811	" "	

TITLE: SHOCKPROOF DENTAL "X" X-RAY TUBE HOLDER BEARING.

H. G. FISCHER & CO.
2335 WABANSIA AVE.
CHICAGO, ILL.

CAT. NO.

PART NO. 9558G

NOTE:-
WELDING MUST BE OIL TIGHT.
TEST FOR LEAKS WITH KERDSENE.
GIVE OUTSIDE OF TANK KEROSENE
BATH TO KEEP FROM RUSTING.

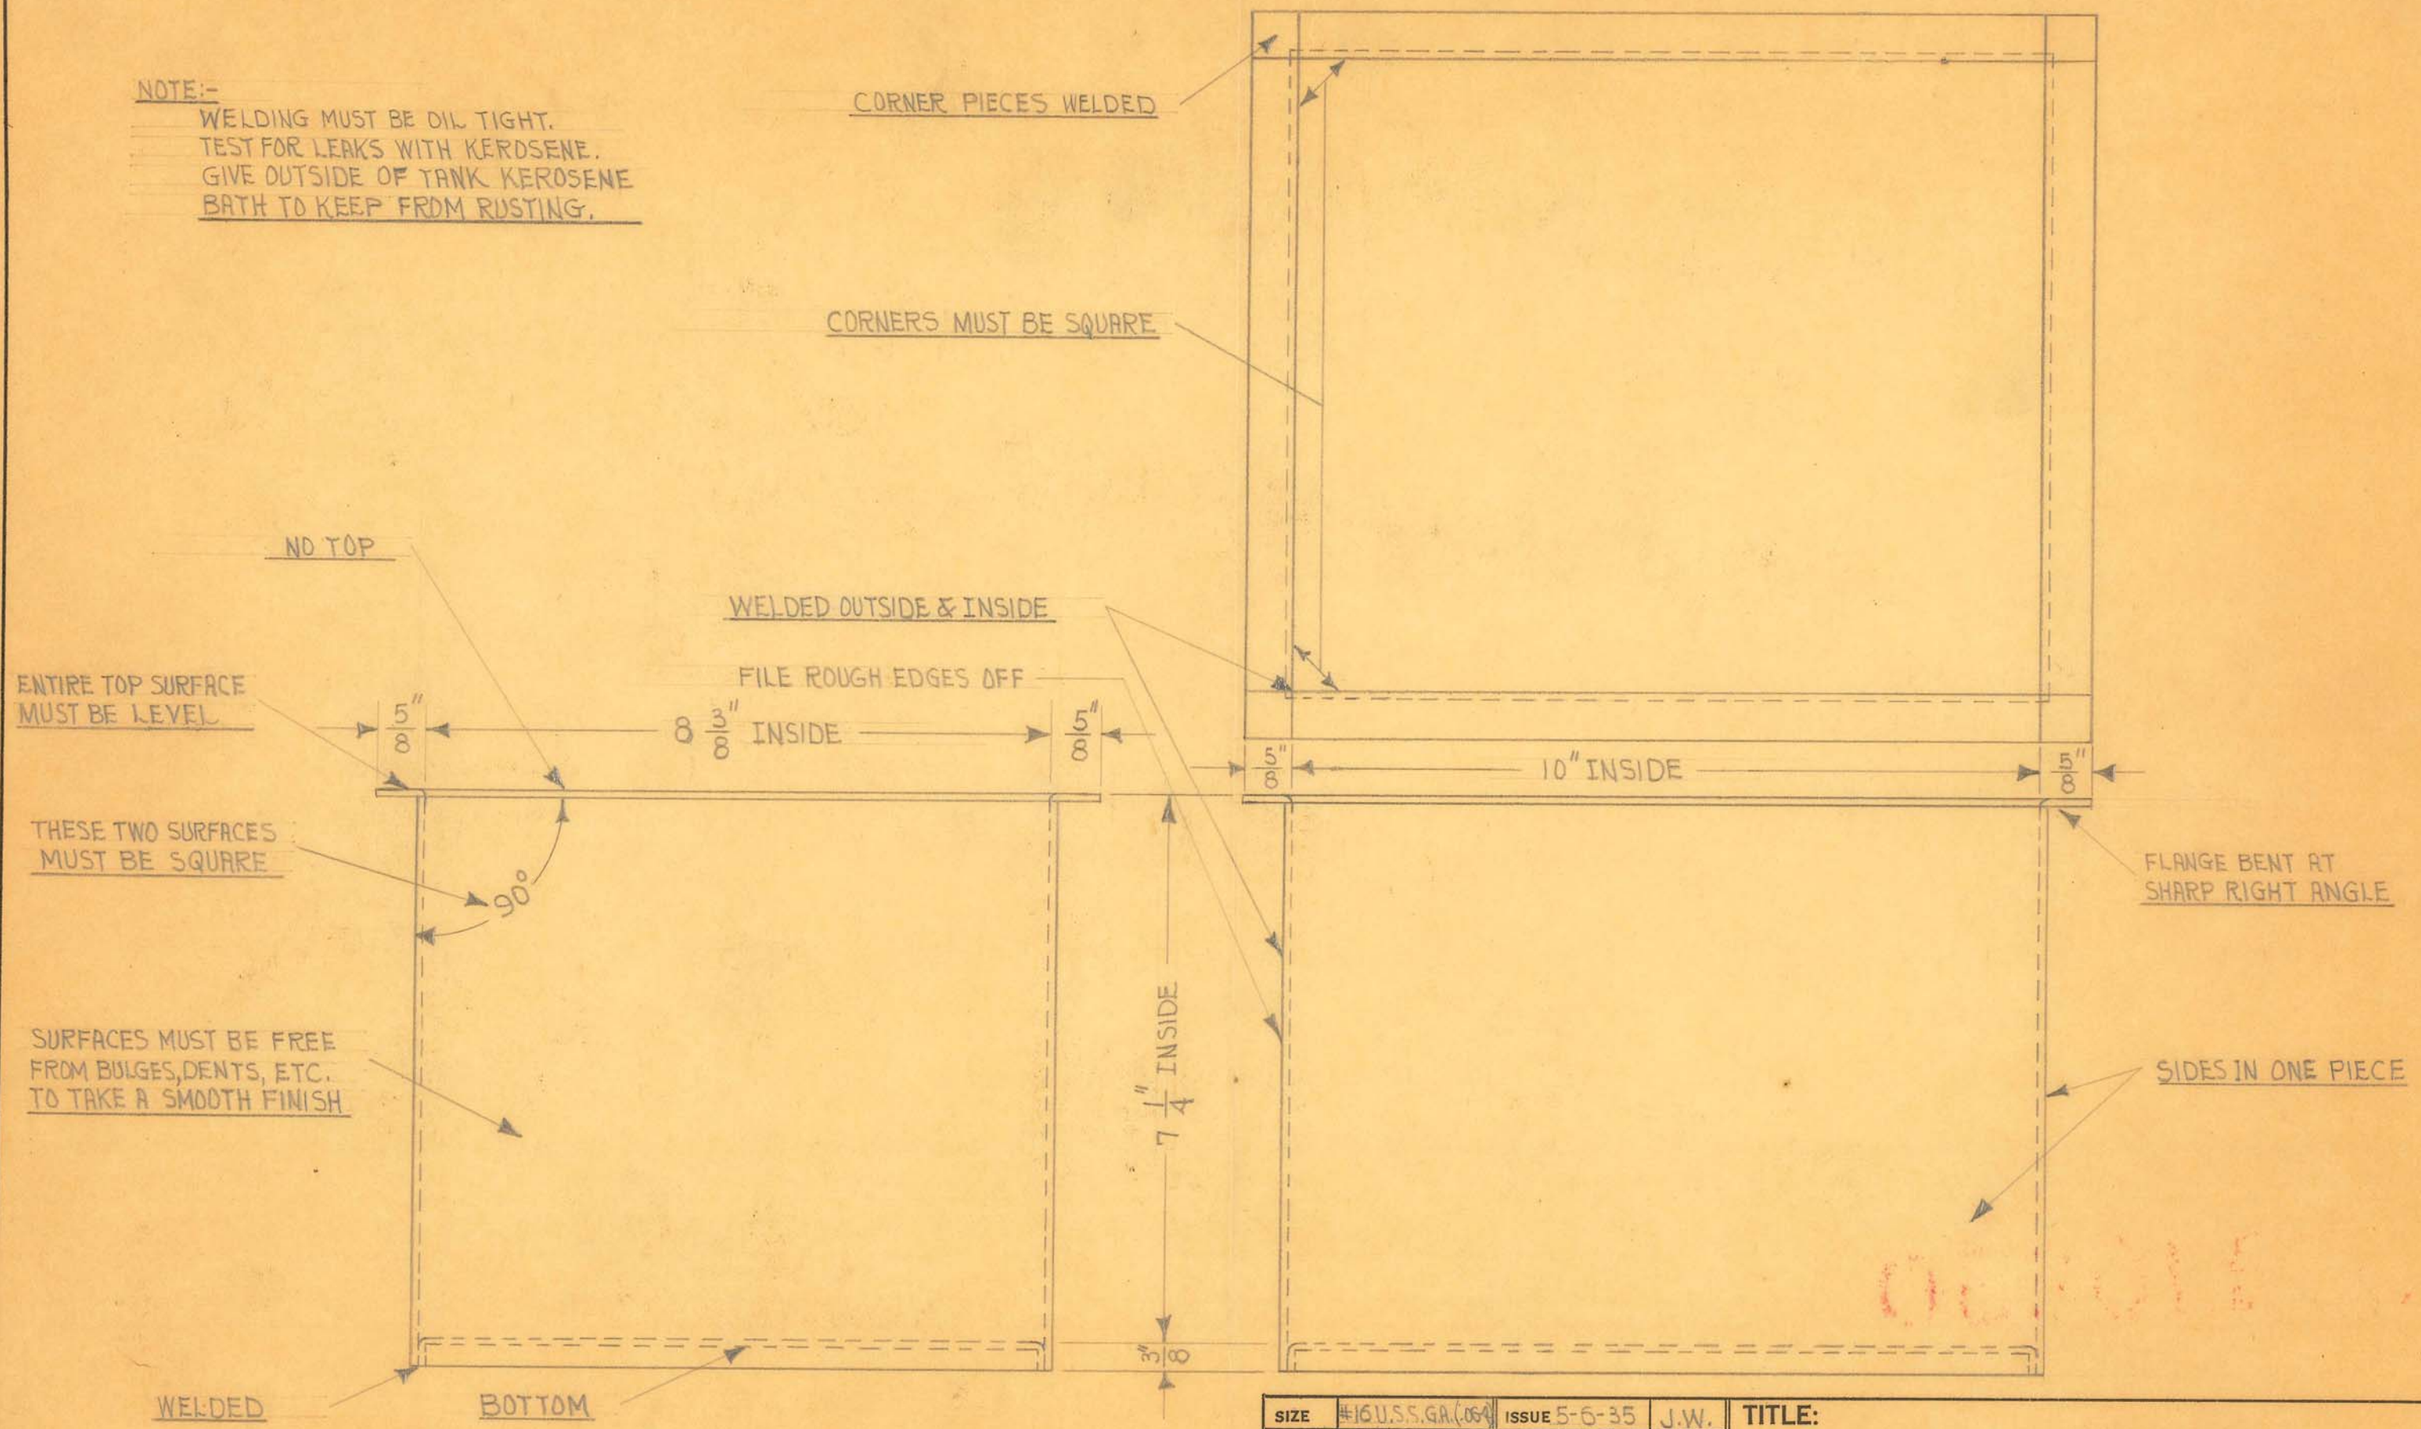

SCALE ÷ 1/2" = 1"

SIZE	#16 U.S.S. GA. (.064)	ISSUE 5-6-35	J.W.	TITLE: SHOCKPROOF DENTAL X TRANSFORMER TANK
KIND	FURNITURE STEEL	CHANGED		
SHAPE		" "		
FINISH		" "		
TEMP.		" "		
PATT.		" "		

OBSOLETE

H. G. FISCHER & CO.
2335 WABANSIA AVE.

CAT. NO.

PART NO. 9562

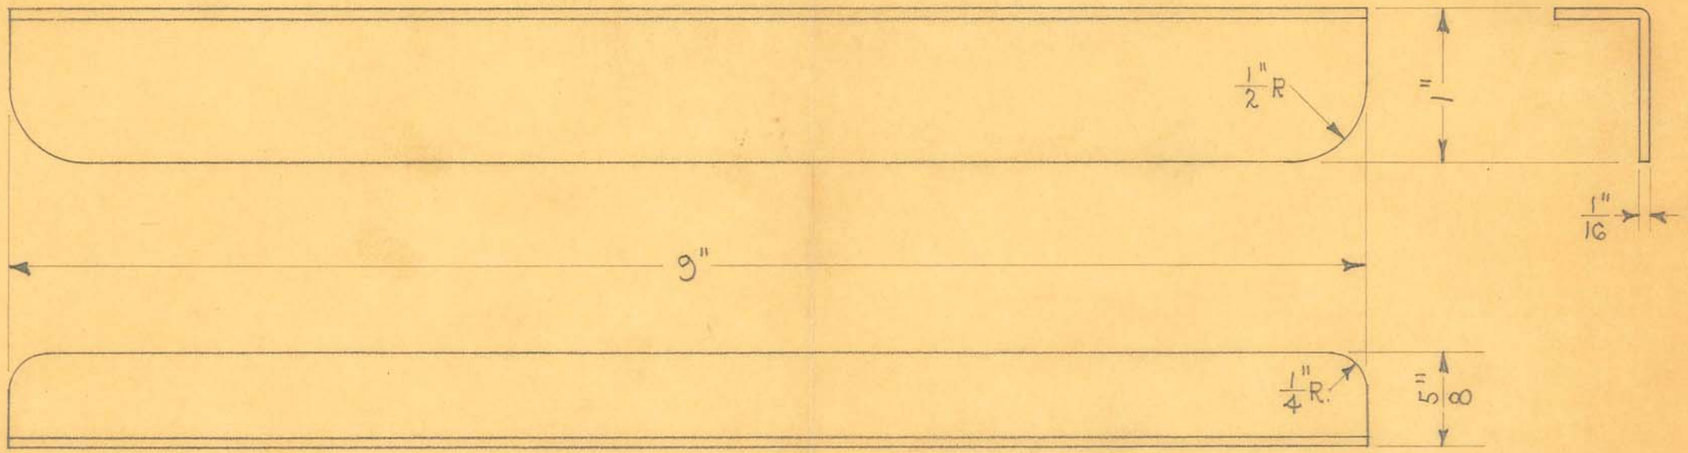

1 REQUIRED

OBSOLETE

SIZE	1/16" SHEET	ISSUE 5-23-35	H.E.
KIND	C.R. STEEL	CHANGED	
SHAPE		" "	
FINISH		" "	
TEMP.		" "	
PATT.		" "	

TITLE: SHOCKPROOF DENTAL "X" TRANSFORMER TANK SUPPORT

H. G. FISCHER & CO.
2335 WABANSIA AVE.
CHICAGO, ILL.

CAT. NO.

PART NO. 9566

4 HLS. #1 DRILL

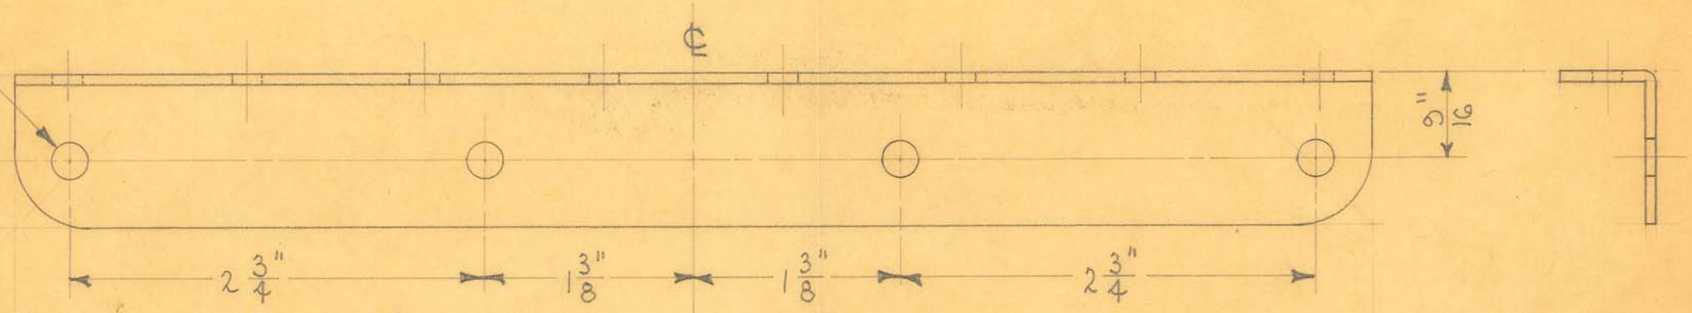

8 HLS. #9 DRILL TO MATCH DRILLING ON LONG SIDE OF TRANSFORMER PANEL

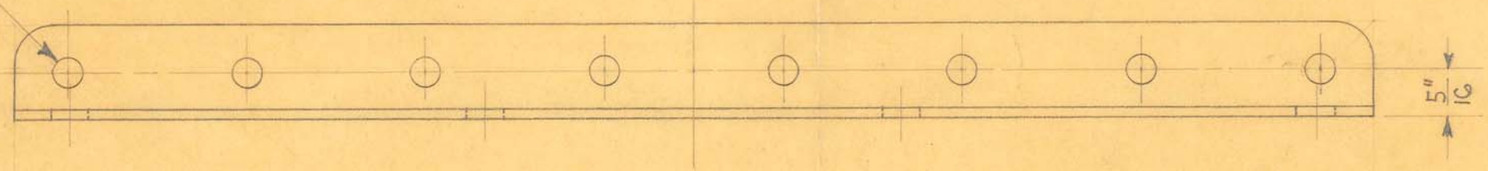

1 REQUIRED

OBSOLETE

OBSOLETE

SIZE		ISSUE 5-23-35	J.E.
KIND		CHANGED	
SHAPE		" "	
FINISH	BLACK #80	" "	
TEMP.		" "	
PATT.		" "	

TITLE: SHOCKPROOF DENTAL "X" TRANSFORMER TANK SUPPORT - DRILLED

H. G. FISCHER & CO.
2335 WABANSIA AVE.
CHICAGO, ILL.

CAT. NO.

PART NO. 9566F

8 1/2"

15 1/2"

7/16" R.

5 5/16"

2 REQUIRED

OBSOLETE

SIZE	#18 U.S.S.GA.	ISSUE 5-17-35	A.E.
KIND	FURNITURE STEEL	CHANGED	
SHAPE		" "	
FINISH		" "	
TEMP.		" "	
PATT.		" "	

TITLE: SHOCKPROOF DENTAL "X" TRANSFORMER & CONTROL BOX - SIDE PLATE

H. G. FISCHER & CO.
2335 WABANSIA AVE.
CHICAGO, ILL.

CAT. NO.

PART NO. 9571

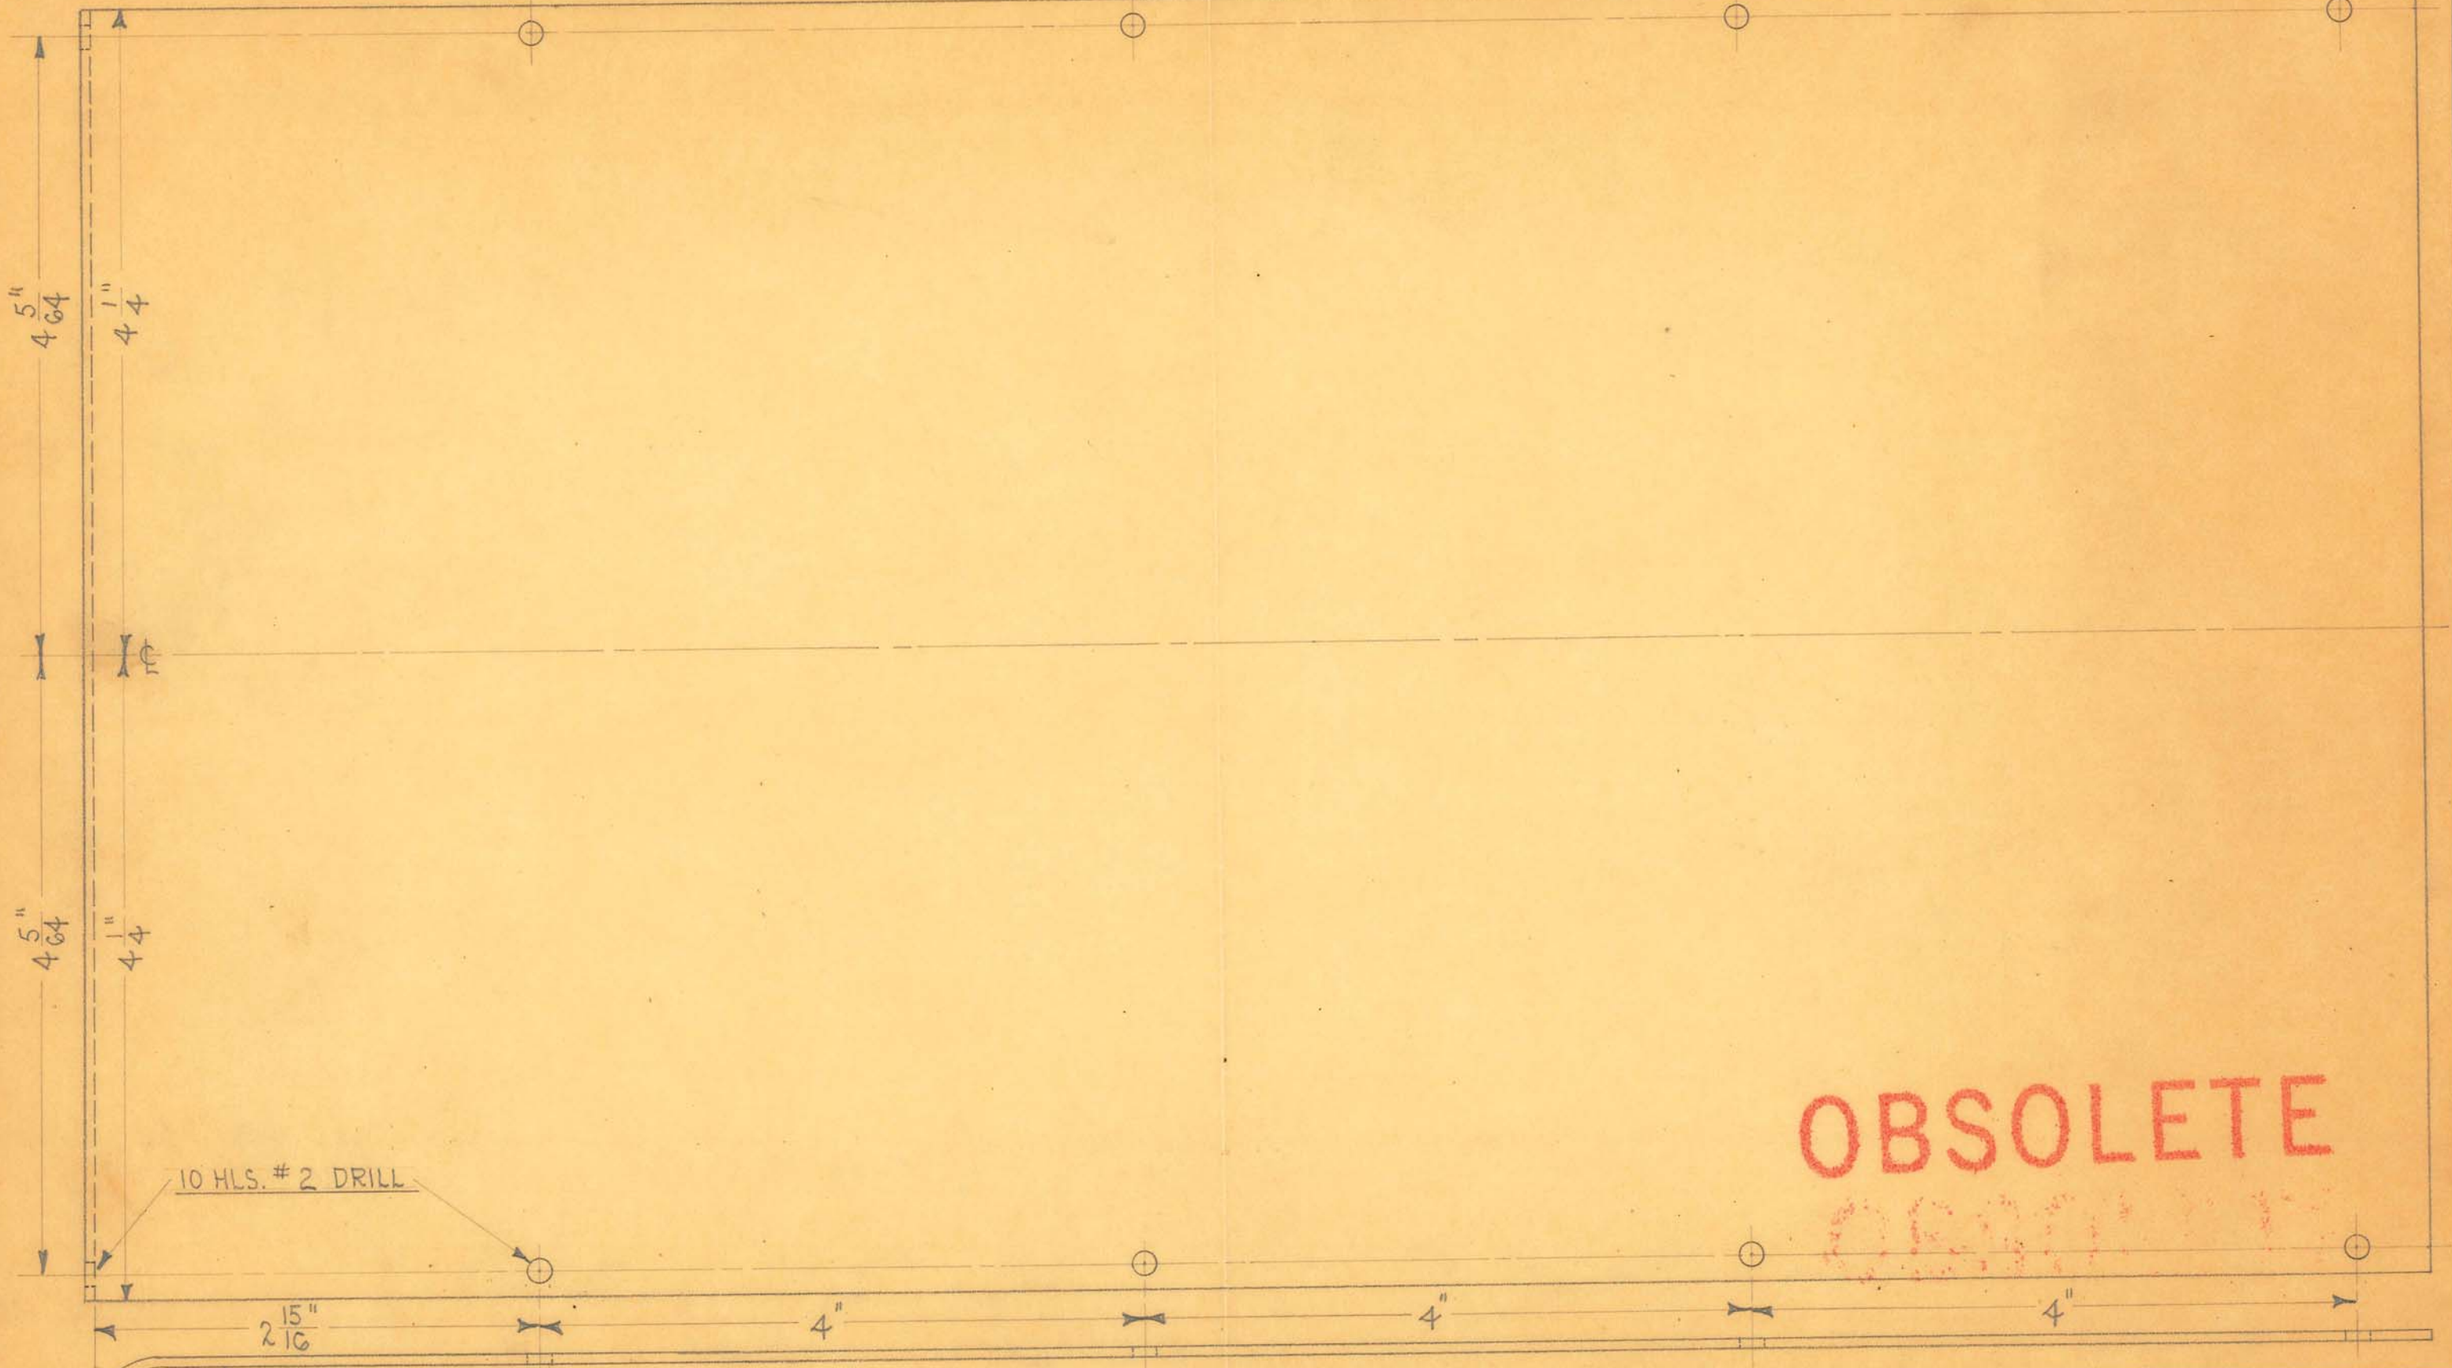

OBSOLETE

2 REQUIRED

SIZE	#18 U.S.S.G.A.	ISSUE 5-17-35	A.E.
KIND	FURNITURE STEEL	CHANGED	
SHAPE		" "	
FINISH	MAH. #53	" "	
TEMP.		" "	
PATT.		" "	

TITLE: SHOCKPROOF DENTAL "X" TRANSFORMER & CONTROL BOX - SIDE PLATE (DRILLED)

H. G. FISCHER & CO.
2335 WABANSIA AVE.
CHICAGO, ILL.

CAT. NO.

PART NO. 9571F

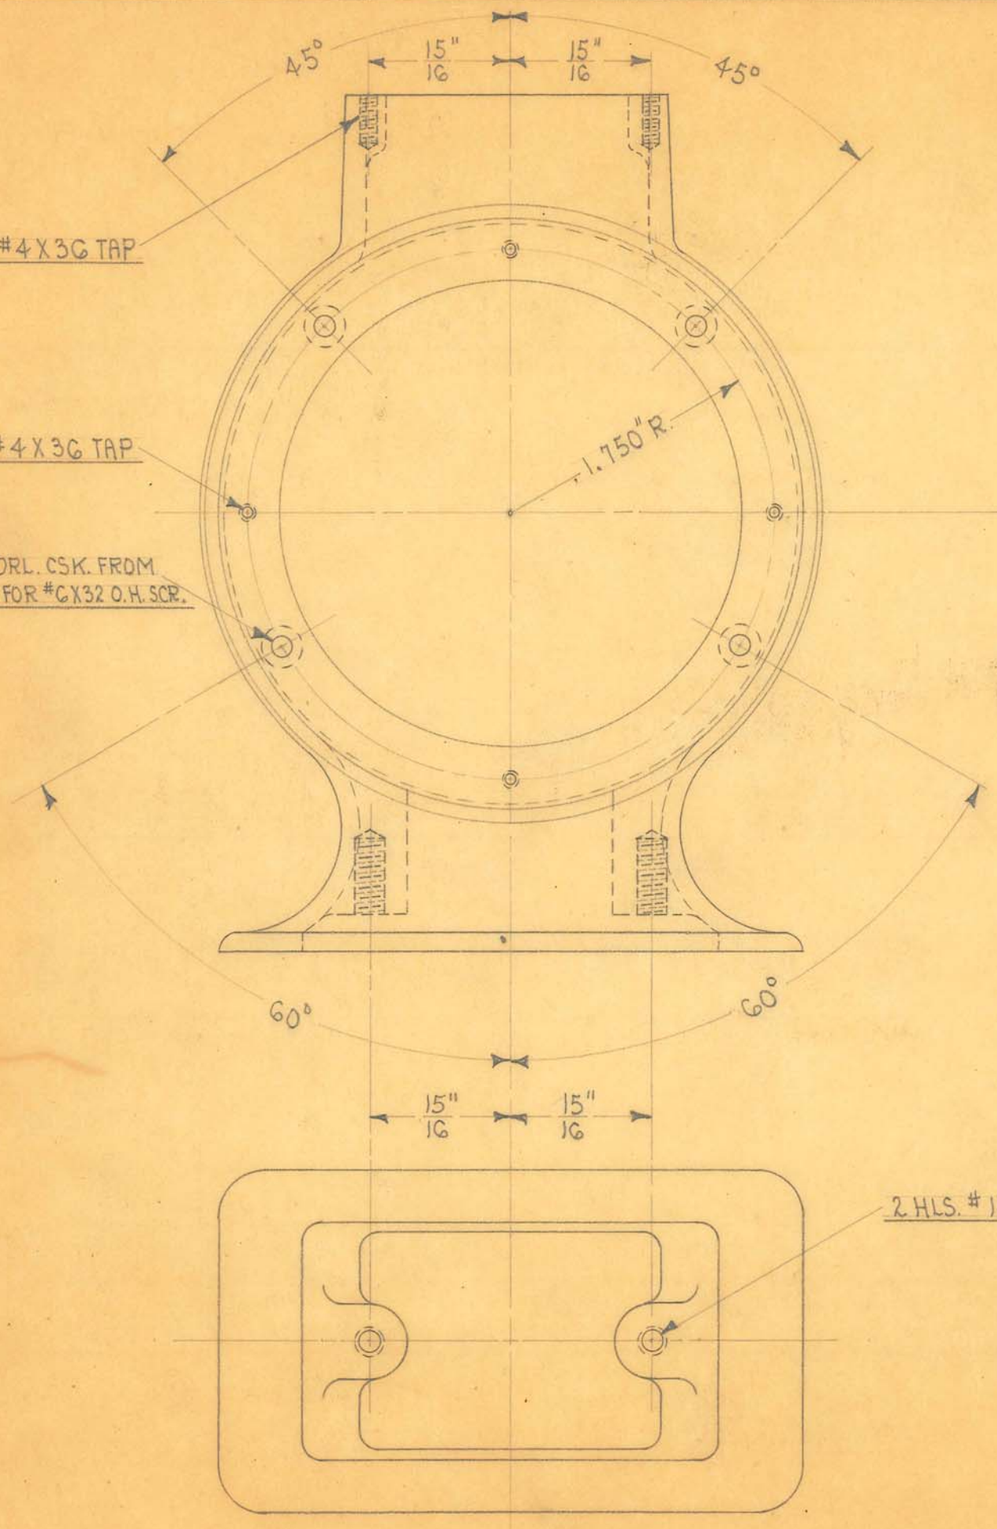

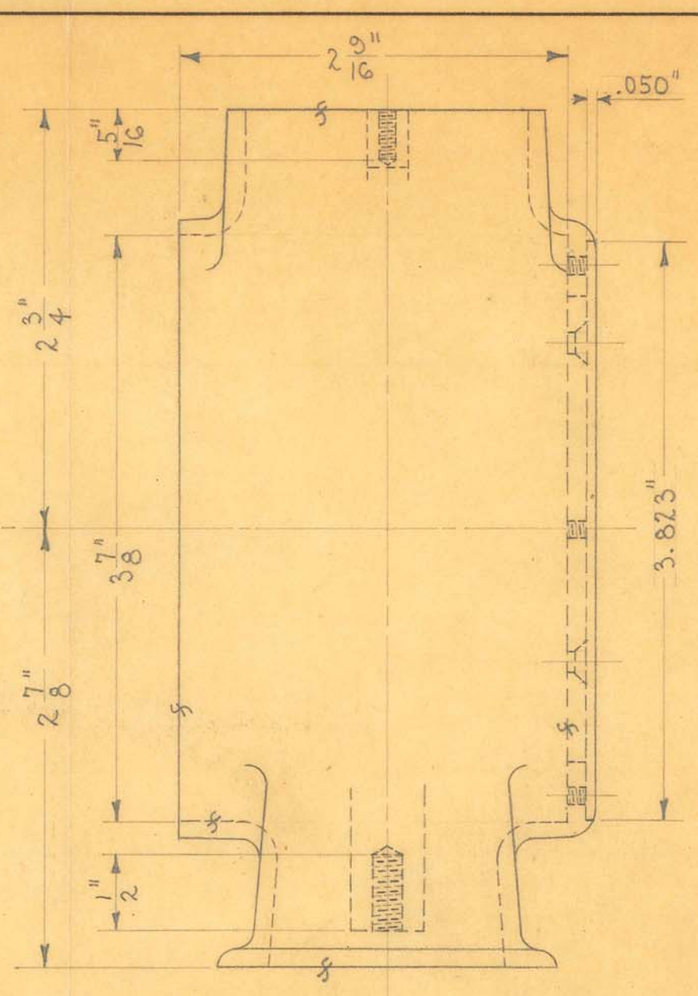

1 REQUIRED

OBSOLETE

SIZE		ISSUE 5-16-35	J.E.
KIND	ALUM. CASTING	CHANGED	
SHAPE		" "	
FINISH	MAH. #51	" "	
TEMP.		" "	

TITLE: SHOCKPROOF DENTAL "X" ELECTRO SYNCHROTIMER CASE

H. G. FISCHER & CO.
2335 WABANSIA AVE.

CAT. NO.

PART NO. 9582F

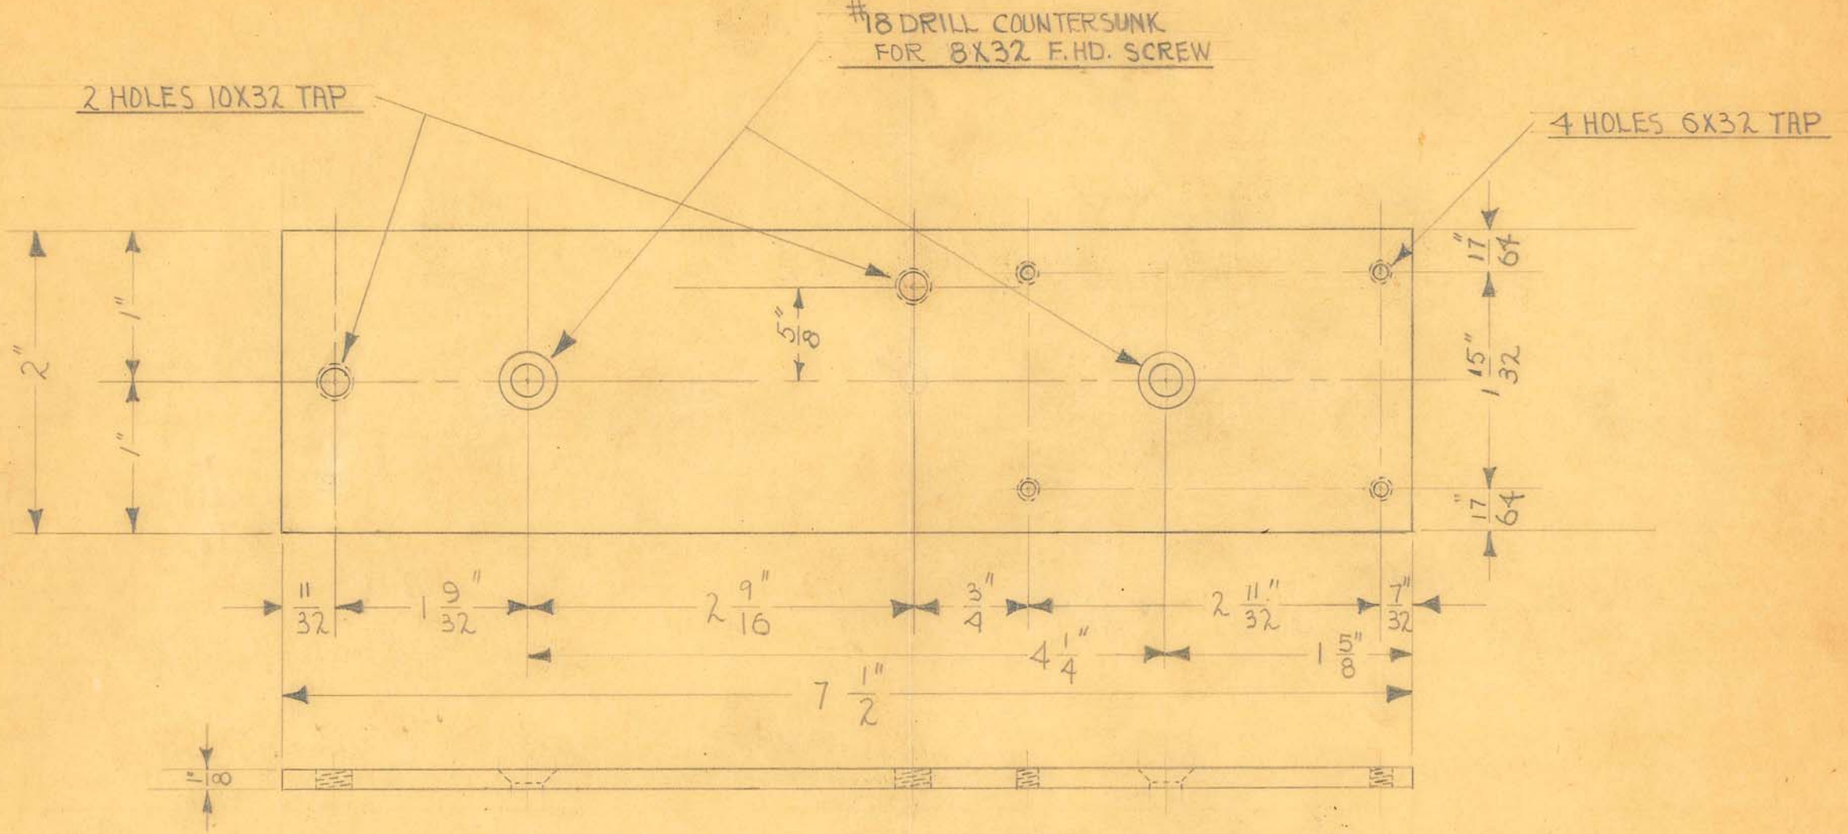

1 REQUIRED

OBSOLETE

SIZE	1/4" X 2" BAR	ISSUE 5-14-35	J.W.	TITLE: SHOCKPROOF DENTAL X CONTACTOR & RELAY MOUNTING PLATE
KIND	C.R. STEEL	CHANGED 11-22-35	J.W.	
SHAPE		" "		
FINISH	STD. BLK. #80	" "		
TEMP.		" "		
PATT.		" "		

H. G. FISCHER & CO.
2335 WABANSIA AVE.
CHICAGO, ILL.

CAT. NO.

PART NO. 9590A

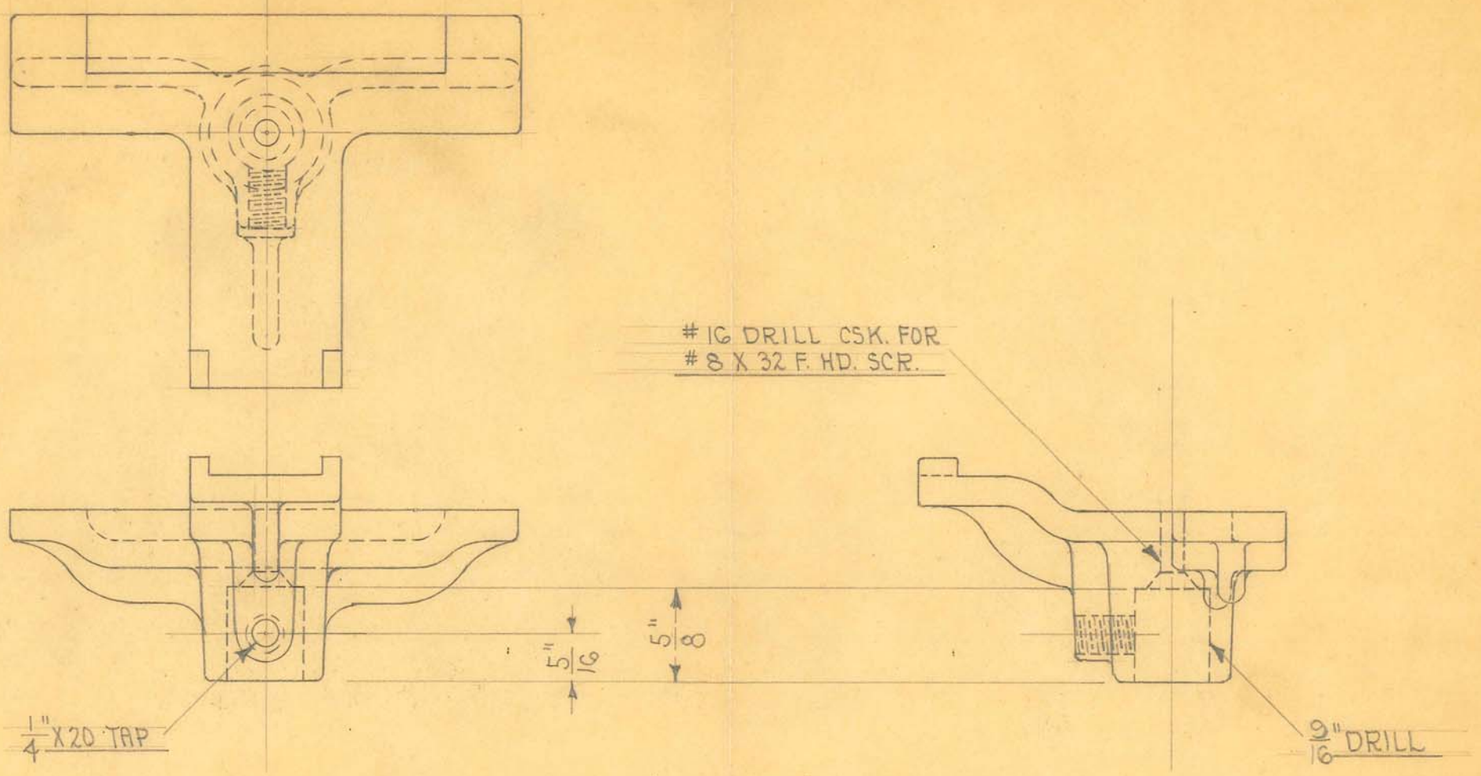

1 REQUIRED

OBSOLETE

SIZE		ISSUE 12-26-35	W.E.
KIND	BRASS CASTING	CHANGED	
SHAPE		" "	
FINISH	MAH. #51.	" "	
TEMP.		" "	
PATT.	5109-225	" "	

TITLE:
SHOCKPROOF DENTAL X CONTROL BOX
HOUSING SUPPORT

H. G. FISCHER & CO.
2335 WABANSIA AVE.
CHICAGO, ILL.

CAT. NO.

PART NO. 9609F

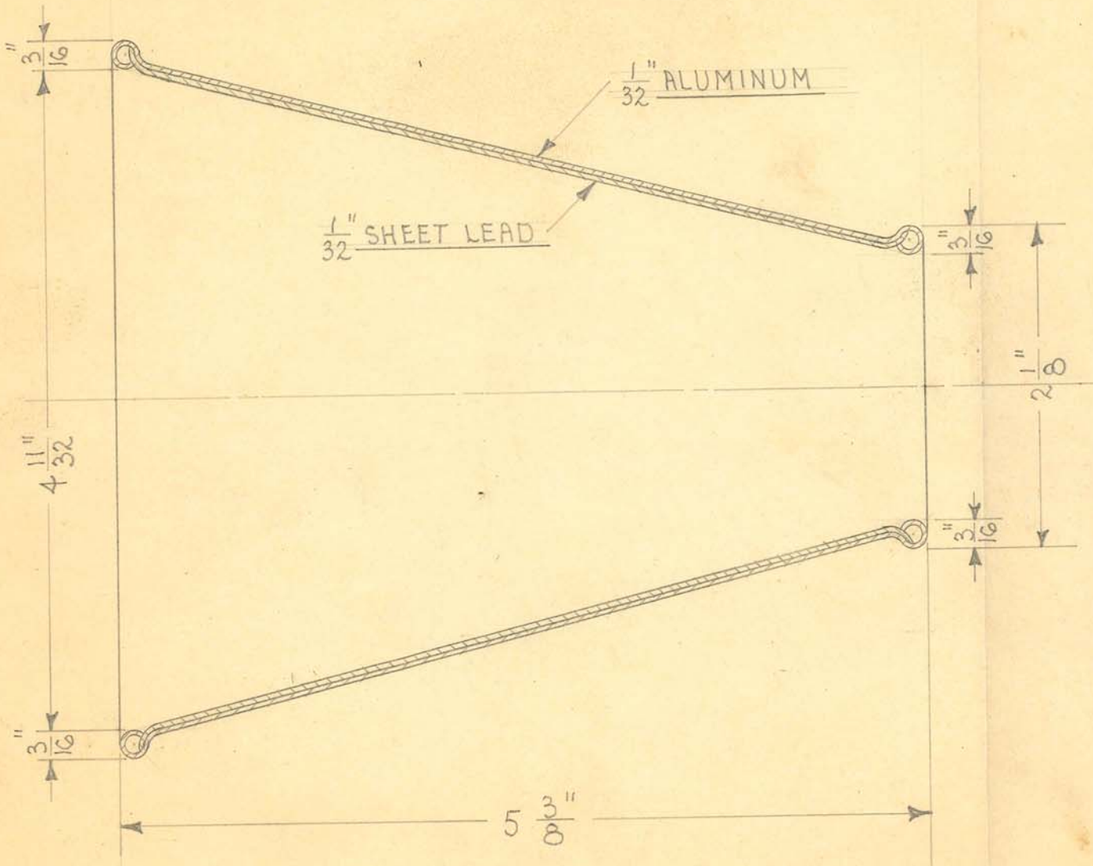

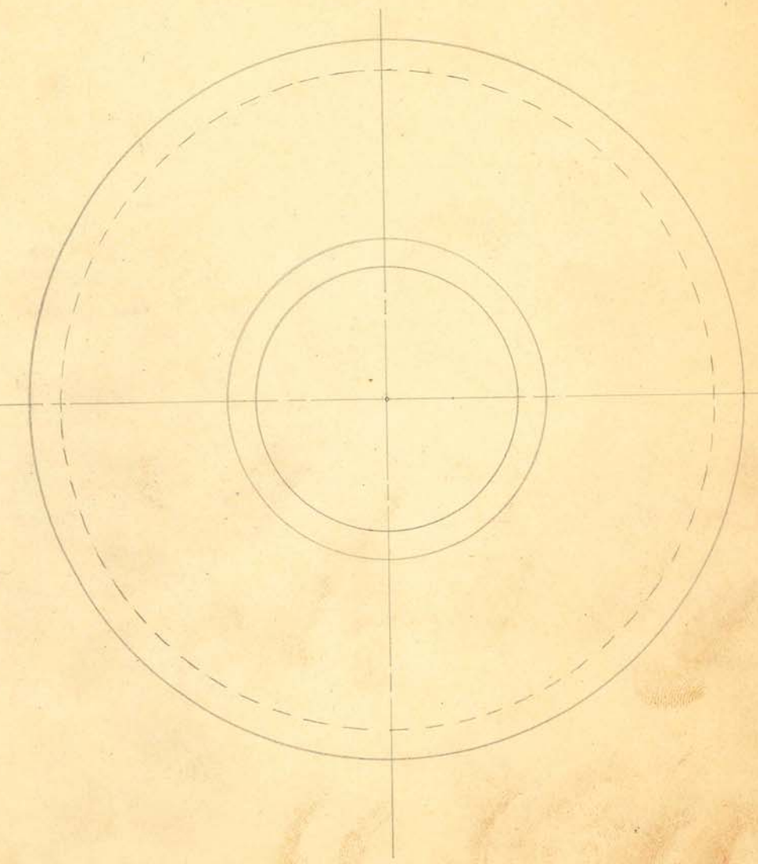

OBSOLETE

SIZE		ISSUE 8-12-36	A.E.
KIND		CHANGED	
SHAPE		"	
FINISH		"	
TEMP.		"	
PATT.		"	

TITLE: SHOCKPROOF DENTAL "X" LEAD LINED COMPRESSION CONE-4 1/2"

H. G. FISCHER & CO.
2335 WABANSIA AVE.
CHICAGO, ILL.

CAT. NO. 3870

PART NO. 9623

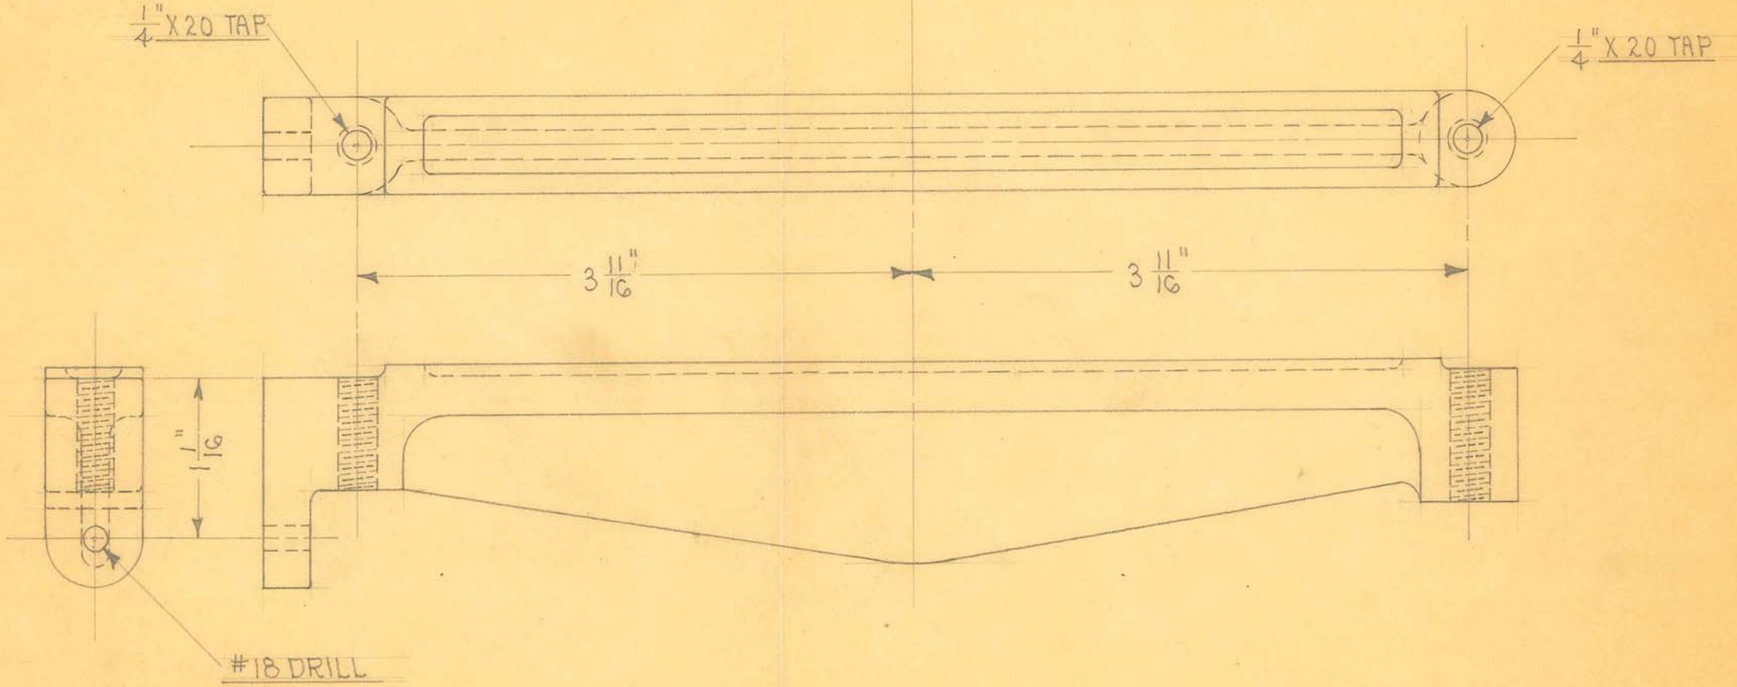

1 REQUIRED

OBSOLETE

SIZE		ISSUE 12-5-35	H.E.
KIND	IRON CASTING	CHANGED	
SHAPE		" "	
FINISH	BLACK #80	" "	
TEMP.		" "	
PATT.	4291-917	" "	

TITLE: INTERMEDIATE MOD. "SW-12" SHORT WAVE H.F. OUTFIT TRANSF. SUPP. - REAR - RIGHT

H. G. FISCHER & CO.
2335 WABANSIA AVE.
CHICAGO, ILL.

CAT. NO.

PART NO. 990GF

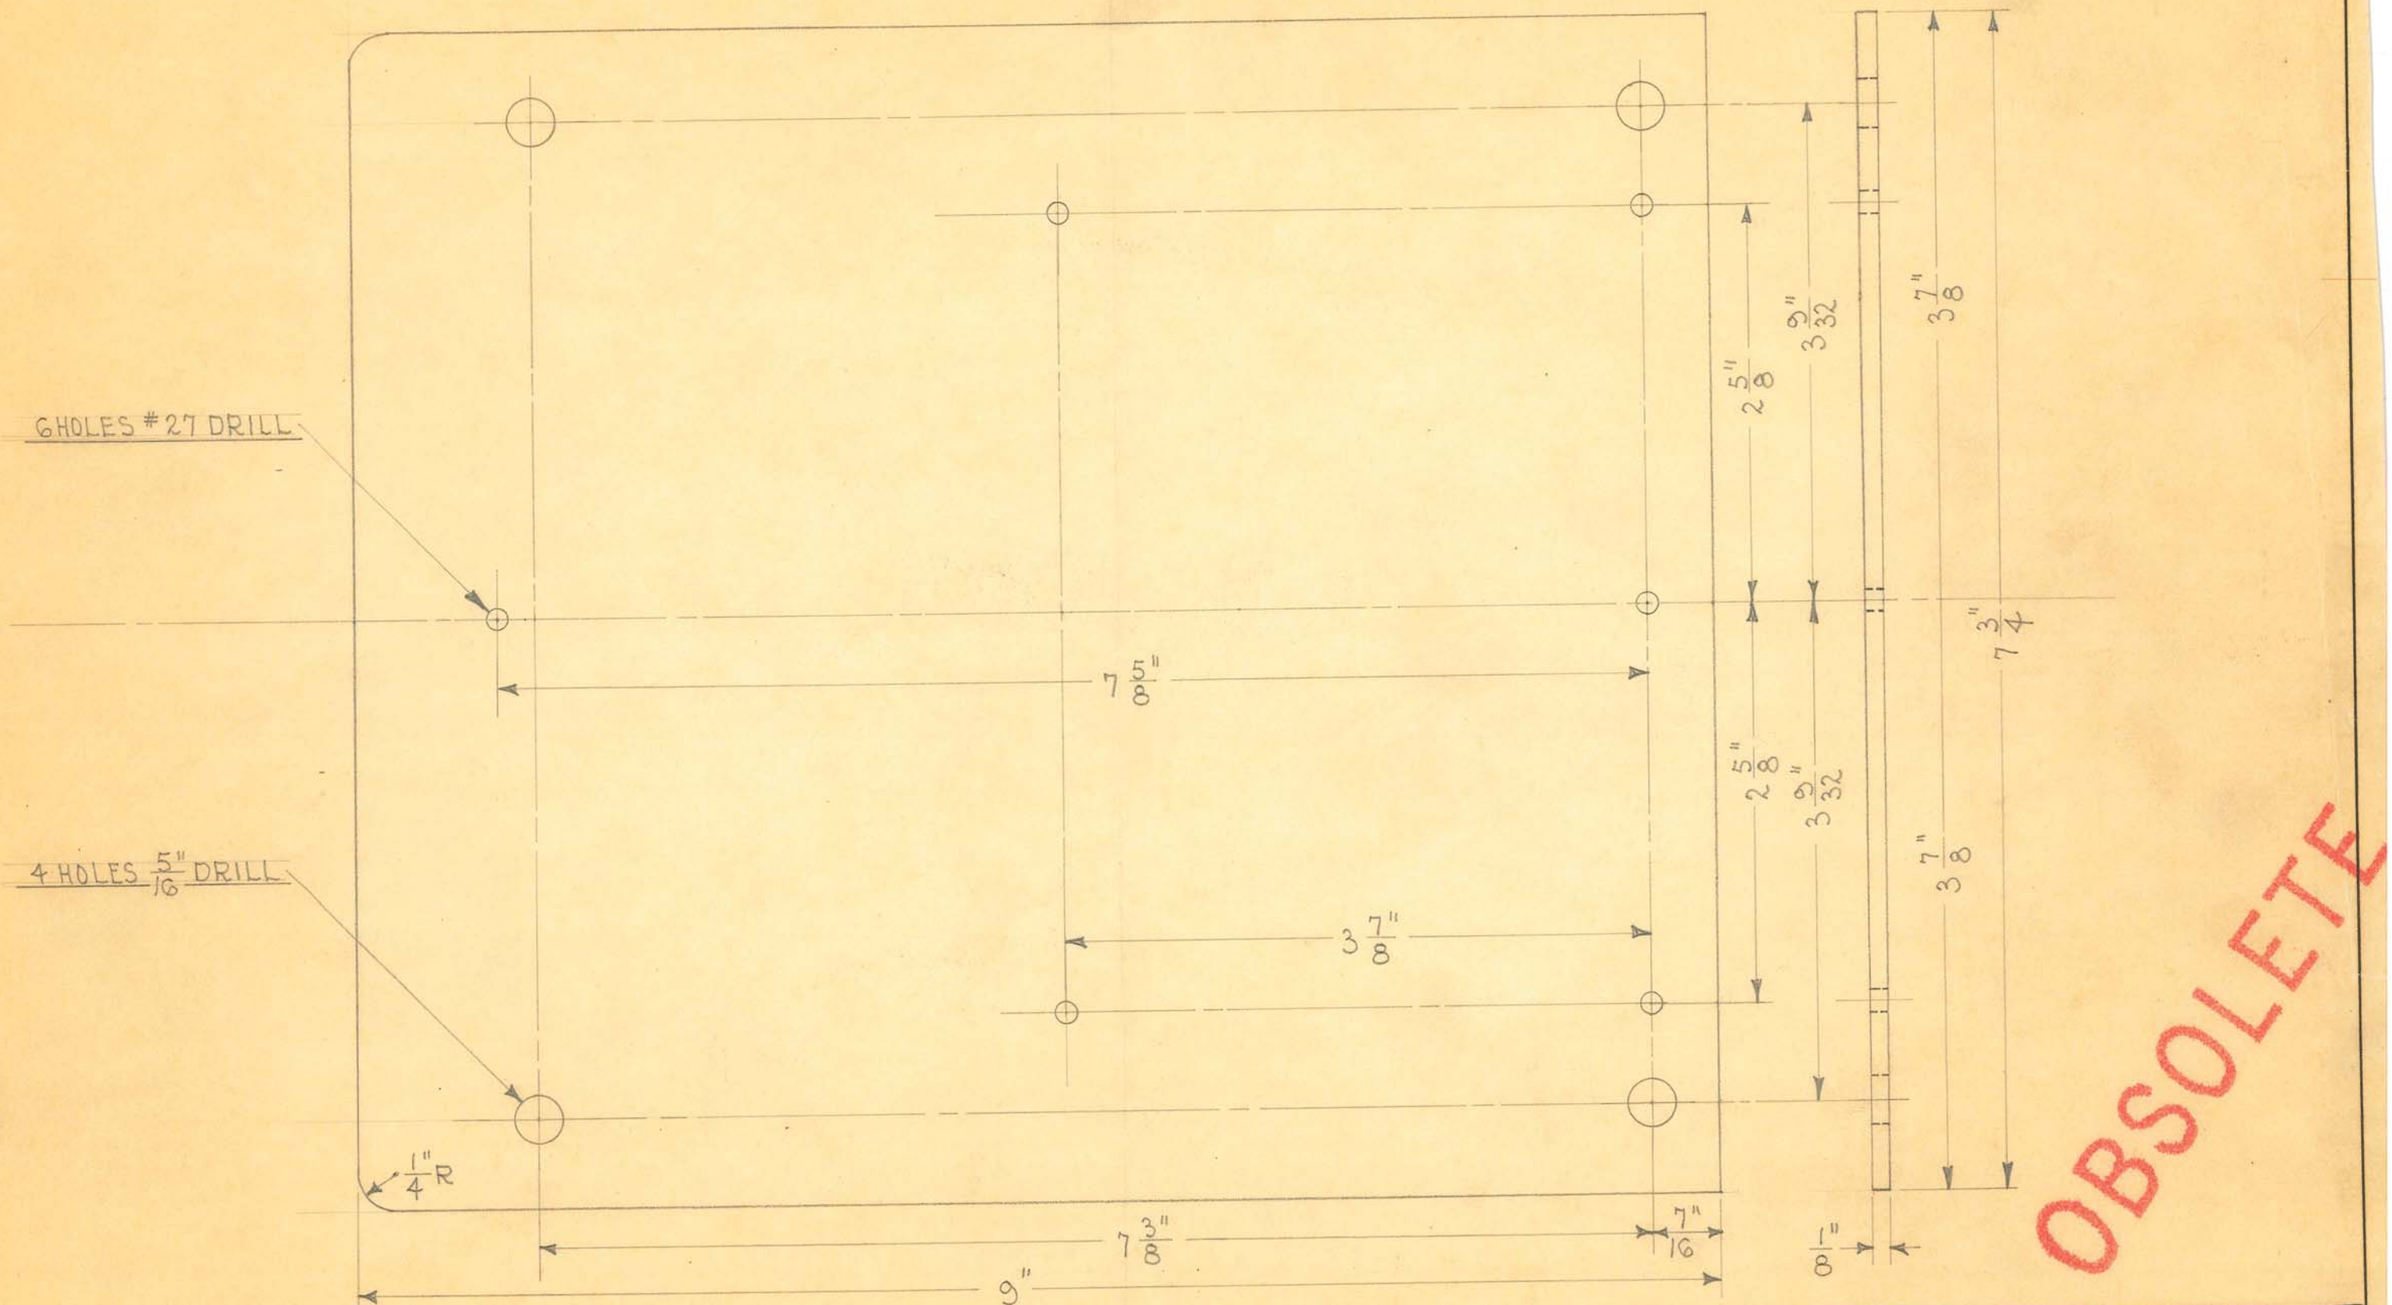

SIZE	1/8" SHEET	ISSUE 4-16-36	2/8	TITLE: INTERMEDIATE "SWI-12" TRANSFORMER HEAT BARRIER
KIND	TRANSITE	CHANGED		
SHAPE		" "		
FINISH		" "		
TEMP.		" "		
PATT.		" "		

H. G. FISCHER & CO.
2335 WABANSIA AVE.
CHICAGO, ILL.

CAT. NO.

PART NO. 9916F

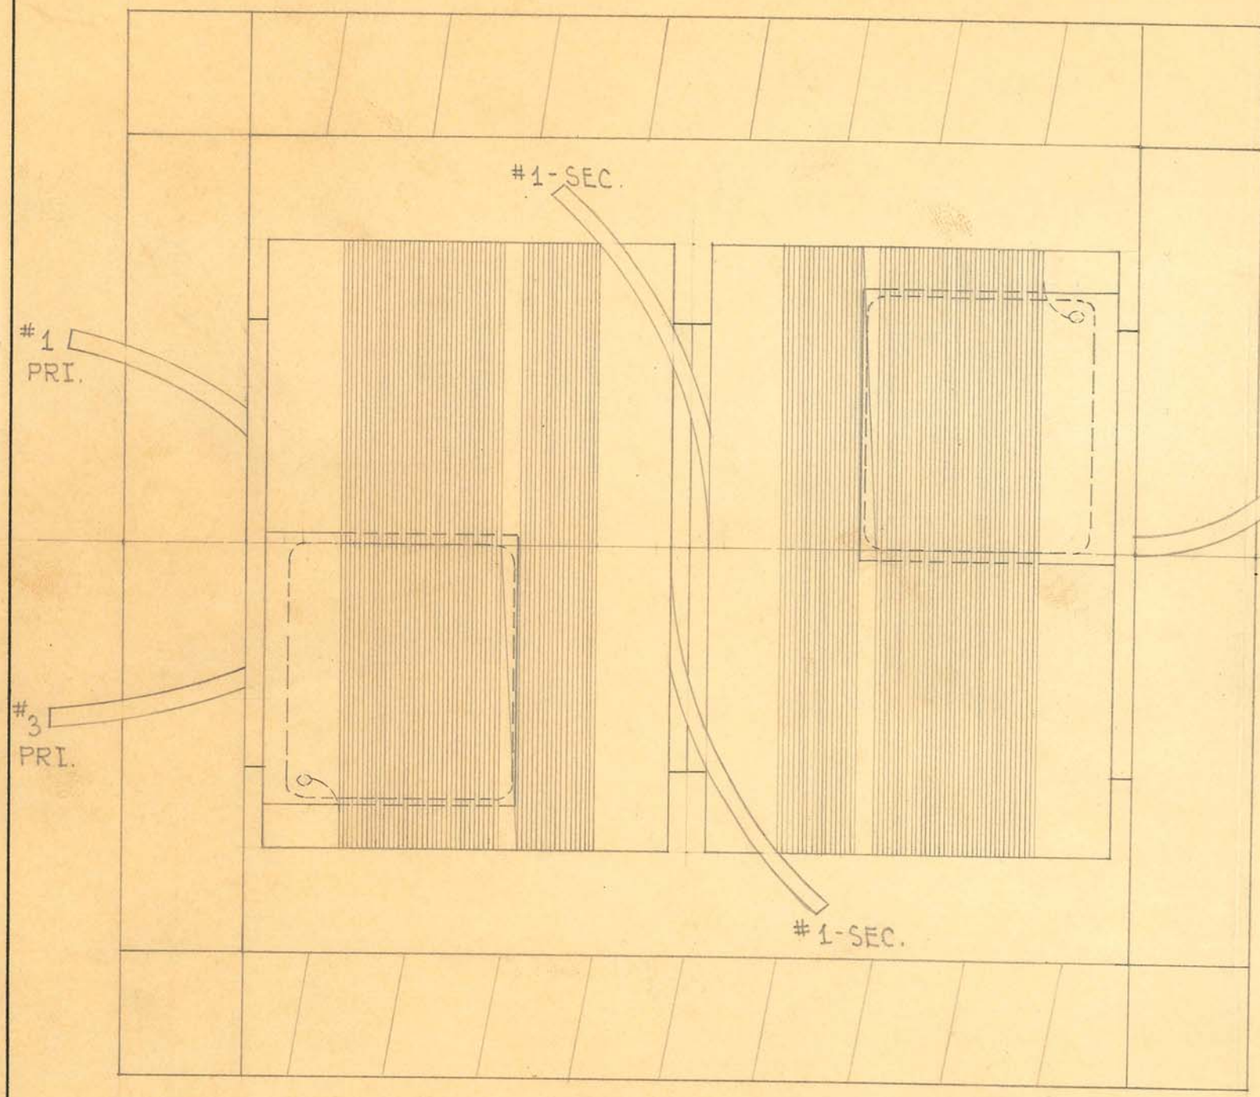

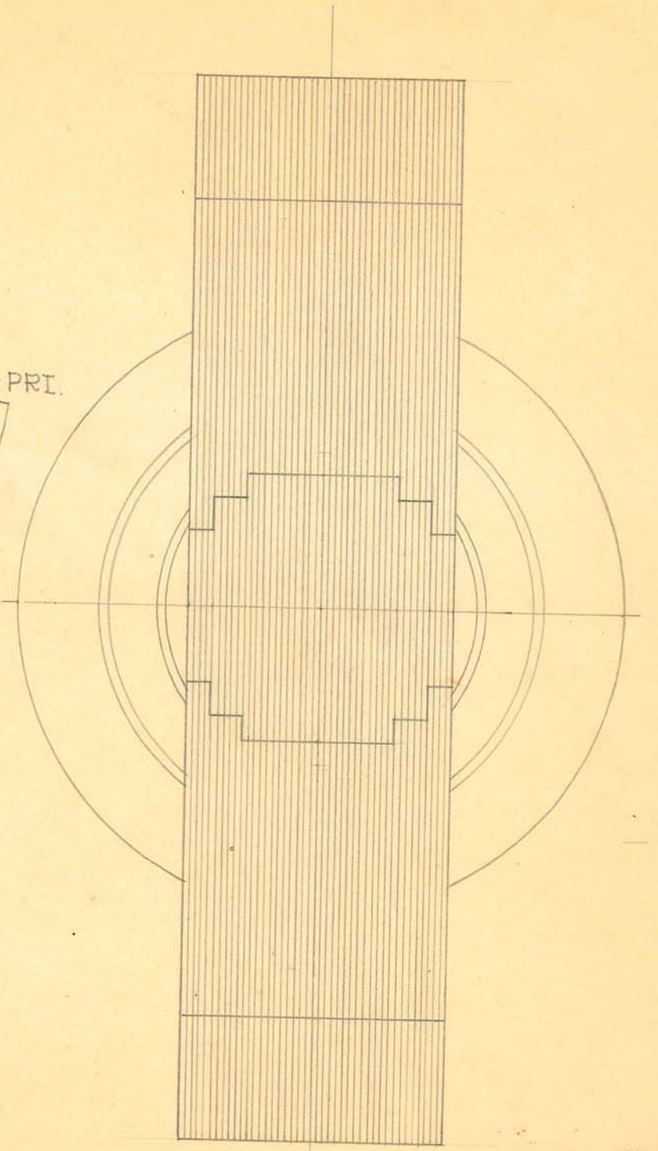

STEEL SIZES

PC. NO. 5043

1-"O" CORE:

LAMS. CUT, 6 $\frac{11}{16}$" X 1 $\frac{3}{4}$" BUILT UP 1".
6 $\frac{11}{16}$" X 1 $\frac{7}{16}$" BUILT UP $\frac{7}{16}$".
6 $\frac{11}{16}$" X 1" BUILT UP $\frac{5}{16}$".

2 SIDE BARS:

LAMS. CUT, 6 $\frac{11}{16}$" X $\frac{13}{16}$" BUILT UP 1 $\frac{3}{4}$".

END PCS. CUT 5 $\frac{3}{8}$" X $\frac{13}{16}$"
3" X $\frac{13}{16}$"
2 $\frac{25}{32}$" X $\frac{13}{16}$"
2 $\frac{5}{8}$" X $\frac{13}{16}$"

BIND "O" CORE & SIDE BARS WITH FRICTION TAPE.

PLACE PRI. COIL ON "O" CORE & SEC. COILS OVER PRI. AS SHOWN.

OBSOLETE

SIZE		ISSUE 12-10-36	J.E.	TITLE: INTERMEDIATE "SWI-12" SHORT WAVE POWER TRANSFORMER
KIND		CHANGED		
SHAPE		"		
FINISH		"		
TEMP.		"		

H. G. FISCHER & CO. | CAT. | PART

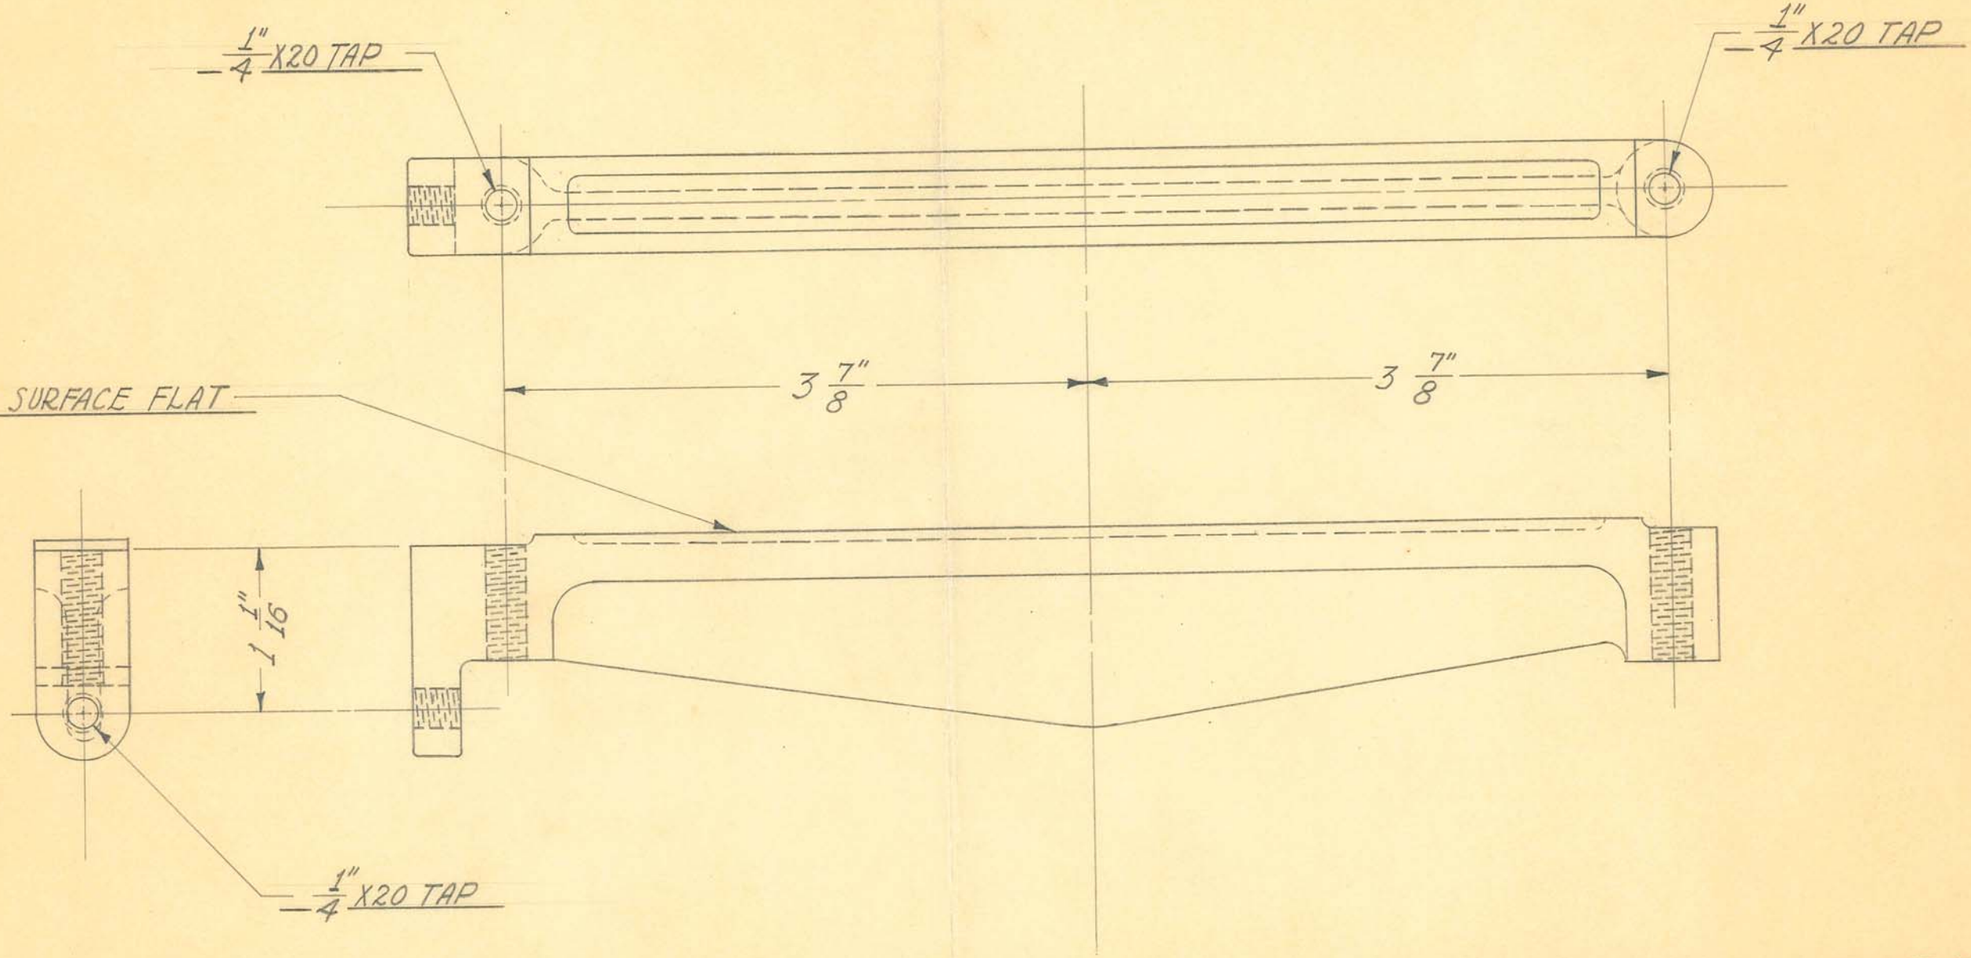

2 REQUIRED

OBSOLETE

SIZE		ISSUE 11-28-38	J.W.	TITLE: SHORT WAVE H.T. TRANSFORMER SUPPORT - FRONT (FOREIGN ORDERS)
KIND	IRON CASTING	CHANGED		
SHAPE		"		
FINISH	BLACK #80	"		
TEMP.		"		
PATT.	1309	"		

H. G. FISCHER & CO.
2335 WABANSIA AVE.
CHICAGO, ILL.

CAT. NO.

PART NO. 9932F

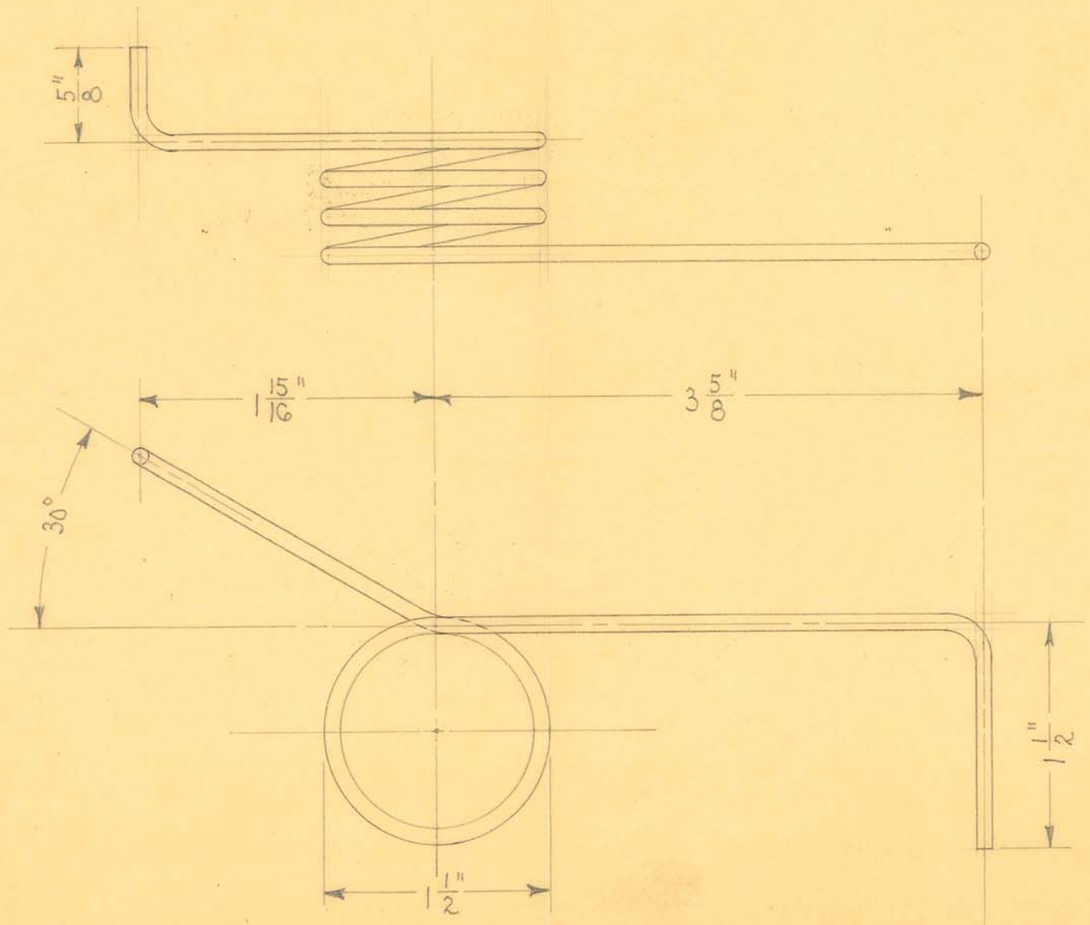

1 REQUIRED
3 TURNS

OBSOLETE

SIZE	#10 TINNED	ISSUE 10-29-35	A.E.
KIND	COPPER WIRE	CHANGED	
SHAPE		" "	
FINISH		" "	
TEMP.		" "	
PATT.		" "	

TITLE: FISCHER "SWD-24" SHORT WAVE OSCILLATOR UNIT PATIENT'S TUNING COIL - RIGHT

H. G. FISCHER & CO.
2335 WABANSIA AVE.
CHICAGO, ILL.

CAT. NO.

PART NO. 9784

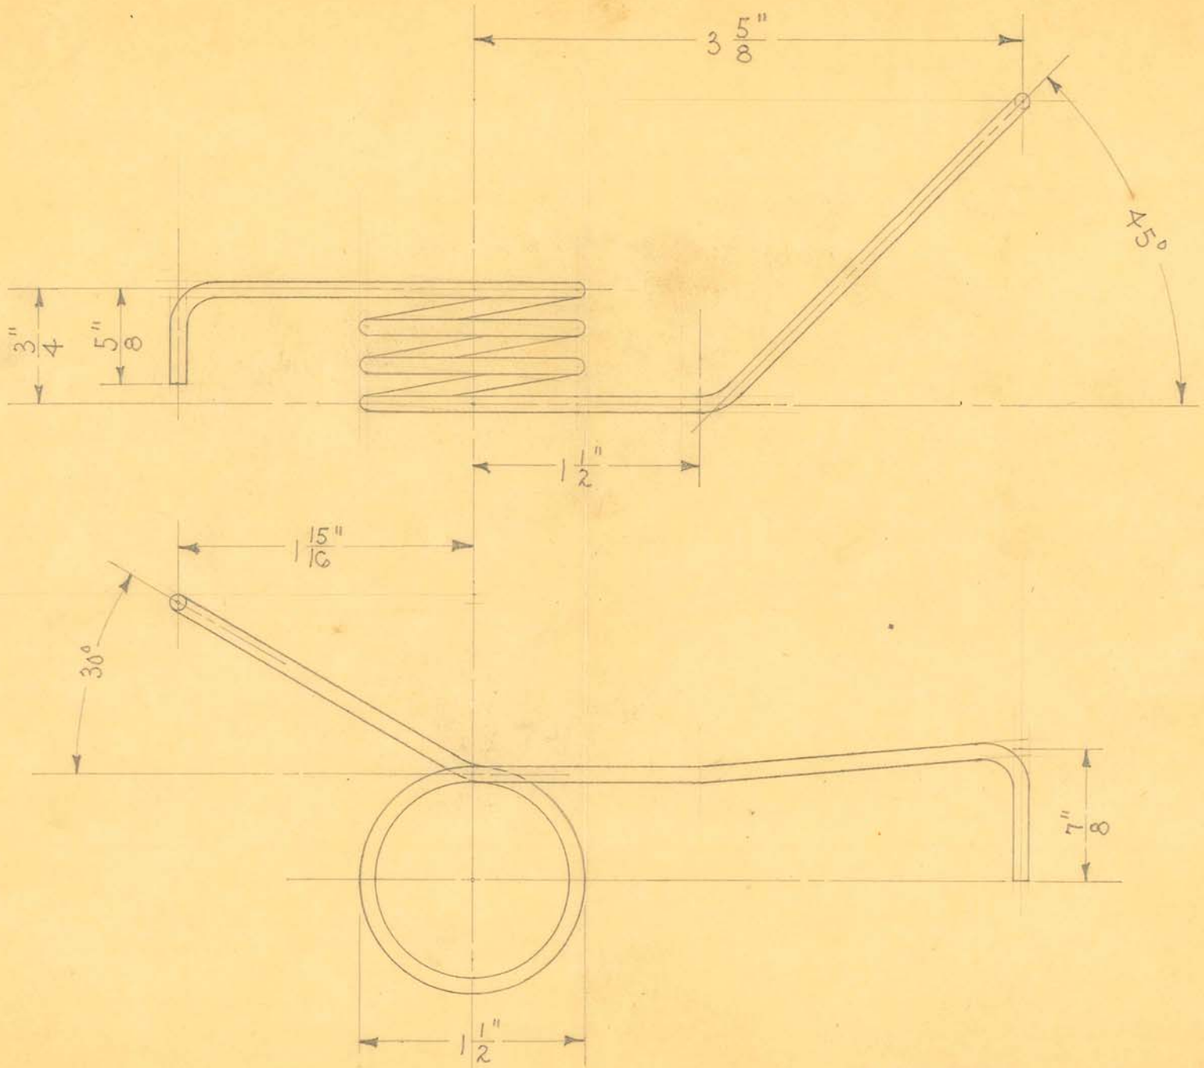

1 REQUIRED

3 TURNS

OBSOLETE

SIZE	#10 TINNED	ISSUE 10-29-35	WC	TITLE: FISCHER "SWD-24" SHORT WAVE OSCILLATOR UNIT PATIENT'S TUNING COIL - LEFT
KIND	COPPER WIRE	CHANGED		
SHAPE		" "		
FINISH		" "		
TEMP.		" "		
PATT.		" "		

H. G. FISCHER & CO.
2335 WABANSIA AVE.
CHICAGO, ILL.

CAT. NO.

PART NO. 9784 1/2

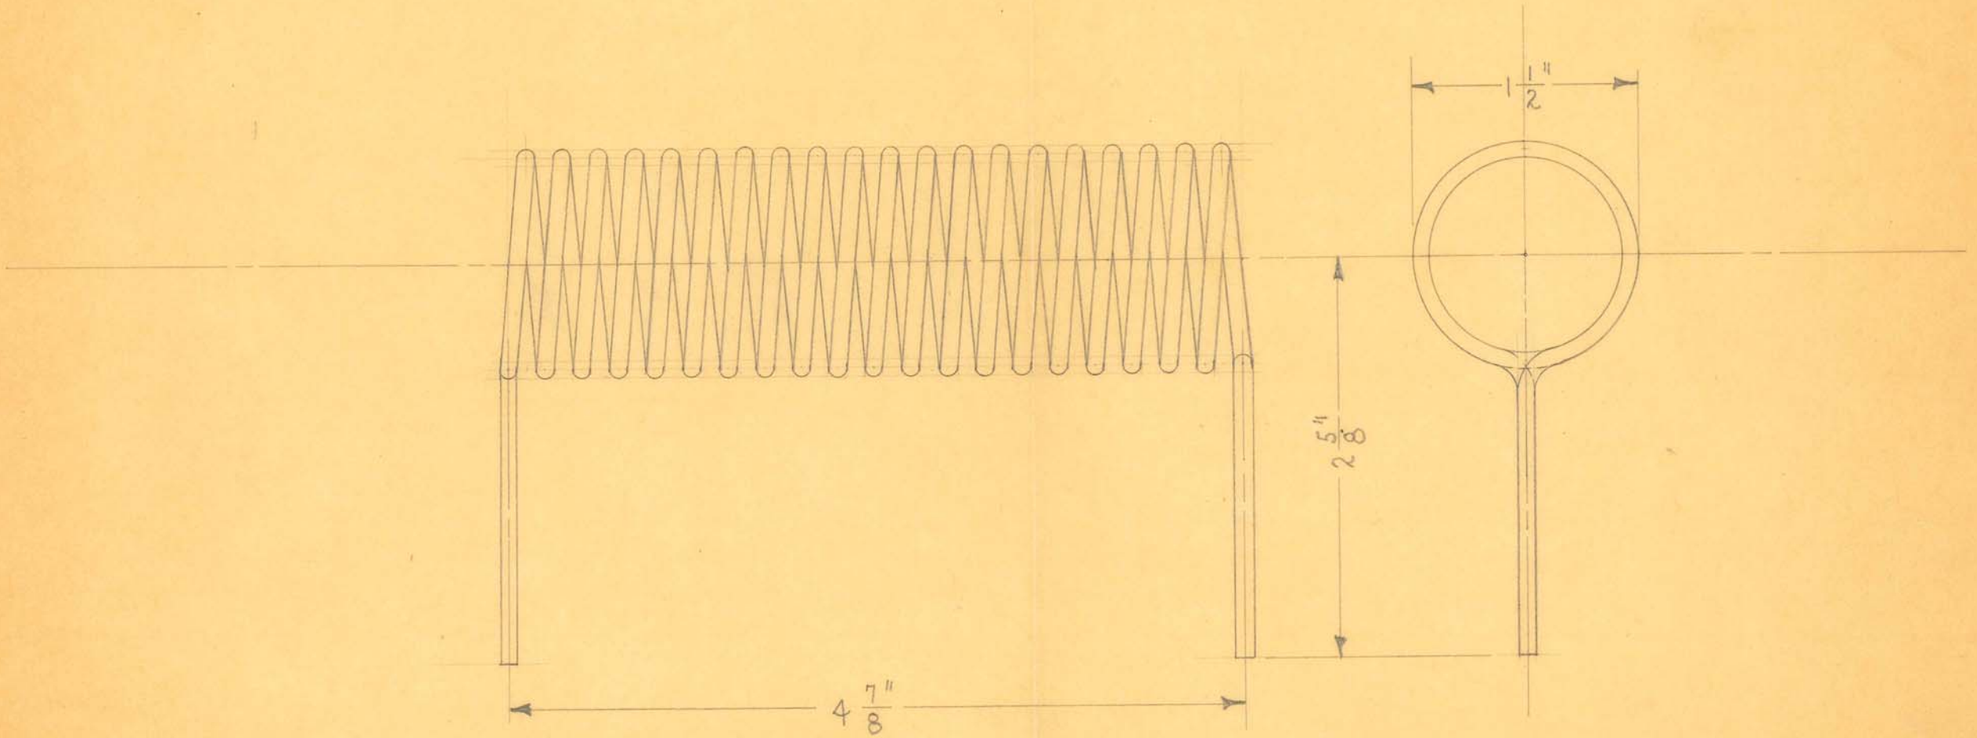

1 REQUIRED
20 TURNS

OBSOLETE

SIZE	#10 TINNED	ISSUE 10-28-35	D.E.
KIND	COPPER WIRE	CHANGED	
SHAPE		" "	
FINISH		" "	
TEMP.		" "	
PATT.		" "	

TITLE: FISCHER "SWD-24" SHORT WAVE OSCILLATOR UNIT
GRID COIL

H. G. FISCHER & CO.
2335 WABANSIA AVE.
CHICAGO, ILL.

CAT. NO.

PART NO. 9786

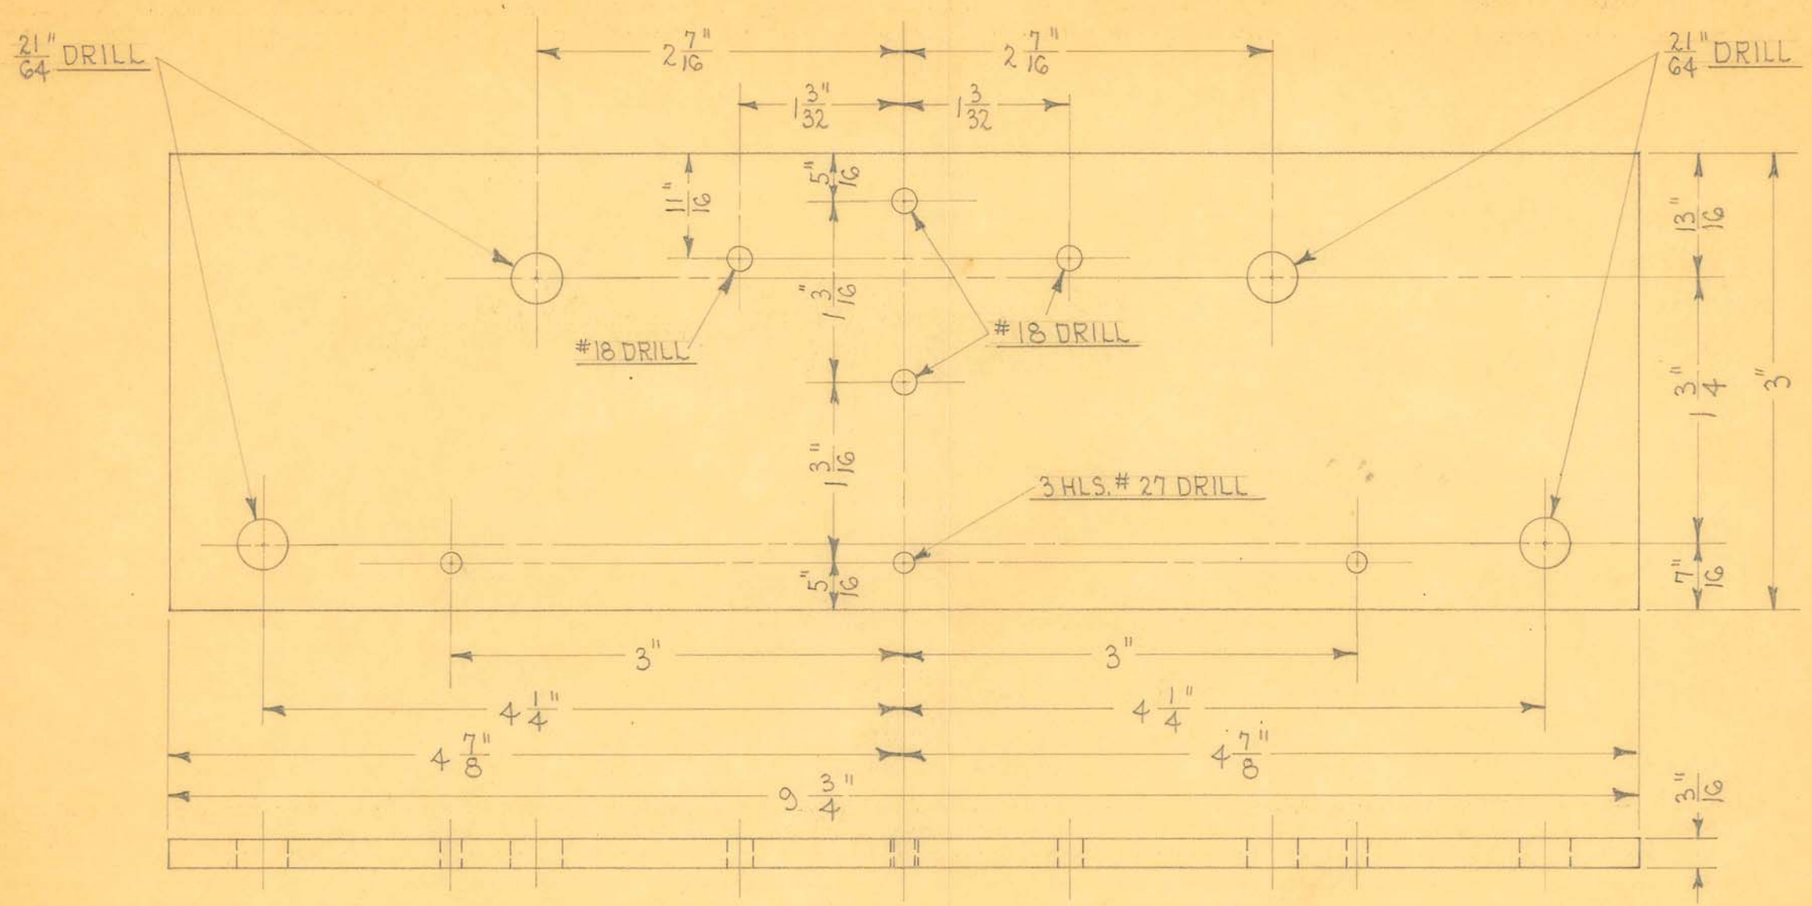

FROM 9434

OBSOLETE

SIZE		ISSUE 11-5-35	J.E.	TITLE: FISCHER "SWD-6" SHORT WAVE OSCIL. UNIT TREATMENT CORD SOCKET MTG. BOARD
KIND		CHANGED		
SHAPE		" "		
FINISH		" "		
TEMP.		" "		H. G. FISCHER & CO. 2335 WABANSIA AVE. CHICAGO, ILL.
PATT.		" "		CAT. NO.
				PART NO. 9817

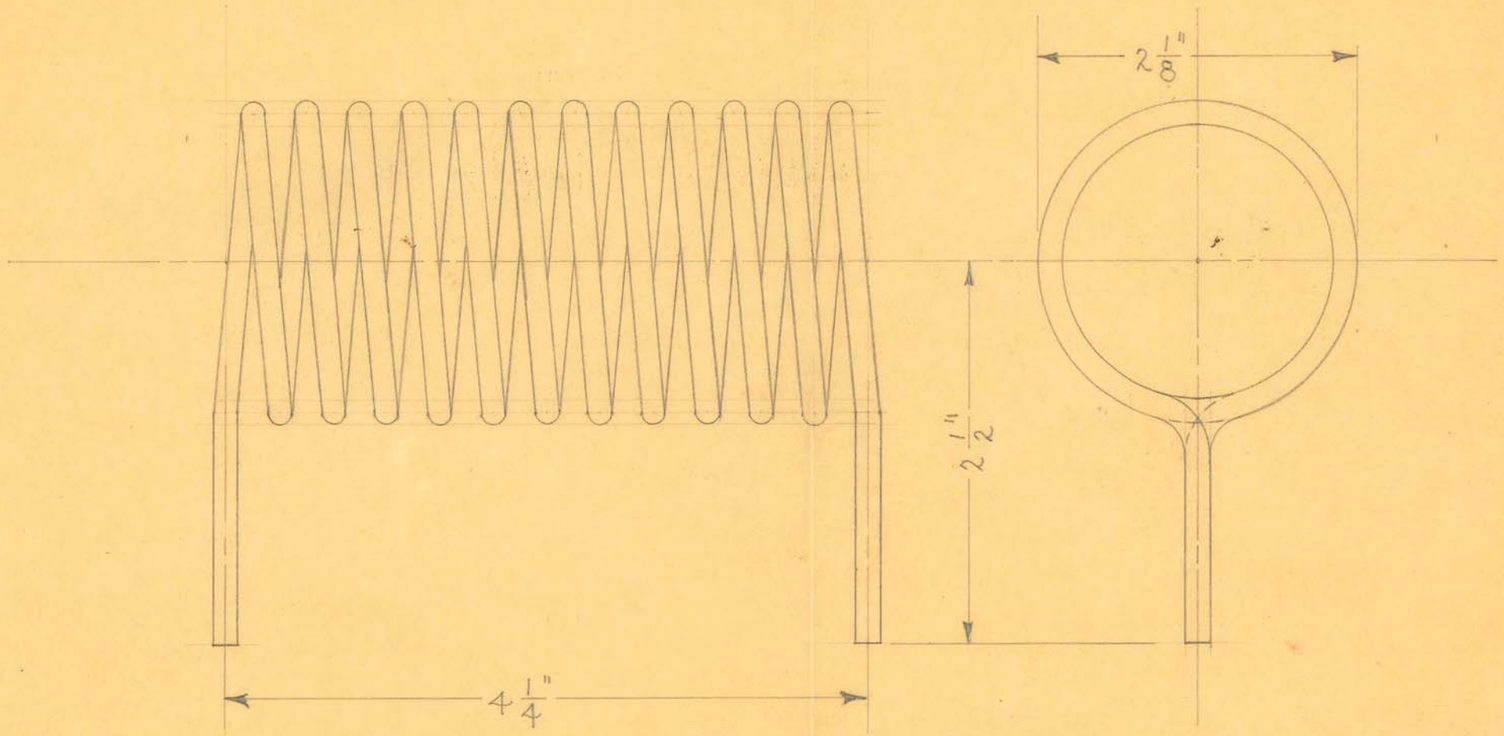

1 REQUIRED
12 TURNS

OBSOLETE

SIZE	#6 BARE	ISSUE 10-21-35	J.E.	TITLE: FISCHER "SWD-12" SHORT WAVE OSCILLATOR UNIT OSCILLATING COIL
KIND	COPPER WIRE	CHANGED		
SHAPE		" "		
FINISH		" "		
TEMP.		" "		H. G. FISCHER & CO. 2335 WABANSIA AVE. CHICAGO, ILL. — CAT. NO. — PART NO. 9819
PATT.		" "		

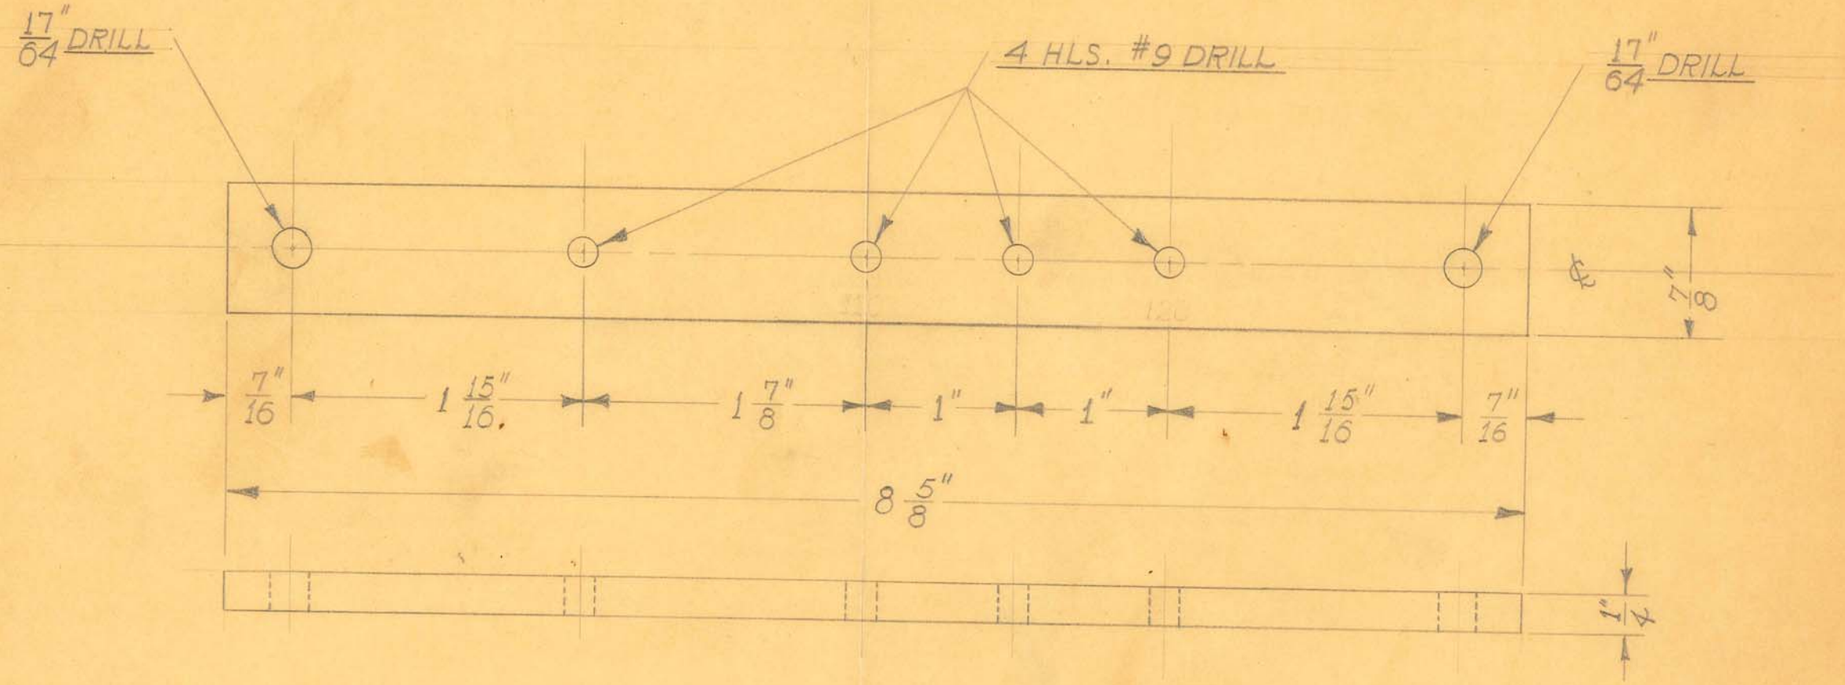

1 REQUIRED

OBSOLETE

SIZE	1/4" SHEET	ISSUE 10-24-35	J.W.	TITLE: FISCHER "SWD-6-12-18-24" SHORT WAVE POWER UNIT TRANSF. TERM. STRIP- FRONT
KIND	RICHELAIN	CHANGED		
SHAPE	BAKELITE	" "		
FINISH		" "		
TEMP.		" "		H. G. FISCHER & CO. CAT. PART

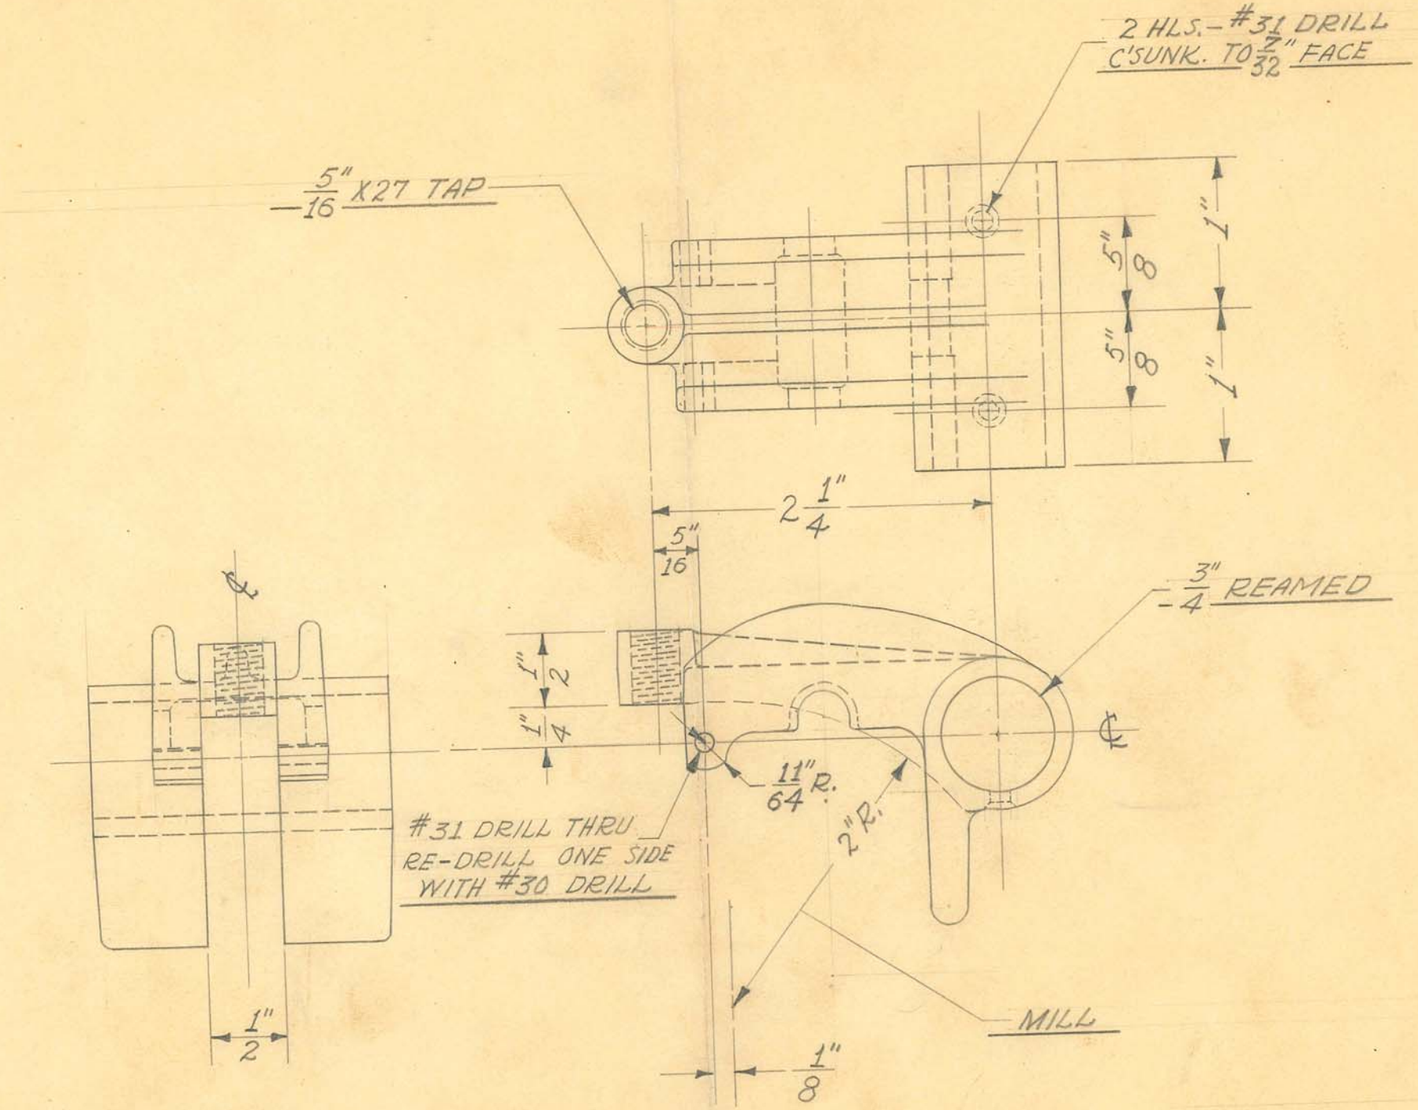

1 REQUIRED

OBSOLETE

SIZE	#214	ISSUE 11-16-38	J.W.
KIND	ALUM. CASTING	CHANGED	
SHAPE		"	
FINISH		"	
TEMP.		"	

TITLE: FISCHER ORTHODIAGRAPHIC ATTACHMENT
TRACING ARM – CLAMP BODY

H. G. FISCHER & CO.
2335 WABANSIA AVE.
CHICAGO, ILL.

CAT. NO.

PART NO. 11731F

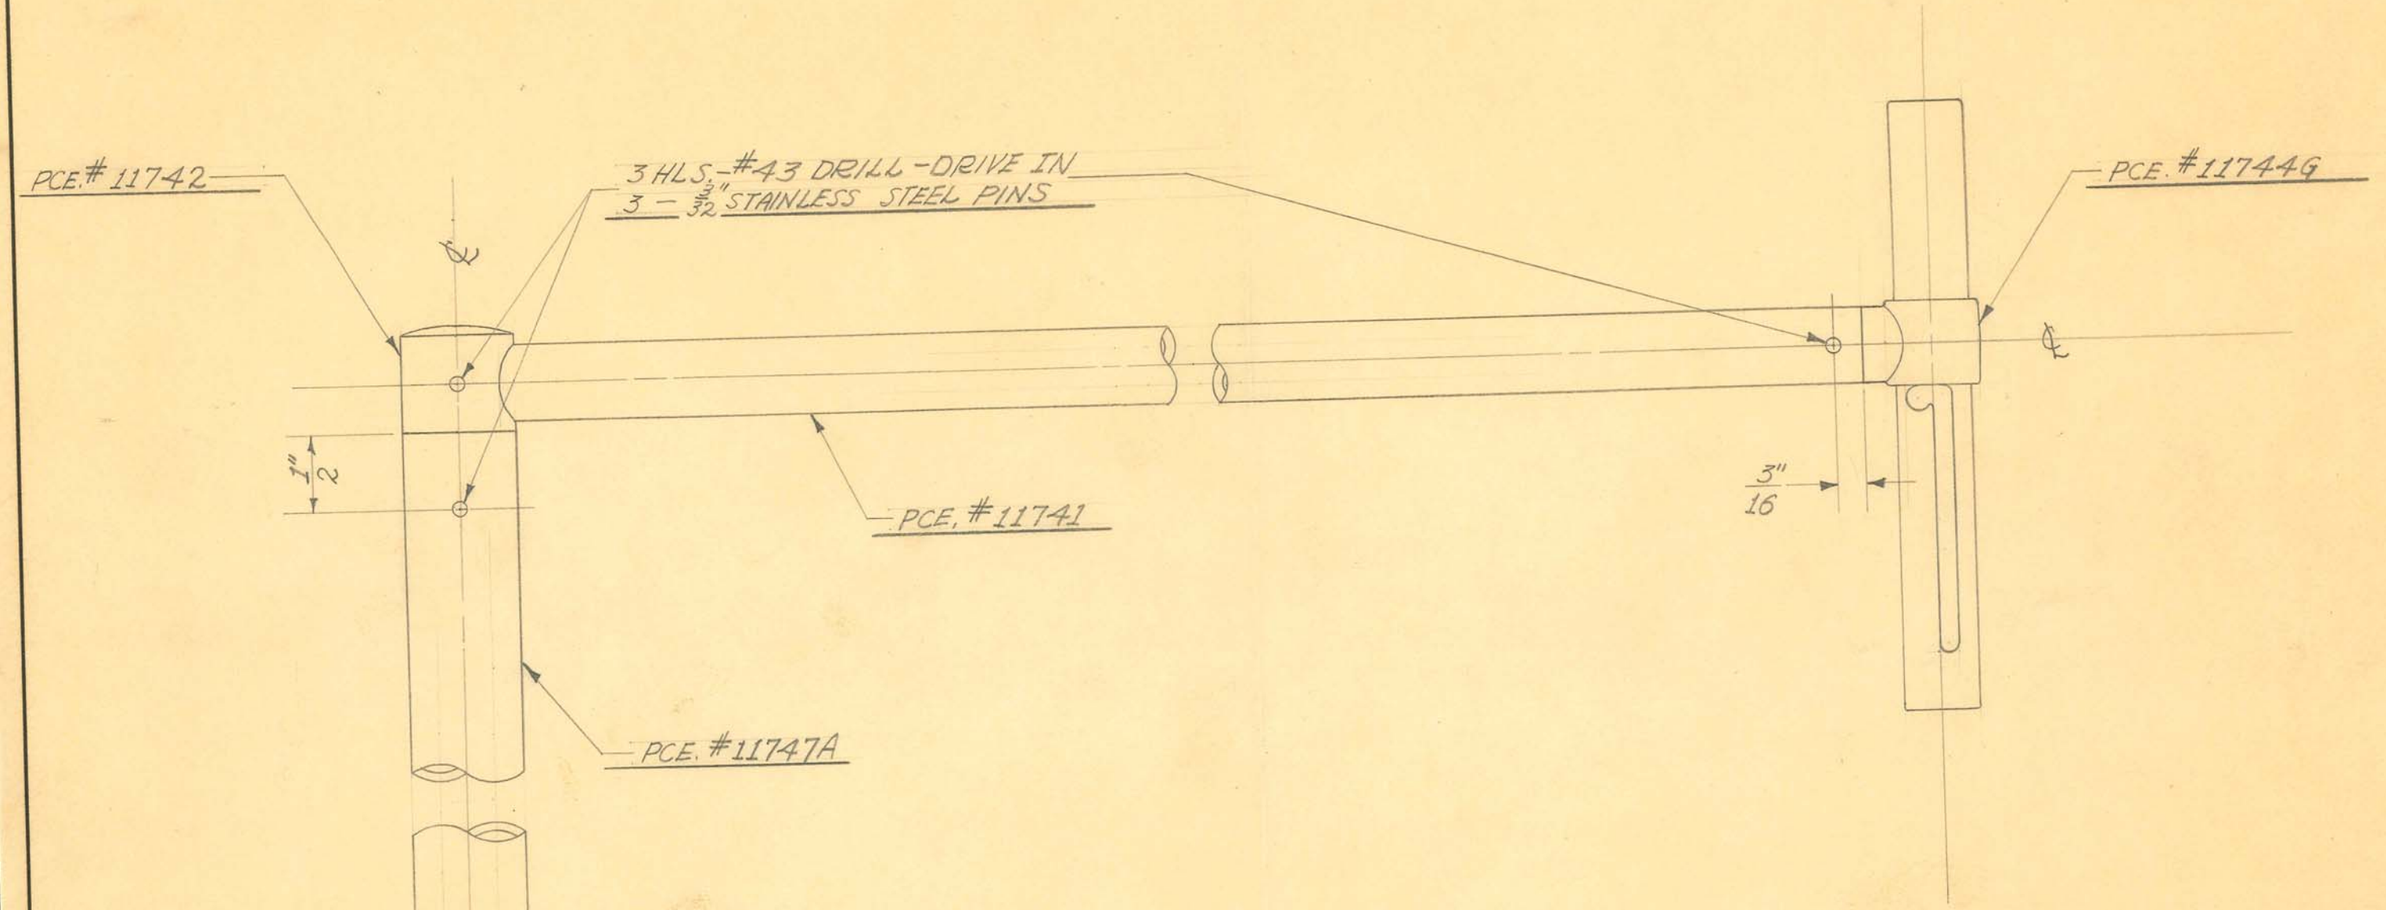

OBSOLETE

SIZE		ISSUE 11-25-38	J.W.	TITLE: FISCHER ORTHODIAGRAPHIC ATTACHMENT PENCIL ARM ASSEMBLY
KIND		CHANGED		
SHAPE		"		
FINISH		"		
TEMP.		"		
		"		

H. G. FISCHER & CO.
2335 WABANSIA AVE.
CHICAGO, ILL.

CAT. NO.

PART NO. IN GROUP 11740GA

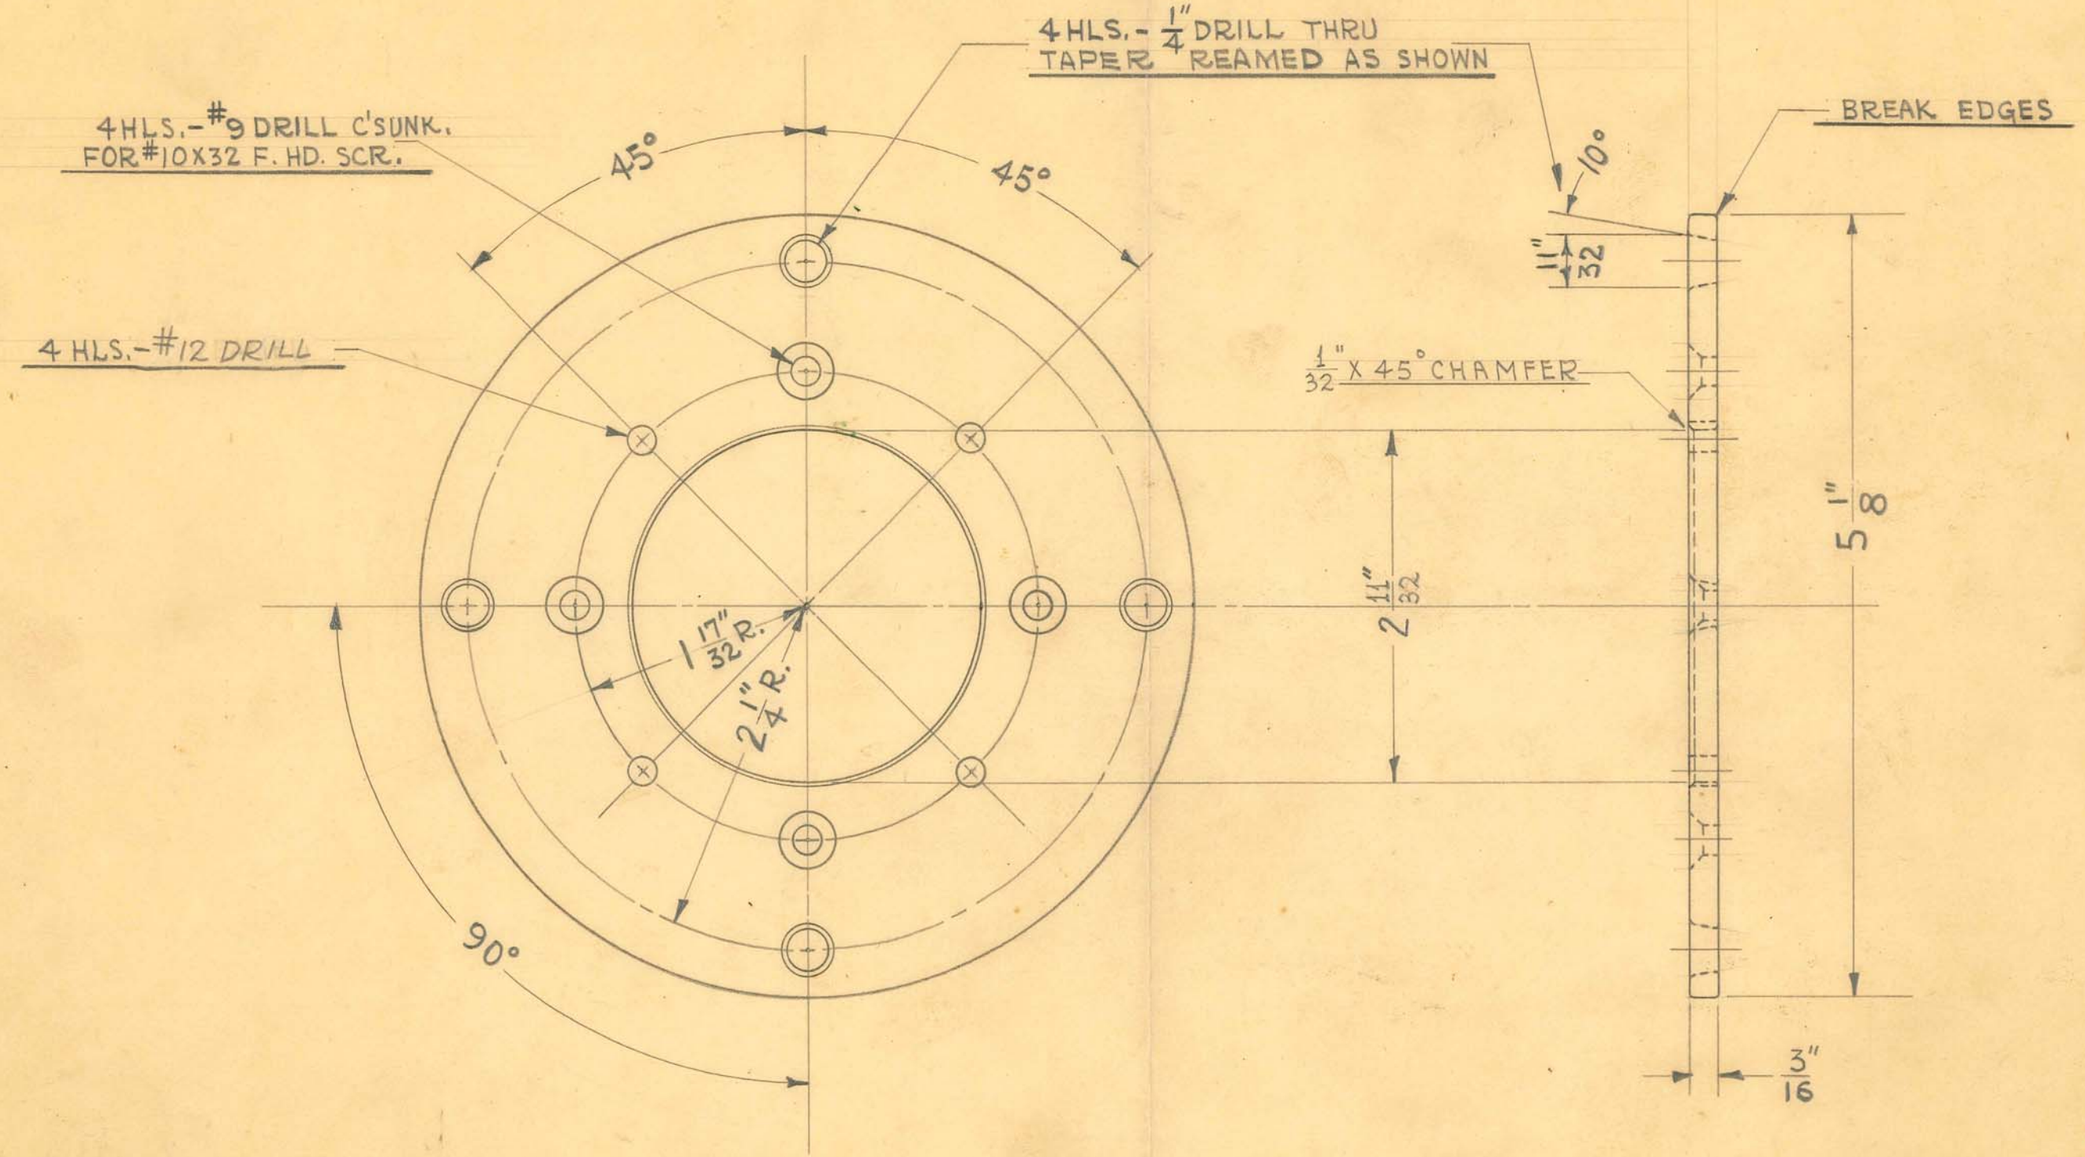

1 REQUIRED

OBSOLETE

SIZE	FROM 14515	ISSUE 4-8-42	J.V.W.
KIND		CHANGED	
SHAPE		" 6-19-46	J.V.W.
FINISH	CAD. #23	"	
TEMP.		"	
PATT.		"	

TITLE:
FISCHER MOD. "TV-30-96" RAD. & FLUO. UNIT
HEAD & SCREEN ARM SWIVEL LOCK PLATE

H. G. FISCHER & CO.
2335 WABANSIA AVE.
CHICAGO, ILL.

CAT. NO.

PART NO. 14515F

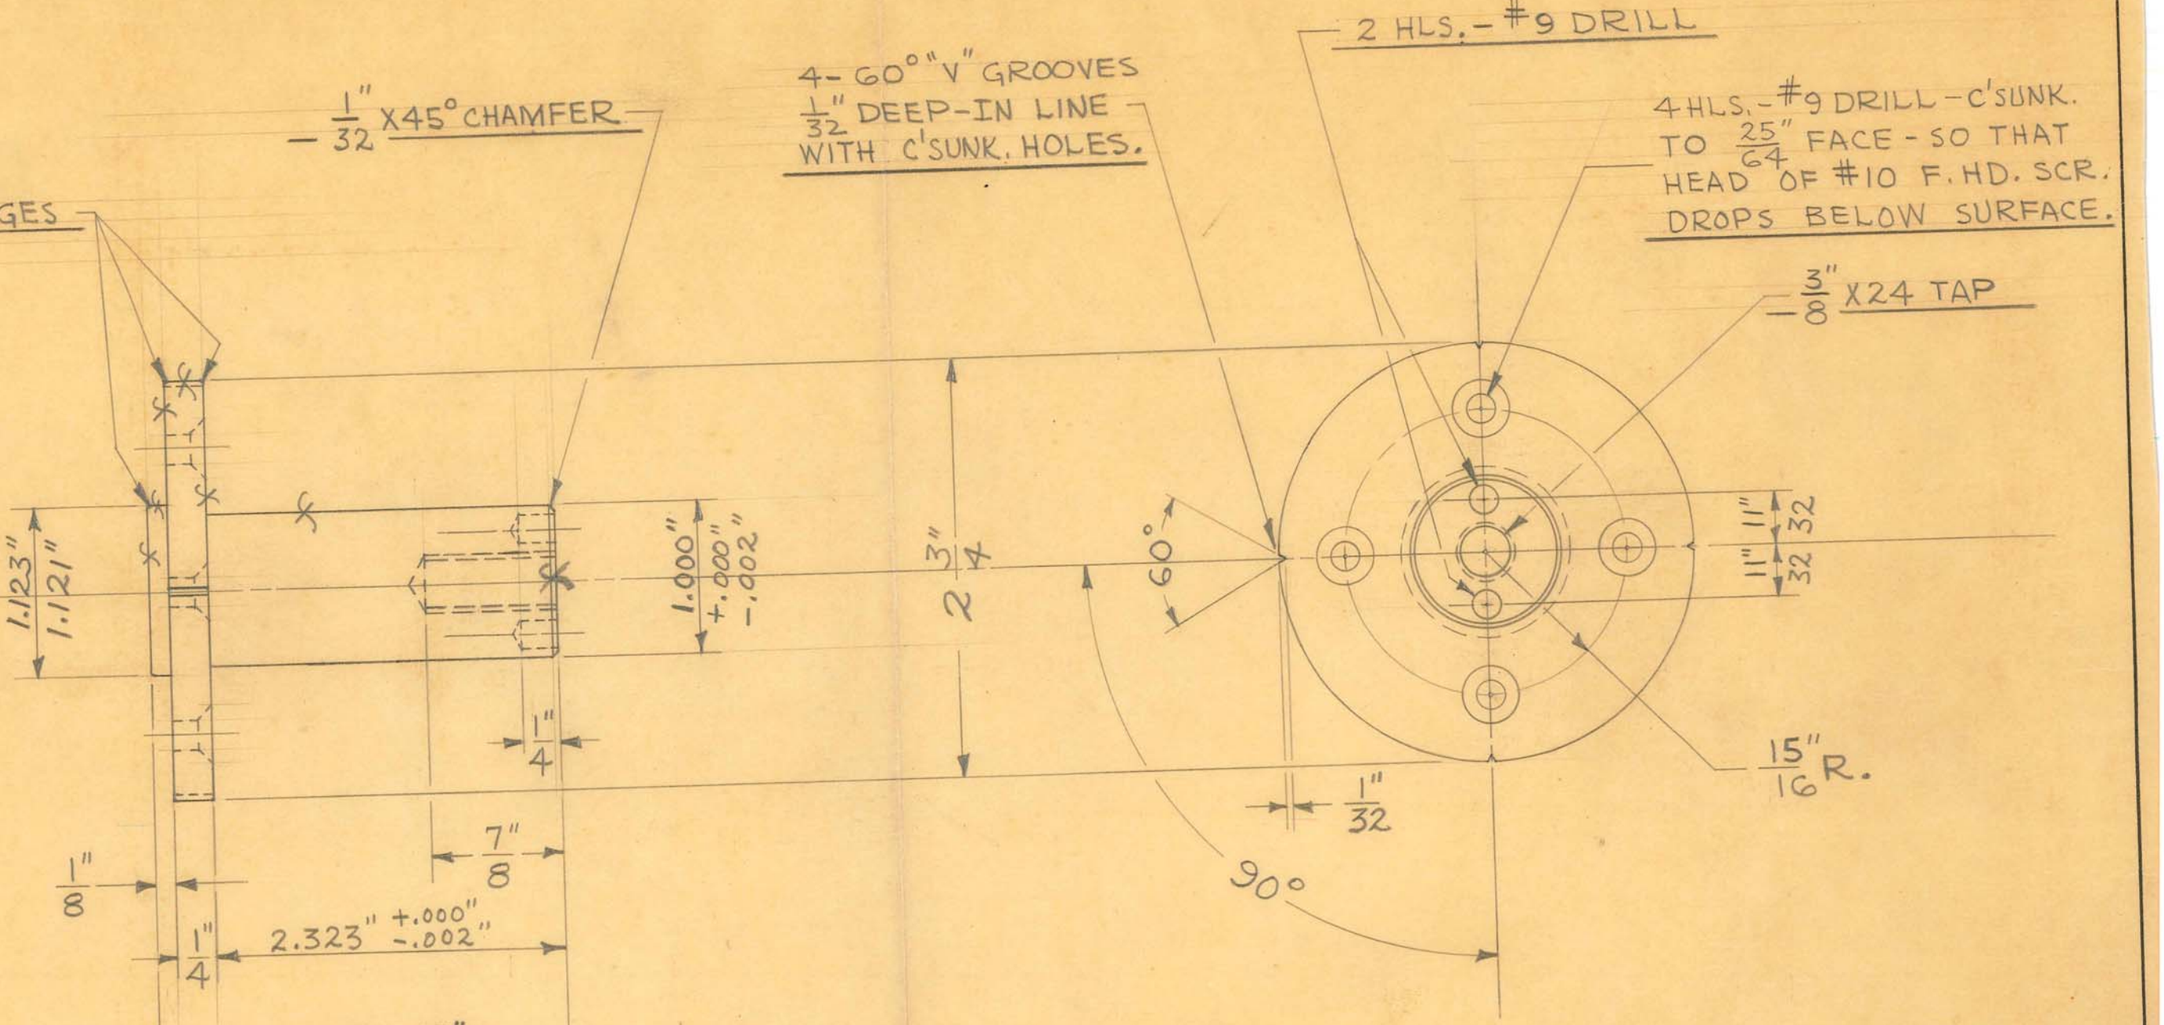

1 REQUIRED

OBSOLETE

NOTE: SATIN CHROME #4 - SATIN FINISH ON EDGE OF 2 3/4" DISC. ONLY

SIZE		ISSUE 9-10-46 J.V.W.	
KIND	BRONZE	CHANGED	
SHAPE		"	
FINISH	SEE NOTE	"	
TEMP.		"	
PAT.	2088	"	

TITLE: FISCHER "TV-30-96" RAD. & FLUO. UNIT TRANSF. HEAD SWIVEL SUPPORT STUD

H. G. FISCHER & CO. 2335 WABANSIA AVE. CHICAGO, ILL. | CAT. NO. | PART NO. 14518AF

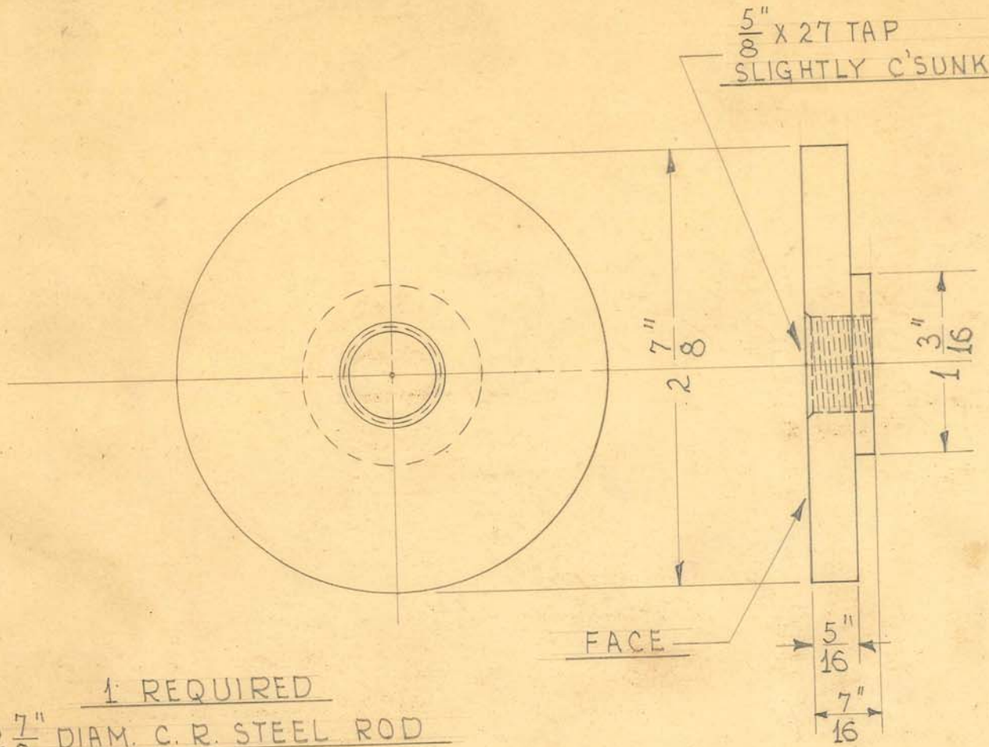

1 REQUIRED
2 7/8" DIAM. C. R. STEEL ROD

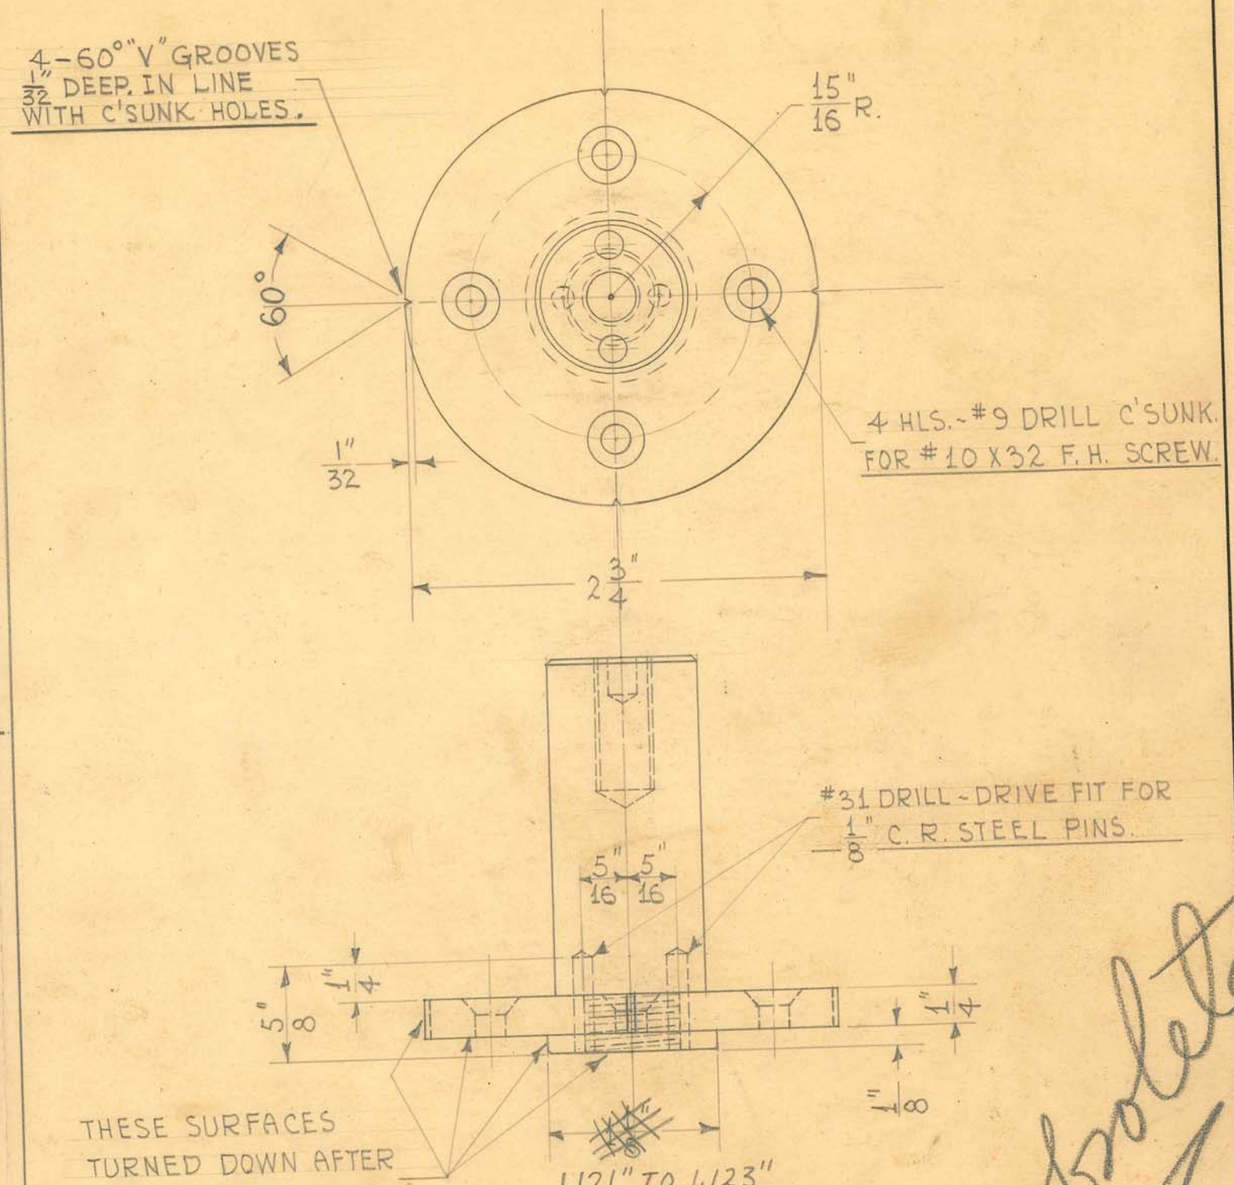

1 REQUIRED

NOTE:
SATIN CHROME #4 EDGE OF 2 3/4" DIA. DISC.

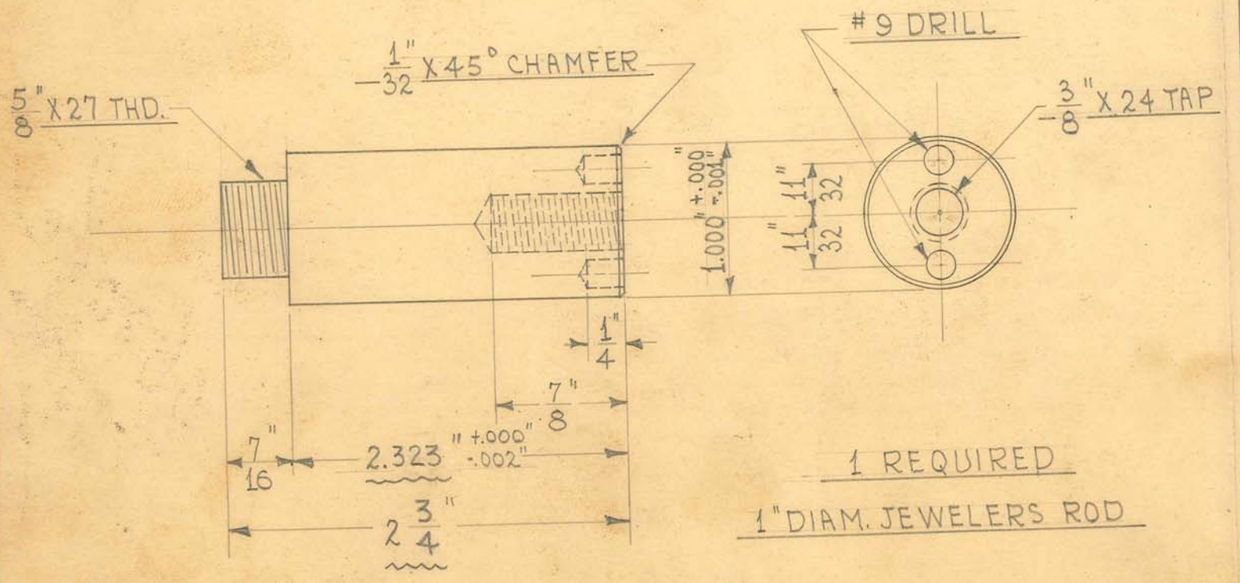

1 REQUIRED
1" DIAM. JEWELERS ROD

SIZE		ISSUED 9-15-41	H.E.	TITLE: FISCHER "TV-30-96" RAD. & FLUOR. UNIT-TRANSF. HEAD SWIVEL SUPPORT STUD
KIND		CHANGED		
SHAPE		"6-19-46	J.V.W.	
FINISH	SEE NOTE	"		
TEMP.		"		
PATT.		"		

H. G. FISCHER & CO.
2335 WABANSIA AVE.
CHICAGO, ILL.

CAT. NO.

PART NO. 14518G

OBSOLETE

Obsolete

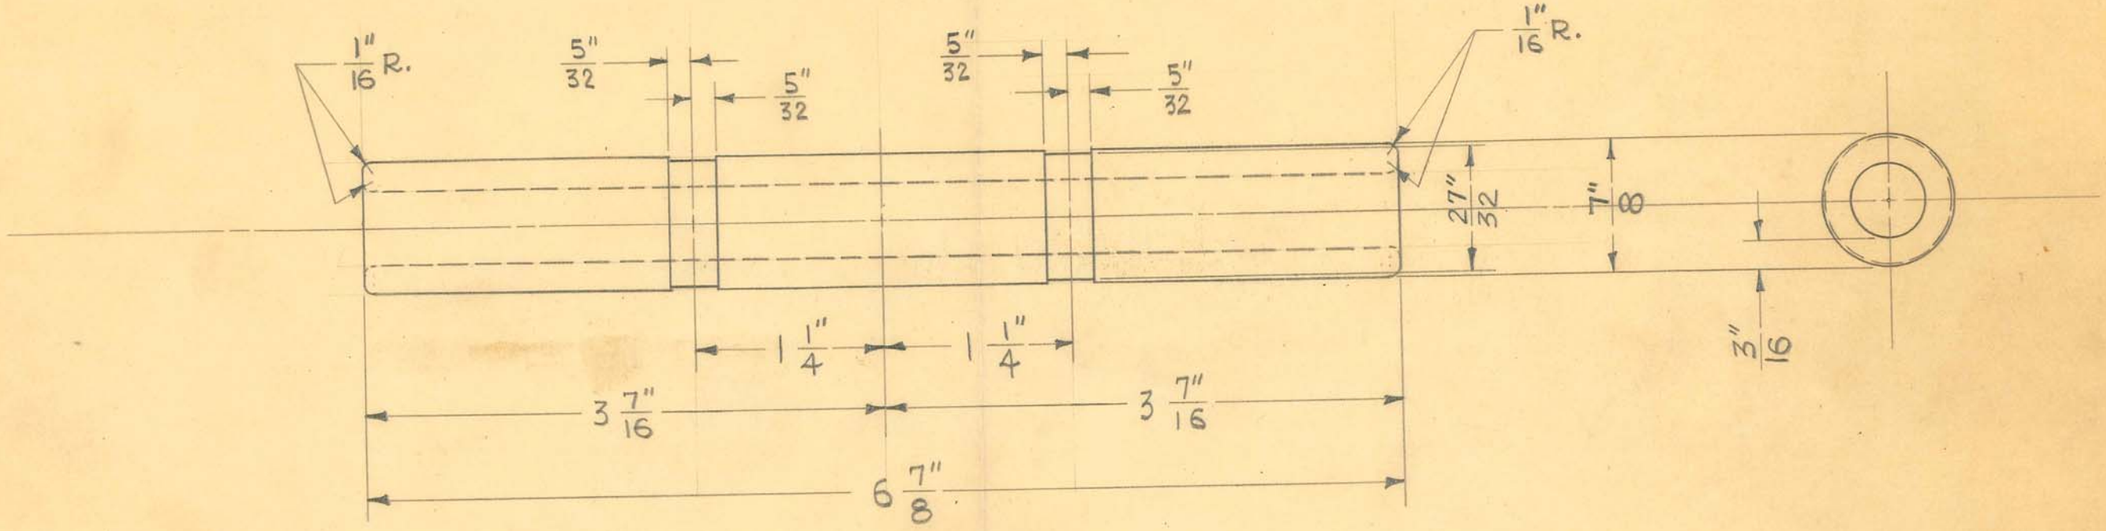

— 7" 8 O.D.X 3" 16 WALL - SHELBY SEAMLESS STEEL TUBING

1 REQUIRED

OBSOLETE

SIZE		ISSUE 4-17-42	J.V.W.
KIND		CHANGED	
SHAPE		"	
FINISH	WHITE CHR. #4	"	
TEMP.		"	
PATT.		"	

TITLE: FISCHER "TV-30-96" RAD. & FLUO. UNIT
SCREEN FORK SWIVEL SHAFT

H. G. FISCHER & CO.
2335 WABANSIA AVE.
CHICAGO, ILL.

CAT. NO.

PART NO. 14524

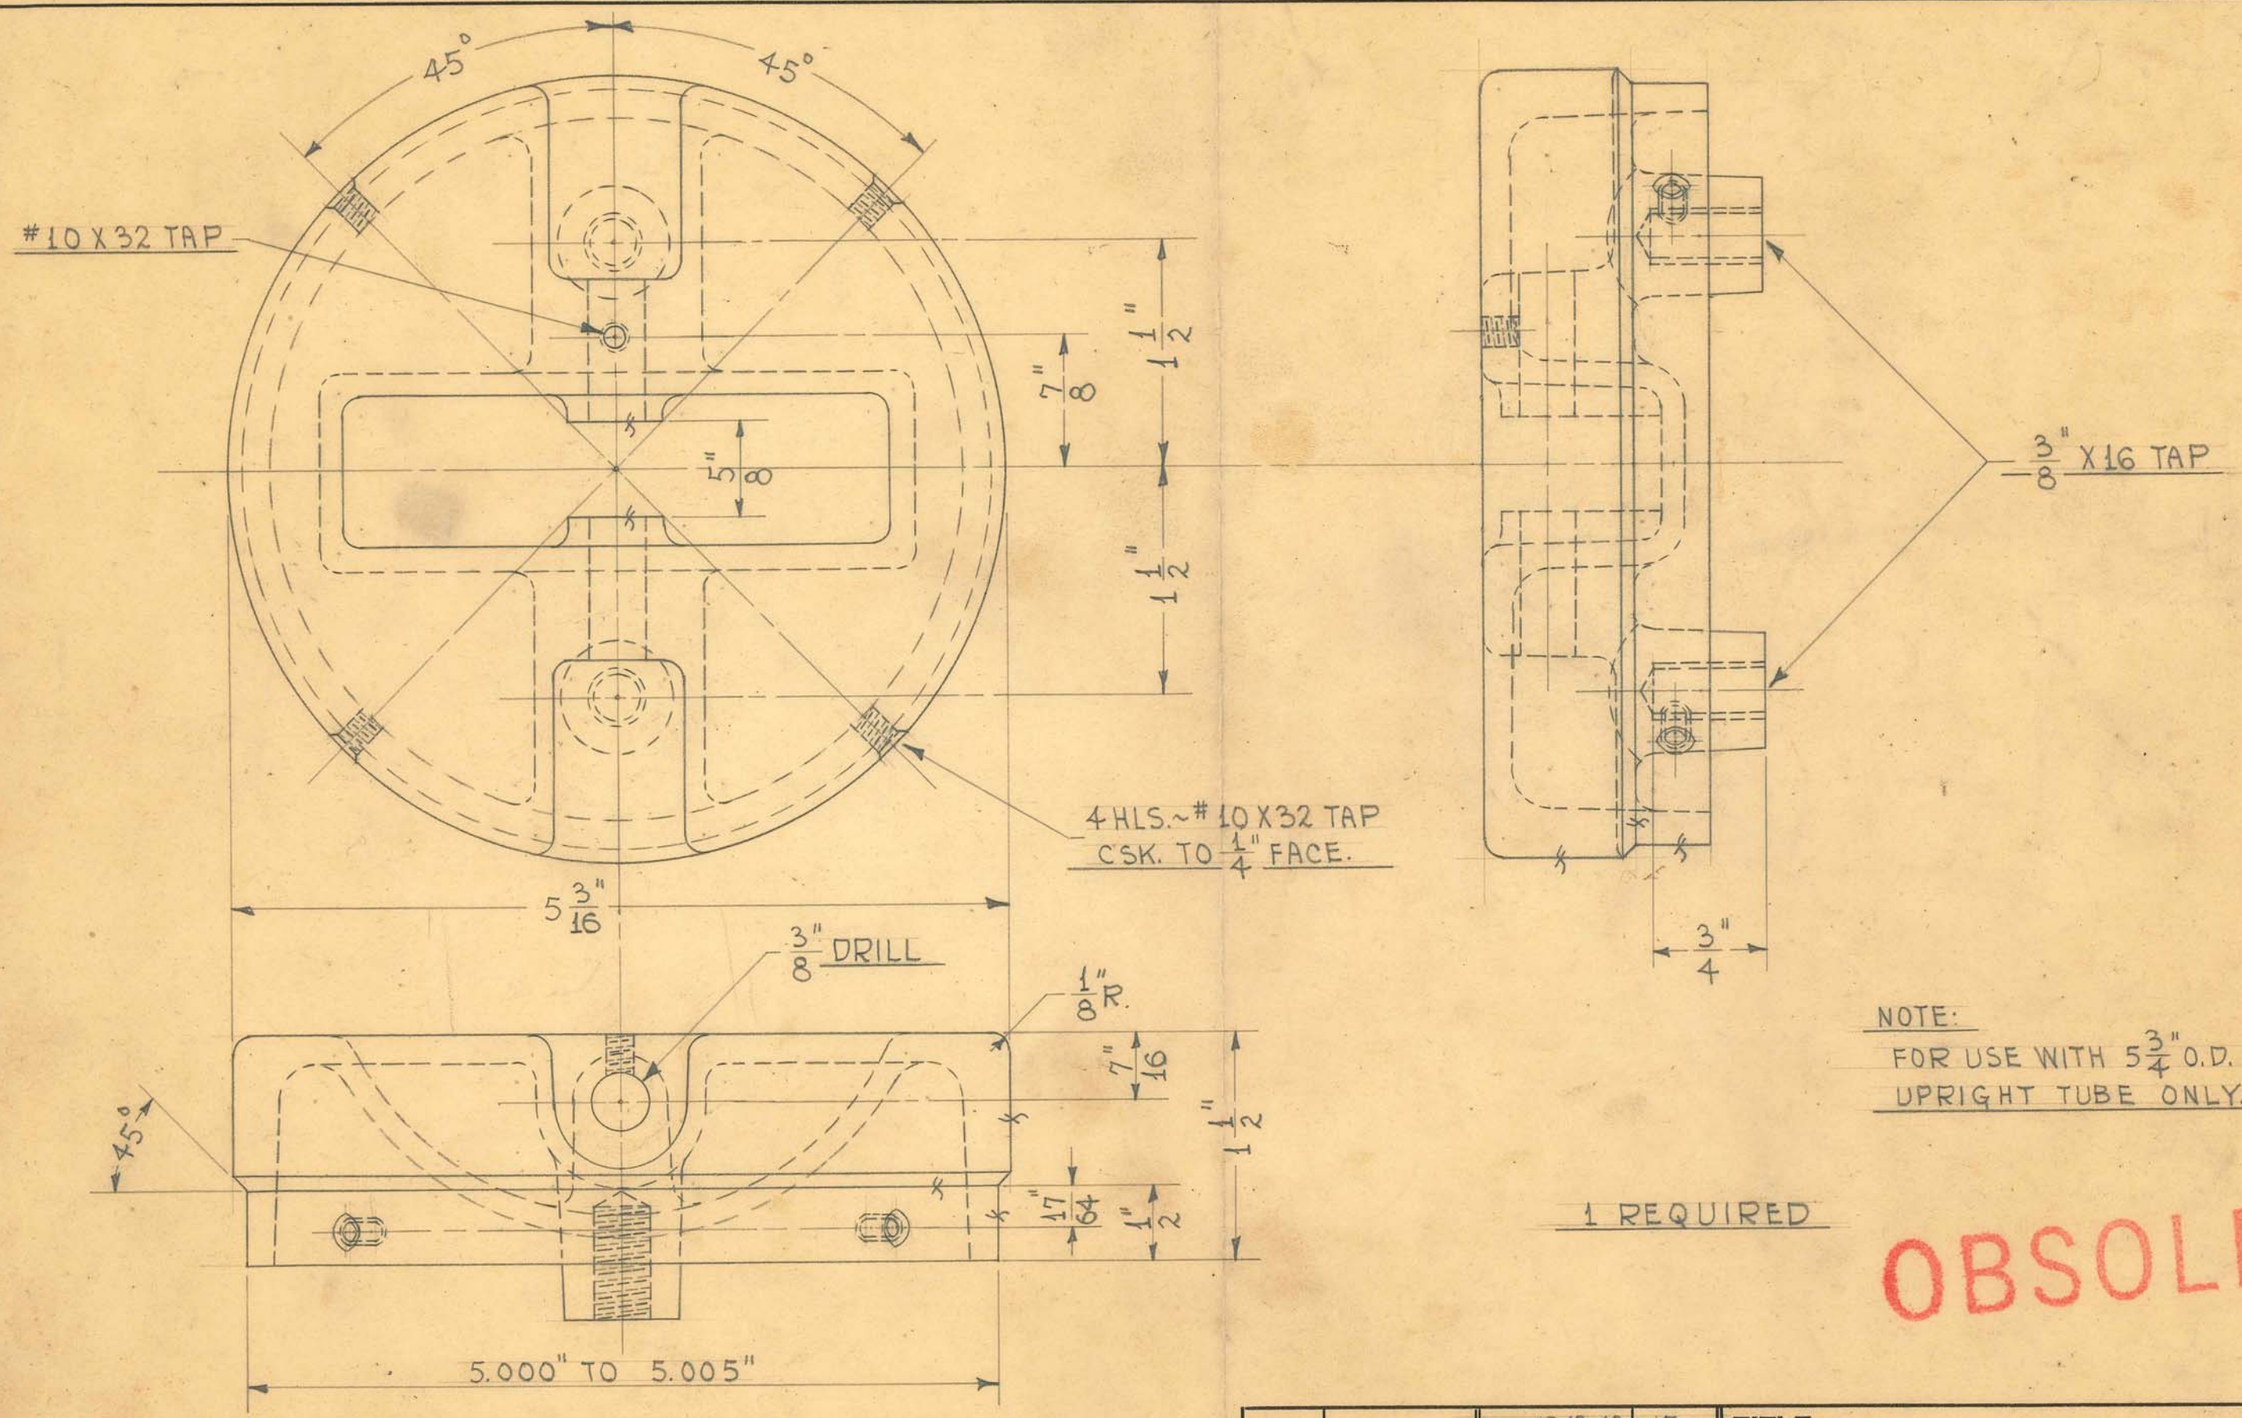

NOTE:
FOR USE WITH $5\frac{3}{4}$" O.D. X $5\frac{3}{8}$" I.D. UPRIGHT TUBE ONLY.

1 REQUIRED

OBSOLETE

SIZE		ISSUE 12-13-43	HE.
KIND	IRON CASTING	CHANGED	
SHAPE		"	
FINISH		"	
TEMP.		"	
PATT.	1806	"	

TITLE: FISCHER MOD. "TV-30-96" RAD. & FLUOR. UNIT~ COUNTERWEIGHT TOP CAP

H. G. FISCHER & CO.
2338 WABANSIA AVE.
CHICAGO, ILL.

CAT. NO.

PART NO. 14561

12 3/4"
3/8"
3 7/8"
5 3/4"
5/16"
3/4"
4 HLS. - 1/4" DRILL
8 HLS. - #4 X 36 TAP
3/4"
5/16"
2 3/8"
45°
5/8"
3/8"
9/16"
5/16"
3/4"
5/16"
45°
9/16"
5/8"
2 7/8"
3 1/8"
45°
1 5/8"
2 HLS. - 33/64" DRILL - 3/4" C'BORE. 5/32" DEEP
1 5/8"
1 3/4"
10"
4 HLS. - #9 DRILL C'SUNK. TO 25/64" FACE
6 3/4"
3 1/4"
7"
13 1/2"
3/8"

OBSOLETE

1 REQUIRED

DRILL JIG Tool #9350

SIZE	3/8" SHEET	ISSUE 6-16-47	J.V.W.
KIND	NATURAL	CHANGED	
~~SHAPE~~	BAKELITE XX	"	
FINISH		"	
TEMP.		"	
		"	

TITLE:
FISCHER "PRECISION 200" X-RAY
H.T. TRANSF. SOCKET MTG. BOARD

H. G. FISCHER & CO.
2335 WABANSIA AVE.
CHICAGO, ILL.

CAT. NO.

PART NO. 16889F

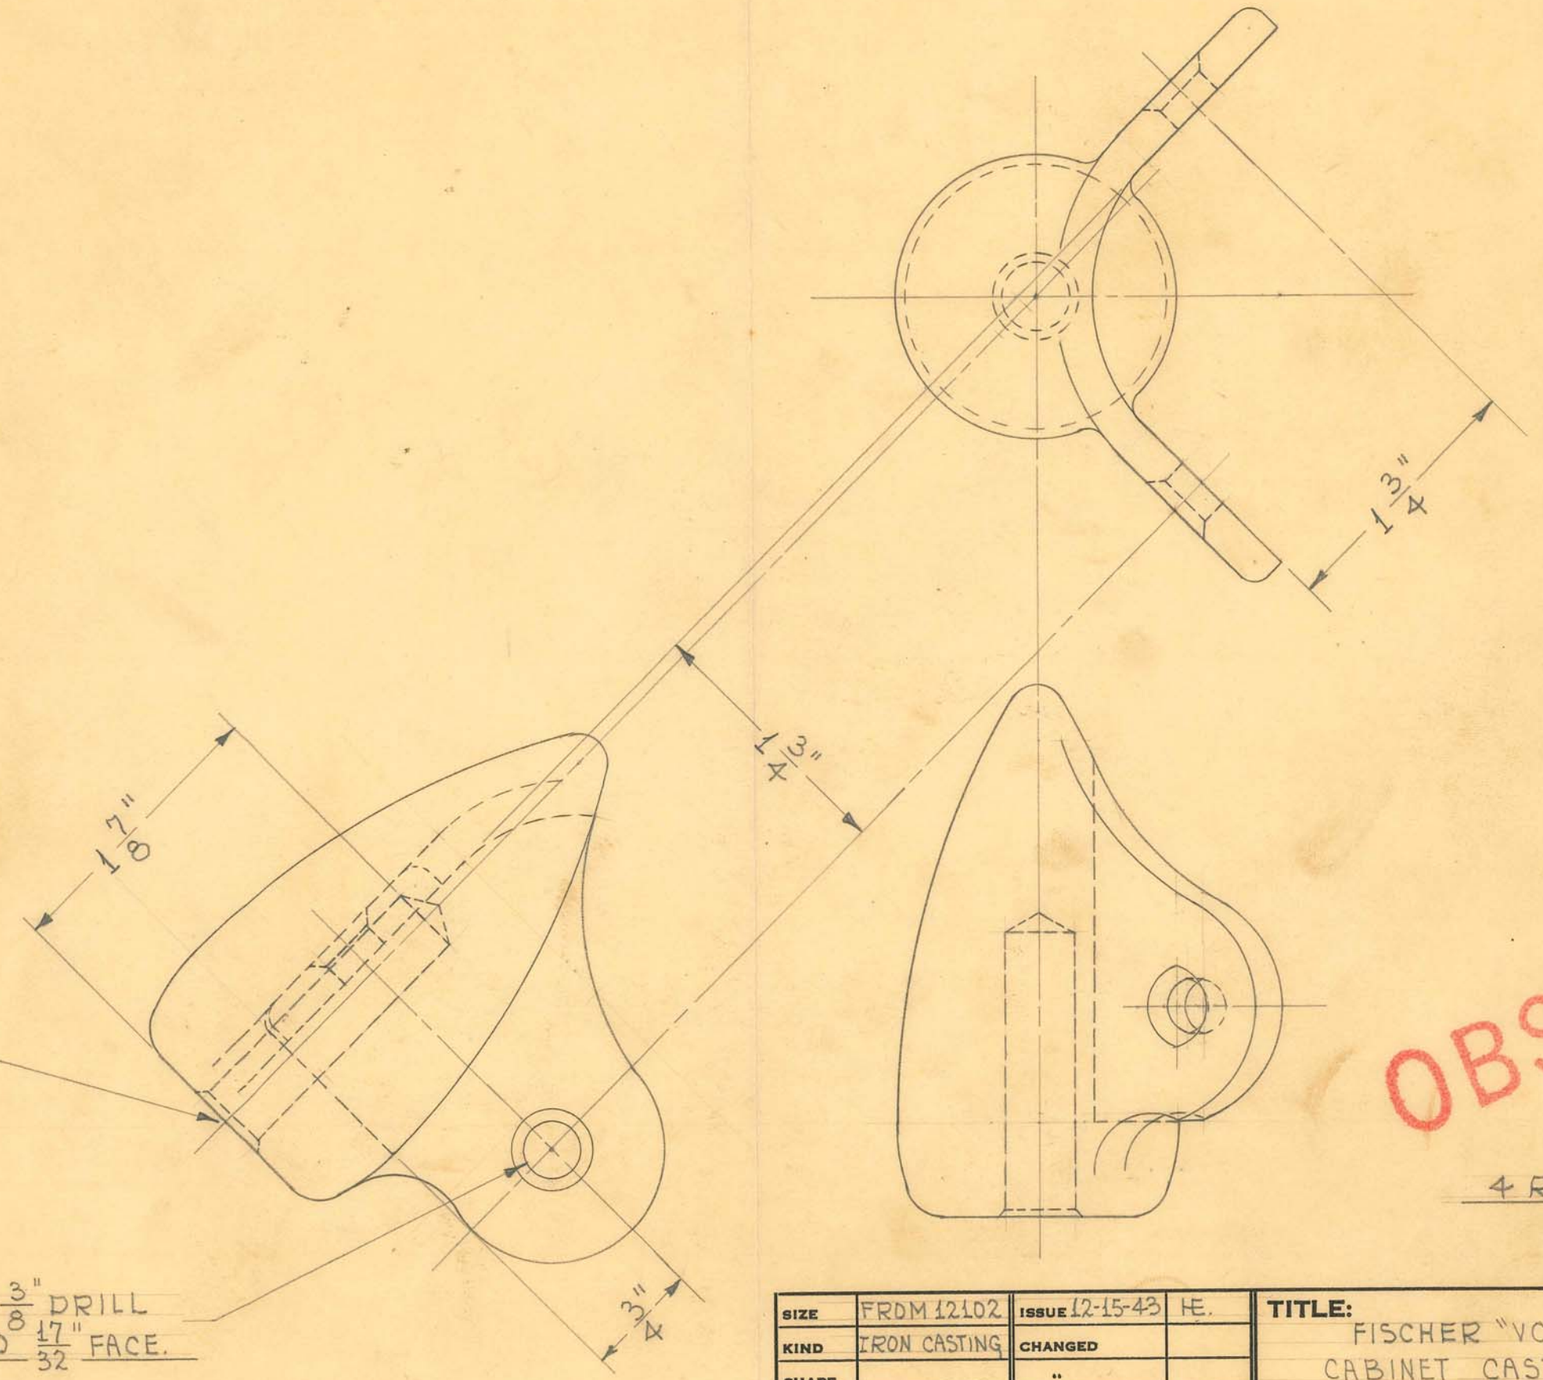

7/16" DRILL ~ 29/64" REAMED & C'SINK. TO 9/16" FACE.

2 HLS. ~ 3/8" DRILL C'SINK. TO 17/32" FACE.

4 REQUIRED

OBSOLETE

SIZE	FRDM 12102	ISSUE 12-15-43	HE.
KIND	IRON CASTING	CHANGED	
SHAPE		"	
FINISH	PAINTED	"	
TEMP.		"	
PATT.	1385	"	

TITLE: FISCHER "VC" SHORT WAVE APPARATUS ~ CABINET CASTER SUPPORT

H. G. FISCHER & CO.
2335 WABANSIA AVE.
CHICAGO, ILL.

CAT. NO.

PART NO. 15531

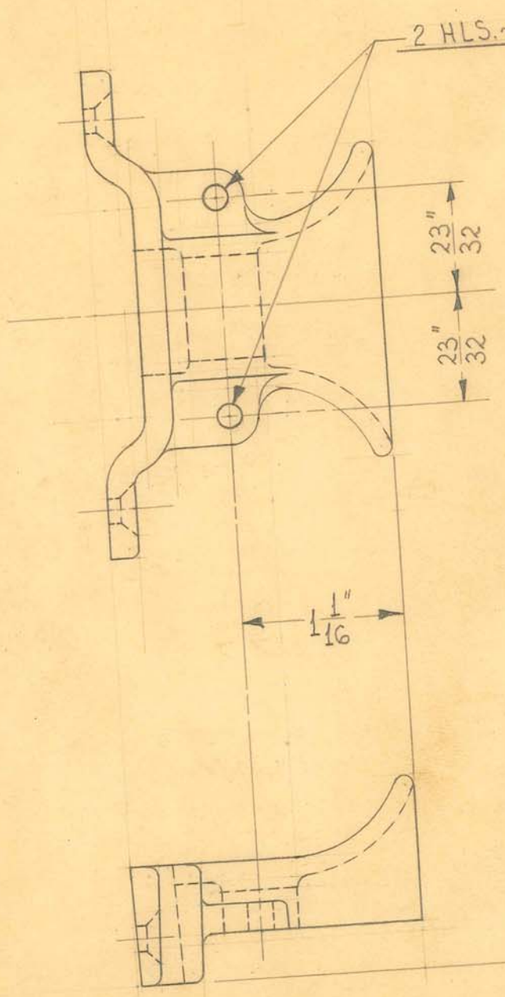

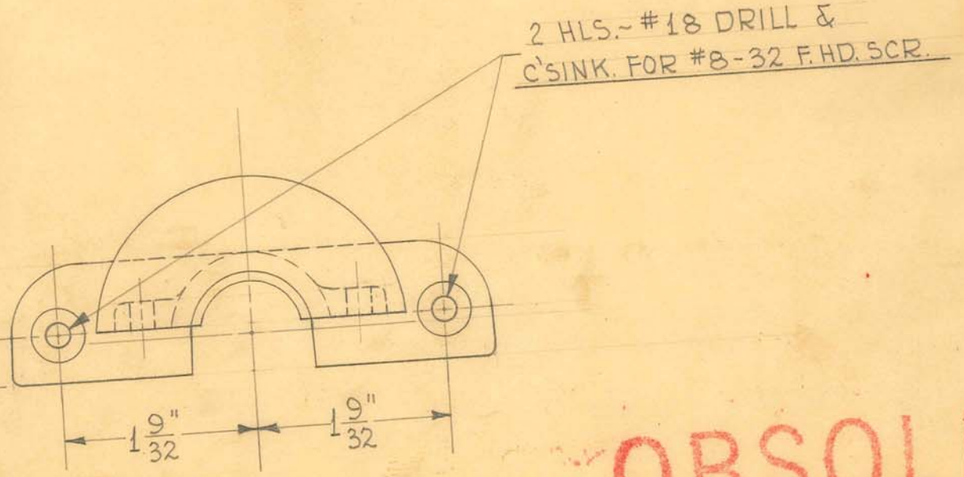

1 REQUIRED

OBSOLETE

SIZE	#12	ISSUE 10-27-44	H.	TITLE: FISCHER MOD. "GA-15"~ TRANSFORMER CABLE SUPPORT
KIND	ALUM. CASTING	CHANGED		
SHAPE		"		
FINISH	PAINTED	"		
TEMP.		"		
PATT.	2013	"		

H. G. FISCHER & CO.
2335 WABANSIA AVE.
CHICAGO, ILL.

CAT. NO.

PART NO. 15628F

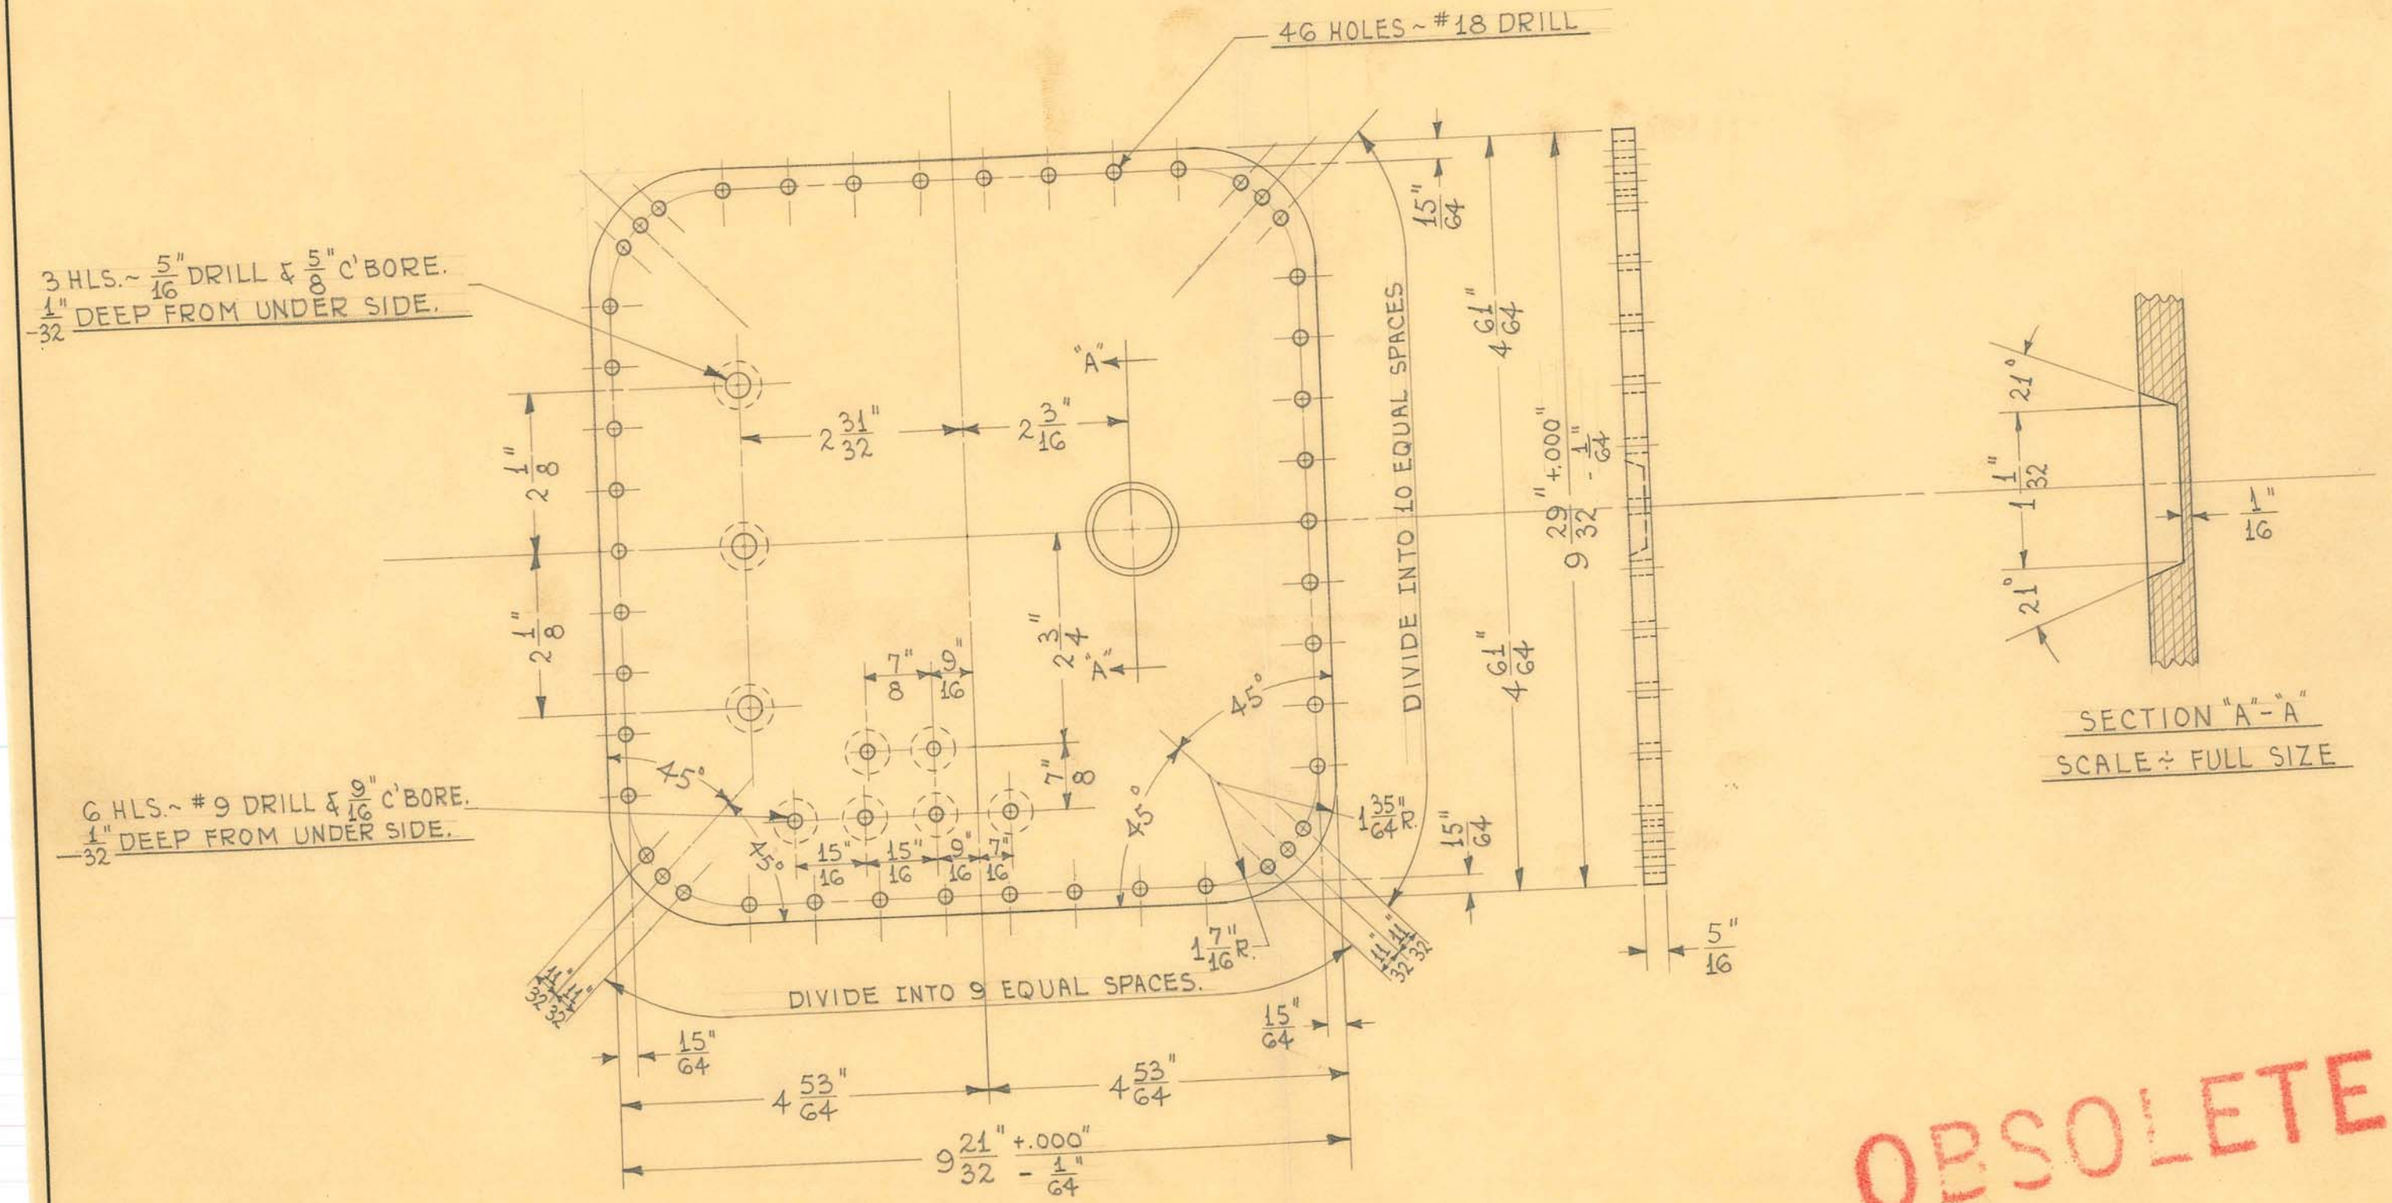

SCALE ÷ HALF SIZE

1 REQUIRED

SECTION "A"-"A"

SCALE ÷ FULL SIZE

OBSOLETE

SIZE	9 21/32" X 9 29/32" X 5/16"	ISSUE 2-16-45	HE.	TITLE: FISCHER MOD. "GA-15" TRANSFORMER TANK PANEL
KIND	NATURAL	CHANGED		
GRADE	BAKELITE	"		
FINISH		"		
TEMP.		"		
		"		

H. G. FISCHER & CO. 2335 WABANSIA AVE. CHICAGO. ILL. | CAT. NO. | PART NO. 15629F

OBSOLETE

TITLE FISCHER "RF-100" H.T. TRANSF. FILAMENT TRANSF. SUPPORT

H. G. FISCHER & CO.
FRANKLIN PARK, ILLINOIS

DATE 12-15-50 DR. BY J.V.W. CH'K'D.

PART NO. 15637

REVISION	DATE	BY

PATTERN | FINISH | SCALE FULL

TOOLS | MATERIAL $\frac{3}{32}$" X 1" SHEARED C.R. STEEL

DIMENSIONS UNLESS OTHERWISE SPECIFIED
FRACTIONAL ± .015
DECIMAL ± .005
ANGULAR ± ½°

OBSOLETE

2 REQUIRED

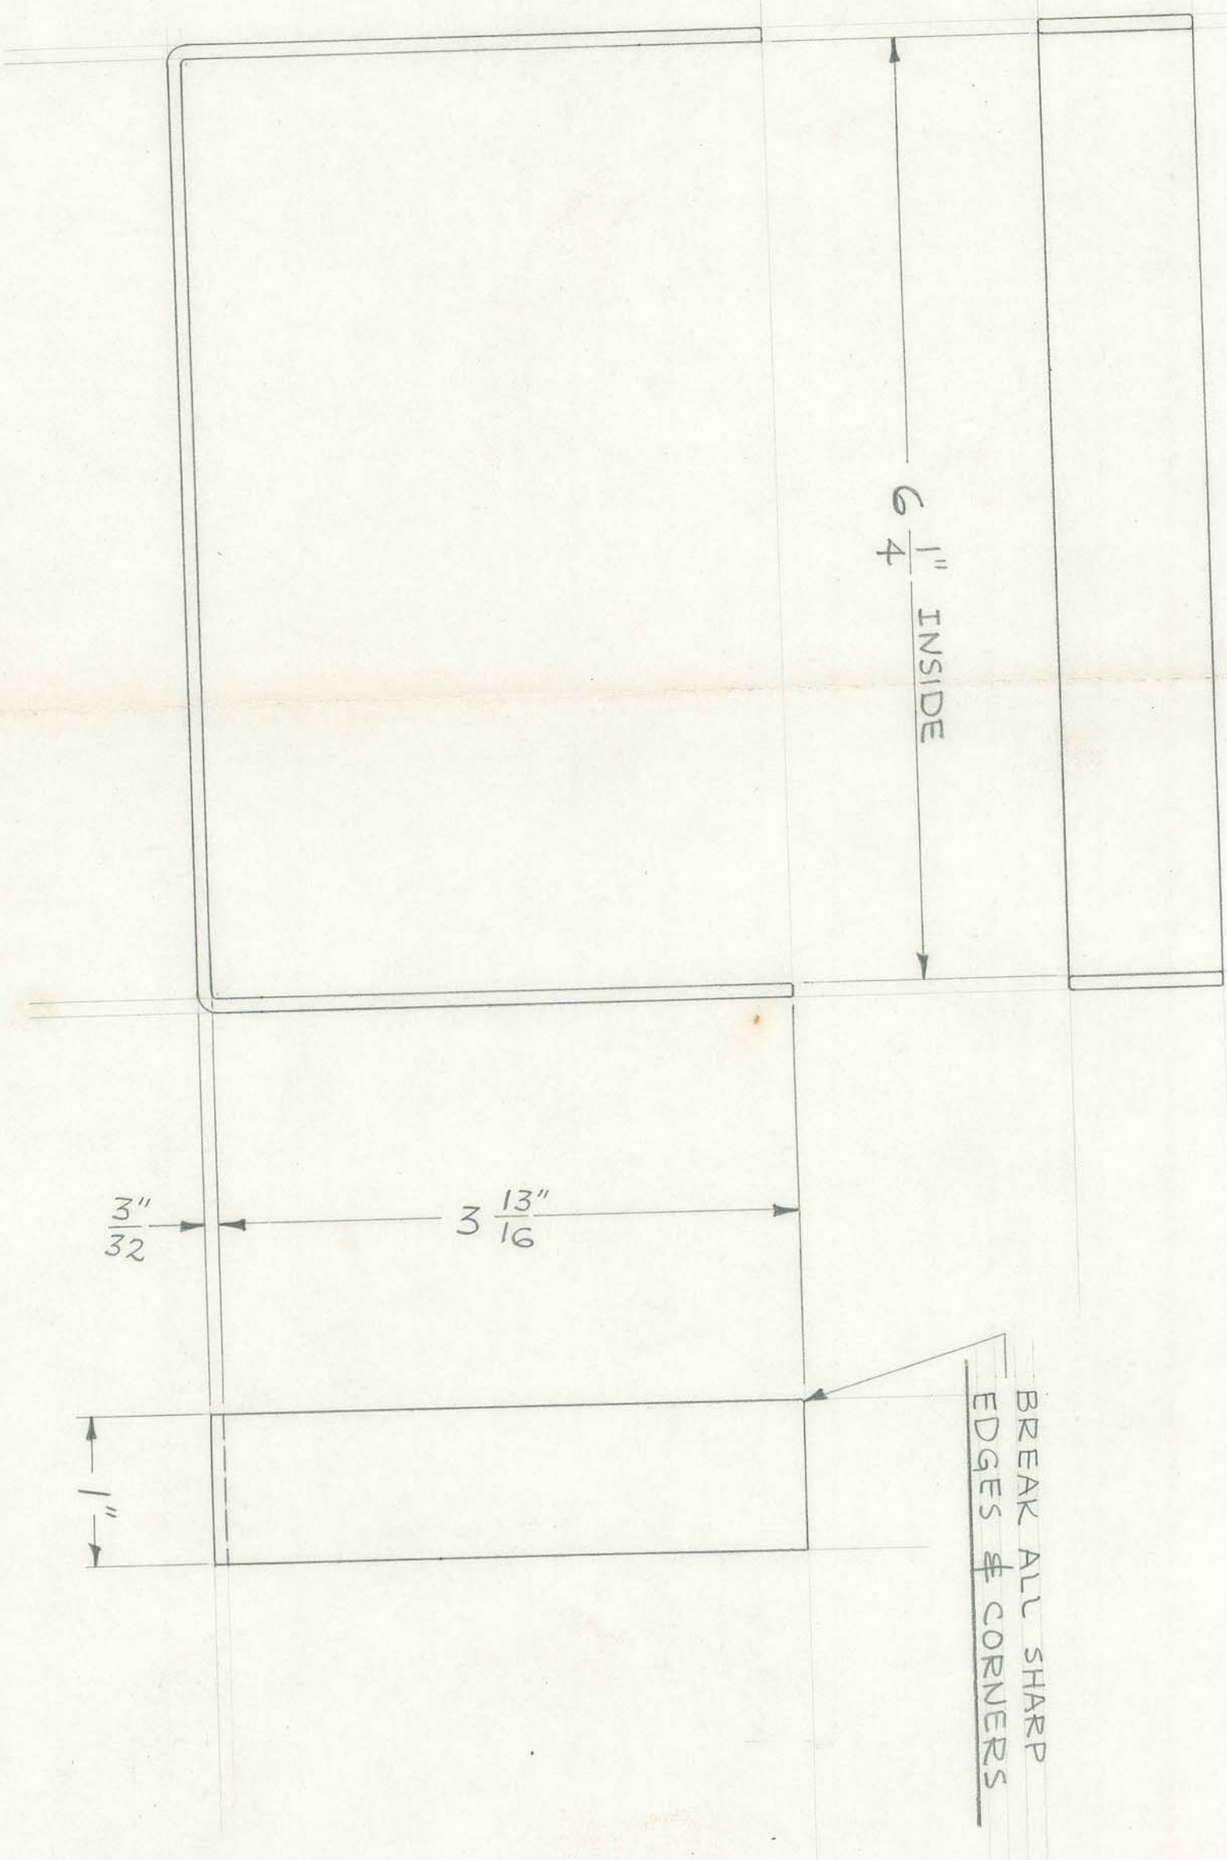

TITLE: FISCHER "RF-100" H.T. TRANSF. FILAMENT TRANSF. SUPPORT

H. G. FISCHER & CO.
FRANKLIN PARK, ILLINOIS

PART NO. 15637F

DATE 12-15-50 | DR. BY J.V.W. | CH'K'D.

REVISION | DATE | BY

PATTERN | FINISH | SCALE FULL

TOOLS: DRILL JIG. # 11499

MATERIAL: FROM PCE. # 15637

DIMENSIONS
FRACTIONAL ± .015
DECIMAL ± .005
ANGULAR ± ½°
UNLESS OTHERWISE SPECIFIED

OBSOLETE

2 REQUIRED

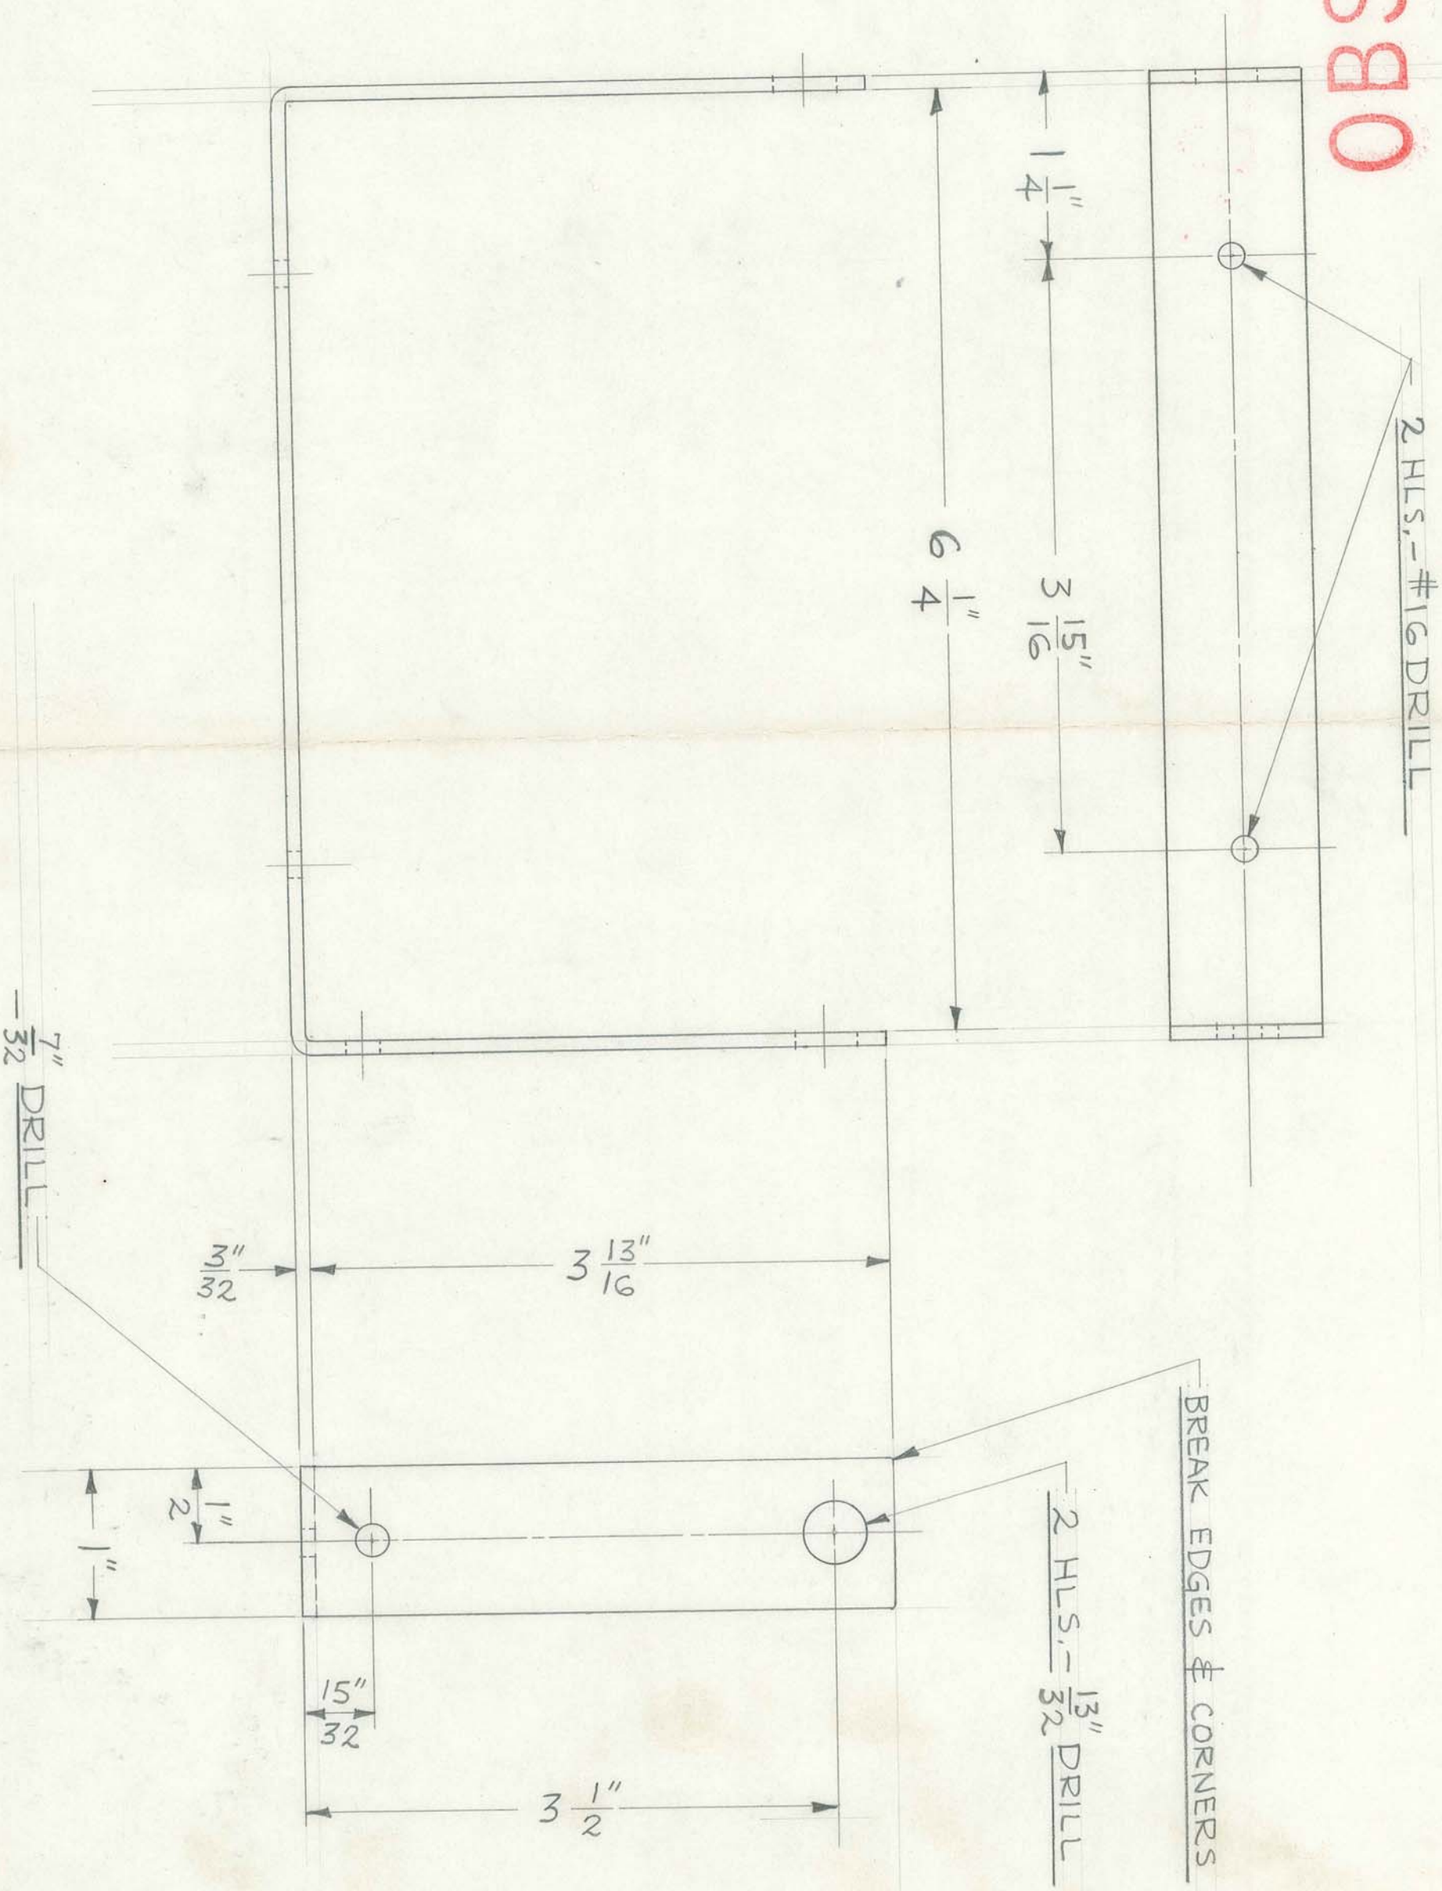

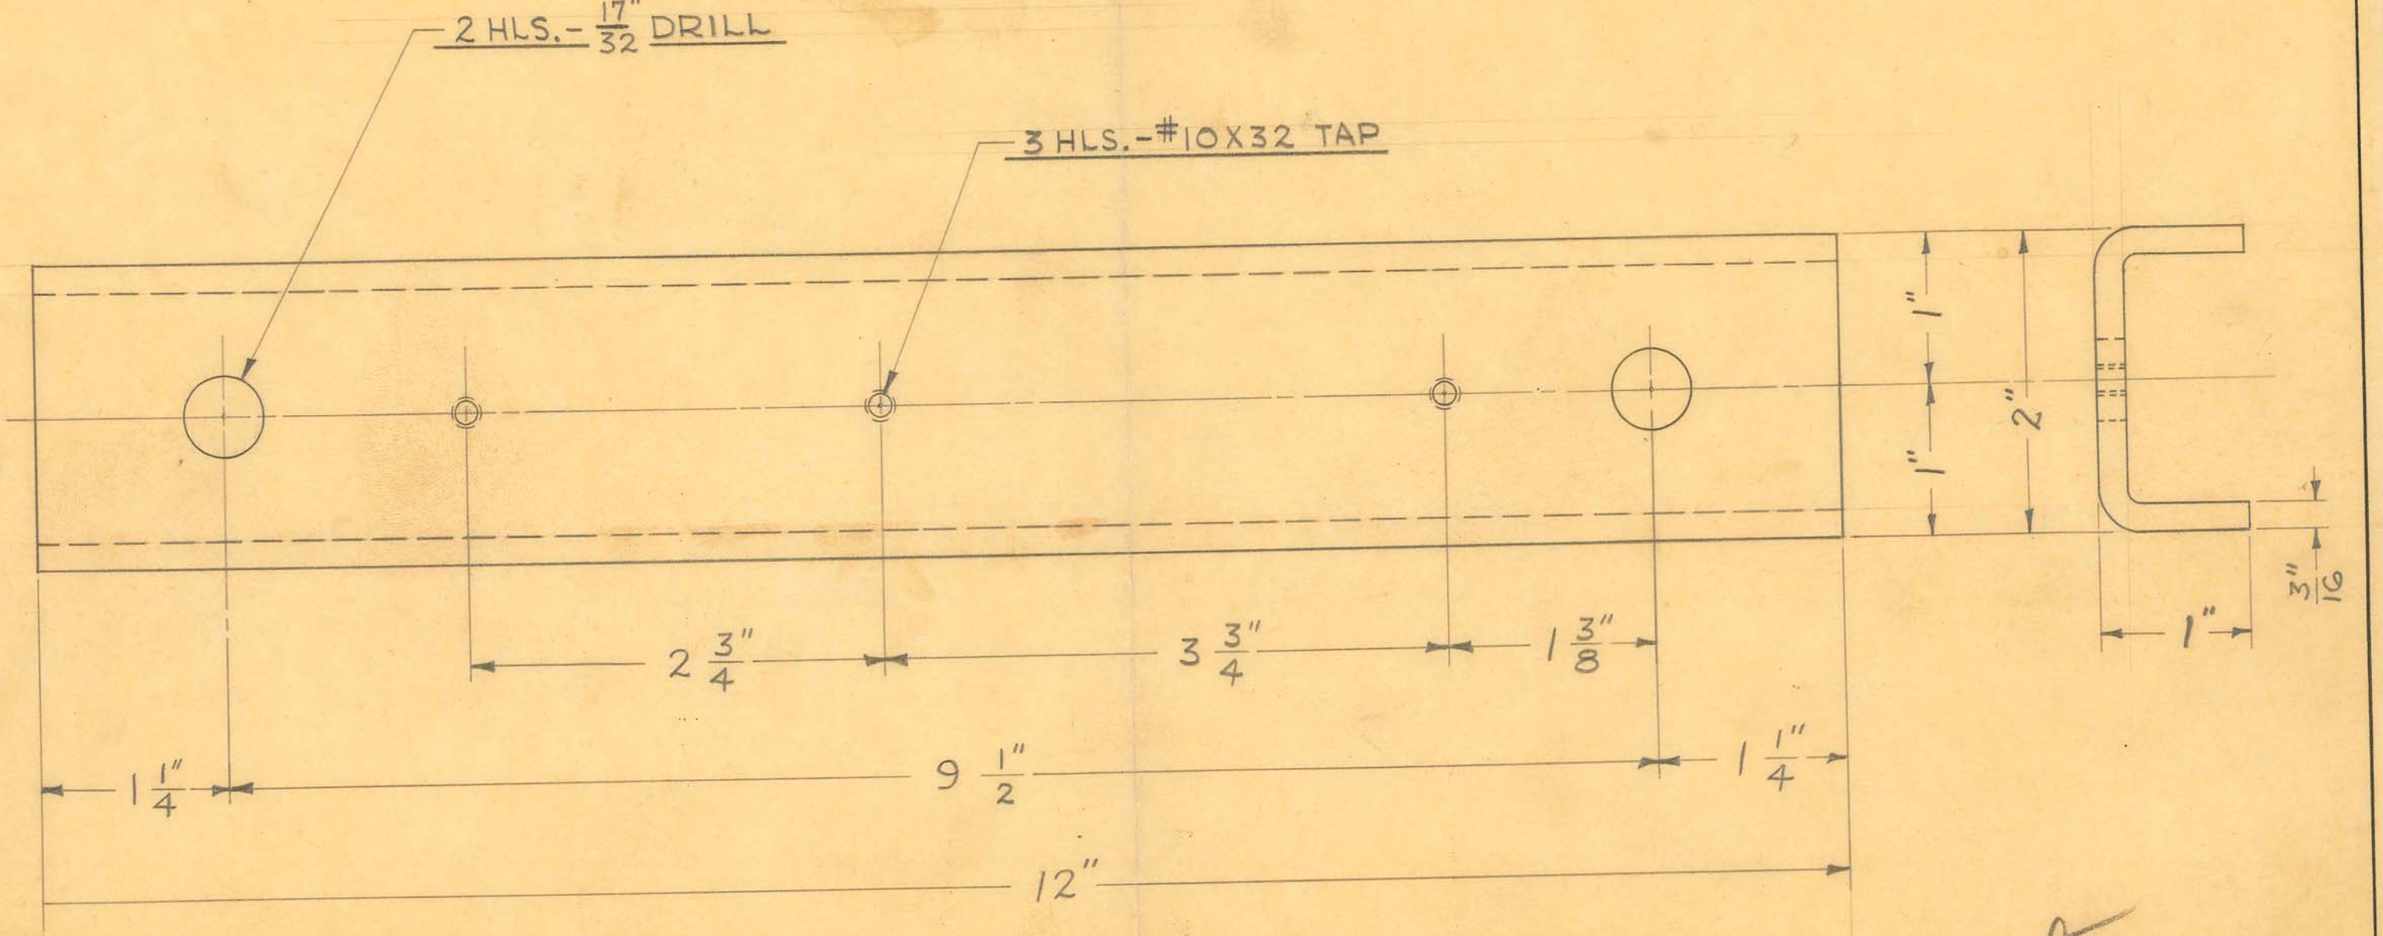

4 REQUIRED

Obsolete 6-30-55

OBSOLETE

SIZE	3/16" SHEET	ISSUE 6-7-46	J.V.W.
KIND	C.R. STEEL	CHANGED	
SHAPE		"	
FINISH		"	
TEMP.		"	
PATT.		"	

TITLE:
FISCHER MOD. "RF-100" X-RAY UNIT
FROM 3 PHASE TO SINGLE PHASE TRANSF.
SUPPORT- TOP

H. G. FISCHER & CO.
2335 WABANSIA AVE.
CHICAGO, ILL.

CAT. NO.

PART NO. 15652

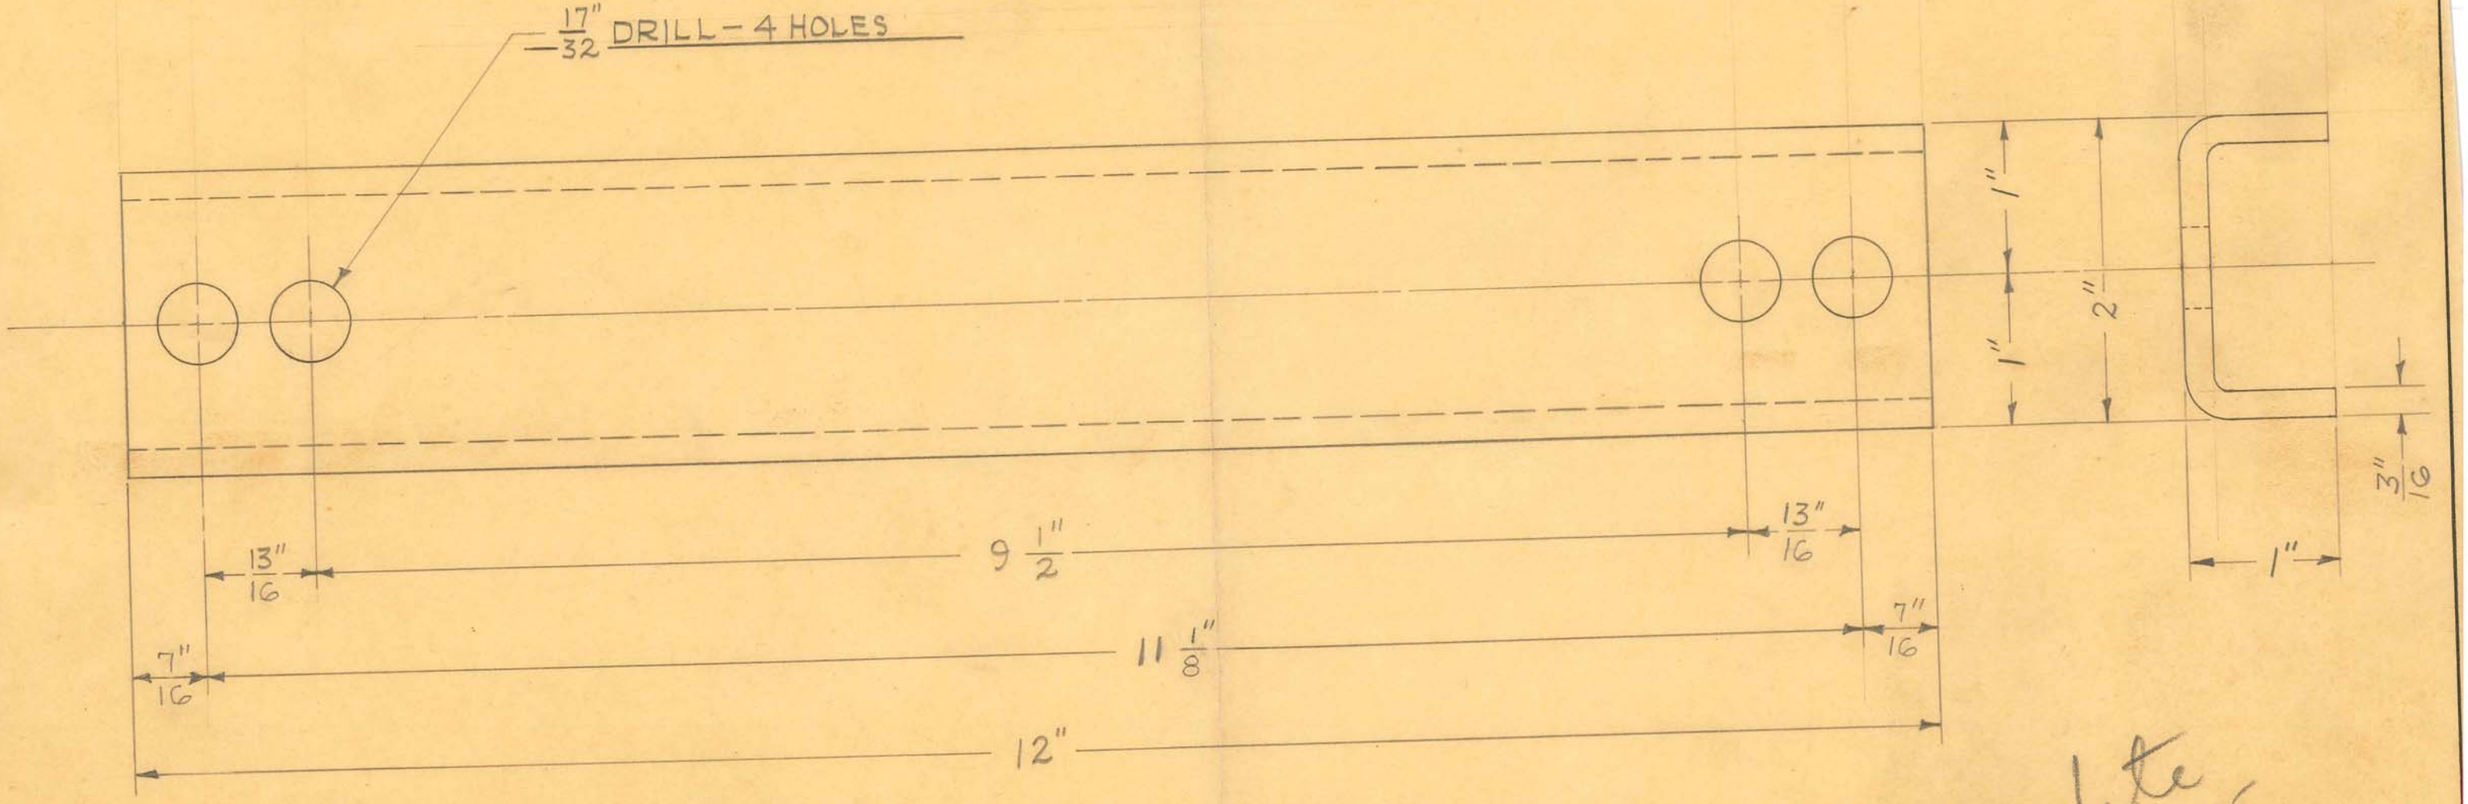

4 REQUIRED

obsolete
6-30-55
JW.

OBSOLETE see drawing #15656A

SIZE	3/16" SHEET	ISSUE 6-25-46	J.V.W.	TITLE: FISCHER MOD. "RF-100" X-RAY UNIT FROM 3 PHASE TO SINGLE PHASE TRANSF. SUPPORT-BOTTOM
KIND	C.R. STEEL	CHANGED		
SHAPE		"		
FINISH		"		
TEMP.		"		

H. G. FISCHER & CO.
2335 WABANSIA AVE.
CHICAGO, ILL.

CAT. NO.

PART NO. 15653

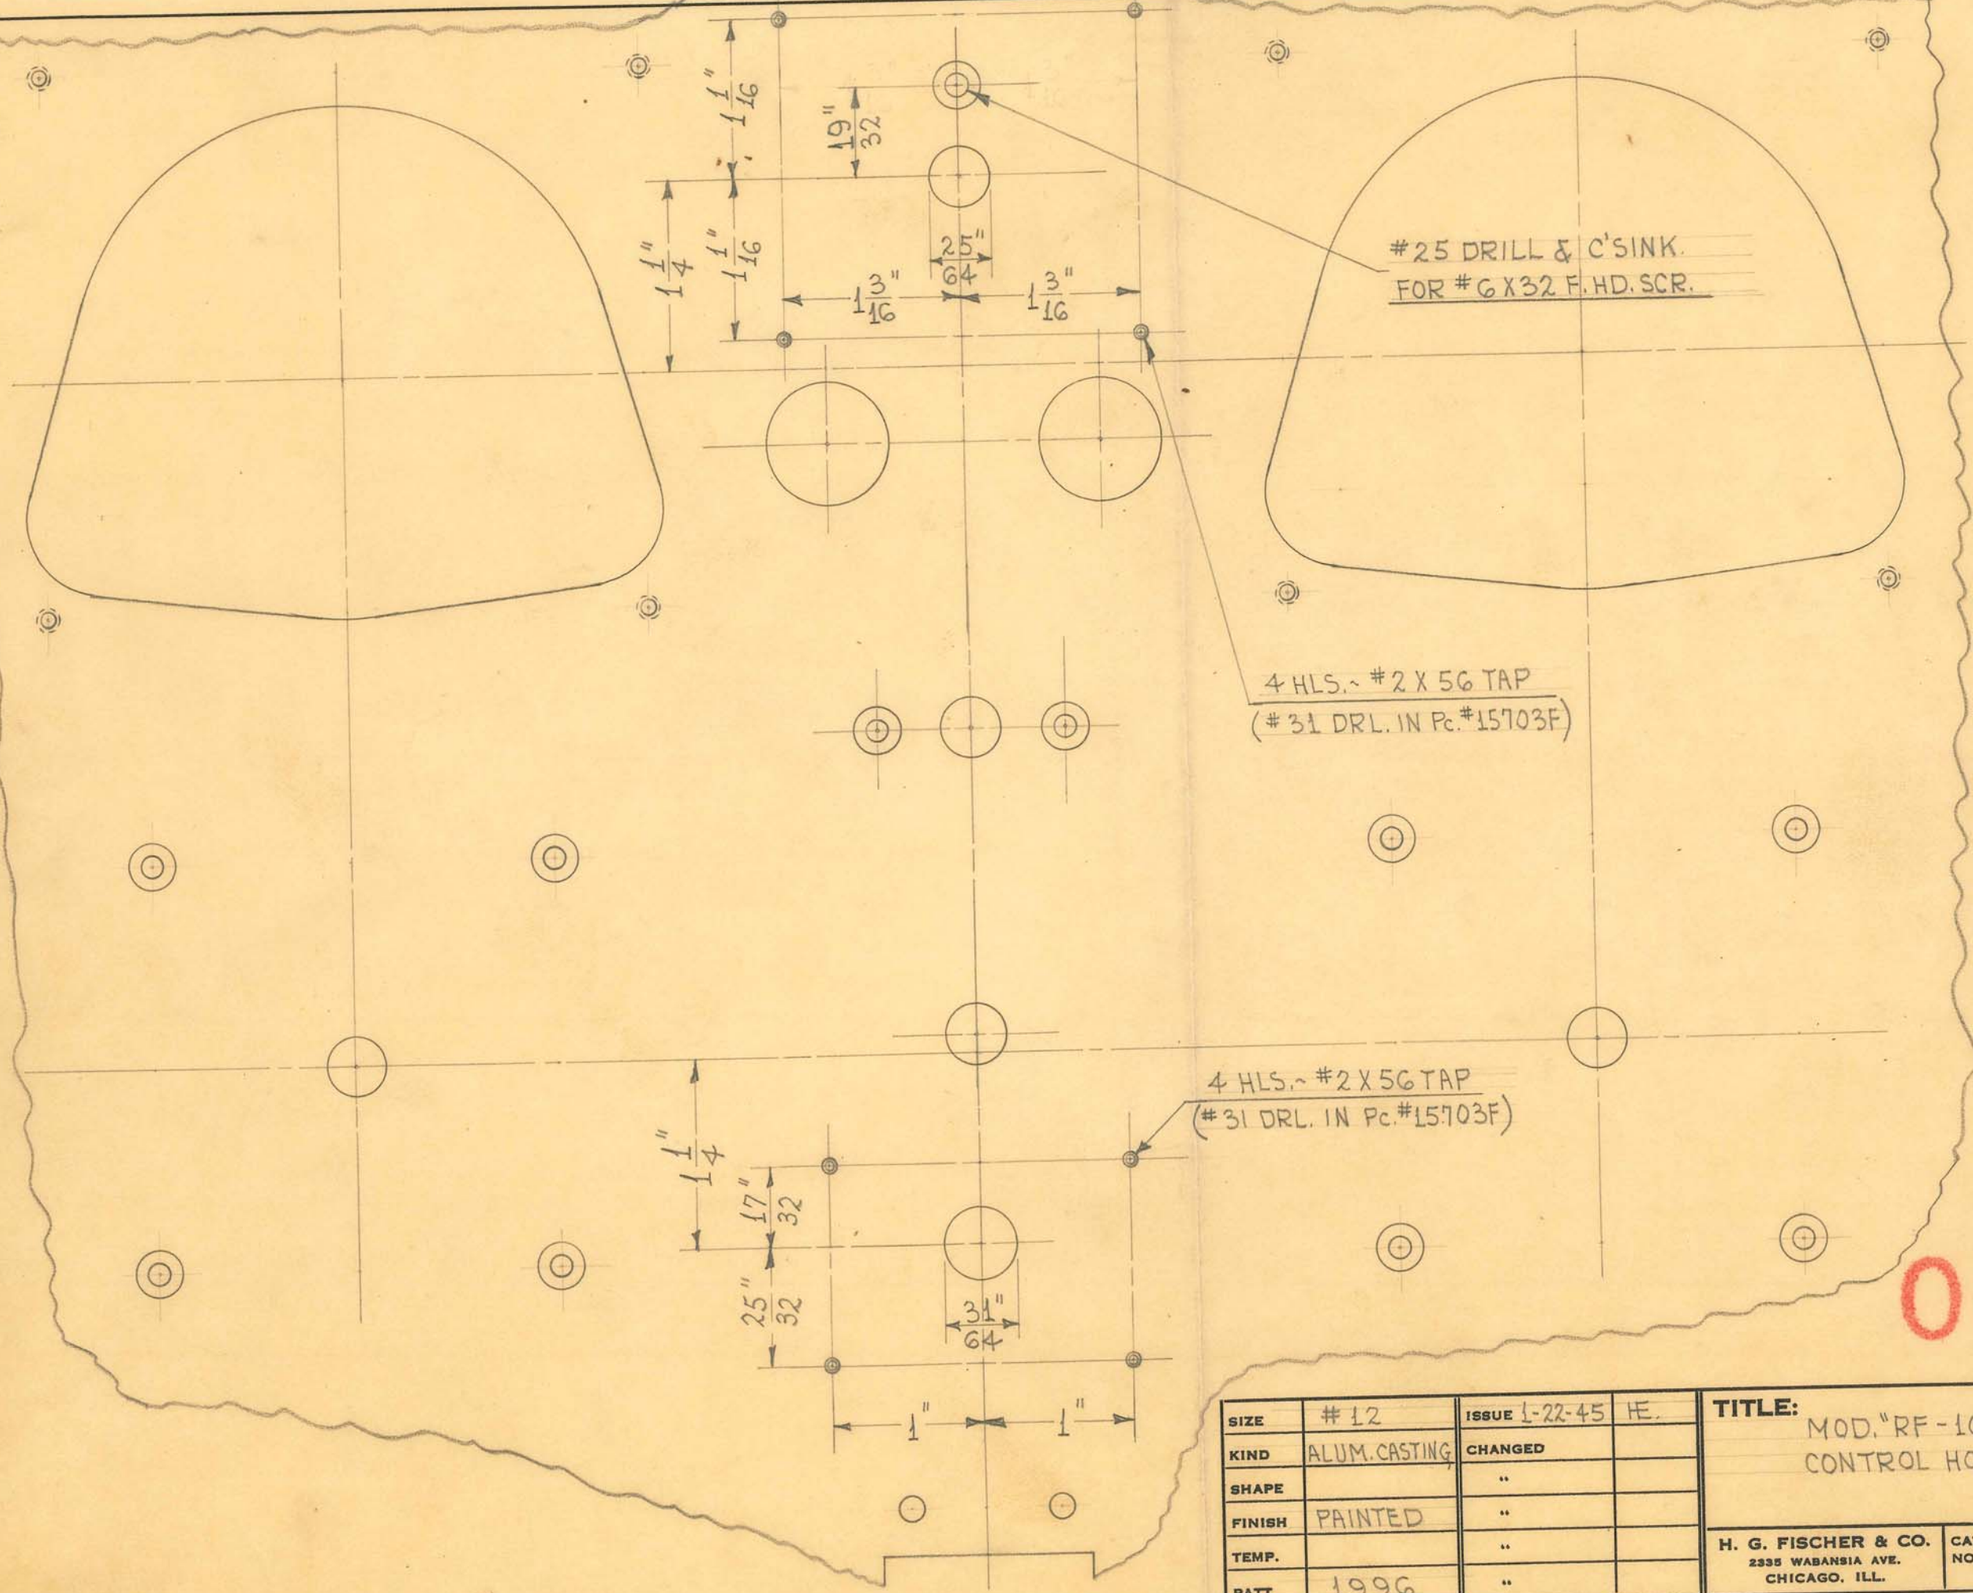

NOTE:-
ALL HOLES, EXCEPT TEN HLS. SHOWN WITH DIMENSIONS, ARE THE SAME AS SHOWN ON DRAWING #15706F.

OBSOLETE

SIZE	#12	ISSUE 1-22-45	HE.
KIND	ALUM. CASTING	CHANGED	
SHAPE		"	
FINISH	PAINTED	"	
TEMP.		"	
PATT.	1996	"	

TITLE: MOD. "RF-100" X-RAY UNIT-
CONTROL HOUSING - UPPER

H. G. FISCHER & CO.
2335 WABANSIA AVE.
CHICAGO, ILL.

CAT. NO.

PART NO. 15706FA

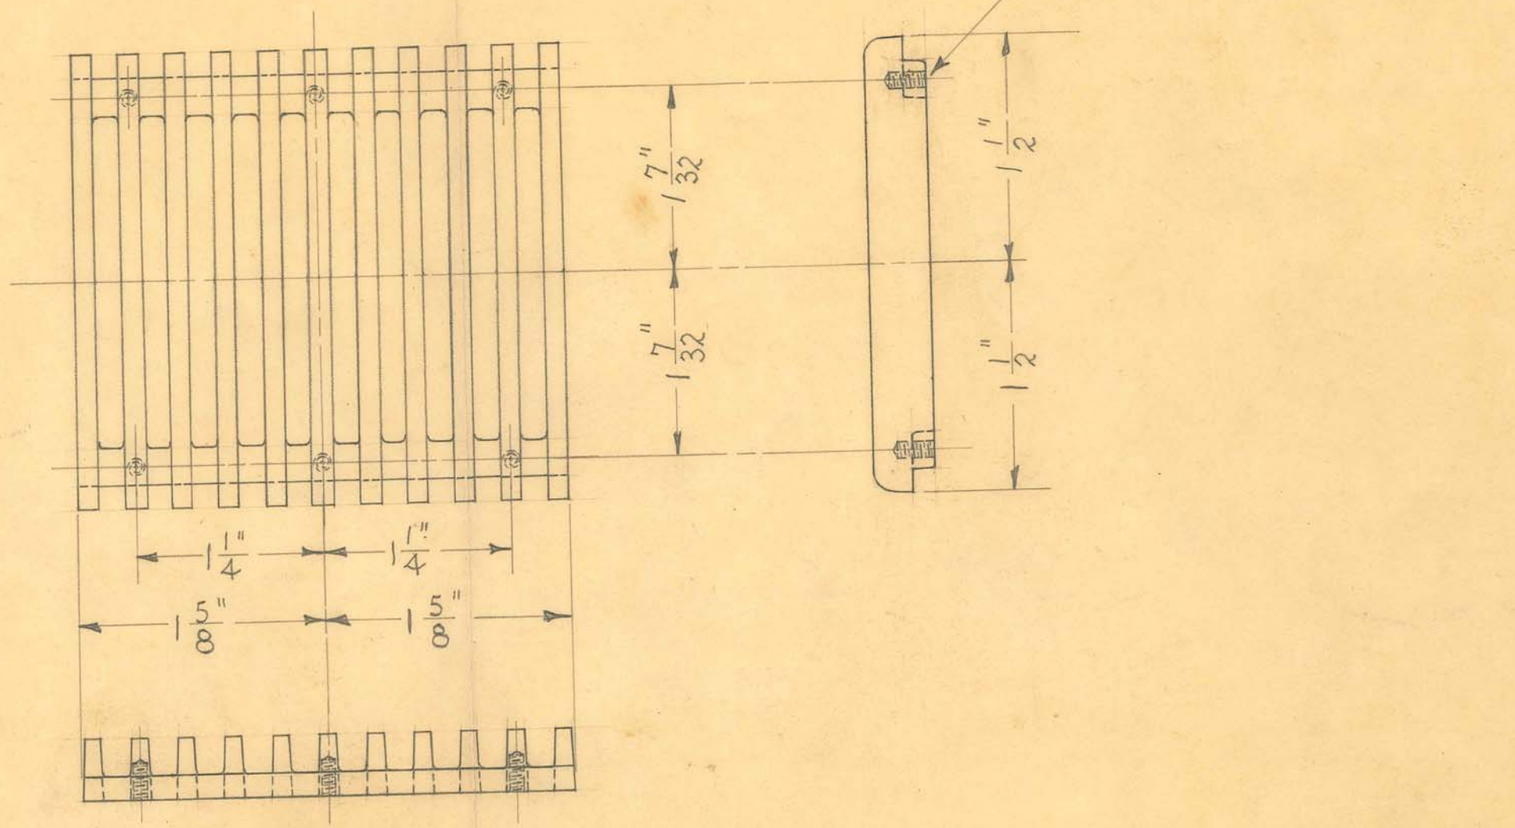

4 REQUIRED

OBSOLETE
Obsolete

SIZE		ISSUE 5-8-44	HE.
KIND	ALUM. CASTING	CHANGED	
SHAPE		"	
FINISH	PAINTED	"	
TEMP.		"	
PATT.	1999	"	

TITLE: MOD. "RF-100" X-RAY UNIT~
CONTROL HOUSING VENTILATOR GRILL

H. G. FISCHER & CO.
2335 WABANSIA AVE.
CHICAGO. ILL.

CAT. NO.

PART NO. 15709F

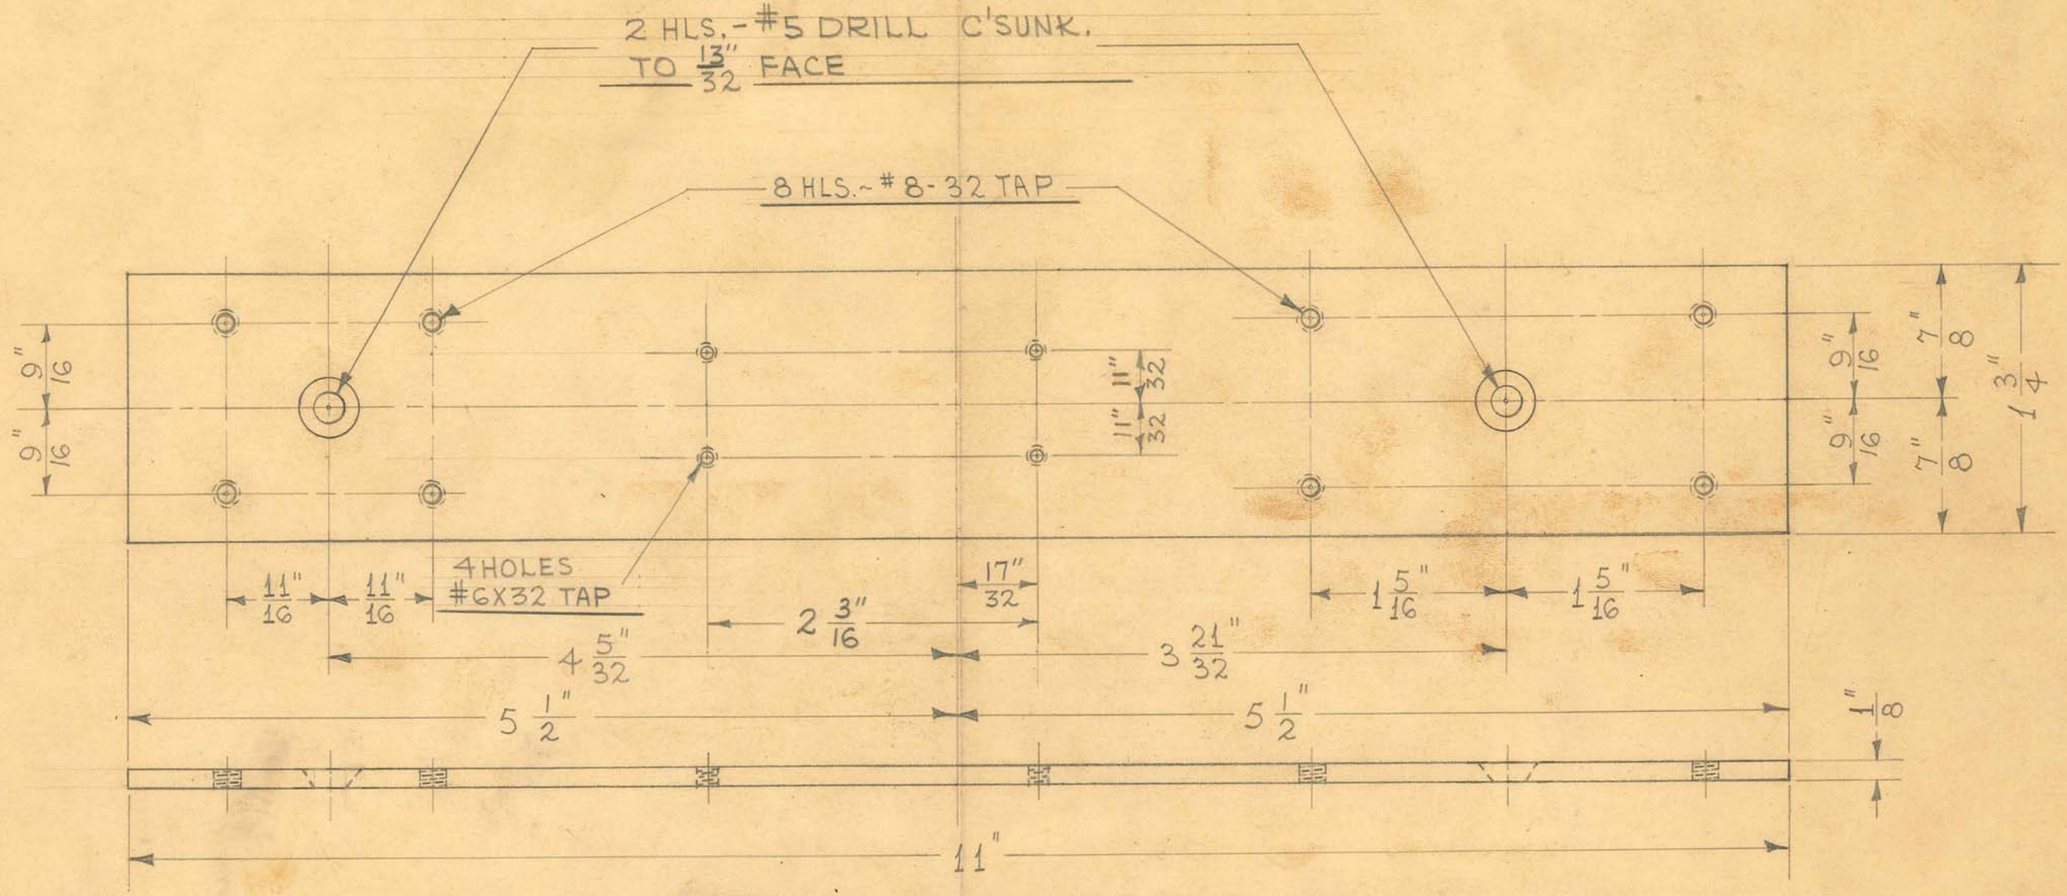

1 REQUIRED

obsolete 6-30-50

OBSOLETE

SIZE	1/8" X 1 3/4"	ISSUE 5-25-44	H.
KIND	C.R. STEEL	CHANGED ~~8-1844~~	J.V.W.
SHAPE	STRIP	"	
FINISH	BLACK #80	"	
TEMP.		"	
PATT.		"	

TITLE: MOD. "RF-100" X-RAY UNIT~ CONTROL BOX ~ CONTACTOR MTG. STRIP

H. G. FISCHER & CO.
2335 WABANSIA AVE.
CHICAGO, ILL.

CAT. NO.

PART NO. 15715

USE ROSIN CORE SOLDER.
DOSSOLVE POWDERED ROSIN IN
GRAIN ALCOHOL FOR FLUX.

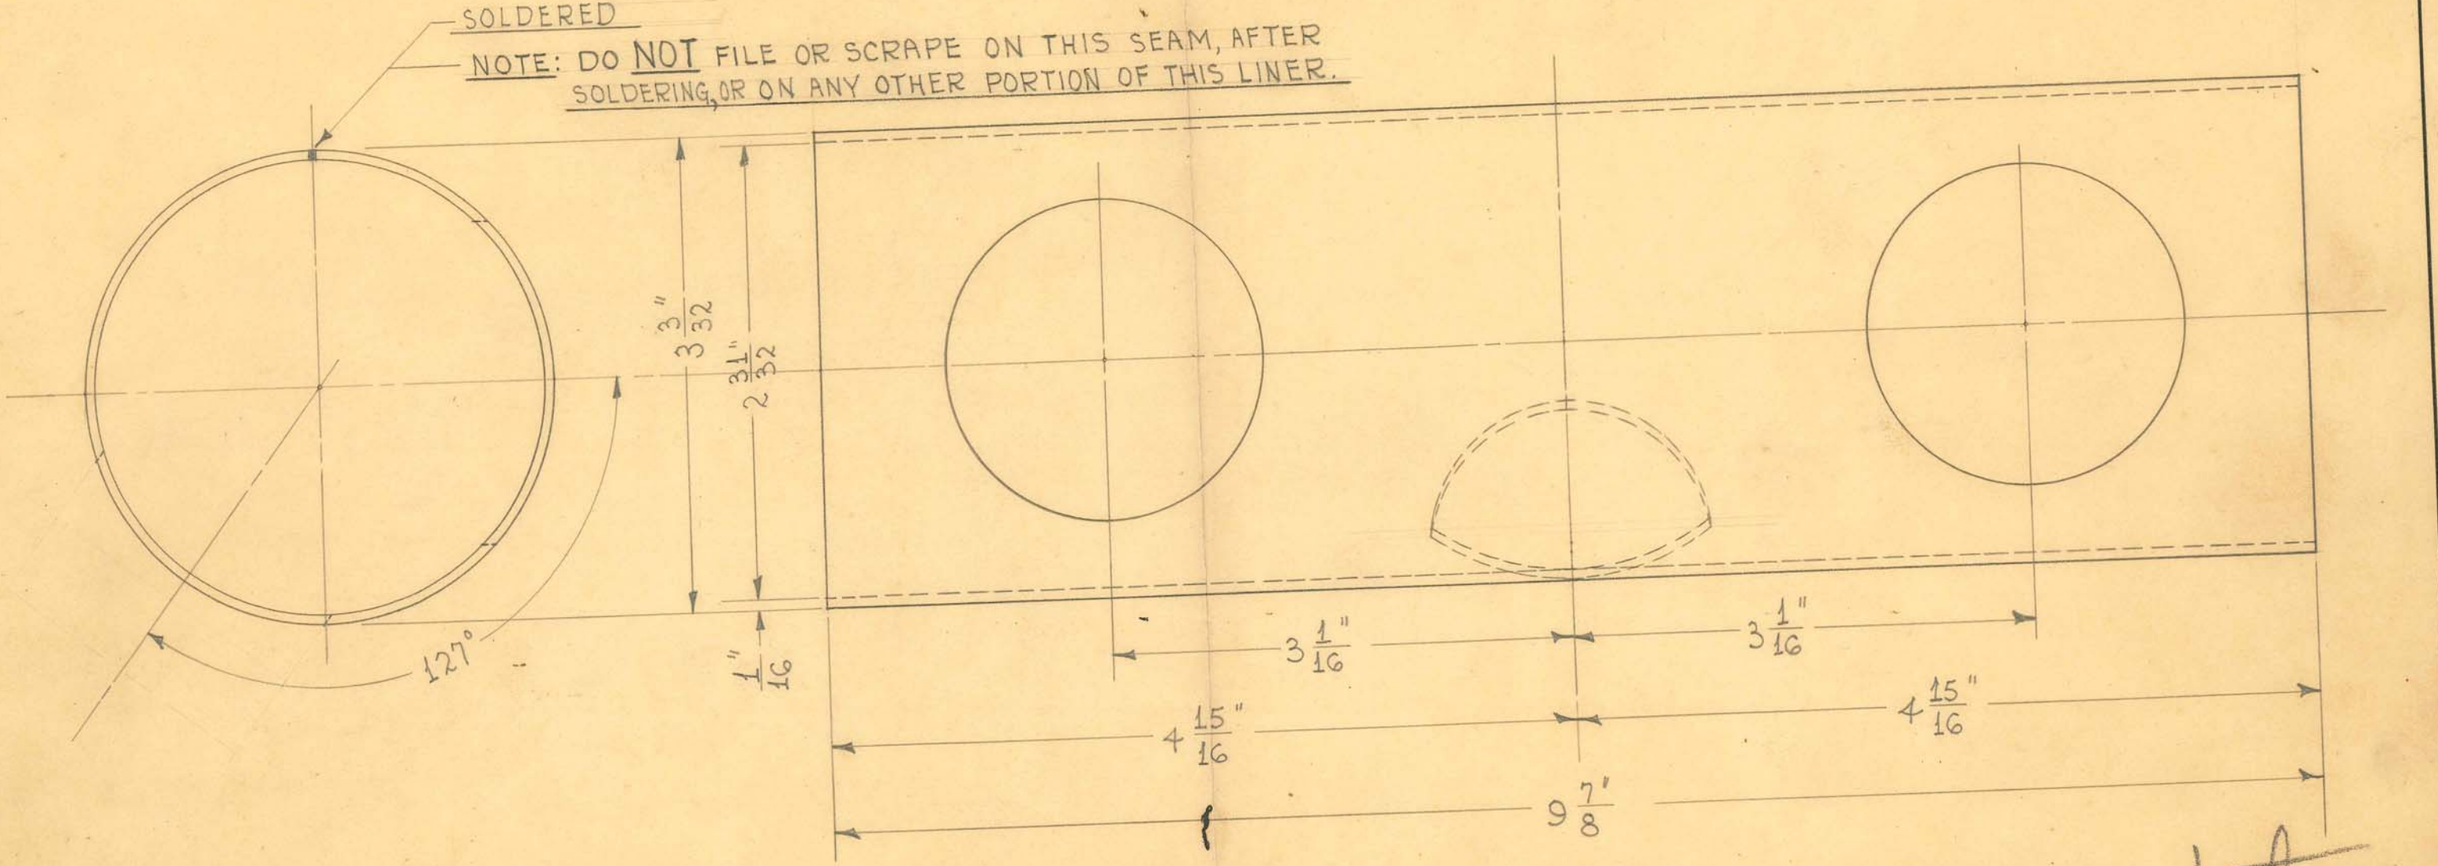

1 REQUIRED

OBSOLETE
10-16-51

SIZE	FROM 15732	ISSUE 11-1-44	HE.
KIND		CHANGED	
SHAPE		"	
FINISH		"	
TEMP.		"	

TITLE: FISCHER MOD. "RF-100" X-RAY UNIT - TUBE HOUSING - MAIN LEAD LINER

H. G. FISCHER & CO.
2235 WABANSIA AVE.
CHICAGO, ILL.

CAT. NO.

PART NO. 15732F

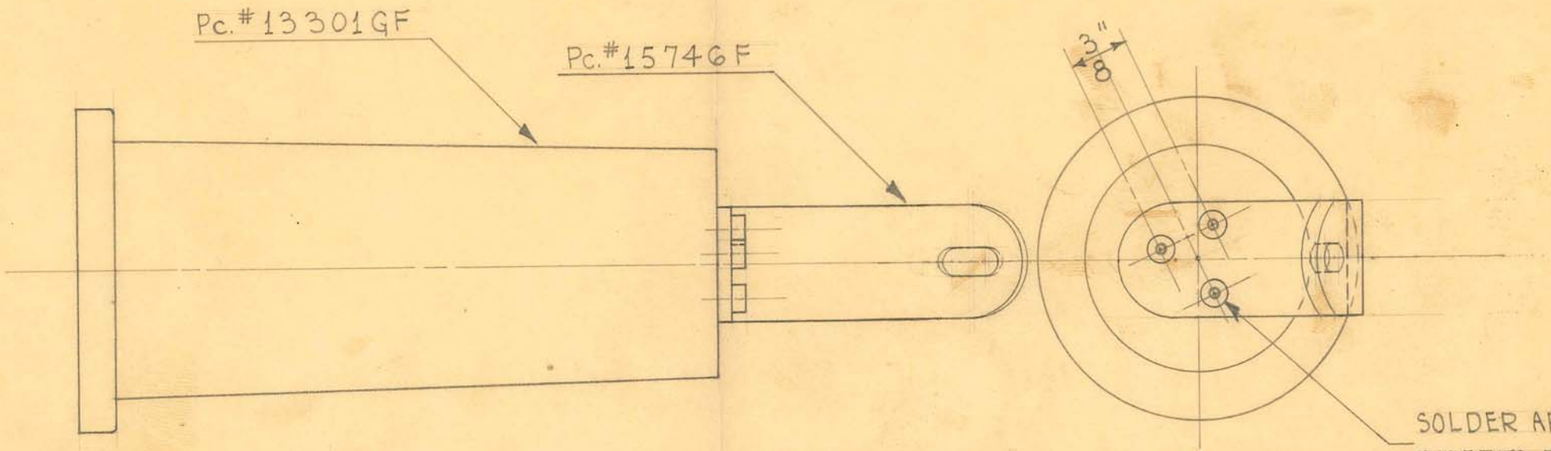

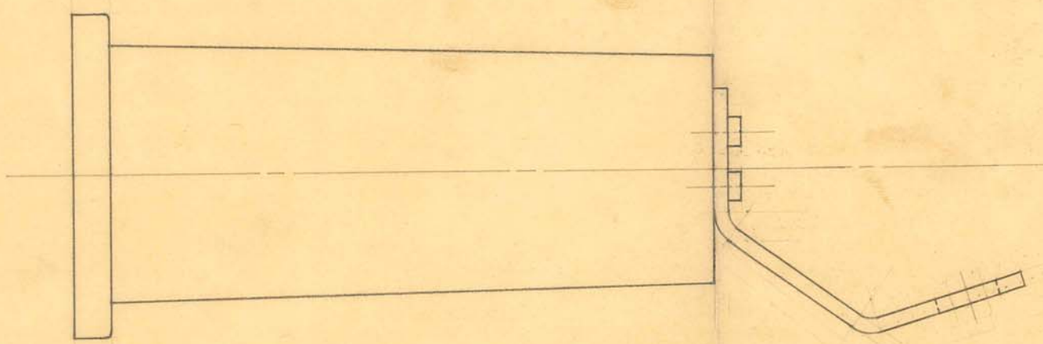

1 REQUIRED

OBSOLETE
Obsoleted

SIZE		ISSUE 11-24-44	HE.
KIND		CHANGED	
SHAPE		"	
FINISH		"	
TEMP.		"	

TITLE: FISCHER MOD. "RF-100" X-RAY UNIT-
H.T. POST SOCKET - ANODE END

H. G. FISCHER & CO. | CAT. NO. | PART NO. 15747G

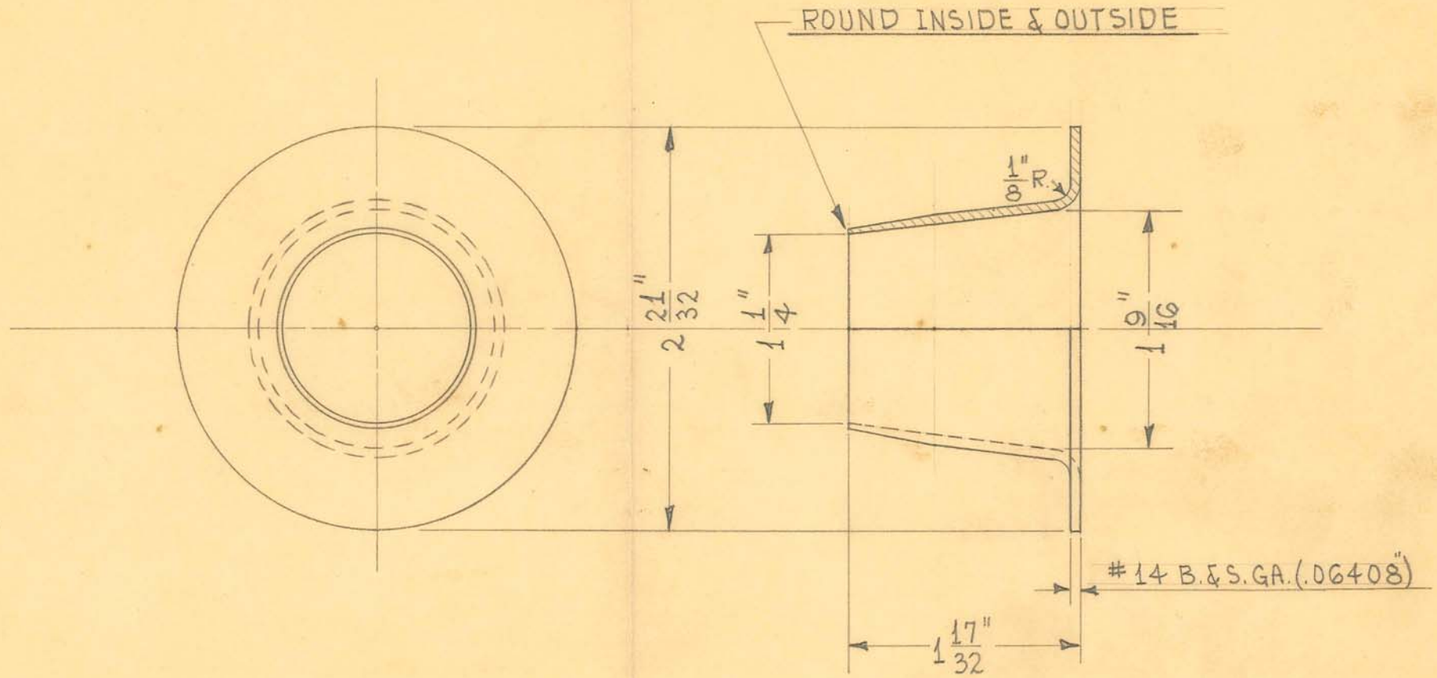

4 REQUIRED

MATERIAL

#14 B.&S. GA.(.06408") DEAD SOFT SHEET BRASS

OBSOLETE

SIZE		ISSUE 2-7-45	HE.
KIND		CHANGED	
SHAPE		"	
FINISH	ACID DIP #7	"	
TEMP.		"	
PATT.		"	

TITLE: FISCHER MOD. "RF-100" X-RAY UNIT-
H.T. POST CABLE FLEXIBLE SLEEVE CONE

H. G. FISCHER & CO.
2335 WABANSIA AVE.
CHICAGO, ILL.

CAT. NO.

PART NO. 15789

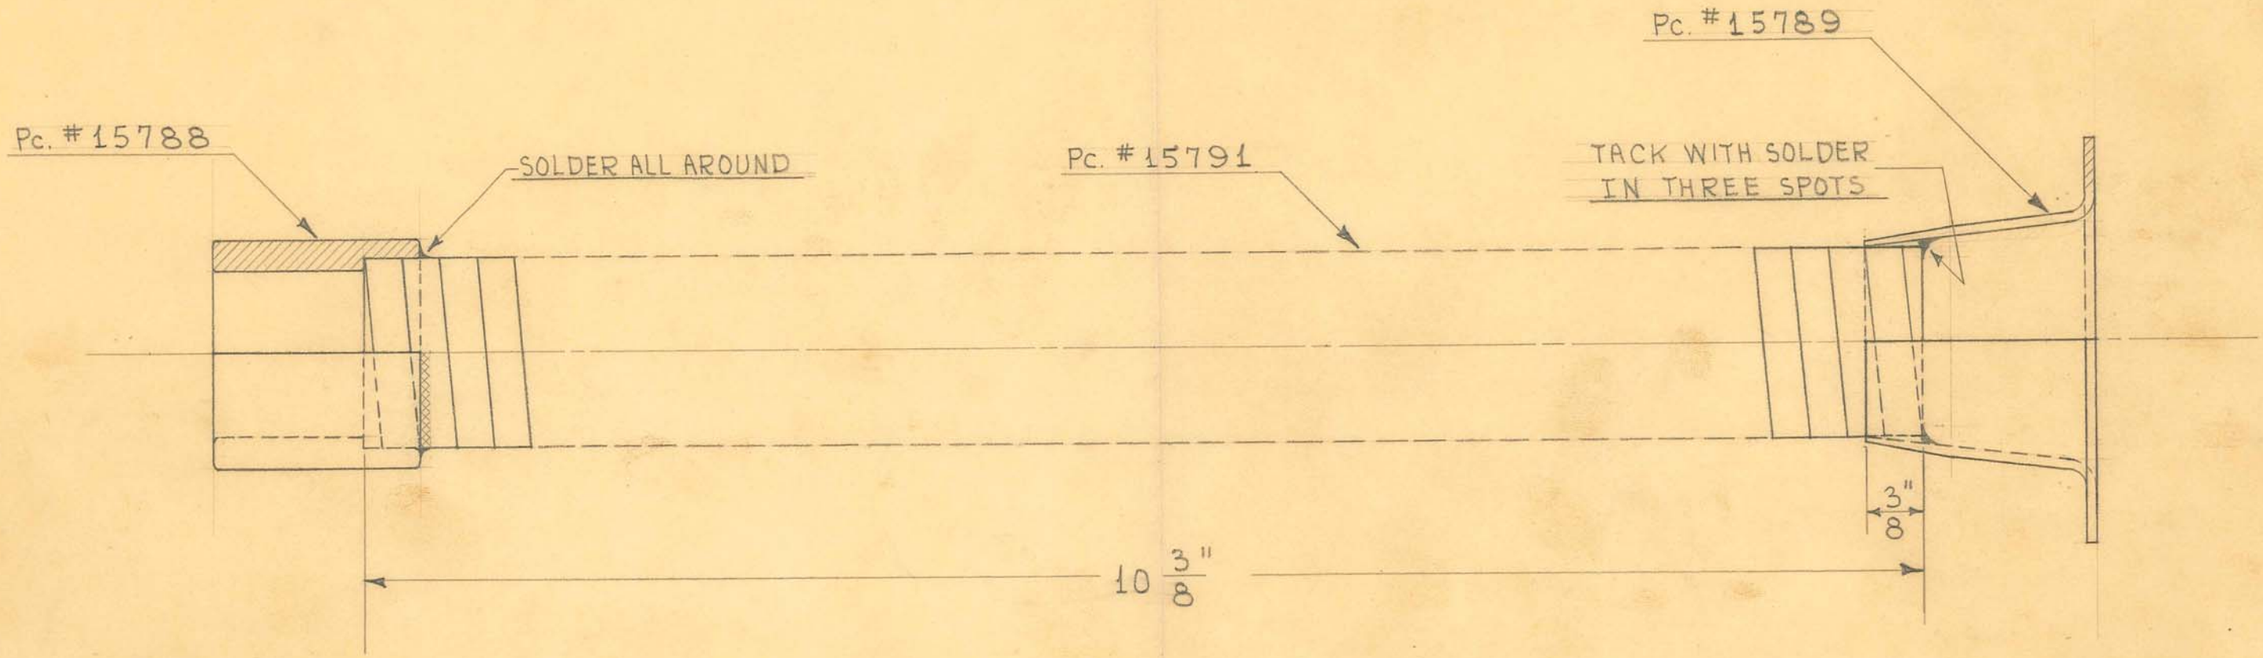

4 REQUIRED

OBSOLETE

SIZE		ISSUE 2-3-45	HE.
KIND		CHANGED	
SHAPE		"	
FINISH	CHR. #2	"	
TEMP.		"	
PATT.		"	

TITLE: FISCHER MOD. "RF-100" X-RAY UNIT-
H.T. CABLE FLEXIBLE SLEEVE ASSEMBLY

H. G. FISCHER & CO.
2335 WABANSIA AVE.
CHICAGO, ILL.

CAT. NO.

PART NO. 15790G

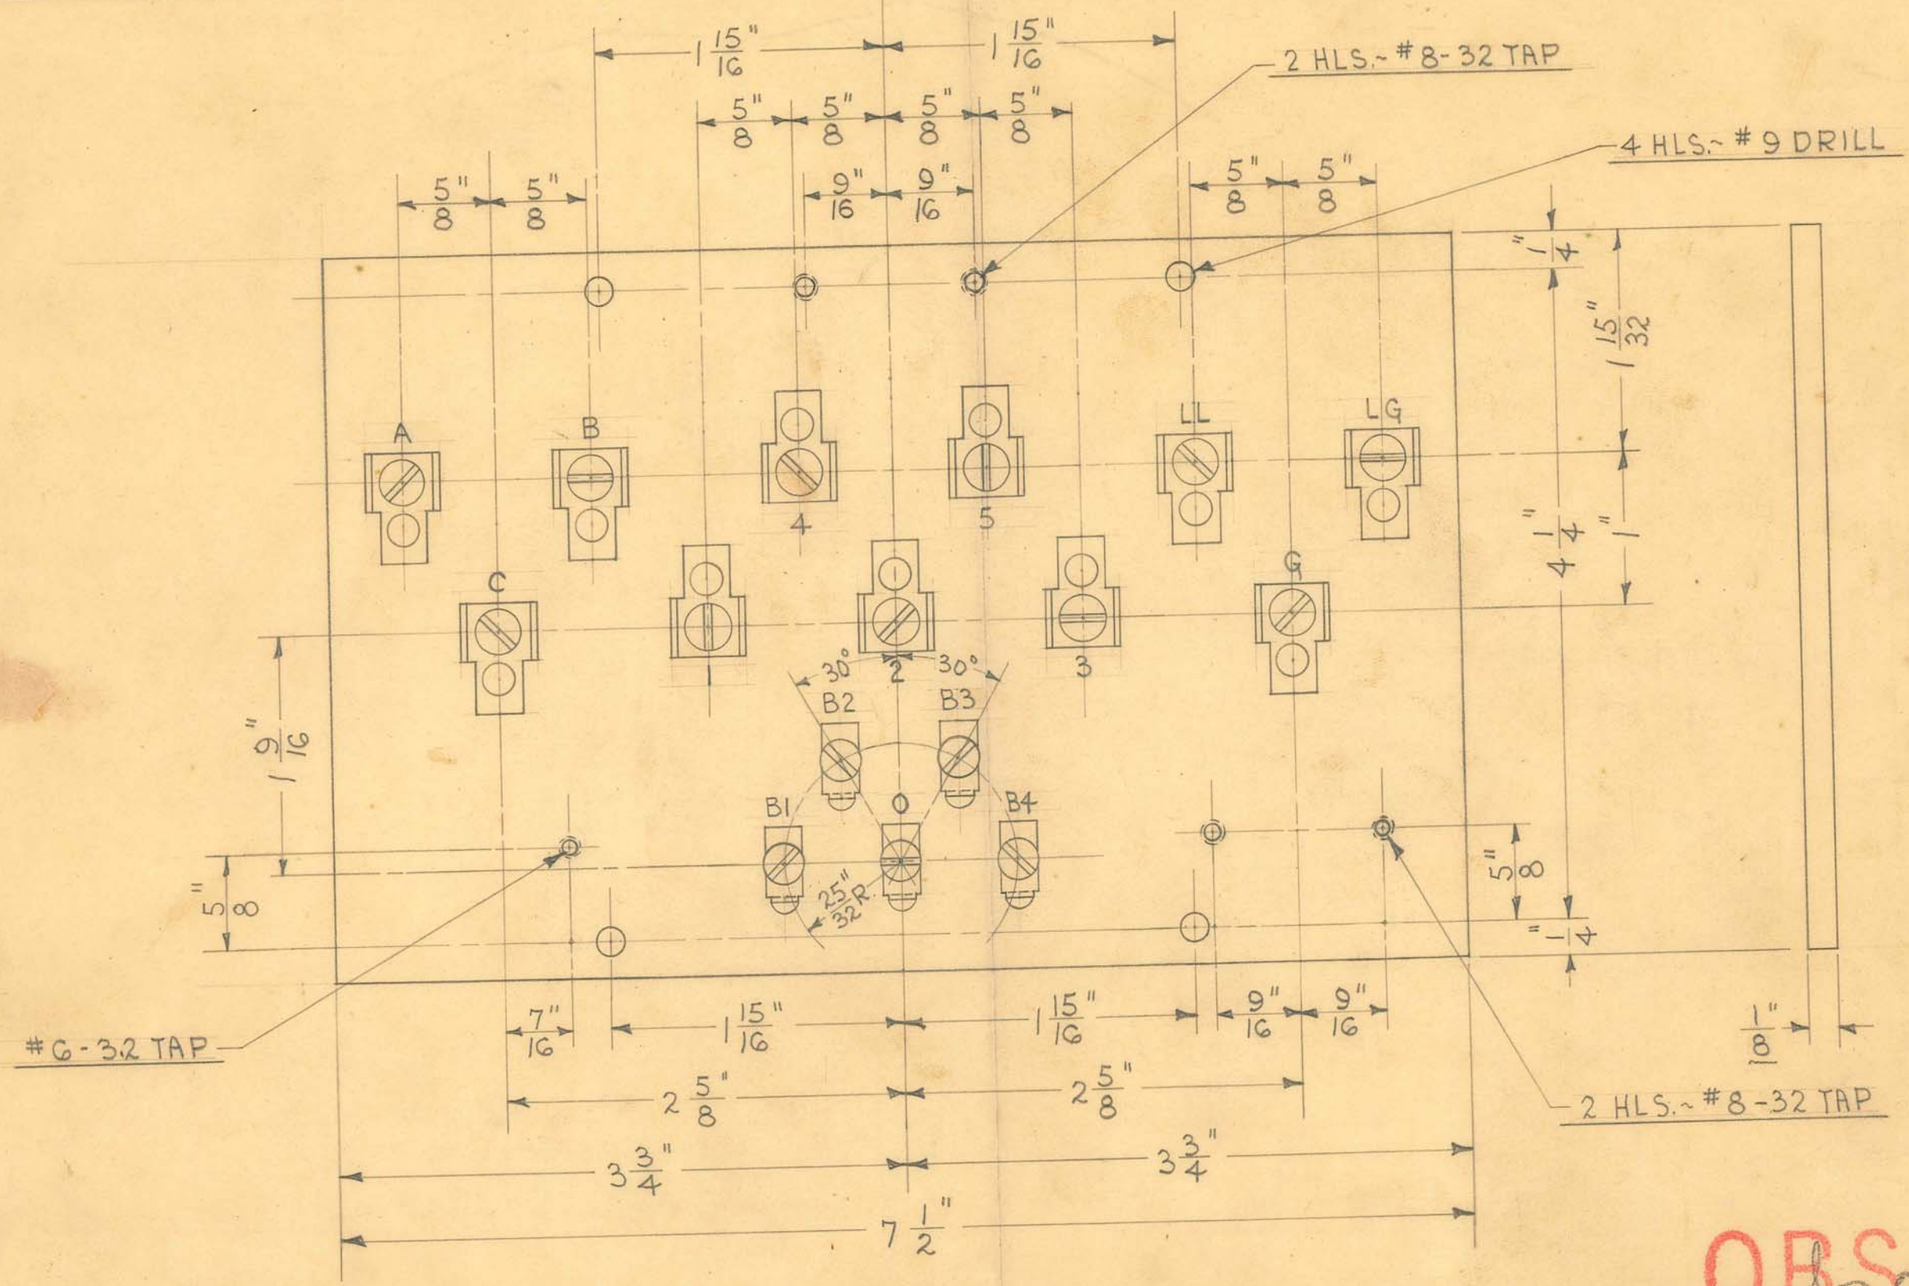

1 REQUIRED

OBSOLETE
Obsolete

SIZE		ISSUE 4-13-44	HE.
KIND	XX BAKELITE	CHANGED	
SHAPE		"	
FINISH		"	
TEMP.		"	

TITLE: WALL MODEL DENTAL X-RAY UNIT~ CONTROL TERMINAL BOARD

H. G. FISCHER & CO.
2335 WABANSIA AVE.

CAT. NO.

PART NO. 15801G

2 HLS.~#22 DRILL

LINE SWITCH

SAFETY CIRCUIT BREAKER

MILLIAMPERAGE CONTROL

KILOVOLTAGE CONTROL

7 HLS.~ #35 DRILL

OBSOLETE

SIZE		ISSUE 5-5-44	HE.	TITLE: WALL MODEL DENTAL X-RAY UNIT~ CONTROL DIAL PLATE
KIND		CHANGED		
SHAPE		"		
FINISH		"		
TEMP.		"		
PATT.		"		

H. G. FISCHER & CO.
2335 WABANSIA AVE.
CHICAGO, ILL.

CAT. NO.

PART NO. 15802

1ST. OPERATION

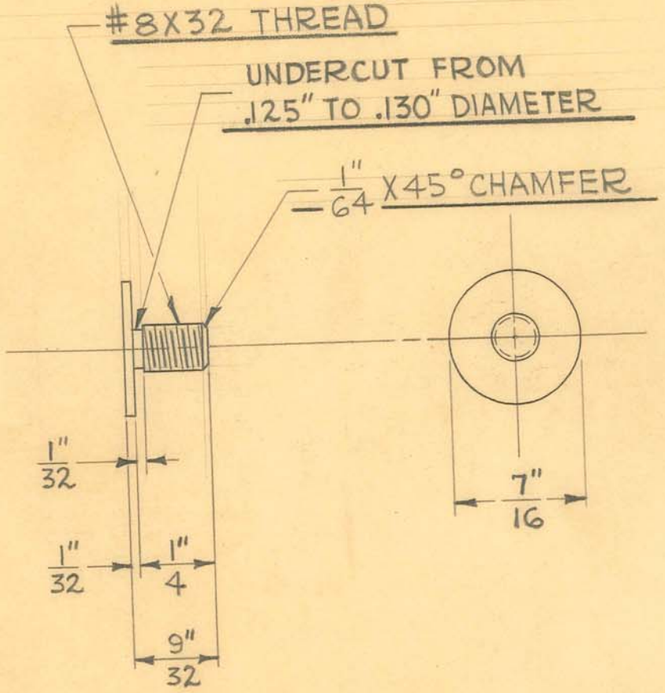

THREAD MUST FIT LOOSELY INTO PCE. #15883

SCALE ÷ DOUBLE SIZE

14 REQUIRED

2ND. OPERATION

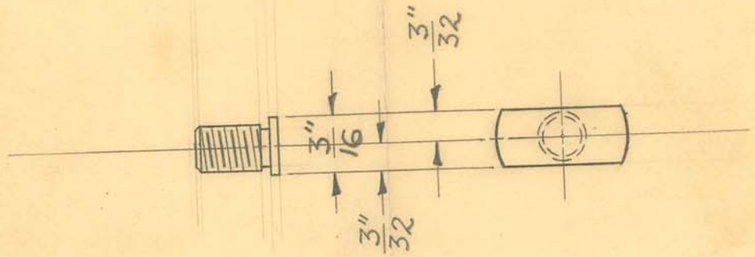

SCALE ÷ DOUBLE SIZE

3RD. OPERATION

ANNEAL BEFORE BENDING
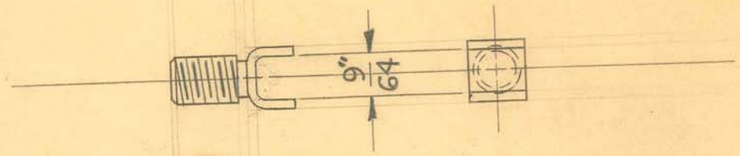
SCALE ÷ DOUBLE SIZE

obsolete 12-12-52

OBSOLETE

TRIMMING DIE #9054 -Y-5 FORMING DIE #9055 Y-5
LEAD CAM 6412 - S.S. 2ND HIGH - 40 SEC. PER PIECE -
72-72-40-80 - SET TURRET 2 3/4" ON STOP LOBE - FEED STOCK -
(BOX TOOL (V REST TYPE) FORM UNDER CUT (FRONT SLIDE)

SIZE	7/16" DIA.	ISSUE 12-11-45	J.V.W.
KIND	BRASS ROD	CHANGED	
SHAPE		"	
FINISH		"	
TEMP.		"	
		"	

TITLE: FISCHER ADJUSTABLE INDUCTION ELECTRODE COIL MOUNTING CLIP

H. G. FISCHER & CO. 2335 WABANSIA AVE. CHICAGO, ILL. | CAT. NO. | PART NO. 15866

TITLE FISCHER ADJUSTABLE INDUCTION ELECTRODE ASSEMBLY

H. G. FISCHER & CO.
FRANKLIN PARK, ILLINOIS

DATE 2-15-52 DR. BY W.J. CH'K'D.

PATTERN | FINISH | SCALE FULL

TOOLS | MATERIAL

DIMENSIONS UNLESS OTHERWISE SPECIFIED
FRACTIONAL ± .015
DECIMAL ± .005
ANGULAR ± ½°

PART NO. 15870GE

REVISION	DATE	BY
A PARTS INDICATED	8-25-52	J.V.W.

OBSOLETE
SEE "D" SIZE

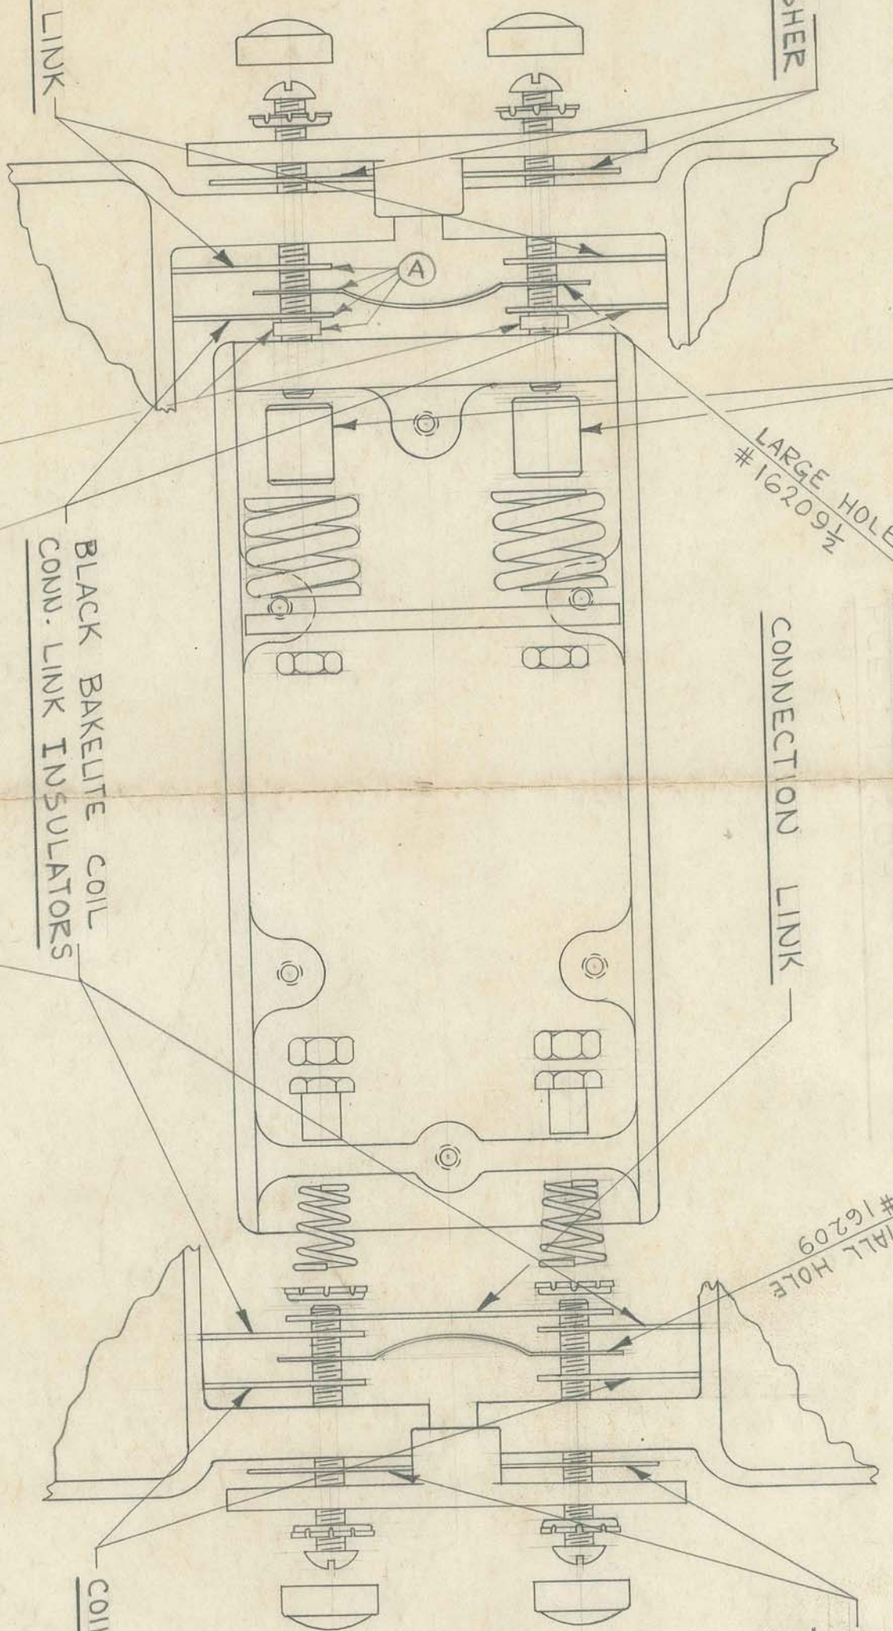

FOLDER #118

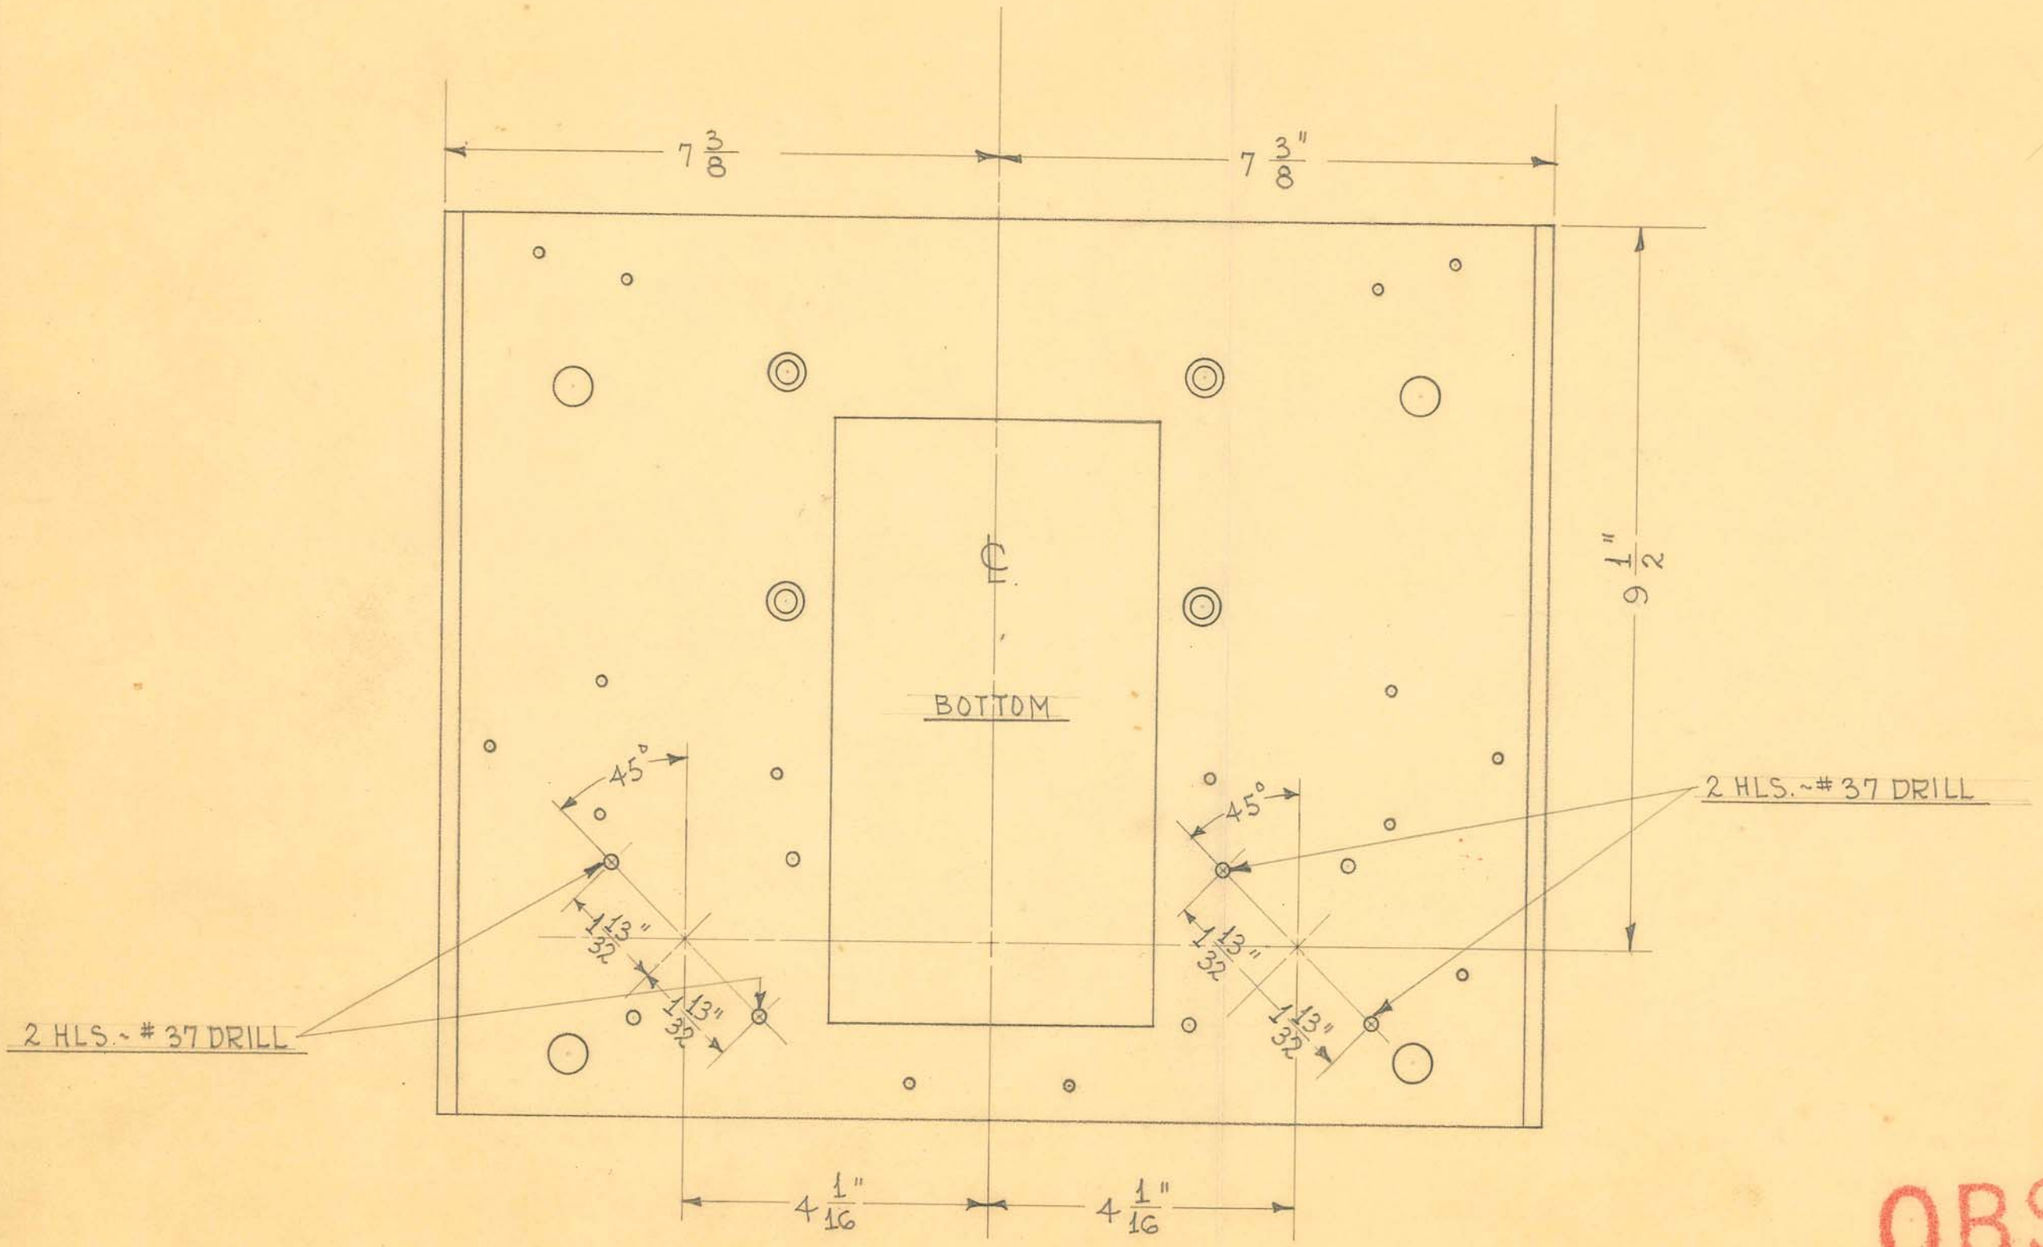

1 REQUIRED

SCALE ÷ 1/2" = 1"

OBSOLETE

SIZE	FROM 12459F	ISSUE 3-5-45	HE.
KIND		CHANGED	
SHAPE		"	
FINISH		"	
TEMP.		"	
PATT.		"	

TITLE: FISCHER MOD. "S" SHORT WAVE & METER OUTFIT - ELECTRICAL UNIT RACK - DRILLED

H. G. FISCHER & CO.
2335 WABANSIA AVE.
CHICAGO, ILL.

CAT. NO.

PART NO. 15894

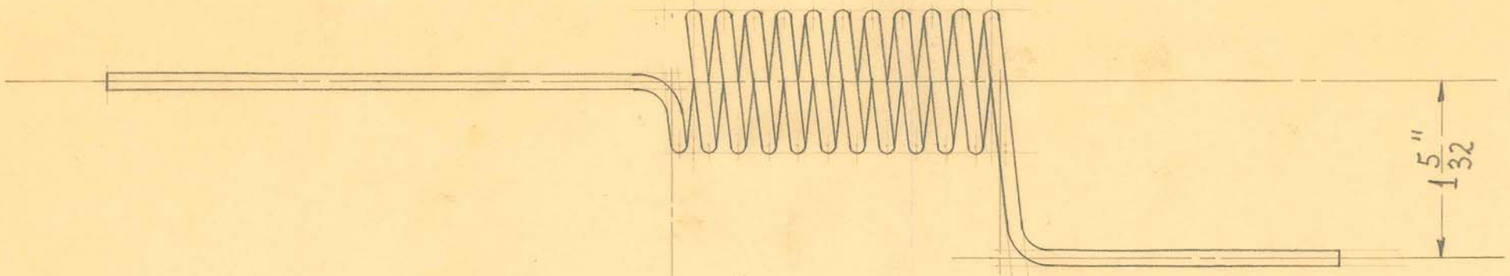

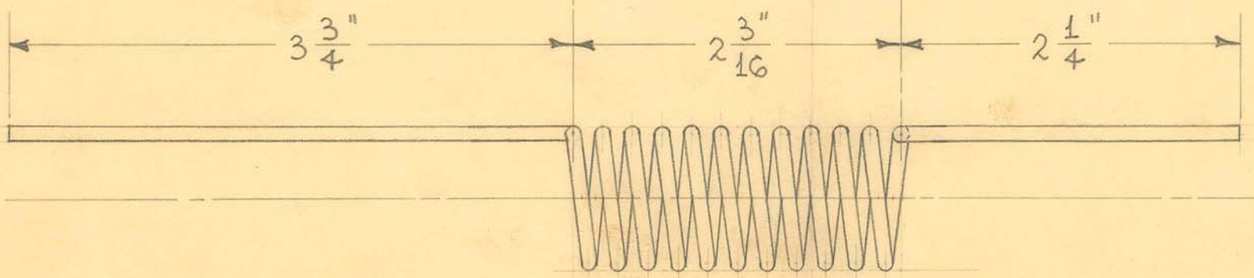

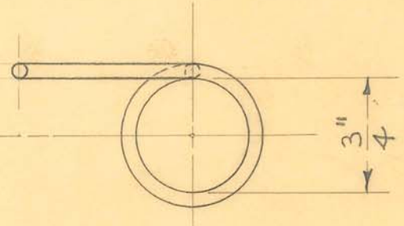

11 TURNS

1 REQUIRED

OBSOLETE

SIZE	#10 TINNED	ISSUE 3-1-45	HE.
KIND	COPPER WIRE	CHANGED	
SHAPE		"	
FINISH		"	
TEMP.		"	
PATT.		"	

TITLE: FISCHER. MOD. "S" SHORT WAVE 6 METER OUTFIT - PATIENT'S TUNING COIL - RIGHT

H. G. FISCHER & CO.
2335 WABANSIA AVE.
CHICAGO. ILL.

CAT. NO.

PART NO. 15895

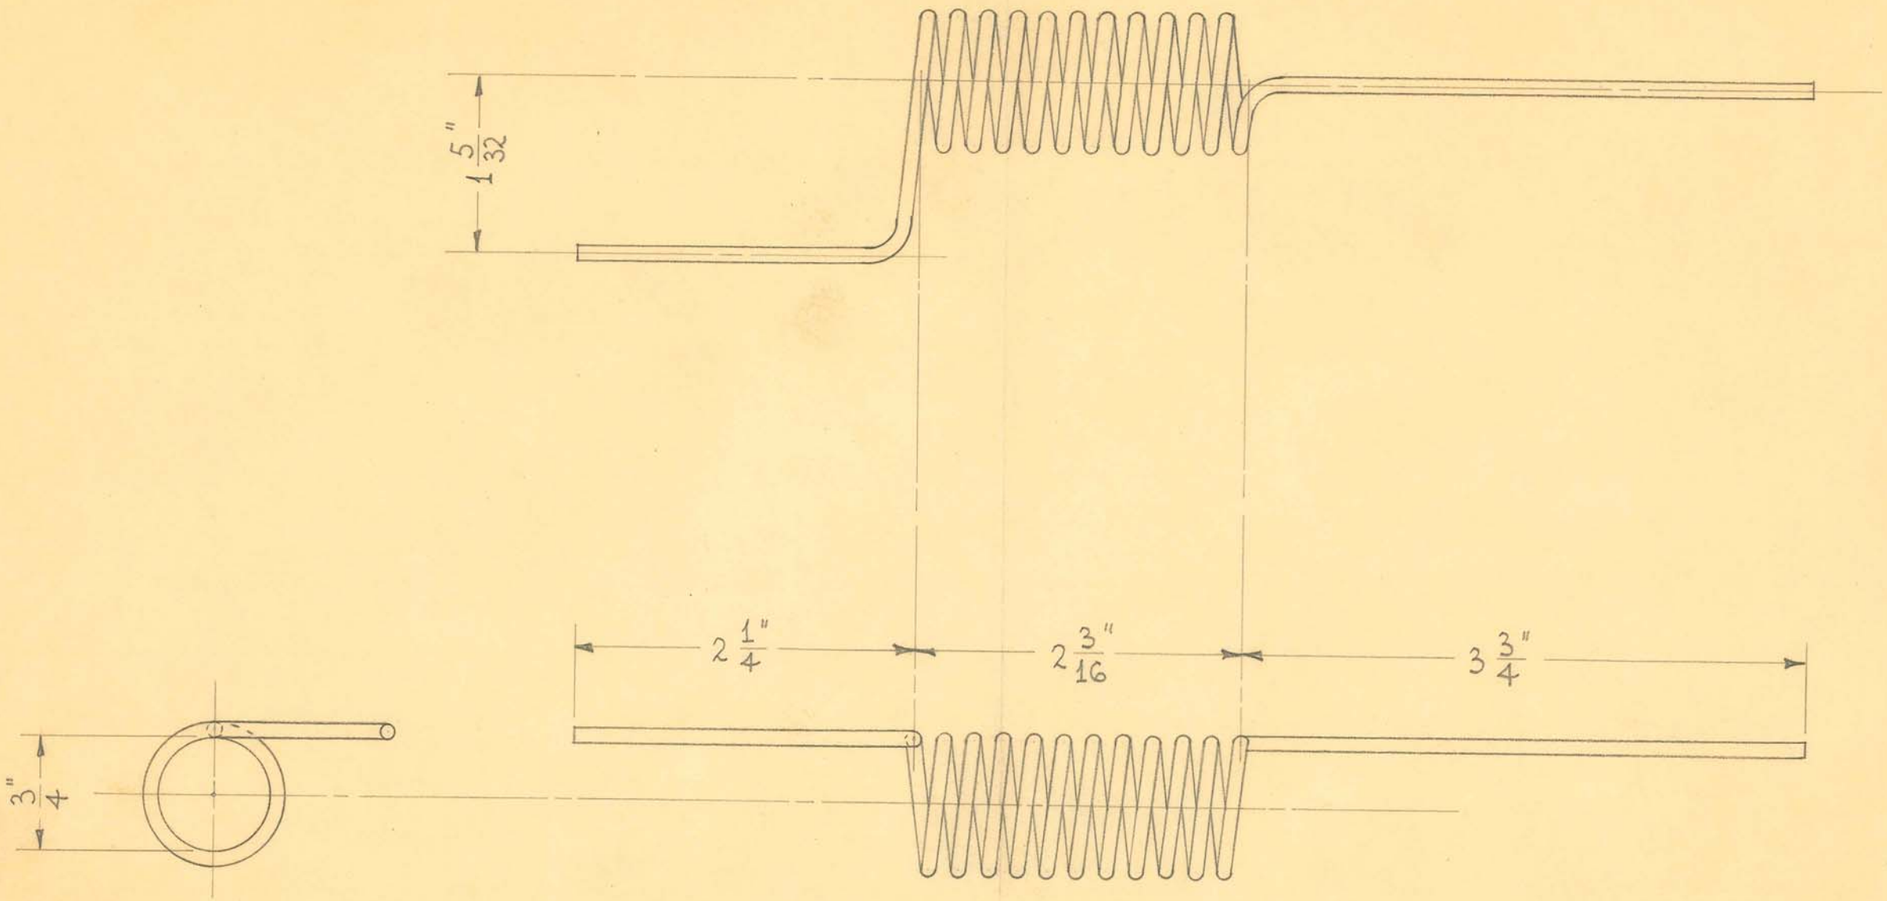

11 TURNS

1 REQUIRED

OBSOLETE

SIZE	#10 TINNED	ISSUE 3-1-45	HE.
KIND	COPPER WIRE	CHANGED	
SHAPE		"	
FINISH		"	
TEMP.		"	
PATT.		"	

TITLE: FISCHER MOD. "S" SHORT WAVE & METER OUTFIT - PATIENT'S TUNING COIL - LEFT

H. G. FISCHER & CO.
2335 WABANSIA AVE.
CHICAGO. ILL.

CAT. NO.

PART NO. 15896

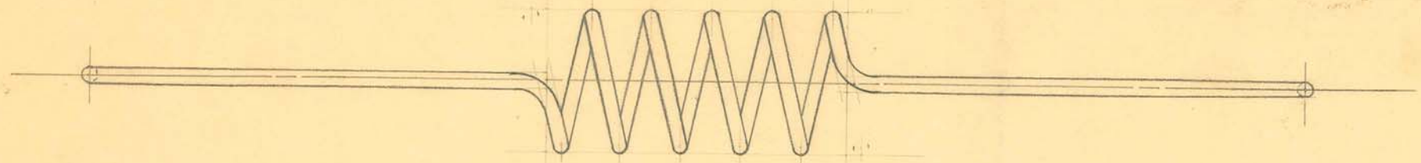

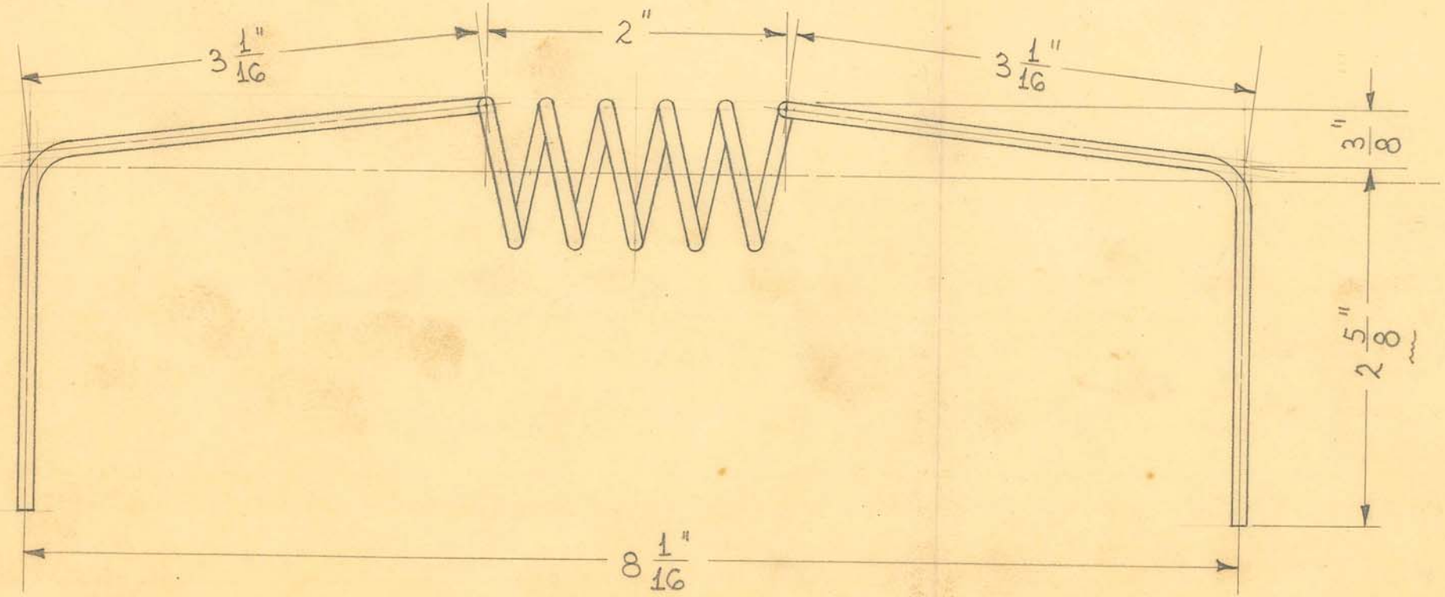

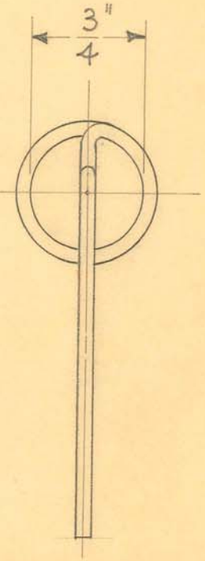

OBSOLETE

5 TURNS

1 REQUIRED

SIZE	#10 TINNED	ISSUE 3-1-45	HE.
KIND	COPPER WIRE	CHANGED	
SHAPE		"	
FINISH		"	
TEMP.		"	

TITLE: FISCHER MOD. "S" SHORT WAVE & METER OUTFIT - PICKUP COIL

H. G. FISCHER & CO. 2335 WABANSIA AVE.

CAT. NO.

PART NO. 15897

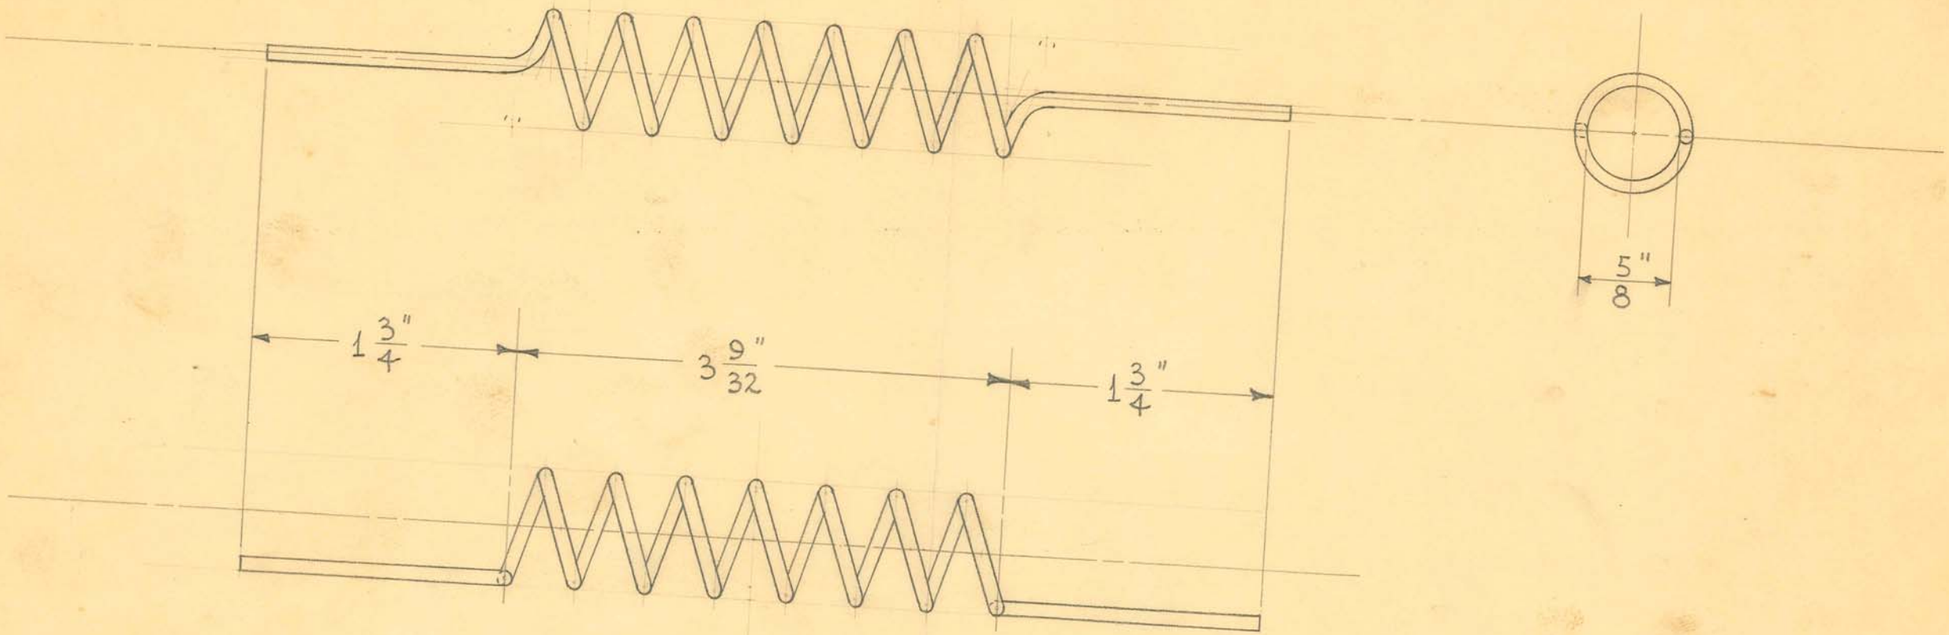

7 TURNS

1 REQUIRED

OBSOLETE

SIZE	#12 TINNED	ISSUE 2-28-45	HE.	TITLE: FISCHER MOD. "S" SHORT WAVE & METER OUTFIT - GRID COIL
KIND	COPPER WIRE	CHANGED		
SHAPE		"		
FINISH		"		
TEMP.		"		

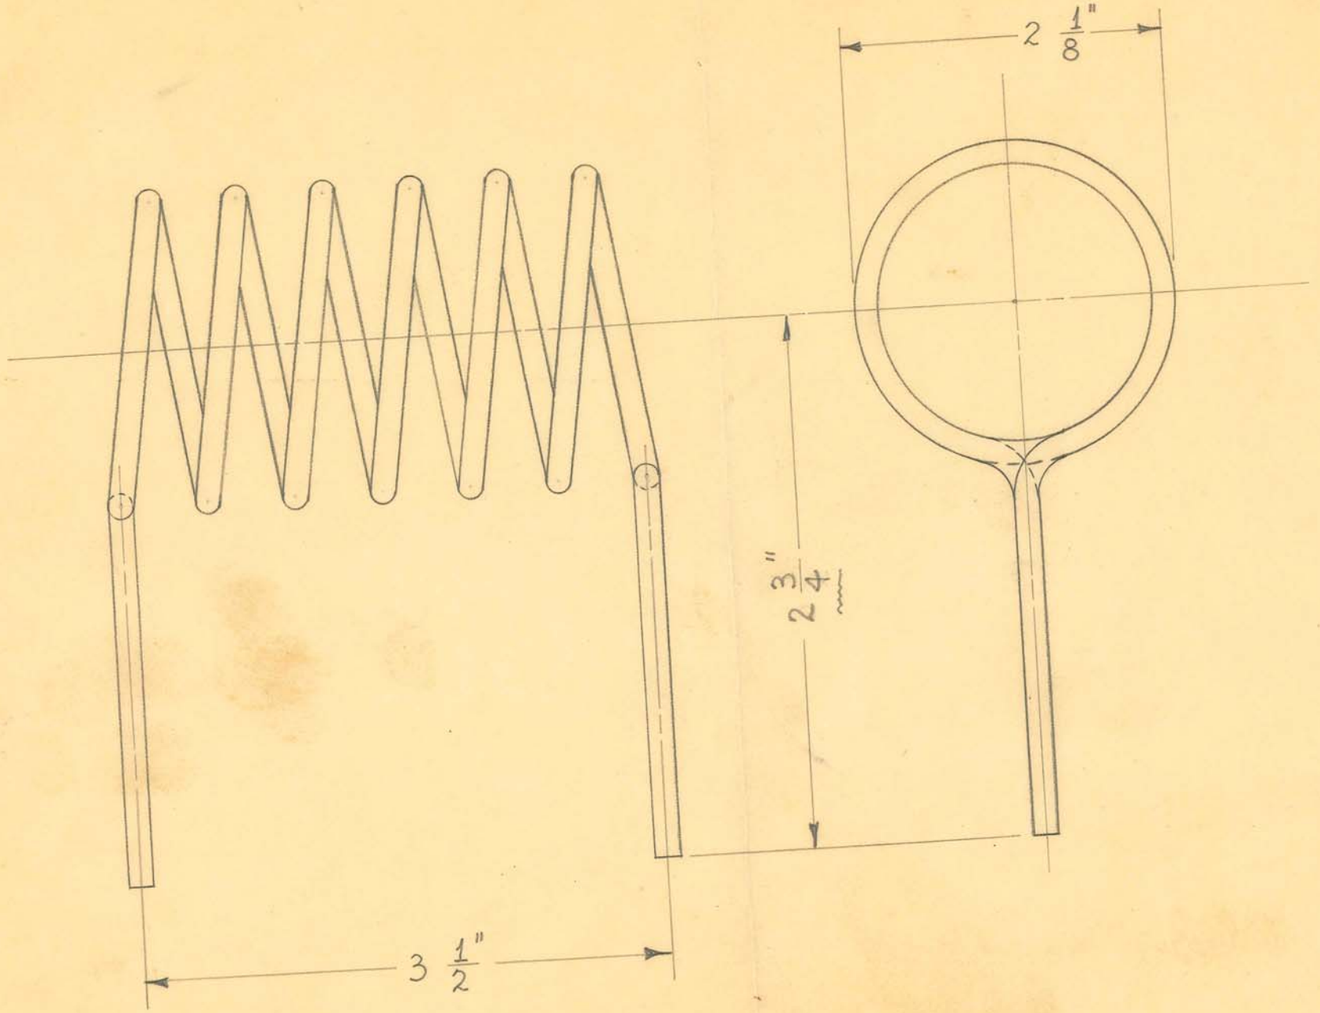

6 TURNS
1 REQUIRED

OBSOLETE

NOTE:-
THIS COIL IS THE SAME AS Pc. # 9637B,
EXCEPT THAT IT IS WOUND THE REVERSE WAY.

SIZE	#6 BARE	ISSUE 2-27-45	HE.
KIND	COPPER WIRE	CHANGED	
SHAPE		"	
FINISH		"	
TEMP.		"	
PATT.		"	

TITLE: FISCHER MOD."S" SHORT WAVE 6 METER OUTFIT PLATE COIL

H. G. FISCHER & CO.
2335 WABANSIA AVE.
CHICAGO, ILL.

CAT. NO.

PART NO. 15899

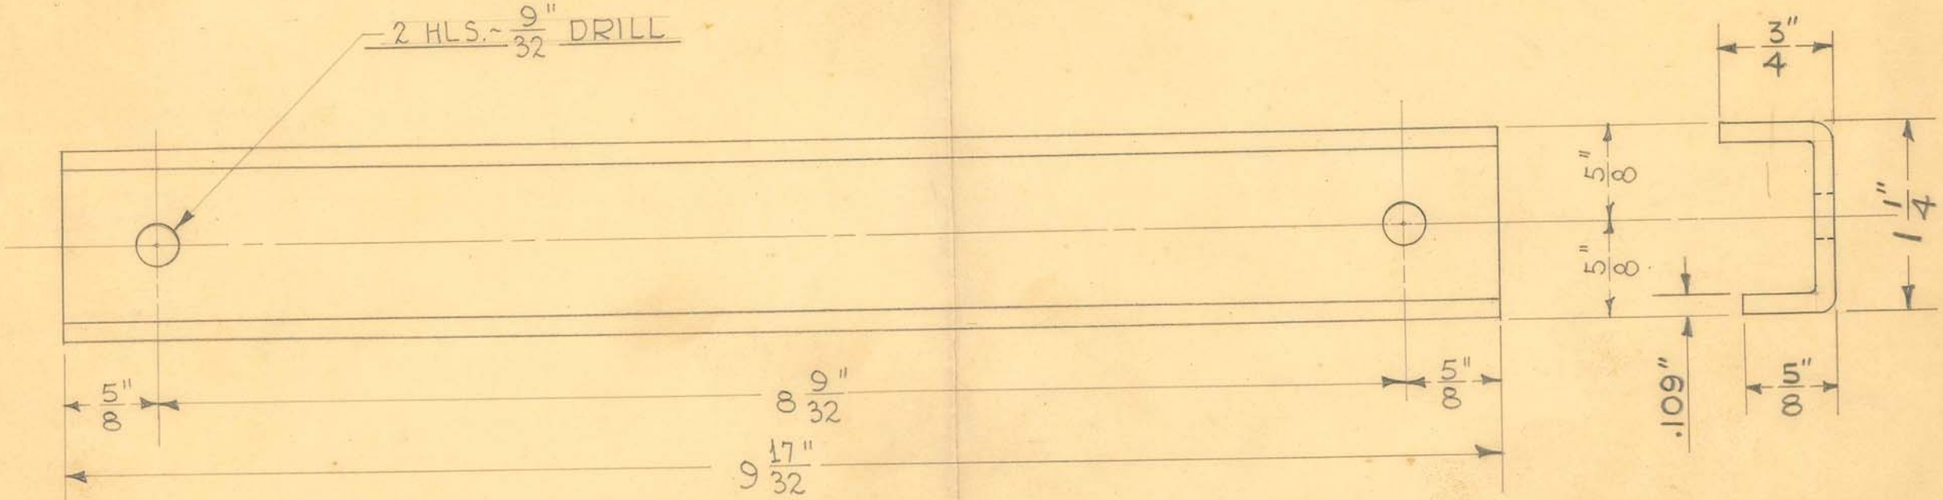

2 REQUIRED

OBSOLETE
SEE 15506A

OBSOLETE

SIZE	#12GA.(.109)	ISSUE 7-26-44	HE.
KIND	C.R. STEEL	CHANGED	
SHAPE	SHEET	"	
FINISH	BLACK #80	"	
TEMP.		"	
		"	

TITLE: FISCHER MOD. "S" SHORT WAVE OUTFIT~ TRANSFORMER CLAMP (TOP~FRONT)

H. G. FISCHER & CO.
2335 WABANSIA AVE.
CHICAGO, ILL.

CAT. NO.

PART NO. 15906

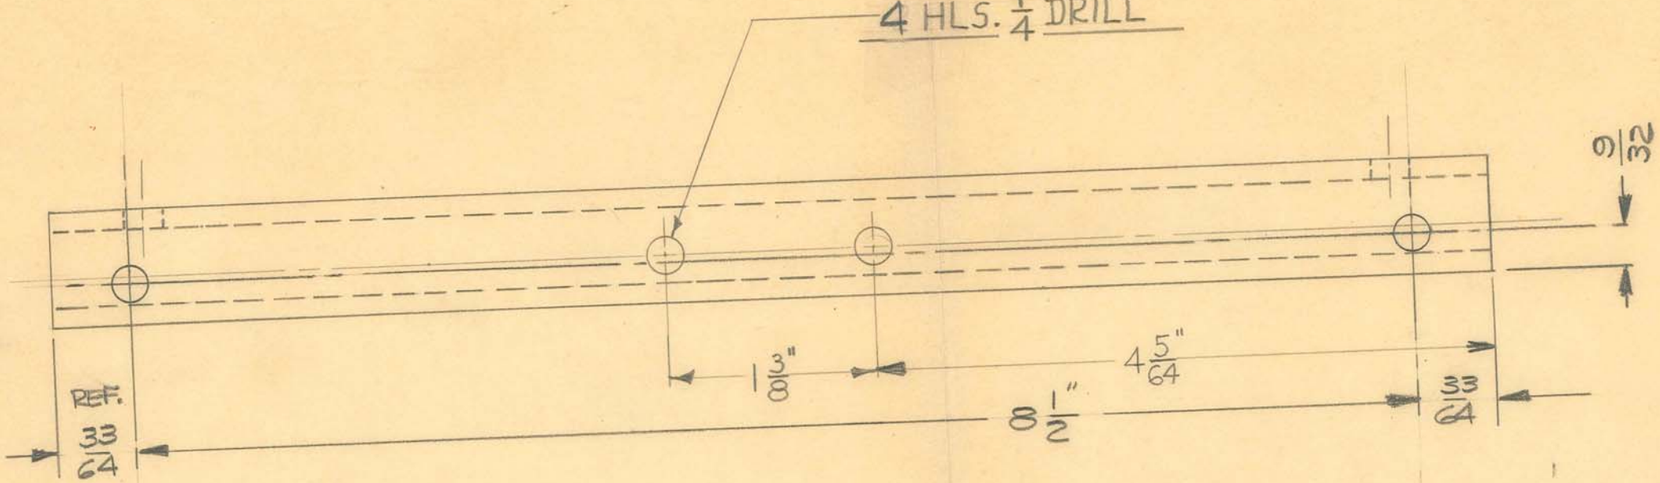

OBSOLETE

BREAK ALL SHARP EDGES AND CORNERS

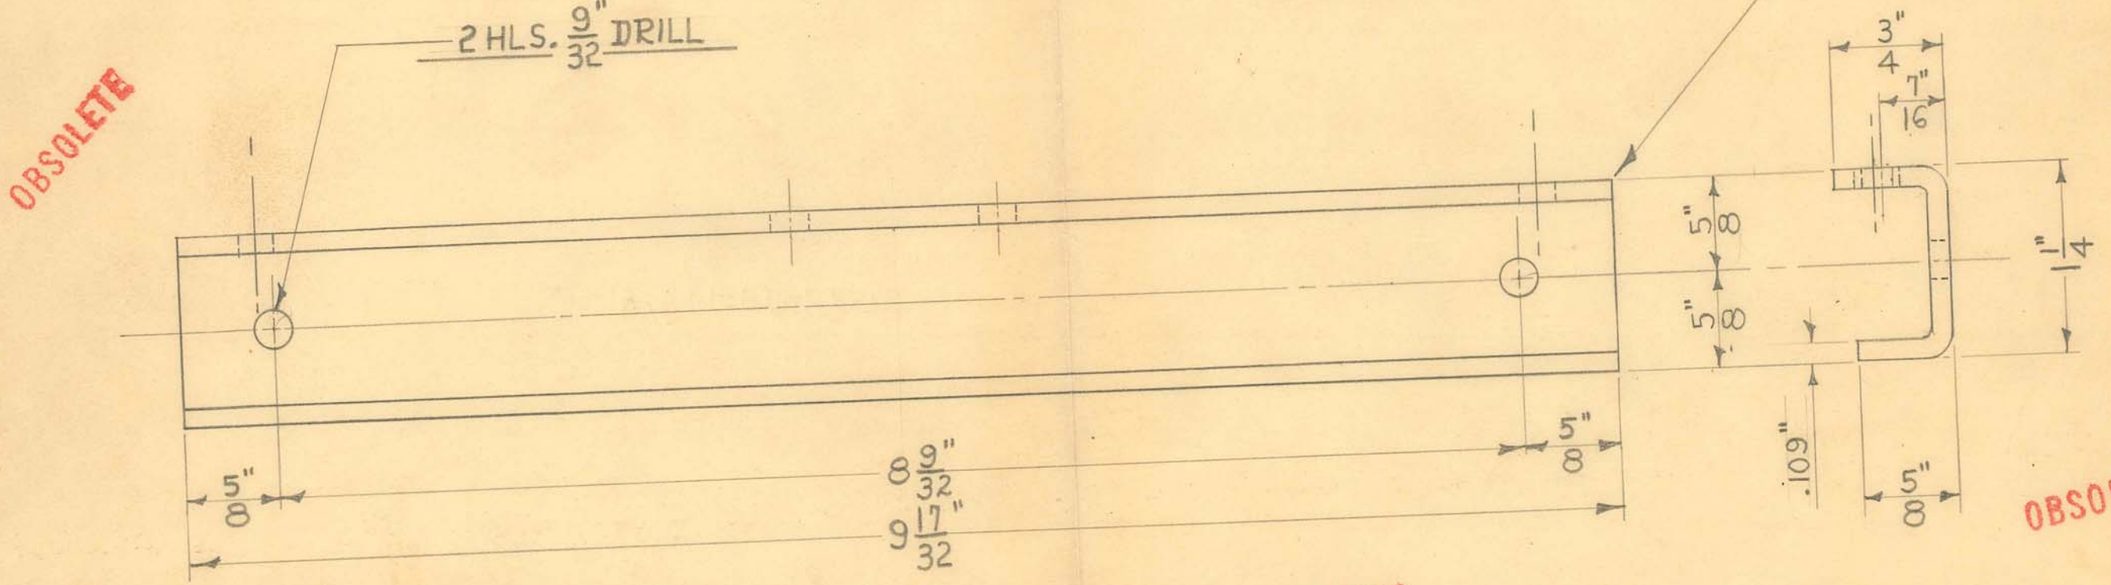

OBSOLETE

OBSOLETE

OBSOLETE

2-REQUIRED

DRILL JIG TOOL # 9606

SIZE	#11 GA. (.120")	ISSUE 12-11-47	J.M.F
KIND	C.R. STEEL	CHANGED	
SHAPE	SHEET	B. ADD 2 1/4" DIA. HOLE	
FINISH	BLACK #80	" 11-11-48	R.W.S
TEMP.		"	
		"	

DIMENSIONS

FRACTIONAL	± .015
DECIMAL	± .005
ANGULAR	± 1/2°

TITLE: MODEL "400" FISCHER DELUXE DIATHERMY TRANSFORMER CLAMP (TOP-)

H. G. FISCHER & CO.
2335 WABANSIA AVE.
CHICAGO. ILL.

CAT. NO.

PART NO. 15906 B

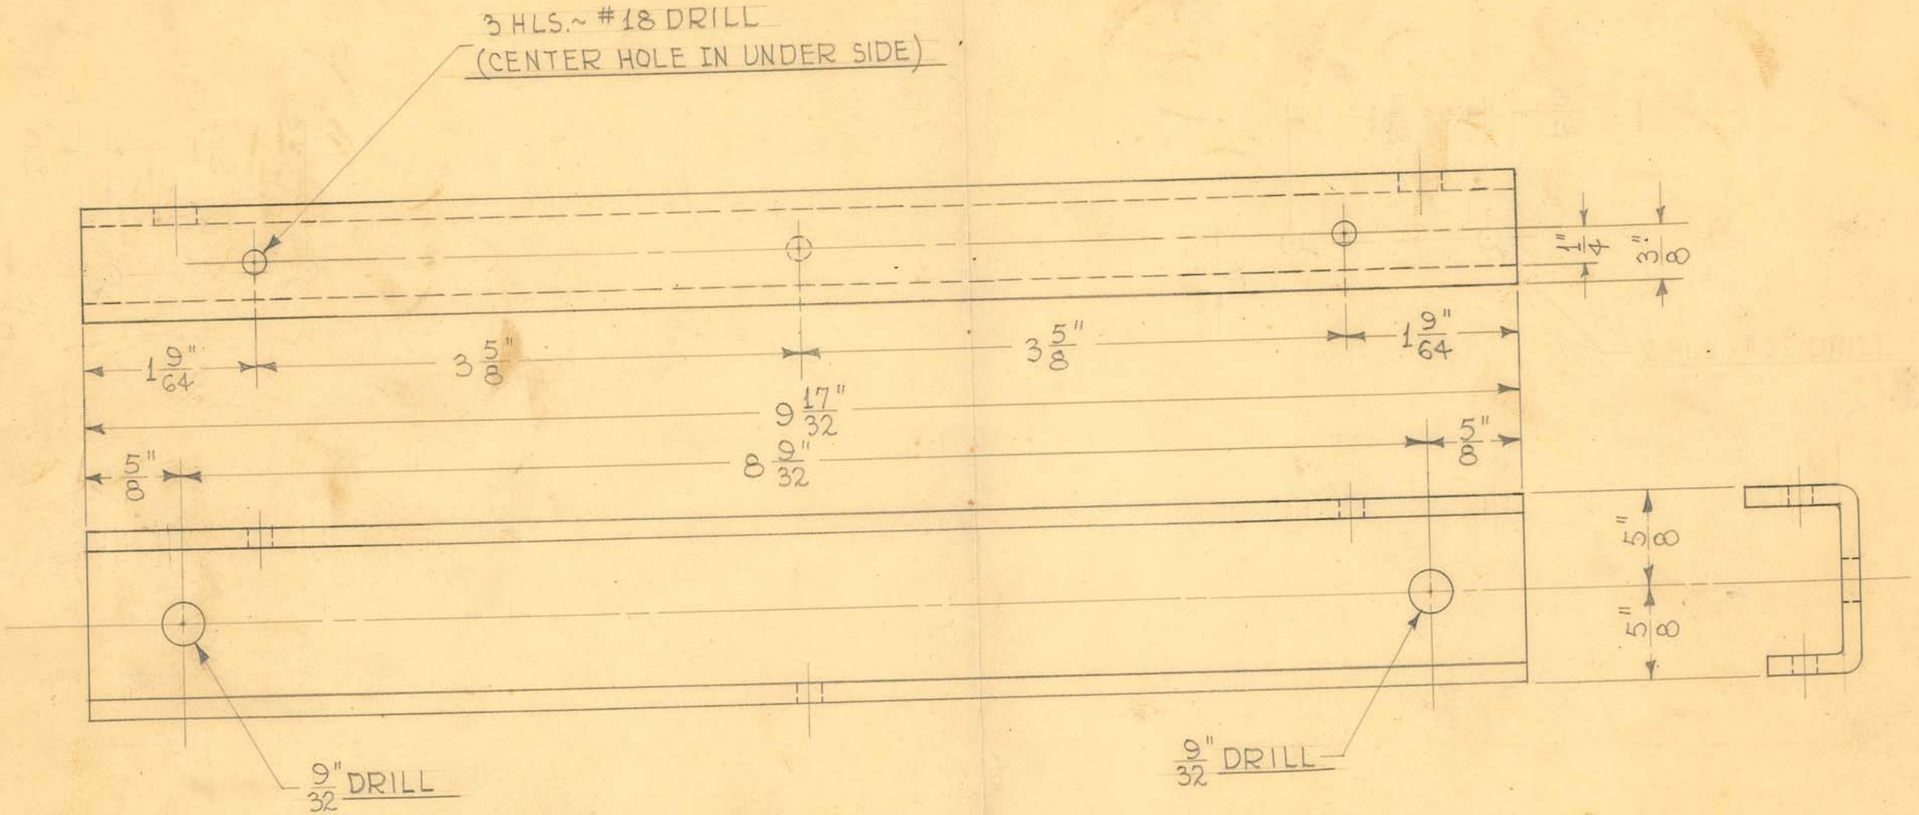

1 REQUIRED

OBSOLETE

SIZE	FROM 15906	ISSUE 7-26-44	HE
KIND		CHANGED	
SHAPE		"	
FINISH	BLACK #80	"	
TEMP.		"	
		"	

TITLE: FISCHER MOD. "S" SHORT WAVE OUTFIT-
TRANSFORMER CLAMP (TOP-REAR)

H. G. FISCHER & CO.
2335 WABANSIA AVE.
CHICAGO, ILL.

CAT. NO.

PART NO. 15907

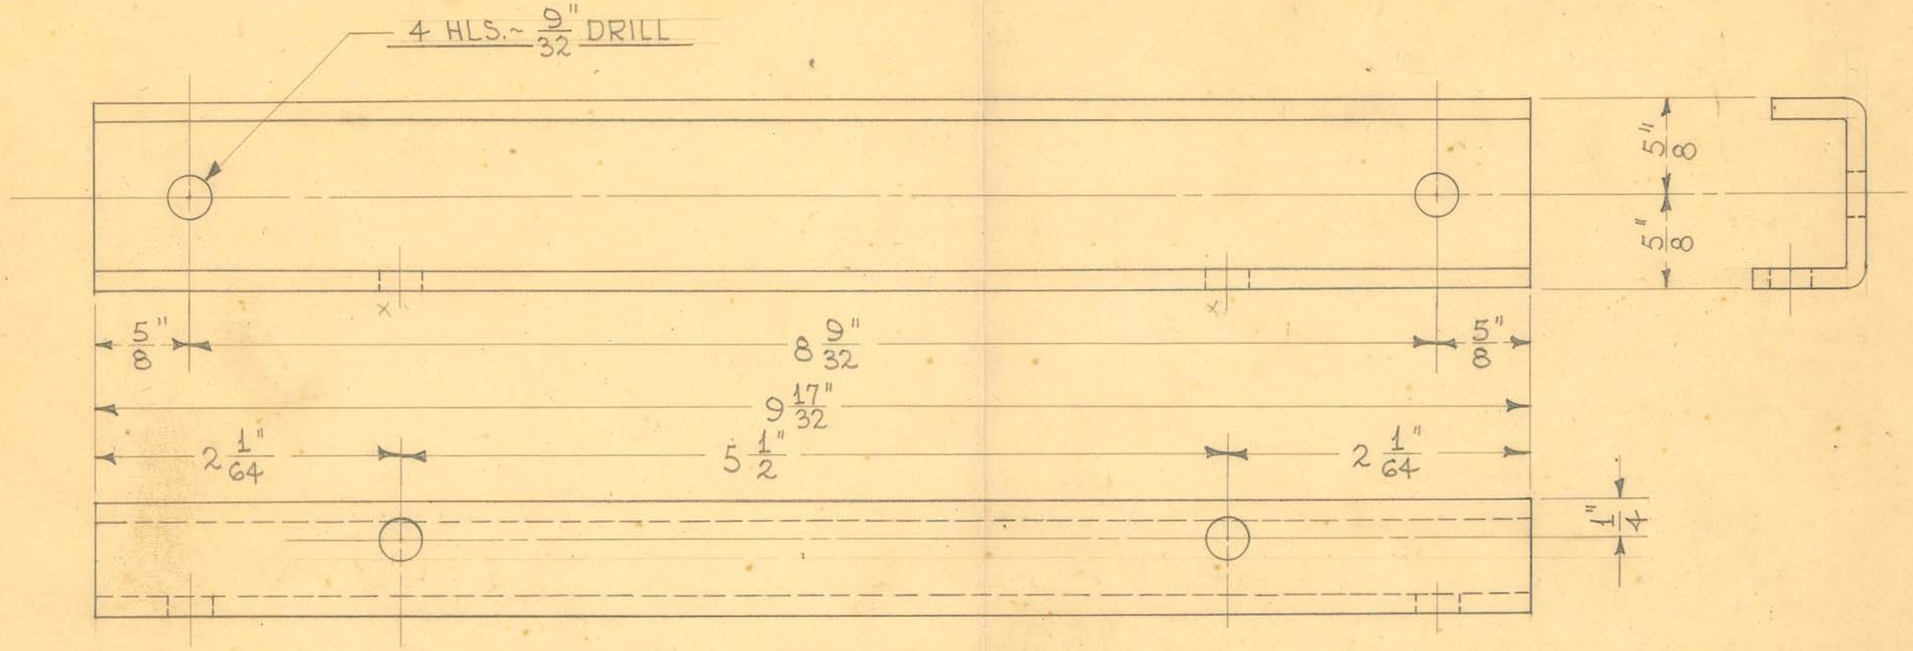

2 REQUIRED

OBSOLETE

SIZE	FROM 15906	ISSUE 7-26-44	HE.
KIND		CHANGED	
SHAPE		"	
FINISH	BLACK #80	"	
TEMP.		"	

TITLE: FISCHER MOD. "S" SHORT WAVE OUTFIT-
TRANSFORMER CLAMP (BOTTOM)

H. G. FISCHER & CO. | CAT. | PART NO. 15908

REDRAWN 8-25
SEE 13302 GBF

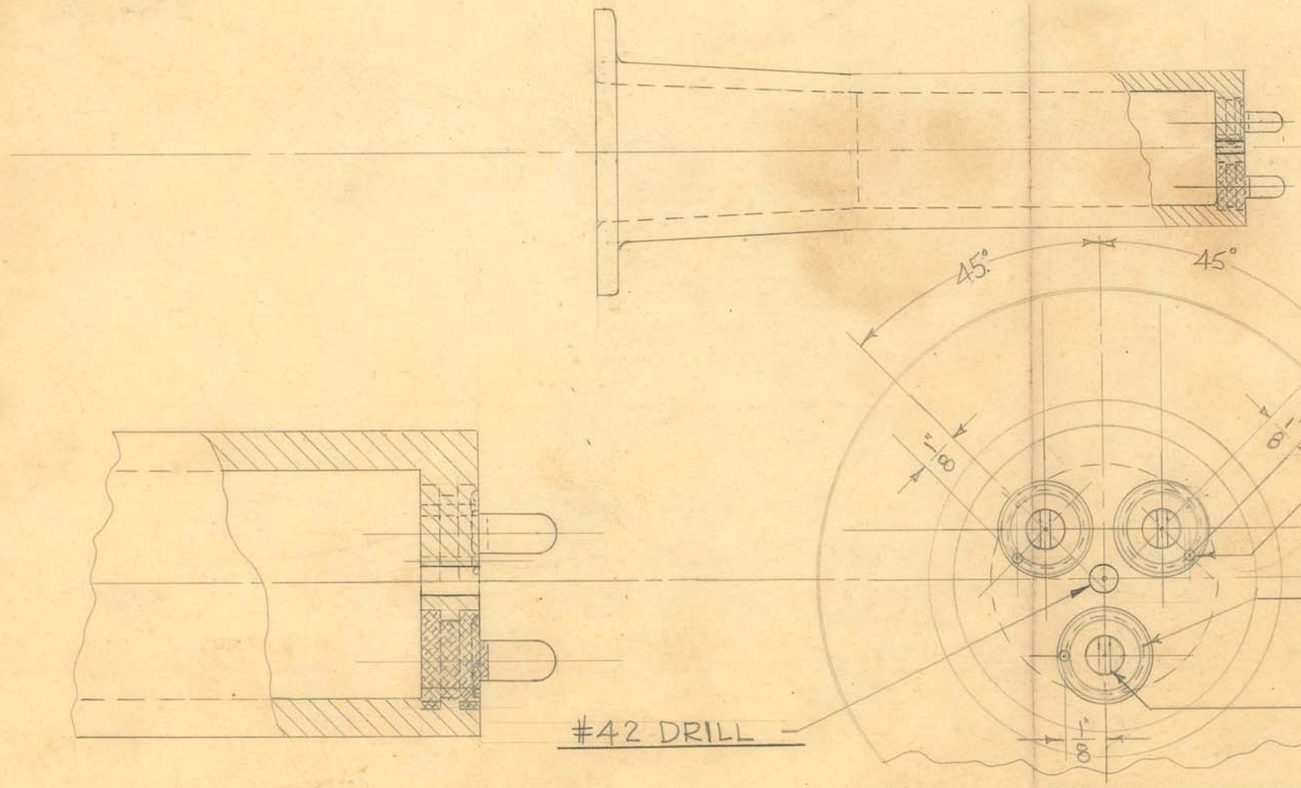

SCALE - DOUBLE SIZE

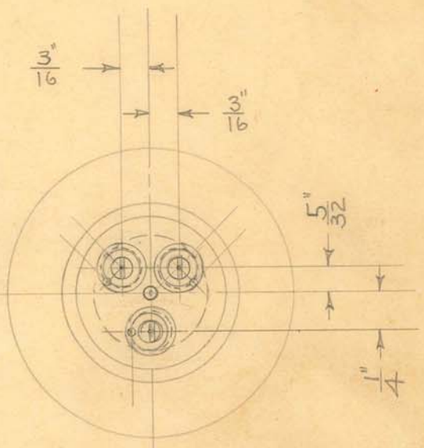

SCALE - FULL SIZE

OBSOLETE

SIZE		ISSUE 6-25-40	C.E.A.
KIND	#105-53 NATURAL PHENOLITE	CHANGED	
SHAPE	MOLDED	"	
FINISH		"	
TEMP.		"	
PATT.		"	

TITLE: FISCHER MOD. "100" X-RAY UNIT
H.T. POST PLUG

H. G. FISCHER & CO.
2335 WABANSIA AVE.
CHICAGO, ILL.

CAT. NO.

PART NO. 13302 GAF

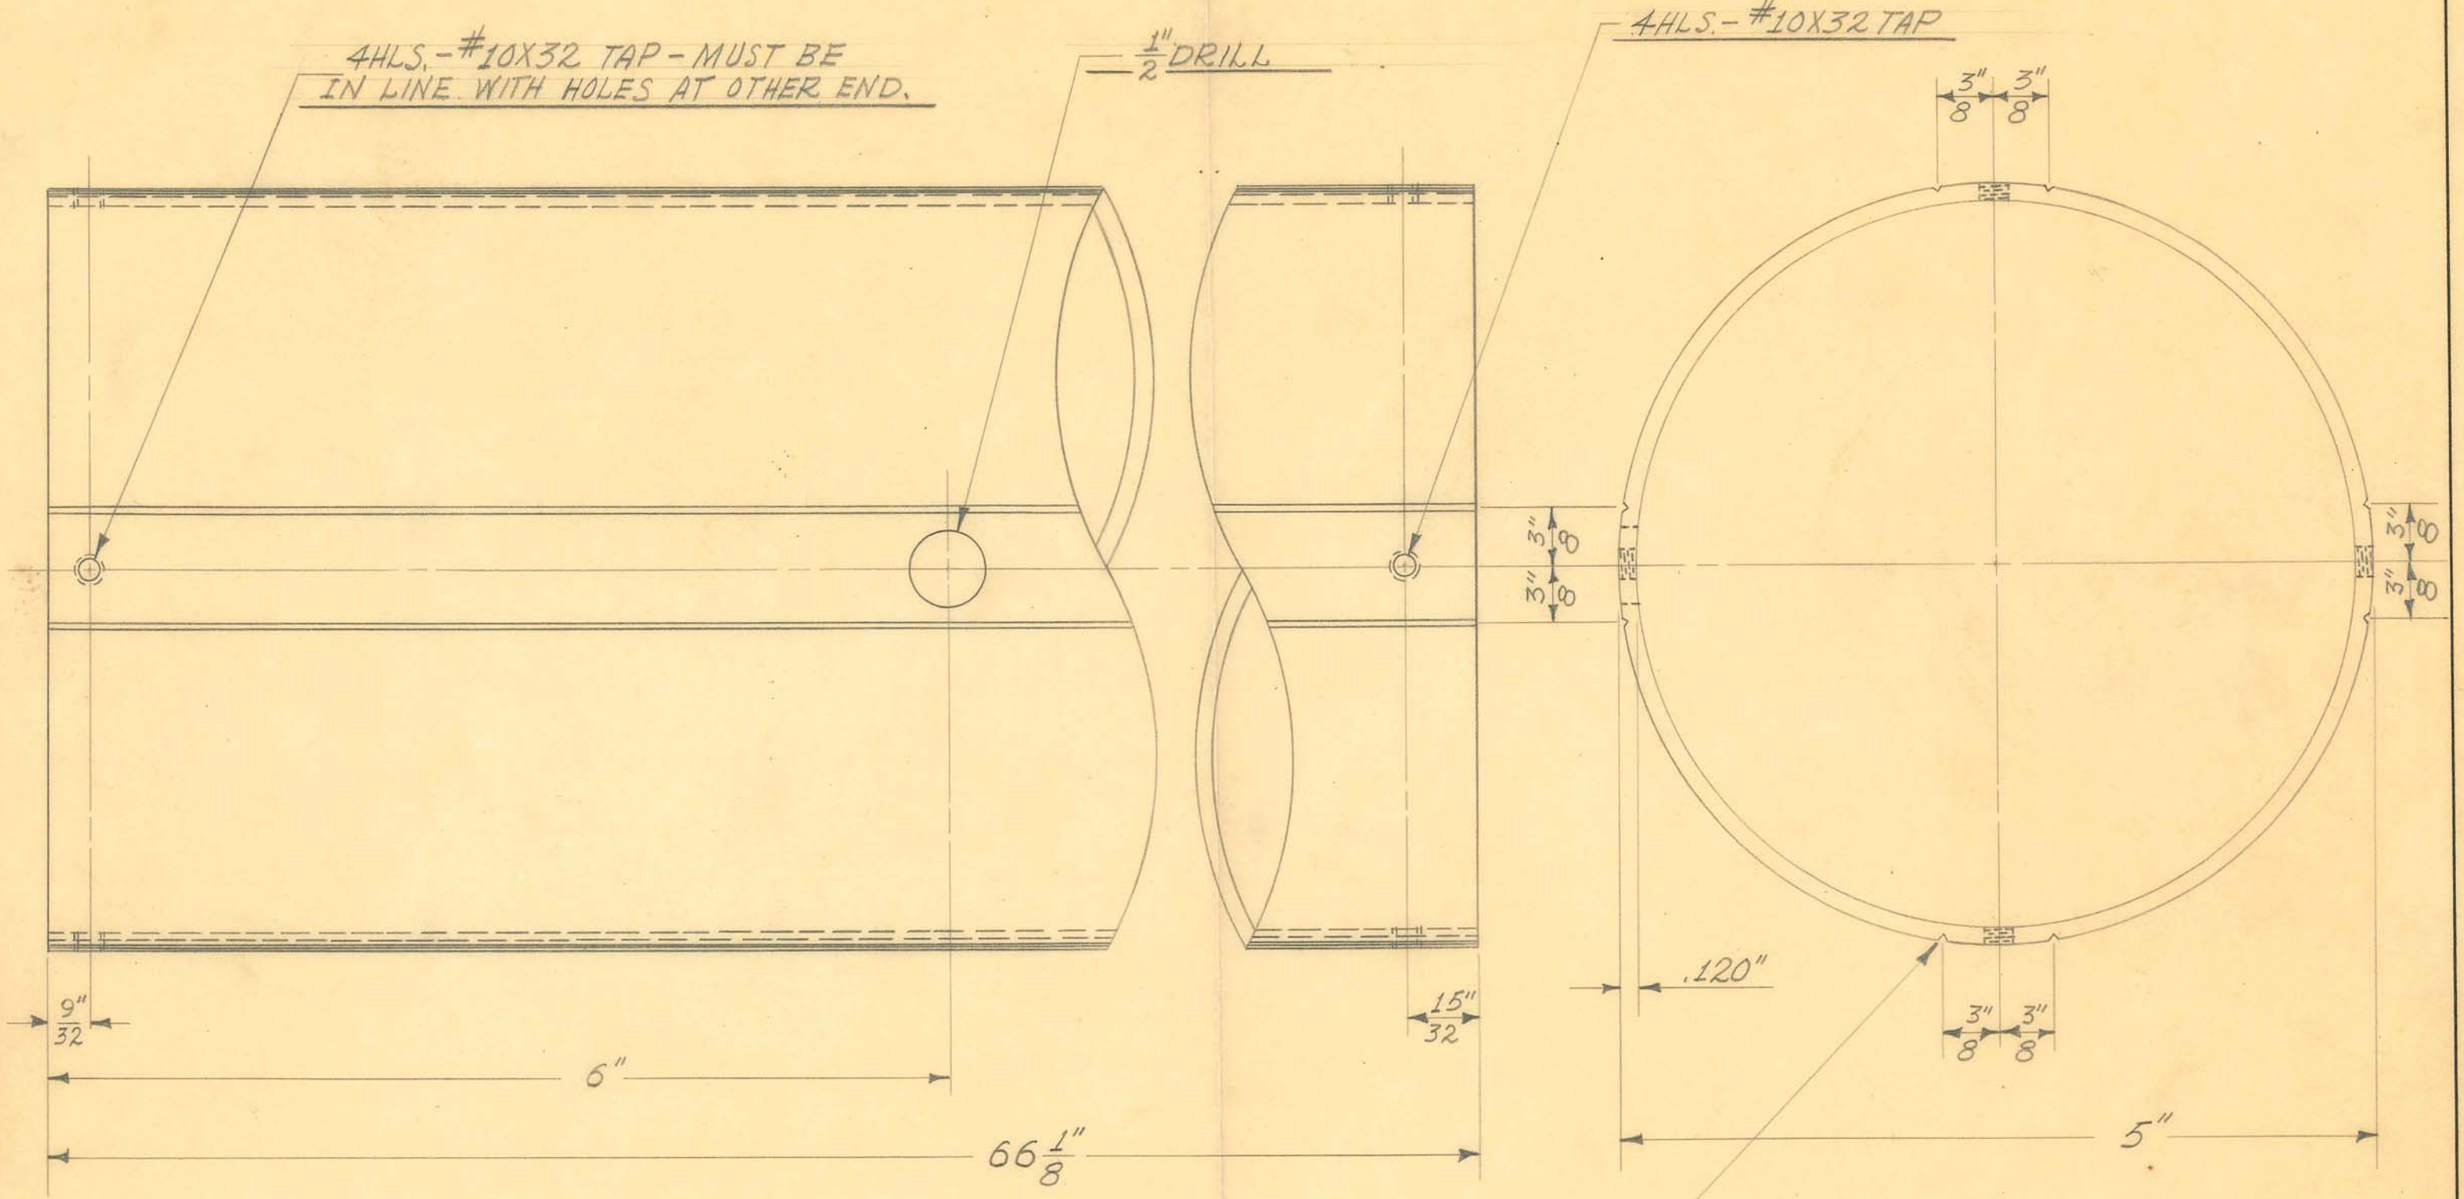

CUT 4 SETS (2 EACH) OF "V" GROOVES 1/32" DEEP - WITH SPECIAL TOOL, 3/8" EITHER SIDE OF CENTER OF TAPPED HOLES AS SHOWN.

5" O.D. X #11 GAUGE WALL SHELBY SEAMLESS STEEL TUBING

1 REQUIRED

SIZE		ISSUE 7-3-40	J.W.
KIND		CHANGED	
SHAPE		"	
FINISH		"	
TEMP.		"	
PATT.		"	

TITLE:
FISCHER MOD. "100" X-RAY UNIT
TUBE STAND - OUTER UPRIGHT TUBE

OBSOLETE

H. G. FISCHER & CO.
2335 WABANSIA AVE.
CHICAGO, ILL.

CAT. NO.

PART NO. 13308

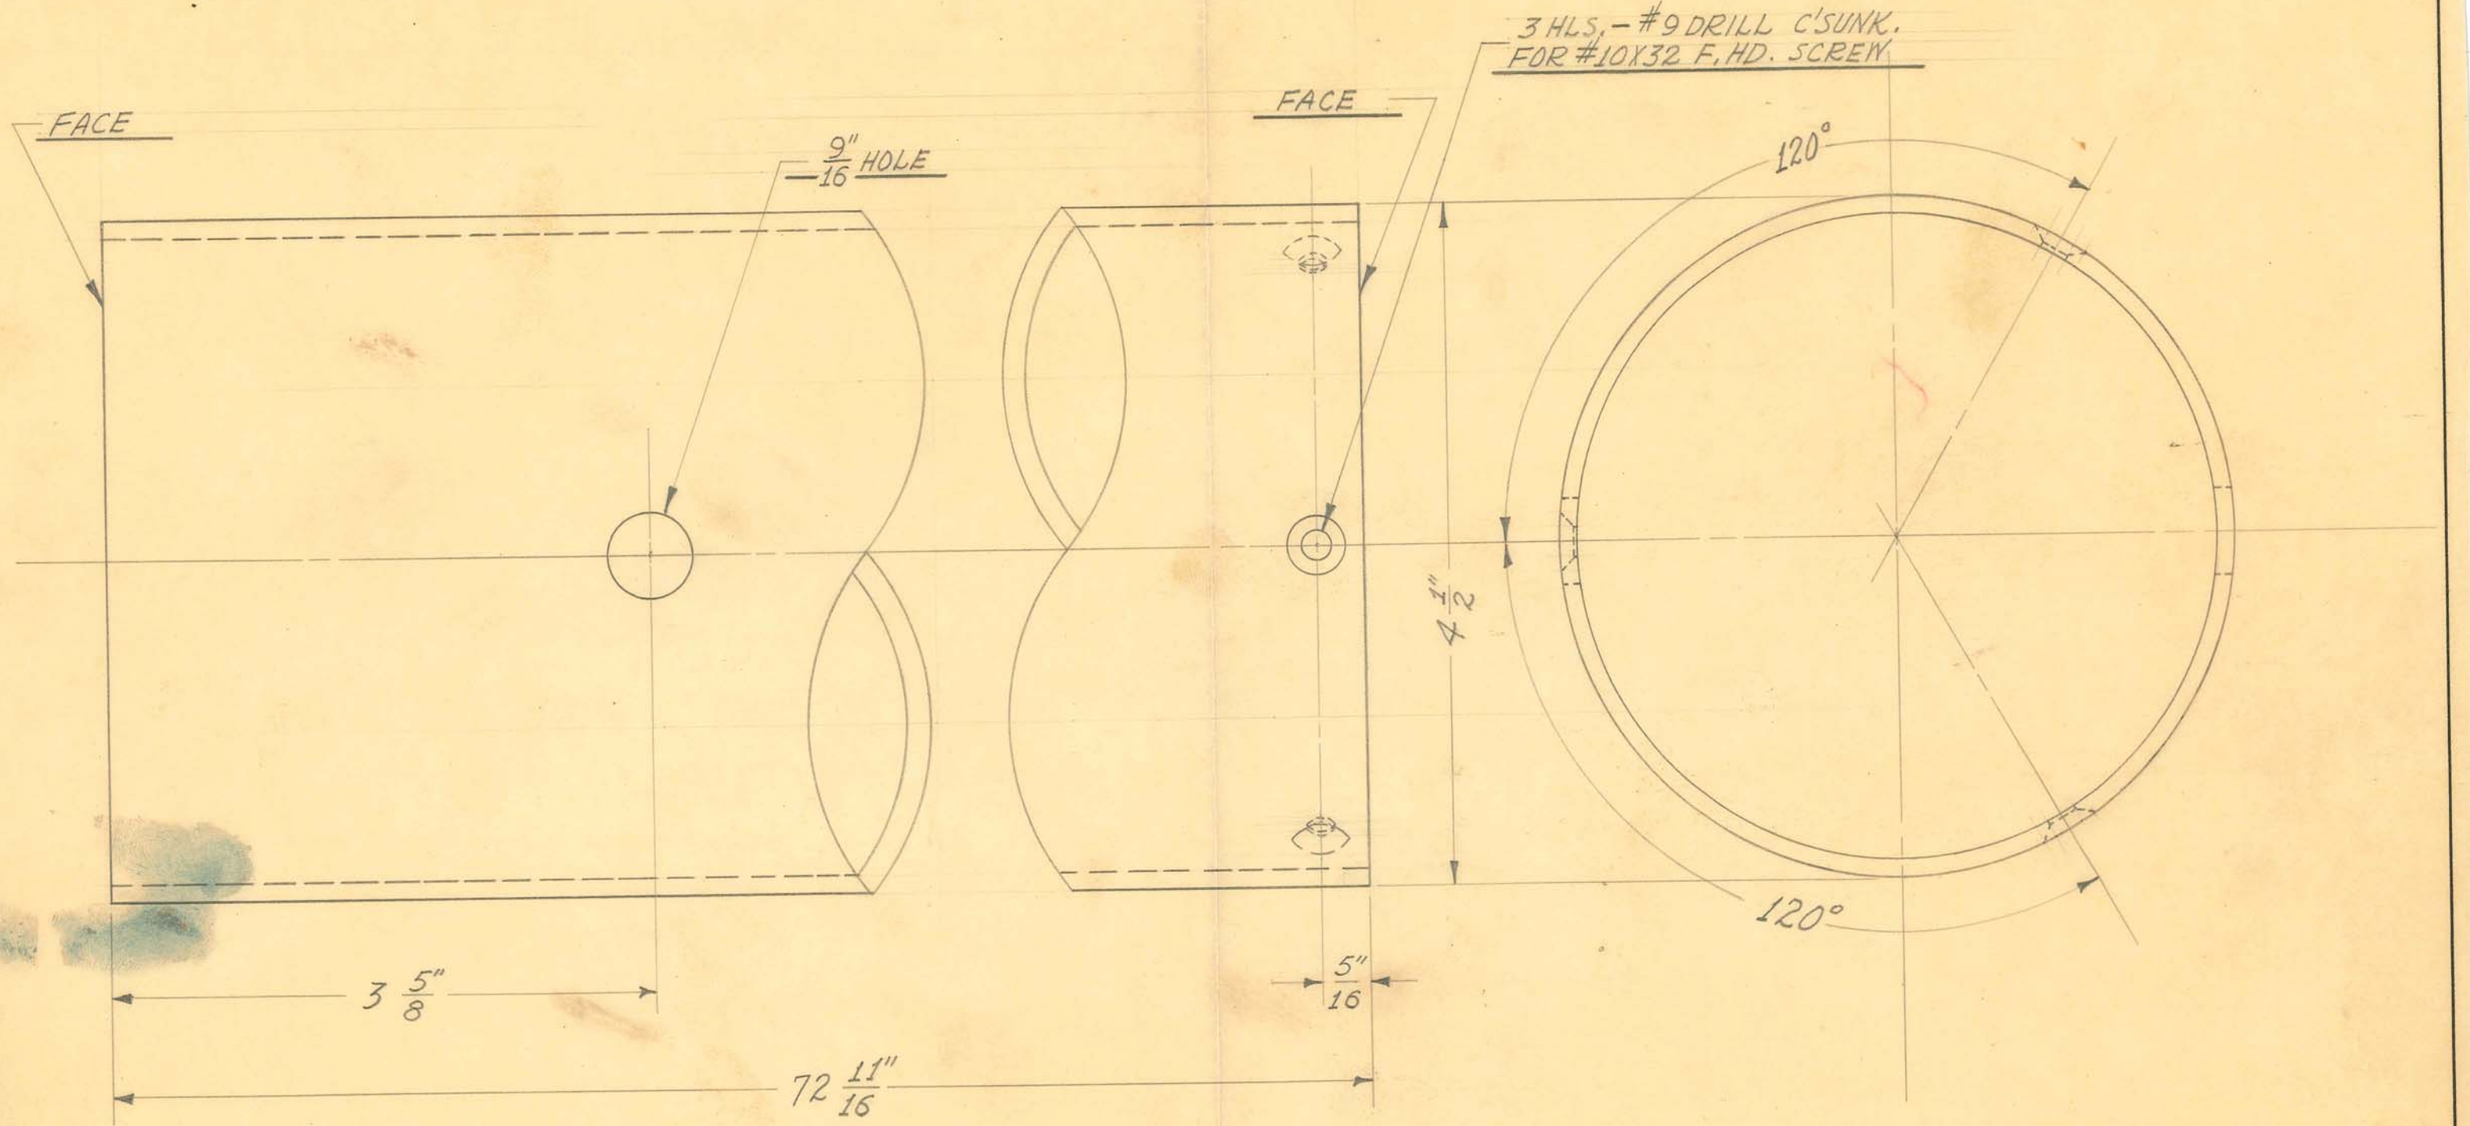

4 1/2" O.D. X #11 GA. WALL SHELBY SEAMLESS STEEL TUBING

1 REQUIRED

OBSOLETE

SIZE		ISSUE 7-3-40	J.W.	TITLE: FISCHER MOD. "200" X-RAY UNIT INNER UPRIGHT TUBE
KIND		CHANGED		
SHAPE		"		
FINISH		"		
TEMP.		"		
PATT.		"		

H. G. FISCHER & CO.
2335 WABANSIA AVE.
CHICAGO, ILL.

CAT. NO.

PART NO. 13309

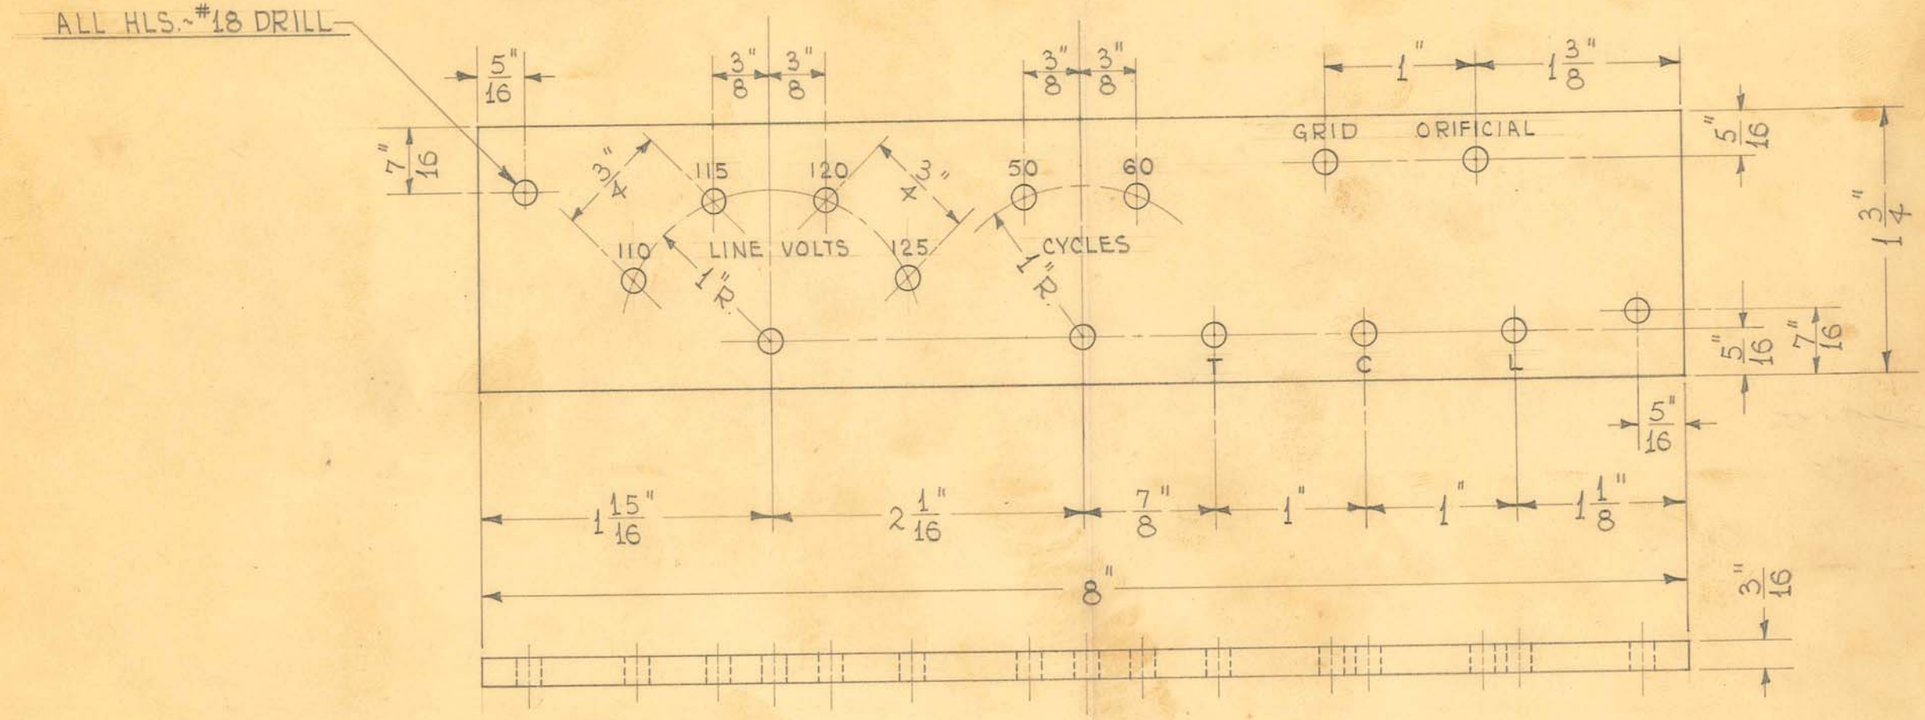

1 REQUIRED

OBSOLETE

SIZE	3/16" SHEET	ISSUE 10-8-43	HE.
KIND	BLK. BAKELITE	CHANGED	
SHAPE		"	
FINISH		"	
TEMP.		"	
PATT.		"	

TITLE: FISCHER MODEL "CK" LAMP ~ TERMINAL BOARD (FOR SPECIAL VOLTAGES)

H. G. FISCHER & CO.
2335 WABANSIA AVE.
CHICAGO, ILL.

CAT. NO.

PART NO. 13534

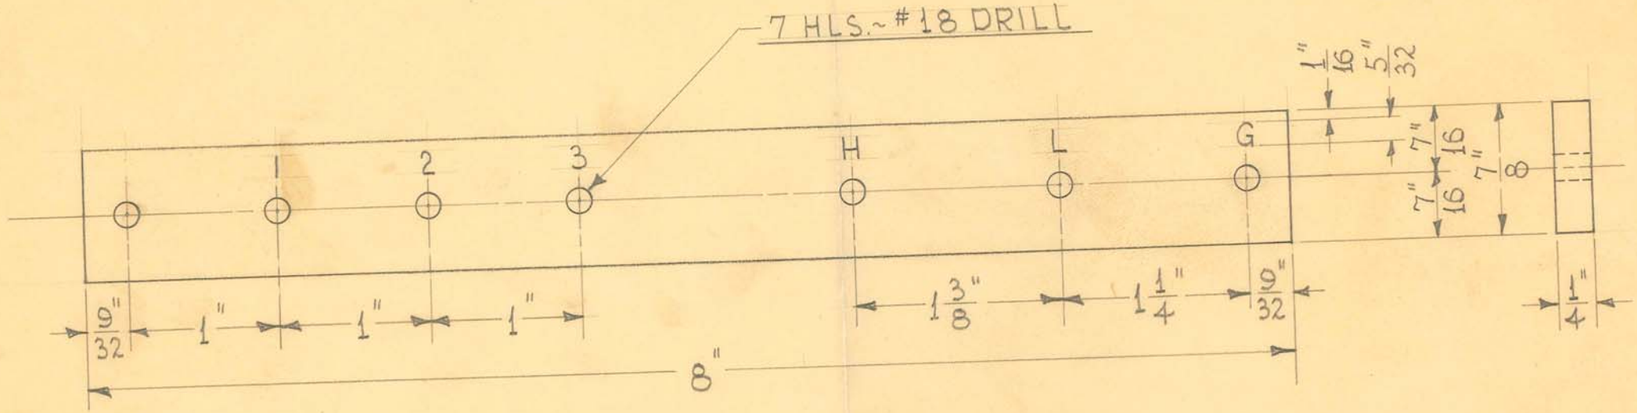

1 REQUIRED

OBSOLETE

Obsolete

SIZE	1/4" SHEET	ISSUE 11-9-43	HE.
KIND	BLK. BAKELITE	CHANGED	
SHAPE		"	
FINISH		"	
TEMP.		"	
PATT.		"	

TITLE: FISCHER MOD. "CK" COLD QUARTZ LAMP~ TERMINAL BOARD

H. G. FISCHER & CO.
2335 WABANSIA AVE.
CHICAGO, ILL.

CAT. NO.

PART NO. 13534 1/2

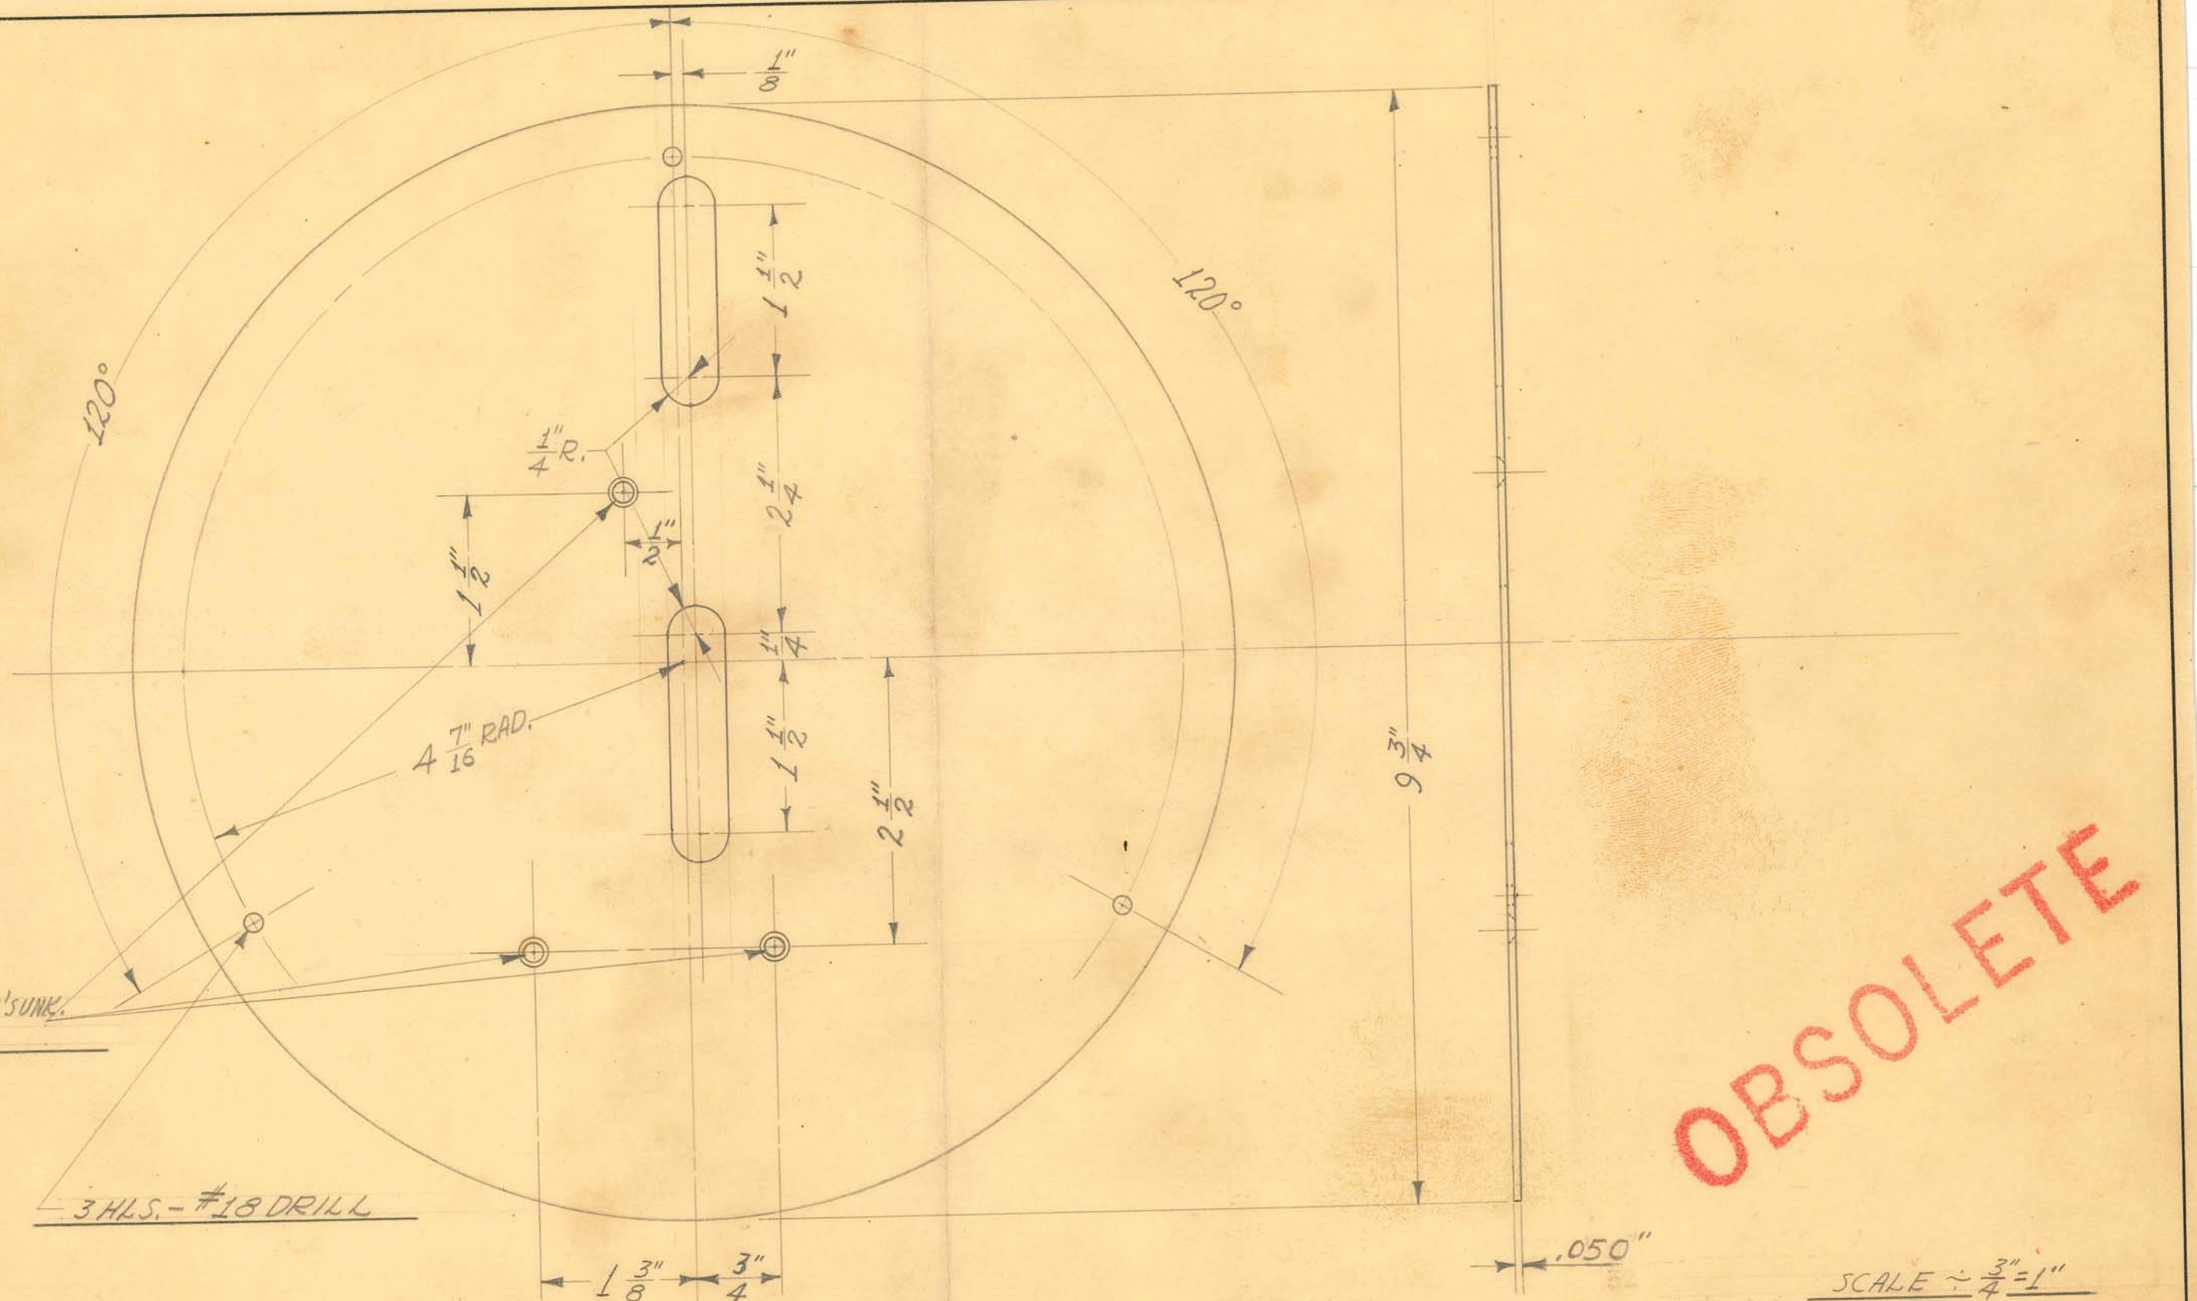

OBSOLETE

SCALE ~ 3/4" = 1"

1 REQUIRED

FROM #11863

SIZE		ISSUE 10-17-40	J.Y.W.
KIND		CHANGED	
SHAPE		"	
FINISH	SAL SODA	"	
TEMP.	DIP #40	"	
PATT.		"	

TITLE: FISCHER MOD. "CK" COLD QUARTZ - ULTRA VIOLET LAMP - GRID BURNER MOUNTING PLATE

H. G. FISCHER & CO.
2335 WABANSIA AVE.
CHICAGO, ILL.

CAT. NO.

PART NO. 13521

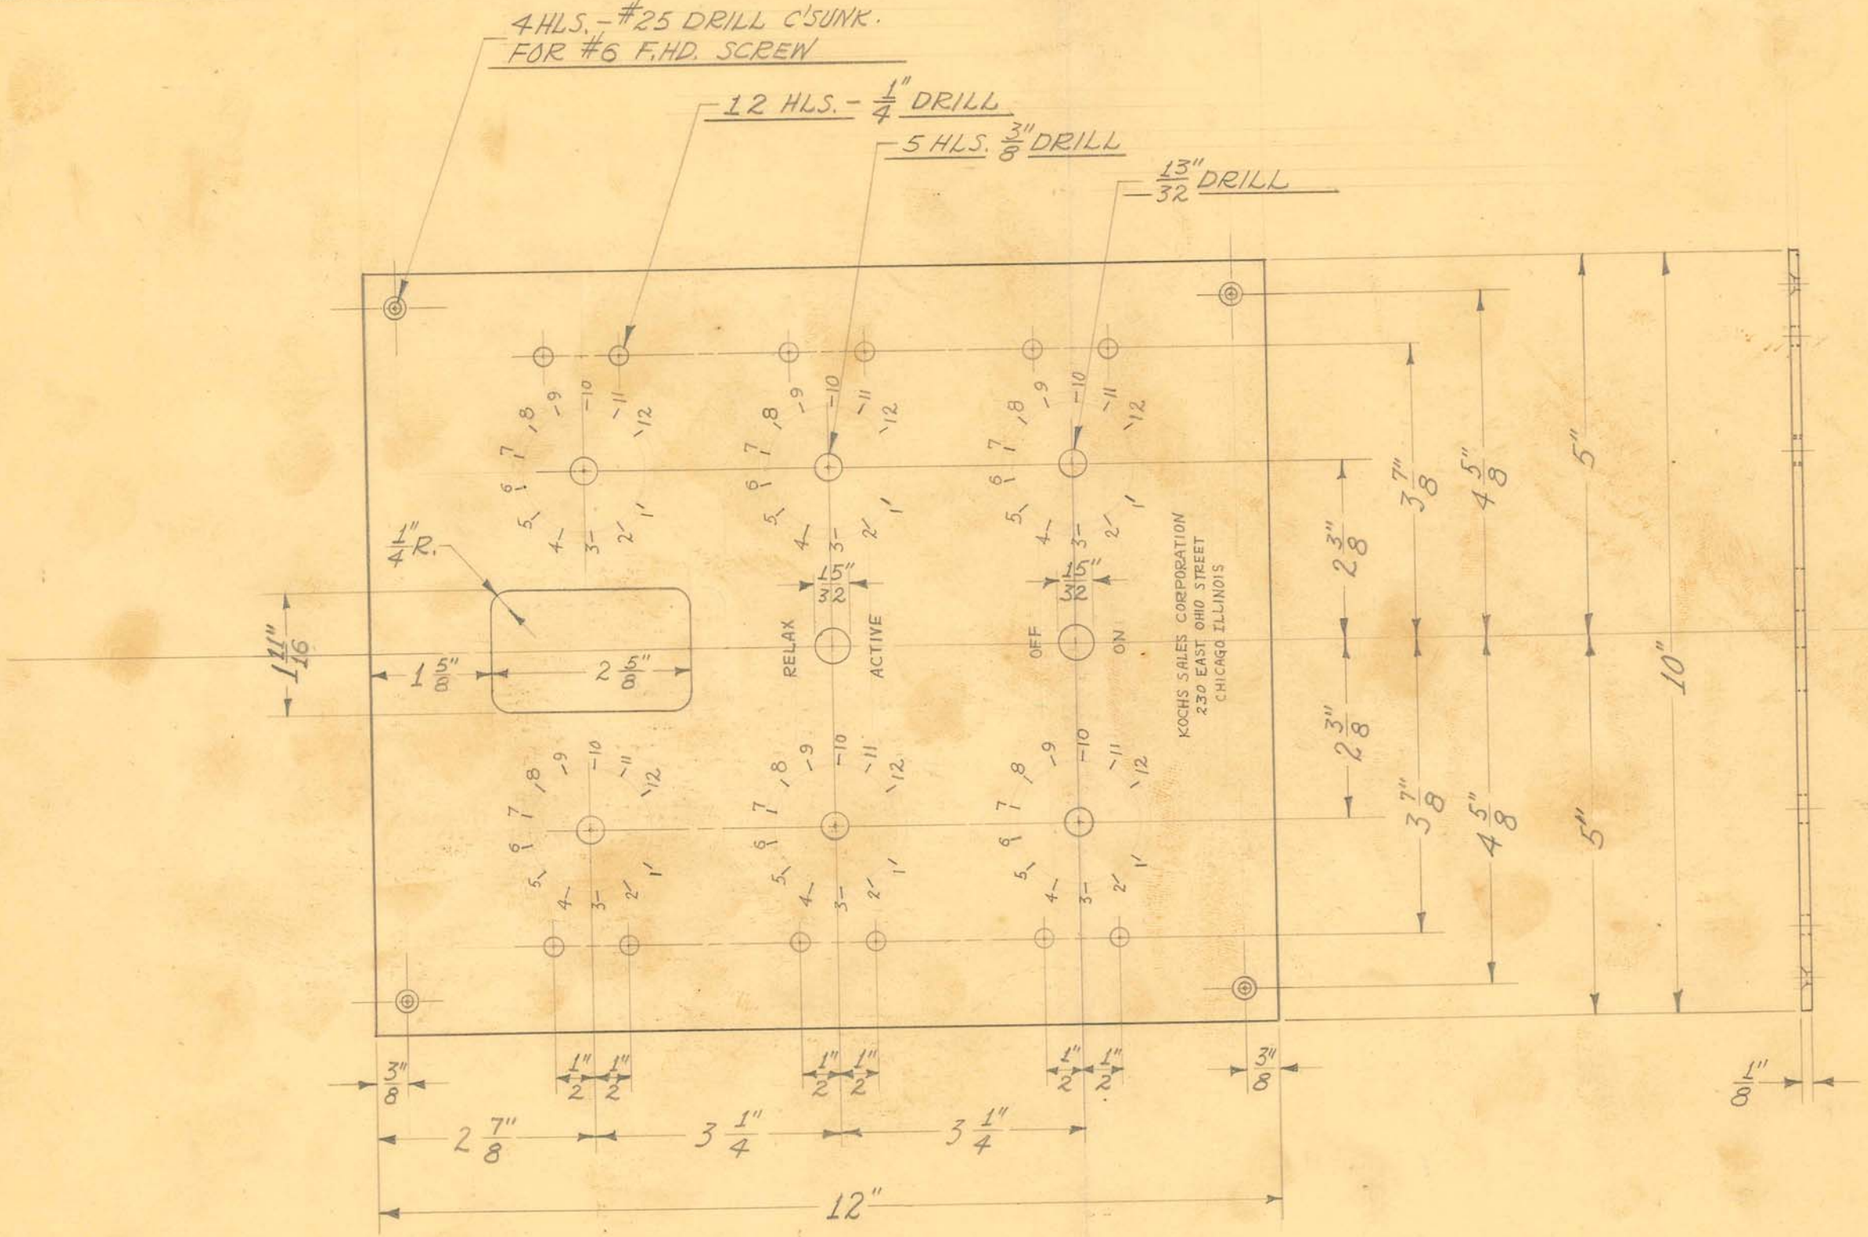

1 REQUIRED

SCALE ÷ 1/2 SIZE

OBSOLETE

SIZE	1/8" SHEET	ISSUE 10-10-40	J.V.W.	TITLE: KOCHS FIGURE CONTROL-BAKELITE PANEL (DRILLED & ENGRAVED)
KIND	LAMICOID	CHANGED		
~~STOCK~~	(BLACK)	"		
FINISH		"		
TEMP.		"		
PATT.		"		

H. G. FISCHER & CO.
2335 WABANSIA AVE.
CHICAGO, ILL.

CAT. NO.

PART NO. 13491F

13491F

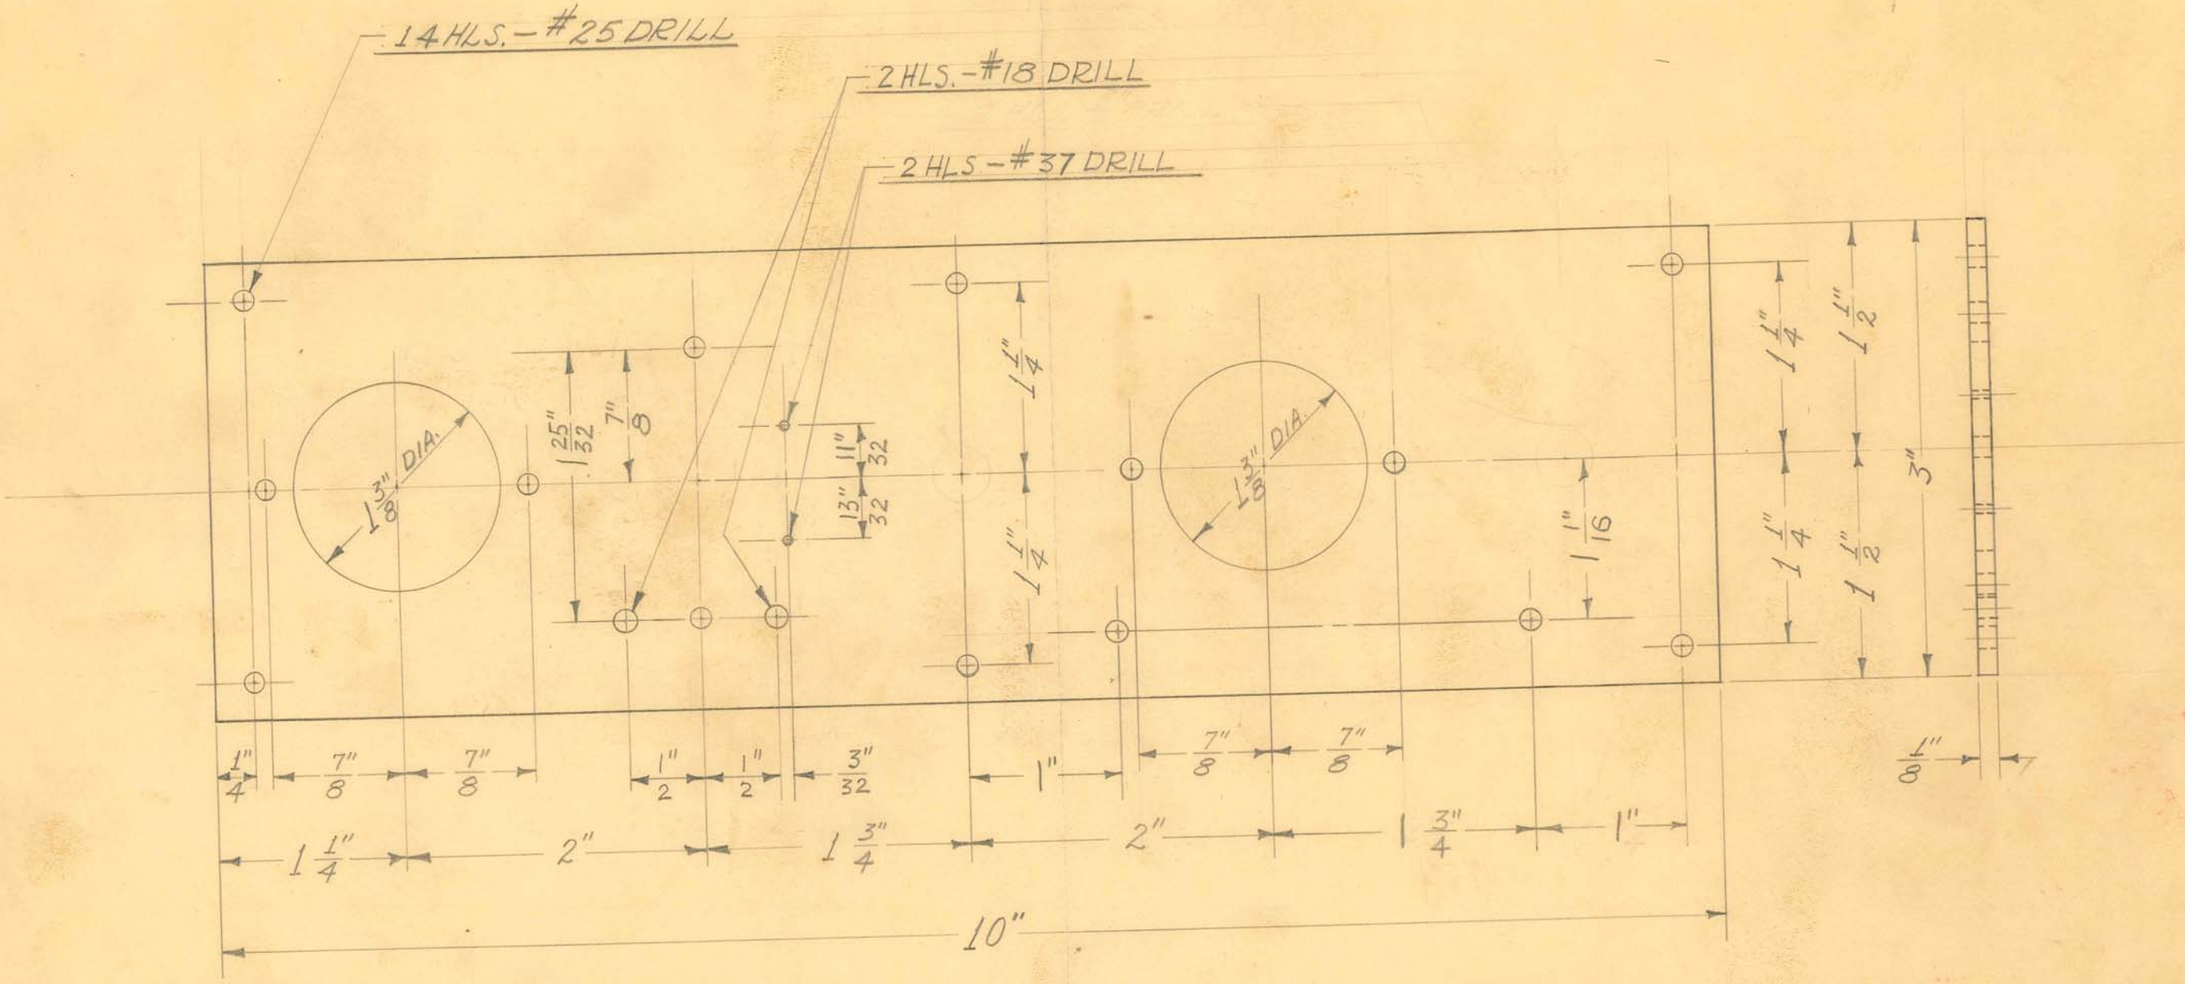

1 REQUIRED

OBSOLETE

SIZE	1/8" SHEET	ISSUE 10-10-40	J.V.W.	TITLE: KOCHS FIGURE CONTROL TUBE MOUNTING BOARD
KIND	BLK. BAKELITE	CHANGED 3-18-41	J.V.W.	
SHAPE		"		
FINISH		"		
TEMP.		"		
PATT.		"		

H. G. FISCHER & CO.
2335 WABANSIA AVE.
CHICAGO, ILL.

CAT. NO.

PART NO. 13512A

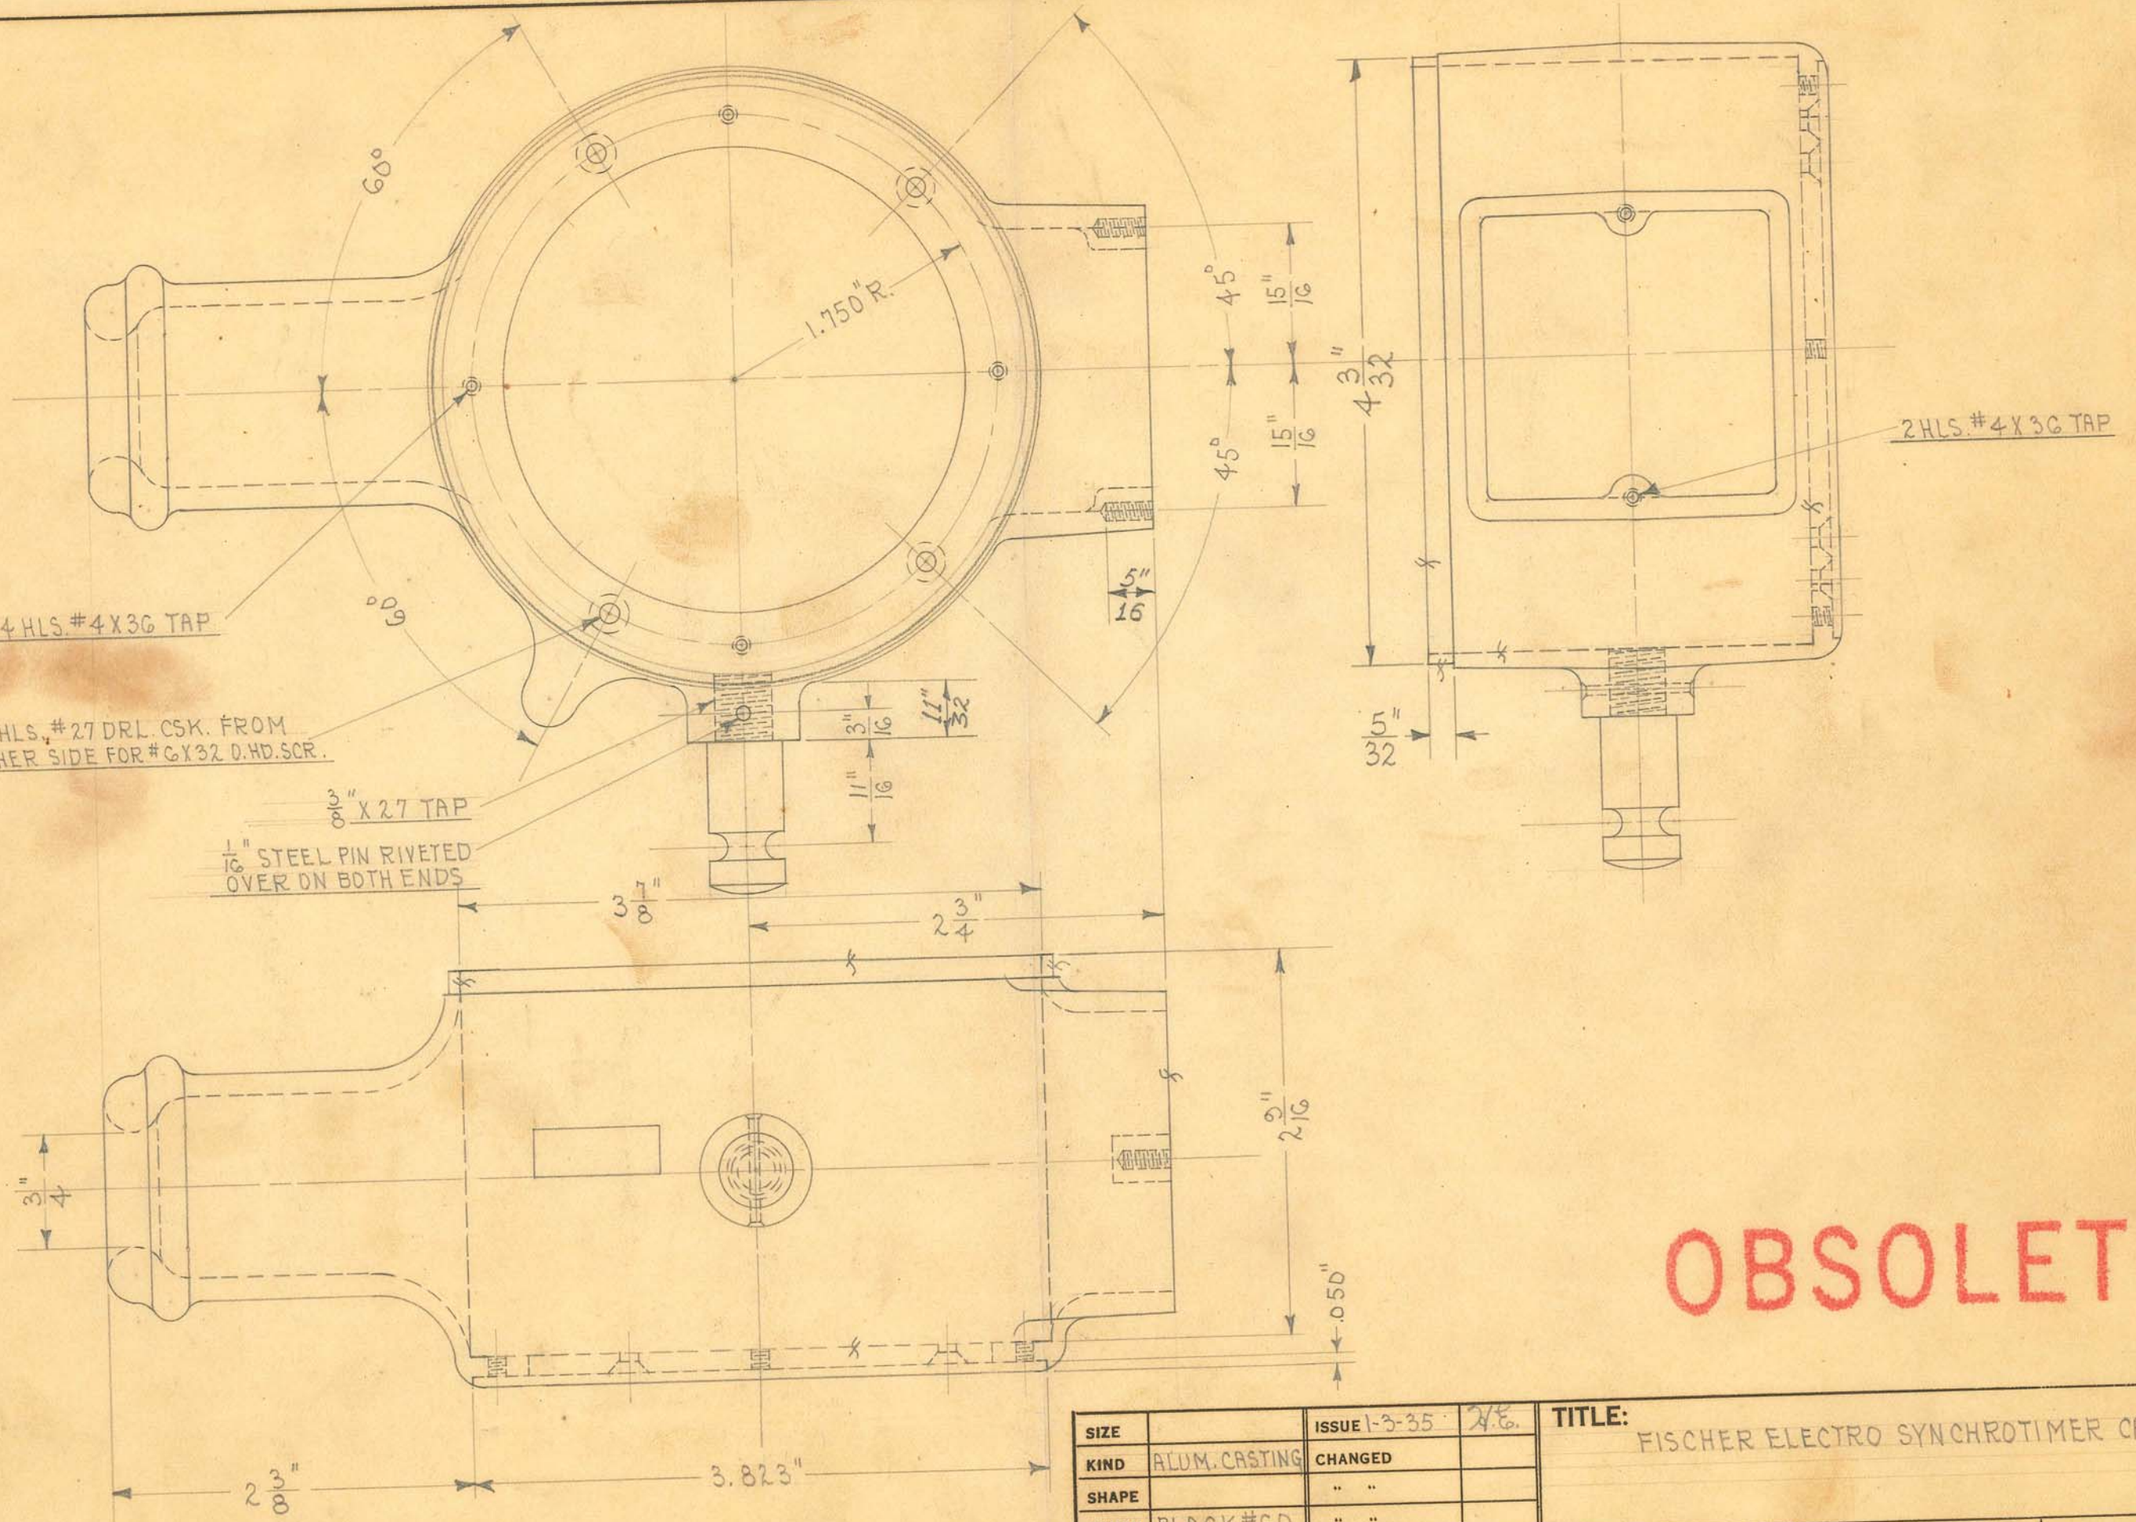

OBSOLETE

SIZE		ISSUE 1-3-35	A.E.	TITLE: FISCHER ELECTRO SYNCHROTIMER CASE
KIND	ALUM. CASTING	CHANGED		
SHAPE		" "		
FINISH	BLACK #60	" "		
TEMP.		" "		H. G. FISCHER & CO. 2335 WABANSIA AVE. CHICAGO, ILL. — CAT. NO. — PART NO. 90196
PATT.	3271-763	" "		

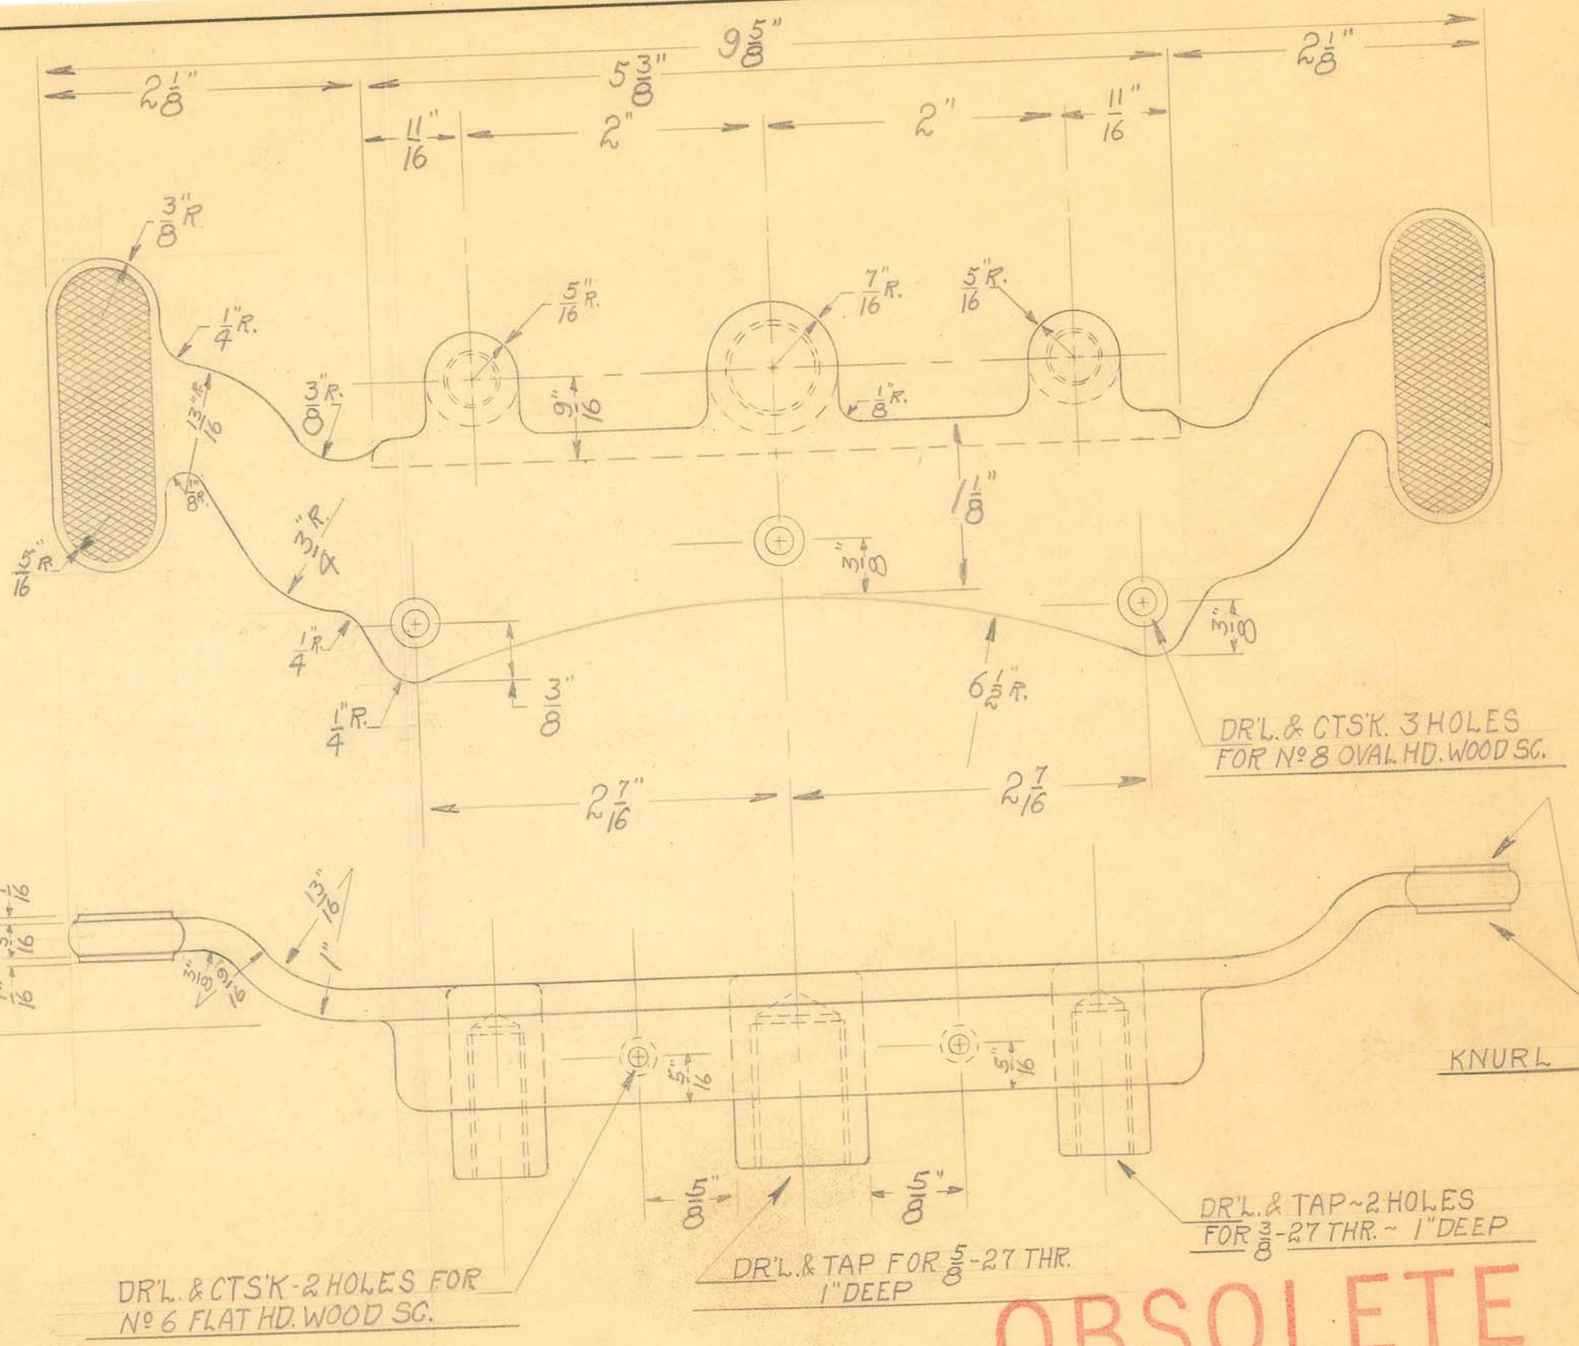

OBSOLETE

DATE: 6-6-32

SIZE	1"-1"	ISSUE	
KIND		CHANGED	
SHAPE		" "	
FINISH	CRYS. BLACK	" "	
TEMP.		" "	
PATT.		" "	

TITLE: FISCHER SAFETY FOOT X-RAY UNIT BELLOWS HANDLE

H. G. FISCHER & CO.
2335 WABANSIA AVE.
CHICAGO, ILL.

CAT. NO.

PART NO. 7605F

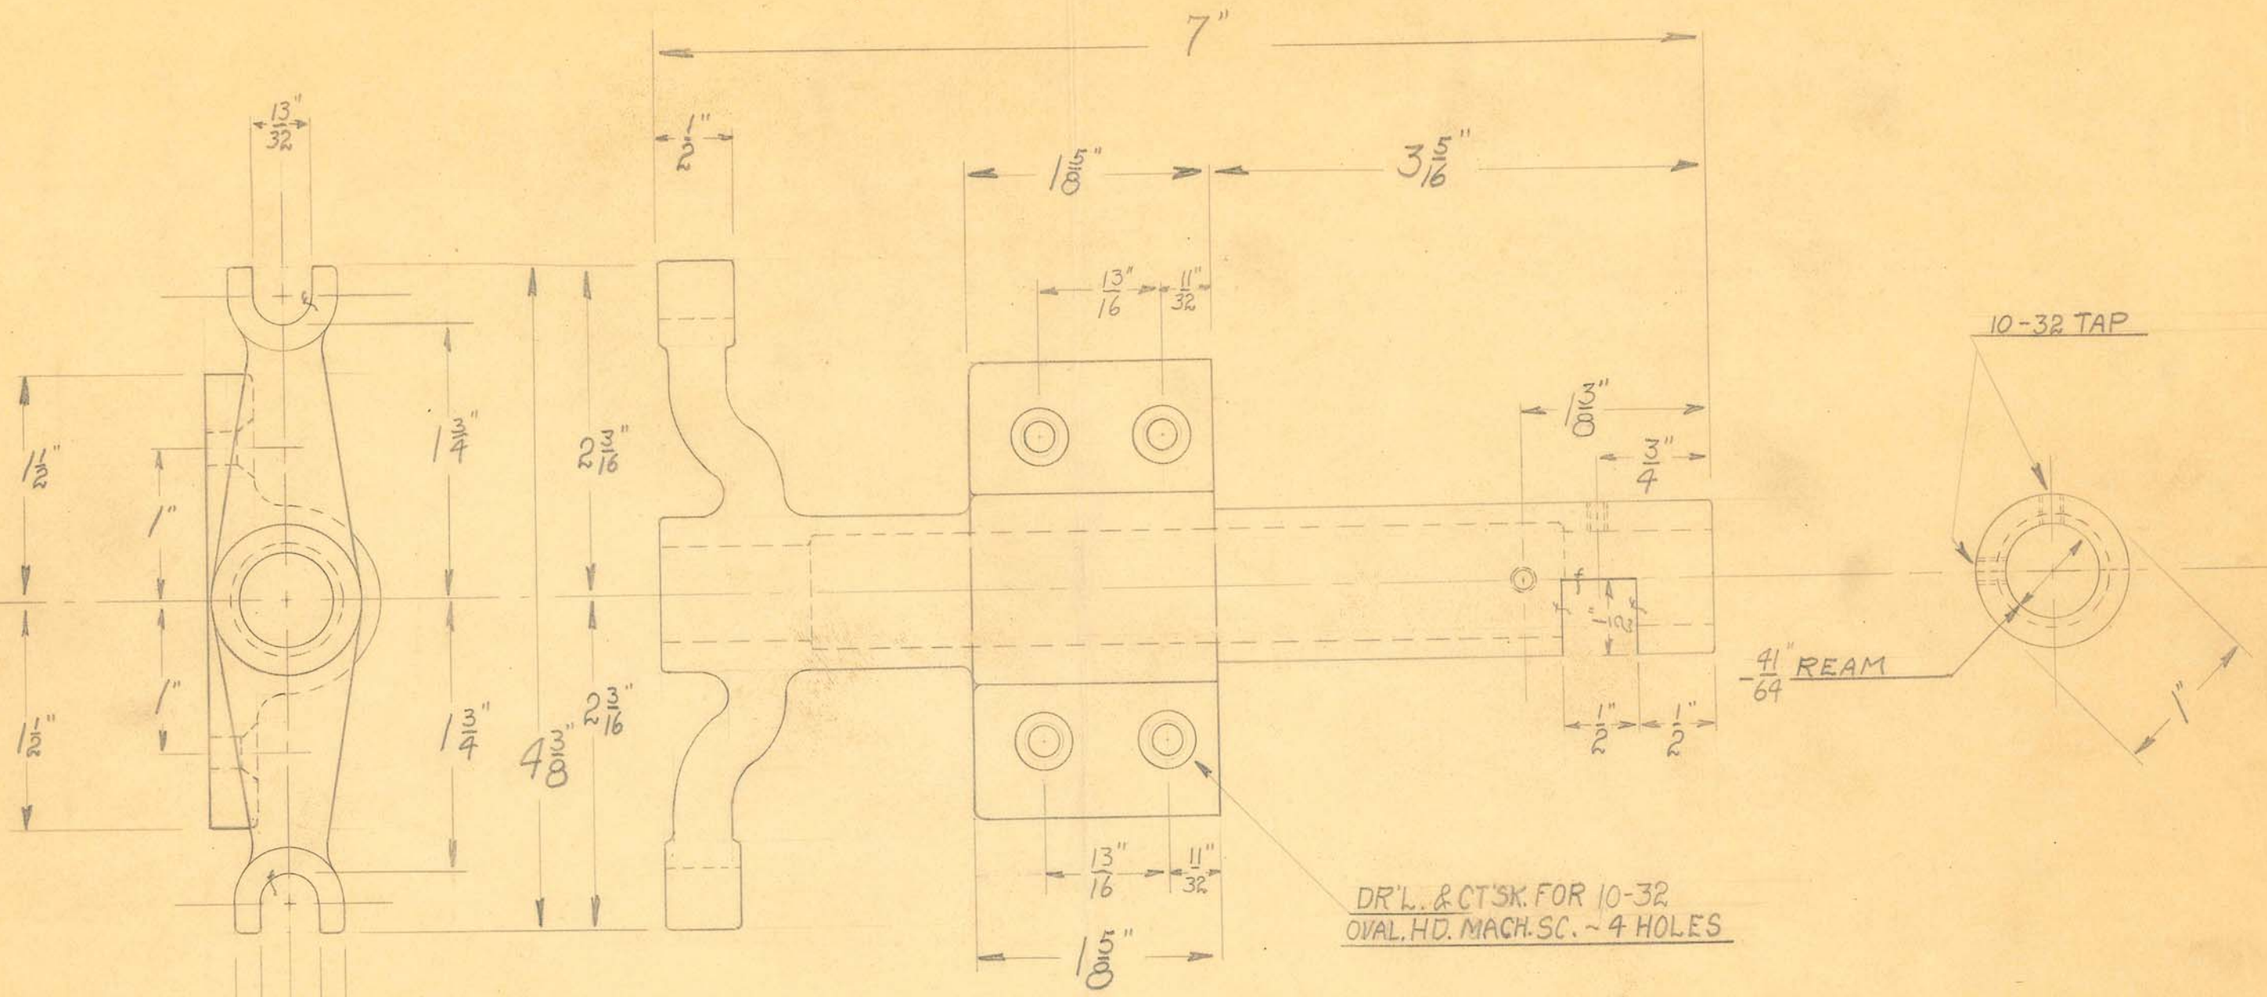

OBSOLETE

SIZE		ISSUE	
KIND		CHANGED	
SHAPE		" "	
FINISH	CRYS. BLACK	" "	
TEMP.		" "	

TITLE: FISCHER SAFETY FOOT X-RAY UNIT BELLOWS GUIDE

H. G. FISCHER & CO.
2335 WABANSIA AVE.

CAT. NO.

PART NO. 7606F

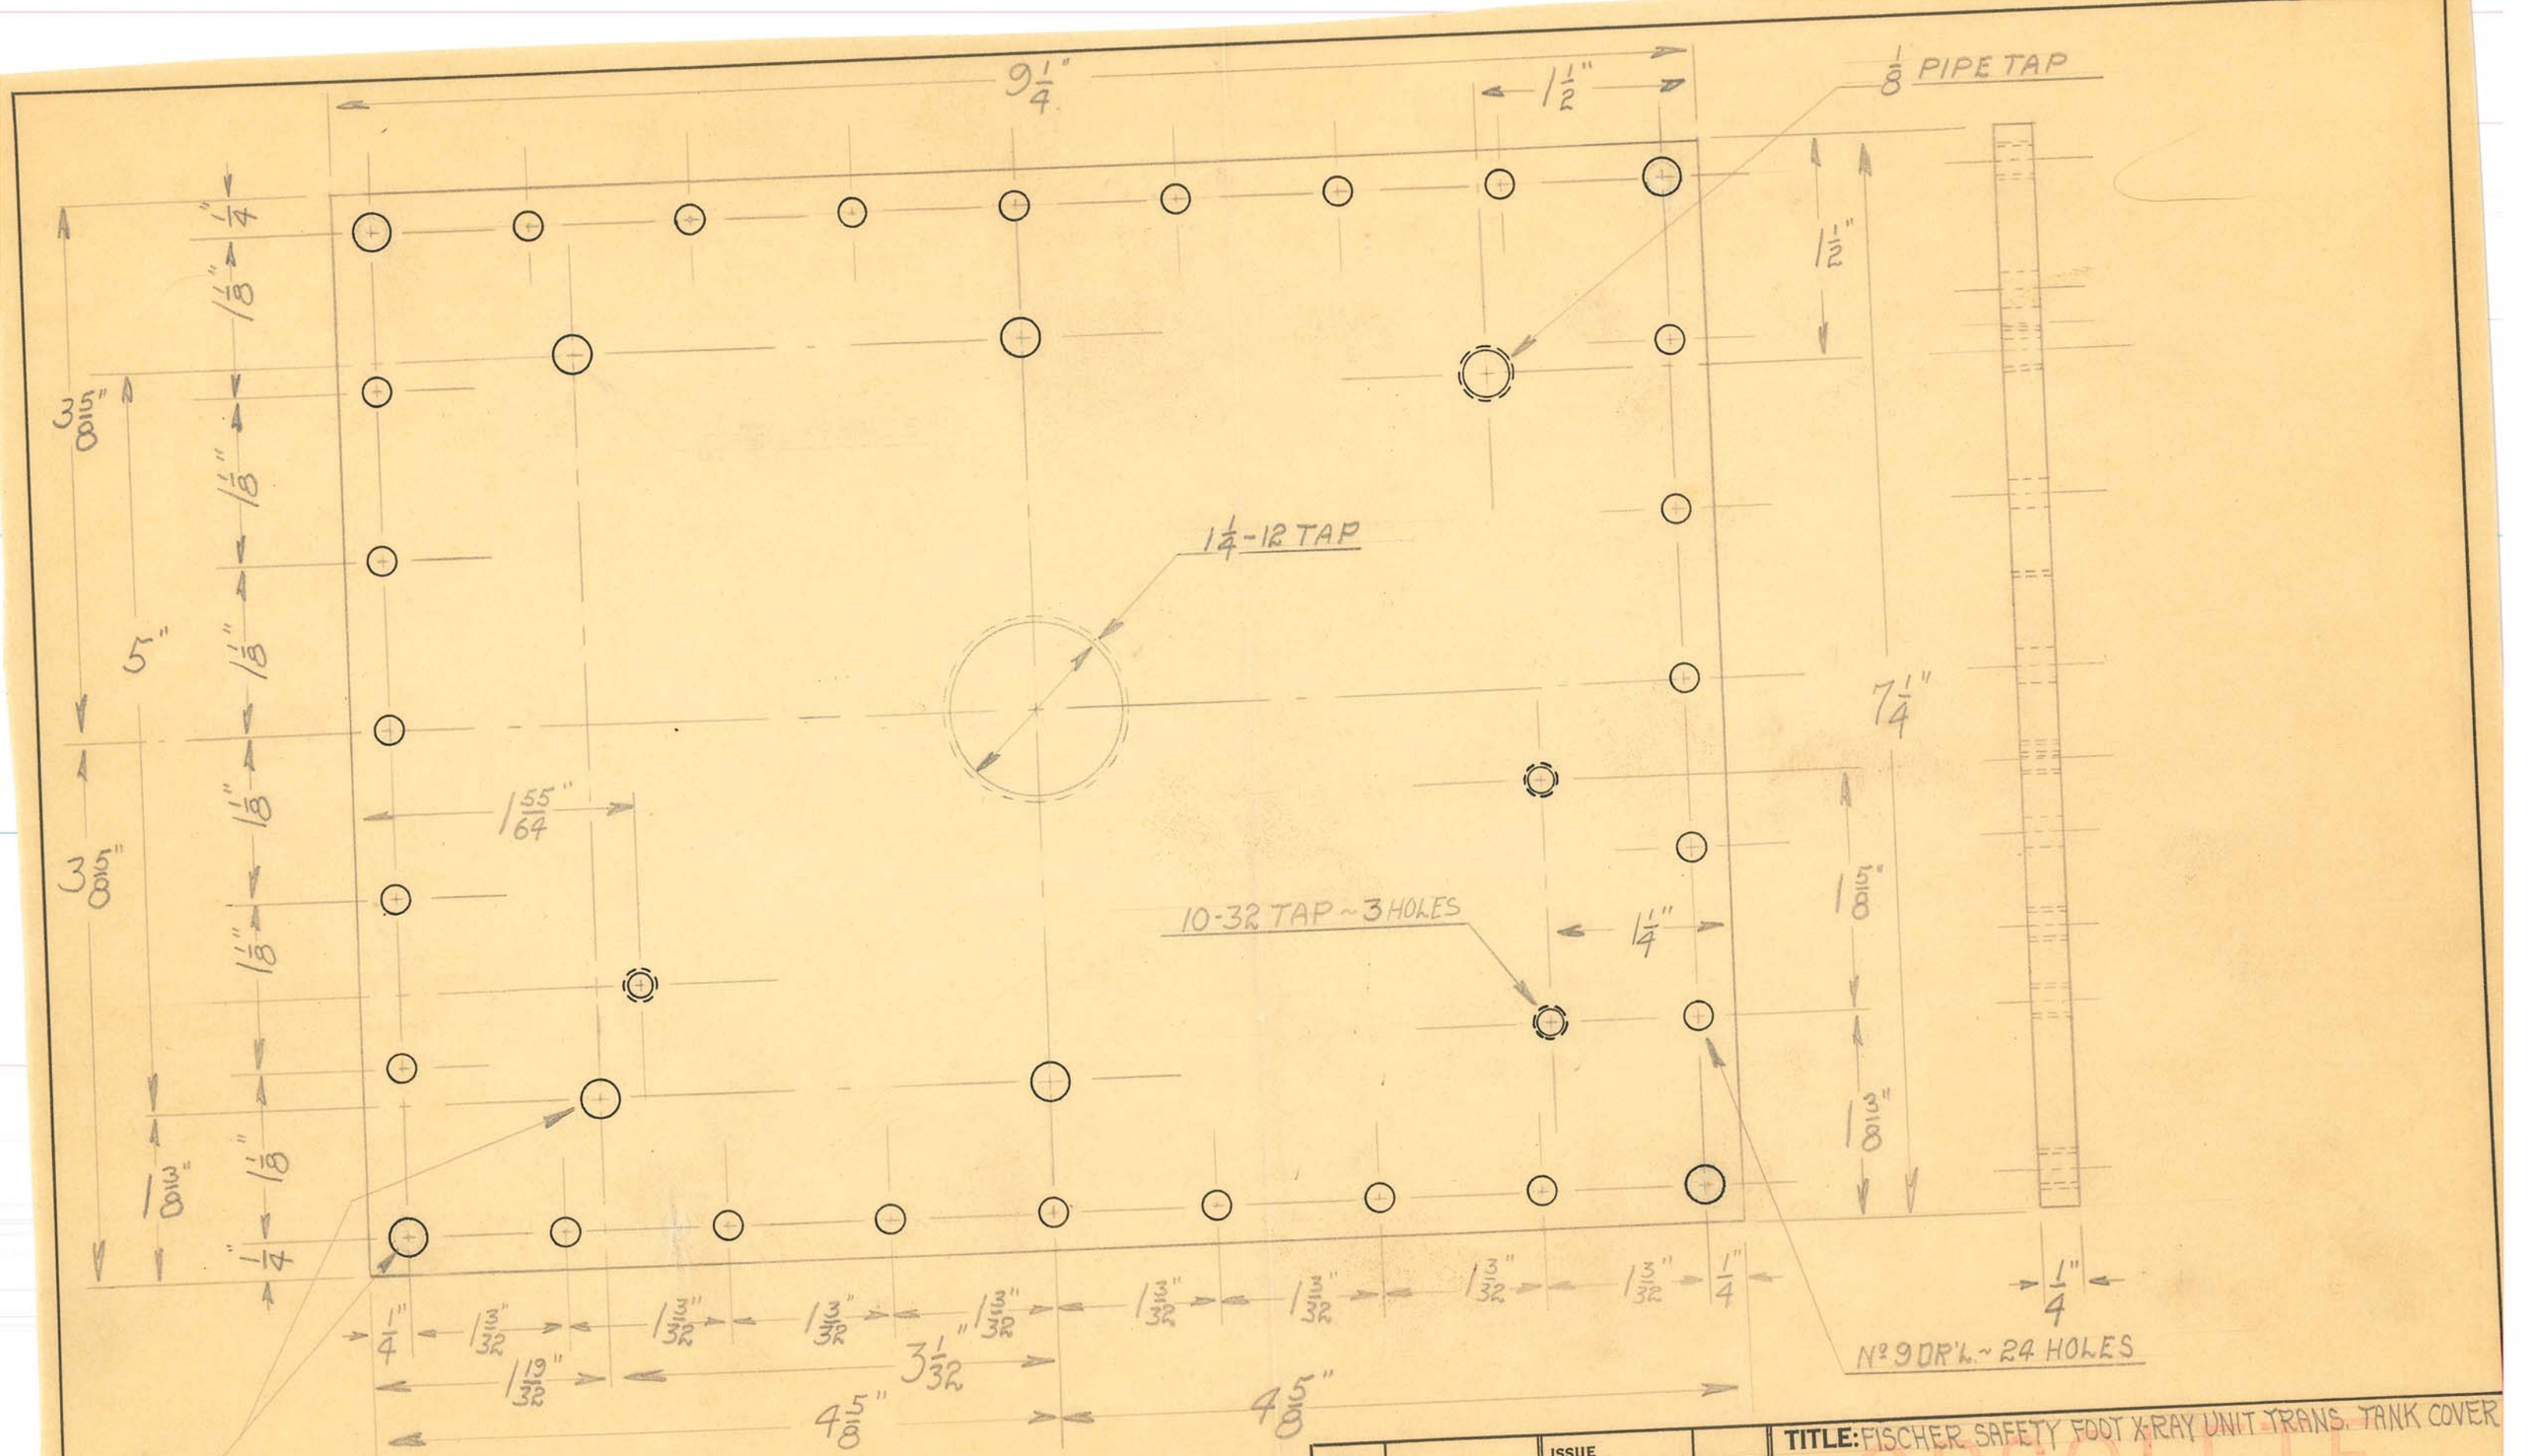

SIZE		ISSUE	
KIND		CHANGED	
SHAPE		" "	
FINISH		" "	
TEMP.		" "	
PATT.		" "	

TITLE: FISCHER SAFETY FOOT X-RAY UNIT TRANS. TANK COVER

OBSOLETE

H. G. FISCHER & CO.
2335 WABANSIA AVE.
CHICAGO, ILL.

CAT. NO.

PART NO. 7621F

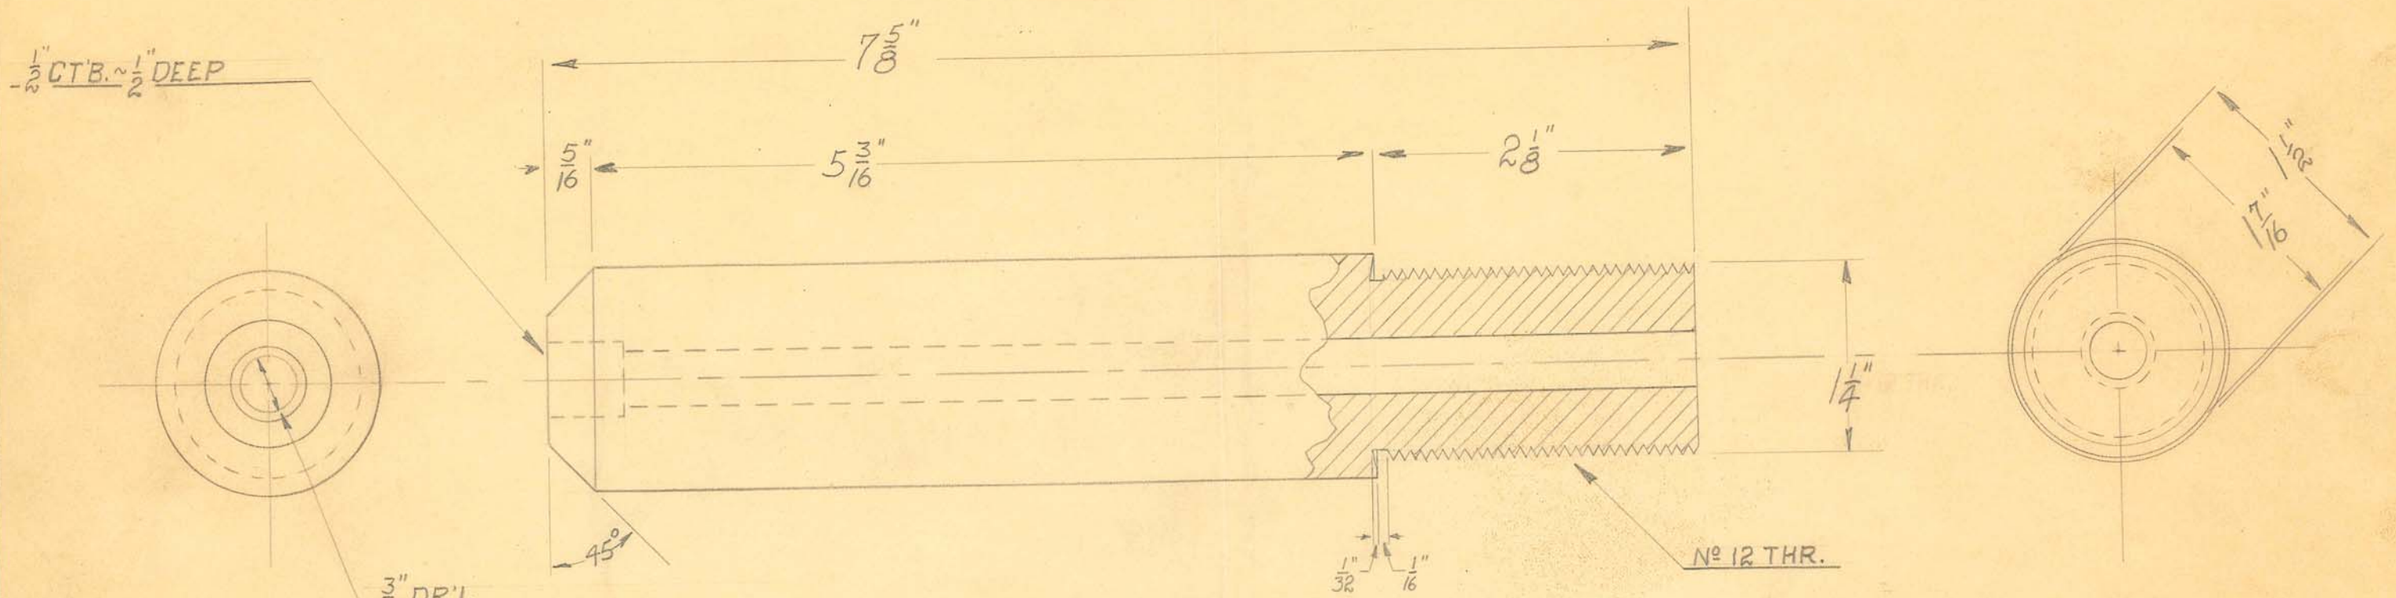

MATERIAL ~ 1½" POLISHED HARD RUBBER

1 ~ REQ'D.

SIZE		ISSUE	
KIND		CHANGED	
SHAPE		" "	
FINISH		" "	
TEMP.		" "	
PATT.		" "	

TITLE: FISCHER SAFETY FOOT X-RAY UNIT TRANS. H.T. POST

OBSOLETE

H. G. FISCHER & CO.
2335 WABANSIA AVE.
CHICAGO, ILL.

CAT. NO.

PART NO. 7622

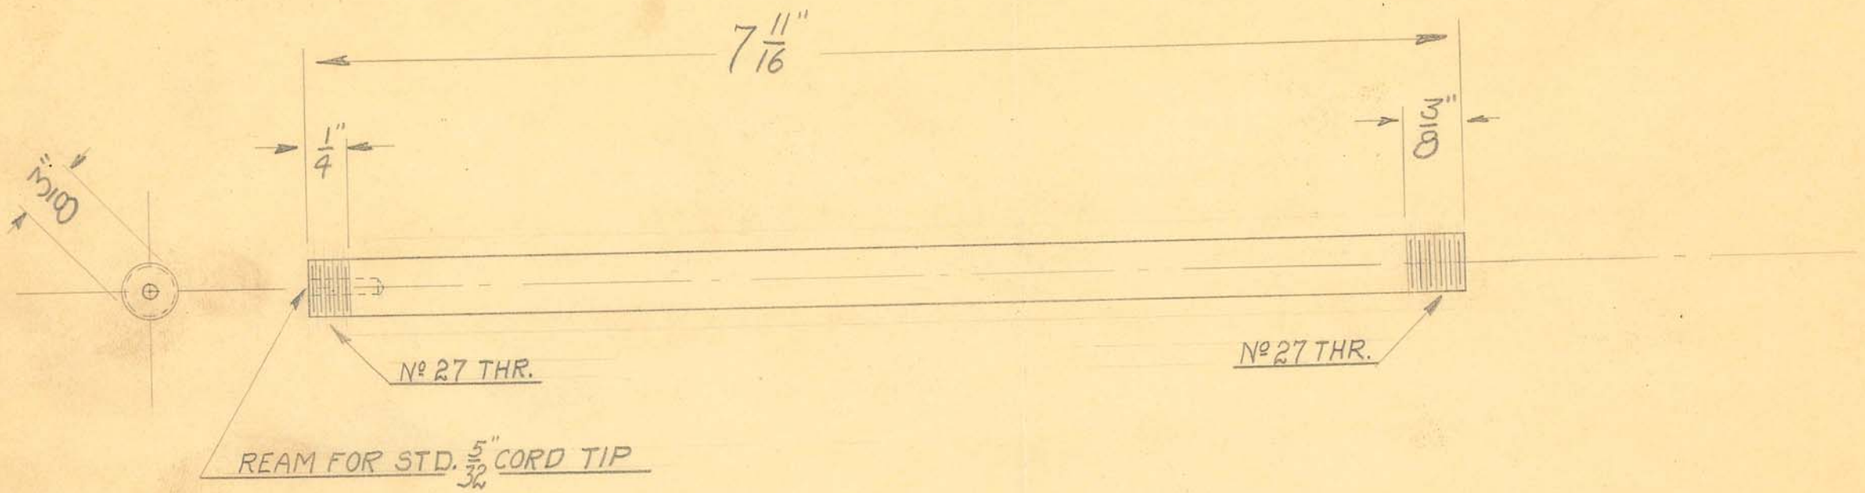

MATERIAL ~ 3/8" BRASS ROD

1 ~ REQ'D.

OBSOLETE

SIZE		ISSUE		TITLE: FISCHER SAFETY FOOT X-RAY UNIT TRANS. H.T. POST ROD
KIND		CHANGED		
SHAPE		" "		
FINISH		" "		
TEMP.		" "		H. G. FISCHER & CO. 2335 WABANSIA AVE. CHICAGO, ILL. / CAT. NO. / PART NO. 7624
PATT.		" "		

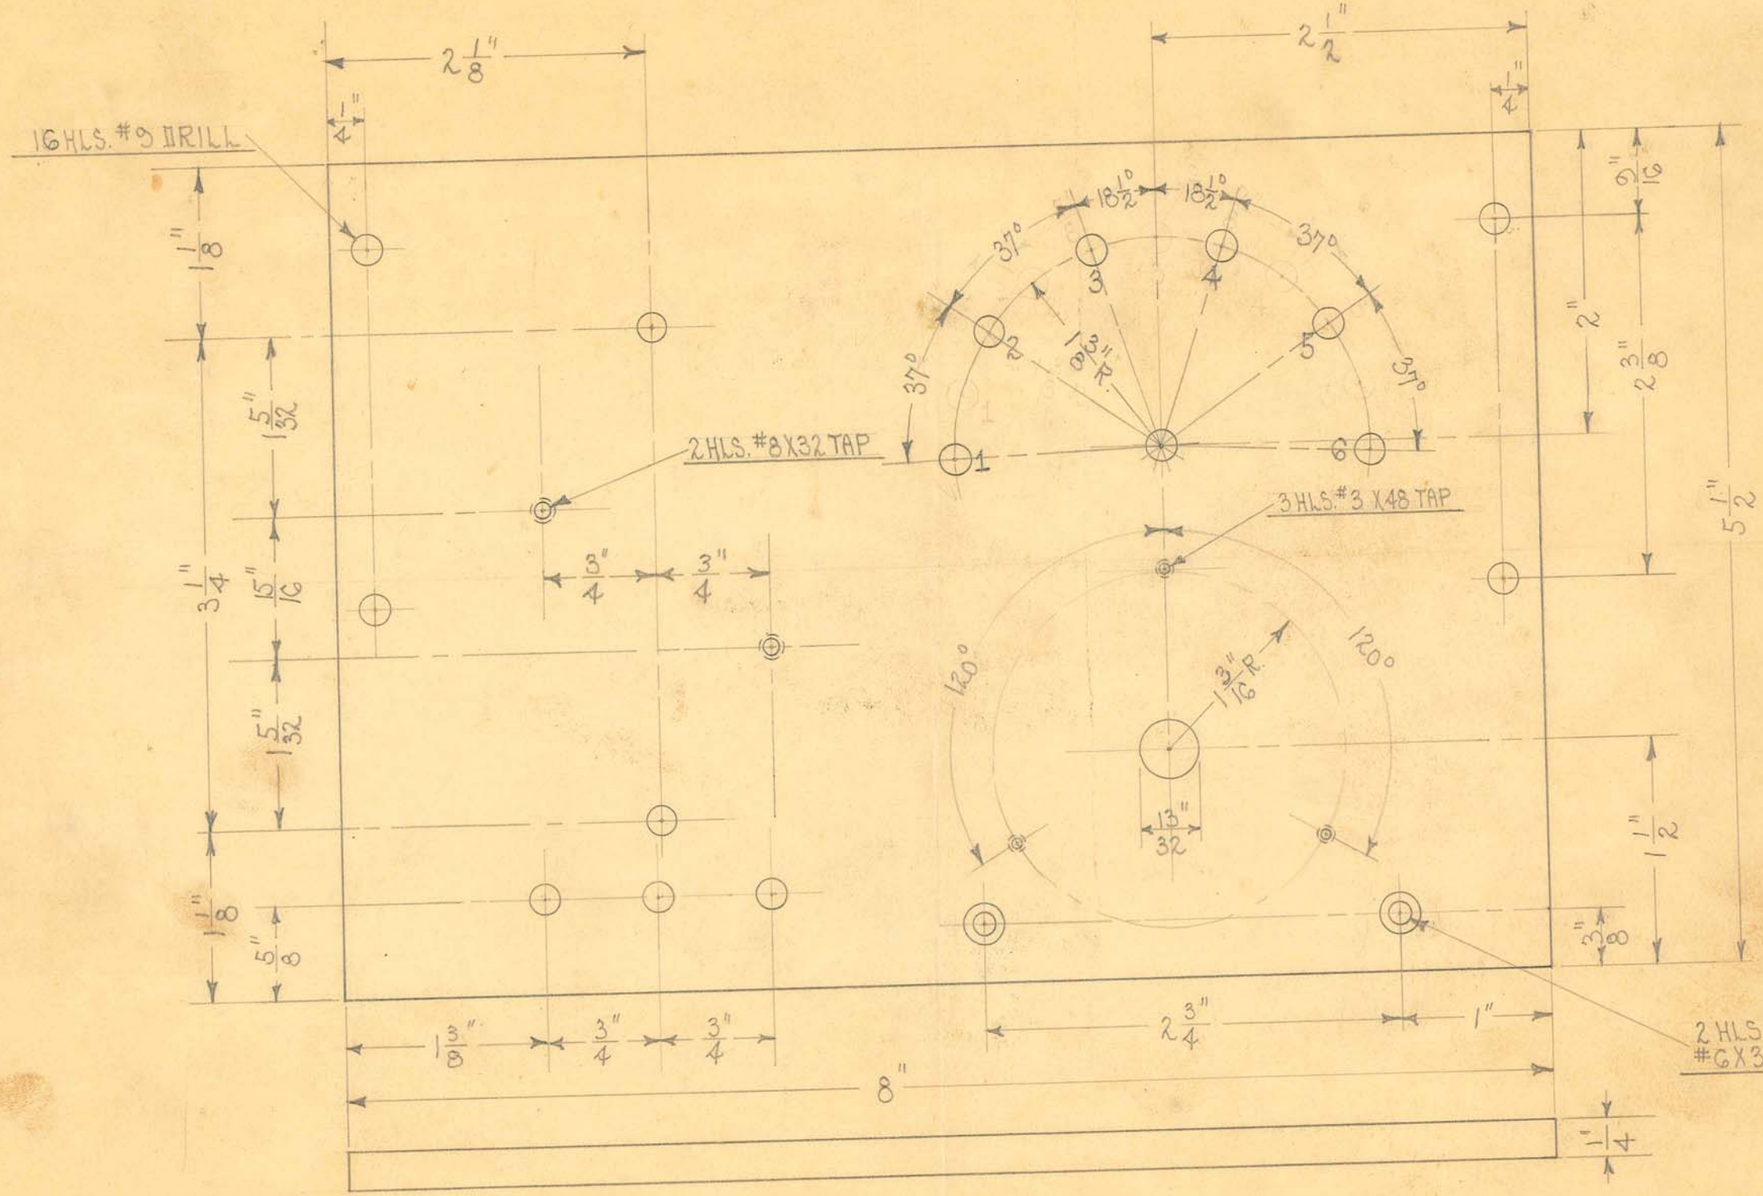

1 REQUIRED

OBSOLETE

SIZE	RICHENLAIN	ISSUE 7-6-32	A.E.	TITLE: FISCHER SAFETY FOOT X-RAY UNIT TERM. BOARD
KIND	BAKELITE (BLK)	CHANGED		
SHAPE		" "		
FINISH		" "		
TEMP.		" "		
PATT.		" "		

H. G. FISCHER & CO.
2335 WABANSIA AVE.
CHICAGO, ILL.

CAT. NO.

PART NO. 7640F

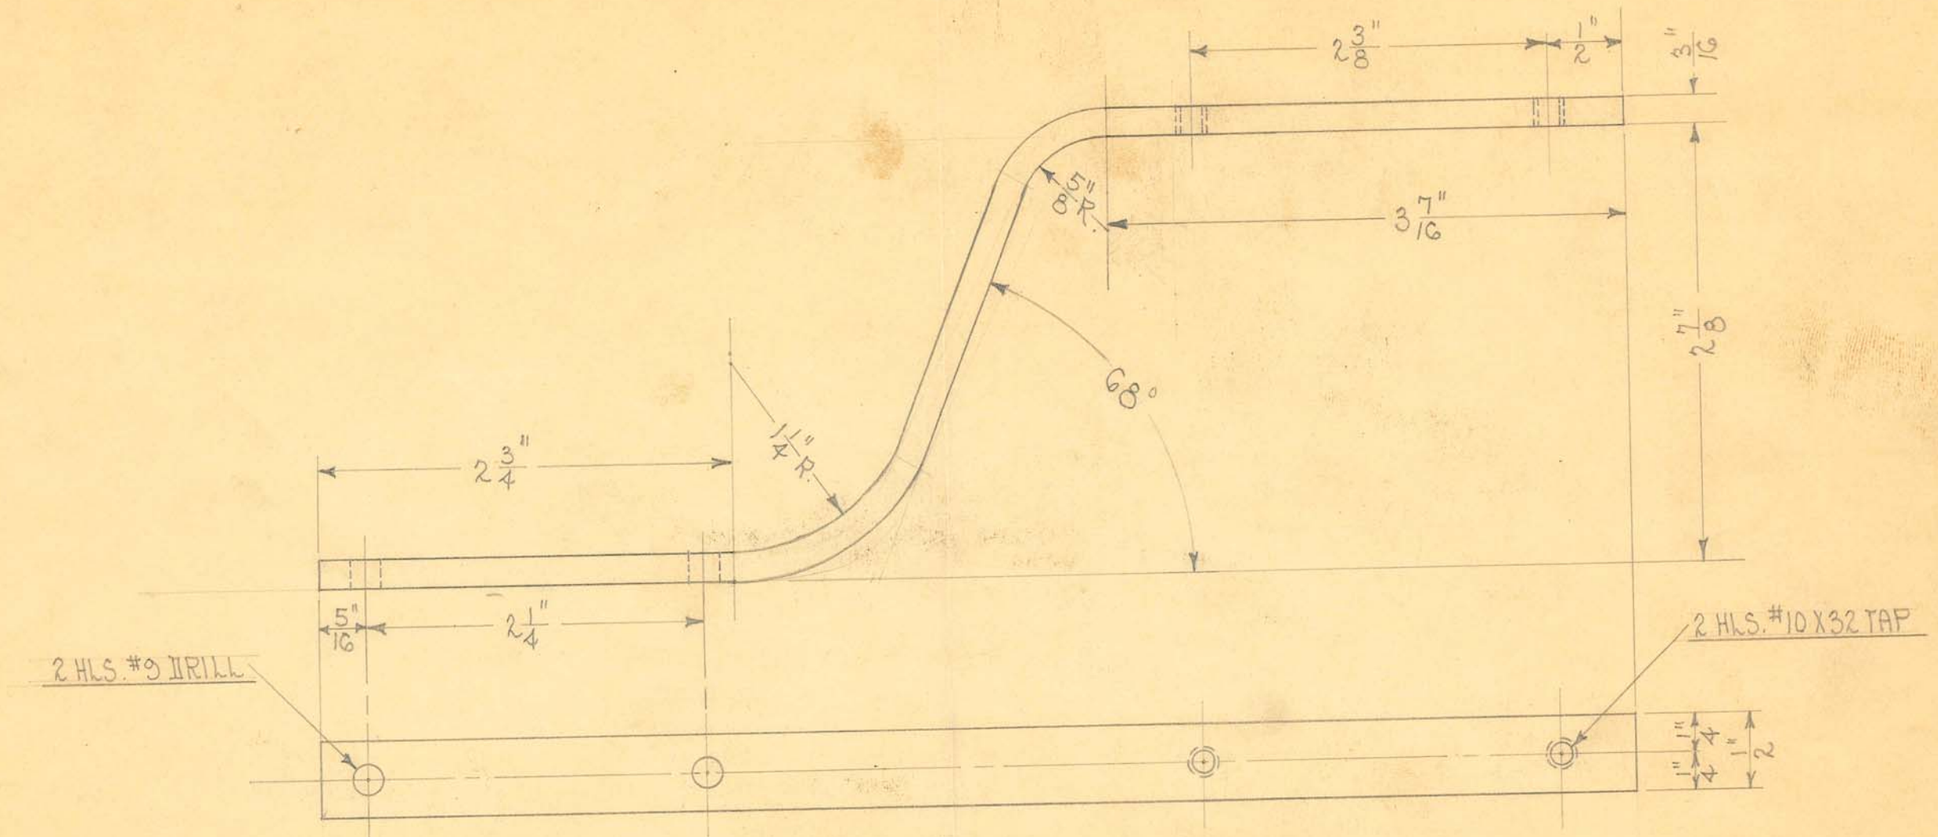

DEVELOPED LENGTH- $10\frac{11}{32}$"

2 REQUIRED

OBSOLETE

SIZE	3/16" X 1/2"	ISSUE 7-6-32	A.E.	TITLE: FISCHER SAFETY FOOT X-RAY UNIT TERM. BOARD BRACKET
KIND	COLD ROLLED	CHANGED		
SHAPE		" "		
FINISH		" "		
TEMP.		" "		H. G. FISCHER & CO. 2335 WABANSIA AVE. CHICAGO, ILL. — CAT. NO. — PART NO. 7641
PATT.		" "		

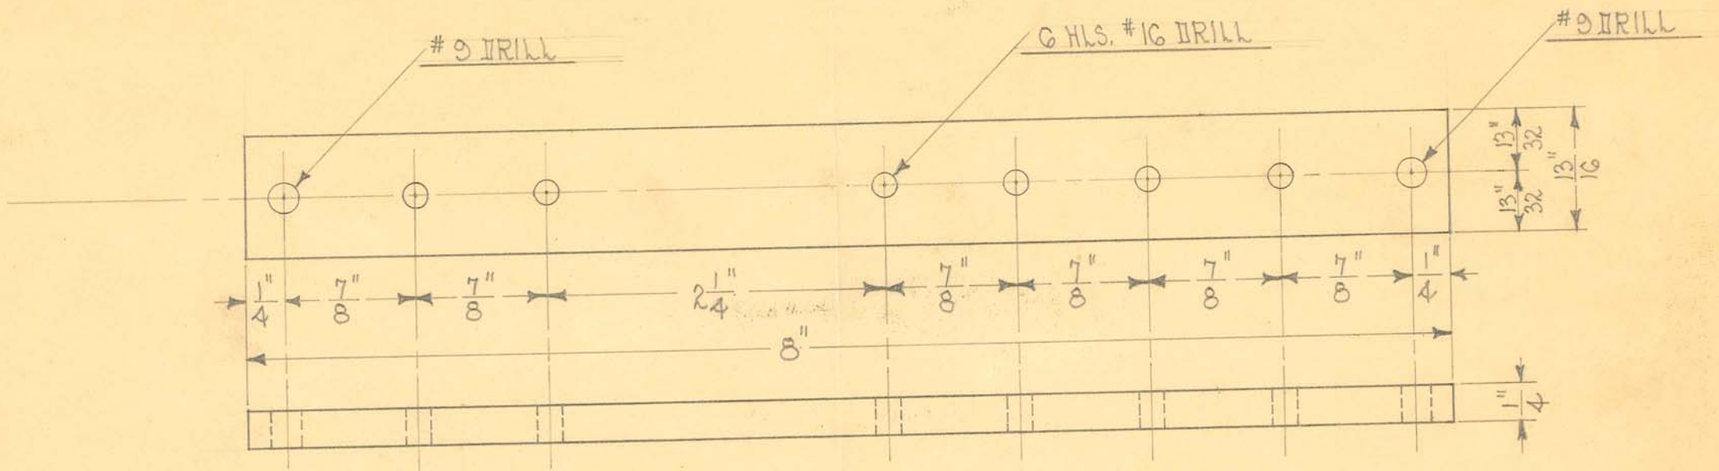

1 REQUIRED

OBSOLETE

SIZE	RICHENLAIN	ISSUE 7-5-32	A.E.	TITLE: FISCHER SAFETY FOOT X-RAY UNIT TERM. STRIP
KIND	BAKELITE BLK	CHANGED		
SHAPE		" "		
FINISH		" "		
TEMP.		" "		
PATT.		" "		

H. G. FISCHER & CO.
2335 WABANSIA AVE.
CHICAGO, ILL.

CAT. NO.

PART NO. 7642F

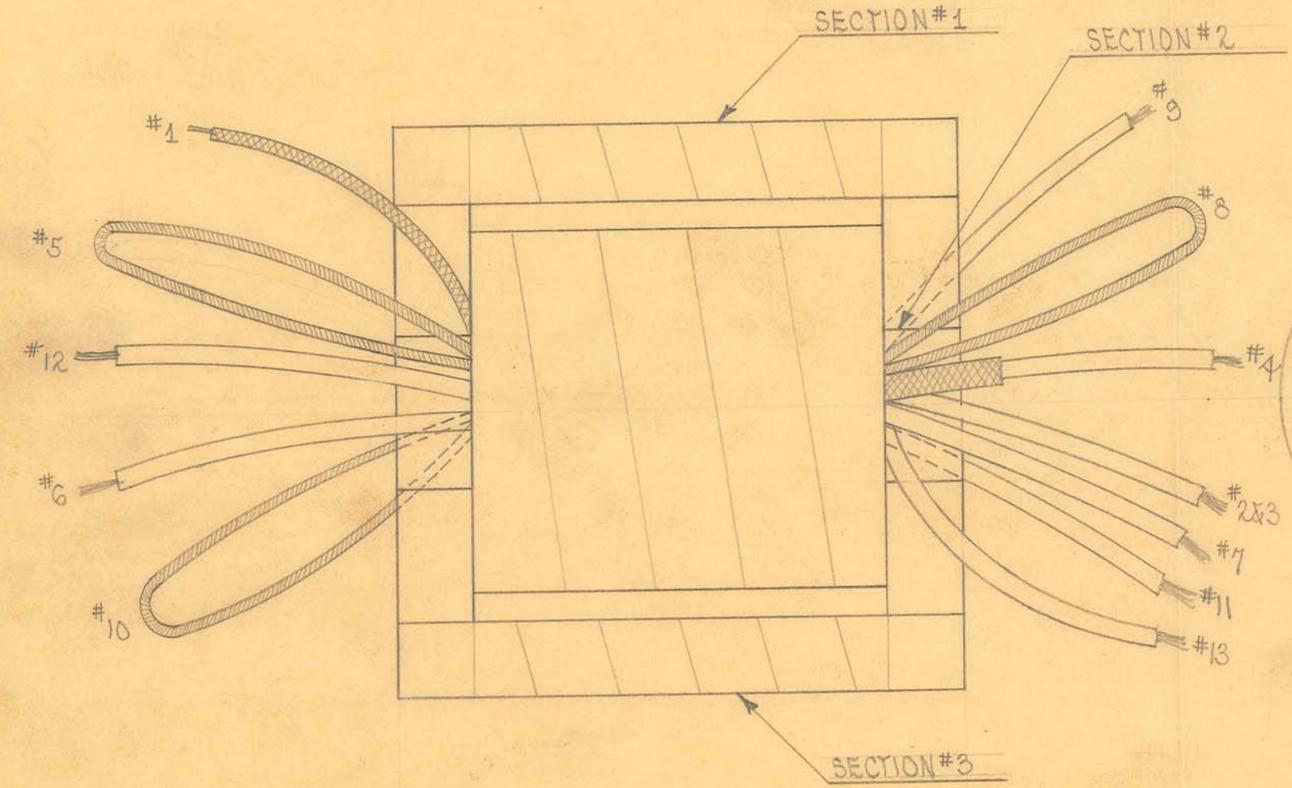

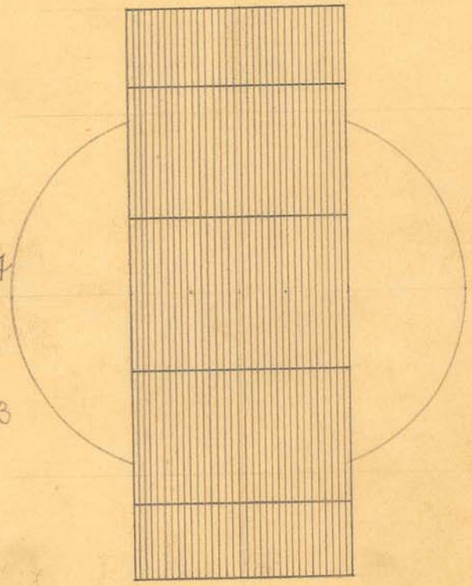

STEEL SIZES

PC. NO. 5043

SECTS. #1 & #3 - LAMS. CUT $3\frac{1}{4}$" X $\frac{1}{2}$" BUILT UP TO $1\frac{7}{16}$".
SECT. #2 - LAMS. CUT $3\frac{1}{4}$" X 1" BUILT UP TO $1\frac{7}{16}$".
END PIECES - CUT $2\frac{3}{4}$" X $\frac{1}{2}$".
CUT $1\frac{3}{8}$" X $\frac{1}{2}$".
BIND ALL SECTS. WITH FRICTION TAPE.

WINDING DATA

3 LAYERS OF 5020 $\frac{1}{4}$ FIBROID PAPER ON SECT. #2.
USE #21 COTENAMEL WIRE. ANCHOR LEAD #1 WITH FRICTION TAPE AND WIND 1ST LAYER TO 68 TURNS. THEN 1 LAYER OF 5020 $\frac{1}{4}$ PAPER. 2ND LAYER TO 136 T. 3RD LAYER TO 204 T. THEN 1 LAYER OF 5020 $\frac{1}{4}$ PAPER. 4TH LAYER TO 272 T. 5TH LAYER TO 330 T. LEAD #1 IS 16 03-#18 STRANDED WIRE. END #21 C.E. WIRE & START #15 S.C. ENAMEL WIRE, BRINGING OUT LEAD #2 & 3.
COVER PRI. WITH 2 LAYERS OF 5020 $\frac{1}{4}$ PAPER. WIND 12 T. & BRING OUT TAP - LEAD #4. WIND 12 T. MORE & BRING OUT TAP #5. WIND 12 T. MORE & BRING OUT TAP - LEAD #6
WIND 12 T. MORE & BRING OUT TAP - LEAD #7.
WIND 12 T. MORE & BRING OUT TAP #8.
WIND 12 $\frac{1}{2}$ T. MORE & BRING OUT TAP - LEAD #9.
WIND 12 T. MORE & BRING OUT TAP #10.
WIND 12 T. MORE & ANCHOR END WITH FRICTION TAPE - LEAD #11. 1 LAYER OF 5020 $\frac{1}{4}$ PAPER BETWEEN EACH LAYER OF #15 WIRE.
COVER SEC. WITH 1 LAYER OF 5020 $\frac{1}{4}$ PAPER. USE #16 COTENAMEL WIRE FOR FILAMENT. ANCHOR LEAD #12 WITH FRICTION TAPE AND WIND 26 T. & ANCHOR END WITH FRICTION TAPE - LEAD #13. COVER WITH 5004 OILED TAPE & SHELLAC. LEADS #2&3, 4, 6, 7, 9, 11, 12 & 13 ARE 23" EACH OF 1608-#14 ASBESTOS COVERED WIRE.
WHEN ASSEMBLING PLACE SECT. #2 WITH SINGLE LAM. UP AND SECTS. #1 & #3 WITH TWO LAMS. UP.

SIZE		ISSUE 10-14-32	J.E.
KIND		CHANGED	
SHAPE		" "	
FINISH		" "	
TEMP.		" "	
PATT.		" "	

TITLE: FISCHER SAFETY FOOT X-RAY UNIT AUTO TRANSFORMER

OBSOLETE

H. G. FISCHER & CO.
2335 WABANSIA AVE.
CHICAGO, ILL.

CAT. NO.

PART NO. 7655G

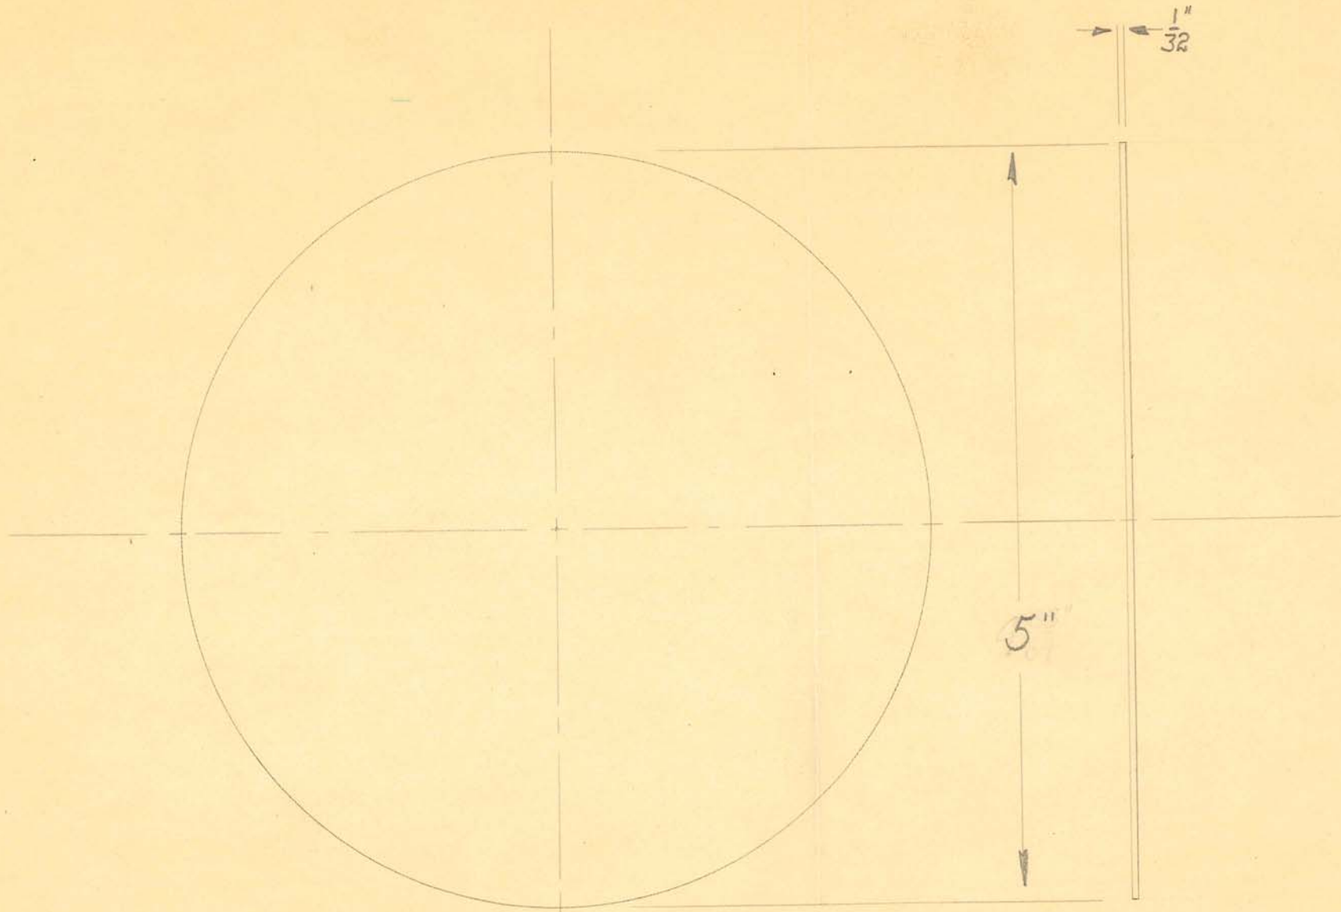

MATERIAL~BAKELITE

OBSOLETE

SIZE		ISSUE	
KIND		CHANGED	
SHAPE		" "	
FINISH		" "	
TEMP.		" "	
		" "	

TITLE: FISCHER SAFETY FOOT X-RAY UNIT TUBE HOLDER WASHER

H. G. FISCHER & CO.
2335 WABANSIA AVE.
CHICAGO, ILL.

CAT. NO.

PART NO. 7666 1/2

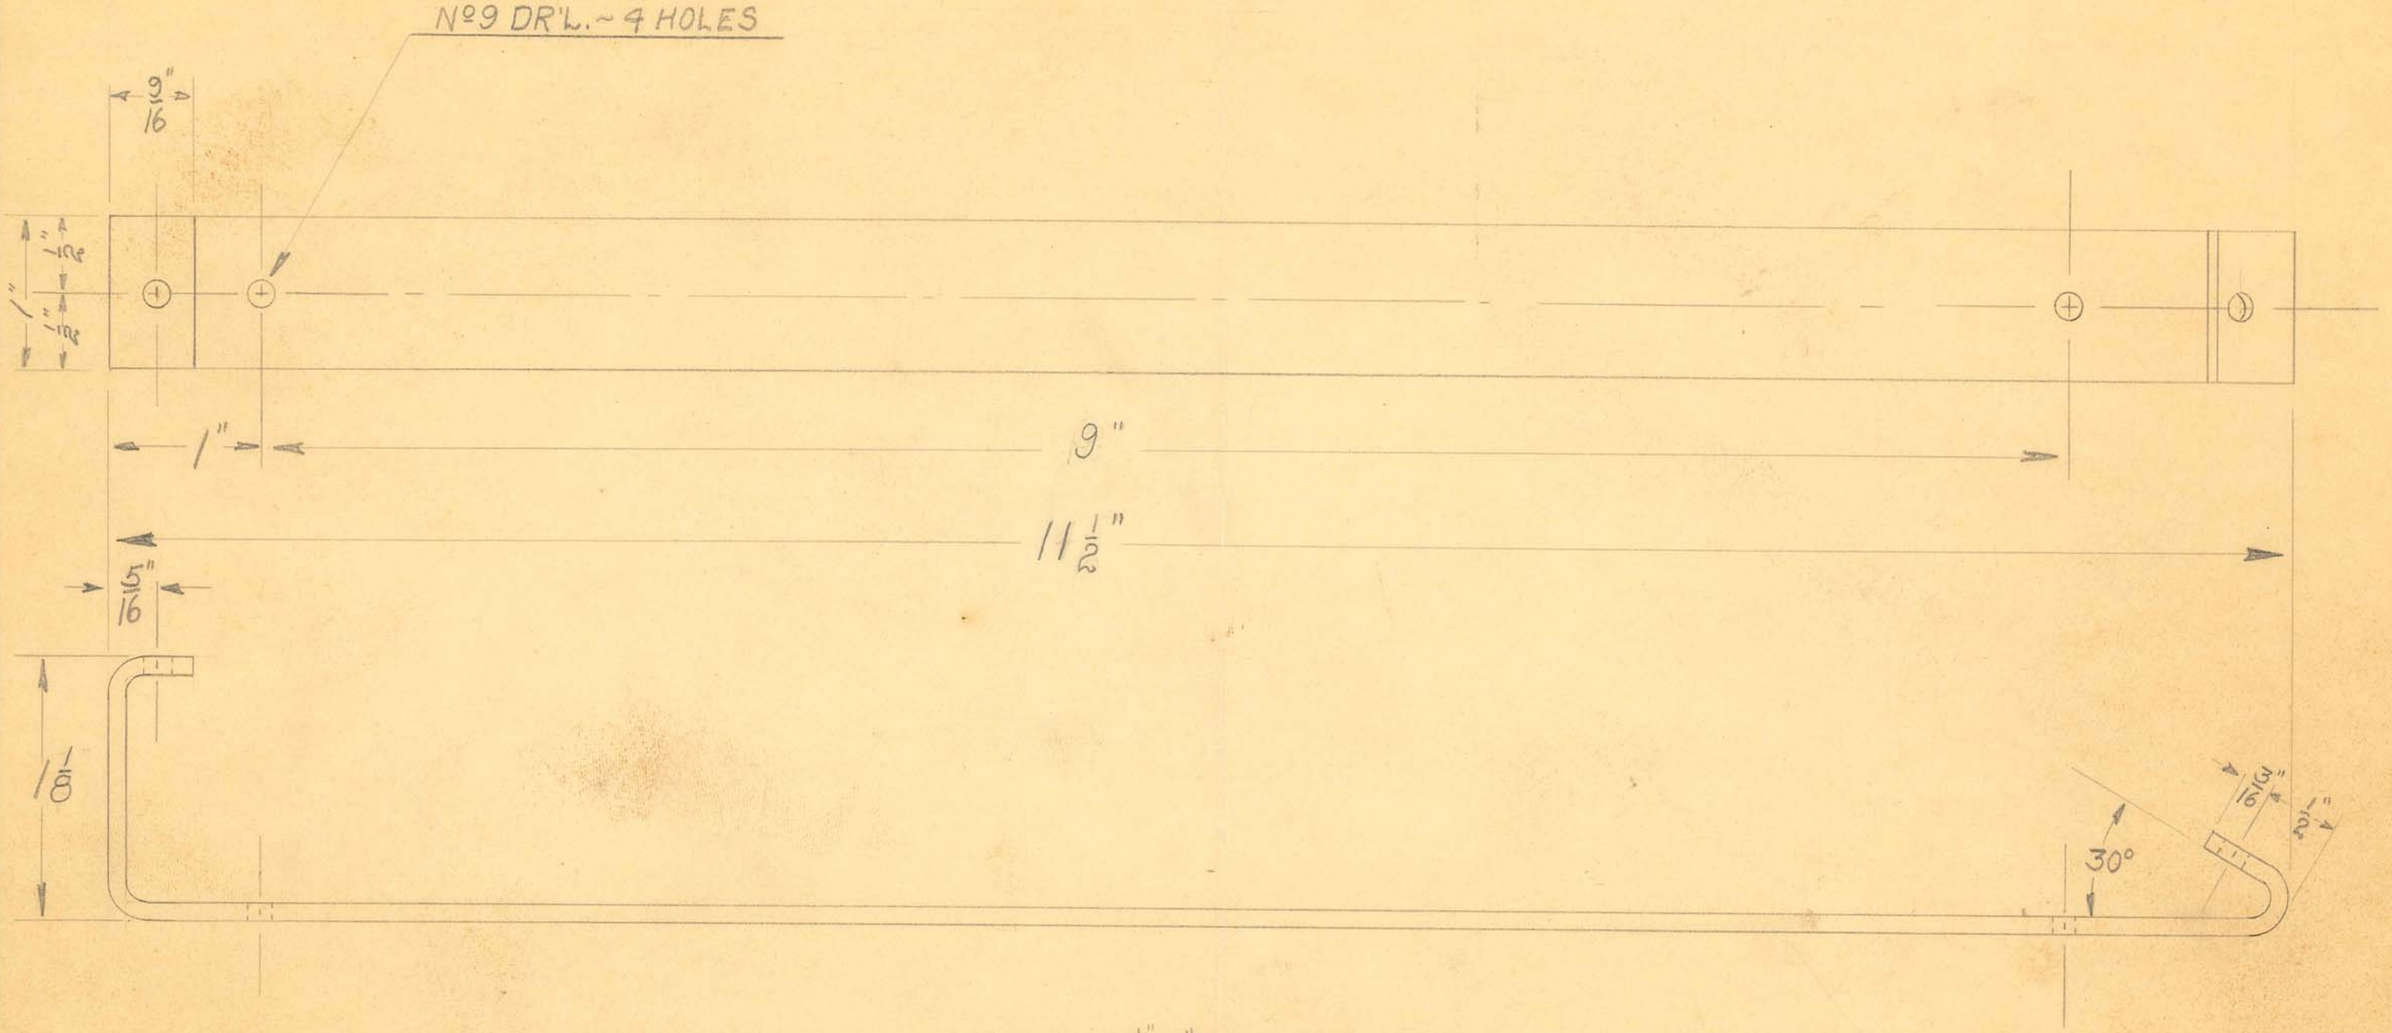

MATERIAL 1/8"X1" FLAT WIRE ~ 2 REQ'D.

OBSOLETE

SIZE	1/8 X 1"	ISSUE		TITLE: FISCHER SAFETY FOOT X-RAY UNIT TUBE MTG. STRIP
KIND	FLAT WIRE	CHANGED		
SHAPE		" "		
FINISH	BLACK ENAMEL	" "		
TEMP.		" "		H. G. FISCHER & CO. CAT. PART 70-07

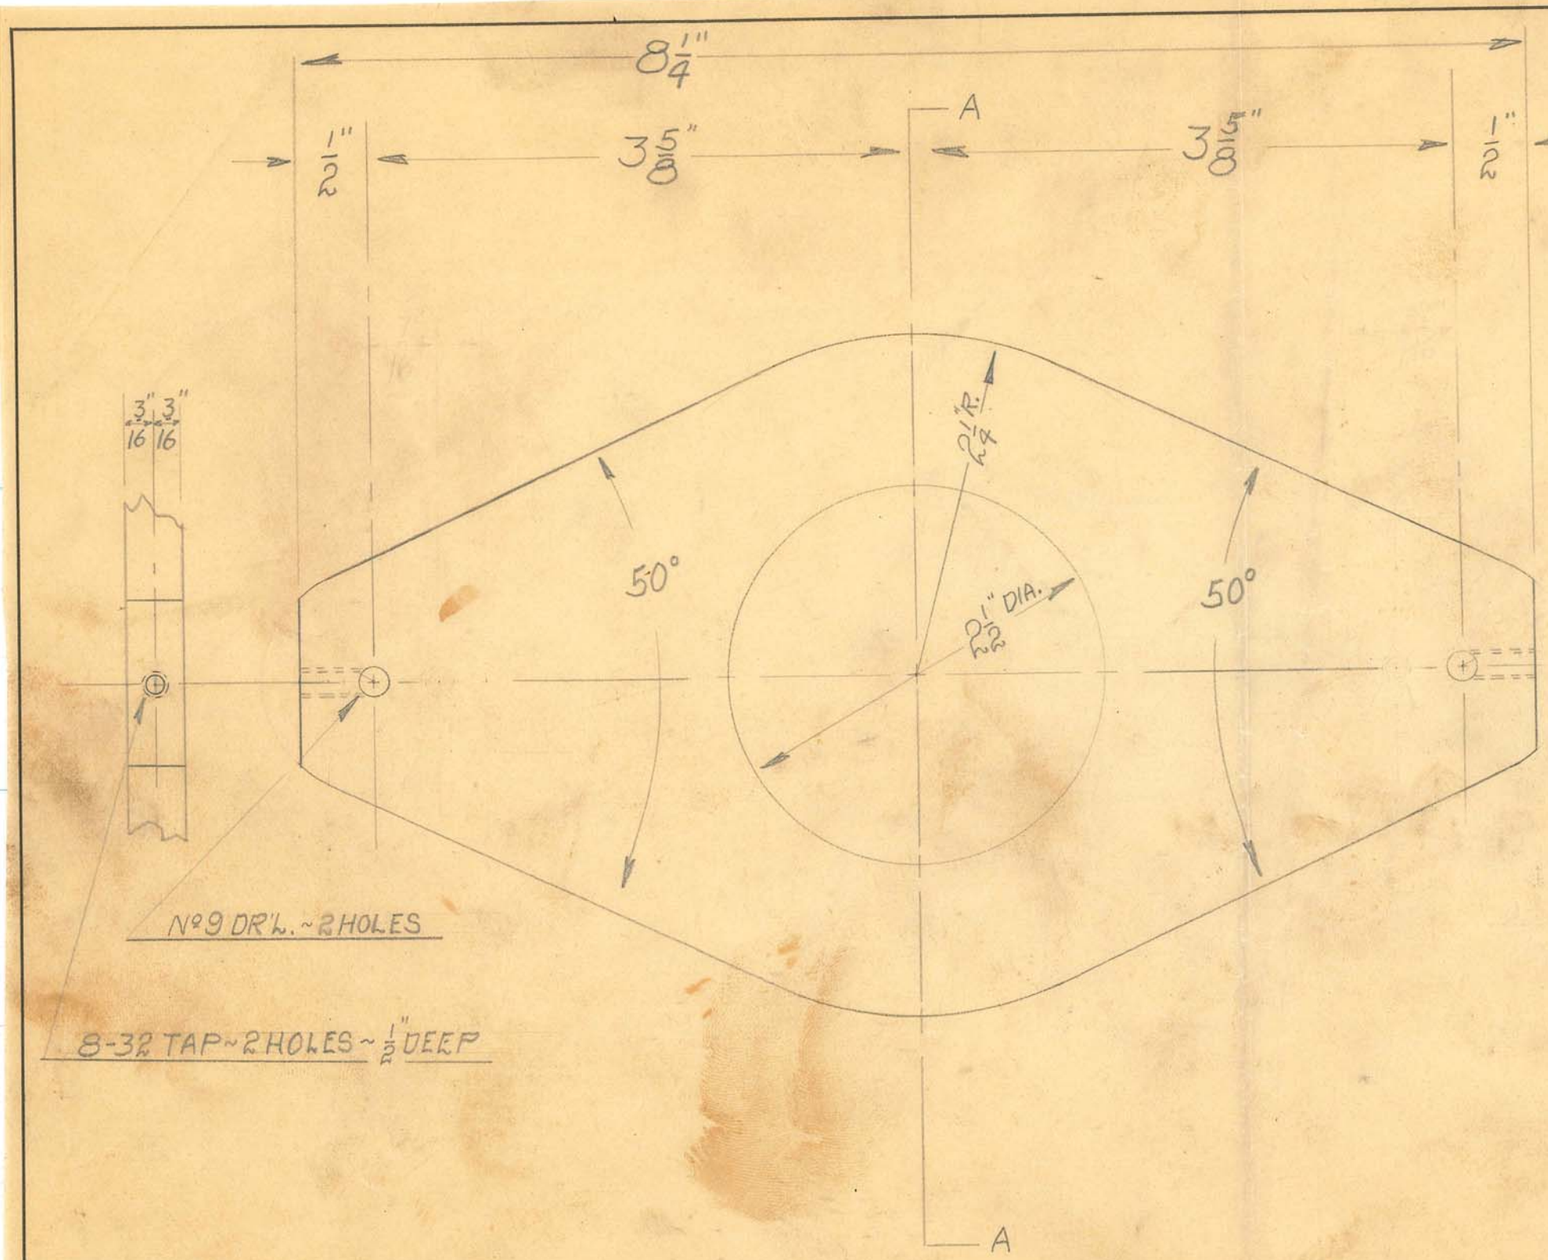

MATERIAL 3/16" BLACK FIBRE ~ 1 REQ'D.

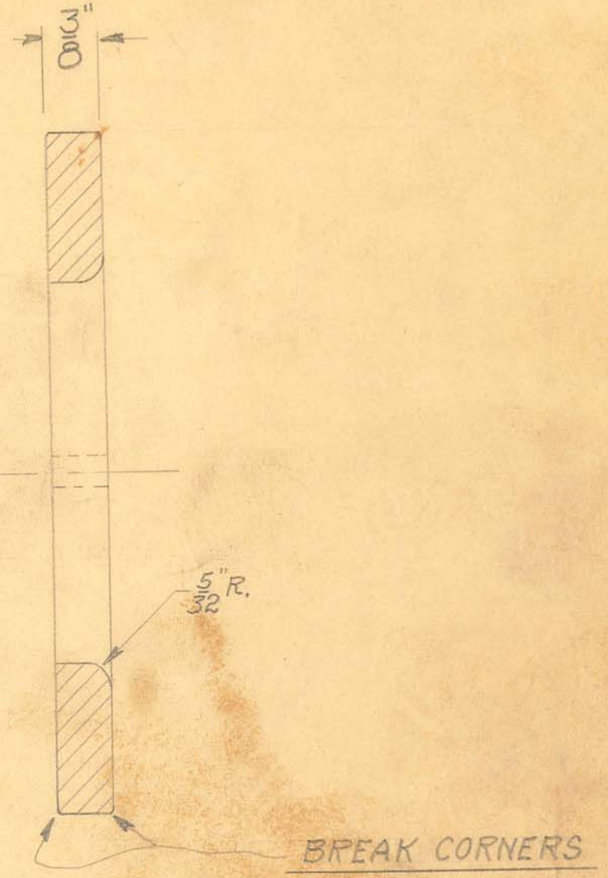

SECTION - "AA"

OBSOLETE

SIZE	3/16"	ISSUE	
KIND	BLACK FIBRE	CHANGED	
SHAPE		" "	
FINISH		" "	
TEMP.		" "	
DATE		" "	Cut

TITLE: FISCHER SAFETY FOOT X-RAY UNIT TUBE CLAMP

H. G. FISCHER & CO.
2335 WABANSIA AVE.
CHICAGO, ILL.

CAT. NO.

PART NO. 7669F

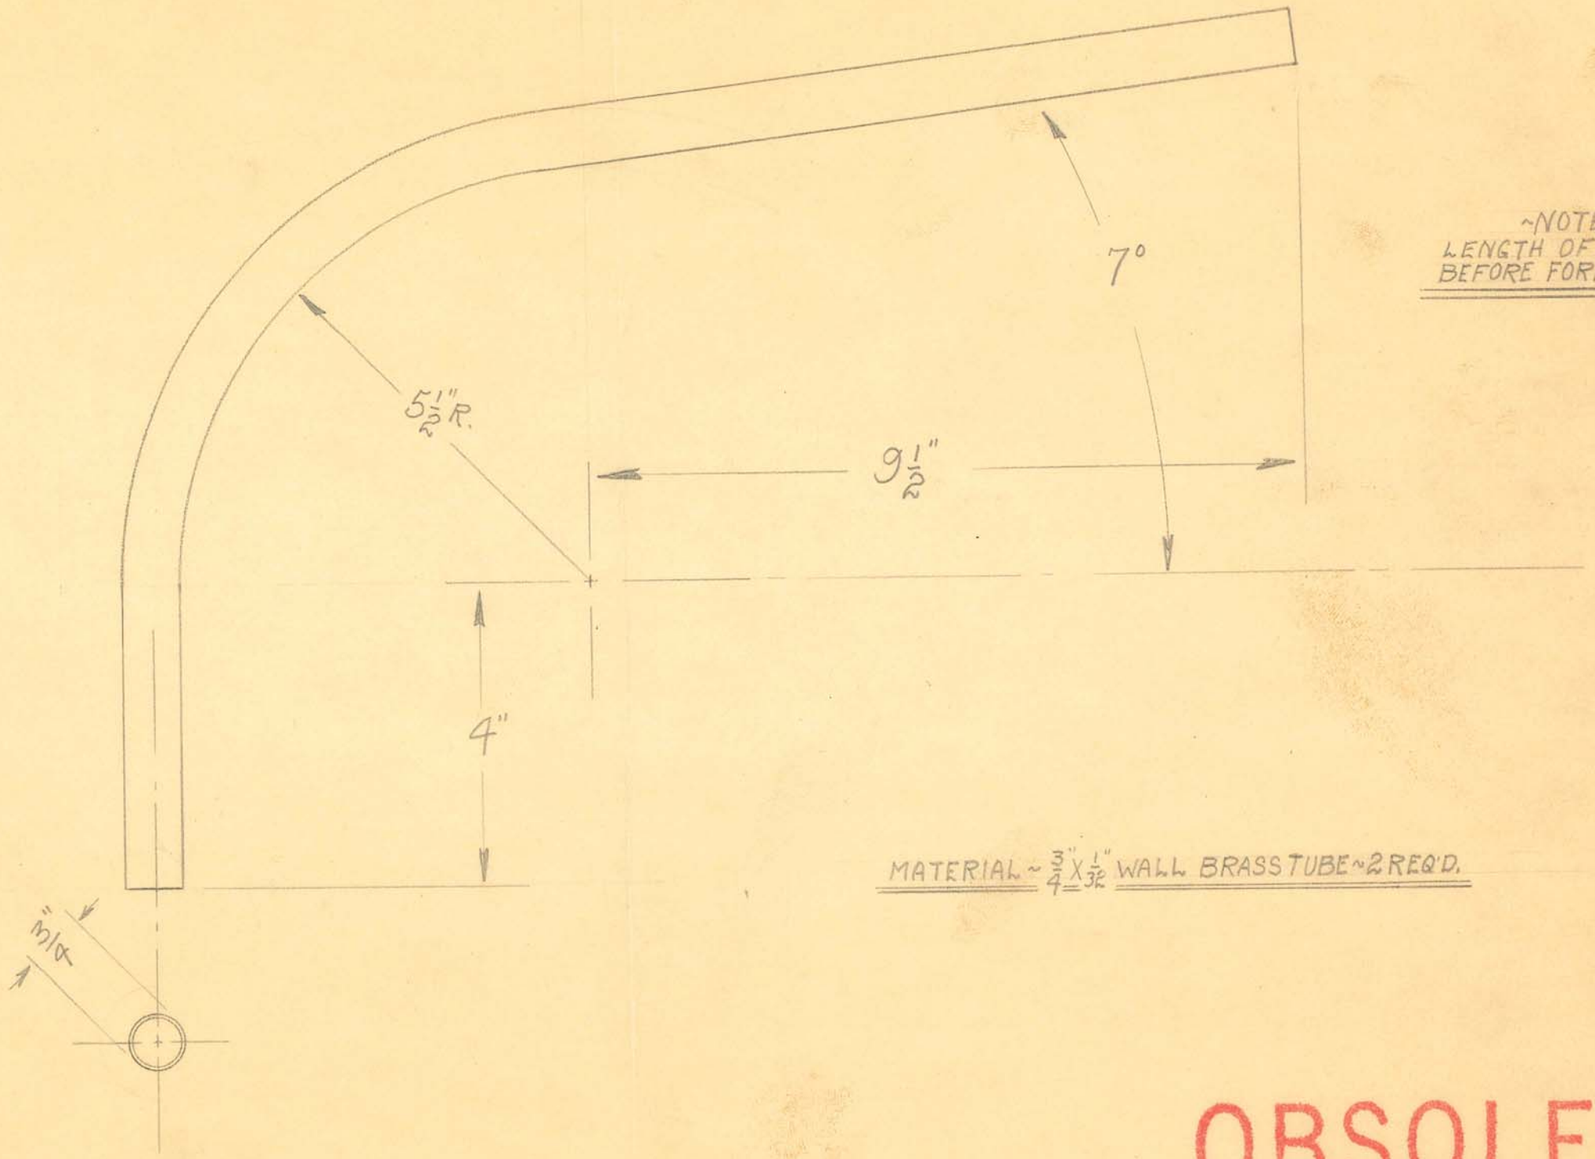

SCALE: ½"-1"

~NOTE~
LENGTH OF TUBE
BEFORE FORMING-23"


OBSOLETE

SIZE		ISSUE	
KIND		CHANGED	
SHAPE		" "	
FINISH		" "	
TEMP.		" "	
DATE		" "	

TITLE: FISCHER SAFETY FOOT X-RAY UNIT GUARD RAIL

H. G. FISCHER & CO.
2335 WABANSIA AVE.
CHICAGO, ILL.

CAT. NO.

PART NO. 7672

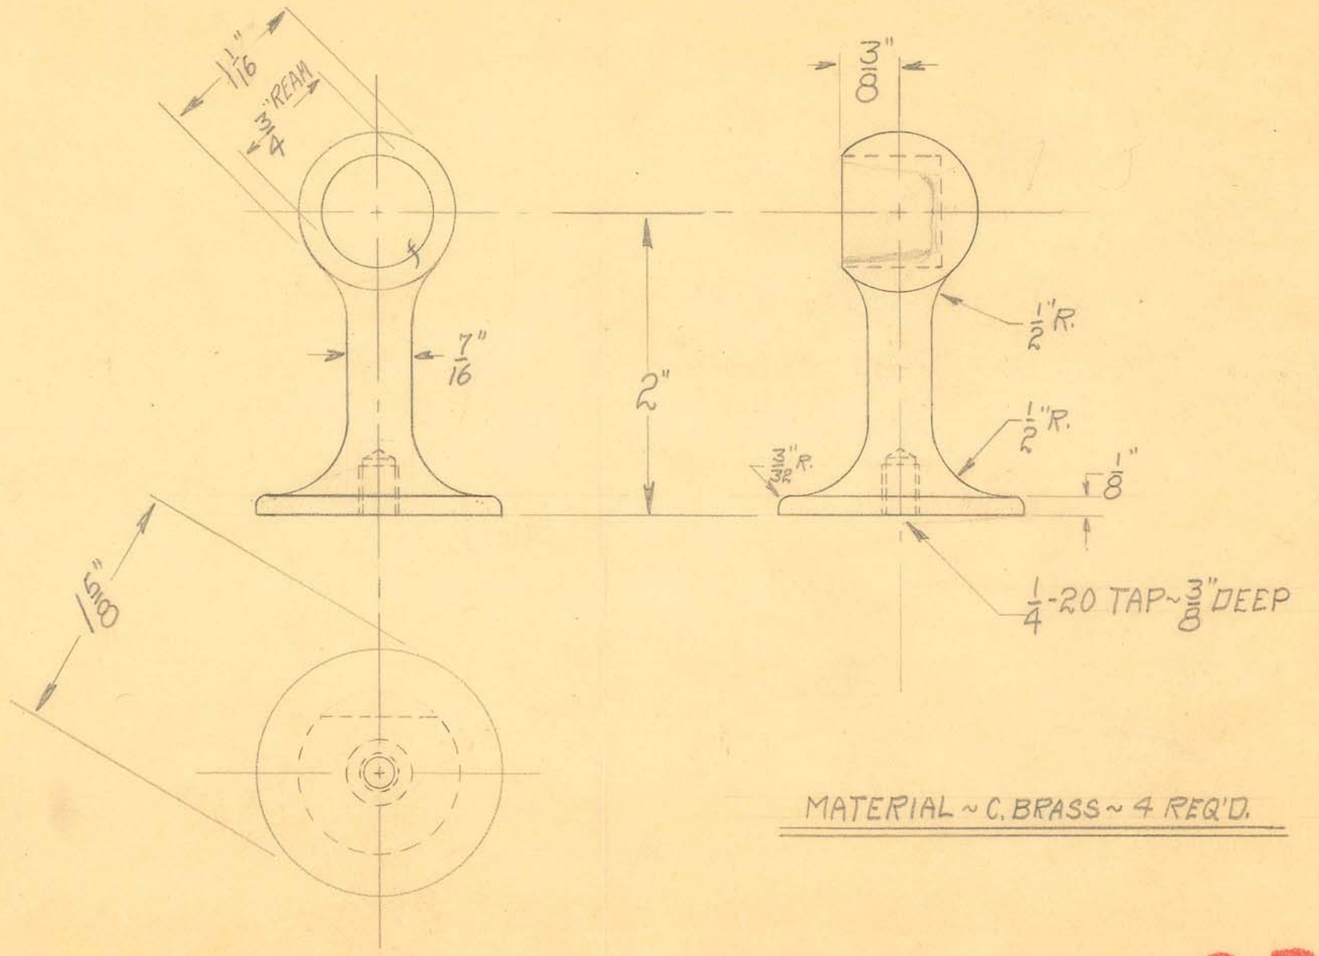

MATERIAL ~ C. BRASS ~ 4 REQ'D.

OBSOLETE

SIZE		ISSUE	
KIND		CHANGED	
SHAPE		" "	
FINISH		" "	
TEMP.		" "	

TITLE: FISCHER SAFETY FOOT X-RAY UNIT GUARD RAIL SUPP.

H. G. FISCHER & CO. | CAT. | PART MC73-5

(64) July 1st. 1932

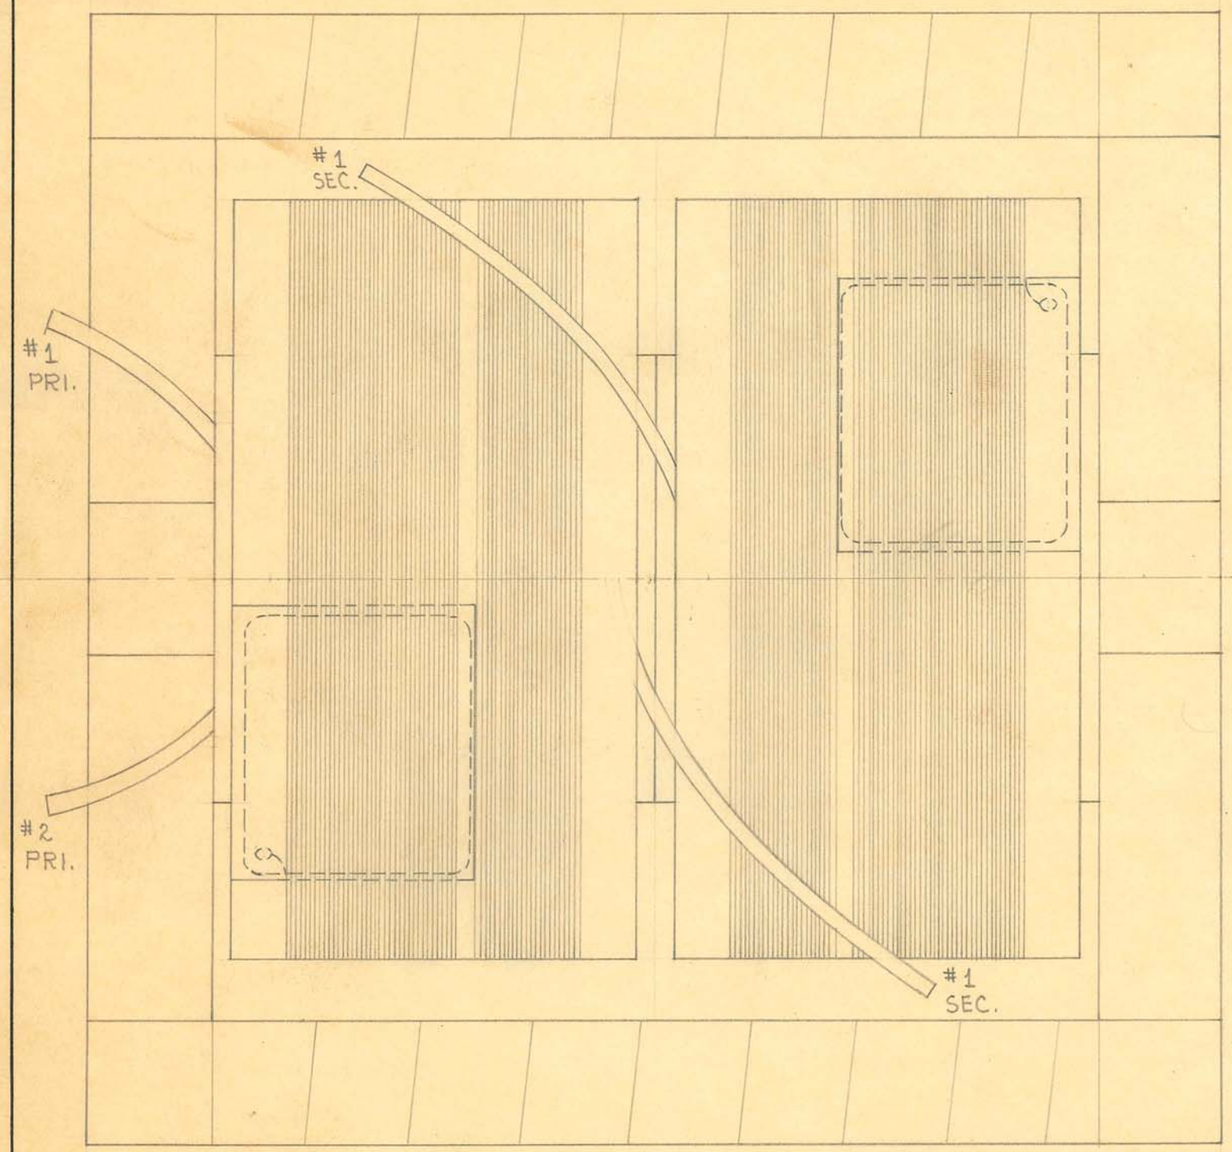

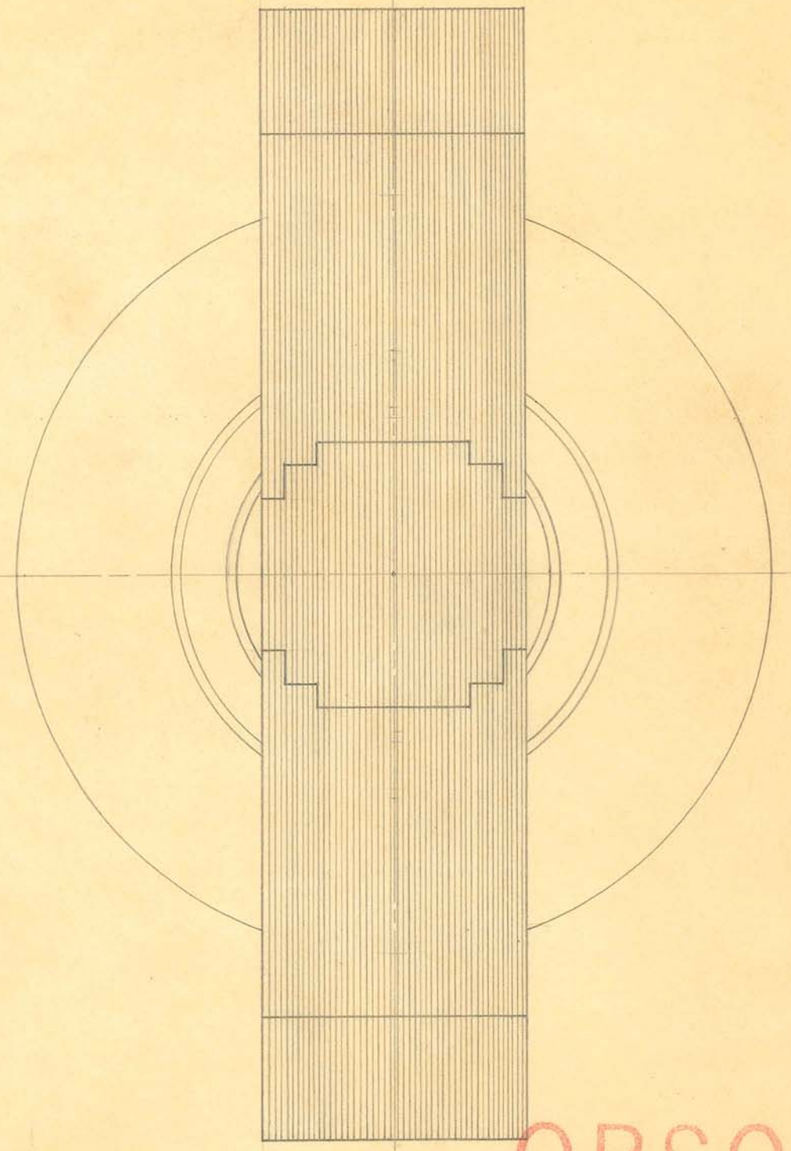

STEEL SIZES

PC. NO. 5043

1 - "O" CORE: LAMS. CUT,
6 $\frac{11}{16}$" X 1 $\frac{3}{4}$" BUILT UP TO 1".
6 $\frac{11}{16}$" X 1 $\frac{7}{16}$" BUILT UP TO $\frac{7}{16}$".
6 $\frac{11}{16}$" X 1" BUILT UP TO $\frac{5}{16}$".
2 SIDE BARS: LAMS. CUT,
6 $\frac{11}{16}$" X $\frac{13}{16}$" BUILT UP TO 1 $\frac{3}{4}$".
END PIECES CUT:
5 $\frac{13}{16}$" X $\frac{13}{16}$"
3 $\frac{7}{32}$" X $\frac{13}{16}$"
3" X $\frac{13}{16}$"
2 $\frac{27}{32}$" X $\frac{13}{16}$"
BIND "O" CORE & SIDE BARS WITH FRICTION TAPE.
PLACE PRI. COIL ON "O" CORE & SEC. COILS OVER PRI. AS SHOWN.

OBSOLETE

SIZE		ISSUE 12-22-36	A.E.
KIND		CHANGED	
SHAPE		"	
FINISH		"	
TEMP.		"	

TITLE:
FISCHER "SWD" SHORT WAVE POWER
UNIT H.T. TRANSFORMER

H. G. FISCHER & CO.
2335 WABANSIA AVE.

CAT. NO.

PART NO. 9824GC

H. G. FISCHER & CO.
FRANKLIN PARK, ILLINOIS

PART NO. 16745G

REVISION	DATE	BY

DATE 11-24-48 DR. BY J.V.W. CH'K'D.

DIMENSIONS
FRACTIONAL ± .015
DECIMAL ± .005
ANGULAR ± ½°
UNLESS OTHERWISE SPECIFIED

SCALE FULL MATERIAL

FINISH

PATTERN

TOOLS

TITLE FISCHER MOD. "200" DIATHERMY PAD ADAPTER

SEE NEW DRAWING

2 REQUIRED

OBSOLETE

I - ASSEMBLE SOCKET #3315A - REAR CAP #16746 AND NUT #16747

II - CUT-BEND & INSERT SHORT END OF COIL #16748 INTO HOLE IN SIDE OF NUT & SOLDER ALSO LOCK NUT TO SOCKET BY SOLDERING — BE SURE COIL CENTERS WITH REAR CAP #16746

III - AFTER ABOVE PARTS ARE ASSEMBLED SPREAD APPROX. $\frac{1}{32}$" COATING OF ADHESIVE #16744 TO SIDE AND UNDERSIDE OF SHOULDER OF REAR CAP #16746 — PRESS INTO INSULATOR TUBE #17079 SO THAT GAP (FILLED WITH ADHESIVE) BETWEEN REAR CAP AND INSULATOR IS NOT MORE THAN $\frac{1}{32}$" WIDE - WIPE OFF EXCESS ADHESIVE.

IV - SCREW CONE POINT SET SCREW #16749 INTO SIDE OF TIP ASSEMBLY #16750 WHICH IN TURN SCREWS INTO FRONT CAP #16751.

V - PULL END OF COIL #16748 OUTSIDE OF TUBE AND INSERT INTO HOLE IN TIP ASSEMBLY #16750 THEN TIGHTEN SET SCREW #16749.

VI - SPREAD APPROX. $\frac{1}{32}$" COATING OF ADHESIVE #16744 TO SIDE AND UNDERSIDE OF SHOULDER OF FRONT CAP #16751 — PRESS INTO INSULATING TUBE #17079 SO THAT GAP (FILLED WITH ADHESIVE) BETWEEN FRONT CAP AND INSULATOR IS NOT MORE THAN $\frac{1}{32}$" WIDE — WIPE OFF EXCESS ADHESIVE.

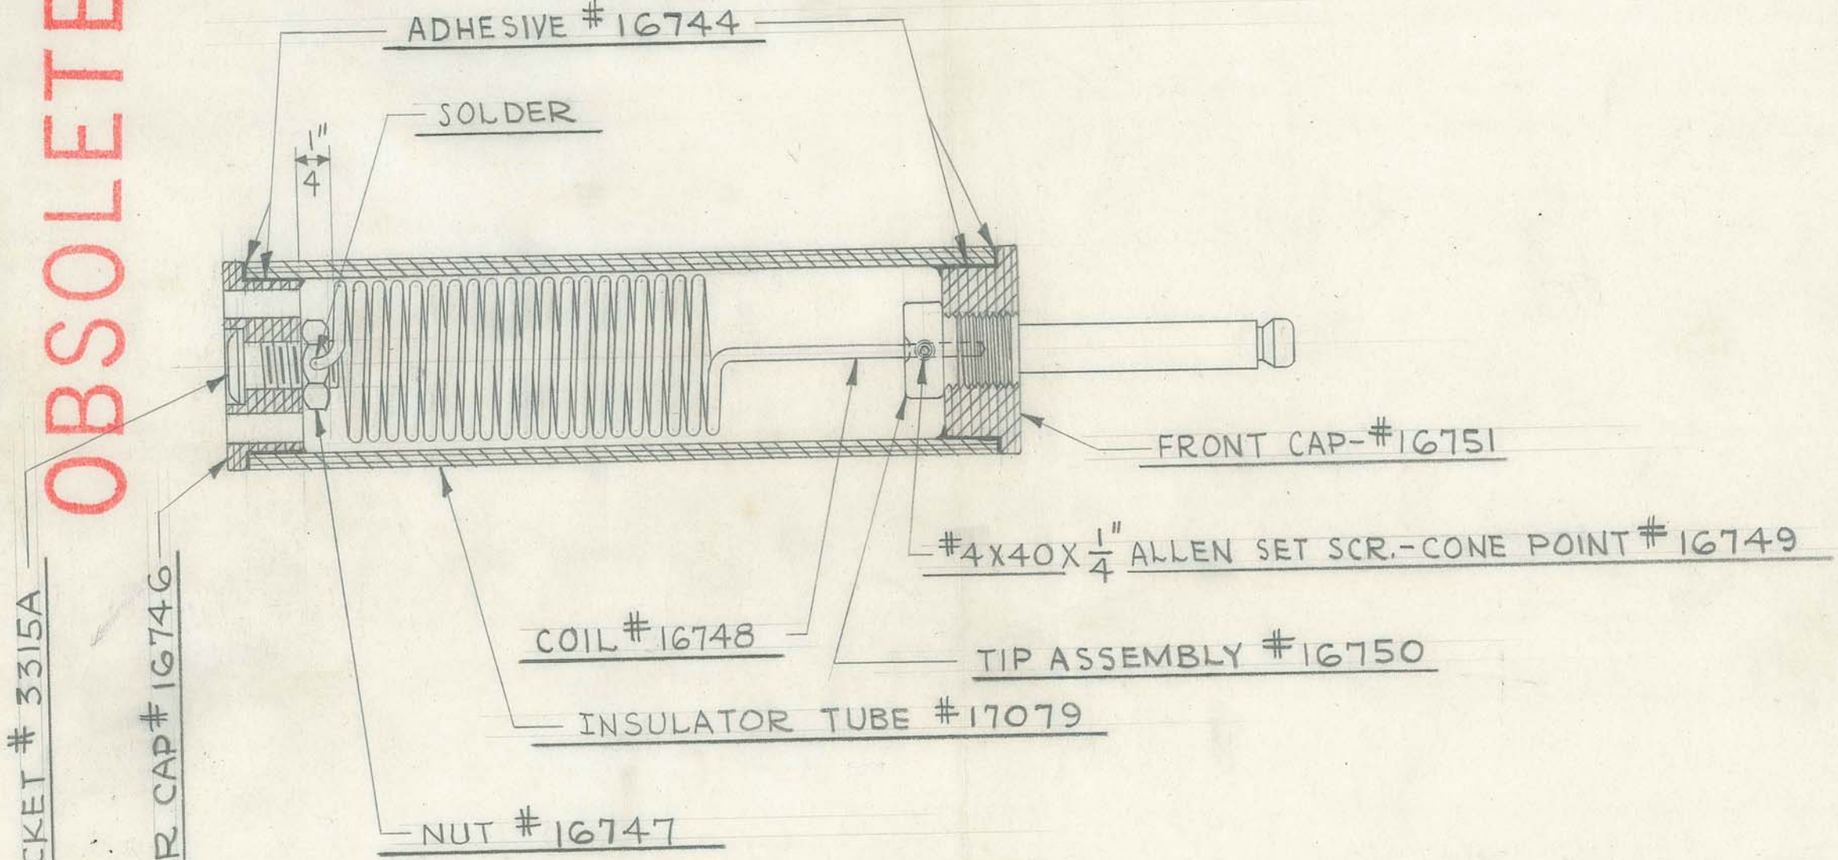

FOLDER #139

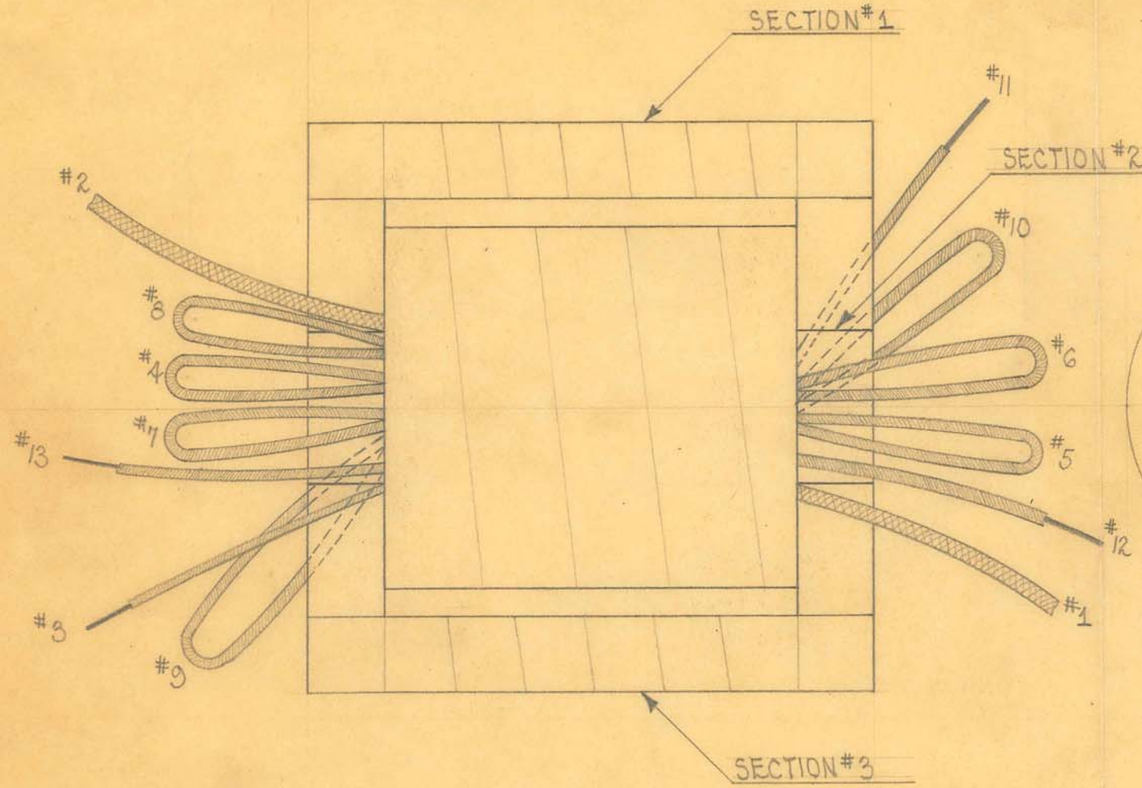

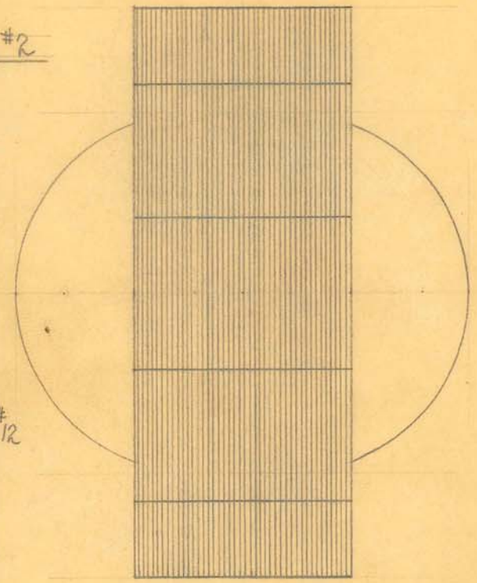

STEEL SIZES

PC. NO. 5043

SECTS. #1 & #3 - LAMS. CUT $3\frac{1}{4}$" X $\frac{1}{2}$" BUILT UP TO $1\frac{7}{16}$".

SECT. #2 - LAMS. CUT $3\frac{1}{4}$" X 1" BUILT UP TO $1\frac{7}{16}$".

END PIECES - CUT $2\frac{3}{4}$" X $\frac{1}{2}$"

CUT $1\frac{3}{8}$" X $\frac{1}{2}$"

BIND ALL SECTS. WITH FRICTION TAPE.

WINDING DATA

3 LAYERS OF 5020 $\frac{1}{4}$ FIBROID PAPER ON SECT. #2. USE #21 COTENAMEL WIRE. ANCHOR LEAD #1 WITH FRICTION TAPE AND WIND 1ST LAYER TO 68 TURNS. THEN 1 LAYER OF 5020 $\frac{1}{4}$ PAPER. 2ND LAYER TO 136 T. 3RD LAYER TO 204 T. THEN 1 LAYER OF 5020 $\frac{1}{4}$ PAPER. 4TH LAYER TO 272 T. 5TH LAYER TO 330 T. AND ANCHOR END WITH FRICTION TAPE - LEAD #2.

LEADS #1 & #2 ARE 1603 - #18 STRANDED WIRE.

COVER PRI. WITH 2 LAYERS OF 5020 $\frac{1}{4}$ PAPER. USE #15 S.C. ENAMEL WIRE. ANCHOR LEAD #3 WITH FRICTION TAPE AND WIND 12 T. & BRING OUT TAP #4.

WIND 12 T. MORE & BRING OUT TAP #5.

" 12 T. " " " " " #6.

" 12 T. " " " " " #7

" 12 T. " " " " " #8

" $12\frac{1}{2}$ T. " " " " " #9

" 12 T. " " " " " #10

" 12 T. " " ANCHOR END WITH FRICTION TAPE - LEAD #11. 1 LAYER OF 5020 $\frac{1}{4}$ PAPER BETWEEN EACH LAYER OF #15 WIRE.

COVER SEC. WITH 1 LAYER OF 5020 $\frac{1}{4}$ PAPER. USE #16 COTENAMEL WIRE FOR FILAMENT. ANCHOR LEAD #12 WITH FRICTION TAPE AND WIND 26 T. & ANCHOR END WITH FRICTION TAPE - LEAD #13. COVER WITH 5004 OILED TAPE & SHELLAC.

WHEN ASSEMBLING PLACE SECT. #2 WITH SINGLE LAM. UP AND SECTS. #1 & #3 WITH TWO LAMS. UP.

SIZE		ISSUE 3-25-32	H.E.
KIND		CHANGED	
SHAPE		" "	
FINISH		" "	
TEMP.		" "	
PATT.		" "	

TITLE: DENTAL X AUTO TRANSFORMER

OBSOLETE

H. G. FISCHER & CO.
2335 WABANSIA AVE.
CHICAGO, ILL.

CAT. NO.

PART NO. 6234GA

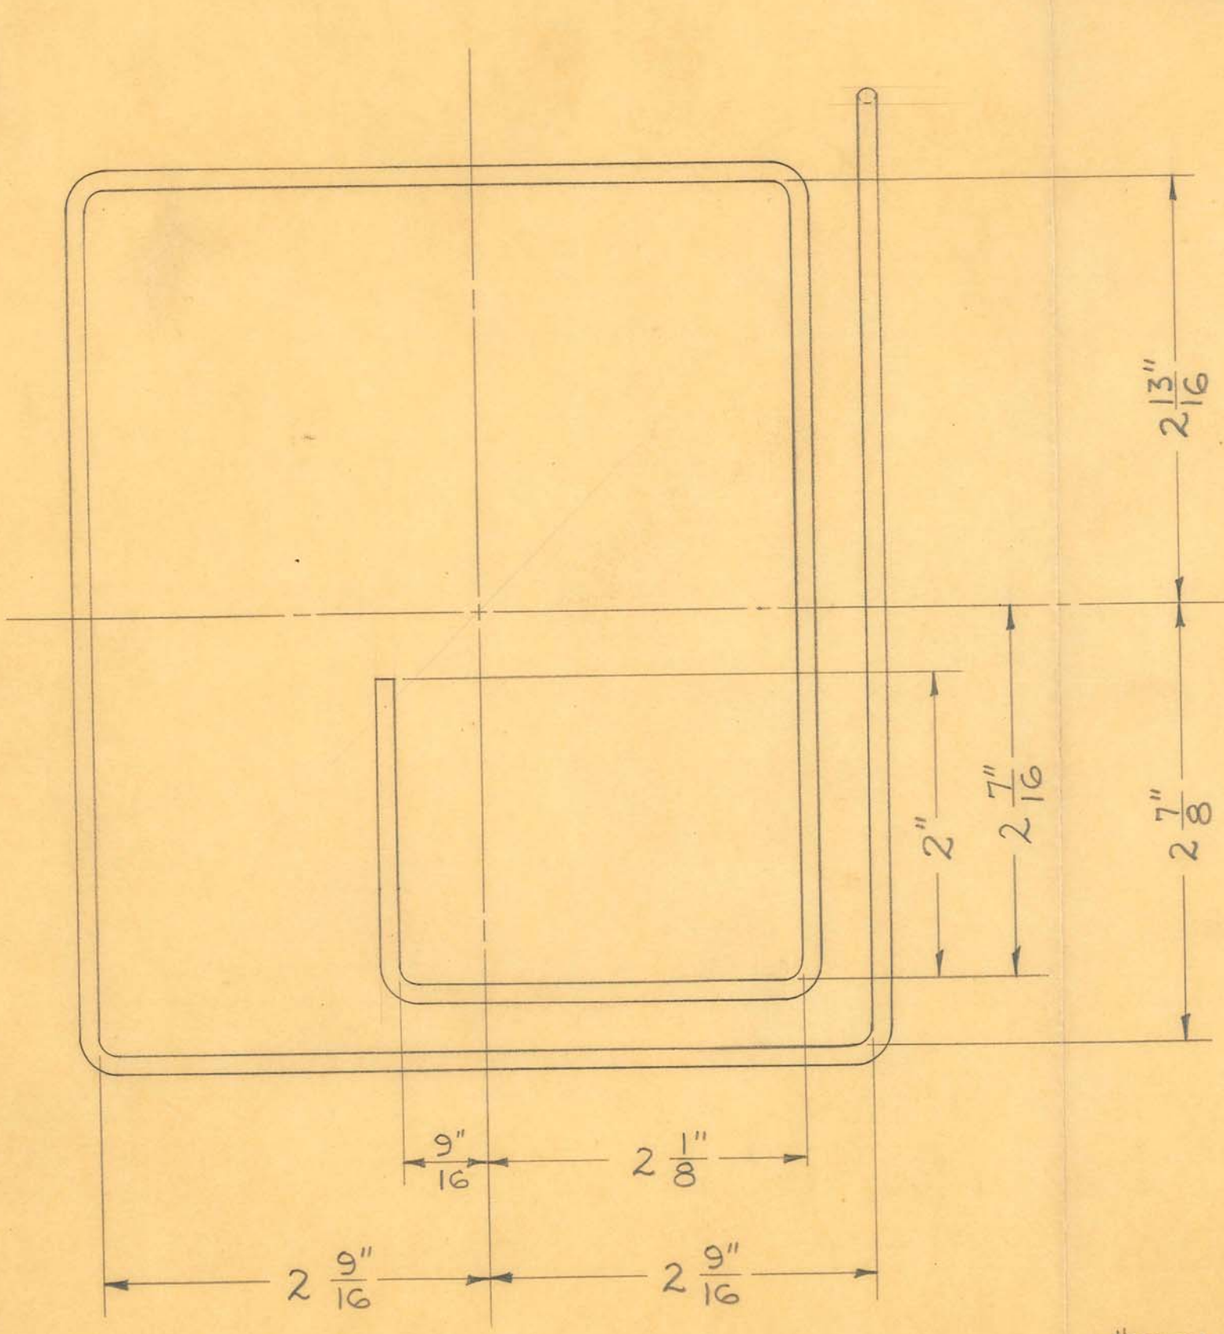

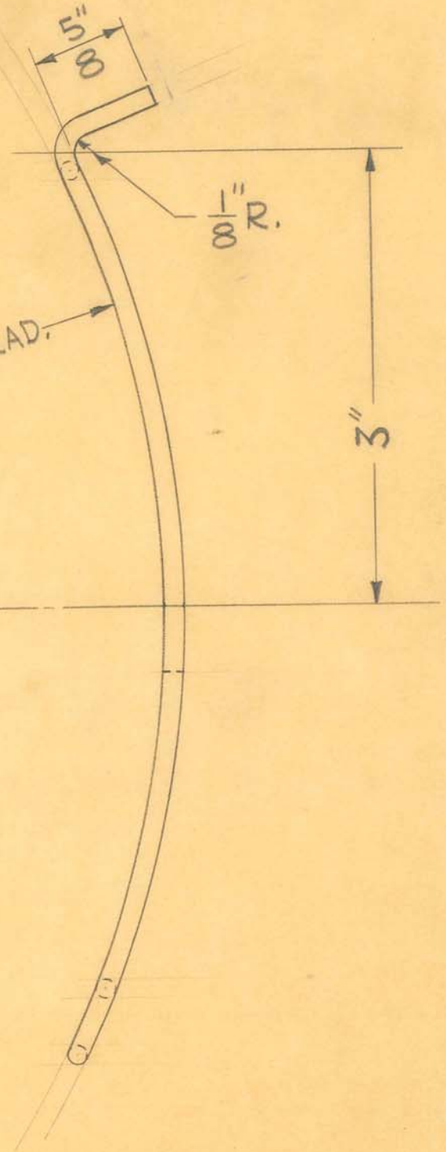

DEVELOPED LENGTH = 32 1/2"

1 REQUIRED

OBSOLETE

#8 GA. (.1285")

SIZE	#8 BARE	ISSUE 2-	
KIND	COPPER WIRE	CHANGED	
SHAPE		"	
FINISH		"	
TEMP.		"	
PATT.		"	

TITLE: FISCHER ADJUSTABLE INDUCTION ELECT. COIL – RIGHT

H. G. FISCHER & CO.
2335 WABANSIA AVE.
CHICAGO, ILL.

CAT. NO.

PART NO. 15875

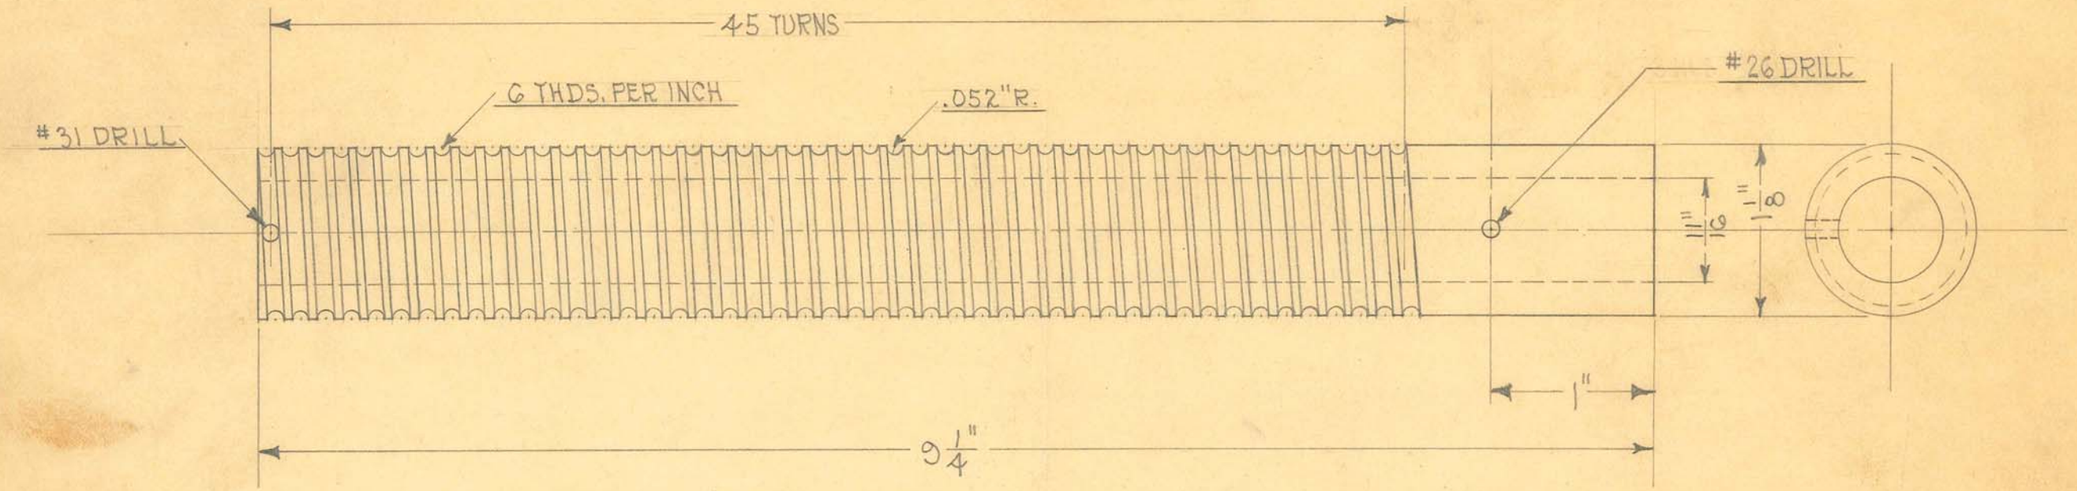

1 REQUIRED

45 TURNS #10 ENAMELED COPPER WIRE

OBSOLETE

SIZE	11/16" I.D. X 1 1/8" O.D.	ISSUE 3-29-33	J.E.	TITLE: SHORT WAVE HIGH FREQ. OUTFIT VARIOMETER COIL TUBE
KIND	BAKELITE	CHANGED		
SHAPE	TUBING	" "		
FINISH		" "		
TEMP.		" "		
PATT.		" "		

H. G. FISCHER & CO.
2335 WABANSIA AVE.
CHICAGO, ILL.

CAT. NO.

PART NO. 8717

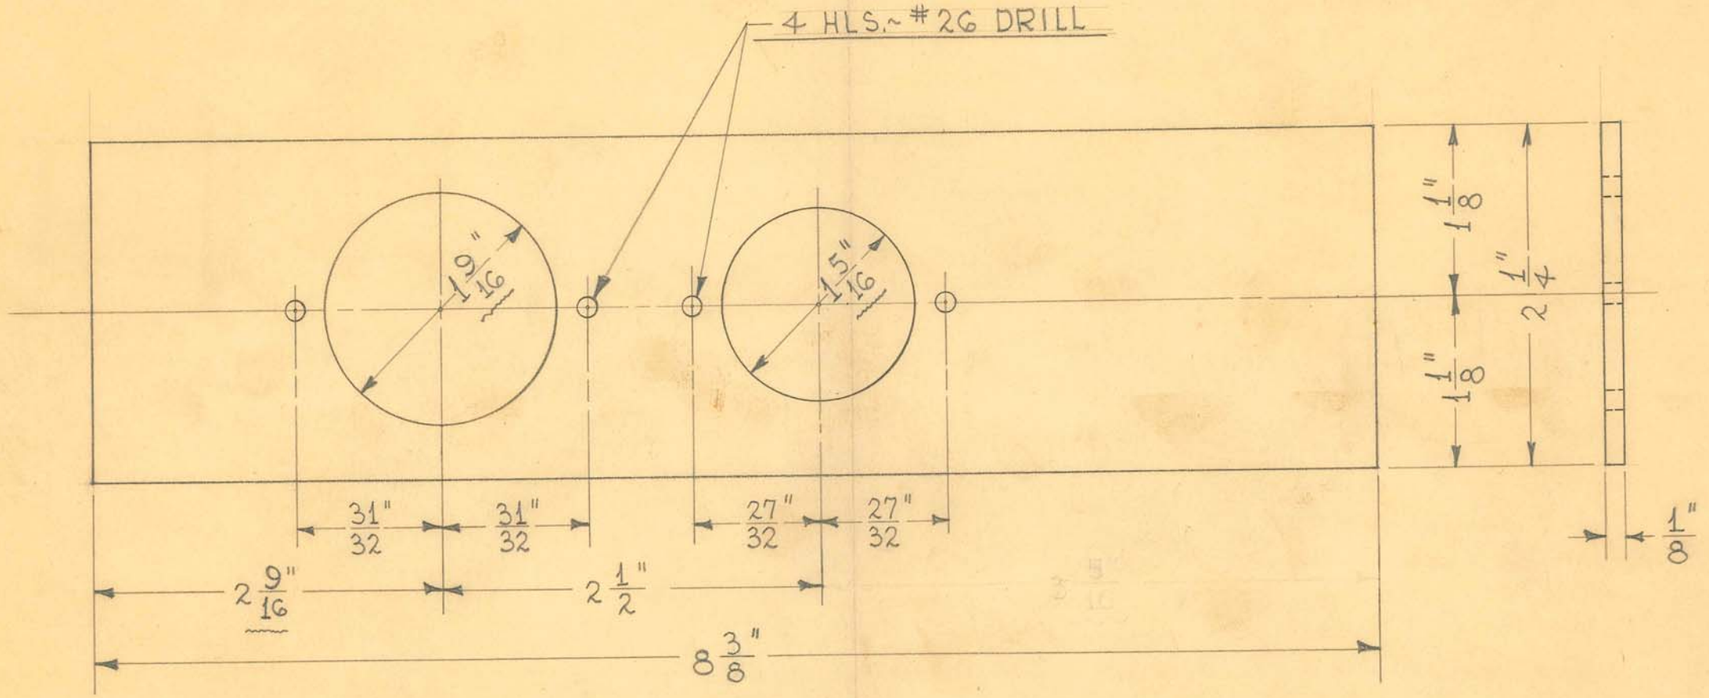

1 REQUIRED

OBSOLETE

SIZE	1/8" X 2 1/4"	ISSUE 2-4-44	H.E.
KIND	C.R. STL.	CHANGED	
SHAPE	STRIP	per H.H.O. 3-1-44	J.V.W.
FINISH		"	
TEMP.		"	
PATT.		"	

TITLE: FISCHER "VC" SHORT WAVE APPARATUS~ POWER UNIT CHASSIS~RECEPTACLE PLATE

H. G. FISCHER & CO.
2335 WABANSIA AVE.
CHICAGO, ILL.

CAT. NO.

PART NO. PART OF 15452

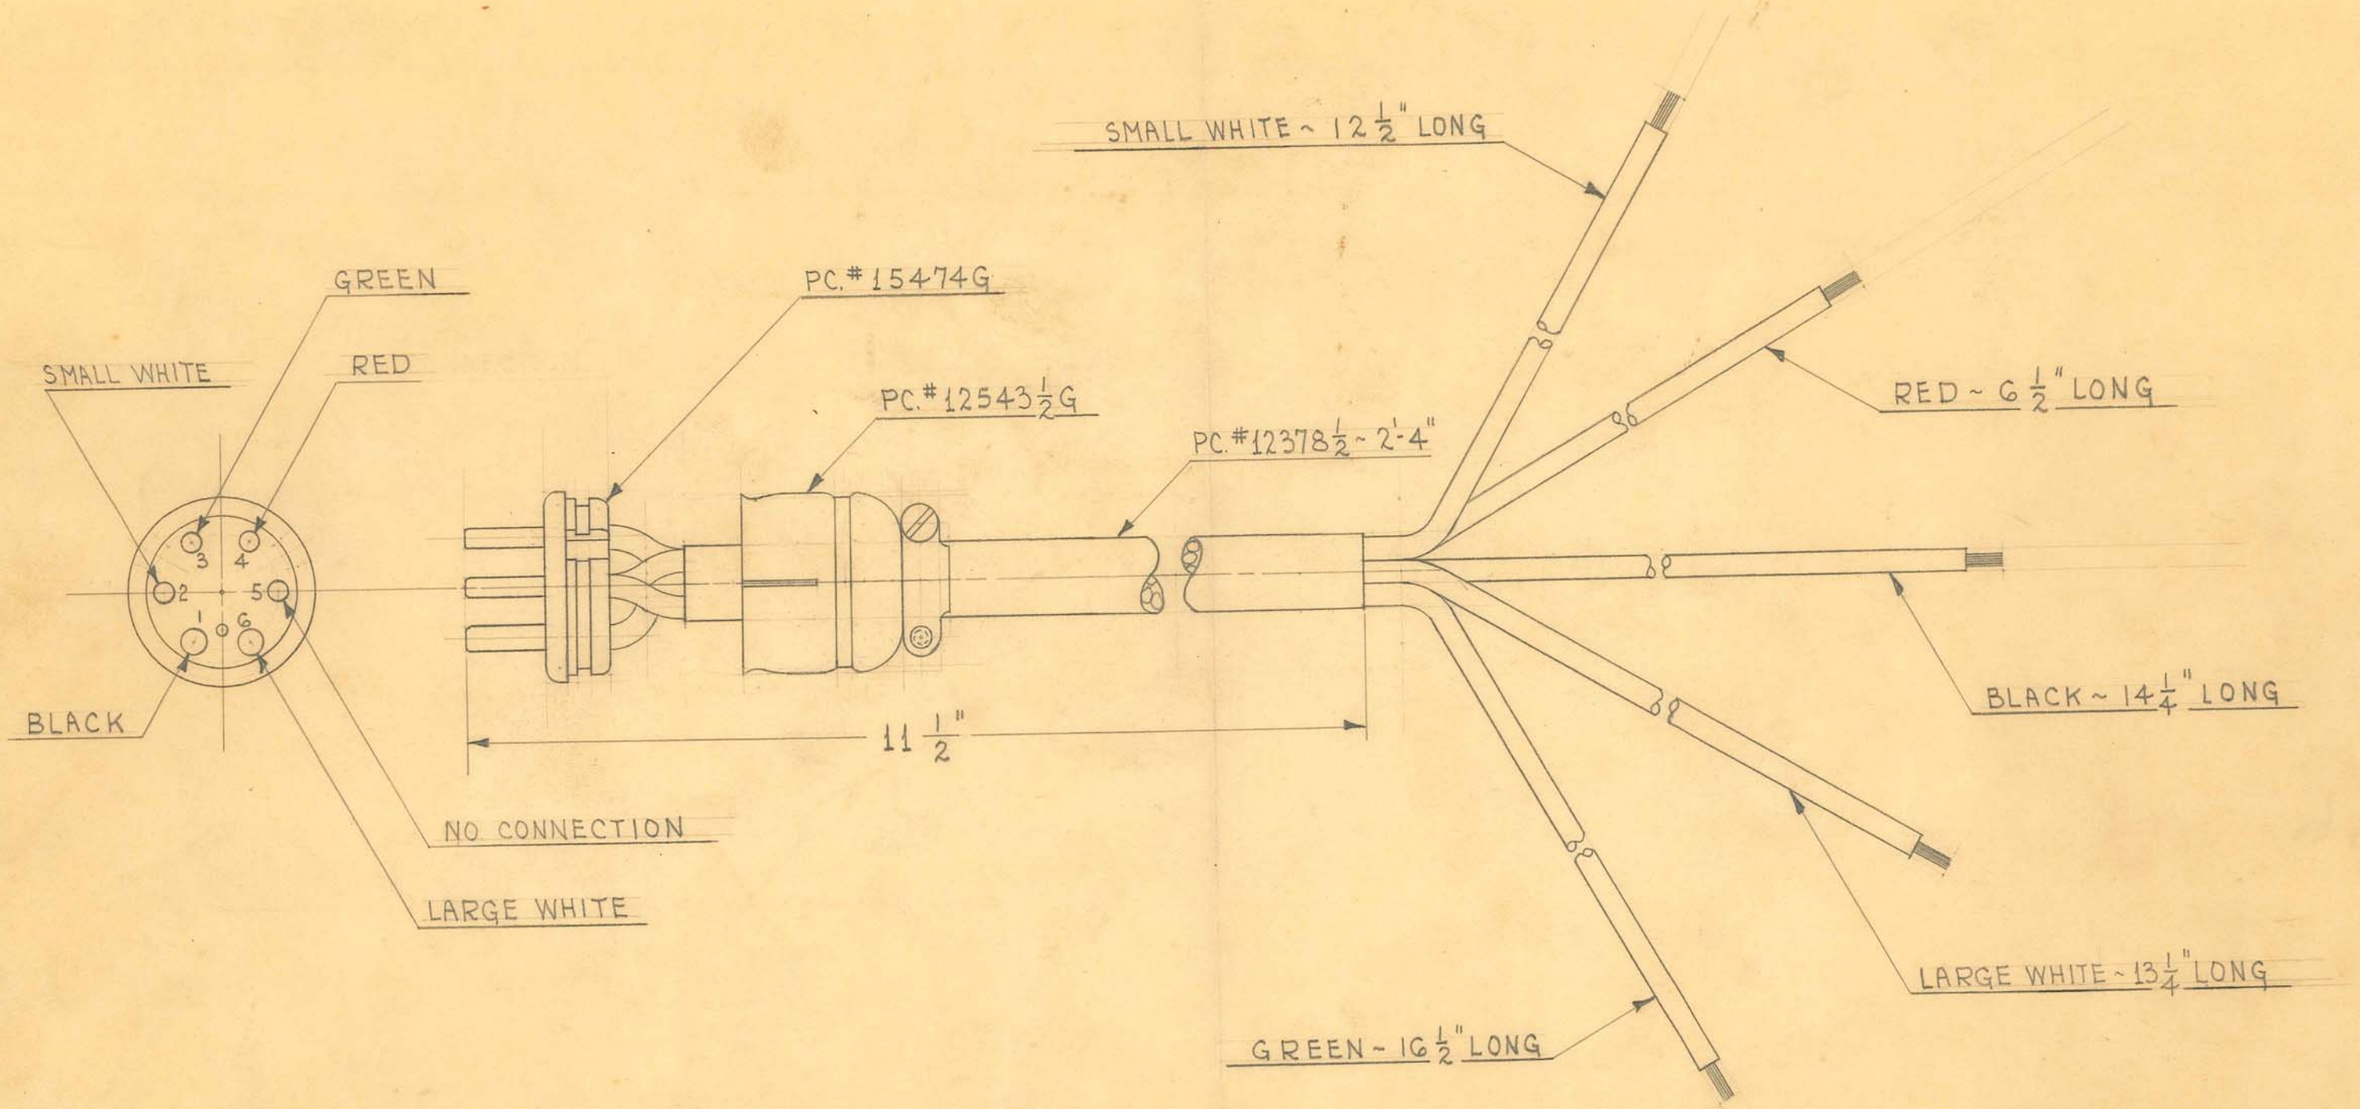

1 REQUIRED

NOTE:

IN ASSEMBLY OF PLUG & CORD, TURN CORD SO THAT WIRES COME OUT IN ORDER SHOWN, TO AVOID TWIST-OVER.

OBSOLETE

SIZE		ISSUE 3-30-44	HE.
KIND		CHANGED	
SHAPE		"	
FINISH		"	
TEMP.		"	
PATT.		"	

TITLE: FISCHER "VC" SHORT WAVE APPARATUS ~ AMP. COMP. ~ POWER CORD ASSEM.

H. G. FISCHER & CO.
2335 WABANSIA AVE.
CHICAGO. ILL.

CAT. NO.

PART NO. 15475G

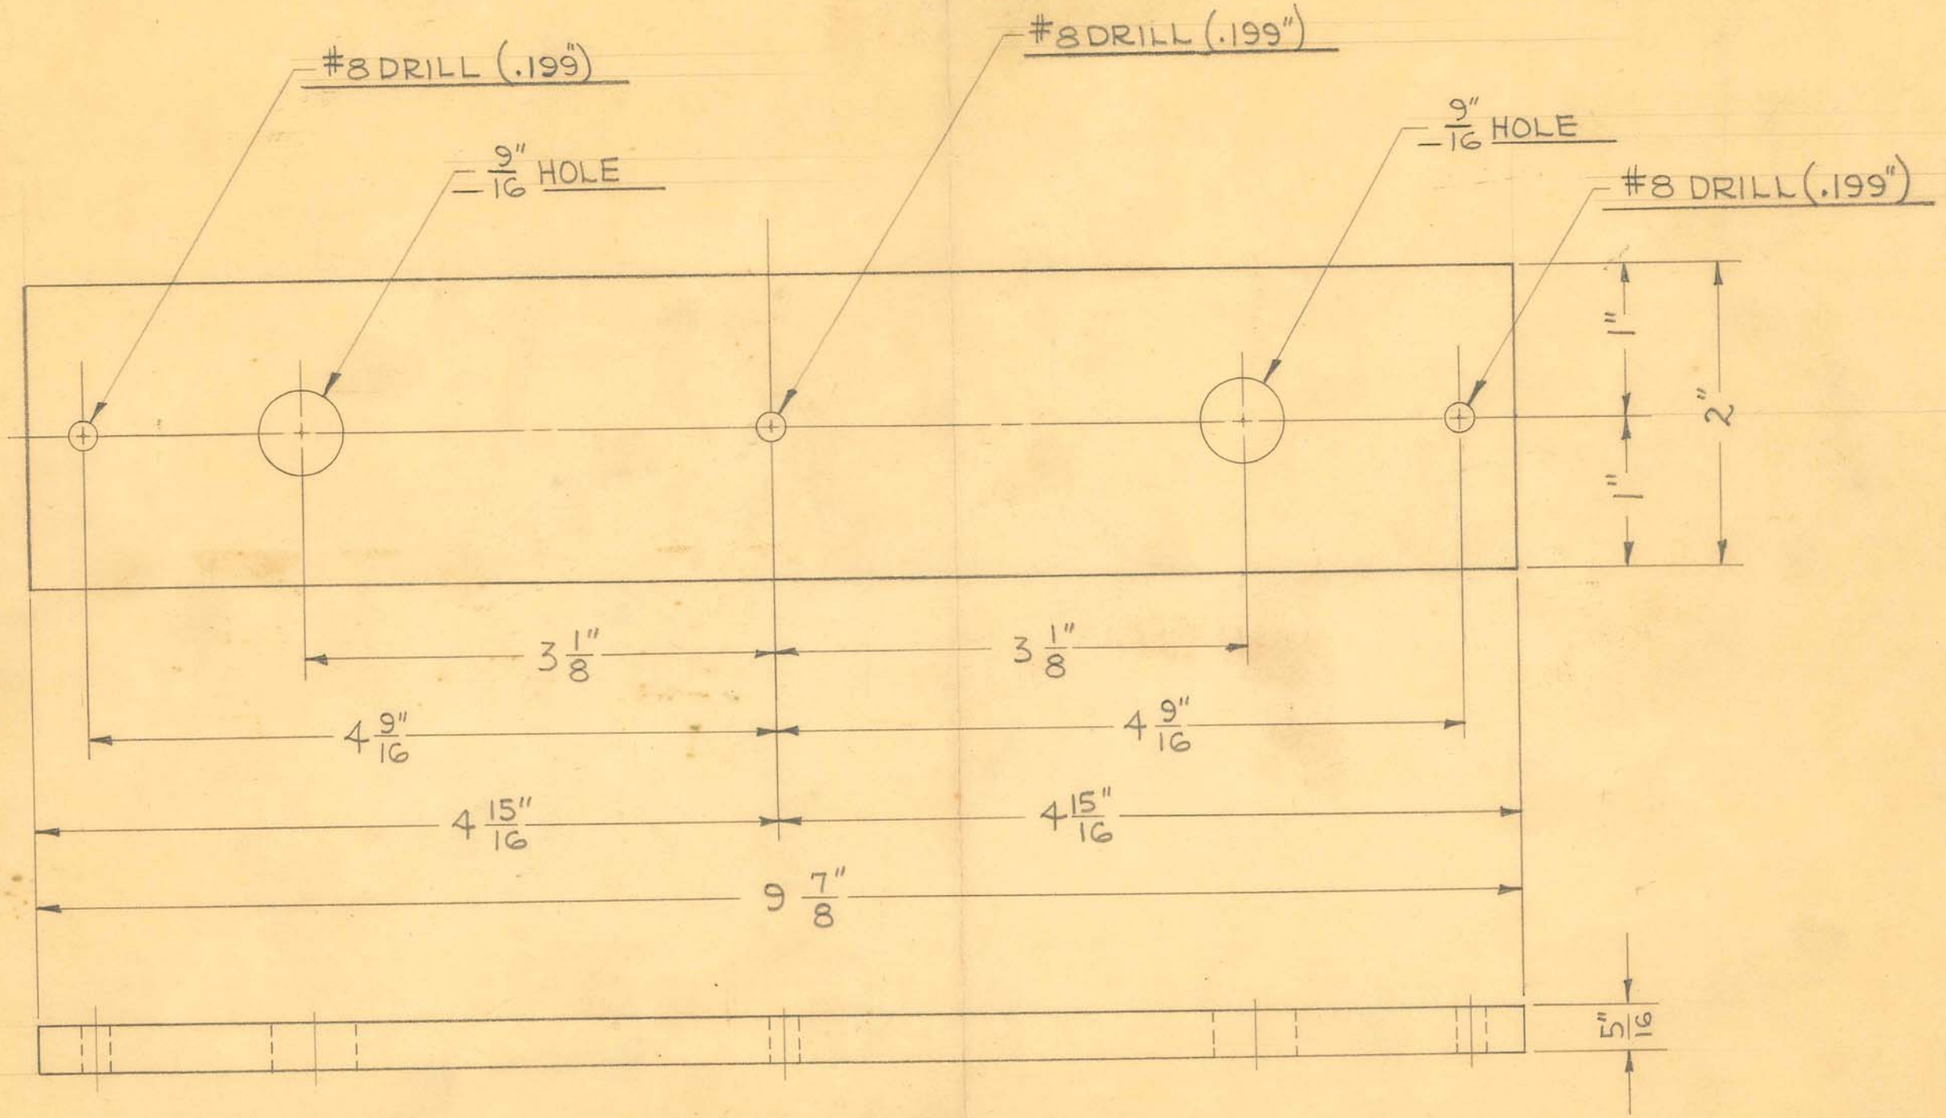

1 REQUIRED

OBSOLETE

SIZE	MYKROY	ISSUE 2-26-44	J.V.W.	TITLE: FISCHER "VC" SHORT WAVE APP. AMPLIFIER COMP. INDUCTION SOCKET MTG. BOARD
KIND		CHANGED		
SHAPE		"		
FINISH		"		
TEMP.		"		
PATT.		"		

H. G. FISCHER & CO.
2335 WABANSIA AVE.
CHICAGO. ILL.

CAT. NO.

PART NO. 15482

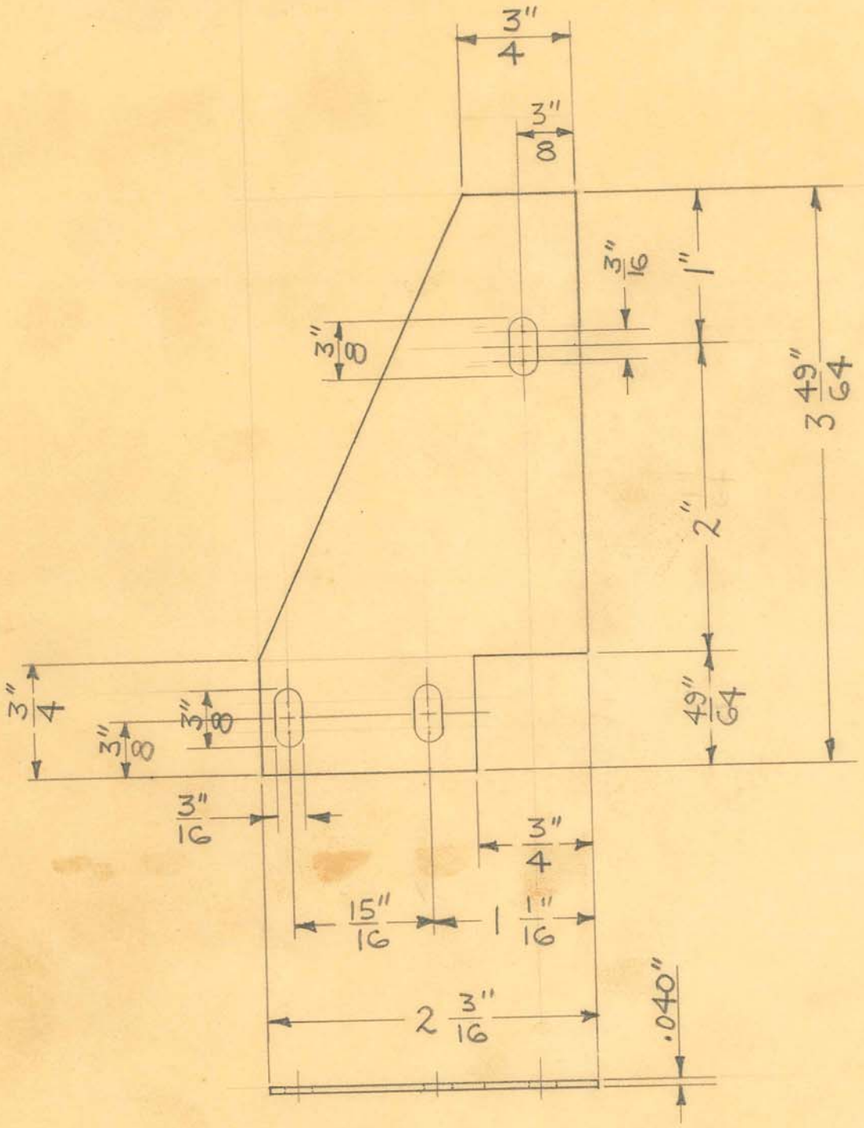

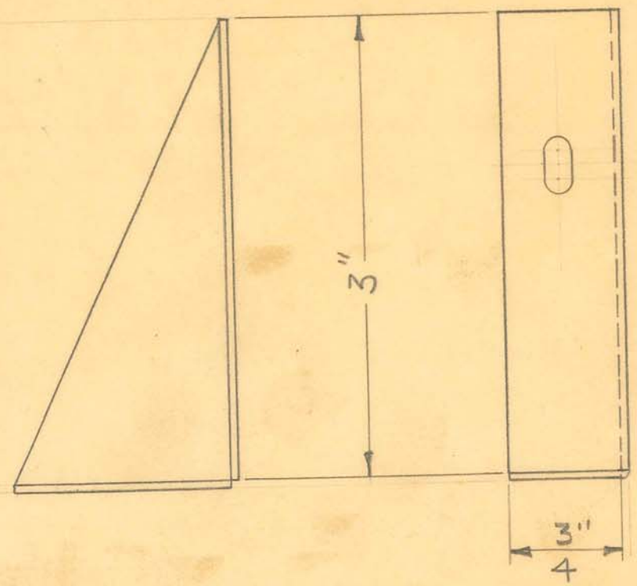

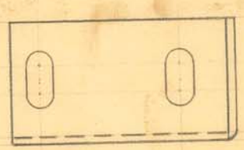

.040" SHEET C.R. STEEL

3 REQUIRED

OBSOLETE

SIZE		ISSUE 2-28-44	J.V.W.
KIND		CHANGED	
SHAPE		"	
FINISH		"	
TEMP.		"	
PATT.		"	

TITLE: FISCHER "VC" SHORT WAVE APP.
AMP. COMP. - INDUCTION SOCKET MTG. BOARD BRACKET

H. G. FISCHER & CO.
2335 WABANSIA AVE.
CHICAGO, ILL.

CAT. NO.

PART NO. 15483

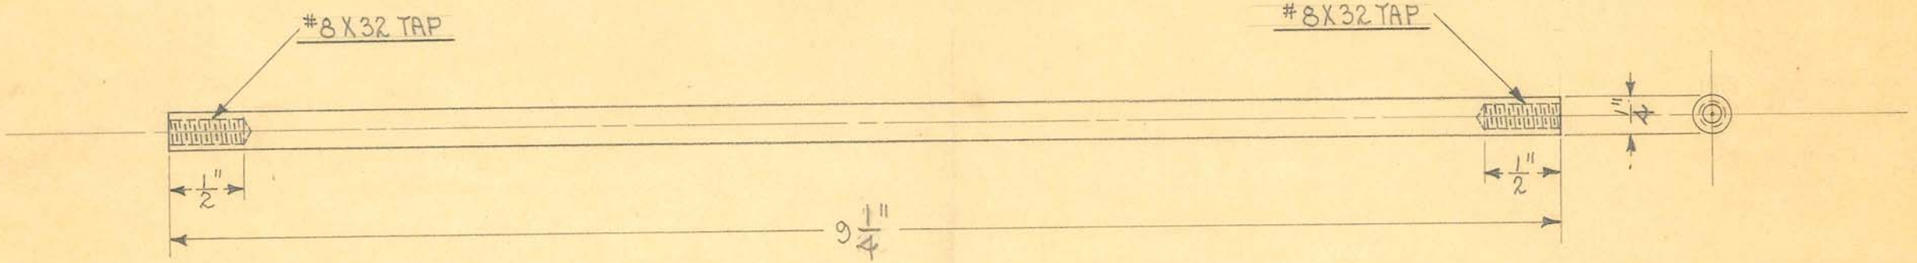

1 REQUIRED

OBSOLETE

SIZE	1/4"	ISSUE 3-28-33	H.E.
KIND	STAINLESS STEEL	CHANGED	
SHAPE		" "	
FINISH		" "	
TEMP.		" "	
PATT.		" "	

TITLE: SHORT WAVE HIGH FREQ. OUTFIT VARIOMETER SLIDER SUPP. GUIDE ROD - LARGE

H. G. FISCHER & CO.
2335 WABANSIA AVE.
CHICAGO, ILL.

CAT. NO.

PART NO. 8724

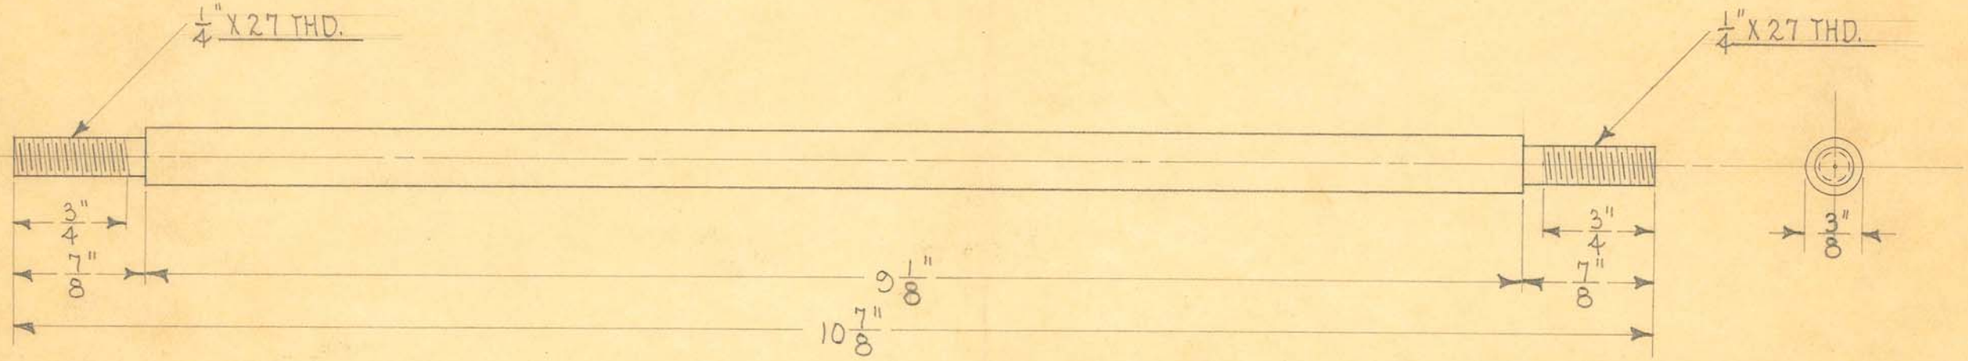

1 REQUIRED

OBSOLETE

SIZE	3/8" BLACK	ISSUE 6-11-34	A.E.
KIND	BAKELITE ROD XX	CHANGED	
SHAPE		" "	
FINISH		" "	
TEMP.		" "	

TITLE: SHORT WAVE HIGH FREQ. OUTFIT VARIOMETER COIL TUBE SUPPORT ROD

H. G. FISCHER & CO.
2335 WABANSIA AVE.

CAT. NO.

PART NO. 8718

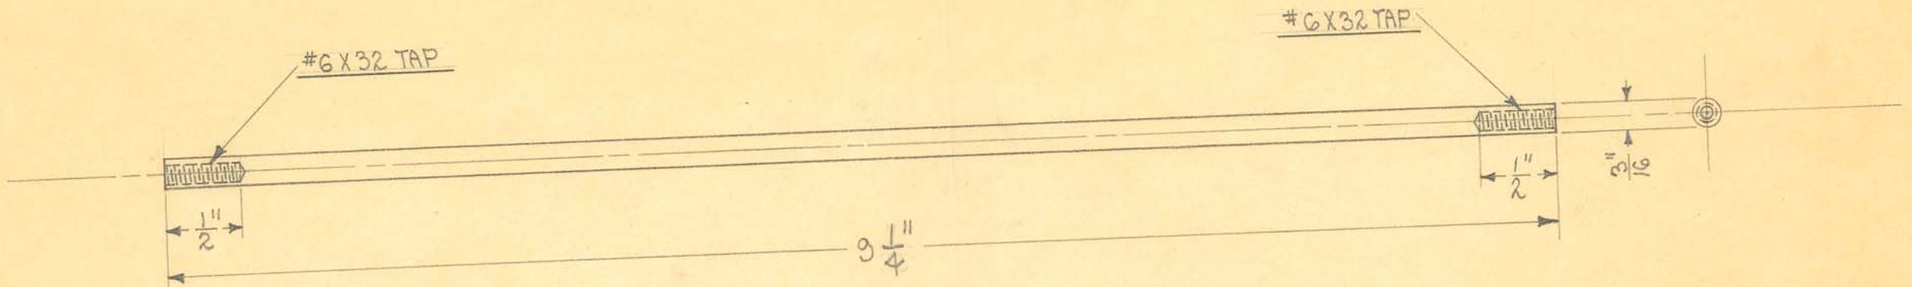

1 REQUIRED

OBSOLETE

SIZE	3/16"	ISSUE 3-28-33	H.E.	TITLE: SHORT WAVE HIGH FREQ. OUTFIT VARIOMETER SLIDER SUPP. GUIDE ROD - SMALL
KIND	BRASS ROD	CHANGED		
SHAPE		" "		
FINISH		" "		
TEMP.		" "		H. G. FISCHER & CO. 2335 WABANSIA AVE. CHICAGO, ILL. — CAT. NO. — PART NO. 8725
PATT.		" "		

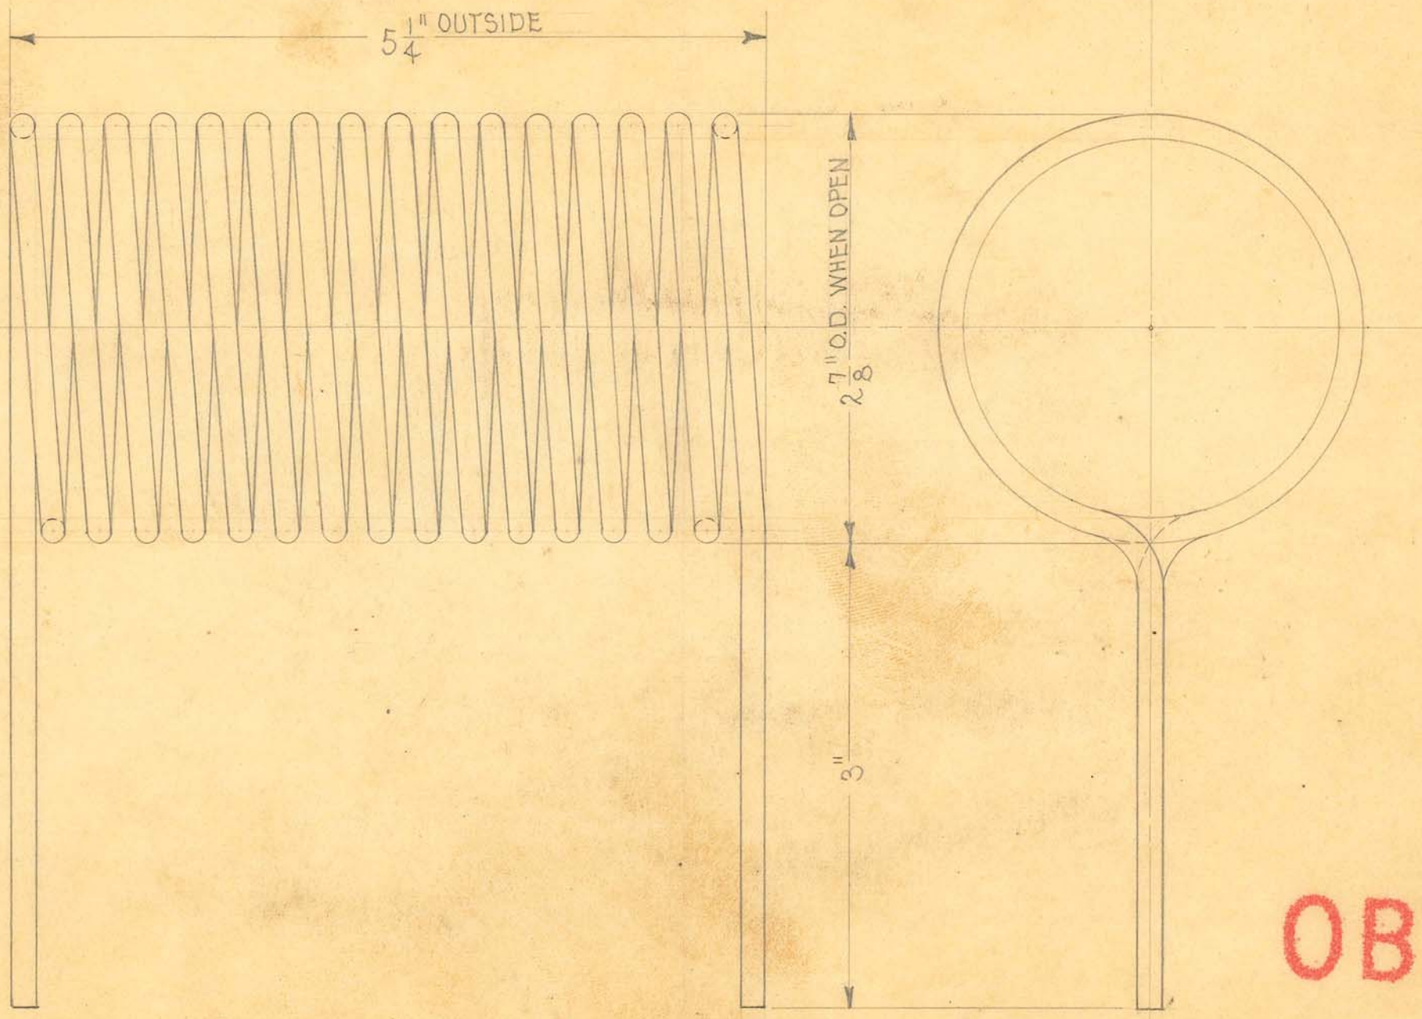

OBSOLETE

16 TURNS
1 REQUIRED

SIZE	#6 BARE	ISSUE 7-18-34	2.8.
KIND	COPPER WIRE	CHANGED	
SHAPE		" "	
FINISH		" "	
TEMP.		" "	

TITLE:
SHORT WAVE HIGH FREQUENCY OUTFIT
GRID COIL

H. G. FISCHER & CO.
2335 WABANSIA AVE.

CAT. NO.

PART NO. 8736

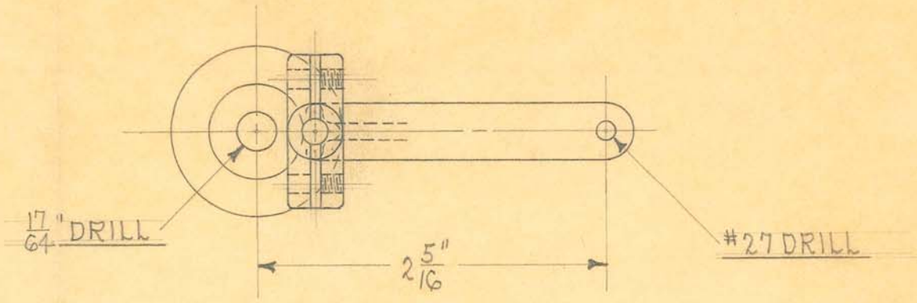

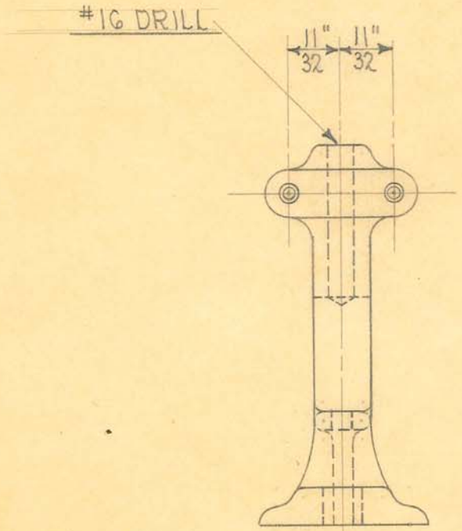

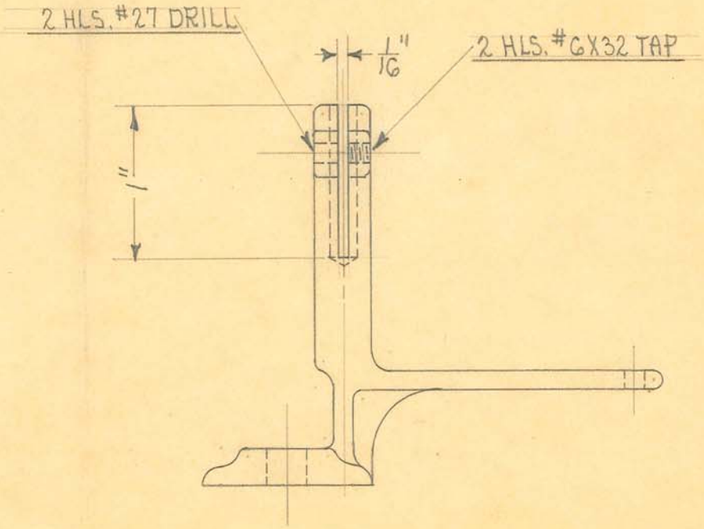

2 REQUIRED

OBSOLETE

SIZE		ISSUE 2-28-34	A.E.	TITLE: ULTRA SHORT WAVE HIGH FREQ. OUTFIT SMALL COIL SUPPORT
KIND	BRASS CASTING	CHANGED		
SHAPE		" "		
FINISH	W.P.	" "		
TEMP.		" "		
DATE	8-24-731	" "		

H. G. FISCHER & CO.
2335 WABANSIA AVE.
CHICAGO, ILL.

CAT. NO.

PART NO. 8738F

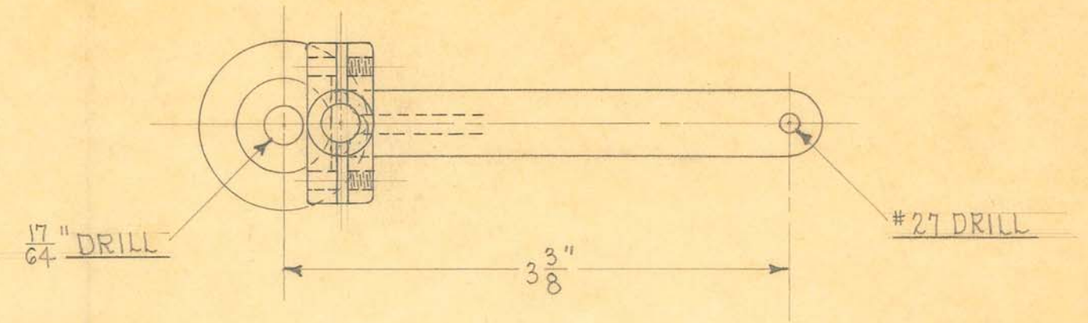

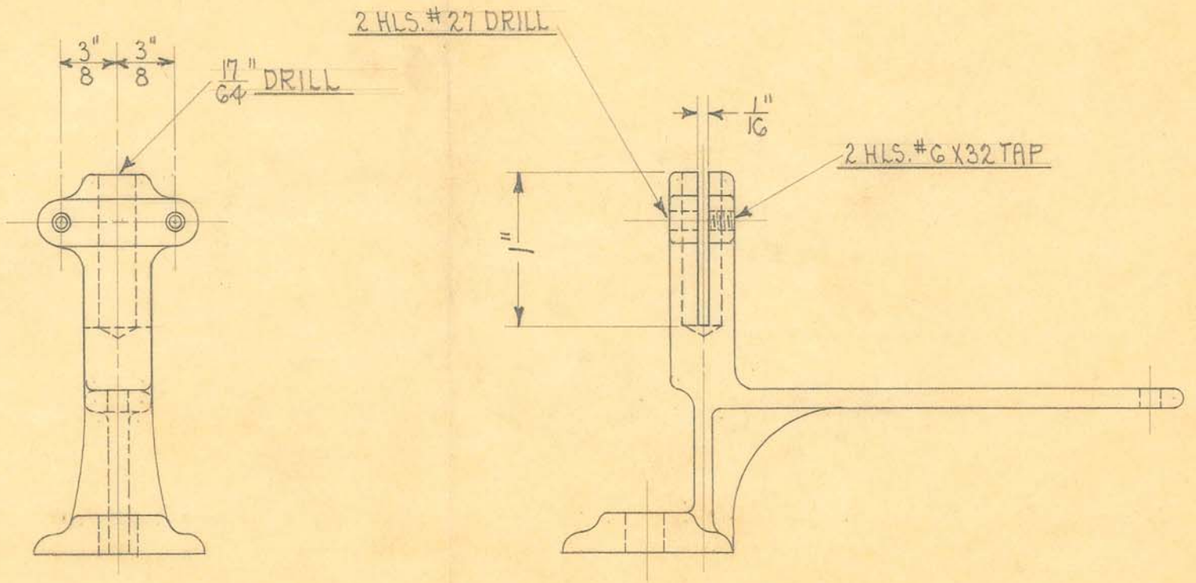

2 REQUIRED

OBSOLETE

SIZE		ISSUE 2-28-34	A.E.
KIND	BRASS CASTING	CHANGED	
SHAPE		" "	
FINISH	W.P.	" "	
TEMP.		" "	
PATT.	86-73-723	" "	

TITLE: ULTRA SHORT WAVE HIGH FREQ. OUTFIT
LARGE COIL SUPPORT

H. G. FISCHER & CO.
2335 WABANSIA AVE.
CHICAGO, ILL.

CAT. NO.

PART NO. 8739F

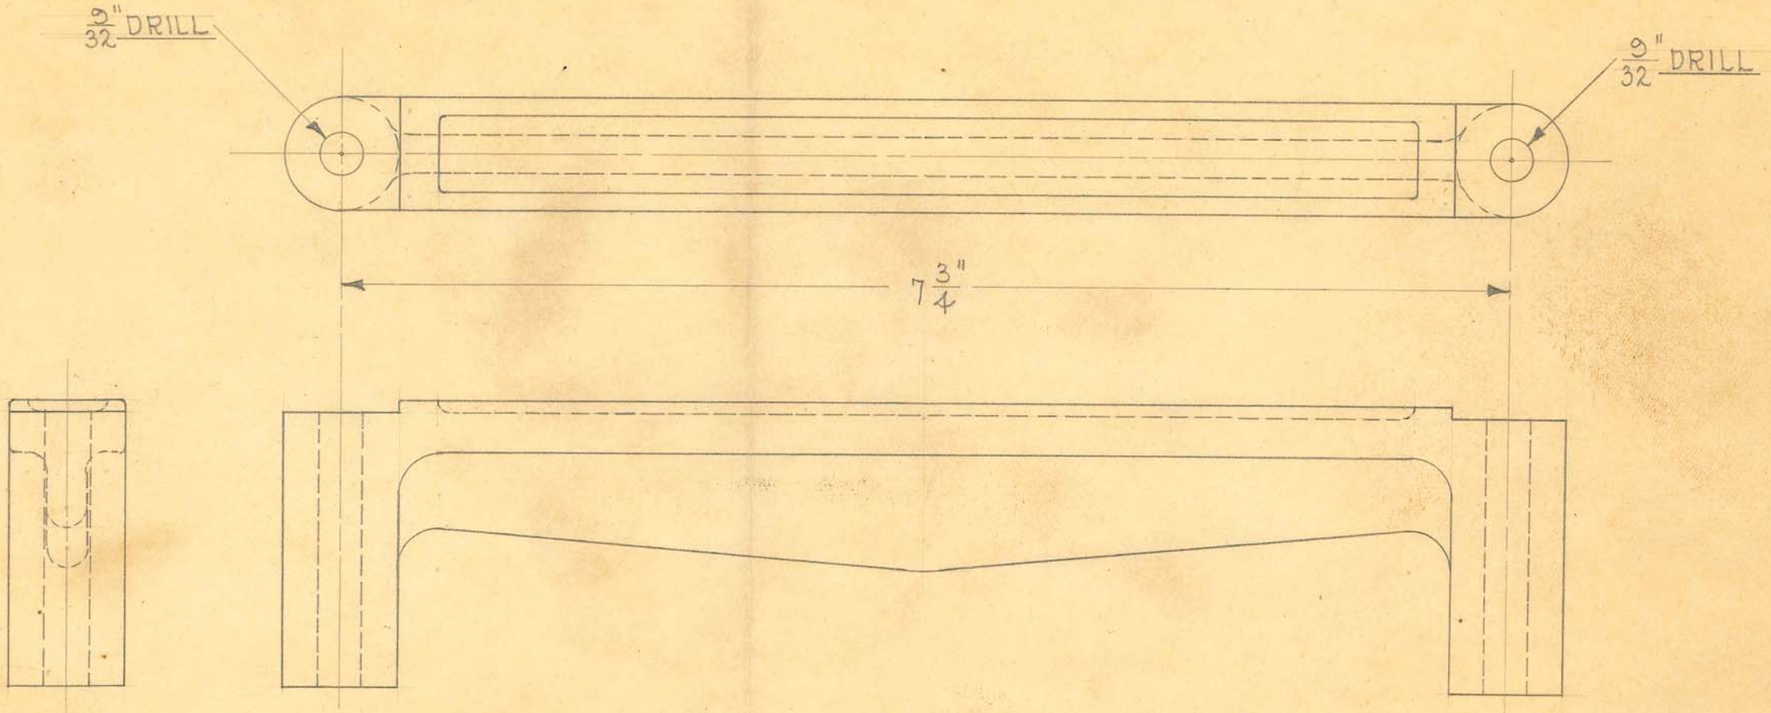

1 REQUIRED

OBSOLETE

SIZE		ISSUE 6-30-34	A.E.
KIND	IRON CASTING	CHANGED	
SHAPE		" "	
FINISH	BLACK #50	" "	
TEMP.		" "	
PATT.	134-739	" "	

TITLE:
SHORT WAVE HIGH FREQ. OUTFIT
TRANSFORMER SUPPORT-UPPER

H. G. FISCHER & CO.
2335 WABANSIA AVE.
CHICAGO, ILL.

CAT. NO.

PART NO. 8756F

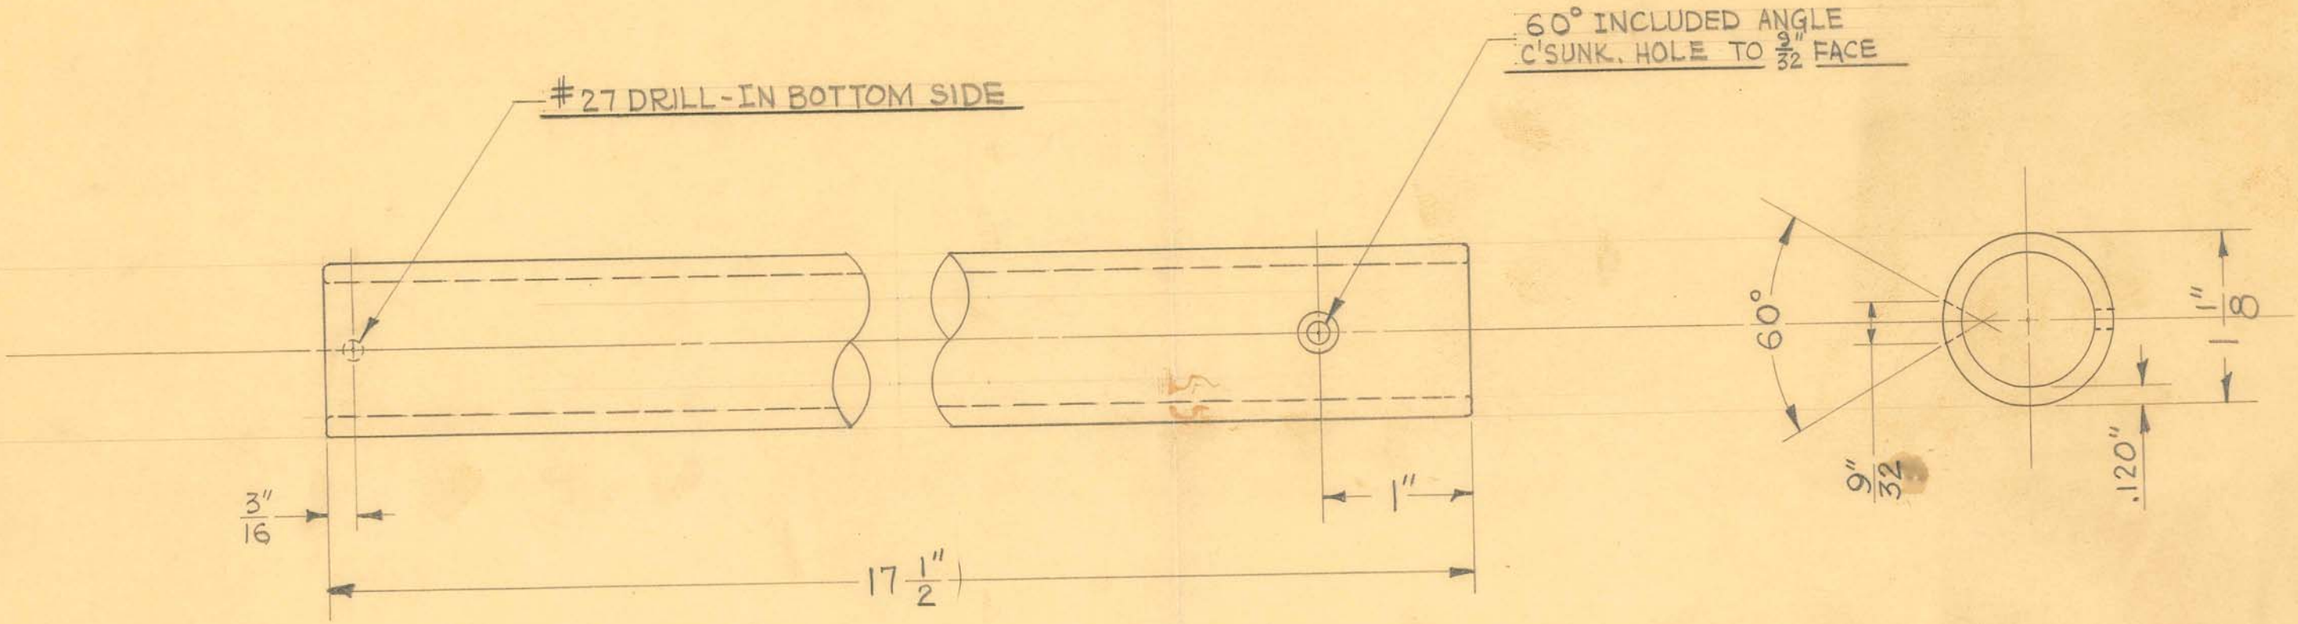

1 1/8" O.D. X #11GA. (.120") WALL SHELBY SEAMLESS STEEL TUBING

1 REQUIRED

OBSOLETE

SIZE		ISSUE 10-28-41	J.Y.W.
KIND		CHANGED	
SHAPE		"	
FINISH	CHROME #2	"	
TEMP.		"	
DATE		"	

TITLE: FISCHER MOD. "PN" PORTABLE X-RAY HEAD HORIZONTAL SLIDE TUBE

H. G. FISCHER & CO.
2335 WABANSIA AVE.
CHICAGO, ILL.

CAT. NO.

PART NO. 14362

4 HLS.-#25 DRILL C'SUNK. FOR #6 O. HD. SCREW.

DIVIDE CIRCLE INTO 11 EQUAL SPACES ON 1 1/8" RAD. STARTING FROM POINT SHOWN.

2 HLS.-#25 DRILL

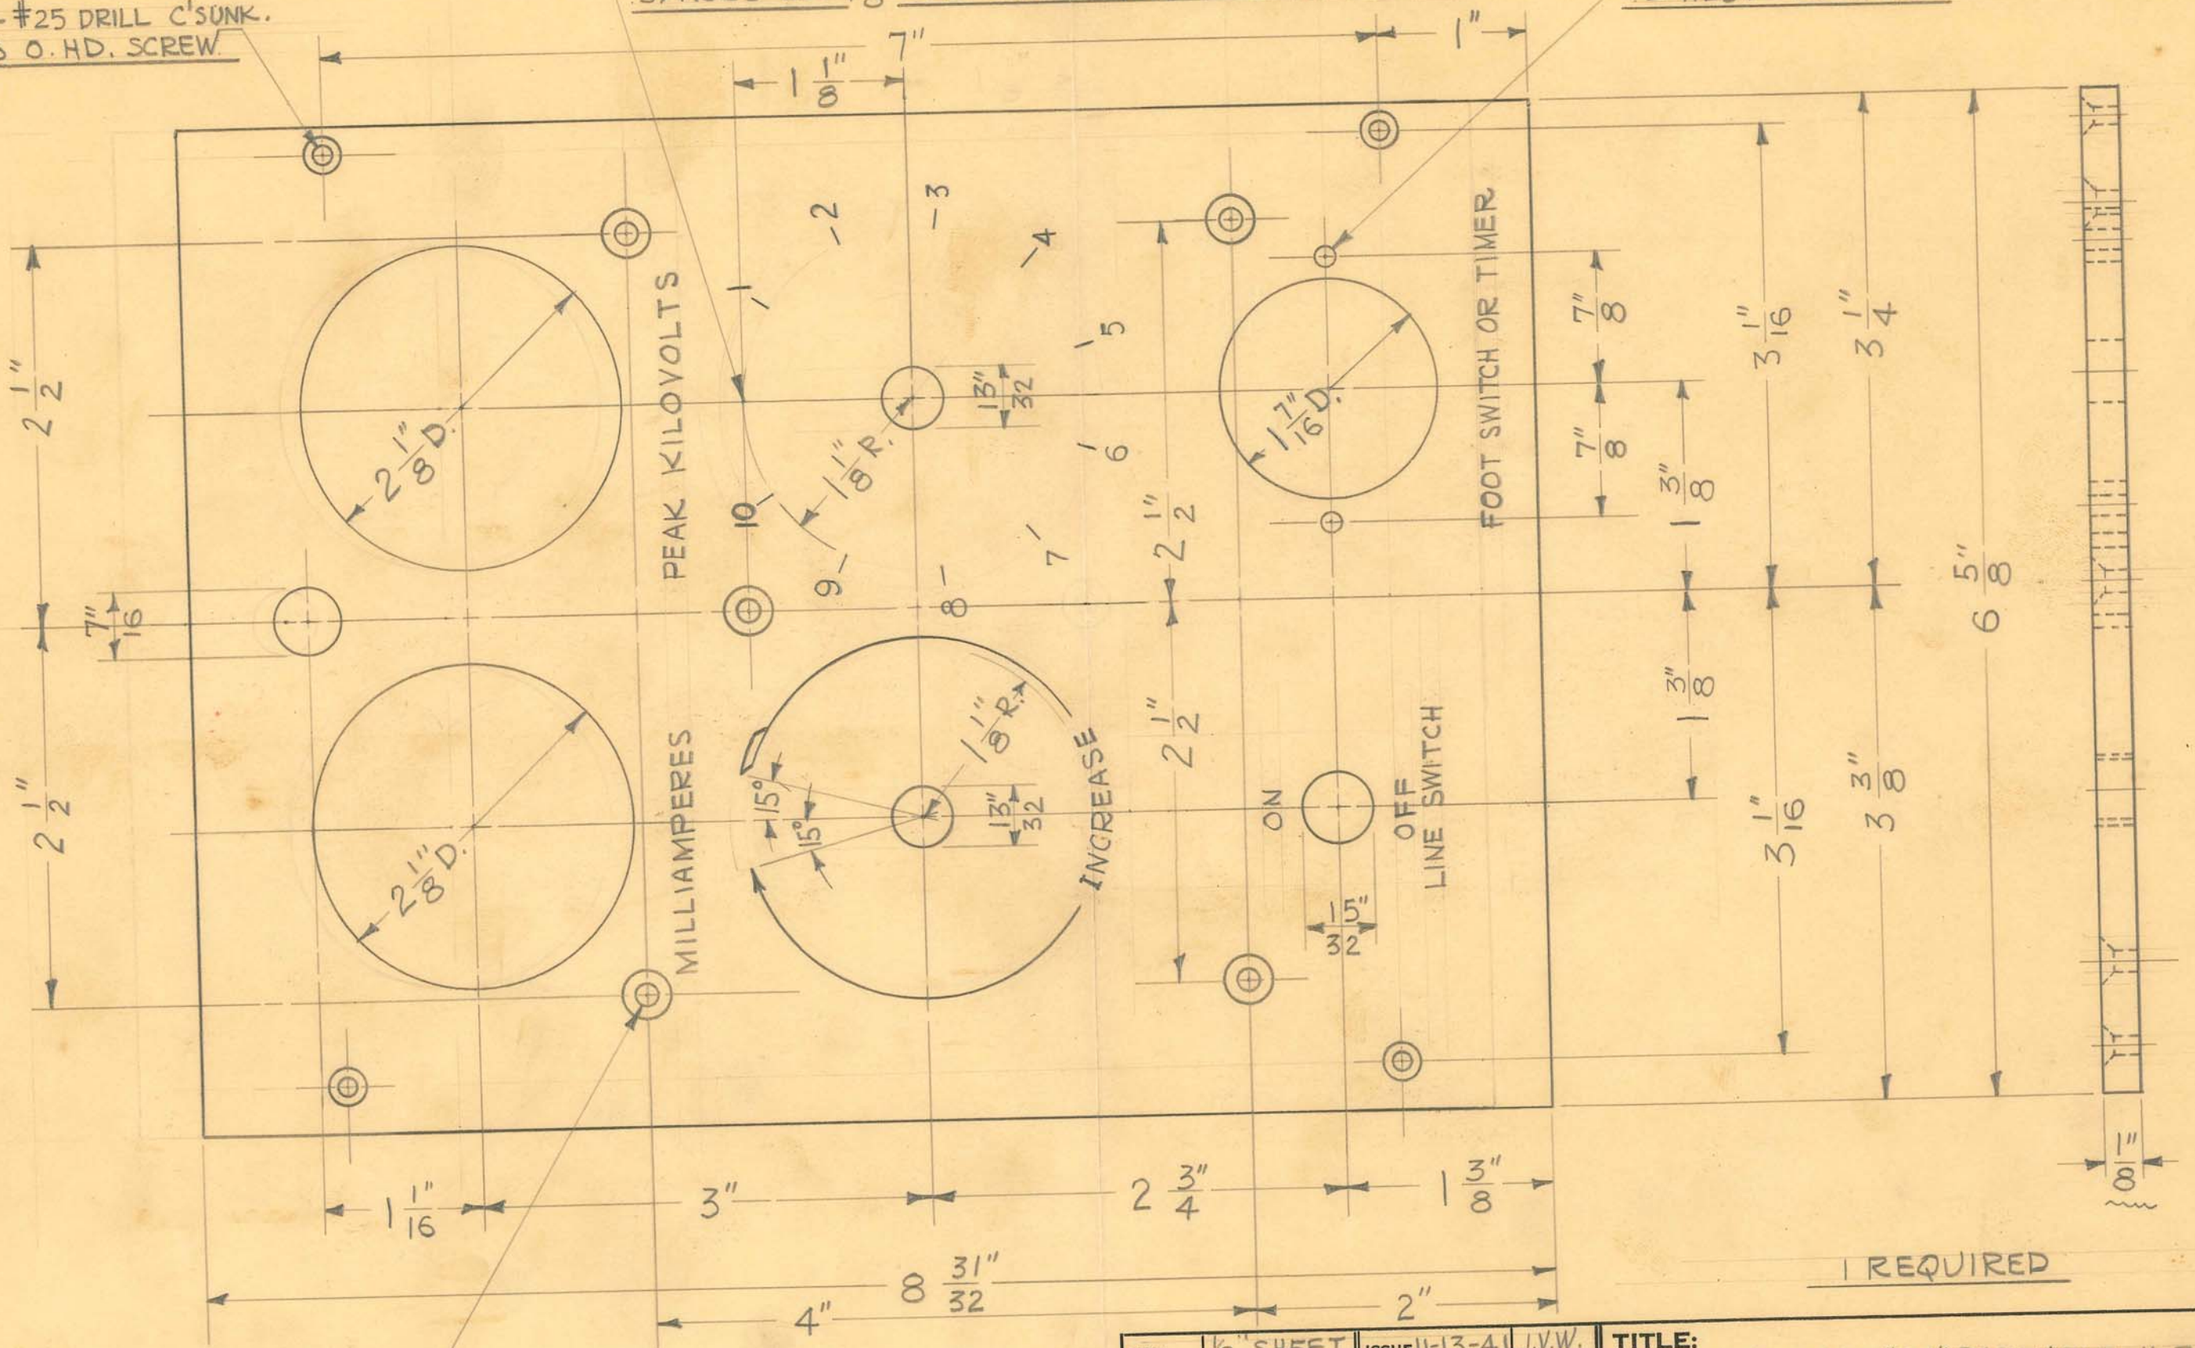

1 REQUIRED

5 HLS.-#18 DRILL C'SUNK. FOR #8 O. HD. SCREW

SIZE	1/8" SHEET	ISSUE 11-13-41	J.V.W.
KIND	LAMICOID	CHANGED	
SHAPE		"	
FINISH		"	
TEMP.		"	
PATT.		"	

TITLE: FISCHER MOD. "PN" PORTABLE X-RAY DOUBLE METER CONTROL PANEL (ENGR.)

OBSOLETE

H. G. FISCHER & CO. 2338 WABANSIA AVE. CHICAGO. ILL.

CAT. NO.

PART NO. 14367F

4 HLS.-#25 DRILL C'SUNK.
FOR #6 O. HD. SCREW

2 HLS.-#25 DRILL

7"

1"

2 1/8" D.

VOLTAGE

15/32" ON

OFF

LINE SWITCH

5/16"

1 5/16"

1 5/16"

7/16

1 7/16" D.

FOOT SWITCH OR TIMER

2 1/8"

3 1/16"

3 1/4"

6 5/8"

7/8"

7/8"

2 1/8"

1 1/16"

3/16

3 3/8"

3/8

9/16"

2 HLS.-#18 DRILL-C'SUNK.
FOR #8 OVAL HD. SCR.

1/8"

1 REQUIRED

2 5/8"

2 3/8"

1 7/8"

8 31/32"

OBSOLETE

SIZE	FROM 14367	ISSUE 11-12-41	J.V.W.
KIND		CHANGED	
SHAPE		"	
FINISH		"	
TEMP.		"	
PATT.		"	

TITLE:
FISCHER MOD. "PN" PORTABLE X-RAY
SINGLE METER CONTROL PANEL (ENGR.)

H. G. FISCHER & CO.
2335 WABANSIA AVE.
CHICAGO, ILL.

CAT. NO.

PART NO. 14368

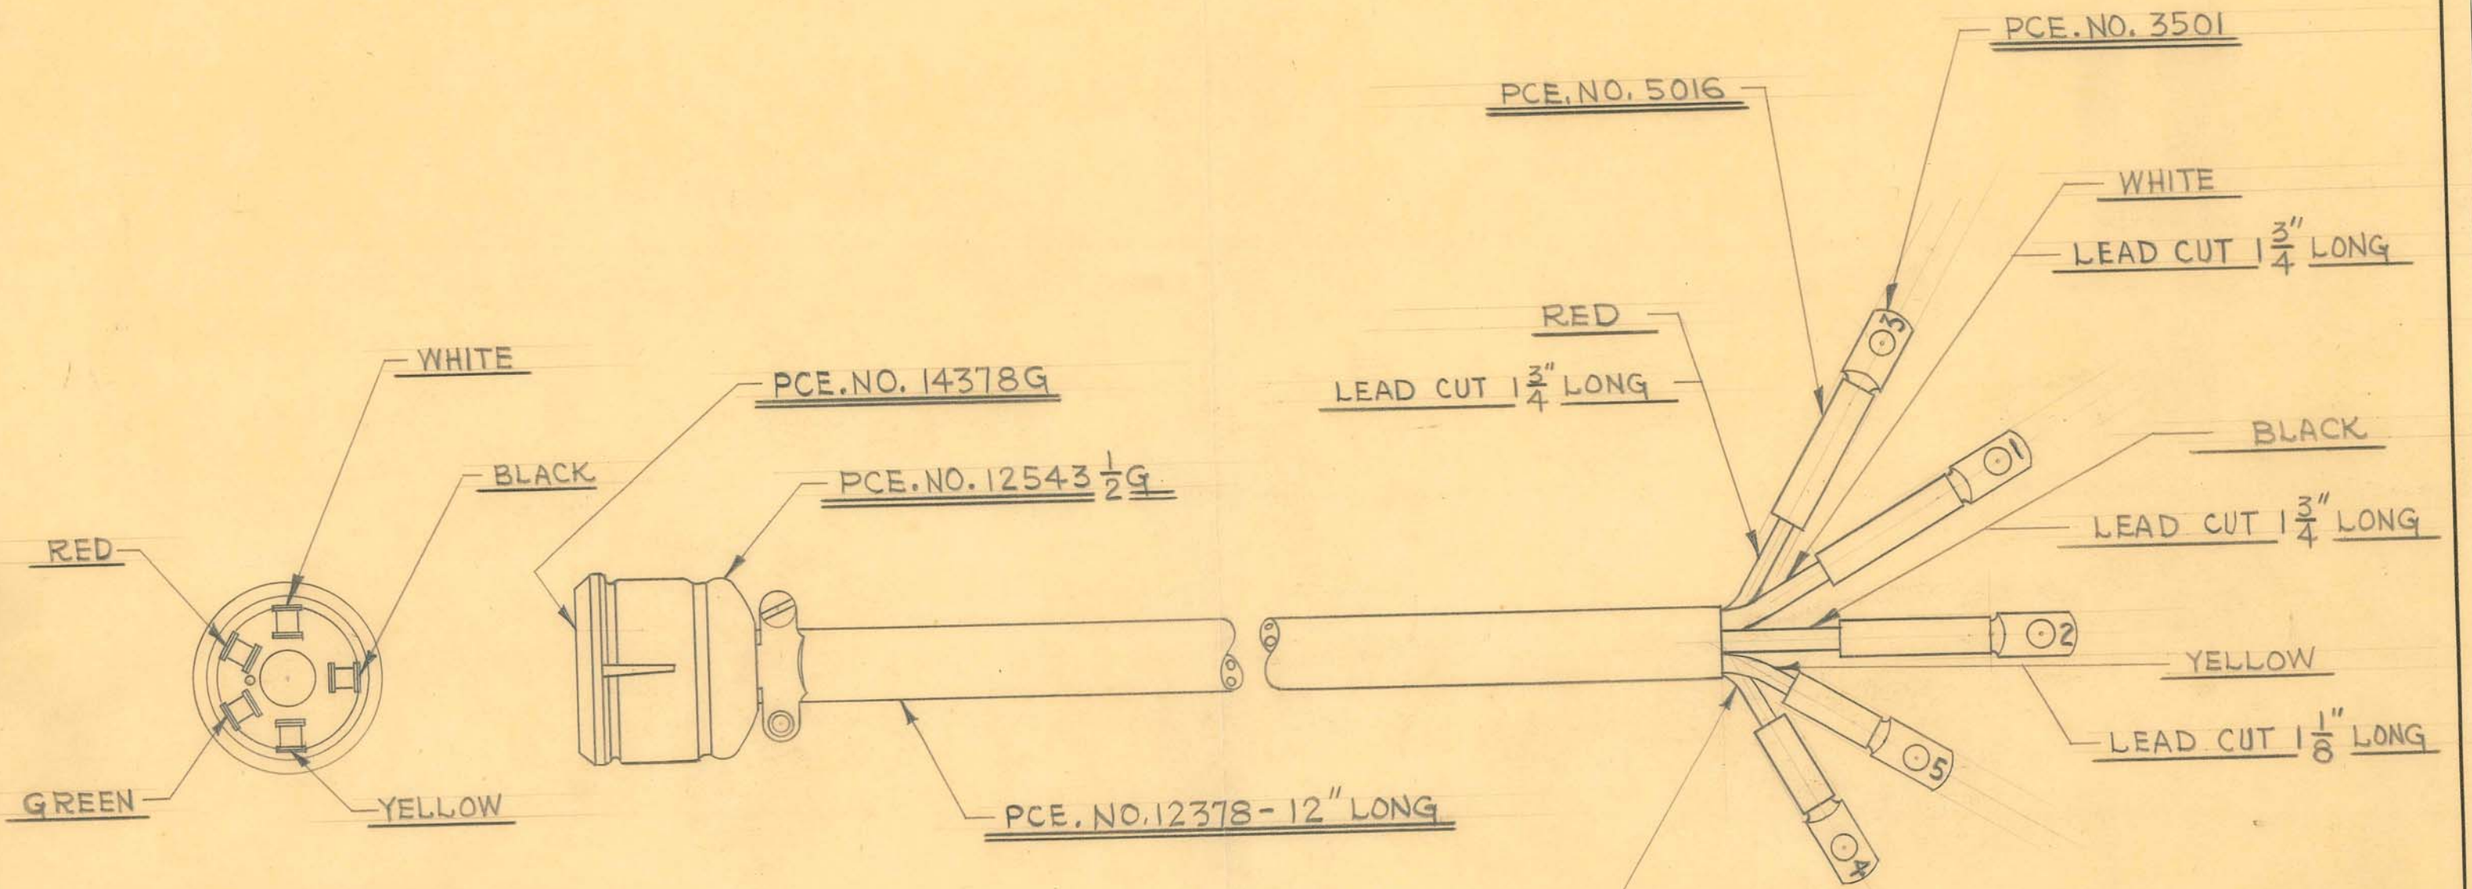

1 REQUIRED

OBSOLETE

SIZE		ISSUE 5-14-42	J.V.W.	TITLE: FISCHER MOD. "MN" X-RAY UNIT CONTROL - POWER CORD ASSEMBLY
KIND		CHANGED		
SHAPE		"		
FINISH		"		
TEMP.		"		
PATT.		"		

H. G. FISCHER & CO.
2335 WABANSIA AVE.
CHICAGO, ILL.

CAT. NO.

PART NO. 14370G

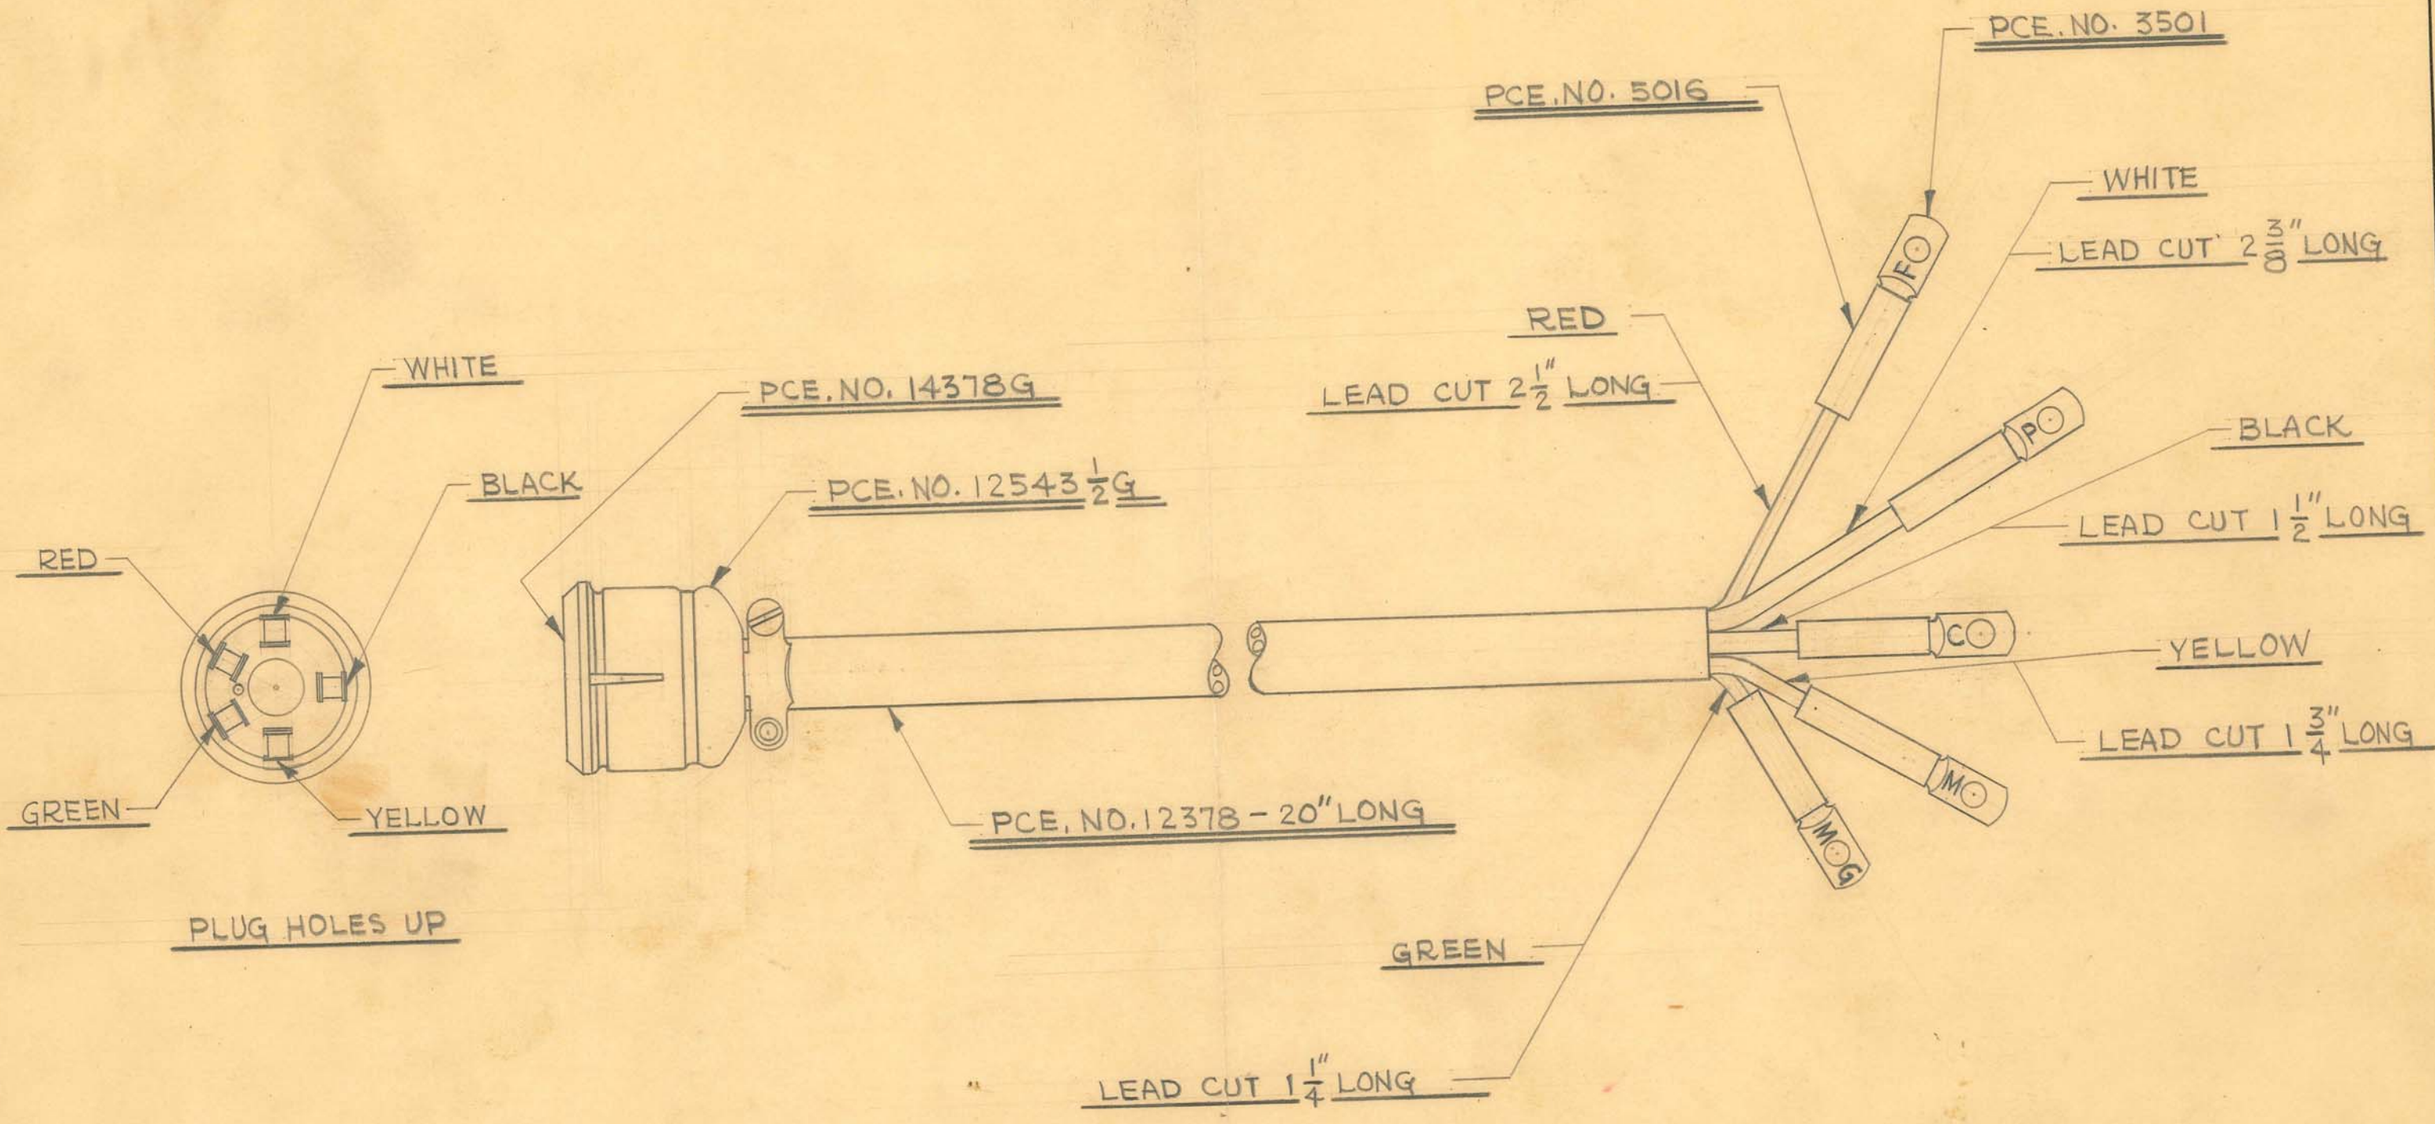

OBSOLETE

SIZE		ISSUE 1-20-42	J.V.W.	TITLE: FISCHER MOD. "PN" PORTABLE X-RAY CONTROL POWER CORD ASSEMBLY
KIND		CHANGED		
SHAPE		"		
FINISH		"		
TEMP.		"		
PATT.		"		

H. G. FISCHER & CO.
2338 WABANSIA AVE.
CHICAGO, ILL.

CAT. NO.

PART NO. 14374G

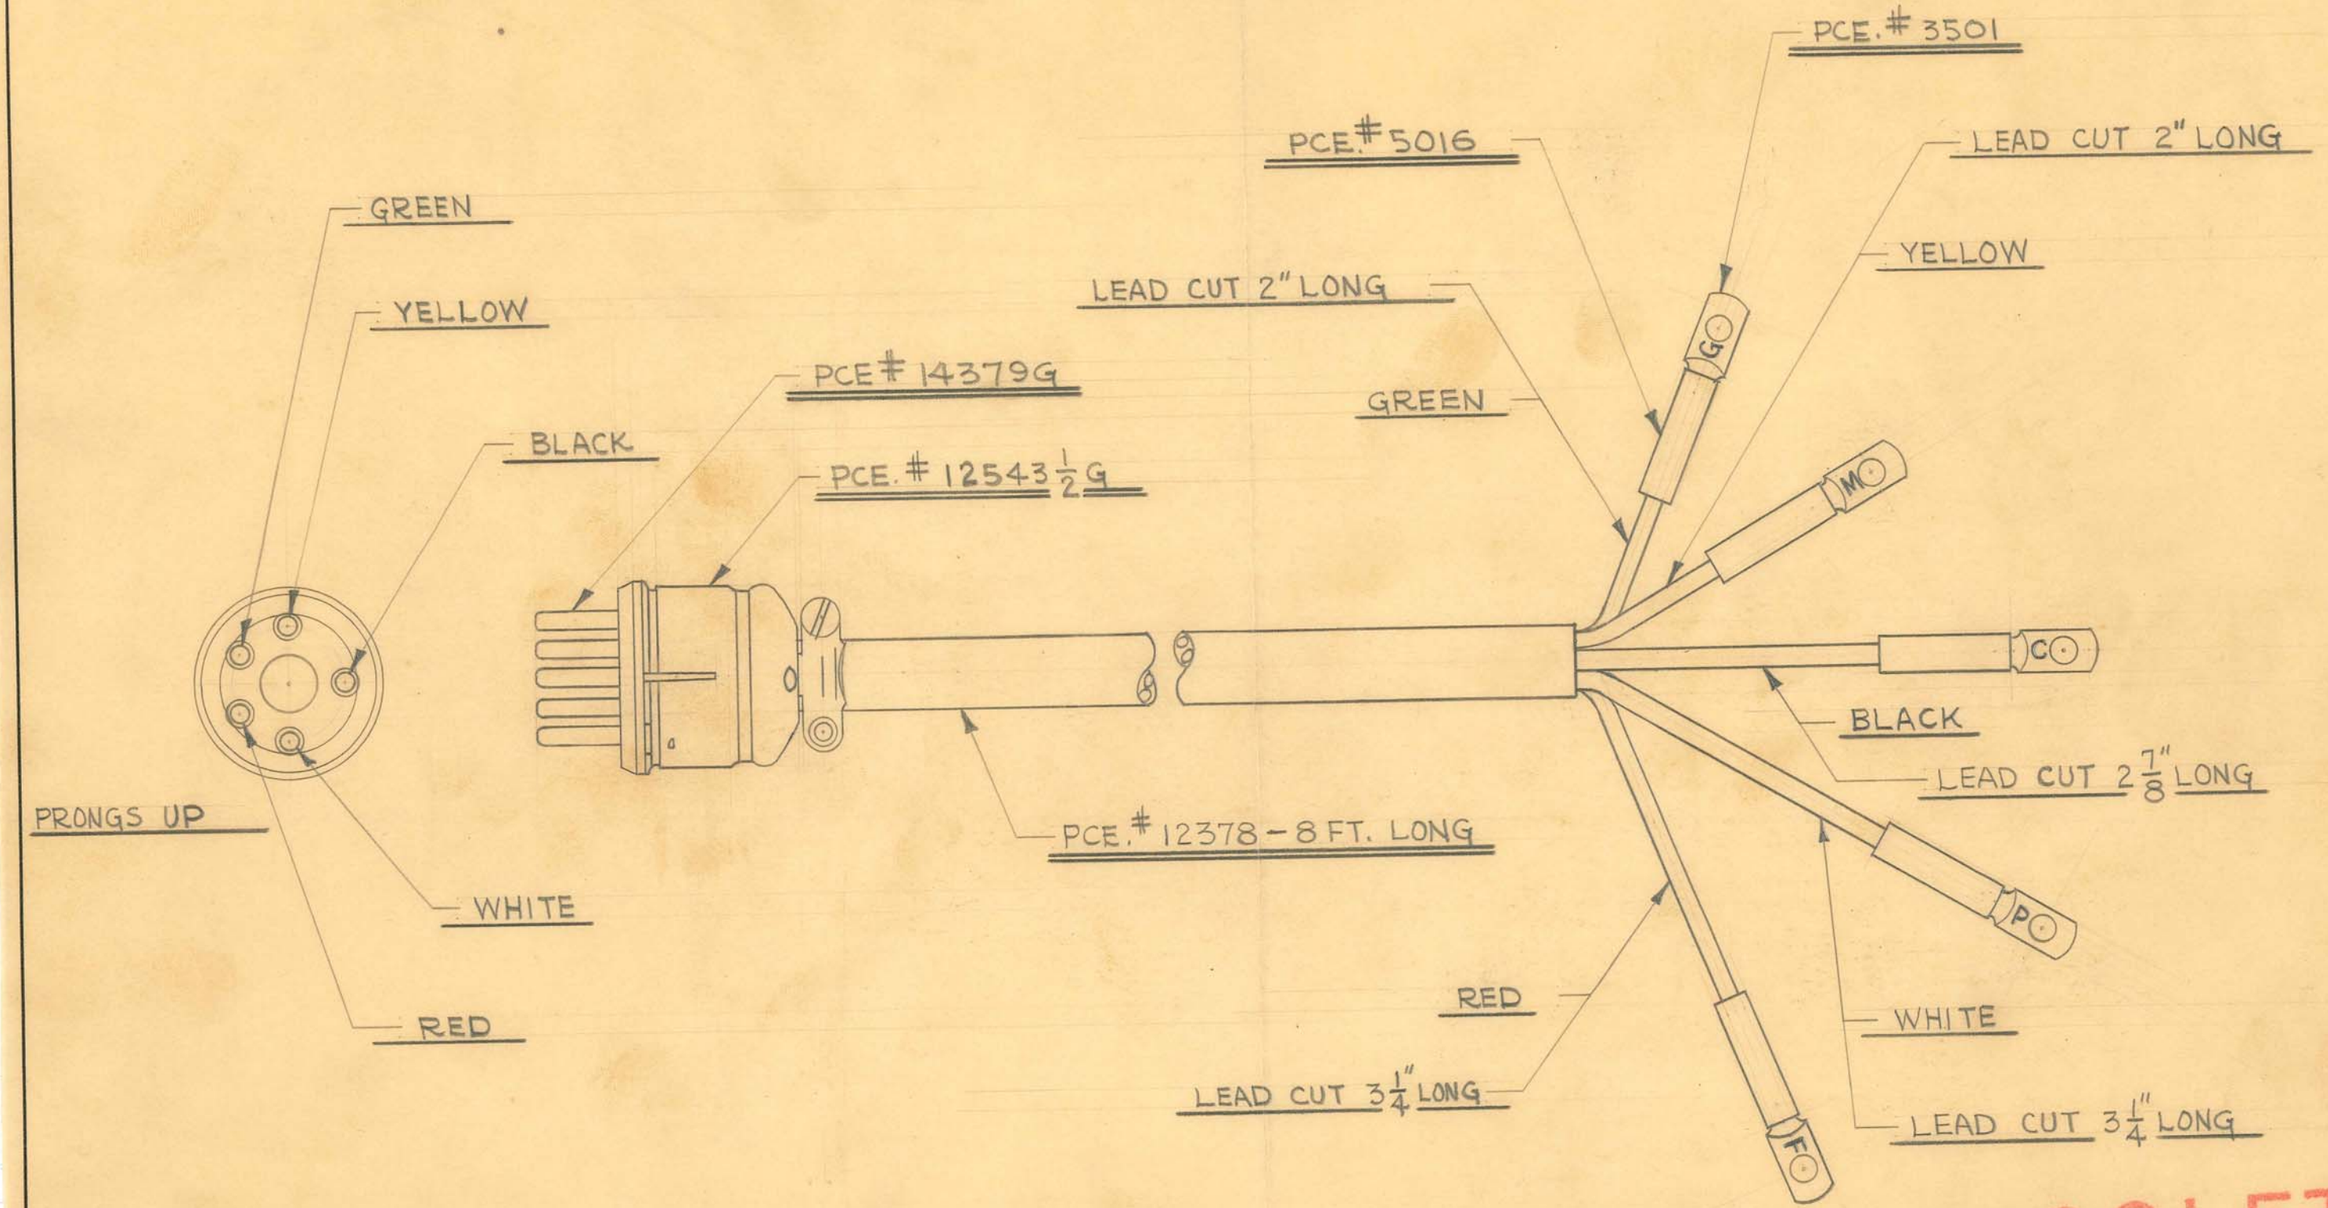

OBSOLETE

SIZE		ISSUE 1-19-42	J.Y.W.
KIND		CHANGED	
SHAPE		"	
FINISH		"	
TEMP.		"	
PATT.		"	

TITLE:
FISCHER MOD. "PN" PORTABLE X-RAY UNIT
TRANSF. HEAD POWER CORD ASSEM.

H. G. FISCHER & CO.
2335 WABANSIA AVE.
CHICAGO, ILL.

CAT. NO.

PART NO. 14382G

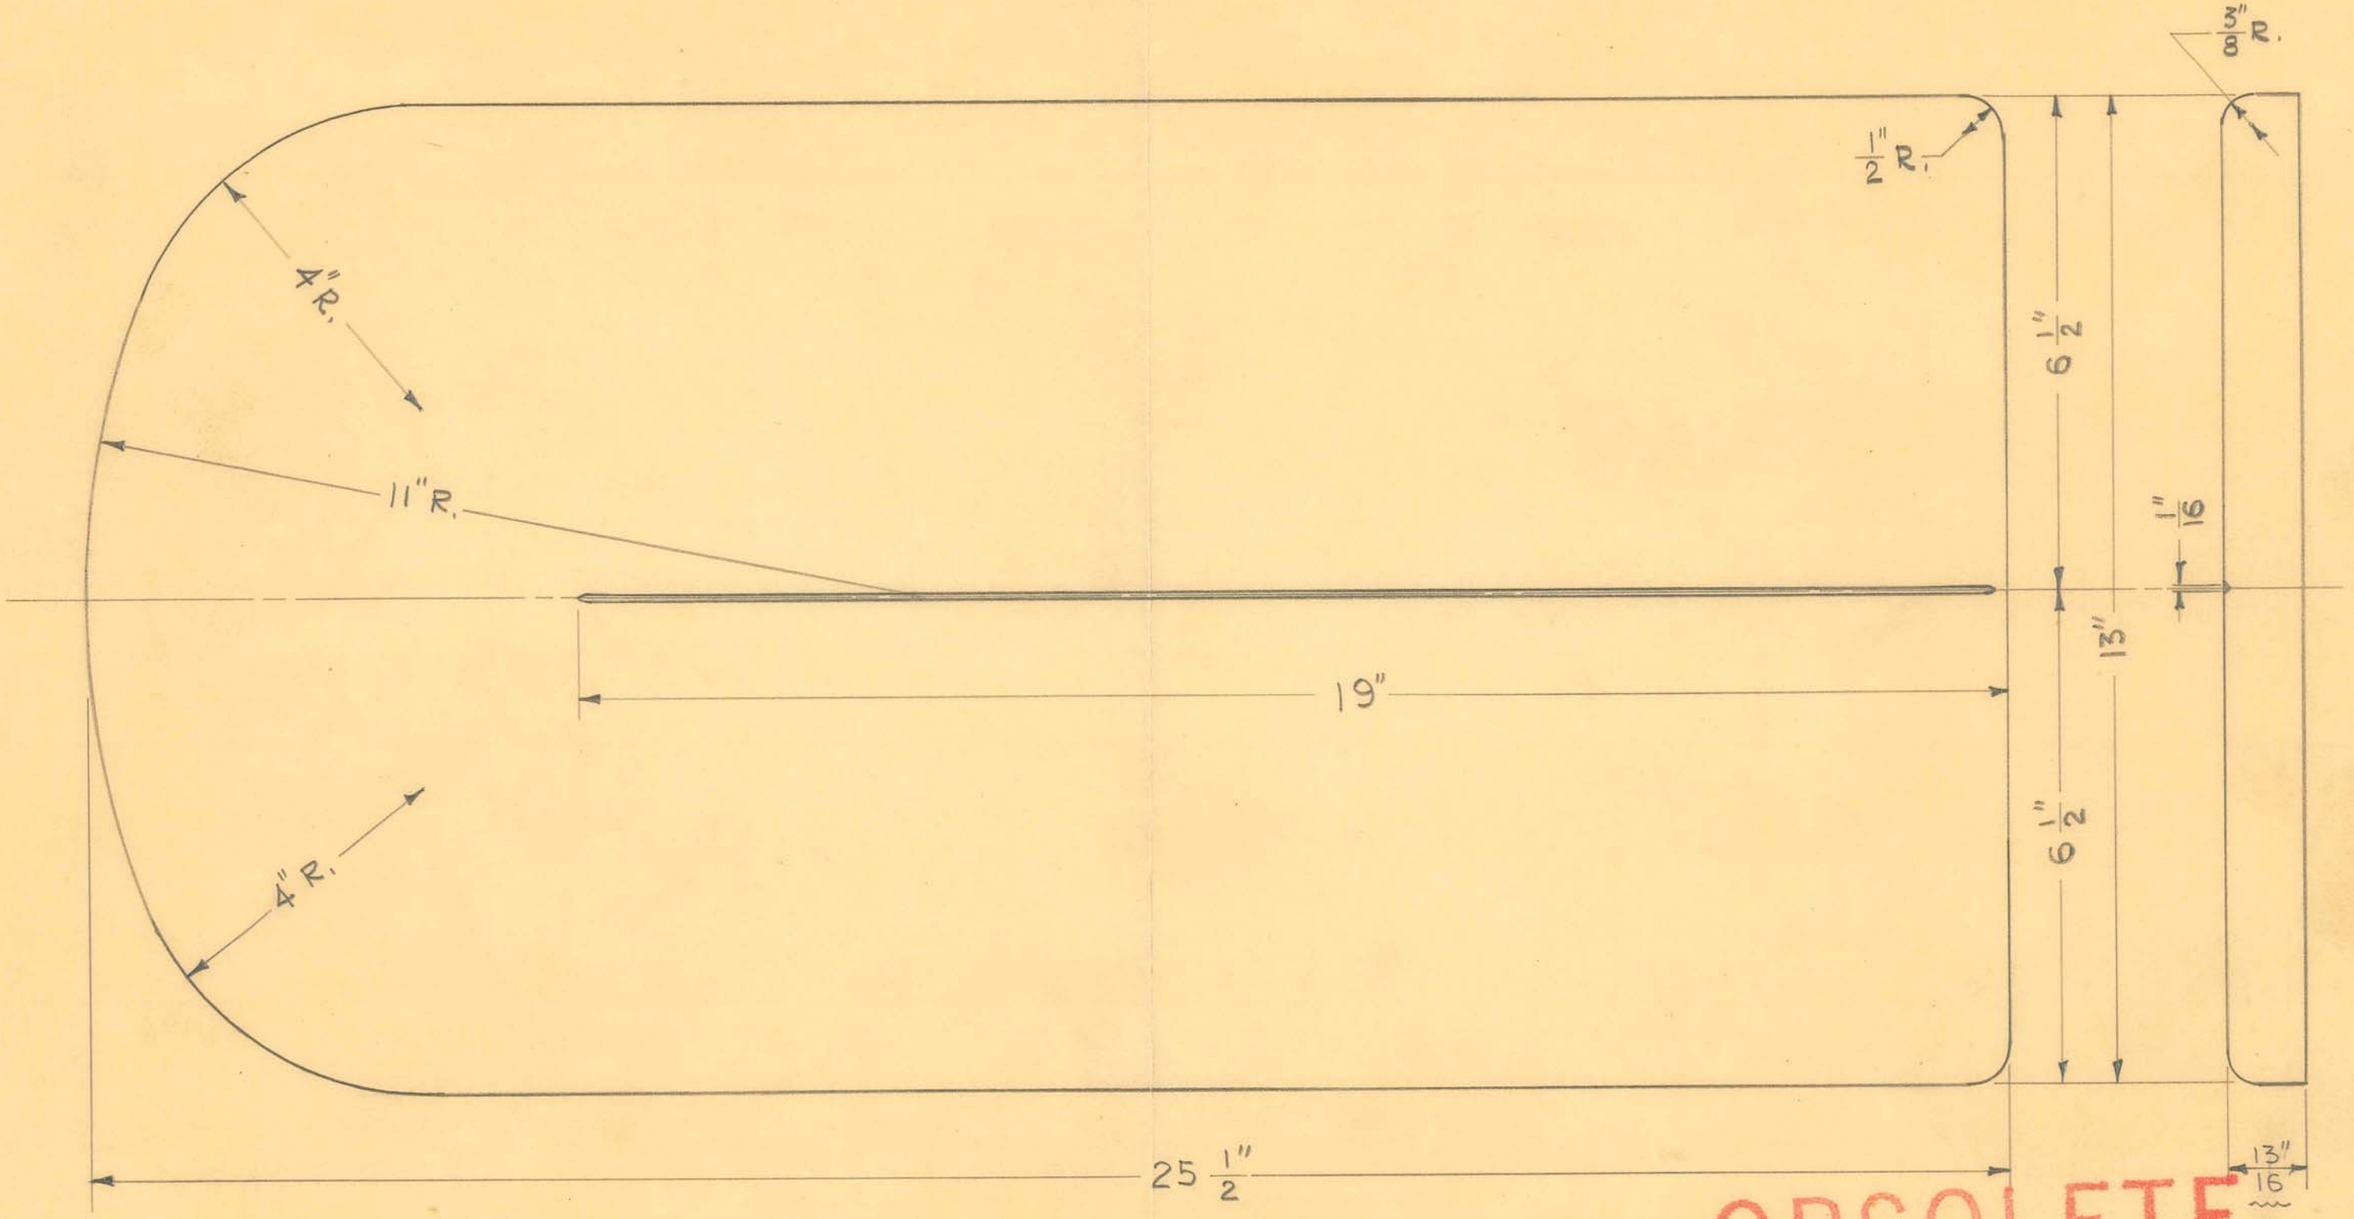

SCALE ~ 1/2" = 1"

OBSOLETE

SIZE	13/16" PLYWOOD	ISSUE 12-1-41	J.V.W.
KIND		CHANGED	
SHAPE		"	
FINISH	BLACK	"	
TEMP.		"	

TITLE: FISCHER MOD. "PN" PORTABLE X-RAY TABLE BASE

H. G. FISCHER & CO. 2338 WABANSIA AVE.

CAT. NO.

PART NO. 14396

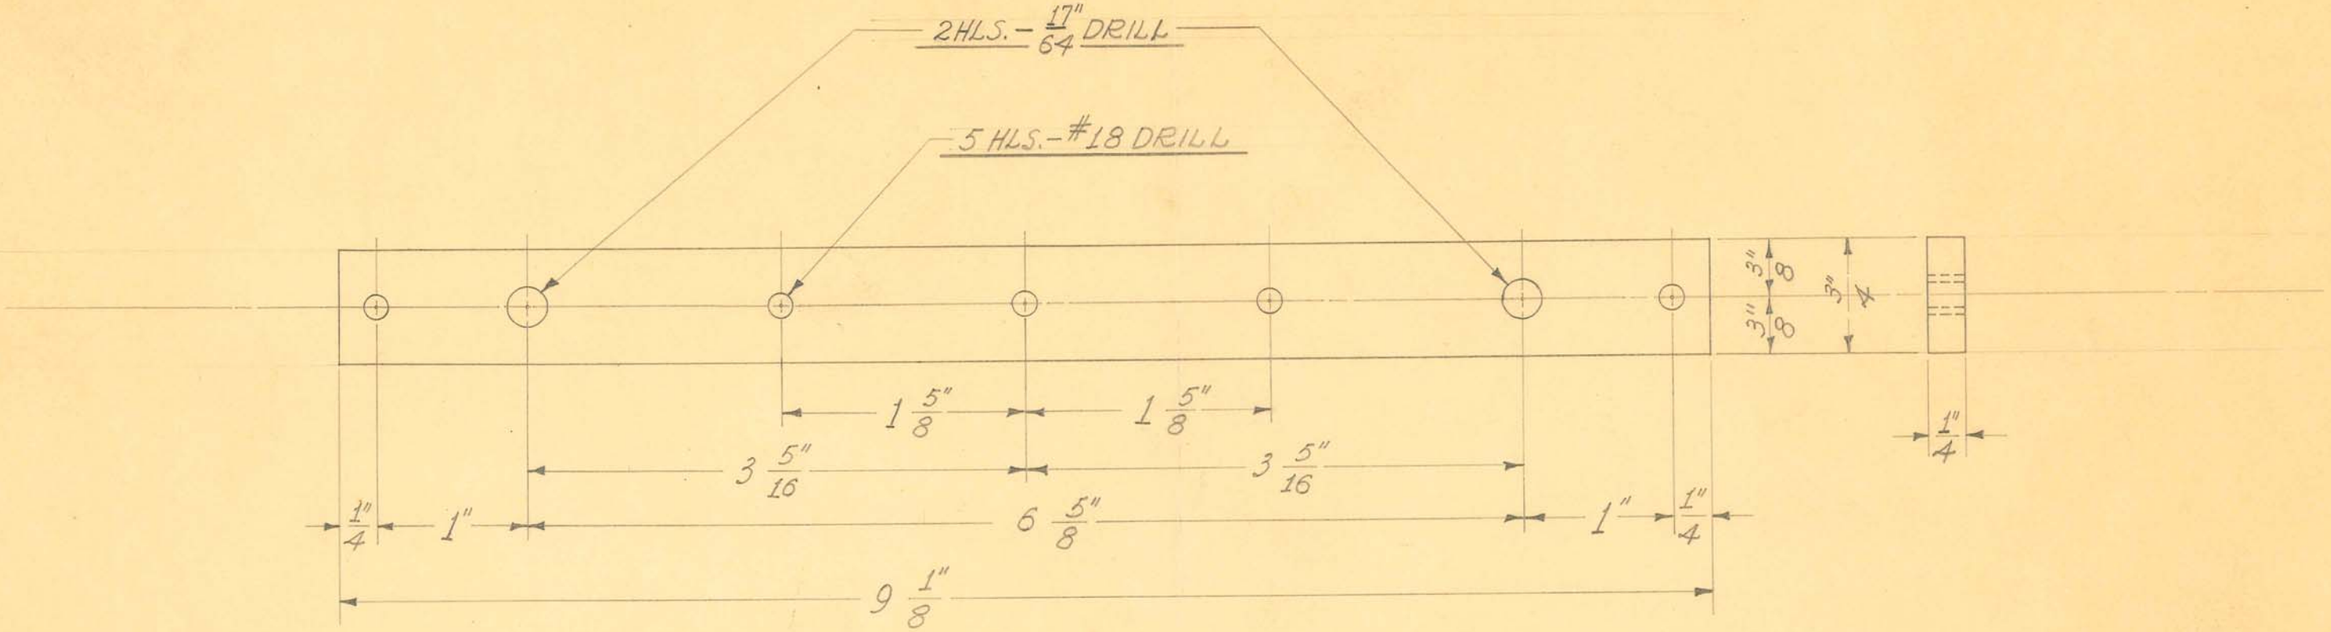

1 REQUIRED

OBSOLETE

SIZE	1/4" SHEET	ISSUE 9-15-38	J.W.	TITLE: FISCHER MOD. "M" SHORT WAVE POWER TRANSFORMER TERMINAL STRIP-UPPER
KIND	BAKELITE	CHANGED		
SHAPE		"		
FINISH		"		
TEMP.		"		
PATT.		"		

H. G. FISCHER & CO.
2335 WABANSIA AVE.
CHICAGO, ILL.

CAT. NO.

PART NO. 12064

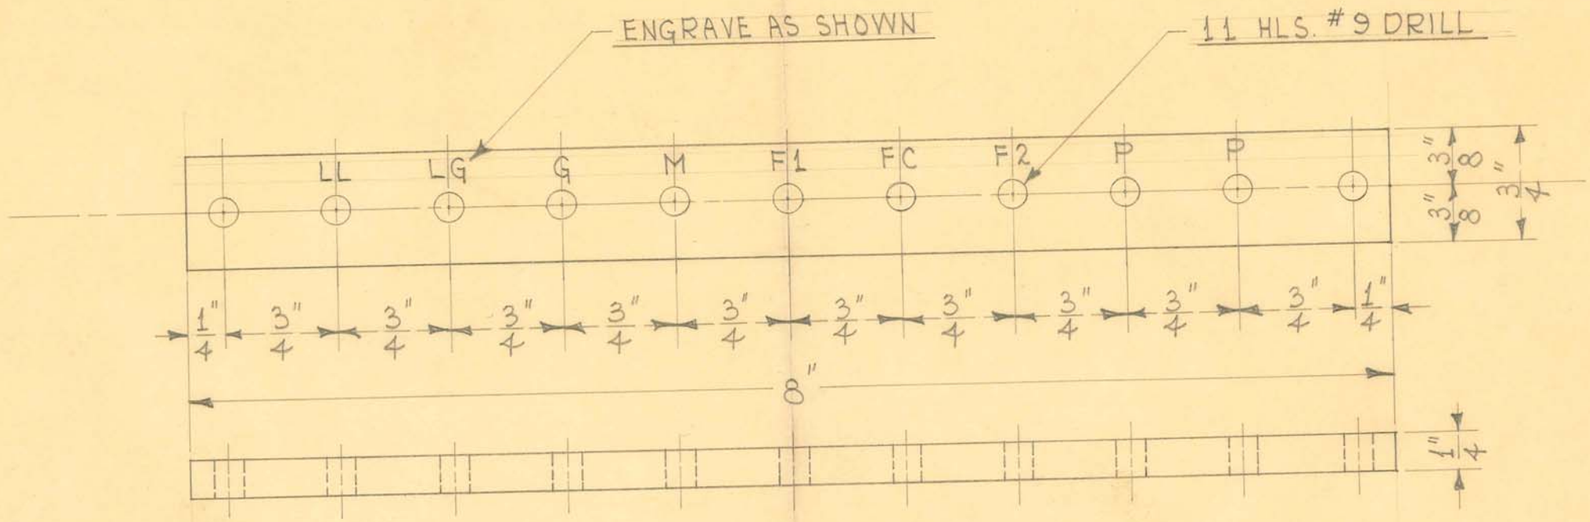

1 REQUIRED

OBSOLETE

SIZE	1/4" SHEET	ISSUE 9-5-40	H.E.
KIND	RICHELAIN	CHANGED	
SHAPE	BAKELITE	"	
FINISH		"	
TEMP.		"	
PATT.		"	

TITLE: FISCHER MOD. "100-96" CONTROL BOX
TERM. STRIP (DRILLED & ENGRAVED)

H. G. FISCHER & CO.
2335 WABANSIA AVE.
CHICAGO. ILL.

CAT. NO.

PART NO. 13327

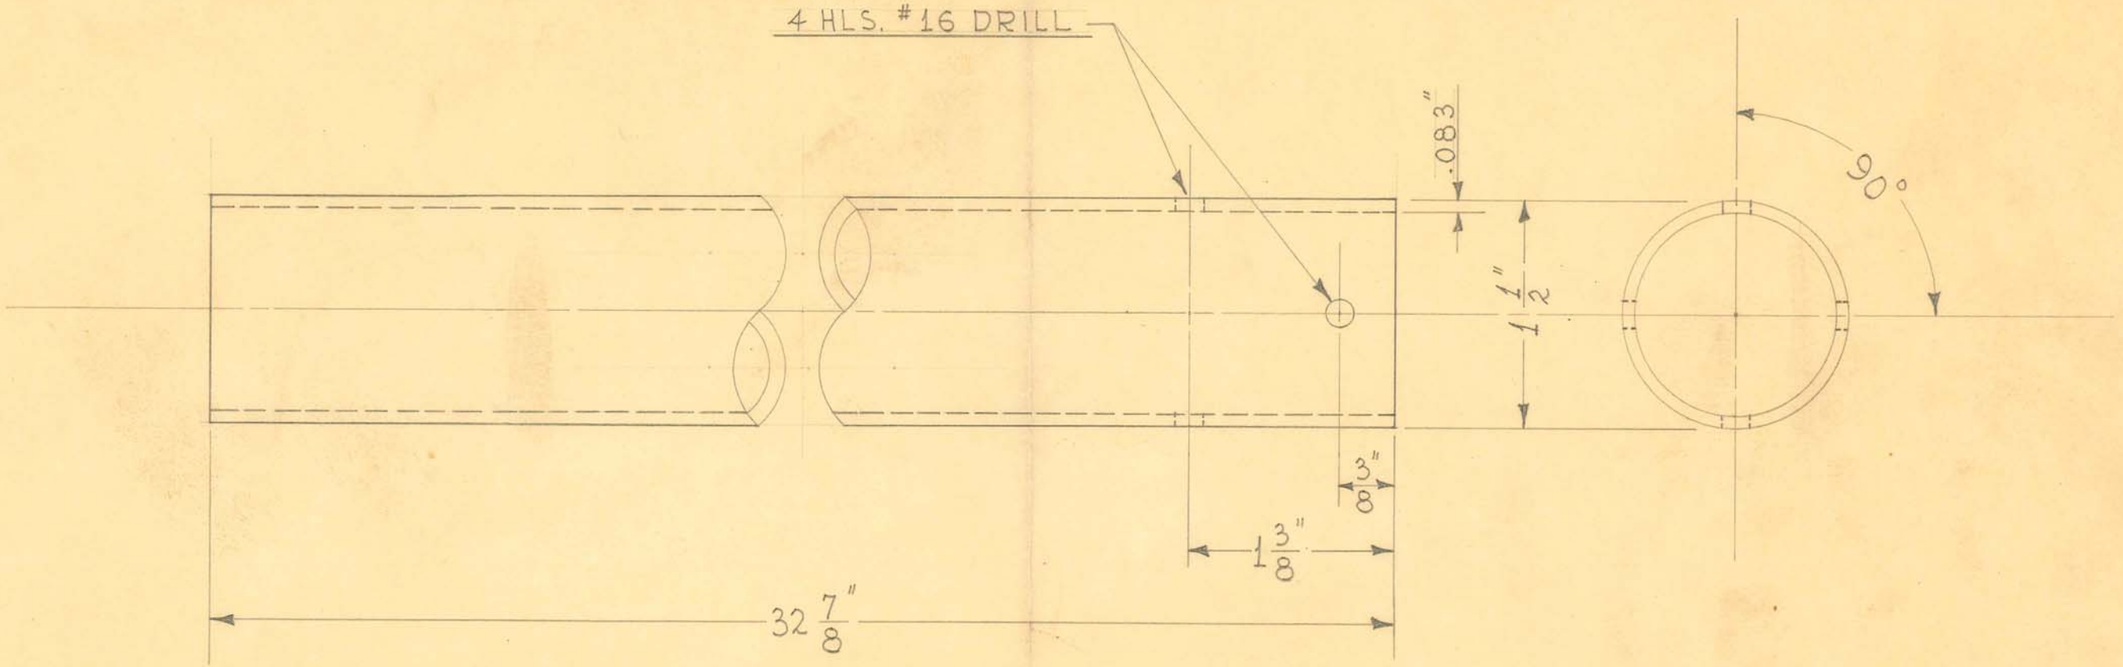

1 REQUIRED

OBSOLETE

SIZE	1½" O.D. X #14 GA.	ISSUE 8-20-40	H.E.
KIND	SEAMLESS STEEL	CHANGED	
SHAPE	TUBING	"	
FINISH	CHROME #2	"	
TEMP.		"	
PATT.		"	

TITLE: FISCHER MOD. "100-96" X-RAY UNIT - SCREEN SLIDE HORIZ. TUBE - FINISHED

H. G. FISCHER & CO.
2335 WABANSIA AVE.
CHICAGO, ILL.

CAT. NO.

PART NO. 13329F

2 HLS. - #3X48 TAP - 1/8" DEEP

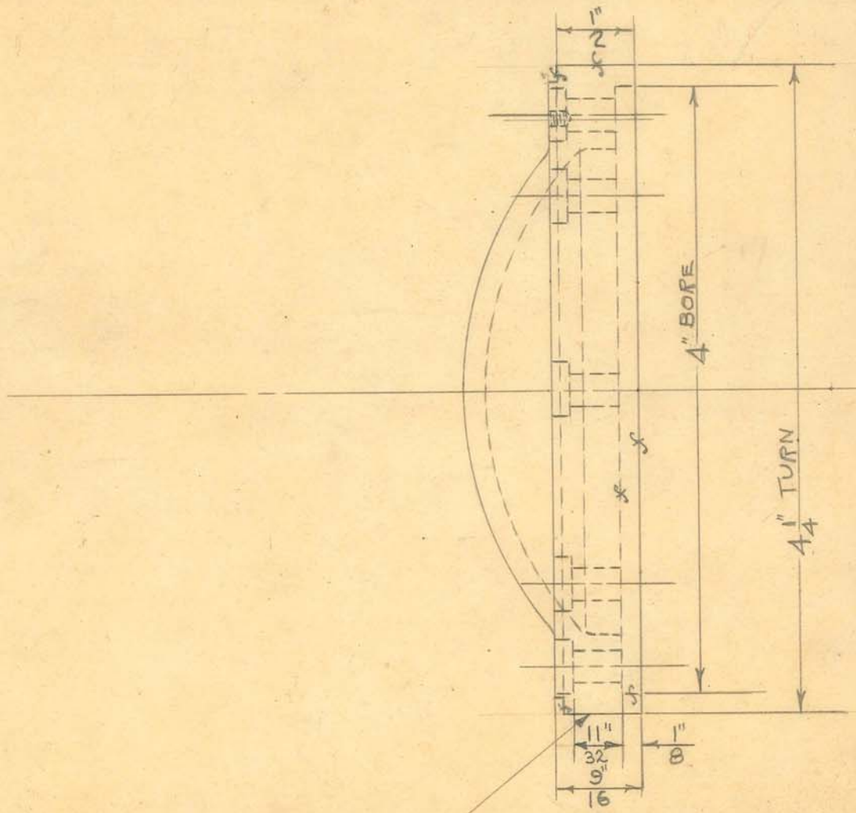

DO NOT PAINT

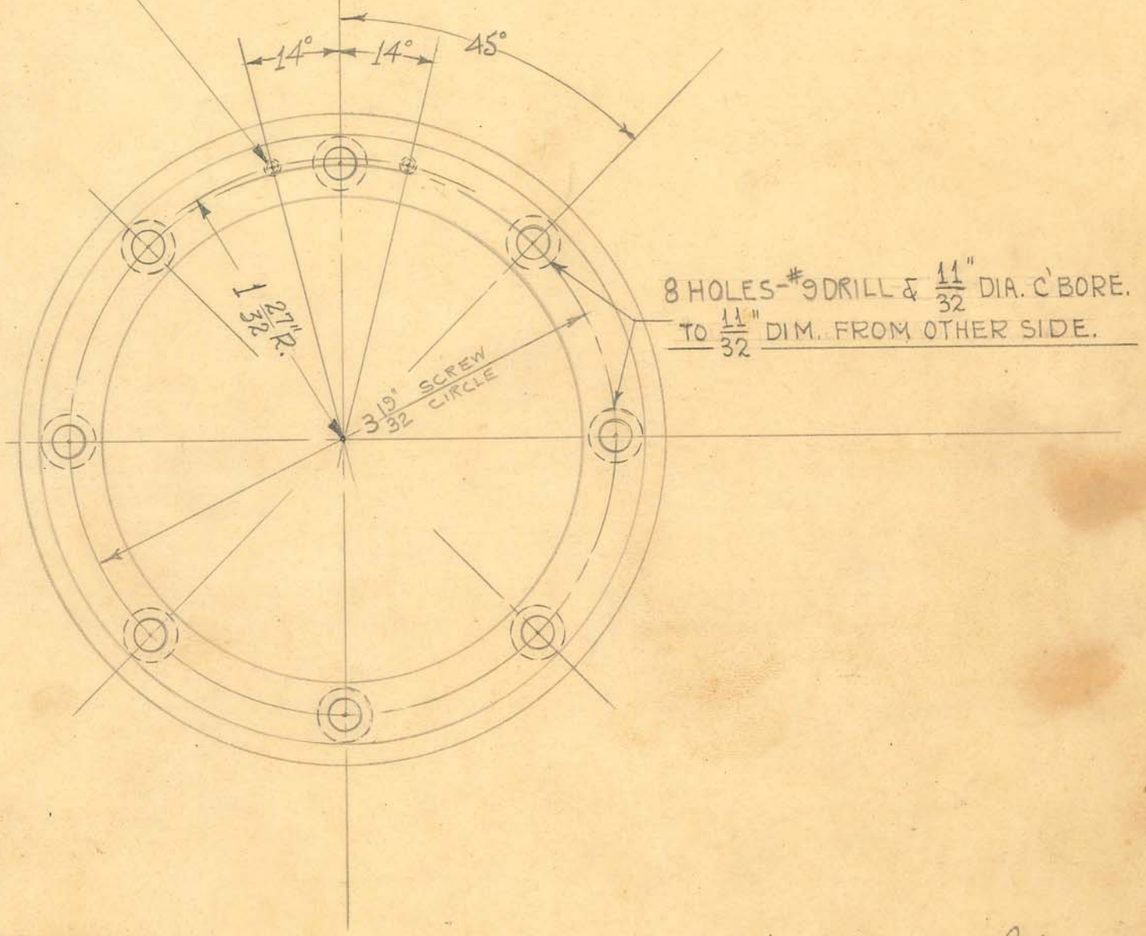

8 HOLES - #9 DRILL & 11/32" DIA. C'BORE.
TO 11/32" DIM. FROM OTHER SIDE.

1 REQUIRED

OBSOLETE

SIZE	#43	ISSUE 7-23-40	C.E.A.
KIND	ALUMINUM	CHANGED	
SHAPE	CAST	"	
FINISH	PAINT	"	
TEMP.		"	
PATT.		"	

TITLE: FISCHER MOD. "100-96" X-RAY UNIT-
OIL IMMERSED TUBE HOUSING END CAP-RIGHT

H. G. FISCHER & CO.
2338 WABANSIA AVE.
CHICAGO, ILL.

CAT. NO.

PART NO. 13338F

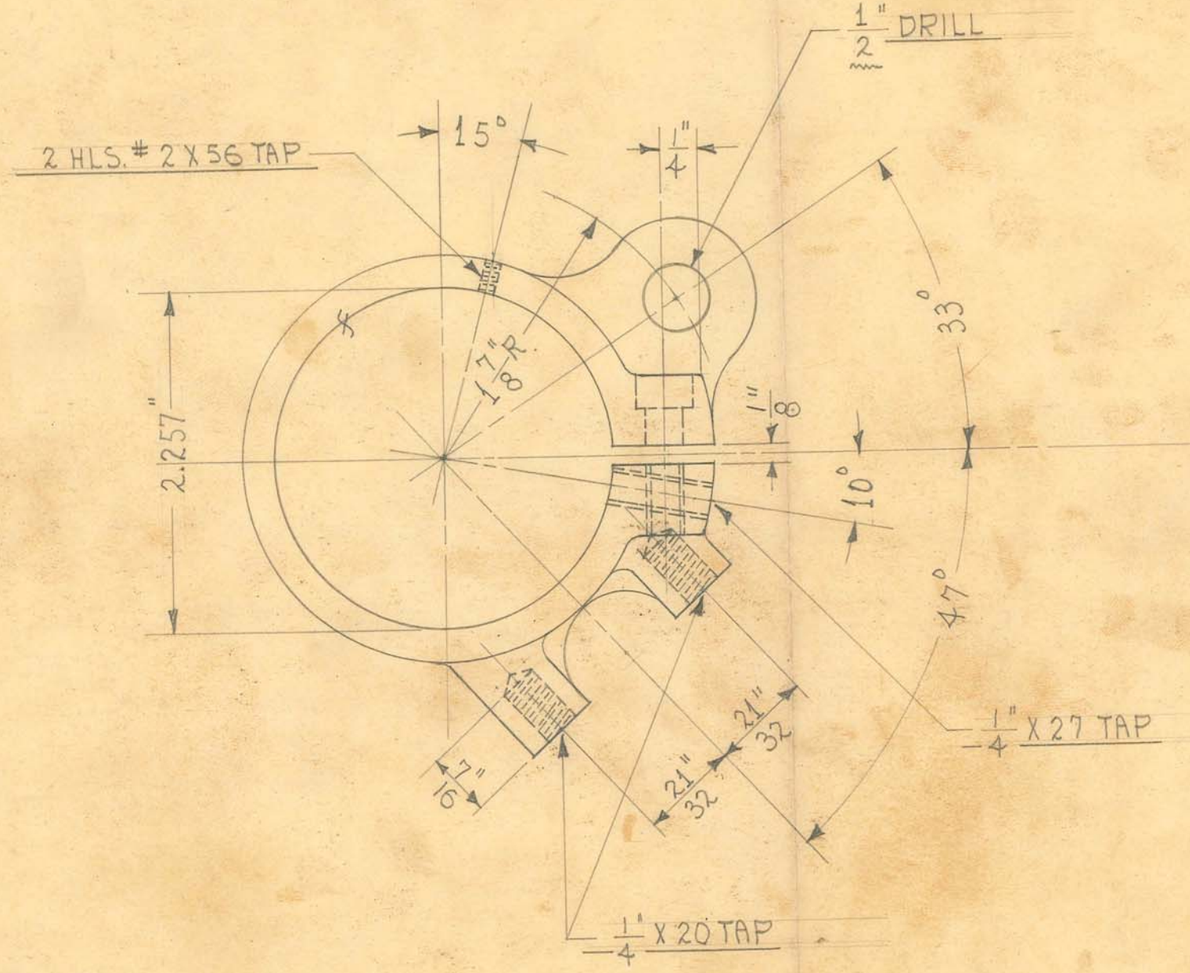

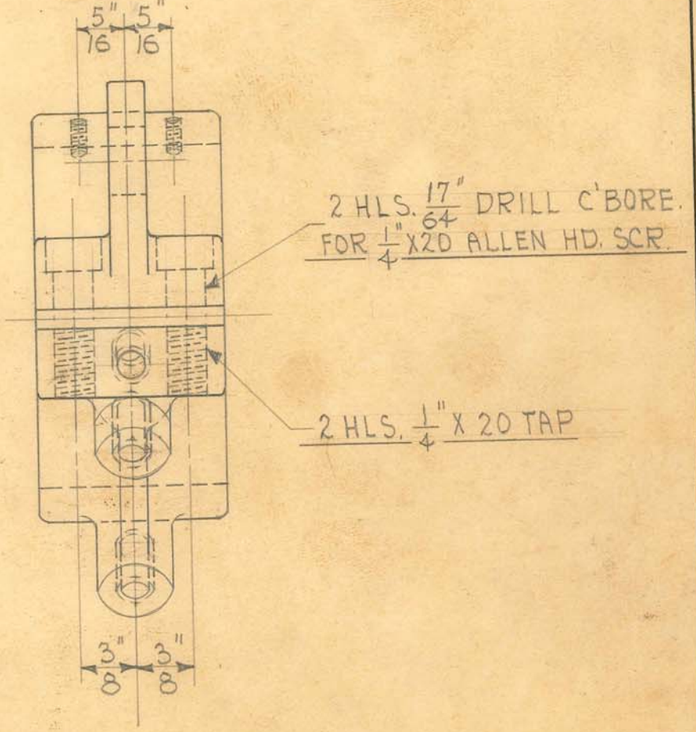

1 REQUIRED

OBSOLETE

SIZE	#12	ISSUE 8-2-40	HE.
KIND	ALUM. CASTING	CHANGED	
SHAPE		"	
FINISH		"	
TEMP.		"	
PATT.	1581	"	

TITLE: FISCHER MOD. "100-96" TUBE STAND - HORIZONTAL TUBE GUIDE

H. G. FISCHER & CO.
2335 WABANSIA AVE.
CHICAGO, ILL.

CAT. NO.

PART NO. 13342F

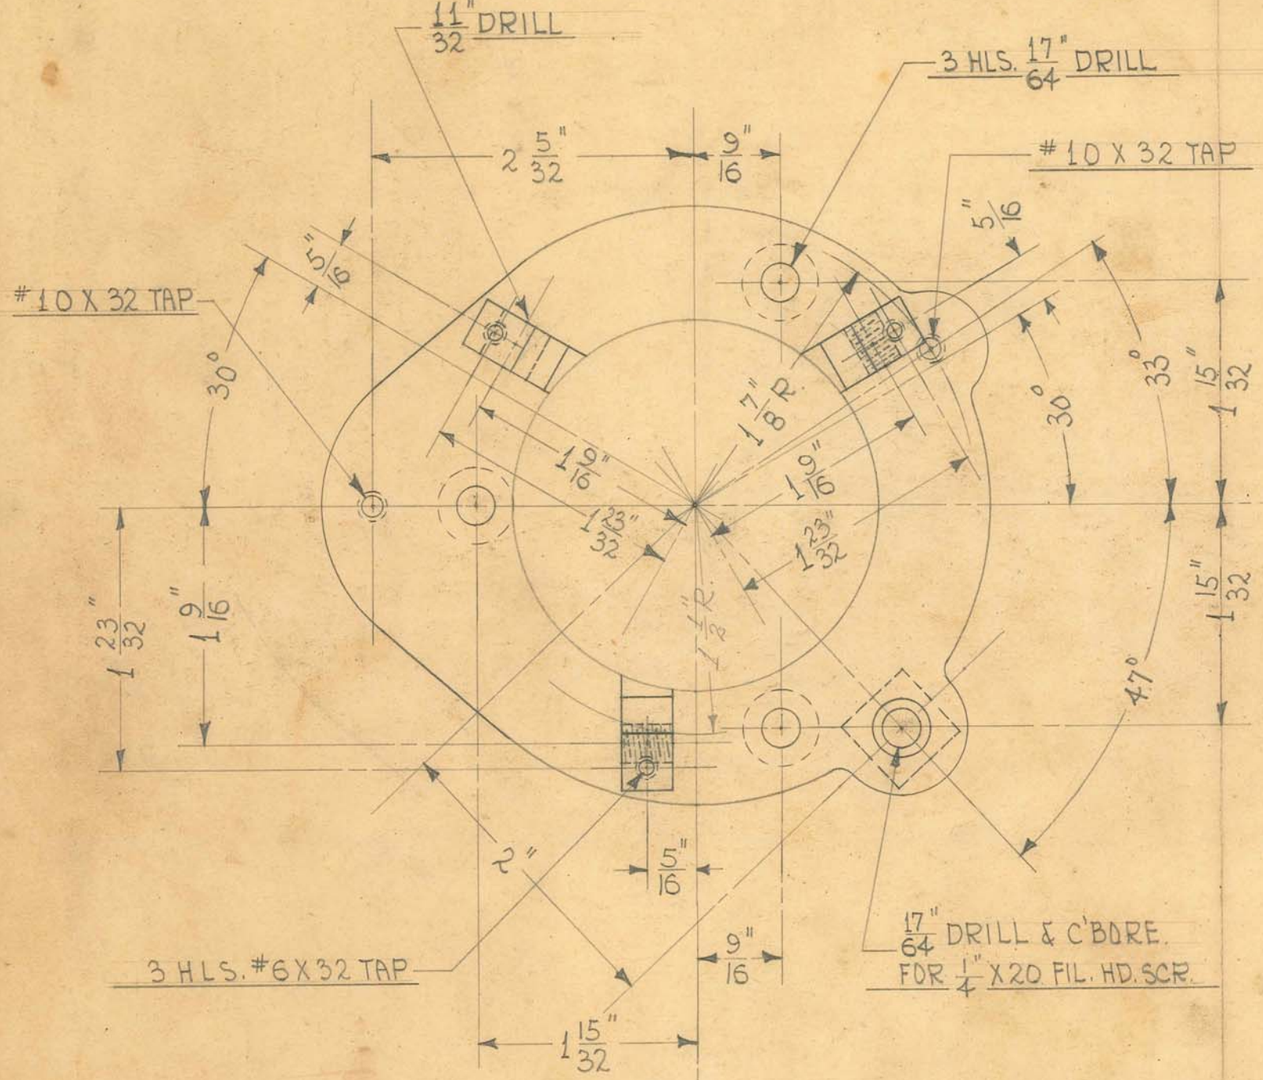

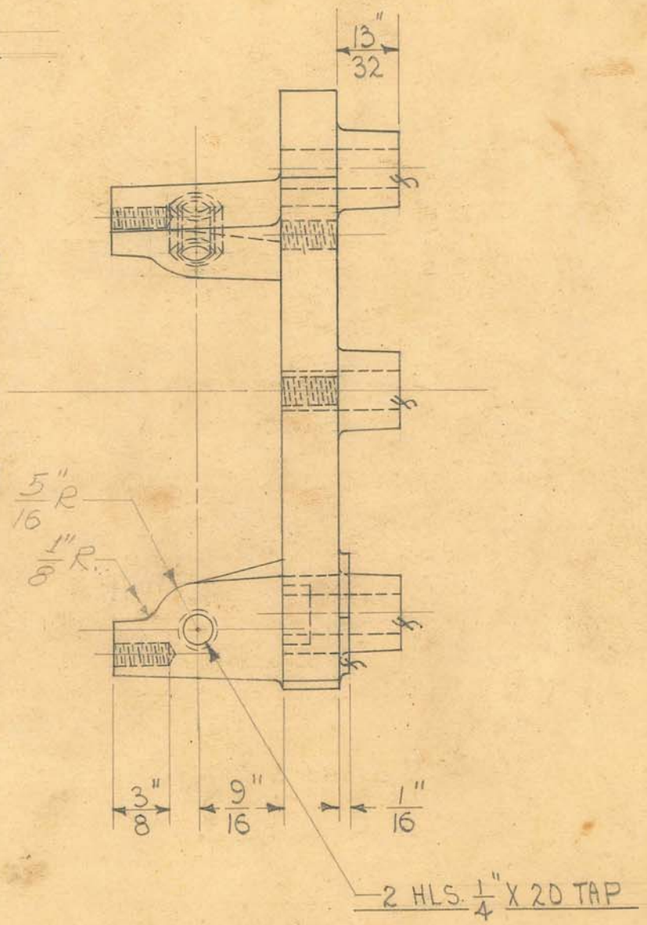

1 REQUIRED

OBSOLETE

SIZE	#12	ISSUE 7-8-40	HE.
KIND	ALUM. CASTING	CHANGED	
SHAPE		"	
FINISH		"	
TEMP.		"	
PATT.	1583	"	

TITLE: FISCHER MOD. "100-B.6" TUBE STAND - HORIZONTAL TUBE SLIDE BEARING SUPP. - FRONT

H. G. FISCHER & CO.
2335 WABANSIA AVE.
CHICAGO, ILL.

CAT. NO.

PART NO. 13344F

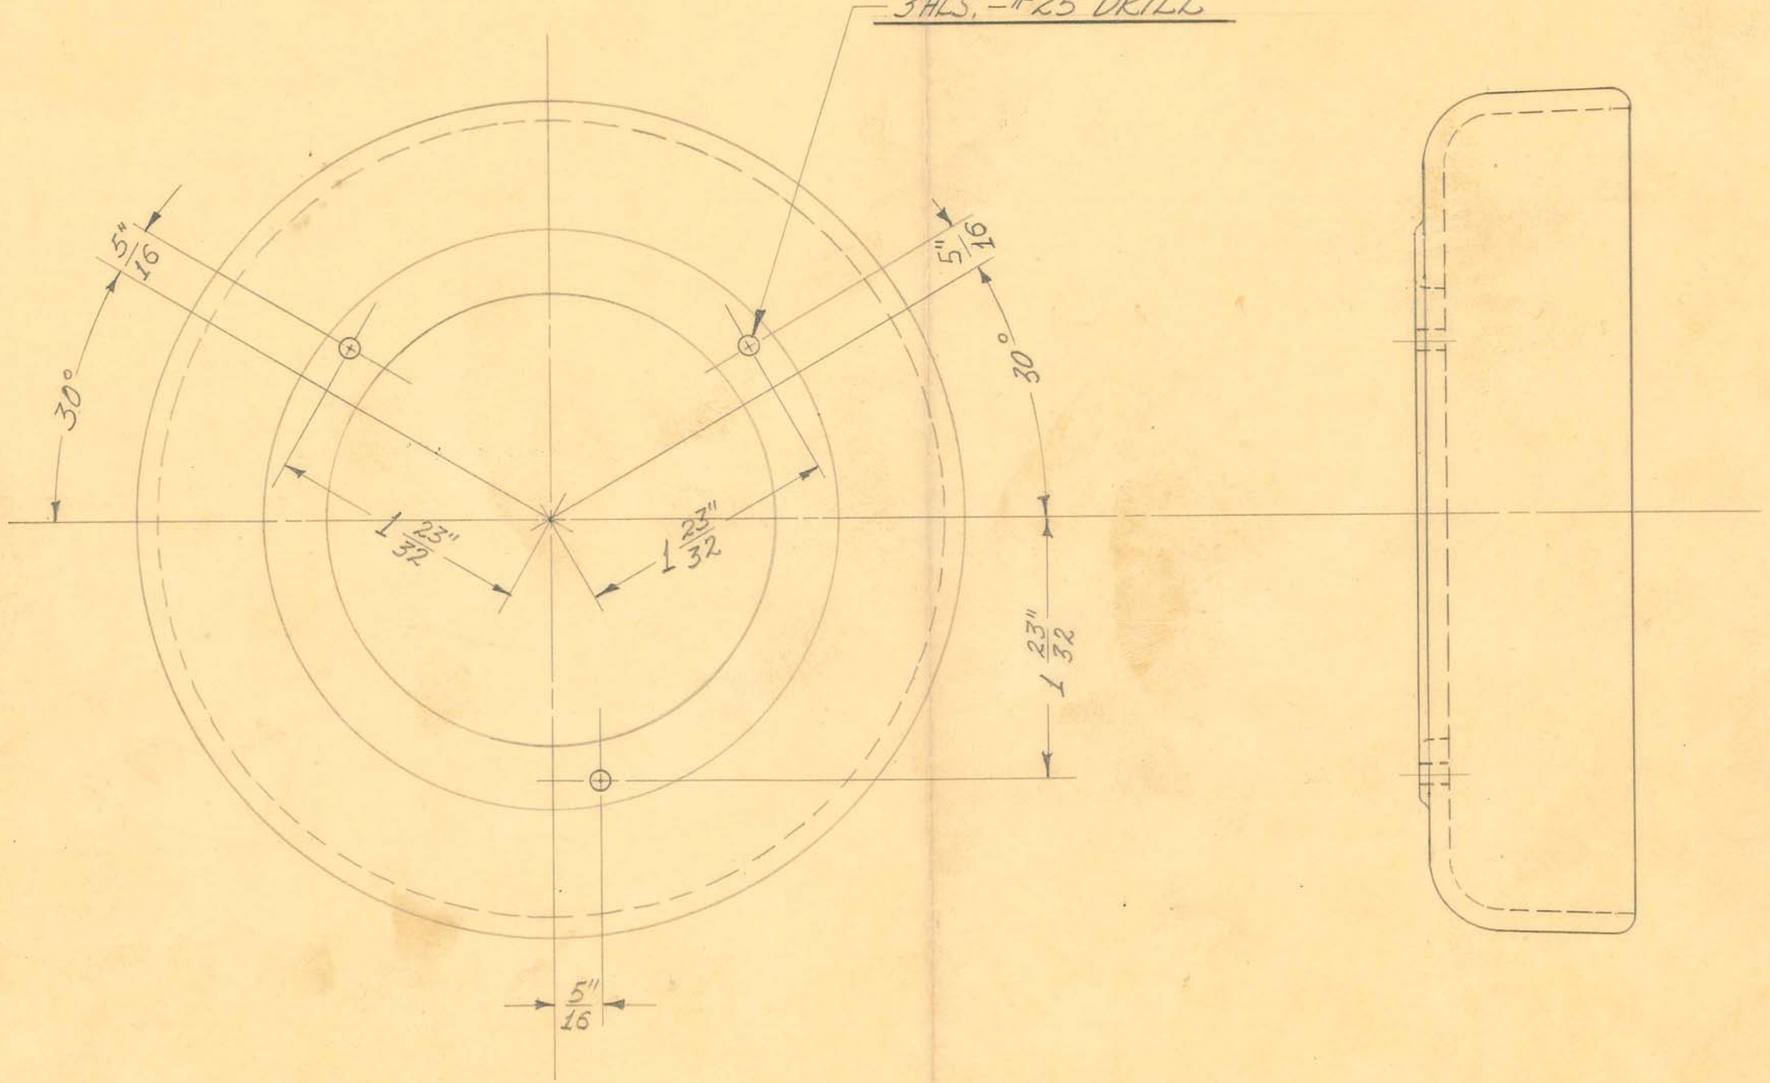

1 REQUIRED

OBSOLETE

SIZE	#12	ISSUE 8-15-40	J.V.W.
KIND	ALUM. CAST.	CHANGED	
SHAPE		"	
FINISH		"	
TEMP.		"	
PATT.	1616	"	

TITLE:
FISCHER "100-96" TUBE STAND - HORIZ.
TUBE SLIDE BEARING SUPP. COVER - REAR

H. G. FISCHER & CO.
2335 WABANSIA AVE.
CHICAGO, ILL.

CAT. NO.

PART NO. 13345

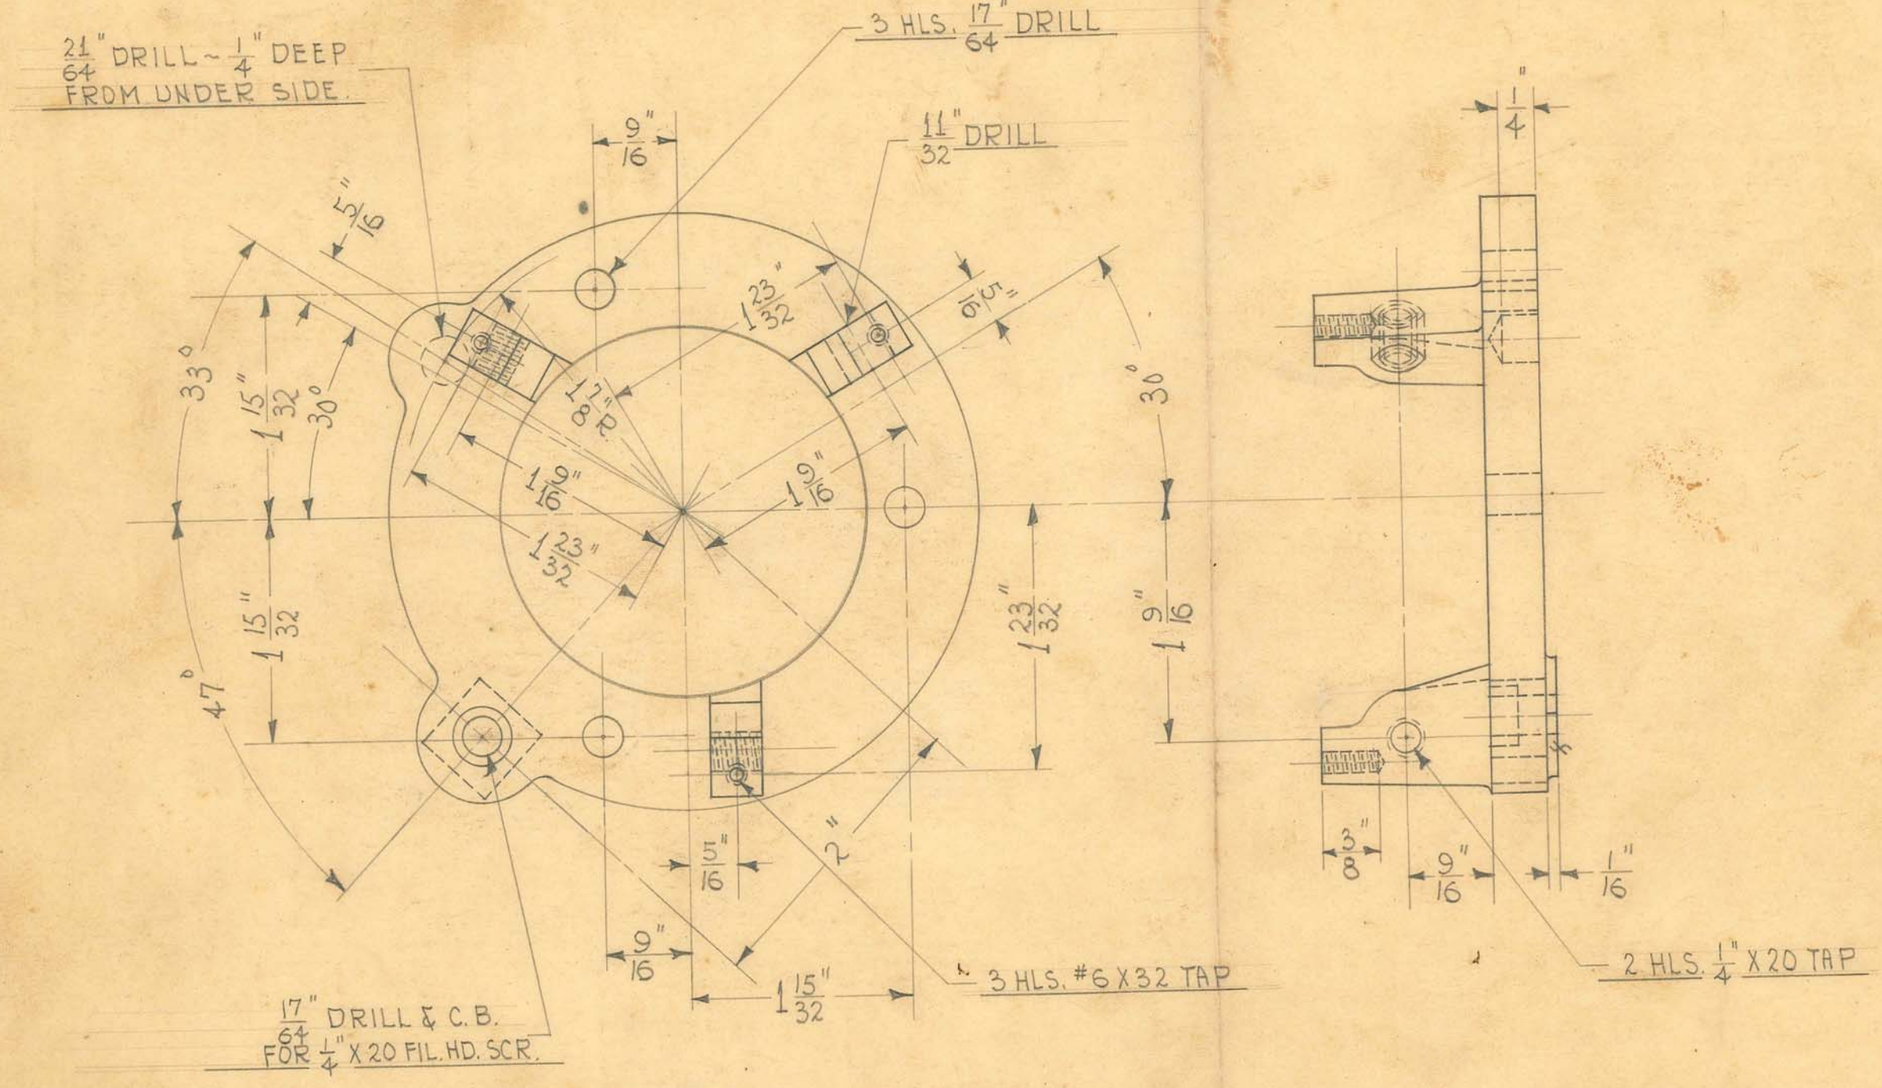

1 REQUIRED

OBSOLETE

SIZE	#12	ISSUE 7-3-40	HE.
KIND	ALUM. CASTING	CHANGED	
SHAPE		"	
FINISH		"	
TEMP.		"	
	1584	"	

TITLE: FISCHER MOD "100-96" TUBE STAND-
HORIZONTAL TUBE SLIDE BEARING SUPP.-REAR

H. G. FISCHER & CO.
2335 WABANSIA AVE.
CHICAGO, ILL.

CAT. NO.

PART NO. 13346F

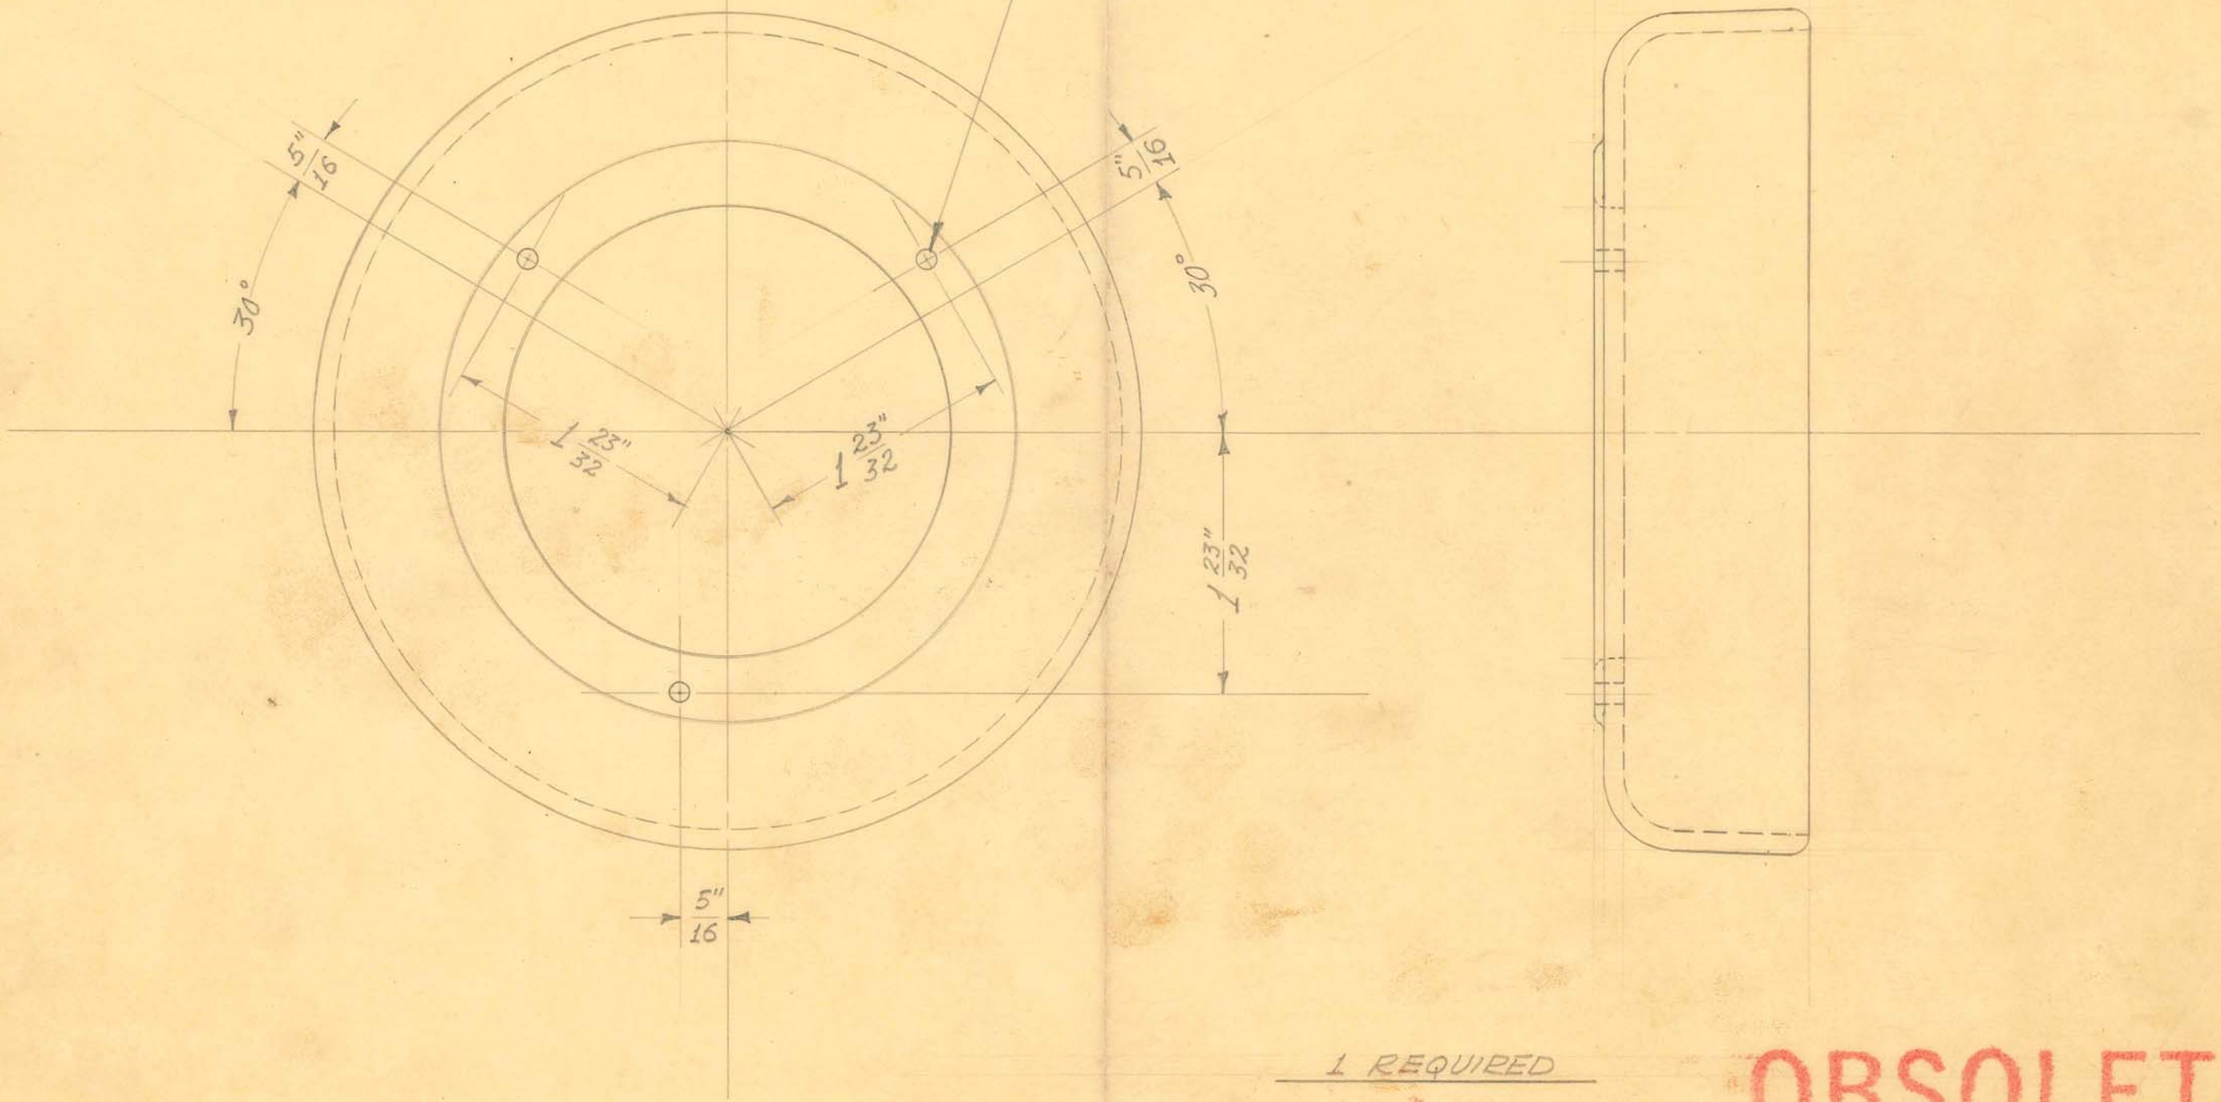

1 REQUIRED

OBSOLETE

SIZE	#12	ISSUE 8-15-40	J.V.W.	TITLE: FISCHER "100-96" TUBE STAND - HORIZ. TUBE SLIDE BEARING SUPP. COVER - FRONT
KIND	ALUM. CAST.	CHANGED		
SHAPE		"		
FINISH		"		
TEMP.		"		
PATT.	1616	"		

H. G. FISCHER & CO.
2335 WABANSIA AVE.
CHICAGO, ILL.

CAT. NO.

PART NO. 13347F

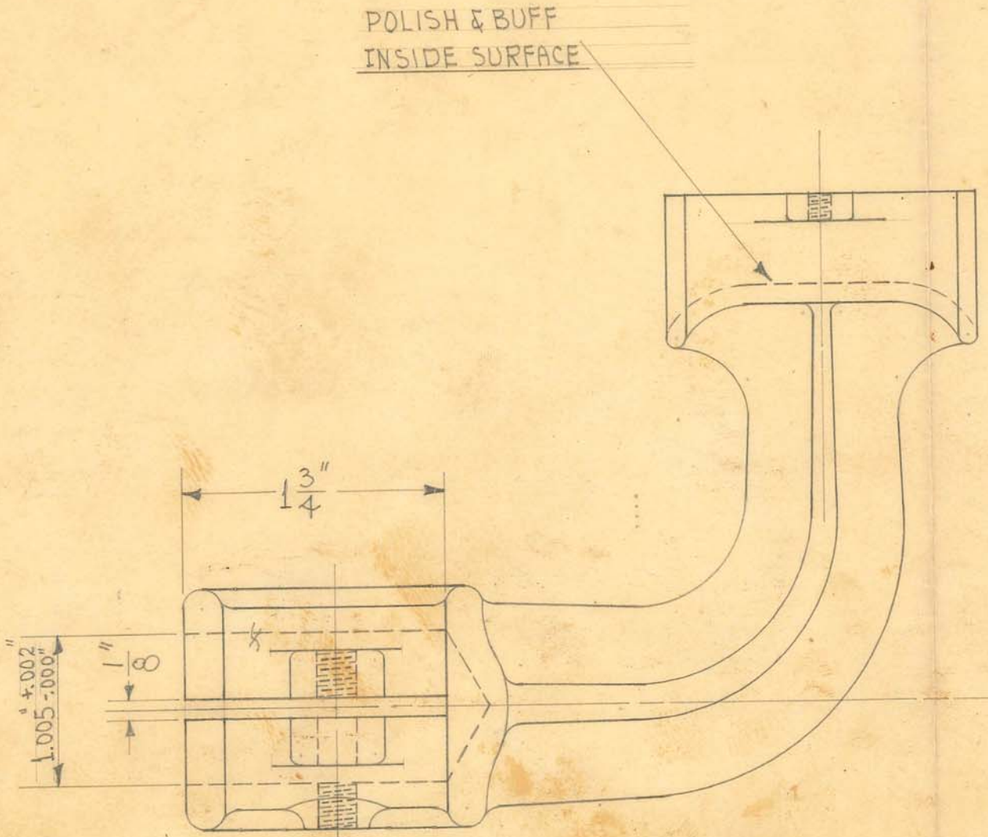

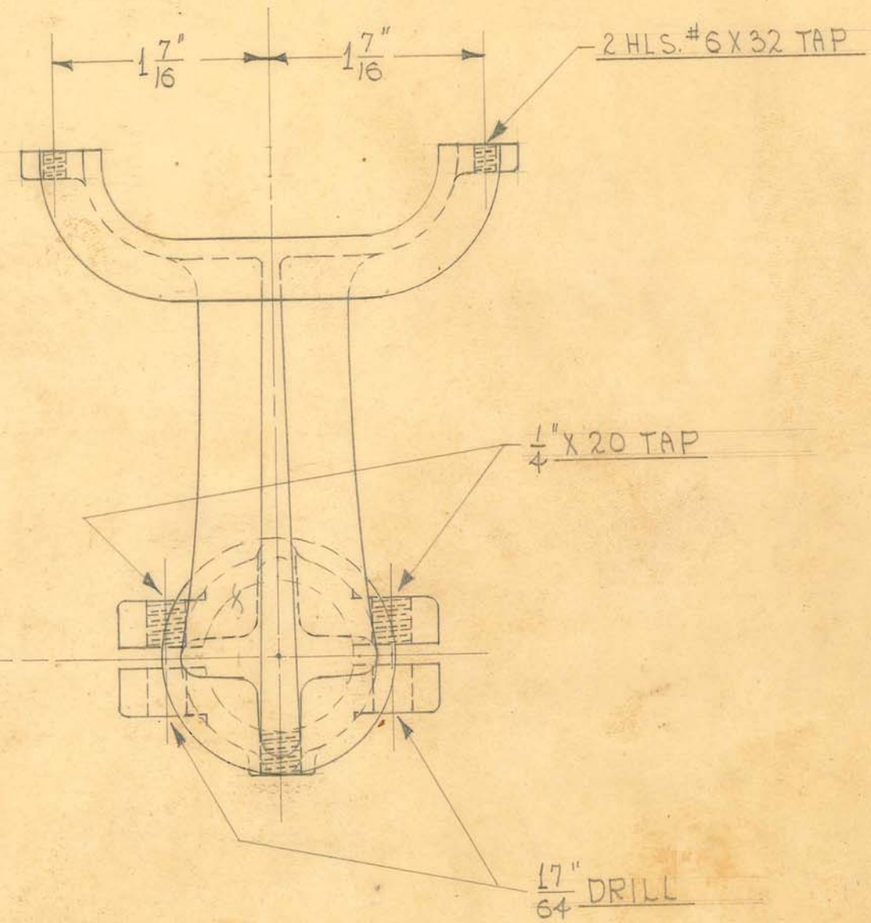

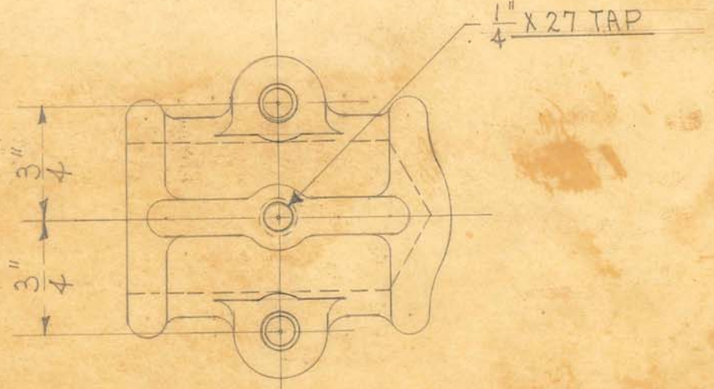

OBSOLETE obsolete

SIZE	#12	ISSUE 7-30-40	HE.
KIND	ALUM. CASTING	CHANGED	
SHAPE		"	
FINISH	PAINTED (SEE ABOVE)	"	
TEMP.		"	
DIE	1591	"	

TITLE: FISCHER MOD. "100-96" TUBE STAND-CABLE BRACKET

H. G. FISCHER & CO.
2335 WABANSIA AVE.
CHICAGO, ILL.

CAT. NO.

PART NO. 13353F

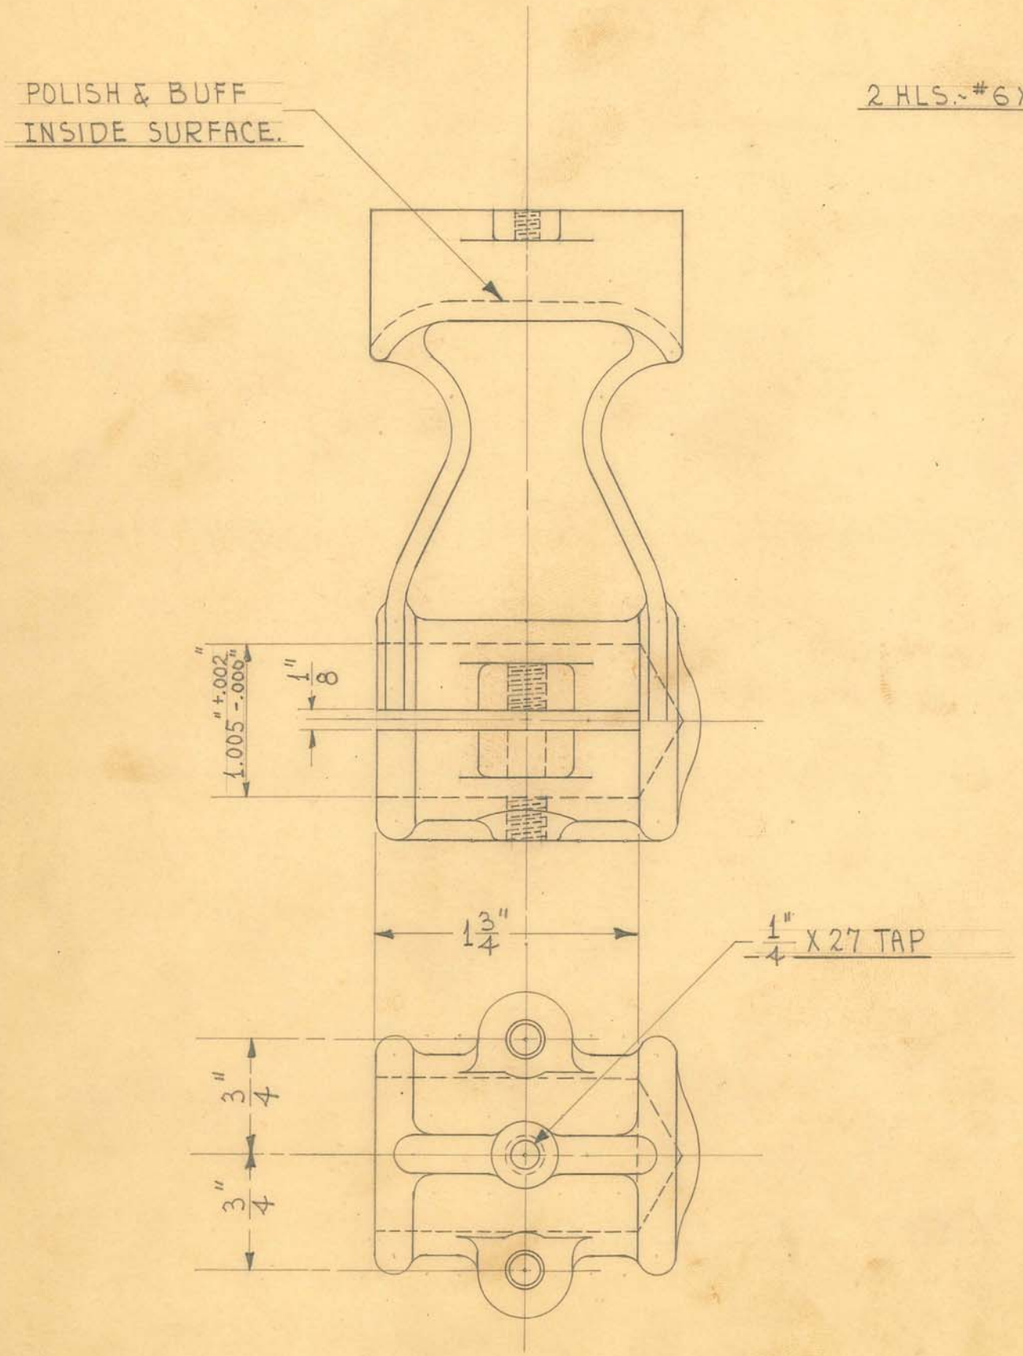

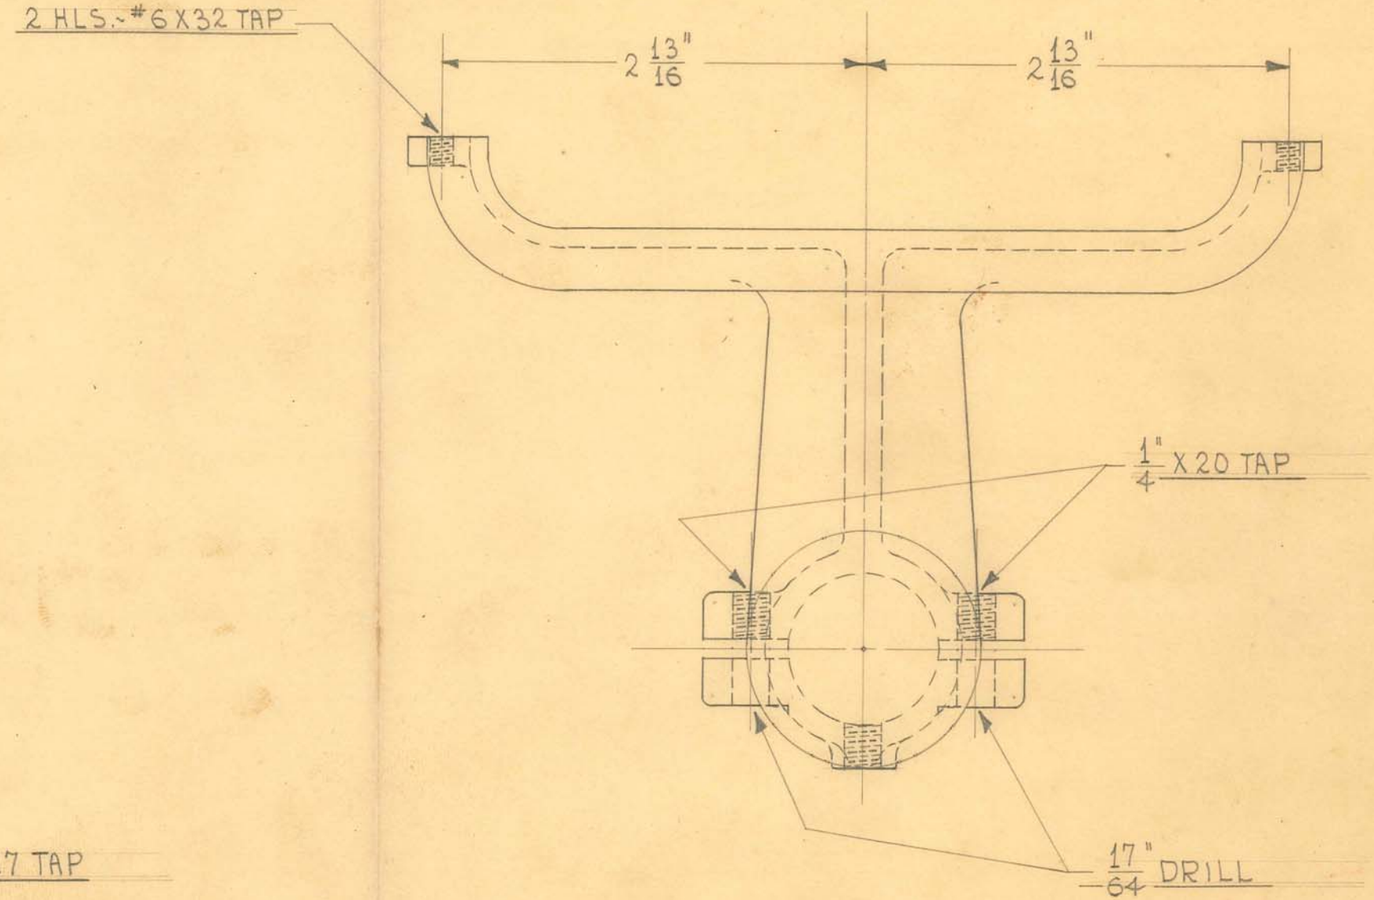

1 REQUIRED

OBSOLETE

SIZE	#12	ISSUE 12-10-41	HE.	TITLE: FISCHER "RF-100" TUBE STAND - CABLE BRACKET.
KIND	ALUM. CASTING	CHANGED		
SHAPE		"		
FINISH	PAINTED (SEE ABOVE)	"		
TEMP.		"		
PATT.	1848	"		

H. G. FISCHER & CO. 2338 WABANSIA AVE. CHICAGO, ILL. | CAT. NO. | PART NO. 13353AF

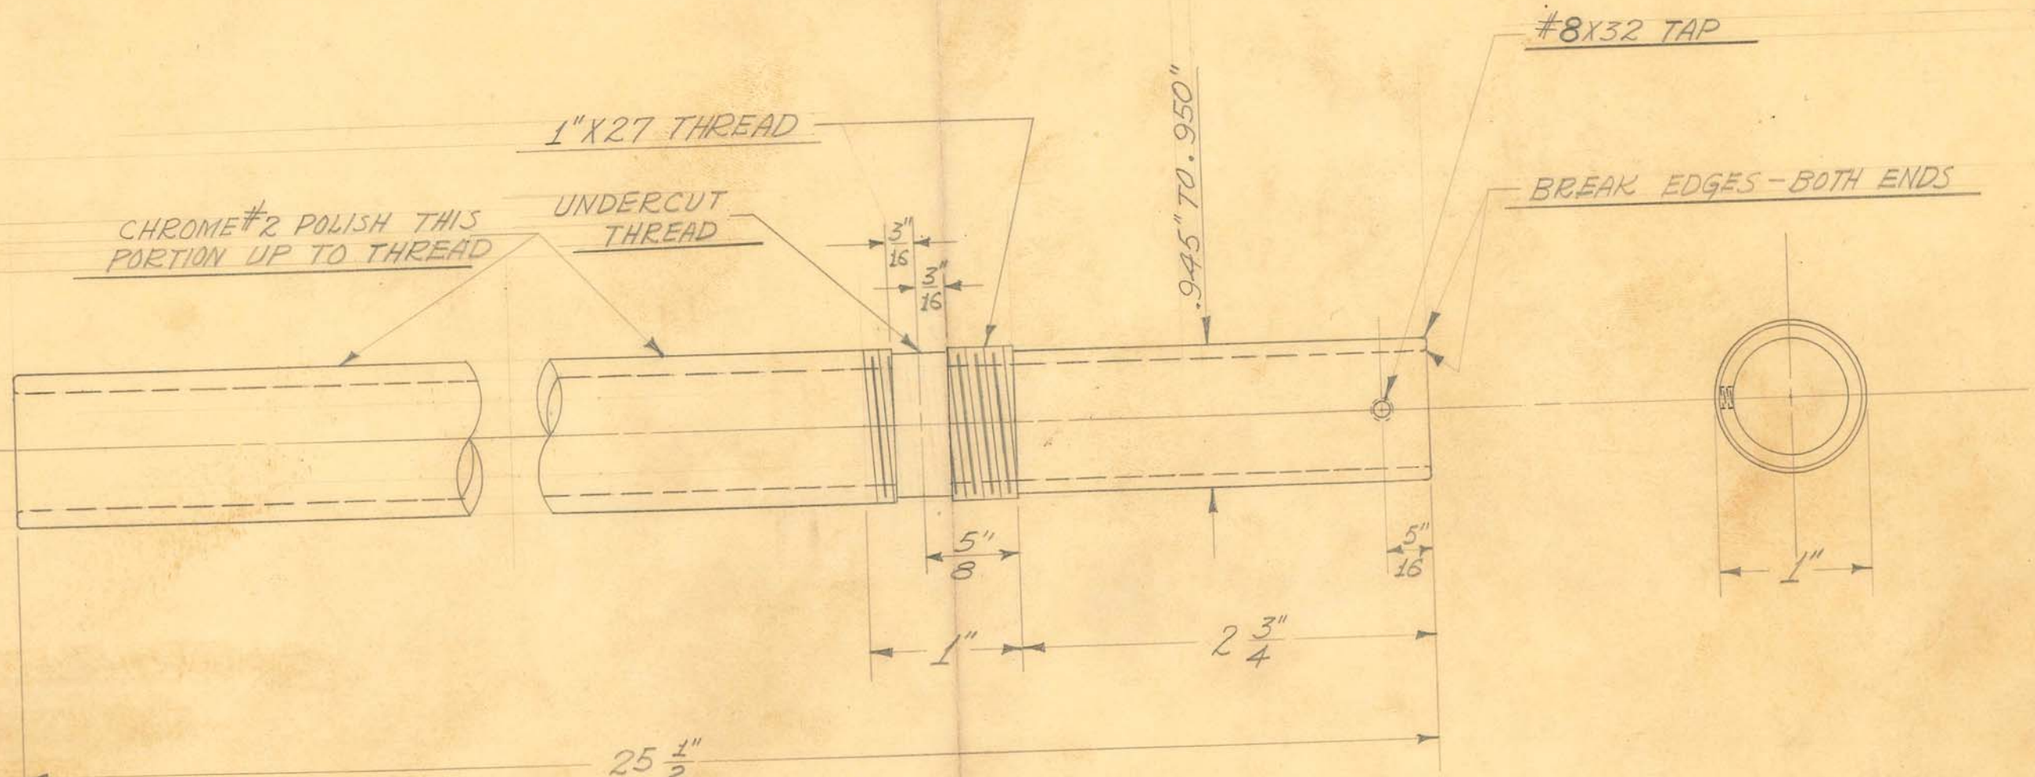

1 REQUIRED

OBSOLETE
Noble

SIZE	1" O.D. X #11GA.	ISSUE 8-16-40	J.V.W.	TITLE: FISCHER "100-96" DIAGNOSTIC S.P. X-RAY BASE STOP VERTICAL TUBE
KIND	SEAMLESS	CHANGED		
SHAPE	STEEL TUBING	"		
FINISH	SEE NOTE.	"		
TEMP.		"		
PATT.		"		

H. G. FISCHER & CO.
2335 WABANSIA AVE.
CHICAGO, ILL.

CAT. NO.

PART NO. 13355F

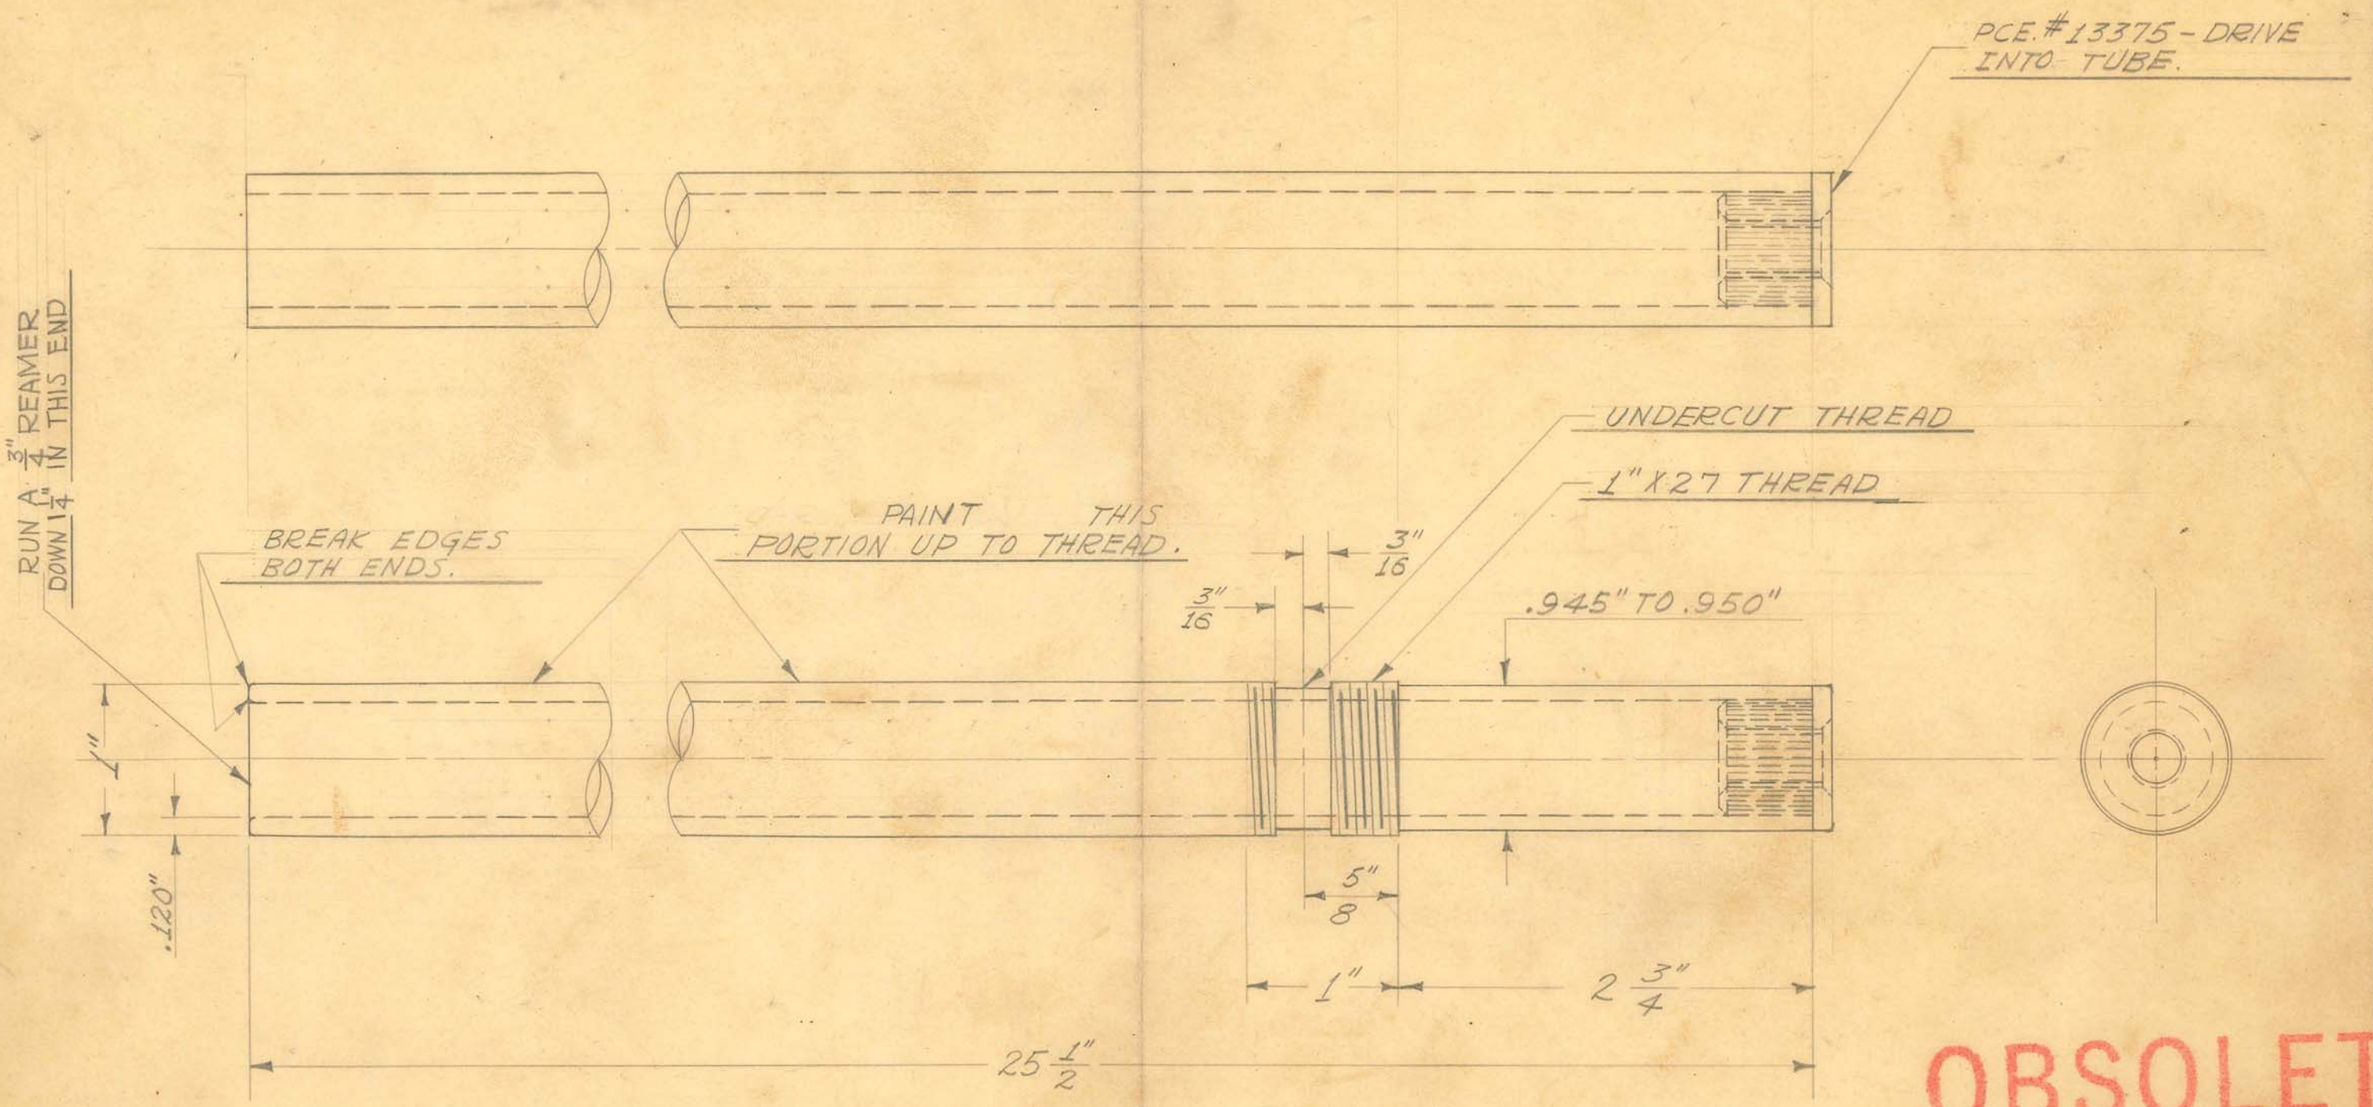

1" O.D. X #11GA. (.120") WALL - SEAMLESS SHELBY STEEL TUBING

1 REQUIRED

OBSOLET

Obsolete

SIZE		ISSUE 9-18-40	J.V.W.	TITLE: FISCHER "100-96" DIAGNOSTIC S.P. X-RAY BASE STOP VERTICAL TUBE
KIND		CHANGED 2-13-41	J.V.W.	
SHAPE		"		
FINISH	PAINT	"		
TEMP.		"		
PATT.		"		

H. G. FISCHER & CO.
2335 WABANSIA AVE.
CHICAGO, ILL.

CAT. NO.

PART NO. 13355G

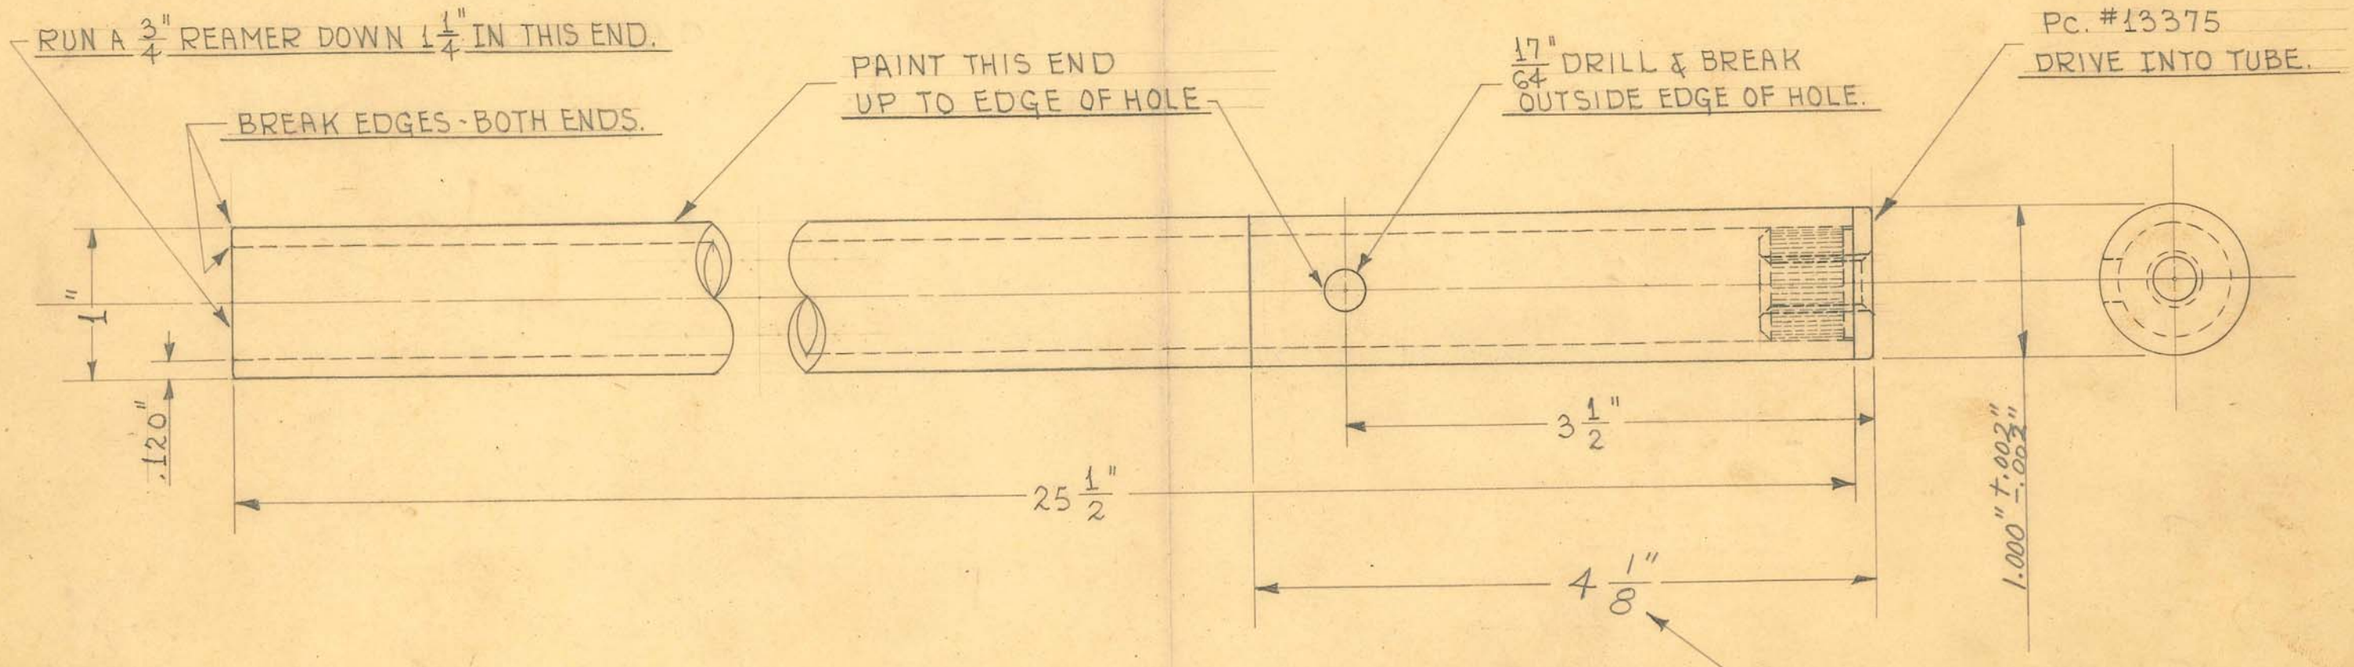

1" O.D. X #11 GA. (.120") WALL SHELBY SEAMLESS STEEL TUBING

1 REQUIRED

OBSOLETE

SIZE		ISSUE 1-25-45	HE.
KIND		CHANGED	
SHAPE		" 12-9-46	J.V.W.
FINISH	PAINTED	"	
TEMP.	(SEE ABOVE)	"	
		"	

TITLE: FISCHER "100-96" DIAGNOSTIC S.P. X-RAY BASE STOP VERTICAL TUBE

H. G. FISCHER & CO.
2335 WABANSIA AVE.
CHICAGO, ILL.

CAT. NO.

PART NO. 13355GA

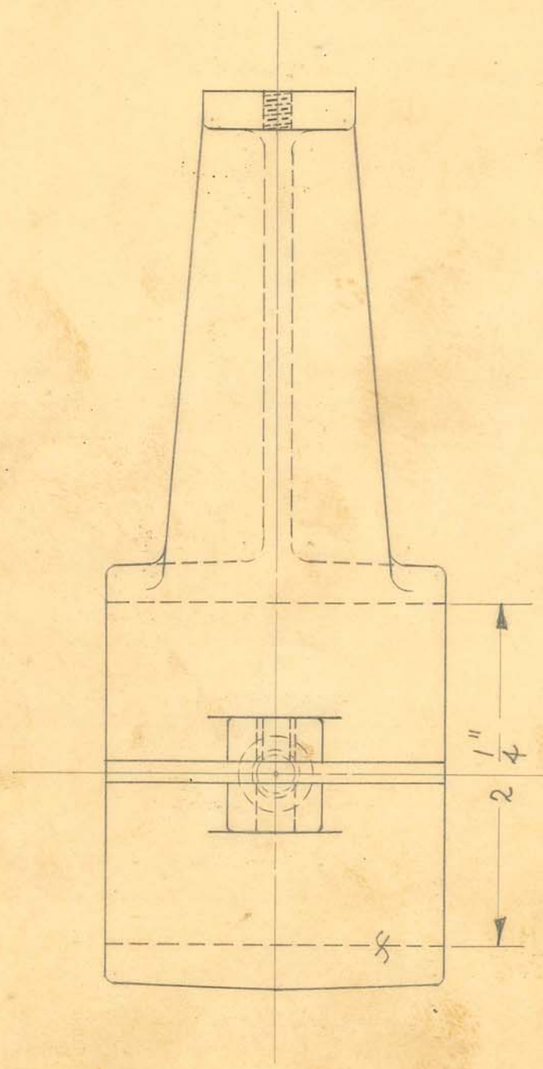

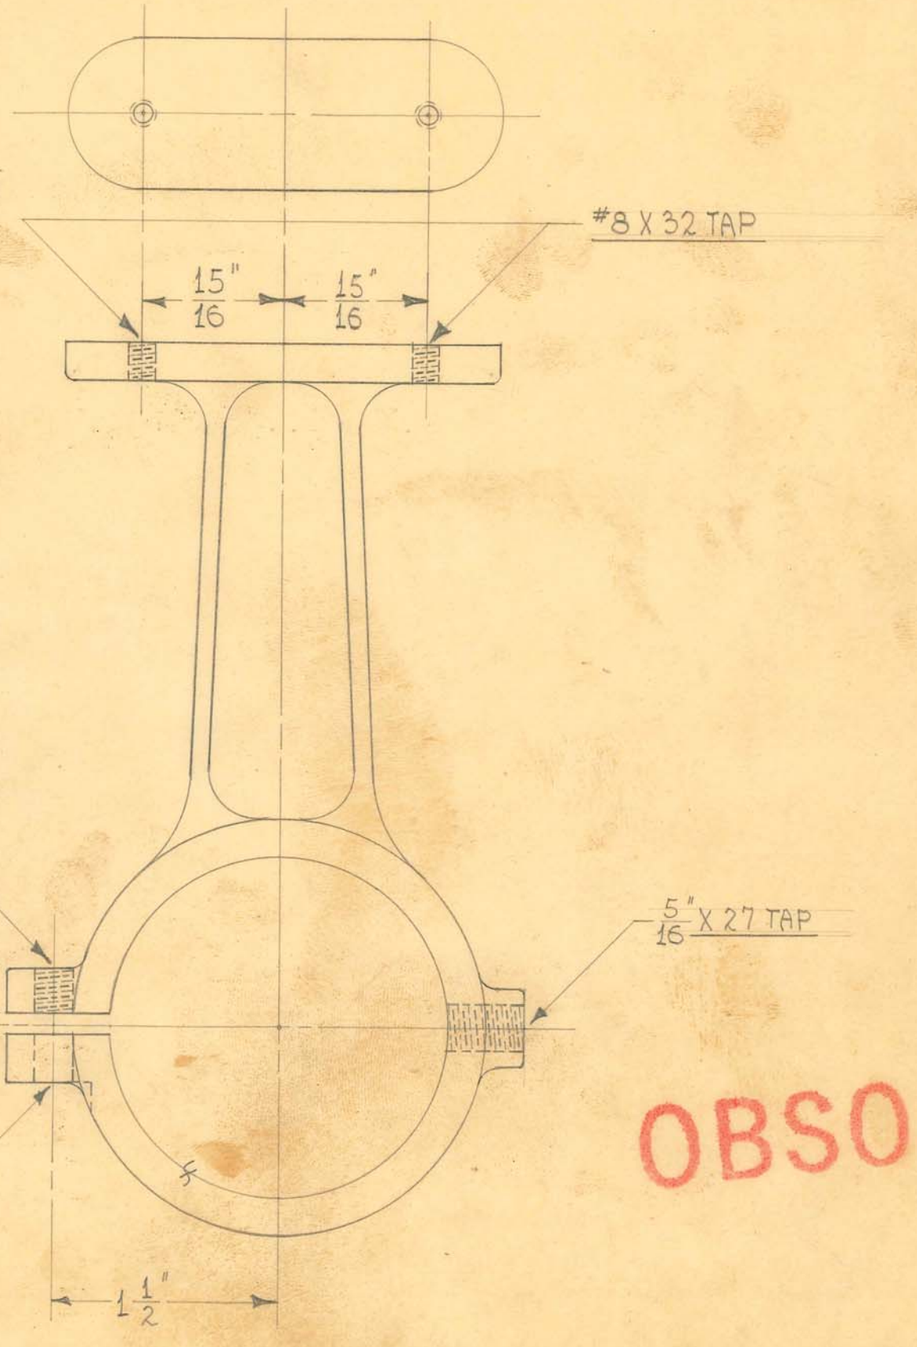

OBSOLETE

1 REQUIRED

SIZE	#12	ISSUE 7-22-40	HE.	TITLE: FISCHER MOD. 100-96 TUBE STAND - CABLE BRACKET SUPPORT
KIND	ALUM. CASTING	CHANGED		
SHAPE		"		
FINISH		"		
TEMP.		"		
PATT.	1594	"		

H. G. FISCHER & CO.
2335 WABANSIA AVE.
CHICAGO, ILL.

CAT. NO.

PART NO. 13356F

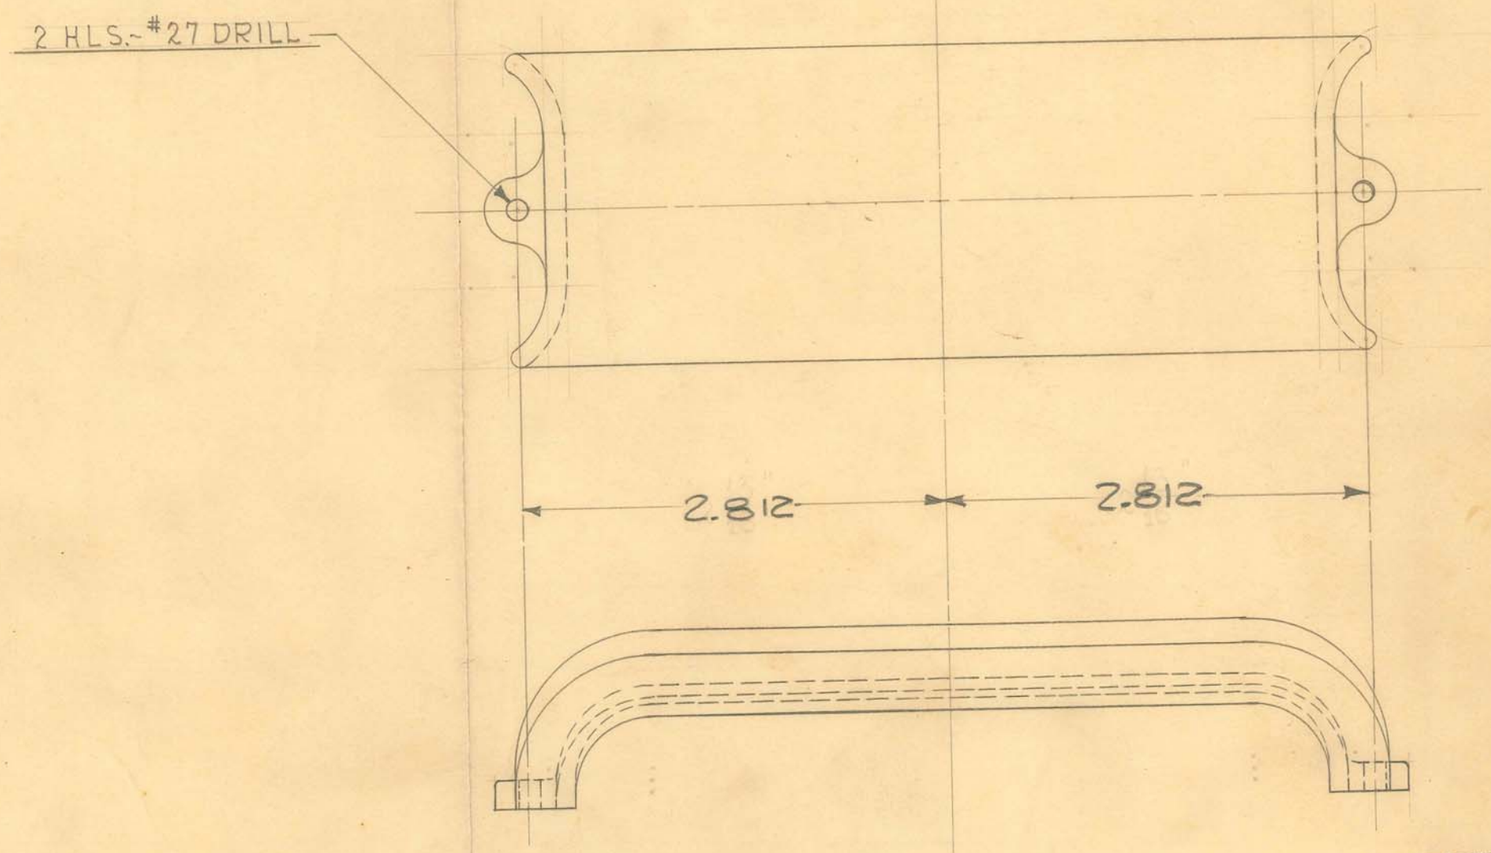

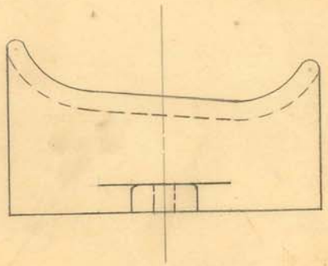

OBSOLETE
ECO#035-3-84
R.P. 3-30-84

1 REQUIRED

RS

SIZE	#12	ISSUE 12-11-41	H. E.
KIND	ALUM. CASTING	CHANGED	
SHAPE		"	
FINISH	PAINTED	"	
TEMP.		"	
PATT.	1849	"	

TITLE: FISCHER "RF-100" TUBE STAND ~ CABLE BRACKET CAP

H. G. FISCHER & CO.
2335 WABANSIA AVE.
CHICAGO, ILL.

CAT. NO.

PART NO. 13358AF

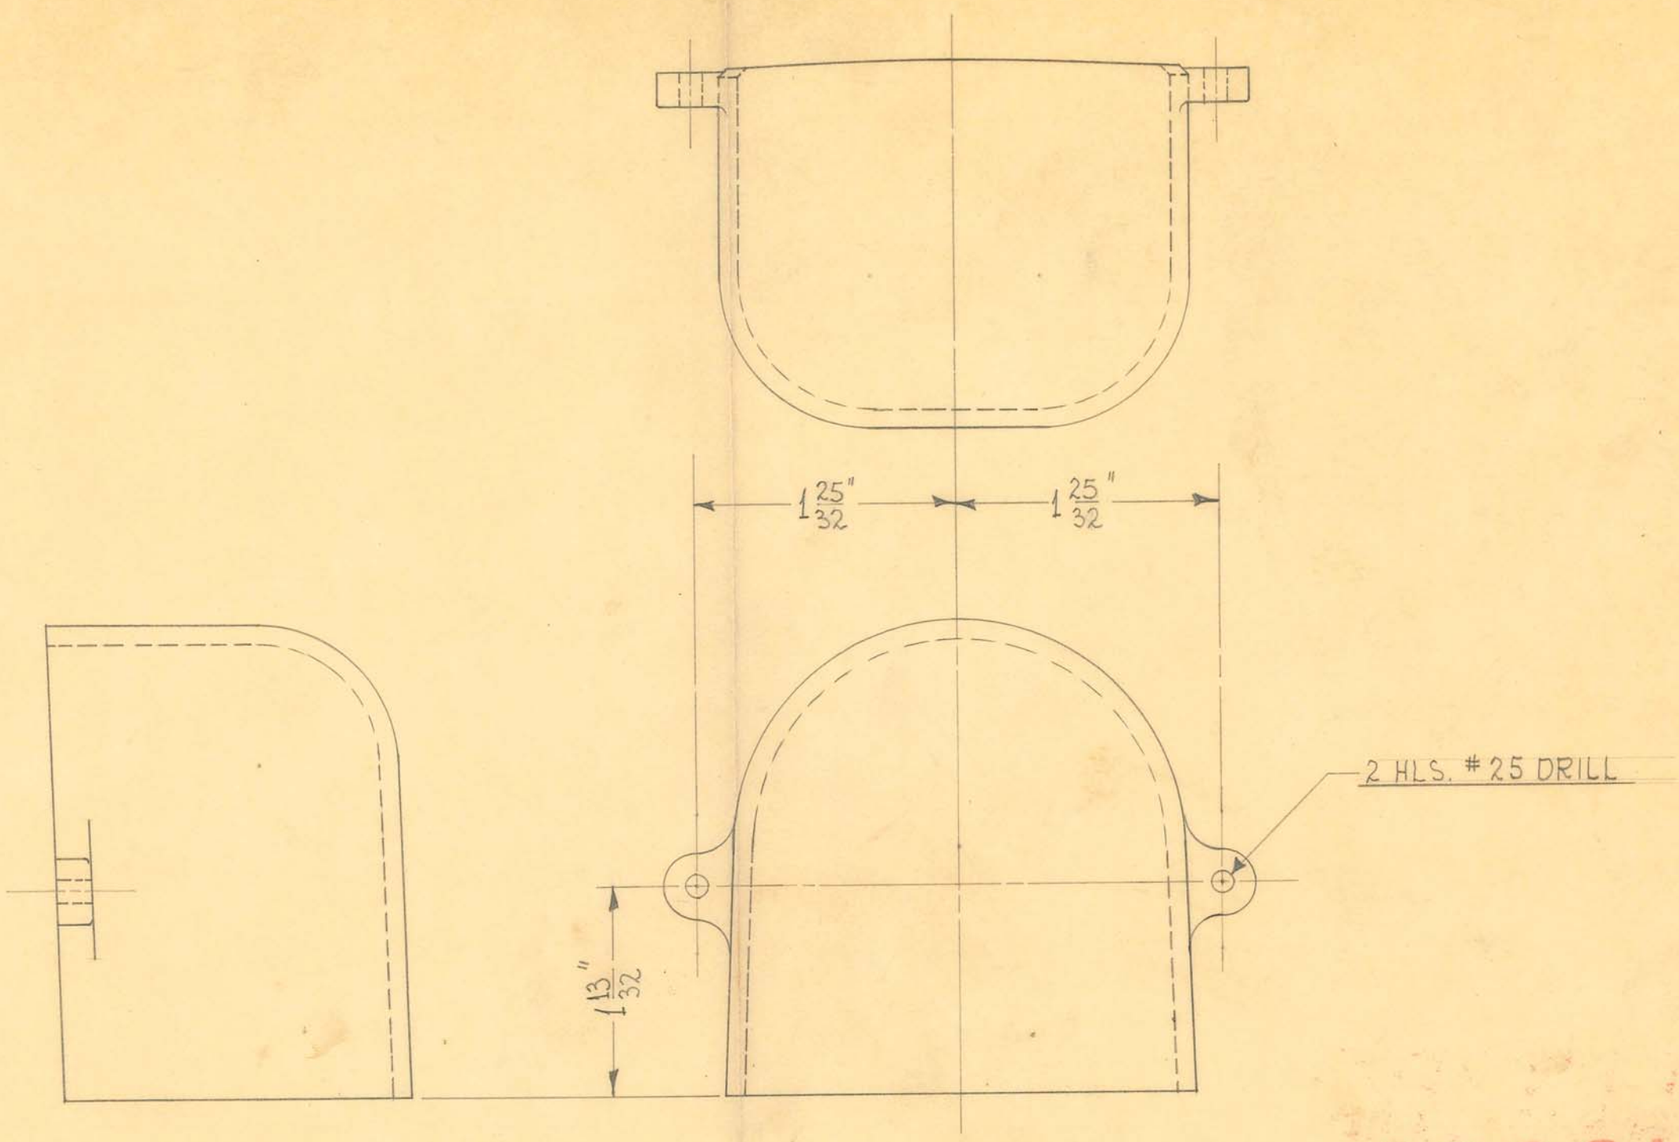

1 REQUIRED

OBSOLETE

SIZE	#12	ISSUE 8-23-40	HE.
KIND	ALUM. CASTING	CHANGED	
SHAPE		"	
FINISH	PAINTED	"	
TEMP.		"	
PATT.	1603	"	

TITLE: FISCHER MOD. "100-96" TUBE STAND BASE-RAIL LOCK COVER

H. G. FISCHER & CO.
2335 WABANSIA AVE.
CHICAGO, ILL.

CAT. NO.

PART NO. 13361F

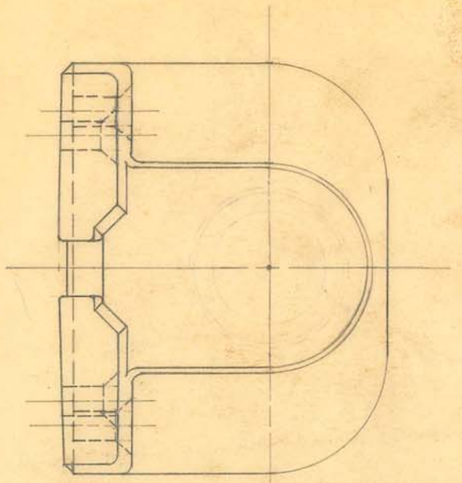

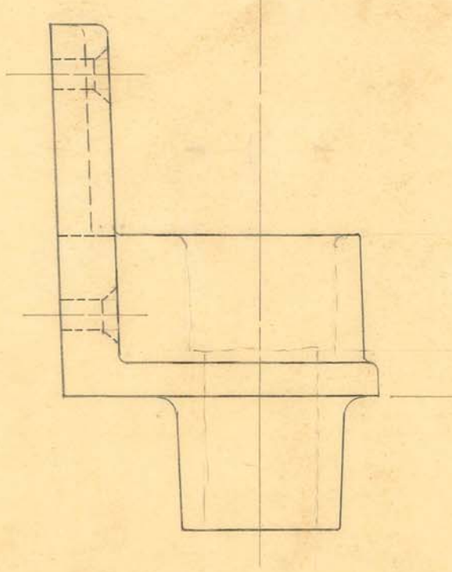

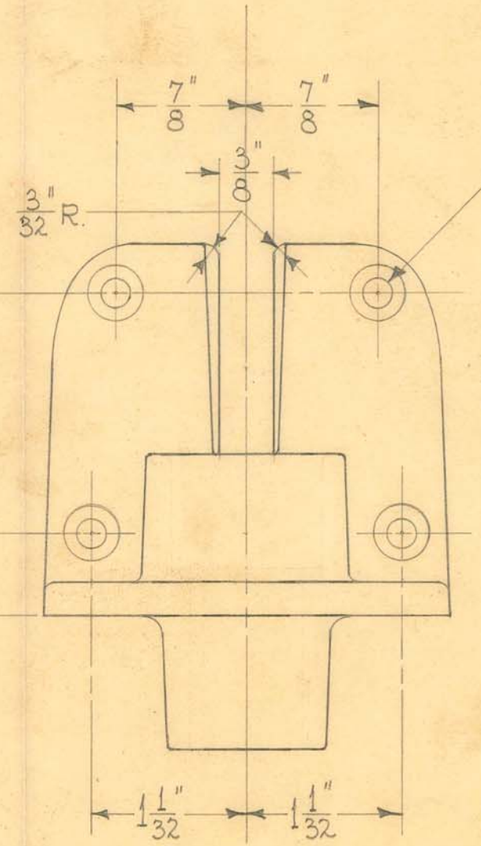

1 REQUIRED

OBSOLETE

Obsolete

SIZE		ISSUE 8-23-40	HE
KIND	CAST IRON	CHANGED	
SHAPE		"	
FINISH		"	
TEMP.		"	
PATT.	1604	"	

TITLE: FISCHER MOD. "100-96" TUBE STAND BASE - RAIL LOCK SUPPORT

H. G. FISCHER & CO. 2335 WABANSIA AVE. CHICAGO, ILL.	CAT. NO.	PART NO. 13362F

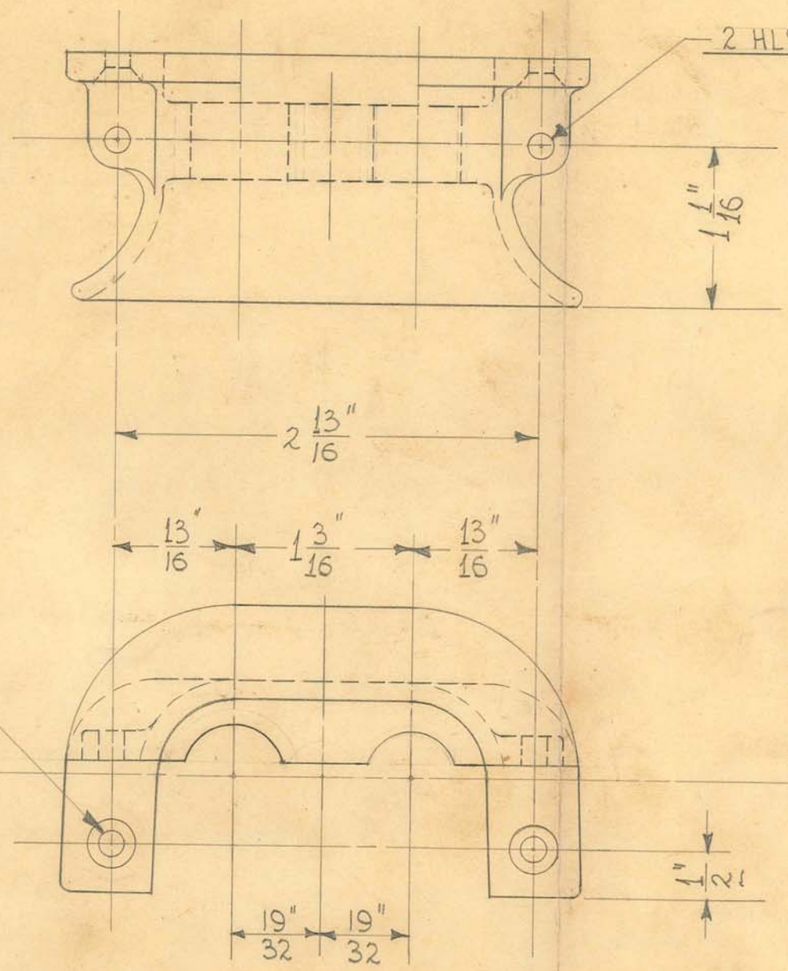

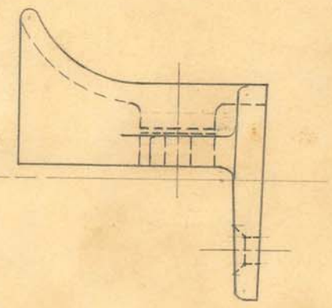

1 REQUIRED

OBSOLETE

Obsolete
10-12-56

SIZE	#12	ISSUE 8-21-40	HE
KIND	ALUM. CASTING	CHANGED	
SHAPE		" 2-18-44	HE
FINISH	PAINTED	"	
TEMP.		"	
PATT.	1607	"	

TITLE: FISCHER MOD. "100-96" X-RAY-
TRANSFORMER CABLE SUPPORT

H. G. FISCHER & CO.
2338 WABANSIA AVE.
CHICAGO, ILL.

CAT. NO.

PART NO. 13366AF

1670½ - 8336

~~8336 - 6432 - 12691½~~

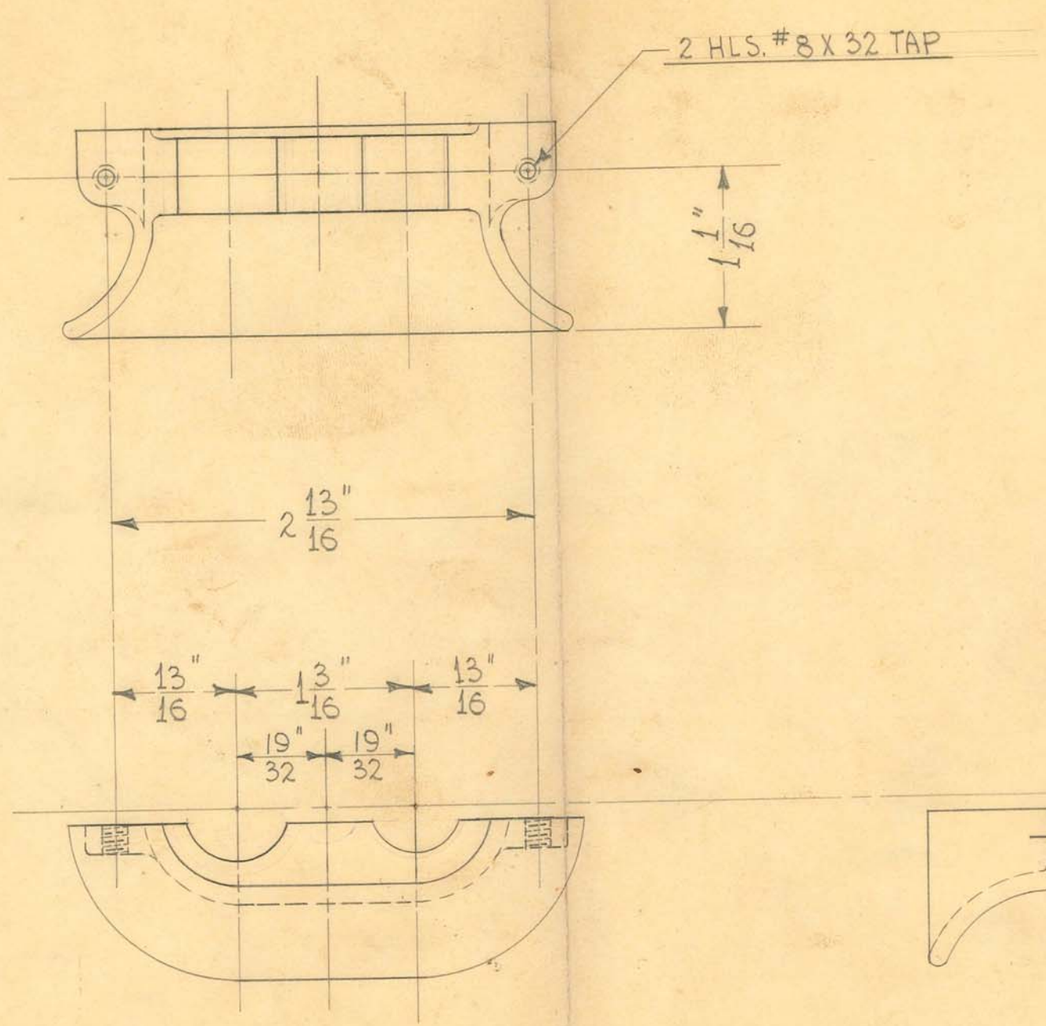

1 REQUIRED

OBSOLETE
obsolete
10-12-56

SIZE	#12	ISSUE 8-21-40	HE.
KIND	ALUM. CASTING	CHANGED	
SHAPE		" 2-18-44	HE
FINISH	PAINTED	"	
TEMP.		"	

TITLE: FISCHER MOD. "100-96" X-RAY - TRANSFORMER CABLE SUPPORT CLAMP

H. G. FISCHER & CO.
2335 WABANSIA AVE.
CHICAGO, ILL.

CAT. NO.

PART NO. 13367AF

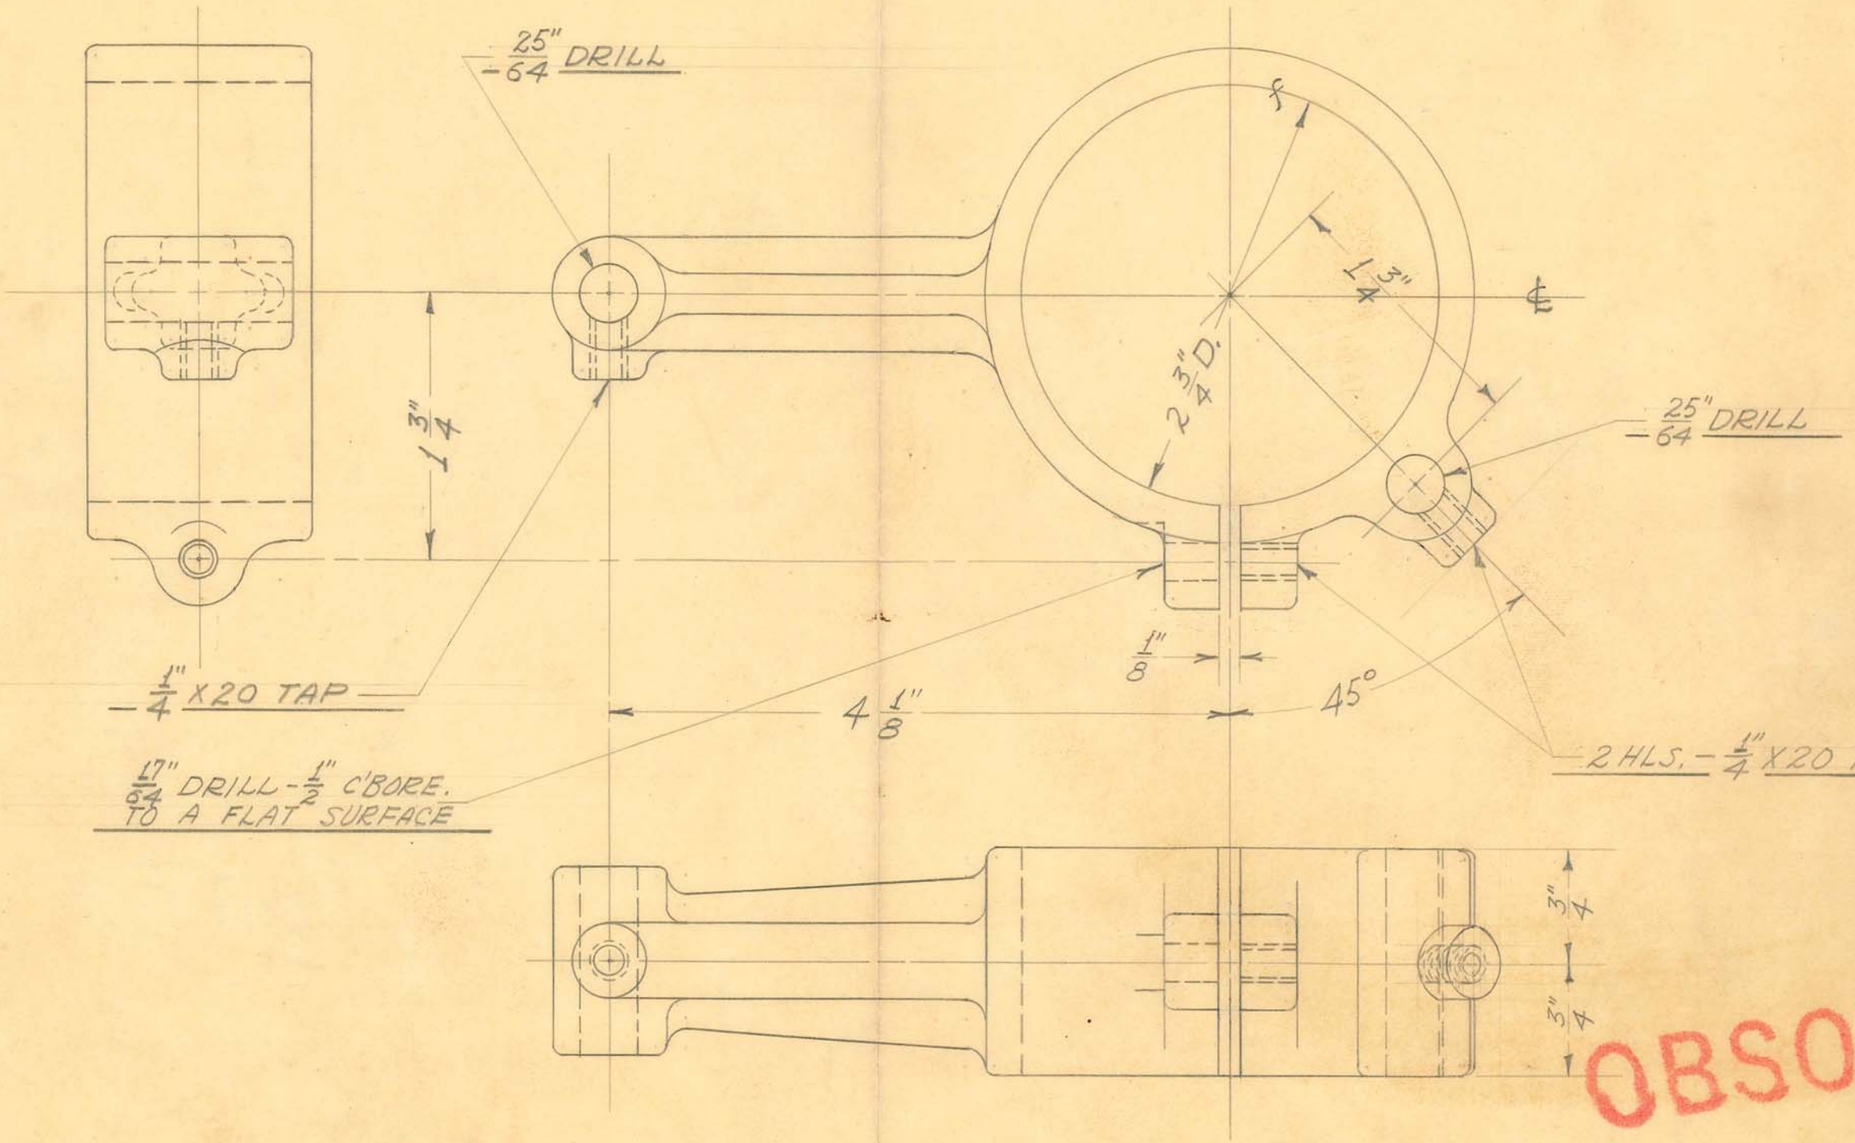

OBSOLETE

1 REQUIRED

SIZE	# 214	ISSUE 8-16-40	J.V.W.
KIND	ALUM. CASTING	CHANGED	
SHAPE		"	
FINISH	PAINTED	"	
TEMP.		"	

TITLE:
FISCHER "100-96" TUBE STAND
VERTICAL SLIDE - STOP COLLAR

H. G. FISCHER & CO. | CAT. NO. | PART NO. 133695

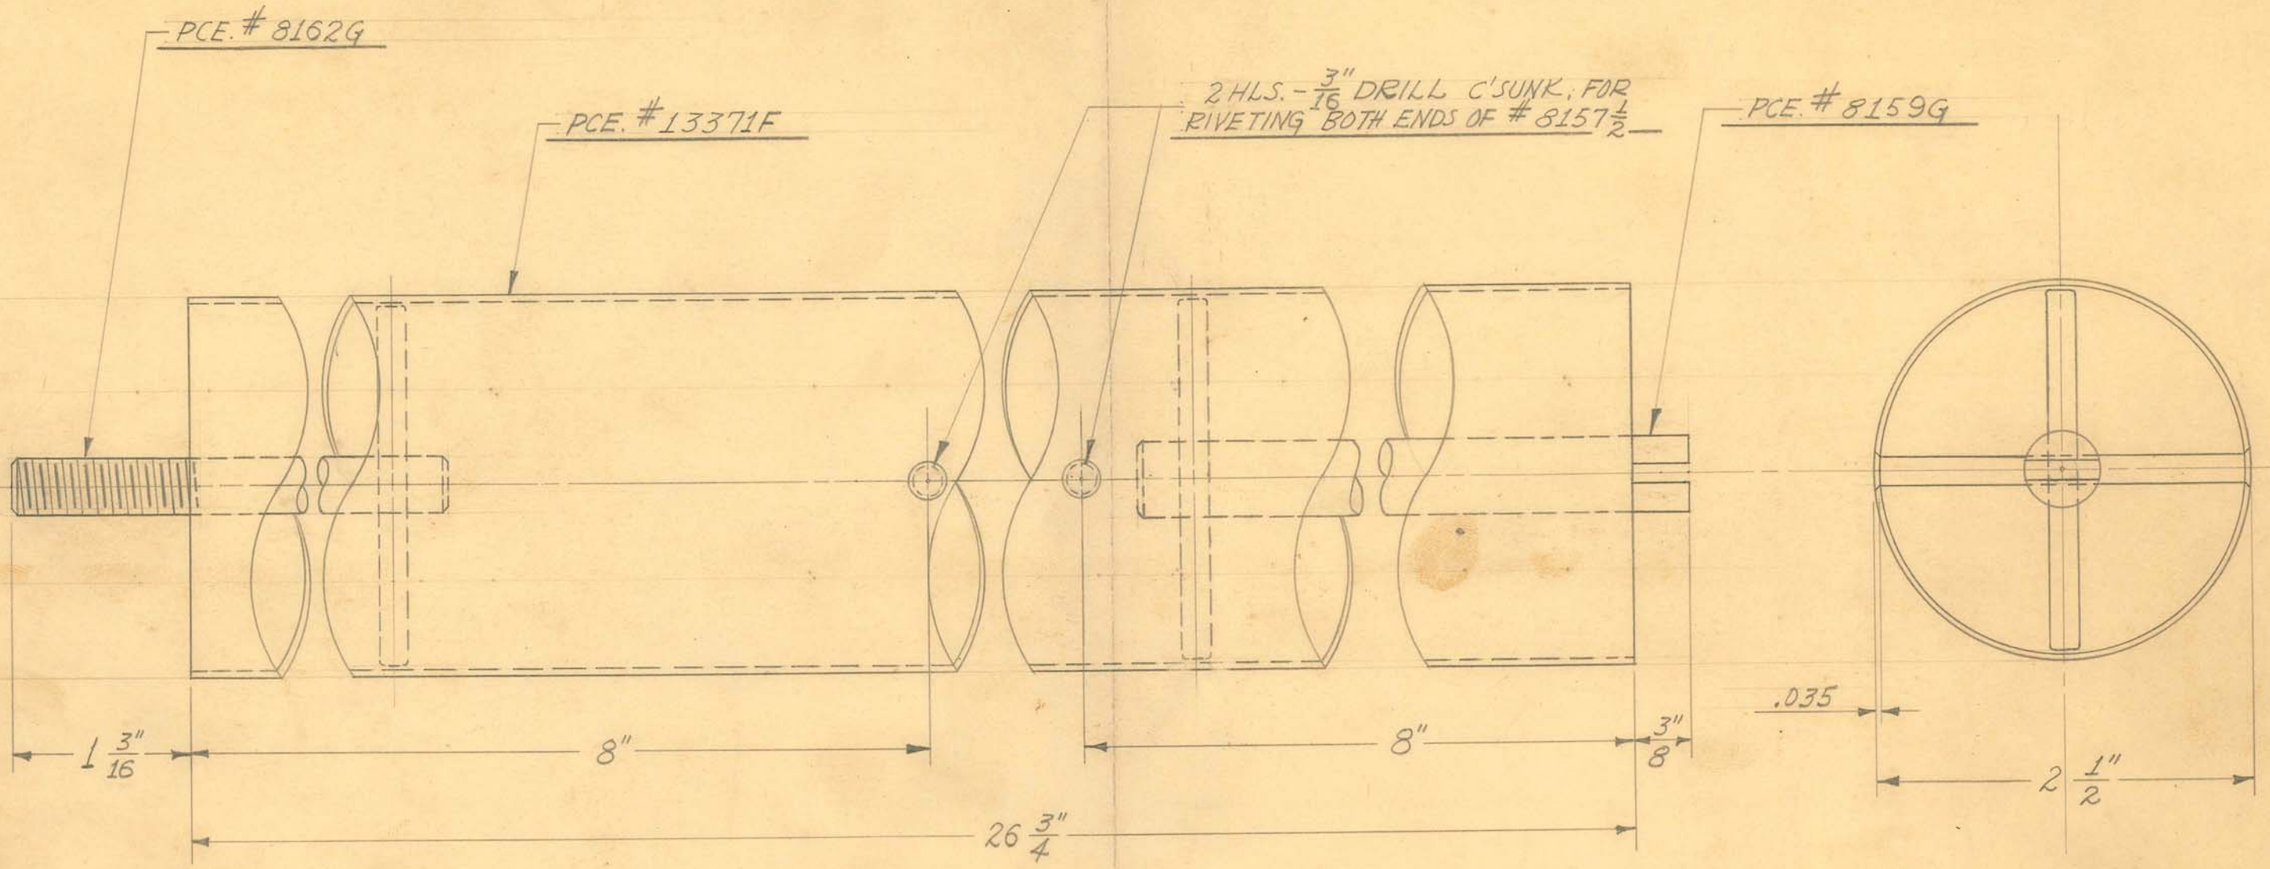

1 REQUIRED

OBSOLETE

SIZE		ISSUE 12-6-40	J.V.W.
KIND		CHANGED	
SHAPE		"	
FINISH		"	
TEMP.		"	
PATT.		"	

TITLE: FISCHER MOD. "100-96" TUBE STAND
TUBE HEAD COUNTERWEIGHT ASSEM.

H. G. FISCHER & CO.
2335 WABANSIA AVE.
CHICAGO, ILL.

CAT. NO.

PART NO. 13372G

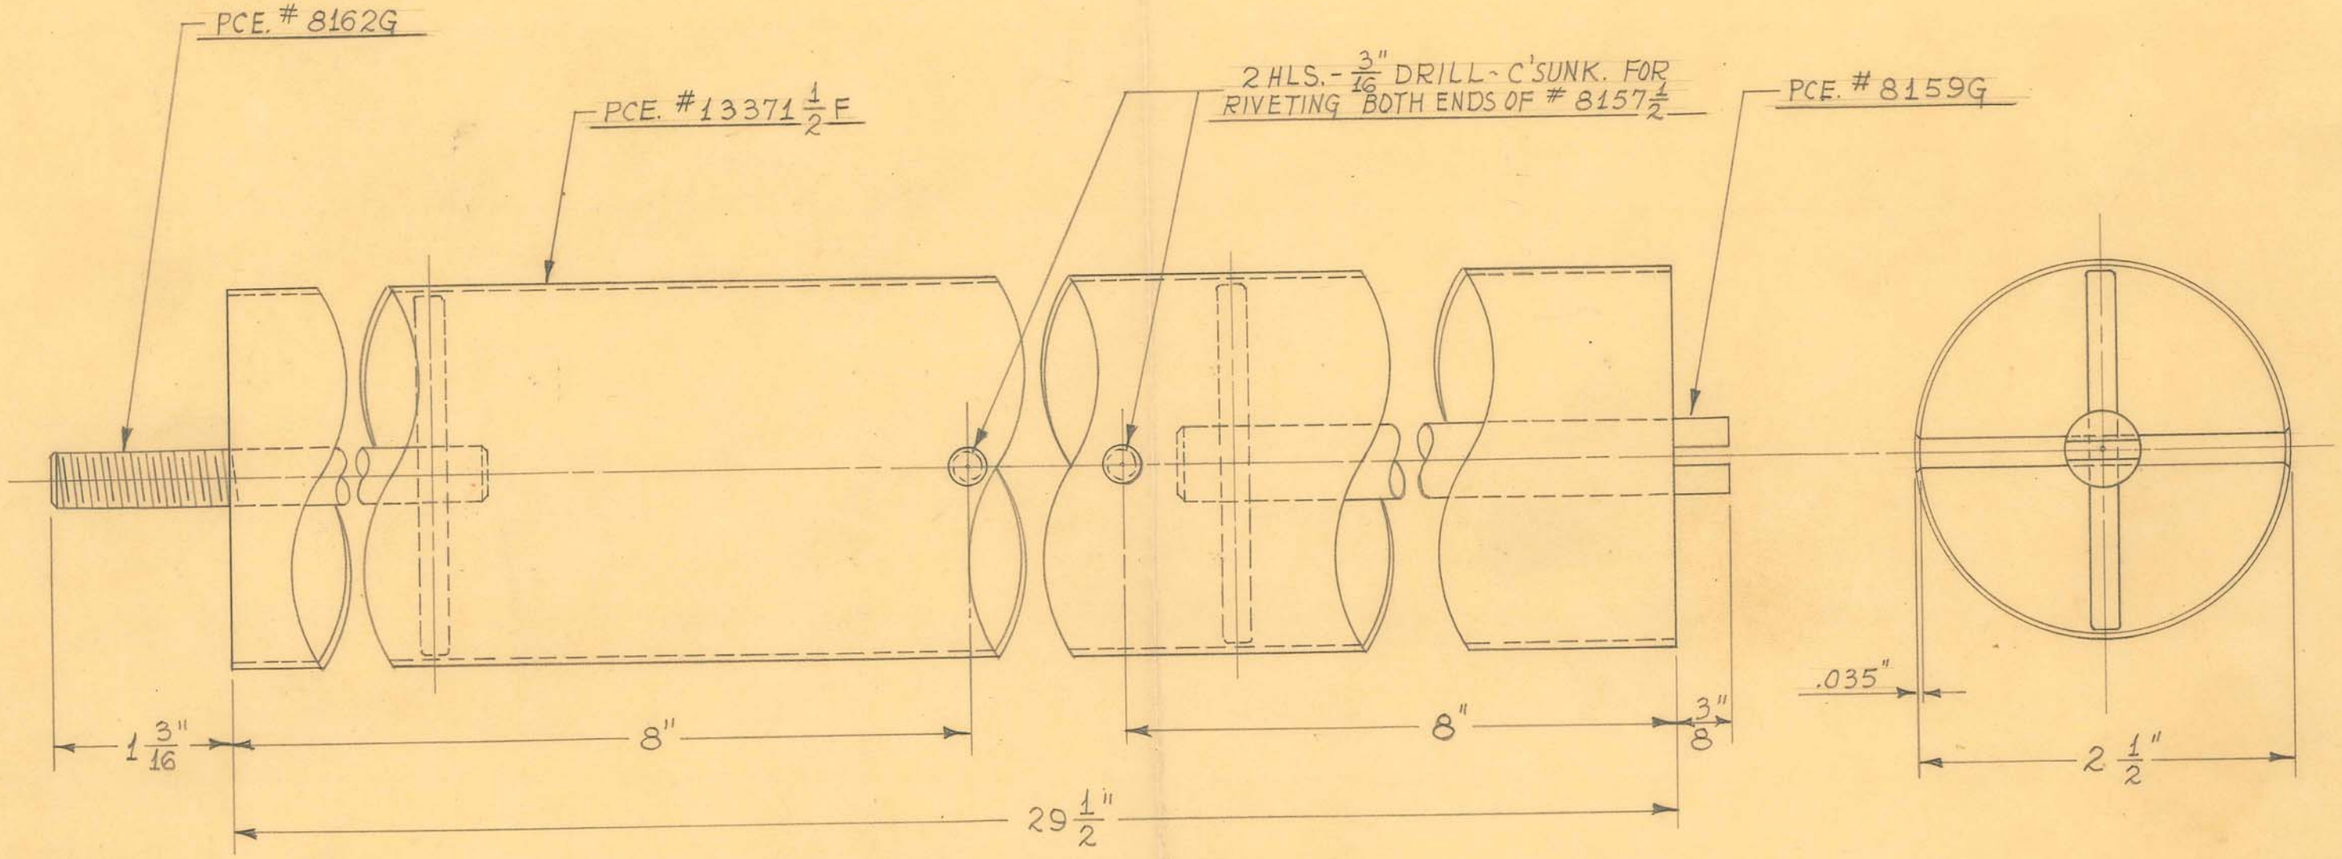

1 REQUIRED

TOTAL WEIGHT WHEN FILLED WITH LEAD ~ 55 1/2 LBS.

OBSOLETE
Obsolete

SIZE		ISSUE 6-23-45	HE.
KIND		CHANGED	
SHAPE		"	
FINISH		"	
TEMP.		"	
PATT.		"	

TITLE: FISCHER MOD. "100-96" TUBE STAND - TUBE HEAD COUNTERWEIGHT ASSEM. (FOR HEAVY CABLE)

H. G. FISCHER & CO.
2335 WABANSIA AVE.
CHICAGO, ILL.

CAT. NO.

PART NO. 13372 1/2 G

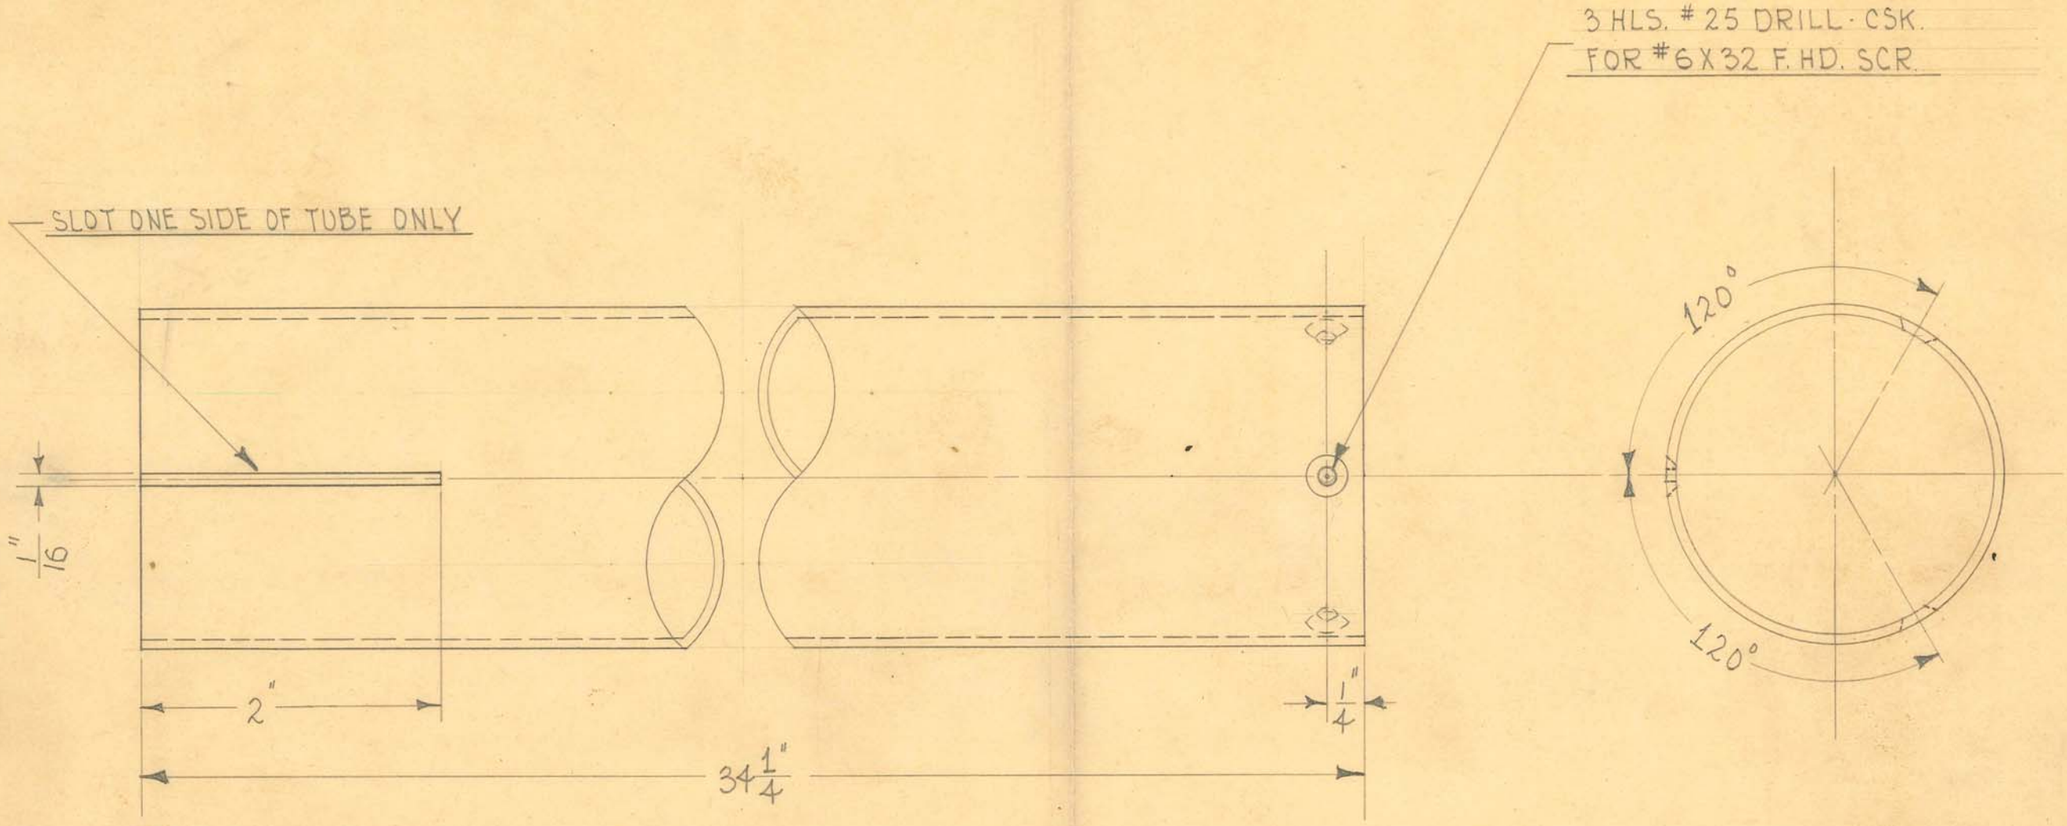

1 REQUIRED

OBSOLETE

SIZE	2¼" O.D. X 16GA	ISSUE 8-19-40	HE
KIND	SEAMLESS STEEL	CHANGED	
SHAPE	TUBING	"	
FINISH	CHROME #2	"	
TEMP.		"	
PATT.		"	

TITLE: FISCHER MOD. "100-96" X-RAY UNIT - OUTER TUBE HEAD SUPP. HORIZ. TUBE (FINISHED)

H. G. FISCHER & CO.
2335 WABANSIA AVE.
CHICAGO, ILL.

CAT. NO.

PART NO. 13389

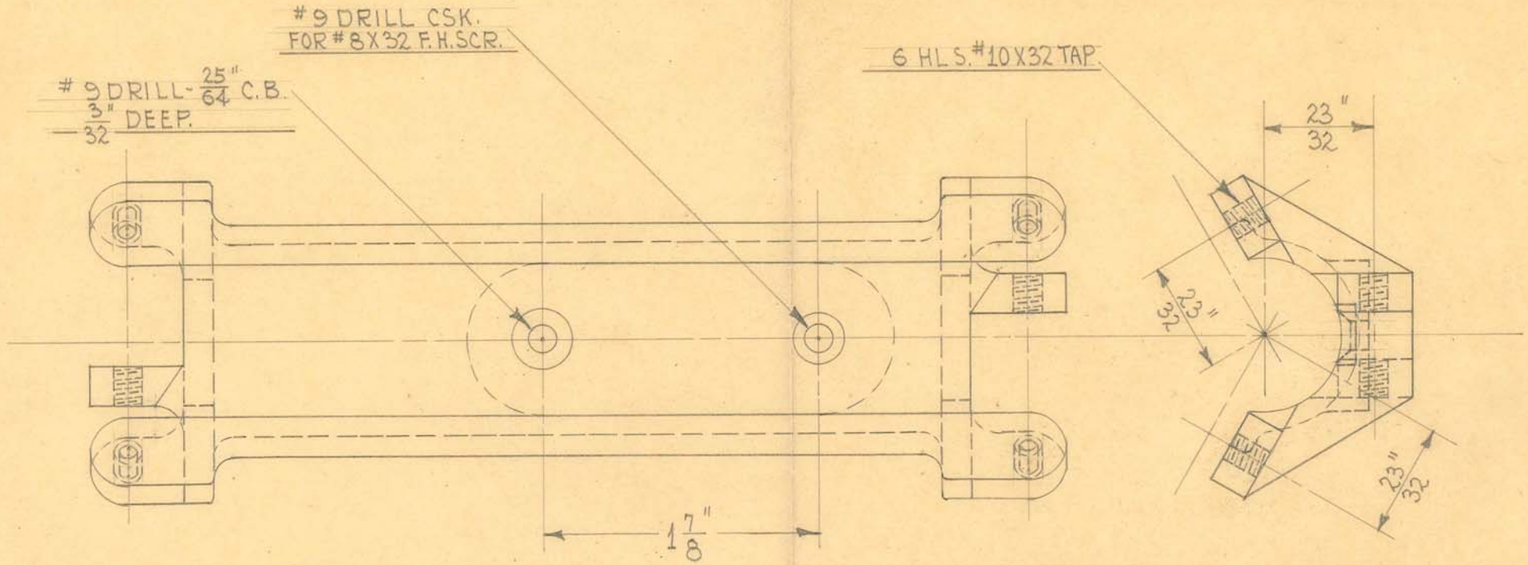

1 REQUIRED

OBSOLETE

SIZE	#12	ISSUE 8-27-40	HE.
KIND	ALUM. CASTING	CHANGED	
SHAPE		"	
FINISH	PAINTED	"	
TEMP.		"	
PATT.	1612	"	

TITLE:
FISCHER MOD. "100"-96" TUBE STAND
HORIZ. TUBE BEARING

H. G. FISCHER & CO.
2335 WABANSIA AVE.
CHICAGO, ILL.

CAT. NO.

PART NO. 13393F

Pattern junked
6/23/71
E.C.O. 1182

OBSOLETE

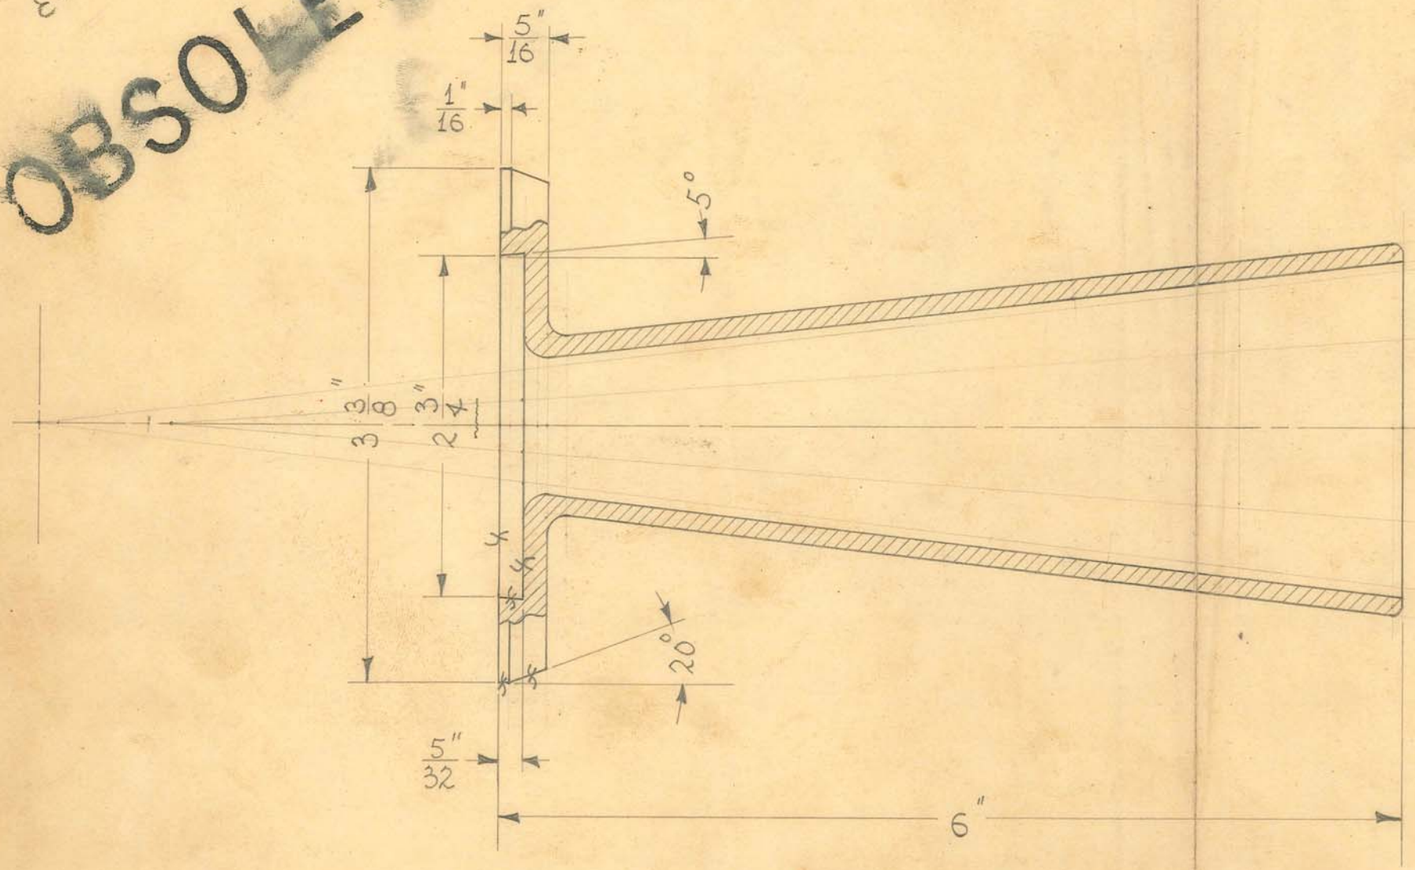

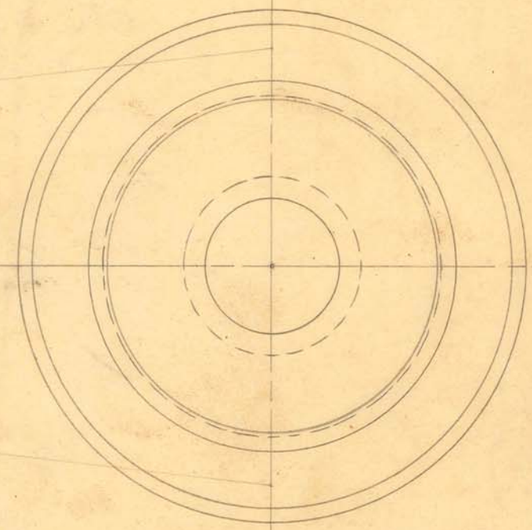

1 REQUIRED

NOTE:-
ALL SURFACES MARKED "4" ARE TO BE MASKED BEFORE PAINTING

#12 ALUMINUM

SIZE		ISSUE 10-1-40	HE.
KIND	~~IRON CASTING~~	CHANGED	
SHAPE		"	
FINISH	PAINTED	"	
~~TEMP.~~	(SEE NOTE)	"	
PATT.	1624	"	

TITLE: X-RAY CONE SIZED TO EXPOSE A 7" DIAM. CIRCLE AT 30" DISTANCE

H. G. FISCHER & CO.
2335 WABANSIA AVE.
CHICAGO. ILL.

CAT. NO.

PART NO. 13415AF

Public
C274-T-33

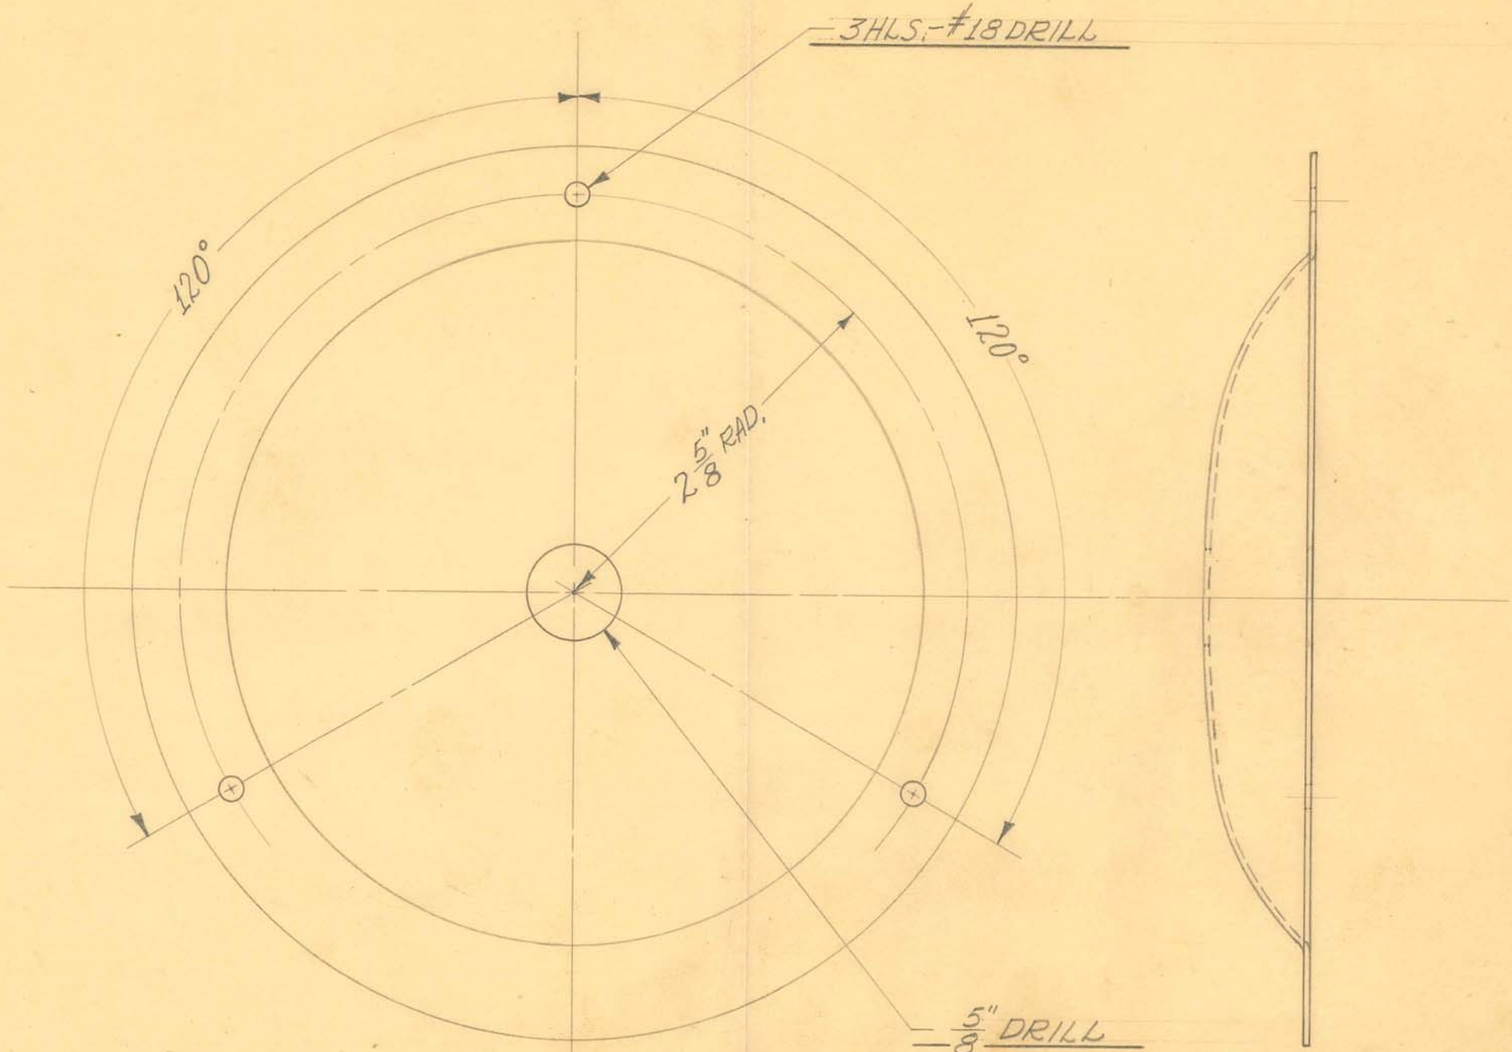

1 REQUIRED

OBSOLETE

SIZE	FROM 11885	ISSUE 10-18-40	J.V.W.
KIND		CHANGED	
SHAPE		"	
FINISH	SATIN FINISH	"	
~~TEMP.~~	#27 OUTSIDE	"	
~~PATT.~~	ONLY	"	

TITLE: FISCHER MOD. "CK" COLD QUARTZ-ULTRA VIOLET LAMP-HOOD BAFFLE PLATE

H. G. FISCHER & CO.
2338 WABANSIA AVE.
CHICAGO, ILL.

CAT. NO.

PART NO. 13522

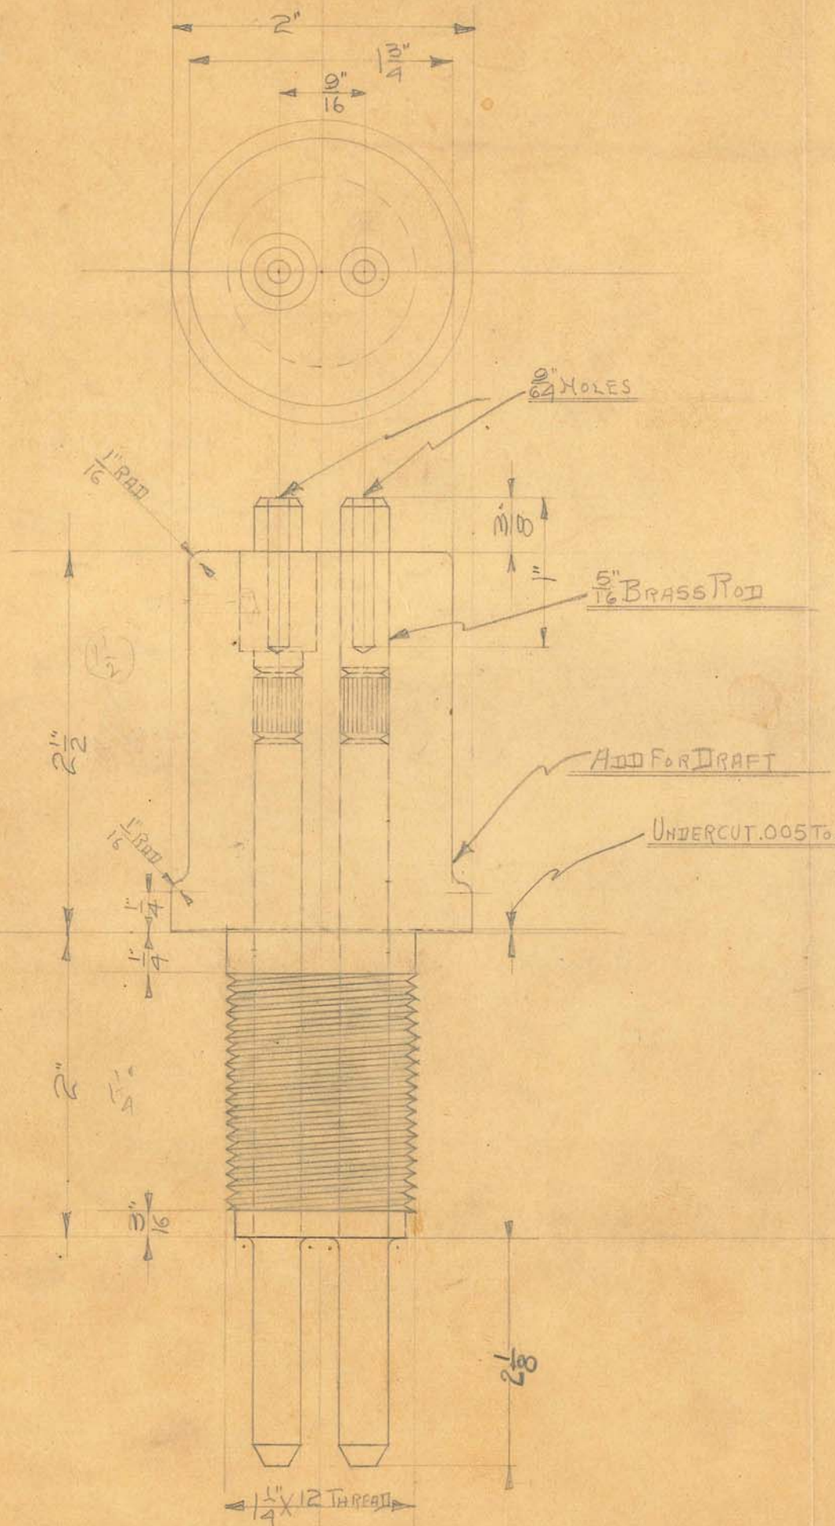

OBSOLETE

SIZE		ISSUE		TITLE: 60—88 TRANSFORMER HIGH TENSION POST.
KIND		CHANGED		
SHAPE		" "		
FINISH		" "		
TEMP.		" "		H. G. FISCHER & CO. 2335 WABANSIA AVE. CHICAGO, ILL. — CAT. NO. — PART NO. 8359G
PATT.		" "		

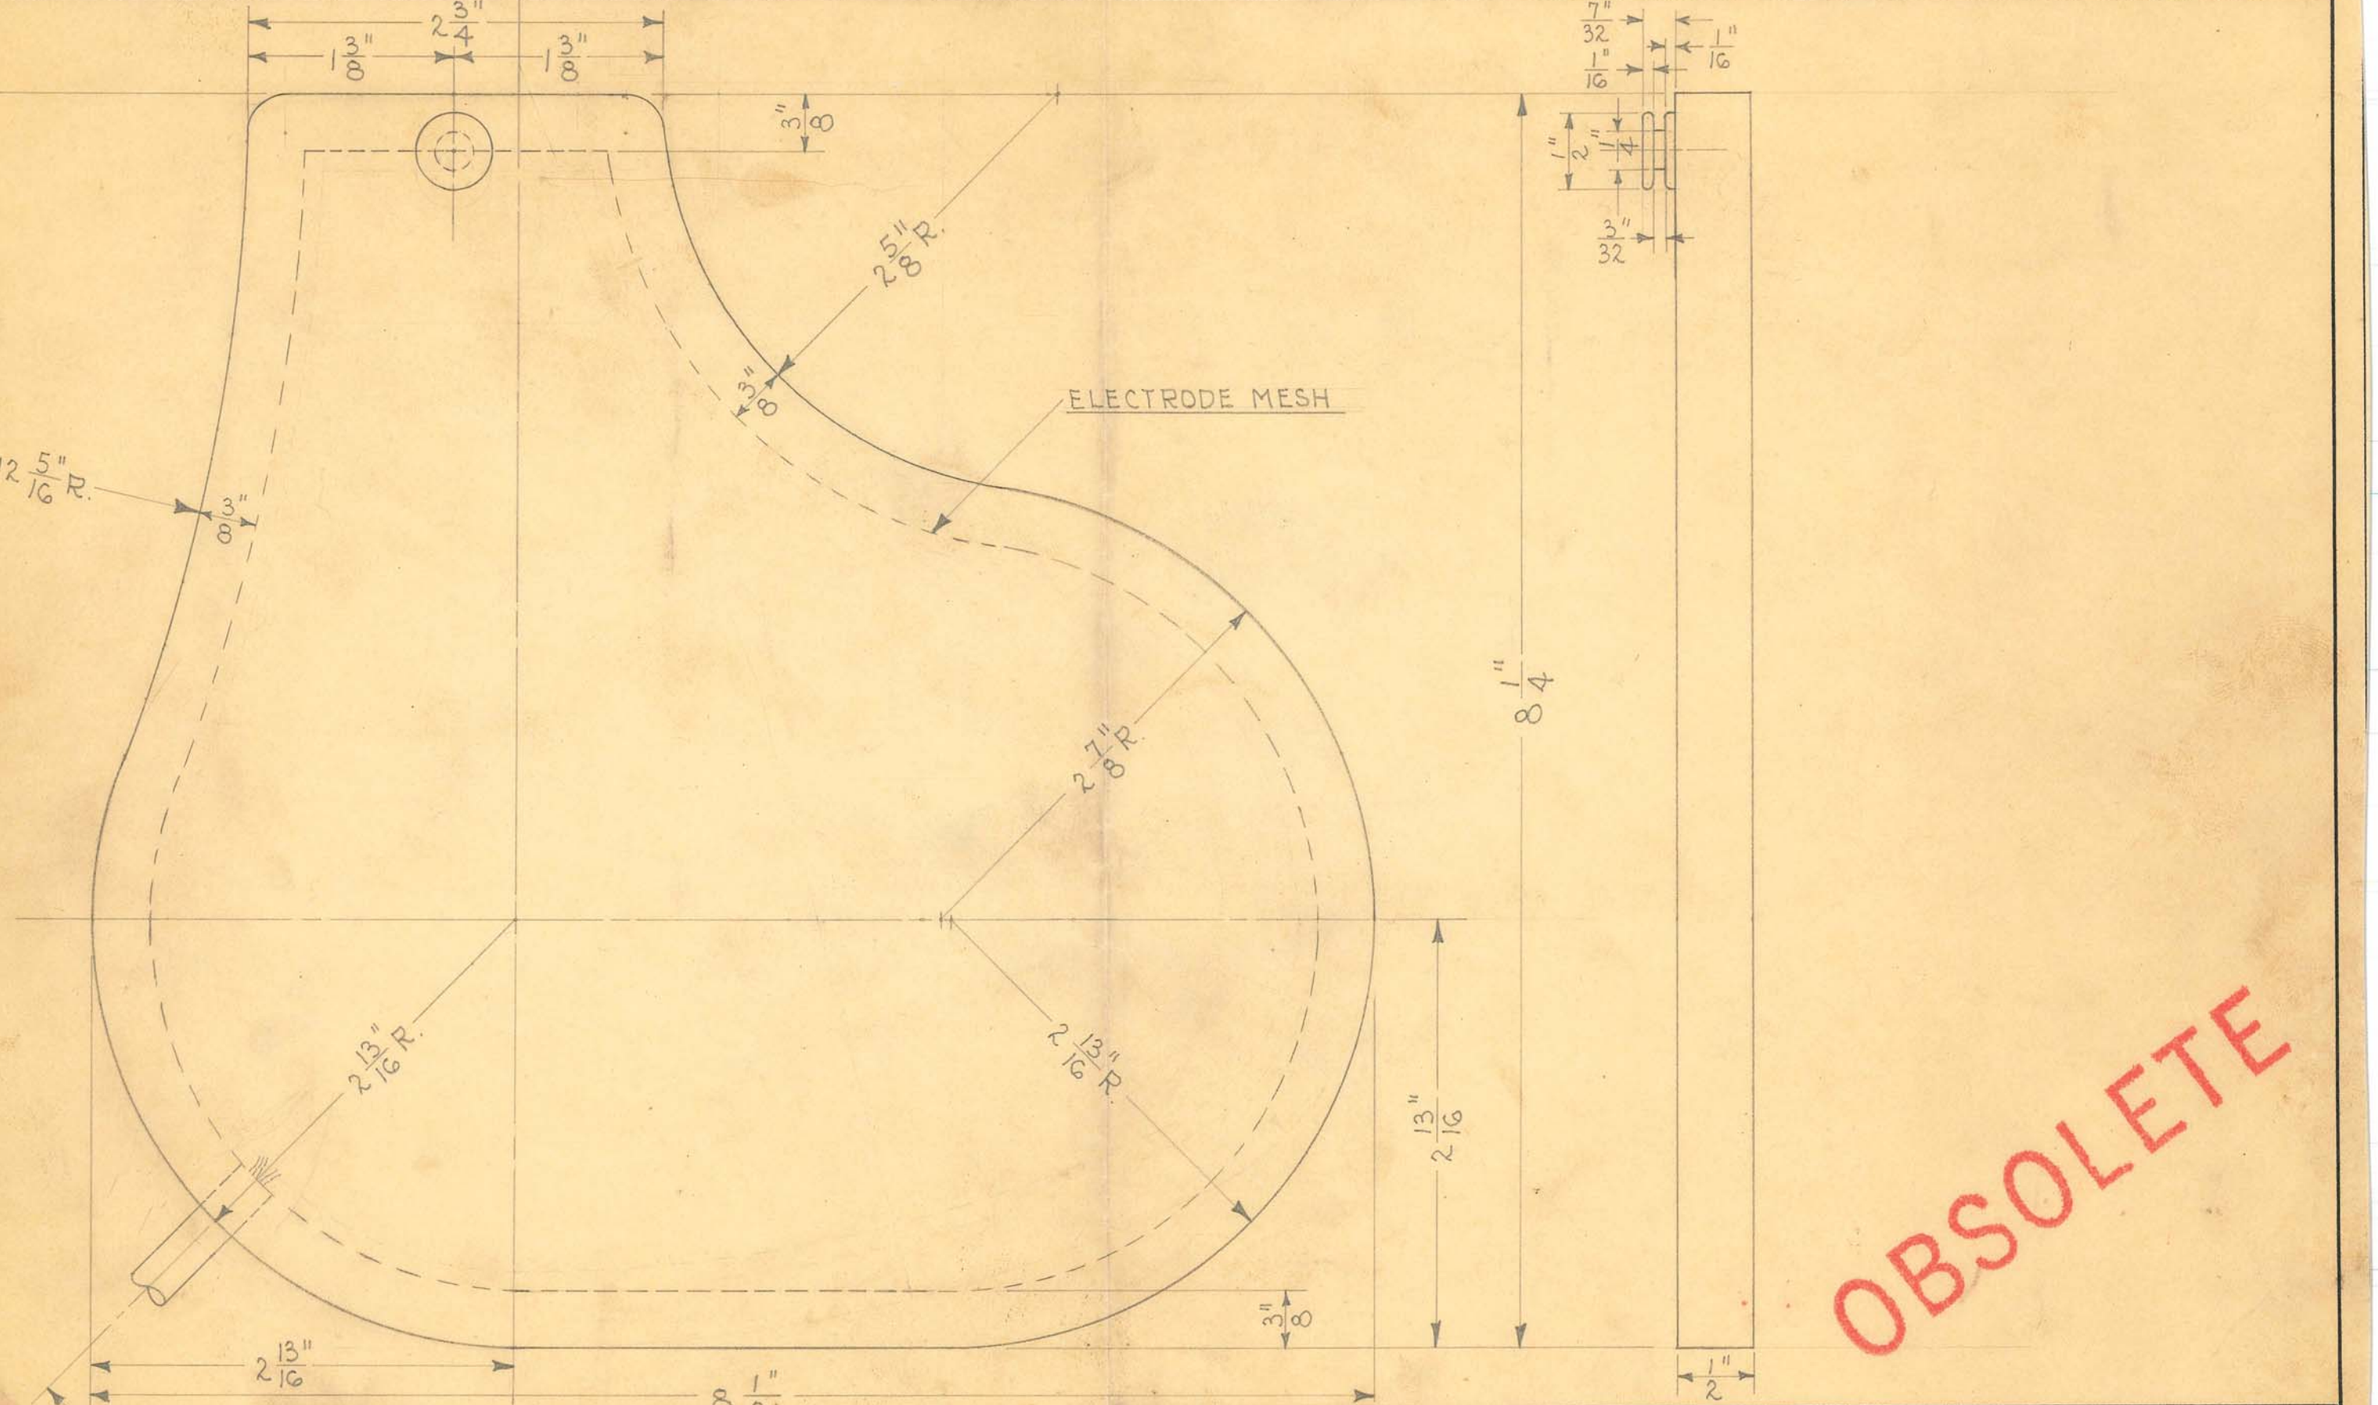

OBSOLETE

SIZE		ISSUE 3-1-37	A.E.
KIND		CHANGED	
SHAPE		"	
FINISH		"	
TEMP.		"	
PATT.		"	

TITLE: SHORT WAVE CONDENSER TYPE SHOULDER PAD ELECTRODE

H. G. FISCHER & CO.
2335 WABANSIA AVE.
CHICAGO, ILL.

CAT. NO.

PART NO. 9175G

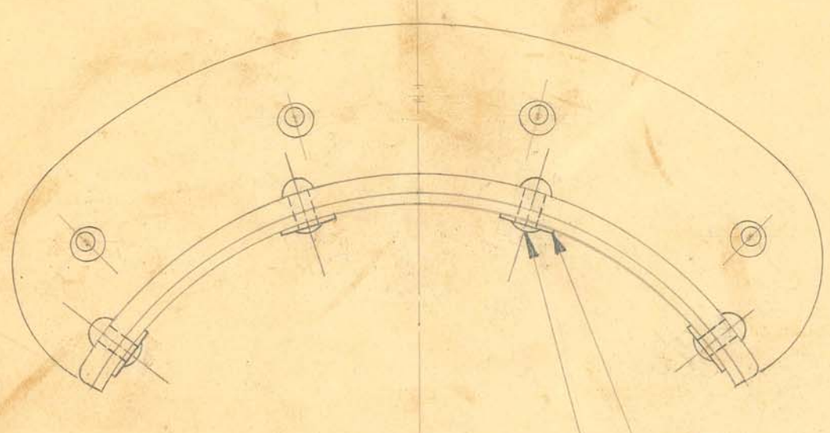

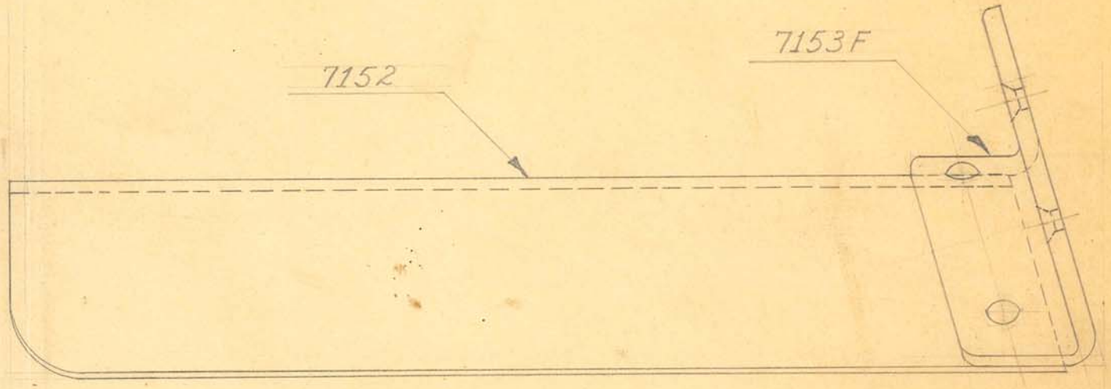

3452

PCE. NO. 7154 - SPIN OVER WASHER

1 REQUIRED

OBSOLETE

SIZE		ISSUE 8-14-36	A.E.
KIND		CHANGED	
SHAPE		"	
FINISH	BLACK #95	"	
TEMP.		"	
PATT.		"	

TITLE: FLUOROSCOPE HANDLE HAND PROTECTOR ASSEM.

H. G. FISCHER & CO.
2335 WABANSIA AVE.
CHICAGO, ILL.

CAT. NO.

PART NO. 7151G

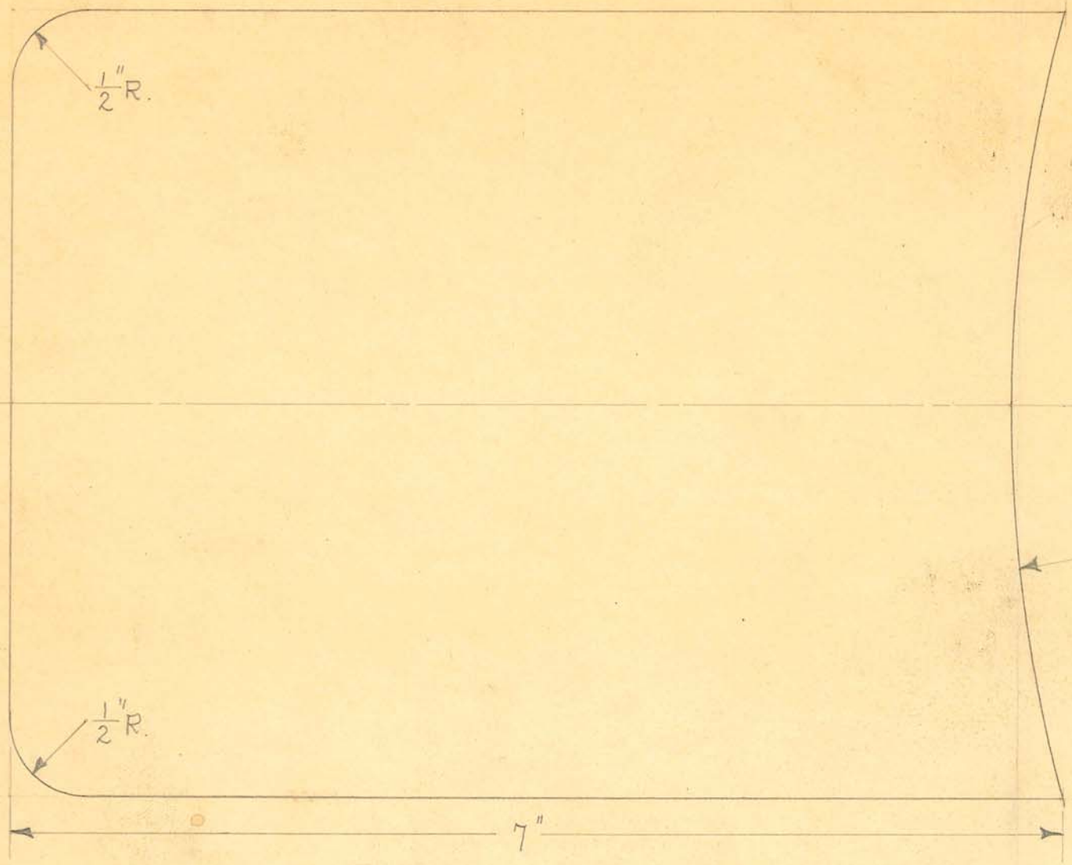

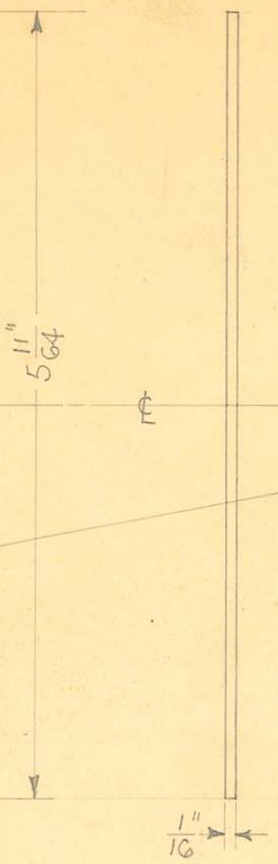

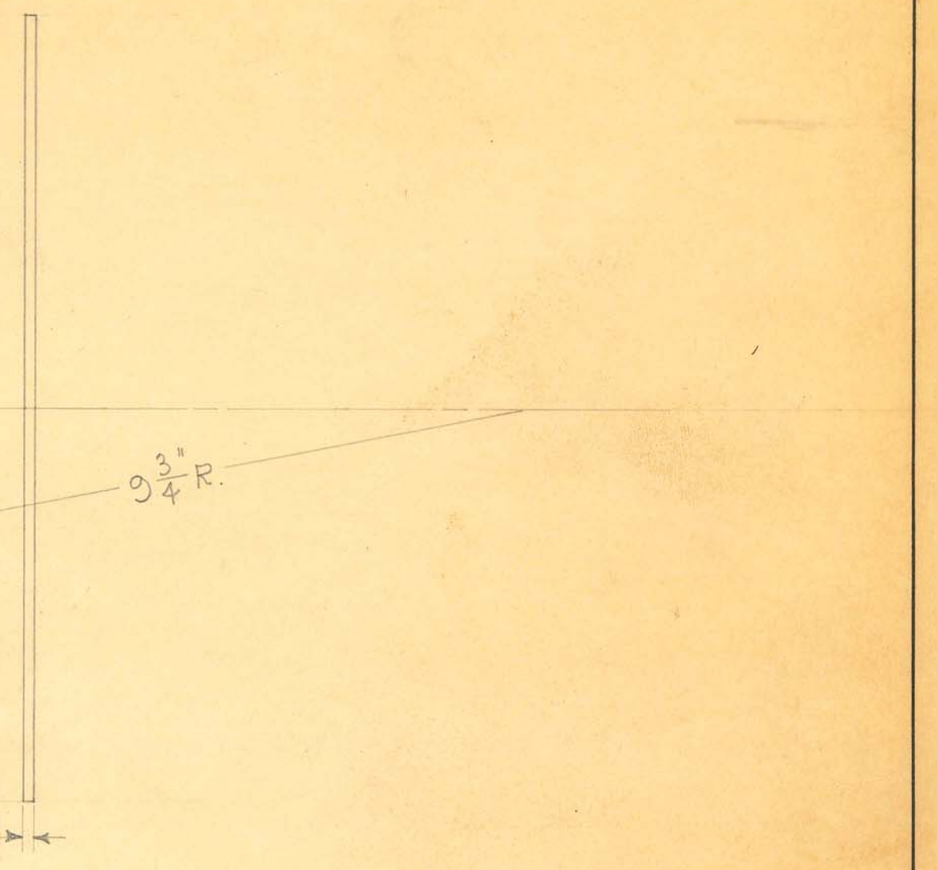

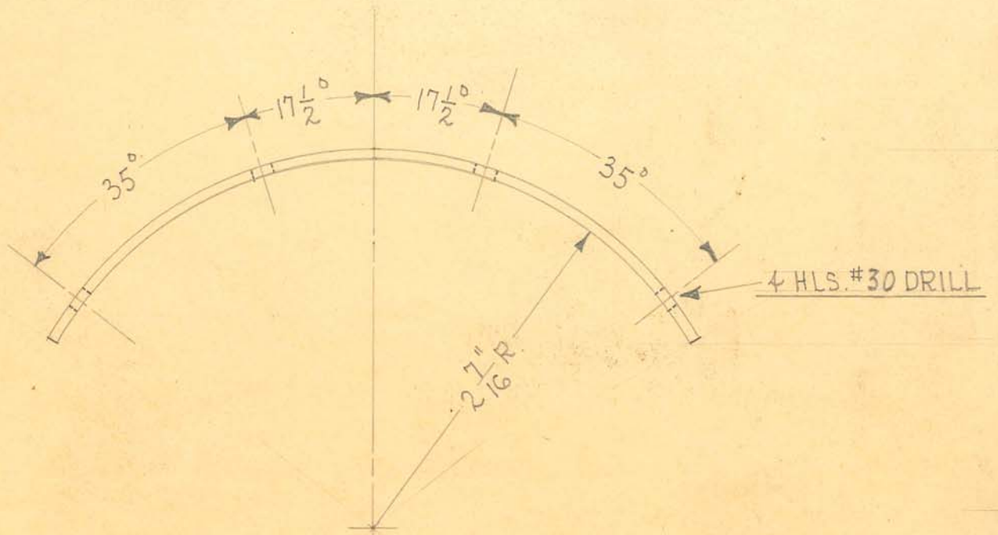

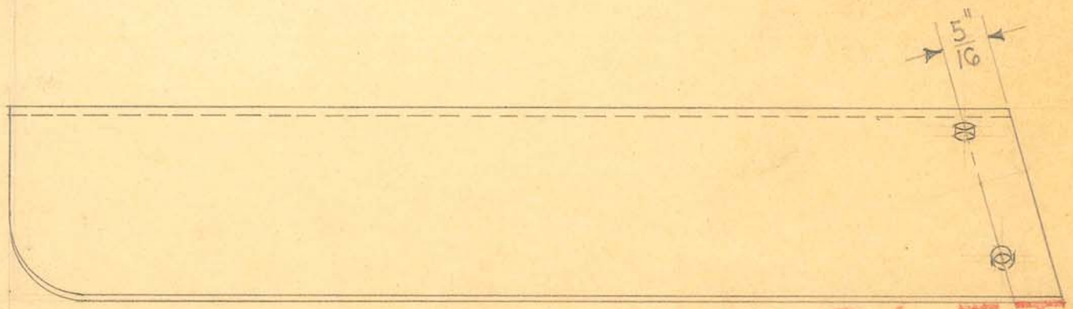

OBSOLETE

SIZE	1/16"	ISSUE 8-14-36	A.E.	TITLE: FLUOROSCOPE HANDLE LEAD PROTECTOR
KIND	SHEET LEAD	CHANGED		
SHAPE		"		
FINISH		"		
TEMP.		"		
PATT.		"		

H. G. FISCHER & CO.
2335 WABANSIA AVE.
CHICAGO, ILL.

CAT. NO.

PART NO. 7152

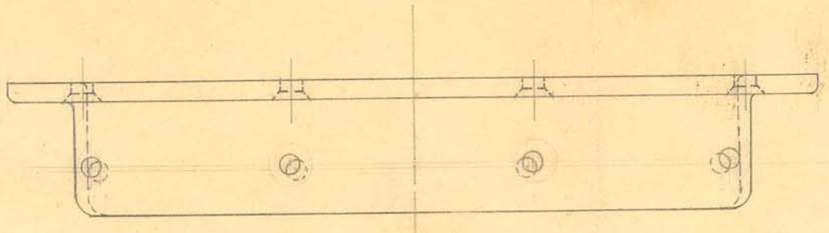

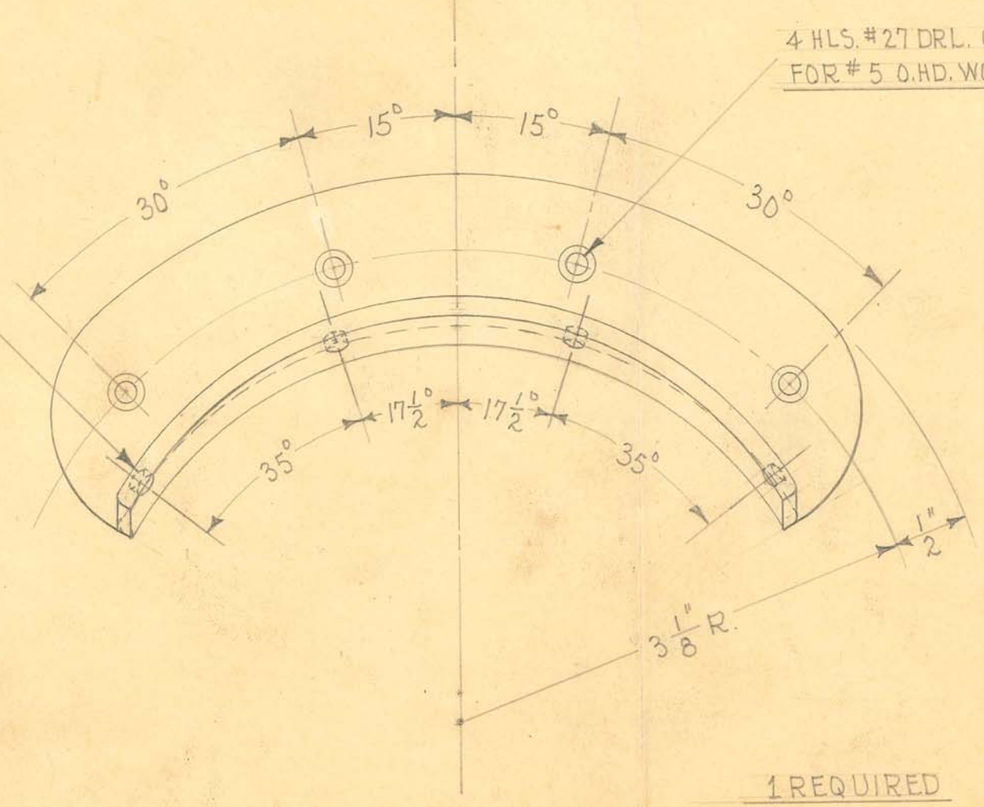

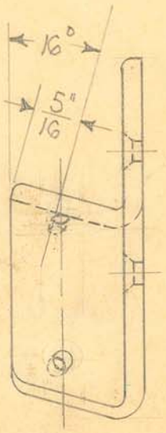

1 REQUIRED

OBSOLETE

SIZE		ISSUE 8-14-36	2478
KIND	ALUM. CASTING	CHANGED	
SHAPE		"	
FINISH		"	
TEMP.		"	
PATT.	2035-270	"	

TITLE: FLUOROSCOPE HANDLE HAND PROTECTOR SUPPORT

H. G. FISCHER & CO.
2335 WABANSIA AVE.
CHICAGO, ILL.

CAT. NO.

PART NO. 7153F

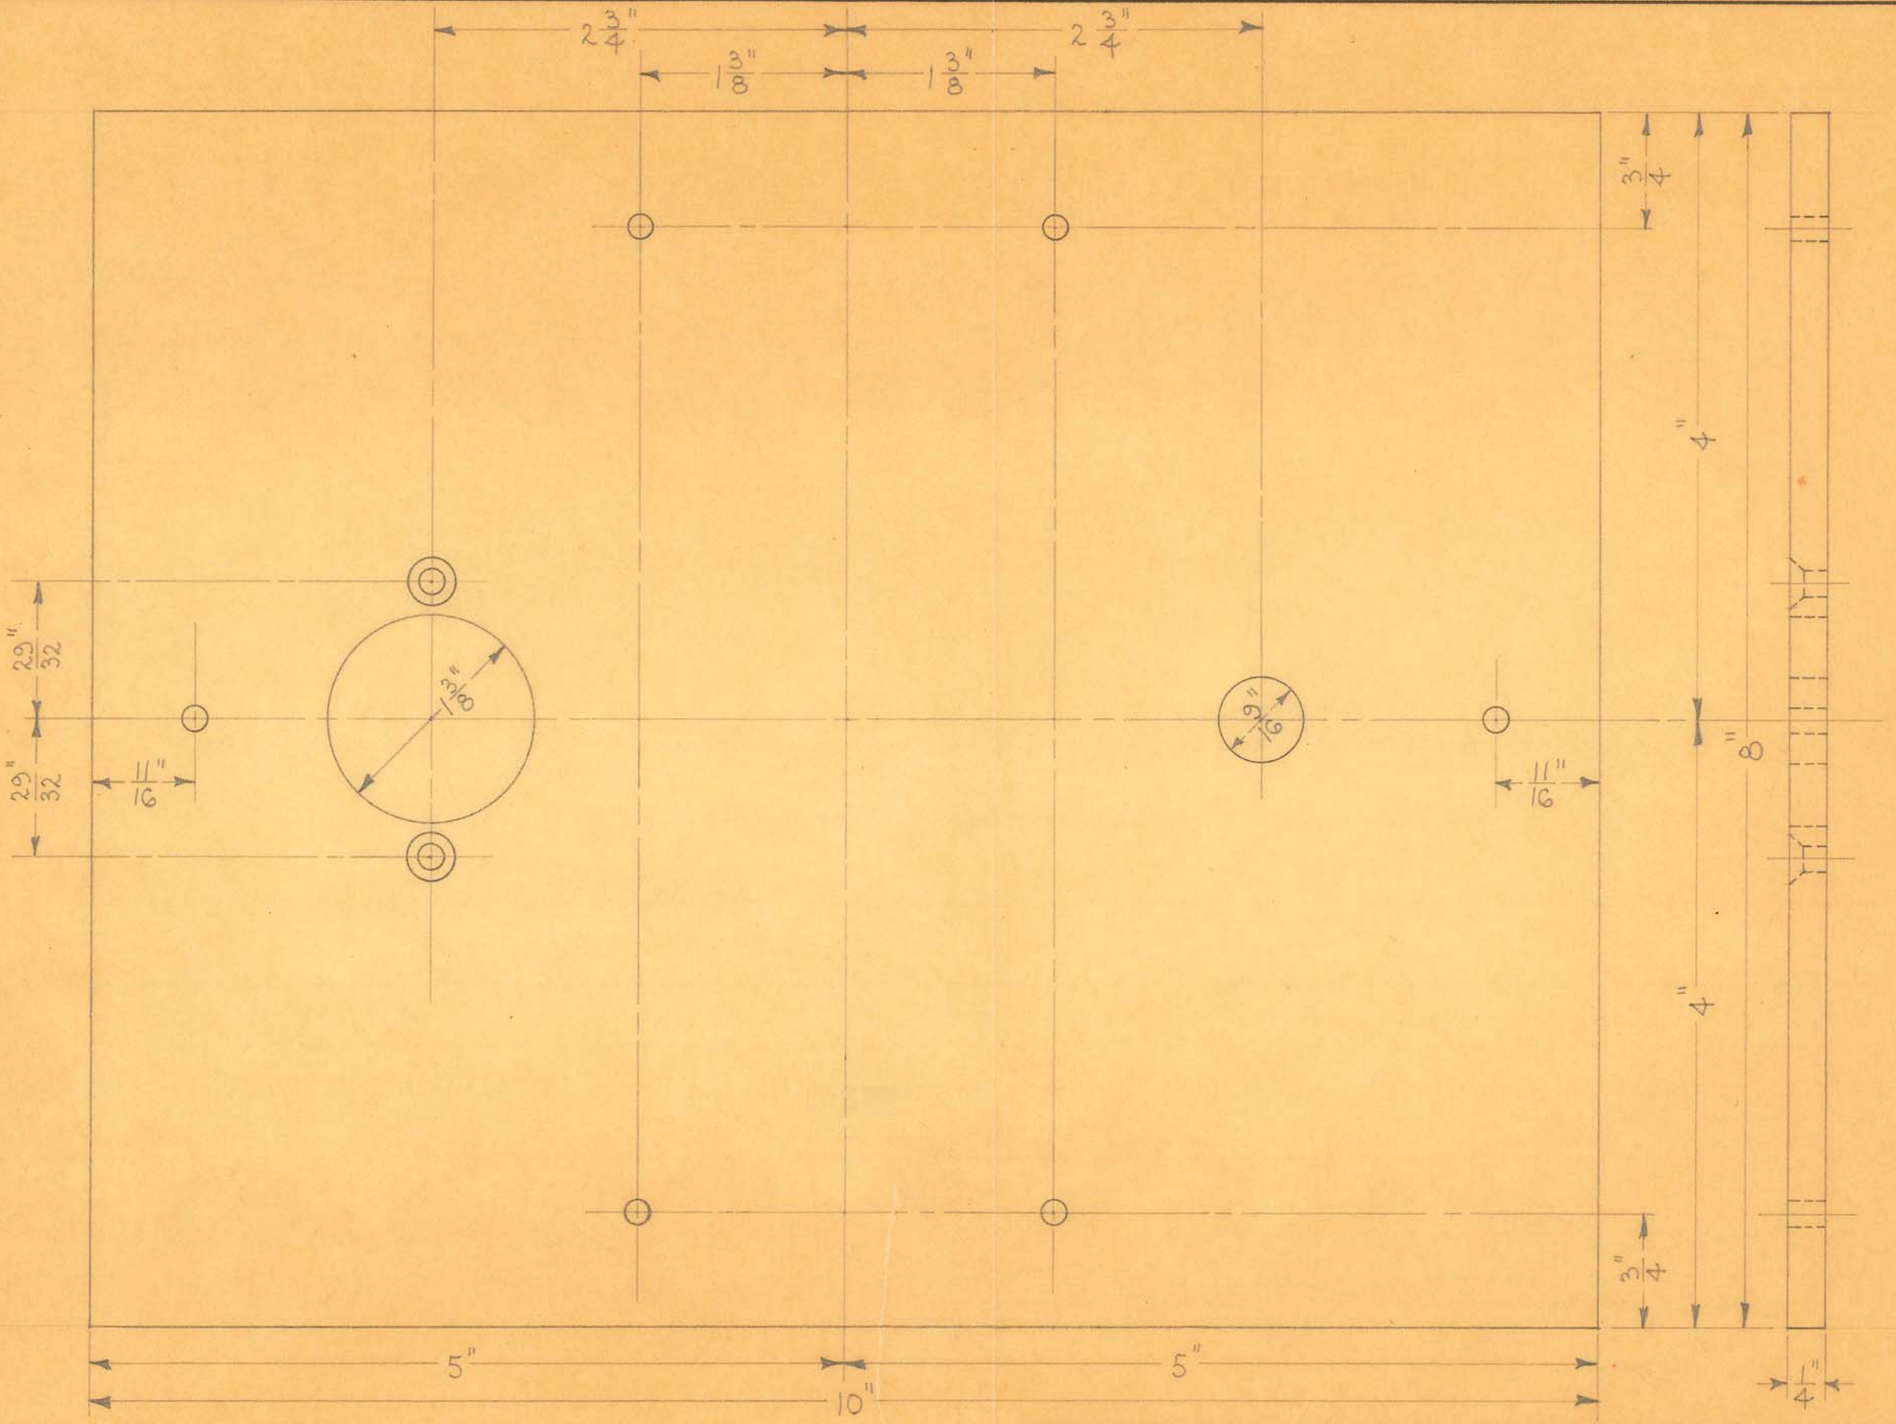

OBSOLETE

SIZE	8"X10"X 1/4"	ISSUE 2-14-36	A.E.	TITLE: STEP DOWN & STEP UP TRANSFORMER PANEL (DRILLED)
KIND	EBONY	CHANGED		
SHAPE		" "		
FINISH		" "		
TEMP.		" "		
PATT.		" "		

H. G. FISCHER & CO.
2335 WABANSIA AVE.
CHICAGO, ILL.

CAT. NO.

PART NO. 3952F

3952F

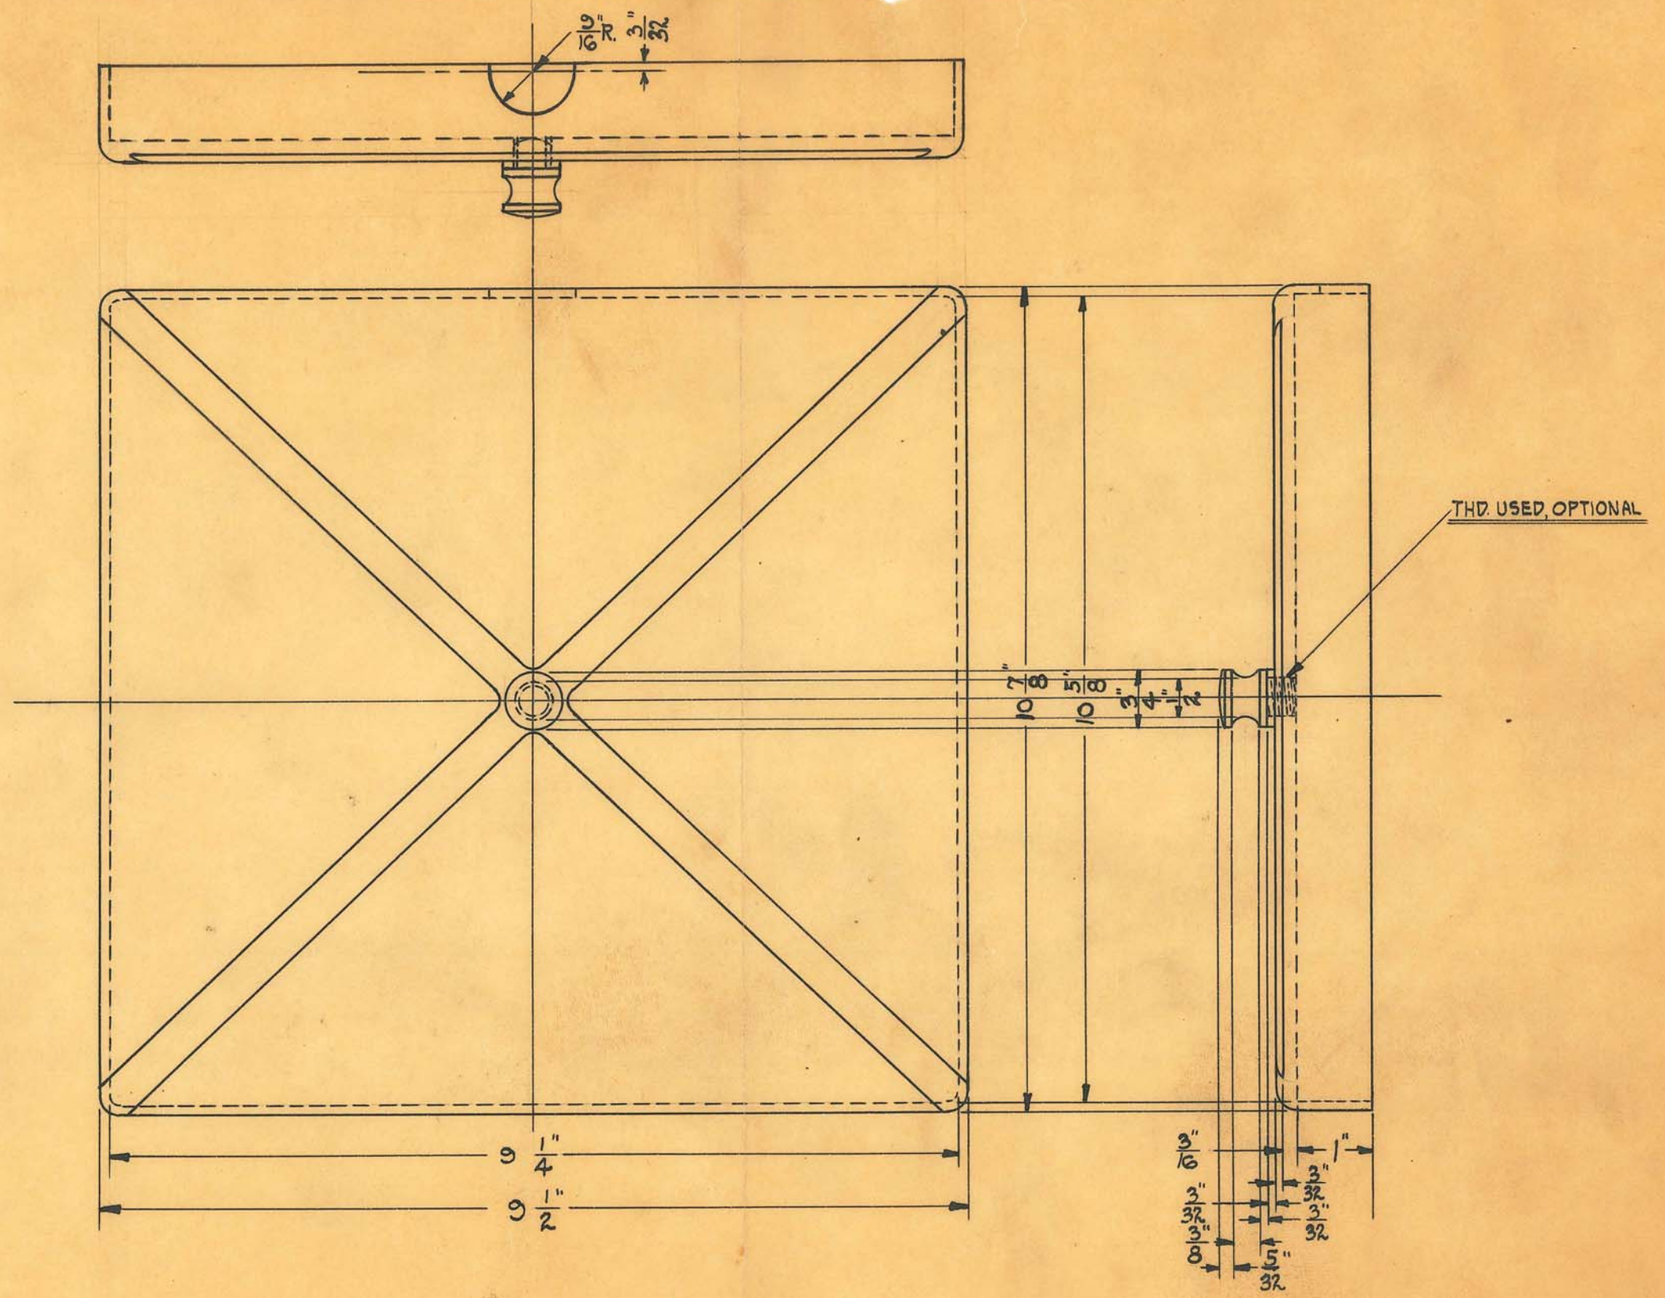

SIZE		ISSUE	H.E.	5-2-30
KIND		CHANGED		
SHAPE		"	"	
FINISH		"	"	
TEMP.		"	"	
PATT.		"	"	

TITLE: DENTAL FILM DEVELOPING TANK COVER

OBSOLETE

H. G. FISCHER & CO.
2335 WABANSIA AVE.
CHICAGO, ILL.

CAT. NO.

PART NO. 5577 1/2 GF

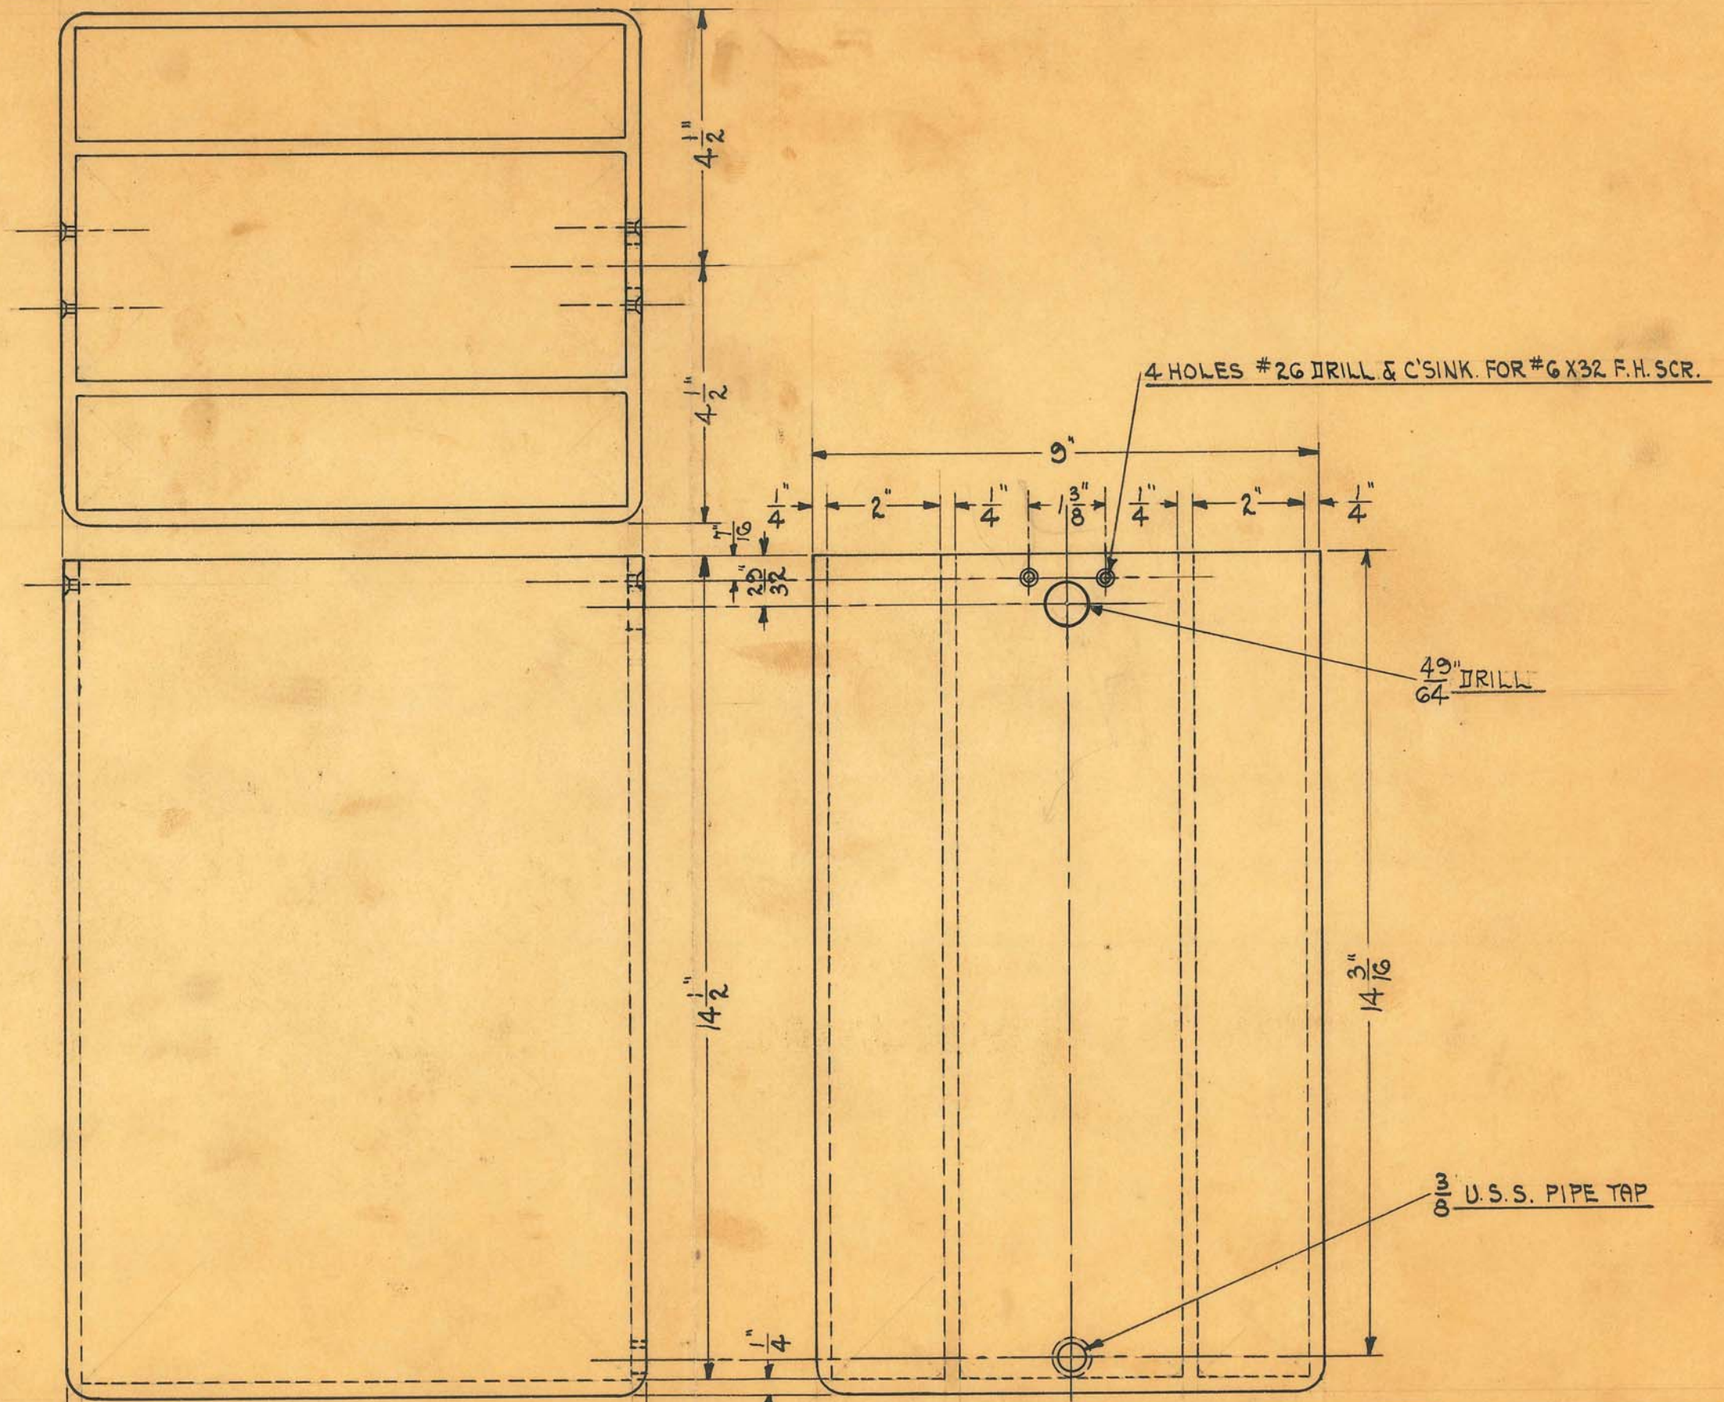

SIZE		ISSUE 9-30-30	A.E.
KIND	RUBBER	CHANGED	
SHAPE		" "	
FINISH		" "	
TEMP.		" "	

TITLE: DENTAL FILM DEVELOPING TANK

OBSOLETE

H. G. FISCHER & CO.
2335 WABANSIA AVE.

CAT. NO.

PART NO. 5575FA

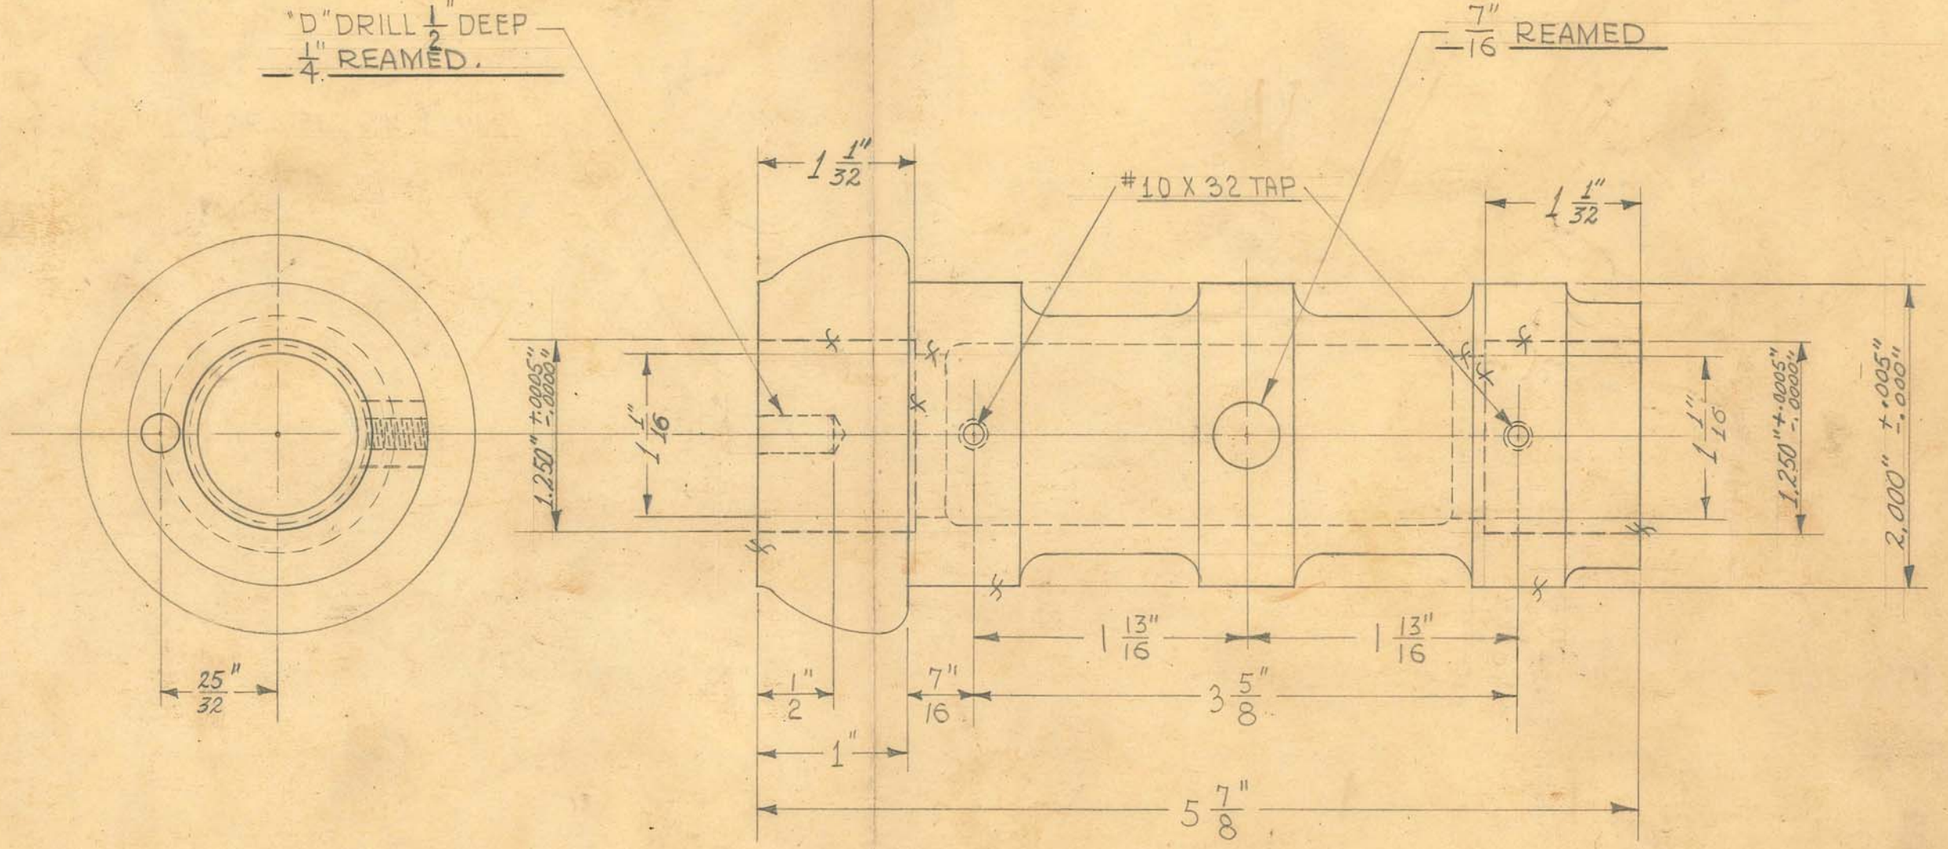

1 REQUIRED

OBSOLETE
Obsolete

SIZE		ISSUE 6-14-39	HE.
KIND	IRON CASTING	CHANGED 4-8-40	J.W.
SHAPE		" 4-18-41	J.V.W.
FINISH	PAINTED	" 5-28-41	J.V.W.
TEMP.		"	
PATT.	1370	"	

TITLE: FISCHER MOBILE MOD. DENTAL X-RAY UNIT-
SWIVEL ARM SUPPORT BEARING

H. G. FISCHER & CO.
2335 WABANSIA AVE.
CHICAGO, ILL.

CAT. NO.

PART NO. 12634BF

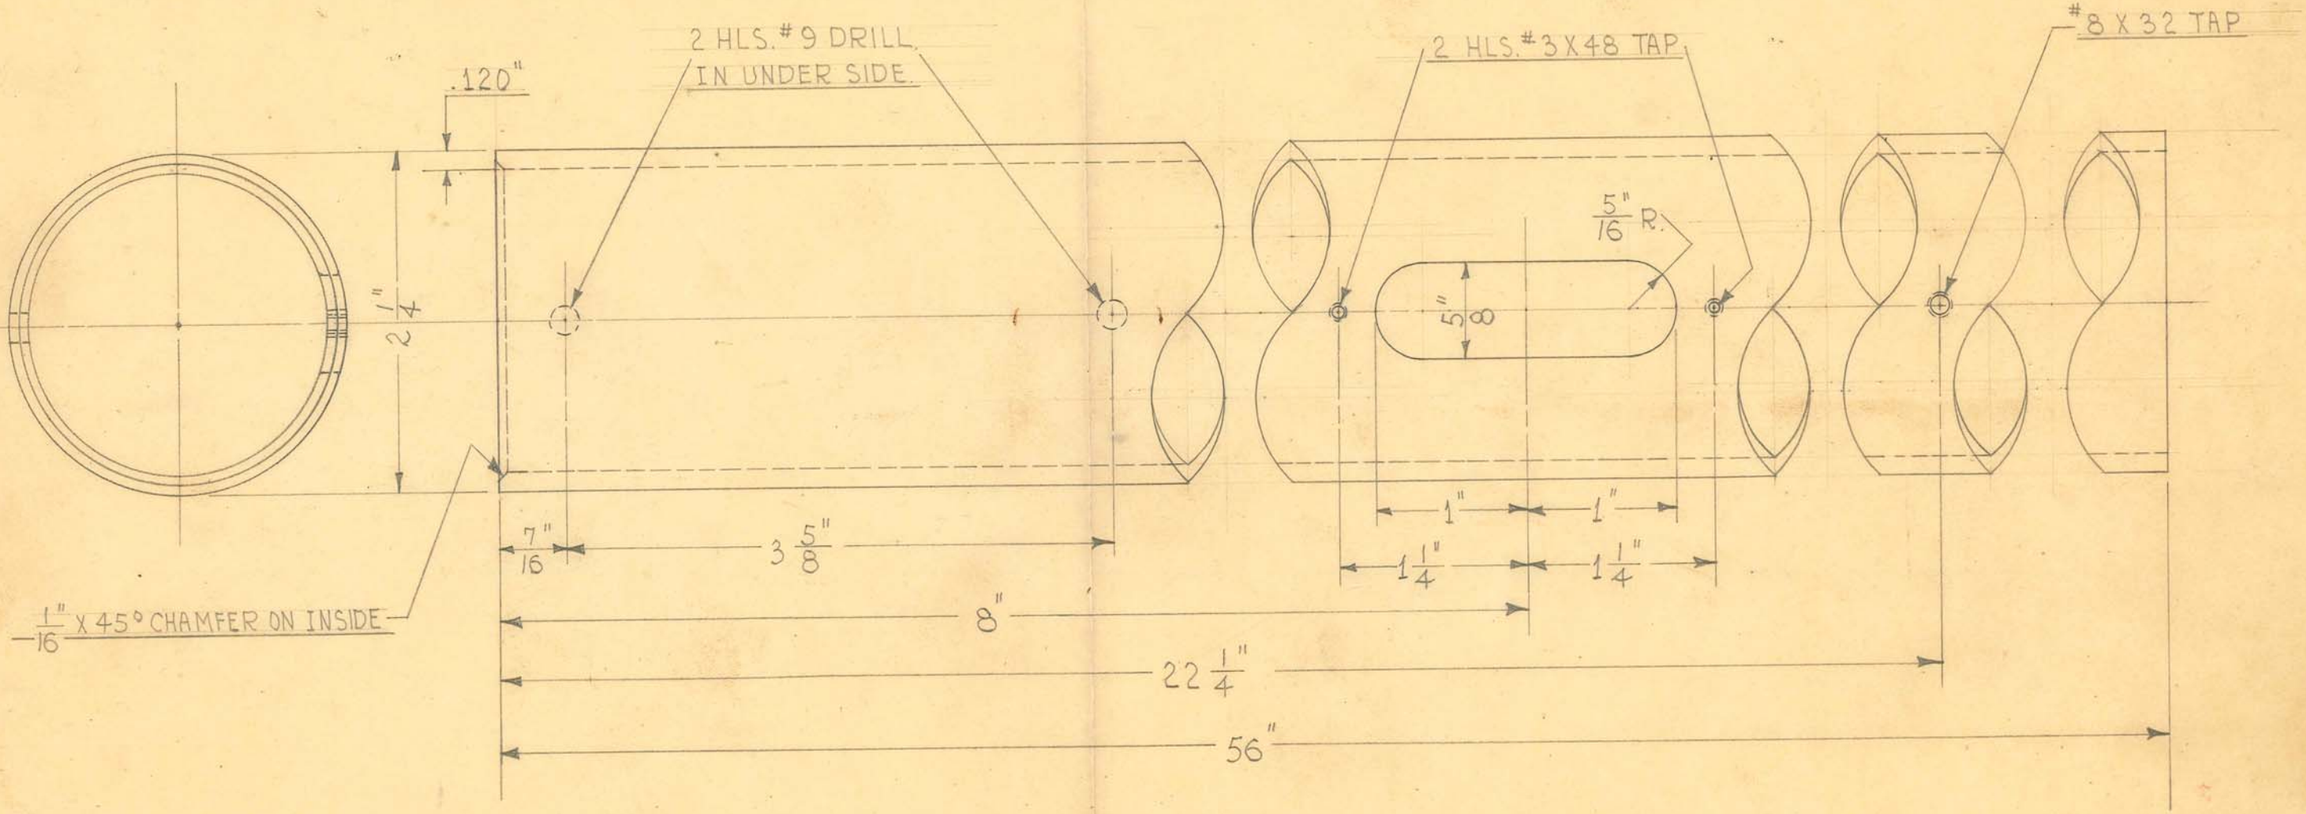

1 REQUIRED

OBSOLETE

SIZE	2¼" O.D. X .11 GA.	ISSUE 6-14-39	HE.	TITLE: FISCHER MOBILE MOD. DENTAL X-RAY UNIT- UPRIGHT TUBE
KIND	SHELBY SEAMLESS	CHANGED		
SHAPE	STEEL TUBING	"		
FINISH		"		
TEMP.		"		
PATT.		"		

H. G. FISCHER & CO.
2335 WABANSIA AVE.
CHICAGO, ILL.

CAT. NO.

PART NO. 12641F

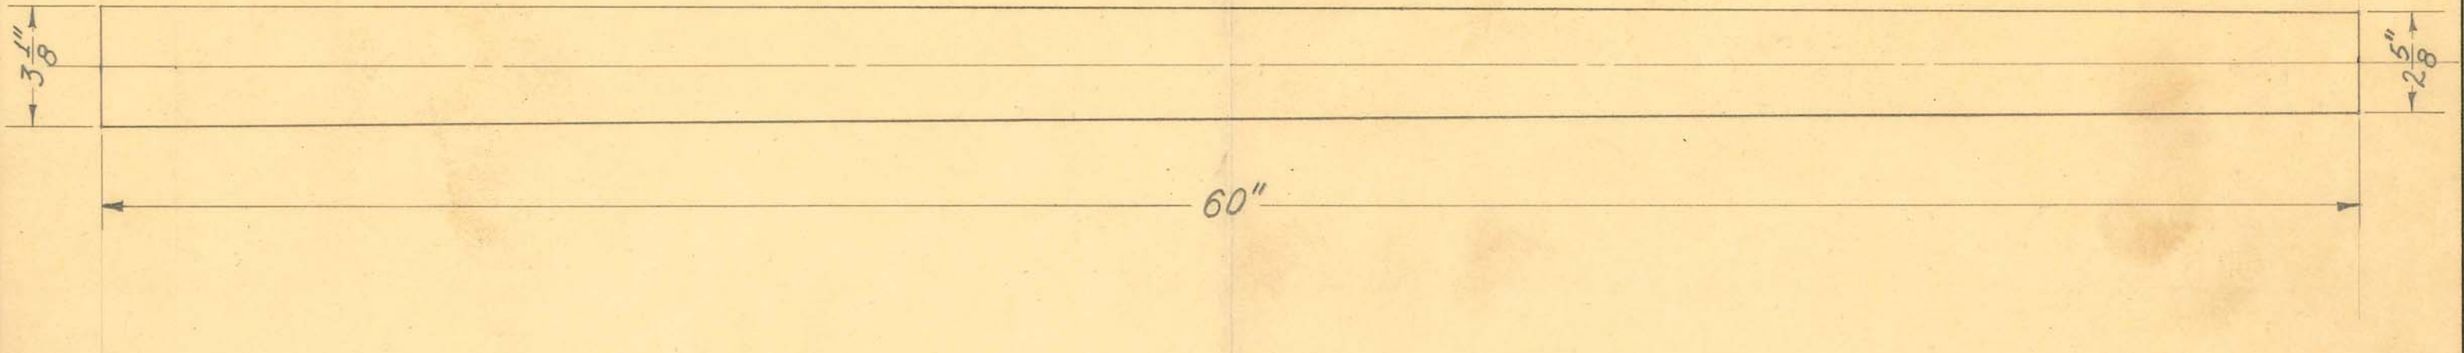

SCALE ÷ 1/4" = 1"

1 REQUIRED

OBSOLETE
obsolete

SIZE		ISSUE 6-16-39	J.W.
KIND	from 3286	CHANGED	
SHAPE		"	
FINISH		"	
TEMP.		"	
PATT.		"	

TITLE:
FISCHER MOD. "TM-30-96" MOBILE SHOCKPROOF
X-RAY—FILAMENT TRANSF. SECONDARY
INSULATING STRIP

H. G. FISCHER & CO.
2338 WABANSIA AVE.
CHICAGO, ILL.

CAT. NO.

PART NO. 12656

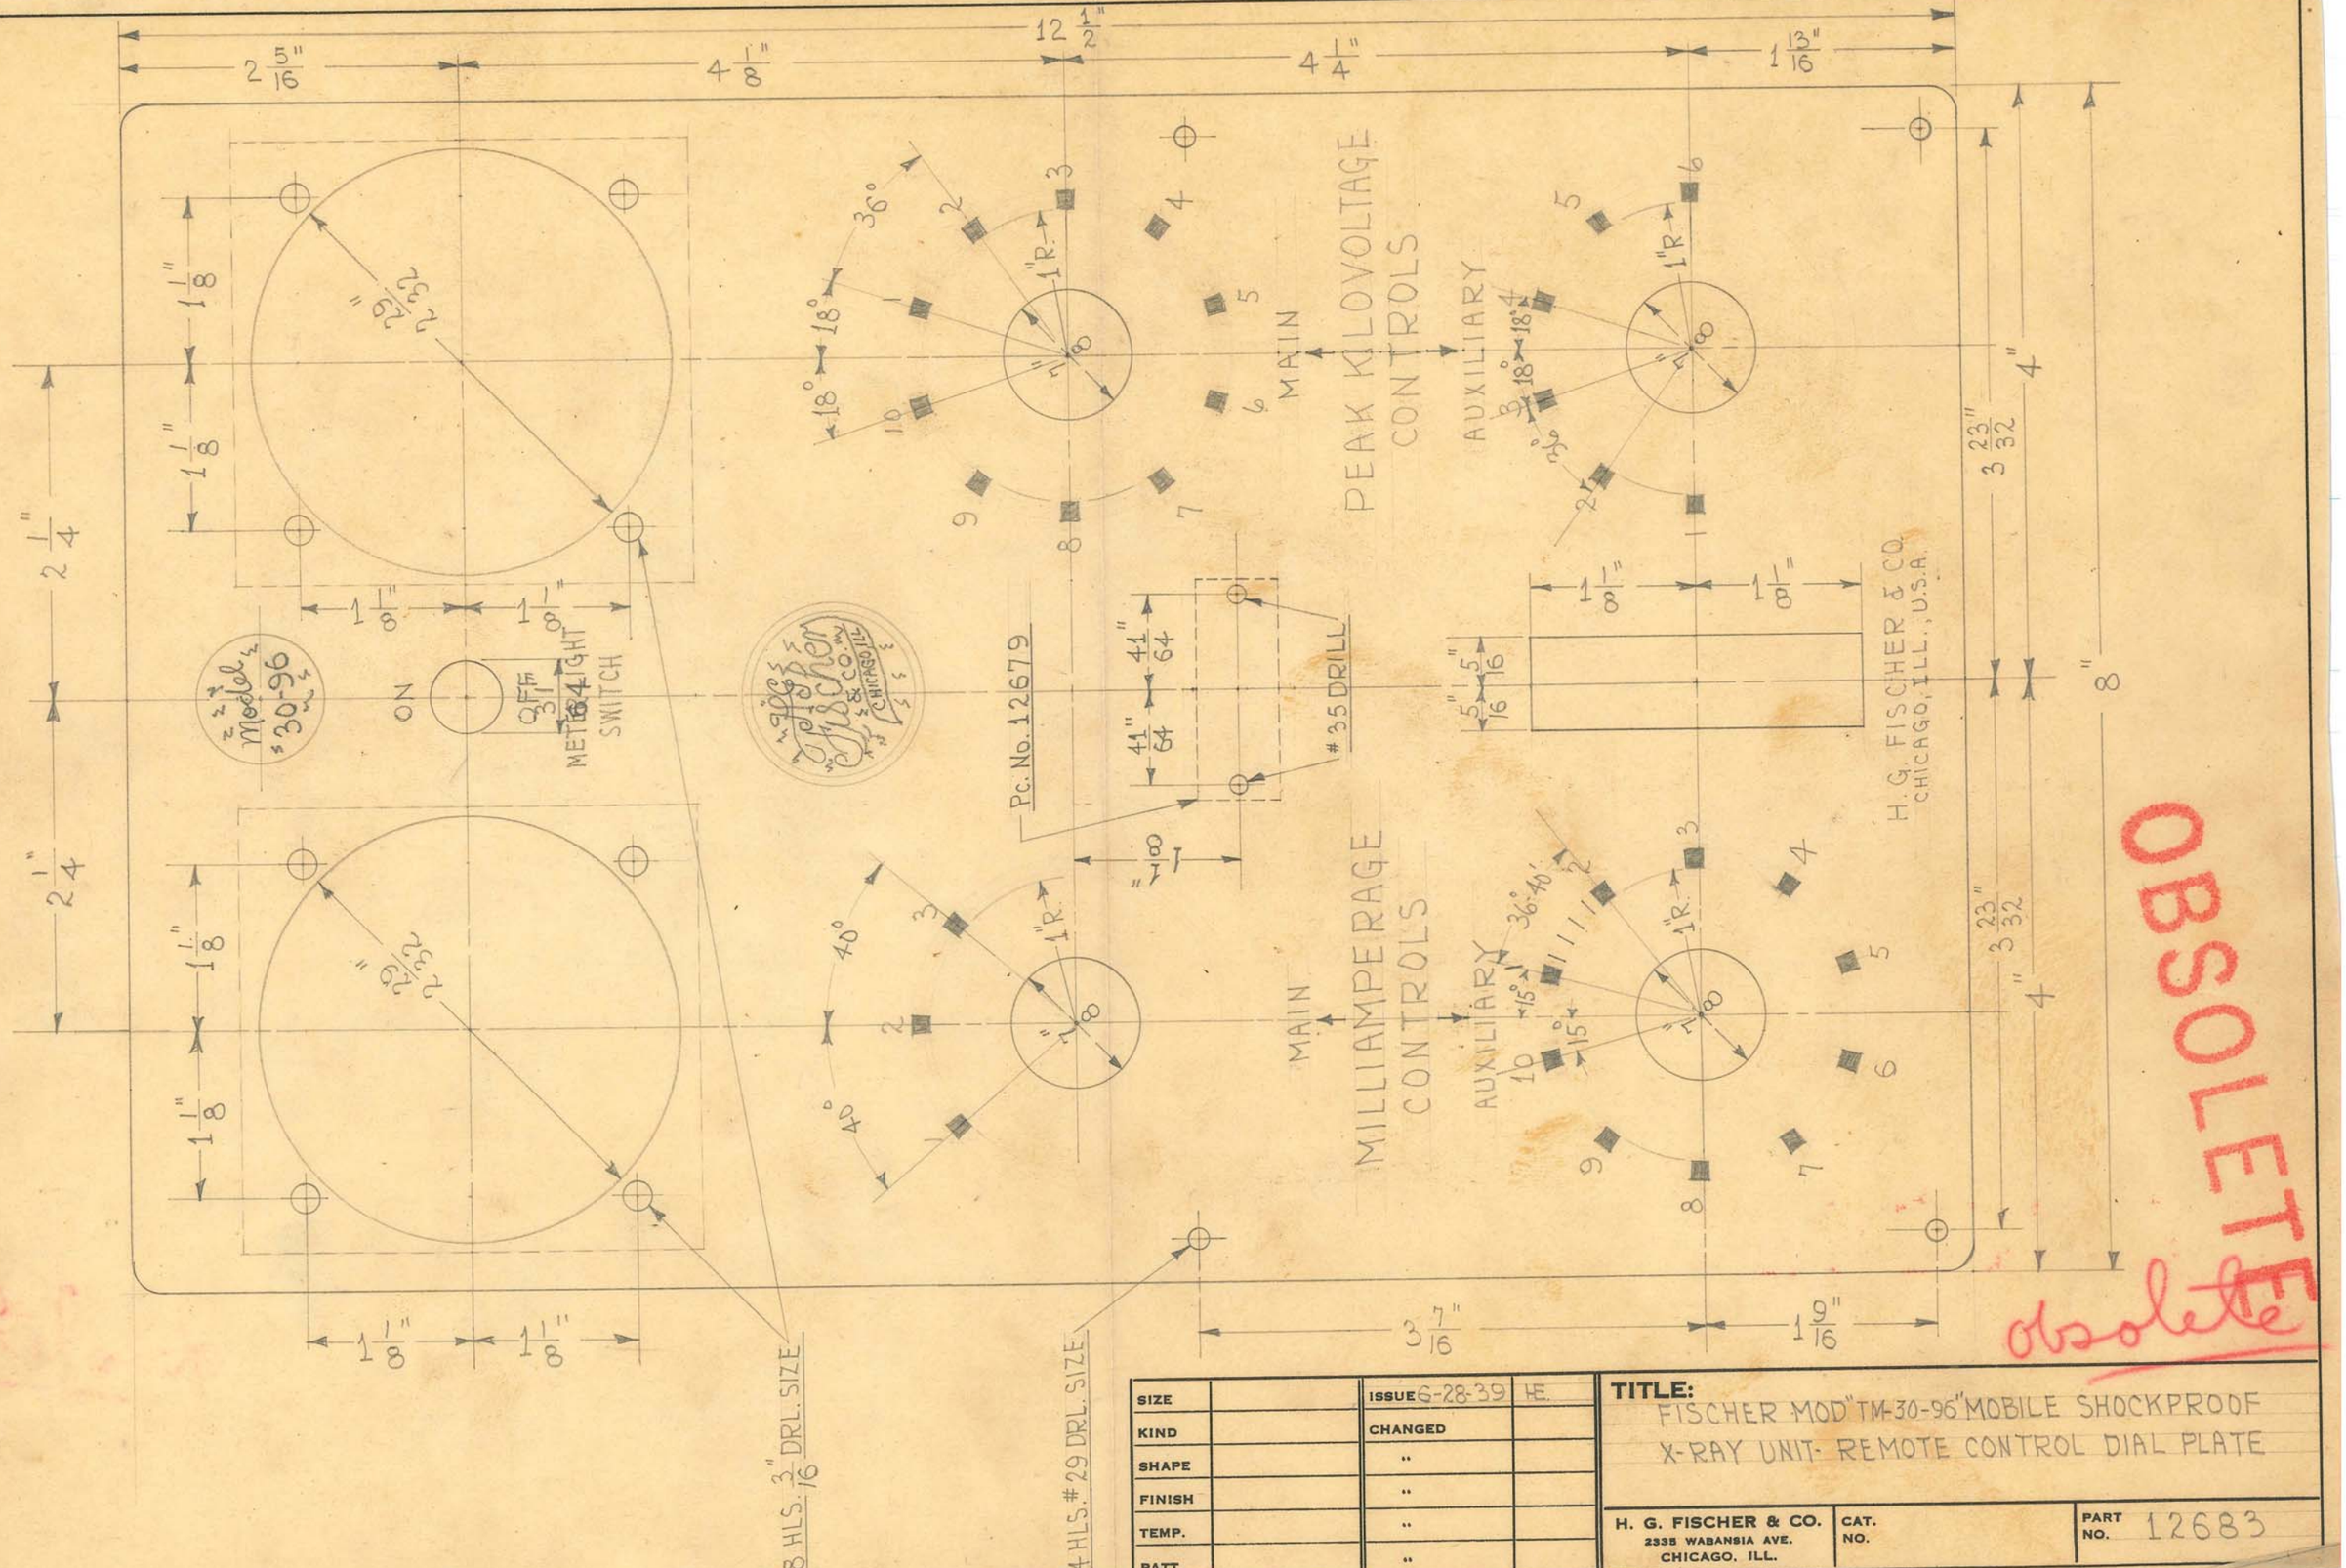

OBSOLETE

obsolete

SIZE		ISSUE 6-28-39	HE.
KIND		CHANGED	
SHAPE		"	
FINISH		"	
TEMP.		"	
PATT.		"	

TITLE: FISCHER MOD "TM-30-96" MOBILE SHOCKPROOF X-RAY UNIT- REMOTE CONTROL DIAL PLATE

H. G. FISCHER & CO.
2335 WABANSIA AVE.
CHICAGO, ILL.

CAT. NO.

PART NO. 12683

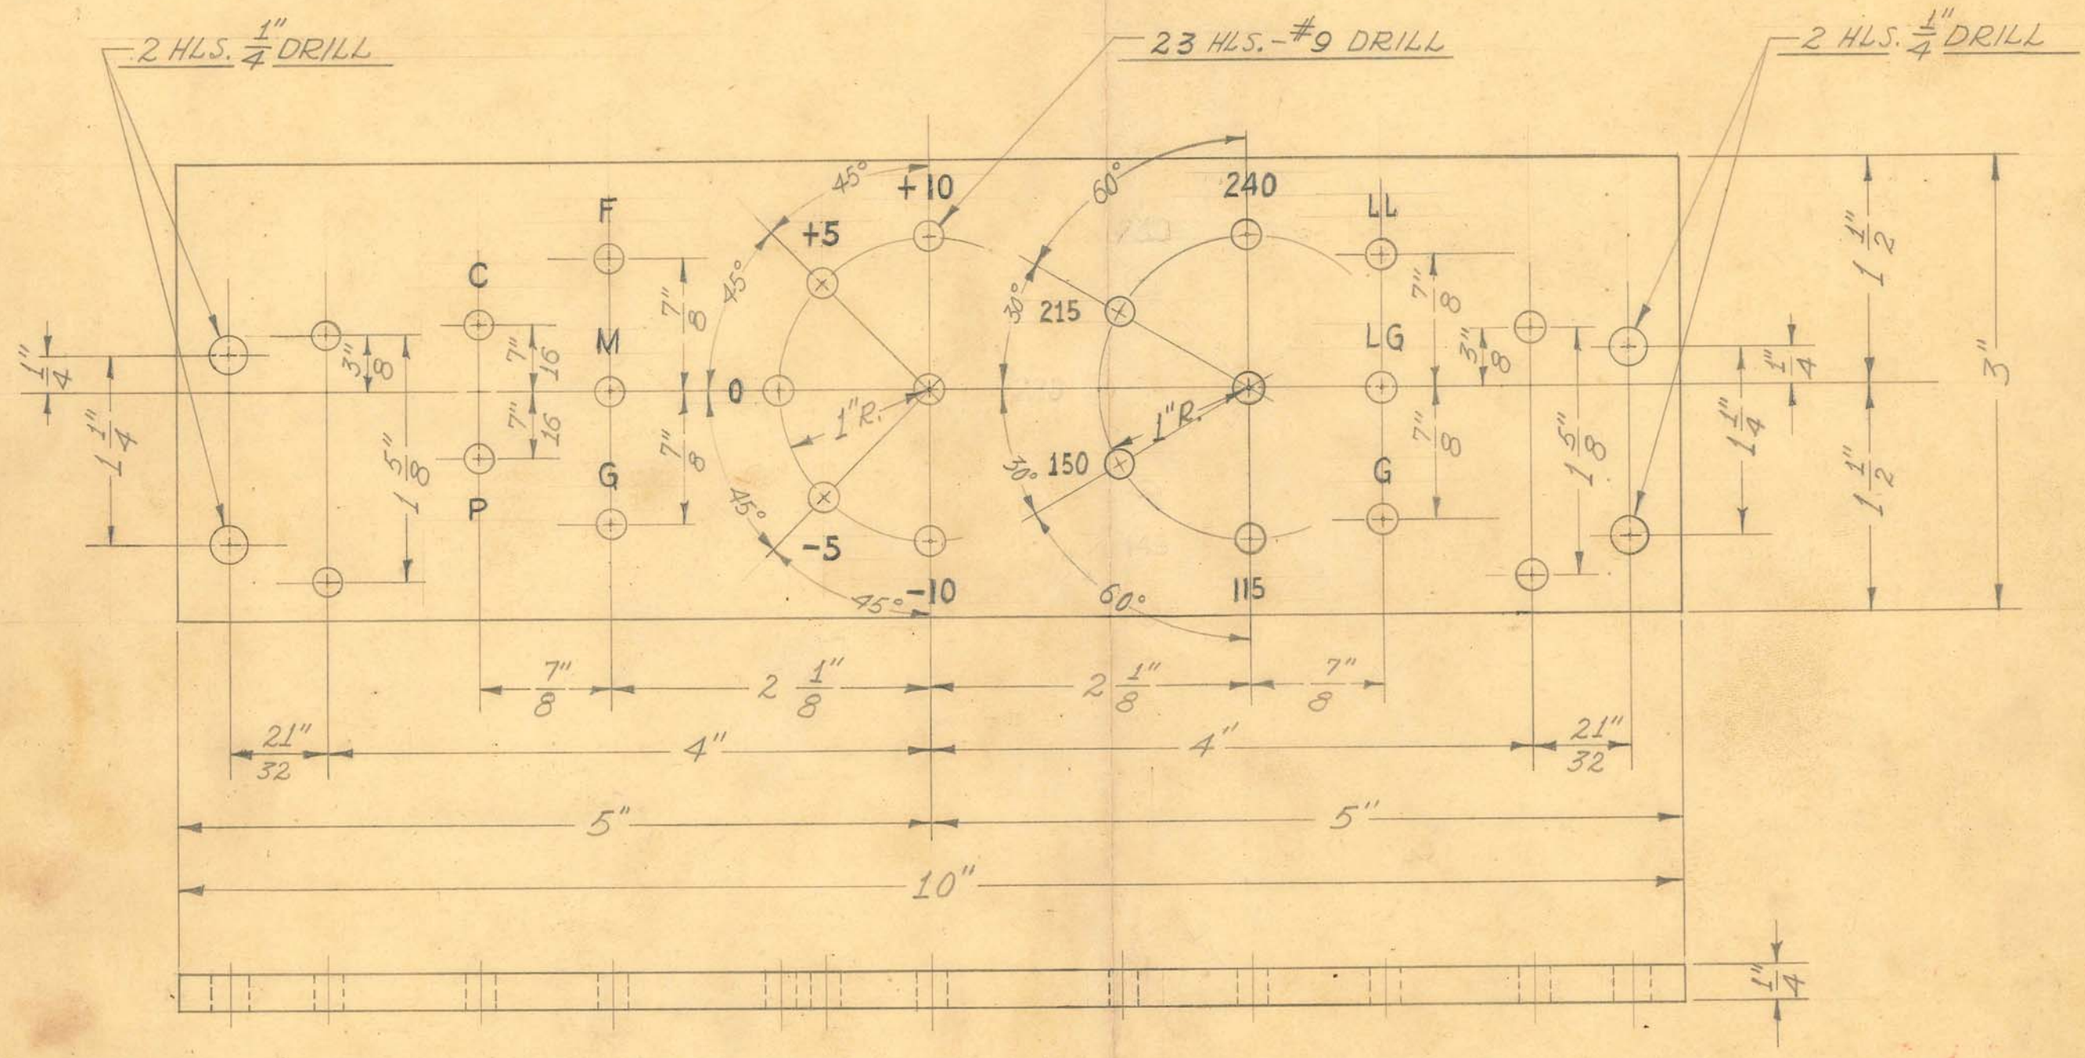

1 REQUIRED

OBSOLETE

SIZE	1/4" SHEET	ISSUE 7-18-39	J.W.	TITLE: FISCHER SHOCKPROOF MOD. "TM-30-95" MOBILE X-RAY UNIT - REMOTE CONTROL - TERMINAL BOARD (ENGRAVED)
KIND	BAKELITE	CHANGED		
SHAPE		"		
FINISH		"		
TEMP.		"		
PATT.		"		

H. G. FISCHER & CO.
2335 WABANSIA AVE.
CHICAGO, ILL.

CAT. NO.

PART NO. 12688AF

2 HLS. – #8X32 TAP – IN ACCORDANCE TO POSITION OF #8X32 TAPPED HOLES IN OTHER END – AS SHOWN

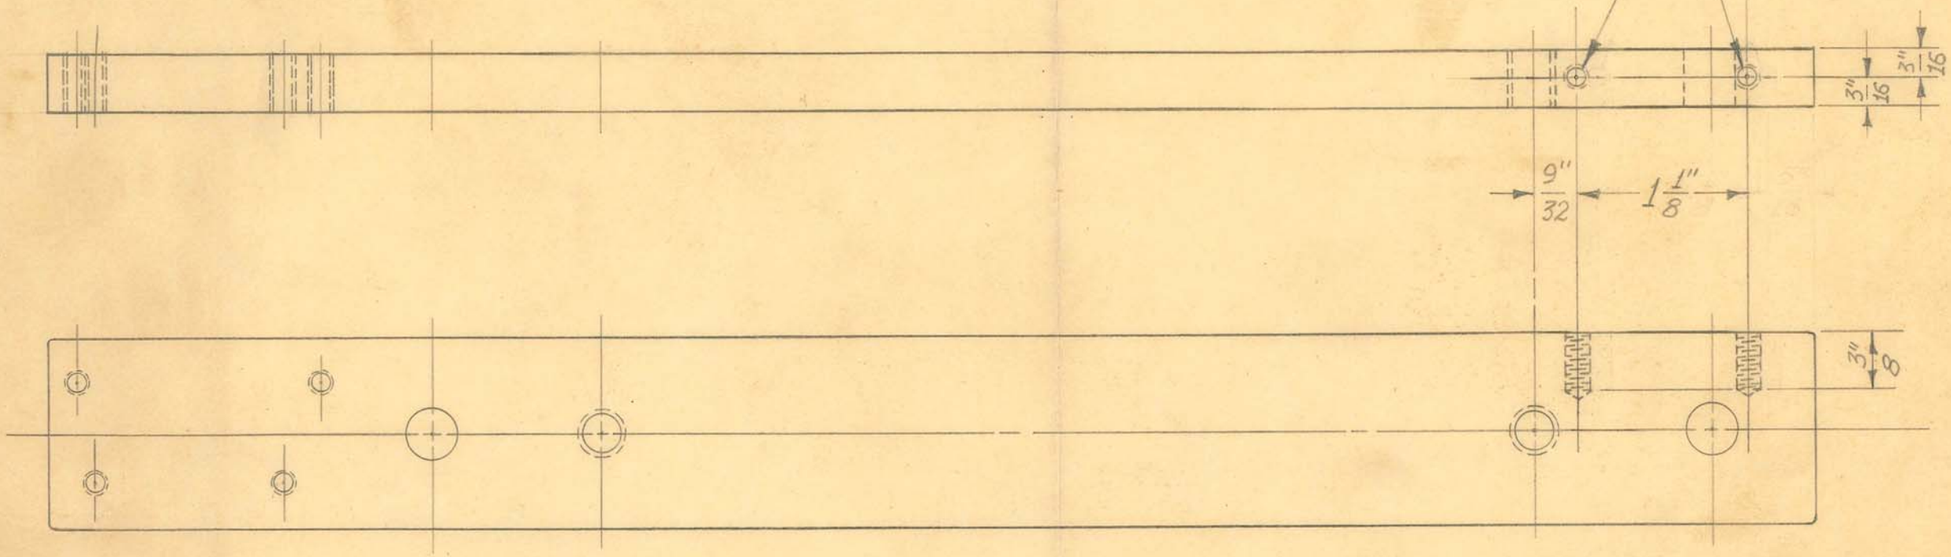

FROM PCE. # 12695

1 REQUIRED

OBSOLETE

Obsolete

SIZE		ISSUE 7-18-39	J.W.
KIND		CHANGED	
SHAPE		"	
FINISH		"	
TEMP.		"	
PATT.		"	

TITLE: FISCHER SHOCKPROOF MOD. "TM-30-96" MOBILE X-RAY UNIT – REMOTE CONTROL – TRANSF. SUPPORT UPPER – LEFT

H. G. FISCHER & CO.
2335 WABANSIA AVE.
CHICAGO, ILL.

CAT. NO.

PART NO. 12694

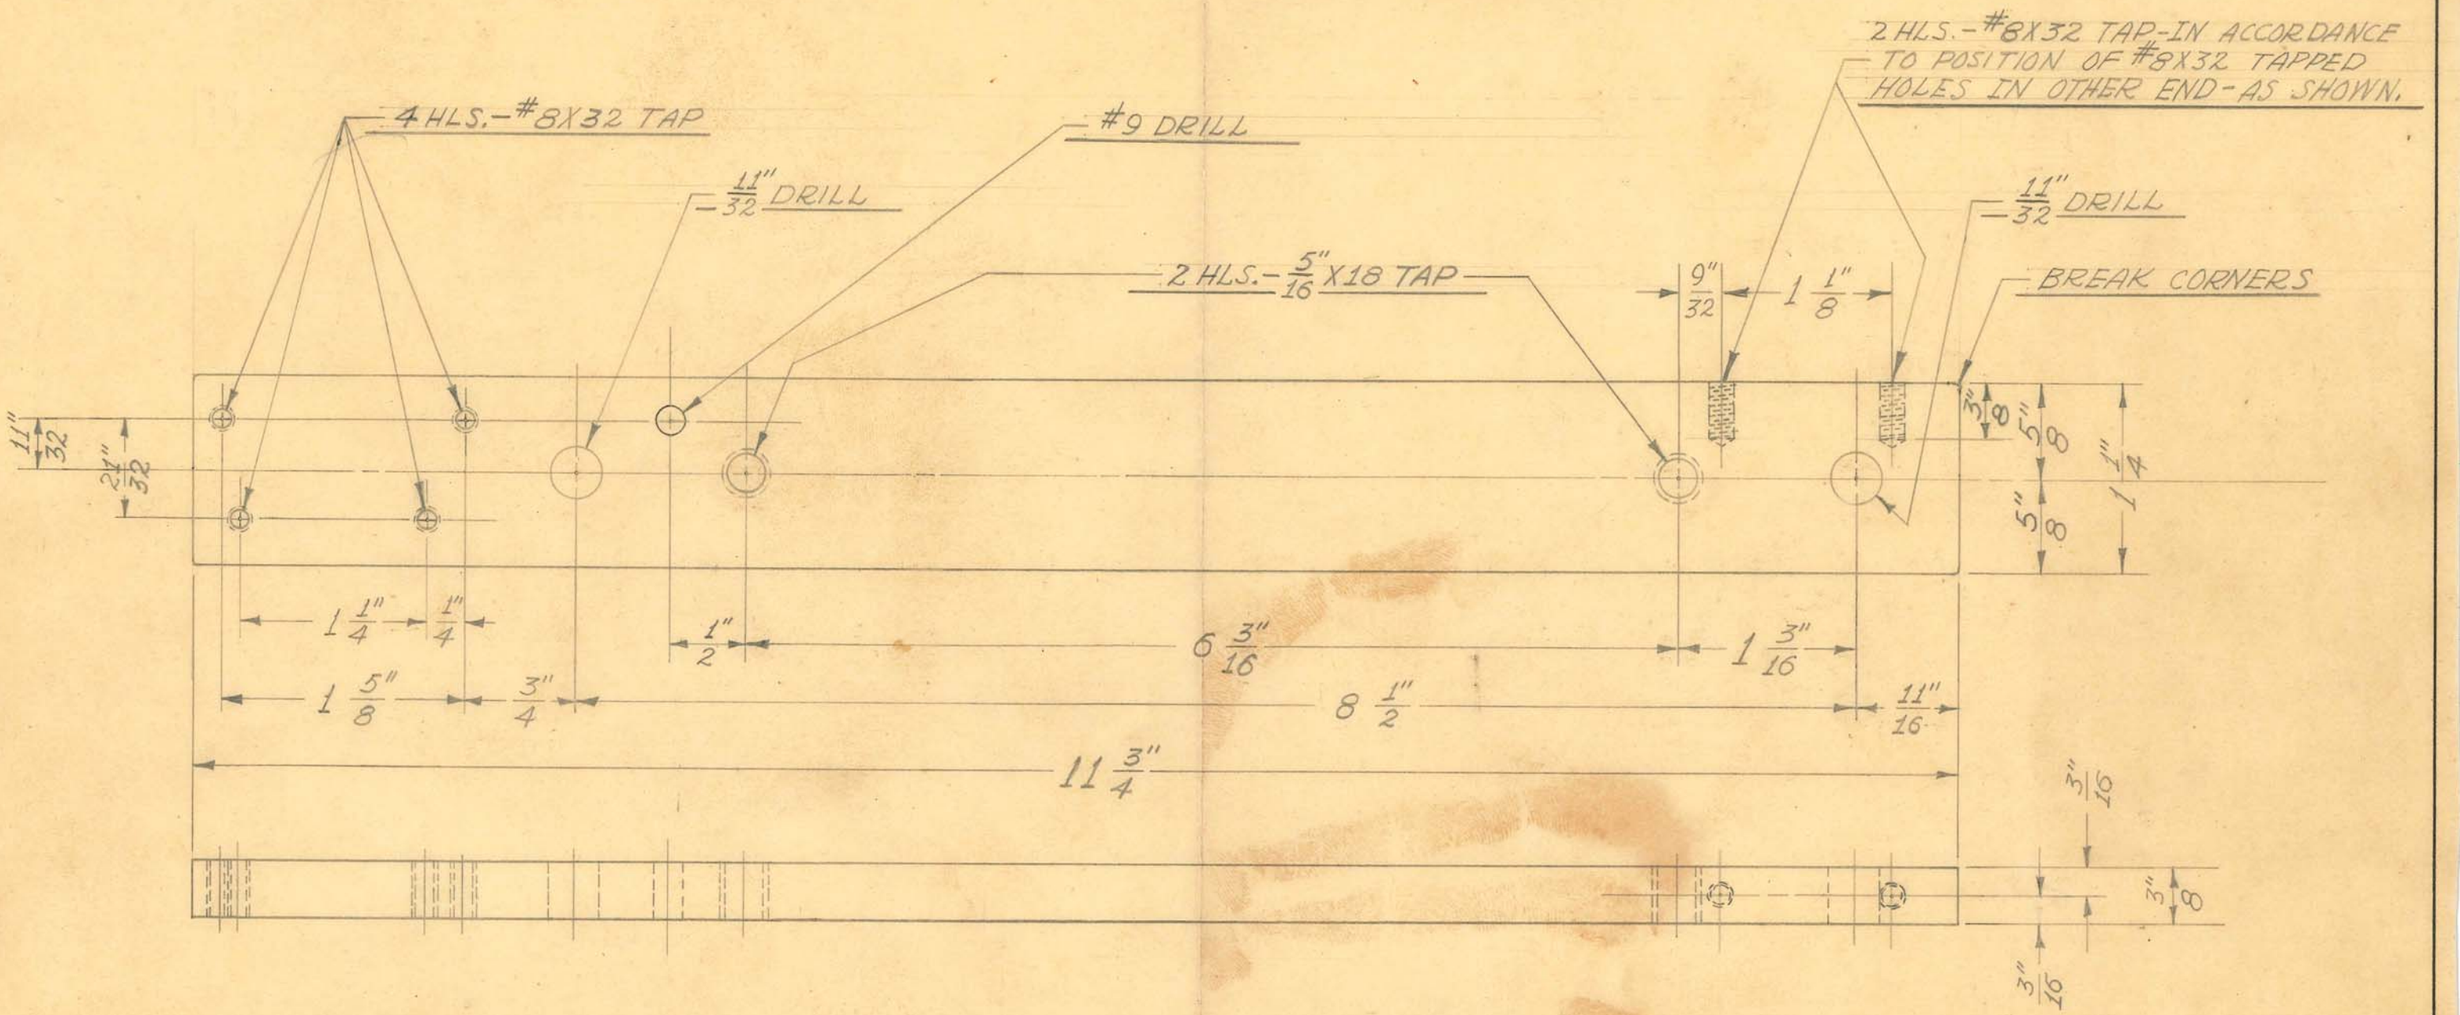

2 REQUIRED

OBSOLETE

SIZE	1¼" X 3/8"	ISSUE 7-18-39	J.W.	TITLE: FISCHER SHOCKPROOF MOD. "TM-30-96" MOBILE X-RAY UNIT-REMOTE CONTROL-TRANSF. SUPPORT UPPER
KIND	C.R. STEEL	CHANGED 8-14-39	J.W.	
SHAPE		"		
FINISH		"		
TEMP.		"		
PATT.		"		

H. G. FISCHER & CO.
2335 WABANSIA AVE.
CHICAGO, ILL.

CAT. NO.

PART NO. 12695A

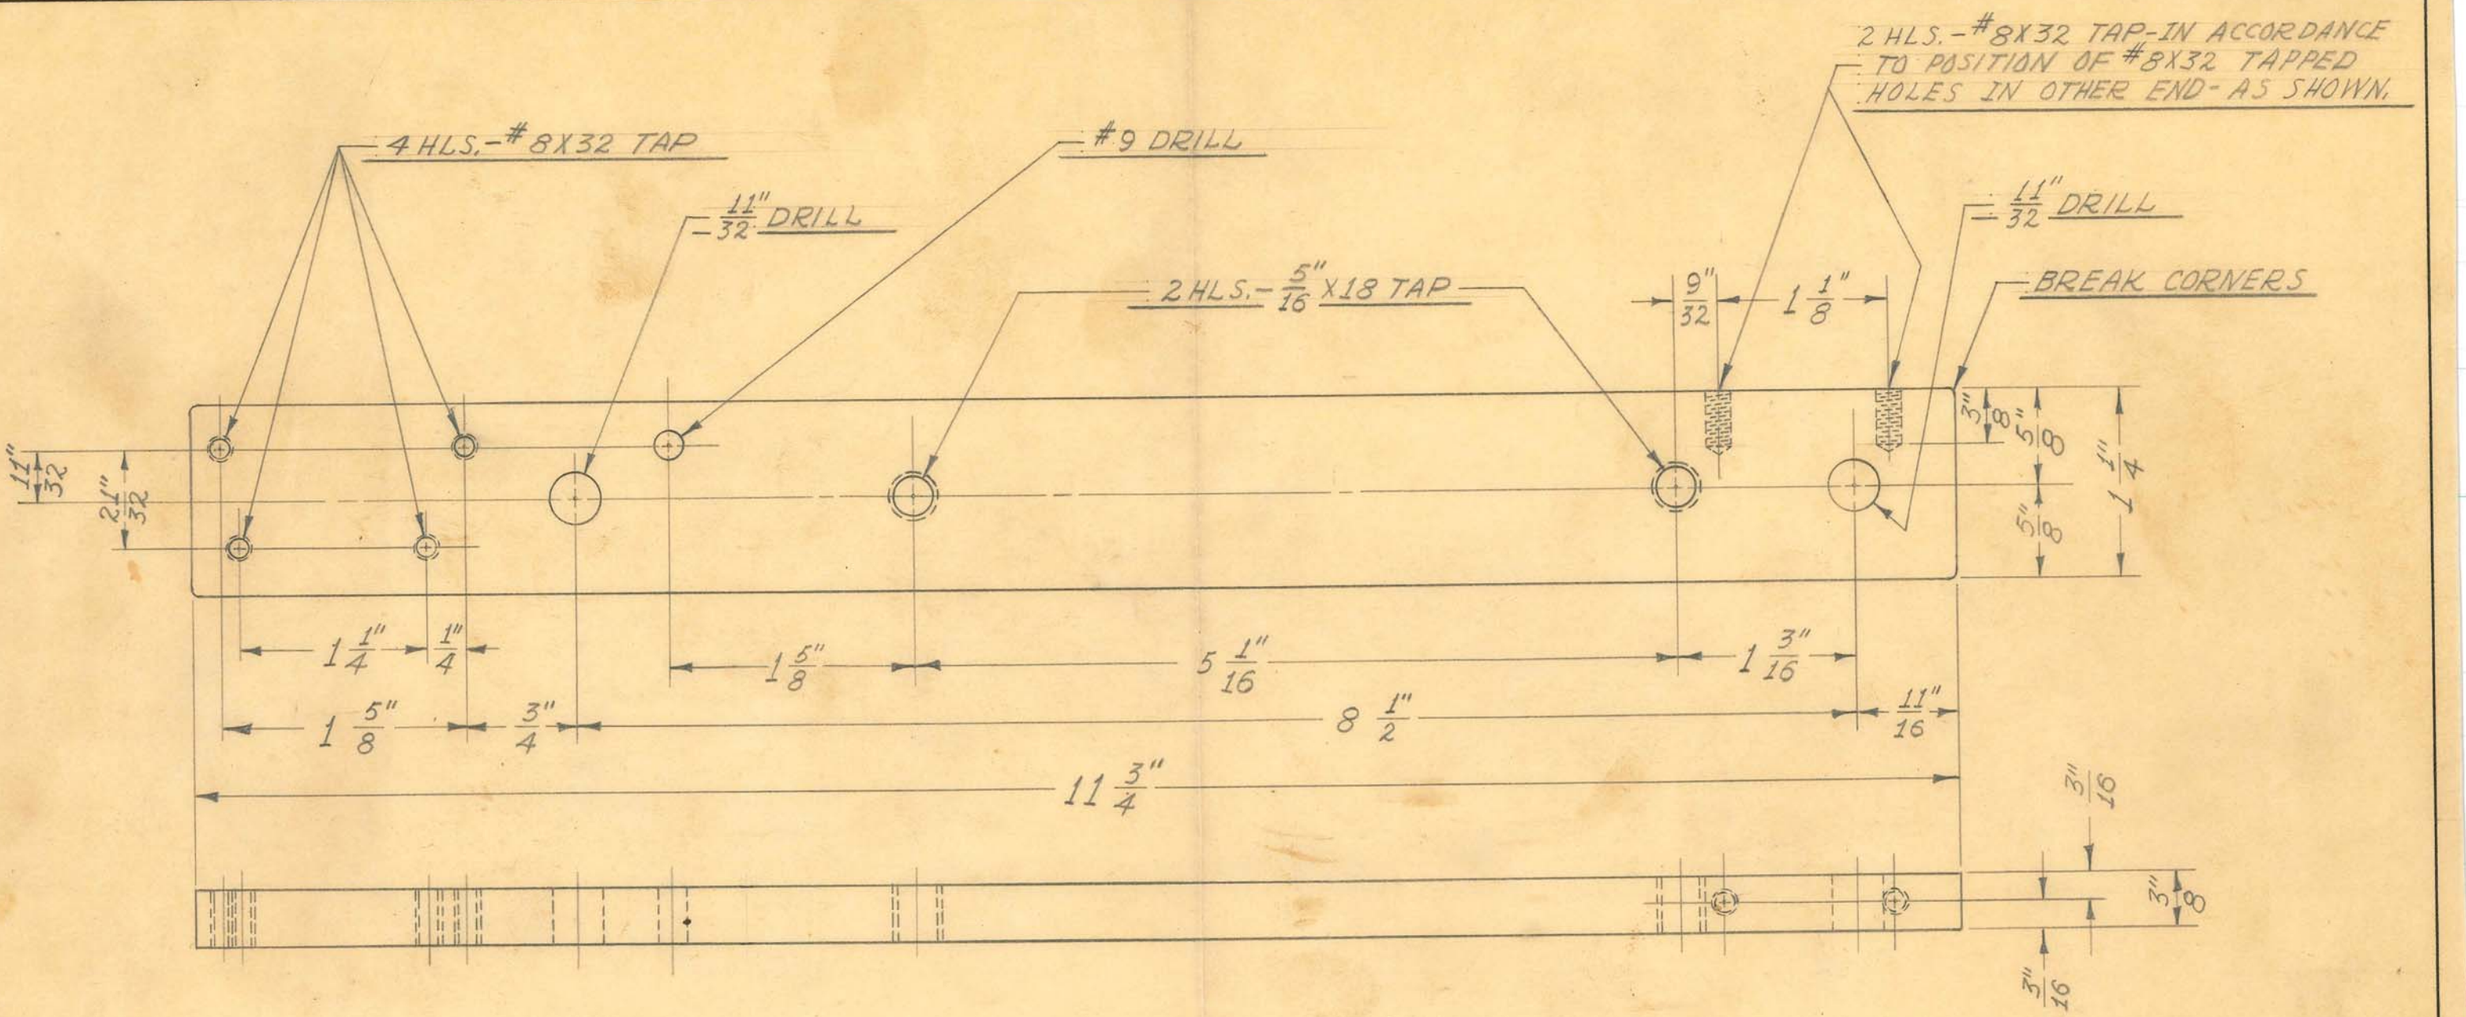

2 REQUIRED

OBSOLETE

SIZE	1¼" X 3/8"	ISSUE 10-6-39	J.W.	TITLE: FISCHER SHOCKPROOF MOD. "TM-30-96" MOBILE X-RAY UNIT-REMOTE CONTROL-TRANSF. SUPPORT -UPPER-
KIND	C.R. STEEL	CHANGED		
SHAPE		"		
FINISH		"		
TEMP.		"		
PATT.		"		

H. G. FISCHER & CO.
2335 WABANSIA AVE.
CHICAGO, ILL.

CAT. NO.

PART NO. 12695B

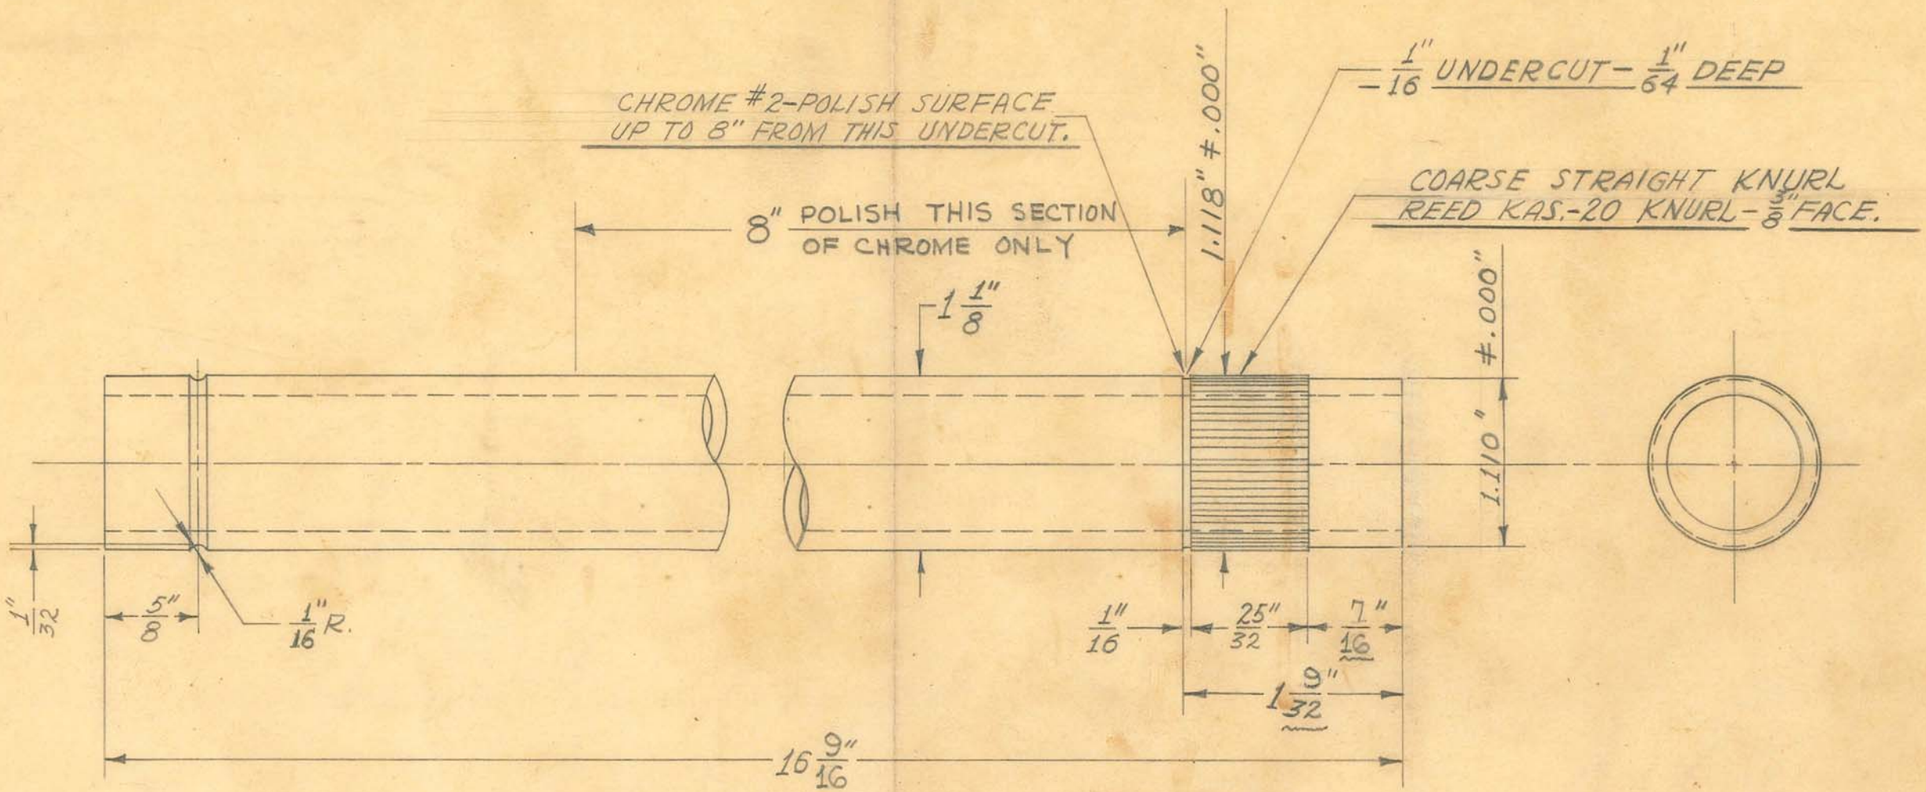

1 1/8" O.D. X #11GA.(.120") WALL – SHELBY SEAMLESS STEEL TUBING

1 REQUIRED

OBSOLETE

Obsolete

SIZE		ISSUE 9-27-39	J.W.	TITLE: FISCHER "TC-30-96" MOBILE STAND HEAD SUPPORT TUBE
KIND		CHANGED		
SHAPE		" 4-6-44	HE.	
FINISH	CHR. #2 SEE NOTE	PER J.B.: " 5-16-46	J.V.W.	
TEMP.		"		H. G. FISCHER & CO. 2335 WABANSIA AVE. CHICAGO, ILL. — CAT. NO. — PART NO. 12737A
PATT.		"		

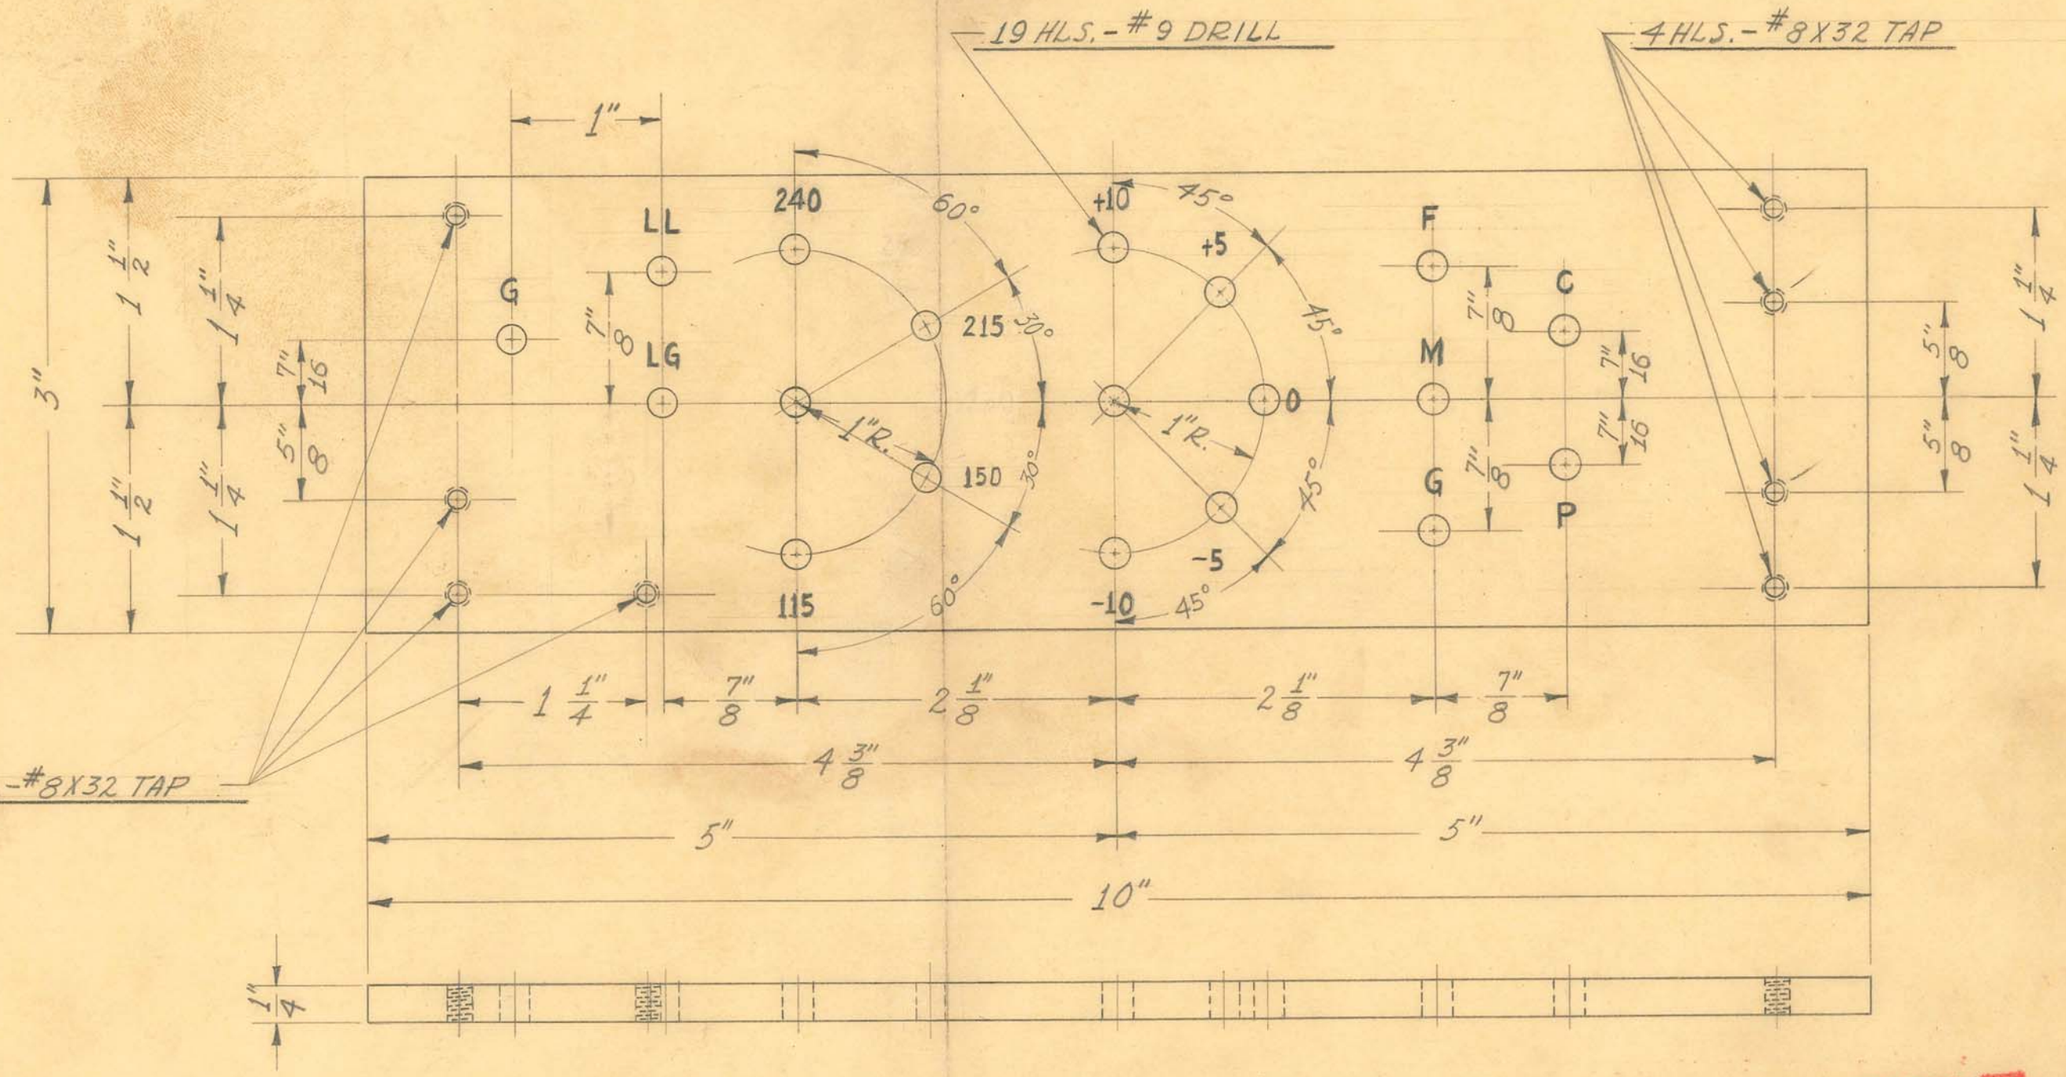

1 REQUIRED

OBSOLETE
Obsolete

SIZE	1/4" SHEET	ISSUE 11-8-39	J.W.	TITLE: FISCHER MOD. "TC-30-96" J.P. MOBILE "X-RAY" CONTROL - TERMINAL BOARD (ENGRAVED)
KIND	BAKELITE	CHANGED 1-22-40	J.W.	
SHAPE		"		
FINISH		"		
TEMP.		"		
PATT.		"		

H. G. FISCHER & CO.
2335 WABANSIA AVE.
CHICAGO, ILL.

CAT. NO.

PART NO. 12755AF

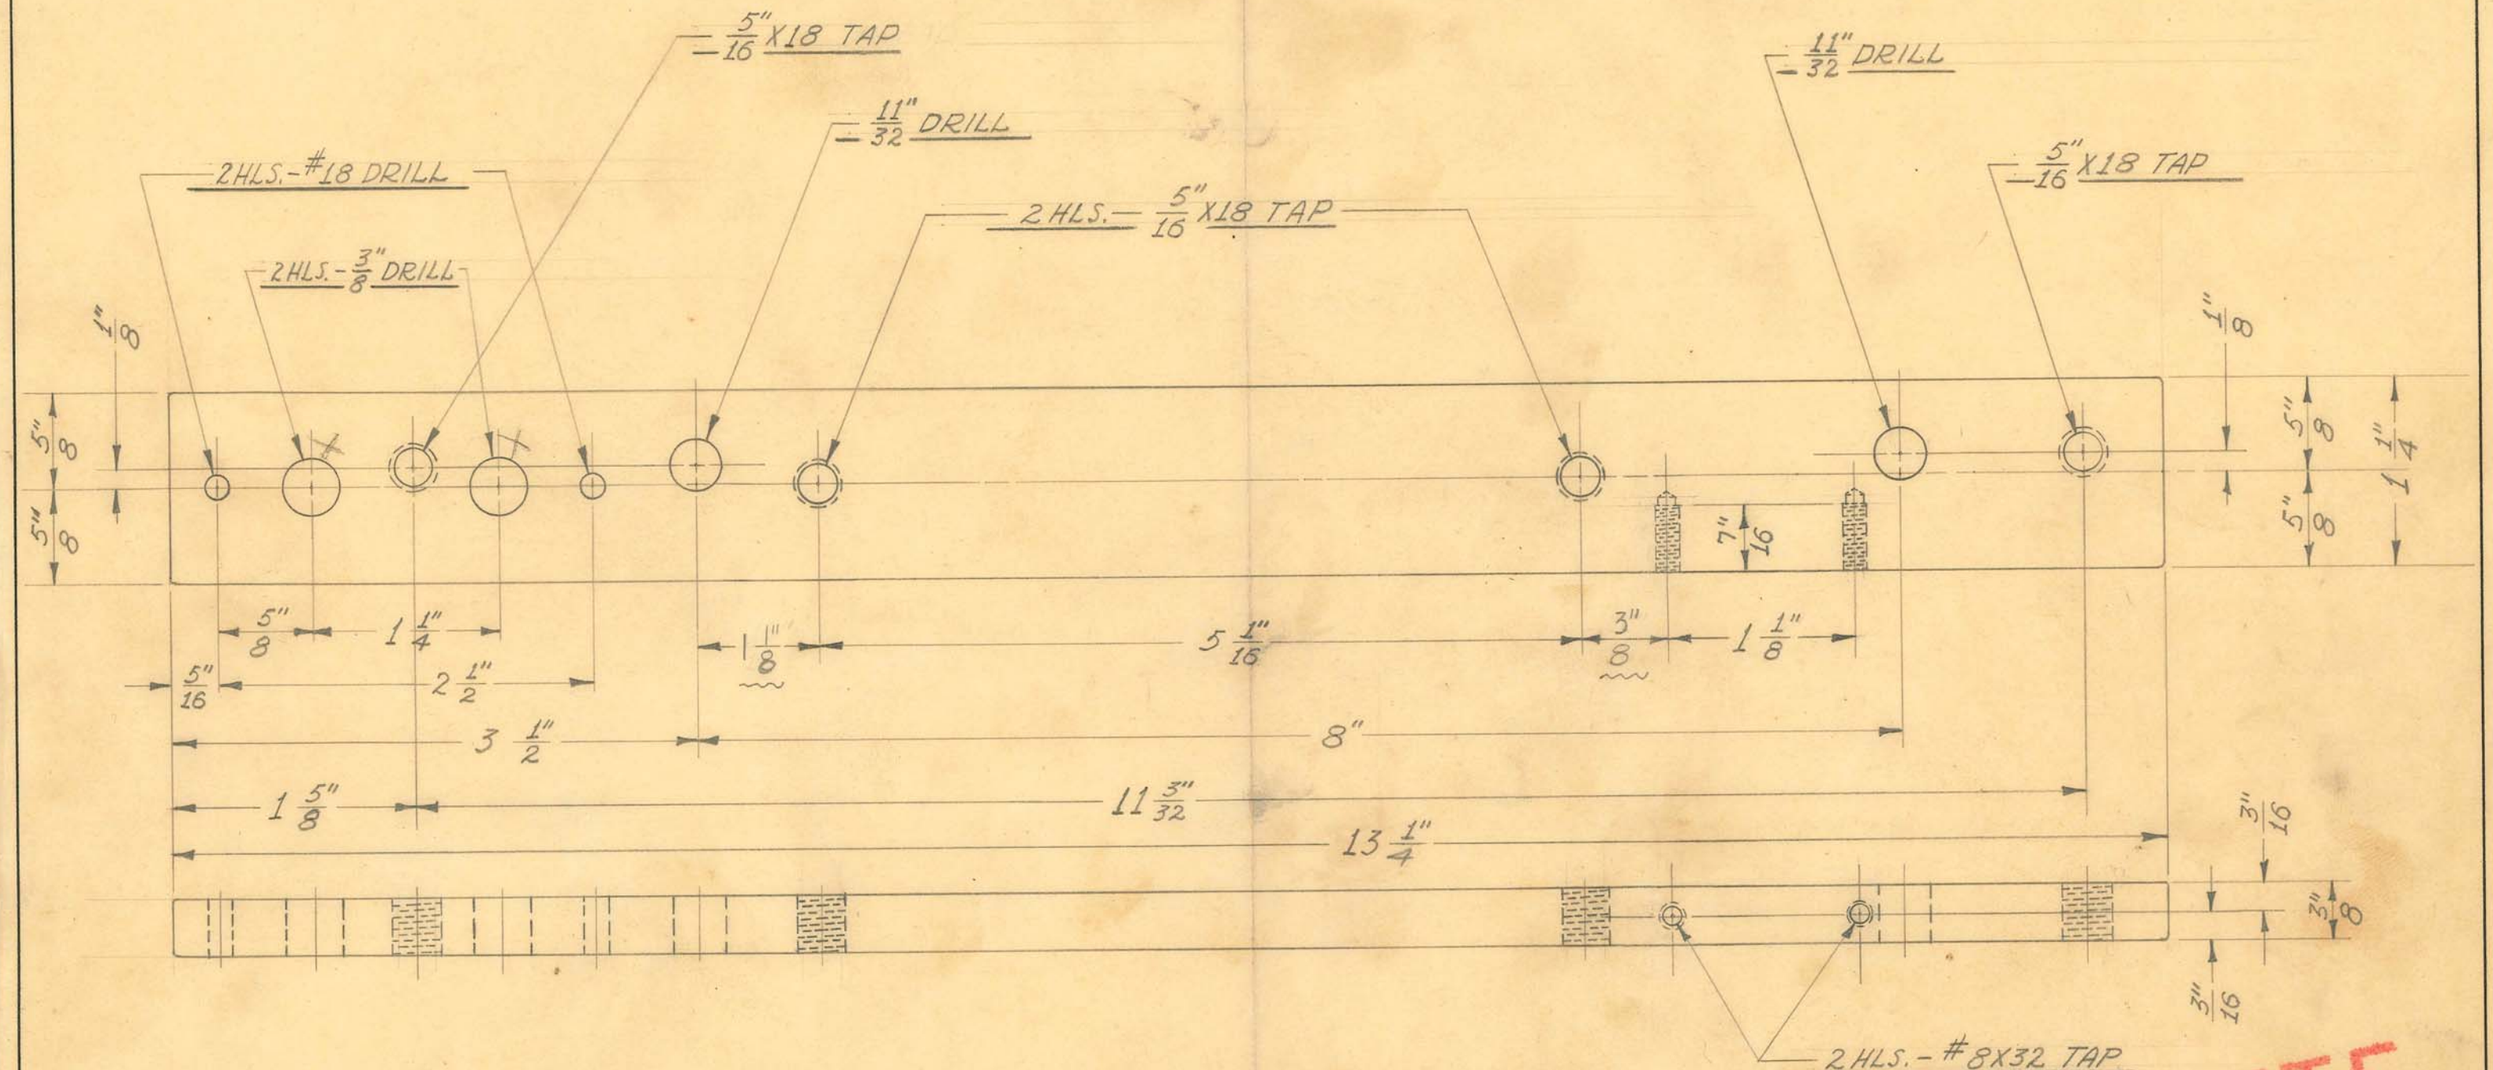

1 REQUIRED

OBSOLETE

Obsolete

SIZE	1 1/4" X 3/8"	ISSUE 10-31-39	J.W.	TITLE: FISCHER MOD. "TC-30-96" S.P. MOBILE "X-RAY" CONTROL - AUTO TRANSF SUPP. - FRONT - LEFT
KIND	C.R. STEEL	CHANGED 4-16-41	J.V.W.	
SHAPE	BAR	"		
FINISH		"		
TEMP.		"		
PATT.		"		

H. G. FISCHER & CO.
2335 WABANSIA AVE.
CHICAGO, ILL.

CAT. NO.

PART NO. 12758A

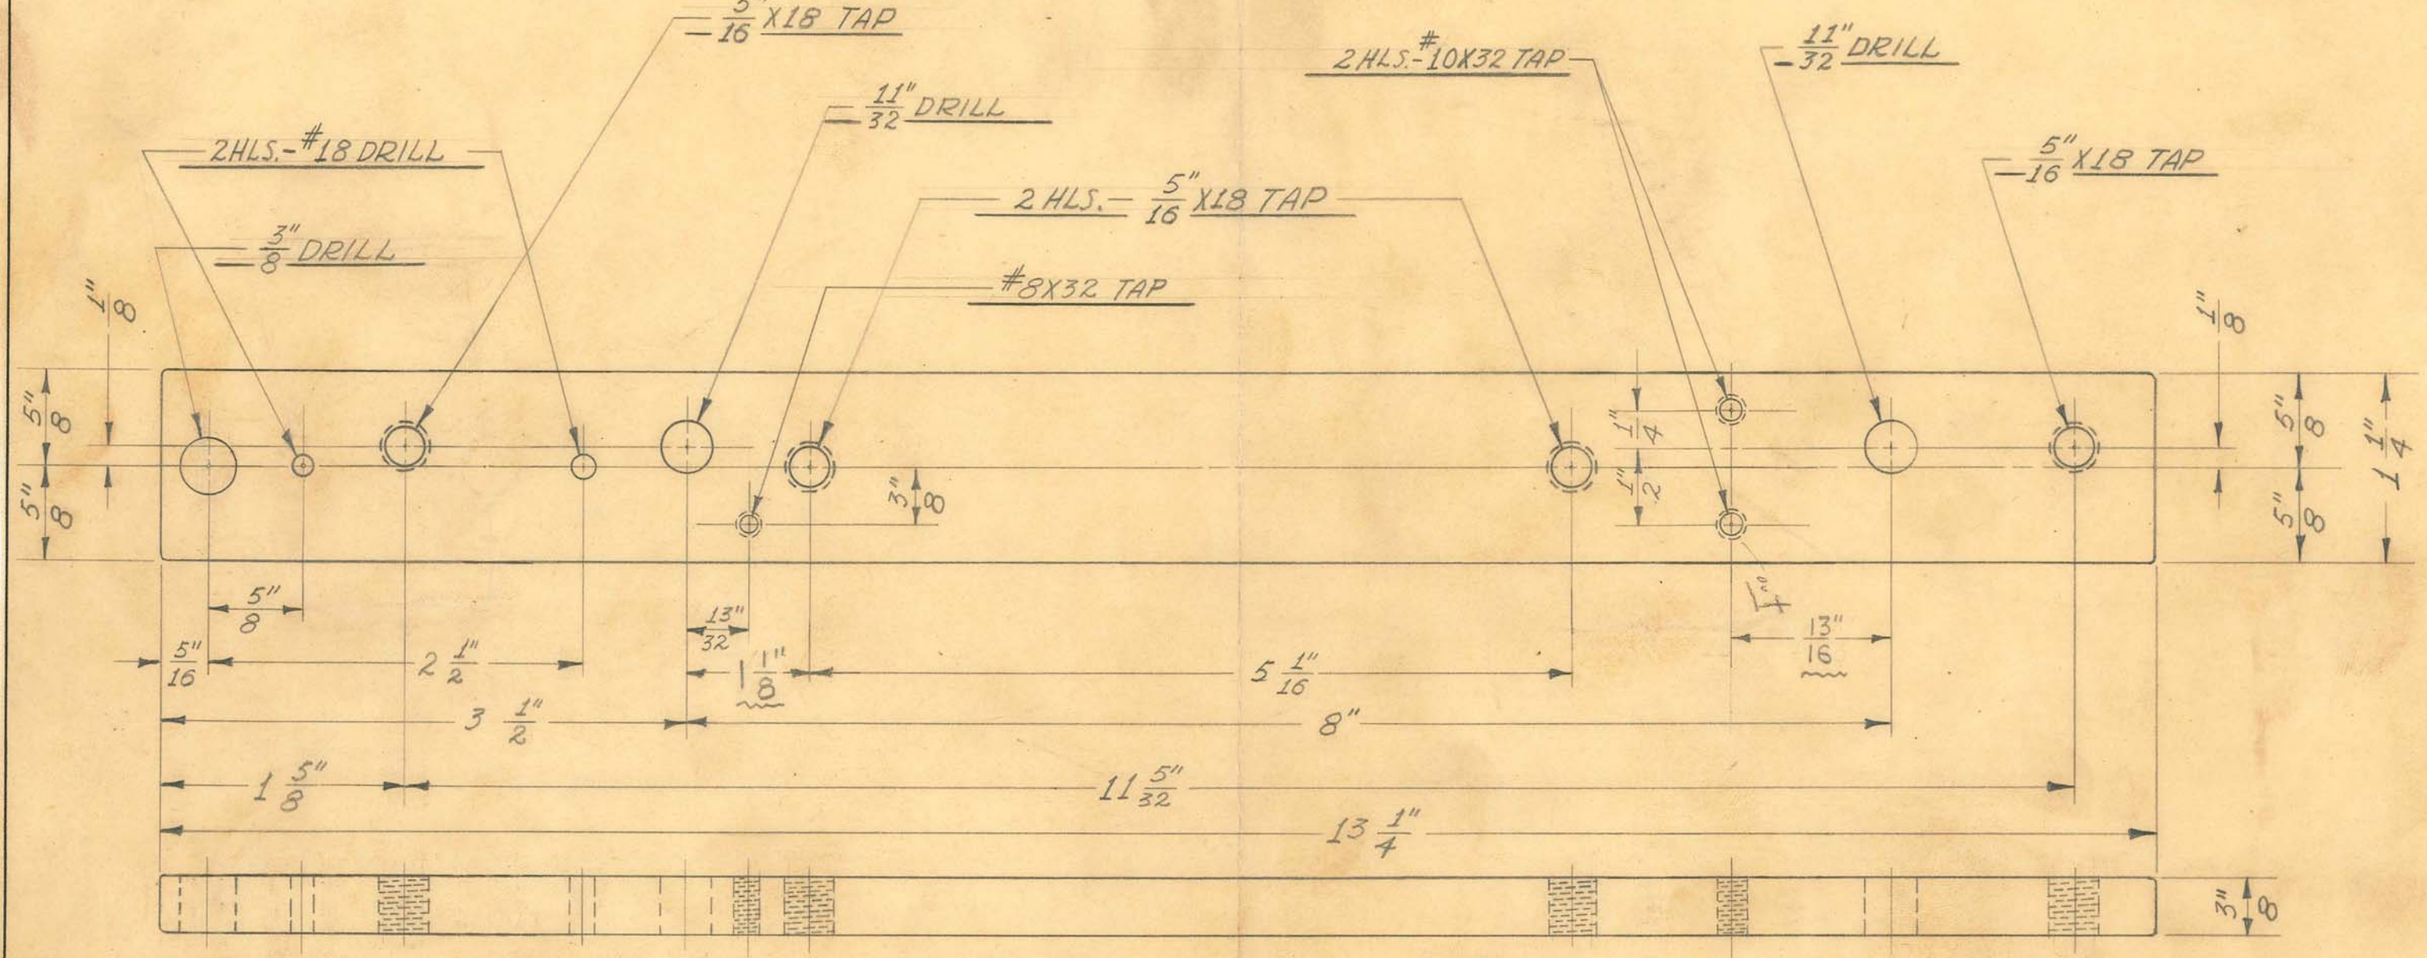

1 REQUIRED

OBSOLETE
Obsolete

SIZE	1¼" X ⅜"	ISSUE 11-1-39	J.W.	TITLE: FISCHER MOD. "TC-30-96" S.R. MOBILE "X-RAY" CONTROL - AUTO TRANSF SUPP. - FRONT - RIGHT
KIND	C.R. STEEL	CHANGED 4-15-41	J.V.W.	
SHAPE	BAR	"		H. G. FISCHER & CO. CAT. PART 107504
FINISH		"		
TEMP.		"		

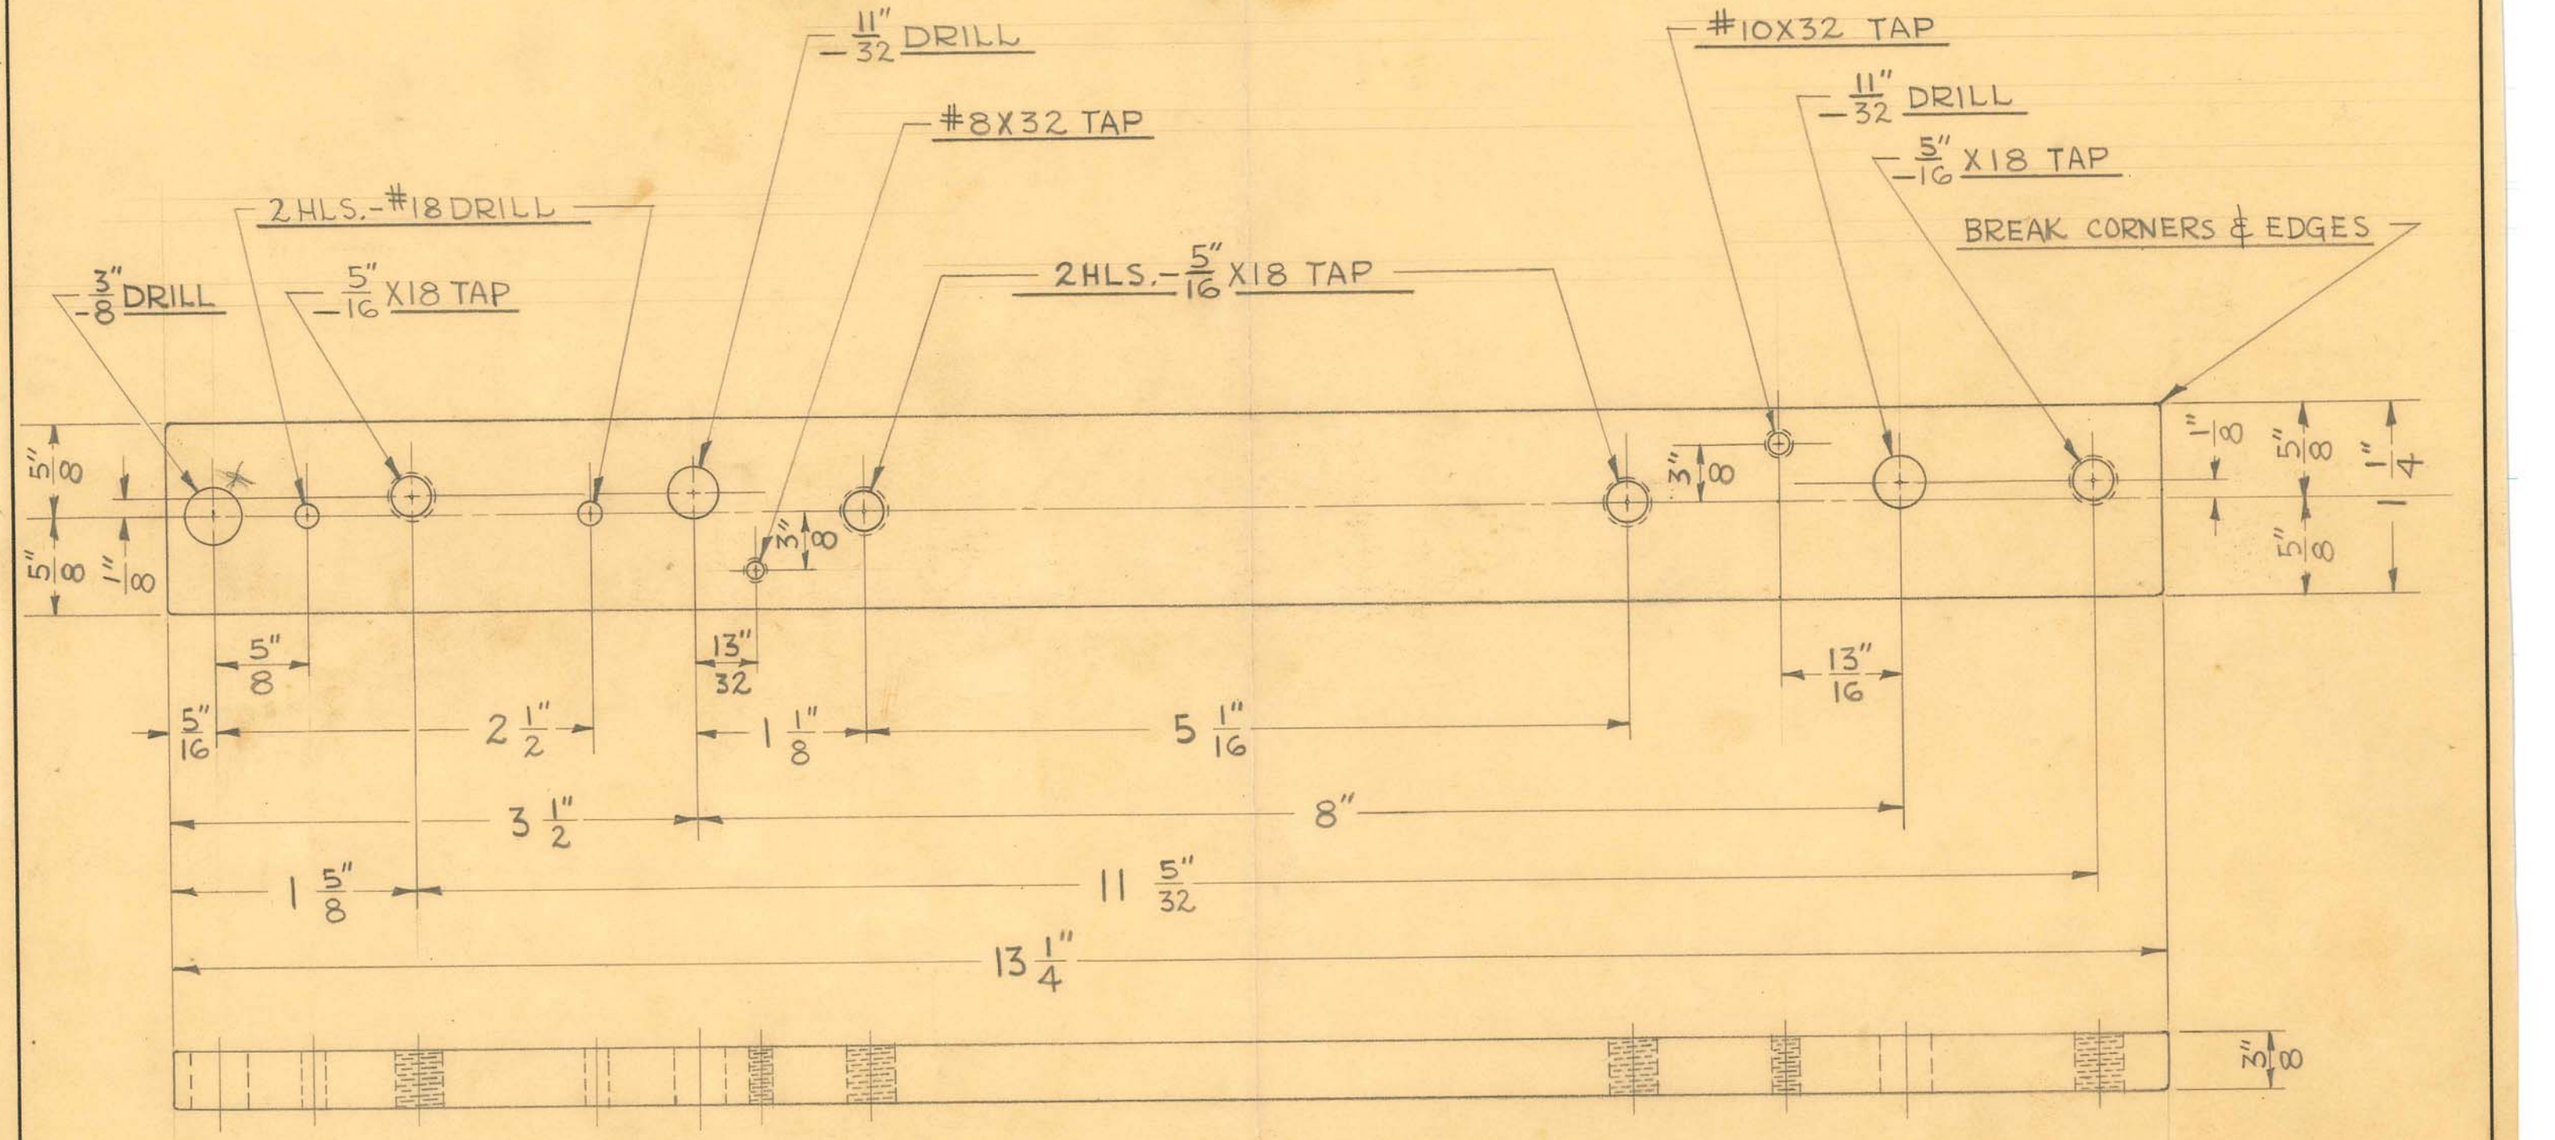

1 REQUIRED

OBSOLETE

Obsolete

SIZE	3/8" X 1 1/4"	ISSUE 12-21-45	J.N.W.	TITLE: FISCHER MOD. "TC-30-96" S.P. MOBILE X-RAY CONTROL-AUTO TRANSF. SUPP.-FRONT-RIGHT
KIND	C.R. STEEL	CHANGED		
SHAPE	BAR	"		
FINISH		"		
TEMP.		"		
PATT.		"		

H. G. FISCHER & CO.
2335 WABANSIA AVE.
CHICAGO, ILL.

CAT. NO.

PART NO. 12759B

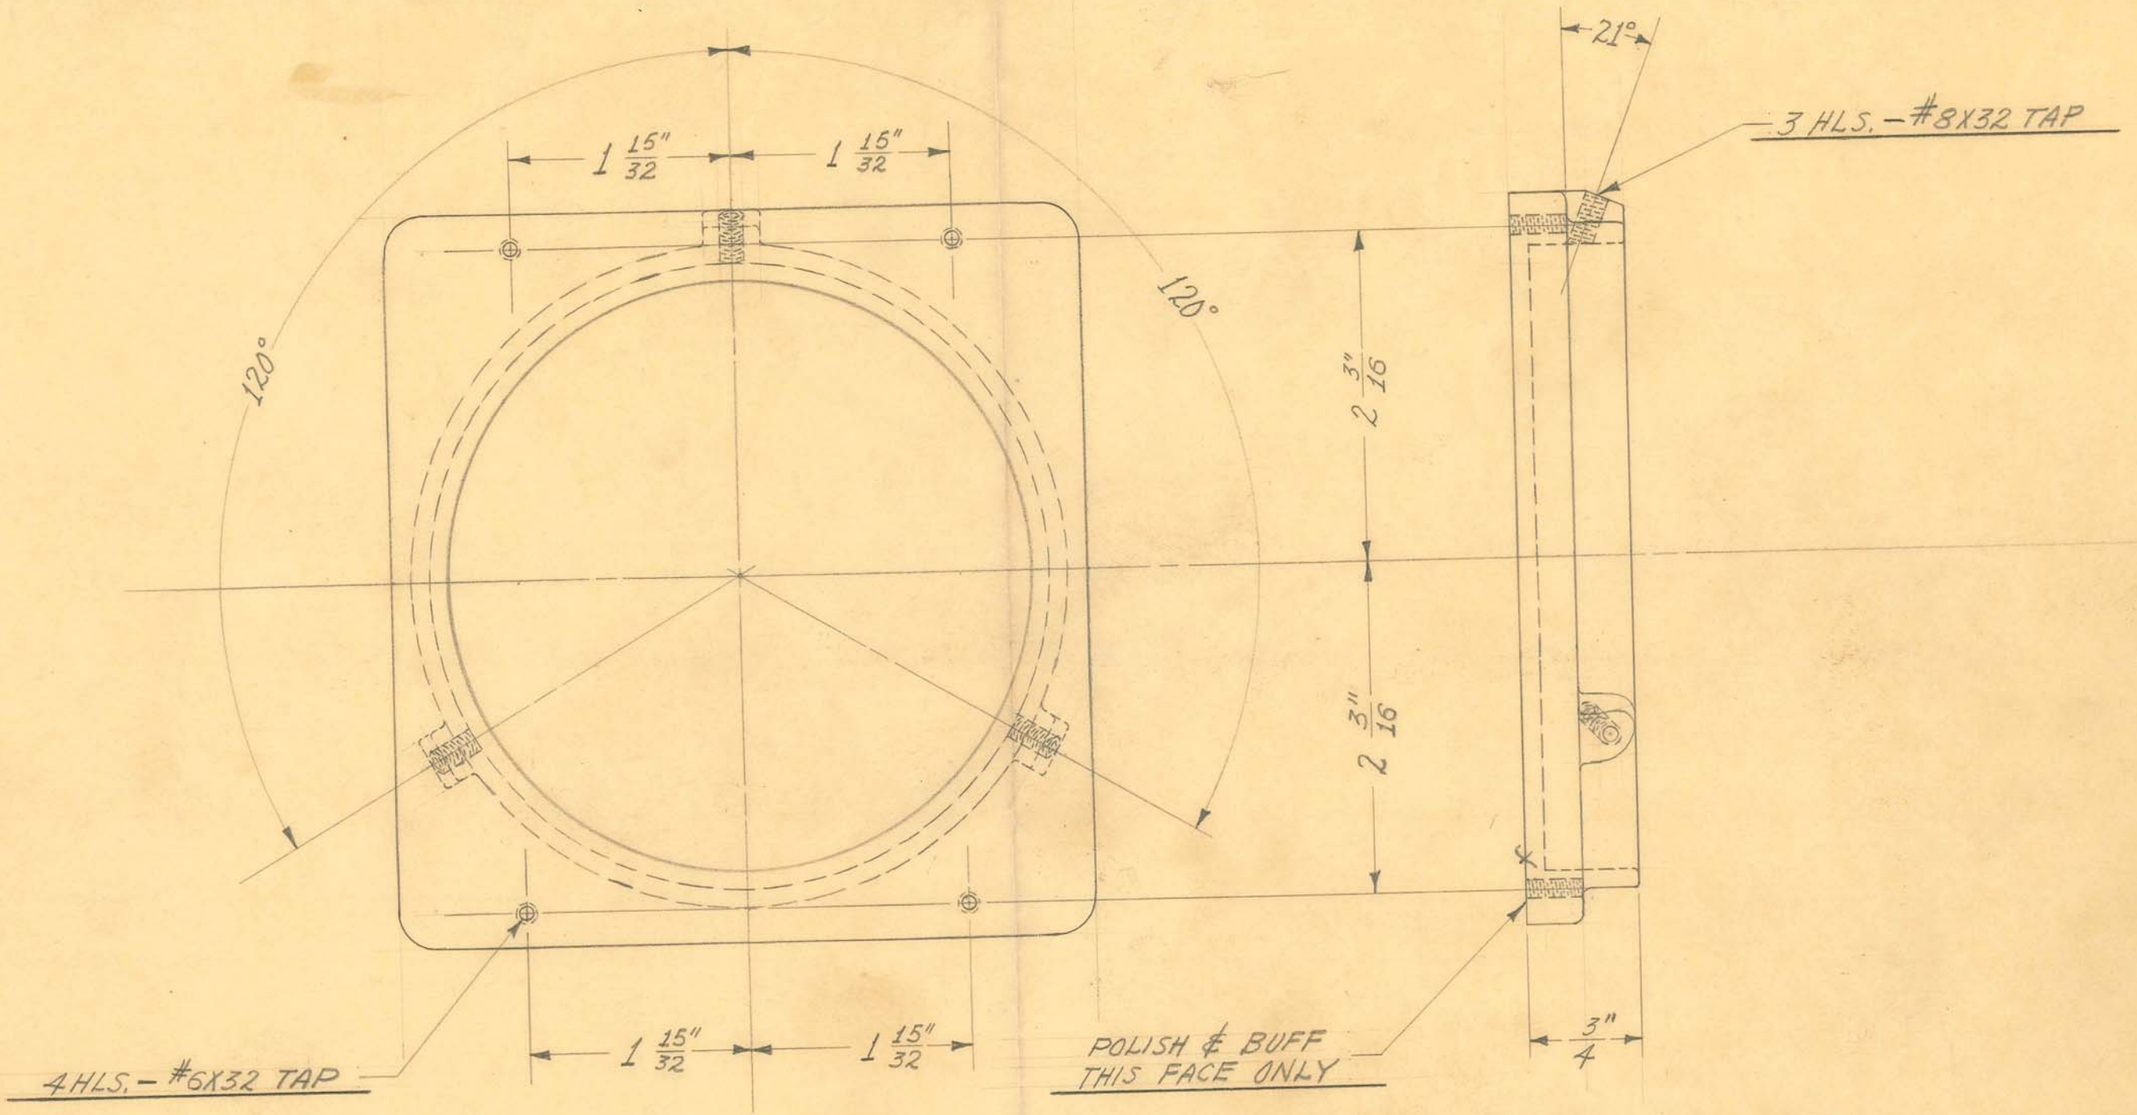

1 REQUIRED

OBSOLETE

SIZE	#12	ISSUE 12-19-39	J.W.
KIND	ALUM. CASTING	CHANGED	
SHAPE		"	
FINISH	PAINTED	"	
TEMP.		"	
	1442	"	

TITLE: FISCHER MOD. "TM-30-96" MOBILE X-RAY-UNIT
FILTER ADAPTER

H. G. FISCHER & CO.
2335 WABANSIA AVE.
CHICAGO, ILL.

CAT. NO.

PART NO. 12776F

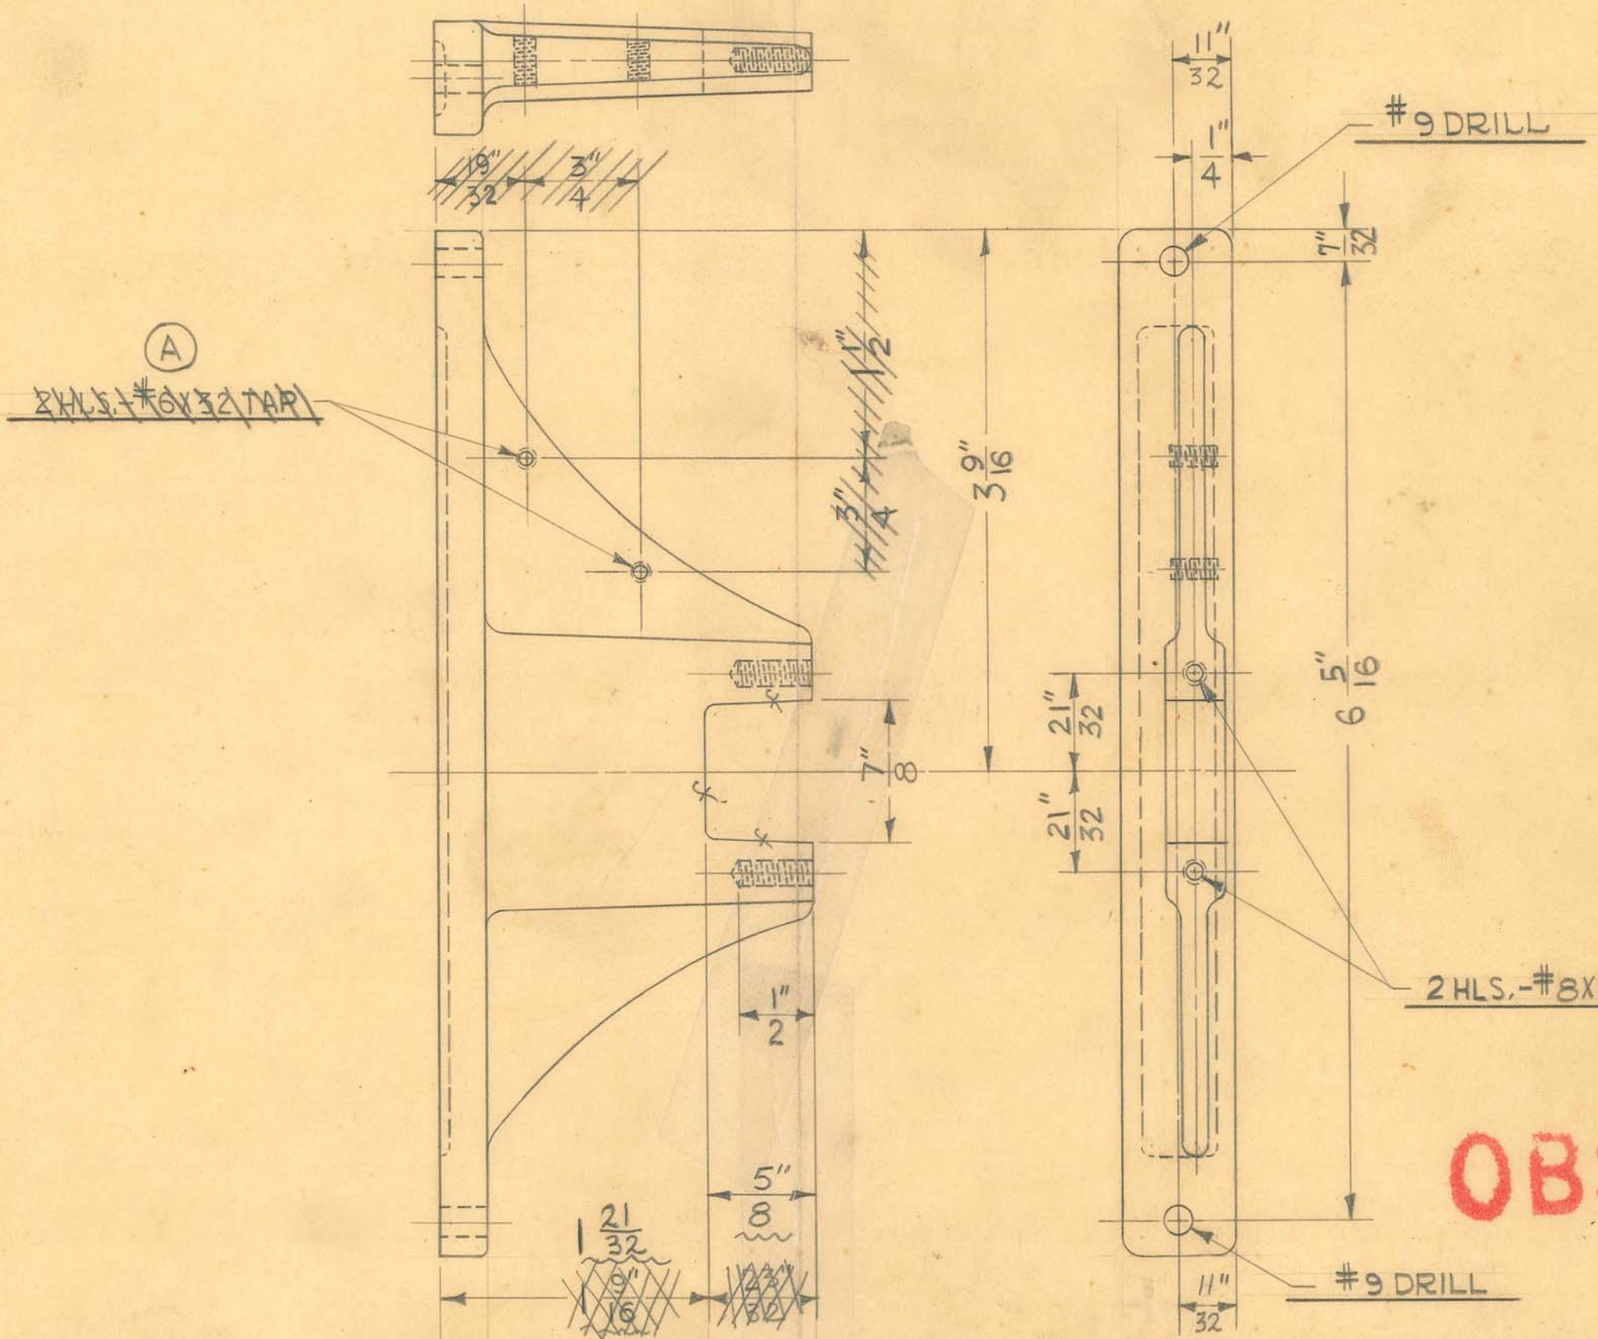

OBSOLETE

REVISION		DATE	BY
A	REMOVED	6-11-51	J.V.W.

1 REQUIRED

SIZE	IRON	ISSUE 4-28-42	J.V.W.
KIND	CASTING	CHANGED 7-17-42	J.V.W.
SHAPE		" 8-24-45	J.V.W.
FINISH		" 5-31-46	J.V.W.
TEMP.		"	
PATT.	1888	"	

TITLE:
FISCHER "NTM" X-RAY UNIT
TRANSF. CLAMP & FIL. TRANSF. SUPP.-RIGHT

H. G. FISCHER & CO.
2335 WABANSIA AVE.
CHICAGO, ILL.

CAT. NO.

PART NO. 12835AF

REVISION		DATE	BY
A	REMOVED	6-17-51	J.V.W.

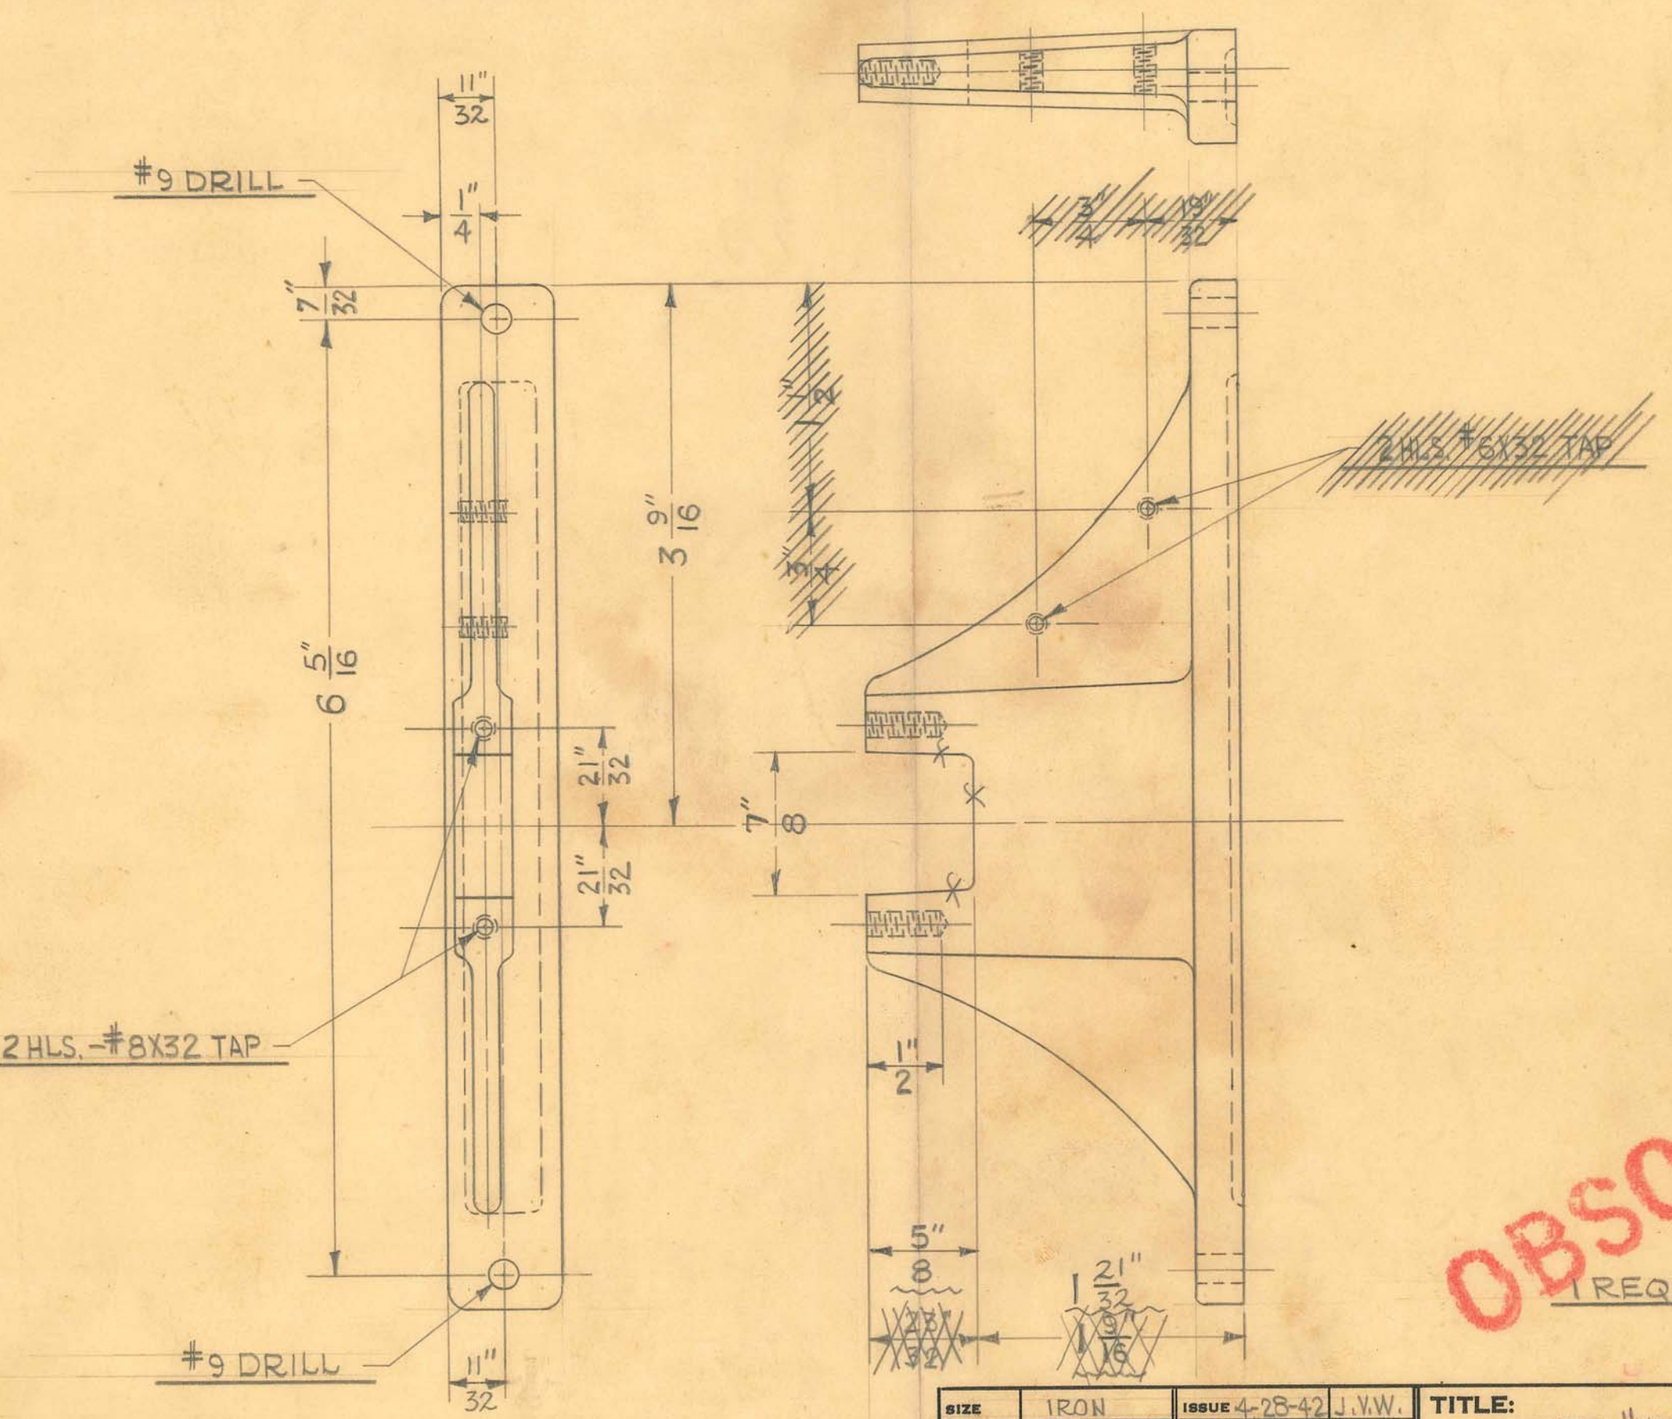

OBSOLETE

1 REQUIRED

SIZE	IRON	ISSUE 4-28-42	J.V.W.	
KIND	CASTING	CHANGED 7-17-42	J.V.W.	
SHAPE		" 8-24-45	J.V.W.	
FINISH		" 5-31-46	J.V.W.	
TEMP.		"		
PATT.	1889	"		

TITLE:
FISCHER "NTM" X-RAY UNIT
TRANSF. CLAMP & FIL. TRANSF. SUPP- LEFT

H. G. FISCHER & CO.
2335 WABANSIA AVE.
CHICAGO, ILL.

CAT. NO.

PART NO. 12836AF

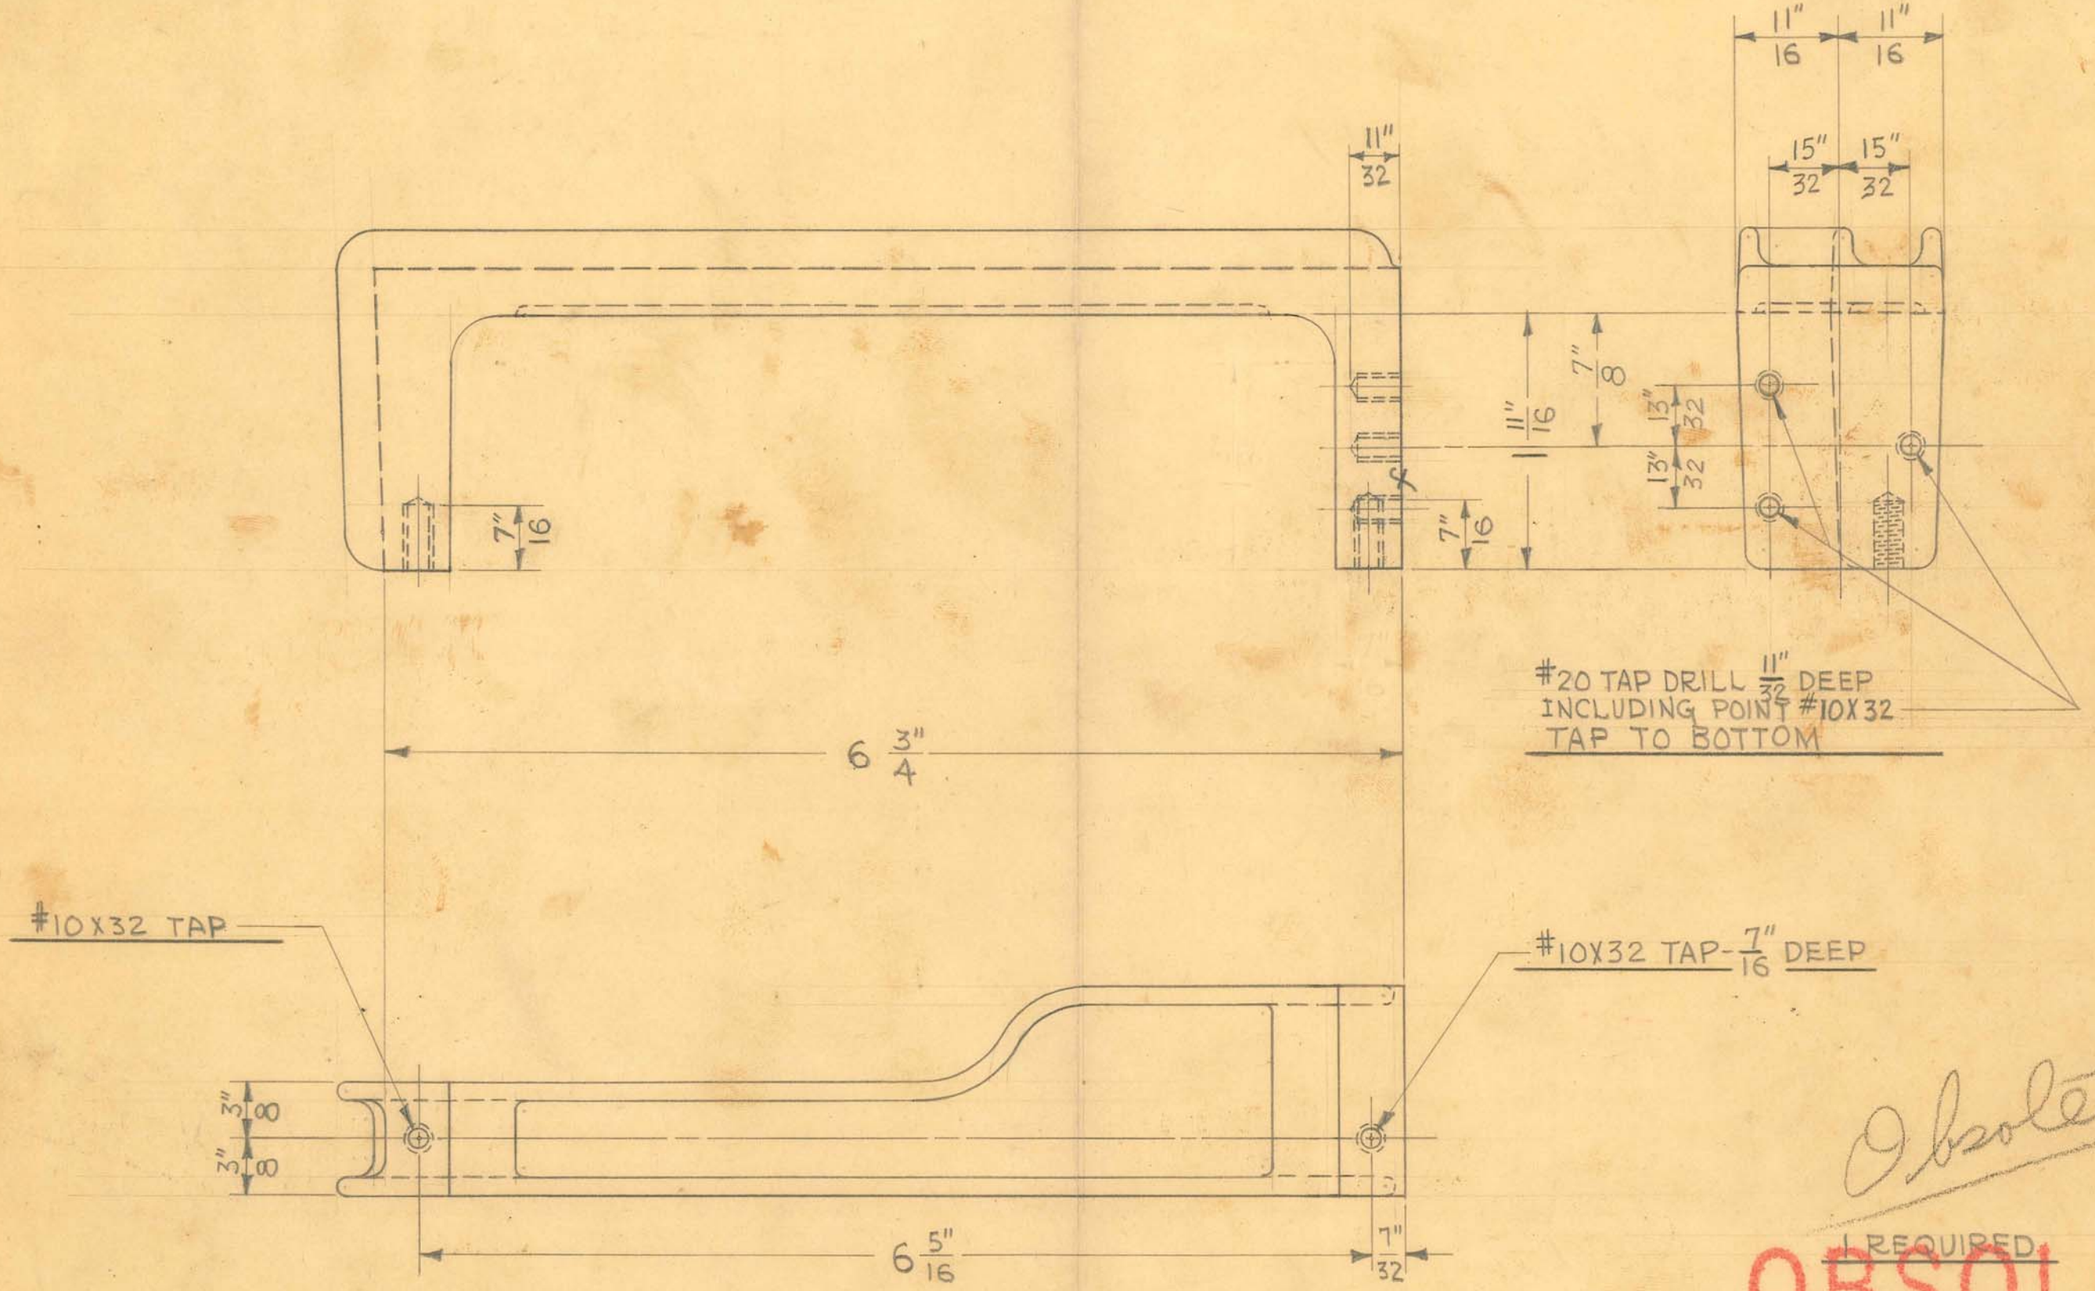

Obsolete

1 REQUIRED

OBSOLETE

SIZE	IRON	ISSUE 4-27-42	J.V.W.
KIND	CASTING	CHANGED	
SHAPE		" 5-10-43	H.E.
FINISH		"	
TEMP.		"	
PATT.	1978	"	

TITLE:
FISCHER "NTM" X-RAY UNIT
TRANSFORMER SUPPORT - RIGHT

H. G. FISCHER & CO.
2335 WABANSIA AVE.
CHICAGO, ILL.

CAT. NO.

PART NO. 12837AF

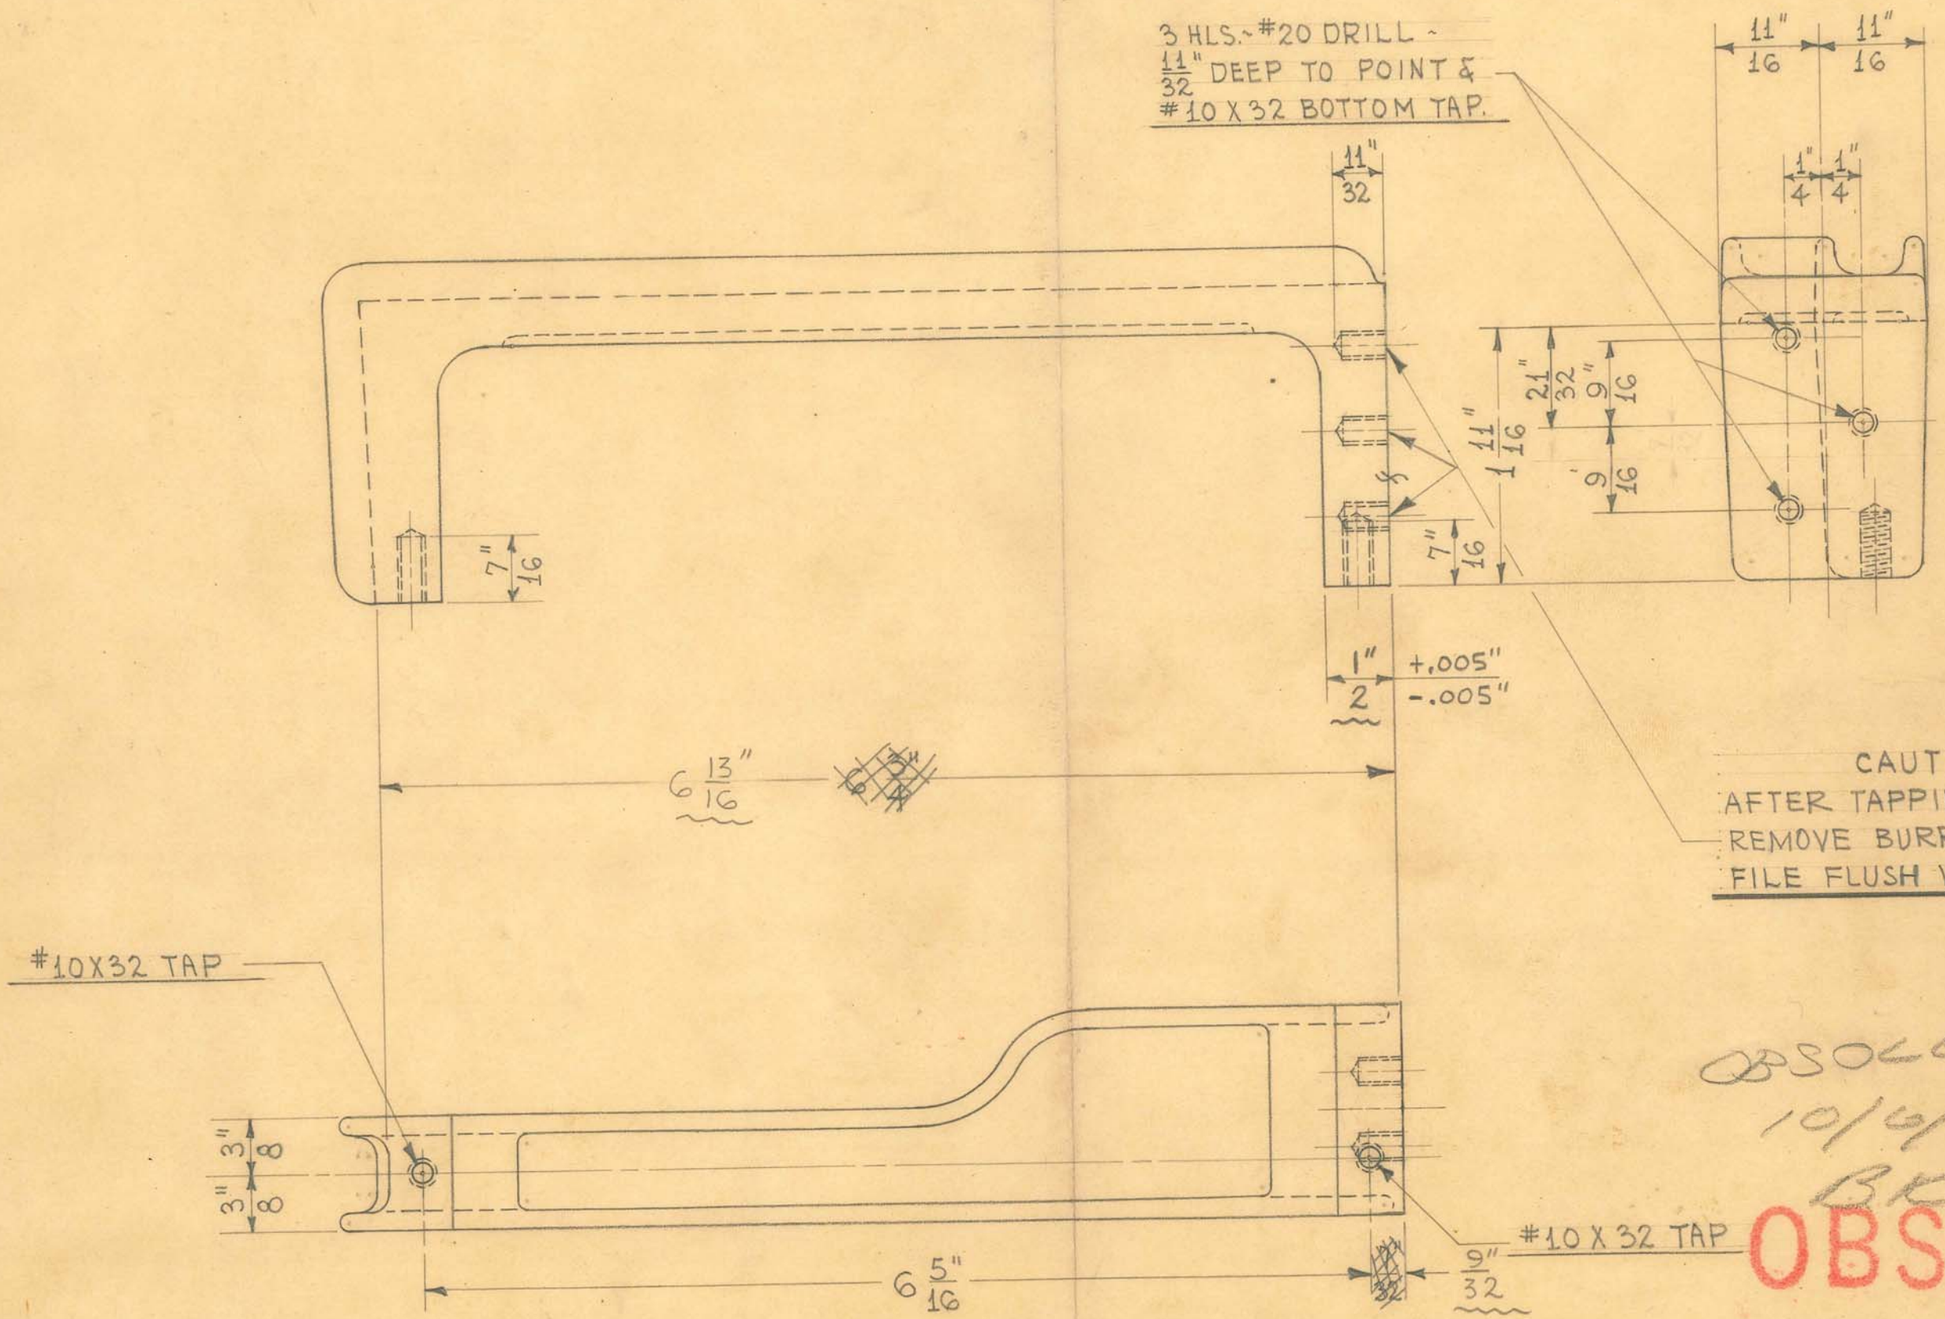

OBSOLETE
10/6/64
BE

OBSOLETE

1 REQUIRED

SIZE	#214	ISSUE 3-8-45	HE.
KIND	ALUM. CASTING	CHANGED	
SHAPE		" 7-10-46	J.V.W.
FINISH		"	
TEMP.		"	
PATT.	1978	"	

TITLE: FISCHER "NTM" X-RAY UNIT~
TRANSFORMER SUPPORT ~ RIGHT

H. G. FISCHER & CO.
2335 WABANSIA AVE.
CHICAGO, ILL.

CAT. NO.

PART NO. 12837AFB

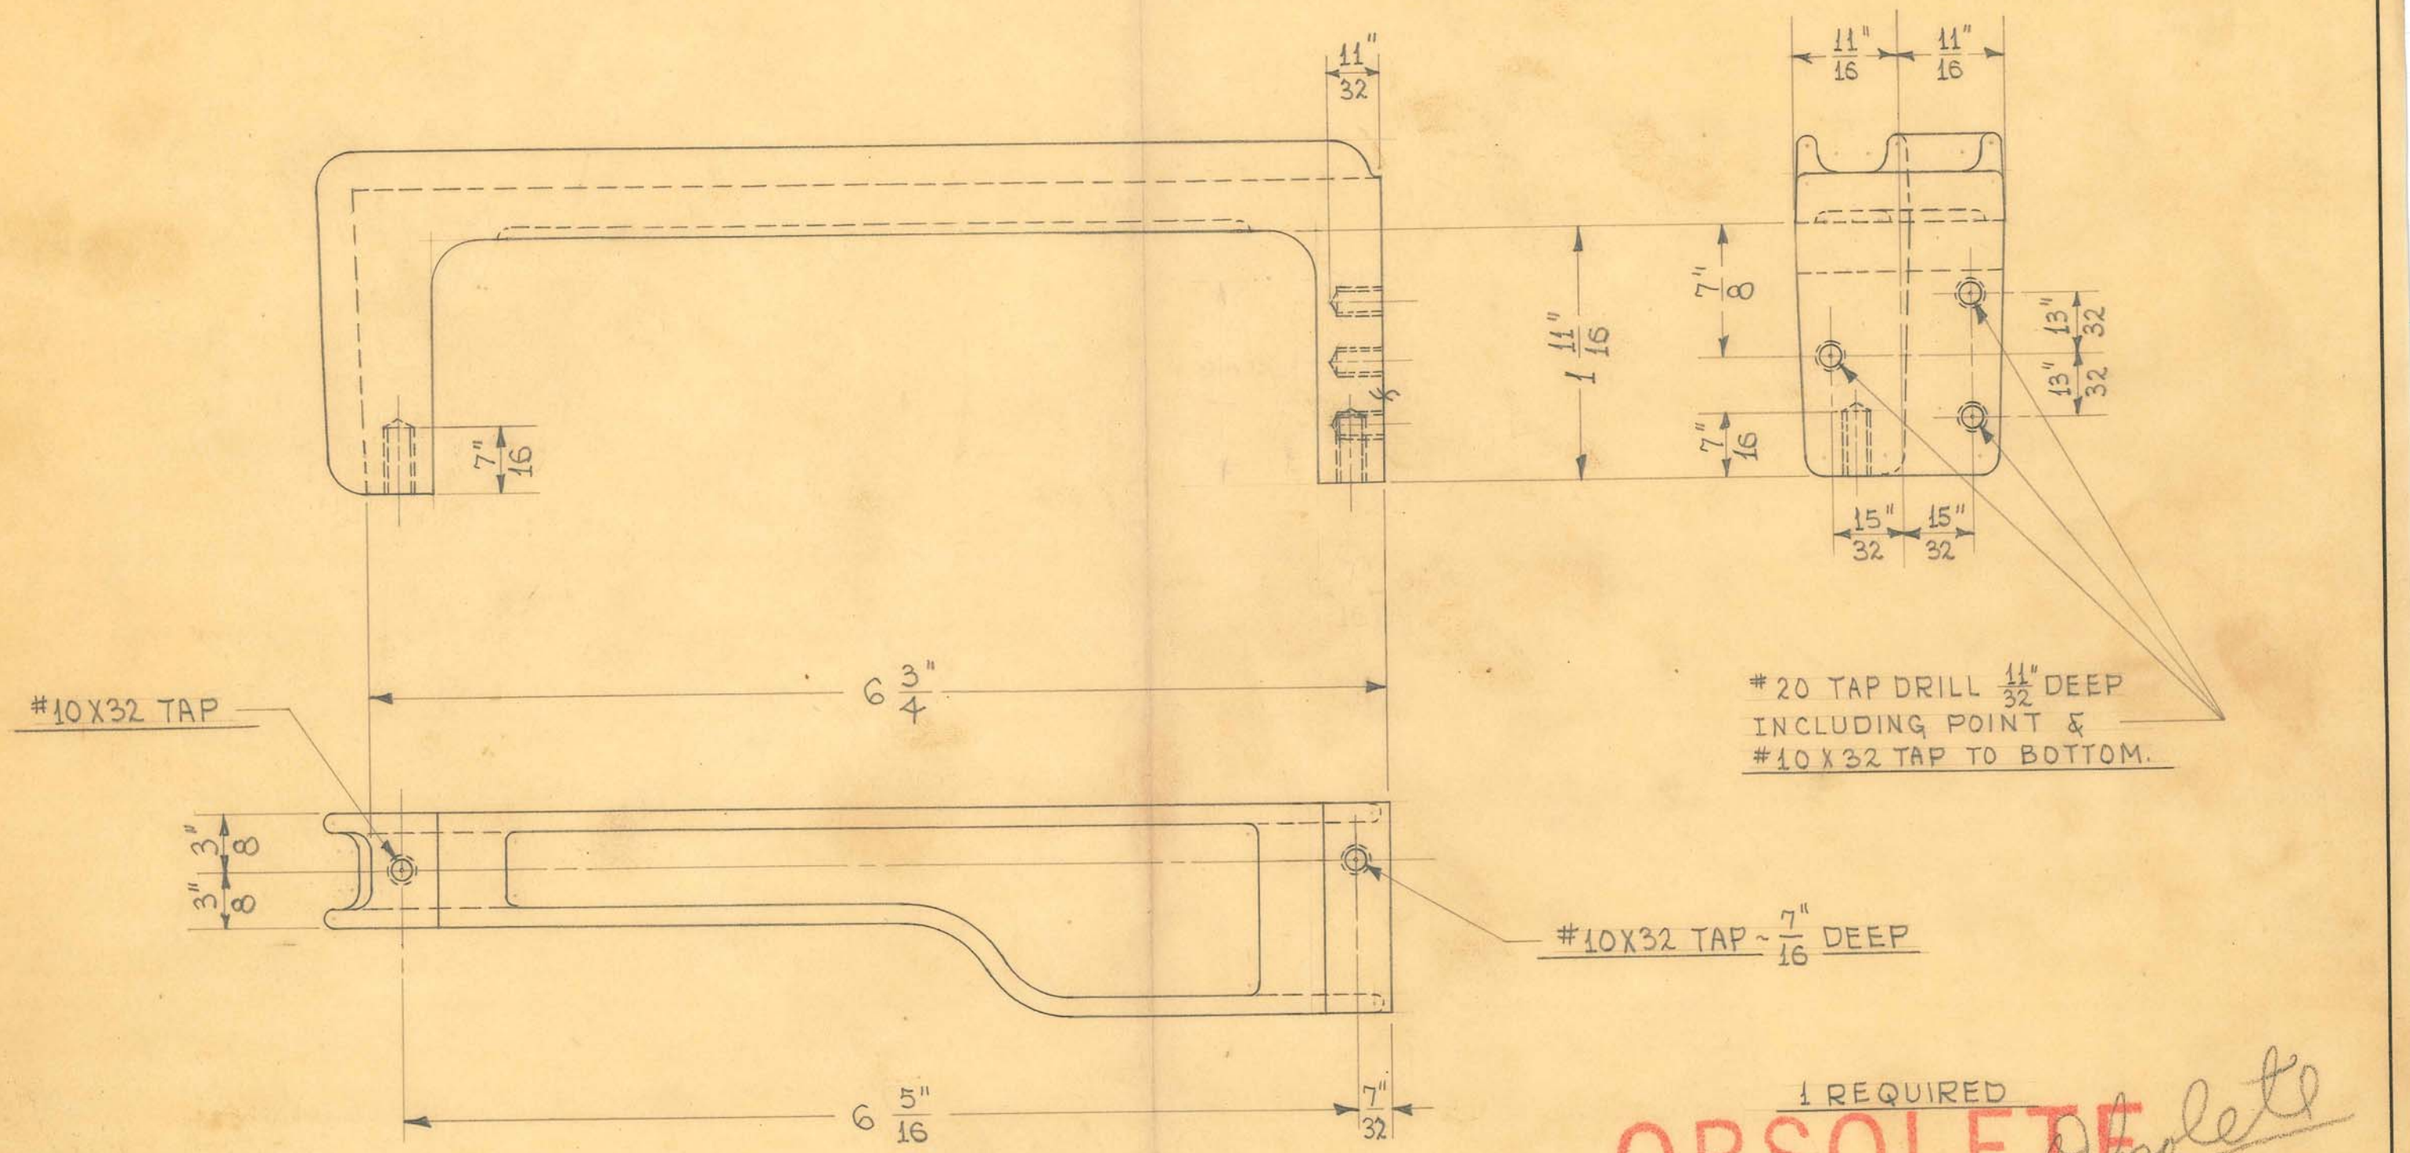

1 REQUIRED

OBSOLETE Obsolete

SIZE	IRON	ISSUE 5-4-43	HE.
KIND	CASTING	CHANGED	
SHAPE		"	
FINISH		"	
TEMP.		"	
PATT.	1979	"	

TITLE: FISCHER "NTM" X-RAY UNIT ~ TRANSFORMER SUPPORT ~ LEFT

H. G. FISCHER & CO.
2335 WABANSIA AVE.
CHICAGO, ILL.

CAT. NO.

PART NO. 12838AF

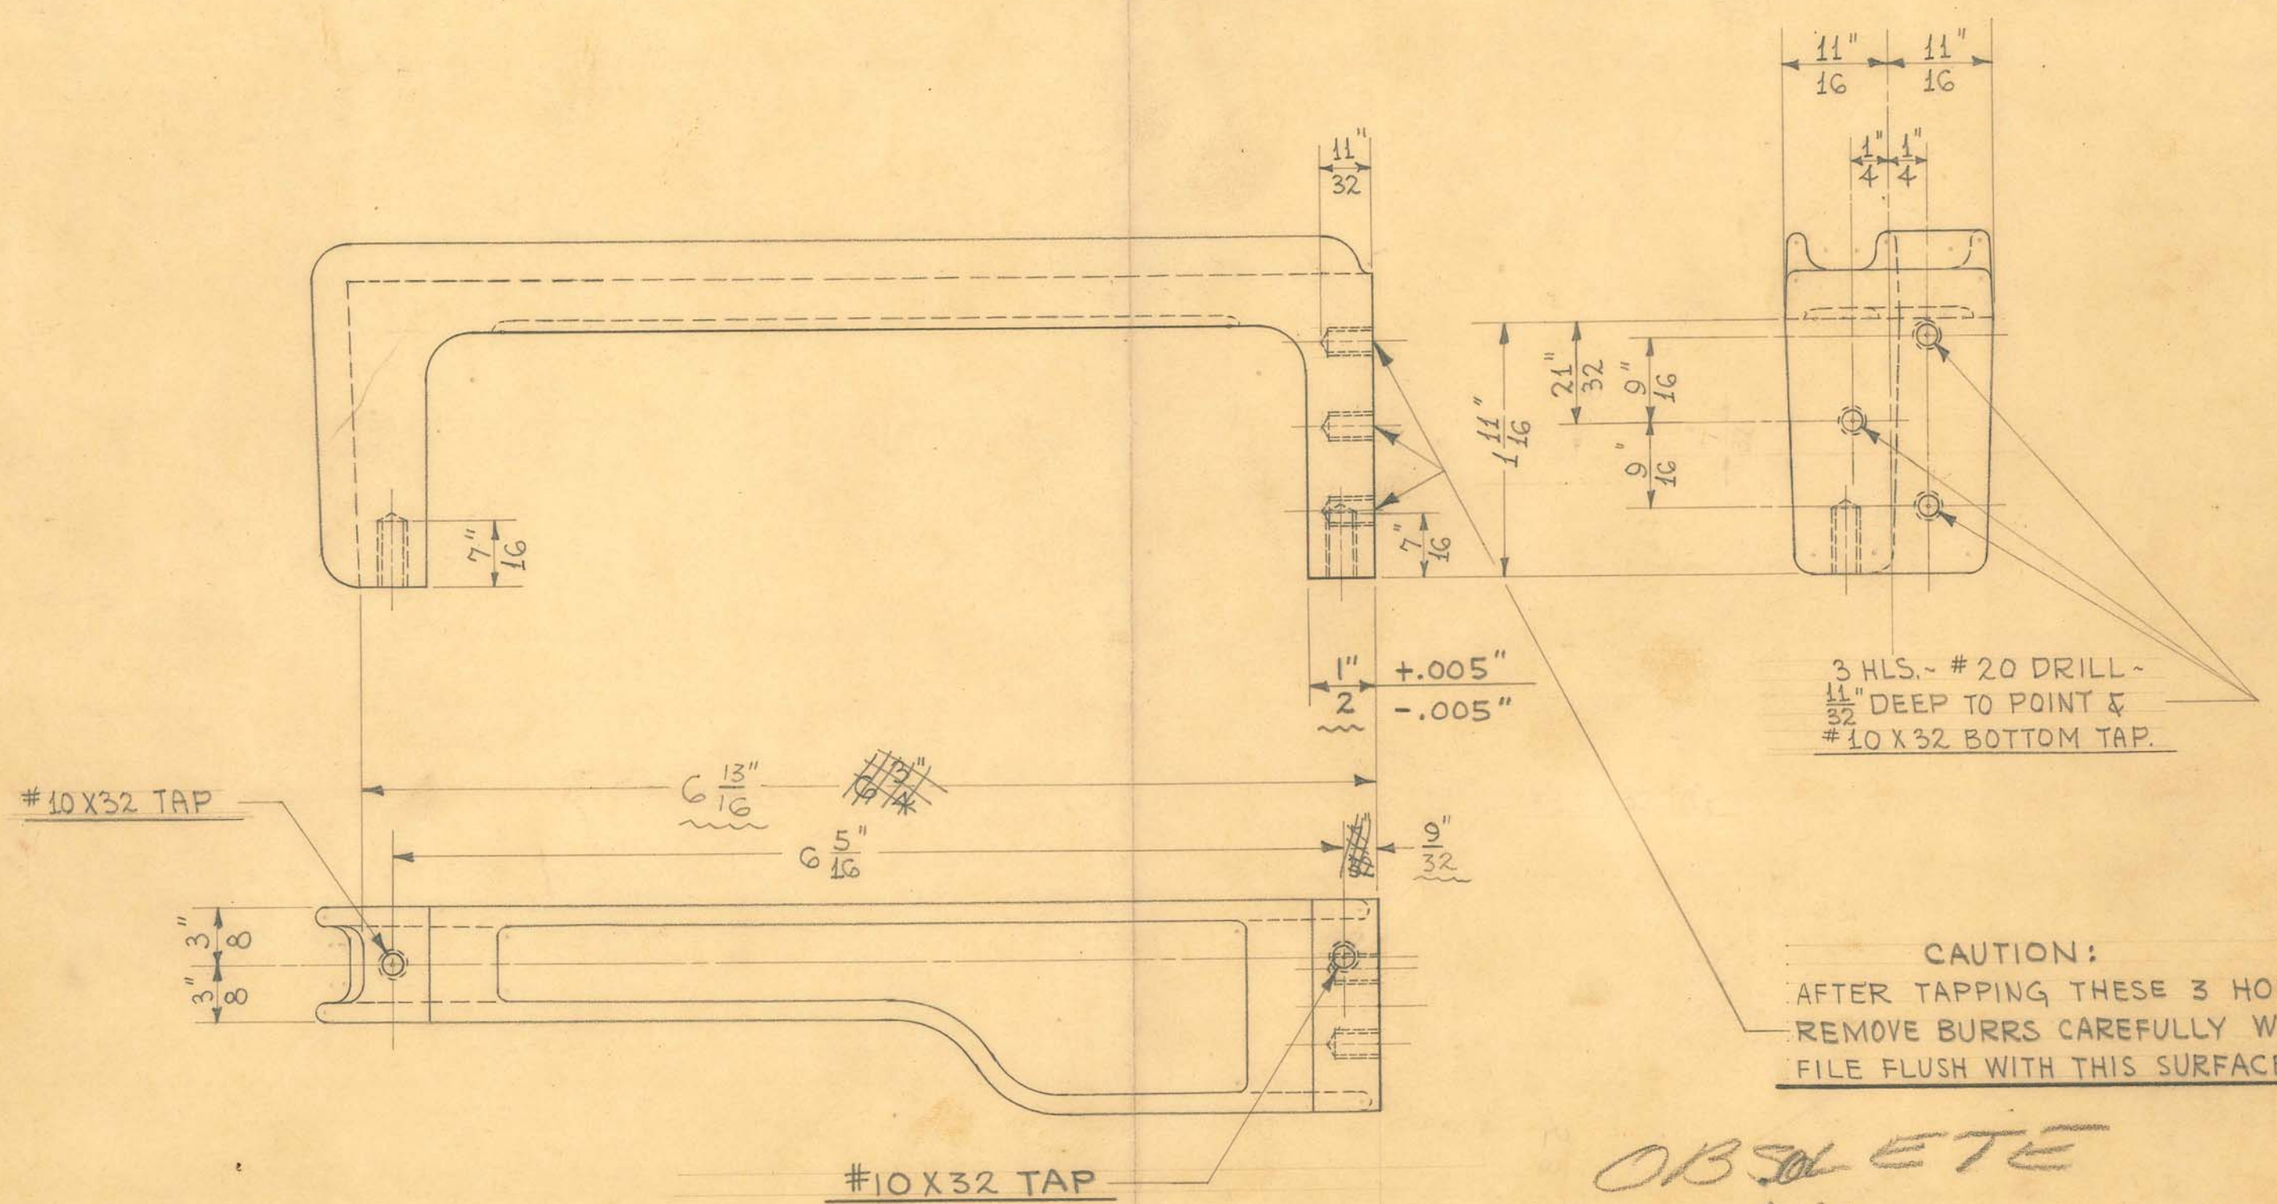

CAUTION:
AFTER TAPPING THESE 3 HOLES REMOVE BURRS CAREFULLY WITH FILE FLUSH WITH THIS SURFACE.

1 REQUIRED

OBSOLETE
10/4/46
OBSOLETE

SIZE	#214	ISSUE 3-8-45	H.E.
KIND	ALUM. CASTING	CHANGED	
SHAPE		" 7-10-46	J.V.W.
FINISH		"	
TEMP.		"	
PATT.	1979	"	

TITLE:
FISCHER "NTM" X-RAY UNIT~
TRANSFORMER SUPPORT ~ LEFT

H. G. FISCHER & CO.
2333 WABANSIA AVE.
CHICAGO, ILL.

CAT. NO.

PART NO. 12838AFB

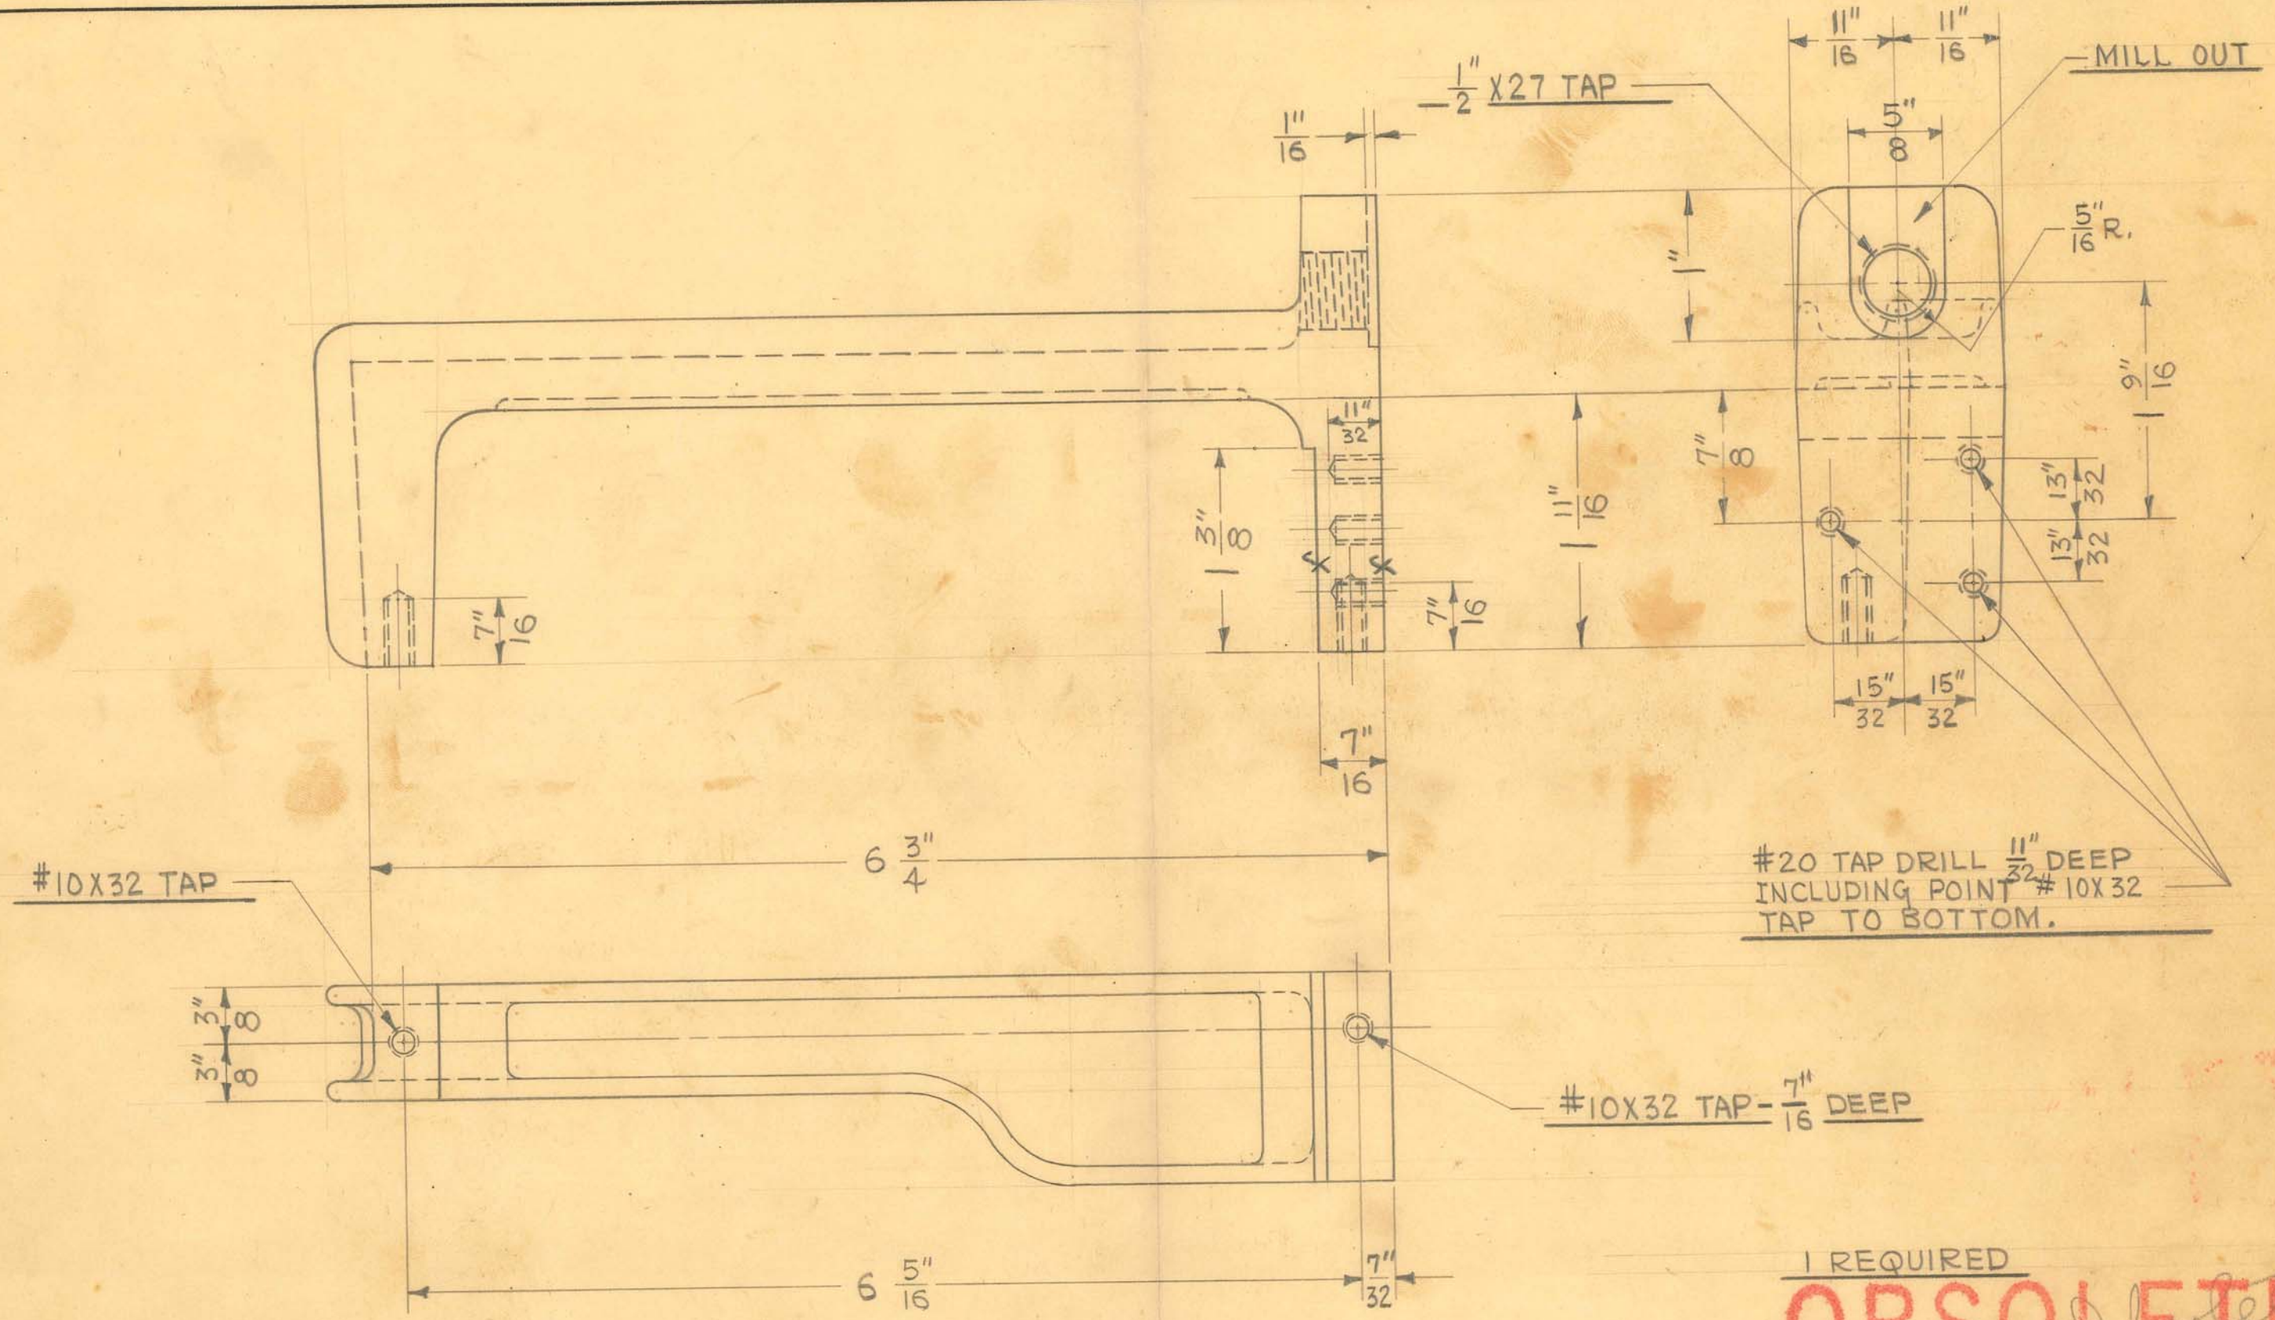

1 REQUIRED

OBSOLETE

SIZE	IRON	ISSUE 4-24-42	J.V.W.
KIND	CASTING	CHANGED	
SHAPE		"	
FINISH		"	
TEMP.		"	
PATT.	1891	"	

TITLE:
FISCHER "NTM" X-RAY UNIT
TRANSFORMER SUPPORT - LEFT

H. G. FISCHER & CO.
2335 WABANSIA AVE.
CHICAGO, ILL.

CAT. NO.

PART NO. 12838F

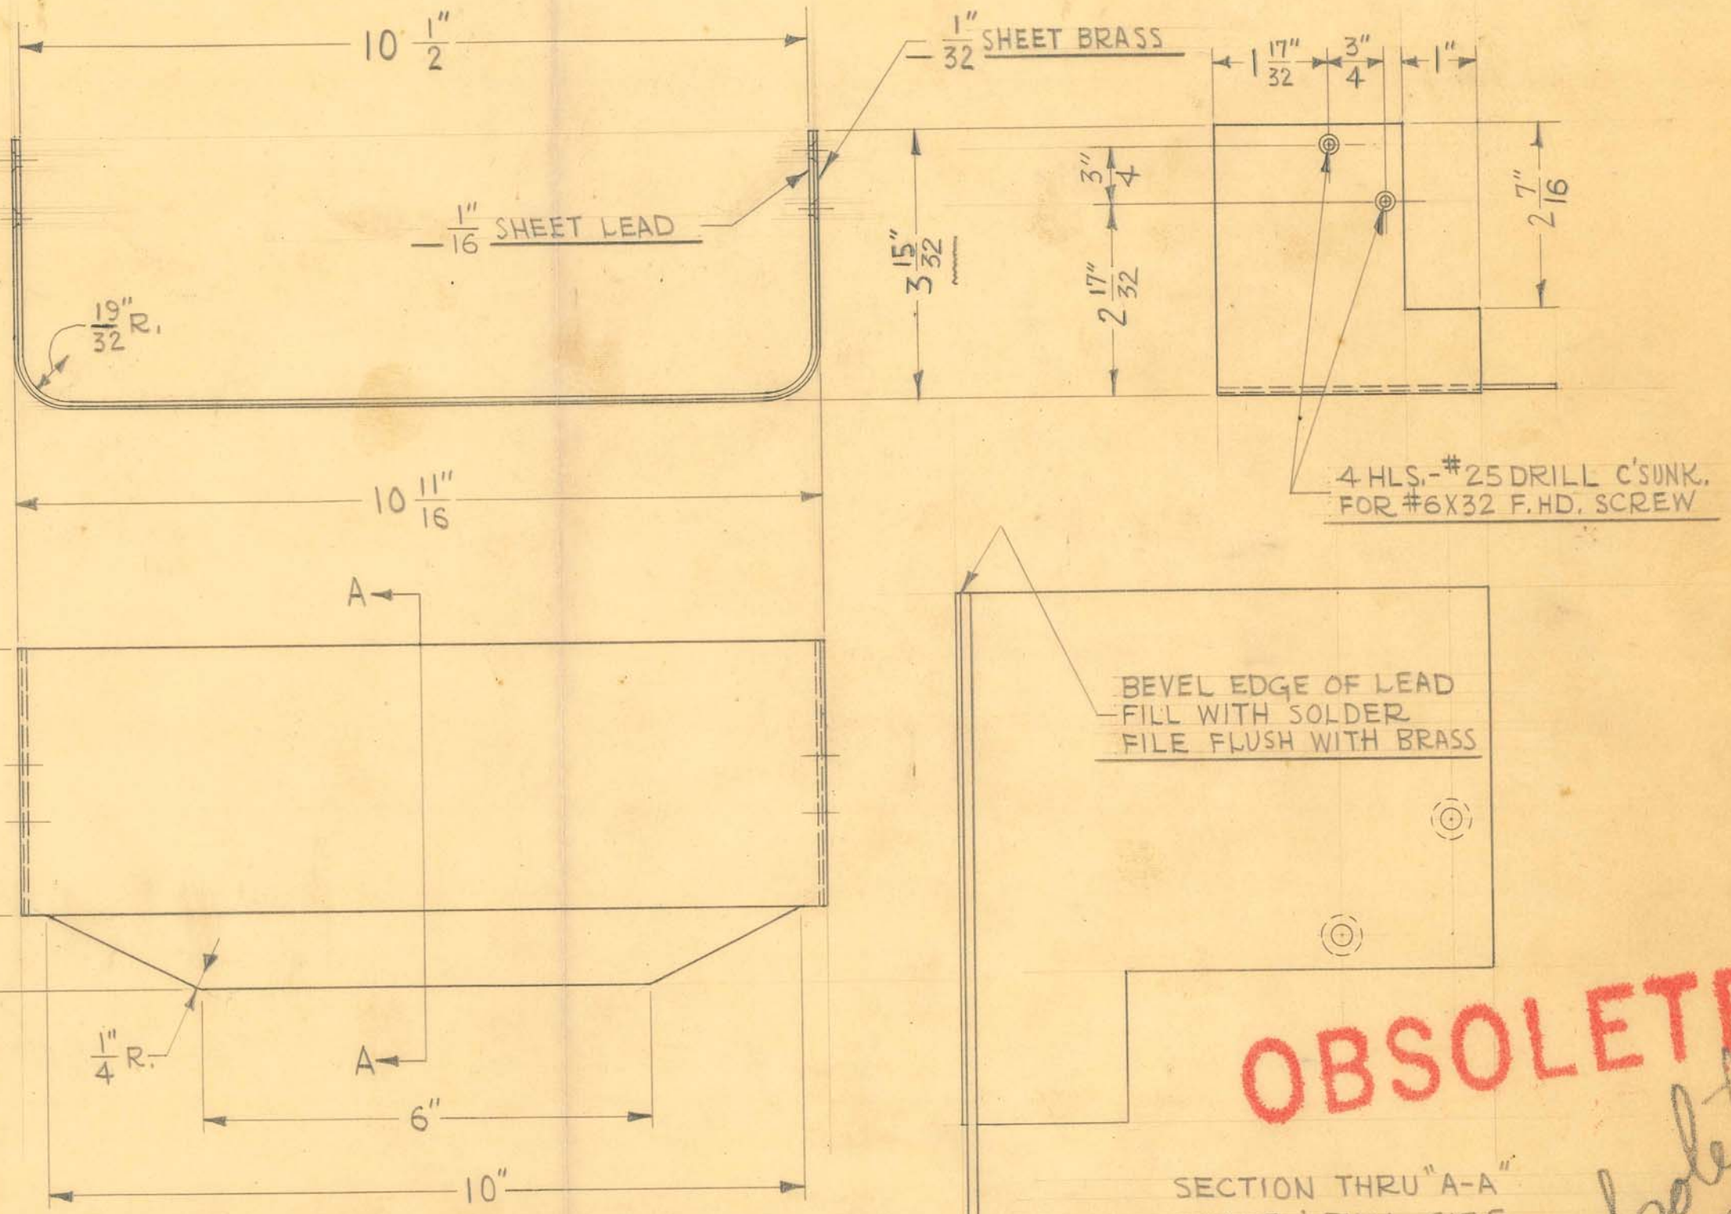

SECTION THRU "A-A"
SCALE ÷ FULL SIZE

DEVELOPED LENGTH =
SCALE ÷ HALF SIZE
1 REQUIRED

OBSOLETE

Obsolete

SIZE		ISSUE 6-2-42	J.V.W.
KIND		CHANGED	
SHAPE		"	
FINISH		"	
TEMP.		"	
PATT.		"	

TITLE:
FISCHER "NTM" X-RAY UNIT
TANK X-RAY SHIELD

H. G. FISCHER & CO.
2335 WABANSIA AVE.
CHICAGO. ILL.

CAT. NO.

PART NO. 12839G

6 HLS. #6 X 32 TAP

4 HLS. 21/64" DRILL

6 HLS. #8 X 32 TAP

4 HLS. 17/64" DRILL

1 REQUIRED

OBSOLETE

SIZE	#12	ISSUE 4-9-40	HE.
KIND	ALUM. CASTING	CHANGED	
SHAPE		"	
FINISH	BLACK #80	"	
TEMP.		"	
PATT.	1538	"	

TITLE: FISCHER MOD. "100" X-RAY UNIT - TIMER ELECTRICAL UNIT MOUNTING BASE

H. G. FISCHER & CO.
2338 WABANSIA AVE.
CHICAGO, ILL.

CAT. NO.

PART NO. 13086F

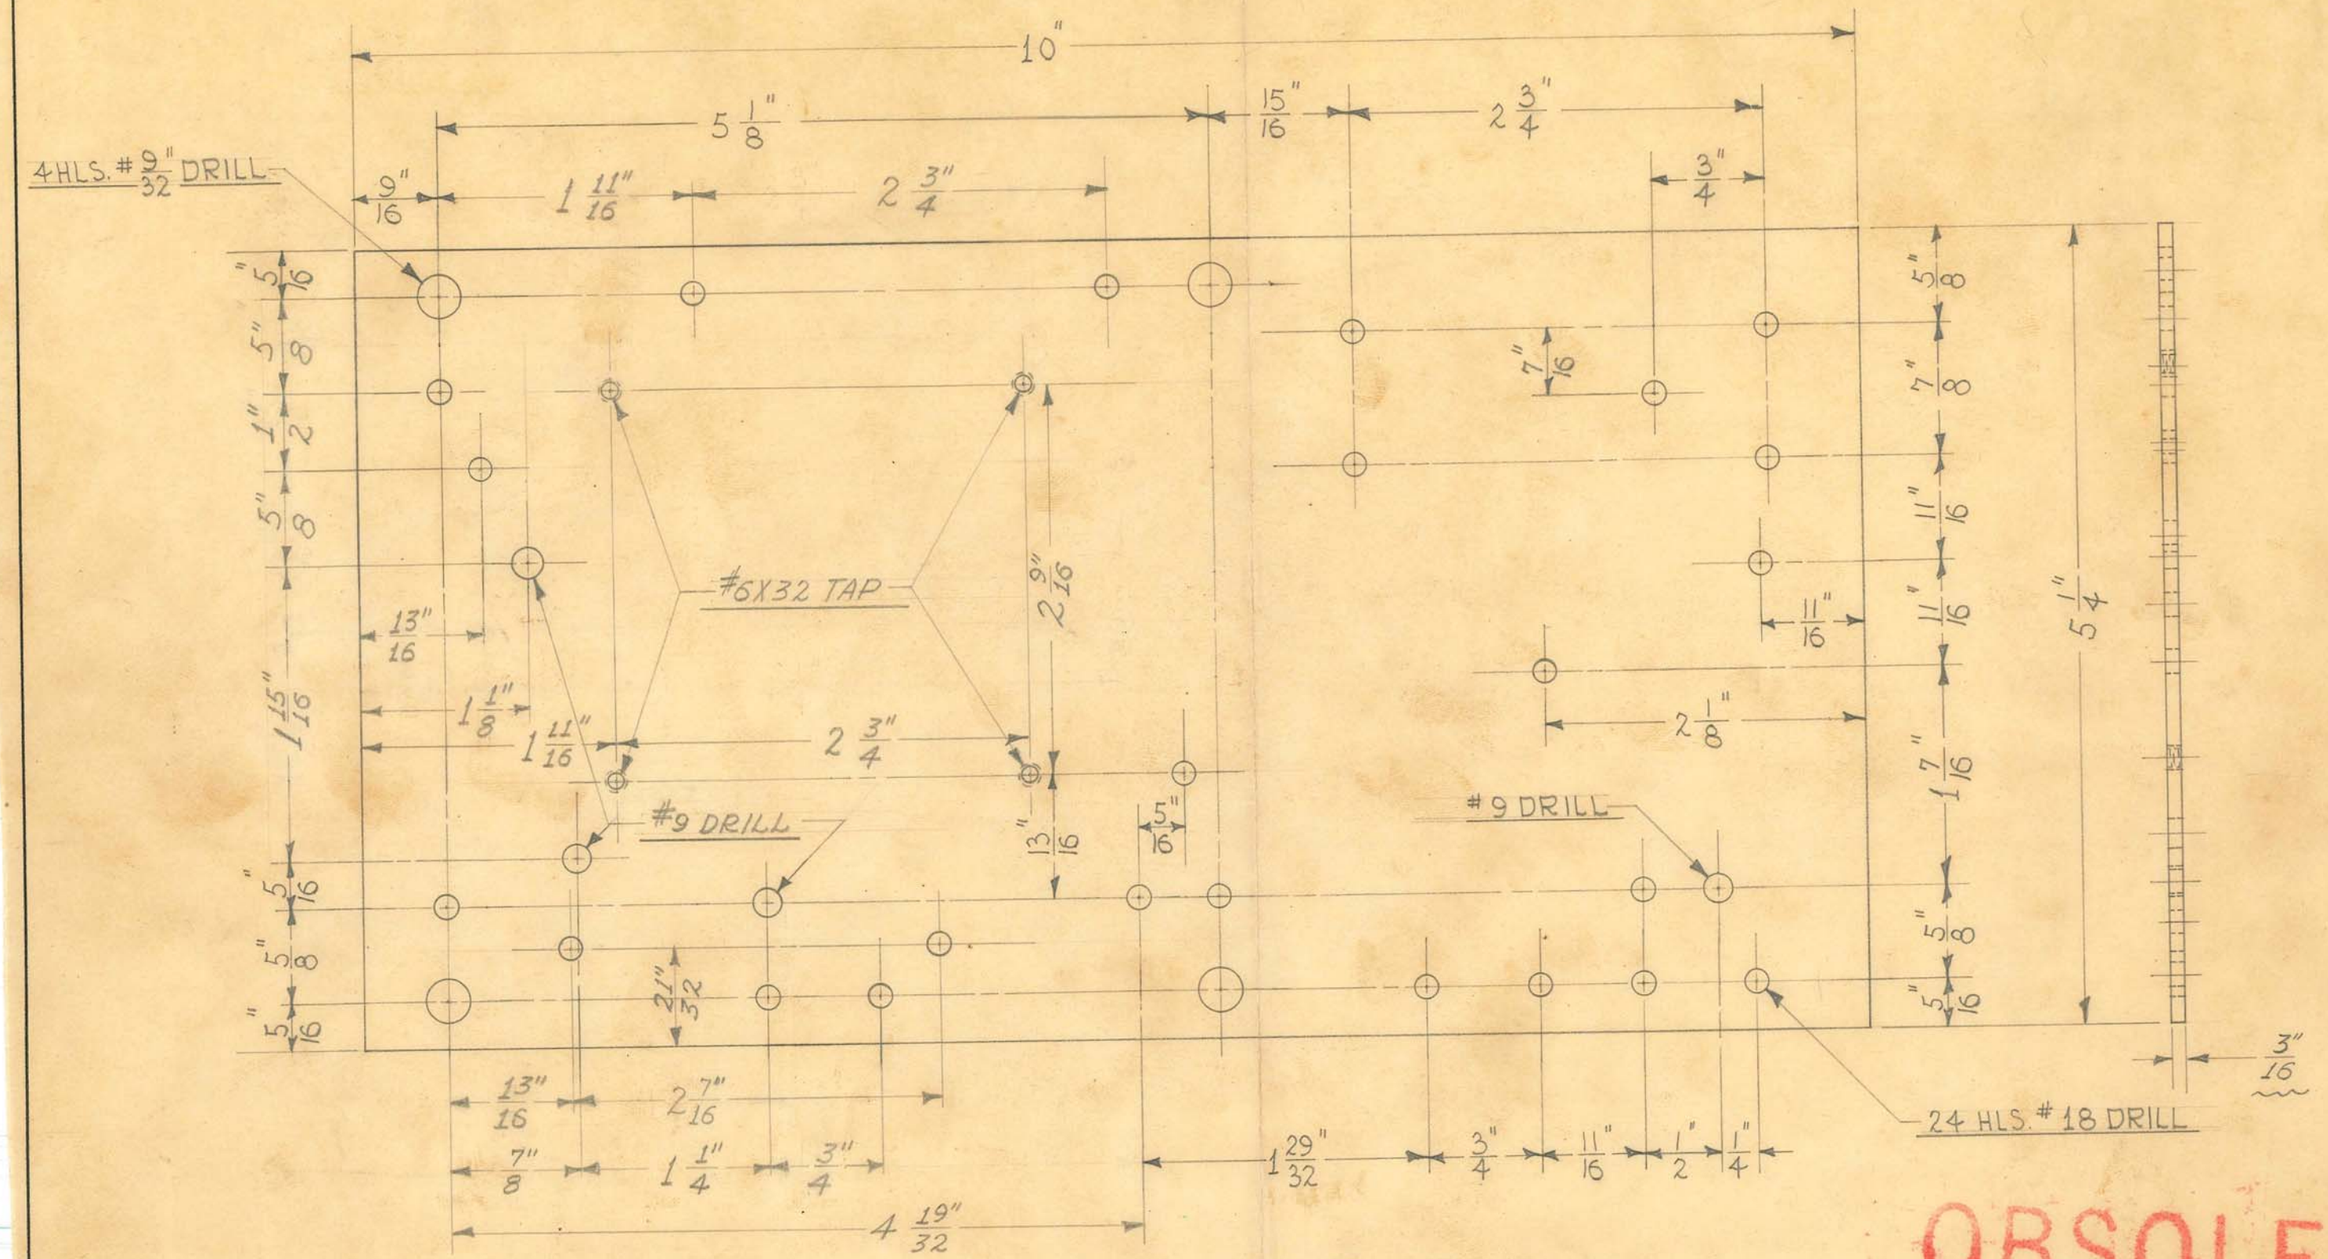

1 REQUIRED

OBSOLETE

SIZE	3/16" SHEET	ISSUE 4-8-40	HE.
KIND	BLK. BAKELITE	CHANGED	
SHAPE		"	
FINISH		"	
TEMP.		"	
PATT.		"	

TITLE: FISCHER MOD. "100" X-RAY UNIT REMOTE CONTROL-TIMER-TUBE SOCKET & RESISTOR MTG. BOARD

H. G. FISCHER & CO.
2335 WABANSIA AVE.
CHICAGO, ILL.

CAT. NO.

PART NO. 13087

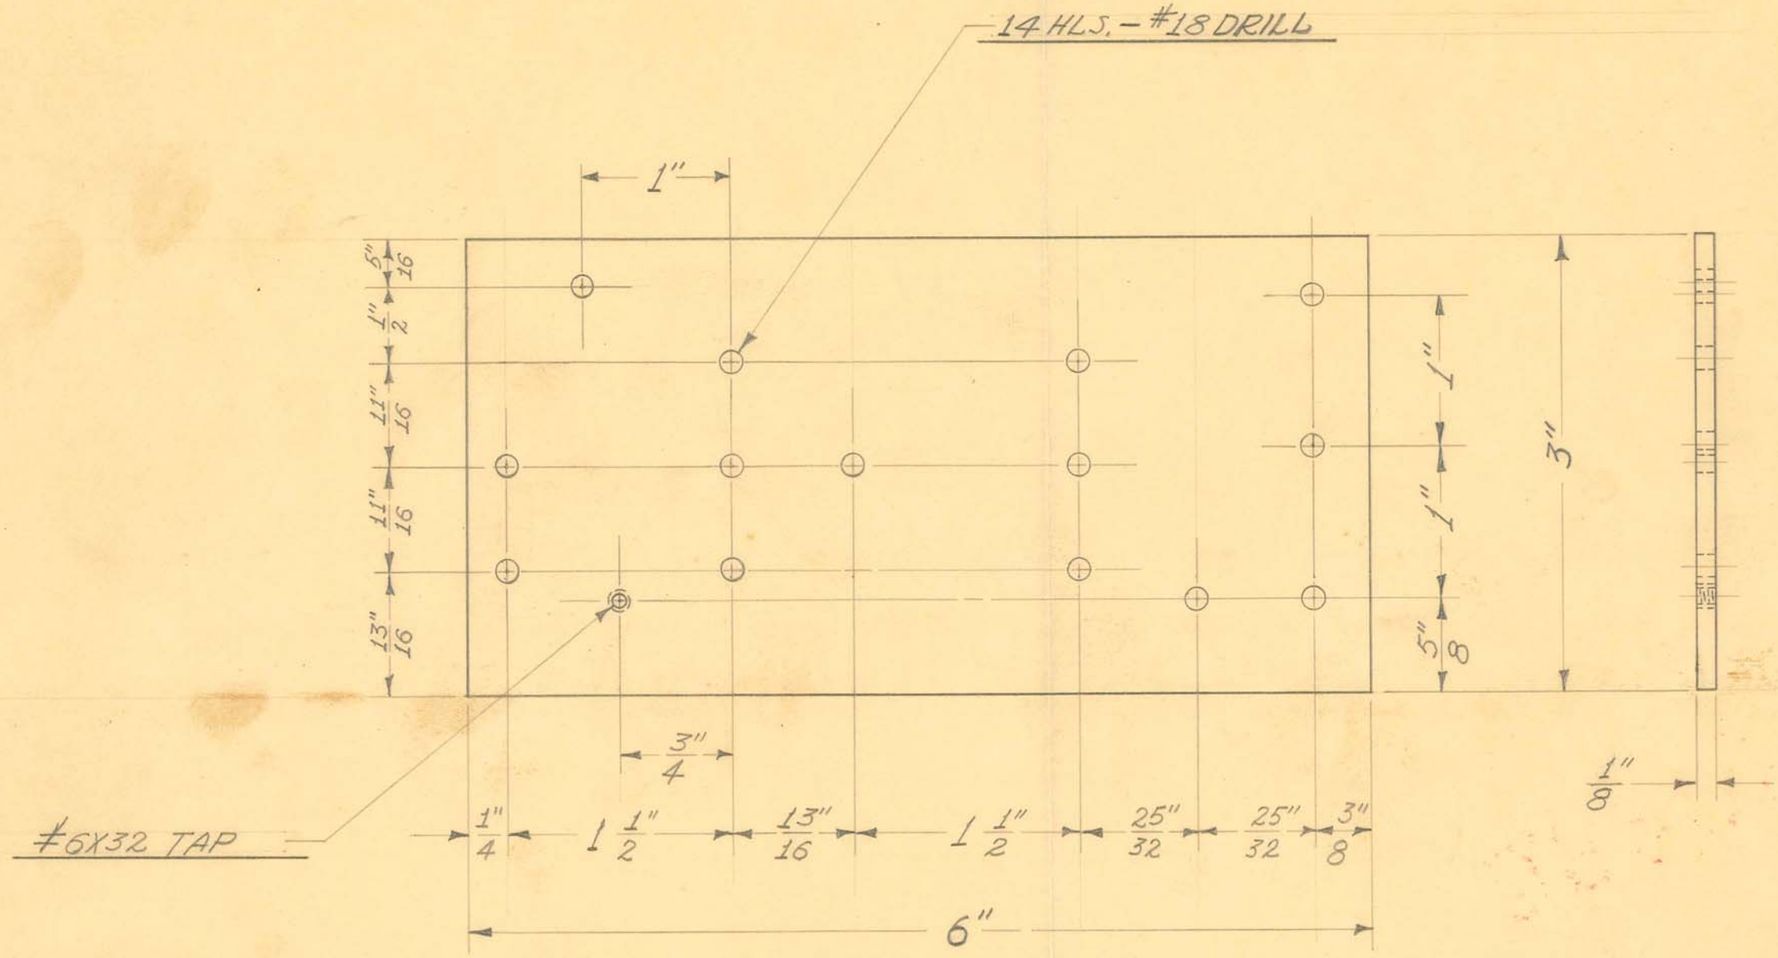

1 REQUIRED

OBSOLETE

SIZE	1/8" SHEET	ISSUE 6-10-40	J.W.
KIND	BLK. BAKELITE	CHANGED	
SHAPE		"	
FINISH		"	
TEMP.		"	
PATT.		"	

TITLE:
FISCHER MOD. "100" X-RAY UNIT
TIMER-RELAY MTG. & TERMINAL BOARD

H. G. FISCHER & CO.
2338 WABANSIA AVE.
CHICAGO, ILL.

CAT. NO.

PART NO. 13088

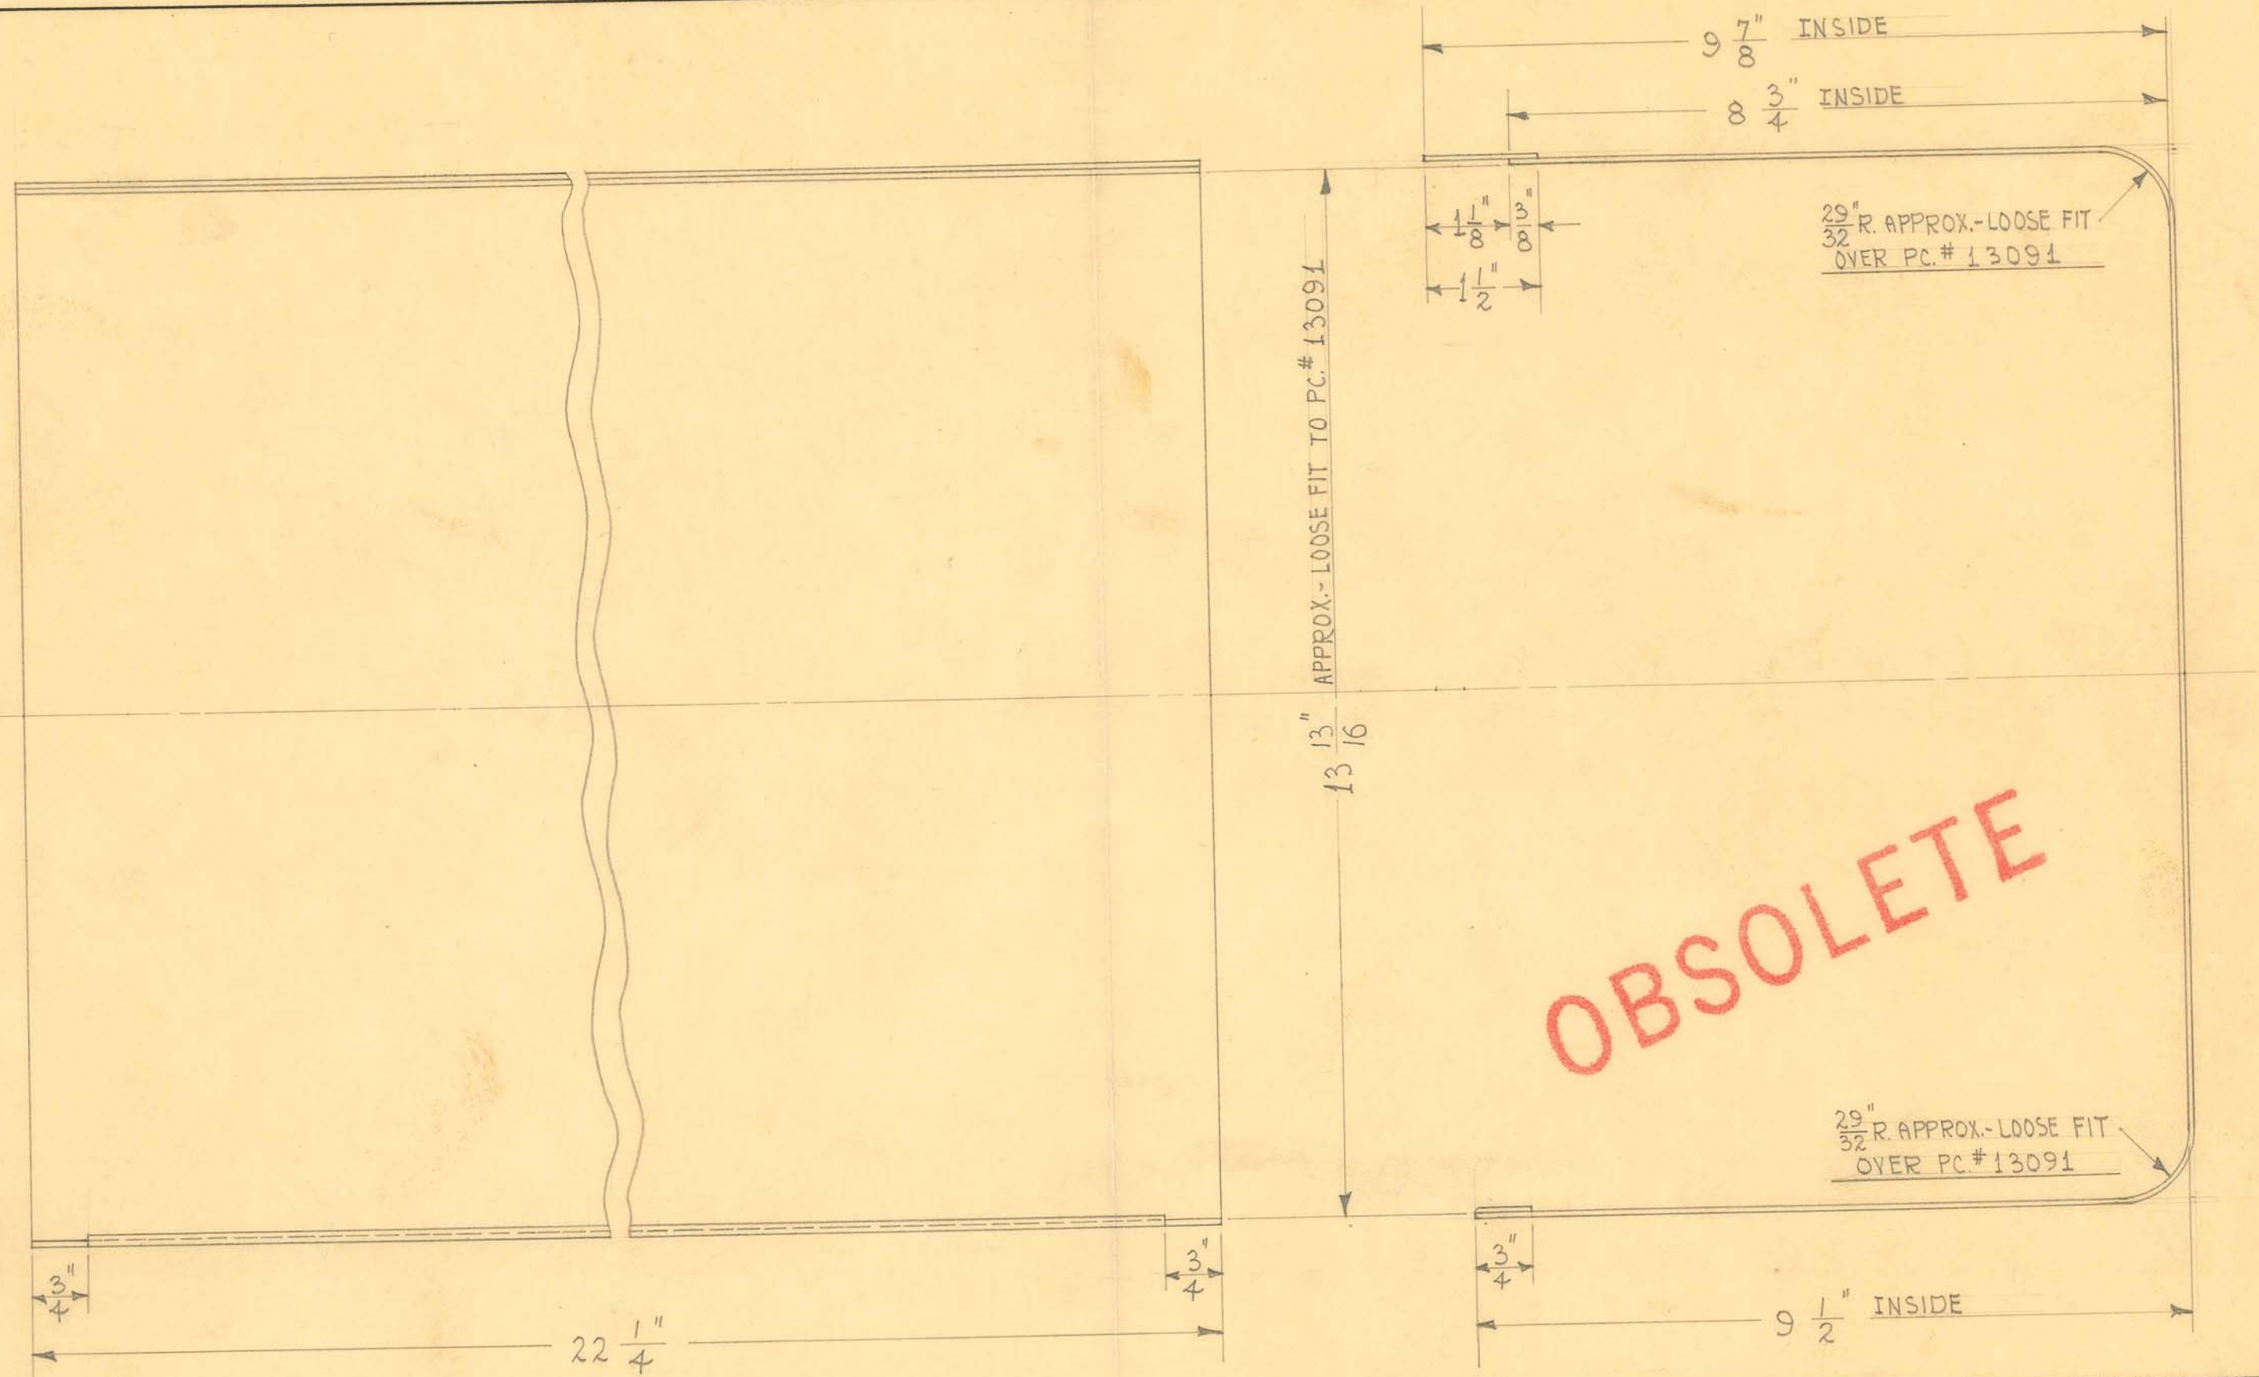

OBSOLETE

SCALE ÷ 1/2 = 1"

1 REQUIRED

SIZE	.0625"	ISSUE 6-10-40	HE.
KIND	C.R. STEEL	CHANGED	
SHAPE	SHEET	"	
FINISH		"	
TEMP.		"	
PATT.		"	

TITLE: FISCHER MOD. "100" X-RAY UNIT - CONTROL BOX COVER - FRONT

OBSOLETE

H. G. FISCHER & CO. 2335 WABANSIA AVE. CHICAGO, ILL.

CAT. NO.

PART NO. 13098

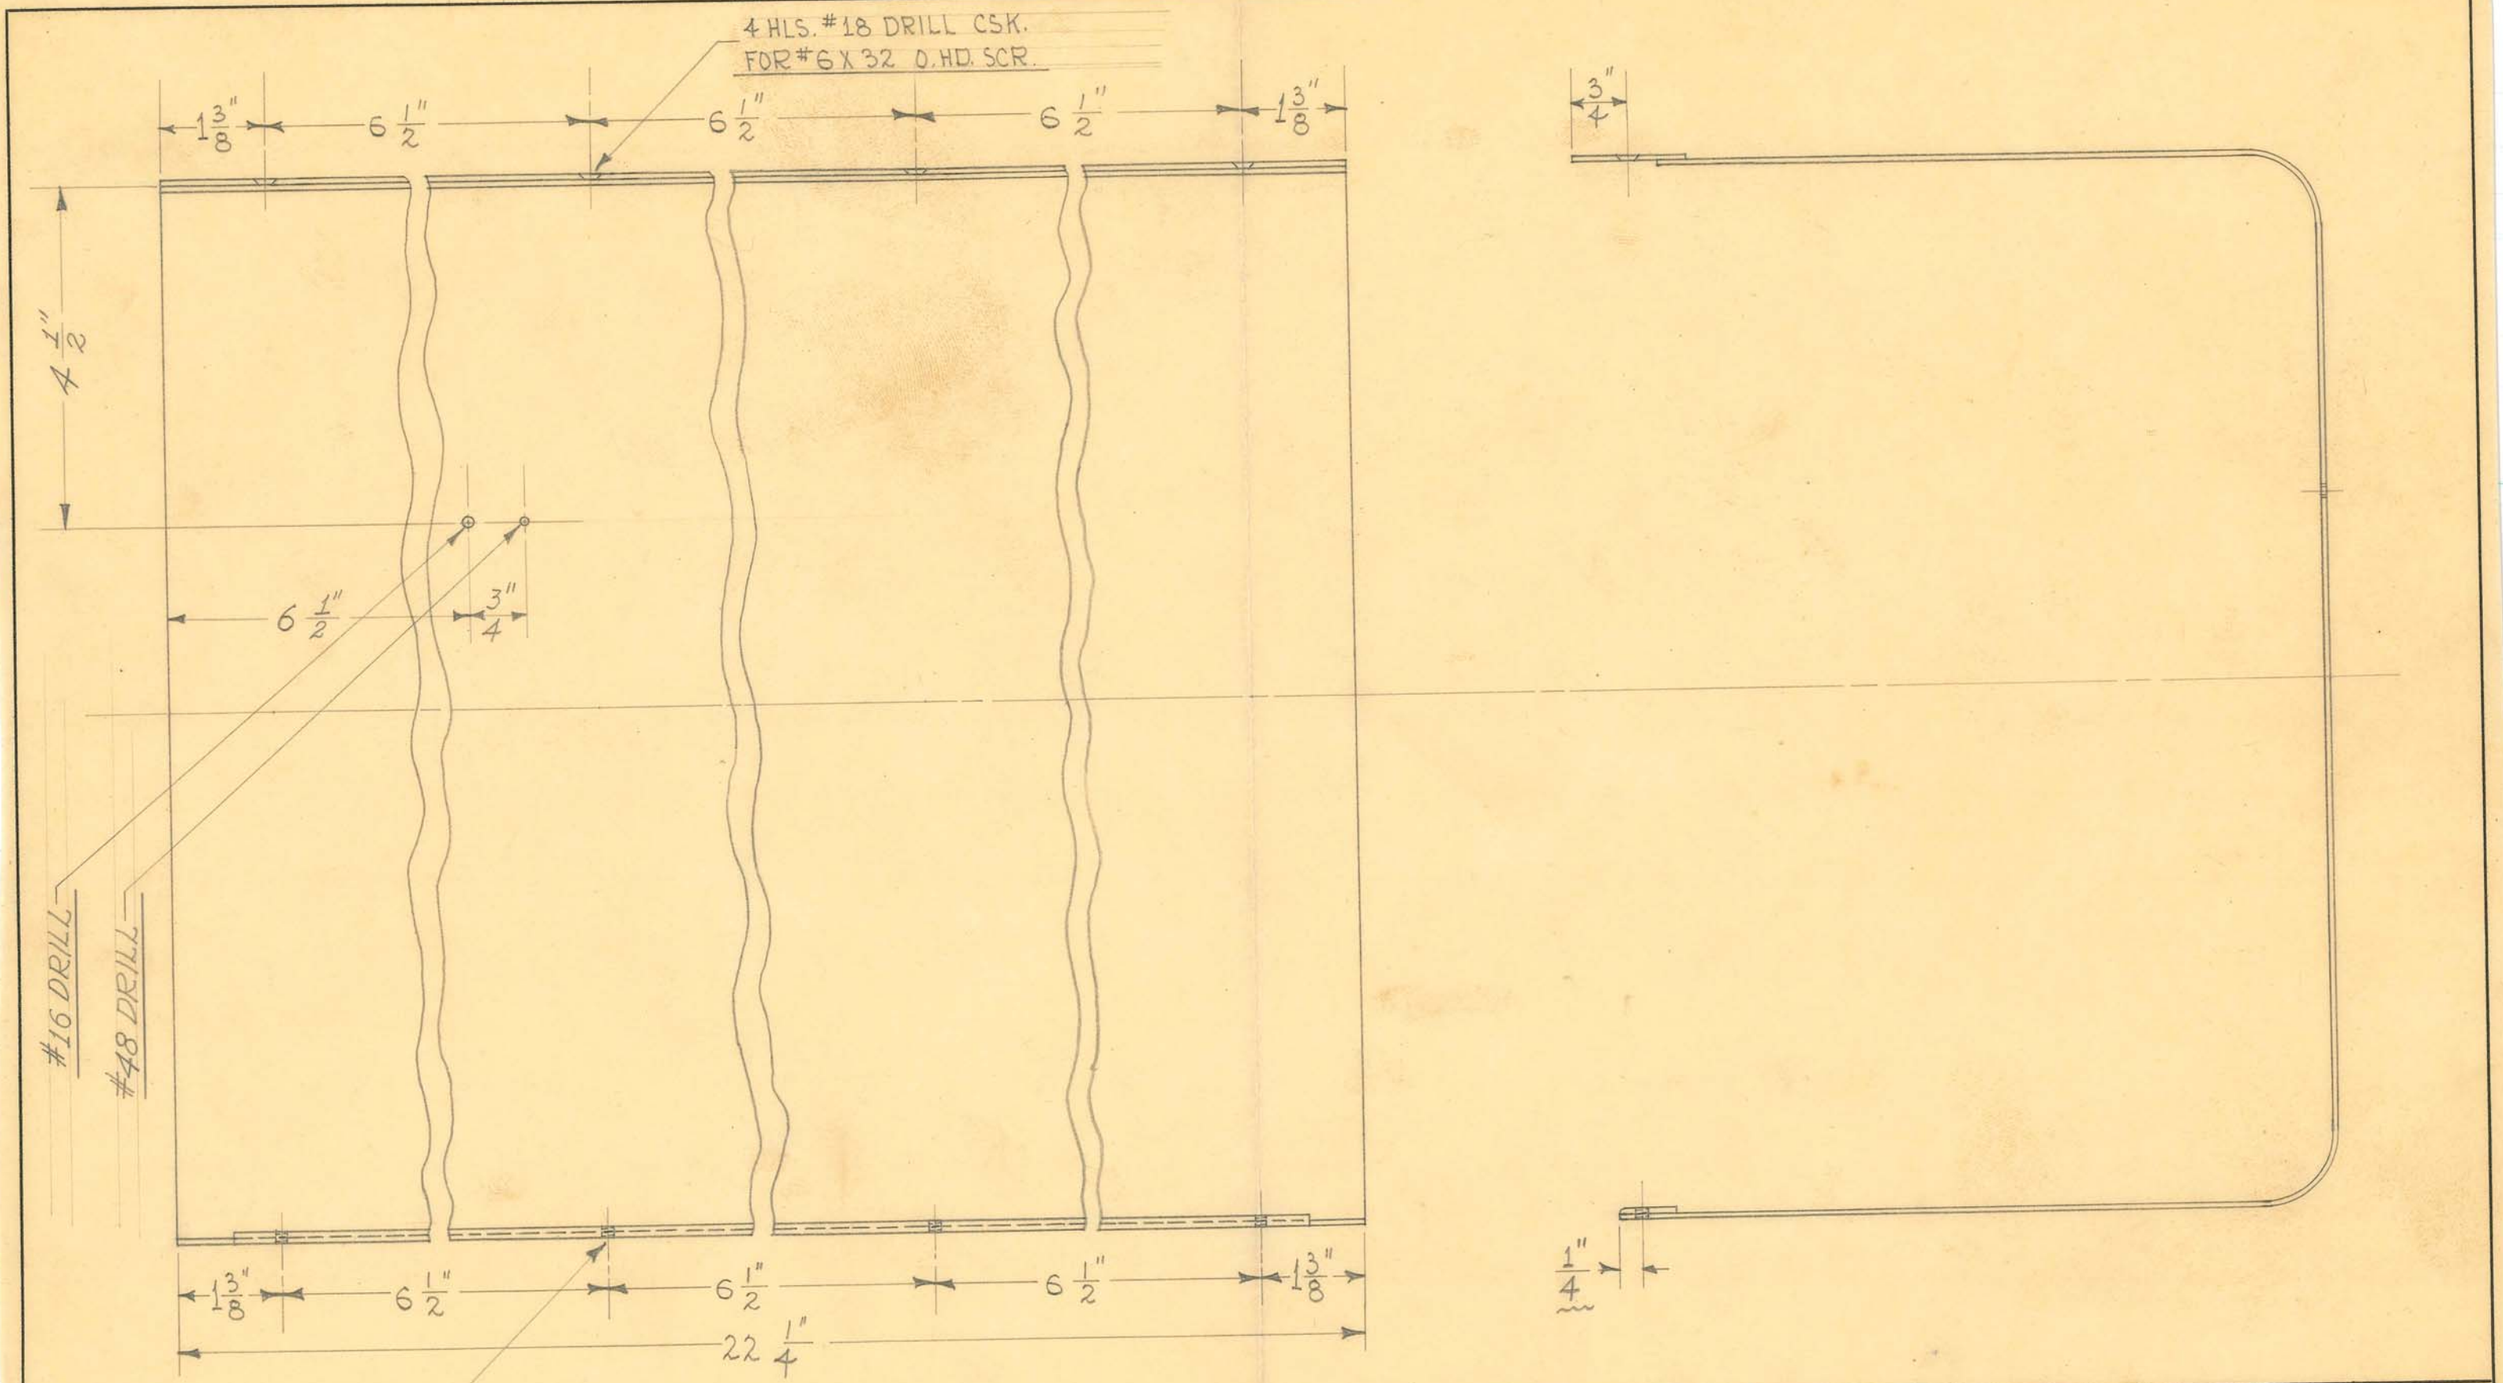

SCALE: 1/2" = 1"

1 REQUIRED

SIZE		ISSUE 6-10-40	HE.	
KIND		CHANGED		
SHAPE		"		
FINISH	PAINTED	"		
TEMP.		"		
PATT.		"		

TITLE: FISCHER MOD. "100" X-RAY UNIT - CONTROL BOX COVER FRONT (DRILLED)

OBSOLETE

H. G. FISCHER & CO.
2338 WABANSIA AVE.
CHICAGO, ILL.

CAT. NO.

PART NO. 13098F

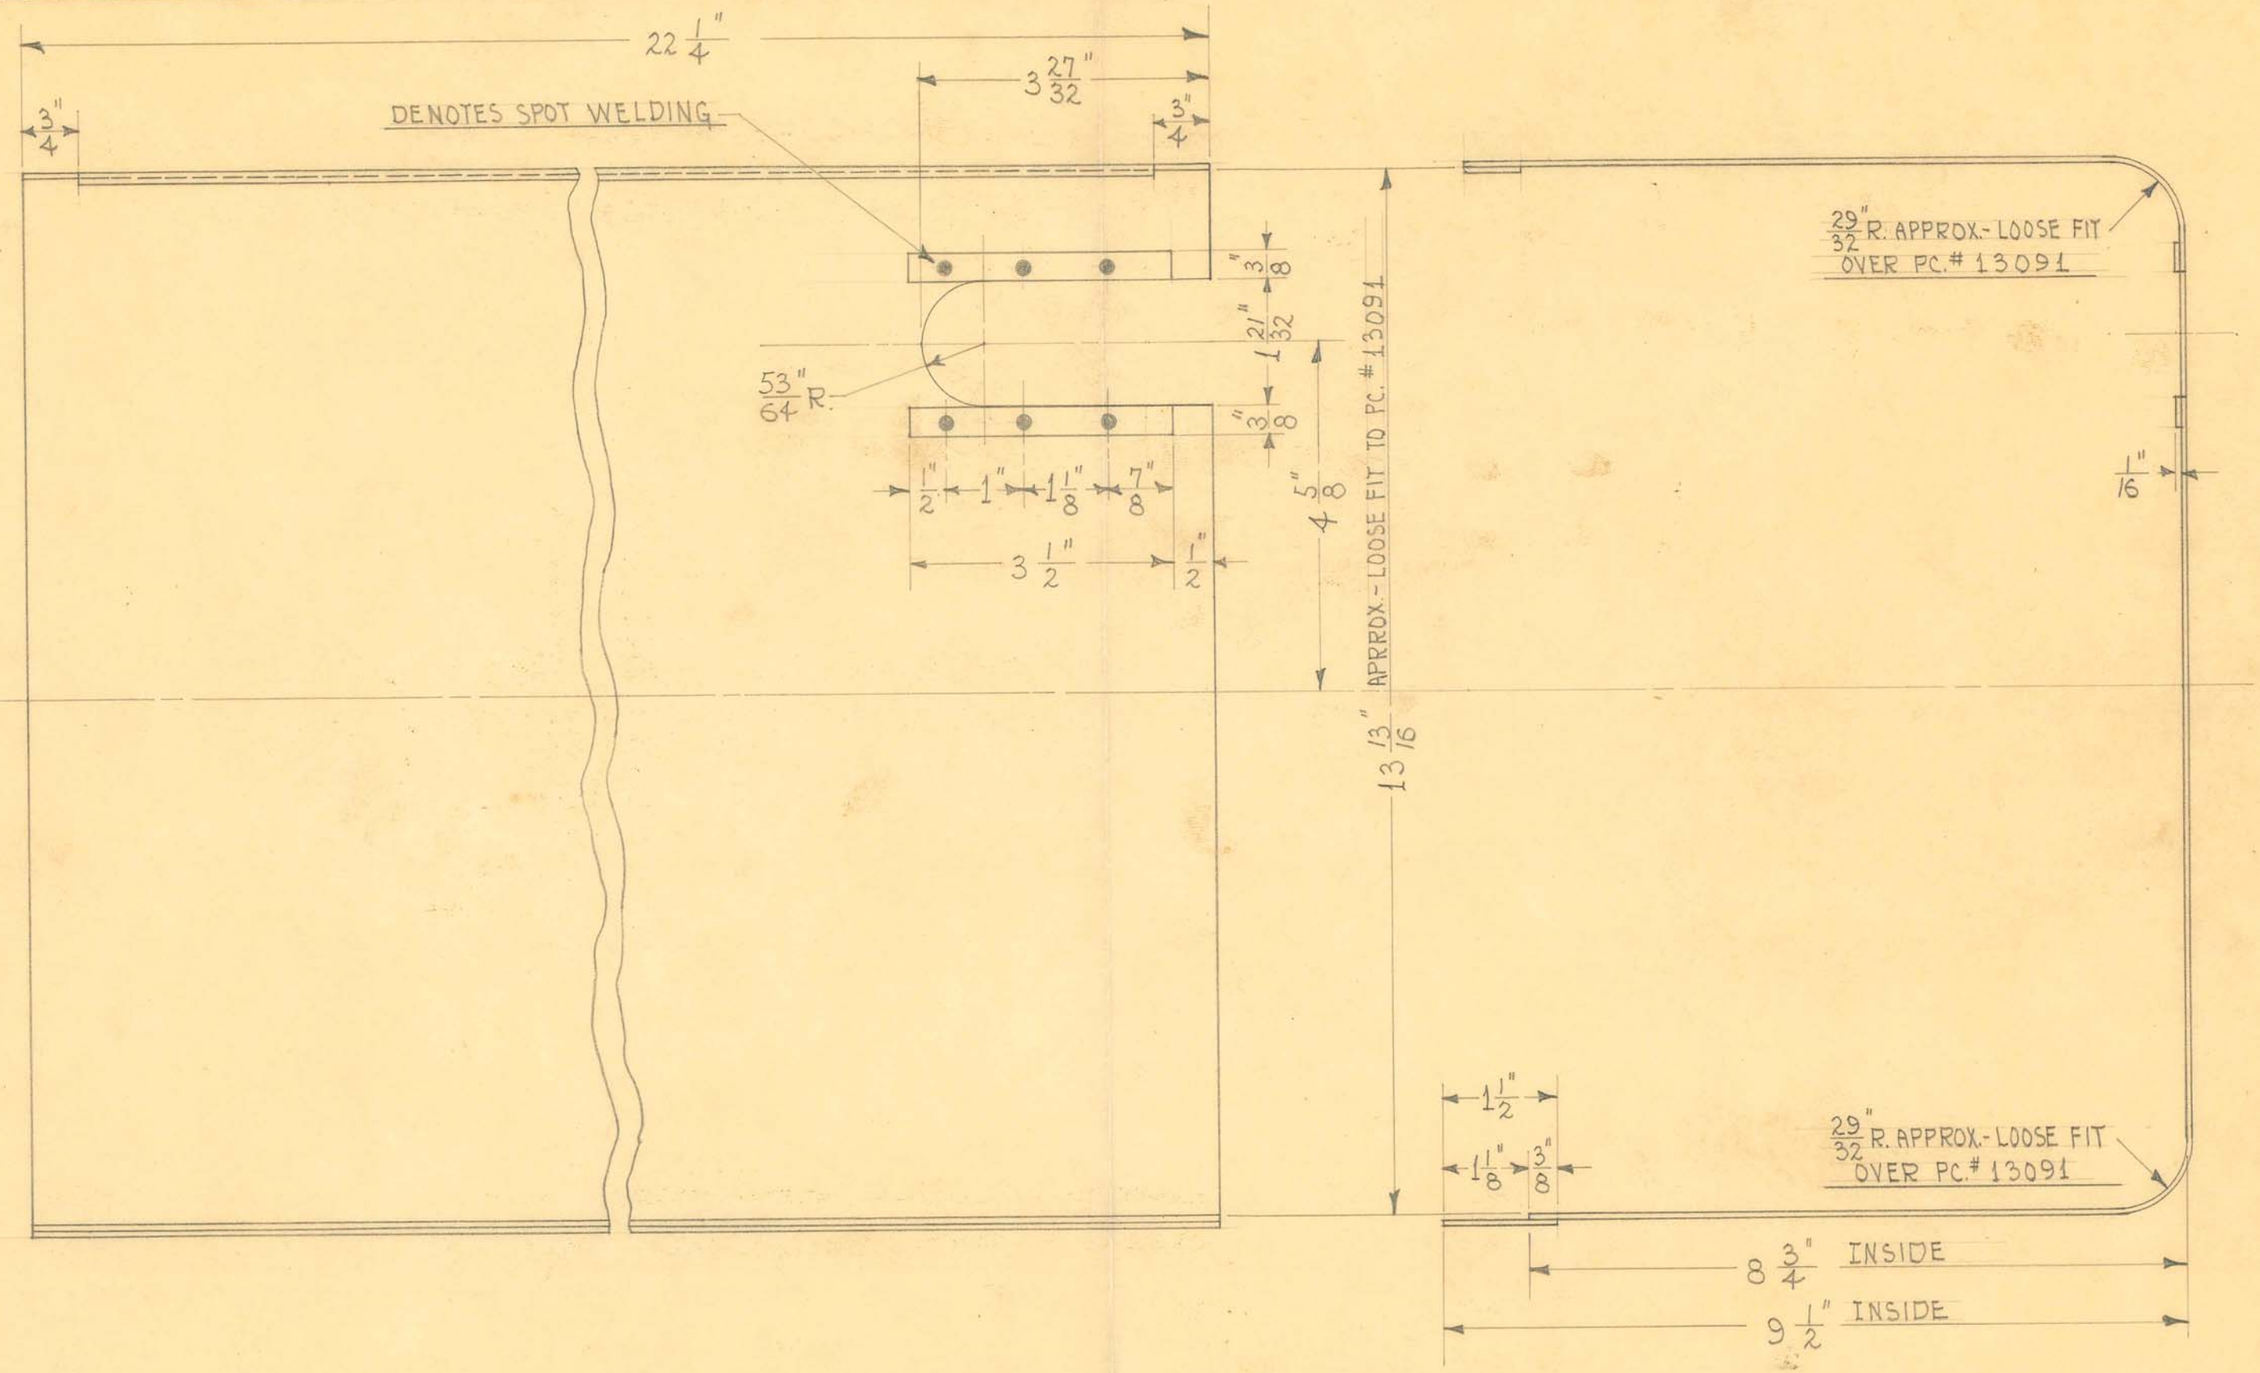

SCALE ÷ 1/2" = 1"

1 REQUIRED

SIZE	.0625"	ISSUE 6-10-40	H.
KIND	C.R. STEEL	CHANGED	
SHAPE	SHEET	"	
FINISH		"	
TEMP.		"	
PATT.		"	

TITLE: FISCHER MOD. "100" X-RAY UNIT- CONTROL BOX COVER-REAR

OBSOLETE

H. G. FISCHER & CO.
2335 WABANSIA AVE.
CHICAGO, ILL.

CAT. NO.

PART NO. 13099

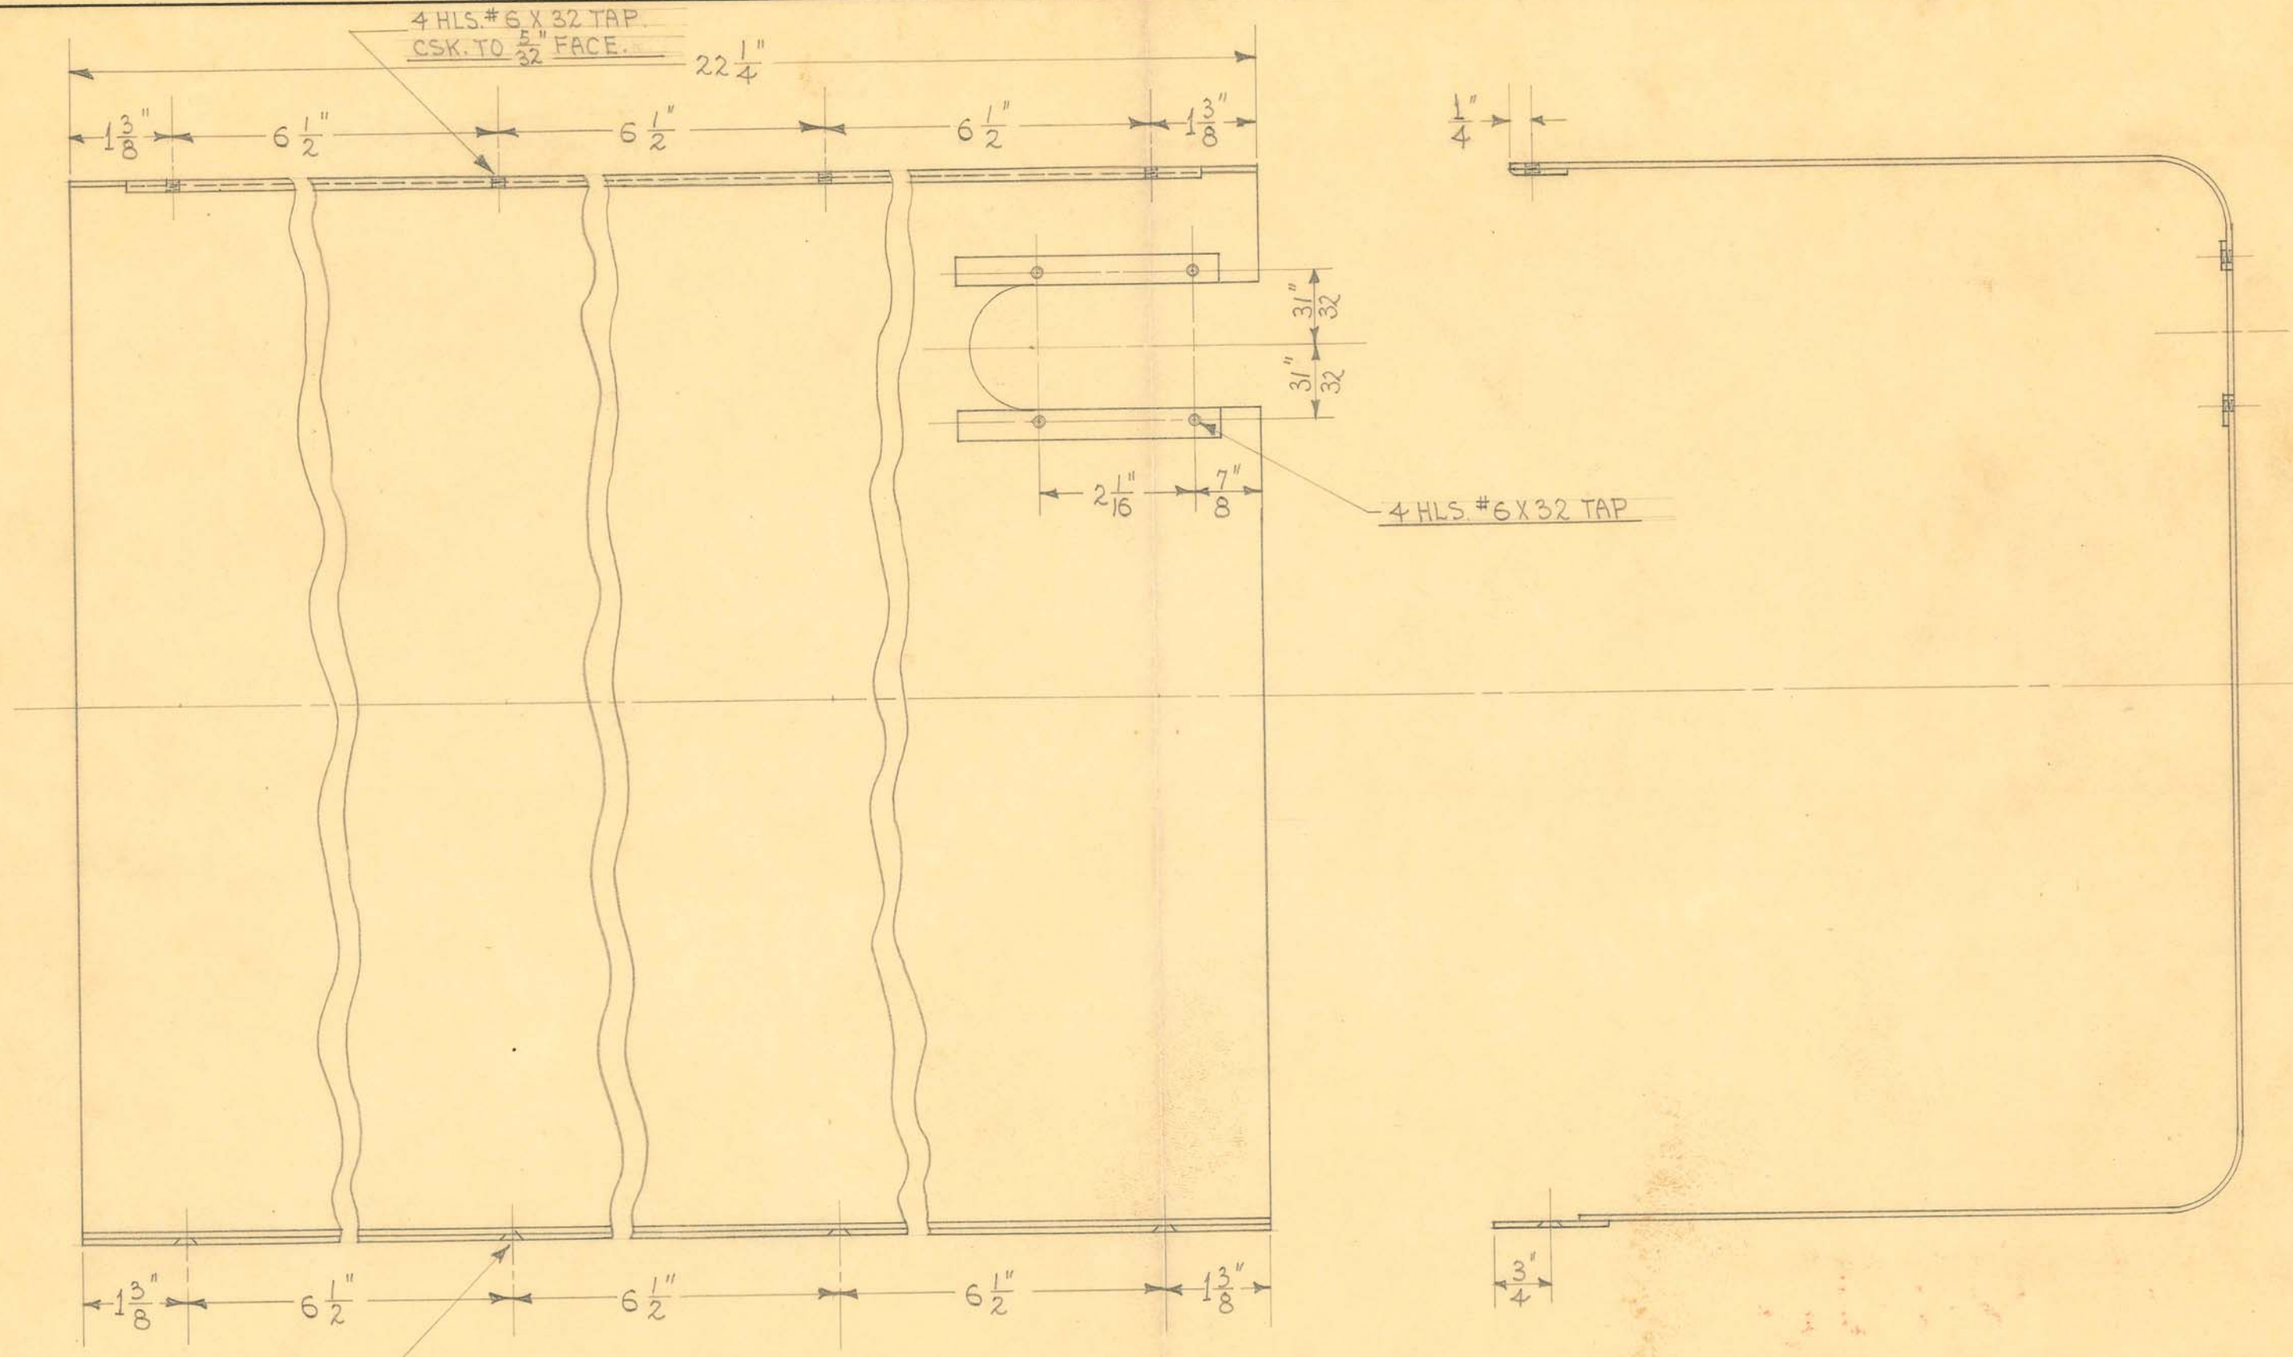

SCALE ÷ 1/2" = 1"

1 REQUIRED

SIZE		ISSUE 6-10-40	E
KIND		CHANGED	
SHAPE		"	
FINISH	PAINTED	"	
TEMP.		"	
PATT.		"	

TITLE: FISCHER MOD. "100" X-RAY UNIT-
CONTROL BOX COVER-REAR (DRILLED)

OBSOLETE

H. G. FISCHER & CO.
2335 WABANSIA AVE.
CHICAGO. ILL.

CAT. NO.

PART NO. 13099F

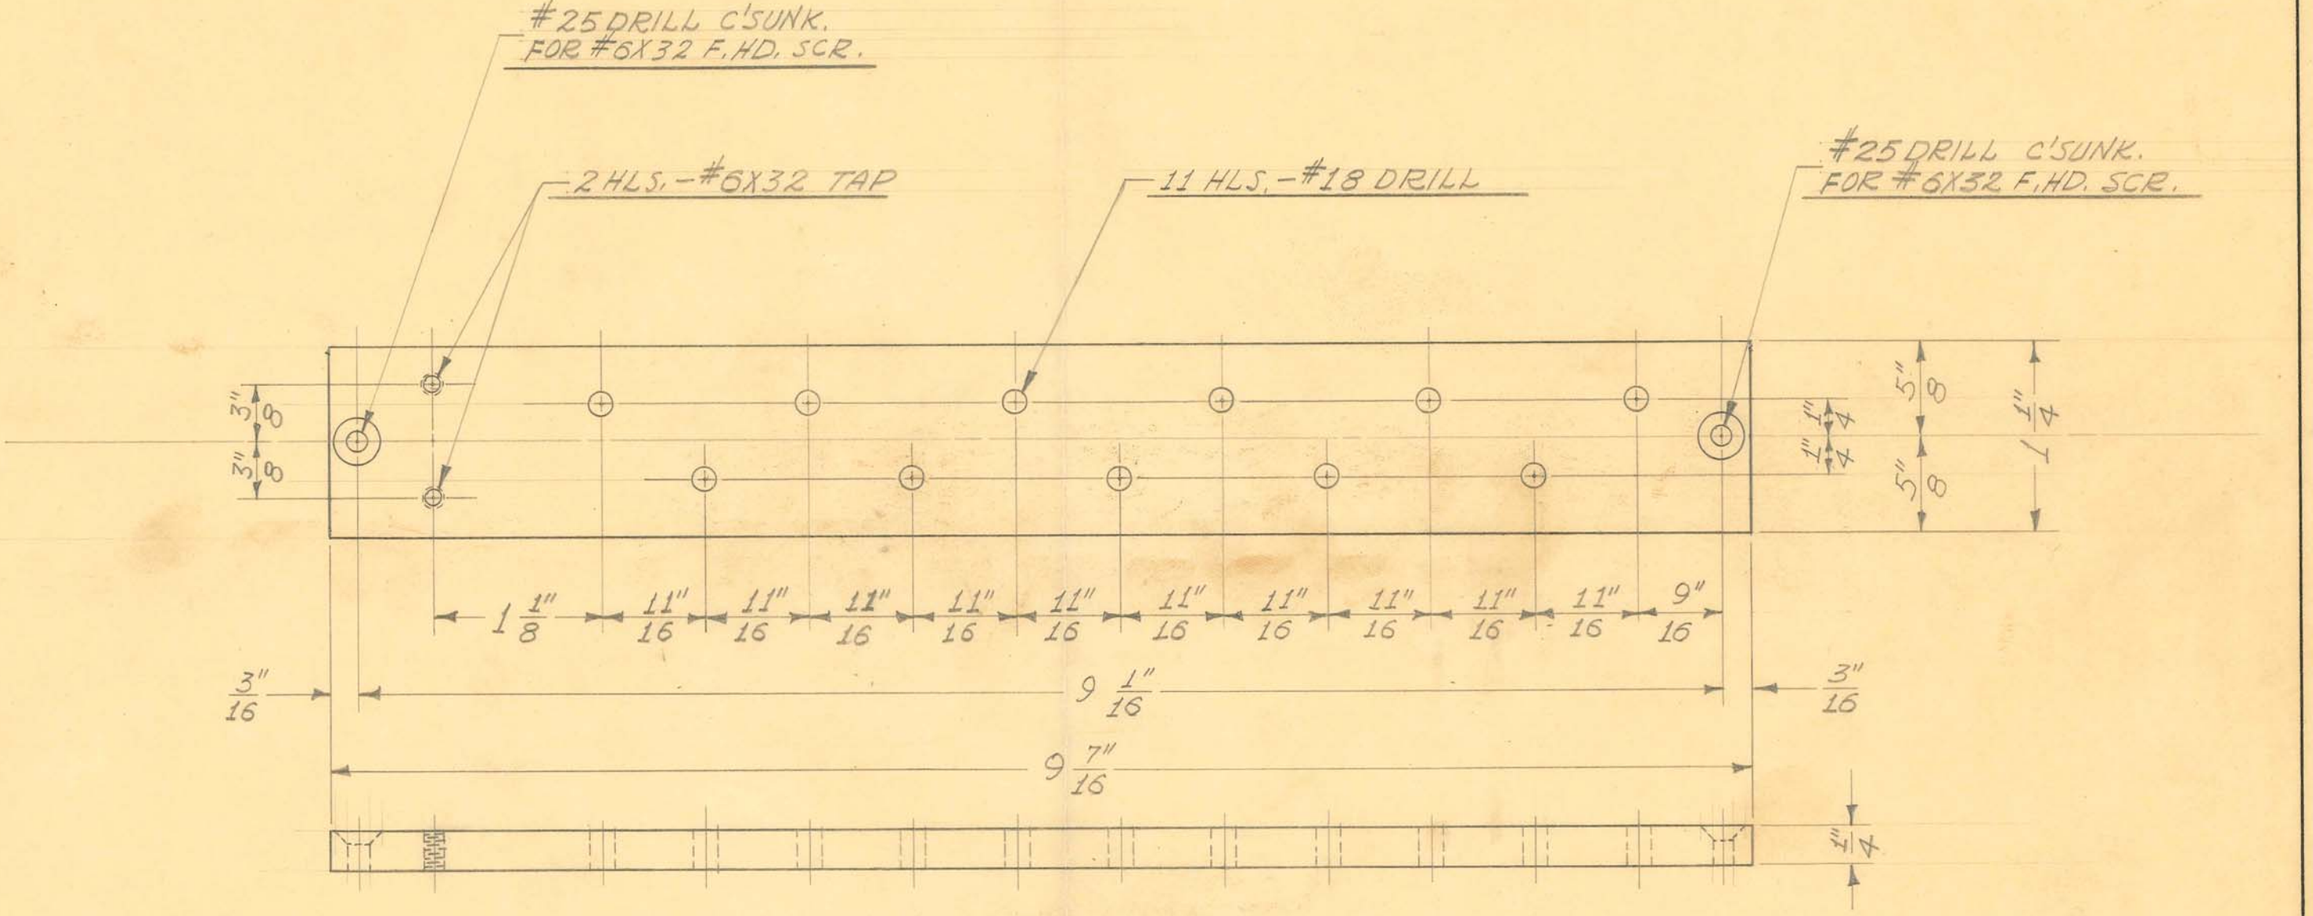

1 REQUIRED

OBSOLETE

SIZE	1/4" SHEET	ISSUE 6-27-40	J.W.
KIND	BLK. BAKELITE	CHANGED	
SHAPE		"	
FINISH		"	
TEMP.		"	
PATT.		"	

TITLE:
FISCHER MOD. "100" X-RAY UNIT
TIMER-CONTROL CASE TERMINAL BOARD

H. G. FISCHER & CO.
2335 WABANSIA AVE.
CHICAGO, ILL.

CAT. NO.

PART NO. 13110

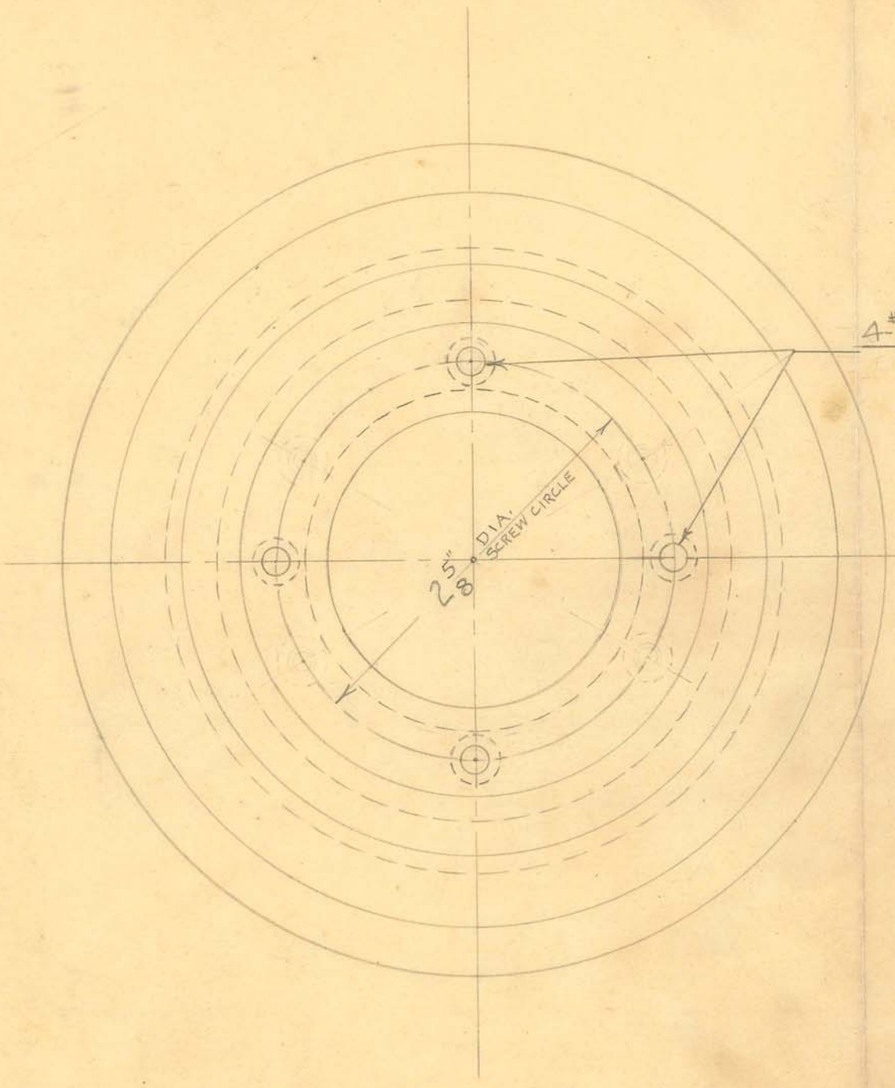

1 REQUIRED

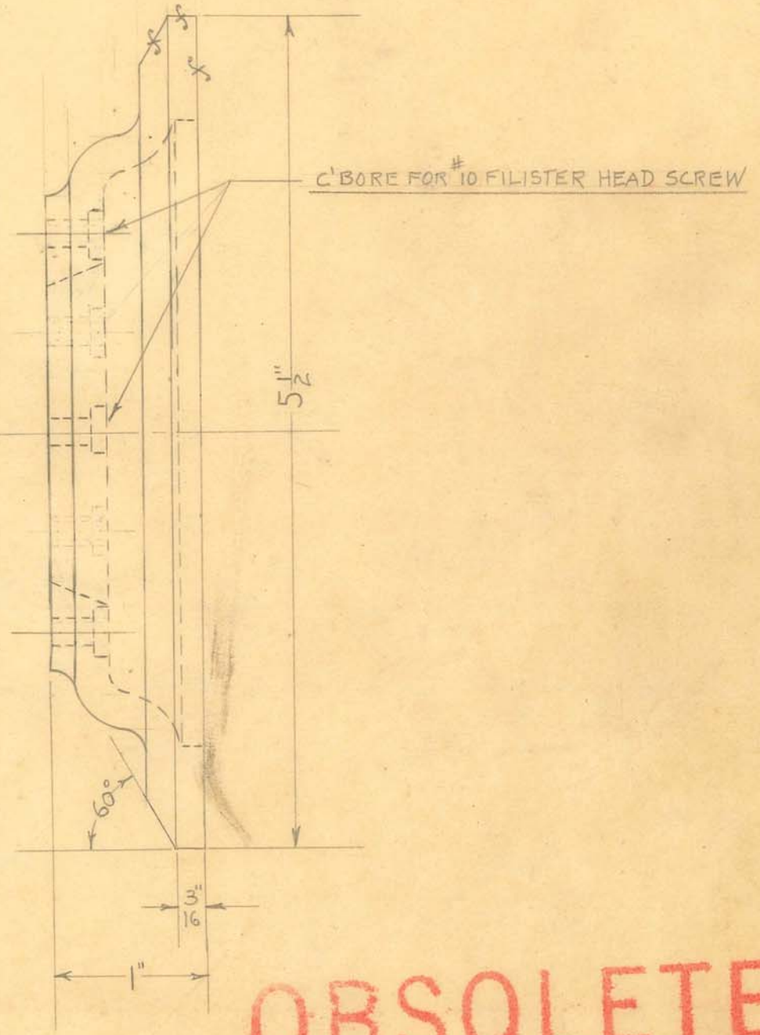

OBSOLETE

SIZE		ISSUE 62-40	C.E.A.
KIND	DOW METAL	CHANGED	
SHAPE	CASTING	"	
FINISH	PAINT	"	
TEMP.		"	
PATT.	1508	"	

TITLE: FISCHER MOD. "100" X-RAY UNIT
X-RAY TUBE ADAPTER

H. G. FISCHER & CO.
2335 WABANSIA AVE.
CHICAGO, ILL.

CAT. NO.

PART NO. 13112F

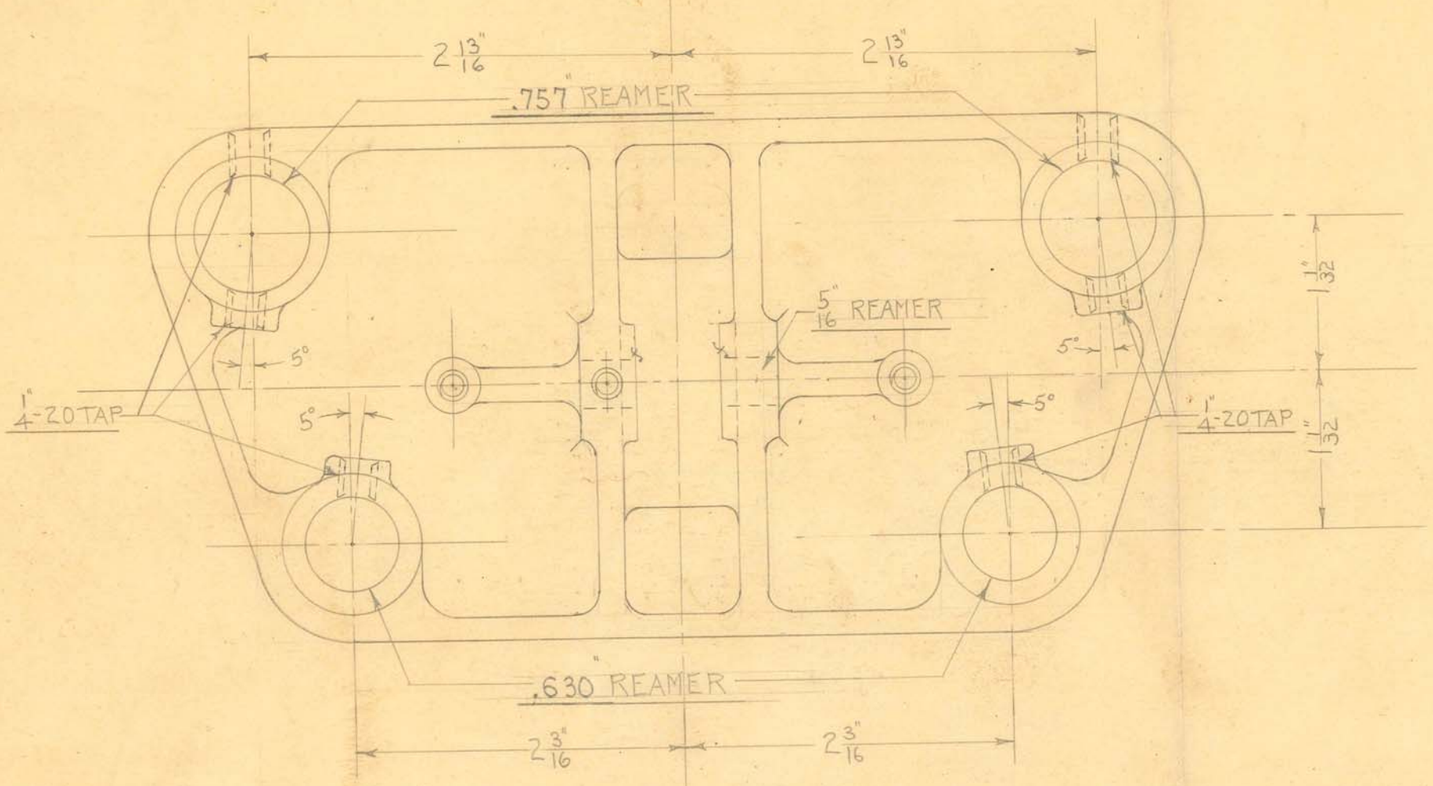

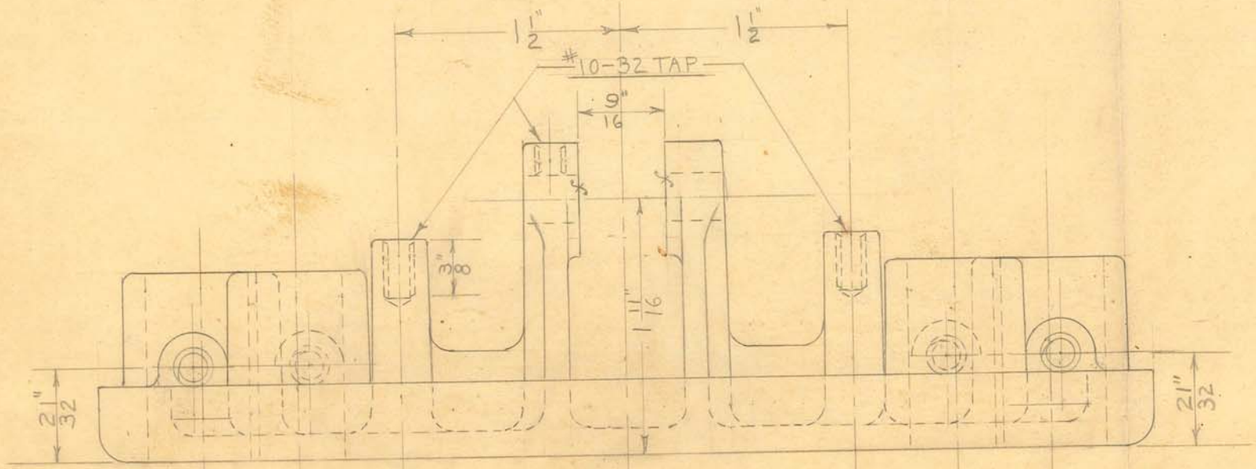

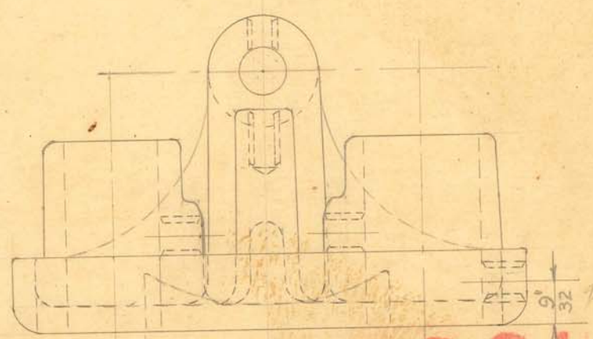

1 REQUIRED

OBSOLETE

SIZE		ISSUE 5-21-40	C.E.A.
KIND	DOW-METAL	CHANGED	
SHAPE		"	
FINISH	PAINTED	"	
TEMP.		"	
PATT.	1509	"	

TITLE: FISCHER MOD. "100" UNIT
SCREEN COUNTERBALANCE PULLEY SUPPORT - UPPER

H. G. FISCHER & CO.
2335 WABANSIA AVE.
CHICAGO, ILL.

CAT. NO.

PART NO. 13113F

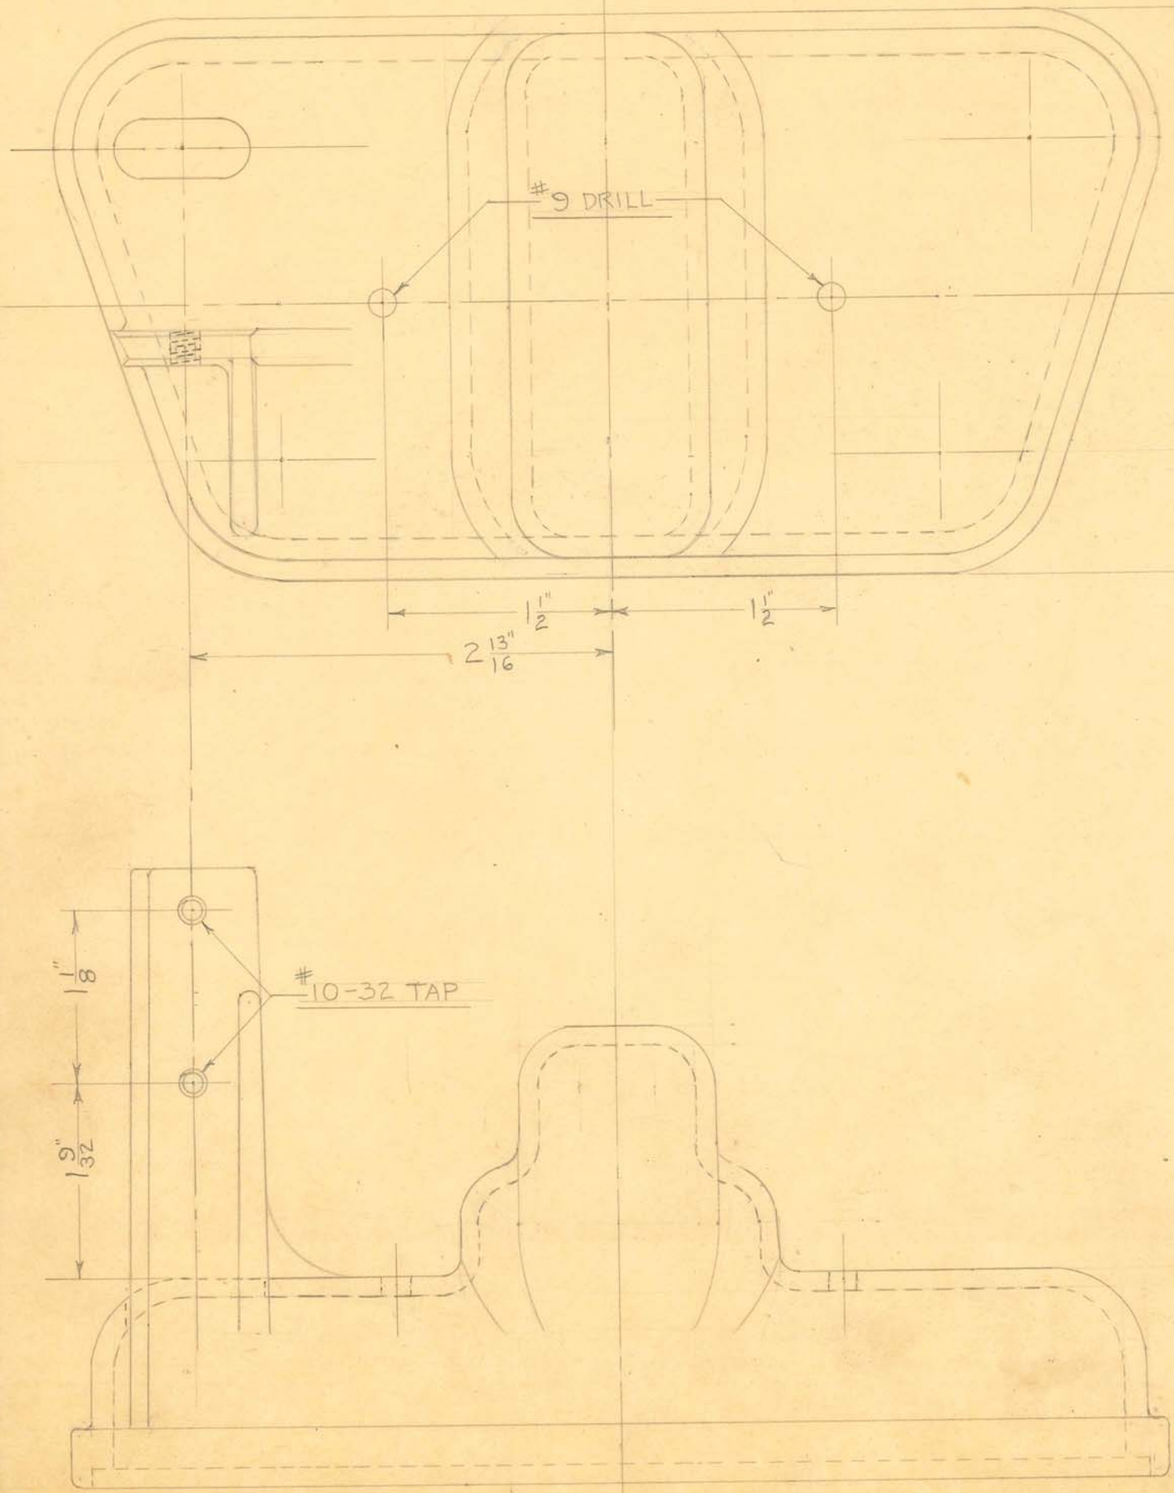

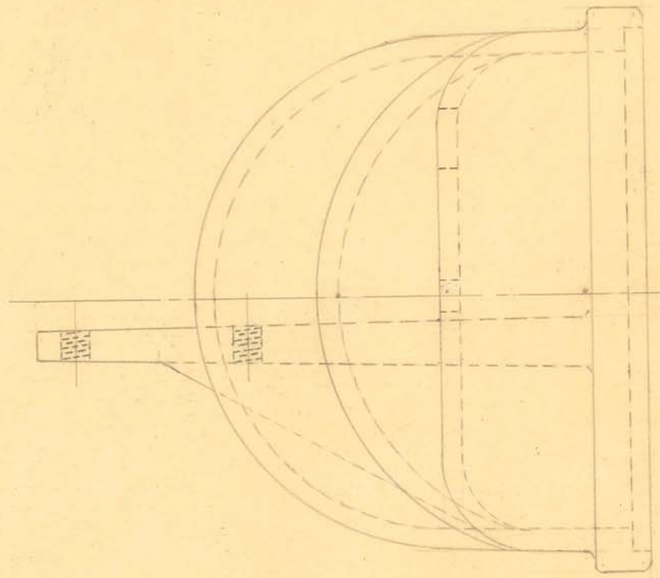

OBSOLETE

SIZE		ISSUE 5-22-40	C.E.A.	TITLE: FISCHER MOD. "100" UNIT SCREEN COUNTERBALANCE PULLEY SUPPORT - CAP
KIND	#12 ALUM.	CHANGED		
SHAPE		"		
FINISH	PAINTED	"		
TEMP.		"		
PATT.	1510	"		

H. G. FISCHER & CO.
2335 WABANSIA AVE.
CHICAGO, ILL.

CAT. NO.

PART NO. 13114F

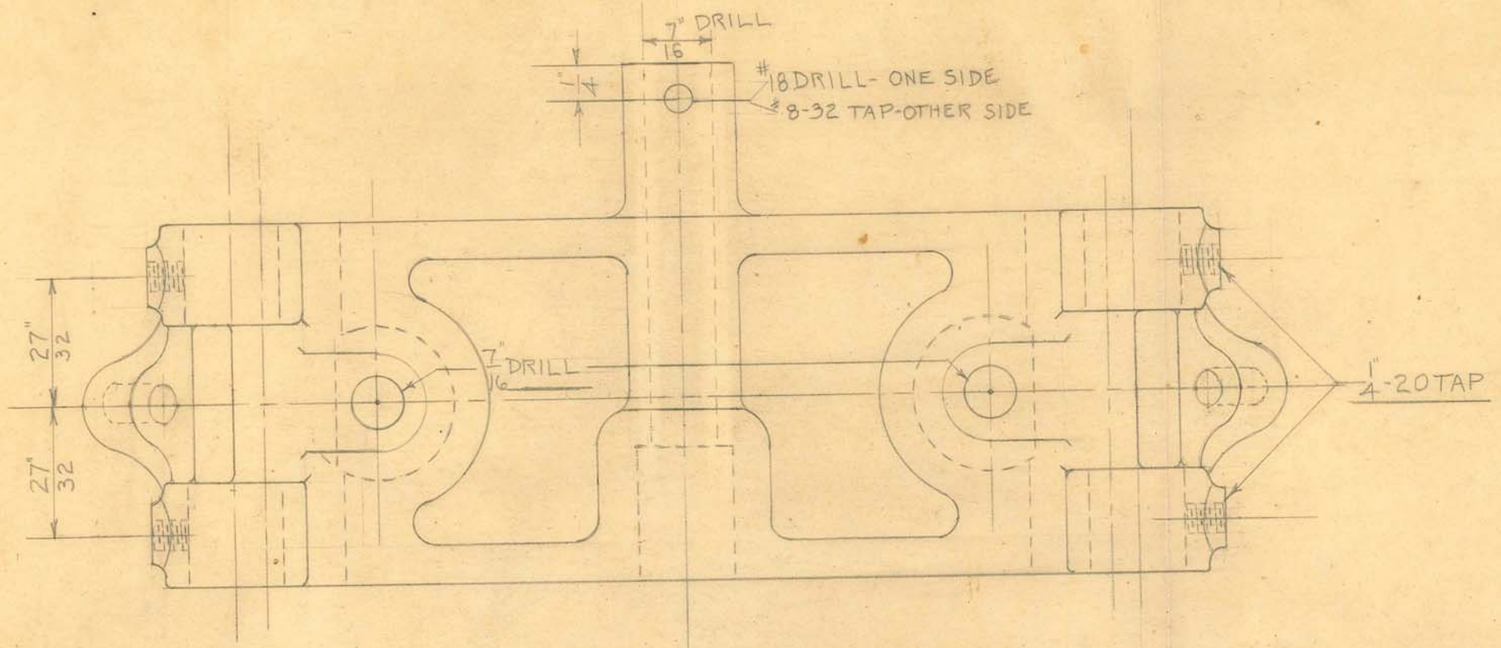

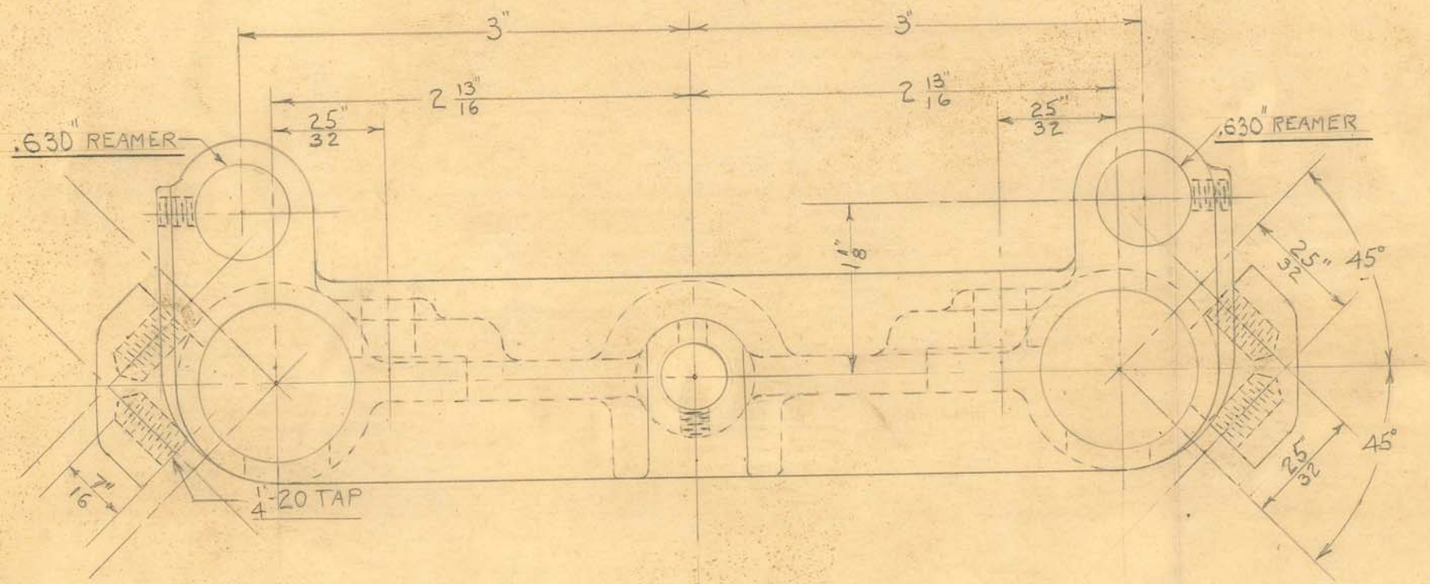

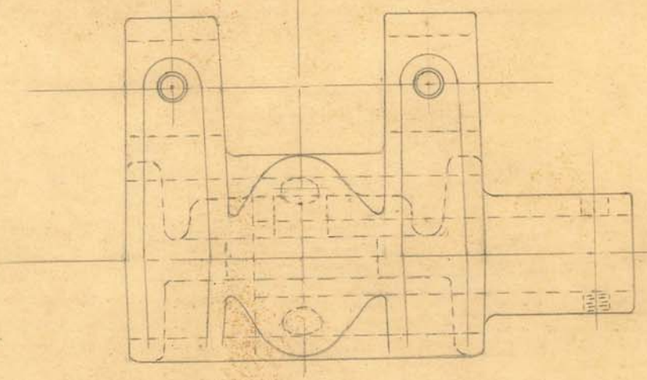

1 REQUIRED

OBSOLETE

SIZE		ISSUE 5-15-40	CEA
KIND	DOW-METAL	CHANGED	
SHAPE		"	
FINISH	PAINTED	"	
TEMP.		"	
PATT.	#1512	"	

TITLE: FISCHER MODEL "100" UNIT
SCREEN SLIDE - LOWER-

H. G. FISCHER & CO.
2335 WABANSIA AVE.
CHICAGO, ILL.

CAT. NO.

PART NO. 13117F

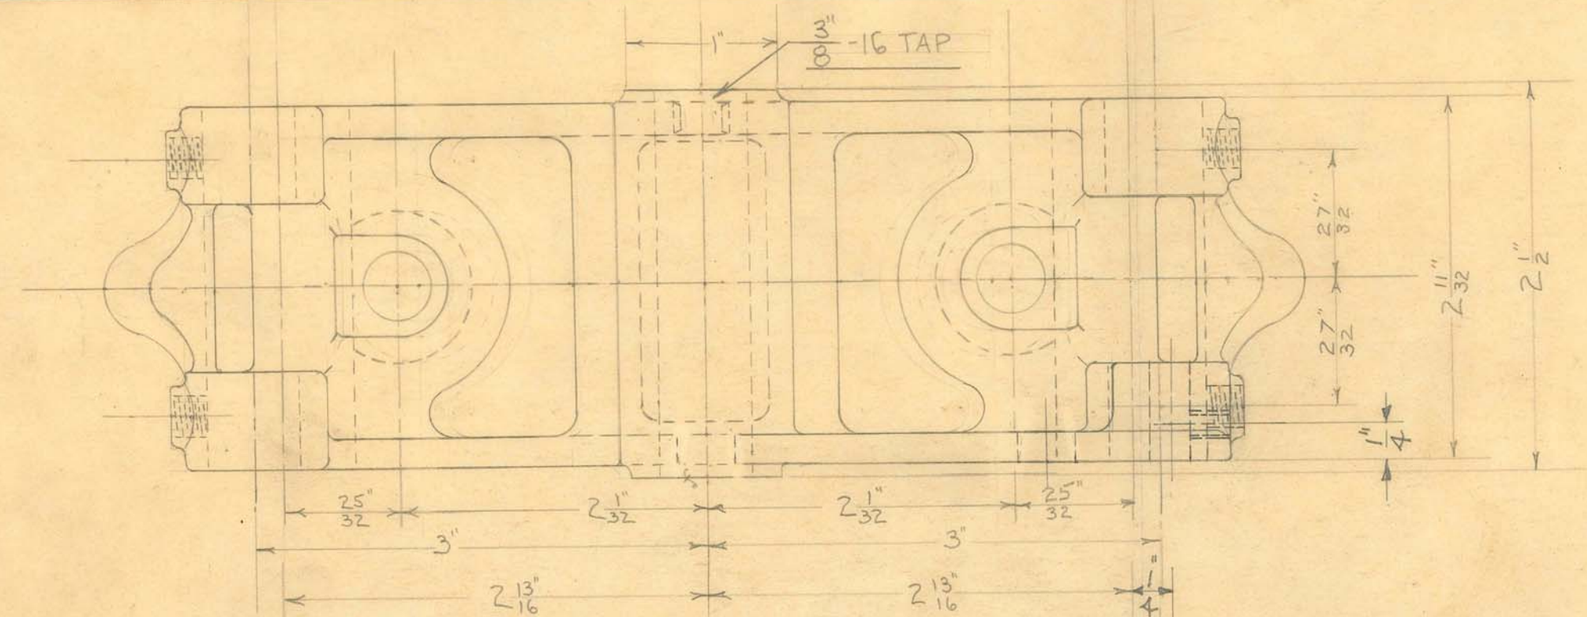

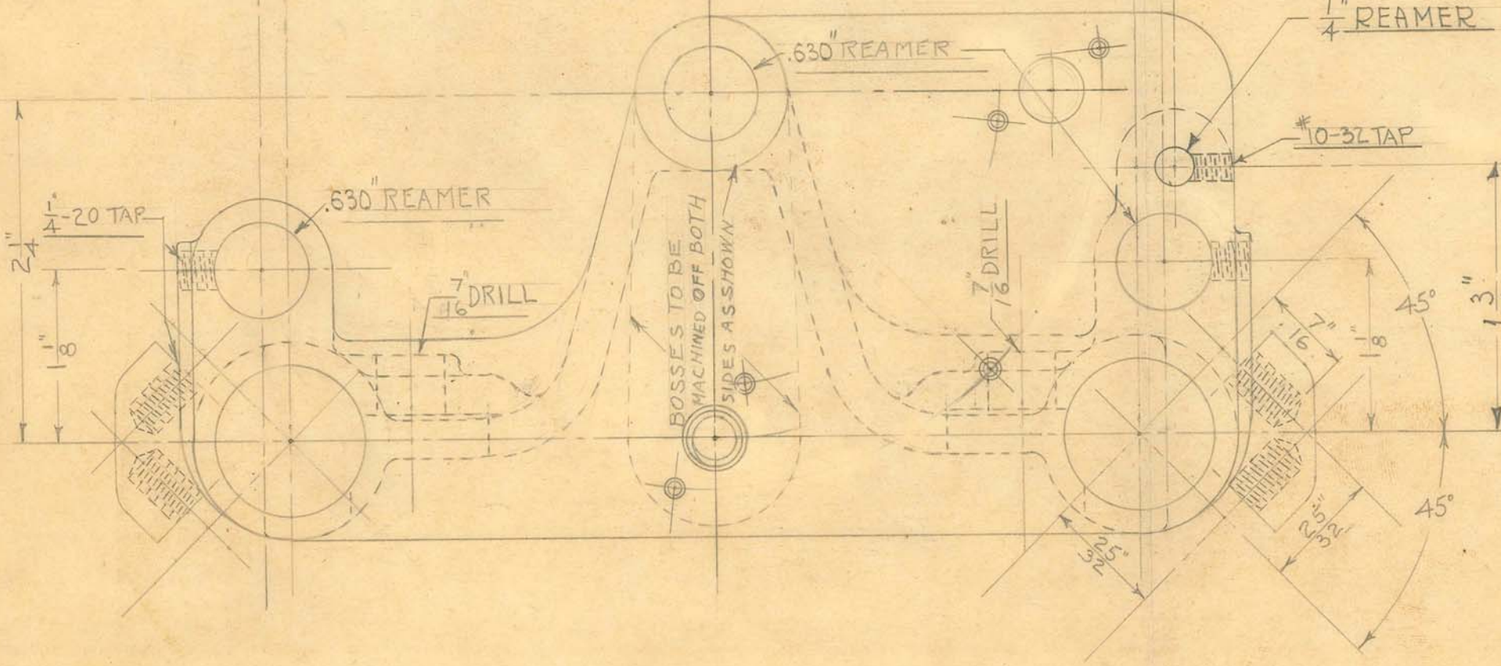

1-REQUIRED

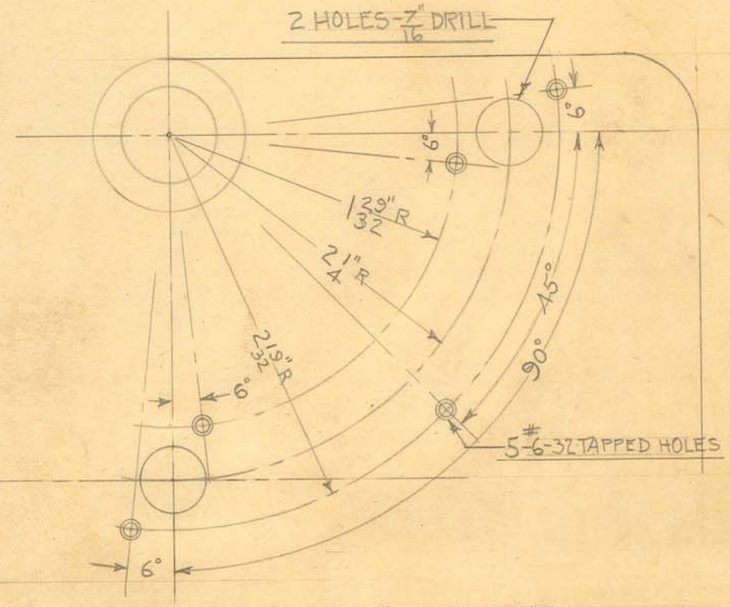

DETAIL OF DRILLING FOR QUADRANT

OBSOLETE

SIZE		ISSUE 5-16-40	C.E.A.
KIND	DOW-METAL	CHANGED	
SHAPE	CASTING-	"	
FINISH	PAINTED	"	
TEMP.		"	
PATT.	1513	"	

TITLE: FISCHER MOD. "100" UNIT
SCREEN SLIDE - UPPER

H. G. FISCHER & CO.
2335 WABANSIA AVE.
CHICAGO, ILL.

CAT. NO.

PART NO. 13118F

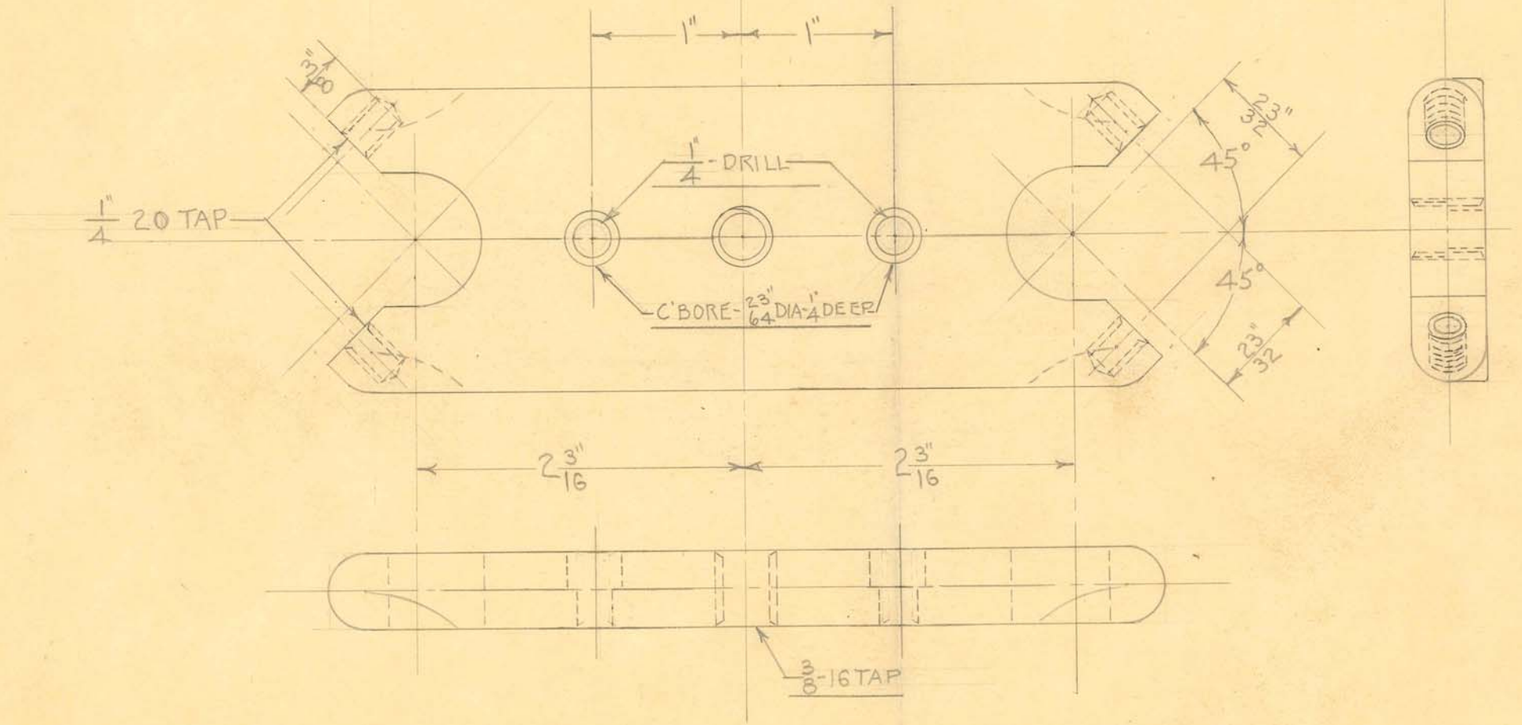

2-REQUIRED

OBSOLETE

SIZE		ISSUE 6-5-40	C.E.A.
KIND	BRASS	CHANGED	
SHAPE	CASTING	"	
FINISH	PAINT	"	
TEMP.		"	
PATT.	1520	"	

TITLE: FISCHER MOD. "100" X-RAY UNIT
SCREEN C'BALANCE END PLATE

H. G. FISCHER & CO.
2335 WABANSIA AVE.
CHICAGO, ILL.

CAT. NO.

PART NO. 13122-F

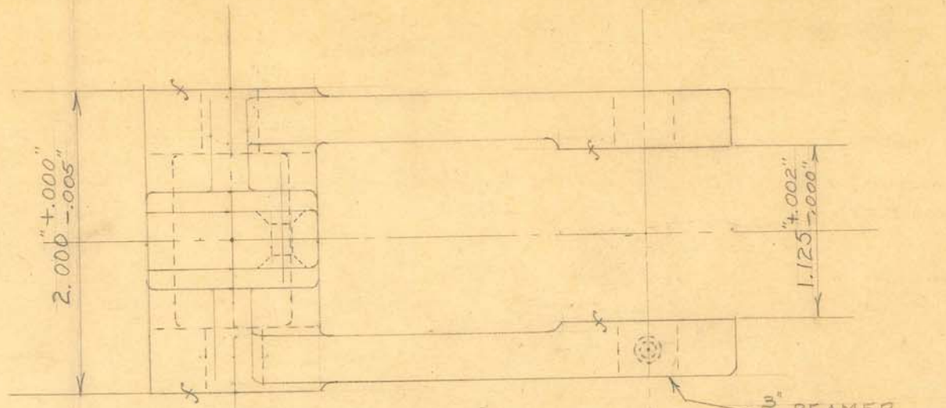

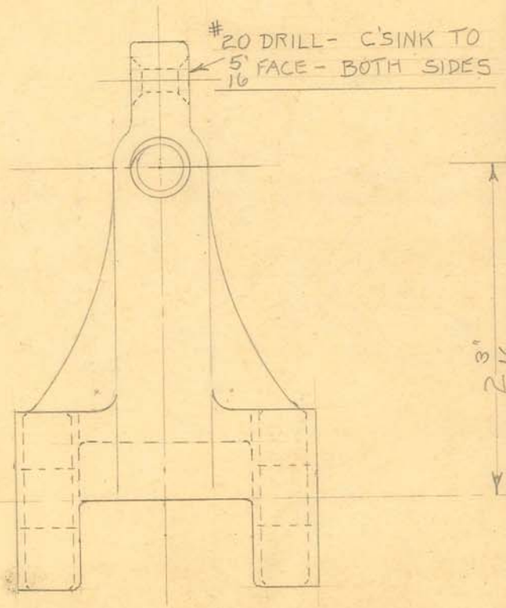

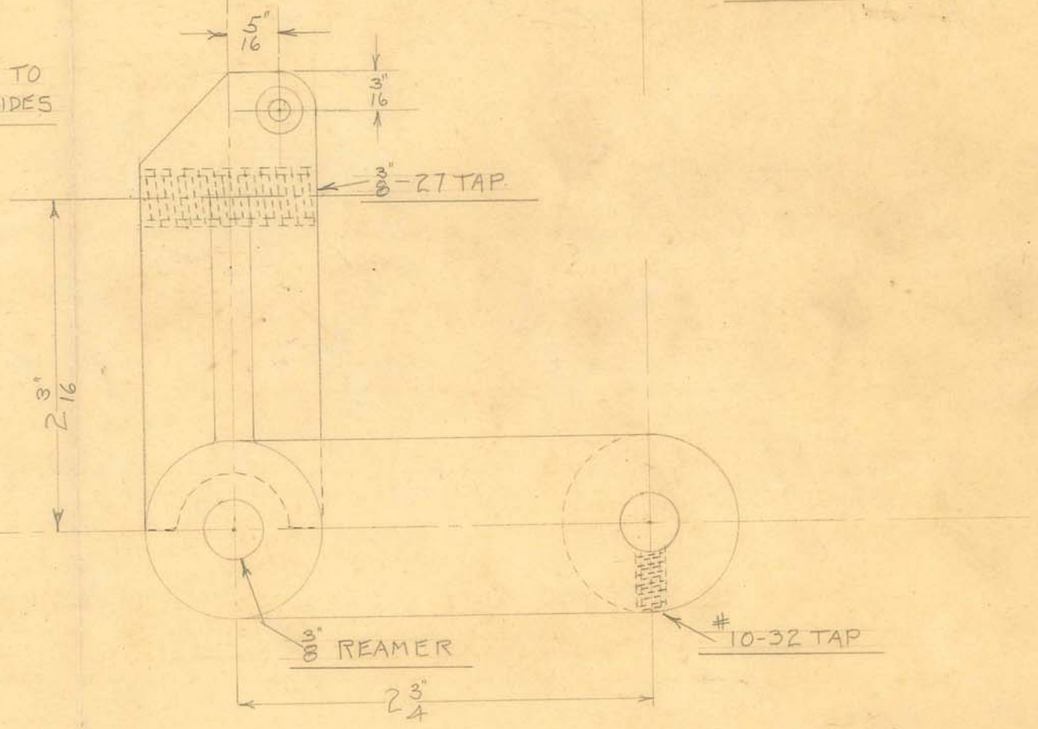

2 REQUIRED

OBSOLETE

SIZE		ISSUE 4-29-40	CEA	TITLE: FISCHER MODEL #100 X-RAY UNIT TUBE STAND & CONT. BASE – ROLLER SUPPORT HINGE
KIND	CAST IRON	CHANGED		
SHAPE		"		
FINISH	PAINT	"		
TEMP.		"		
PATT.	1537	"		

H. G. FISCHER & CO.
2338 WABANSIA AVE.
CHICAGO. ILL.

CAT. NO.

PART NO. 13124-F

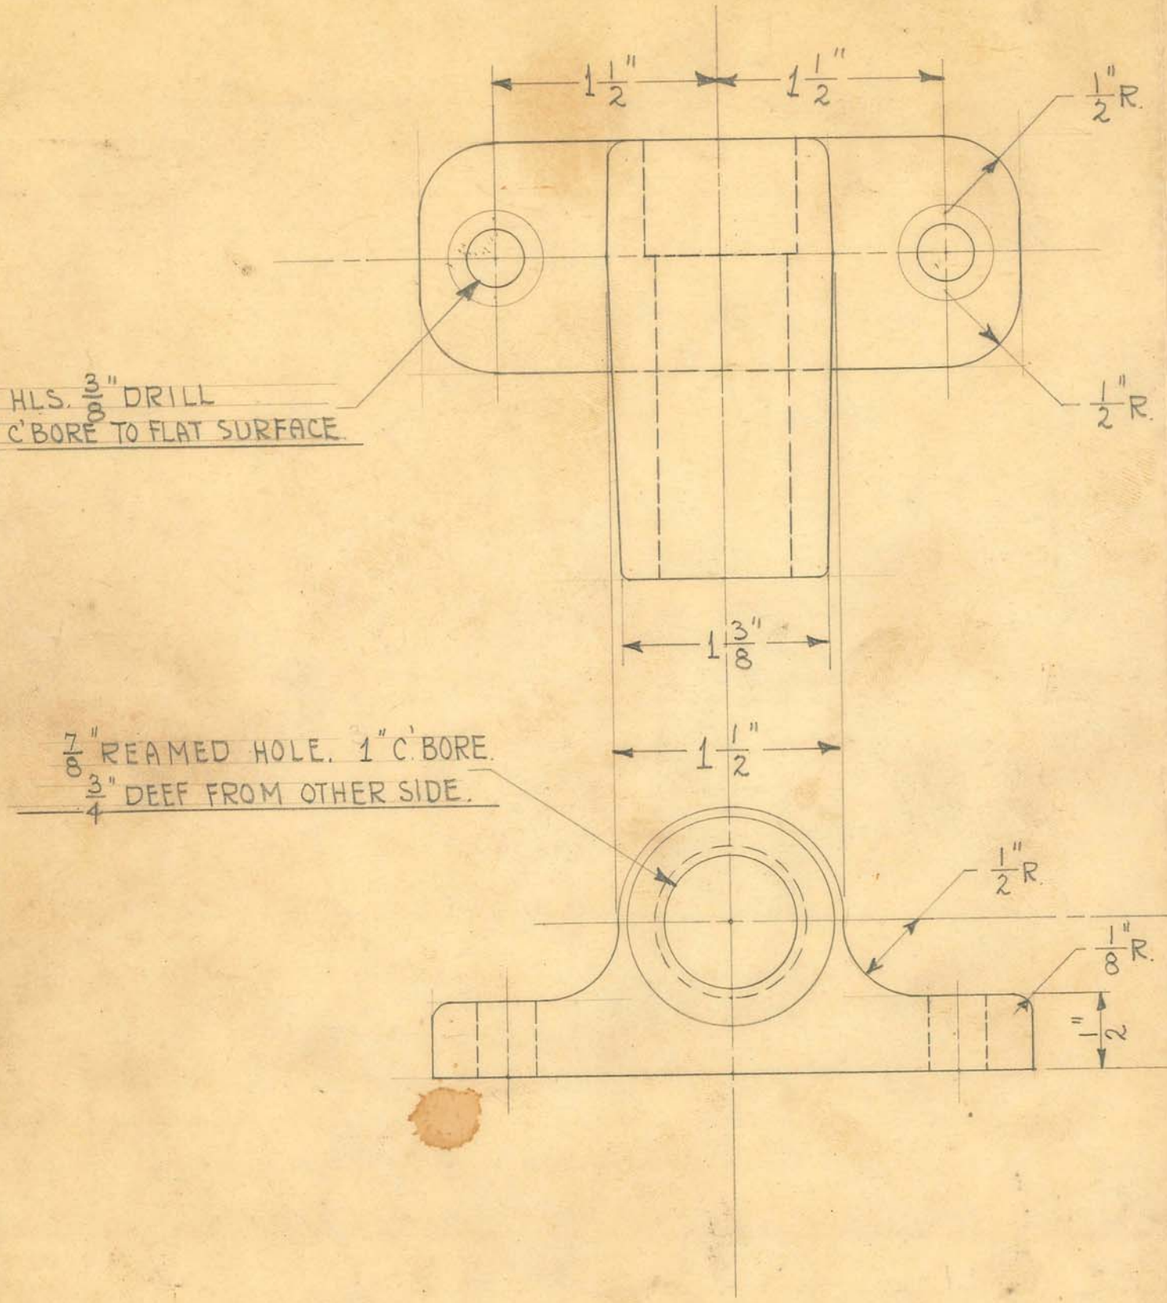

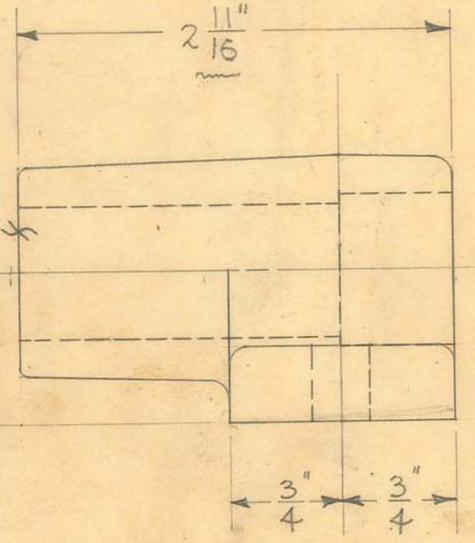

OBSOLETE

SIZE		ISSUE 4-19-40	H. E.	
KIND	IRON CASTING	CHANGED		
SHAPE		"		
FINISH	PAINTED	"		
TEMP.		"		
PATT.	1545	"		

TITLE: FISCHER MOD. "100" X-RAY UNIT TABLE - SIDE FRAME TIE ROD BEARING

H. G. FISCHER & CO.
2338 WABANSIA AVE.
CHICAGO, ILL.

CAT. NO.

PART NO. 13126F

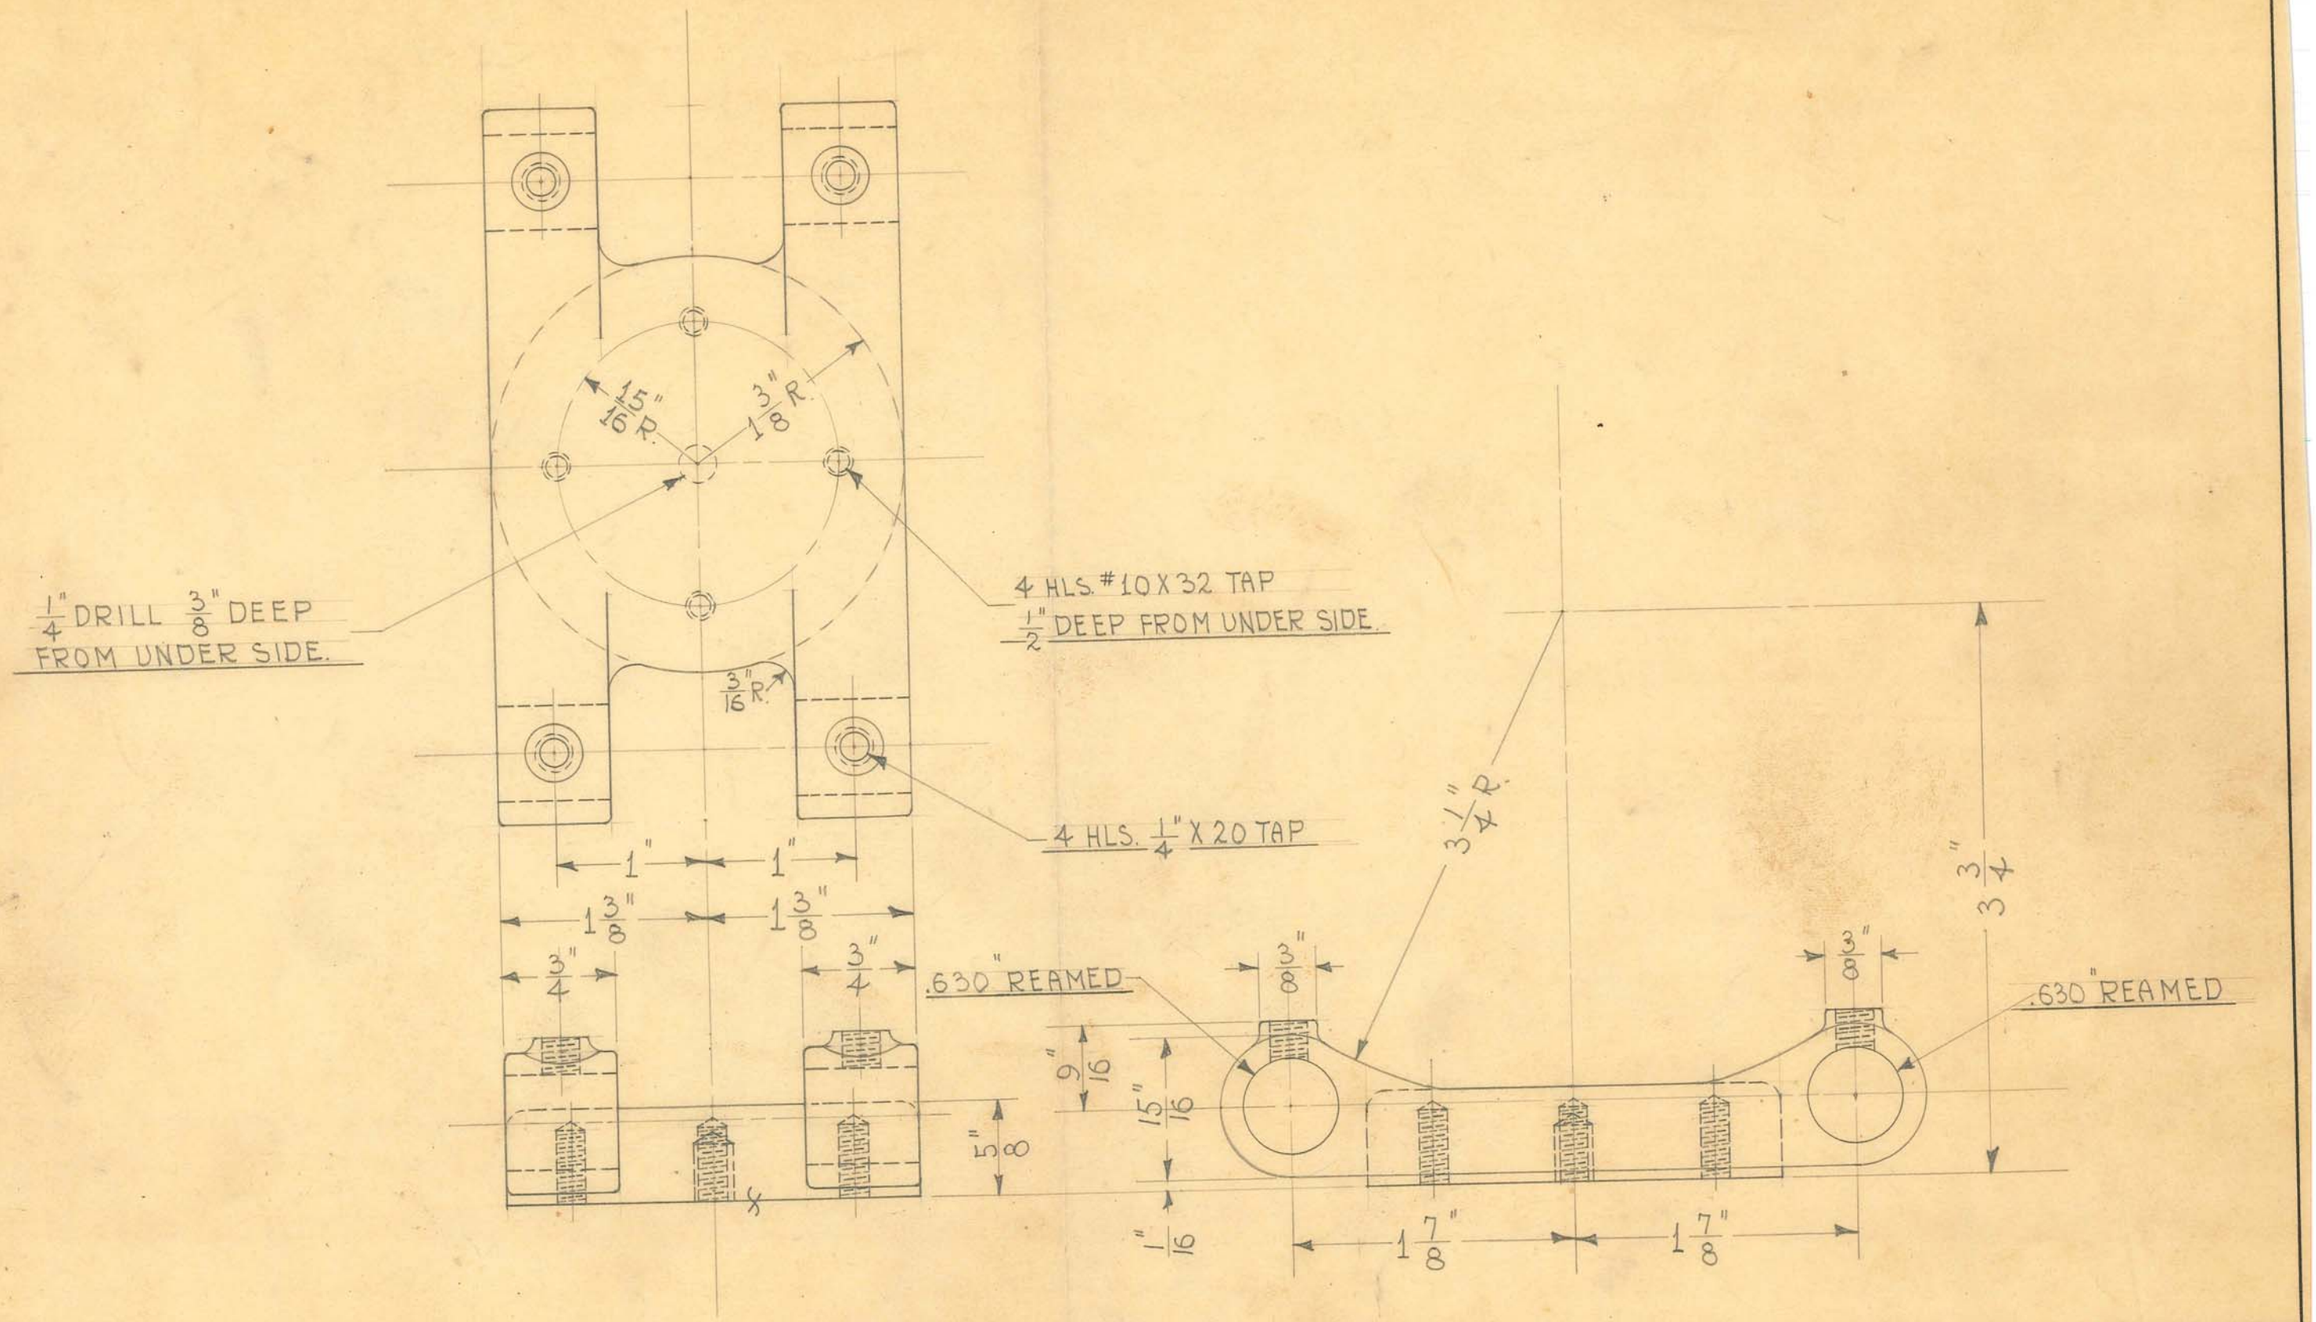

1 REQUIRED

SIZE		ISSUE 4-29-40	HE.
KIND	DOW METAL	CHANGED	
SHAPE	CASTING	"	
FINISH	PAINTED	"	
TEMP.		"	
PATT.	1551	"	

TITLE: FISCHER MOD. "100" X-RAY UNIT TUBE STAND-TUBE HEAD SWIVEL

OBSOLETE

H. G. FISCHER & CO.
2335 WABANSIA AVE.
CHICAGO, ILL.

CAT. NO.

PART NO. 13131F

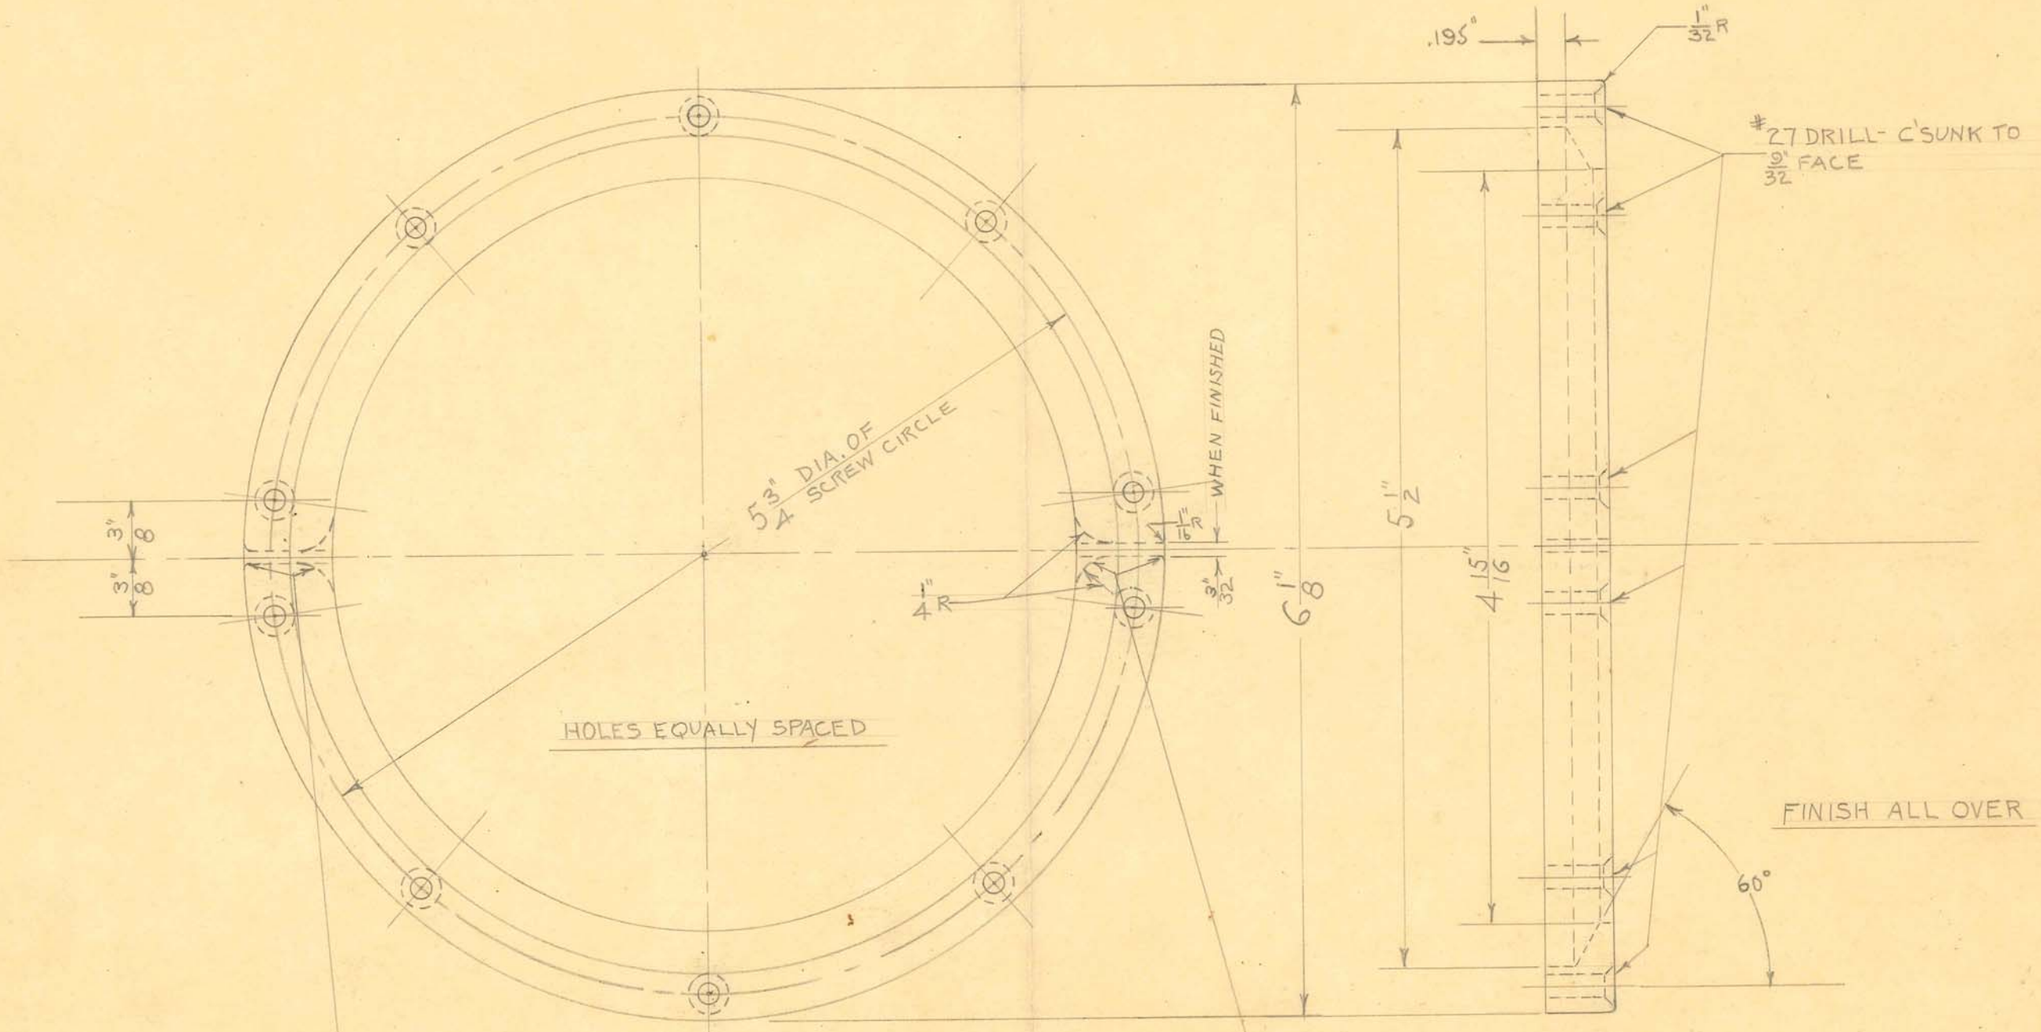

NOTE: RINGS TO BE COMPLETELY MACHINED & DRILLED THEN CUT IN HALF AS SHOWN, & RADIUS & CORNERS FILED, PRODUCING 2 HALVES.

2 HALVES REQUIRED FOR EACH MACHINE

SIZE		ISSUE 6-1-40	C.E.A.
KIND	DOWMETAL	CHANGED	
SHAPE	CASTING	"	
FINISH	PAINTED	"	
TEMP.		"	
PATT.	1554	"	

TITLE: FISCHER MOD. "100" X-RAY UNIT
X-RAY TUBE ADAPTER LOCATING RING.

OBSOLETE

H. G. FISCHER & CO.
2338 WABANSIA AVE.
CHICAGO, ILL.

CAT. NO.

PART NO. 13134 F

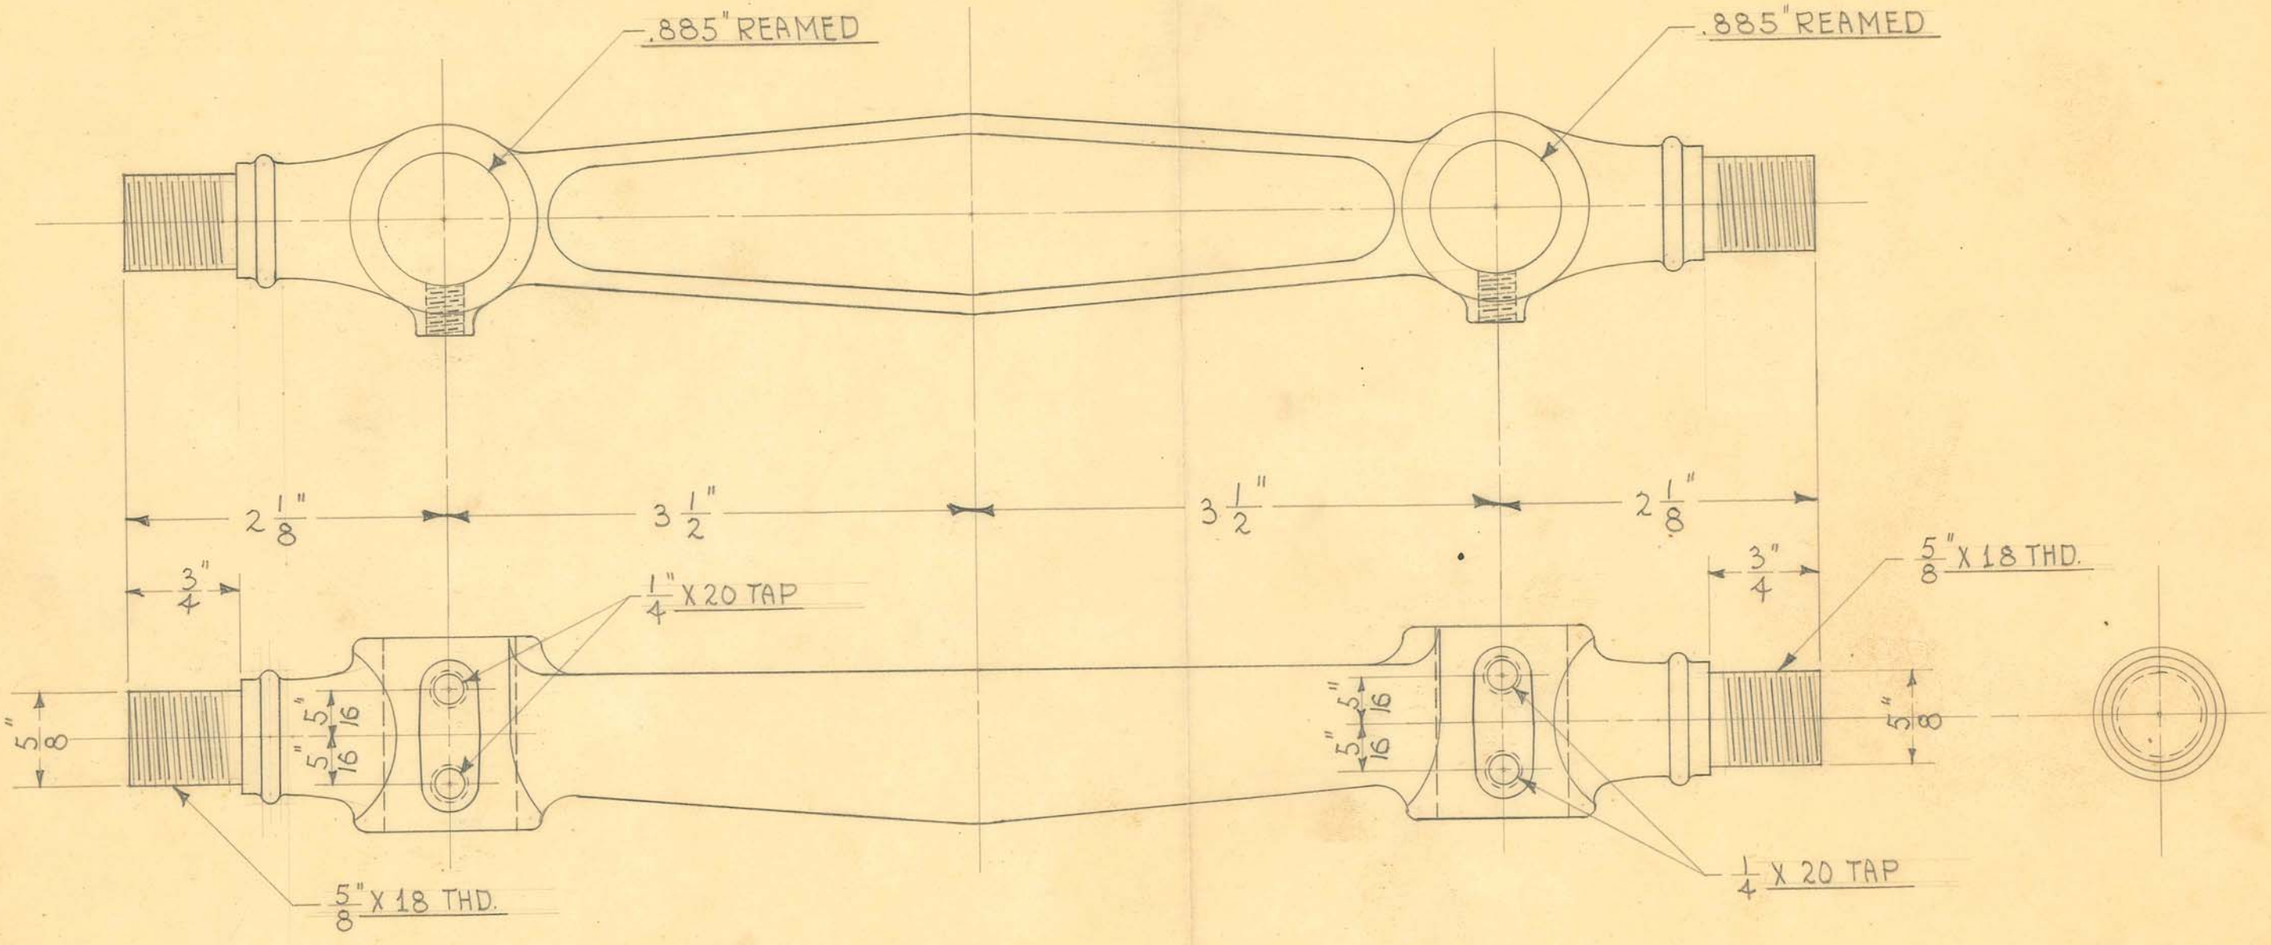

1 REQUIRED

SIZE	# 214	ISSUE 5-31-40	HE.
KIND	ALUM. CASTING	CHANGED	
SHAPE		"	
FINISH	PAINTED	"	
TEMP.		"	
PATT.	1566	"	

TITLE: FISCHER MOD." 100" X-RAY UNIT-
TUBE STAND GUIDE RODS TIE

OBSOLETE

H. G. FISCHER & CO.
2335 WABANSIA AVE.
CHICAGO. ILL.

CAT. NO.

PART NO. 13148F

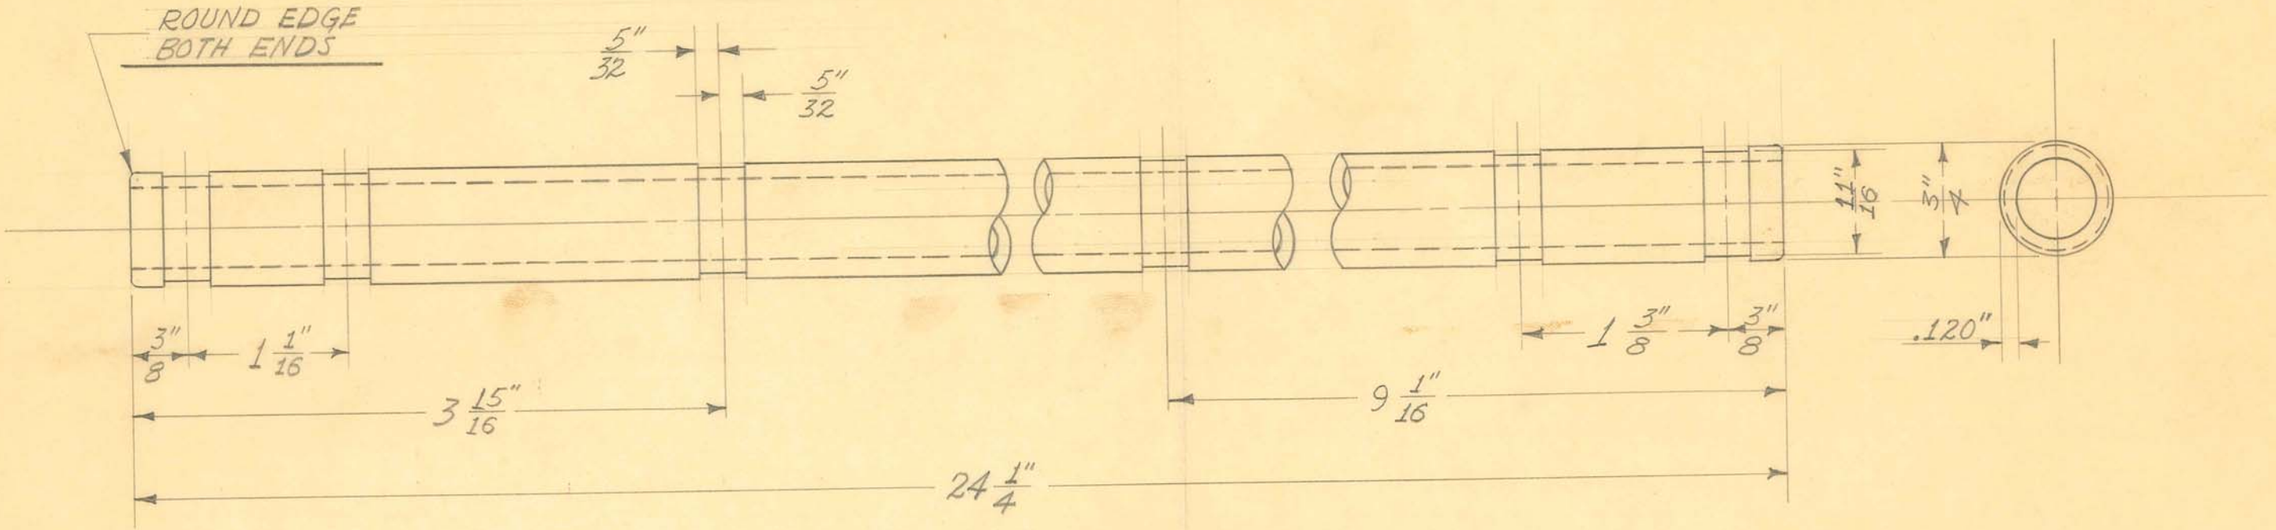

3/4" O.D. #11 GA. (.120") WALL - SHELBY SEAMLESS STEEL TUBING

1 REQUIRED

SIZE		ISSUE 7-8-40	J.W.
KIND		CHANGED	
SHAPE		"	
FINISH	CHROME #2	"	
TEMP.		"	
PATT.		"	

TITLE: FISCHER MOD. "100" X-RAY UNIT
SHUTTER & TUBE HEAD SLIDE ROD-LOWER

OBSOLETE

H. G. FISCHER & CO.
2335 WABANSIA AVE.
CHICAGO, ILL.

CAT. NO.

PART NO. 13167 1/2

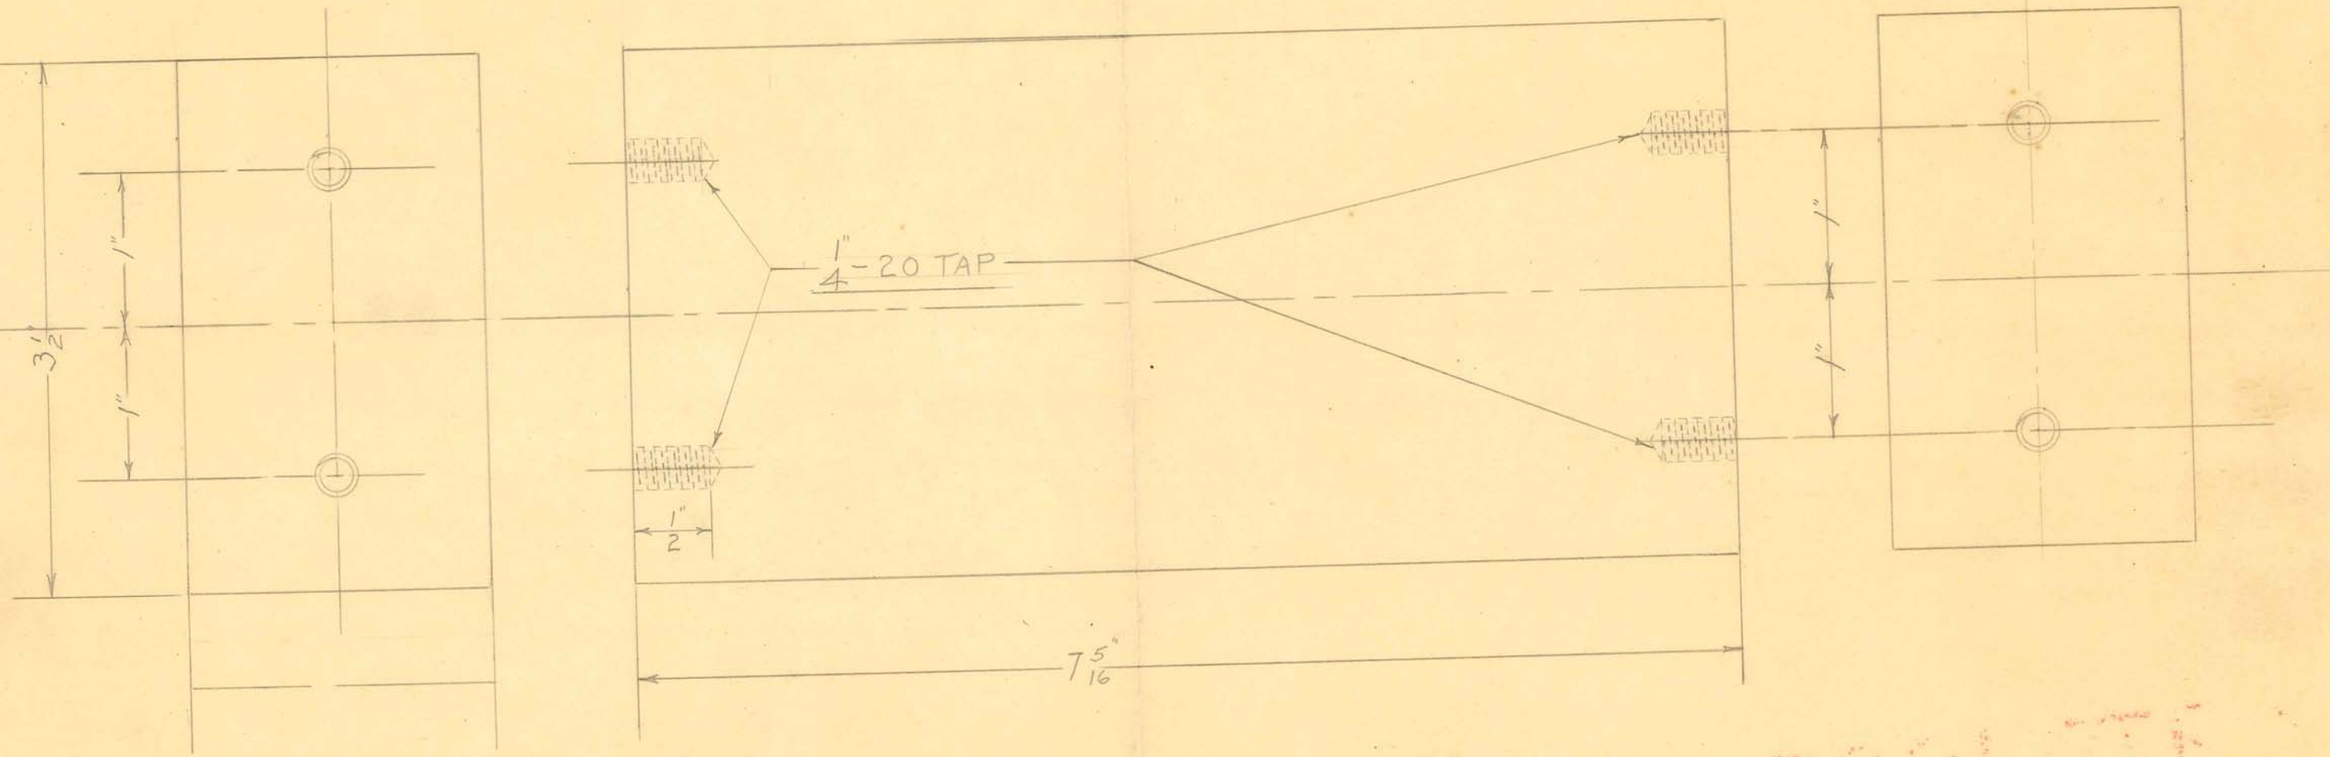

1 REQUIRED

OBSOLETE

SIZE	2"X3 1/2"	ISSUE 5-9-40	C.E.A.	TITLE: FISCHER MODEL "100" UNIT SCREEN COUNTER BALANCE
KIND	C.R. STEEL	CHANGED		
SHAPE		"		
FINISH	CAD. #23	"		
TEMP.		"		
PATT.		"		

OBSOLETE

H. G. FISCHER & CO.
2335 WABANSIA AVE.
CHICAGO, ILL.

CAT. NO.

PART NO. 13169

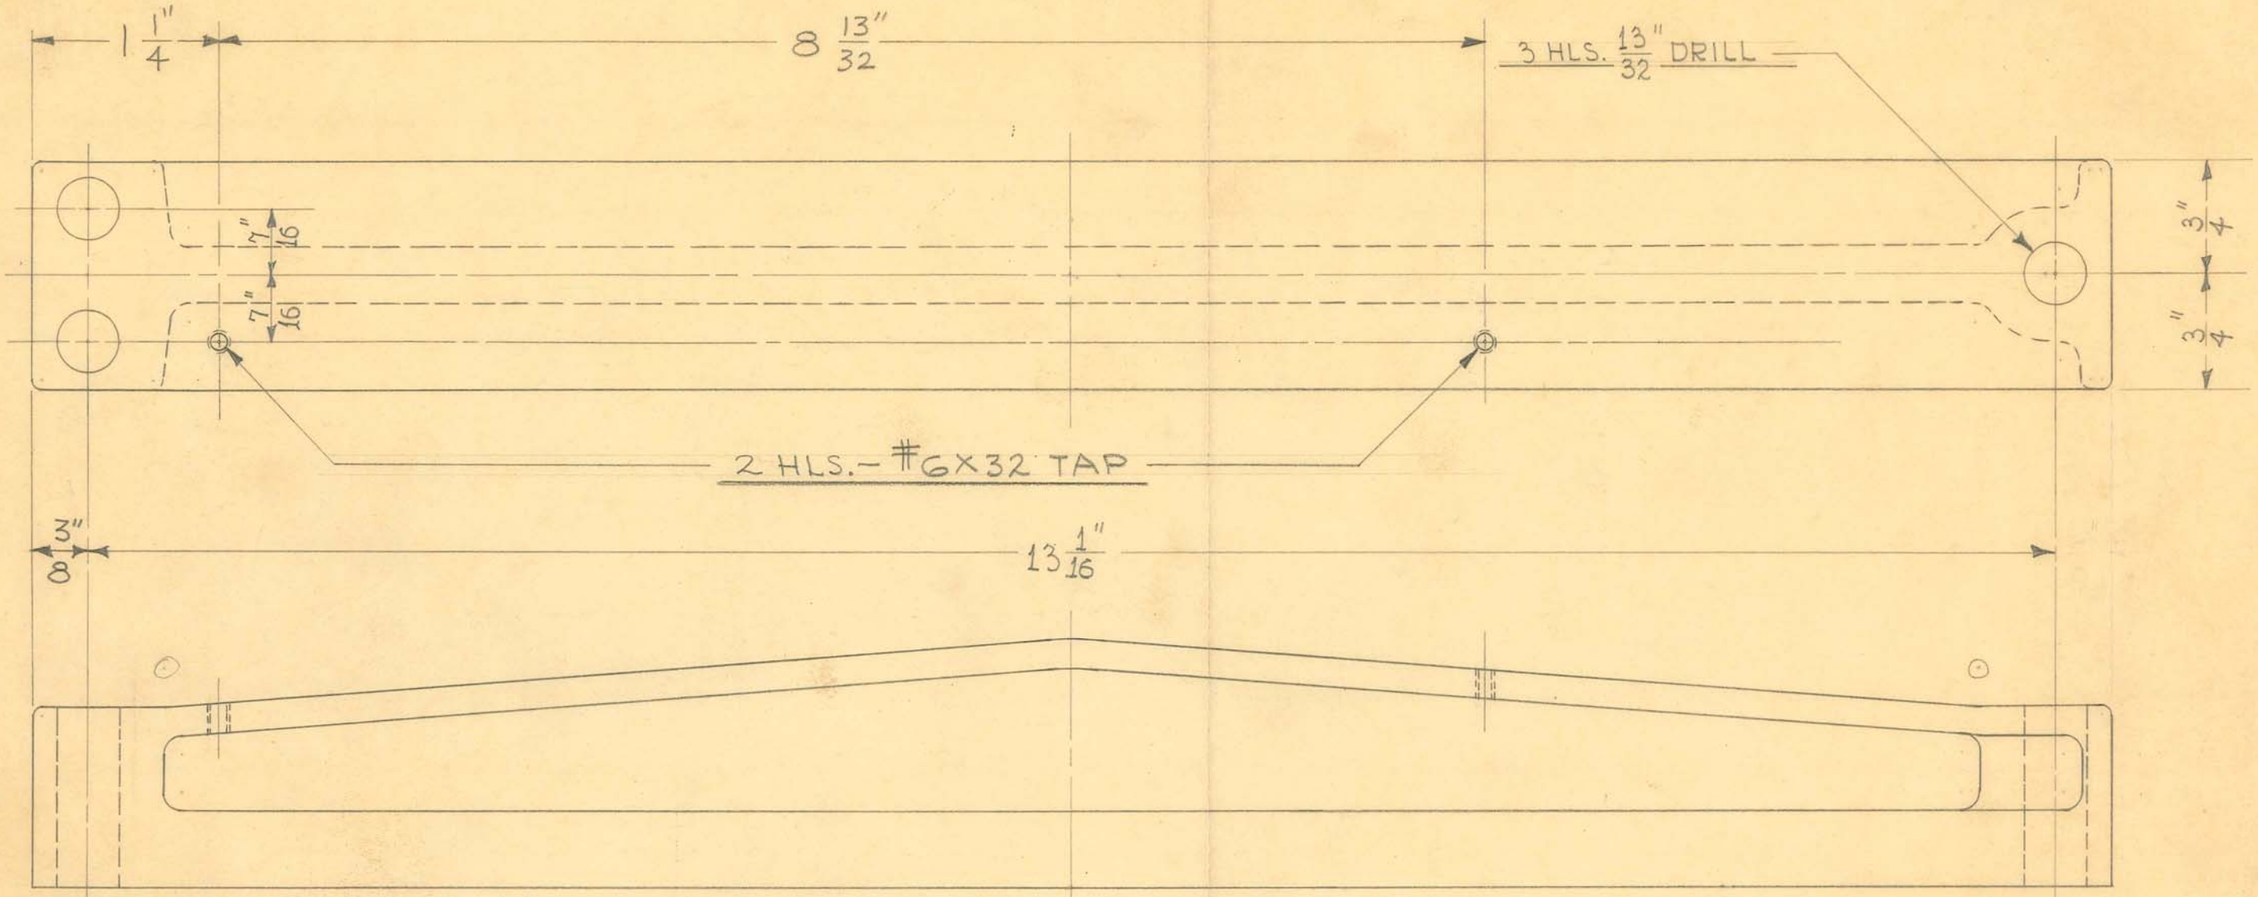

2 REQUIRED

OBSOLETE
Obsolete 12-11-50
JCF

SIZE		ISSUE 6-11-40	HE.	TITLE: FISCHER MOD. "100" X-RAY UNIT- TRANSFORMER CLAMP
KIND	IRON CASTING	CHANGED		
SHAPE		" 5-10-47	J.V.W.	
FINISH		"		
TEMP.		"		
PATT.	1546	"		

H. G. FISCHER & CO.
2338 WABANSIA AVE.
CHICAGO. ILL.

CAT. NO.

PART NO. 13182F

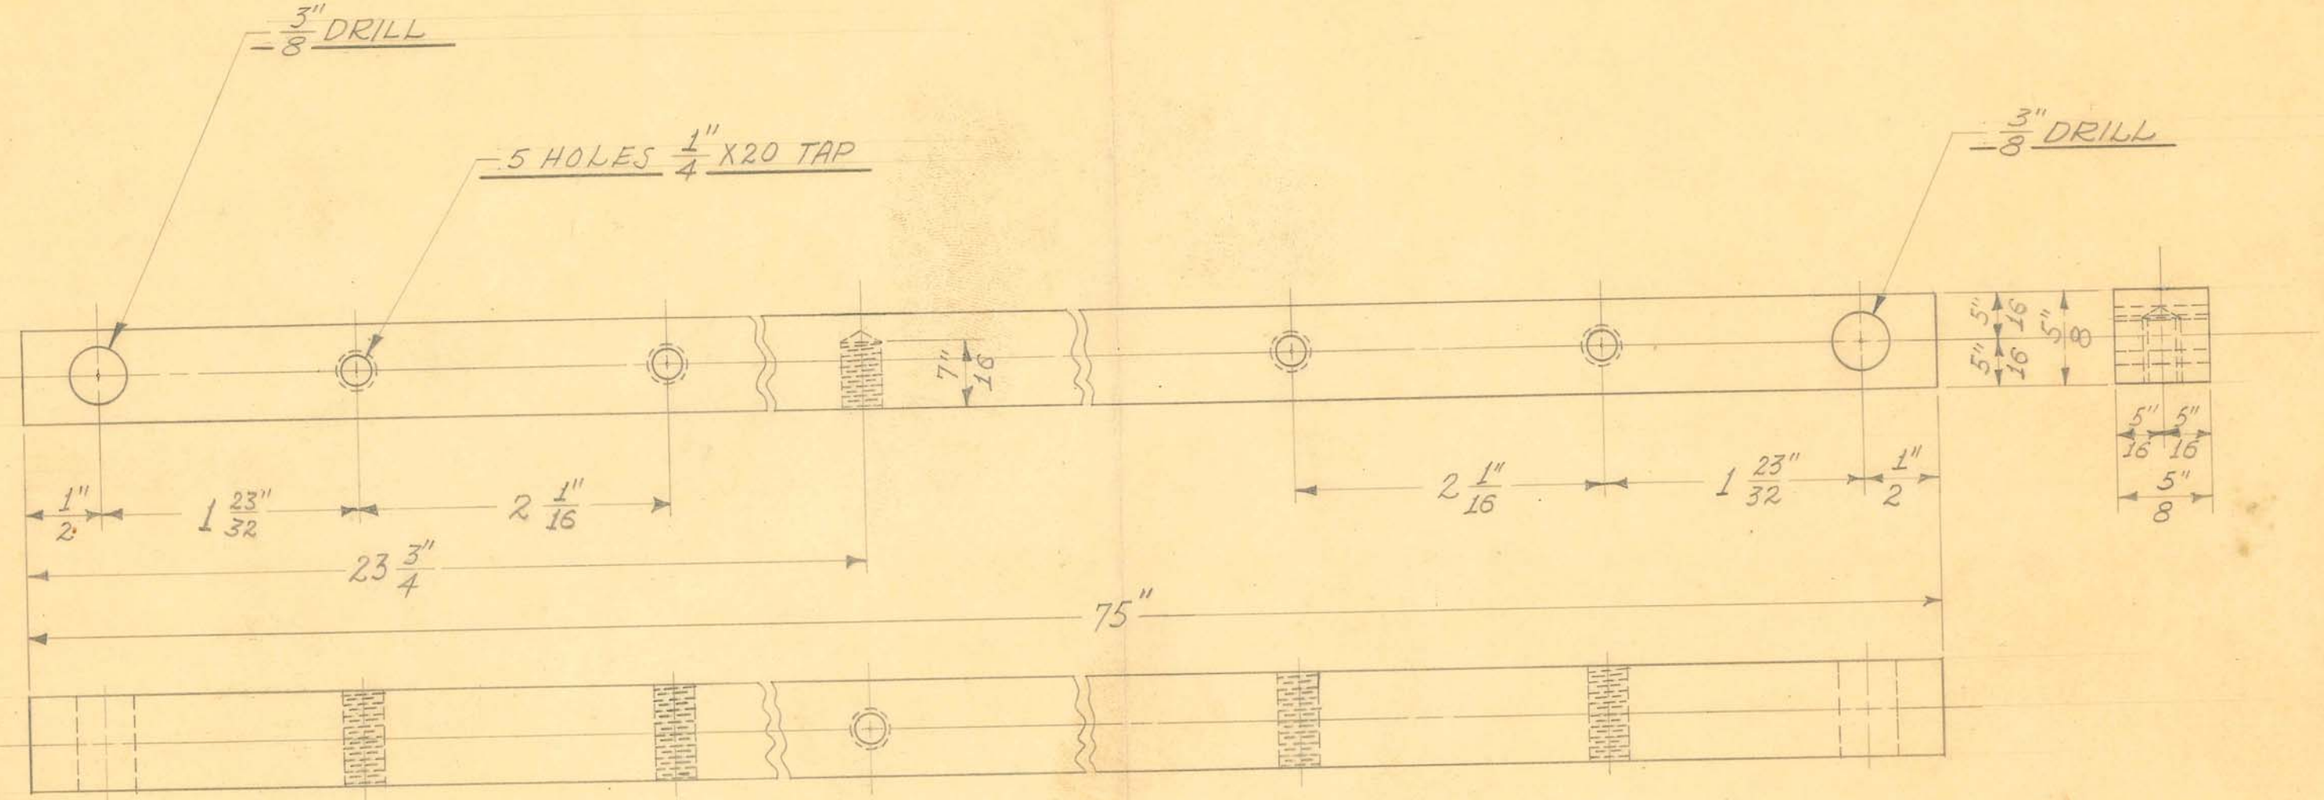

1 REQUIRED

OBSOLETE

SIZE	5/8" SQUARE	ISSUE 6-13-40	J.W.	TITLE: FISCHER MOD. "100" X-RAY UNIT TUBE HEAD COUNTERWEIGHT GUIDE RAIL
KIND	C.R. STEEL	CHANGED		
SHAPE		"		
FINISH	CAD. #23	"		
TEMP.		"		
PATT.		"		

H. G. FISCHER & CO.
2335 WABANSIA AVE.
CHICAGO. ILL.

CAT. NO.

PART NO. 13194

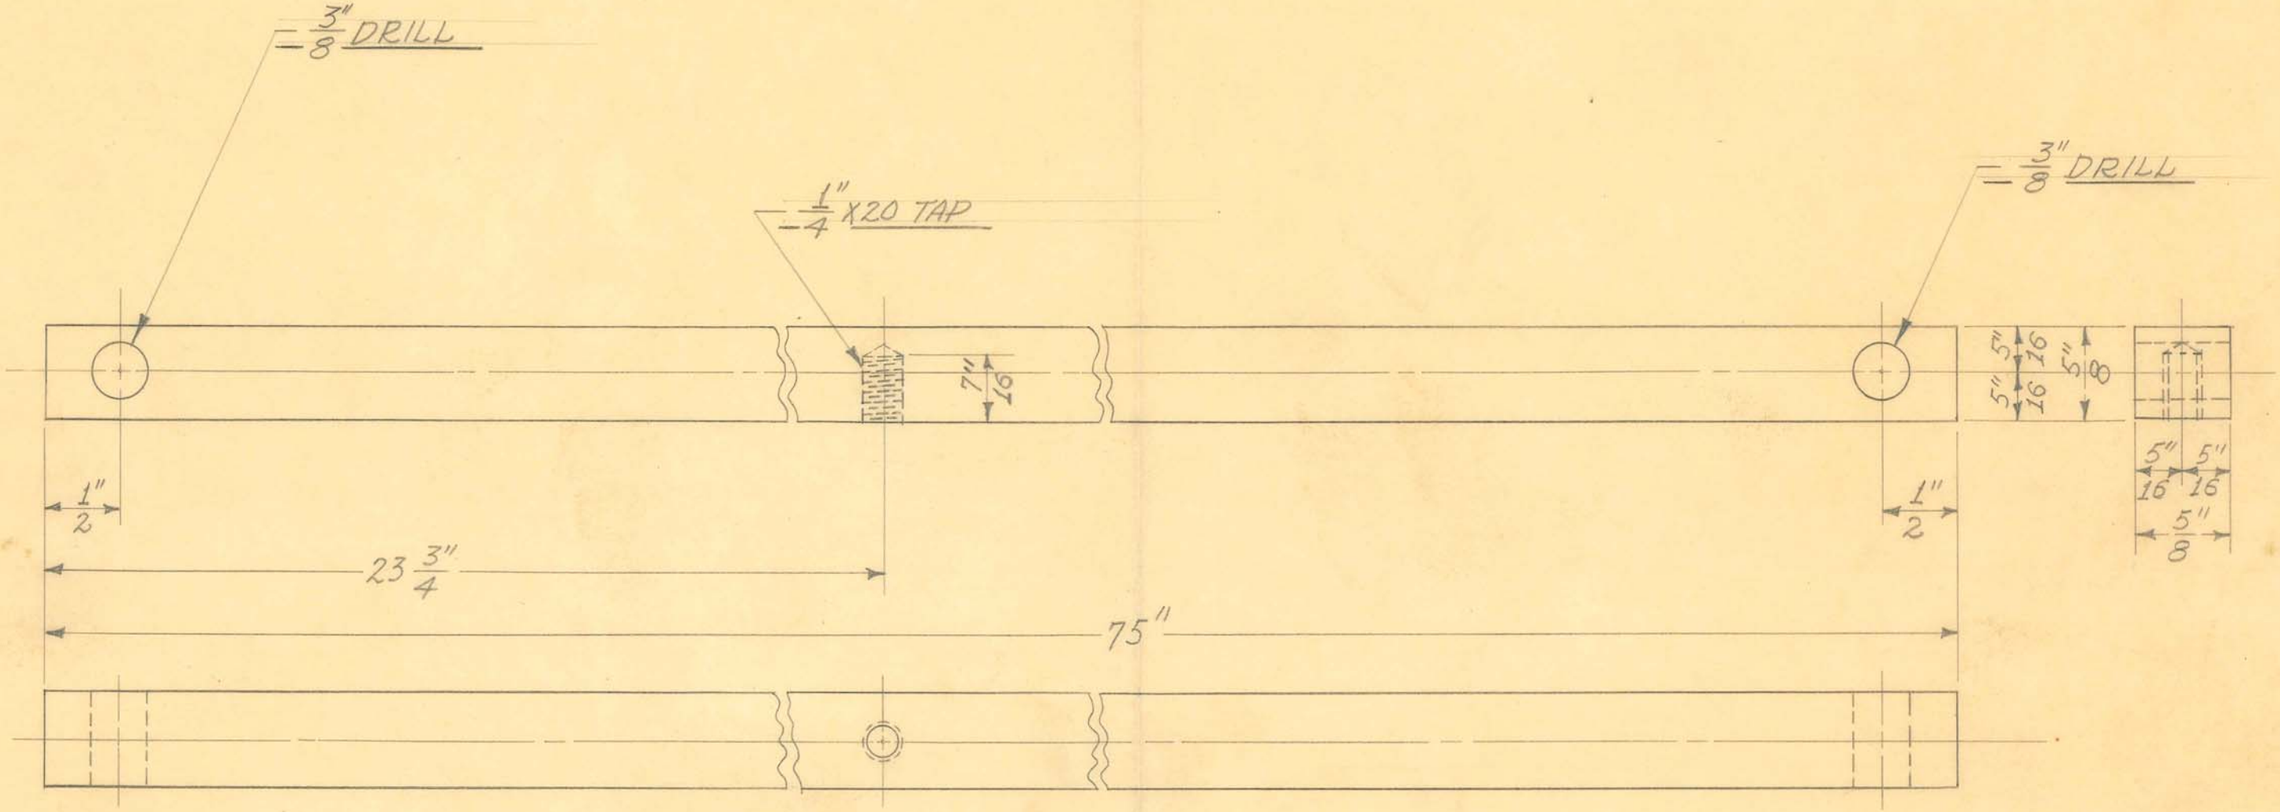

1 REQUIRED

OBSOLETE

SIZE	5/8" SQUARE	ISSUE 6-17-40	J.W.
KIND	C.R. STEEL	CHANGED	
SHAPE		"	
FINISH	CAD. #23	"	
TEMP.		"	
PATT.		"	

TITLE:
FISCHER MOD. "100" X-RAY UNIT
BUCKY COUNTERWEIGHT GUIDE RAIL

H. G. FISCHER & CO.
2335 WABANSIA AVE.
CHICAGO, ILL.

CAT. NO.

PART NO. 13194 1/2

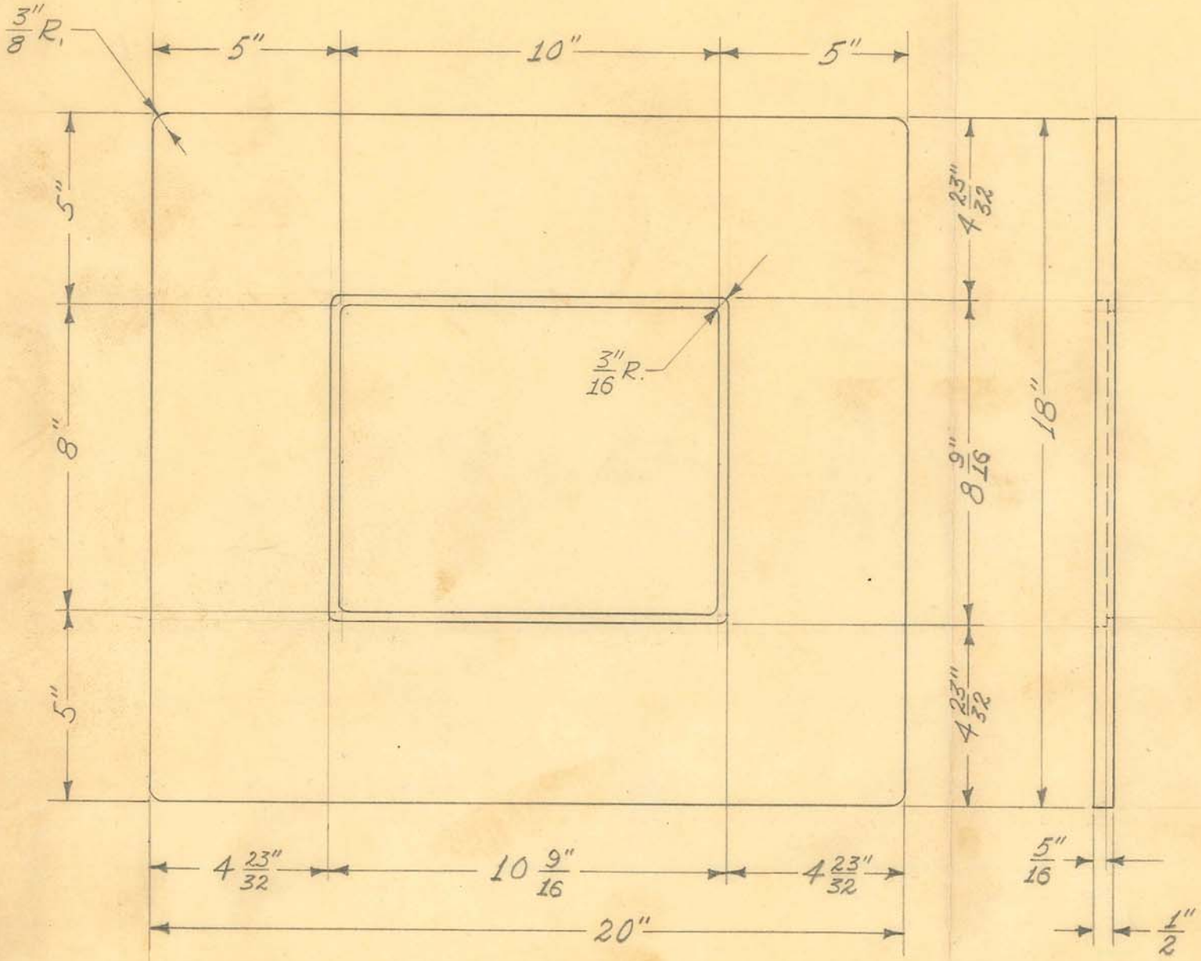

SCALE ÷ 1/4" = 1"

1 REQUIRED

OBSOLETE

SIZE	1/2" PLYWOOD	ISSUE 5-6-40	J.W.
KIND		CHANGED	
SHAPE		"	
FINISH	BLACK	"	
TEMP.		"	
PATT.		"	

TITLE: FISCHER COUNTERBALANCED FLUOROSCOPIC SCREEN FRAME

H. G. FISCHER & CO.
2335 WABANSIA AVE.
CHICAGO, ILL.

CAT. NO.

PART NO. 13202

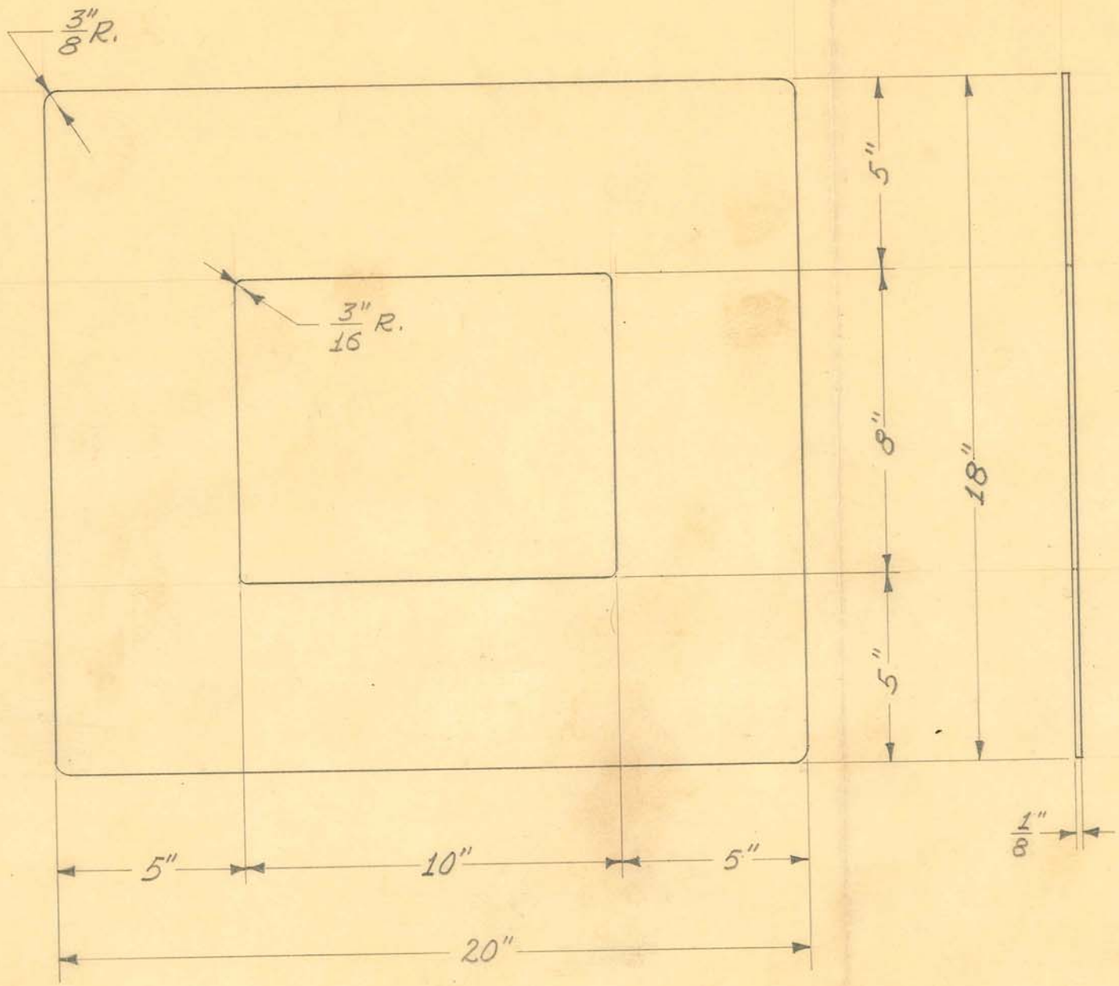

1 REQUIRED

SCALE ÷ 1/4 = 1"

OBSOLETE

SIZE	1/8" PLYWOOD	ISSUE 5-6-40	J.W.	TITLE: FISCHER COUNTERBALANCED FLUOROSCOPIC SCREEN FRONT PANEL
KIND		CHANGED		
SHAPE		"		
FINISH	BLACK	"		
TEMP.		"		
PATT.		"		

H. G. FISCHER & CO.
2338 WABANSIA AVE.
CHICAGO, ILL.

CAT. NO.

PART NO. 13203

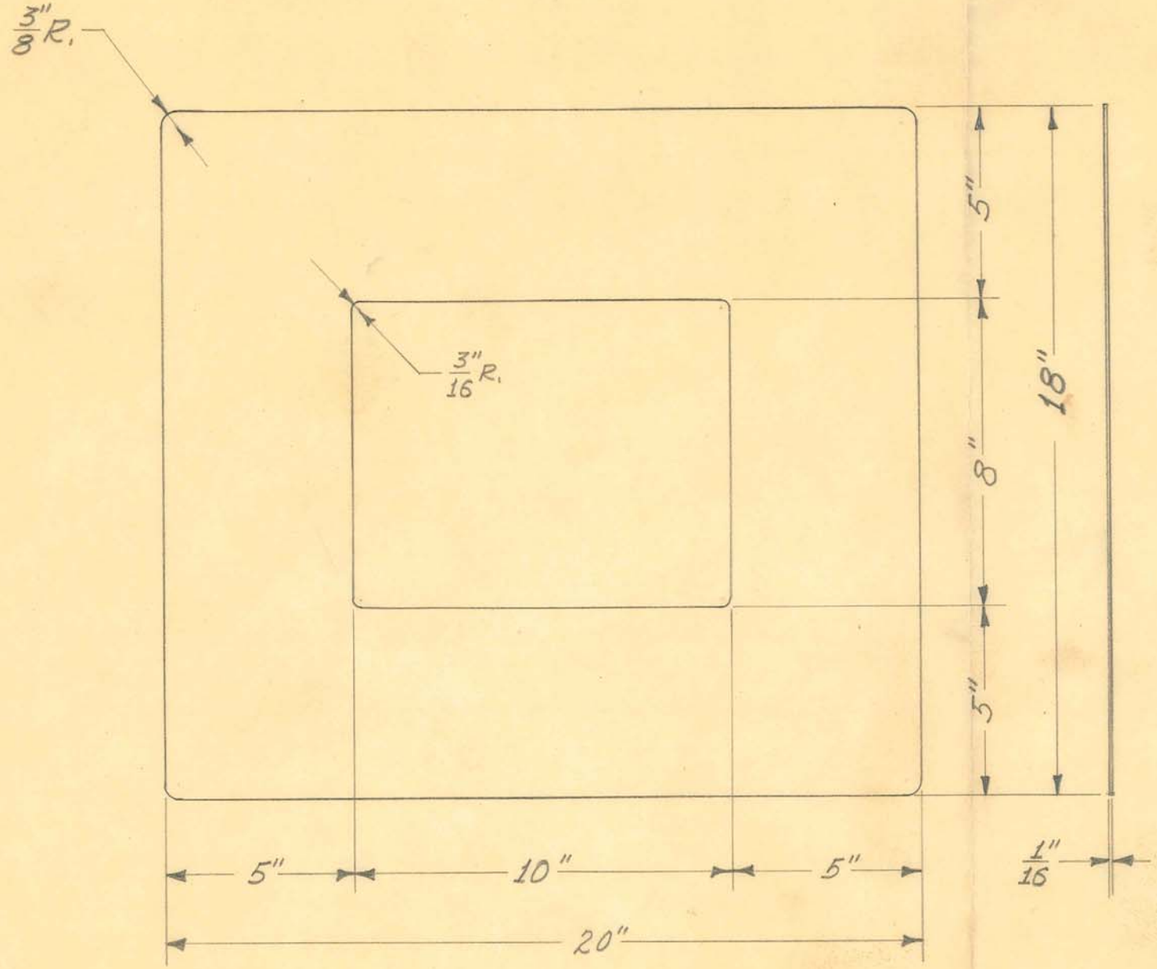

SCALE ÷ 1/4" = 1"

1 REQUIRED

OBSOLETE

SIZE	1/16" SHEET	ISSUE 5-6-40	J.W.
KIND	LEAD	CHANGED	
SHAPE		"	
FINISH		"	
TEMP.		"	
PATT.		"	

TITLE: FISCHER COUNTERBALANCED FLUOROSCOPIC SCREEN - LEAD SHIELD

H. G. FISCHER & CO.
2335 WABANSIA AVE.
CHICAGO, ILL.

CAT. NO.

PART NO. 13204

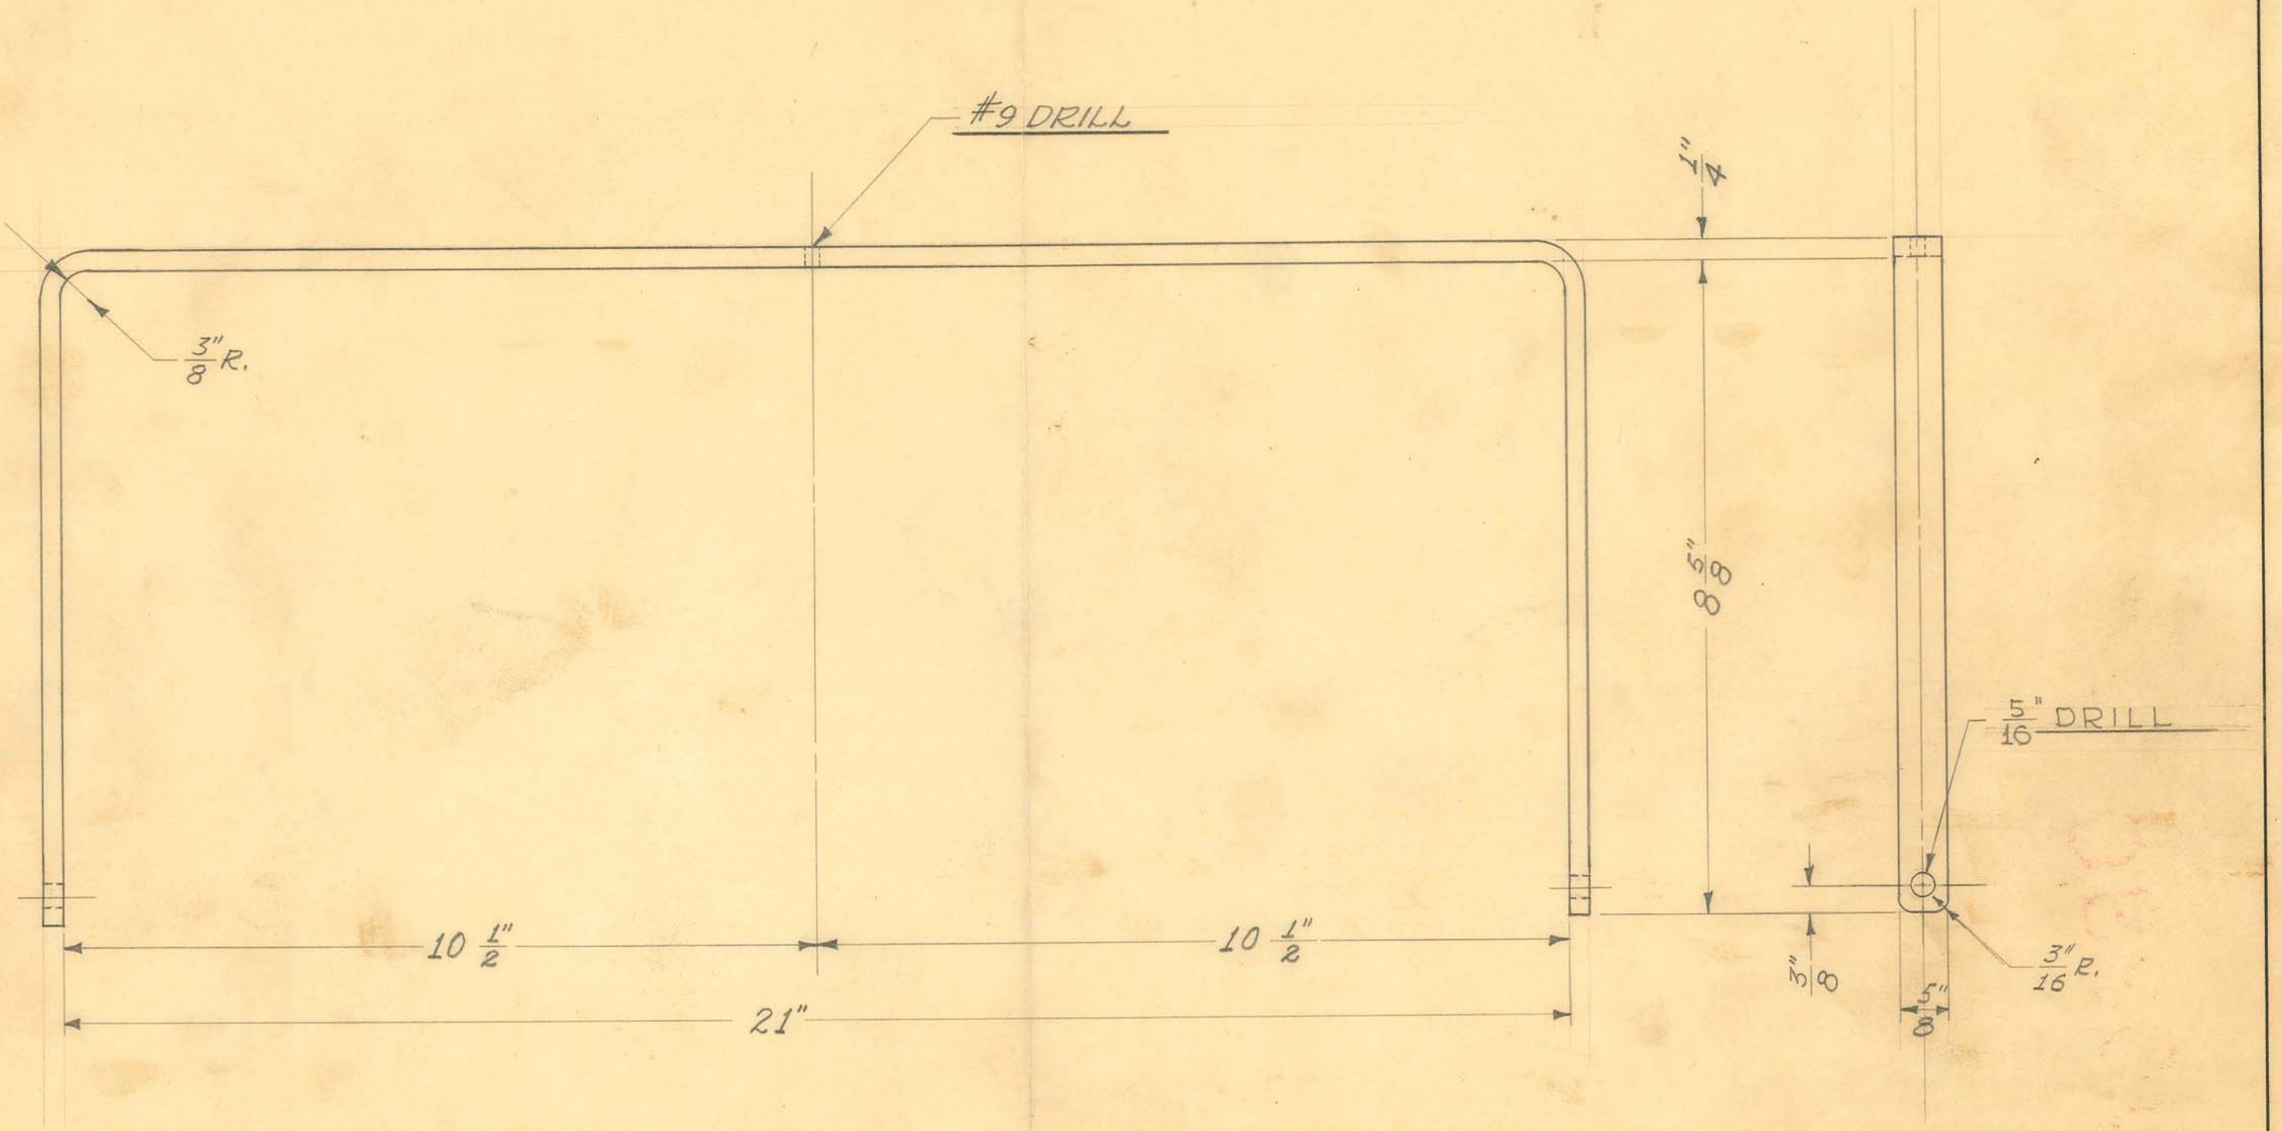

SCALE ~ 1/2" = 1"

1 REQUIRED

DEVELOPED LENGTH = 38 1/4" per I.B.

OBSOLETE

SIZE	5/8" X 1/4"	ISSUE 5-7-40	J.W.
KIND	C.R. STEEL	CHANGED 1-14-44	HE.
SHAPE	BAR.	"	
FINISH	PAINTED	"	
TEMP.		"	
PATT.		"	

TITLE: FISCHER COUNTERBALANCED FLUOROSCOPIC SCREEN - SUPPORT FORK

H. G. FISCHER & CO.
2335 WABANSIA AVE.
CHICAGO, ILL.

CAT. NO.

PART NO. 13212 A

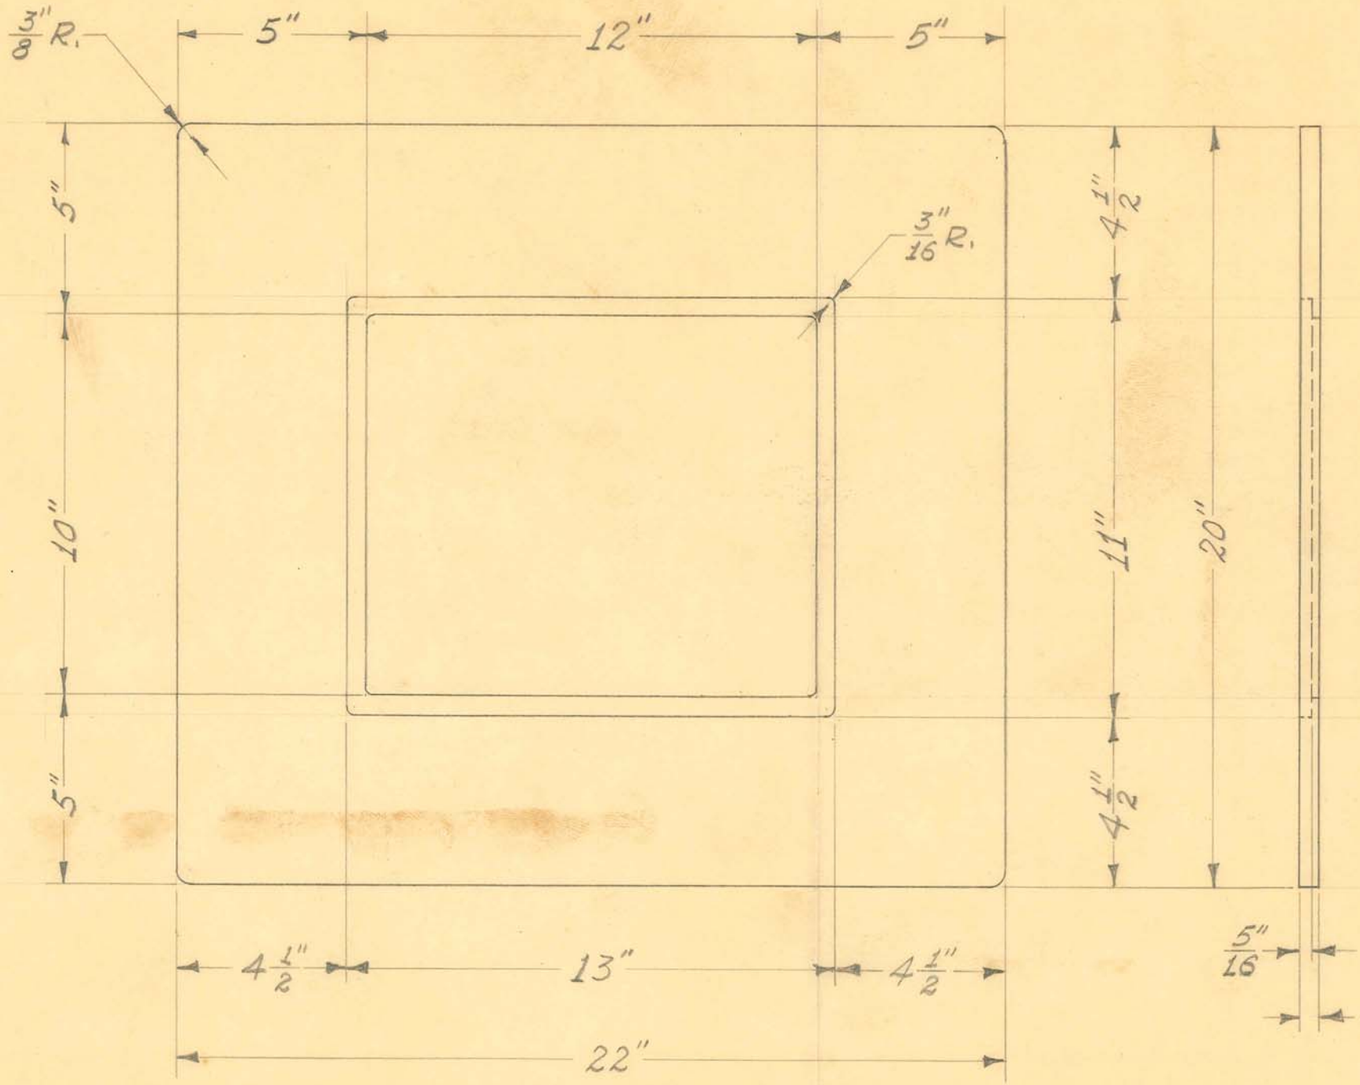

SCALE 1/4" = 1"

1 REQUIRED

OBSOLETE

SIZE	1/2" PLYWOOD	ISSUE 7-2-40	J. W.
KIND		CHANGED	
SHAPE		"	
FINISH	BLACK	"	
TEMP.		"	

TITLE: FISCHER COUNTERBALANCED FLUOROSCOPIC SCREEN FRAME (10X12)

H. G. FISCHER & CO.
2338 WABANSIA AVE.

CAT. NO.

PART NO. 13213

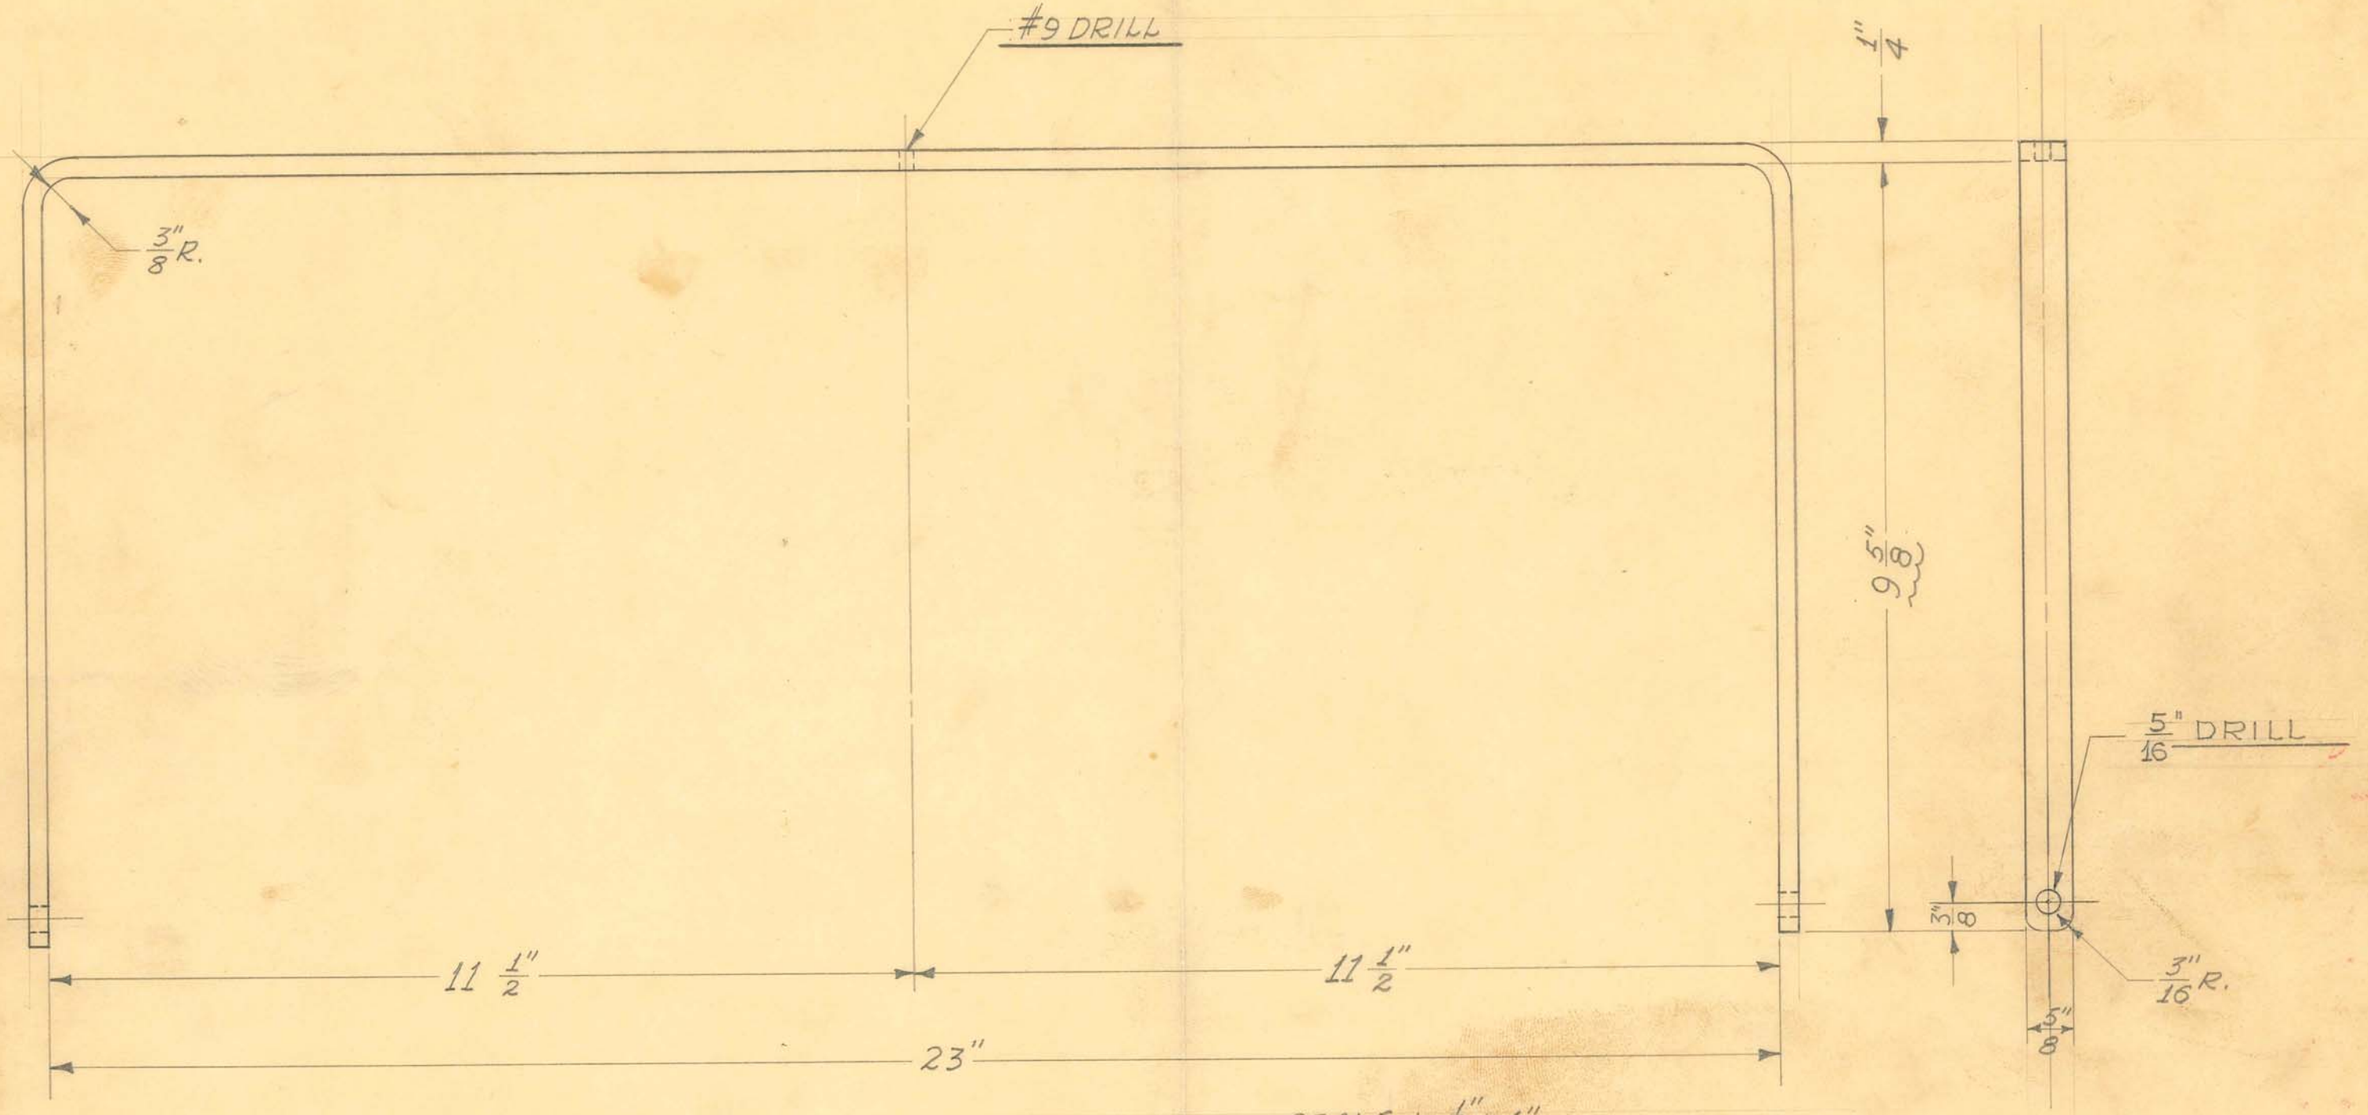

SCALE ~ 1" 2 = 1"

1 REQUIRED

DEVELOPED LENGTH = 42 1" 4

OBSOLETE

SIZE	5" 8 X 1" 4	ISSUE 7-2-40	J.W.
KIND	C.R. STEEL	CHANGED ~~1-14-44~~	H.E.
SHAPE	BAR	"	
FINISH	PAINTED	"	
TEMP.		"	
PATT.		"	

TITLE: FISCHER COUNTERBALANCED FLUOROSCOPIC SCREEN - SUPPORT FORK (10X12)

H. G. FISCHER & CO.
2335 WABANSIA AVE.
CHICAGO, ILL.

CAT. NO.

PART NO. 13217A

3 HLS. $\frac{17}{64}$" DRILL

$\frac{1}{2}$"

6 $\frac{27}{32}$"

120°

$\frac{5}{32}$"

1 $\frac{29}{32}$"

1 $\frac{25}{32}$"

$\frac{5}{32}$"

1 $\frac{25}{32}$"

1 $\frac{29}{32}$"

$\frac{5}{32}$"

$\frac{11}{32}$" DRILL

1 $\frac{13}{16}$"

1 $\frac{13}{16}$"

.254" REAMED

$\frac{5}{8}$"

.072" SLOT

(#13 B. & S. GA. SLOTTING SAW)

3 HLS. — $\frac{1}{4}$" X 20 TAP

$\frac{11}{32}$" DRILL

120°

$\frac{5}{8}$"

1" / 2

9" / 32 — 9" / 32

FACE FLAT WITH PILOT C'BORE.

THIS BOSS SLOTTED

$\frac{5}{8}$"

$\frac{11}{16}$"

1 REQUIRED

FACE FLAT TO $\frac{11}{16}$" DIM. BEFORE DRILLING 2 BOSSES.

1 $\frac{29}{32}$" — 2 $\frac{15}{16}$" — $\frac{23}{64}$" — $\frac{3}{16}$" — 1 $\frac{1}{8}$" — $\frac{3}{16}$"

OBSOLETE

SIZE	#12	ISSUE 1-24-41	J.V.W.
KIND	ALUM. CAST.	CHANGED	
SHAPE		"	
FINISH		"	
TEMP.		"	
PATT.	1692	"	

TITLE: FISCHER MOD. "100-96" DIAGNOSTIC S.P. X-RAY TUBE STAND SLIDE BALL BEARING SUPP. - LOWER

H. G. FISCHER & CO.
2335 WABANSIA AVE.
CHICAGO, ILL.

CAT. NO.

PART NO. 13231F

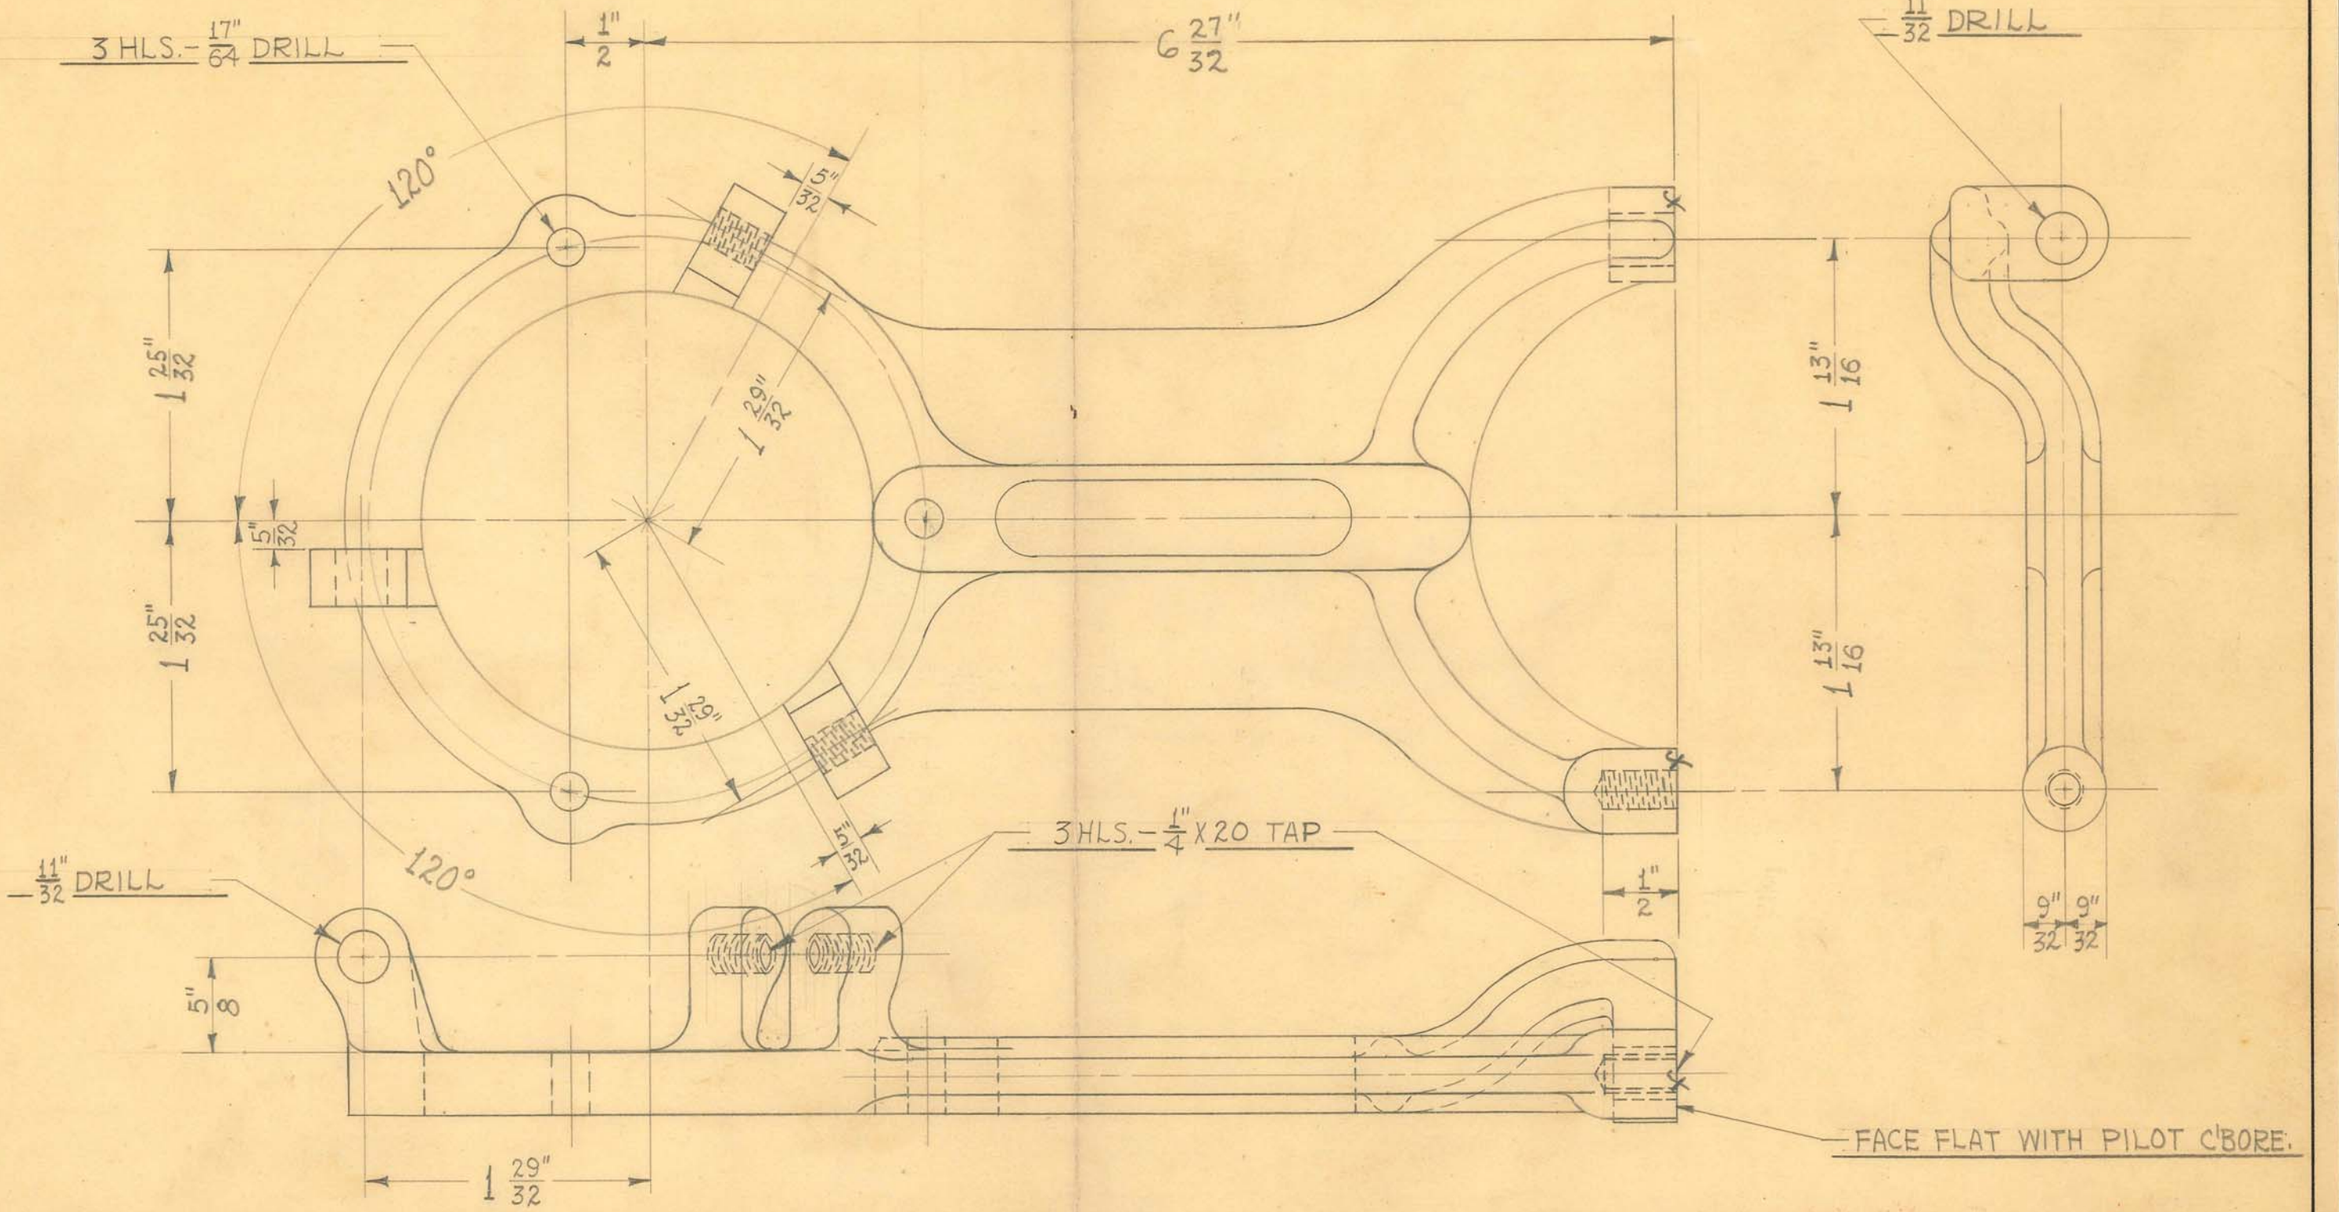

1 REQUIRED

OBSOLETE

SIZE	#12	ISSUE 1-23-41	J.Y.W.
KIND	ALUM. CAST.	CHANGED	
SHAPE		"	
FINISH		"	
TEMP.		"	
PATT.	1693	"	

TITLE:
FISCHER MOD. "100-96" DIAG. S.P. X-RAY UNIT
SLIDE BALL BEARING SUPPORT- UPPER

H. G. FISCHER & CO.
2335 WABANSIA AVE.
CHICAGO, ILL.

CAT. NO.

PART NO. 13232F

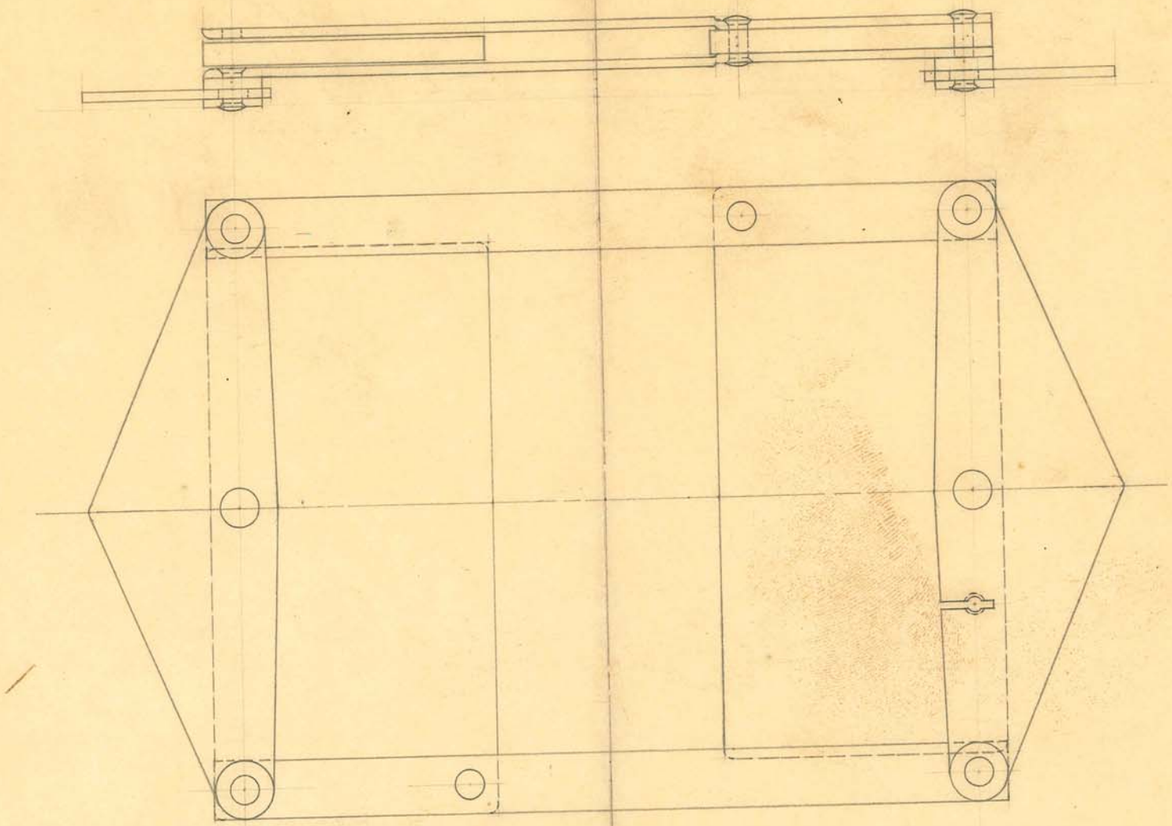

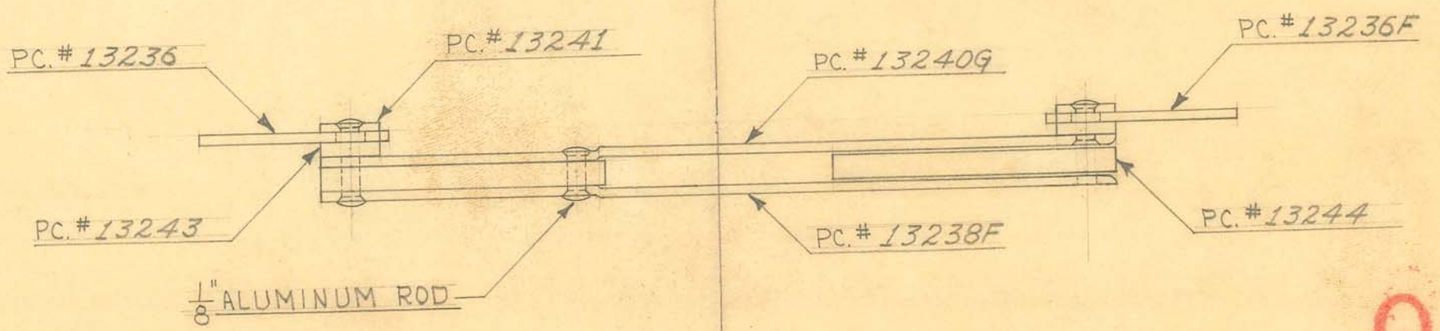

SCALE ≈ FULL SIZE

1 REQUIRED

OBSOLETE

SIZE		ISSUE 2-14-40	HE.	TITLE: FISCHER MOD. "200" X-RAY UNIT HORIZONTAL SHUTTER ASSEM.
KIND		CHANGED		
SHAPE		"		
FINISH		"		
TEMP.		"		
PATT.		"		

H. G. FISCHER & CO.
2338 WABANSIA AVE.
CHICAGO, ILL.

CAT. NO.

PART NO. 13245G

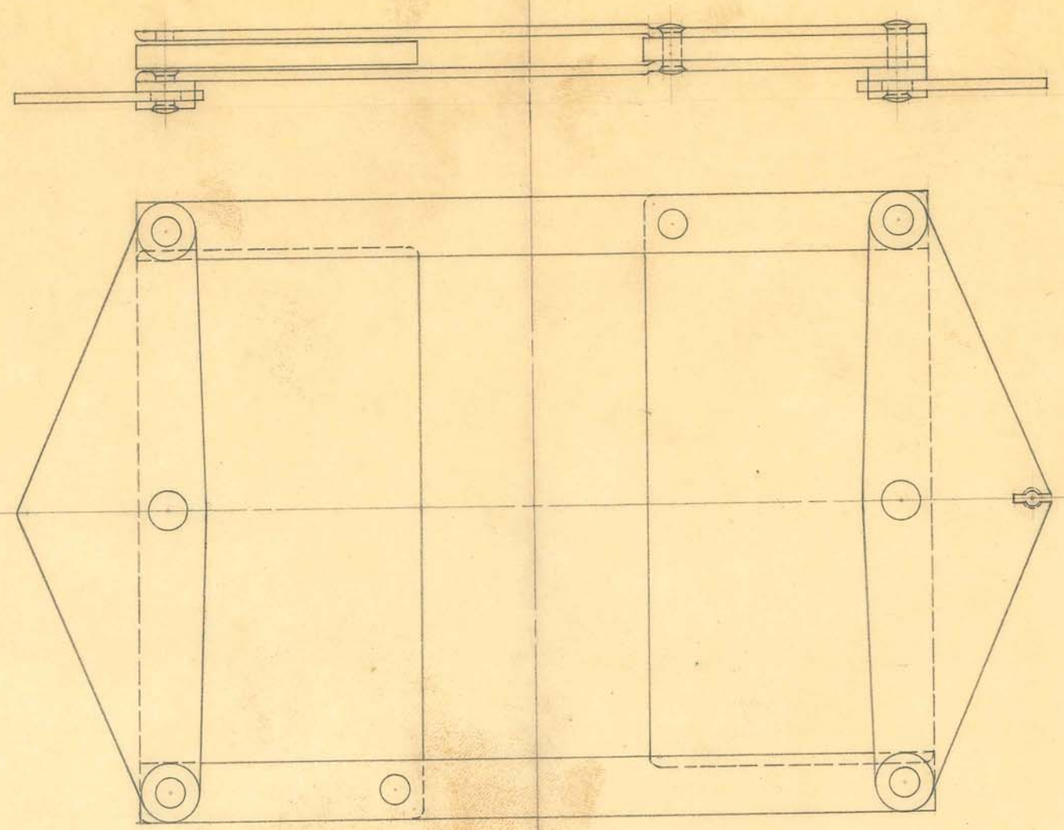

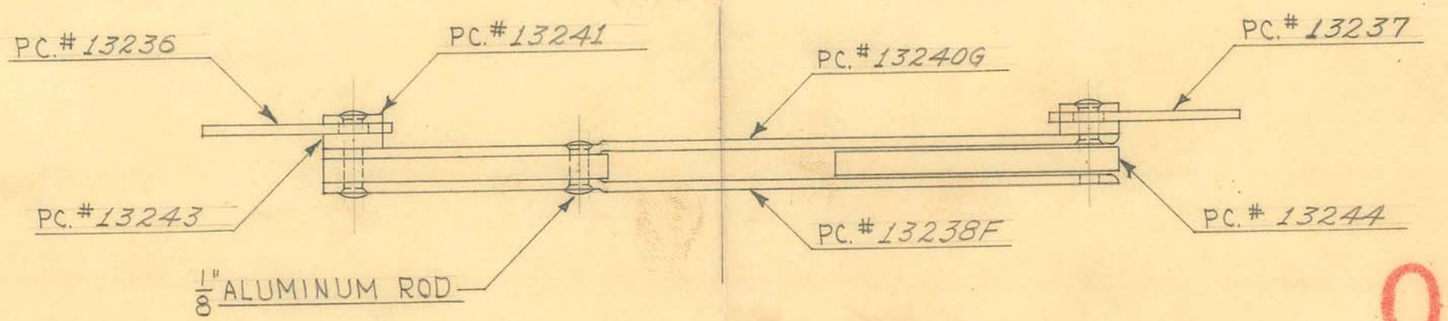

OBSOLETE

SCALE ÷ FULL SIZE

1 REQUIRED

SIZE		ISSUE 2-14-40	HE
KIND		CHANGED	
SHAPE		"	
FINISH		"	
TEMP.		"	

TITLE: FISCHER MOD. "100" X-RAY UNIT
VERTICAL SHUTTER ASSEMBLY

H. G. FISCHER & CO.
2335 WABANSIA AVE.
CHICAGO, ILL.

CAT. NO.

PART NO. 132469

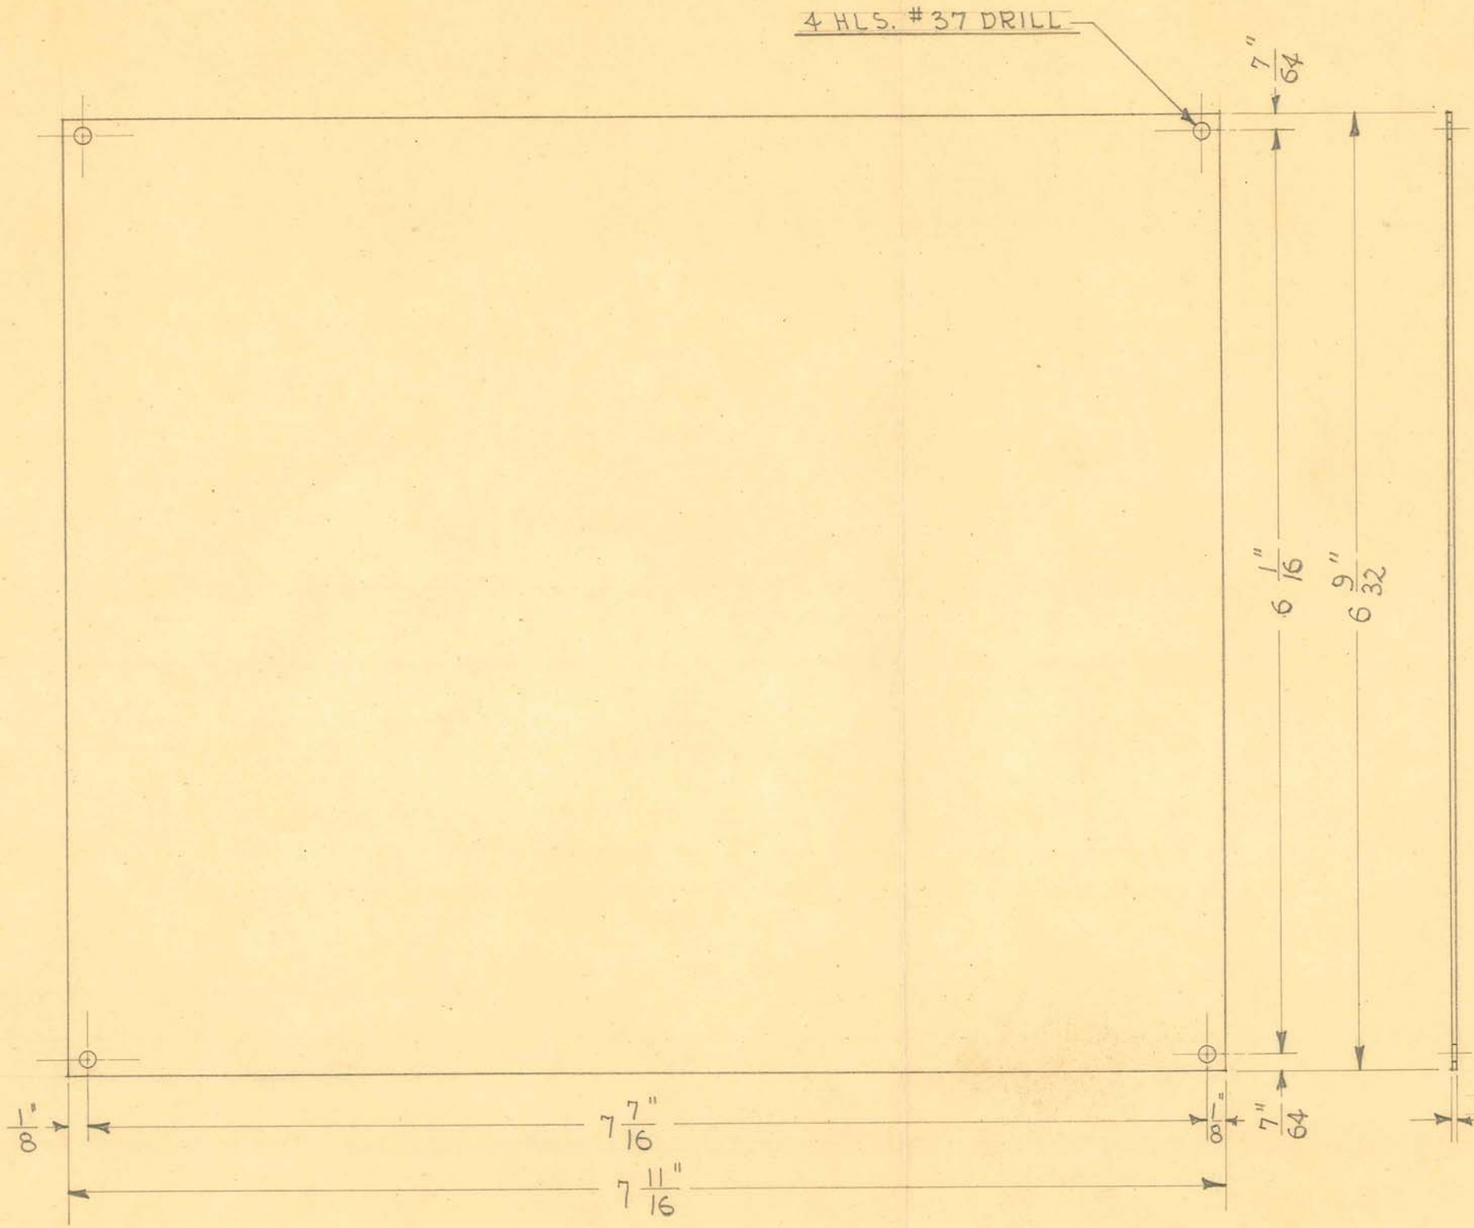

OBSOLETE

1 REQUIRED

SIZE	.020"	ISSUE 6-26-40	HE.	TITLE: FISCHER MOD. "100" X-RAY UNIT - FILTER
KIND	ALUMINUM	CHANGED		
SHAPE	SHEET	"		
FINISH		"		
TEMP.		"		
		"		

H. G. FISCHER & CO.
2335 WABANSIA AVE.
CHICAGO, ILL.

CAT. NO.

PART NO. 13247

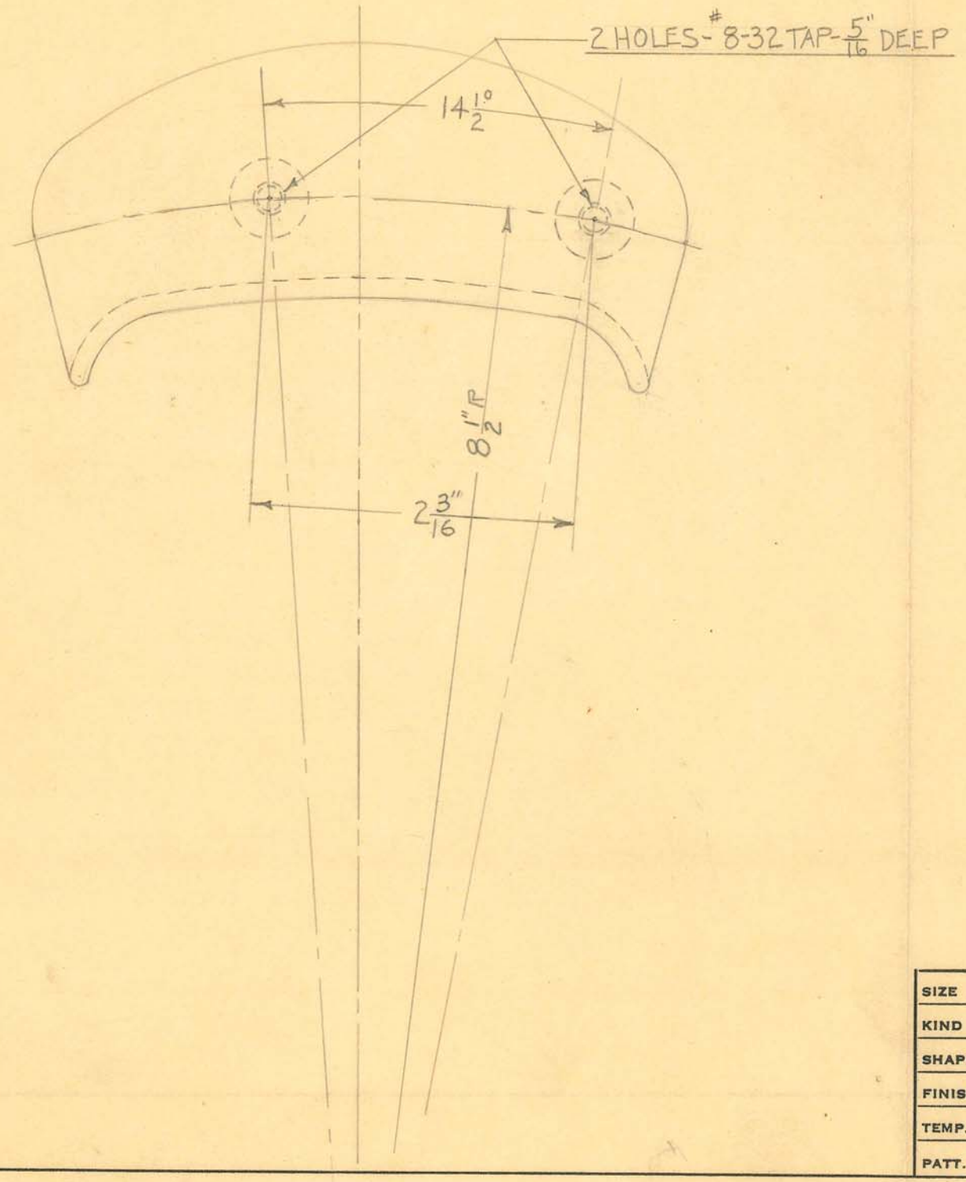

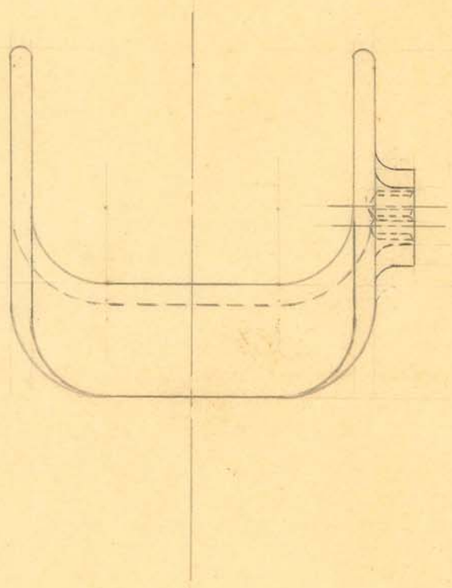

1 REQUIRED

OBSOLETE

SIZE		ISSUE 6-20-40	C.E.A	TITLE: FISCHER MOD. "100" X-RAY UNIT TUBE STAND — CABLE REST
KIND	#12 ALUMINUM	CHANGED		
SHAPE	CASTING	"		
FINISH		"		
TEMP.		"		
PATT.	1572	"		

H. G. FISCHER & CO.
2335 WABANSIA AVE.
CHICAGO, ILL.

CAT. NO.

PART NO. 13257F

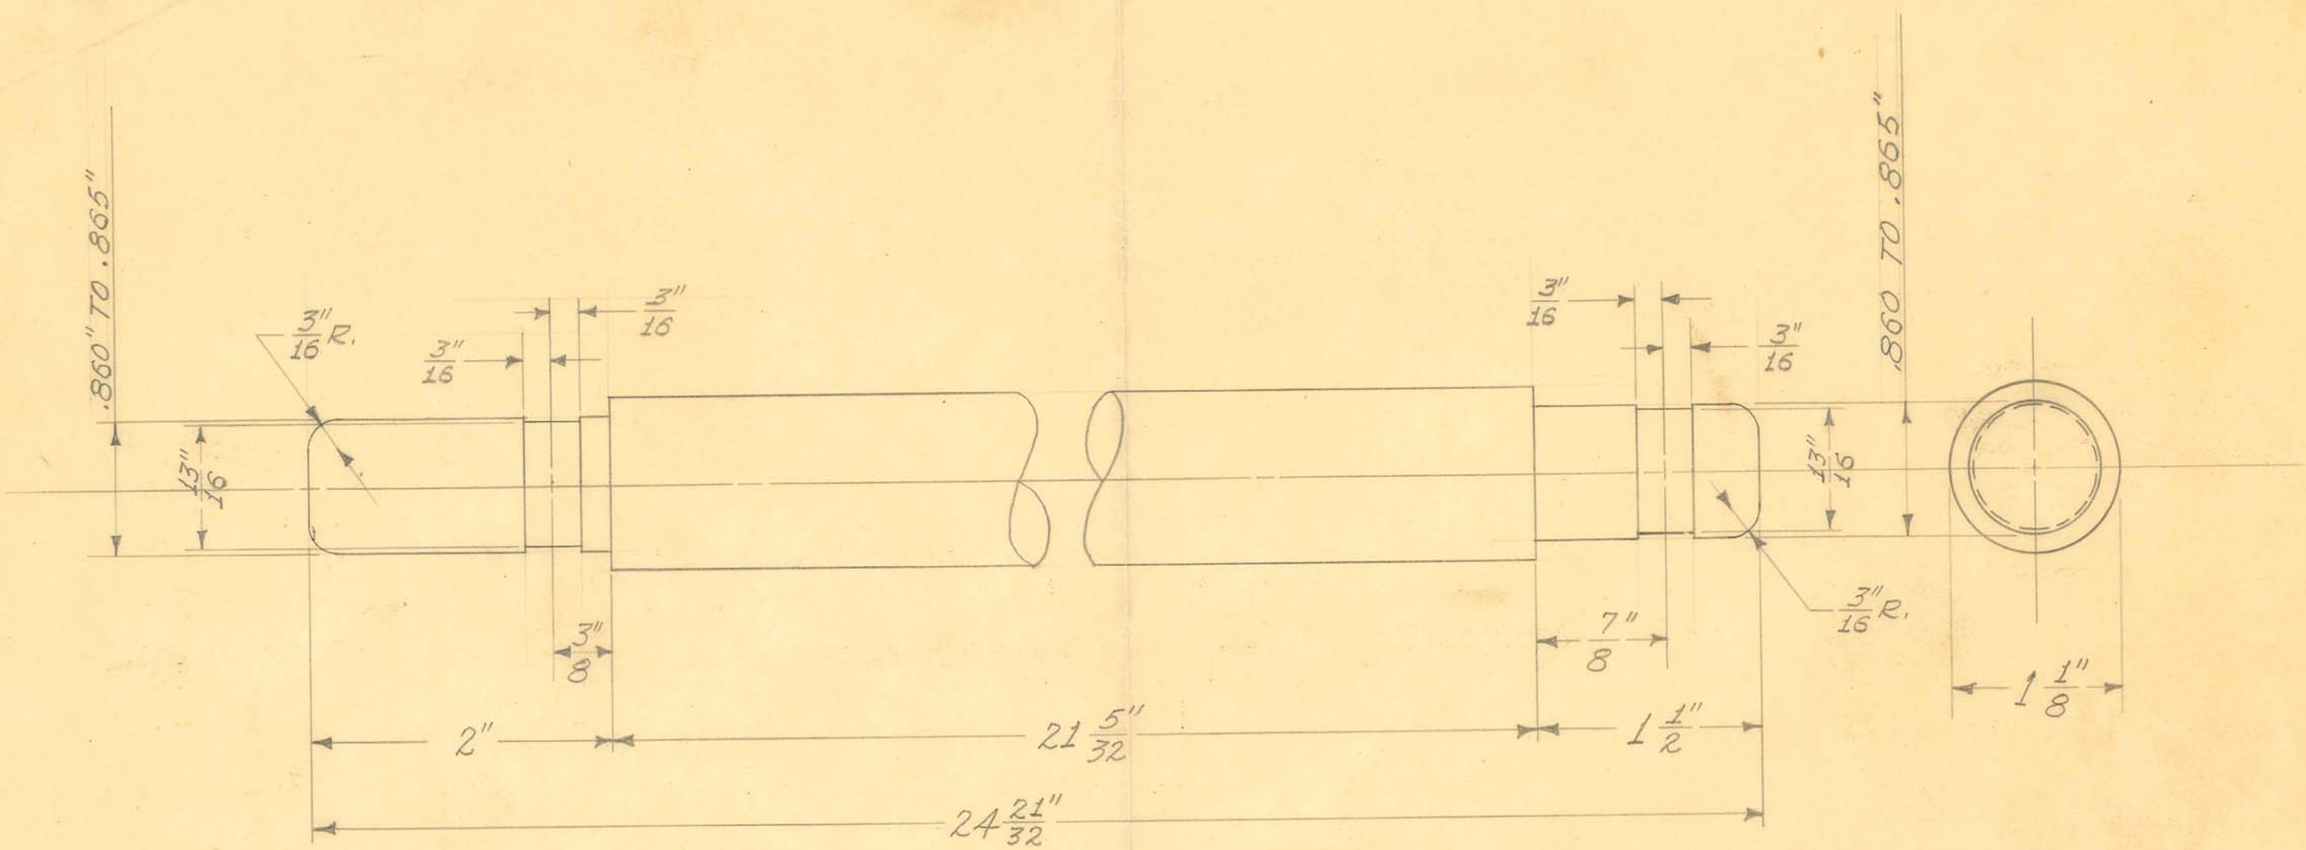

4. REQUIRED

OBSOLETE

SIZE	1 3/8" DIAM.	ISSUE 6-6-40	J.W.
KIND	C.R. STEEL	CHANGED	
SHAPE		"	
FINISH	CAD. #23	"	
TEMP.		"	

TITLE: FISCHER MOD. "100" X-RAY UNIT CONTROL BOX SUPPORT POST

H. G. FISCHER & CO.
2335 WABANSIA AVE.
CHICAGO, ILL.

CAT. NO.

PART NO. 13272

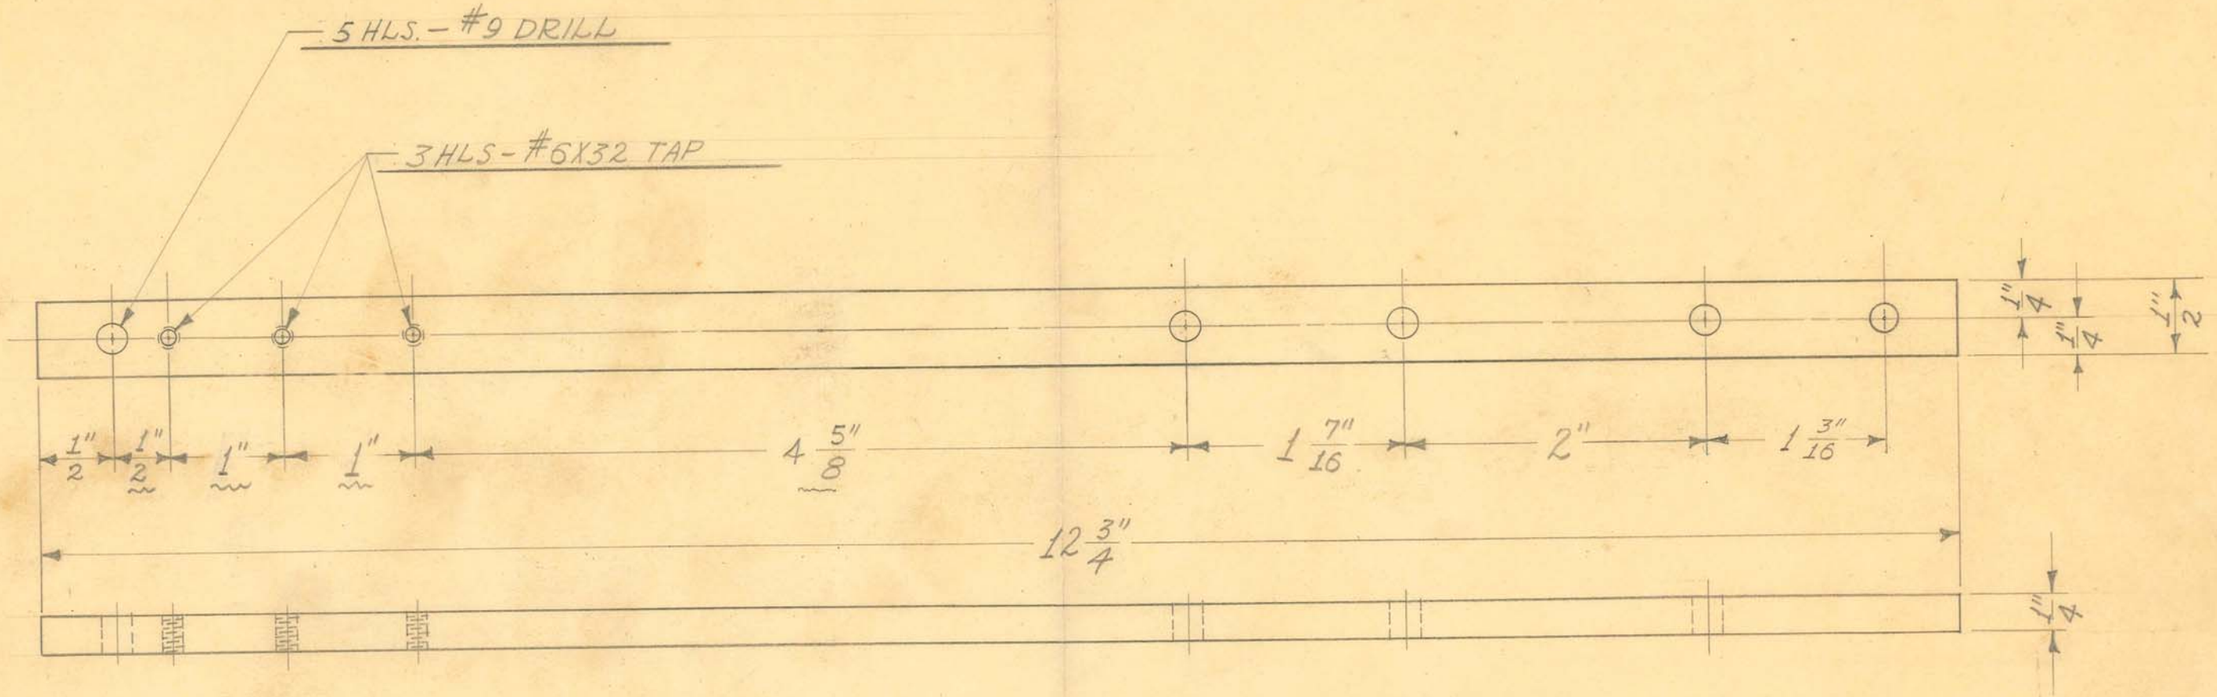

1 REQUIRED

OBSOLETE

SIZE	1/2" X 1/4"	ISSUE 6-6-40	J.W.
KIND	C.R. STEEL	CHANGED	
SHAPE	BAR	"	
FINISH	CAD. #23	"	
TEMP.		"	
DATE		"	

TITLE: FISCHER MOD. "100" X-RAY UNIT
CONTROL BOX - CONTROL BOARD - REINFORCING BAR

H. G. FISCHER & CO.
2335 WABANSIA AVE.
CHICAGO, ILL.

CAT. NO.

PART NO. 13273

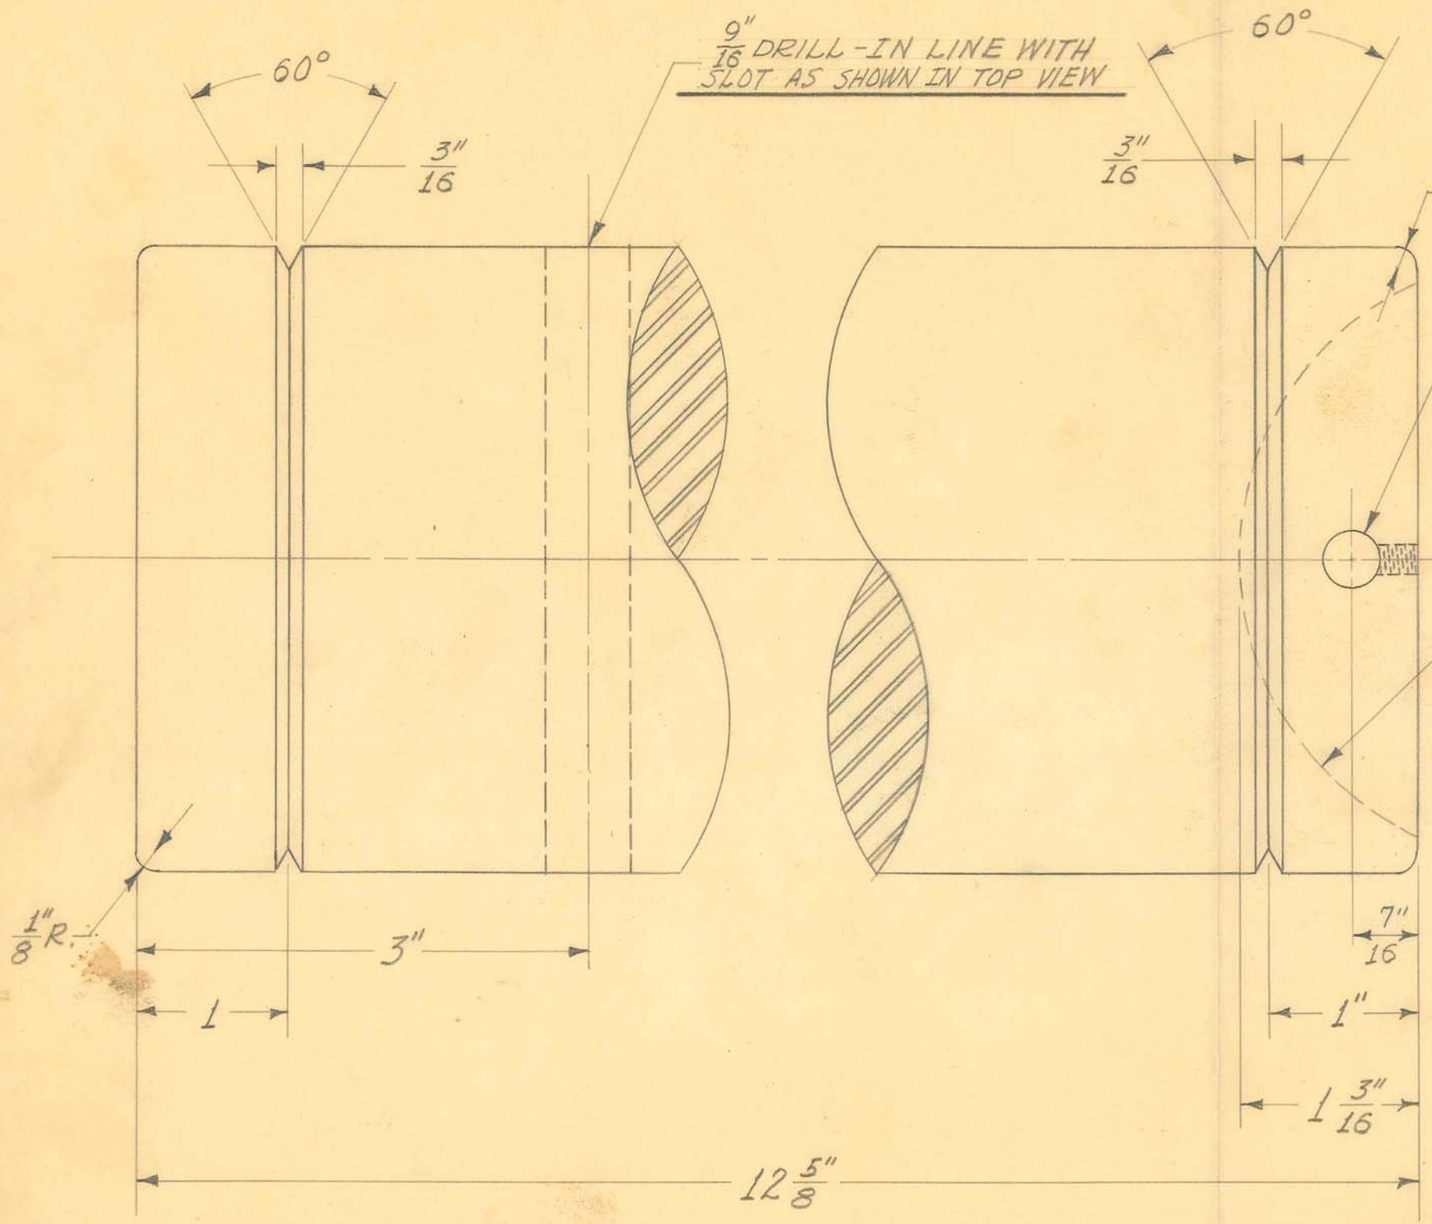

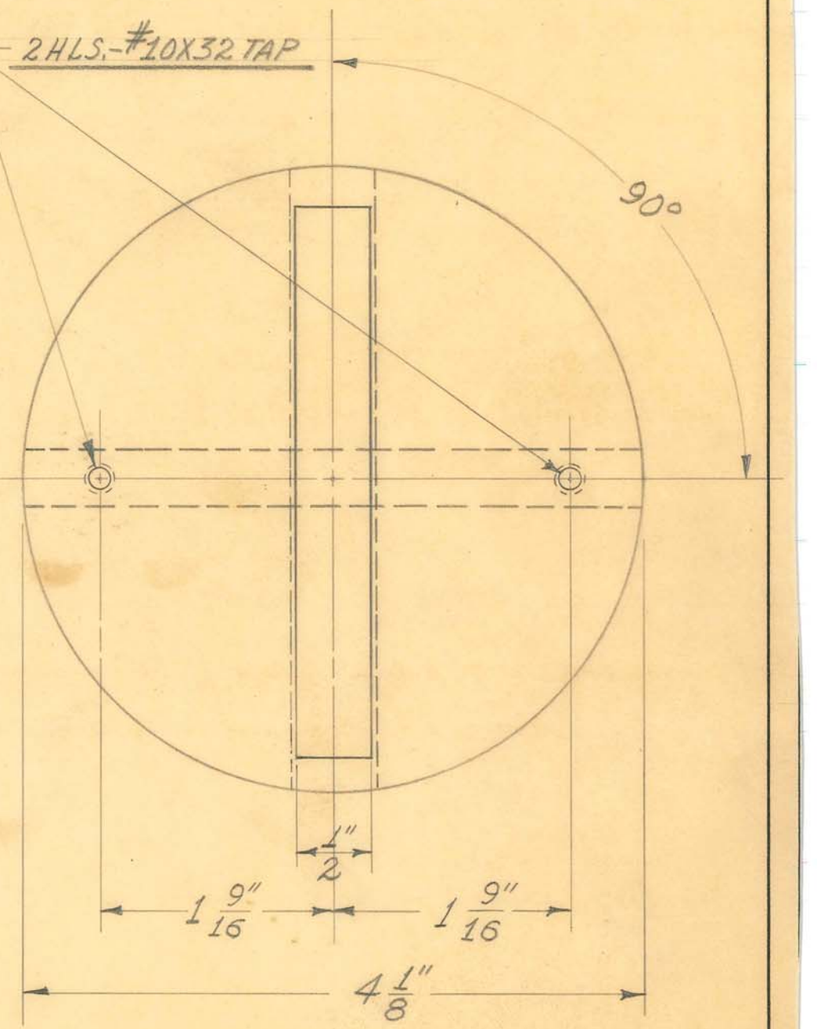

OBSOLETE

1 REQUIRED

SIZE	4 5/8" DIAM.	ISSUE 7-3-40	J.W.
KIND	C.R. STEEL	CHANGED	
SHAPE		"	
FINISH		"	
TEMP.		"	
PATT.		"	

TITLE: FISCHER MOD "100" X-RAY UNIT COUNTERWEIGHT - FINISHED

H. G. FISCHER & CO.
2338 WABANSIA AVE.
CHICAGO, ILL.

CAT. NO.

PART NO. 13274F

REVISION		DATE	BY
A	WAS $14\frac{1}{4}$"	9-22-50	J.V.W.

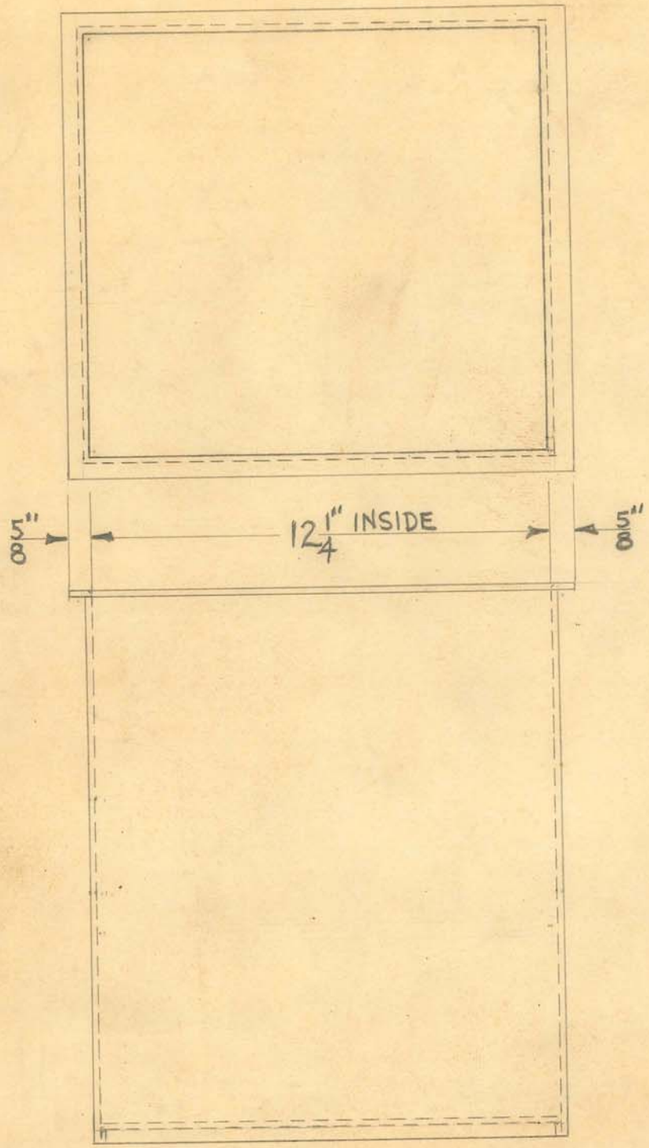

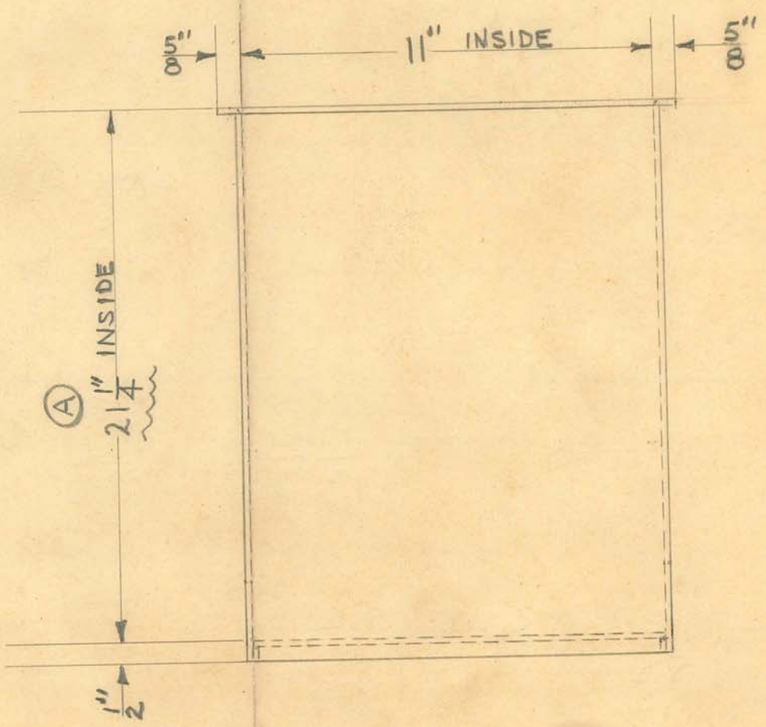

1-REQUIRED

obsolete
9-14-52

NOTE: TANK MUST BE OIL TIGHT

SCALE – ONE FOURTH SIZE

SIZE	.093-U.S.GA.#13	ISSUE 6-7-40	C.E.A.
KIND	SHEET STEEL	CHANGED	
SHAPE		" 5-9-47	J.V.W.
FINISH		"	
TEMP.		"	
PATT.		"	

TITLE: FISCHER MOD "100" X-RAY UNIT
TRANSFORMER TANK

OBSOLETE

H. G. FISCHER & CO. 2335 WABANSIA AVE. CHICAGO, ILL.	CAT. NO.	PART NO. 13278 B

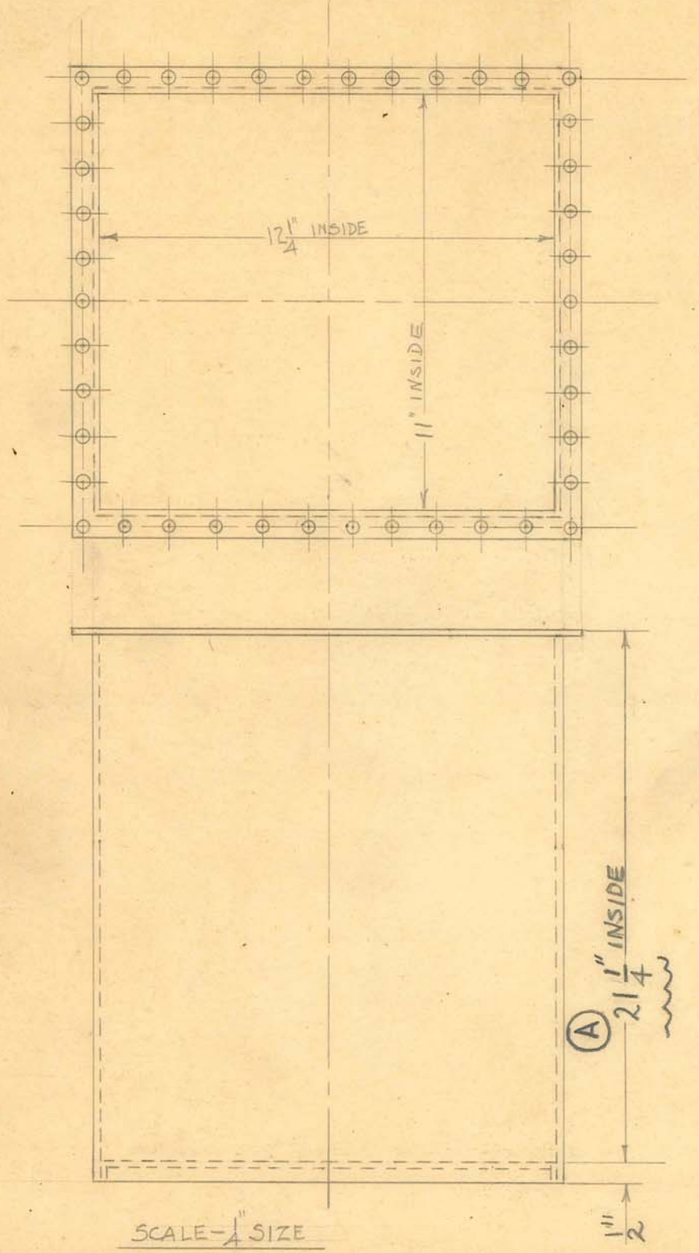

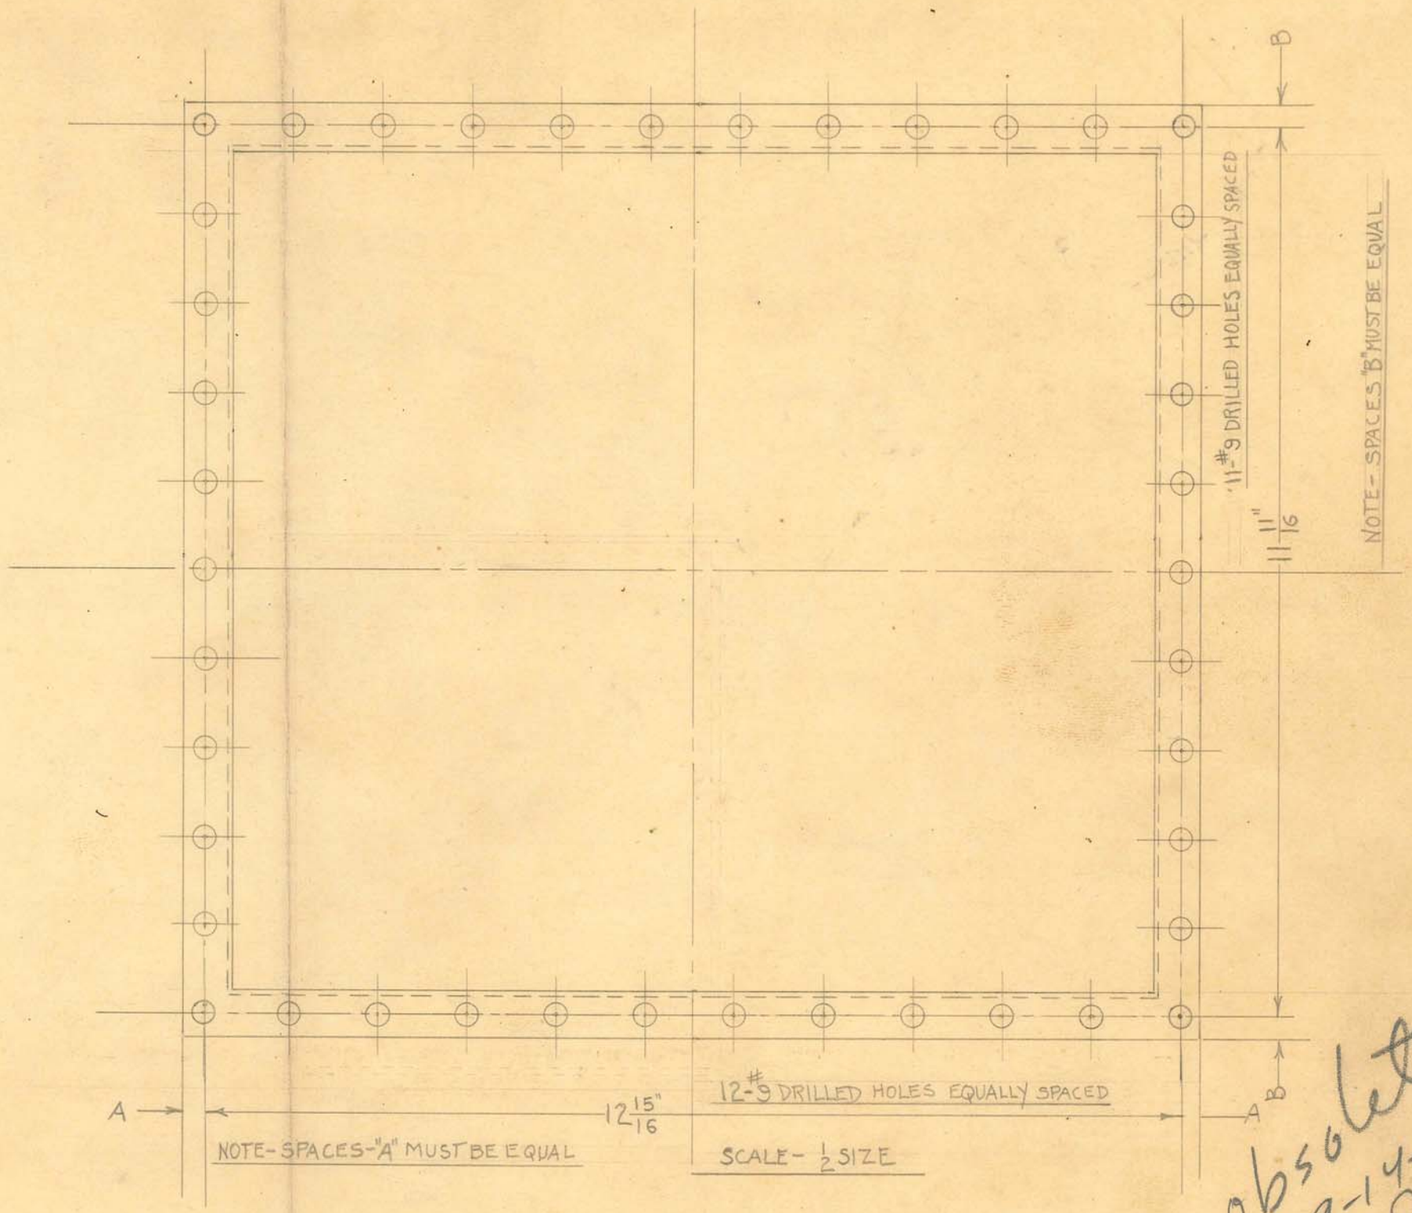

obsolete 9-14-56

REVISION	DATE	BY
A · WAS 14 1/4"	9-26-50	W.J.

SIZE	.093"-U.S.GA. #13	ISSUE 6-10-40	C.E.A.	
KIND	SHEET STEEL	CHANGED		
SHAPE		" 5-9-47	J.Y.W.	
FINISH		"		
TEMP.		"		
PATT.		"		

TITLE: FISCHER MOD. "100" X-RAY UNIT
TRANSFORMER TANK

OBSOLETE

H. G. FISCHER & CO.
2335 WABANSIA AVE.
CHICAGO, ILL.

CAT. NO.

PART NO. 13278 BF

ALL #9 DRILLED HOLES AROUND EDGE OF PANEL TO BE C'SUNK. APPROX. $\frac{1}{4}$" FACE ON TOP SIDE ONLY

$\frac{3}{4}$" DRILL & $1\frac{3}{8}$" C'BORE. $\frac{3}{16}$" DEEP ON UNDER SIDE.

$5\frac{1}{4}$"

$1\frac{1}{8}$" $1\frac{1}{8}$" $1\frac{1}{8}$"

$\frac{1}{4}$"-20 TAP

$\frac{1}{4}$"-20 TAP P2 #10-32 TAP F2 F1 P1

FC M #8-32 TAP G

$2\frac{1}{4}$"

$3\frac{1}{8}$" $3\frac{7}{16}$" $4\frac{3}{8}$"

$1\frac{7}{16}$" $1\frac{9}{16}$"

$5\frac{1}{8}$" $5\frac{1}{8}$"

$2\frac{1}{4}$" $2\frac{1}{4}$"

60° 60° 60° 60° 60° 60° 60° 60° 60° 60° 60° 60°

$\frac{3}{4}$" $\frac{3}{4}$"

#10-32 TAP #10-32 TAP #10-32 TAP

$\frac{3}{8}$" DIA. SCREW CIRCLE

$1\frac{11}{16}$" BORE $1\frac{11}{16}$" BORE

$\frac{3}{4}$" $\frac{3}{4}$"

$\frac{13}{32}$" DRILL $\frac{13}{32}$" DRILL

$1\frac{9}{16}$" $1\frac{9}{16}$"

$\frac{3}{4}$" $\frac{3}{4}$"

$4\frac{5}{8}$"

$6\frac{1}{8}$"

11 #9 DRILLED HOLES SPACED EQUALLY

$11\frac{1}{16}$" SPACES "B" MUST BE EQUAL

$6\frac{1}{8}$"

B B

A A

$12\frac{15}{16}$" 12 #9 DRILLED HOLES SPACED EQUALLY

NOTE- SPACES "A" MUST BE EQUAL

$6\frac{3}{4}$" $6\frac{3}{4}$"

1-REQUIRED

$\frac{3}{8}$"

SCALE- HALF SIZE

Obsolete 9-14-52

SIZE	$\frac{3}{8}$" THICK	ISSUE 6-11-40	C.E.A.	TITLE: FISCHER MOD. "100" X-RAY UNIT TRANSFORMER PANEL -ENGRAVED- OBSOLETE
KIND	BAKE LITE	CHANGED		
SHAPE		" 1-23-45	H.E.	
FINISH		"4-17-45	J.V.W.	
TEMP.		"		
PATT.		"		

H. G. FISCHER & CO. 2335 WABANSIA AVE. CHICAGO, ILL. | CAT. NO. | PART NO. 13279FB

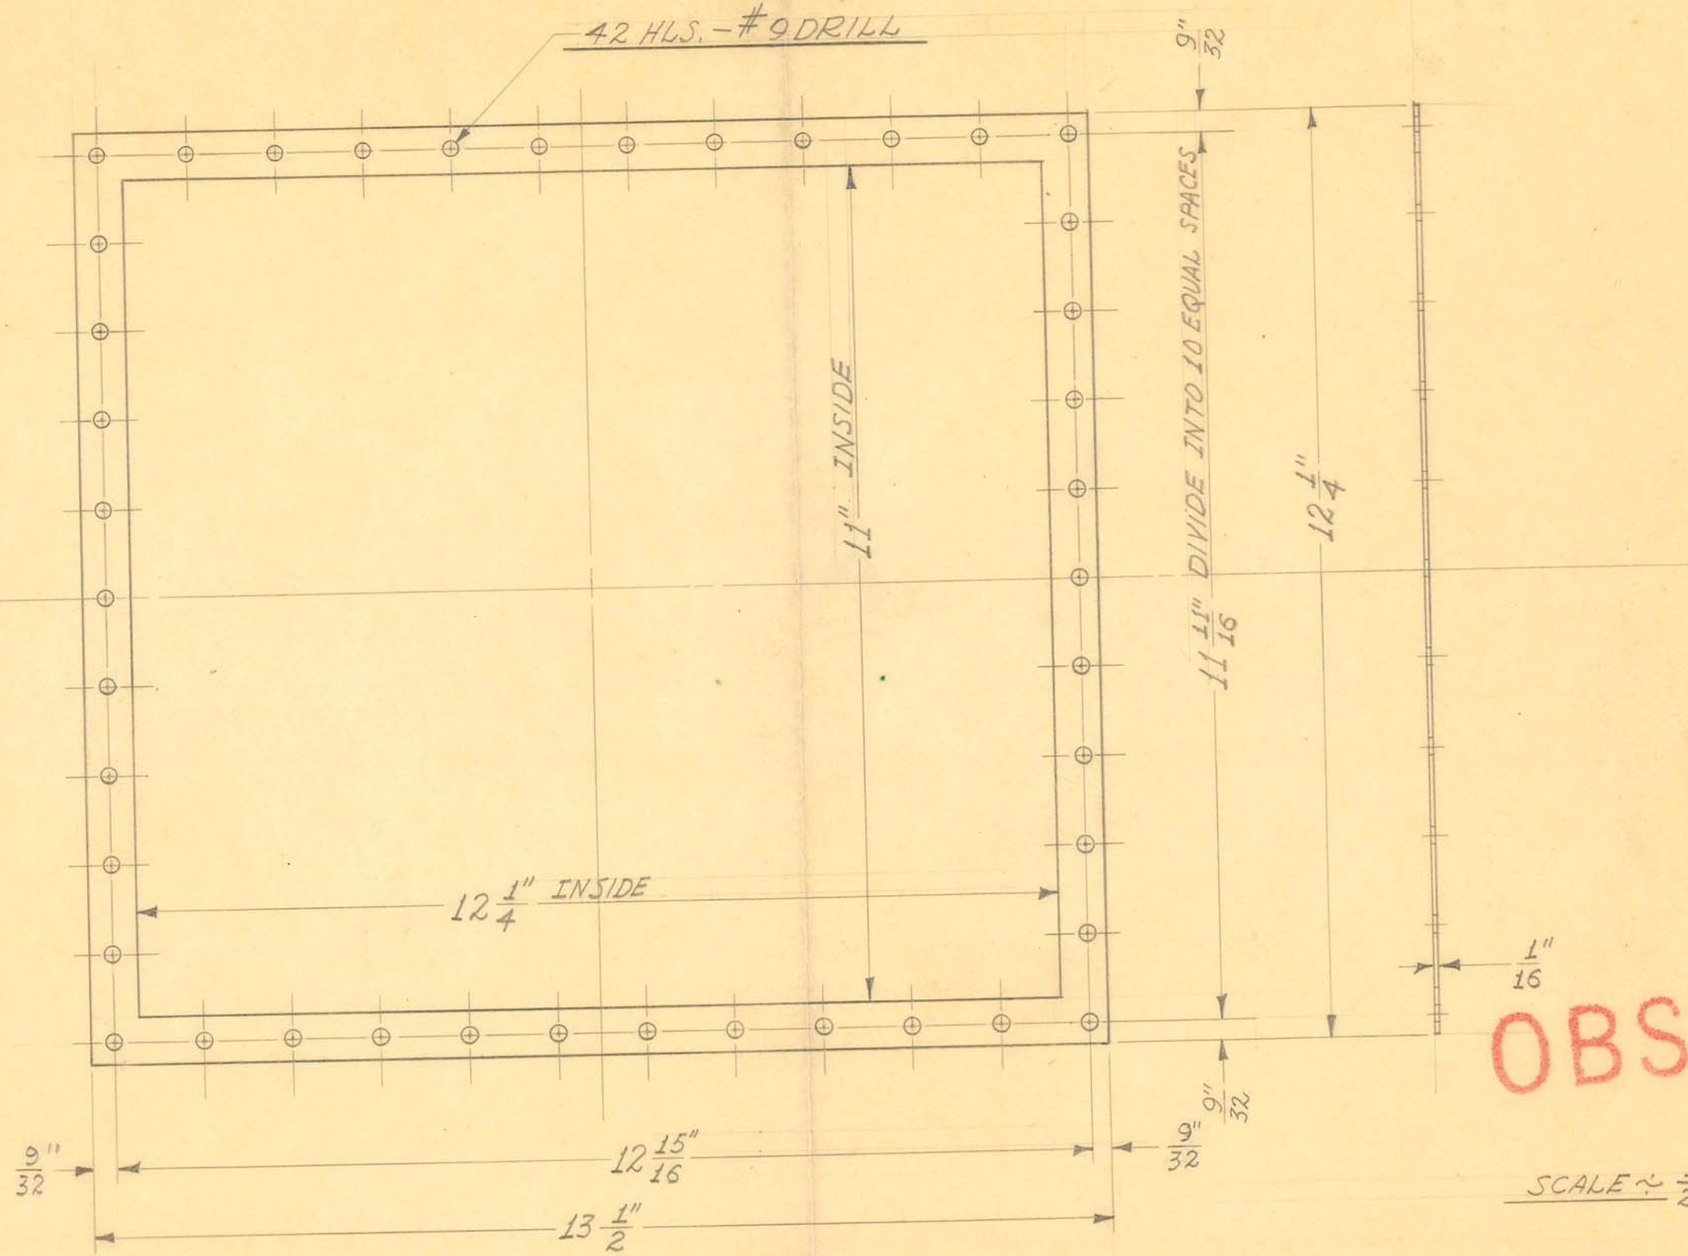

OBSOLETE

SCALE ~ 1/2" = 1"

1 REQUIRED

SIZE	1/16" SHEET	ISSUE 6-13-40	J.W.	
KIND	VELLUMOID	CHANGED		
SHAPE		"		
FINISH		"		
TEMP.		"		
PATT.		"		

TITLE: FISCHER MOD. "100" X-RAY UNIT
TRANSFORMER PANEL GASKET

H. G. FISCHER & CO.
2335 WABANSIA AVE.
CHICAGO, ILL.

CAT. NO.

PART NO. 13282

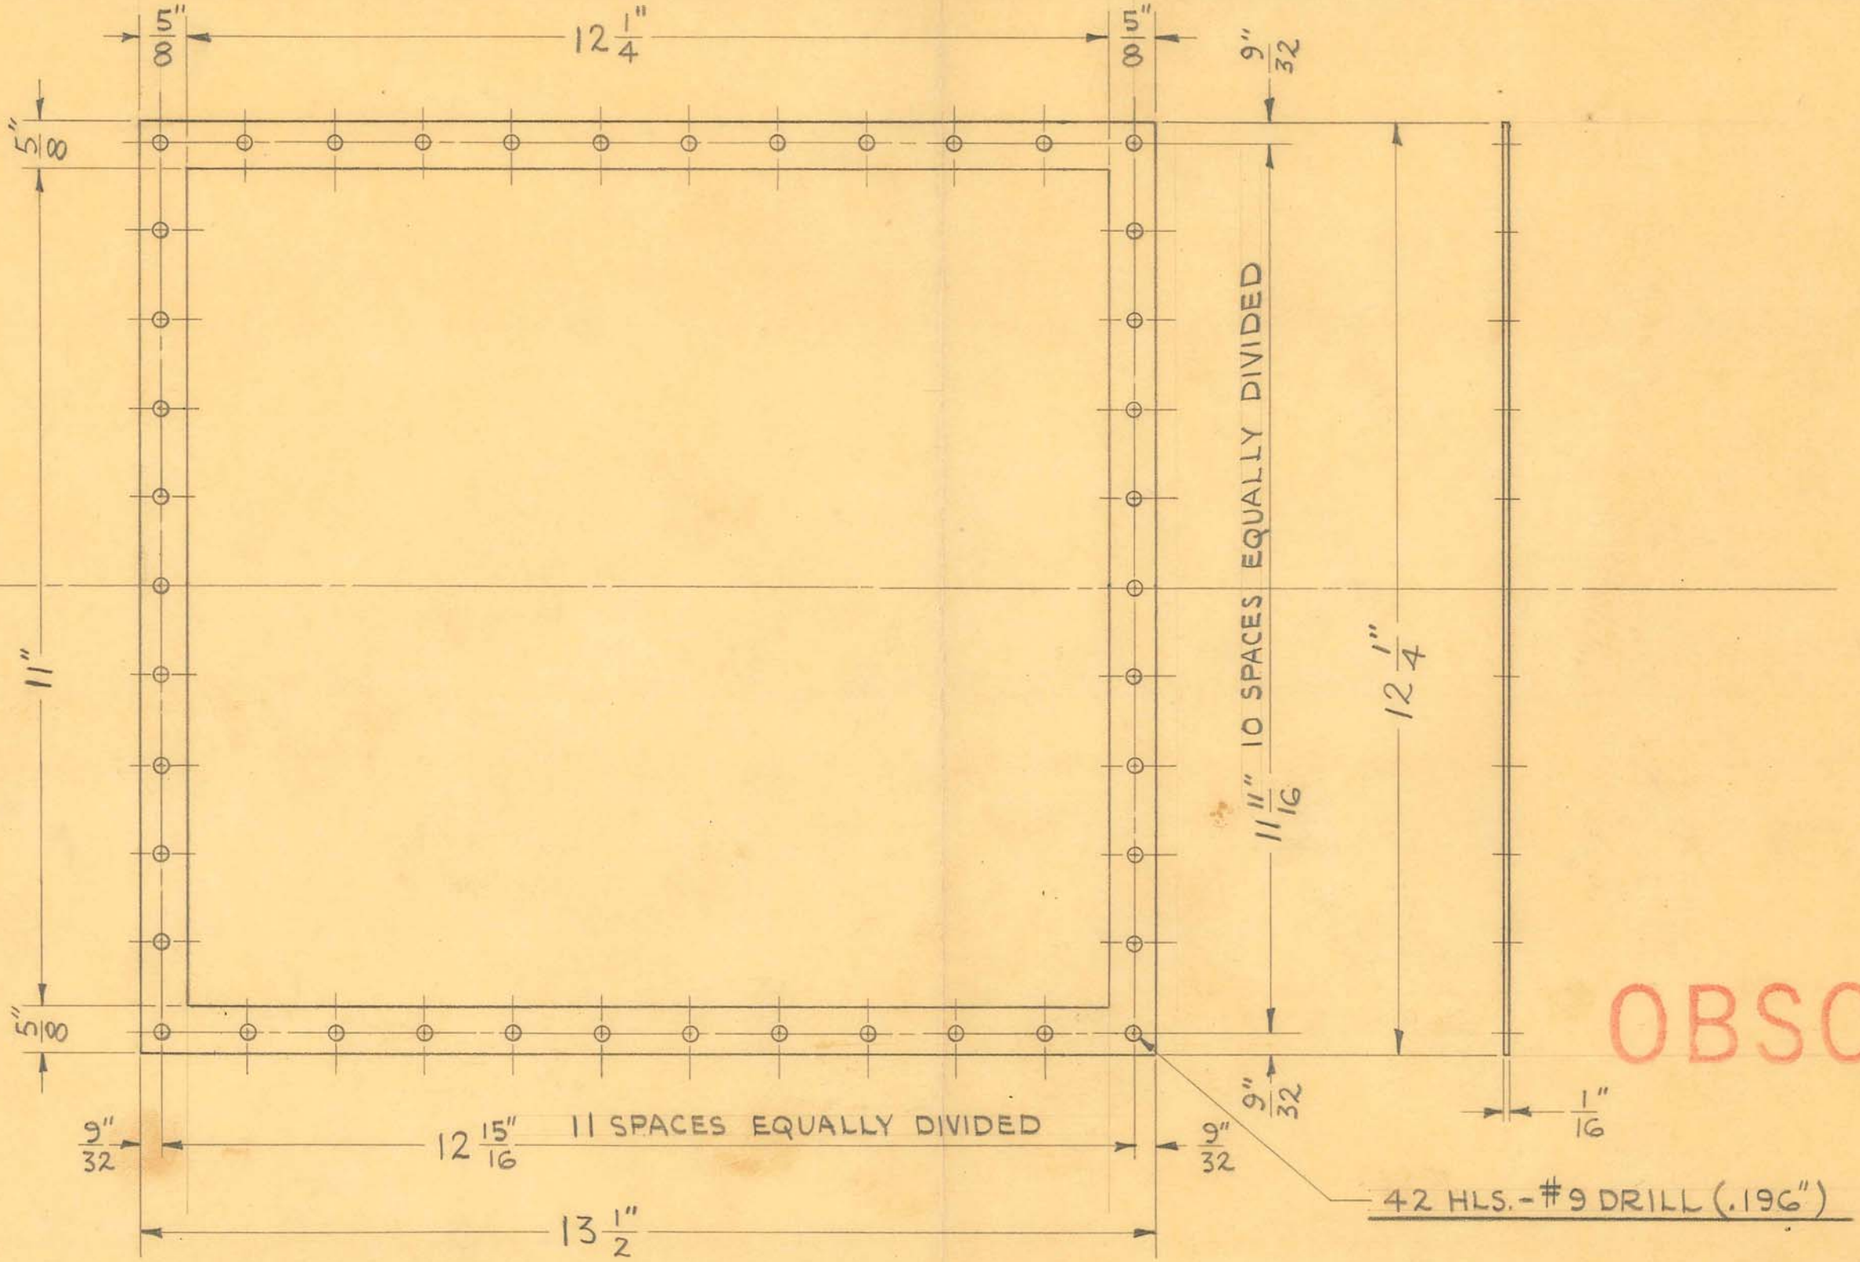

OBSOLETE

Obsolete
9-14-56

SCALE ≈ HALF SIZE

SIZE	1/16" SHEET	ISSUE 2-28-46	J.V.W.
KIND	TEXTICORK	CHANGED	
SHAPE		"	
FINISH		"	
TEMP.		"	

TITLE:
FISCHER "RF-100" X-RAY UNIT
H.T. TRANSFORMER TANK GASKET

H. G. FISCHER & CO.
2335 WABANSIA AVE.

CAT. NO.

PART NO. 13282A

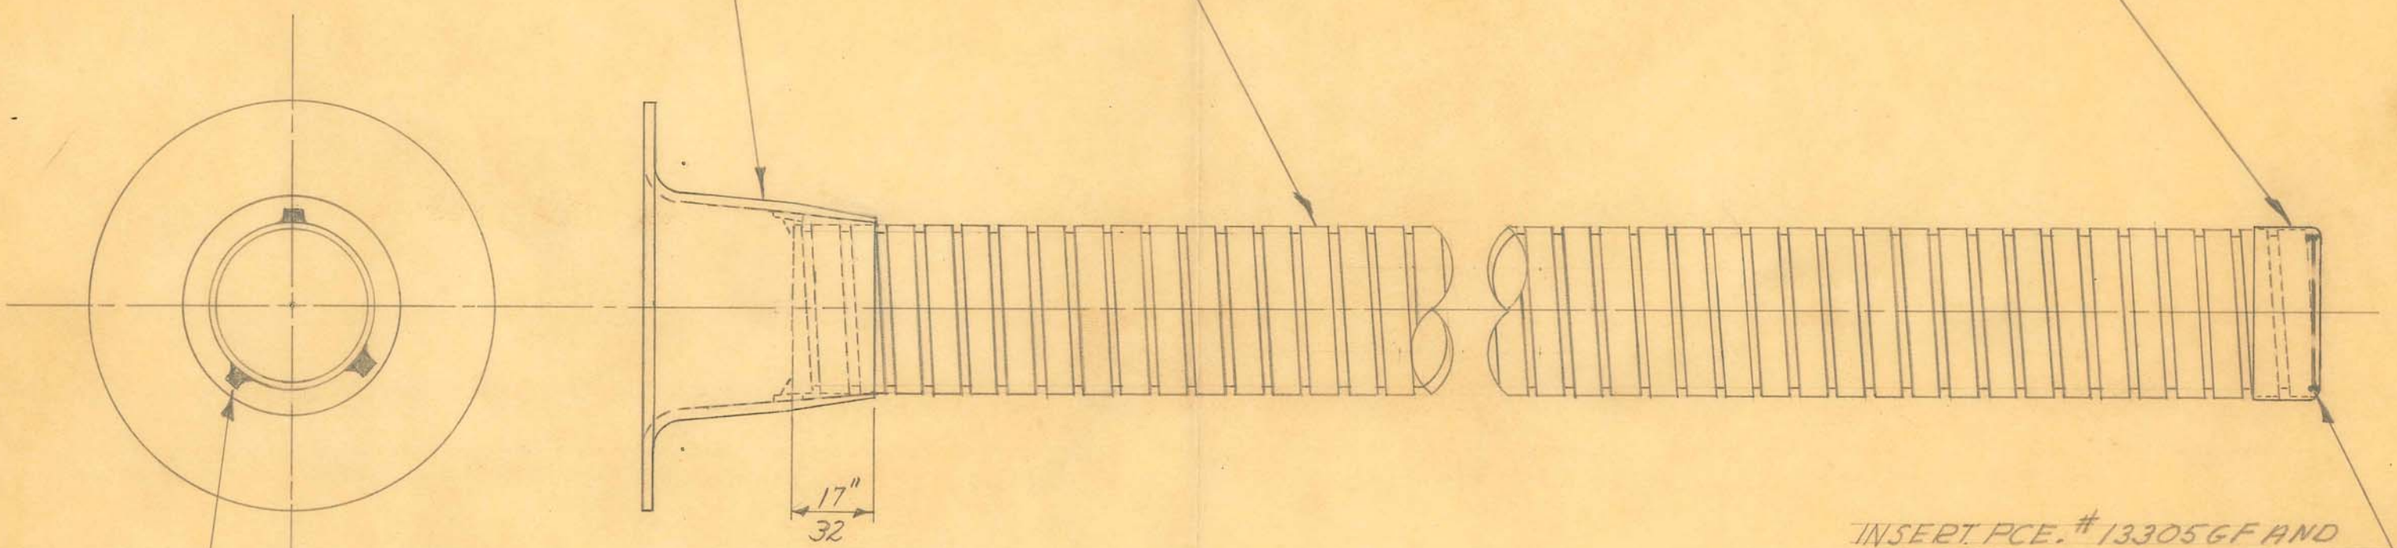

2 ~ REQUIRED

4-20-54

SIZE		ISSUE 10-8-47	J.M.F
KIND		CHANGED	
SHAPE		"	
FINISH		"	
TEMP.		"	
PATT.		"	

OBSOLETE

TITLE:
FISCHER MOD. "100" X RAY UNIT
H.T. CABLE FLEXABLE SLEEVE ASSEM
TUBE HEAD. END

H. G. FISCHER & CO.
2335 WABANSIA AVE.
CHICAGO, ILL.

CAT. NO.

PART NO. 13297G

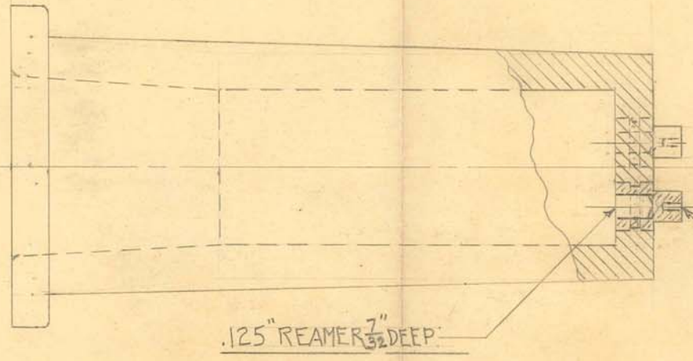

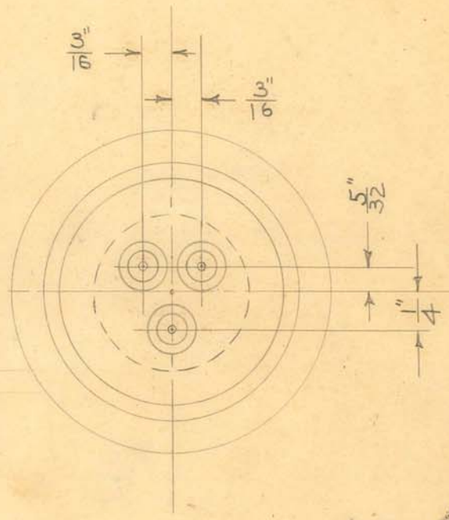

4 REQUIRED

New Tracing made

OBSOLETE

SIZE		ISSUE 6-24-40	C.E.A.
KIND	#105-53 NATURAL BAKELITE	CHANGED	
SHAPE	MOLDED	"	
FINISH		"	
TEMP.		"	
PATT.		"	

TITLE: FISCHER MOD. "100" X-RAY UNIT
H. T. POST SOCKET

H. G. FISCHER & CO.
2335 WABANSIA AVE.
CHICAGO, ILL.

CAT. NO.

PART NO. 13301GF

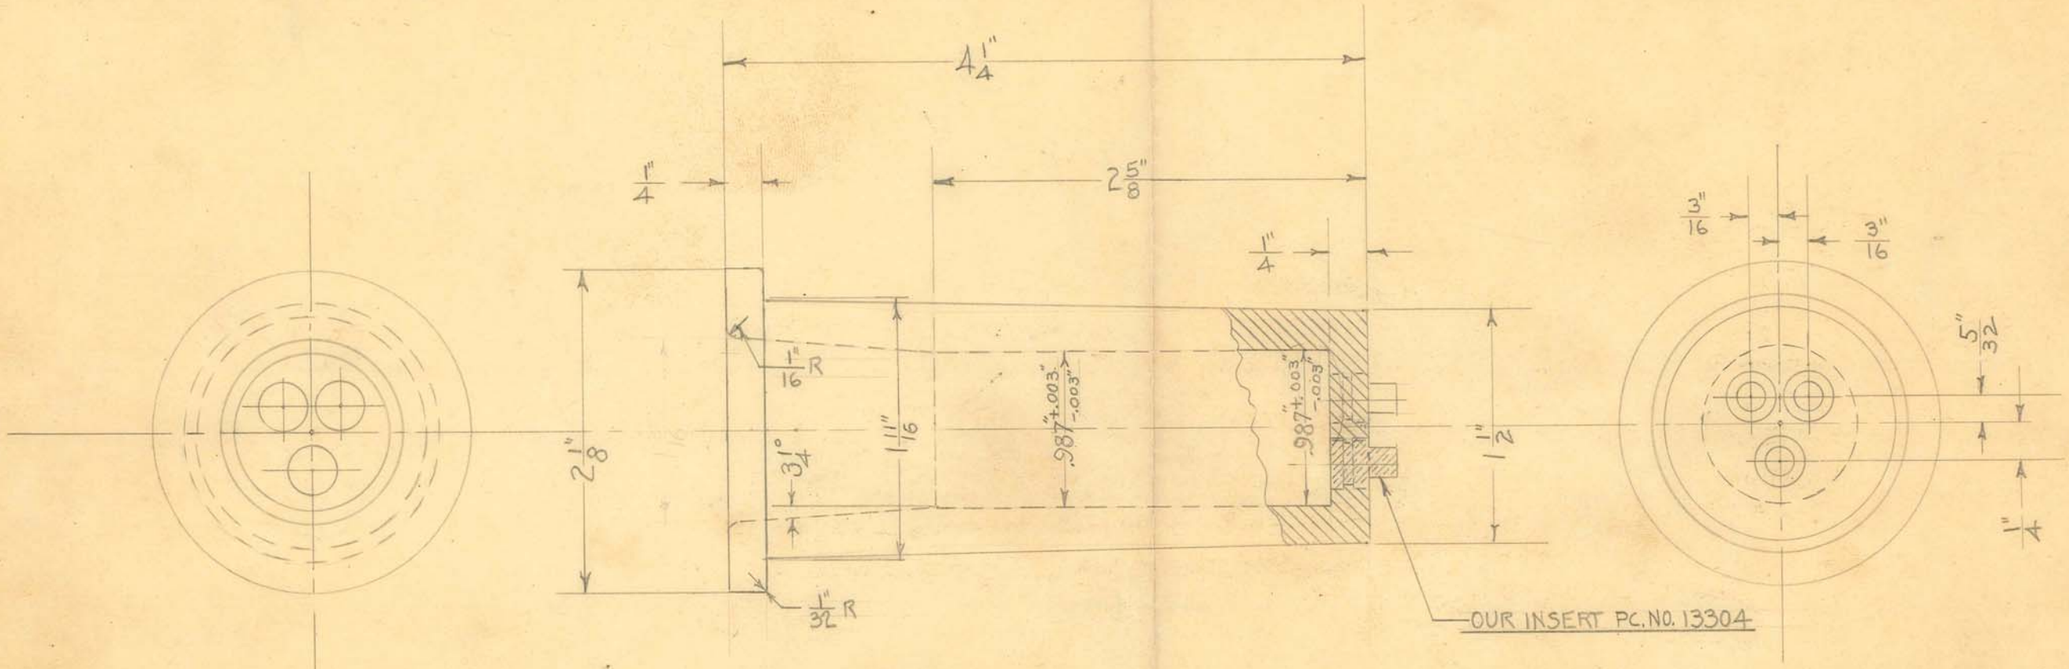

New tracing made

OBSOLETE

SIZE		ISSUE 6-24-40	C.E.A.
KIND	#105-53 NATURAL BAKELITE	CHANGED	
SHAPE	MOLDED	"	
FINISH		"	
TEMP.		"	
DATE		"	

TITLE: FISCHER MOD. "100" X-RAY UNIT
H. T. POST SOCKET

H. G. FISCHER & CO.
2335 WABANSIA AVE.
CHICAGO, ILL.

CAT. NO.

PART NO. 13301G

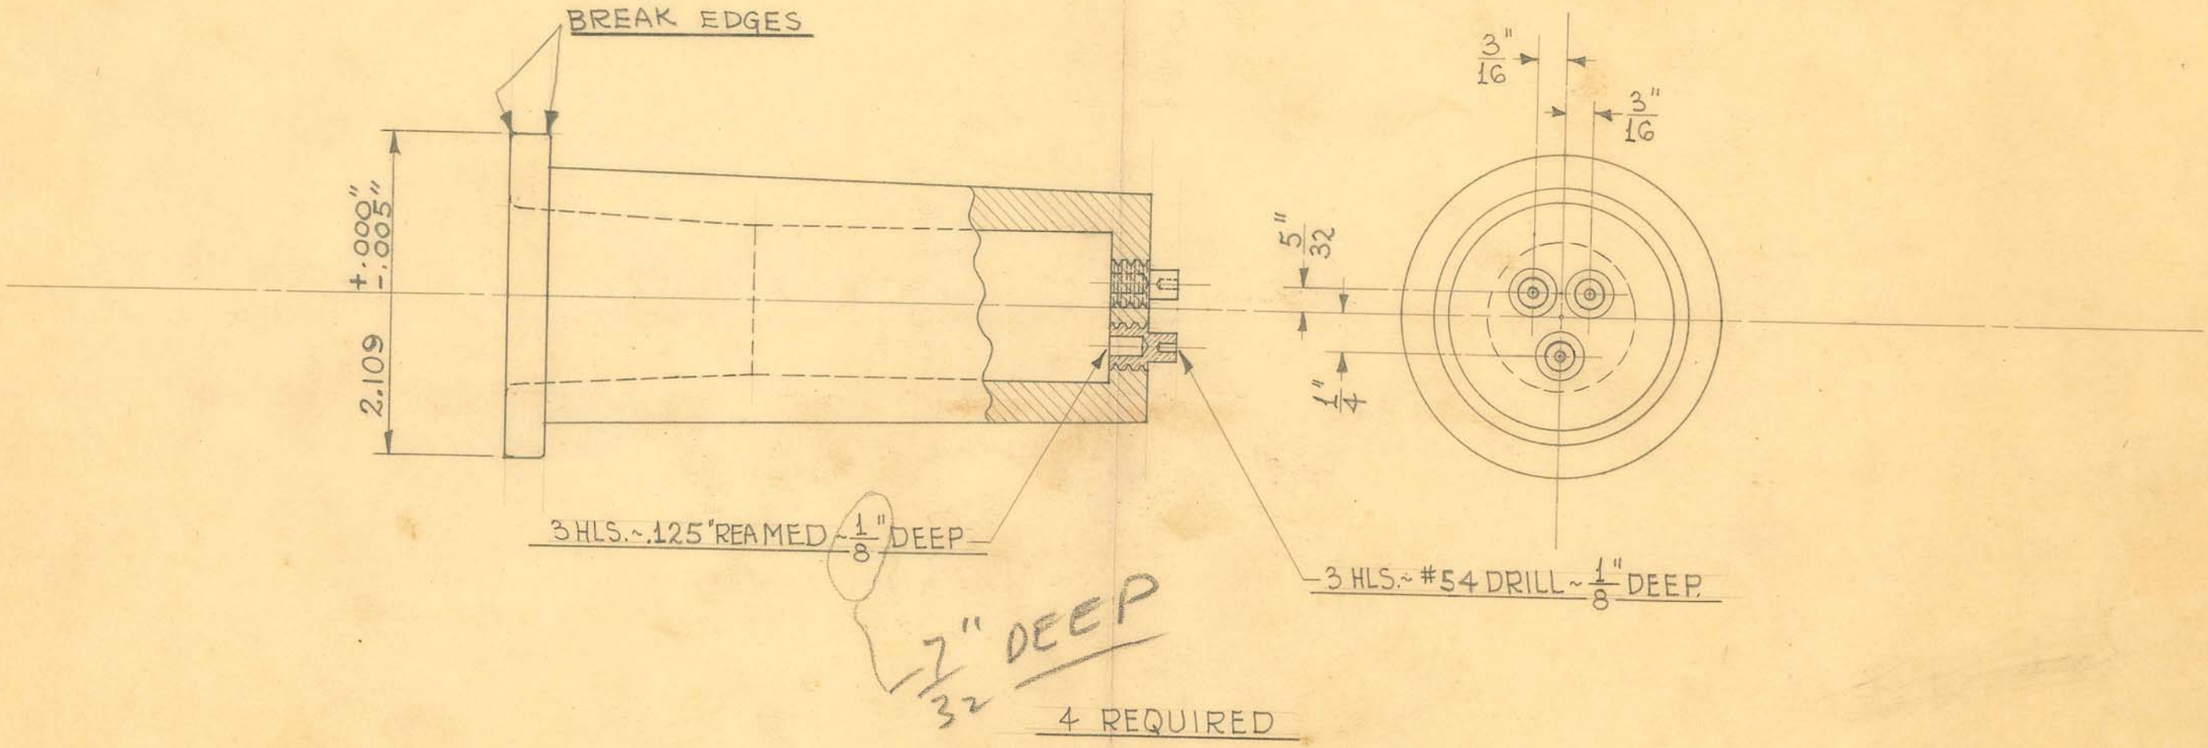

OBSOLETE
Obsolete

SIZE	FROM 13301GA	ISSUE 11-27-44	HE.	TITLE: FISCHER MOD. "100" X-RAY UNIT- H.T. POST SOCKET
KIND		CHANGED		
SHAPE		"		
FINISH		"		
TEMP.		"		
				H. G. FISCHER & CO. 2335 WABANSIA AVE. CHICAGO, ILL.
				CAT. NO.
				PART 13301GAE

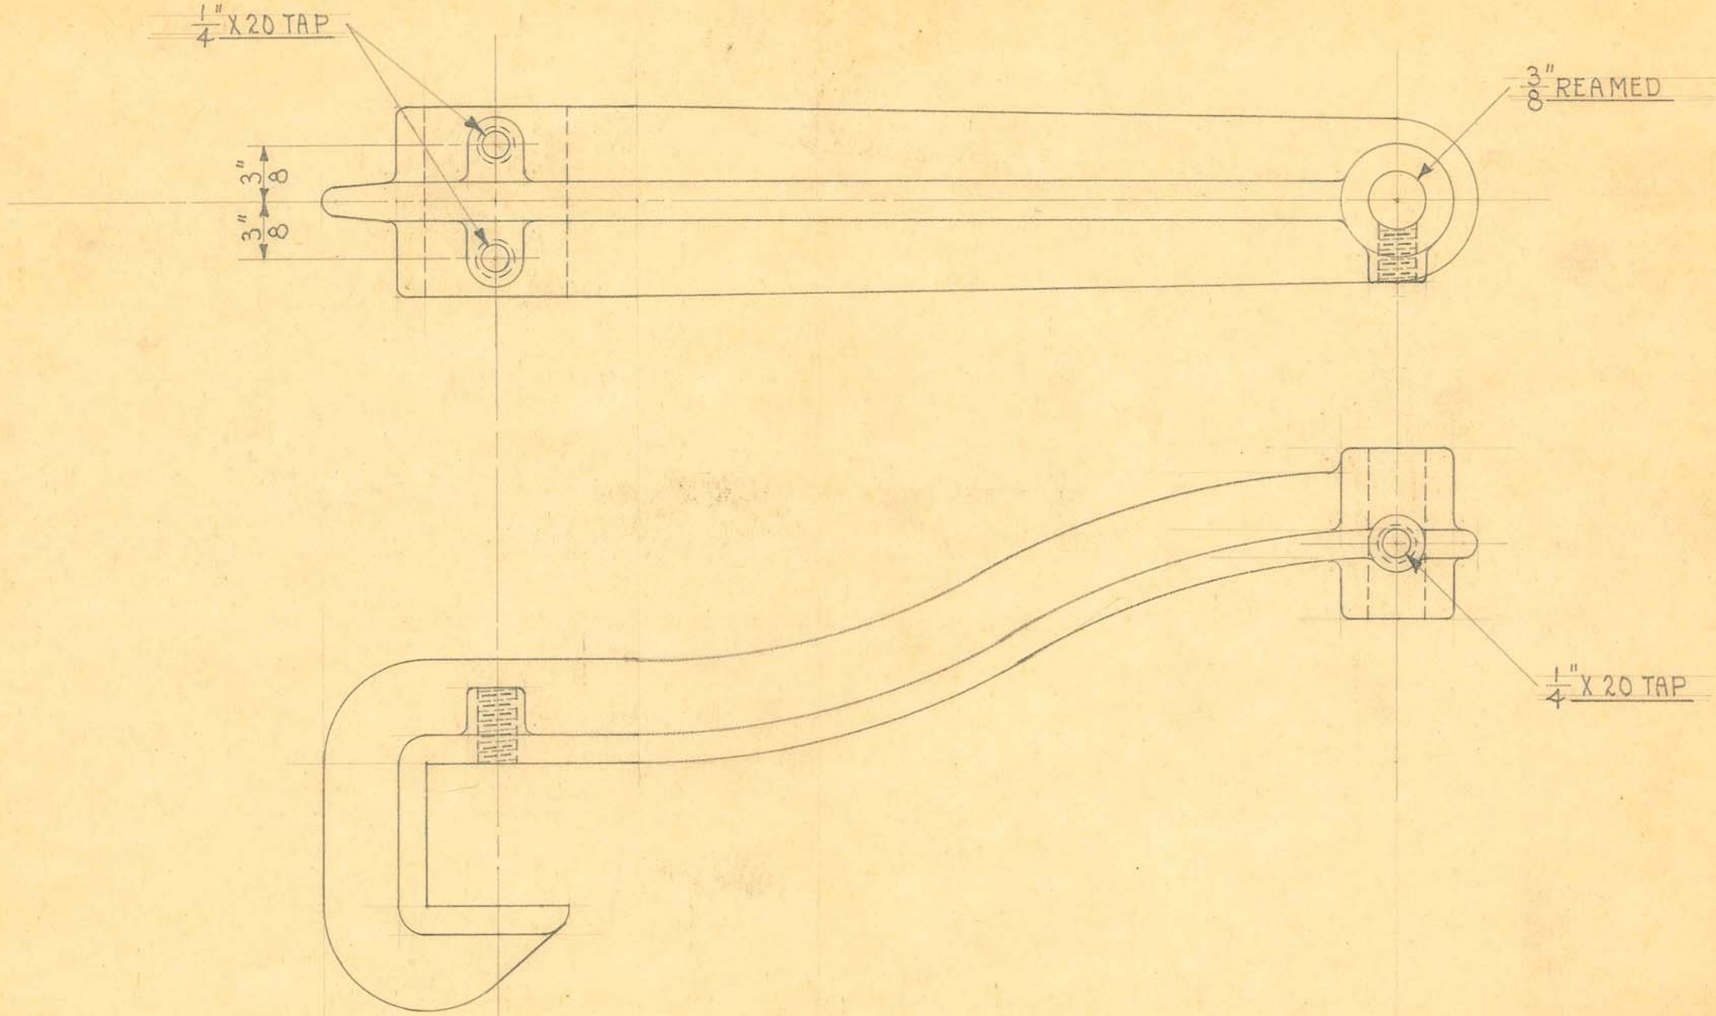

2 REQUIRED

OBSOLETE

SIZE		ISSUE 4-22-36	AE	TITLE: FISCHER FLUOROSCOPE-WALL MODEL- HEART TRACING PULLEY FORWARD SUPP.
KIND	IRON CASTING	CHANGED		
SHAPE		" "		
FINISH	BLACK #50	" "		
TEMP.		" "		
PATT.	7416-939	" "		

H. G. FISCHER & CO.
2335 WABANSIA AVE.
CHICAGO, ILL.

CAT. NO.

PART NO. 10042F

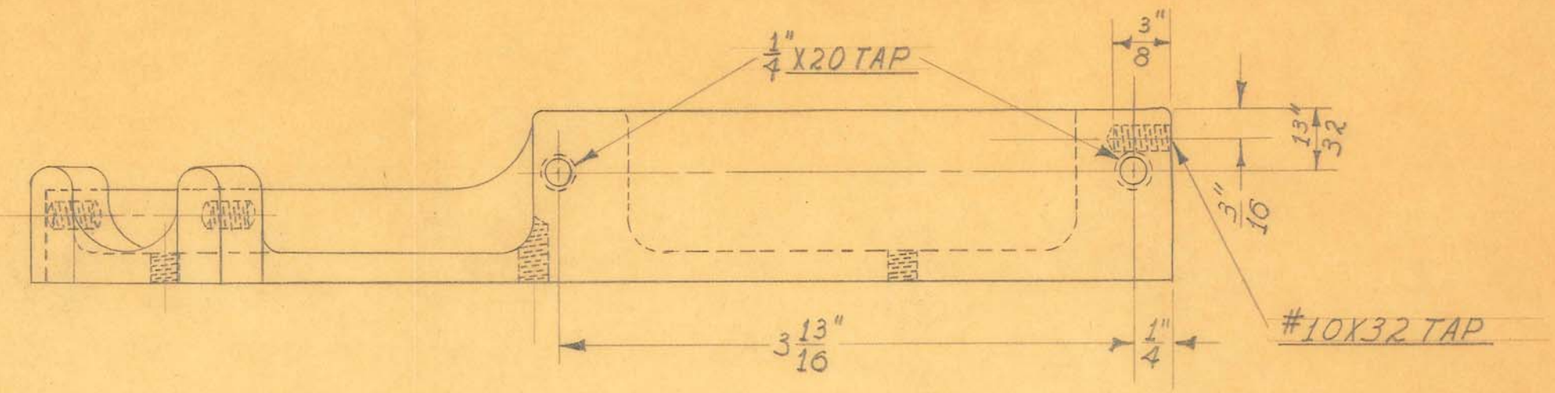

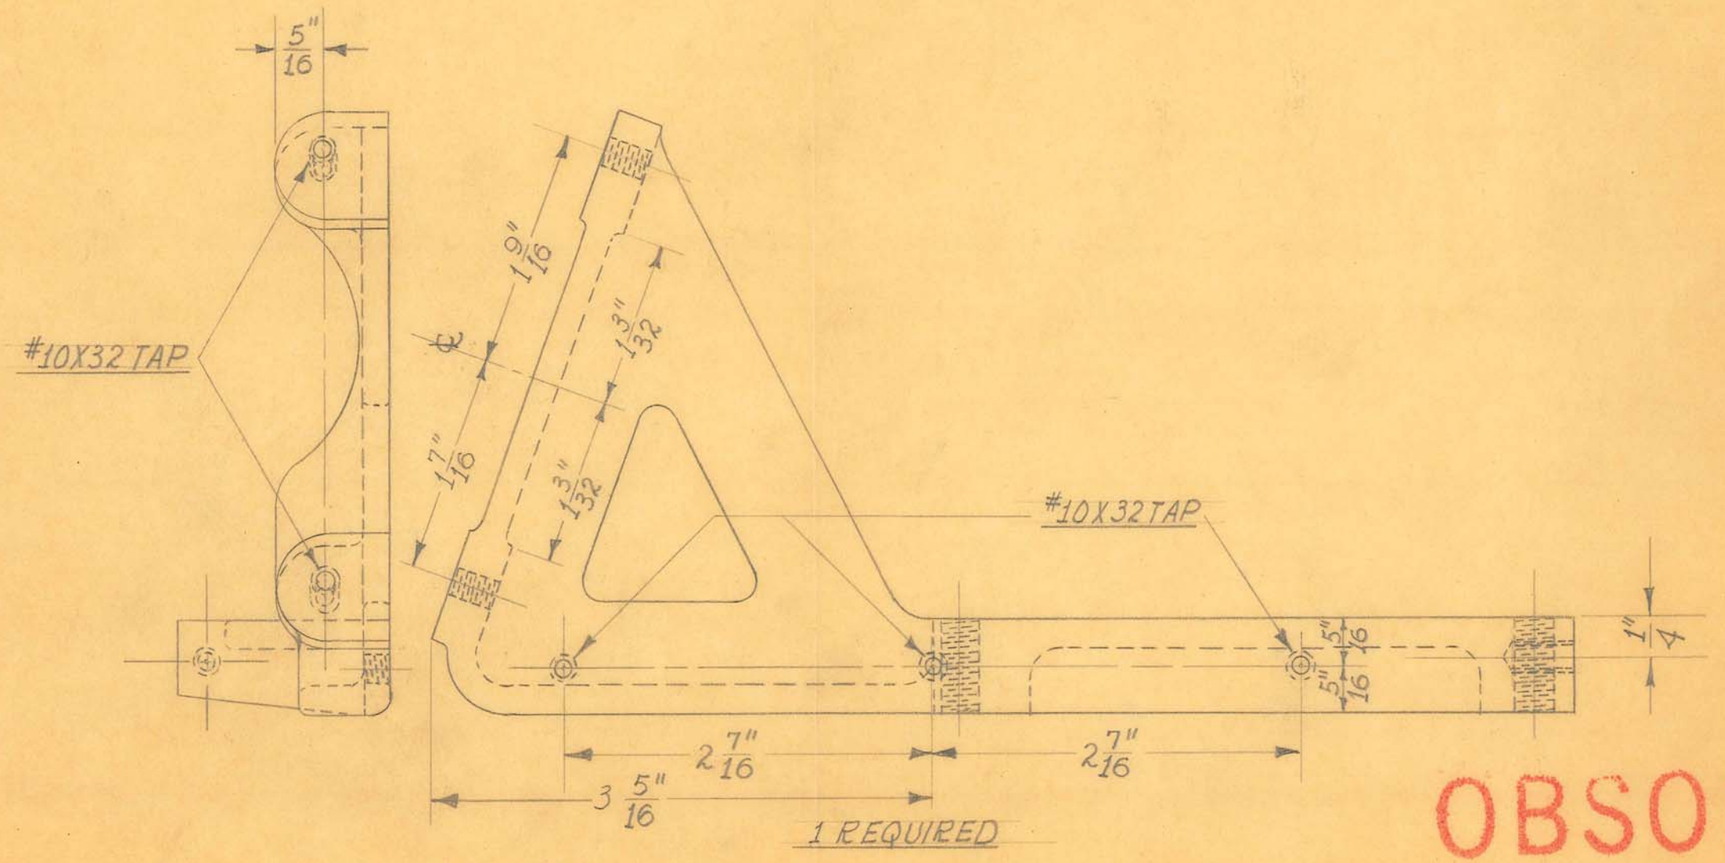

OBSOLETE

SIZE		ISSUE 2-19-36	J.W	TITLE: FISCHER FLUOROSCOPE - WALL MOD. - AUTO TRANSFORMER SUPPORT - LEFT
KIND	ALUM. CASTING	CHANGED		
SHAPE		" "		
FINISH		" "		
TEMP.		" "		H. G. FISCHER & CO. 2335 WABANSIA AVE. CHICAGO, ILL. — CAT. NO. — PART NO. 10033
PATT.	4450-780	" "		

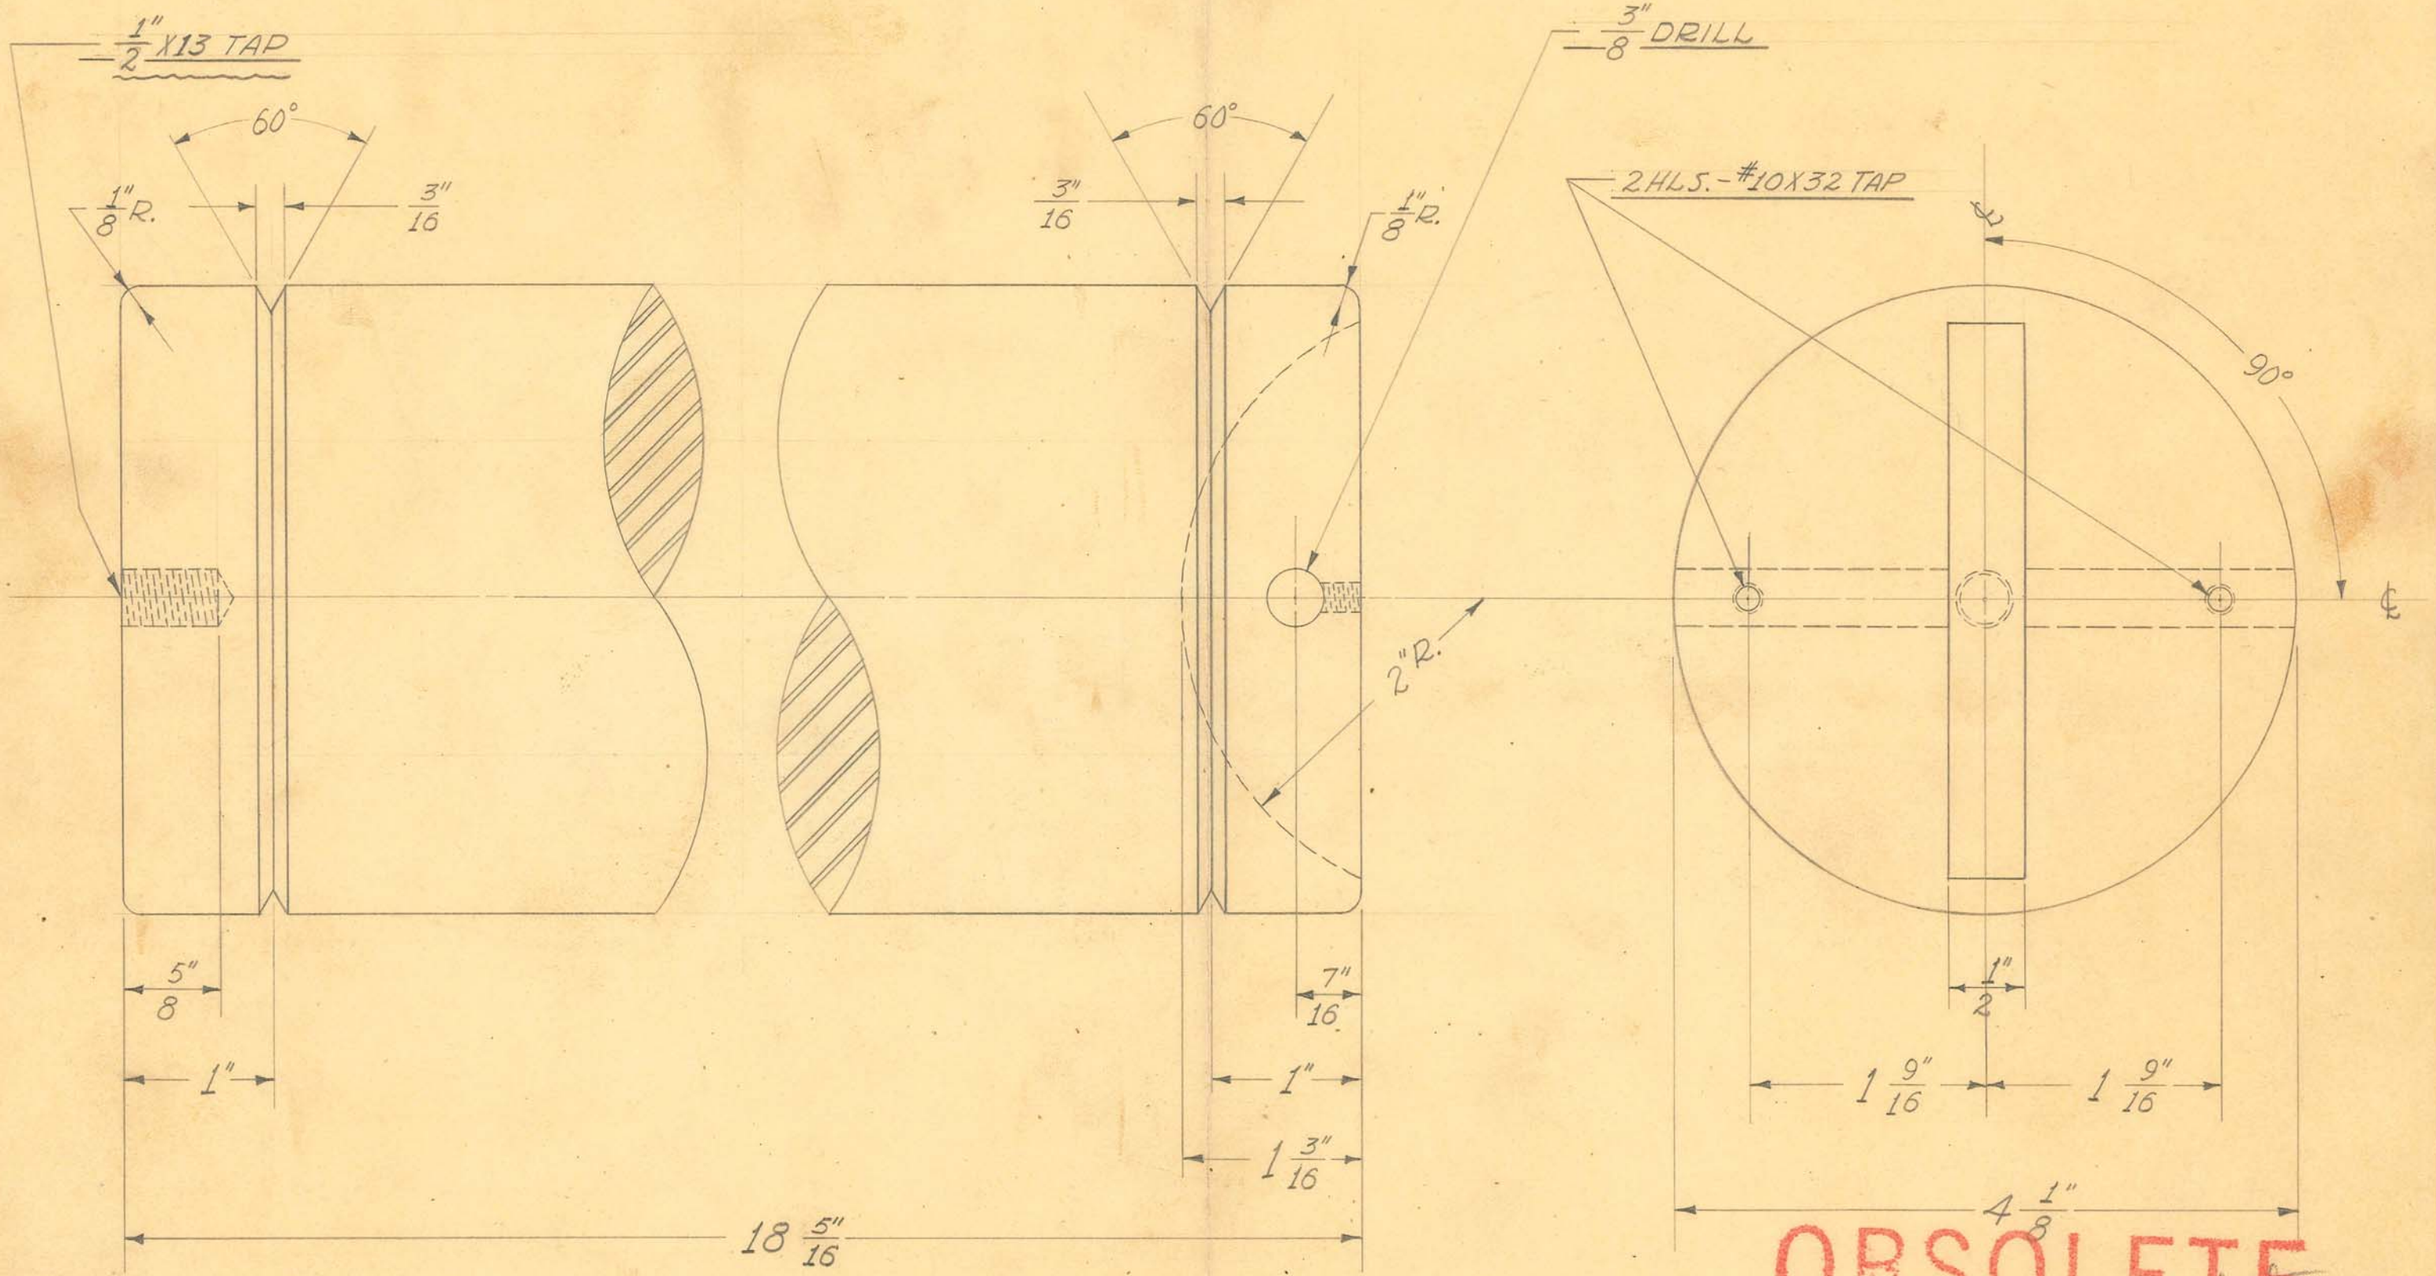

OBSOLETE

1 REQUIRED

SIZE	4 1/8" DIAM.	ISSUE 12-1-38	J.W.
KIND	C.R. STEEL	CHANGED	
SHAPE		"	
FINISH		"	
TEMP.		"	
PATT.		"	

TITLE: FISCHER MOD. "GM" MOBILE UNIT - COUNTERWEIGHT

H. G. FISCHER & CO.
2335 WABANSIA AVE.
CHICAGO, ILL.

CAT. NO.

PART NO. 12275

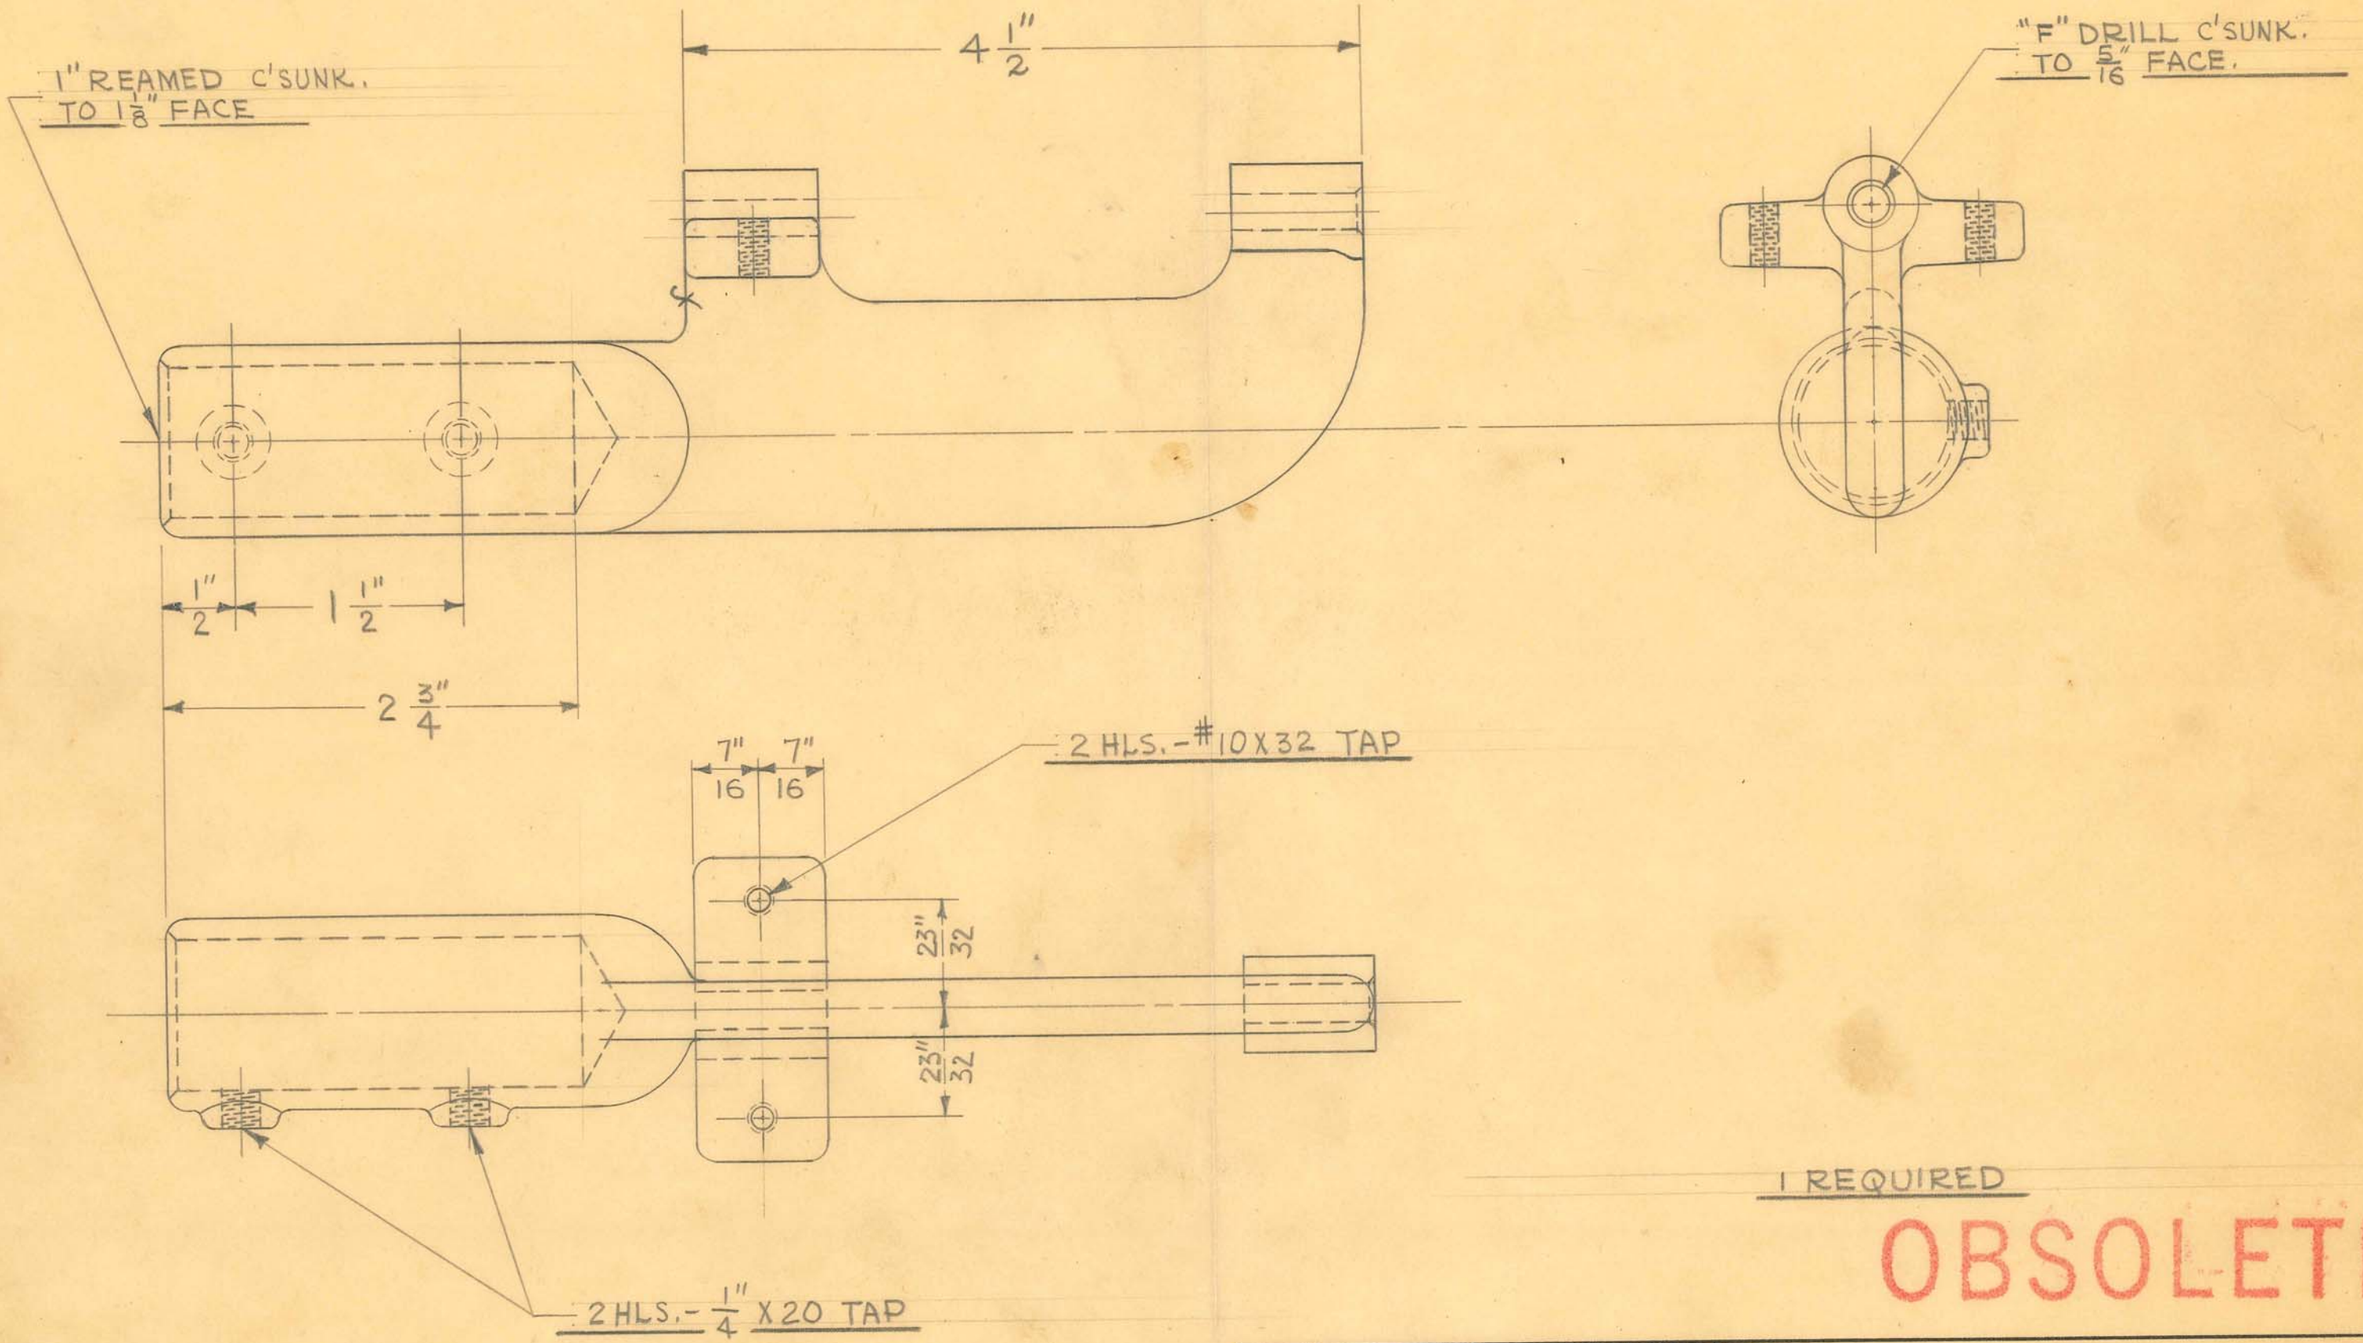

1 REQUIRED

OBSOLETE

SIZE	IRON	ISSUE 5-7-42	J.V.W.
KIND	CASTING	CHANGED	
SHAPE		"	
FINISH	PAINTED	"	
TEMP.		"	
PATT.	1882	"	

TITLE: FISCHER MOD. "GA-15" LIGHT MOBILE STAND CONTROL MOUNTING BRACKET

H. G. FISCHER & CO.
2335 WABANSIA AVE.
CHICAGO, ILL.

CAT. NO.

PART NO. 14342F

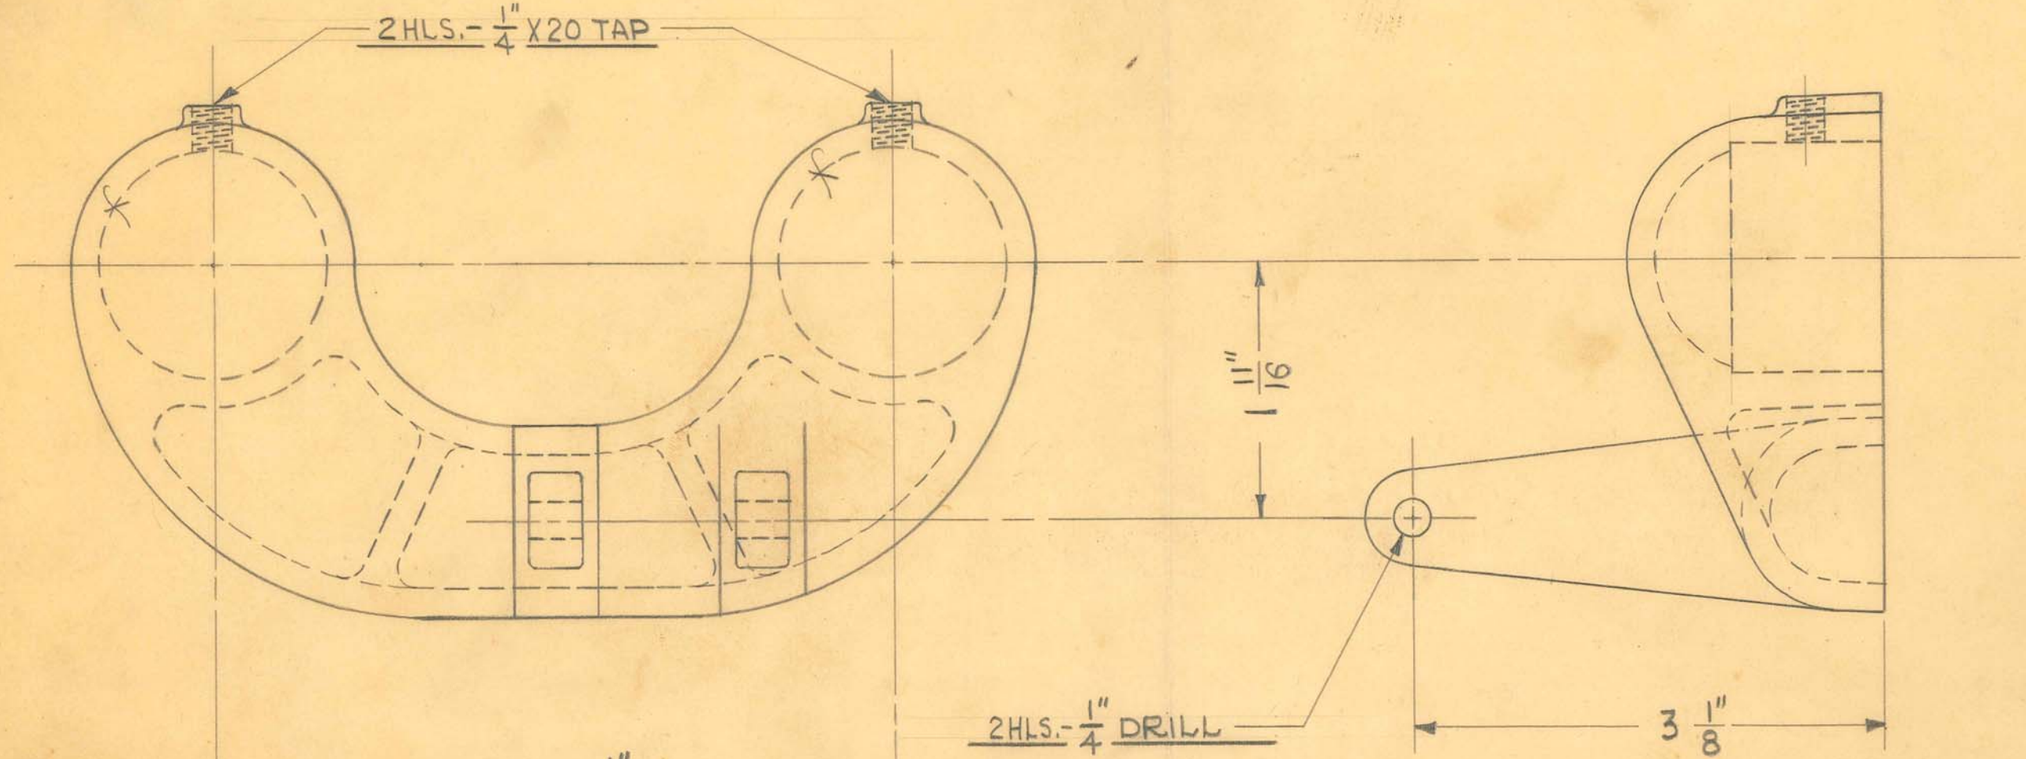

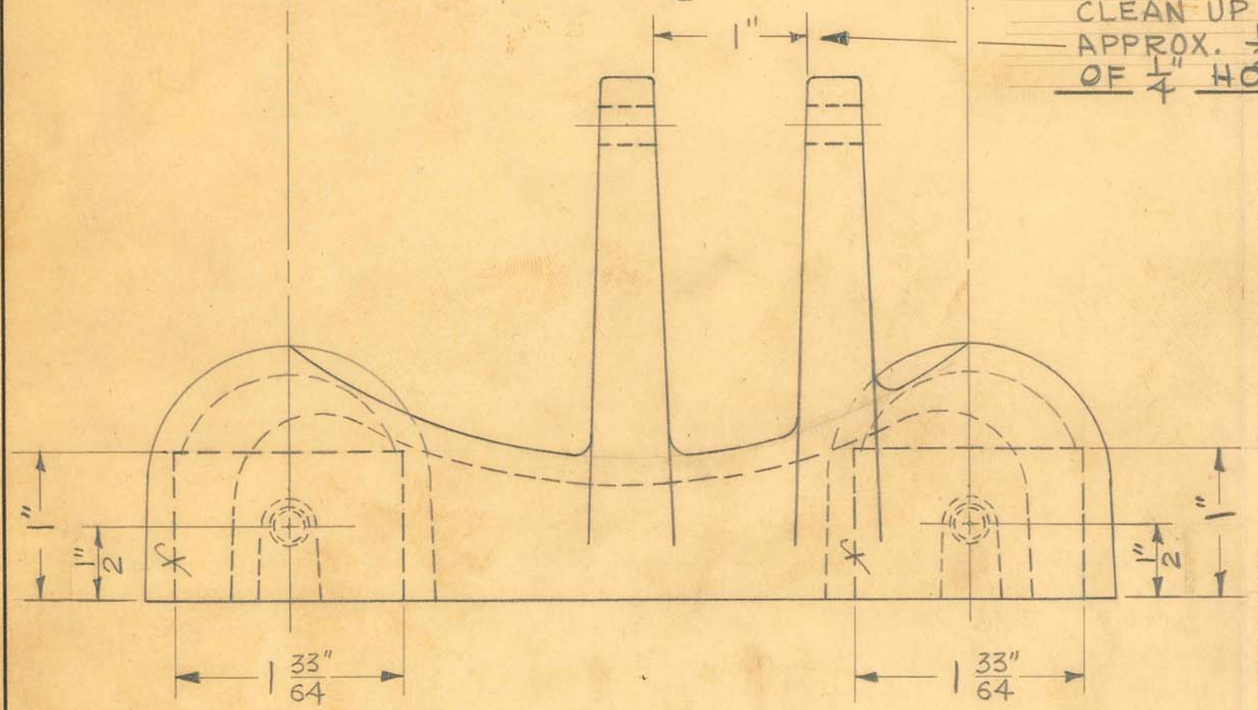

CLEAN UP TO 1" DIMENSION
APPROX. 1/2" BELOW CENTER
OF 1/4" HOLE.

1 REQUIRED

OBSOLETE

#214 ALUMINUM

SIZE	~~IRON~~	ISSUE 4-21-42	J.V.W.	
KIND	~~CASTING~~	CHANGED		
SHAPE		"		
FINISH	PAINTED	"		
TEMP.		"		
PATT.	1875	"		

TITLE:
FISCHER MOD. "GA-15" LIGHT MOBILE STAND
UPRIGHT TUBE CAP

H. G. FISCHER & CO.
2335 WABANSIA AVE.
CHICAGO, ILL.

CAT. NO.

PART NO. 14345AF

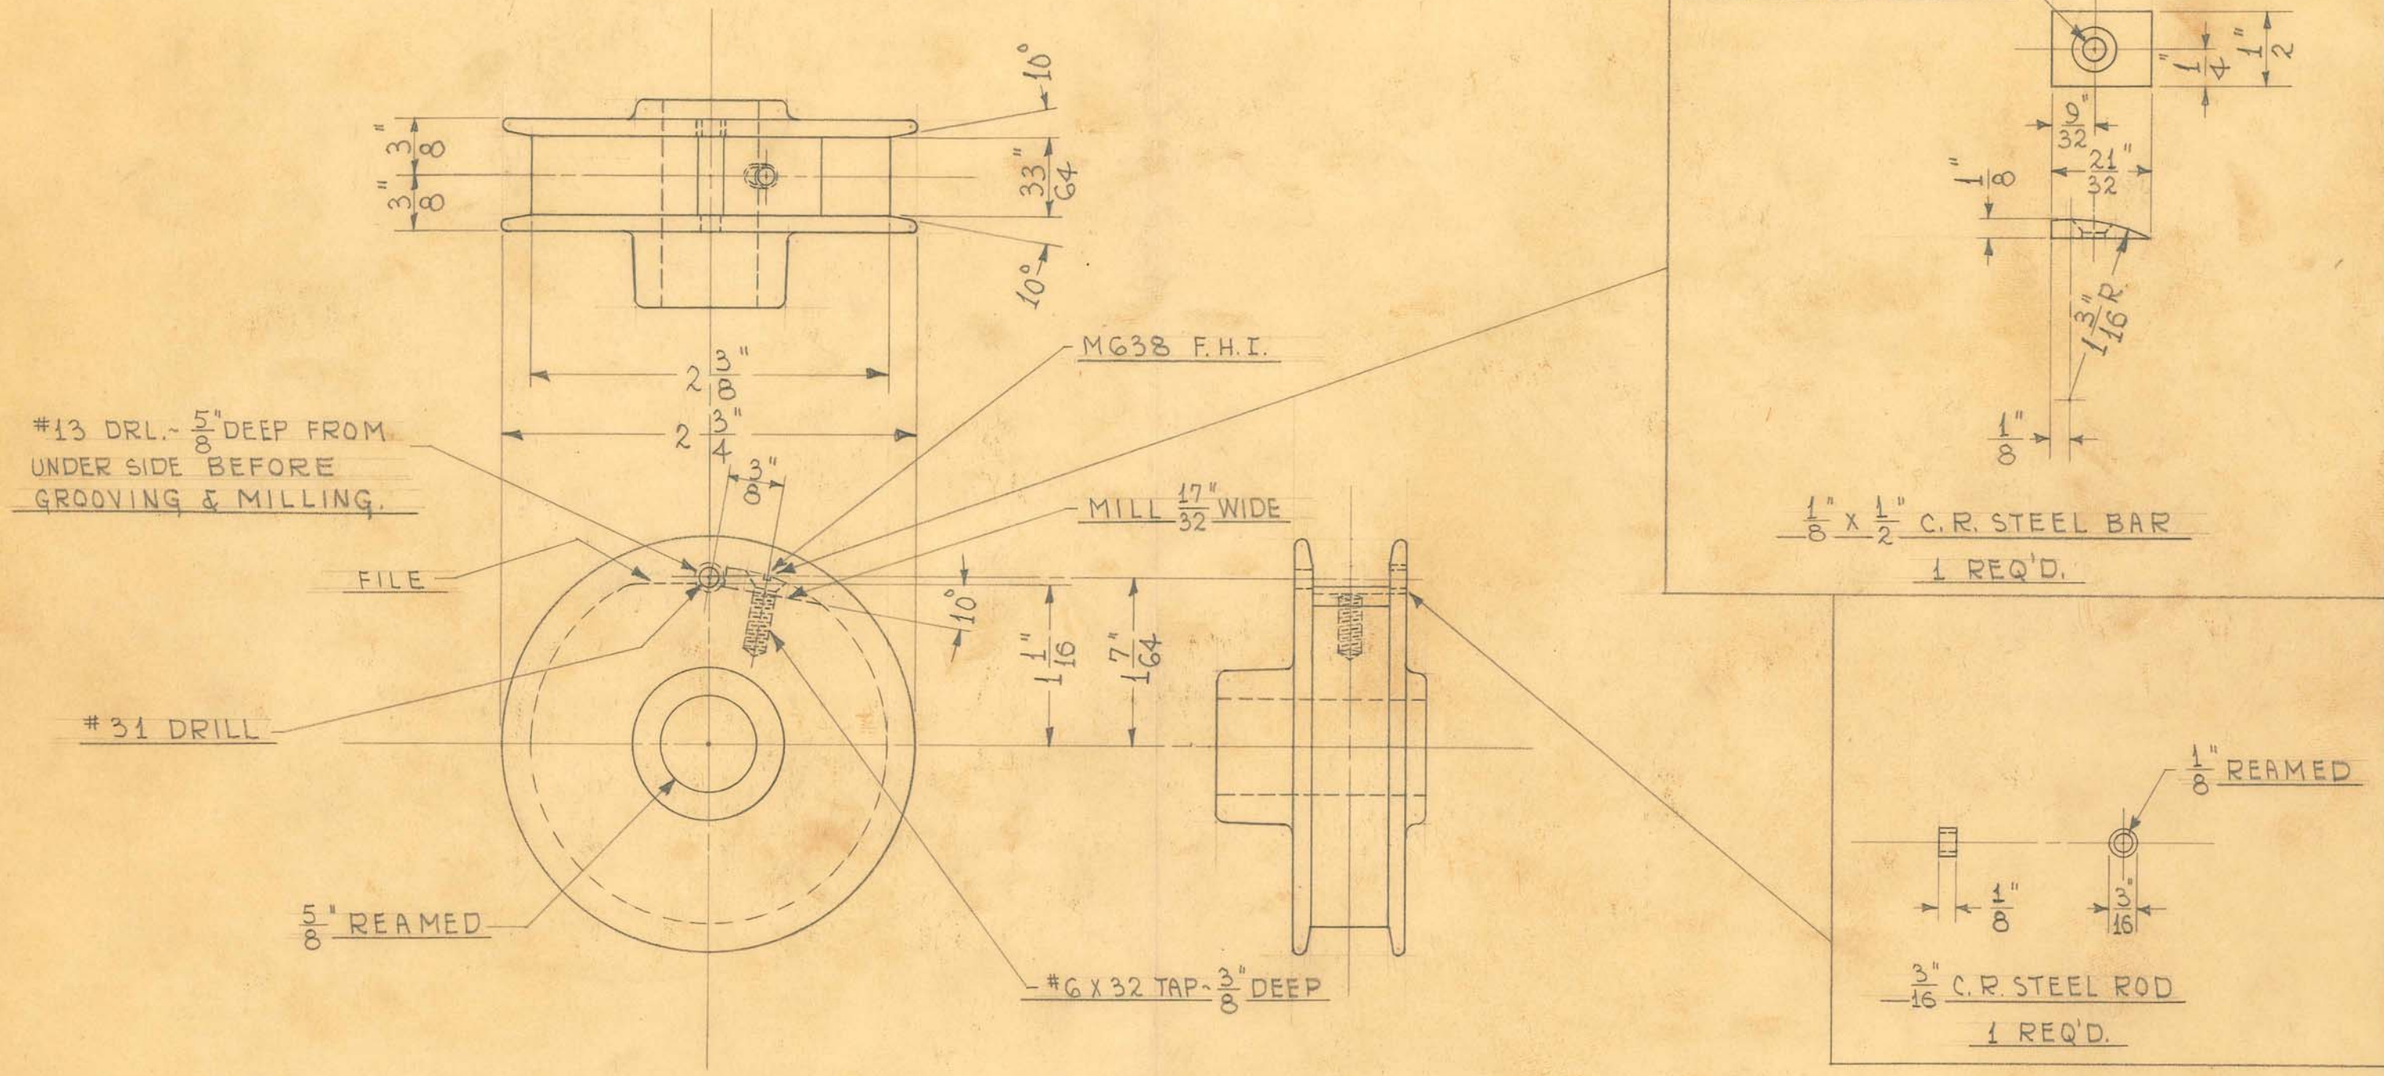

1 REQUIRED

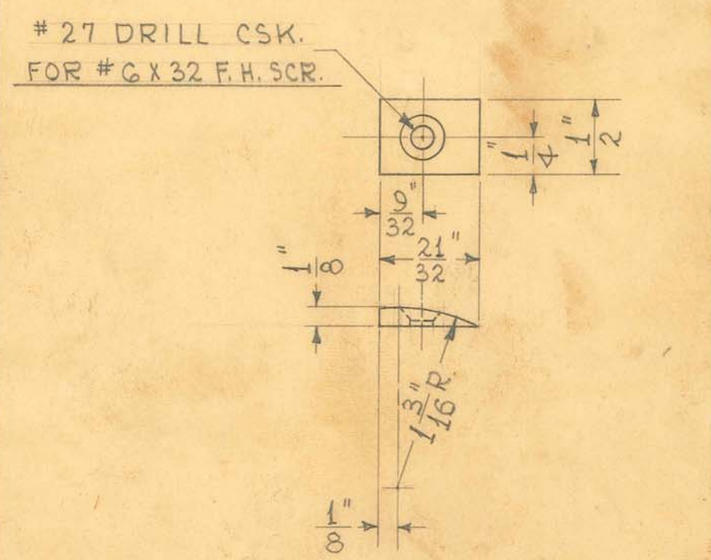

1/8" X 1/2" C.R. STEEL BAR

1 REQ'D.

3/16" C.R. STEEL ROD

1 REQ'D.

OBSOLETE

SIZE		ISSUE 12-1-43	HE.	TITLE: FISCHER MOD. "GA-15" LIGHT MOBILE STAND CRANK PULLEY
KIND	IRON CASTING	CHANGED		
SHAPE		"		
FINISH	WH. NICK. #13	"		
TEMP.		"		
PATT.	1879	"		

H. G. FISCHER & CO. 2335 WABANSIA AVE. CHICAGO. ILL.	CAT. NO.	PART NO. 14349G

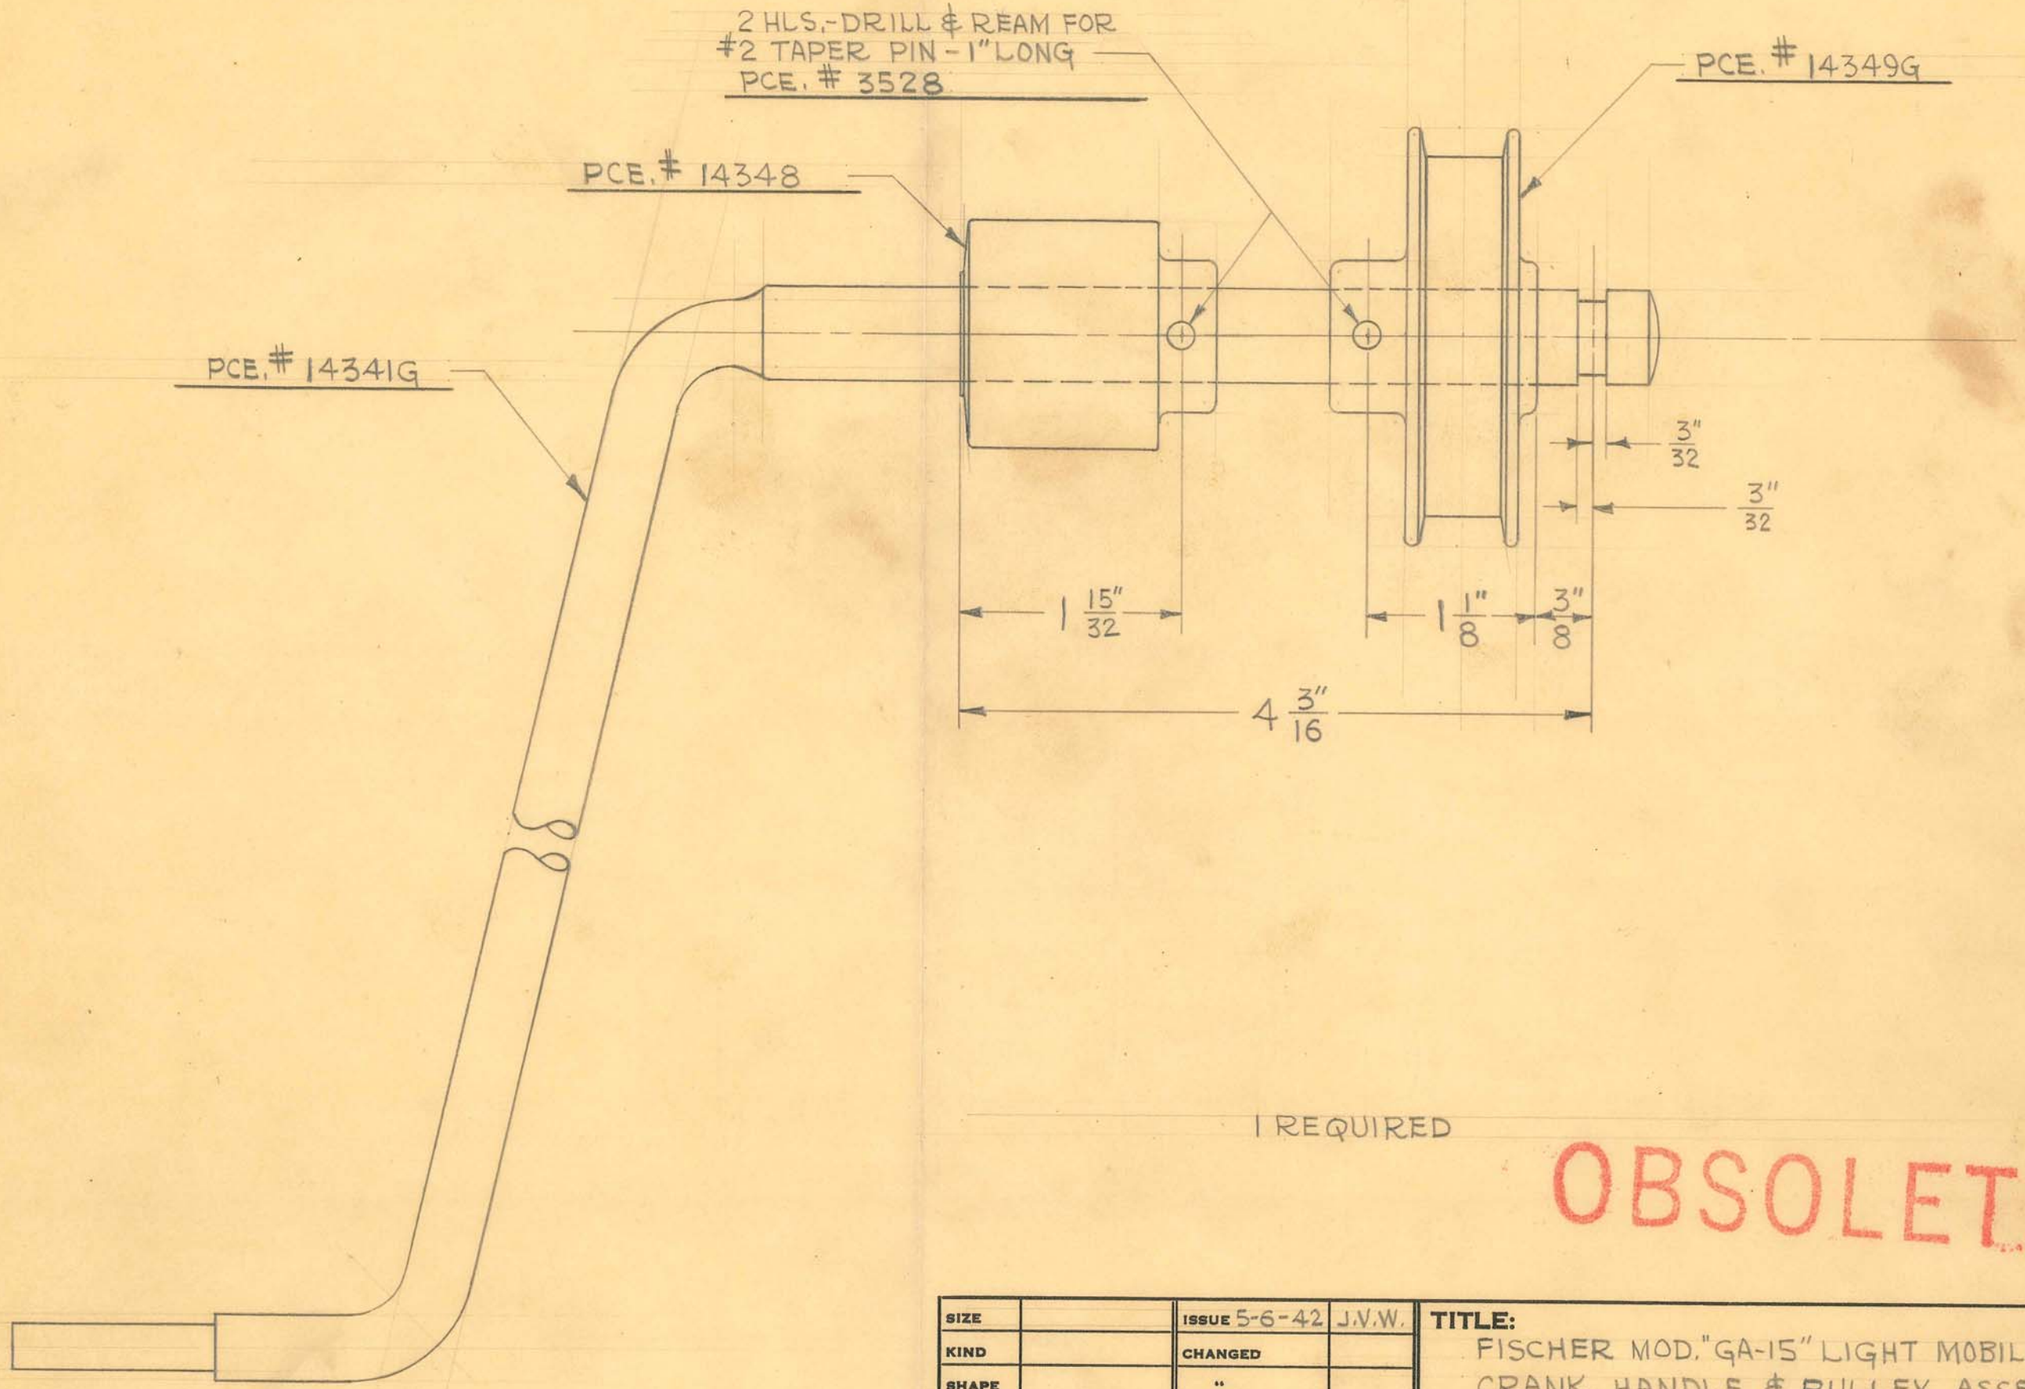

1 REQUIRED

OBSOLETE

SIZE		ISSUE 5-6-42	J.V.W.	
KIND		CHANGED		
SHAPE		"		
FINISH		"		
TEMP.		"		
PATT.		"		

TITLE:
FISCHER MOD. "GA-15" LIGHT MOBILE STAND
CRANK HANDLE & PULLEY ASSEM.

H. G. FISCHER & CO. 2335 WABANSIA AVE. CHICAGO, ILL.	CAT. NO.	PART NO. 14350G

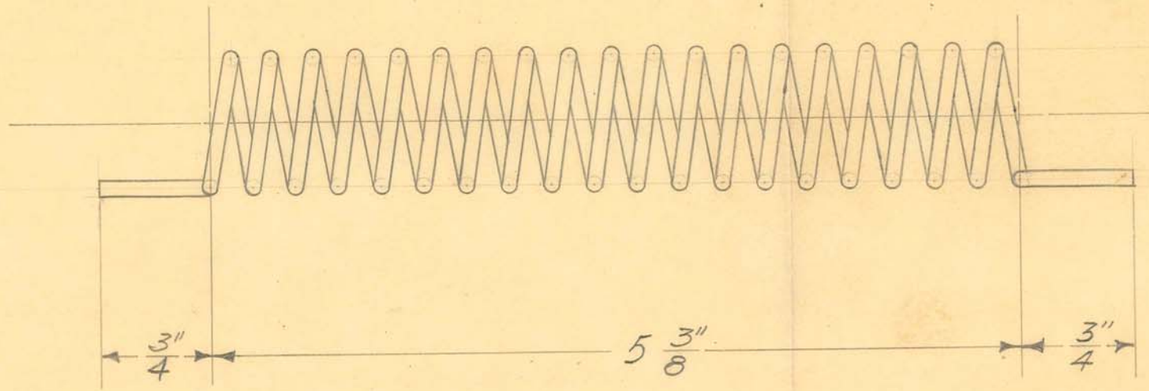

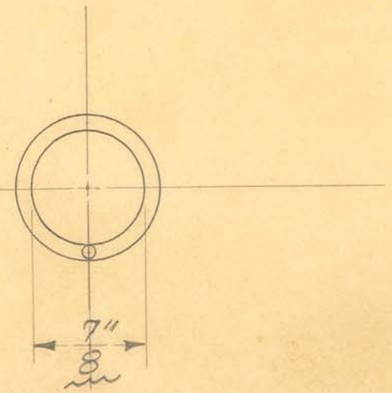

15 TURNS

OBSOLETE

Absolete

SIZE	#10 TINNED	ISSUE 6-5-40	J.W.	TITLE: FISCHER MOD. "D" SHORT WAVE 12 METER GRID COIL
KIND	COPPER WIRE	CHANGED 7-8-40	J.W.	
SHAPE		"		
FINISH		"		
TEMP.		"		
PATT.		"		

H. G. FISCHER & CO.
2335 WABANSIA AVE.
CHICAGO. ILL.

CAT. NO.

PART NO. 12846

d4851

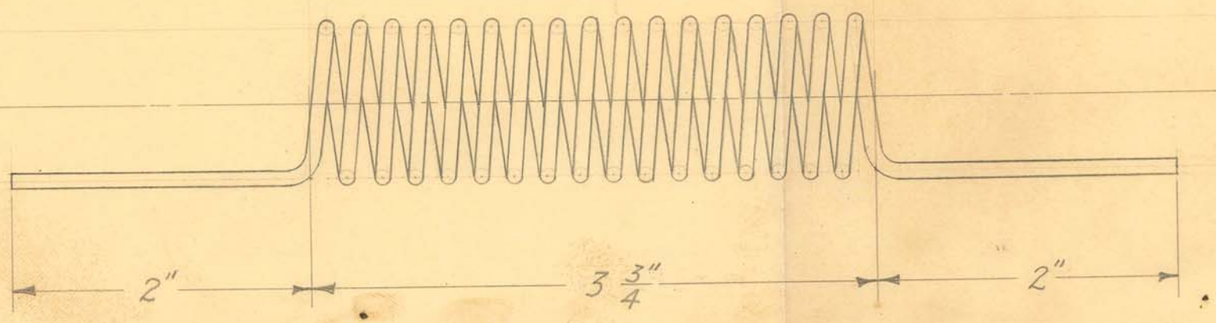

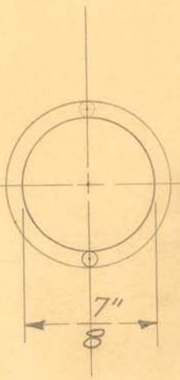

17 TURNS

OBSOLETE

SIZE	#10 TINNED	ISSUE 12-10-40	J.V.W.	TITLE: FISCHER MOD. "S-12" SHORT WAVE GRID COIL
KIND	COPPER WIRE	CHANGED		
SHAPE		"		
FINISH		"		
TEMP.		"		
PATT.		"		

H. G. FISCHER & CO.
2335 WABANSIA AVE.
CHICAGO, ILL.

CAT. NO.

PART NO. 12846A

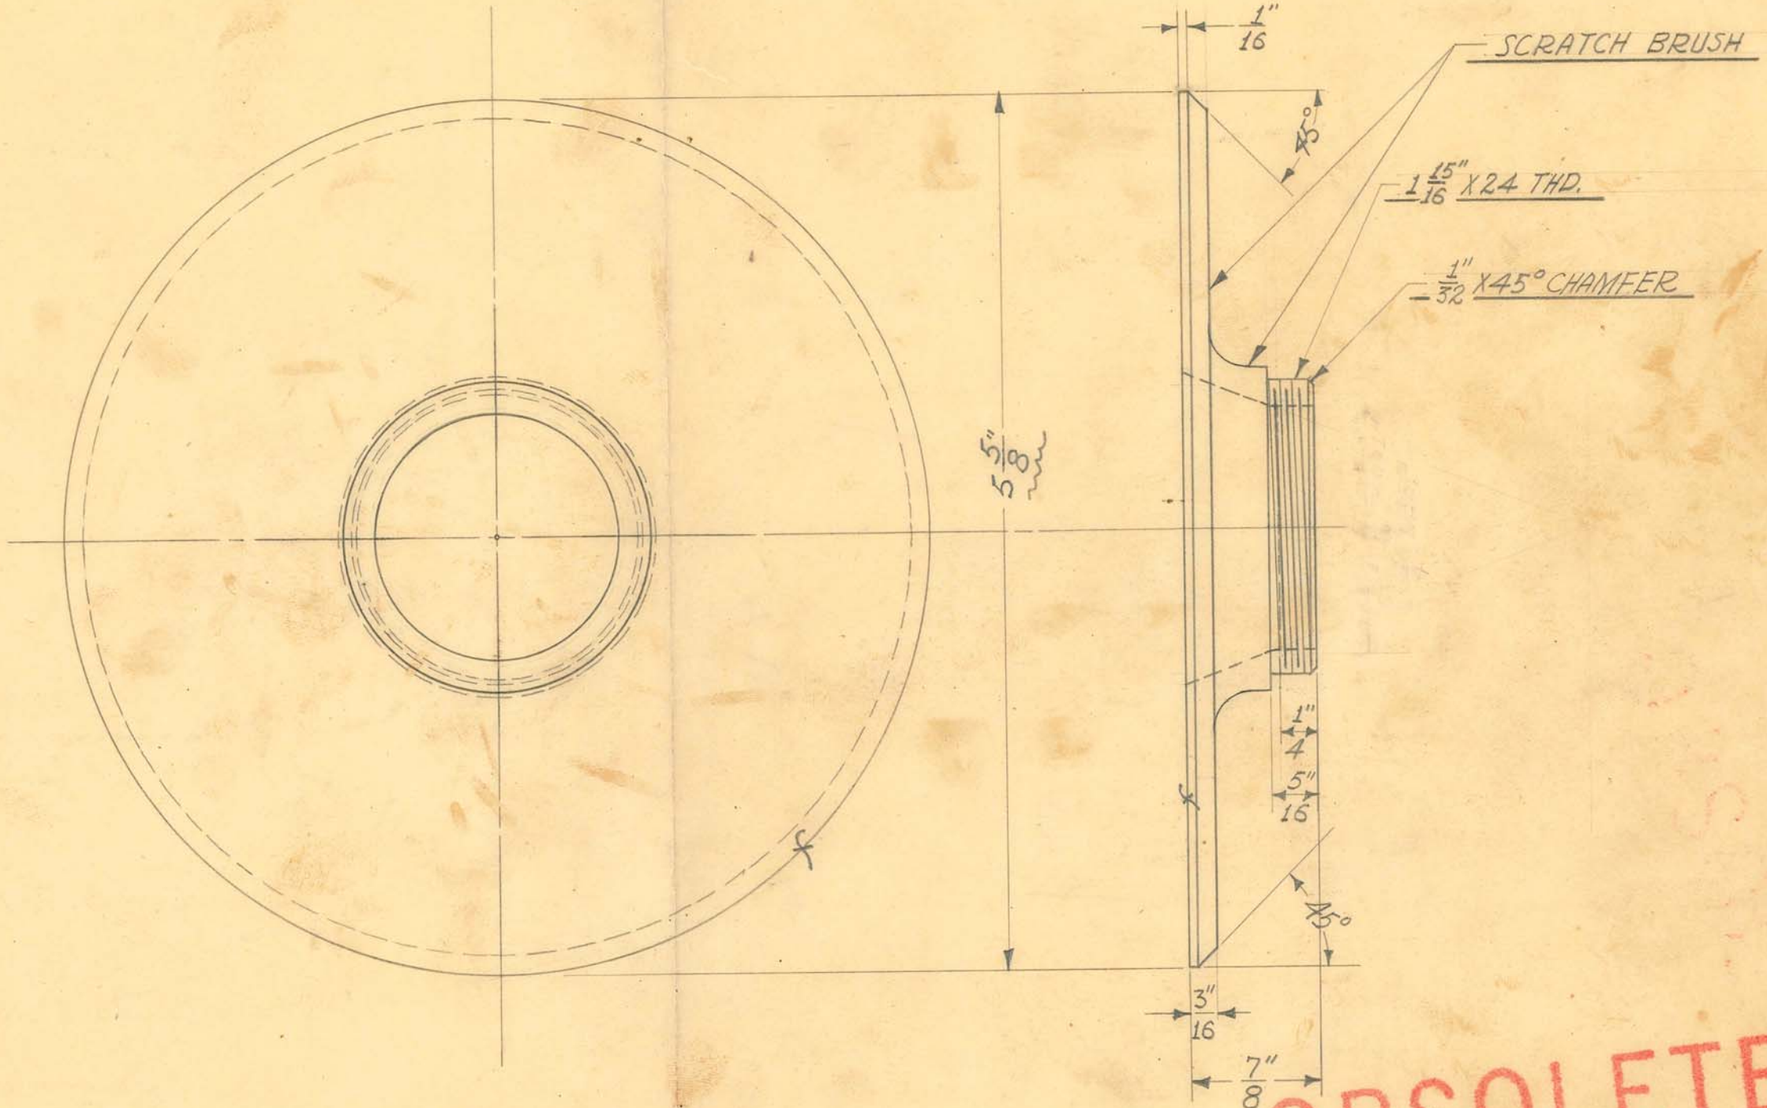

1 REQUIRED

OBSOLETE

SIZE	#12	ISSUE 5-13-40	J.W.	TITLE: FISCHER MOD. "TM-30-96" TRANSF & TUBE SHUTTER FRAME ADAPTER
KIND	ALUM. CASTING	CHANGED		
SHAPE		"		
FINISH	SCRATCH BRUSH	"		
TEMP.		"		
PATT.	1518	"		

H. G. FISCHER & CO.
2835 WABANSIA AVE.
CHICAGO. ILL.

CAT. NO.

PART NO. 12928F

2 HLS. - #55 DRILL

5/32

1"

5/32

#6X32 TAP

5/16" X27 TAP 9/16" C'BORE TO FLAT SURFACE

2 7/8" R.

1 5/8"

1 5/8"

1 5/8"

1 5/8"

2 15/16"

#6X32 TAP

5/8"

1/4" X27 TAP

1 REQUIRED

1 3/32"

25/32

7/32

45°

1 11/16"

11/16"

1/4"

7/16

3/8"

45°

45°

7/32

13/32

9/16"

1 5/16"

OBSOLETE

SIZE	#12	ISSUE 5-10-40	J.W.
KIND	ALUM. CASTING	CHANGED	
SHAPE		"	
FINISH	PAINTED	"	
TEMP.		"	
PATT.	1517	"	

TITLE: FISCHER MOD. "TM-30-96" TRANSF. & TUBE SHUTTER FRAME

H. G. FISCHER & CO.
2335 WABANSIA AVE.
CHICAGO, ILL.

CAT. NO.

PART NO. 12929F

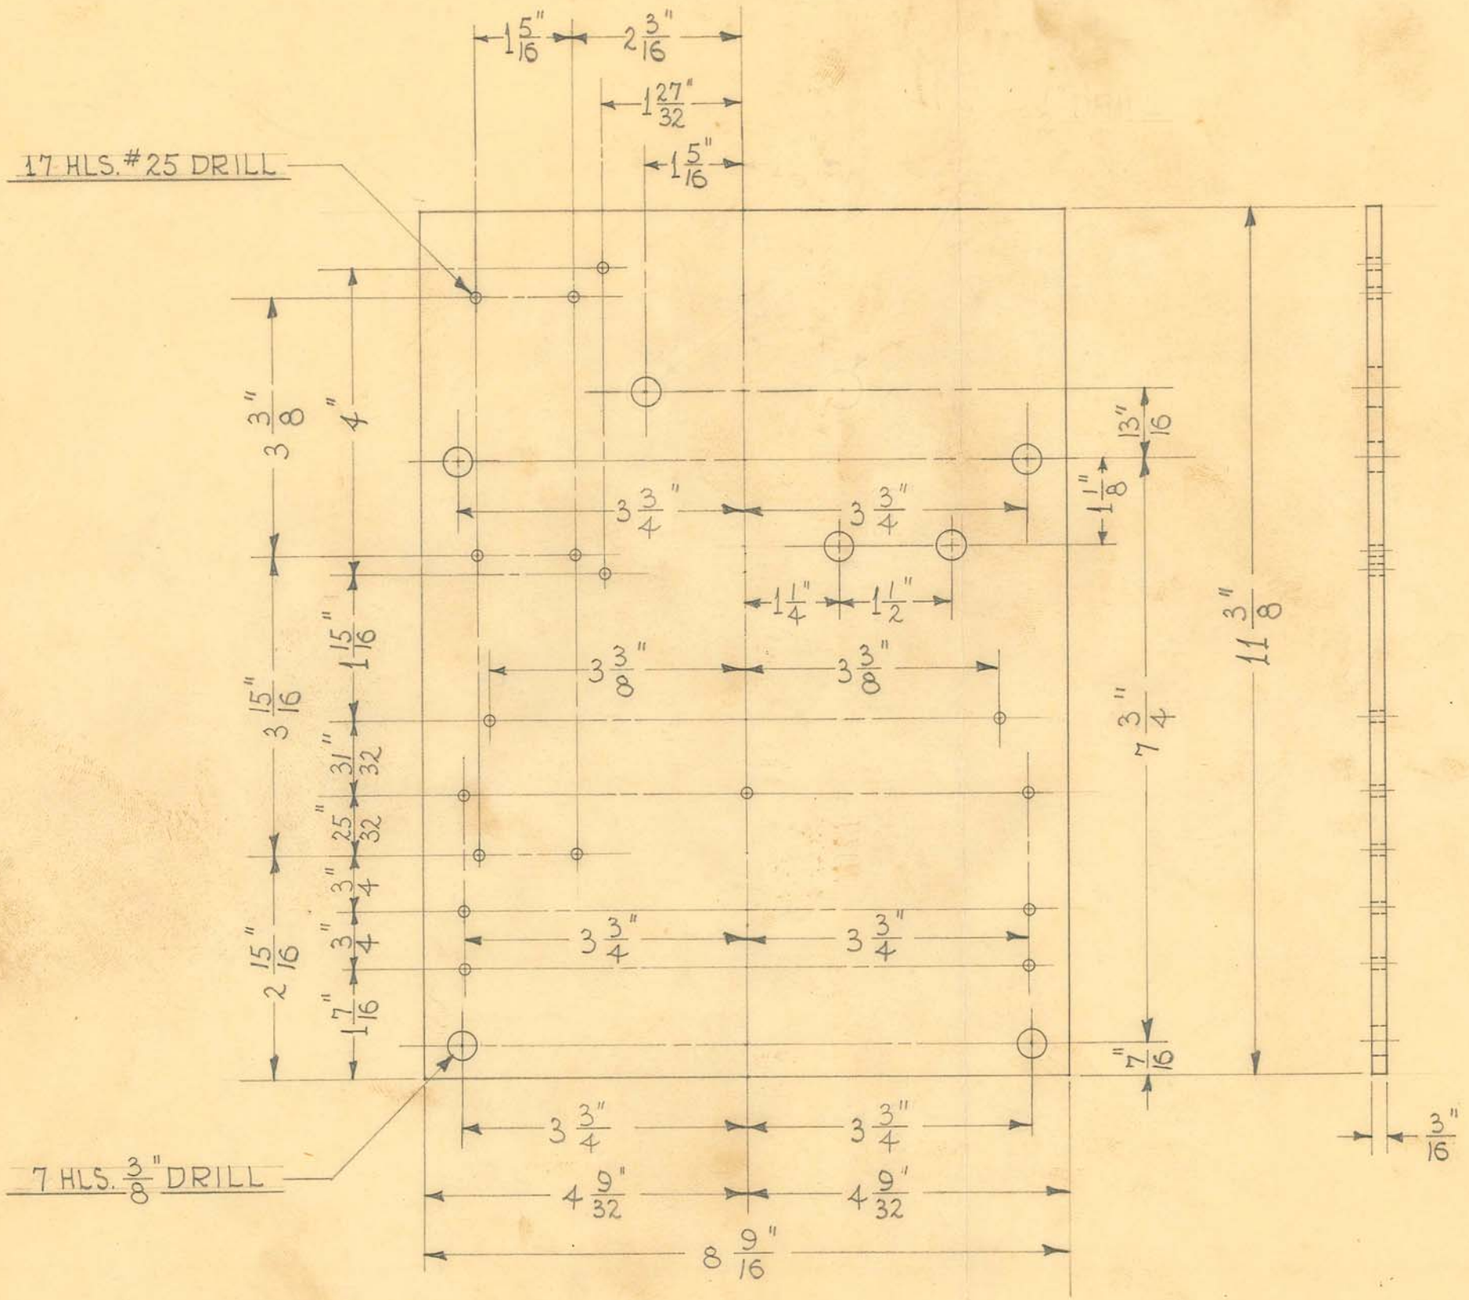

OBSOLETE

SCALE ÷ 1/2" = 1"

1 REQUIRED

SIZE	8 9/16" X 11 3/8" X 3/16"	ISSUE 3-5-40	HE.	
KIND	SHEET TRANSITE	CHANGED		
SHAPE		"		
FINISH		"		
TEMP.		"		
PATT.		"		

TITLE: FISCHER MOD. "A" SHORT WAVE TRANSFORMER HEAT BARRIER

H. G. FISCHER & CO.
2335 WABANSIA AVE.
CHICAGO, ILL.

CAT. NO.

PART NO. 13011F

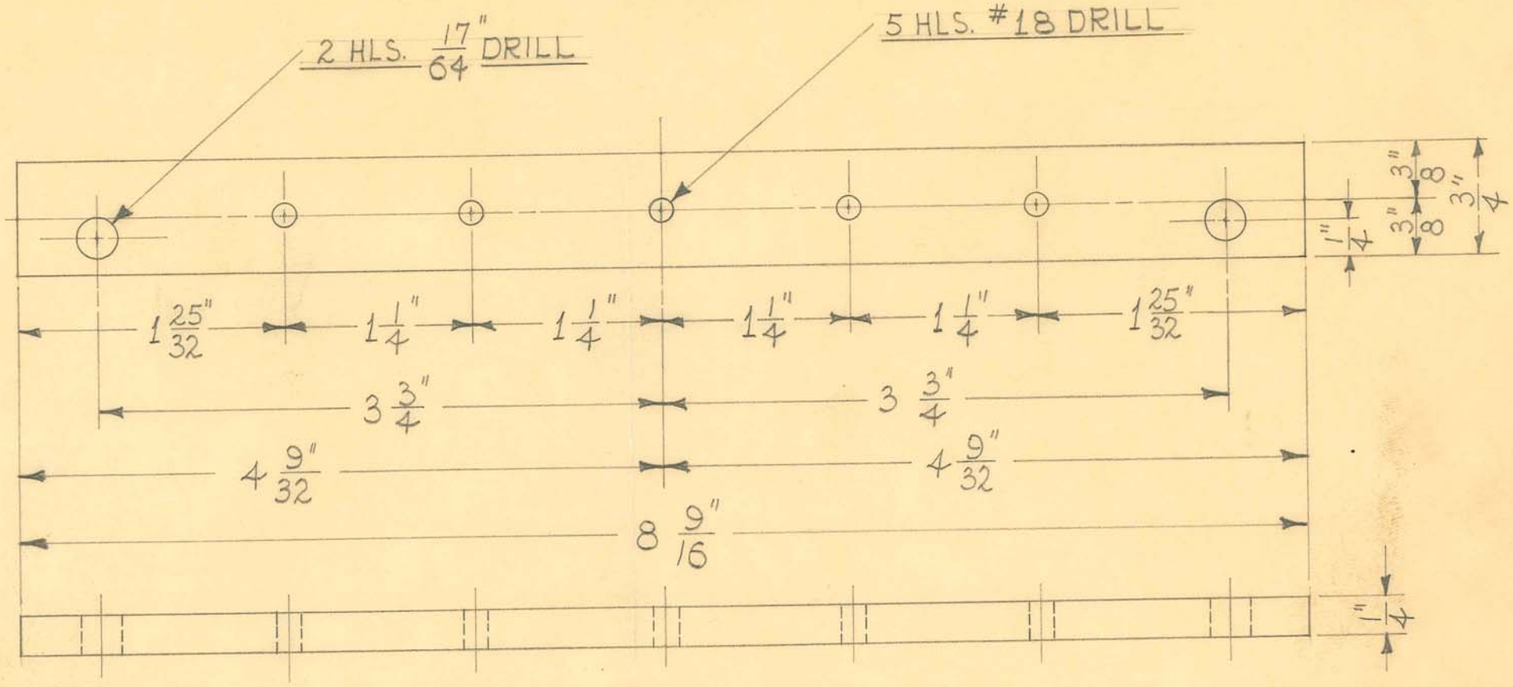

2 REQUIRED

OBSOLETE

SIZE	1/4" SHEET	ISSUE 3-4-40	HE.
KIND	BAKELITE	CHANGED	
SHAPE		"	
FINISH		"	
TEMP.		"	
PATT.		"	

TITLE: FISCHER MOD. "A" SHORT WAVE TRANSFORMER TERMINAL STRIP

H. G. FISCHER & CO.
2335 WABANSIA AVE.
CHICAGO, ILL.

CAT. NO.

PART NO. 13012

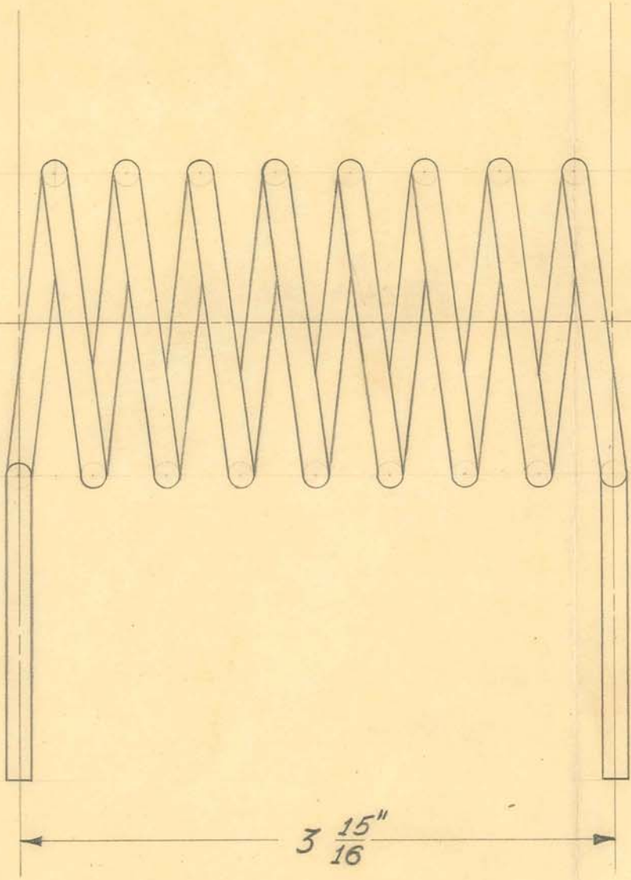

3 15/16"

8 TURNS

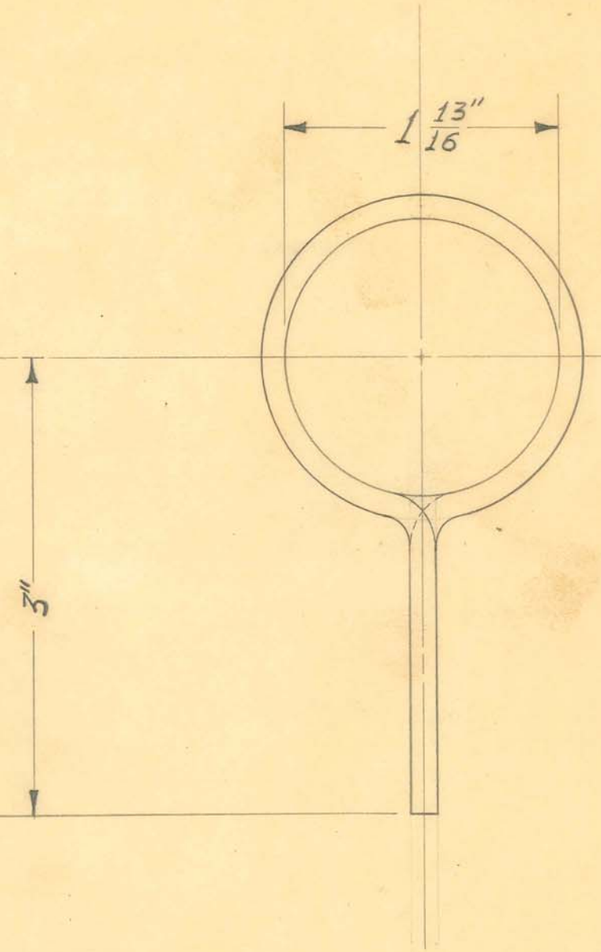

1 REQUIRED

OBSOLETE

SIZE	#6 BARE	ISSUE 3-18-40	J.W.	TITLE: FISCHER MOD. "A" SHORT WAVE PLATE COIL
KIND	COPPER WIRE	CHANGED		
SHAPE		"		
FINISH		"		
TEMP.		"		
PATT.		"		

H. G. FISCHER & CO.
2335 WABANSIA AVE.
CHICAGO. ILL.

CAT. NO.

PART NO. 13016

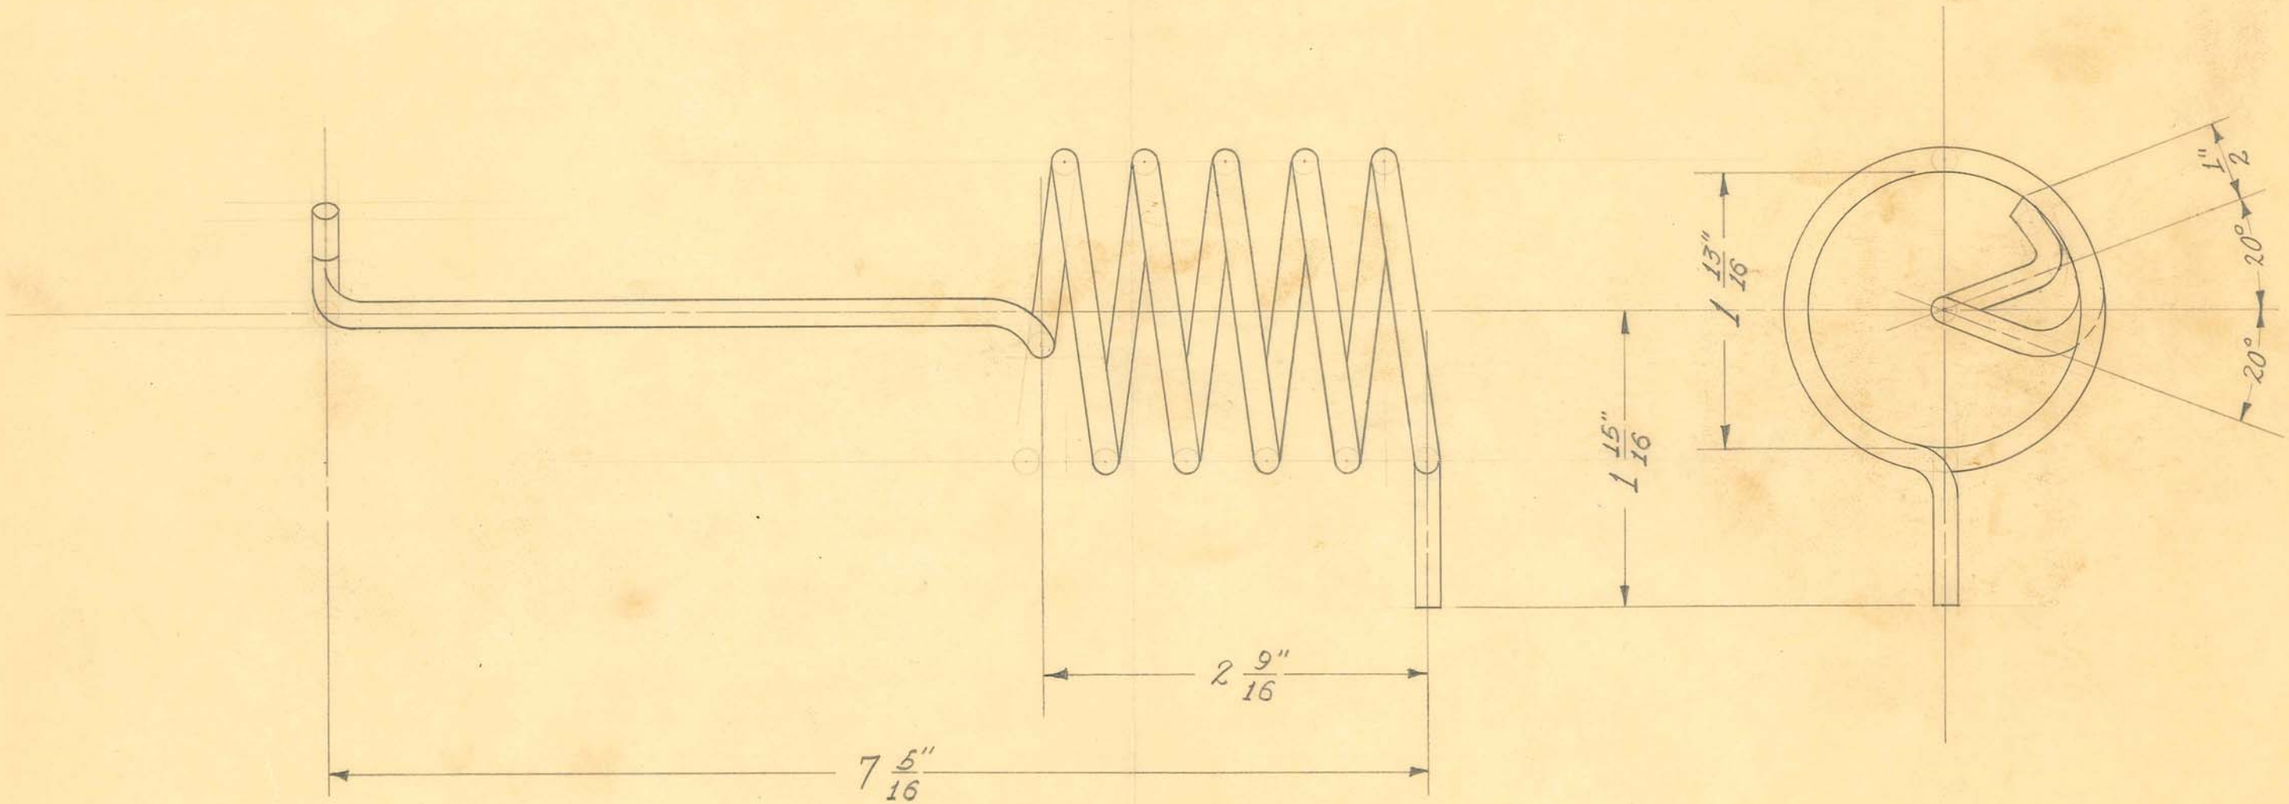

4 3/4 TURNS

1 REQUIRED

OBSOLETE

SIZE	#6 BARE	ISSUE 3-11-40	J.W.	TITLE: FISCHER MOD. "A" SHORT WAVE PICKUP COIL
KIND	COPPER WIRE	CHANGED		
SHAPE		"		
FINISH		"		
TEMP.		"		
PATT.		"		

H. G. FISCHER & CO.
2335 WABANSIA AVE.
CHICAGO, ILL.

CAT. NO.

PART NO. 13017

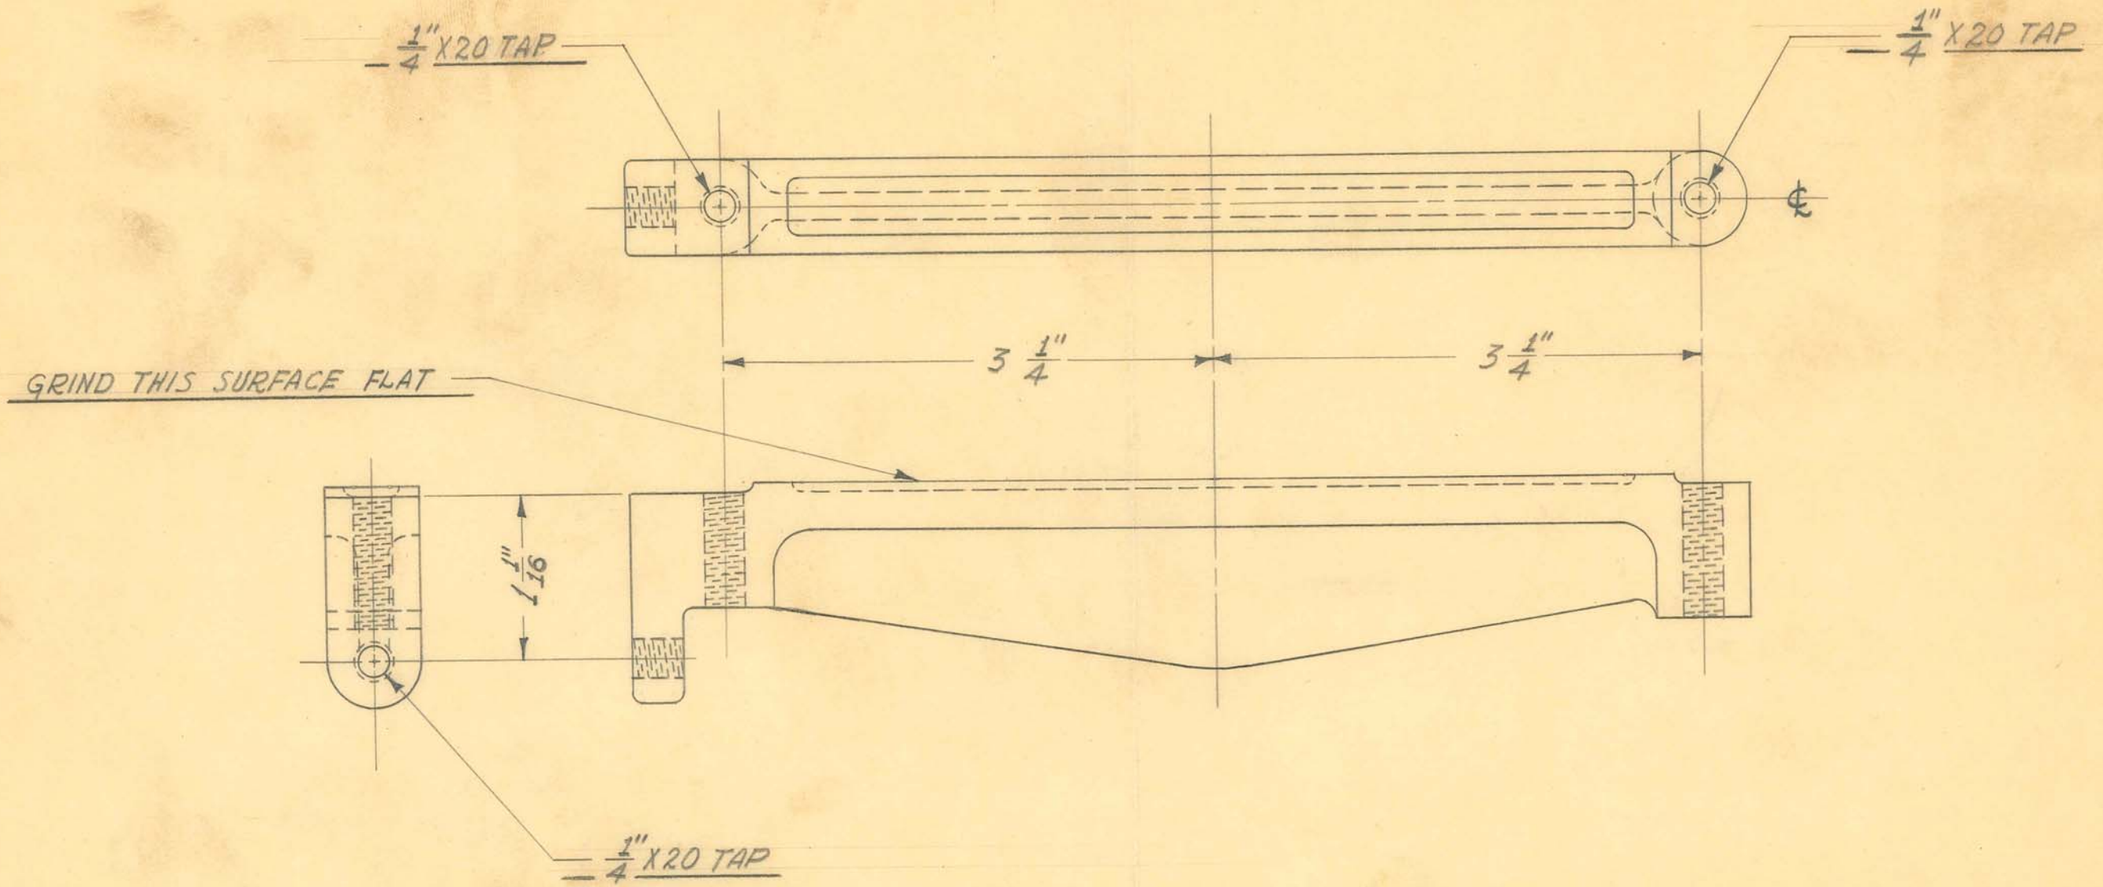

2 REQUIRED

OBSOLETE

SIZE	IRON	ISSUE 4-19-40	J.W.
KIND	CASTING	CHANGED	
SHAPE		"	
FINISH	BLK. #80	"	
TEMP.		"	
PATT.	1543	"	

TITLE:
FISCHER MOD. "B" SHORT WAVE
POWER TRANSFORMER SUPPORT - TAPPED

H. G. FISCHER & CO.
2338 WABANSIA AVE.
CHICAGO, ILL.

CAT. NO.

PART NO. 13046F

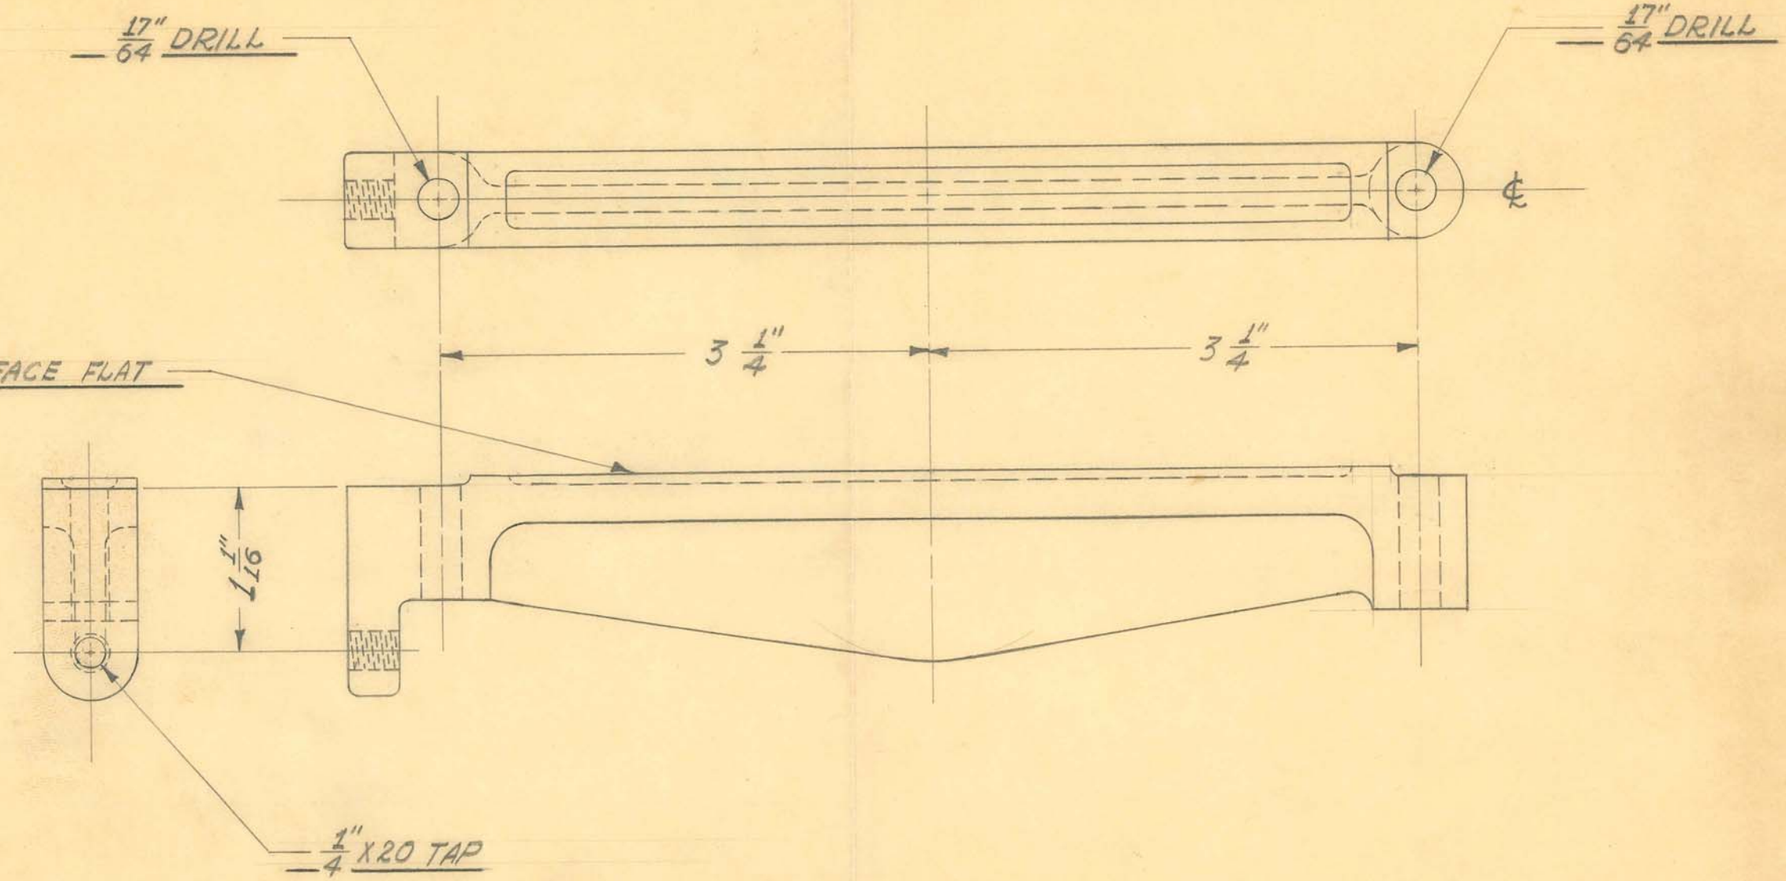

2 REQUIRED

OBSOLETE

SIZE	IRON	ISSUE 4-19-40	J.W.	TITLE: FISCHER MOD, "B" SHORT WAVE POWER TRANSFORMER SUPPORT - CLEARANCE
KIND	CASTING	CHANGED		
SHAPE		"		
FINISH	BLK.#80	"		
TEMP.		"		
PATT.	1543	"		

H. G. FISCHER & CO.
2335 WABANSIA AVE.
CHICAGO. ILL.

CAT. NO.

PART NO. 13047

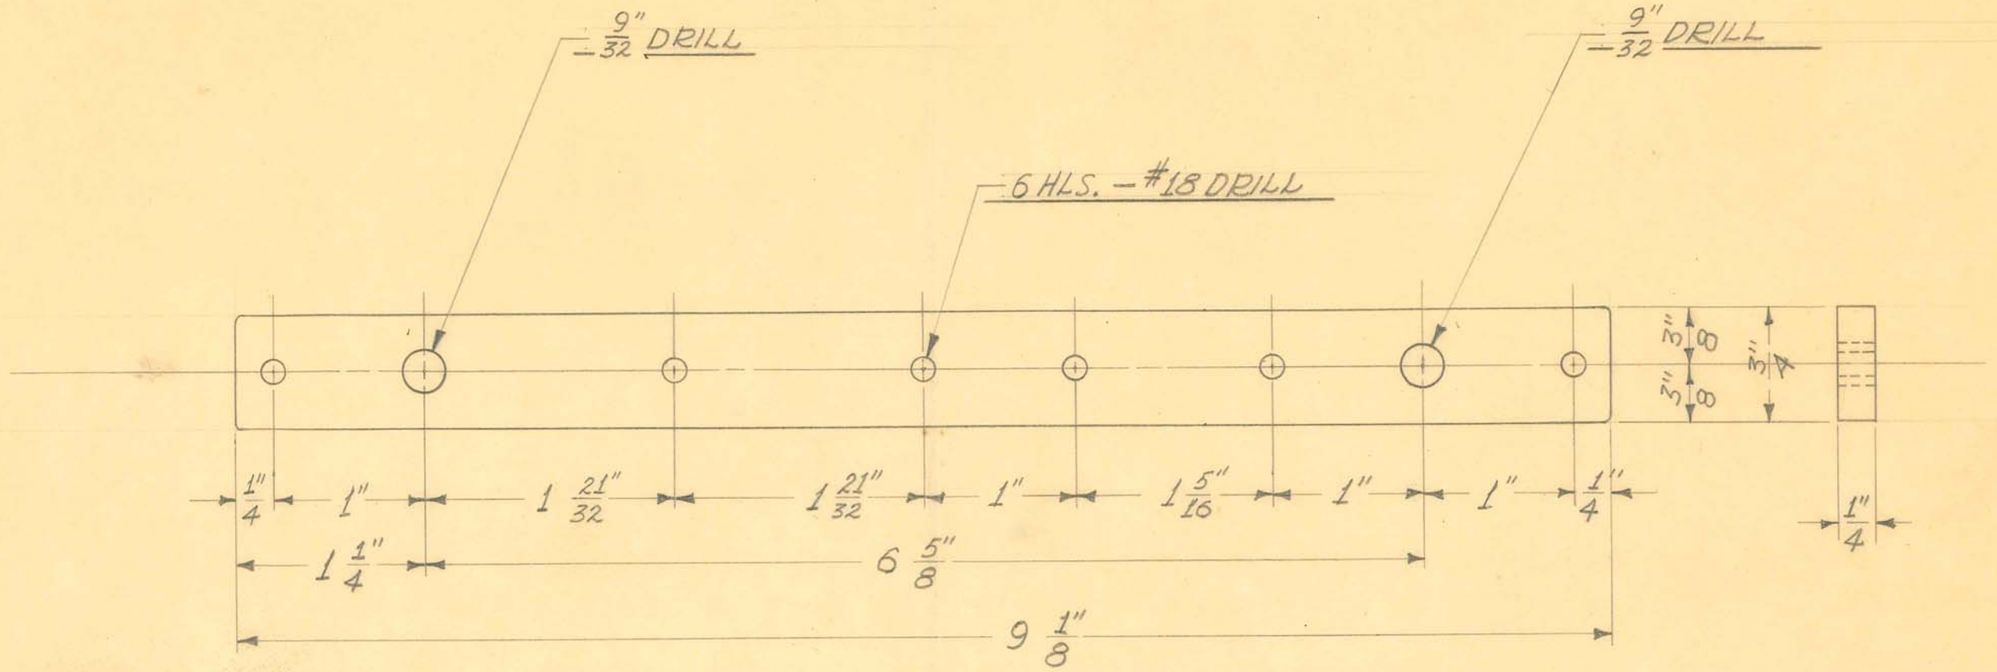

1 REQUIRED

OBSOLETE

SIZE	7/4" SHEET	ISSUE 4-12-40	J.W.
KIND	BLK. BAKELITE	CHANGED	
SHAPE		"	
FINISH		"	
TEMP.		"	
PATT.		"	

TITLE: FISCHER MOD. "B" SHORT WAVE RESISTOR MTG. & TERMINAL STRIP

H. G. FISCHER & CO.
2335 WABANSIA AVE.
CHICAGO, ILL.

CAT. NO.

PART NO. 13048

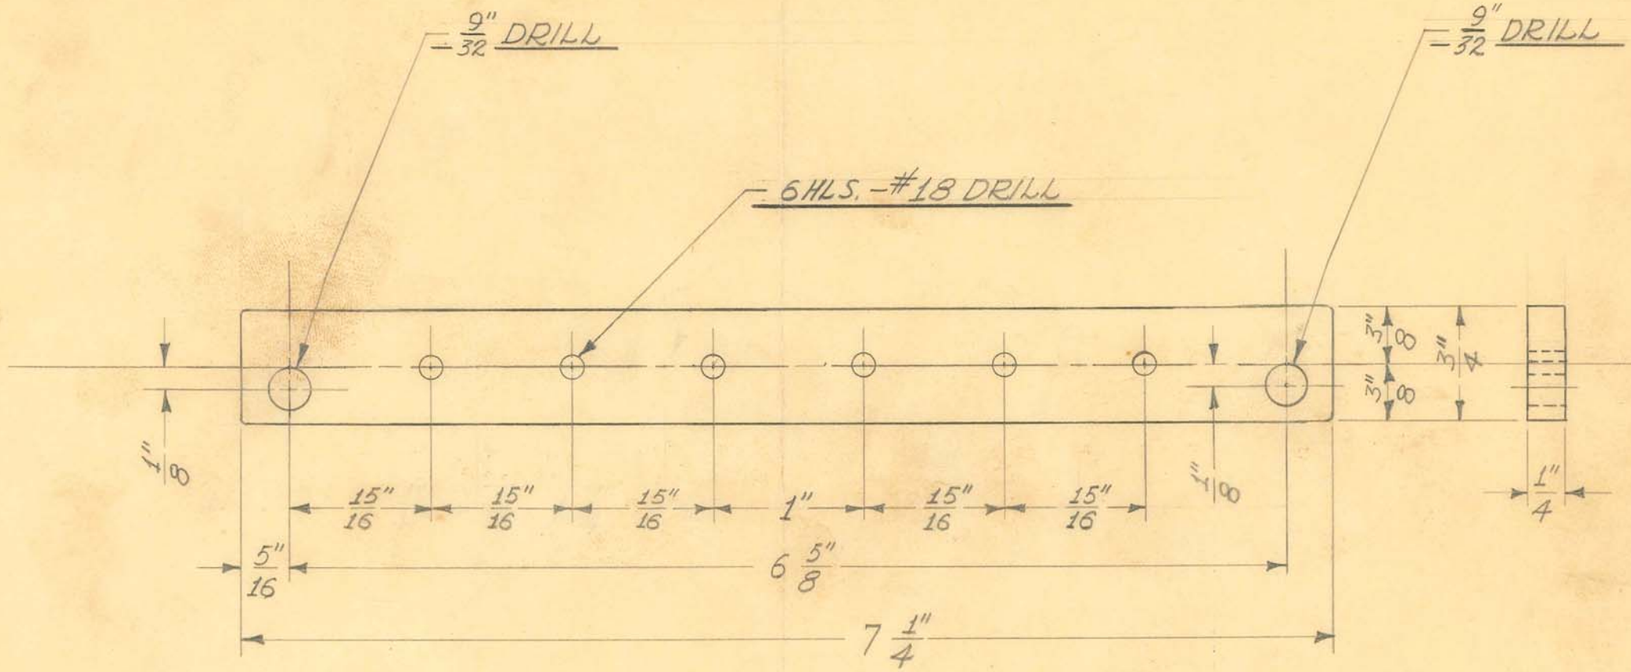

1 REQUIRED

OBSOLETE

SIZE	1/4" SHEET	ISSUE 4-12-40	J.W.	TITLE: FISCHER MOD. "B" SHORT WAVE FILAMENT TERMINAL STRIP
KIND	BLK. BAKELITE	CHANGED		
SHAPE		"		
FINISH		"		
TEMP.		"		
PATT.		"		

H. G. FISCHER & CO.
2335 WABANSIA AVE.
CHICAGO, ILL.

CAT. NO.

PART NO. 13049

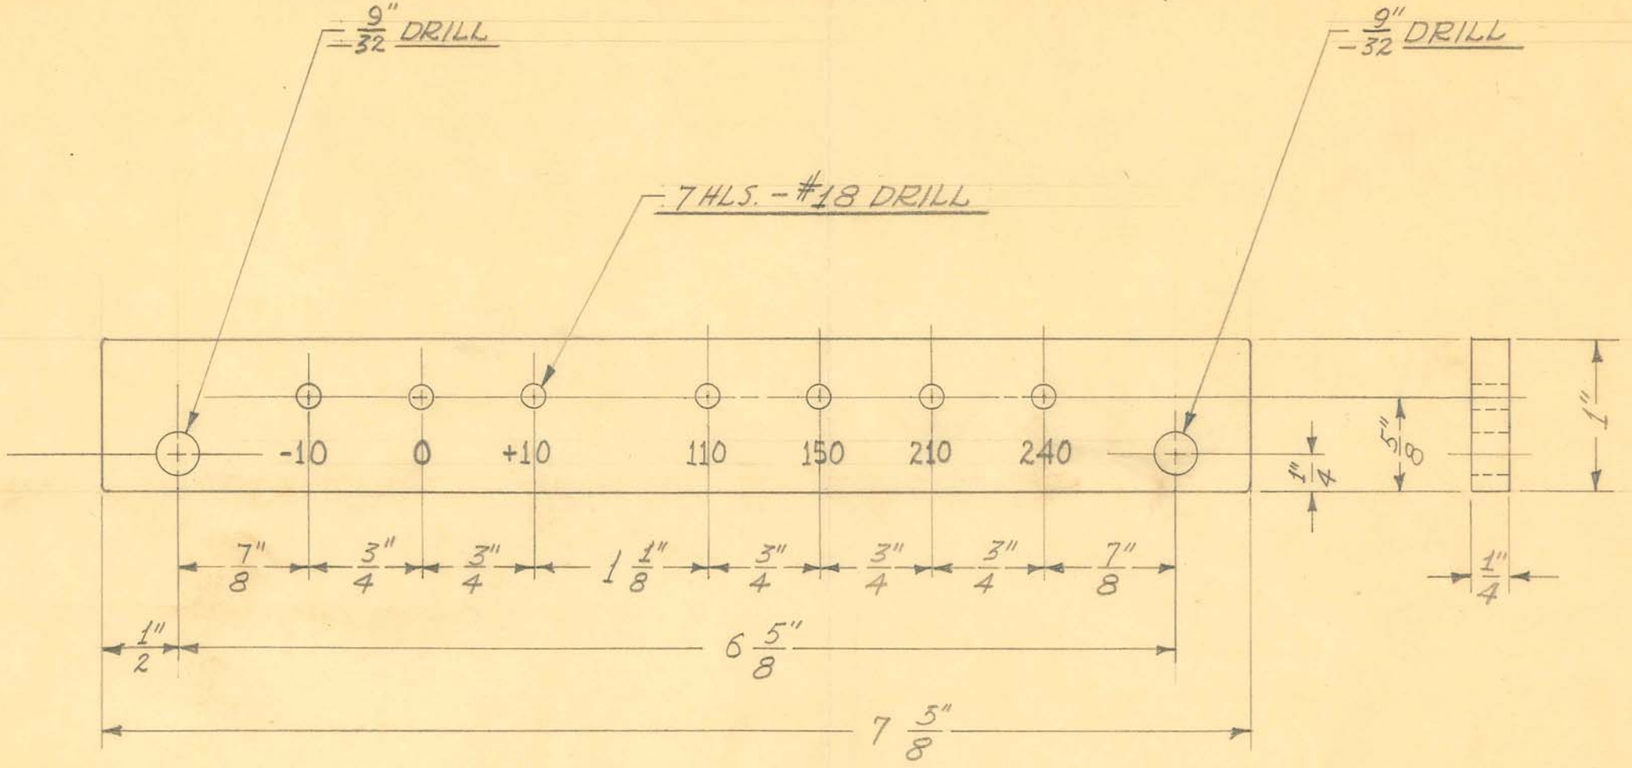

1. REQUIRED

OBSOLETE

SIZE	1/4" SHEET	ISSUE 4-12-40	J.W.
KIND	BLK. BAKELITE	CHANGED	
SHAPE		"	
FINISH		"	
TEMP.		"	
PATT.		"	

TITLE: FISCHER MOD. "B" SHORT WAVE VOLTAGE CHANGE TERMINAL STRIP (FOREIGN) (ENGRAVED)

H. G. FISCHER & CO.
2335 WABANSIA AVE.
CHICAGO, ILL.

CAT. NO.

PART NO. 13054

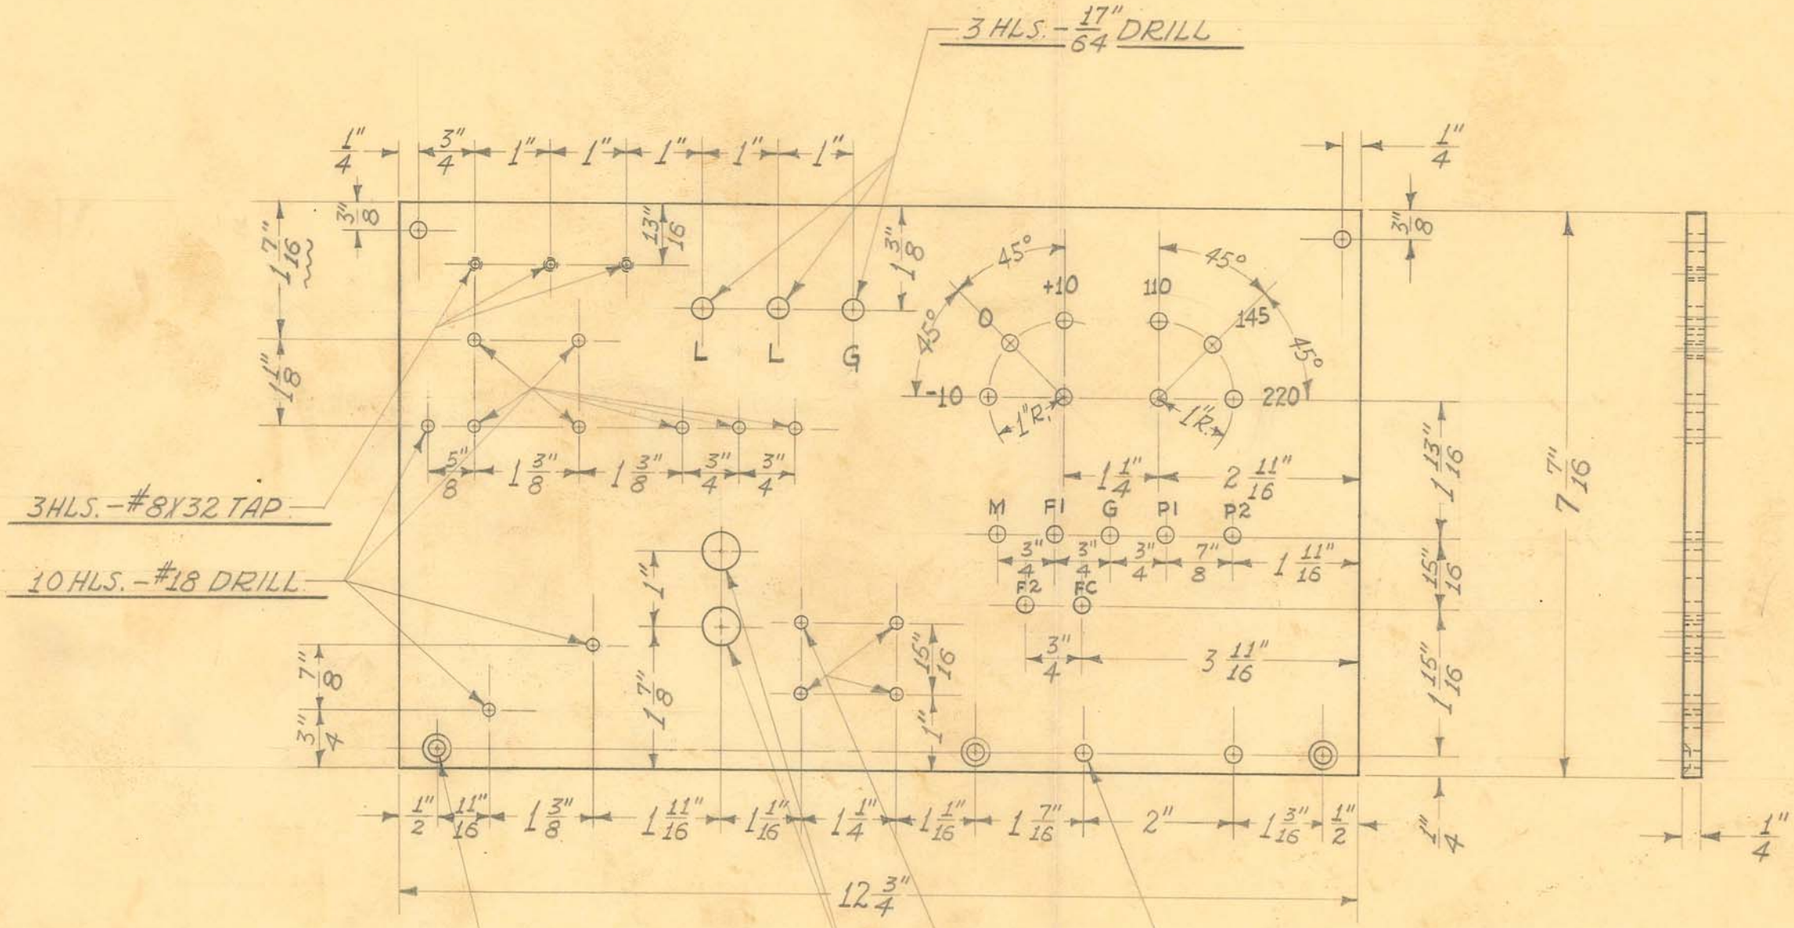

SCALE ÷ HALF SIZE

OBSOLETE

1 REQUIRED

SIZE	1/4" SHEET	ISSUE 7-16-40	J.V.W.
KIND	BLK. BAKELITE	CHANGED	
SHAPE		"	
FINISH		"	
TEMP.		"	
PATT.		"	

TITLE:
FISCHER MOD. "200" X-RAY UNIT
CONTROL BOX - CONTROL BOARD

H. G. FISCHER & CO.
2335 WABANSIA AVE.
CHICAGO, ILL.

CAT. NO.

PART NO. 13067

3 HLS.-$\frac{11}{32}$" DRILL THRU-$\frac{7}{8}$" C'BORE.
-$\frac{5}{16}$" DEEP-FROM BOTTOM SIDE.

4 HLS.-#25 DRILL-$\frac{1}{2}$" DEEP
FROM BOTTOM SIDE.

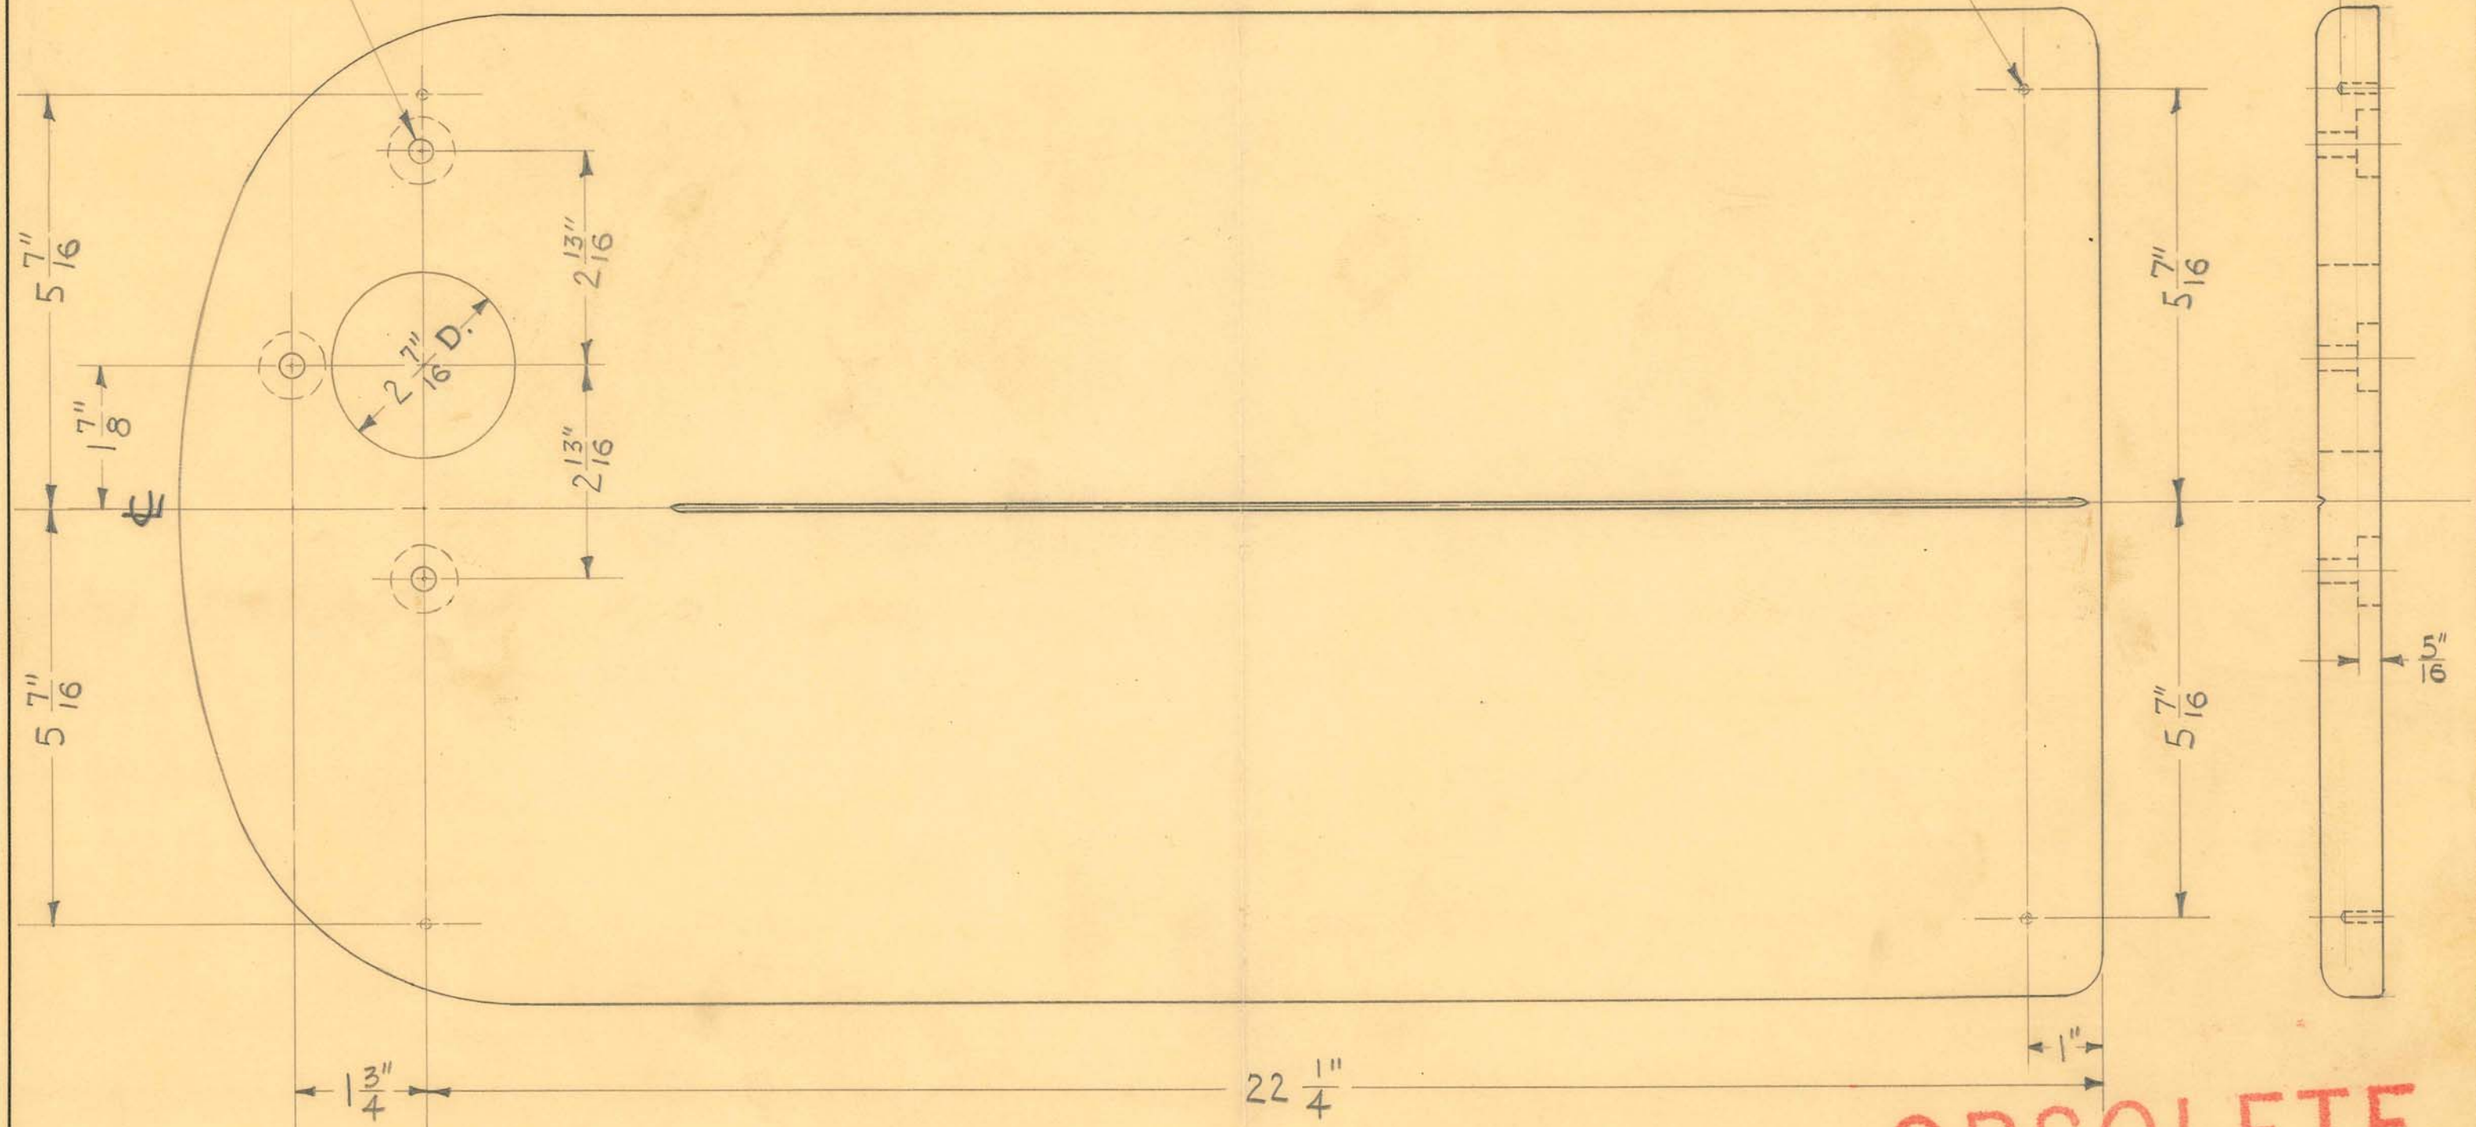

1 REQUIRED

SCALE ~ $\frac{1}{2}$" = 1"

OBSOLETE

SIZE	FROM 14396	ISSUE 12-17-41	J.V.W.	TITLE: FISCHER MOD. "PN" PORTABLE X-RAY TABLE BASE (DRILLED)
KIND		CHANGED		
SHAPE		"		
FINISH		"		
TEMP.		"		
PATT.		"		

H. G. FISCHER & CO.
2335 WABANSIA AVE.
CHICAGO, ILL.

CAT. NO.

PART NO. 14396F

$\frac{1}{4}$" DRILL C'SINK BOTH ENDS TO $\frac{3}{8}$" FACE. INSERT $\frac{1}{4}$" C.R. STEEL PIN. RIVET BOTH ENDS & SMOOTHEN

DRIVE BAR INTO TUBE AS SHOWN. FILE PROTRUDING END TO APPROX. THE DIMENSIONS SHOWN. ON ALL CORNERS, OR UNTIL BAR SLIDES INTO ANOTHER SQUARE TUBE AND CAN BE EASILY REMOVED BY HAND

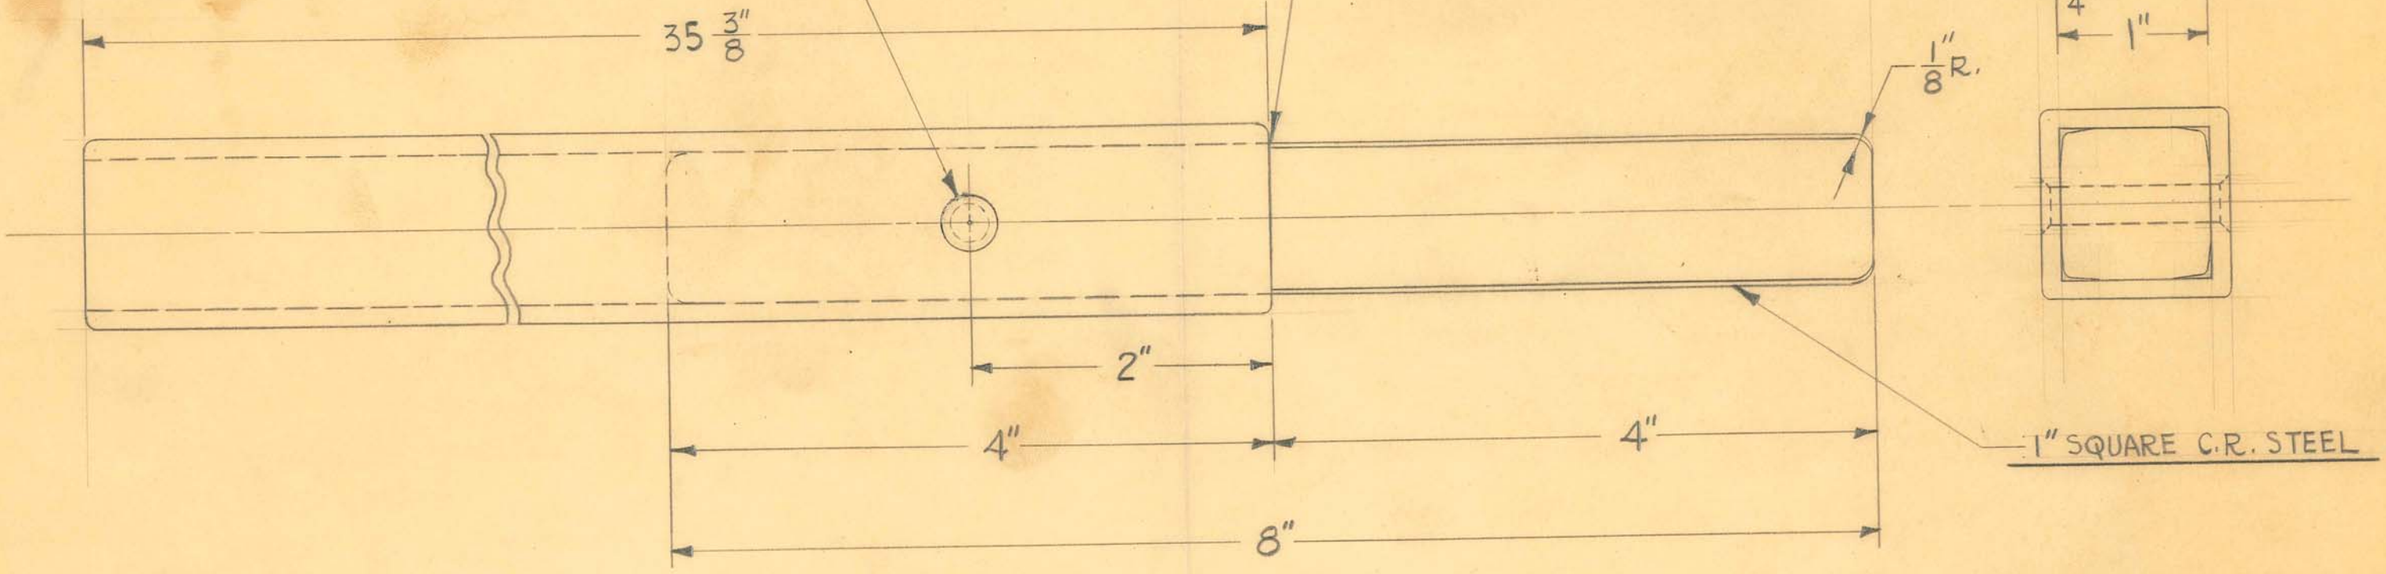

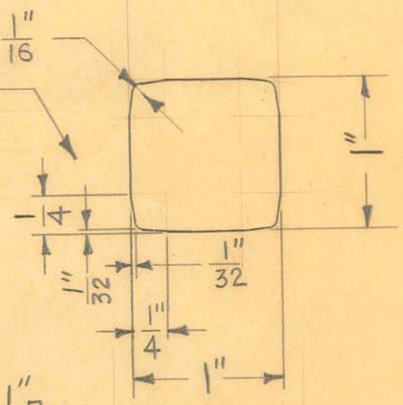

1 REQUIRED

OBSOLETE

SIZE	FROM 11965	ISSUE 2-25-42	J.V.W.	
KIND		CHANGED		
SHAPE		"		
FINISH	CAD. #24	"		
TEMP.		"		
PATT.		"		

TITLE: FISCHER MOD. "PNC"-"PND" PORTABLE X-RAY TABLE STAND-UPRIGHT TUBE EXTENSION ASSEMBLY

H. G. FISCHER & CO. 2335 WABANSIA AVE. CHICAGO, ILL.

CAT. NO.

PART NO. 14408G

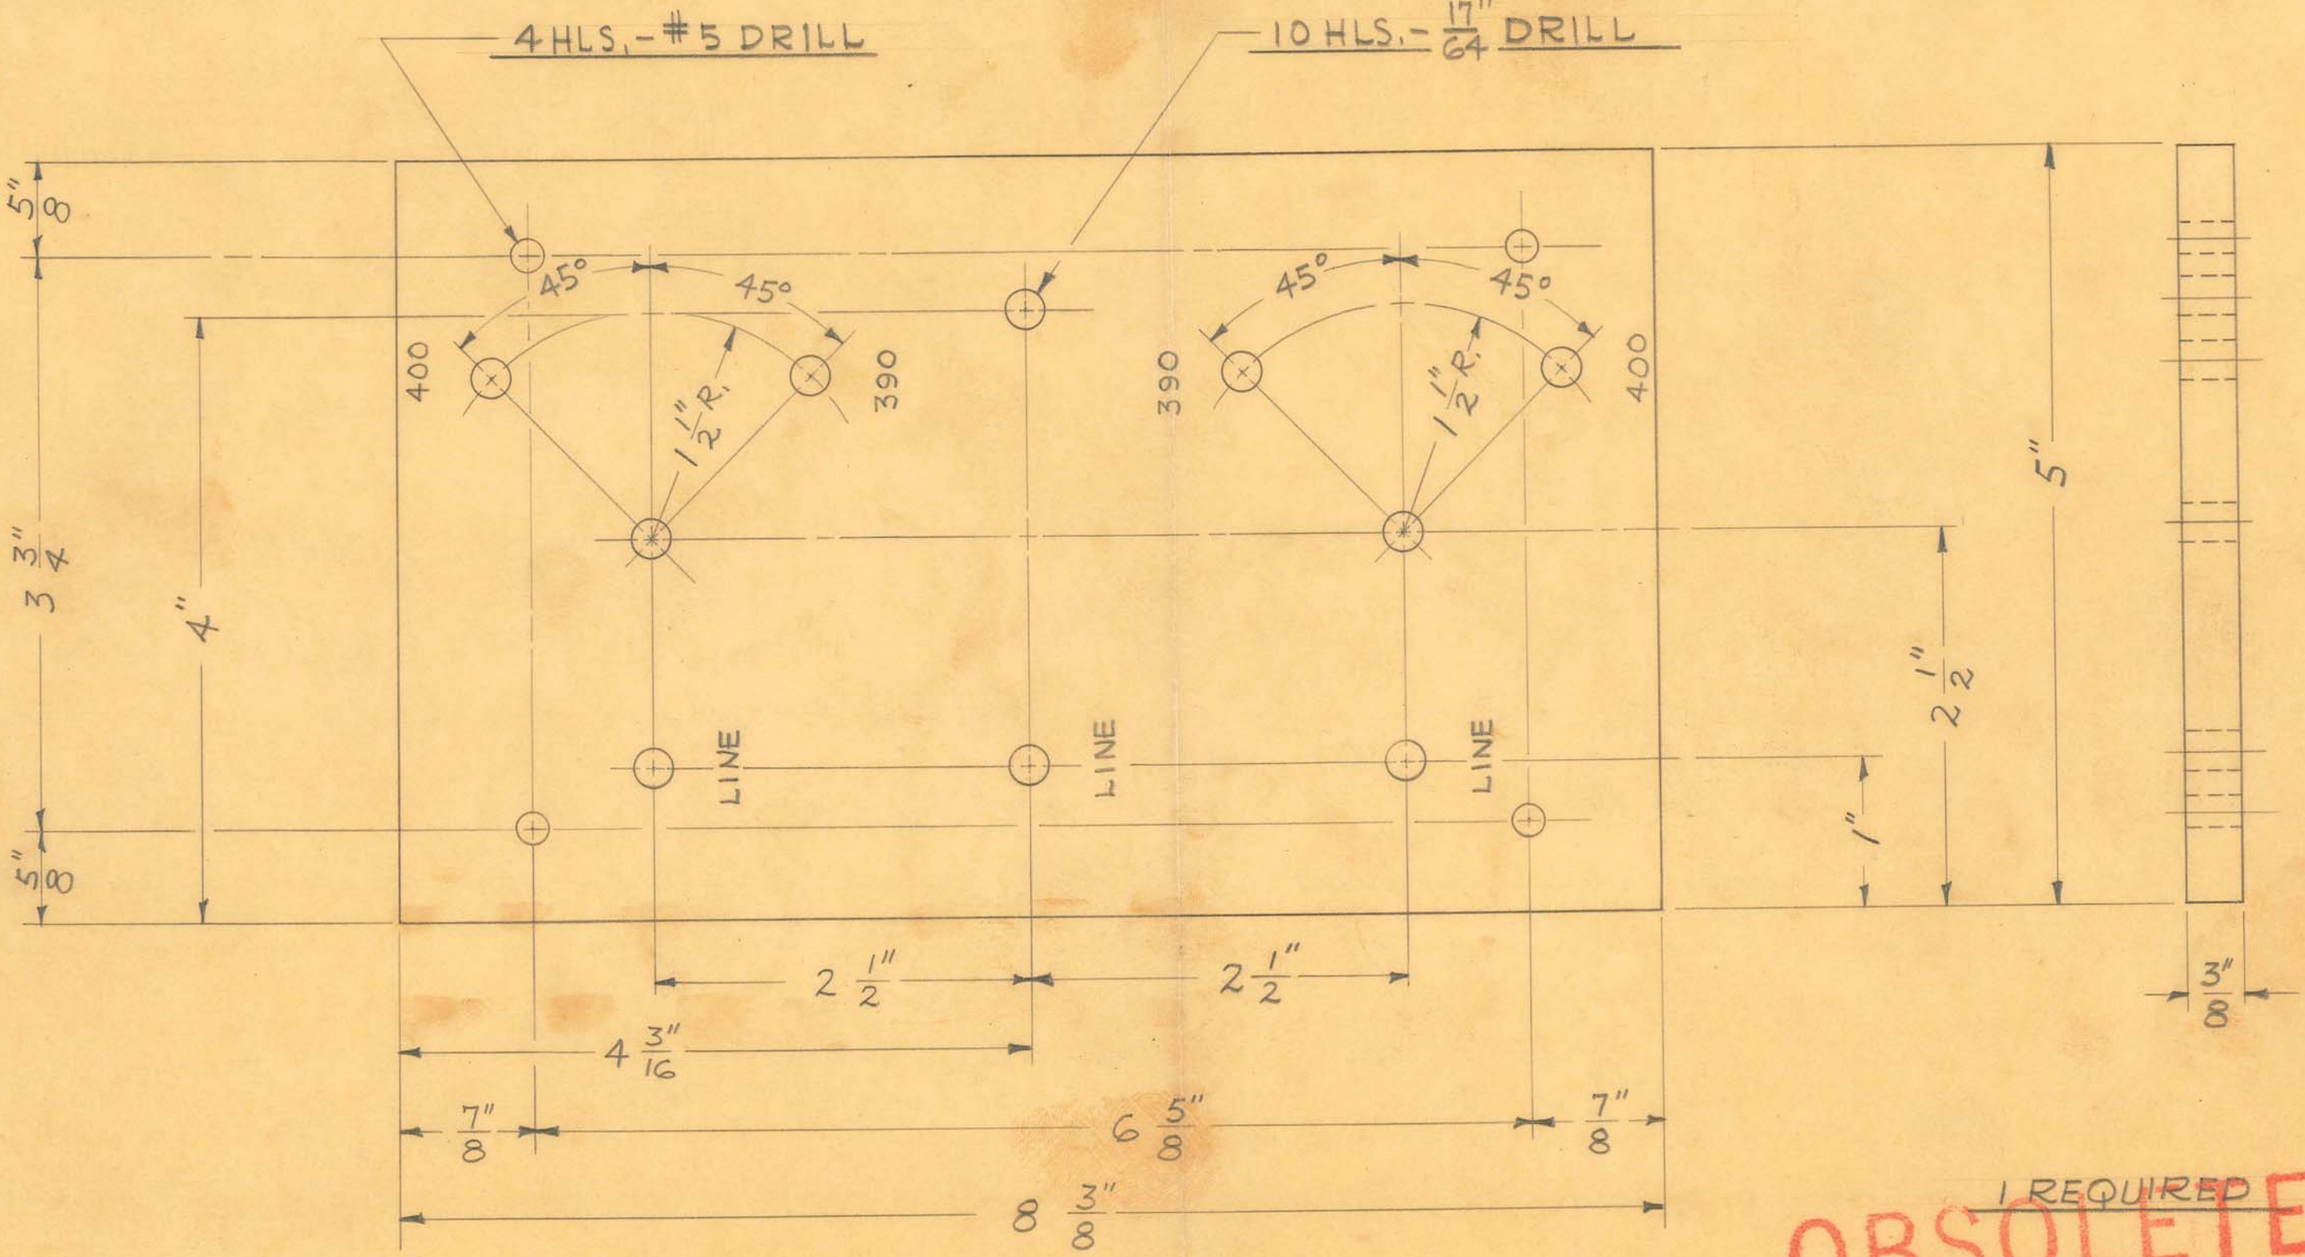

I REQUIRED

OBSOLETE

SIZE	3/8" SHEET	ISSUE 7-22-46	J.V.W.
KIND	BLK. BAKELITE	CHANGED	
SHAPE		"	
FINISH		"	
TEMP.		"	
PATT.		"	

TITLE: FISCHER MOD. "TV-30-96" X-RAY UNIT
FROM 3 PHASE TO SINGLE PHASE TRANSF.
BALANCING TRANSF. TERM. BOARD

H. G. FISCHER & CO.
2335 WABANSIA AVE.
CHICAGO, ILL.

CAT. NO.

PART NO. 14433

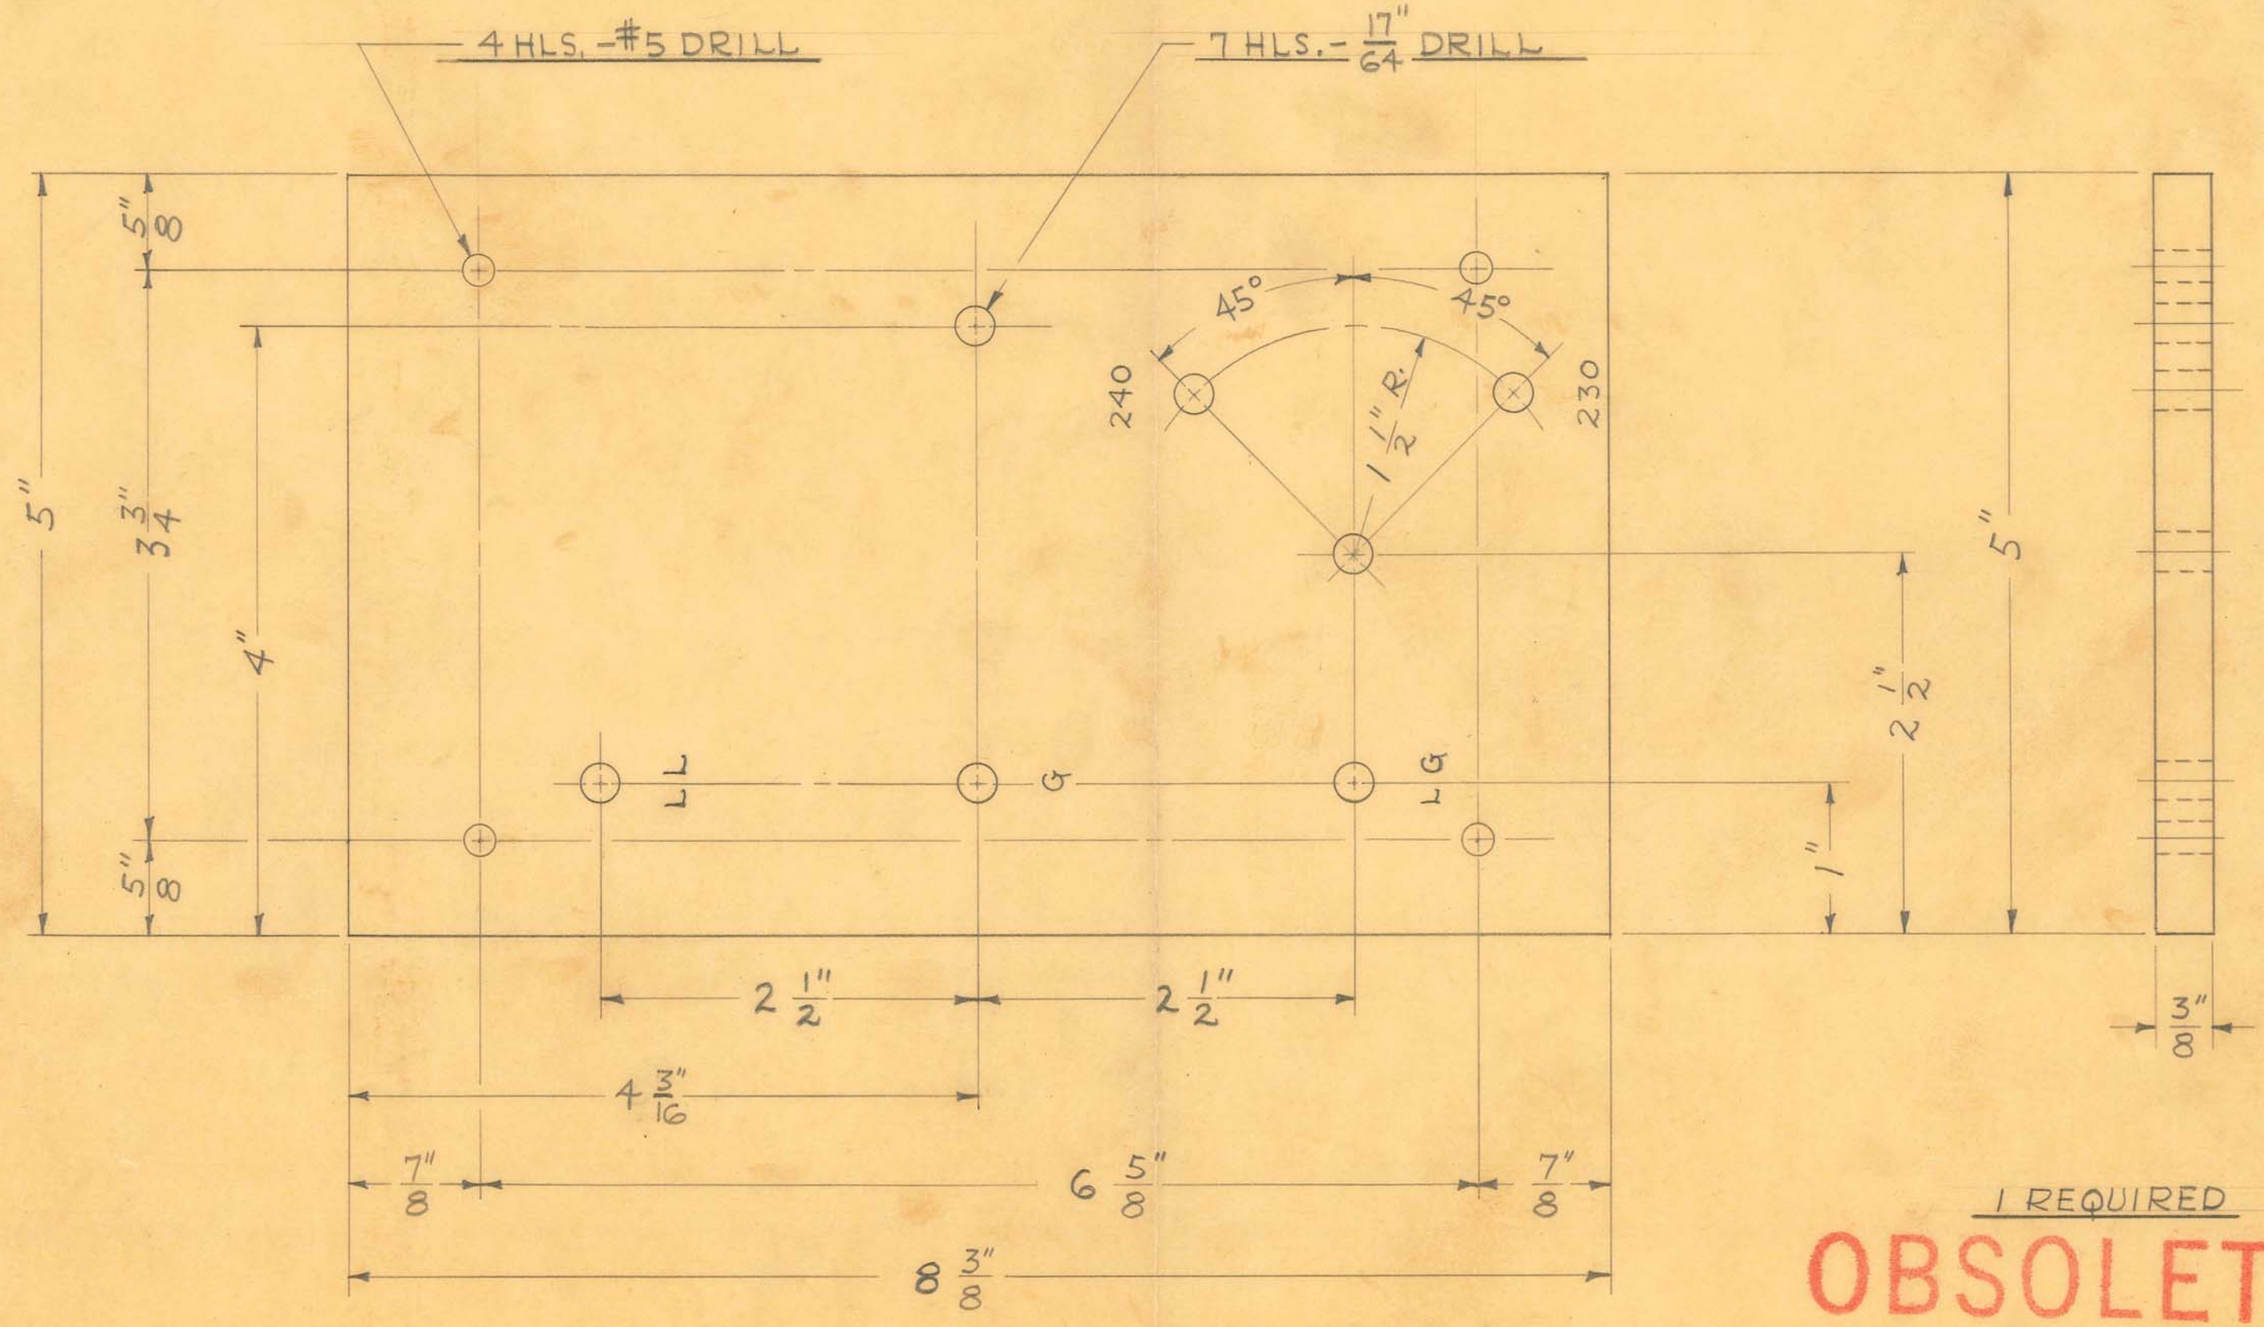

1 REQUIRED

OBSOLETE

SIZE	3/8" SHEET	ISSUE 7-22-46	J.V.W.	TITLE: FISCHER MOD. "TV-30-96" X-RAY UNIT FROM 3 PHASE TO SINGLE PHASE TRANSF. AUTO TRANSF. TERM. BOARD
KIND	BLK. BAKELITE	CHANGED		
SHAPE		"		
FINISH		"		
TEMP.		"		
PATT.		"		

H. G. FISCHER & CO.
2338 WABANSIA AVE.
CHICAGO, ILL.

CAT. NO.

PART NO. 14434

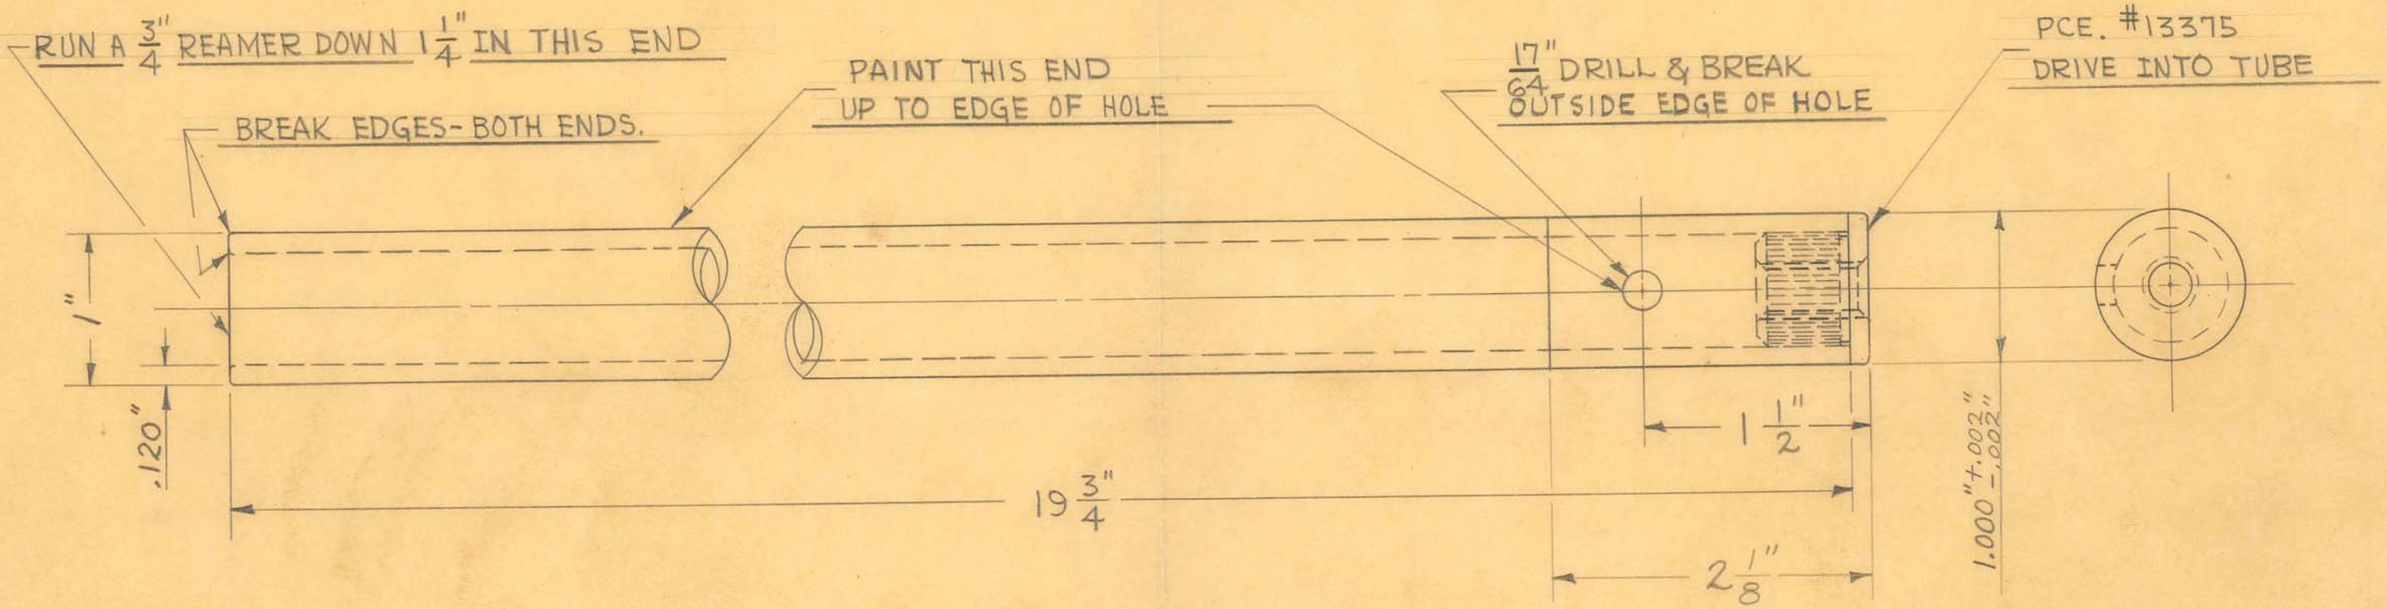

1" O.D. X #11 GA. (.120") WALL SHELBY SEAMLESS STEEL TUBING

1 REQUIRED

OBSOLETE

SIZE		ISSUE 8-21-46	J.V.W.
KIND		CHANGED	
SHAPE		" 12-9-46	J.V.W.
FINISH	PAINTED	"	
TEMP.	(SEE ABOVE)	"	
PATT.		"	

TITLE: FISCHER "TV-30-96" X-RAY UNIT
VERTICAL COLUMN ROTATION LOCK TUBE

H. G. FISCHER & CO.
2338 WABANSIA AVE.
CHICAGO, ILL.

CAT. NO.

PART NO. 14441G

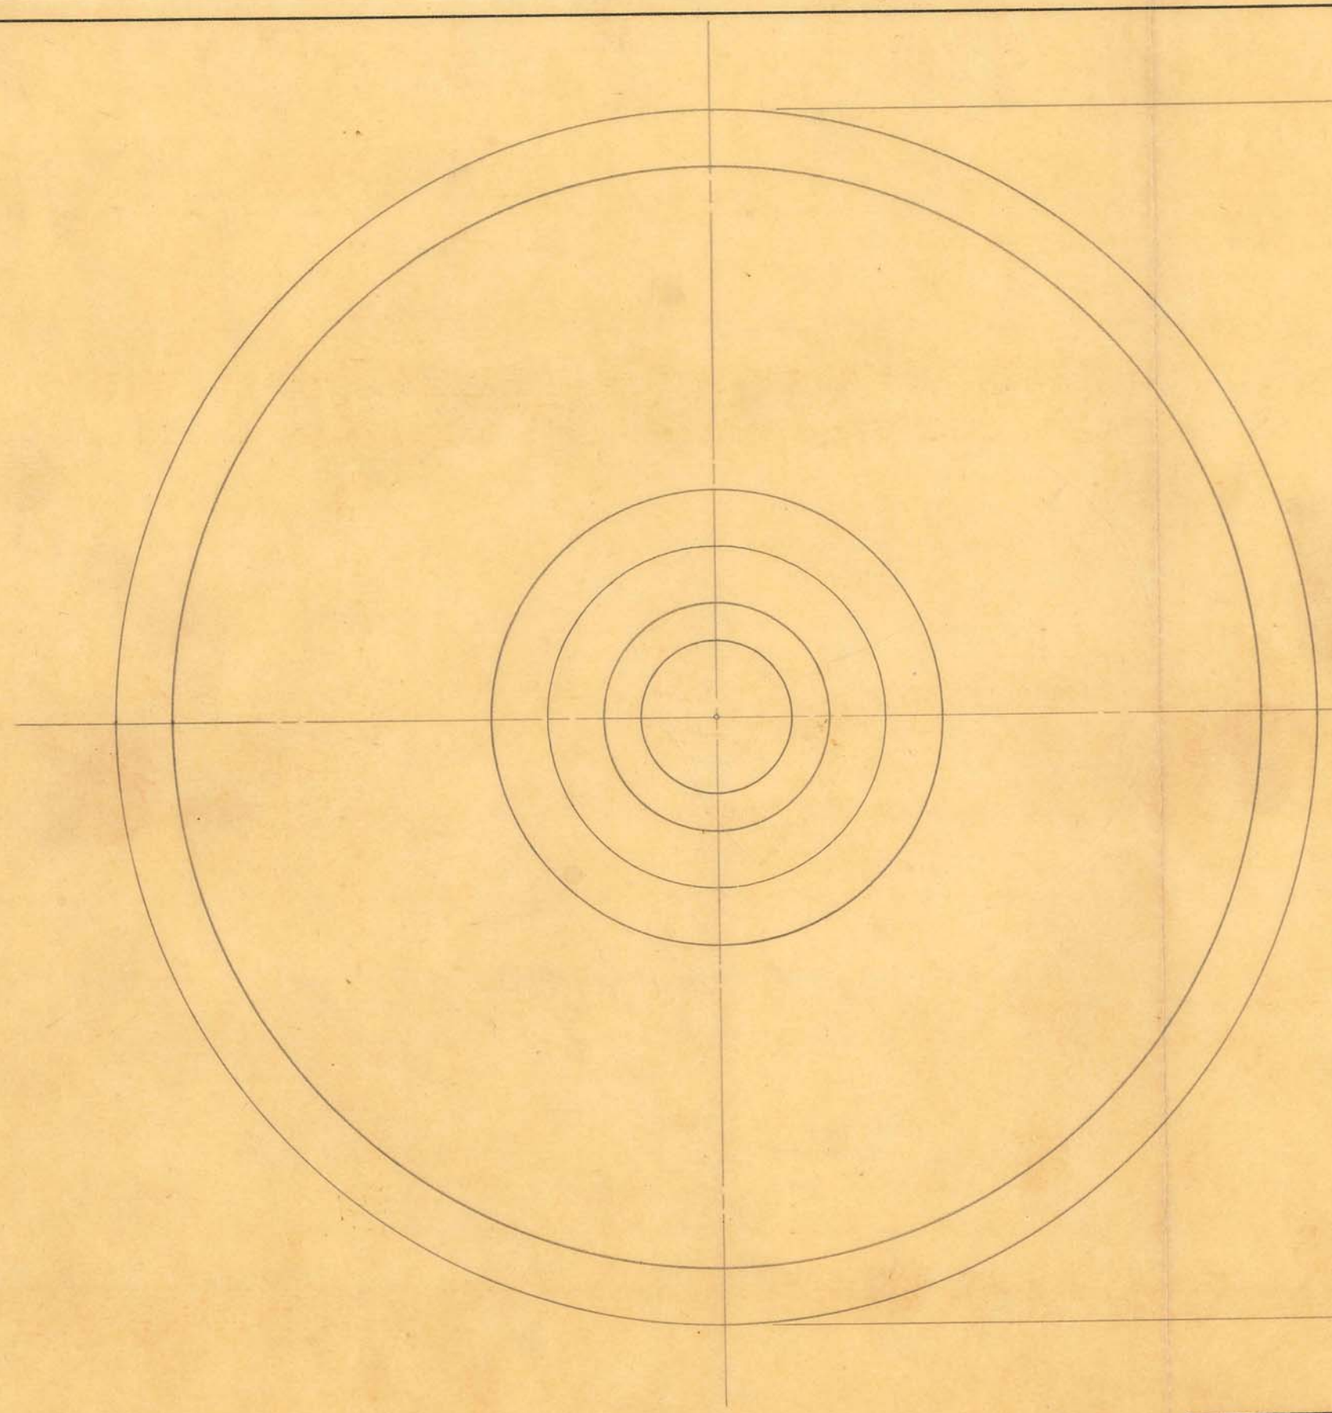

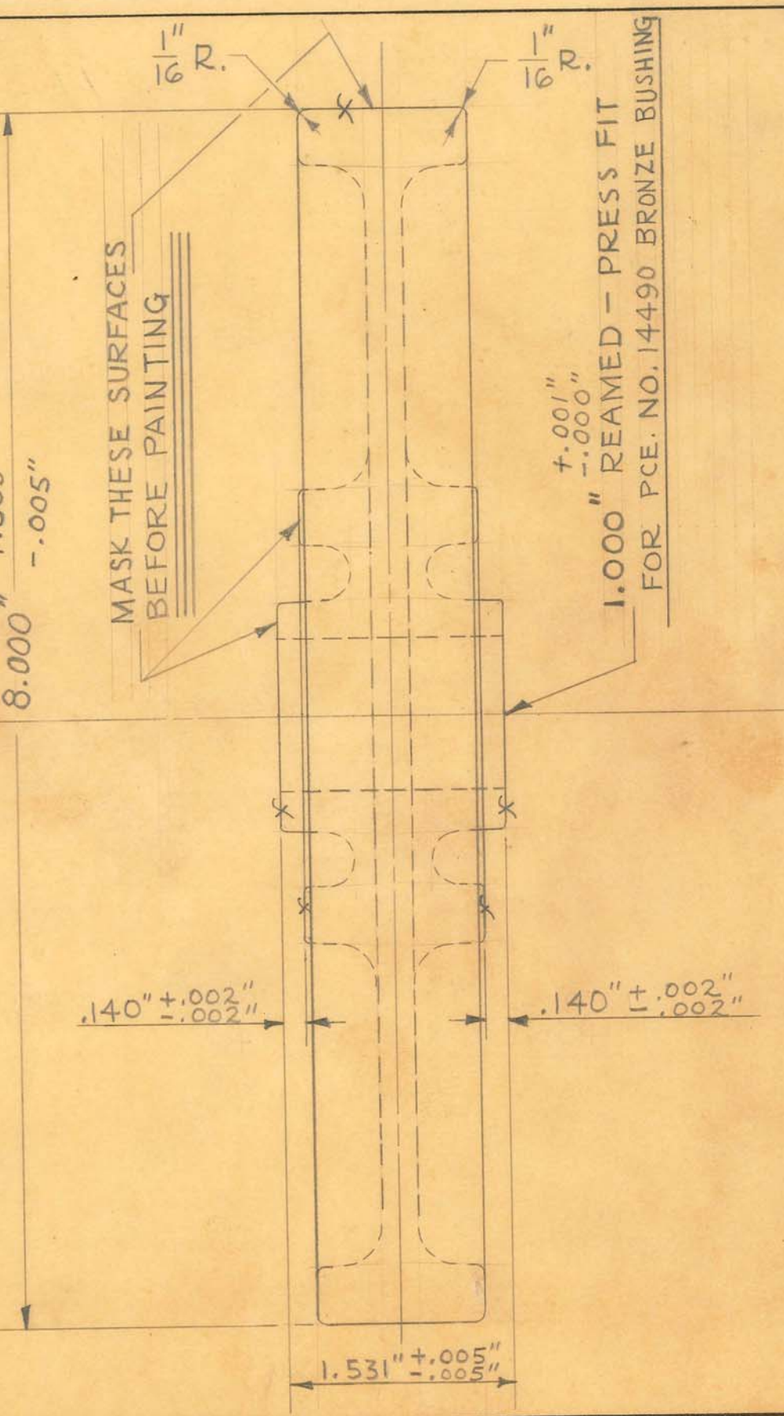

2 REQUIRED

SIZE	IRON CASTING	ISSUE 8-13-46	
KIND		CHANGED	
SHAPE		"	
FINISH	PAINTED SEE NOTE	"	
TEMP.		"	
PATT.	2084	"	

TITLE: FISCHER MOD. "TV-30-96" RAD. & FLUO. UNIT
BASE ROLLER – PLAIN

H. G. FISCHER & CO.
2335 WABANSIA AVE.
CHICAGO, ILL.

CAT. NO.

PART NO. 14446F

OBSOLETE

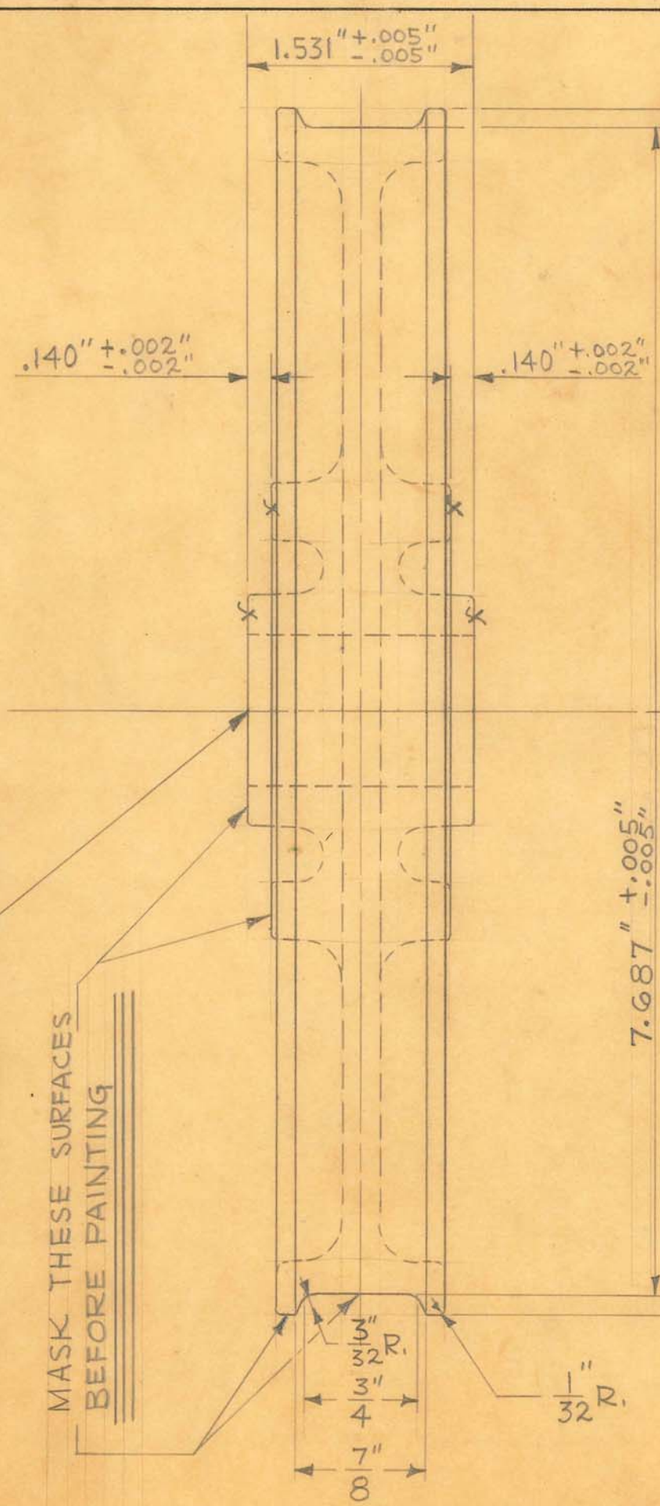

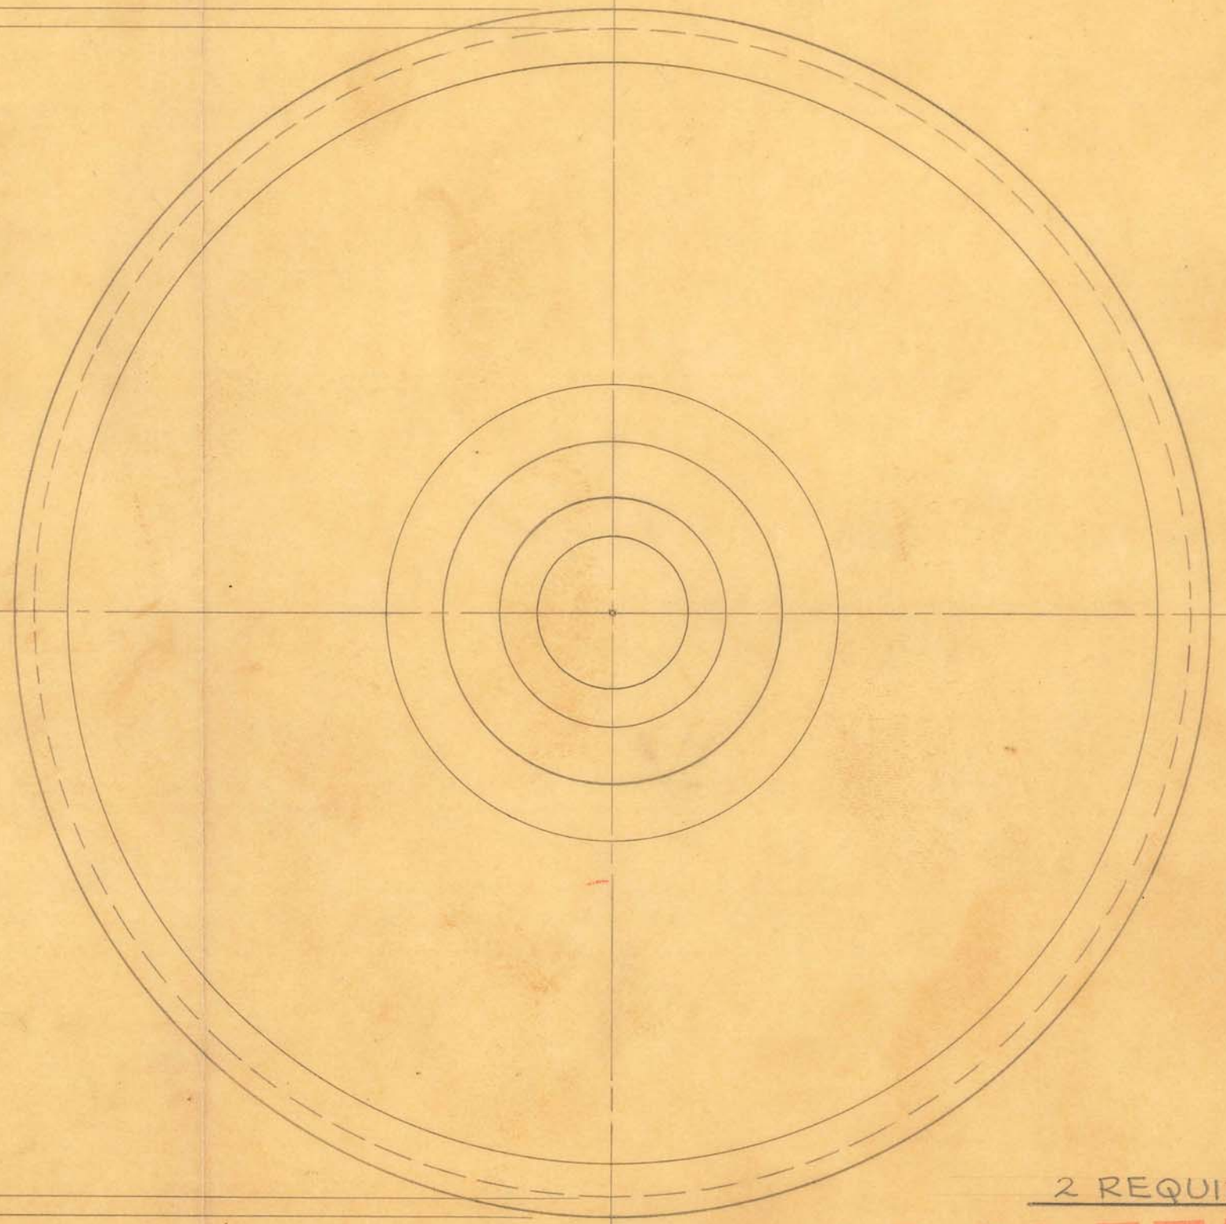

2 REQUIRED

OBSOLETE

FROM 14446

SIZE	IRON	ISSUE 8-13-46	J.V.W.
KIND	CASTING	CHANGED	
SHAPE		"	
FINISH	PAINTED SEE NOTE	"	
TEMP.		"	
PATT.	2084	"	

TITLE:
FISCHER MOD. "TV-30-96" RAD. & FLUO. UNIT
BASE ROLLER - GROOVED

H. G. FISCHER & CO.
2335 WABANSIA AVE.
CHICAGO, ILL.

CAT. NO.

PART NO. 14447

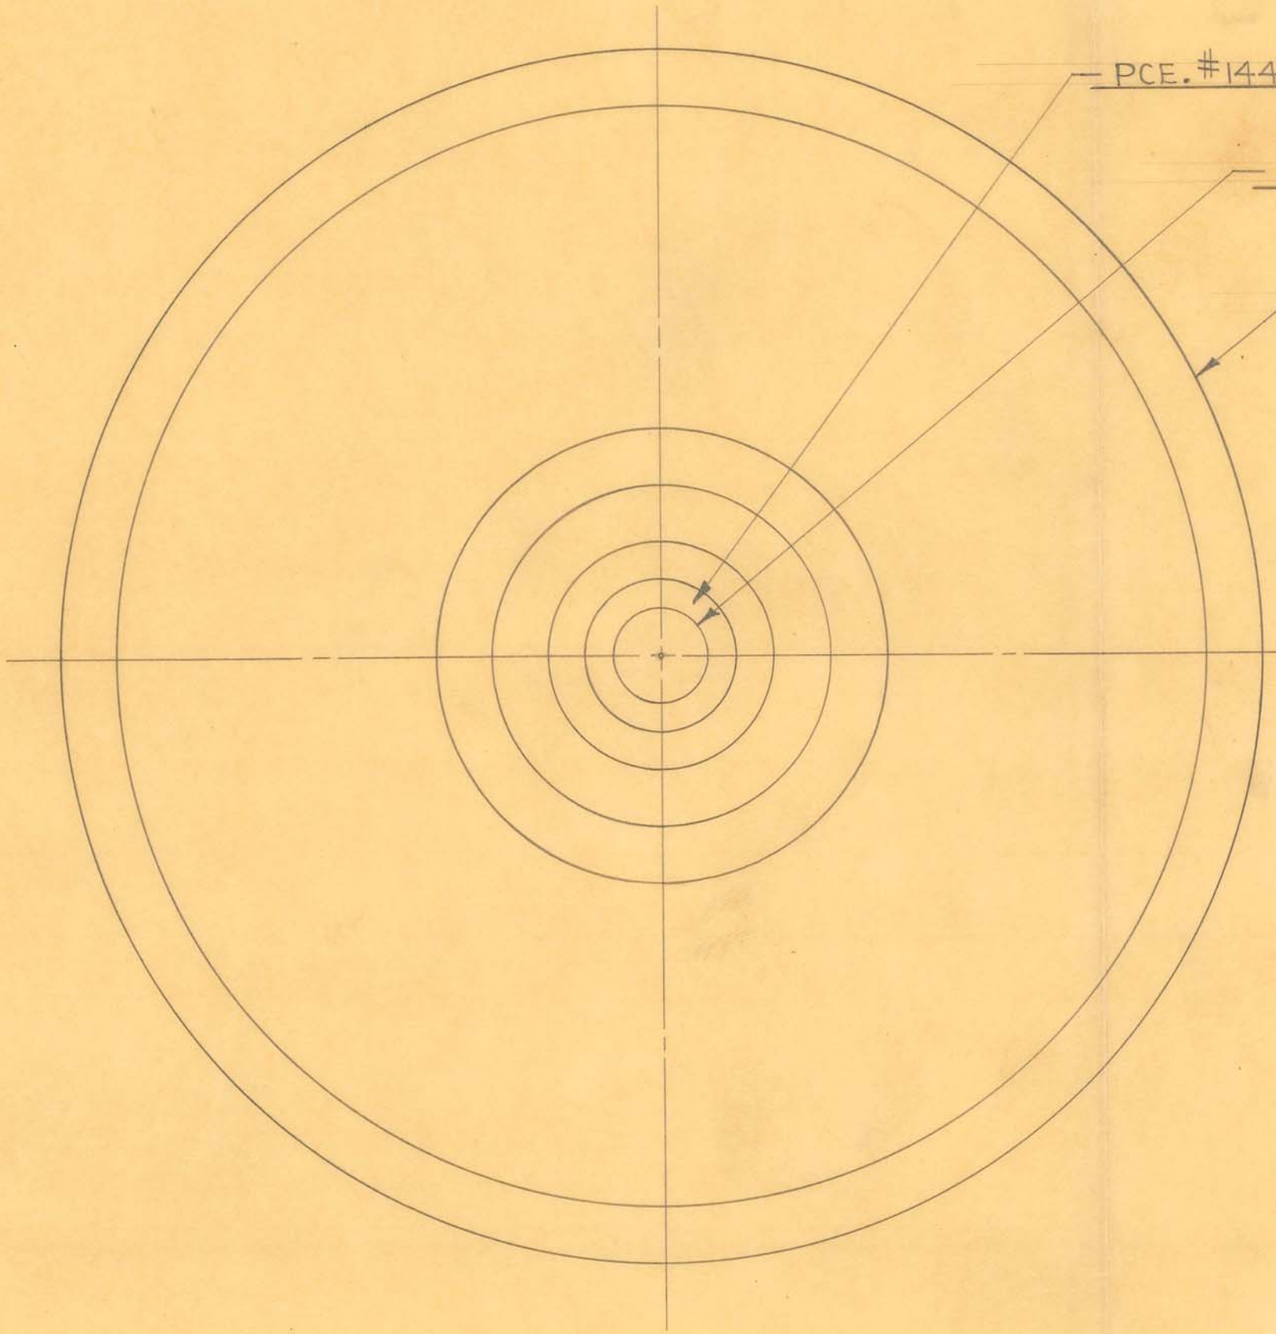

2 REQUIRED

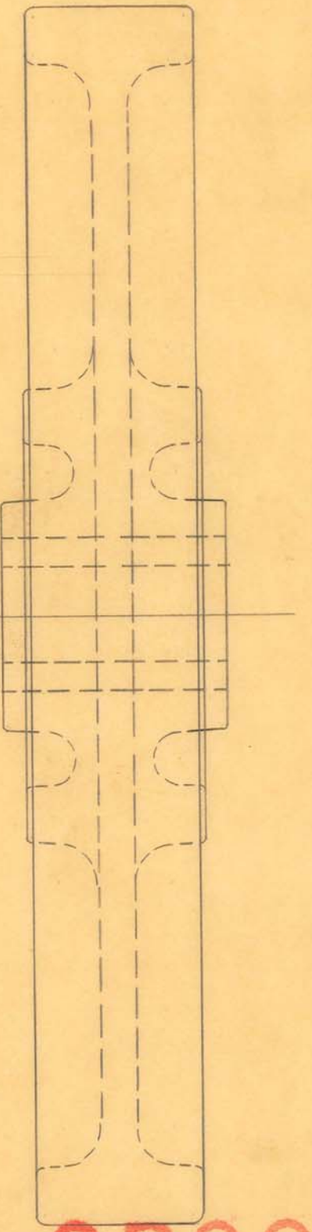

OBSOLETE

SIZE		ISSUE 10-29-46	J.V.W.
KIND		CHANGED	
SHAPE		"	
FINISH		"	
TEMP.		"	
PATT.		"	

TITLE: FISCHER MOD. "TV-30-96" RAD. & FLUO. UNIT
BASE ROLLER - PLAIN

H. G. FISCHER & CO.
2335 WABANSIA AVE.
CHICAGO, ILL.

CAT. NO.

PART NO. 14448G

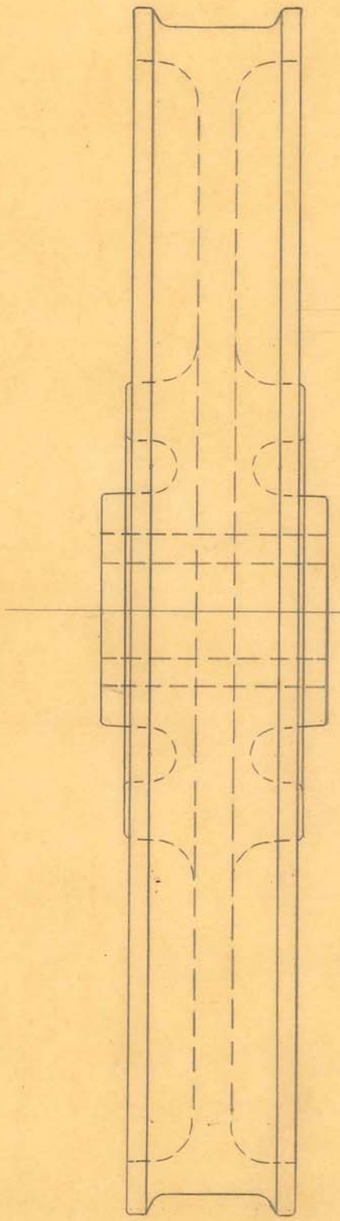

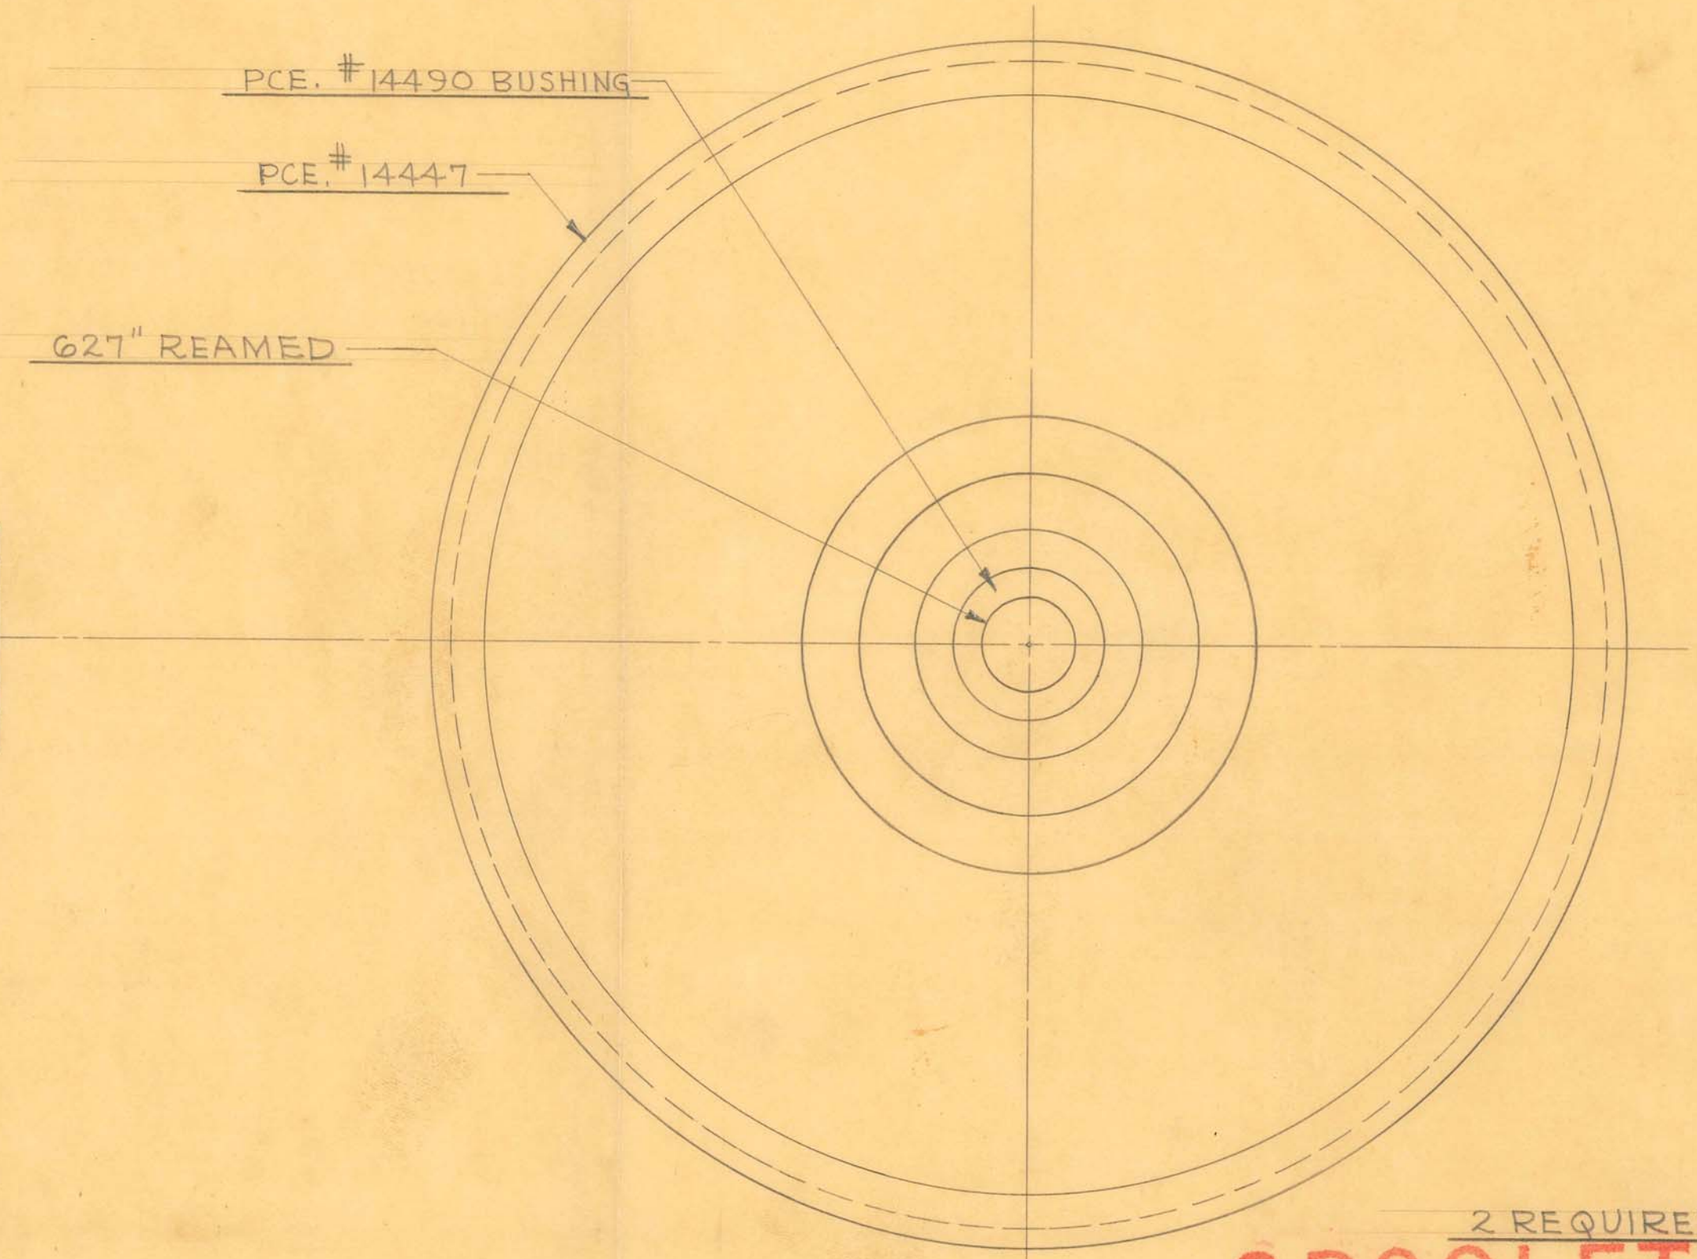

2 REQUIRED

OBSOLETE

SIZE		ISSUE 10-29-46	J.V.W.	TITLE: FISCHER MOD. "TV-30-96" RAD. & FLUO. UNIT BASE ROLLER - GROOVED
KIND		CHANGED		
SHAPE		"		
FINISH		"		
TEMP.		"		H. G. FISCHER & CO. 2333 WABANSIA AVE. CHICAGO, ILL. — CAT. NO. — PART NO. 14449G
PATT.		"		

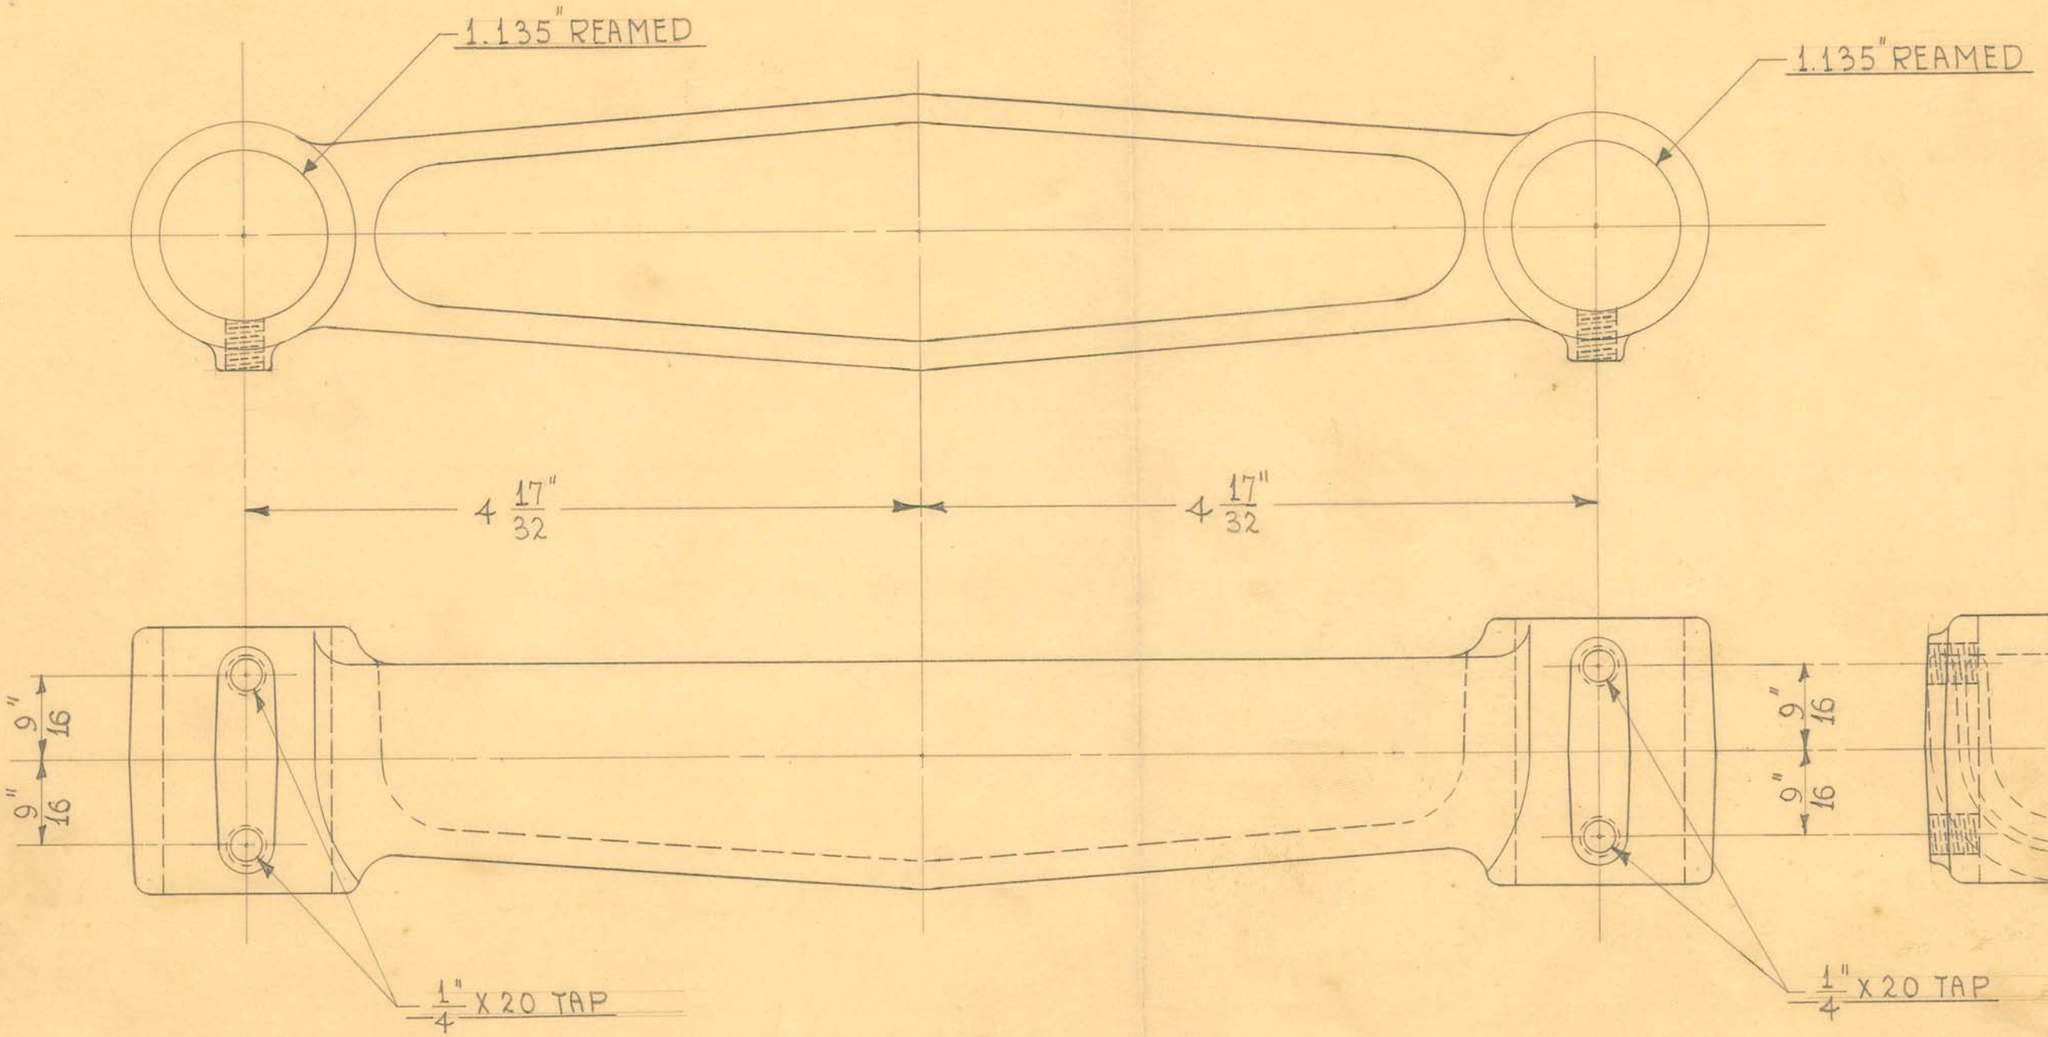

1 REQUIRED

OBSOLETE

SIZE		ISSUE 12-17-41	HE.	
KIND	IRON CASTING	CHANGED		
SHAPE		"		
FINISH	PAINTED	"		
TEMP.		"		
PATT.	1814	"		

TITLE: "TV-30-96" RAD. & FLUOR. UNIT-
HORIZ. SLIDE RODS TIE

H. G. FISCHER & CO. 2335 WABANSIA AVE. CHICAGO, ILL.	CAT. NO.	PART NO. 14456F

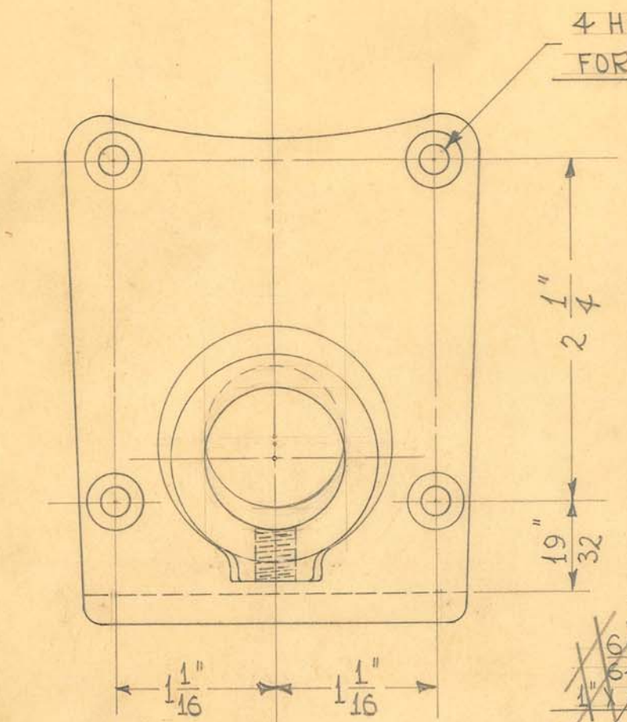

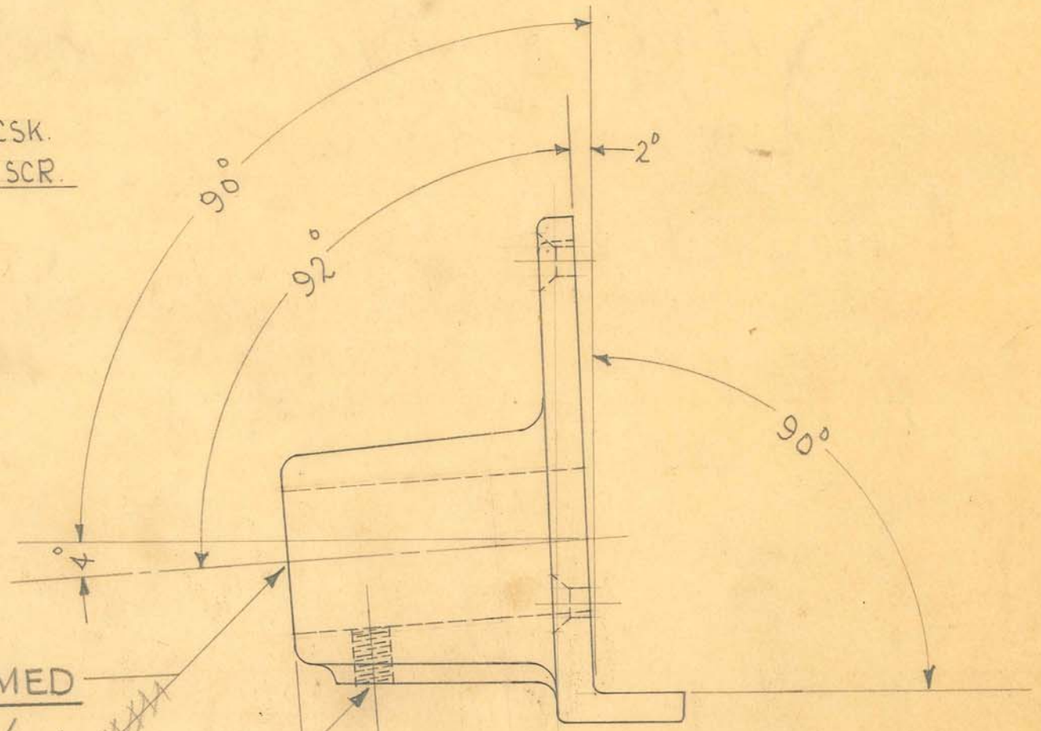

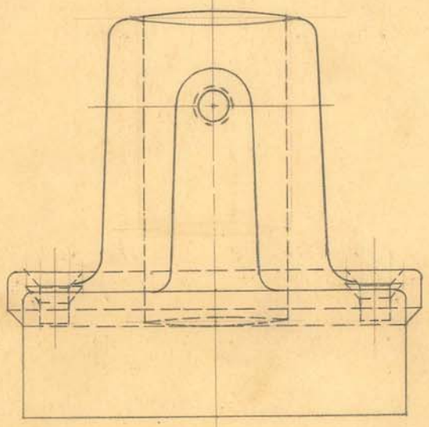

1 REQUIRED

OBSOLETE

SIZE		ISSUE 3-27-42	HE.
KIND	IRON CASTING	CHANGED	
SHAPE		"	
FINISH	PAINTED	"	
TEMP.		"	
PATT.	1847	"	

TITLE: "TV-30-96" RAD. & FLUOR. UNIT~
VERT. COL. ROTATION LOCK TUBE~ SUPPORT

H. G. FISCHER & CO.
2335 WABANSIA AVE.
CHICAGO, ILL.

CAT. NO.

PART NO. 14466FA

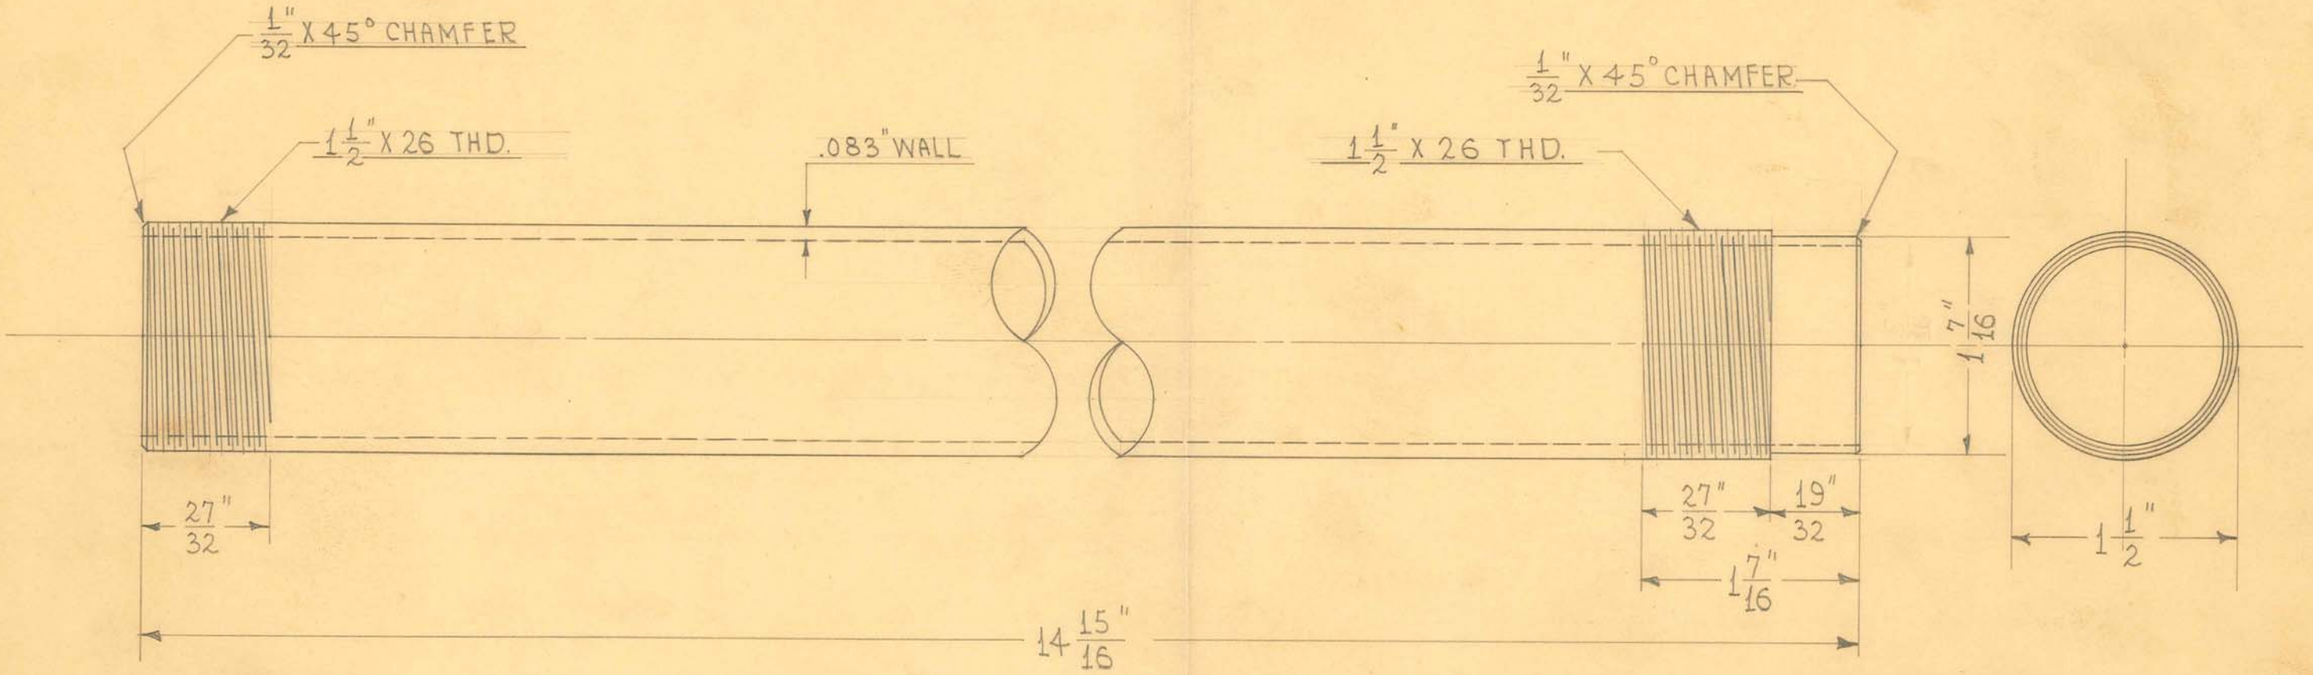

1 REQUIRED

OBSOLETE

SIZE	1½" O.D. X .083" WALL	ISSUE 11-11-41	HE	**TITLE:** "TY-30-96" RAD. & FLUOR. UNIT~ SCREEN COUNTERBALANCE TUBE
KIND	SEAMLESS STEEL	CHANGED		
SHAPE	TUBING	"		
FINISH	PAINTED	"		
TEMP.		"		
PATT.		"		

H. G. FISCHER & CO.
2335 WABANSIA AVE.
CHICAGO, ILL.

CAT. NO.

PART NO. 14468F

1/32" X 45° CHAMFER - INSIDE & OUTSIDE - BOTH ENDS.

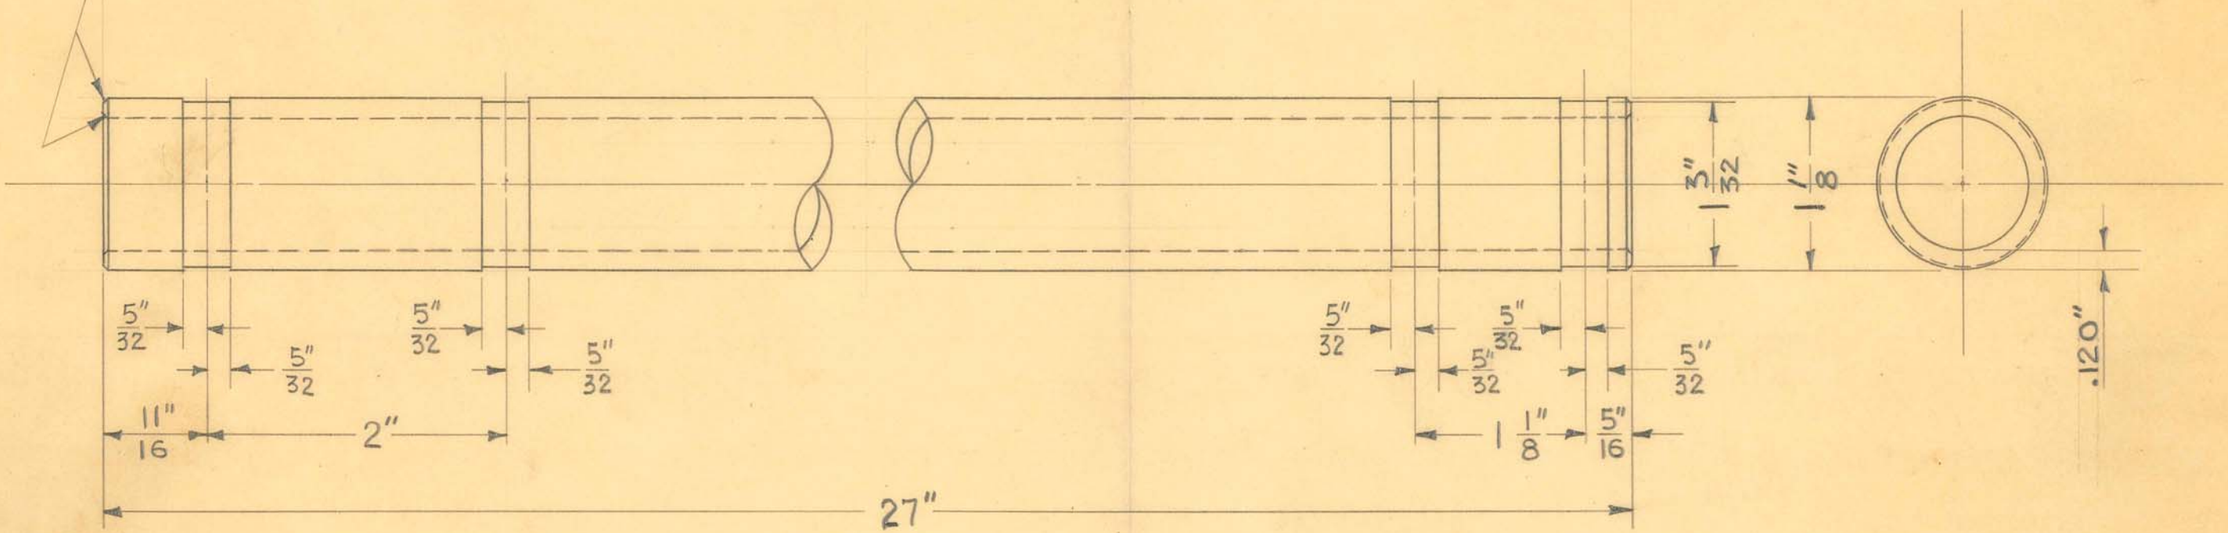

1 1/8" O.D. X #11 GA. (.120") WALL SHELBY SEAMLESS STEEL TUBING

2 REQUIRED

OBSOLETE

SIZE		ISSUE 3-28-42	J.V.W.
KIND		CHANGED	
SHAPE		"	
FINISH	SATIN CHR. #4	"	
TEMP.		"	
PATT.		"	

TITLE: FISCHER MOD. "TV-30-96" RAD. & FLUO. UNIT HORIZONTAL SLIDE TUBE

H. G. FISCHER & CO. 2335 WABANSIA AVE. CHICAGO, ILL. | CAT. NO. | PART NO. 14470F

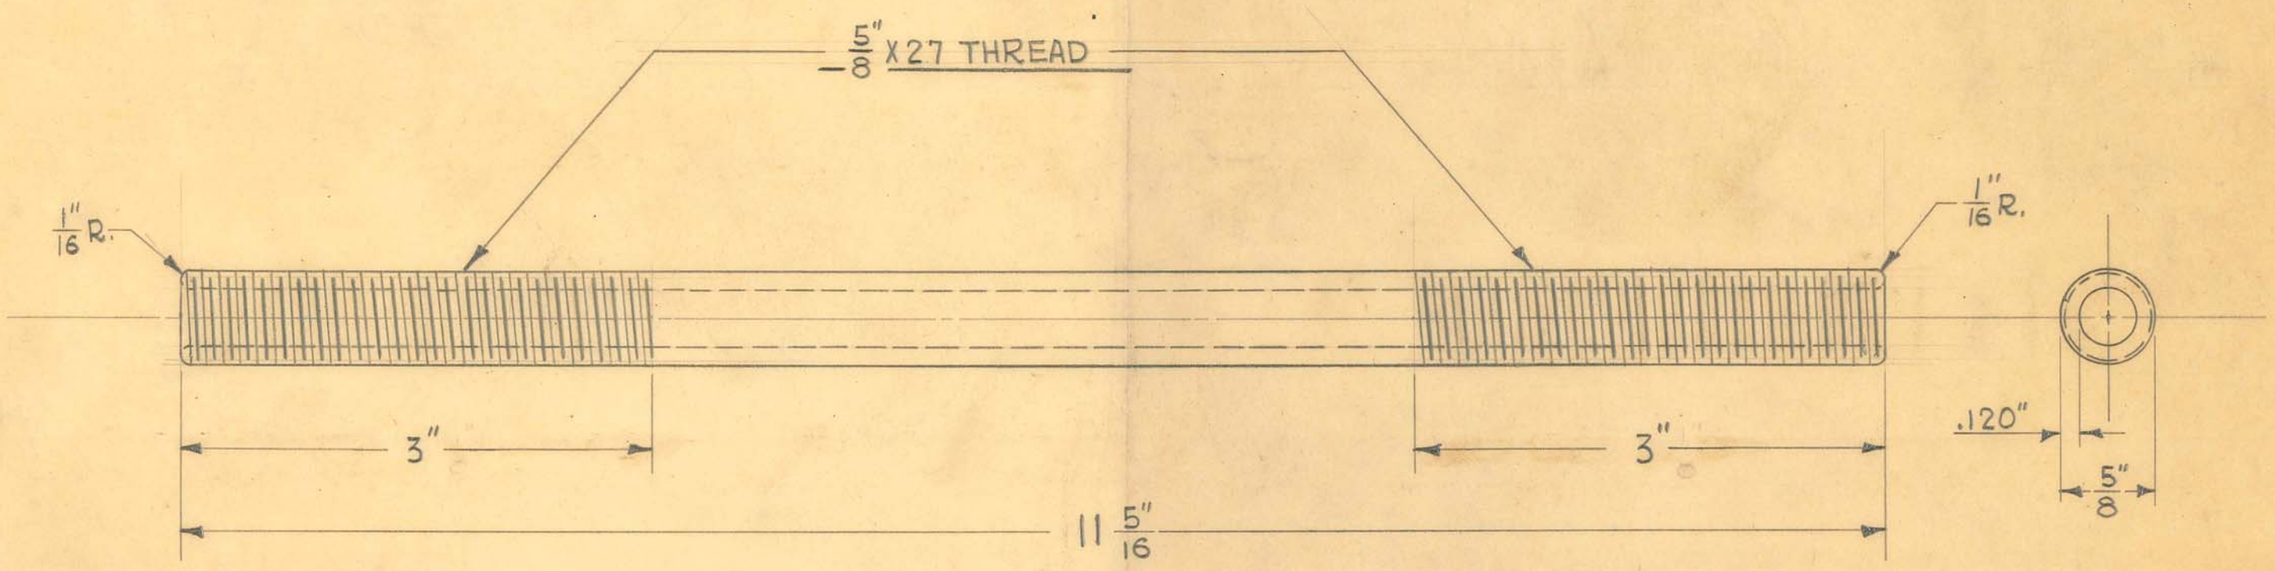

5/8" O.D. X #11 GA. (.120") WALL SHELBY SEAMLESS STEEL TUBING

2 REQUIRED

OBSOLETE

SIZE		ISSUE	
KIND		CHANGED	
SHAPE		"	
FINISH	WHITE CHR. #3	"	
TEMP.		"	
PATT.		"	

TITLE: FISCHER "TV-30-96" RAD. & FLUO. UNIT HORIZONTAL SLIDE CLAMP ROD

H. G. FISCHER & CO.
2335 WABANSIA AVE.
CHICAGO, ILL.

CAT. NO.

PART NO. 14471F

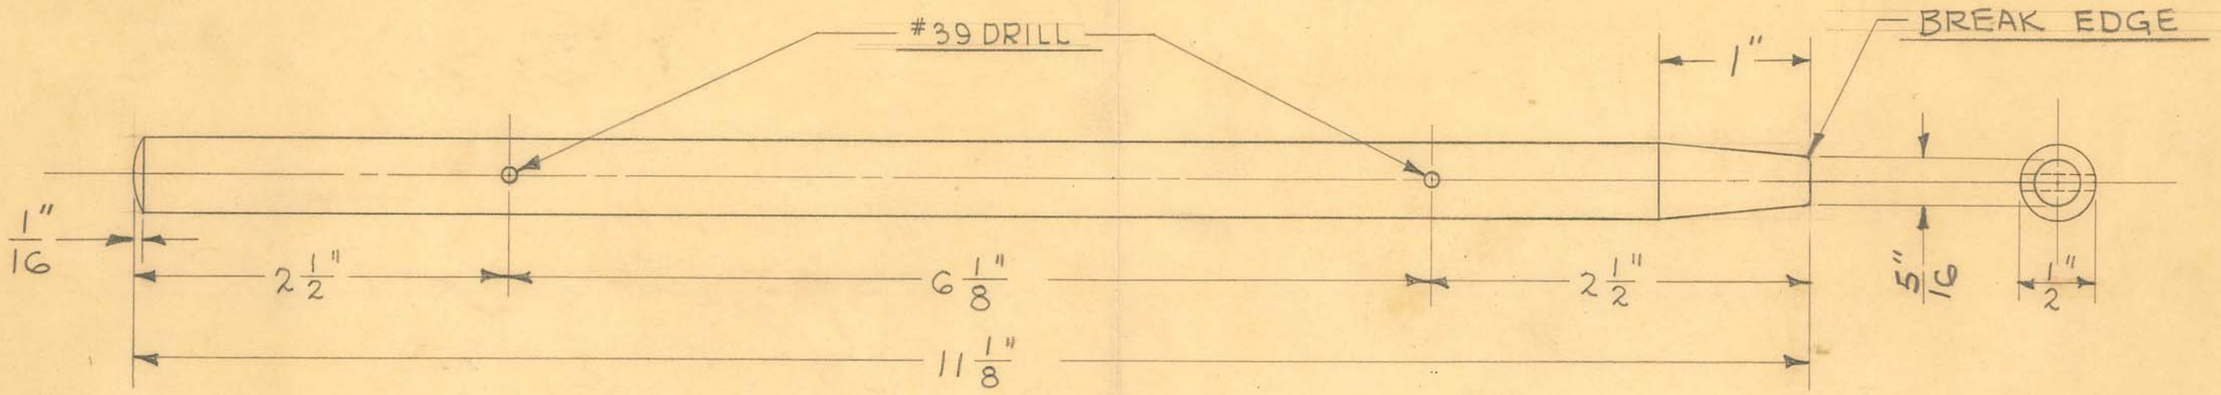

1 REQUIRED

OBSOLETE

SIZE	1/2" DIAM.	ISSUE 3-24-44	HE.	TITLE: FISCHER "TV-30-96" RAD. & FLUOR. UNIT- CWT. CLAMP ROD. (FOR SHIPPING)
KIND	C.R. STEEL	CHANGED		
SHAPE	ROD	" 10-3-46	J.V.W.	
FINISH		"		
TEMP.		"		
PATT.		"		

H. G. FISCHER & CO.
2335 WABANSIA AVE.
CHICAGO, ILL.

CAT. NO.

PART NO. 14472

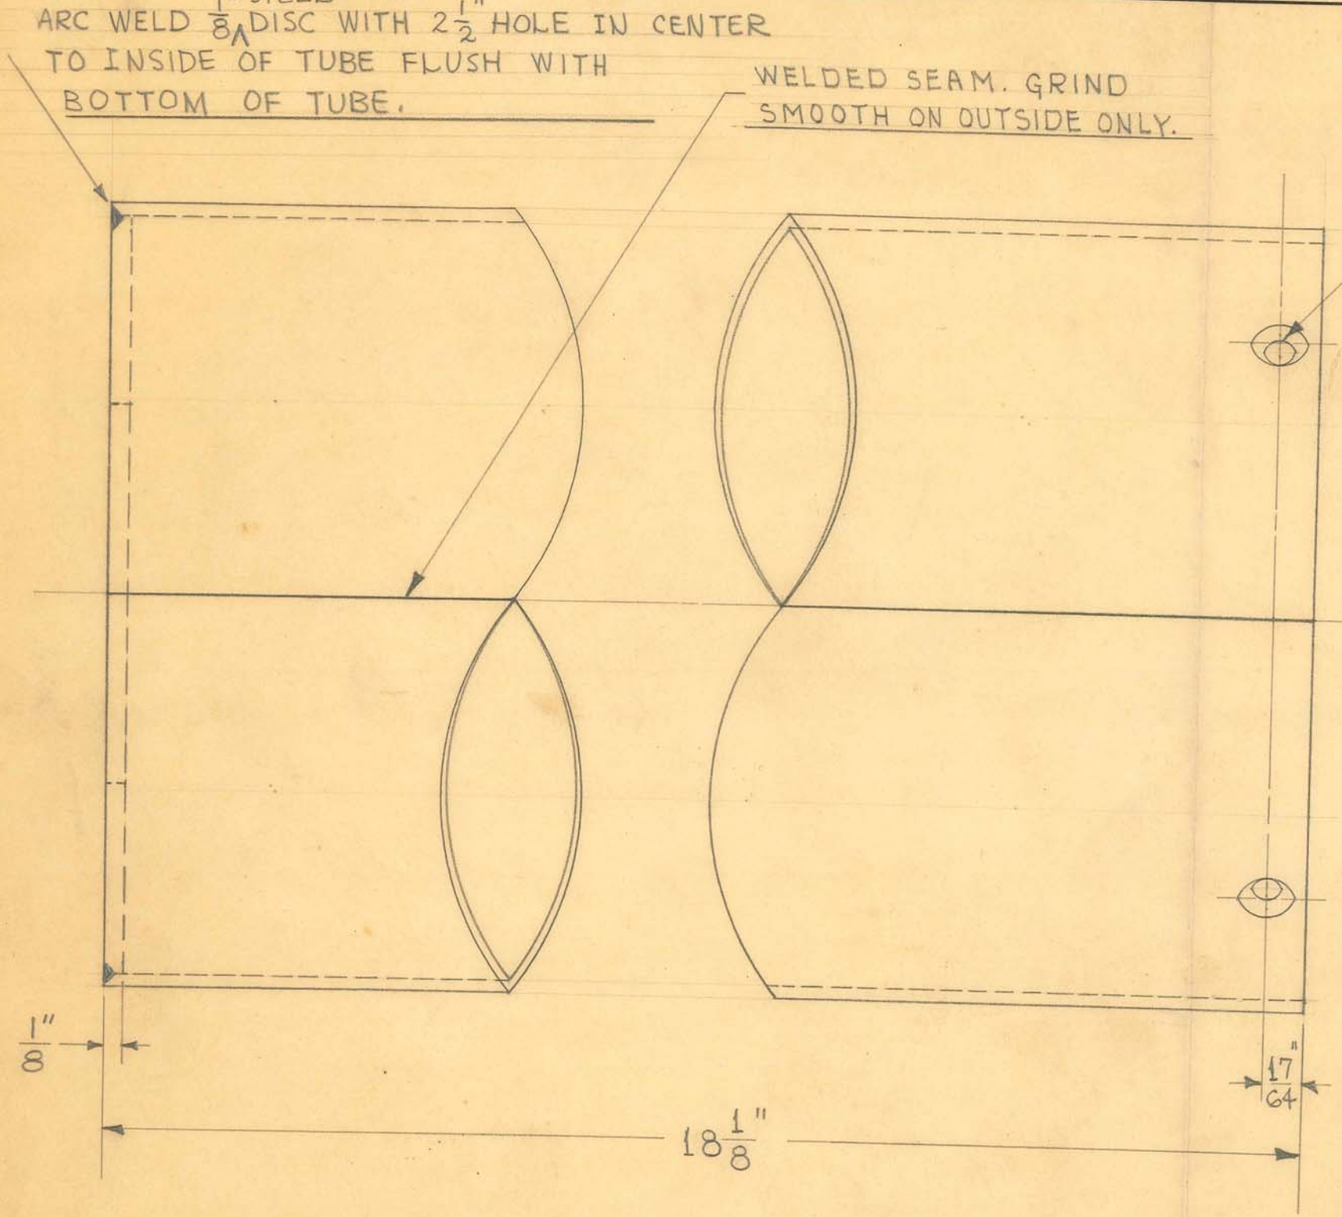

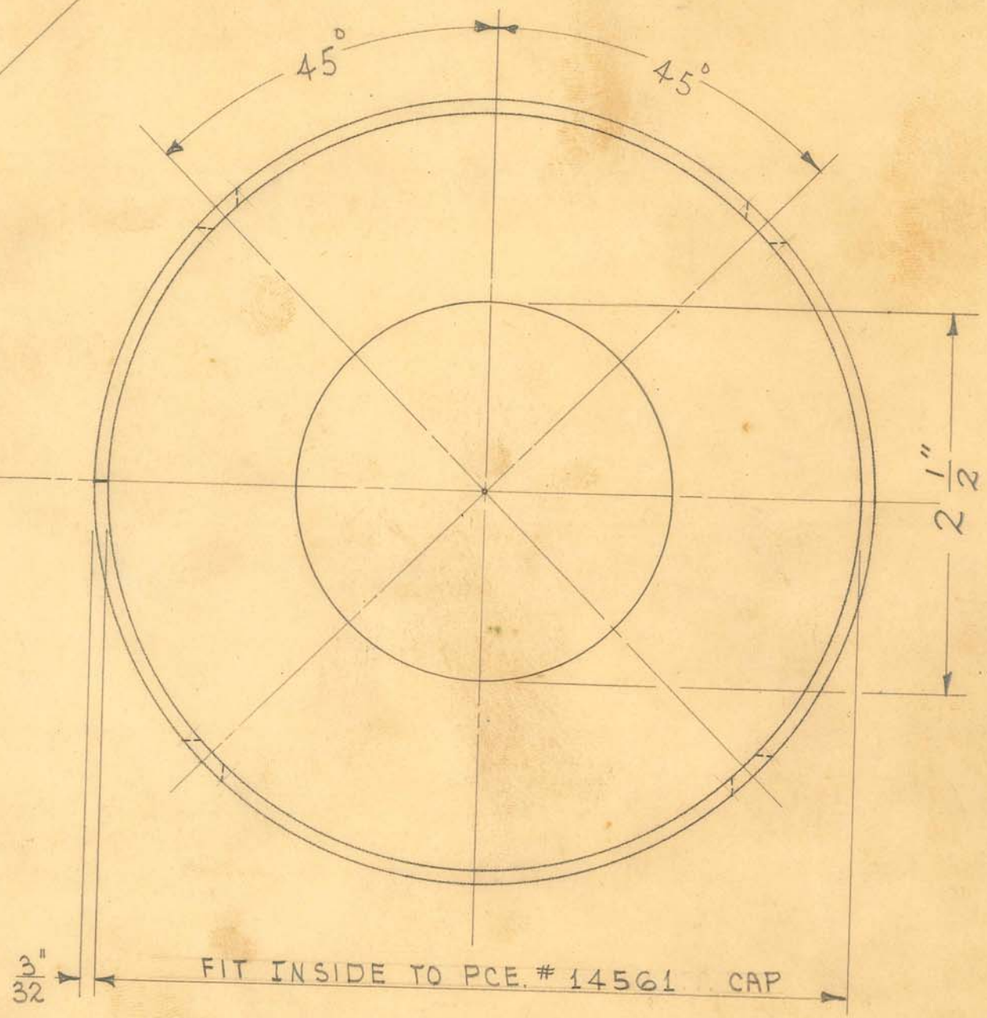

3/32" SHEET BLUE ANNEALED STEEL

1 REQUIRED

OBSOLETE

SIZE		ISSUE 12-2-43	HE.
KIND		CHANGED	
SHAPE		"6-19-46	J.V.W.
FINISH		"	
TEMP.		"	
PATT.		"	

TITLE: FISCHER MOD. "TV-30-96" RAD & FLUOR. UNIT ~ COUNTERWEIGHT TUBE

H. G. FISCHER & CO.
2335 WABANSIA AVE.
CHICAGO

CAT. NO.

PART NO. 14487F

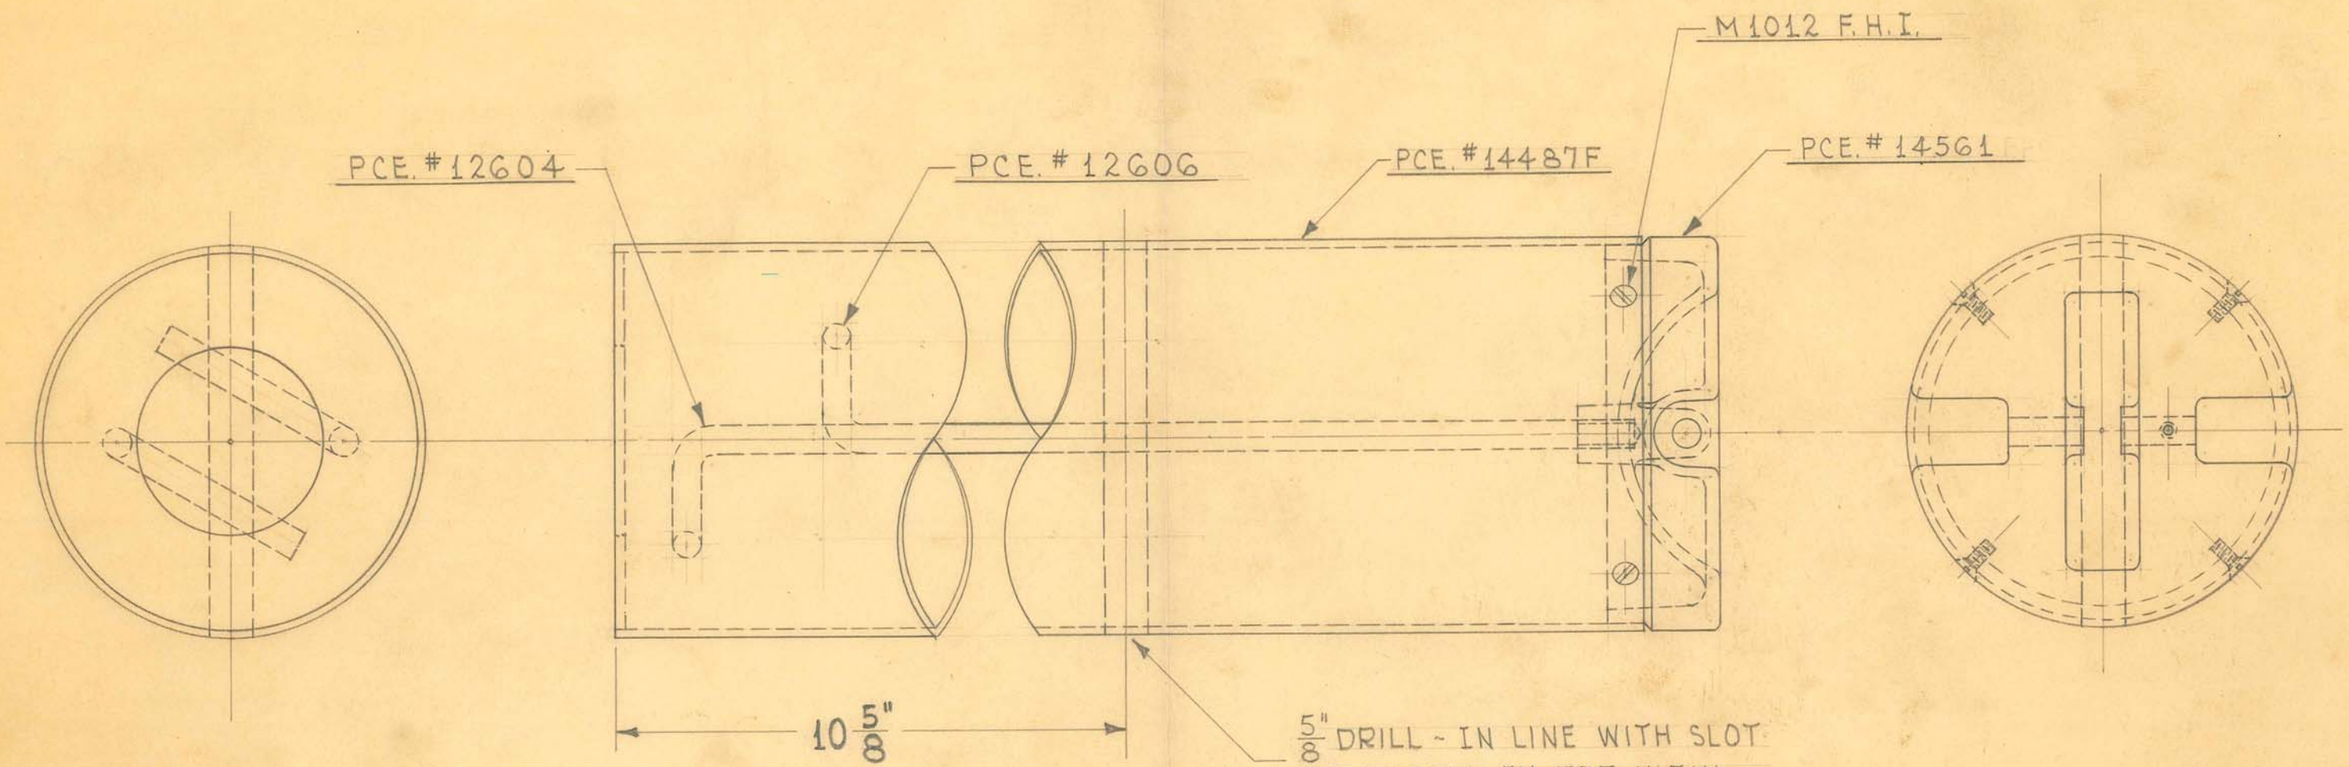

SCREW RODS INTO TOP CAP AS SHOWN.
FASTEN TUBE TO TOP CAP WITH #10 X 32 SCREWS
FILL WITH LEAD SO THAT TOTAL WEIGHT
AFTER DRILLING 5/8" HOLE IS 150 LBS.

1 REQUIRED

OBSOLETE

IRON CASTINGS ON VERTICAL CARRIAGE

SIZE		ISSUE 12-7-43	HE.
KIND		CHANGED 6-19-46	J.V.W.
SHAPE		"	
FINISH		"	
TEMP.		"	
PATT.		"	

TITLE: FISCHER MOD. "TV-30-96" RAD. & FLUOR. UNIT - COUNTERWEIGHT ASSEM.

H. G. FISCHER & CO.
2335 WABANSIA AVE.
CHICAGO, ILL.

CAT. NO.

PART NO. 14488G

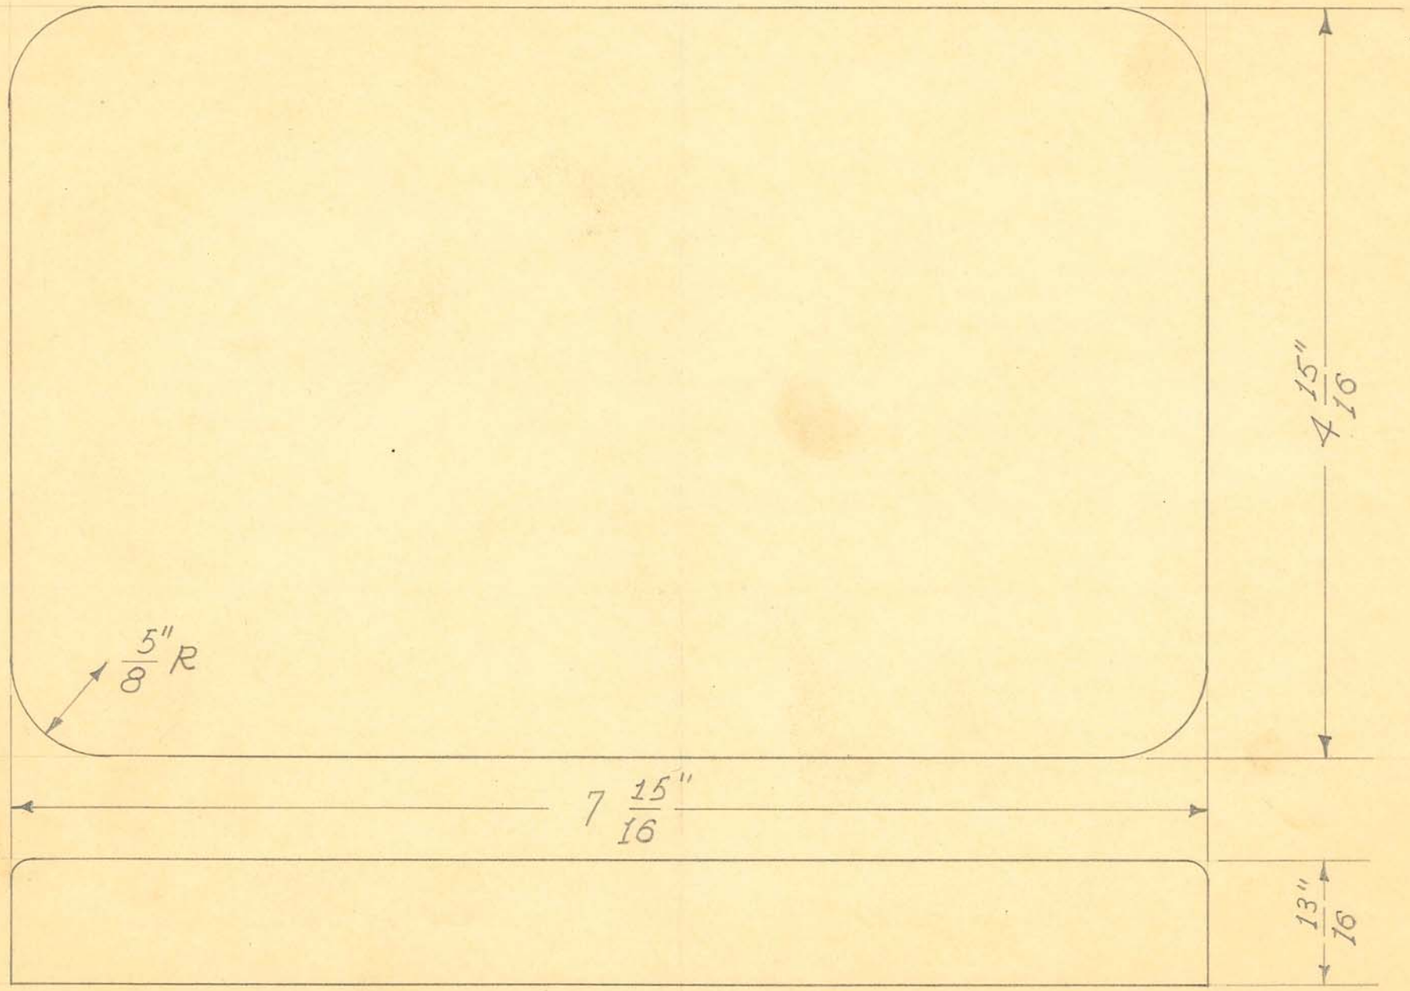

OBSOLETE

SIZE	OAK	ISSUE 3-5-37	J.W.	
KIND		CHANGED		
SHAPE		"		
FINISH	VARNISH	"		
TEMP.		"		
PATT.		"		

TITLE: EFFICIENCY TEST DEVICE FOR SHORT WAVE - BASE - BLANK

H. G. FISCHER & CO.
2335 WABANSIA AVE.
CHICAGO, ILL.

CAT. NO.

PART NO. 9946

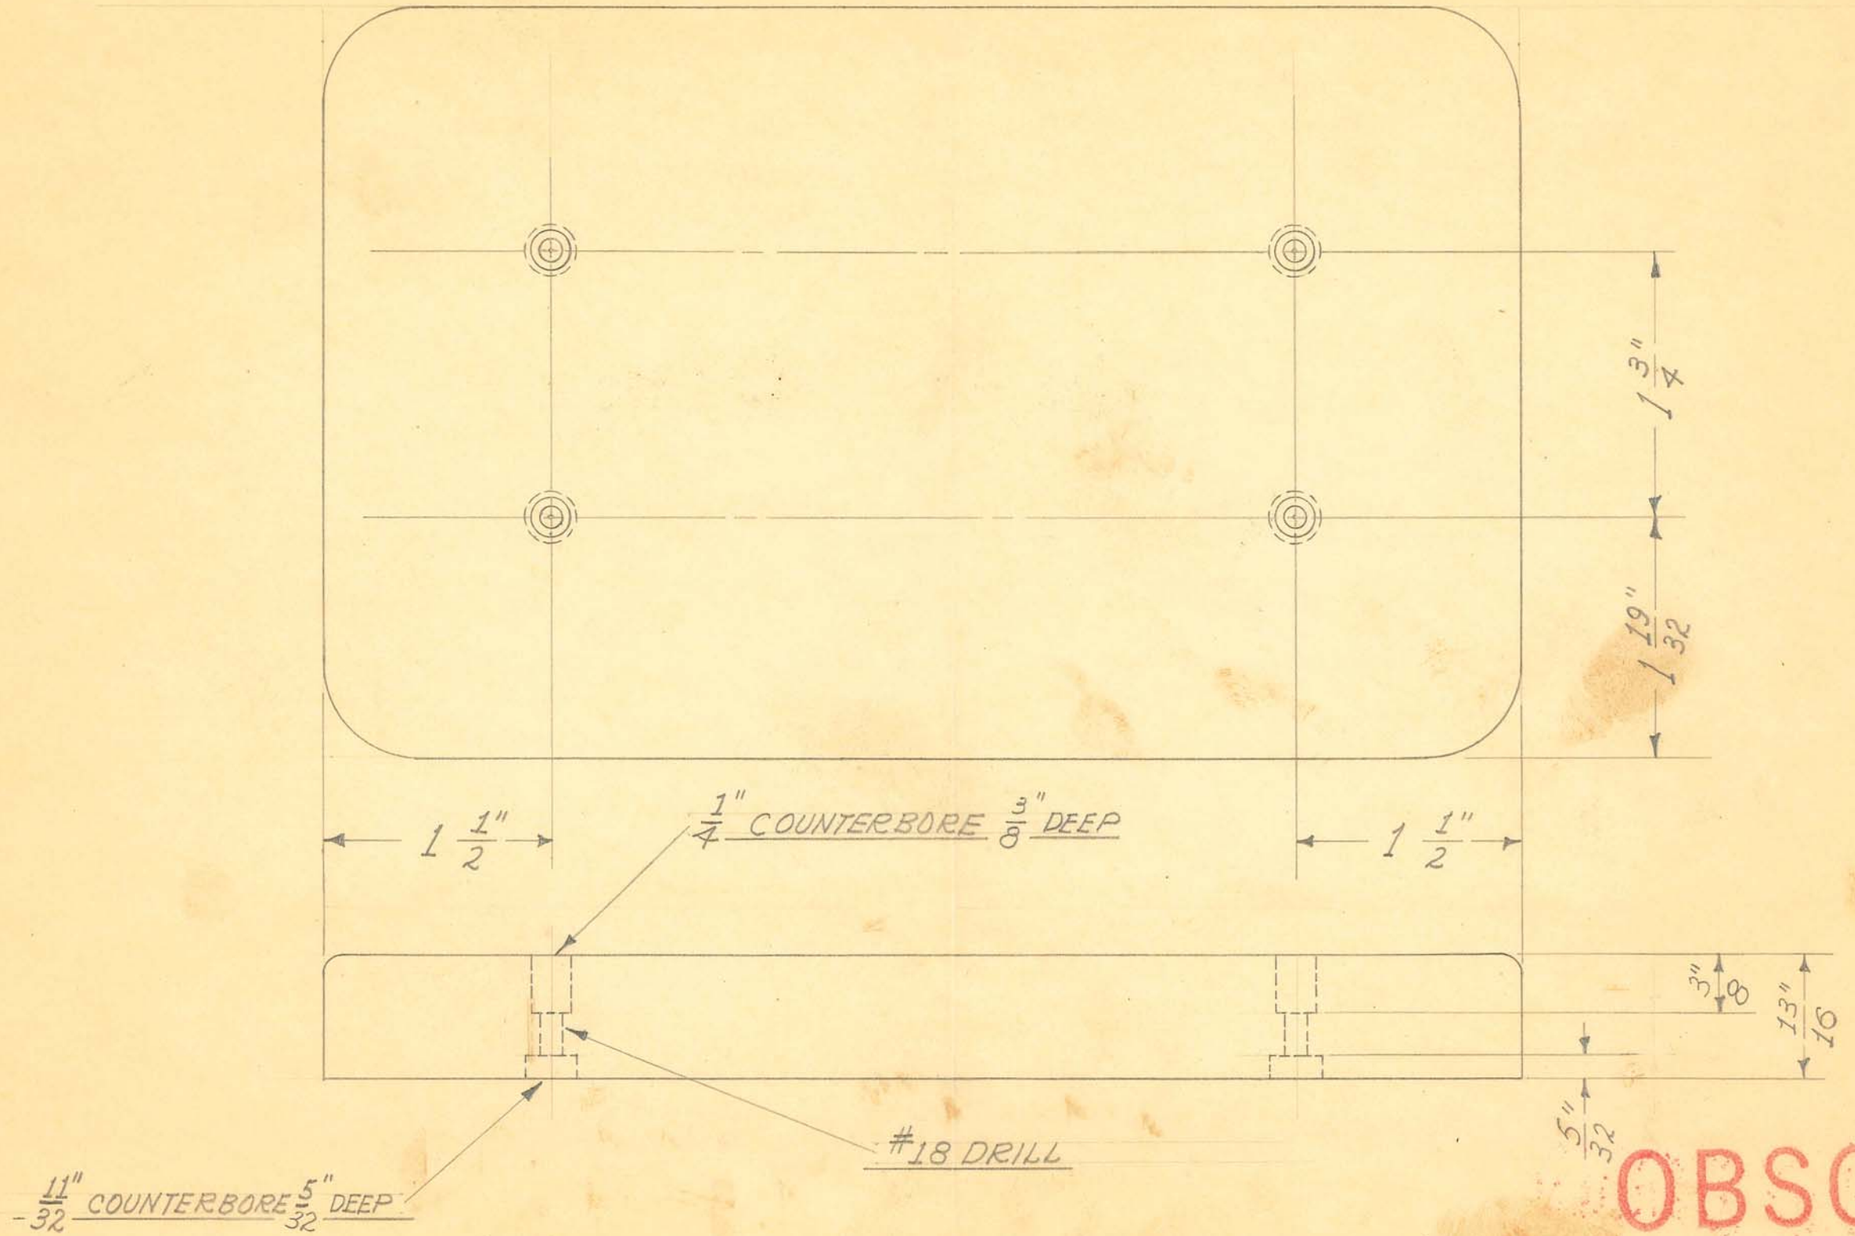

OBSOLETE

SIZE		ISSUE 3-5-37	J.W.	
KIND		CHANGED		
SHAPE		"		
FINISH		"		
TEMP.		"		
PATT.		"		

TITLE: EFFICIENCY TEST DEVICE FOR SHORT WAVE - BASE

H. G. FISCHER & CO.
2335 WABANSIA AVE.
CHICAGO, ILL.

CAT. NO.

PART NO. 9946F

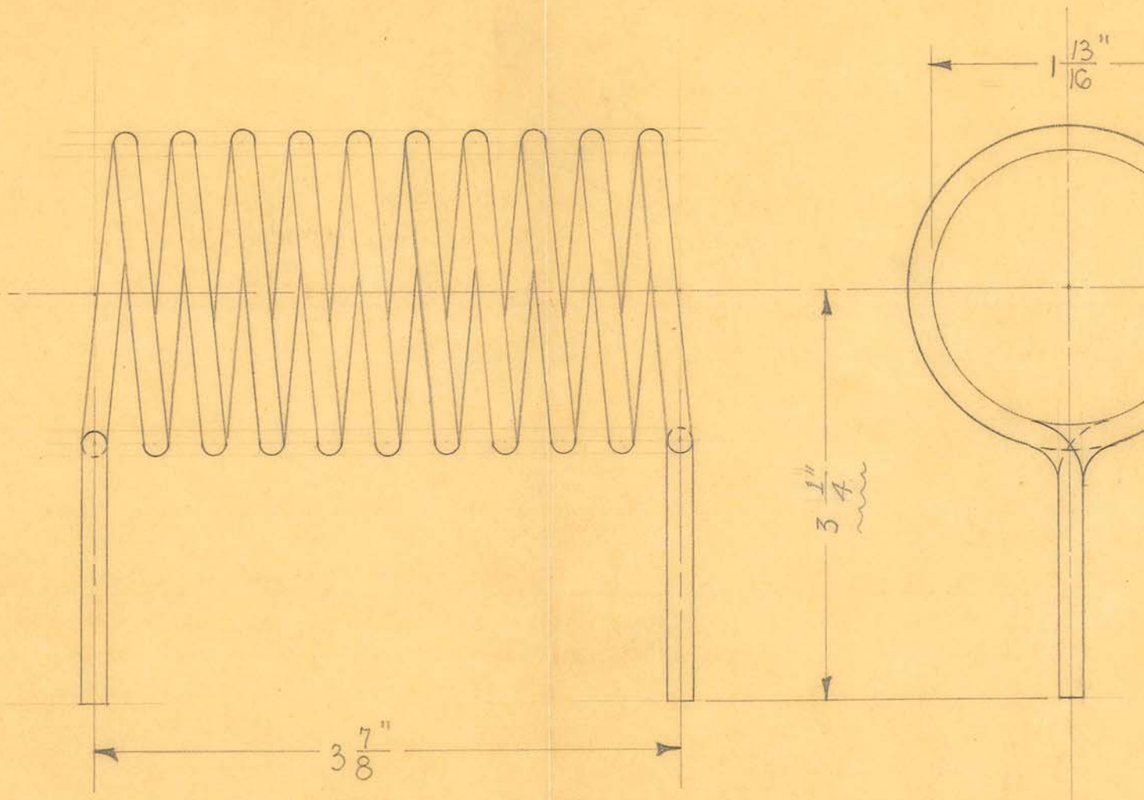

1 REQUIRED
10 TURNS

OBSOLETE

SIZE	#6 BARE	ISSUE 2-15-36	A.E.
KIND	COPPER WIRE	CHANGED 6-5-40	J.W.
SHAPE		" "	
FINISH		" "	
TEMP.		" "	
PATT.		" "	

TITLE:
FISCHER "SWDI-12" SHORT WAVE OSCIL. UNIT
OSCILLATING COIL

H. G. FISCHER & CO.
2335 WABANSIA AVE.
CHICAGO, ILL.

CAT. NO.

PART NO. 9869A

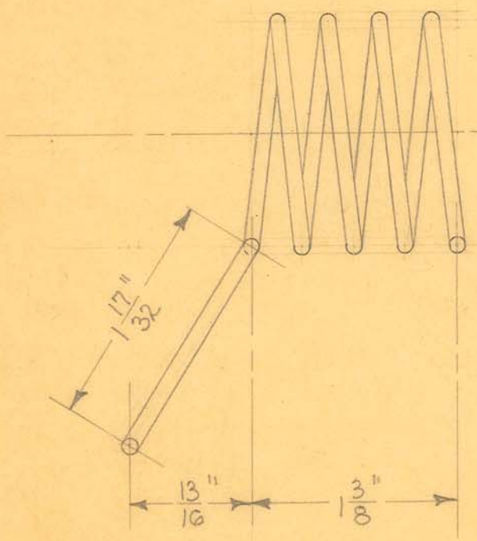

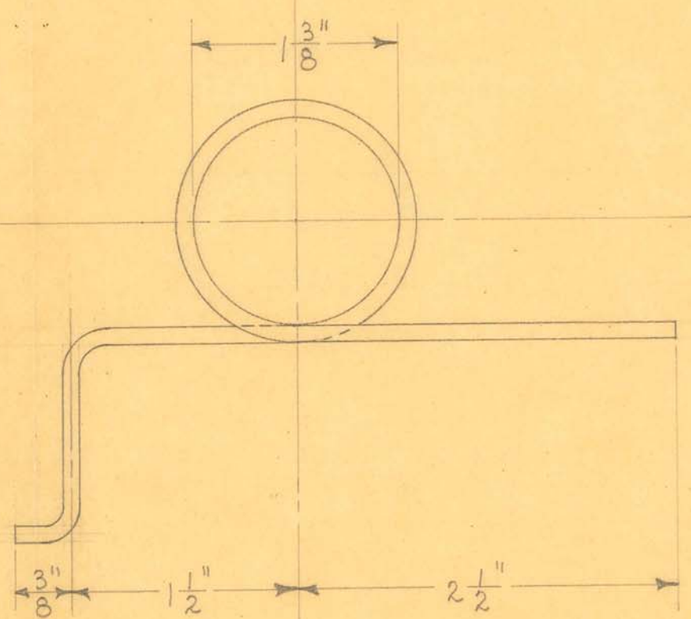

1 REQUIRED
4 TURNS

OBSOLETE
Obsolete

SIZE	#10 TINNED	ISSUE 2-14-36	A.E.
KIND	COPPER WIRE	CHANGED	
SHAPE		" "	
FINISH		" "	
TEMP.		" "	

TITLE:
FISCHER "SWDI-12" SHORT WAVE OSCIL. UNIT
PATIENT'S TUNING COIL-LEFT

H. G. FISCHER & CO.
2335 WABANSIA AVE.

CAT. NO.

PART NO. 9872

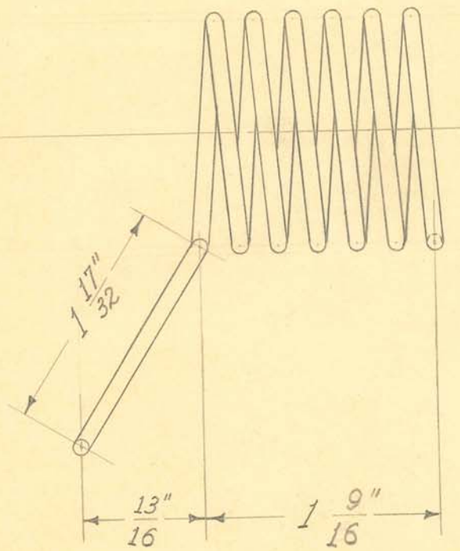

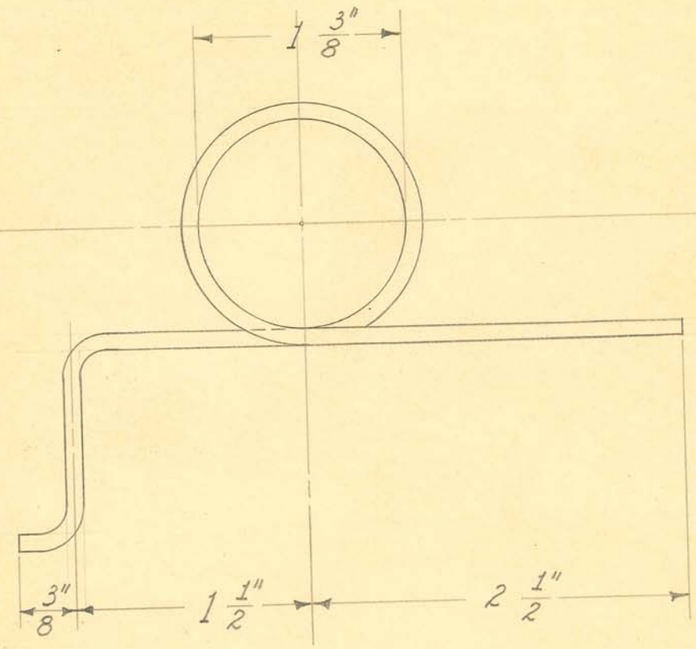

1 REQUIRED
6 TURNS

OBSOLETE

SIZE	#10 TINNED	ISSUE 6-21-37	J.W.	TITLE: FISCHER "SWDI-12" SHORT WAVE OSCIL. UNIT PATIENT'S TUNING COIL - LEFT
KIND	COPPER WIRE	CHANGED		
SHAPE		"		
FINISH		"		
TEMP.		"		
PATT.		"		

H. G. FISCHER & CO.
2335 WABANSIA AVE.
CHICAGO, ILL.

CAT. NO.

PART NO. 9872A

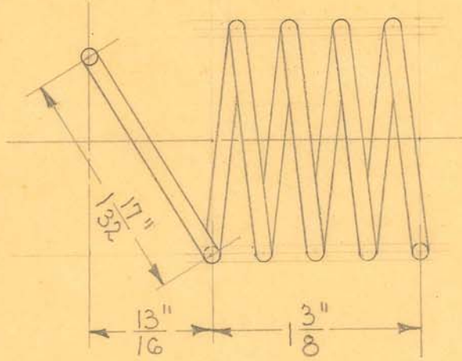

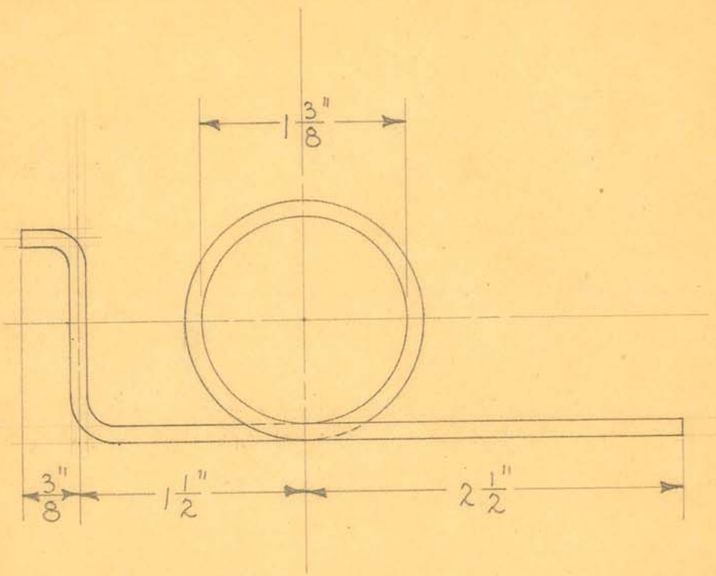

1 REQUIRED
4 TURNS

OBSOLETE

SIZE	#10 TINNED	ISSUE 2-14-36	J.F.E.
KIND	COPPER WIRE	CHANGED	
SHAPE		" "	
FINISH		" "	
TEMP.		" "	
PATT.		" "	

TITLE: FISCHER "SWDI-12" SHORT WAVE OSCIL. UNIT
PATIENT'S TUNING COIL - RIGHT

H. G. FISCHER & CO.
2335 WABANSIA AVE.
CHICAGO, ILL.

CAT. NO.

PART NO. 9872 1/2

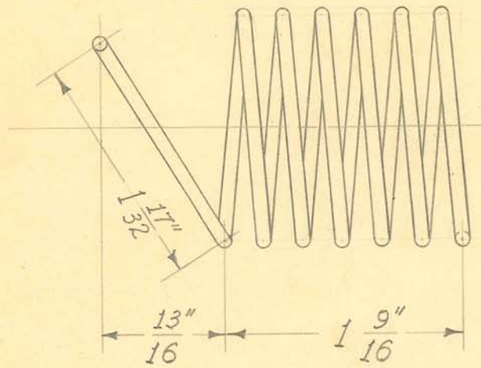

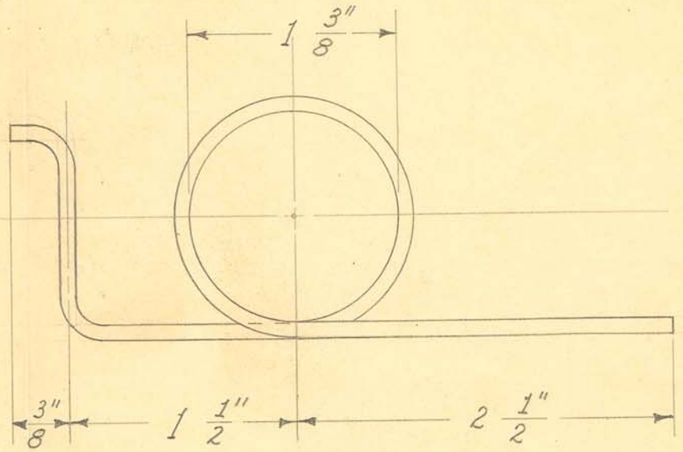

1 REQUIRED
6 TURNS

OBSOLETE

SIZE	#10 TINNED	ISSUE 6-21-37	J.W.	
KIND	COPPER WIRE	CHANGED		
SHAPE		"		
FINISH		"		
TEMP.		"		
PATT.		"		

TITLE:
FISCHER "SWDT-12" SHORT WAVE OSCIL. UNIT
PATIENT'S TUNING COIL - RIGHT

H. G. FISCHER & CO.
2335 WABANSIA AVE.
CHICAGO, ILL.

CAT. NO.

PART NO. 9872 1/2 A

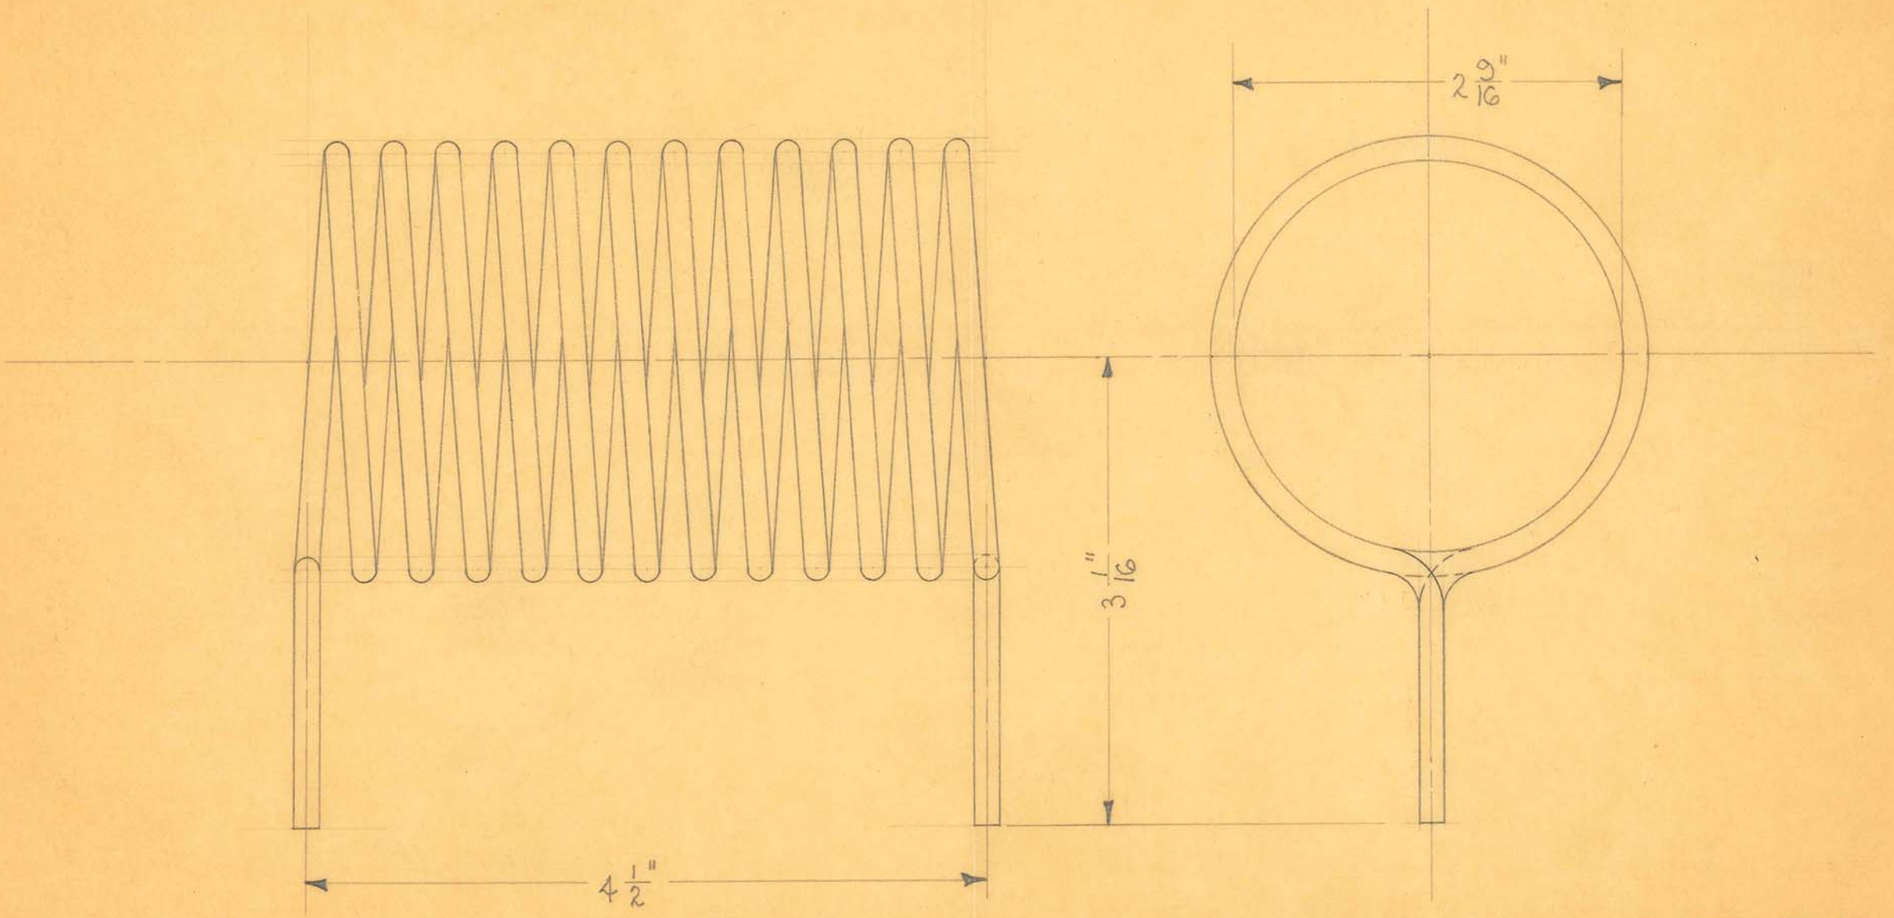

1 REQUIRED
12 TURNS

OBSOLETE

SIZE	#6 BARE	ISSUE 2-20-36	A.E.
KIND	COPPER WIRE	CHANGED	
SHAPE		" "	
FINISH		" "	
TEMP.		" "	
PATT.		" "	

TITLE: FISCHER "SWDI-18" SHORT WAVE OSCIL. UNIT OSCILLATING COIL

H. G. FISCHER & CO.
2335 WABANSIA AVE.
CHICAGO, ILL.

CAT. NO.

PART NO. 9879

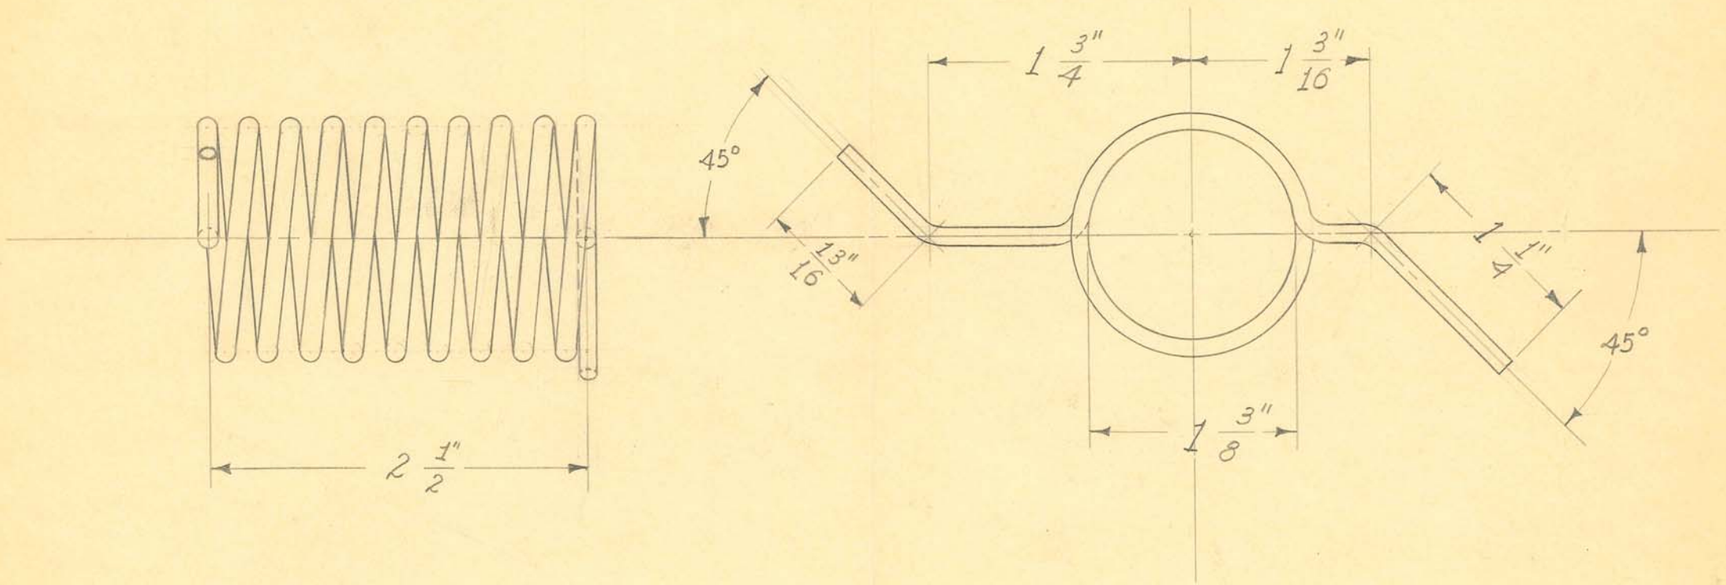

1 REQUIRED
9 1/2 TURNS

OBSOLETE

SIZE	#10 TINNED	ISSUE 6-22-37	J.W.
KIND	COPPER WIRE	CHANGED	
SHAPE		"	
FINISH		"	
TEMP.		"	
PATT.		"	

TITLE:
FISCHER "SWDI-24" SHORT WAVE OSCIL. UNIT
PATIENT'S TUNING COIL - LEFT

H. G. FISCHER & CO.
2335 WABANSIA AVE.
CHICAGO. ILL.

CAT. NO.

PART NO. 9892A

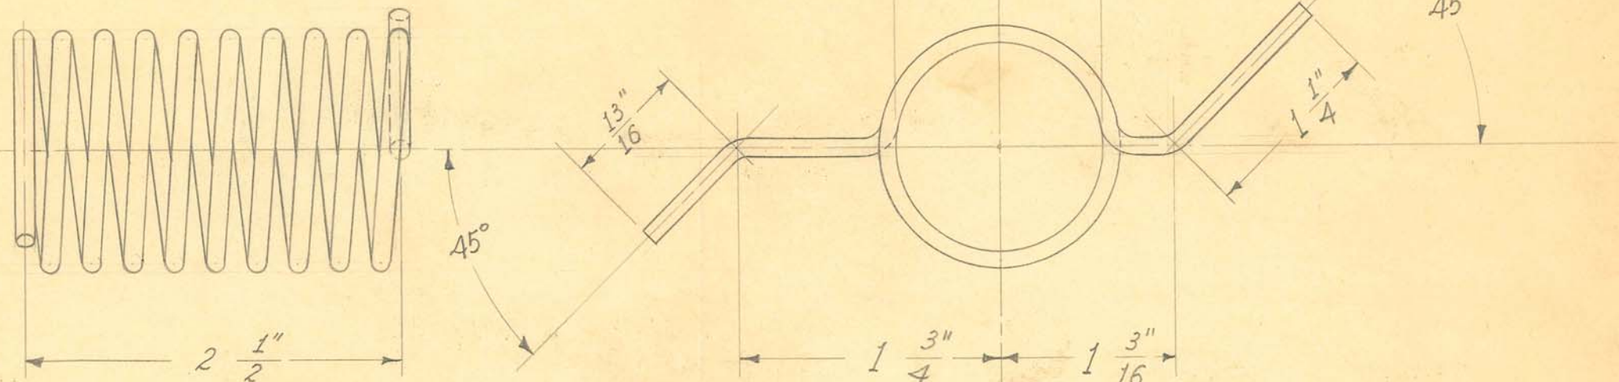

1 REQUIRED
9½ TURNS

OBSOLETE

SIZE	#10 TINNED	ISSUE 6-21-37	J.W.	TITLE: FISCHER "SWDI-24" SHORT WAVE OSCIL. UNIT PATIENT'S TUNING COIL – RIGHT
KIND	COPPER WIRE	CHANGED		
SHAPE		"		
FINISH		"		
TEMP.		"		
PATT.		"		

H. G. FISCHER & CO.
2335 WABANSIA AVE.
CHICAGO, ILL.

CAT. NO.

PART NO. 9892½A

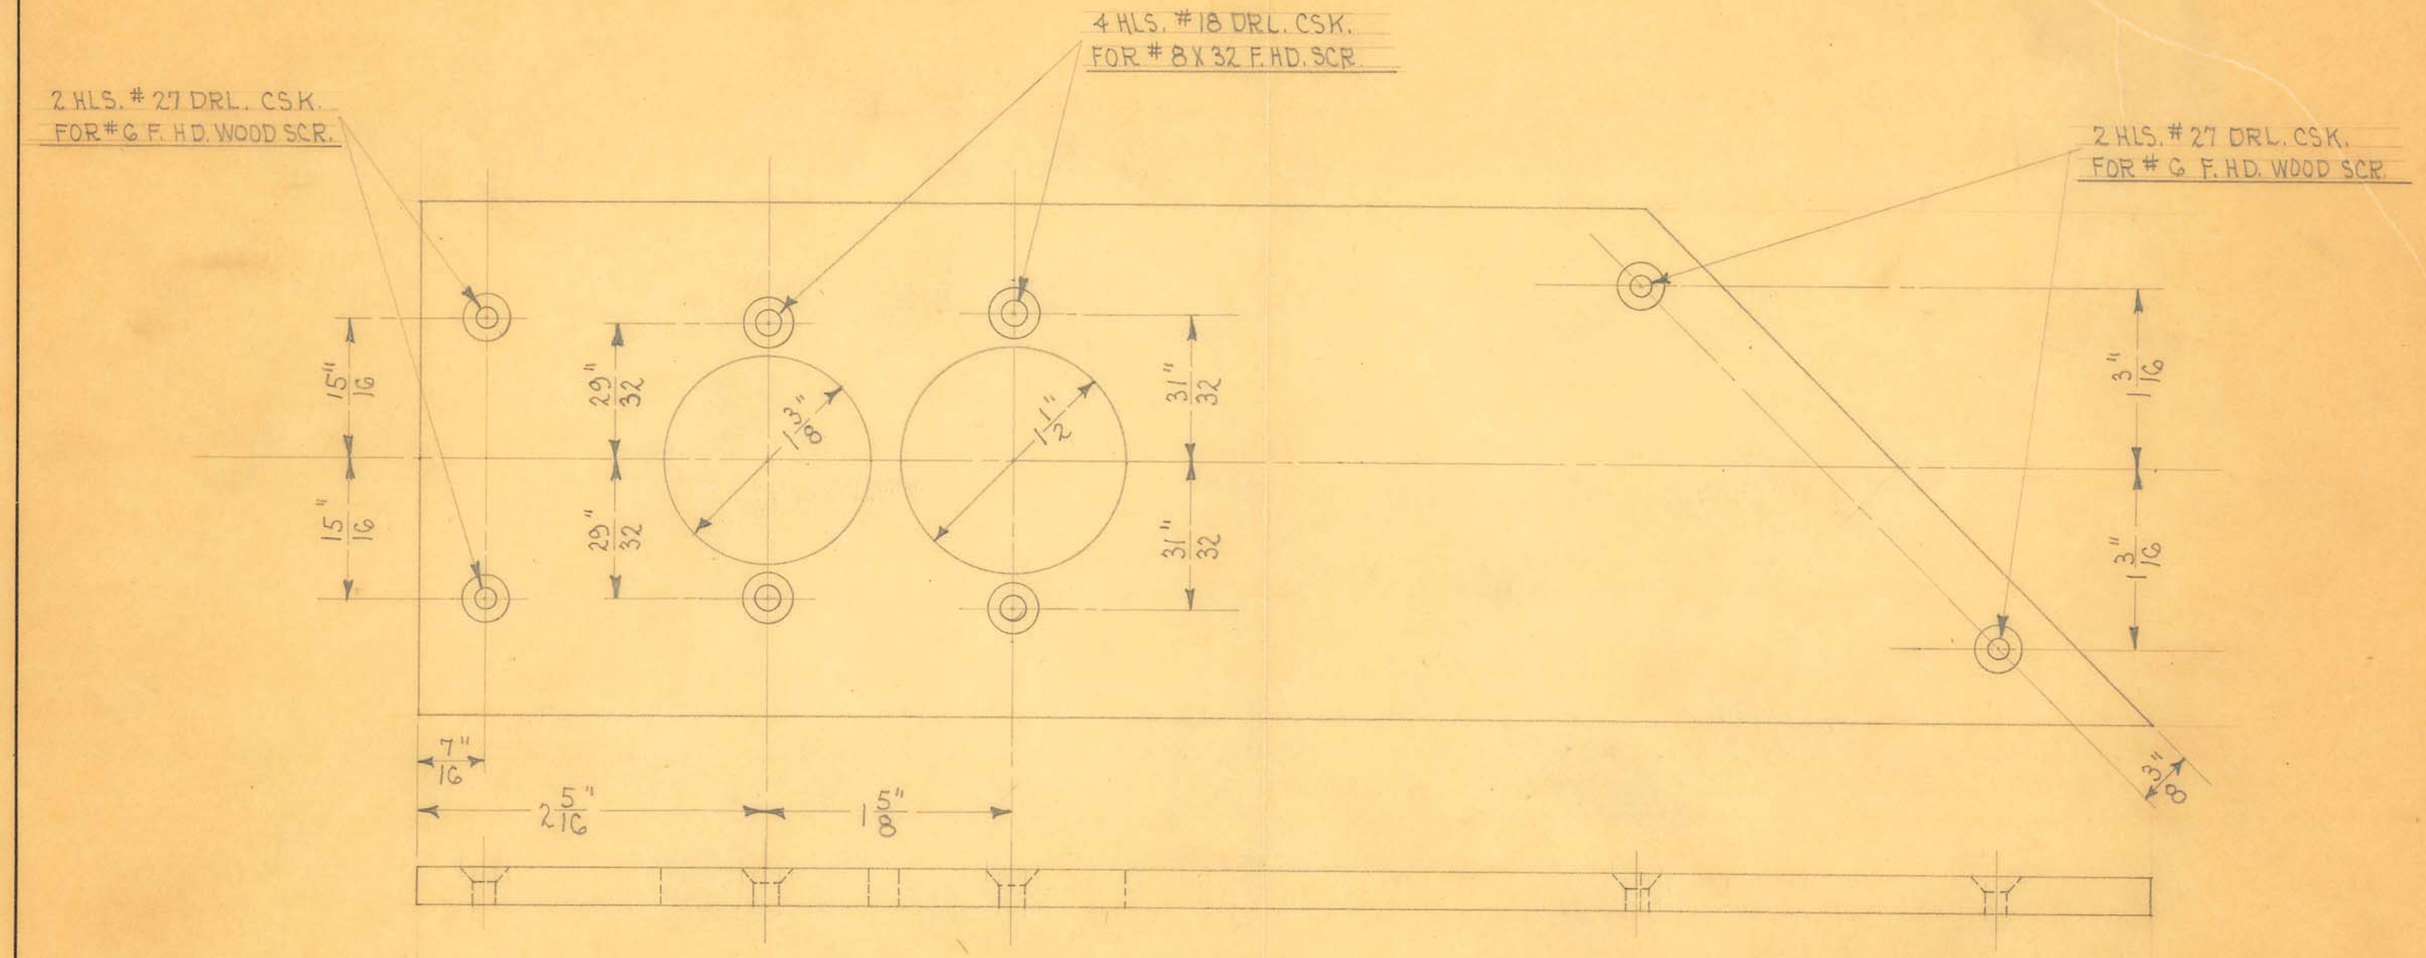

1 REQUIRED

OBSOLETE

SIZE		ISSUE 12-14-35	JE
KIND		CHANGED	
SHAPE		" "	
FINISH		" "	
TEMP.		" "	
PATT.		" "	

TITLE: INTERMEDIATE MOD. "SW-12" SHORT WAVE H.F. OUTFIT LINE & FOOT SW. MTG. BOARD

H. G. FISCHER & CO.
2335 WABANSIA AVE.

CAT. NO.

PART NO. 2205F

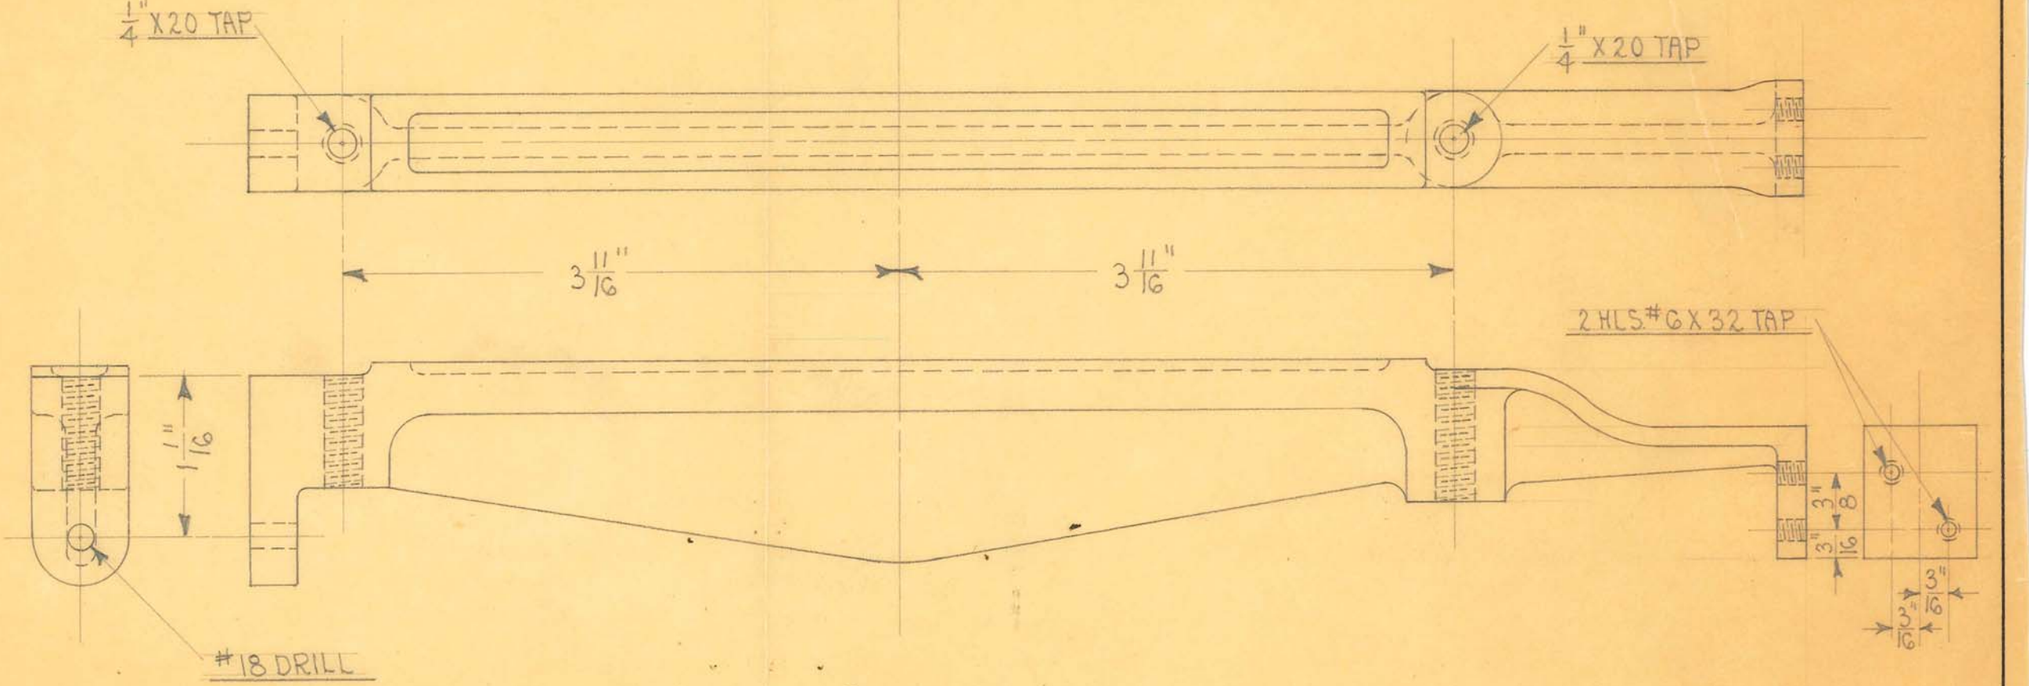

1 REQUIRED

OBSOLETE

SIZE		ISSUE 12-5-35	A.E.	TITLE: INTERMEDIATE MOD. "SW-12" SHORT WAVE H.F. OUTFIT TRANSF. SUPP.-REAR-LEFT
KIND	IRON CASTING	CHANGED		
SHAPE		" "		
FINISH	BLACK #80	" "		
TEMP.		" "		H. G. FISCHER & CO. 2335 WABANSIA AVE. CHICAGO, ILL. — CAT. NO. — PART NO. 9907F
PATT.	4301-918	" "		

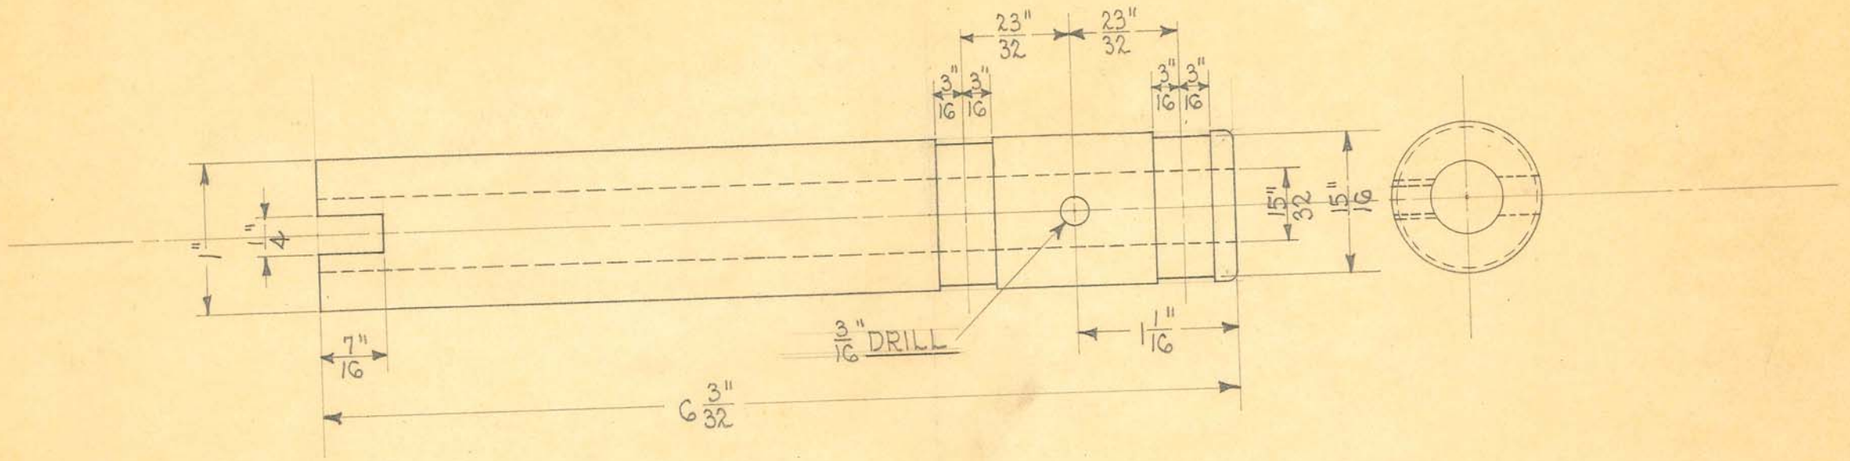

1 REQUIRED

OBSOLETE

SIZE	1" O.D. x 1/4" WALL	ISSUE 3-27-34	A.E.	TITLE: FISCHER "D-S-GO" UNIT TUBE HEAD SWIVEL BEARING
KIND	HYDRAULIC STEEL	CHANGED		
SHAPE	TUBING	" "		
FINISH	CAD. PLATE	" "		
TEMP.		" "		
PATT.		" "		

H. G. FISCHER & CO.
2335 WABANSIA AVE.
CHICAGO, ILL.

CAT. NO.

PART NO. 8864

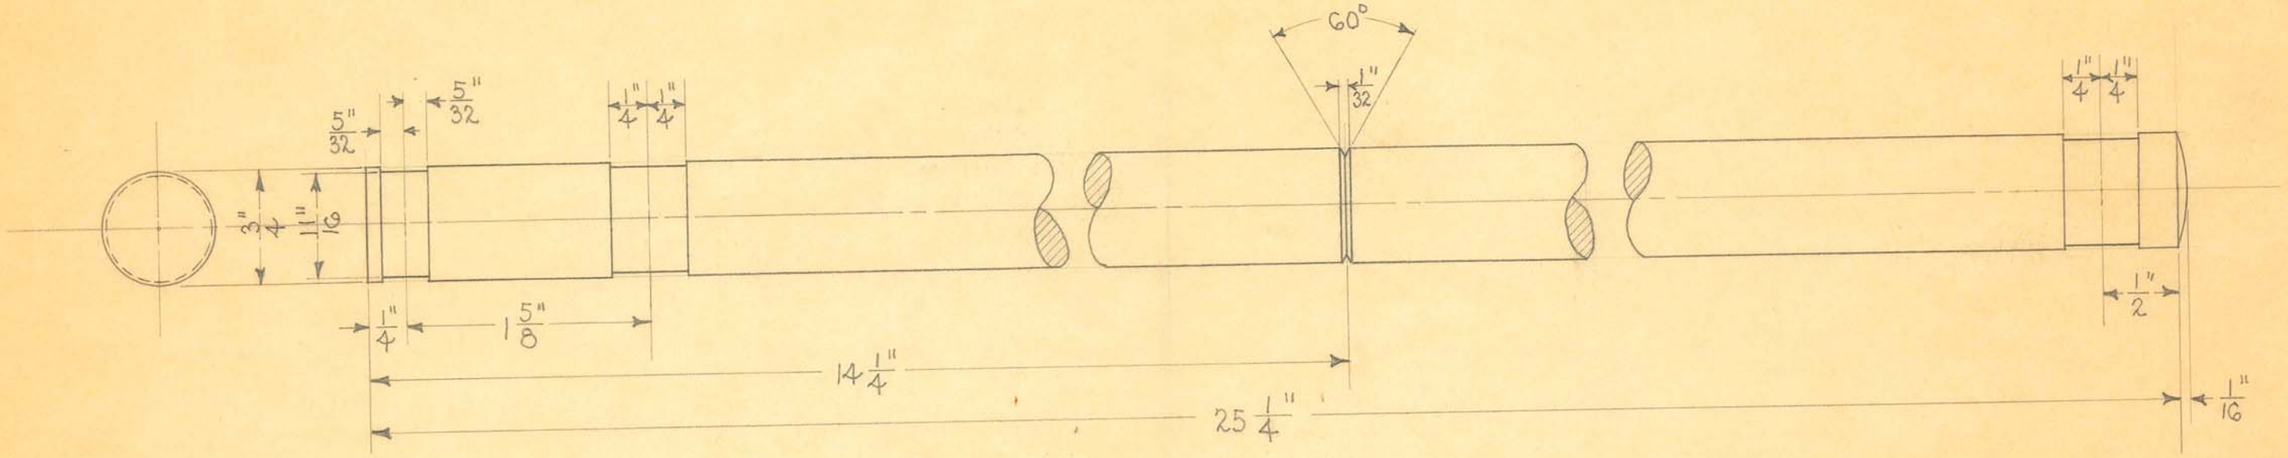

1 REQUIRED

OBSOLETE

SIZE	3/4" GROUND	ISSUE 3-21-34	A.E.	TITLE: FISCHER "D-S-CO" UNIT TUBE HEAD SLIDE ROD-RIGHT
KIND	C.R. STEEL	CHANGED		
SHAPE		" "		
FINISH	CHROME POL.	" "		
TEMP.		" "		H. G. FISCHER & CO. 2335 WABANSIA AVE. CHICAGO, ILL. — CAT. NO. — PART NO. 8869
PATT.		" "		

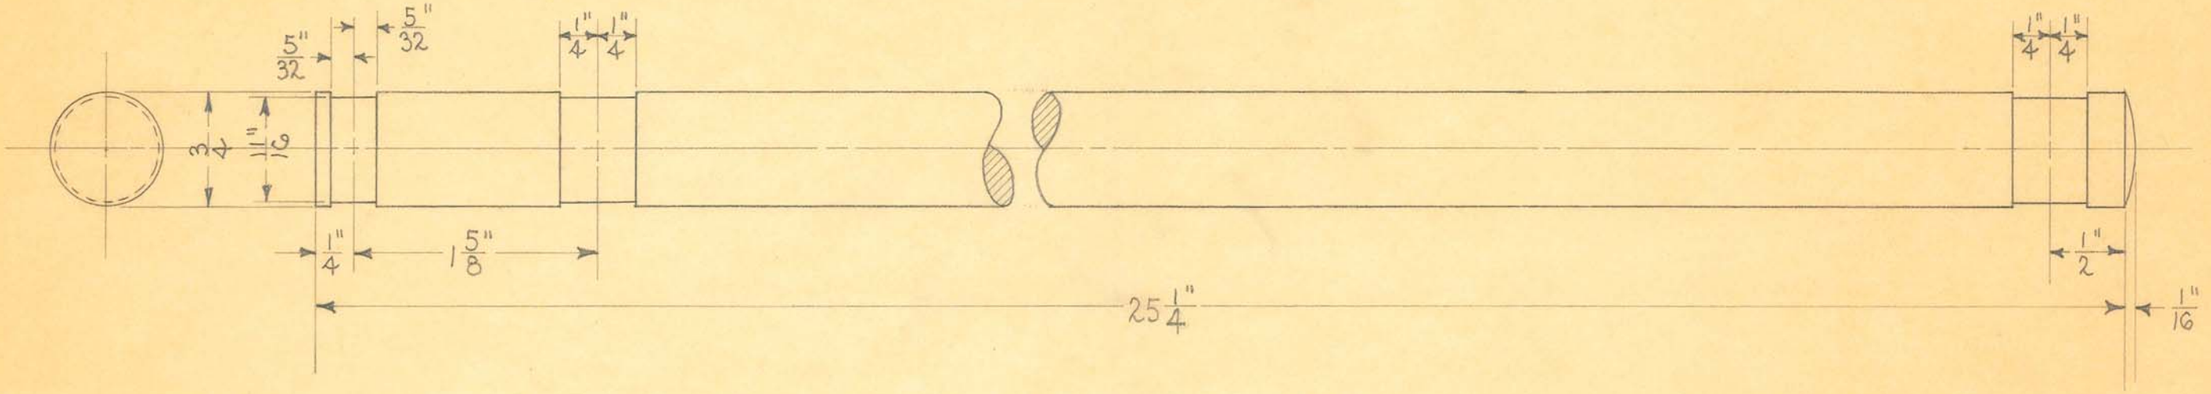

1 REQUIRED

OBSOLETE

SIZE	3/4" GROUND	ISSUE 3-21-34	A.E.
KIND	C.R. STEEL	CHANGED	
SHAPE		" "	
FINISH	CHROME POL.	" "	
TEMP.		" "	
PATT.		" "	

TITLE: FISCHER "D-S-GO" UNIT TUBE HEAD SLIDE ROD-LEFT

H. G. FISCHER & CO.
2335 WABANSIA AVE.
CHICAGO, ILL.

CAT. NO.

PART NO. 8870

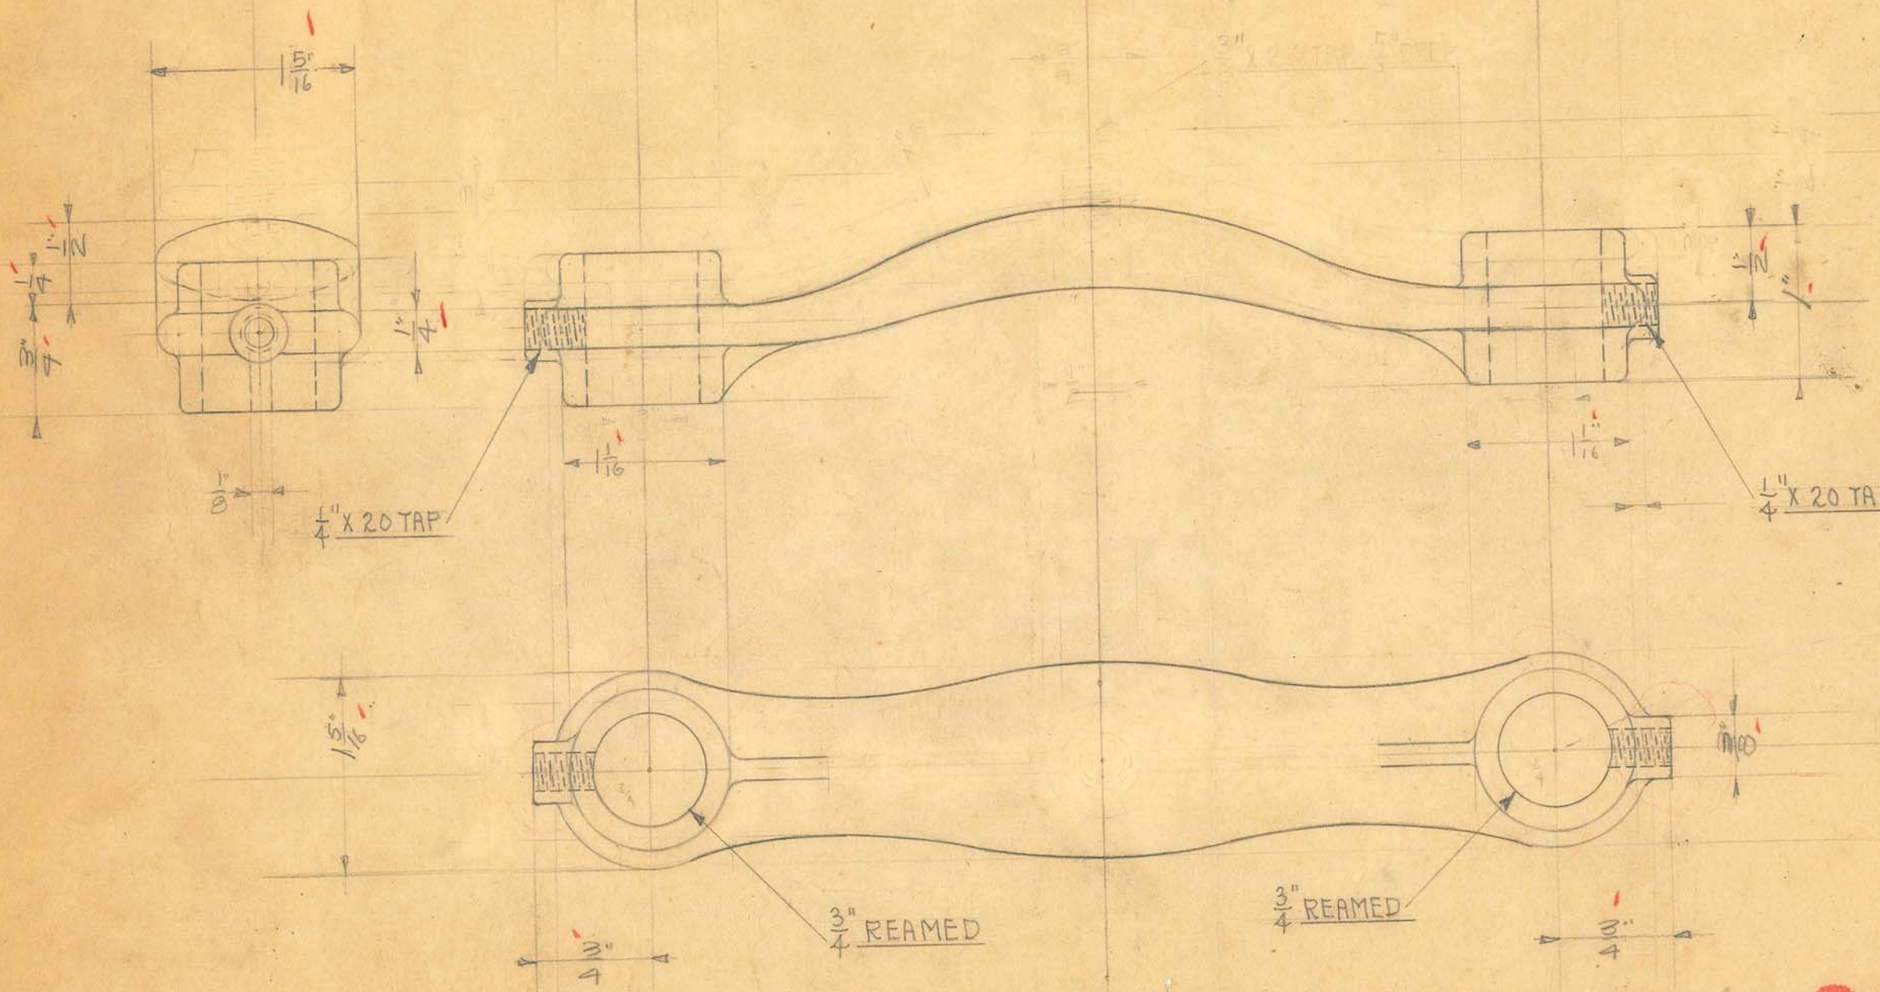

OBSOLETE

SIZE		ISSUE		TITLE: FISCHER "D-S-GO" UNIT TUBE HEAD SLIDLE ROD HANDLE
KIND	ALUM. CASTING	CHANGED		
SHAPE		" "		
FINISH	BLK. LACQUER	" "		H. G. FISCHER & CO. 2335 WABANSIA AVE. CHICAGO, ILL. — CAT. NO. — PART NO. 8871F
TEMP.		" "		
PATT.	7856-704	" "		

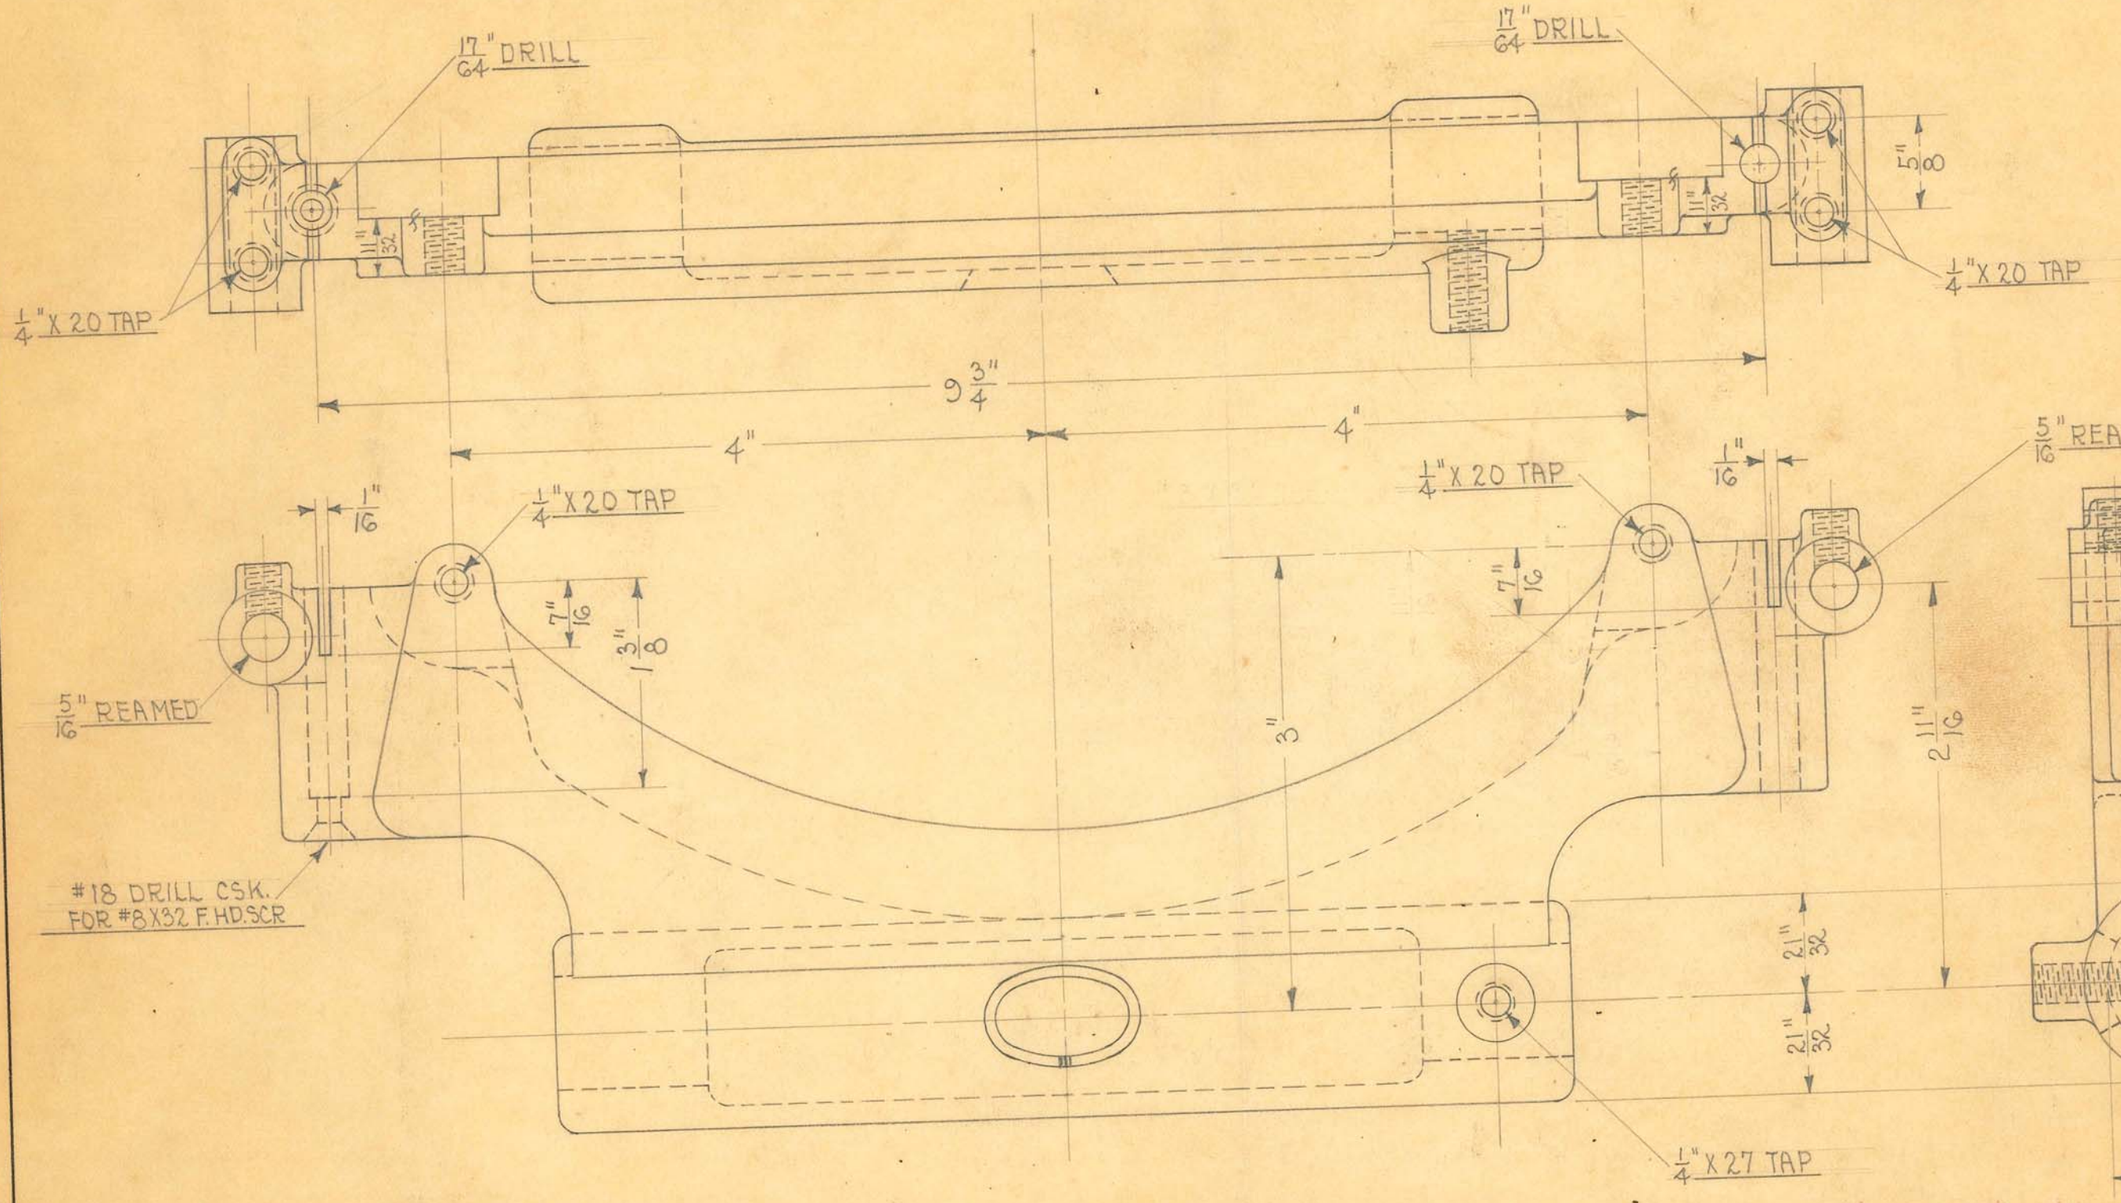

2 REQUIRED

OBSOLETE

SIZE		ISSUE 2-8-34	J.E.
KIND	ALUM. CASTING	CHANGED	
SHAPE		" "	
FINISH		" "	
TEMP.		" "	
PATT.	7570-680	" "	

TITLE: FISCHER "D-S-60" UNIT
TUBE HEAD SLIDE

H. G. FISCHER & CO.
2335 WABANSIA AVE.
CHICAGO, ILL.

CAT. NO.

PART NO. 8874F - RIGHT
8875F - LEFT

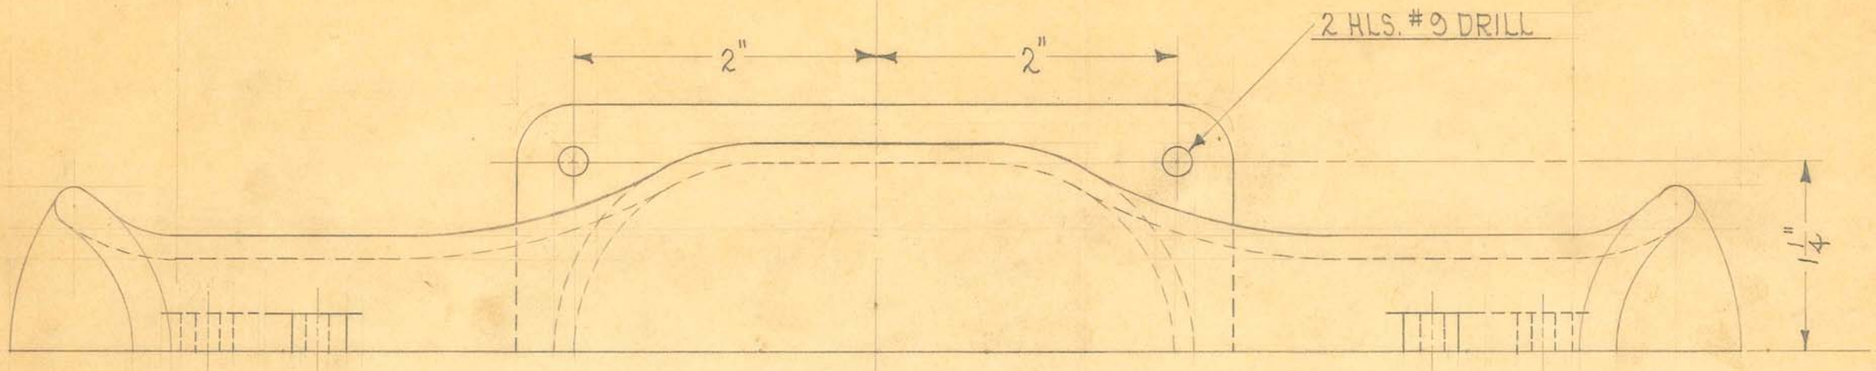

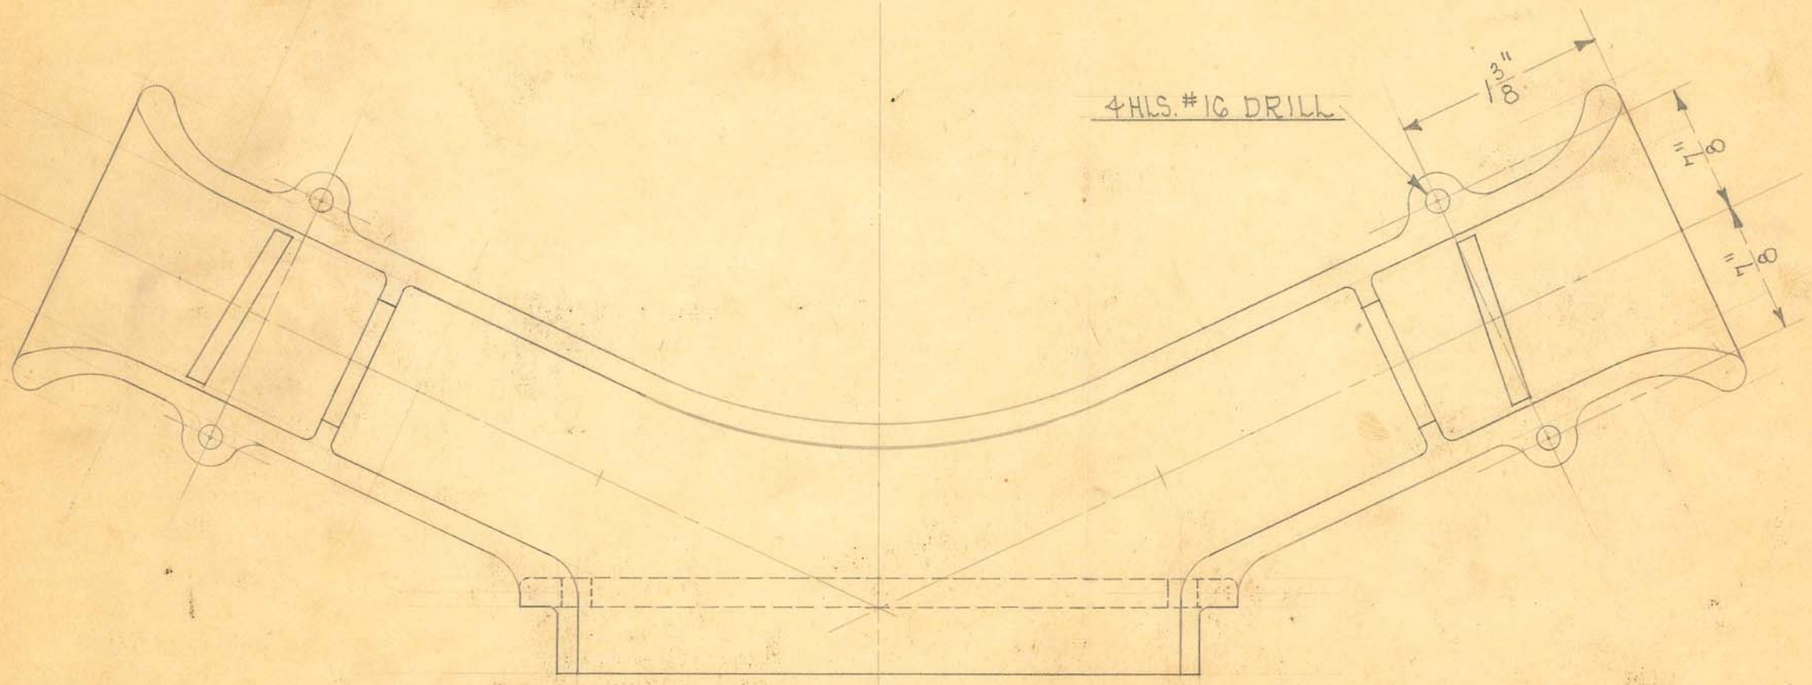

1 REQUIRED

OBSOLETE

SIZE		ISSUE 7-30-34	H.E.
KIND	ALUM. CASTING	CHANGED	
SHAPE		" "	
FINISH	BLACK #60	" "	
TEMP.		" "	
PATT.	8741-726	" "	

TITLE: FISCHER "D-S-GO" UNIT TUBE HEAD CABLE SUPPORT - UPPER

H. G. FISCHER & CO.
2335 WABANSIA AVE.
CHICAGO, ILL.

CAT. NO.

PART NO. 8882F

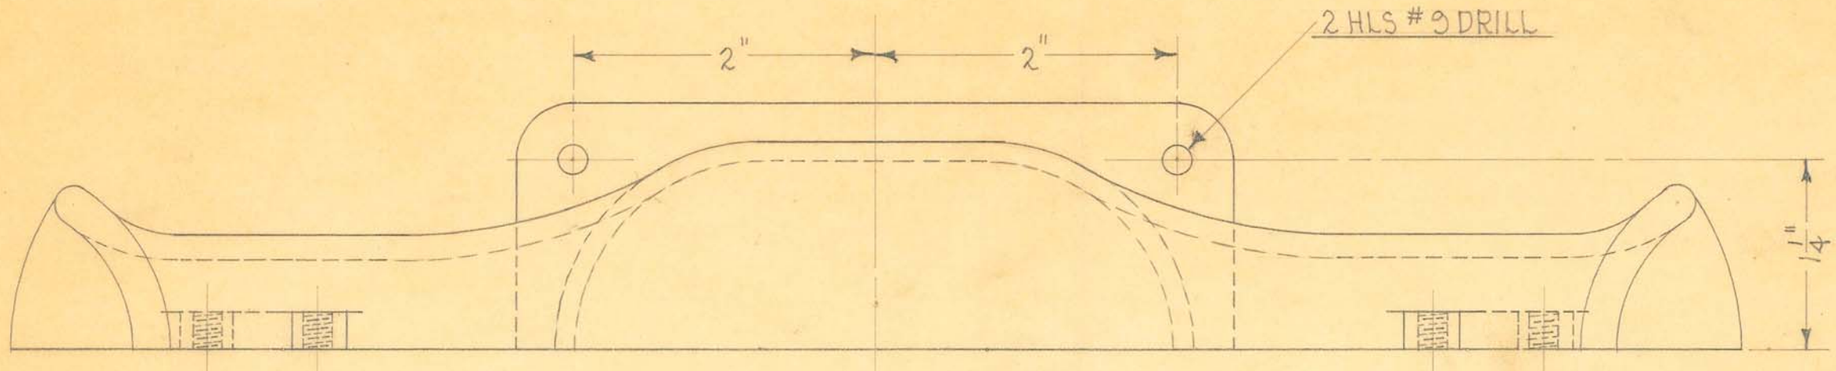

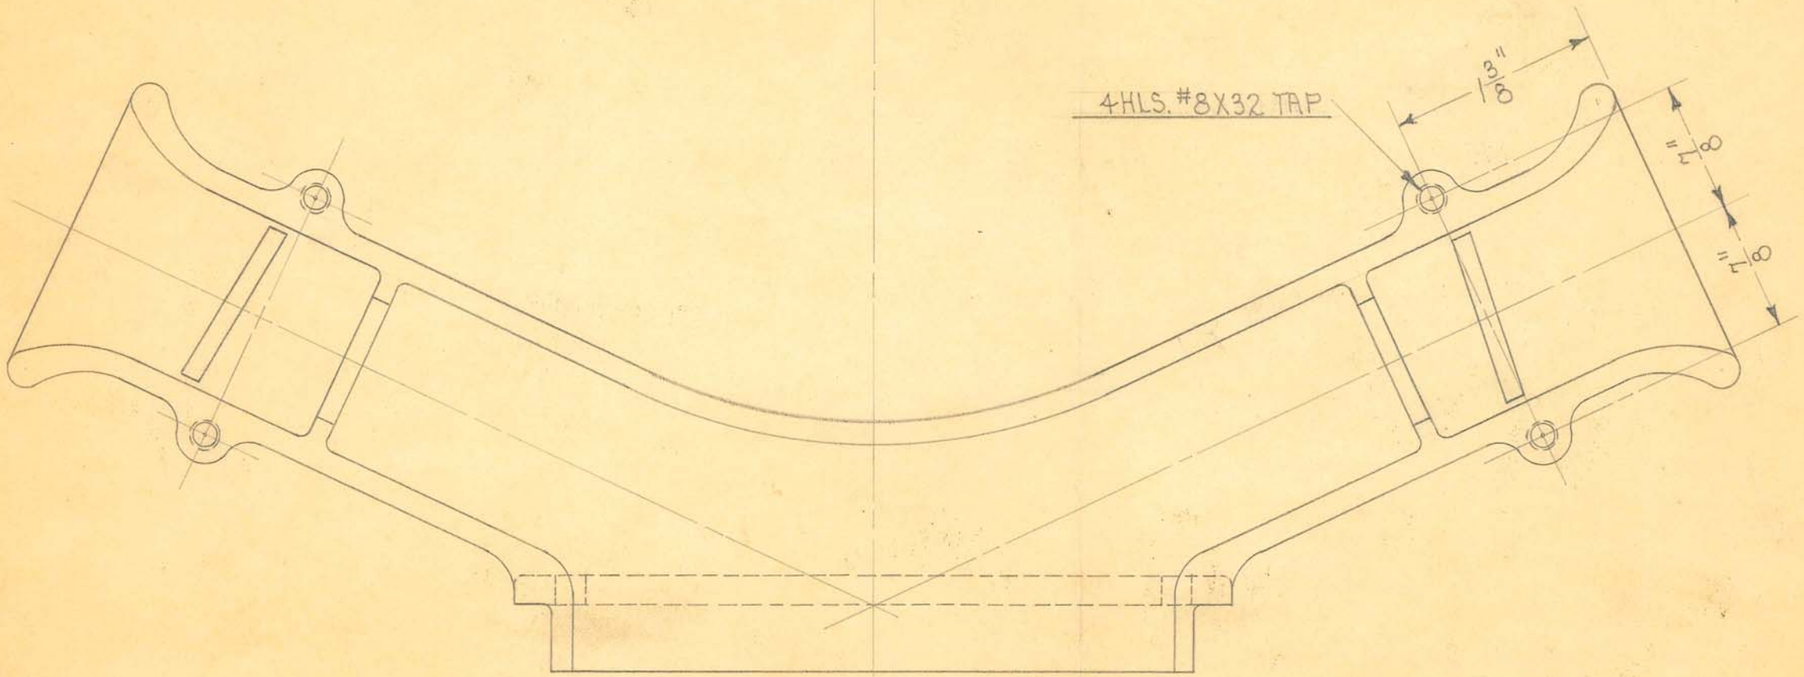

1 REQUIRED

OBSOLETE

SIZE		ISSUE 7-30-34	H.E.	TITLE: FISCHER "D-S-GO" UNIT TUBE HEAD CABLE SUPPORT - LOWER
KIND	ALUM. CASTING	CHANGED		
SHAPE		" "		
FINISH	BLACK #60	" "		
TEMP.		" "		

H. G. FISCHER & CO.
2335 WABANSIA AVE.

CAT. NO.

PART NO. 8883F

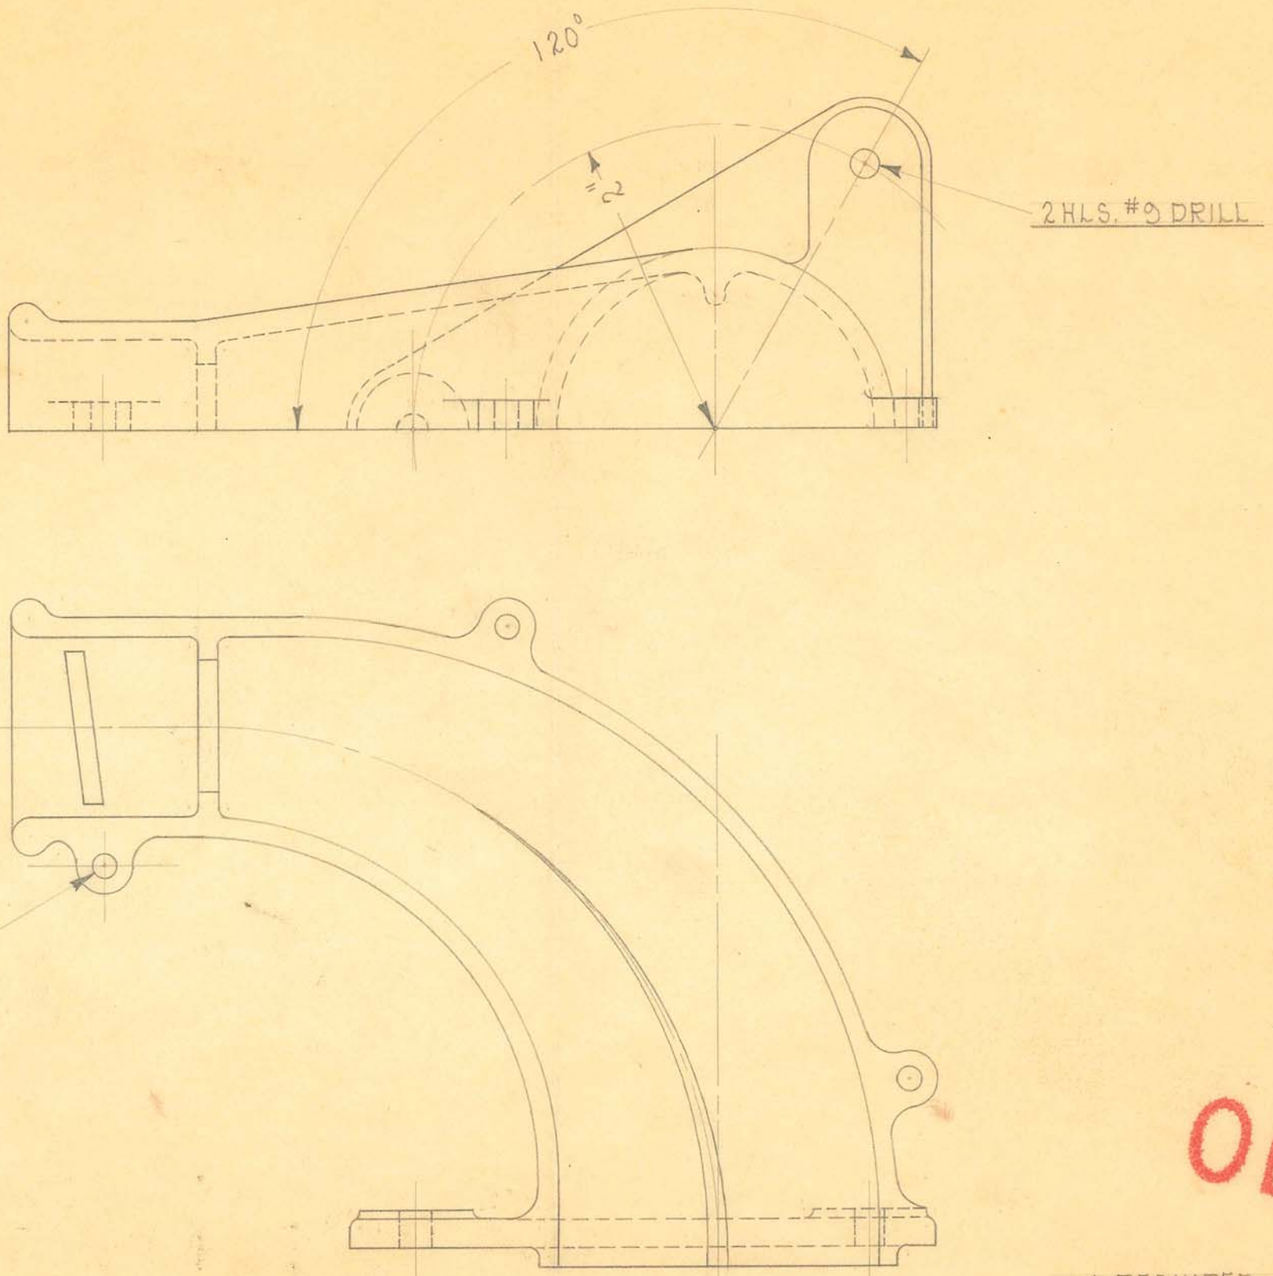

OBSOLETE

1 REQUIRED
DRILLED IN JIG. #3598

SIZE		ISSUE 8-3-34	J.E.
KIND	ALUM. CASTING	CHANGED	
SHAPE		" "	
FINISH	BLACK #60	" "	
TEMP.		" "	
PATT.	8672-722	" "	

TITLE: FISCHER "D-S-60" UNIT TRANSFORMER CABLE SUPPORT - RIGHT (CLEARANCE)

H. G. FISCHER & CO.
2335 WABANSIA AVE.
CHICAGO, ILL.

CAT. NO.

PART NO. 8884F

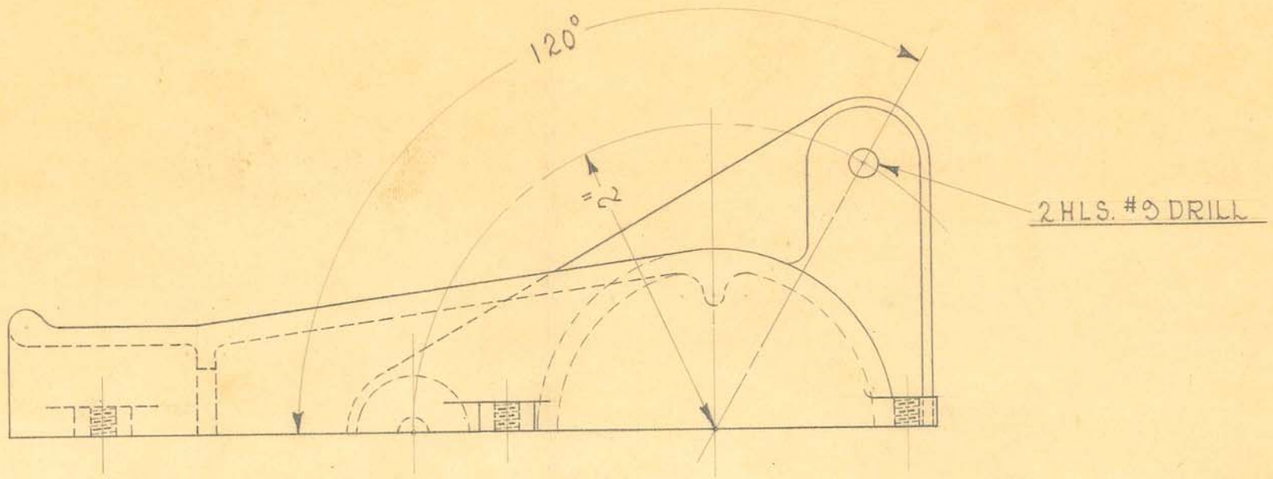

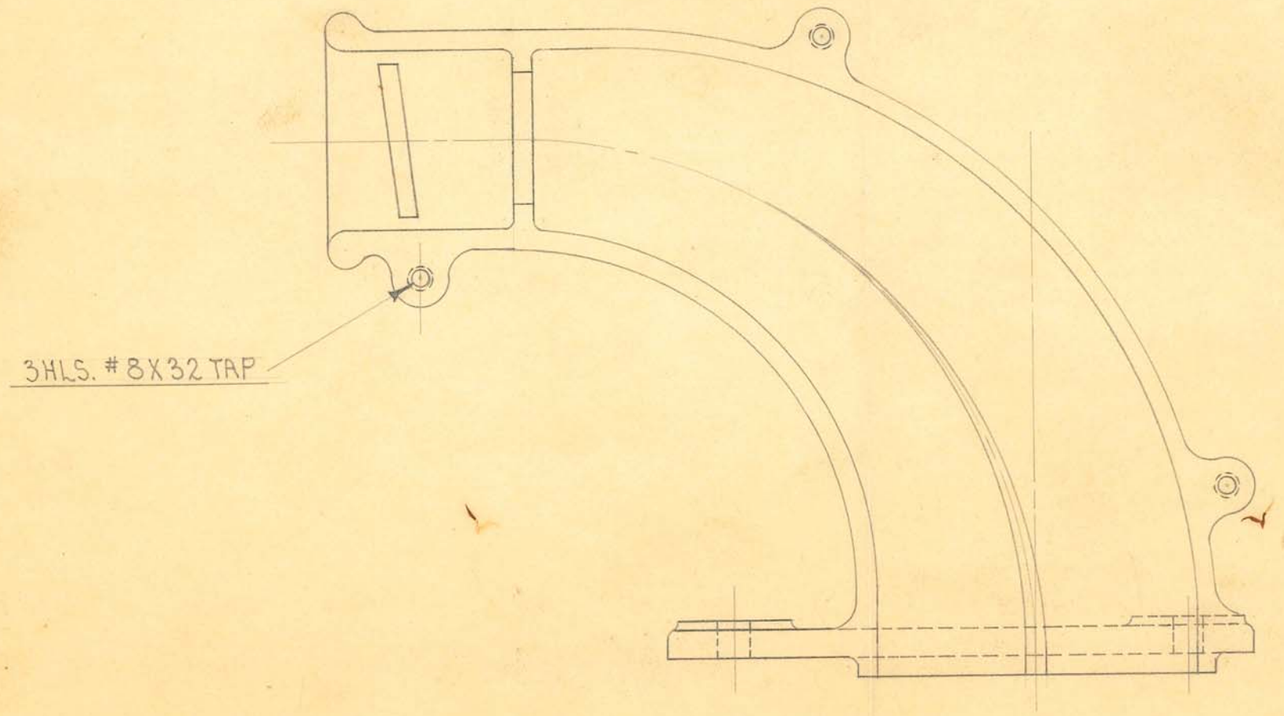

OBSOLETE

1 REQUIRED
DRILLED IN JIG. #3598

SIZE		ISSUE 8-3-34	A.E.
KIND	ALUM. CASTING	CHANGED	
SHAPE		" "	
FINISH	BLACK #60	" "	
TEMP.		" "	
PATT.	8672-722	" "	

TITLE: FISCHER "D-S-GO" UNIT TRANSFORMER CABLE SUPPORT - RIGHT (TAPPED)

H. G. FISCHER & CO.
2335 WABANSIA AVE.
CHICAGO, ILL.

CAT. NO.

PART NO. 8885F

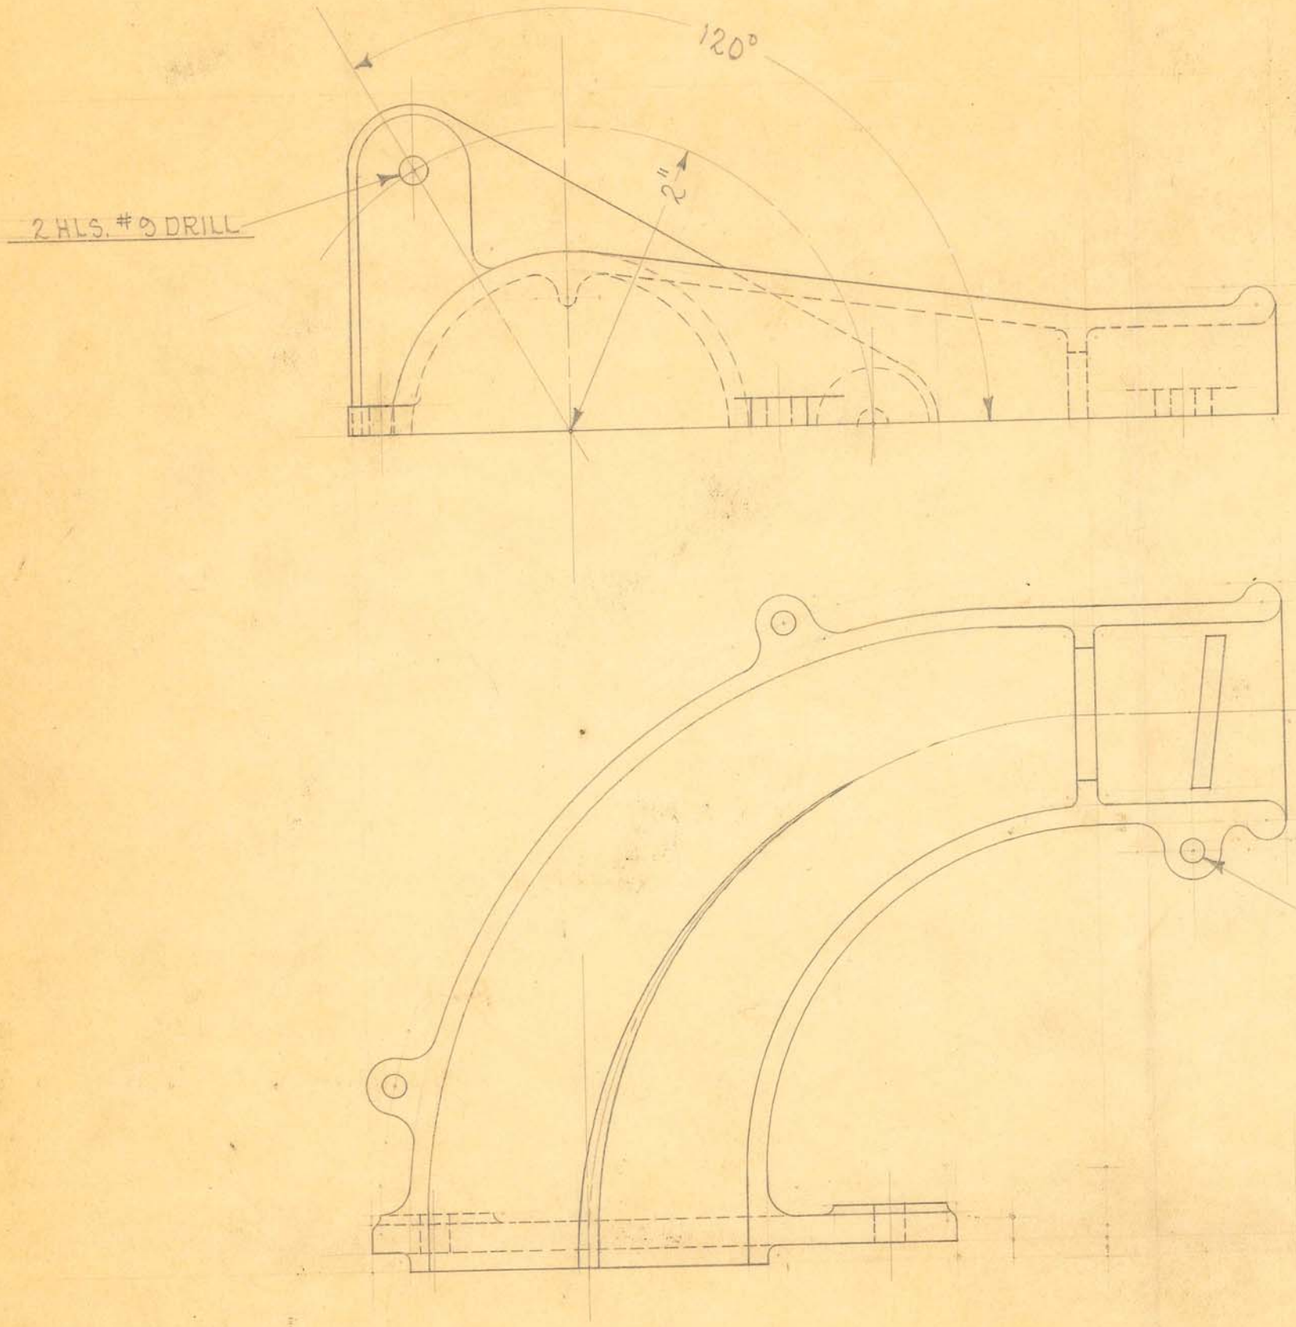

1 REQUIRED

DRILLED IN JIG # 3598

OBSOLETE

SIZE		ISSUE 8-2-34	A.E.
KIND	ALUM. CASTING	CHANGED	
SHAPE		" "	
FINISH	BLACK #60	" "	
TEMP.		" "	
PATT.	8675-725	" "	

TITLE: FISCHER "D-S-GO" UNIT TRANSFORMER CABLE SUPPORT - LEFT (CLEARANCE)

H. G. FISCHER & CO.
2335 WABANSIA AVE.
CHICAGO, ILL.

CAT. NO.

PART NO. 8886F

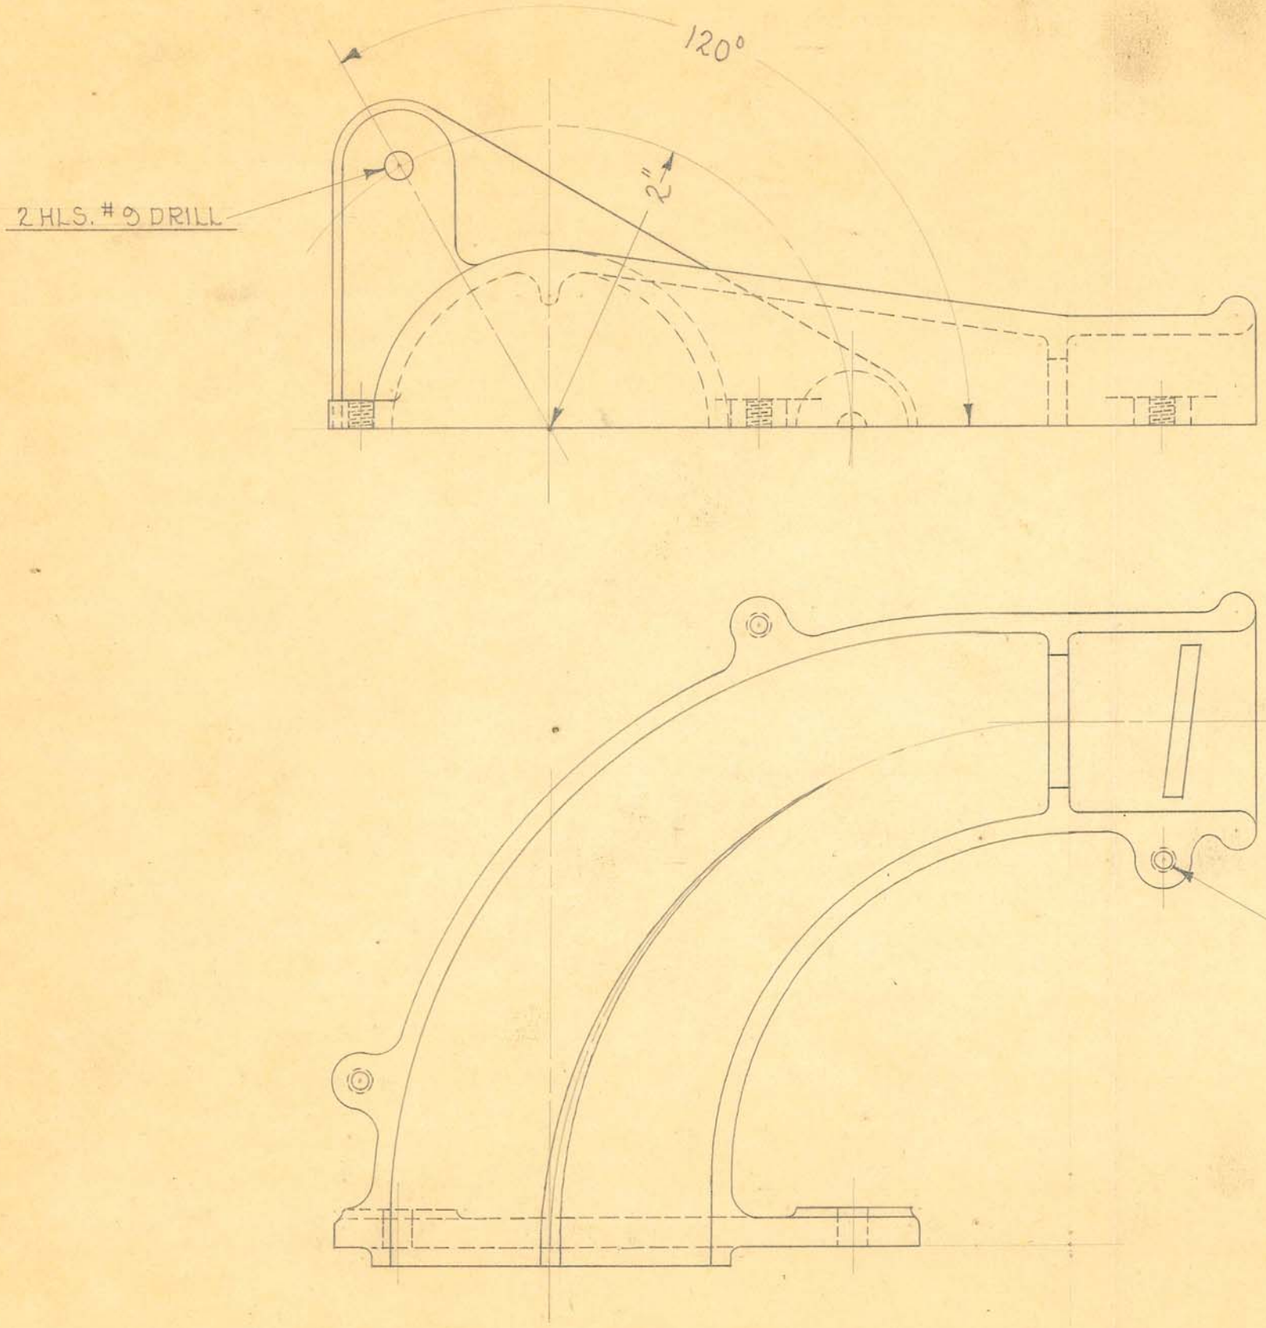

1 REQUIRED

DRILLED IN JIG # 3598

OBSOLETE

SIZE		ISSUE 8-2-34	A.E.
KIND	ALUM. CASTING	CHANGED	
SHAPE		" "	
FINISH	BLACK # 60	" "	
TEMP.		" "	
PATT.	8675-725	" "	

TITLE: FISCHER "D-S-GO" UNIT TRANSFORMER CABLE SUPPORT-LEFT (TAPPED)

H. G. FISCHER & CO.
2335 WABANSIA AVE.
CHICAGO, ILL.

CAT. NO.

PART NO. 8887F

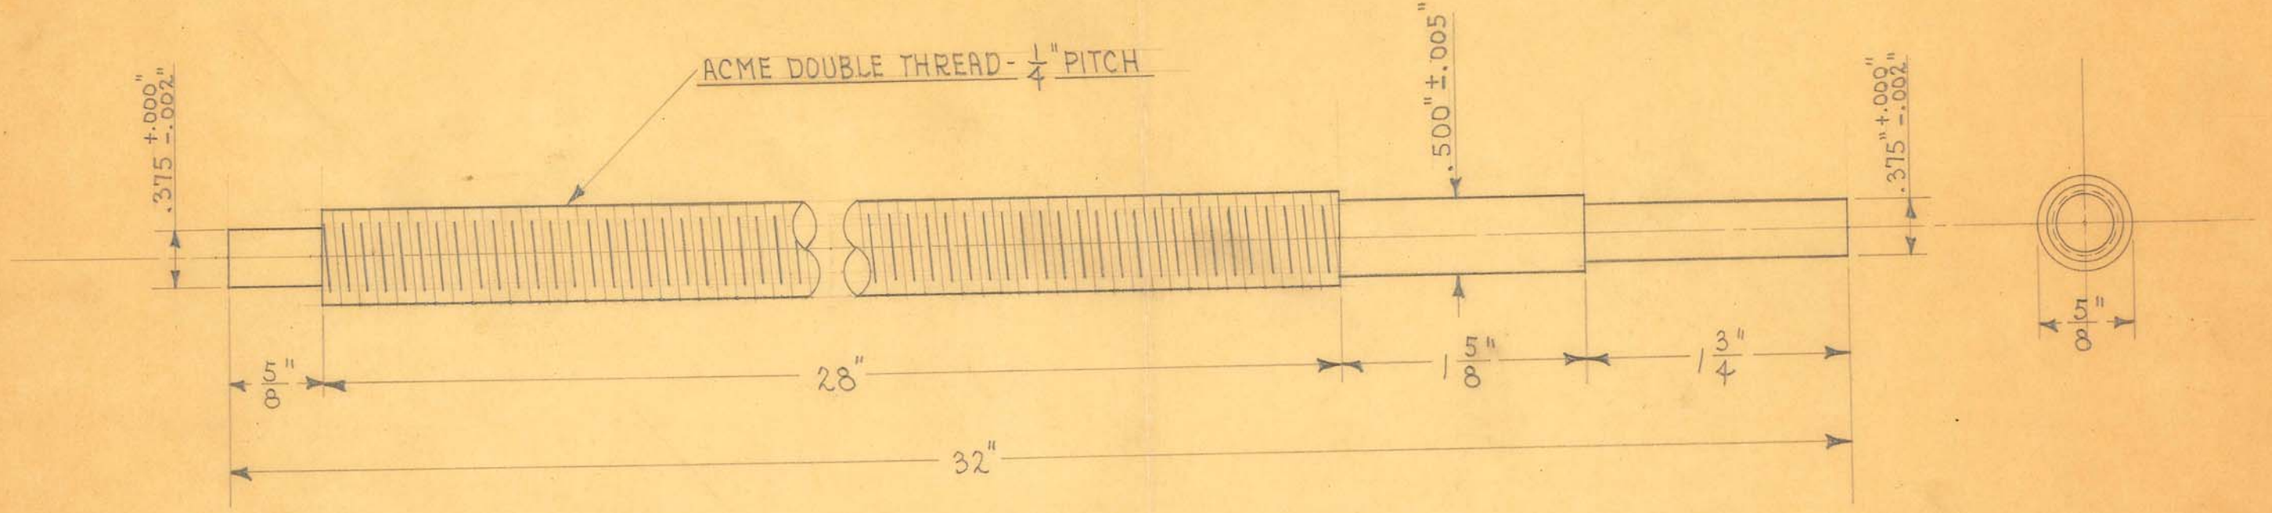

1 REQUIRED

OBSOLETE

1938 cost 2.45

SIZE	5/8" DIAM.	ISSUE 10-10-35	H.E.	TITLE: FISCHER 30" BUCKY VERTICAL ADJUSTMENT ATTACHMENT SCREW
KIND	C.R. STEEL	CHANGED		
SHAPE		" "		
FINISH		" "		
TEMP.		" "		
PATT.		" "		

H. G. FISCHER & CO.
2335 WABANSIA AVE.
CHICAGO, ILL.

CAT. NO.

PART NO. 8926

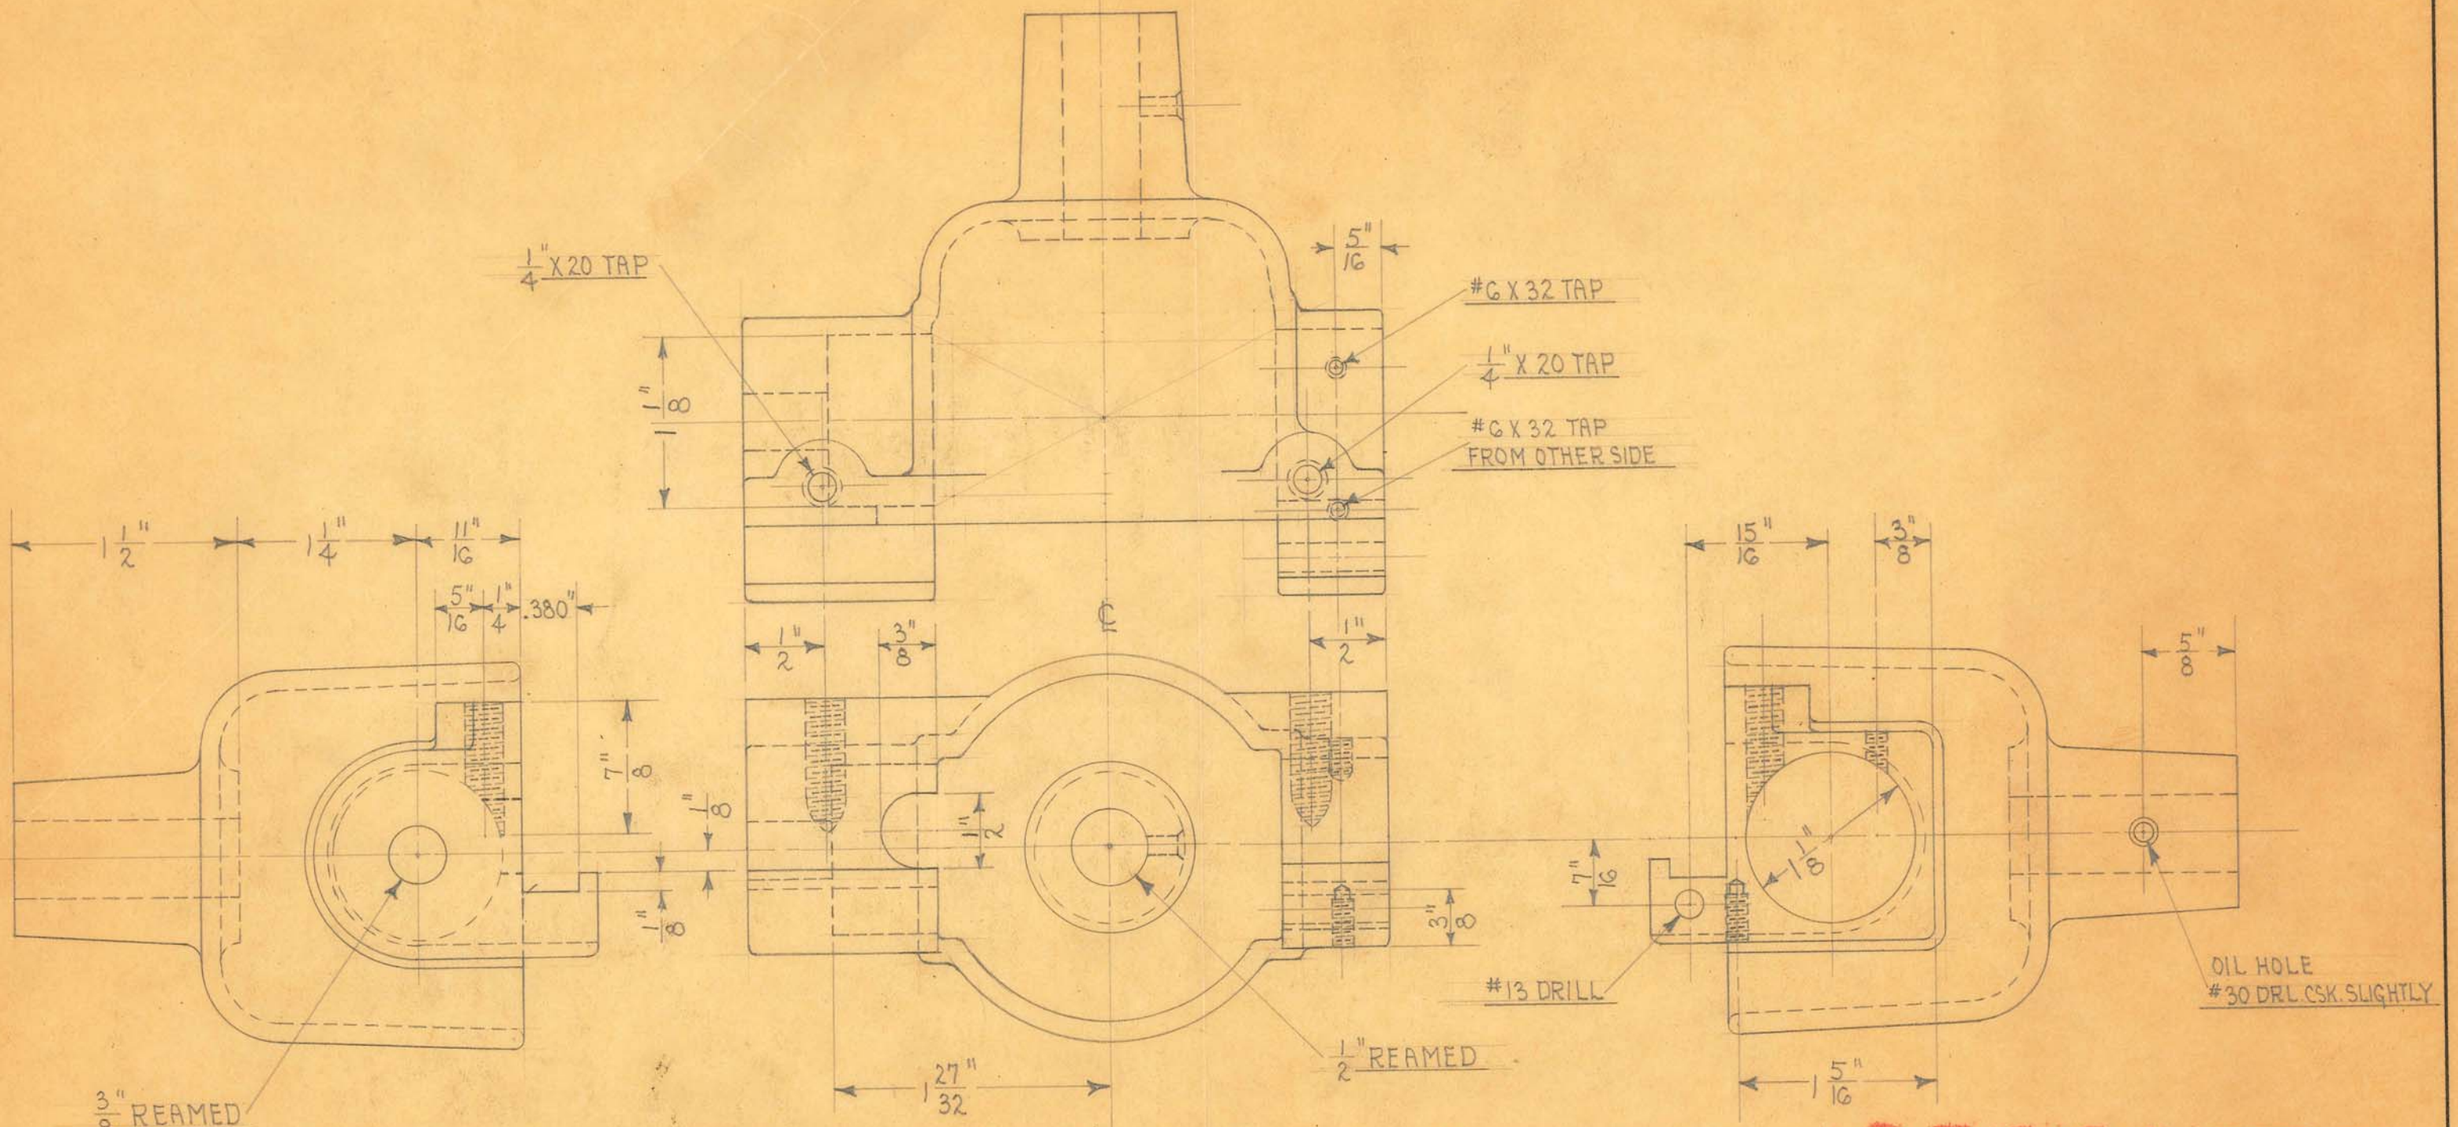

1 REQUIRED

OBSOLETE

SIZE		ISSUE 10-23-35	A.E.	TITLE: FISCHER 36" BUCKY VERTICAL ADJUSTMENT ATTACHMENT LOWER BEARING
KIND	IRON CASTING	CHANGED		
SHAPE		" "		
FINISH	BLACK #50	" "		H. G. FISCHER & CO. 2335 WABANSIA AVE. CHICAGO, ILL. — CAT. NO. — PART NO. 8930F
TEMP.		" "		
PATT.	2358-879	" "		

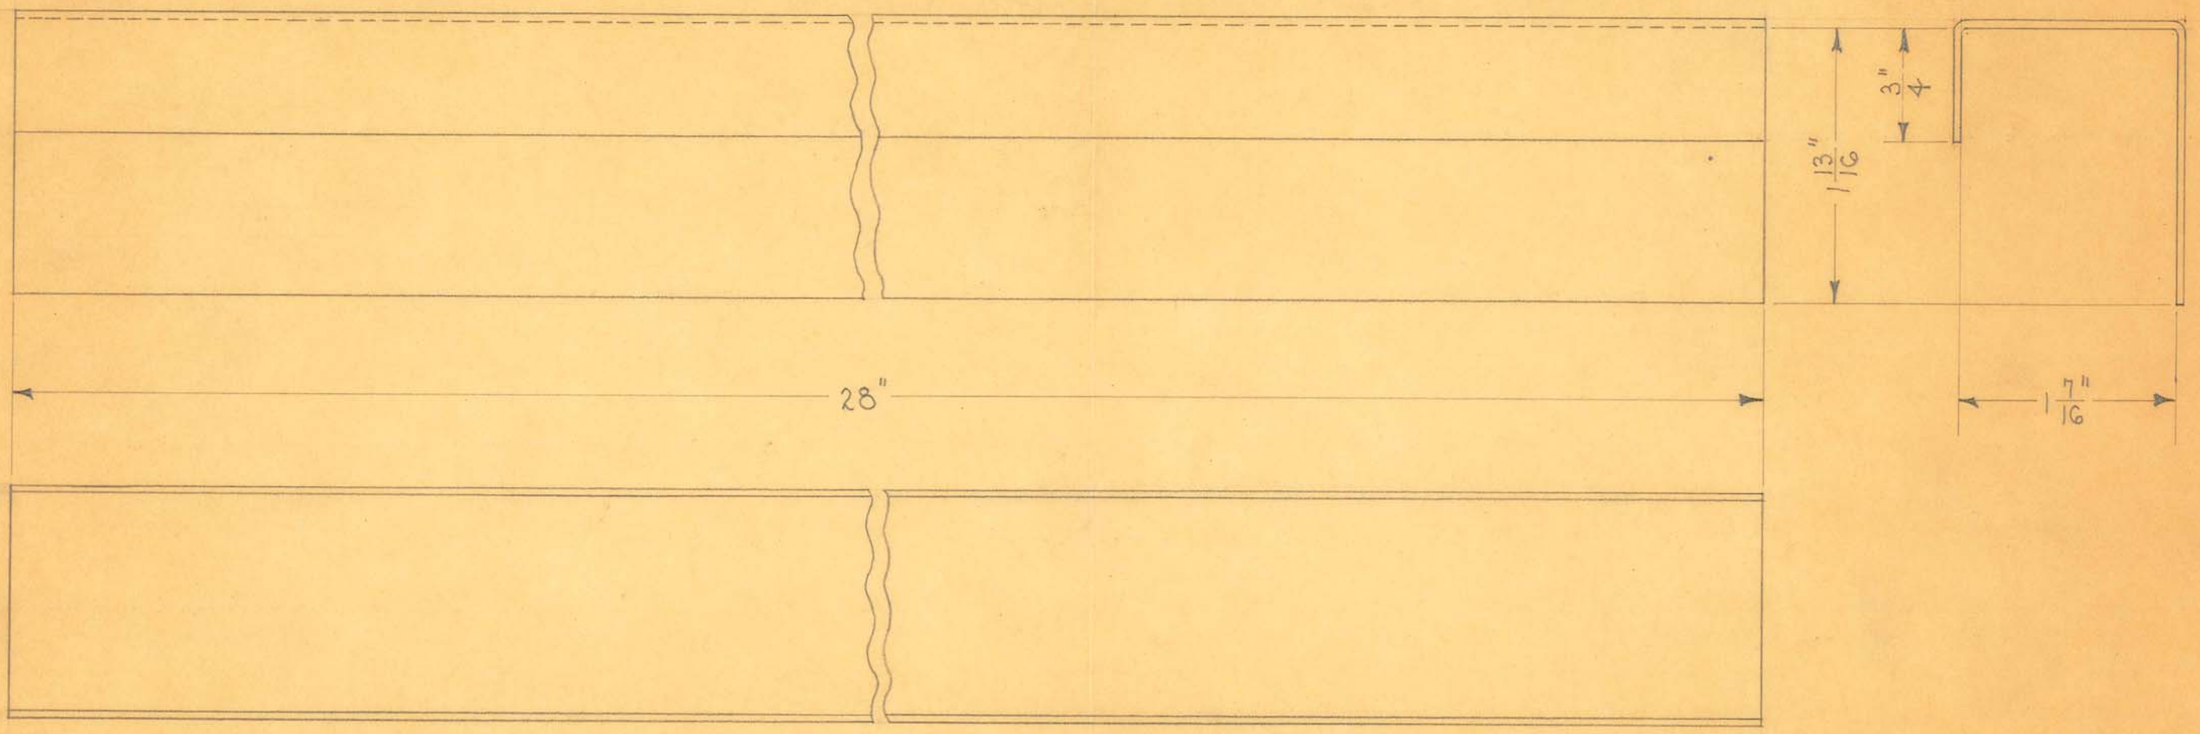

1 REQUIRED

OBSOLETE

SIZE	.050"	ISSUE 10-10-35	H.E.	TITLE: FISCHER 36" BUCKY VERTICAL ADJUSTMENT ATTACHMENT COVER PLATE
KIND	SHEET STEEL (FURNITURE)	CHANGED		
~~SHAPE~~		" "		
FINISH		" "		
TEMP.		" "		
PATT.		" "		

H. G. FISCHER & CO.
2335 WABANSIA AVE.
CHICAGO, ILL.

CAT. NO.

PART NO. 8933

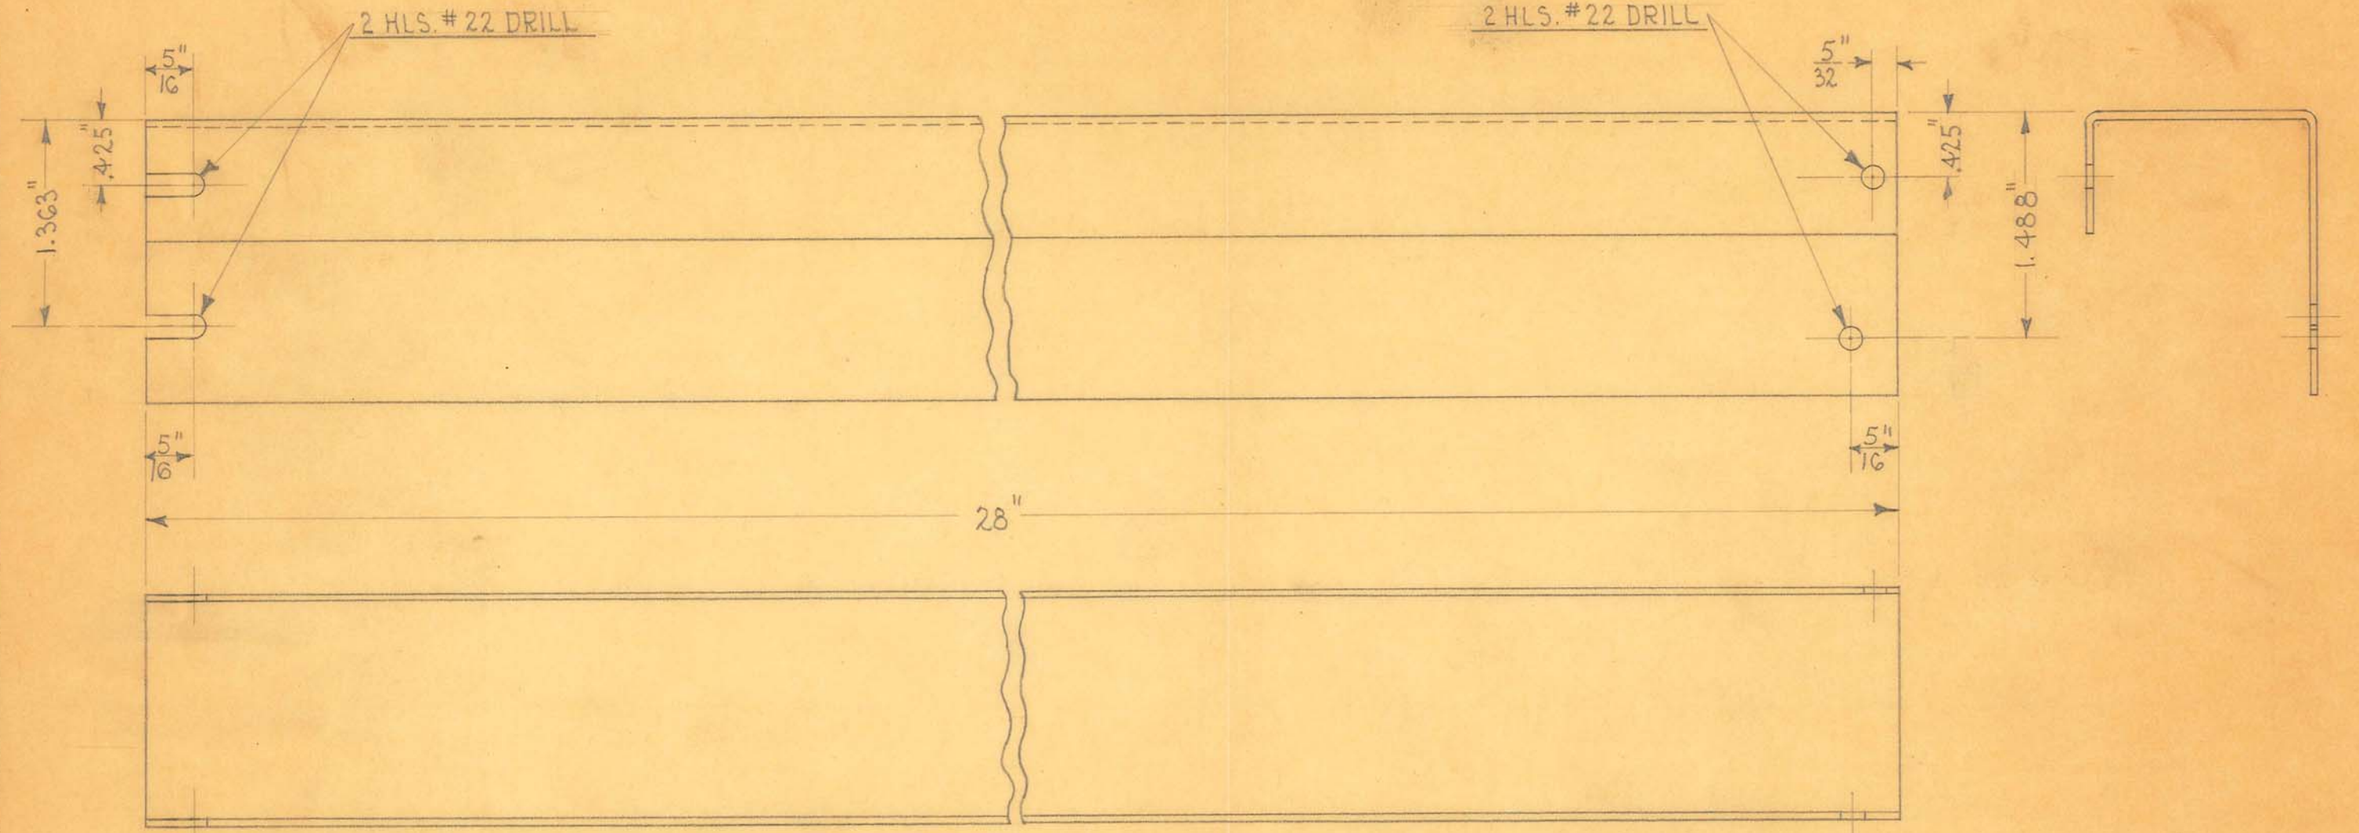

1 REQUIRED

OBSOLETE

SIZE		ISSUE 10-10-35	A.E.
KIND		CHANGED	
SHAPE		" "	
FINISH		" "	
TEMP.		" "	
PATT.		" "	

TITLE: FISCHER 36" BUCKY VERTICAL ADJUSTMENT ATTACHMENT COVER PLATE (DRILLED)

H. G. FISCHER & CO.
2335 WABANSIA AVE.
CHICAGO, ILL.

CAT. NO.

PART NO. 8933F

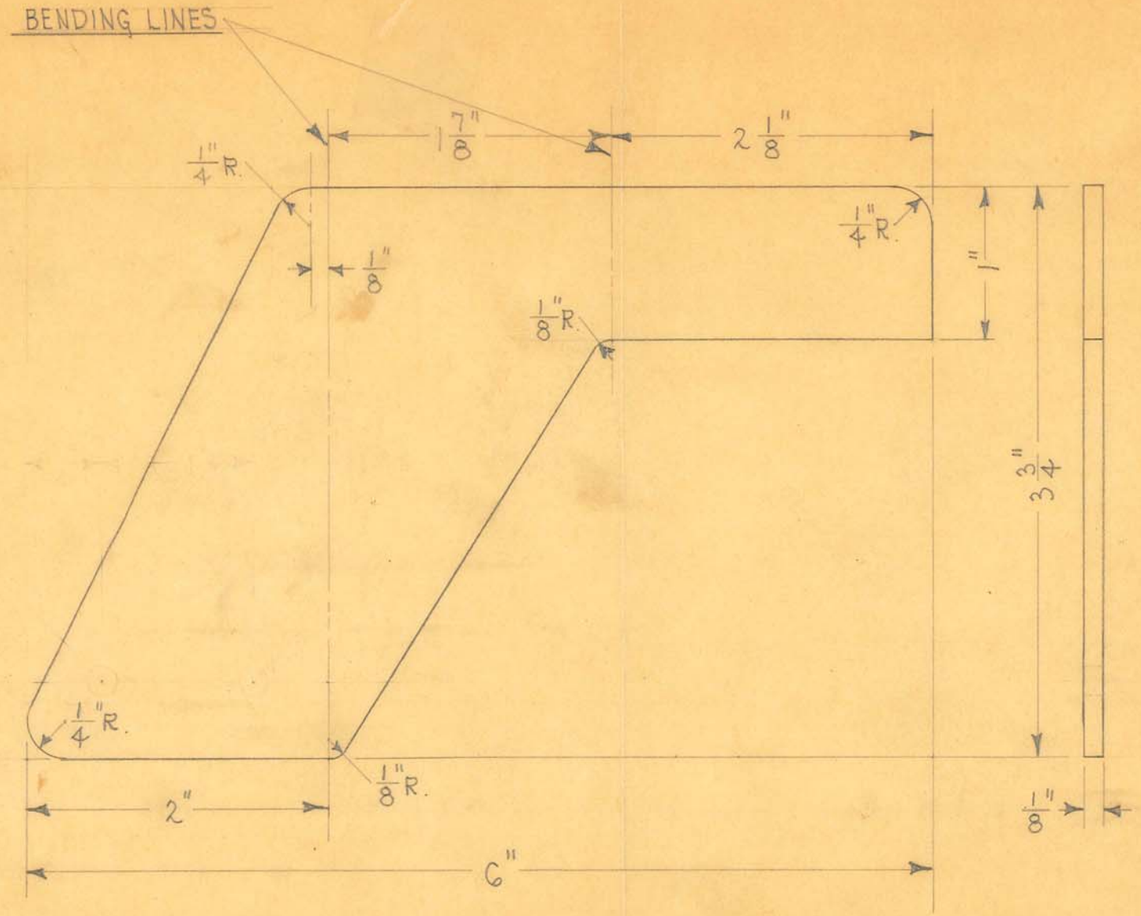

1 REQUIRED

OBSOLETE

SIZE	1/8" SHEET	ISSUE 10-10-35	A.E.
KIND	C.R. STEEL	CHANGED	
SHAPE		" "	
FINISH		" "	
TEMP.		" "	
PATT.		" "	

TITLE: FISCHER 36" BUCKY VERTICAL ADJUSTMENT ATTACHMENT PLATE CONNECTOR-BLANK

H. G. FISCHER & CO.
2335 WABANSIA AVE.
CHICAGO, ILL.

CAT. NO.

PART NO. 8940

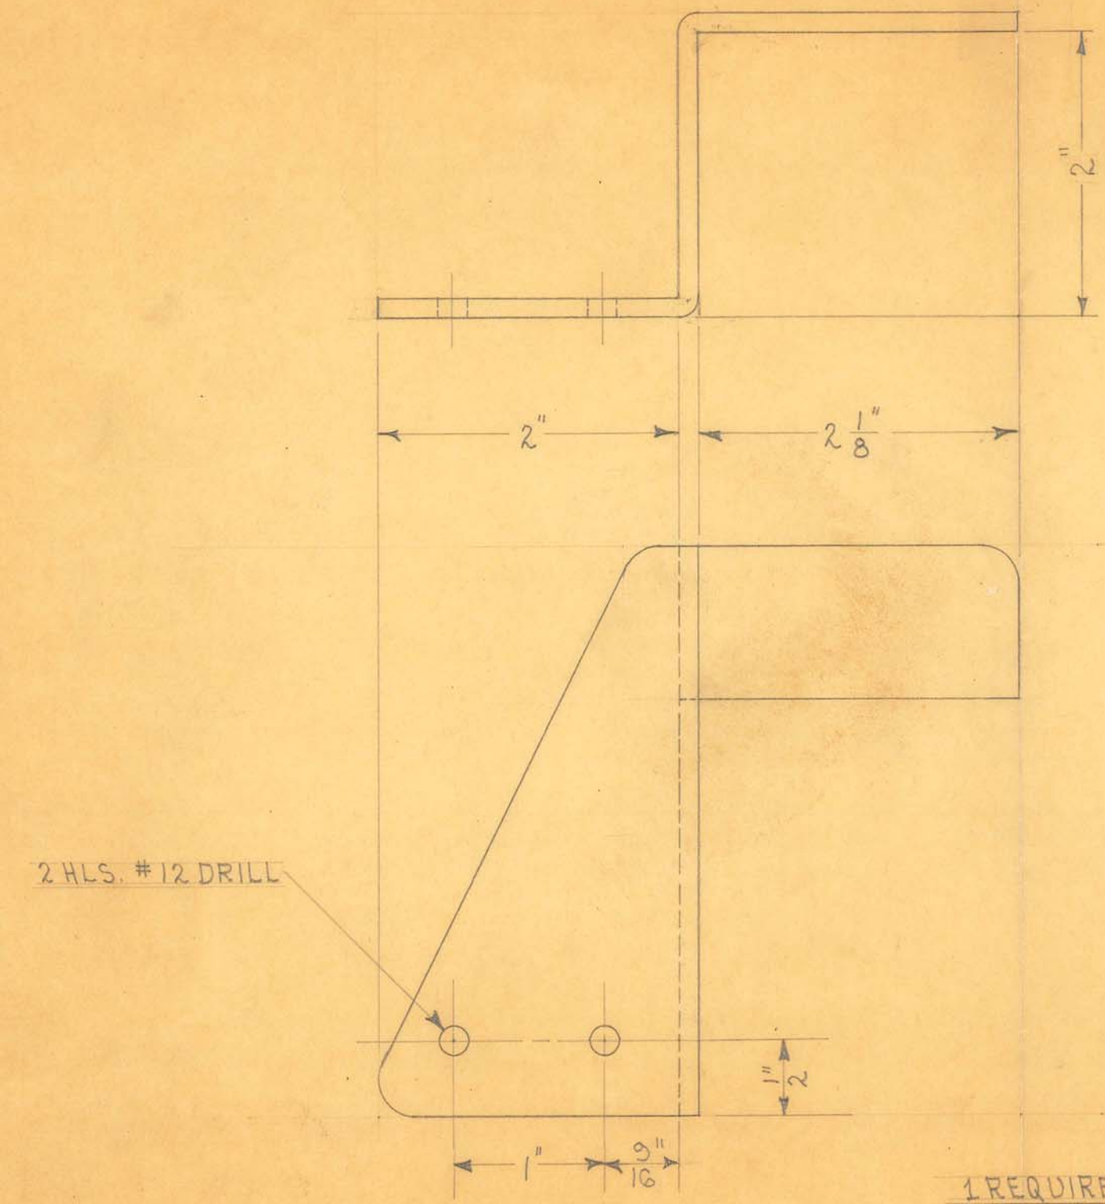

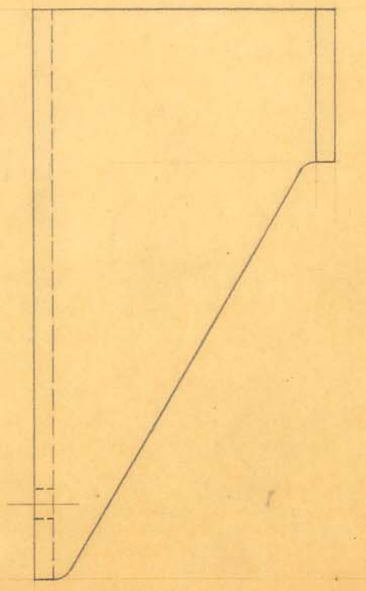

1 REQUIRED

OBSOLETE

SIZE		ISSUE 10-10-35	2/8	TITLE: FISCHER 36" BUCKY VERTICAL ADJUSTMENT ATTACHMENT PLATE CONNECTOR
KIND		CHANGED		
SHAPE		" "		
FINISH	CAD. # 23	" "		
TEMP.		" "		H. G. FISCHER & CO. 2335 WABANSIA AVE. CHICAGO, ILL. — CAT. NO. — PART NO. 8940F
PATT.		" "		

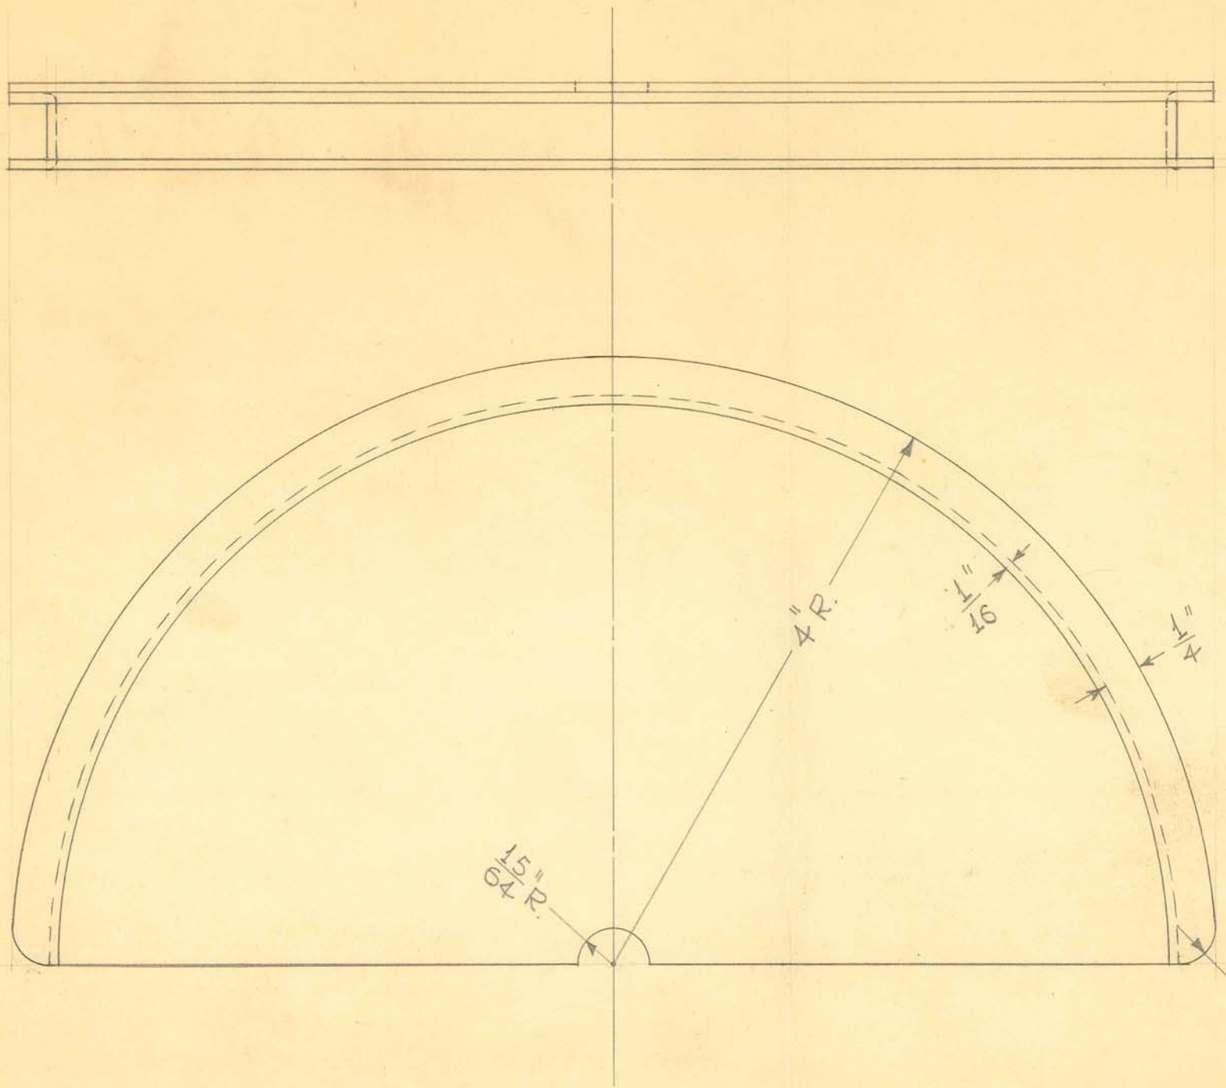

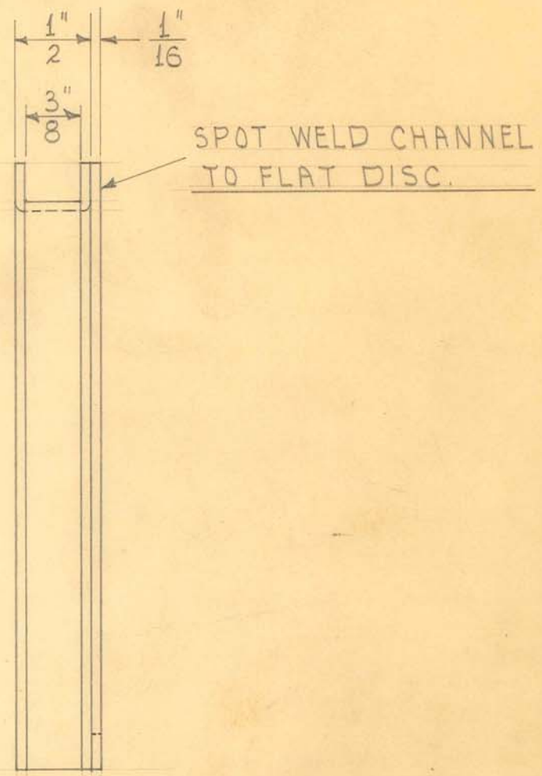

1 REQUIRED

OBSOLETE

SIZE	.062"	ISSUE 8-17-43	HE.
KIND	C.R. STEEL	CHANGED	
SHAPE	SHEET	"	
FINISH		"	
TEMP.		"	
PATT.		"	

TITLE: ARMY RADIOGRAPHIC TABLE - SPRING GUIDE - BLANK

H. G. FISCHER & CO.
2335 WABANSIA AVE.
CHICAGO, ILL.

CAT. NO.

PART NO. 8991

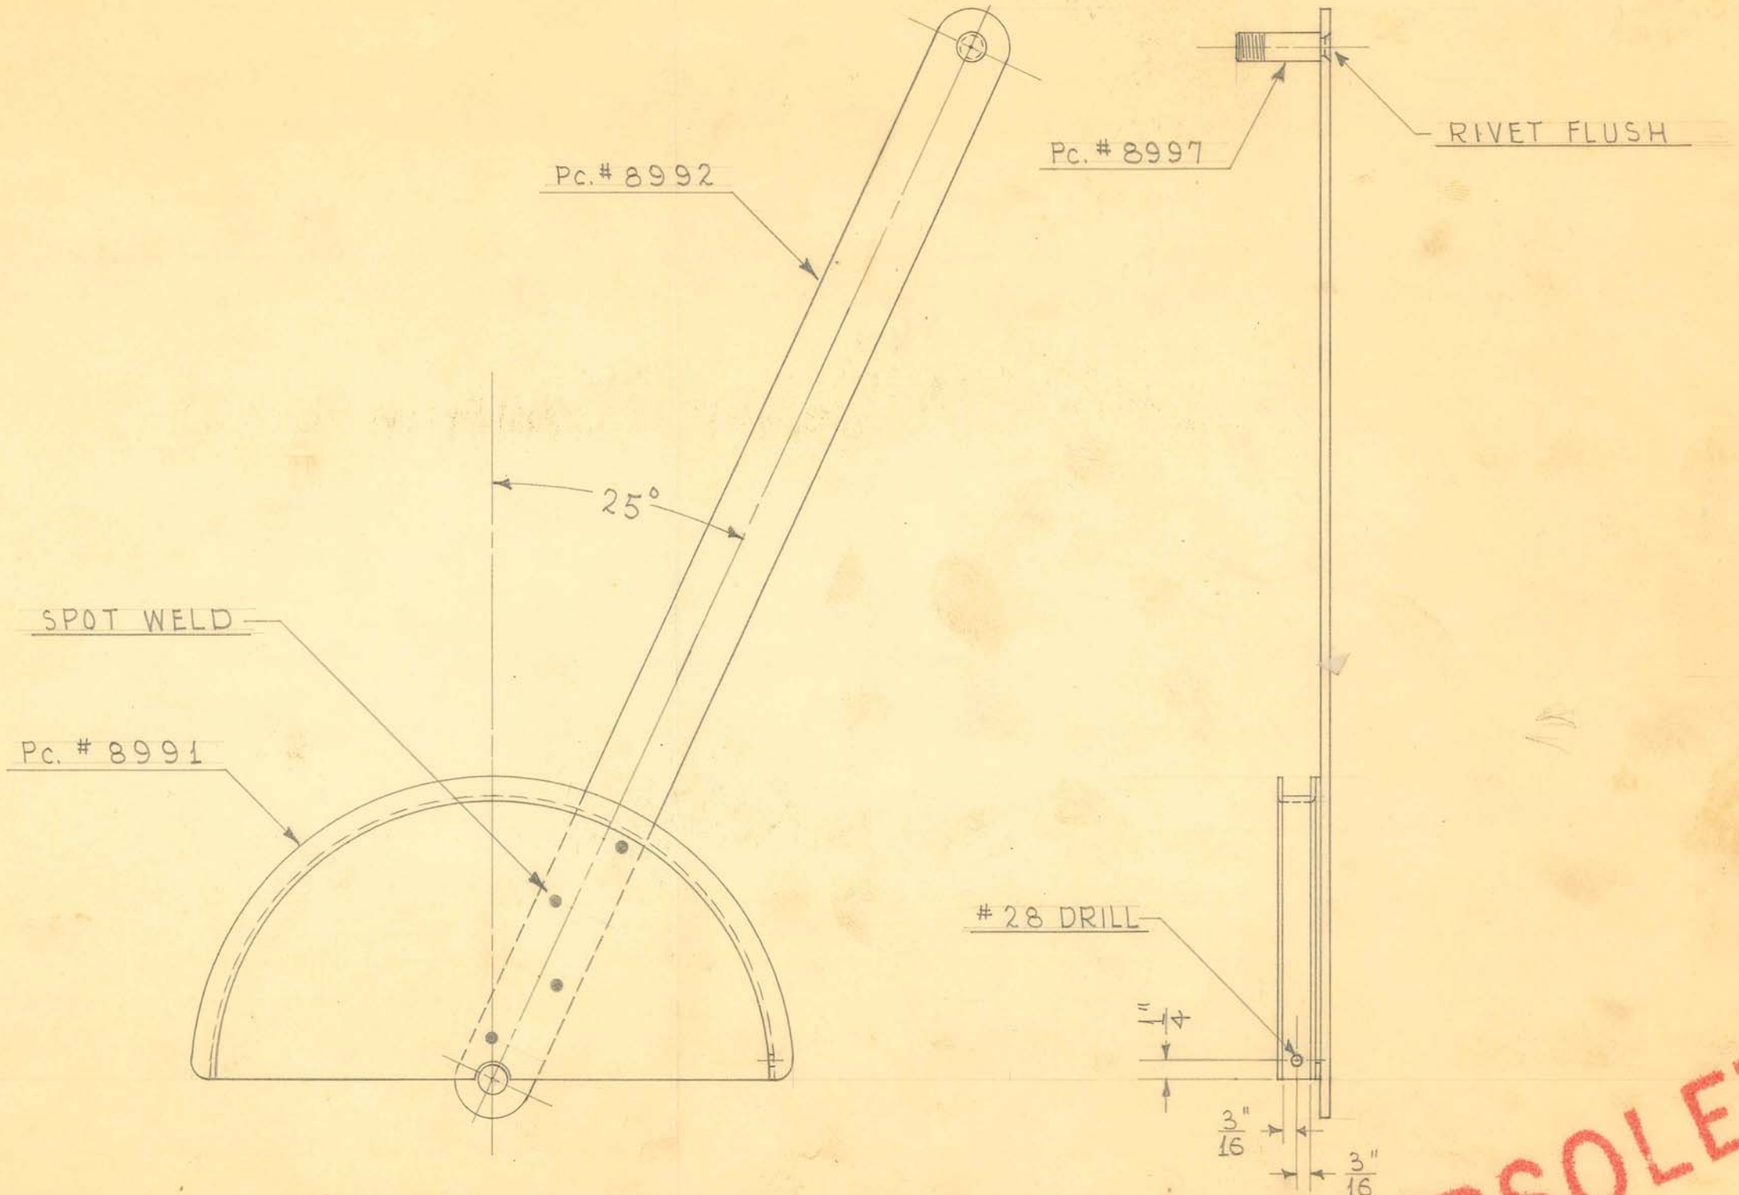

SCALE: $\frac{1}{2}" = 1"$

1 REQUIRED

OBSOLETE

SIZE		ISSUE 8-19-43	HE.	**TITLE:** ARMY RADIOGRAPHIC TABLE - SPRING GUIDE ASSEM.
KIND		CHANGED		
SHAPE		"		
FINISH	CHR. WH. #3	"		
TEMP.		"		
PATT.		"		

H. G. FISCHER & CO.
2335 WABANSIA AVE.
CHICAGO. ILL.

CAT. NO.

PART NO. 8991G

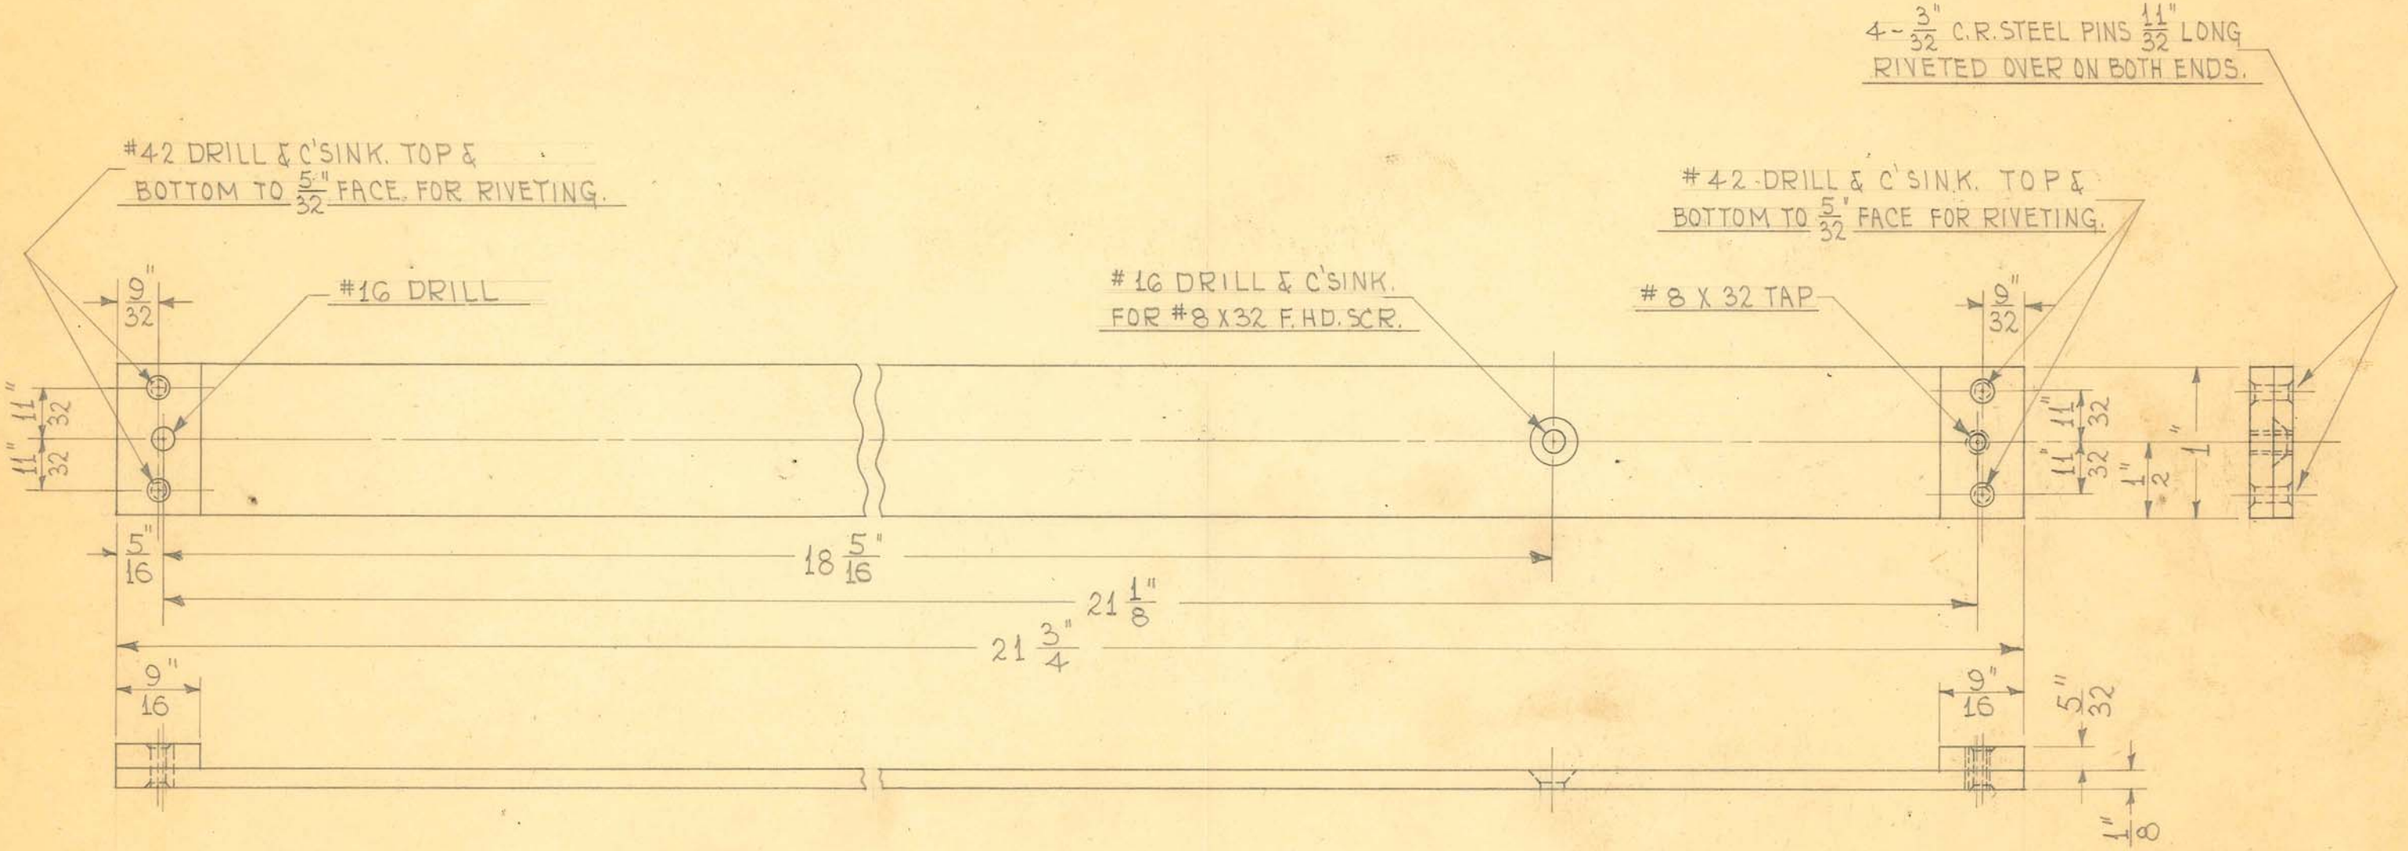

1 REQUIRED

OBSOLETE

MATERIAL

1" X 1/8" C.R. STEEL BAR
1" X 5/32" C.R. STEEL BAR
3/32" DIAM. C.R. STEEL ROD

SIZE		ISSUE 8-18-43	HE.	TITLE: ARMY RADIOGRAPHIC TABLE - PULLEY ARM GUIDE - LOWER
KIND		CHANGED		
SHAPE		"		
FINISH	CHR. WH. #3	"		
TEMP.		"		
PATT.		"		

H. G. FISCHER & CO.
2335 WABANSIA AVE.
CHICAGO, ILL.

CAT. NO.

PART NO. 8993G

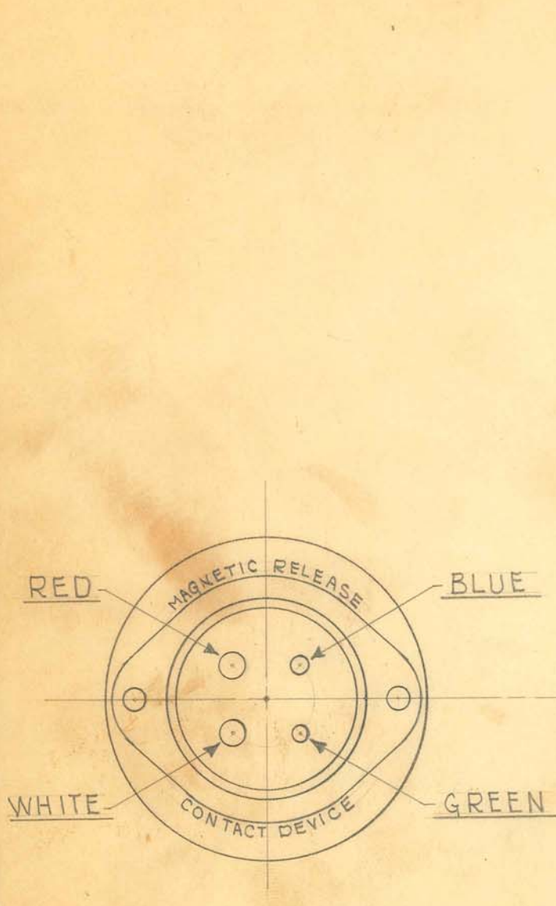

MALE RECEPTACLE

SHOWN WITH PRONGS UP
STRIP CORD $1\frac{3}{8}$" & $\frac{3}{4}$" & SOLDER
COLORED WIRES TO UNDER
SIDE OF PRONGS AS SHOWN.

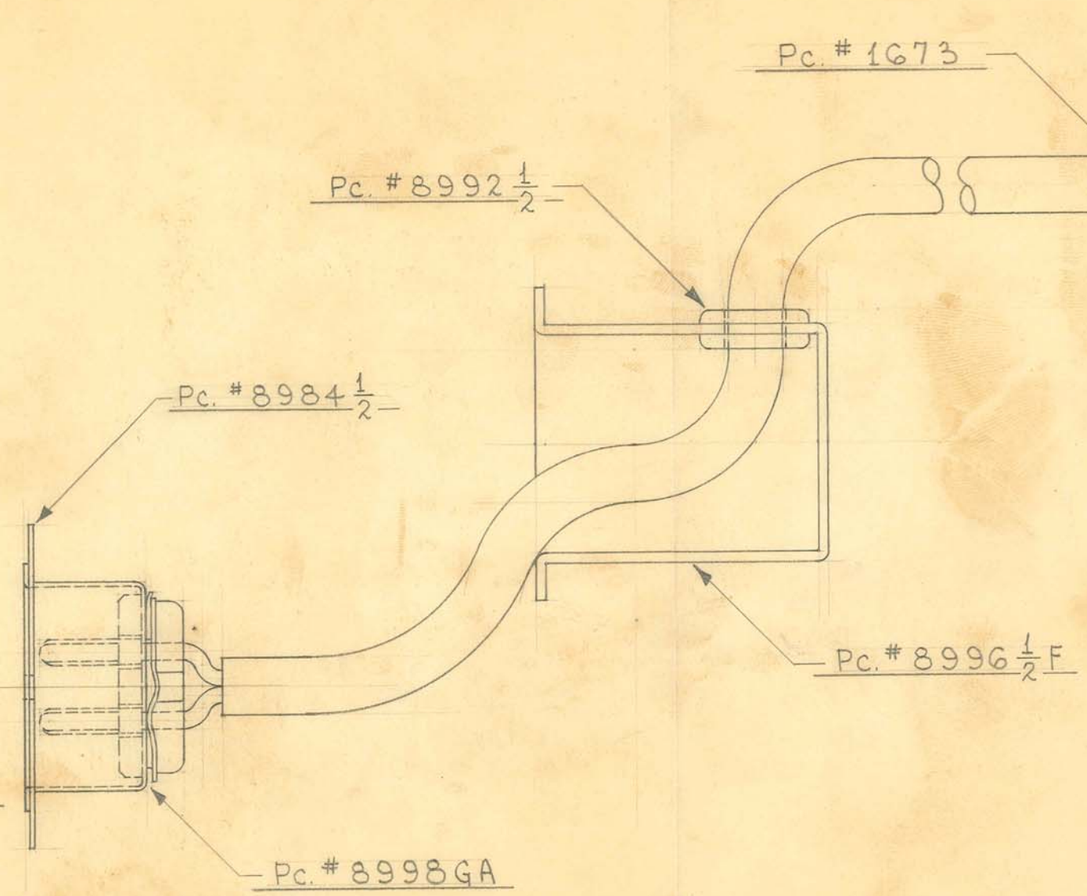

1 REQUIRED

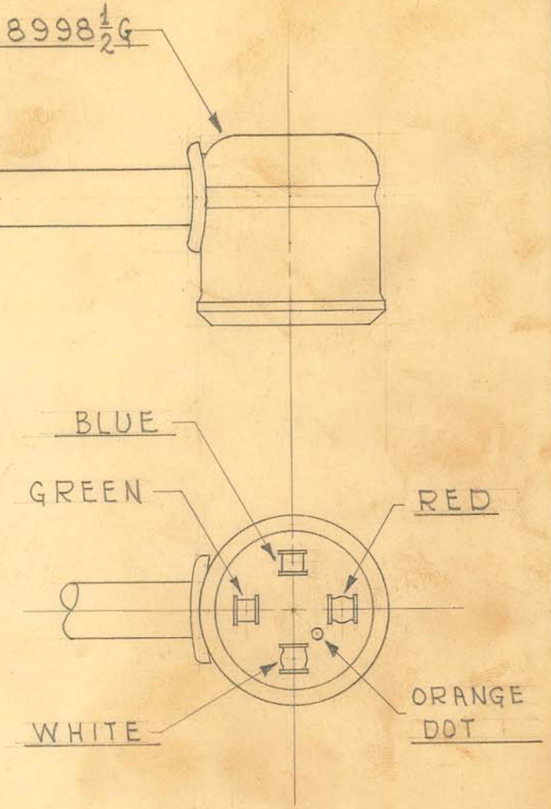

FEMALE RECEPTACLE

SHOWN WITH SIDE FOR WIRES
TO BE SOLDERED TO, DOWN.
STRIP CORD $\frac{5}{8}$" & SOLDER
COLORED LEADS AS SHOWN.

OBSOLETE

SIZE		ISSUE 10-23-43	HE.	TITLE: ARMY RADIOGRAPHIC TABLE - BUCKY CORD ASSEMBLY
KIND		CHANGED		
SHAPE		"		
FINISH		"		
TEMP.		"		
PATT.		"		

H. G. FISCHER & CO.
2335 WABANSIA AVE.
CHICAGO, ILL.

CAT. NO.

PART NO. 8999G

TITLE: FISCHER ELECTRO SYNCHROTIMER
UPPER COLLECTOR RING

H. G. FISCHER & CO.
FRANKLIN PARK, ILLINOIS

DATE 7-18-51 | DR. BY W.J. | CH'K'D. J.V.W.

PART NO. 9006G

REVISION	DATE	BY

PATTERN | FINISH SEE NOTE | SCALE FULL

TOOLS GAUGE # 3900
MANDREL # 4012

MATERIAL FROM 9005

DIMENSIONS
FRACTIONAL ± .015
DECIMAL ± .005
ANGULAR ± ½°
UNLESS OTHERWISE SPECIFIED

NOTCH DIE # 3849
PERF. DIE # 3850
SPINNING TOOL # X1311
SPINNING BLOCK # X1310
DRILL JIG # 3895

OBSOLETE

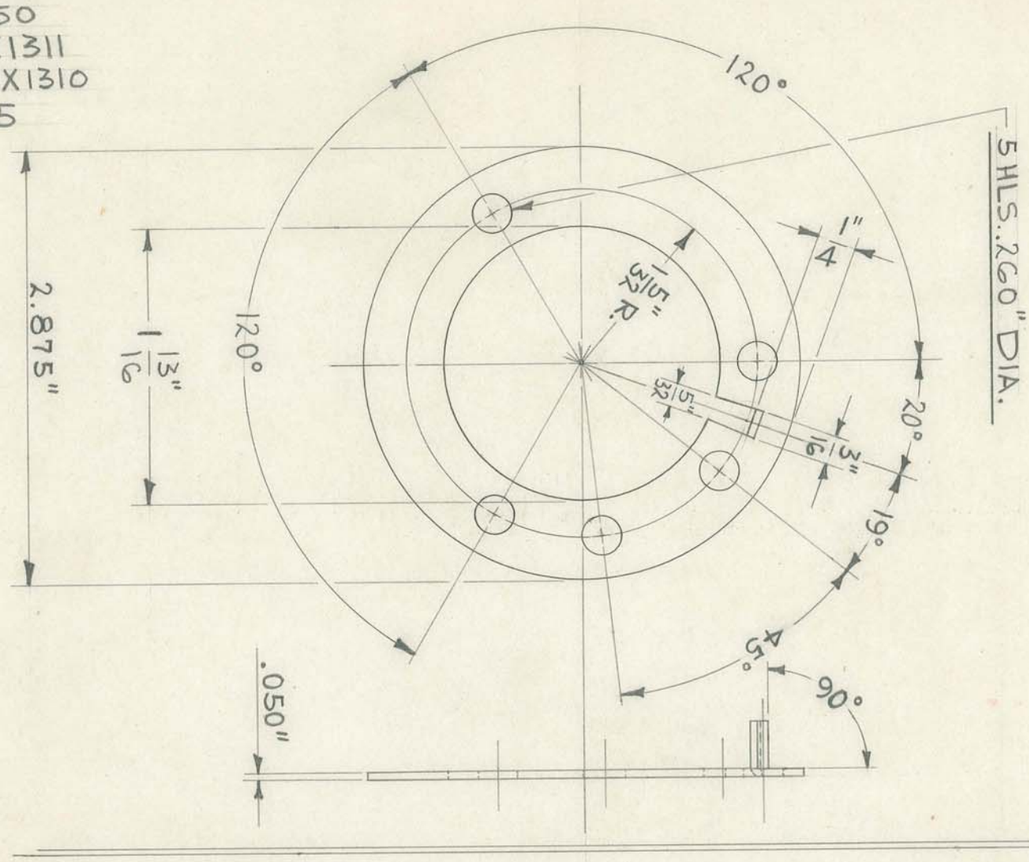

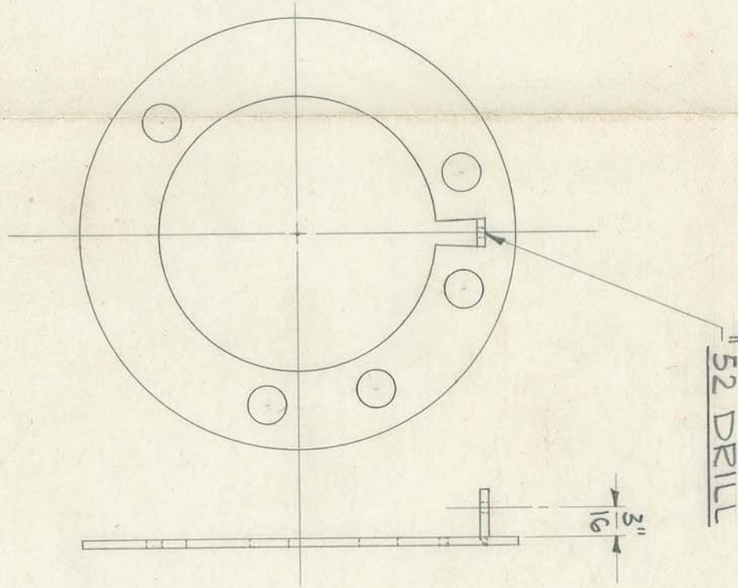

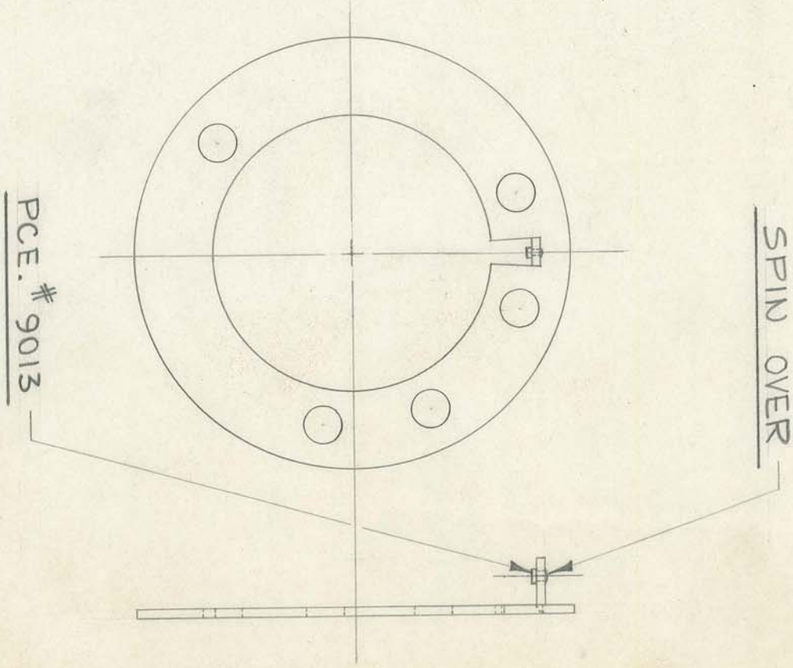

NOTE:
BEFORE ASSEMBLING CONTACT IF SUBSTITUTE BRASS MATERIAL IS USED PIECE MUST BE SENT OUT FOR .001" THICK LAYER OF SILVER PLATING

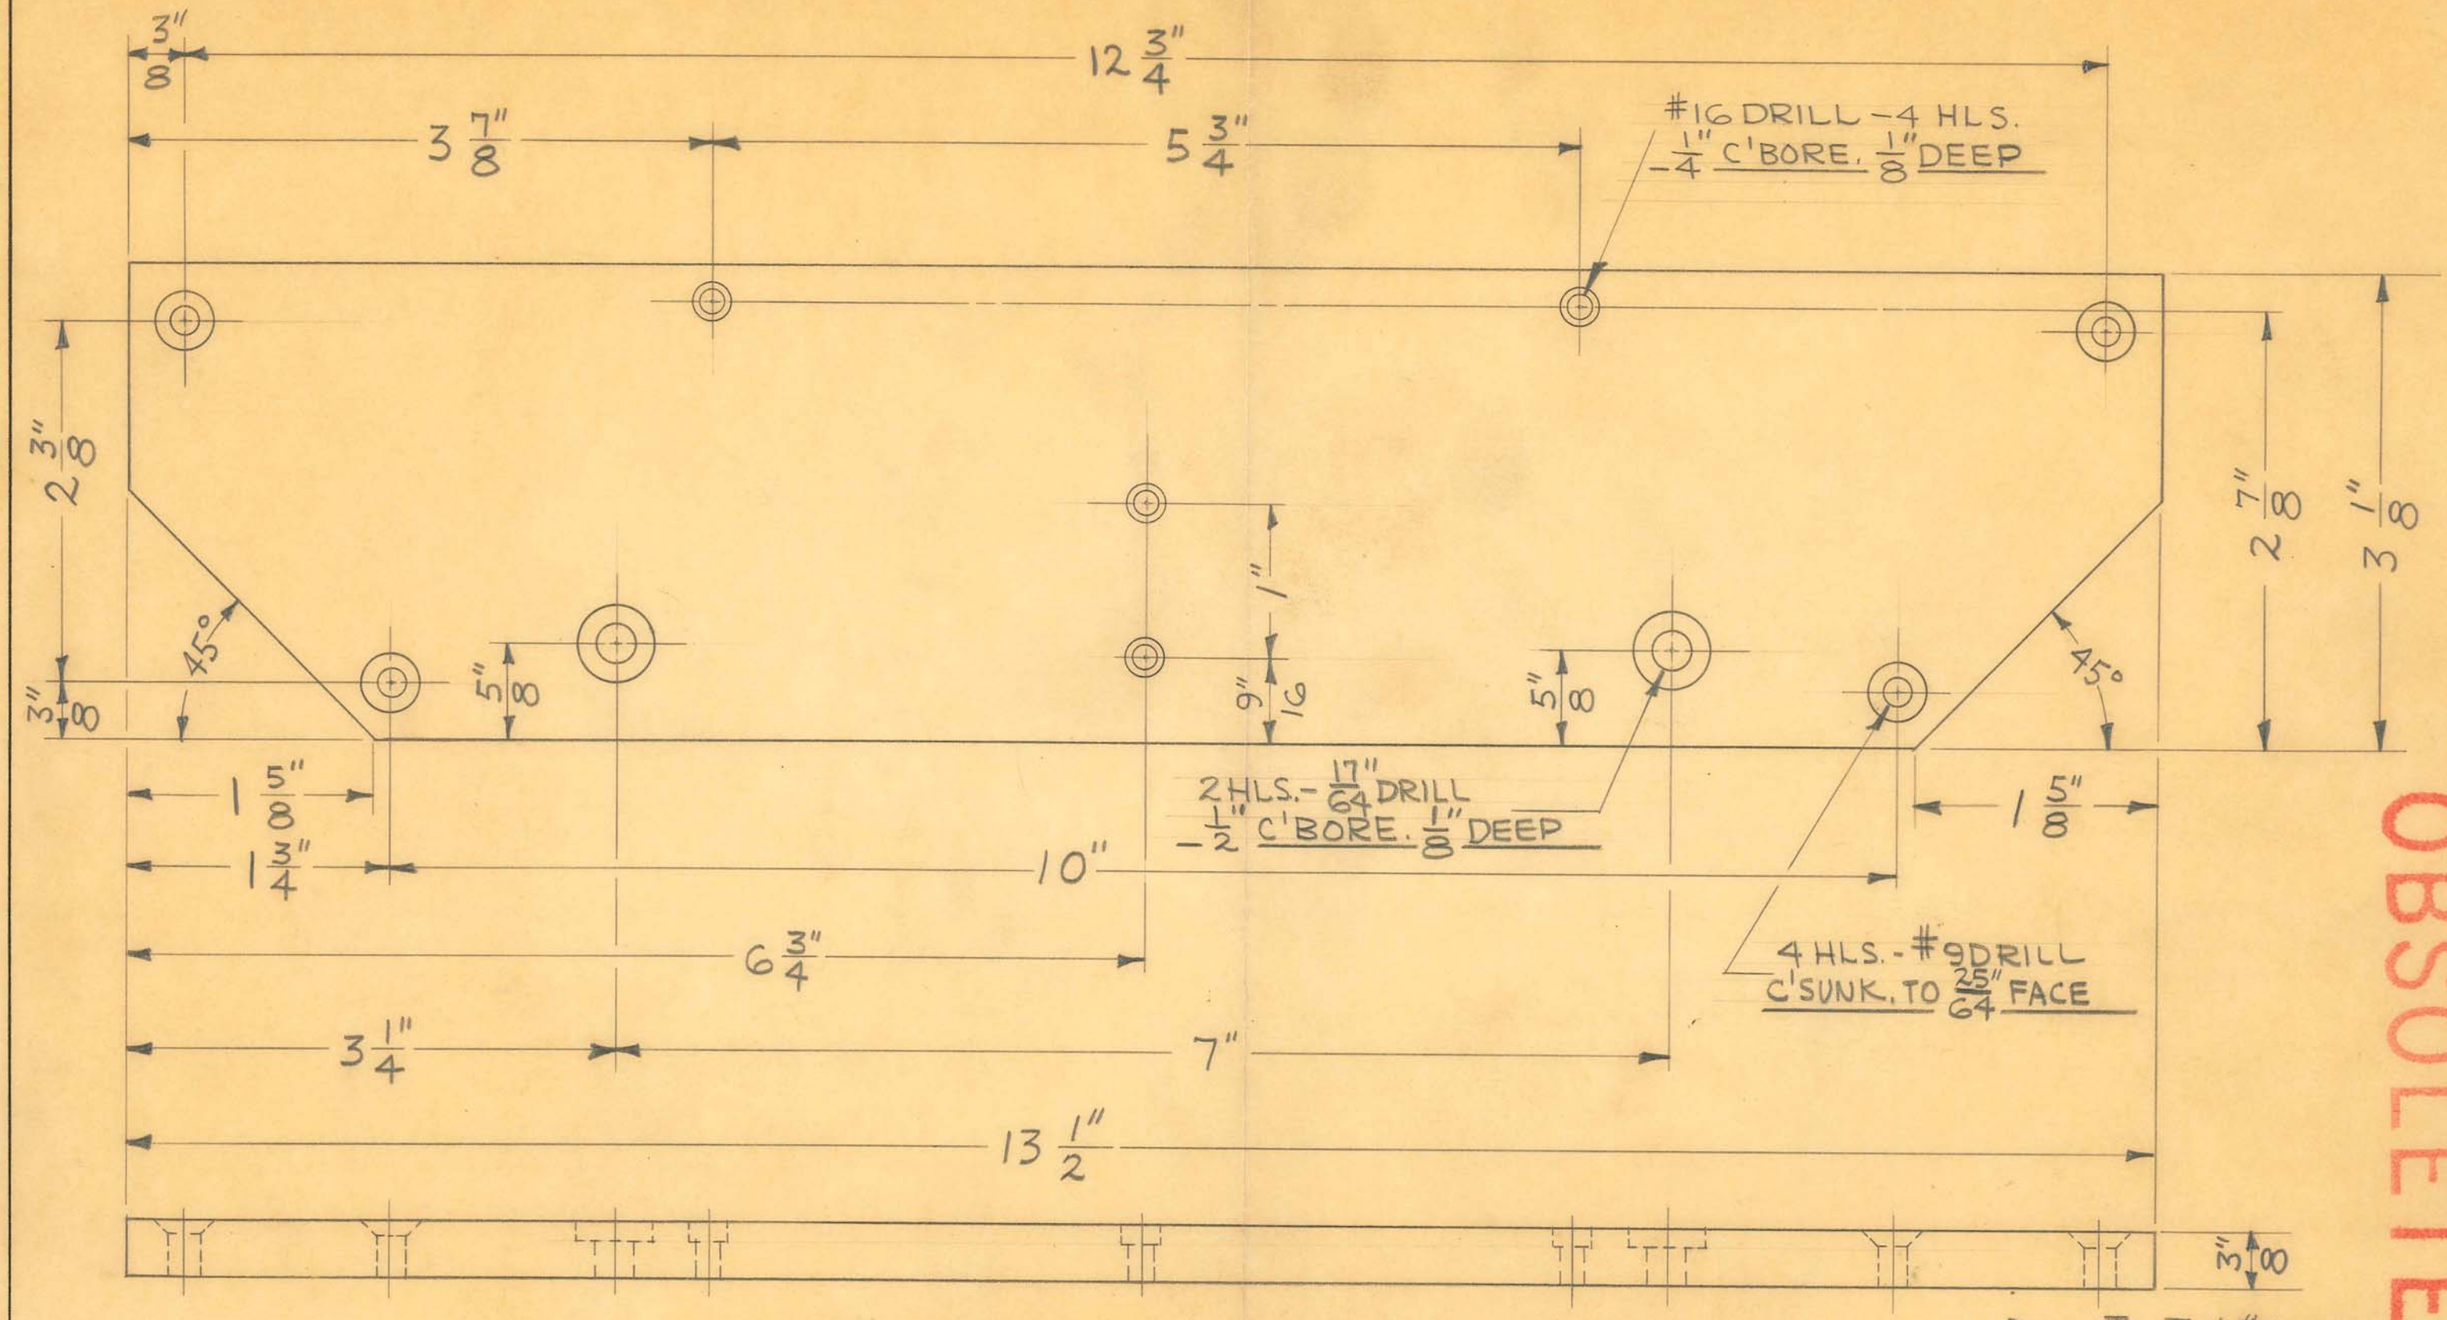

OBSOLETE

DRILL JIG TOOL #9351

1 REQUIRED

SIZE	3/8" SHEET	ISSUE 6-18-47	J.V.W.
KIND	NATURAL	CHANGED	
SHAPE	BAKELITE XX	"	
FINISH		"	
TEMP.		"	
PATT.		"	

TITLE: FISCHER "PRECISION 200" X-RAY H.T. TRANSF. PLUG MTG. BOARD

H. G. FISCHER & CO.
2335 WABANSIA AVE.
CHICAGO, ILL.

CAT. NO.

PART NO. 16890

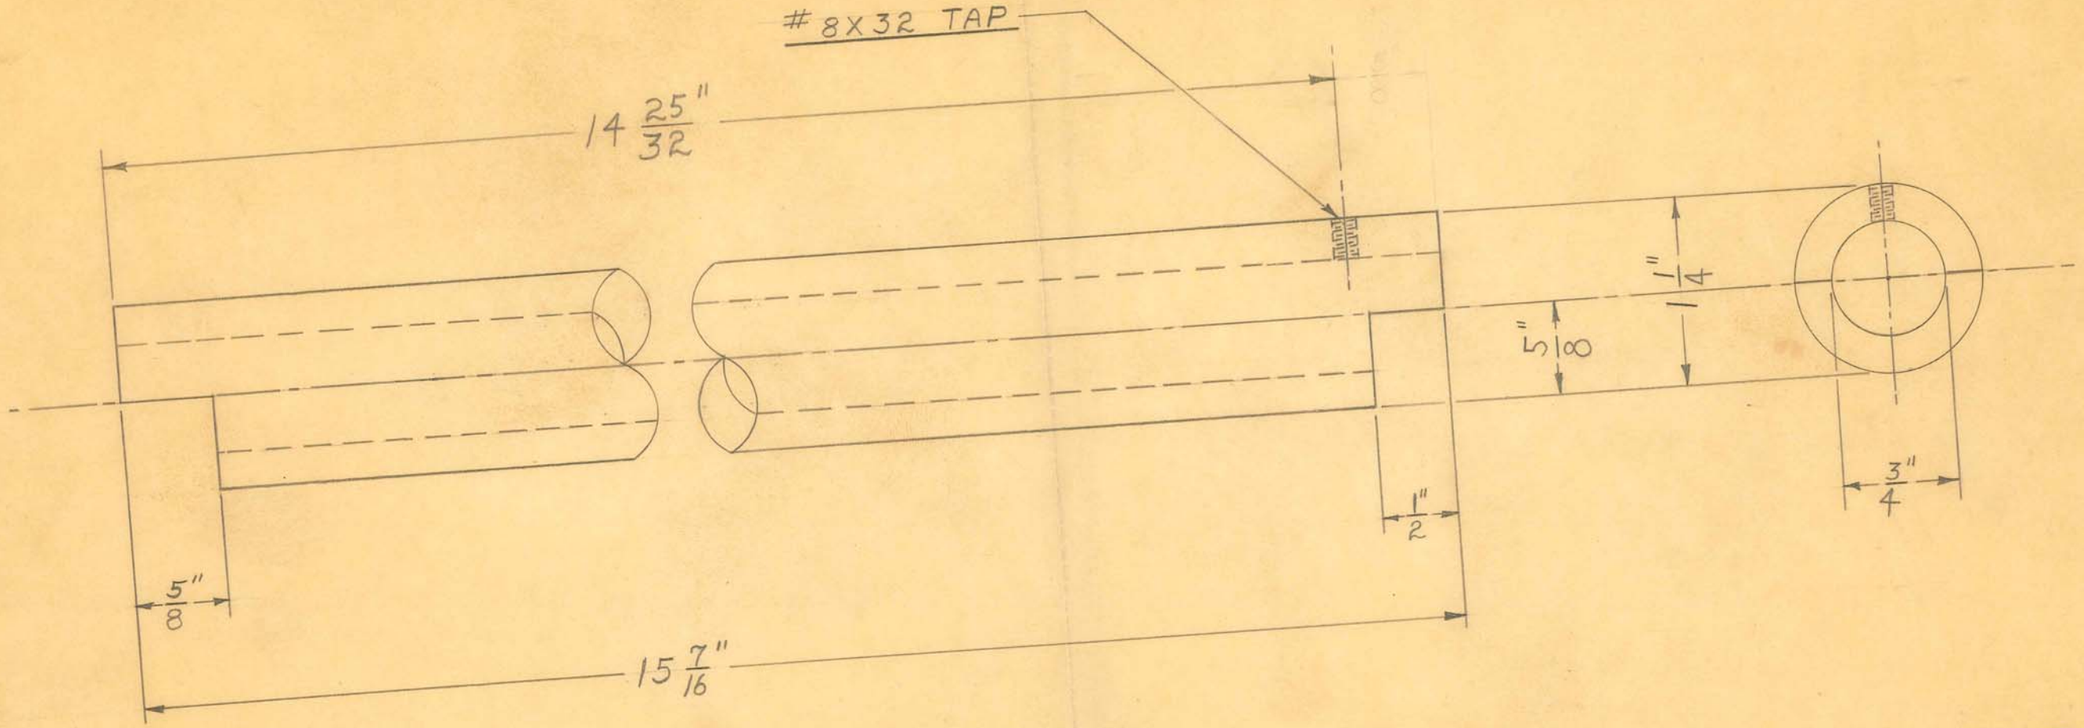

1 REQUIRED

OBSOLETE

DRILL JIG TOOL #9347
MILLING FIXTURE TOOL #9348

1 1/4" O.D. X 3/4" I.D. HARD RUBBER TUBING-

SIZE		ISSUE 6-16-47	W.J.	TITLE: FISCHER "PRECISION 200" X-RAY UN.
KIND		CHANGED		LEAD INSULATING TUBE
SHAPE		"		
FINISH		"		
TEMP.		"		
PATT.		"		

H. G. FISCHER & CO.
2335 WABANSIA AVE.
CHICAGO, ILL.

CAT. NO.

PART NO. 1689

CLAMP CASTING IN LATHE
SET LEAD DISC INTO CASTING.
WITH ROUNDED TOOL - WORK
LEAD INTO ANGLE OF CASTING.

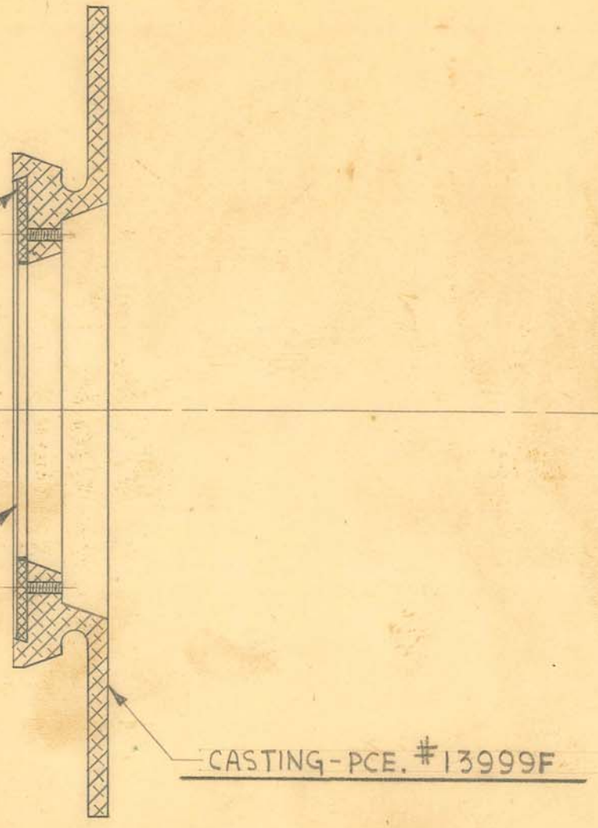

LEAD DISC - PCE. # 14076

CASTING - PCE. # 13999F

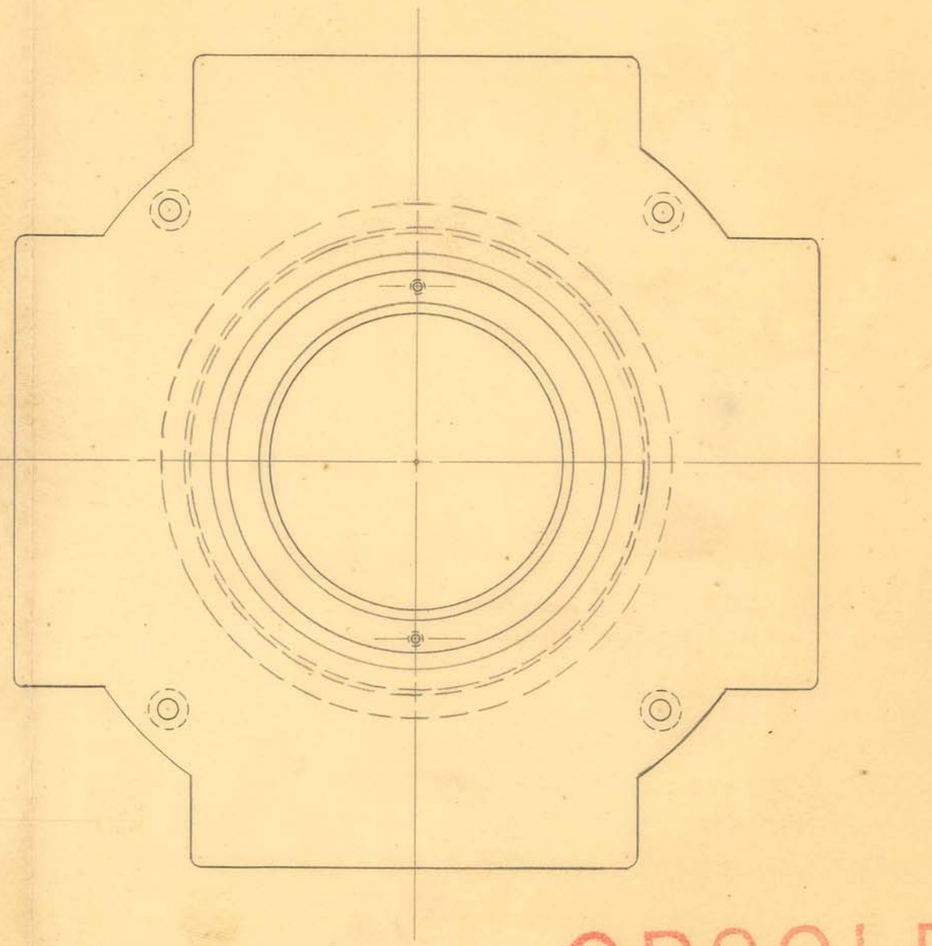

OBSOLETE

1 REQUIRED

SIZE		ISSUE 5-8-41	J.V.W.
KIND		CHANGED	
SHAPE		"	
FINISH		"	
TEMP.		"	

TITLE:
U.S. NAVY X-RAY UNIT
SHUTTER FRAME ADAPTER ASSEMBLY

H. G. FISCHER & CO.
2338 WABANSIA AVE.

CAT. NO.

PART NO. 14077G

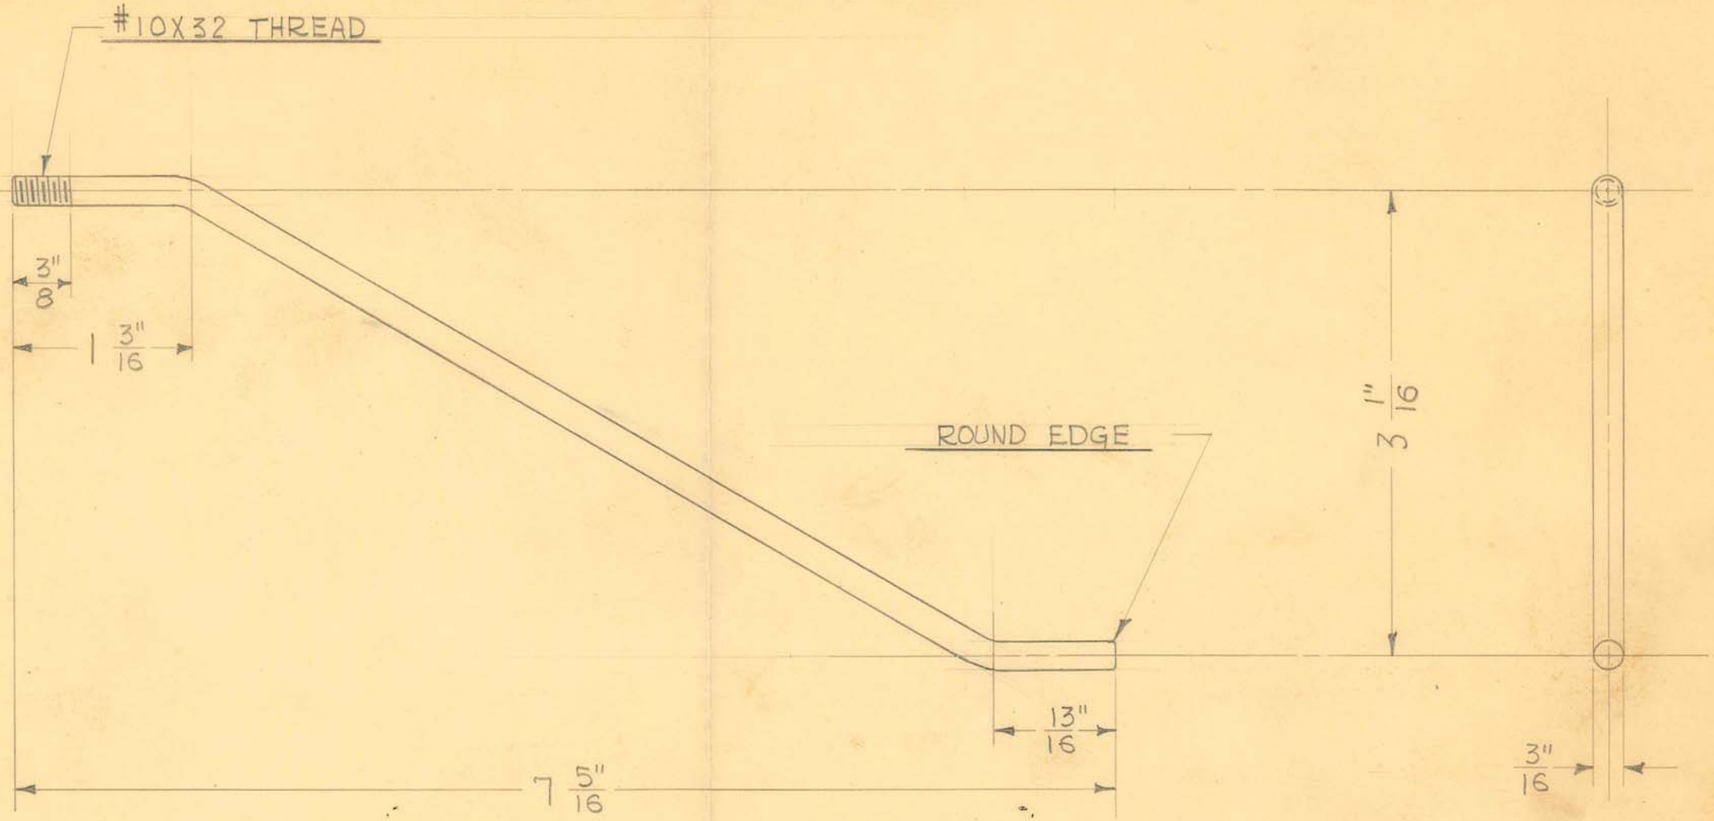

DEVELOPED LENGTH = 8 5" 16

4 REQUIRED

OBSOLETE

SIZE	3/16" DIA.	ISSUE 5-6-41	J.V.W.
KIND	C.R.STEEL	CHANGED	
SHAPE	ROD	"	
FINISH	CAD. #23	"	
TEMP.		"	
PATT.		"	

TITLE:
U.S. NAVY X-RAY UNIT
FLUOROSCOPIC DISTANCE SPACER

H. G. FISCHER & CO.
2338 WABANSIA AVE.
CHICAGO, ILL.

CAT. NO.

PART NO. 14078

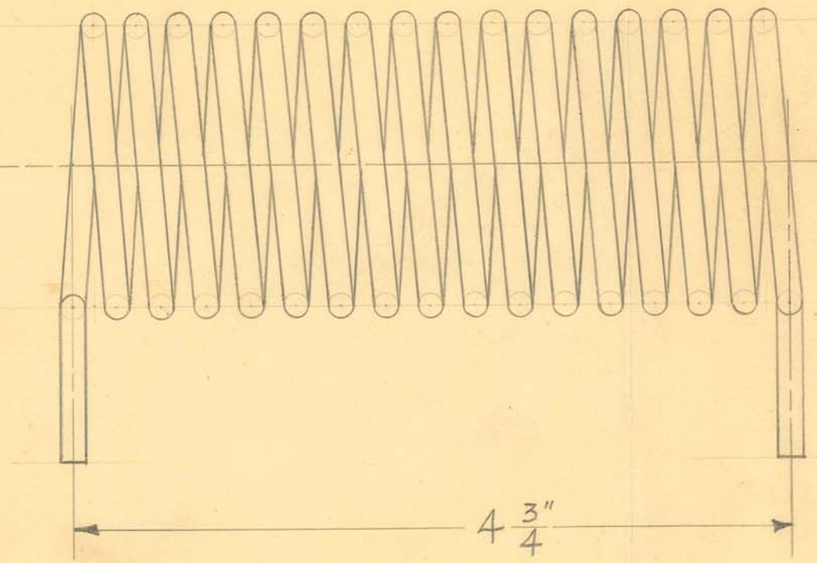

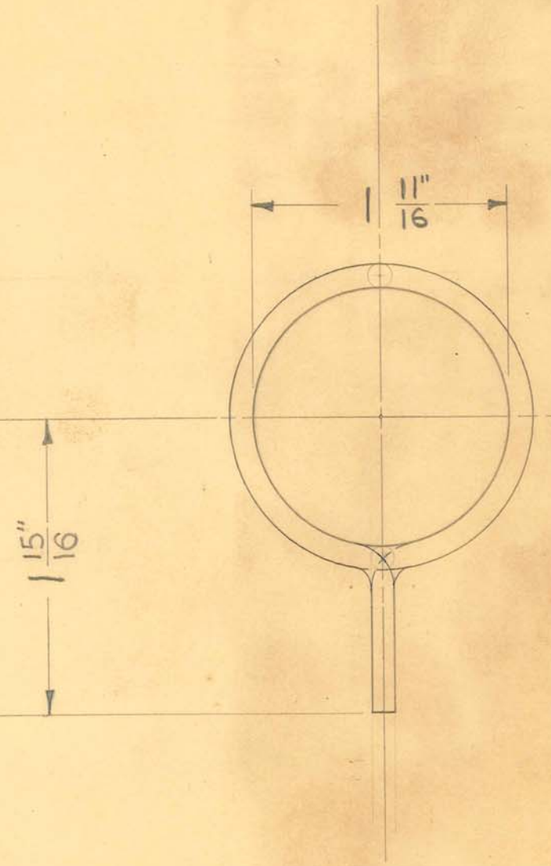

16 TURNS

1 REQUIRED

OBSOLETE

SIZE	#6 BARE	ISSUE 5-20-41	J.V.W.
KIND	COPPER WIRE	CHANGED	
SHAPE		"	
FINISH		"	
TEMP.		"	
PATT.		"	

TITLE: FISCHER MOD. "PB" SHORT WAVE PLATE COIL

H. G. FISCHER & CO.
2338 WABANSIA AVE.
CHICAGO, ILL.

CAT. NO.

PART NO. 14213

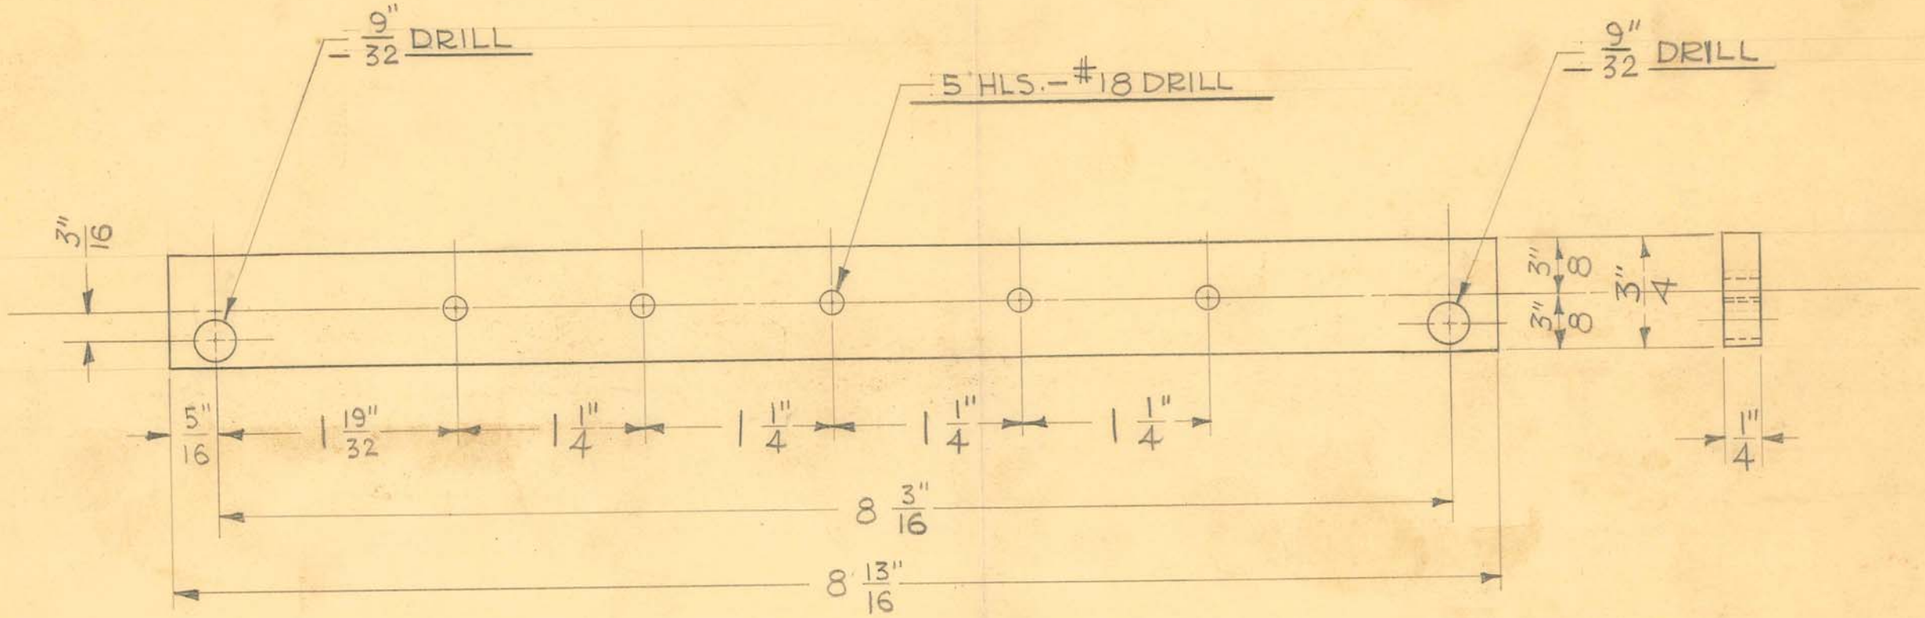

2 REQUIRED

OBSOLETE

SIZE	1/4" SHEET	ISSUE 5-22-41	J.V.W.
KIND	BLK. BAKELITE	CHANGED	
SHAPE		"	
FINISH		"	
TEMP.		"	
PATT.		"	

TITLE: FISCHER MOD, "PB" SHORT WAVE TRANSFORMER TERMINAL BOARD

H. G. FISCHER & CO.
2335 WABANSIA AVE.
CHICAGO. ILL.

CAT. NO.

PART NO. 14221

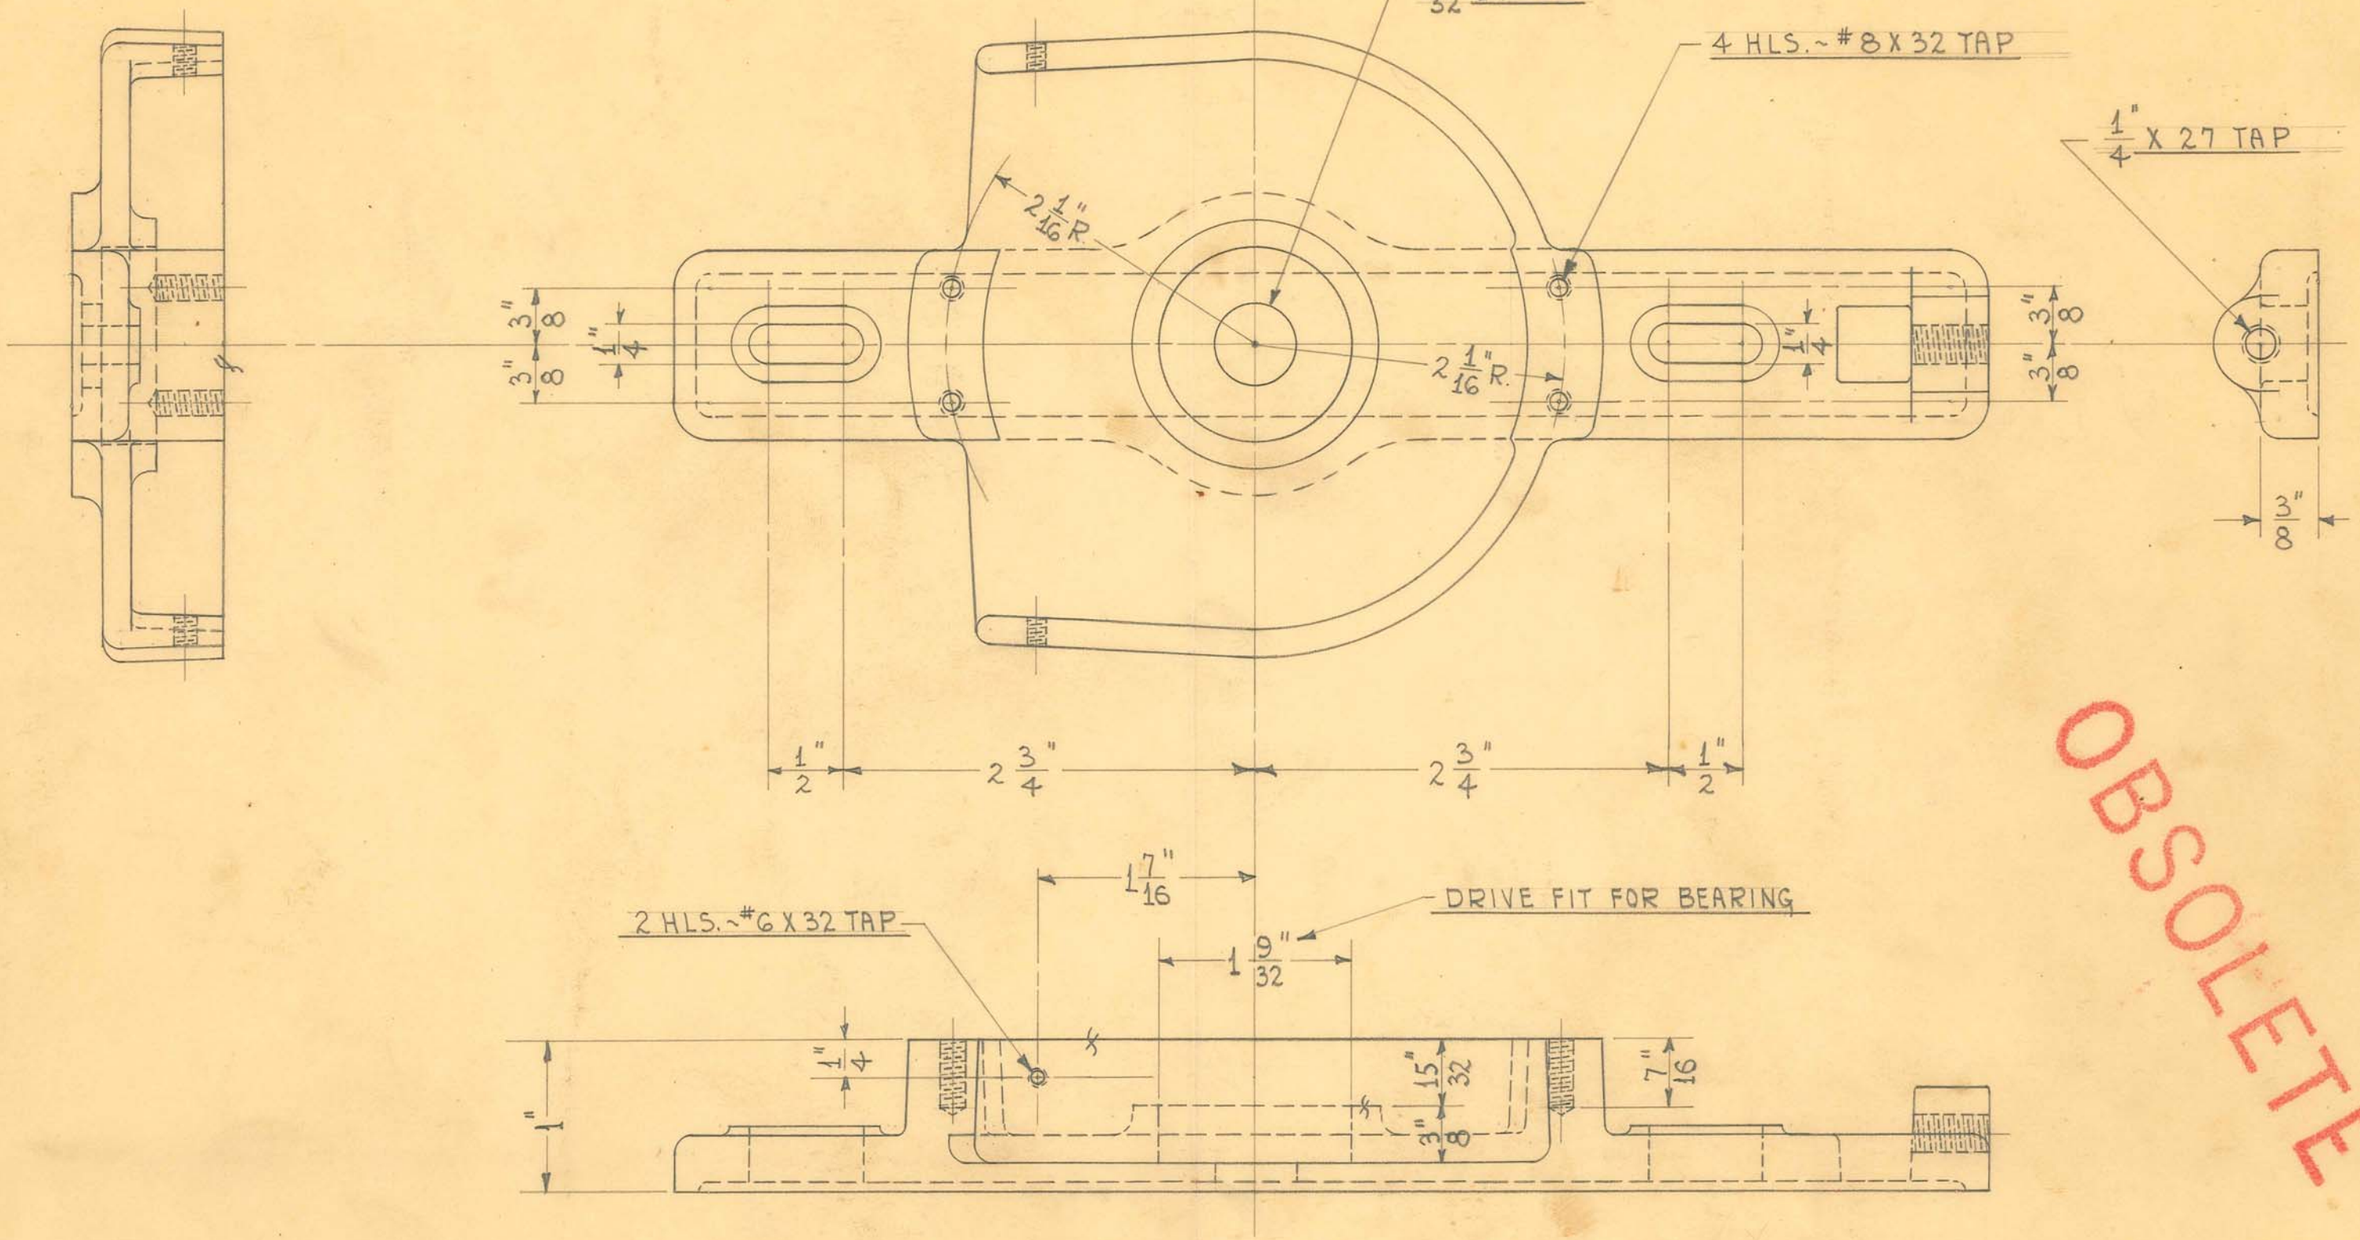

1 REQUIRED

SIZE	IRON	ISSUE 12-16-43	HE	
KIND	CASTING	CHANGED		
SHAPE		"		
FINISH	PAINTED	"		
TEMP.		"		
PATT.	1902	"		

TITLE: FISCHER HAND CRANK "NTM" X-RAY UNIT-
LOWER SPROCKET SUPPORT

H. G. FISCHER & CO.
2335 WABANSIA AVE.
CHICAGO, ILL.

CAT. NO.

PART NO. 14238F

OBSOLETE

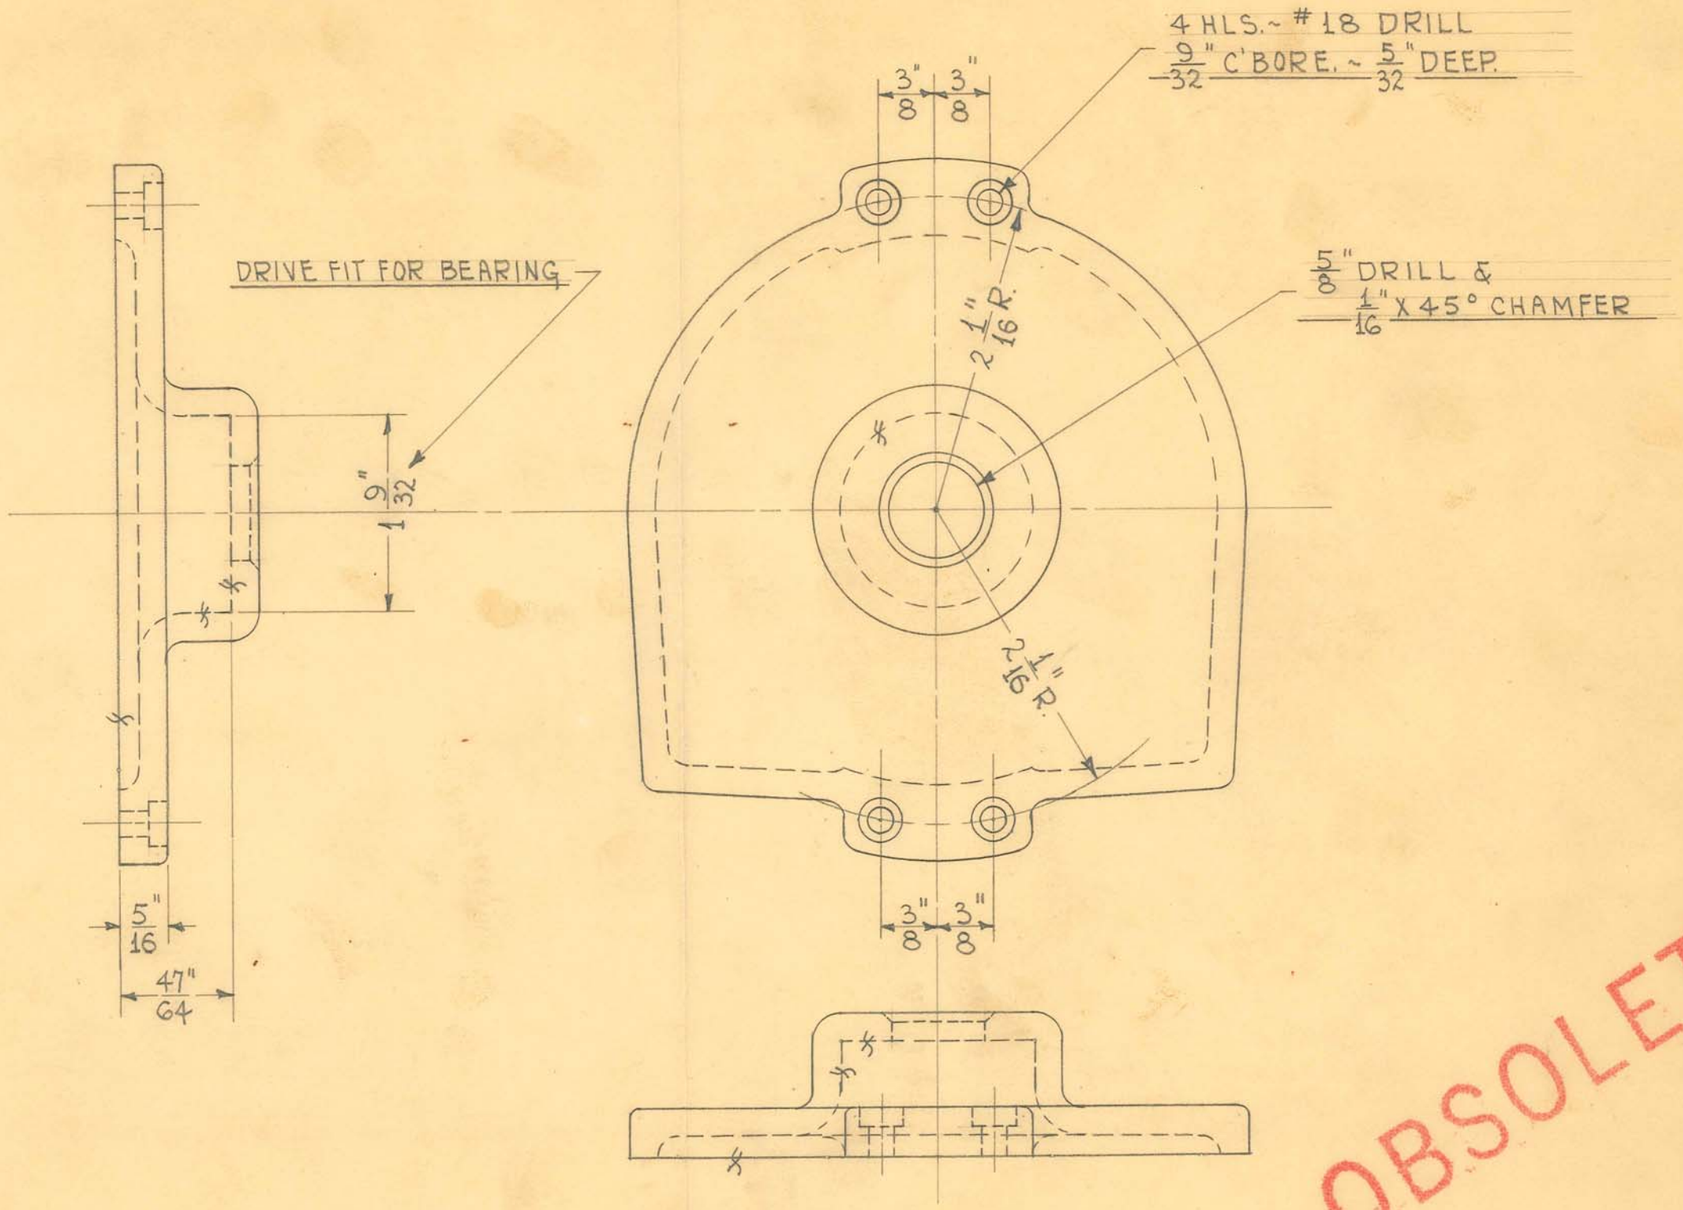

1 REQUIRED

OBSOLETE

SIZE	IRON	ISSUE 12-16-43	HE.
KIND	CASTING	CHANGED	
SHAPE		"	
FINISH	PAINTED	"	
TEMP.		"	
PATT.	1903	"	

TITLE: FISCHER HAND CRANK "NTM" X-RAY UNIT-
LOWER SPROCKET SUPPORT CAP

H. G. FISCHER & CO.
2338 WABANSIA AVE.
CHICAGO, ILL.

CAT. NO.

PART NO. 14238 1/2 F

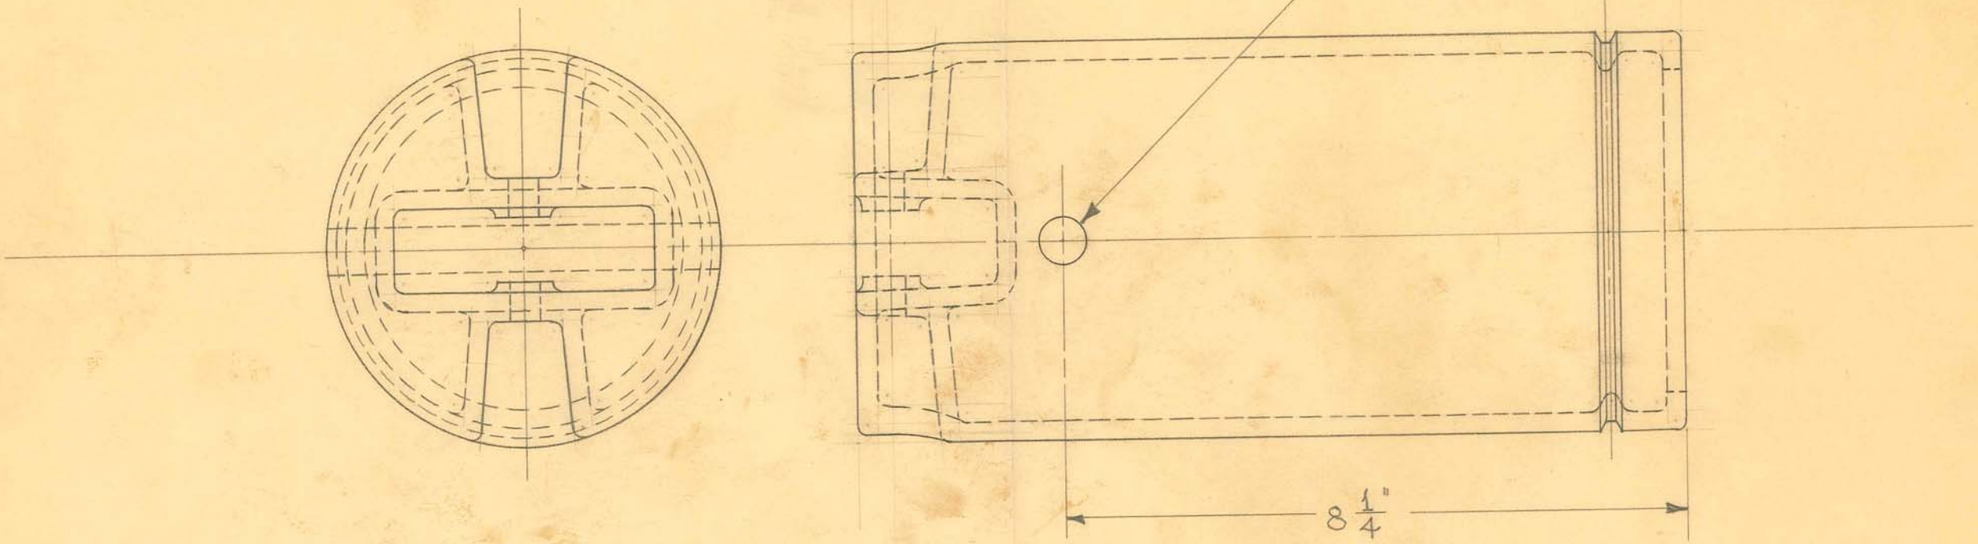

1 REQUIRED

SCALE: 1/2" = 1"

NOTE:

FILL WITH WITH LEAD SO THAT TOTAL WEIGHT AFTER DRILLING 5/8" HOLE IS 86 LBS.

OBSOLETE

SIZE		ISSUE 12-29-43	HE.	TITLE: FISCHER HAND CRANK "NTM" X-RAY UNIT~ COUNTERWEIGHT ASSEMBLY
KIND		CHANGED		
SHAPE		"		
FINISH		"		
TEMP.		"		
PATT.		"		

H. G. FISCHER & CO.
2335 WABANSIA AVE.
CHICAGO, ILL.

CAT. NO.

PART NO. 14240G

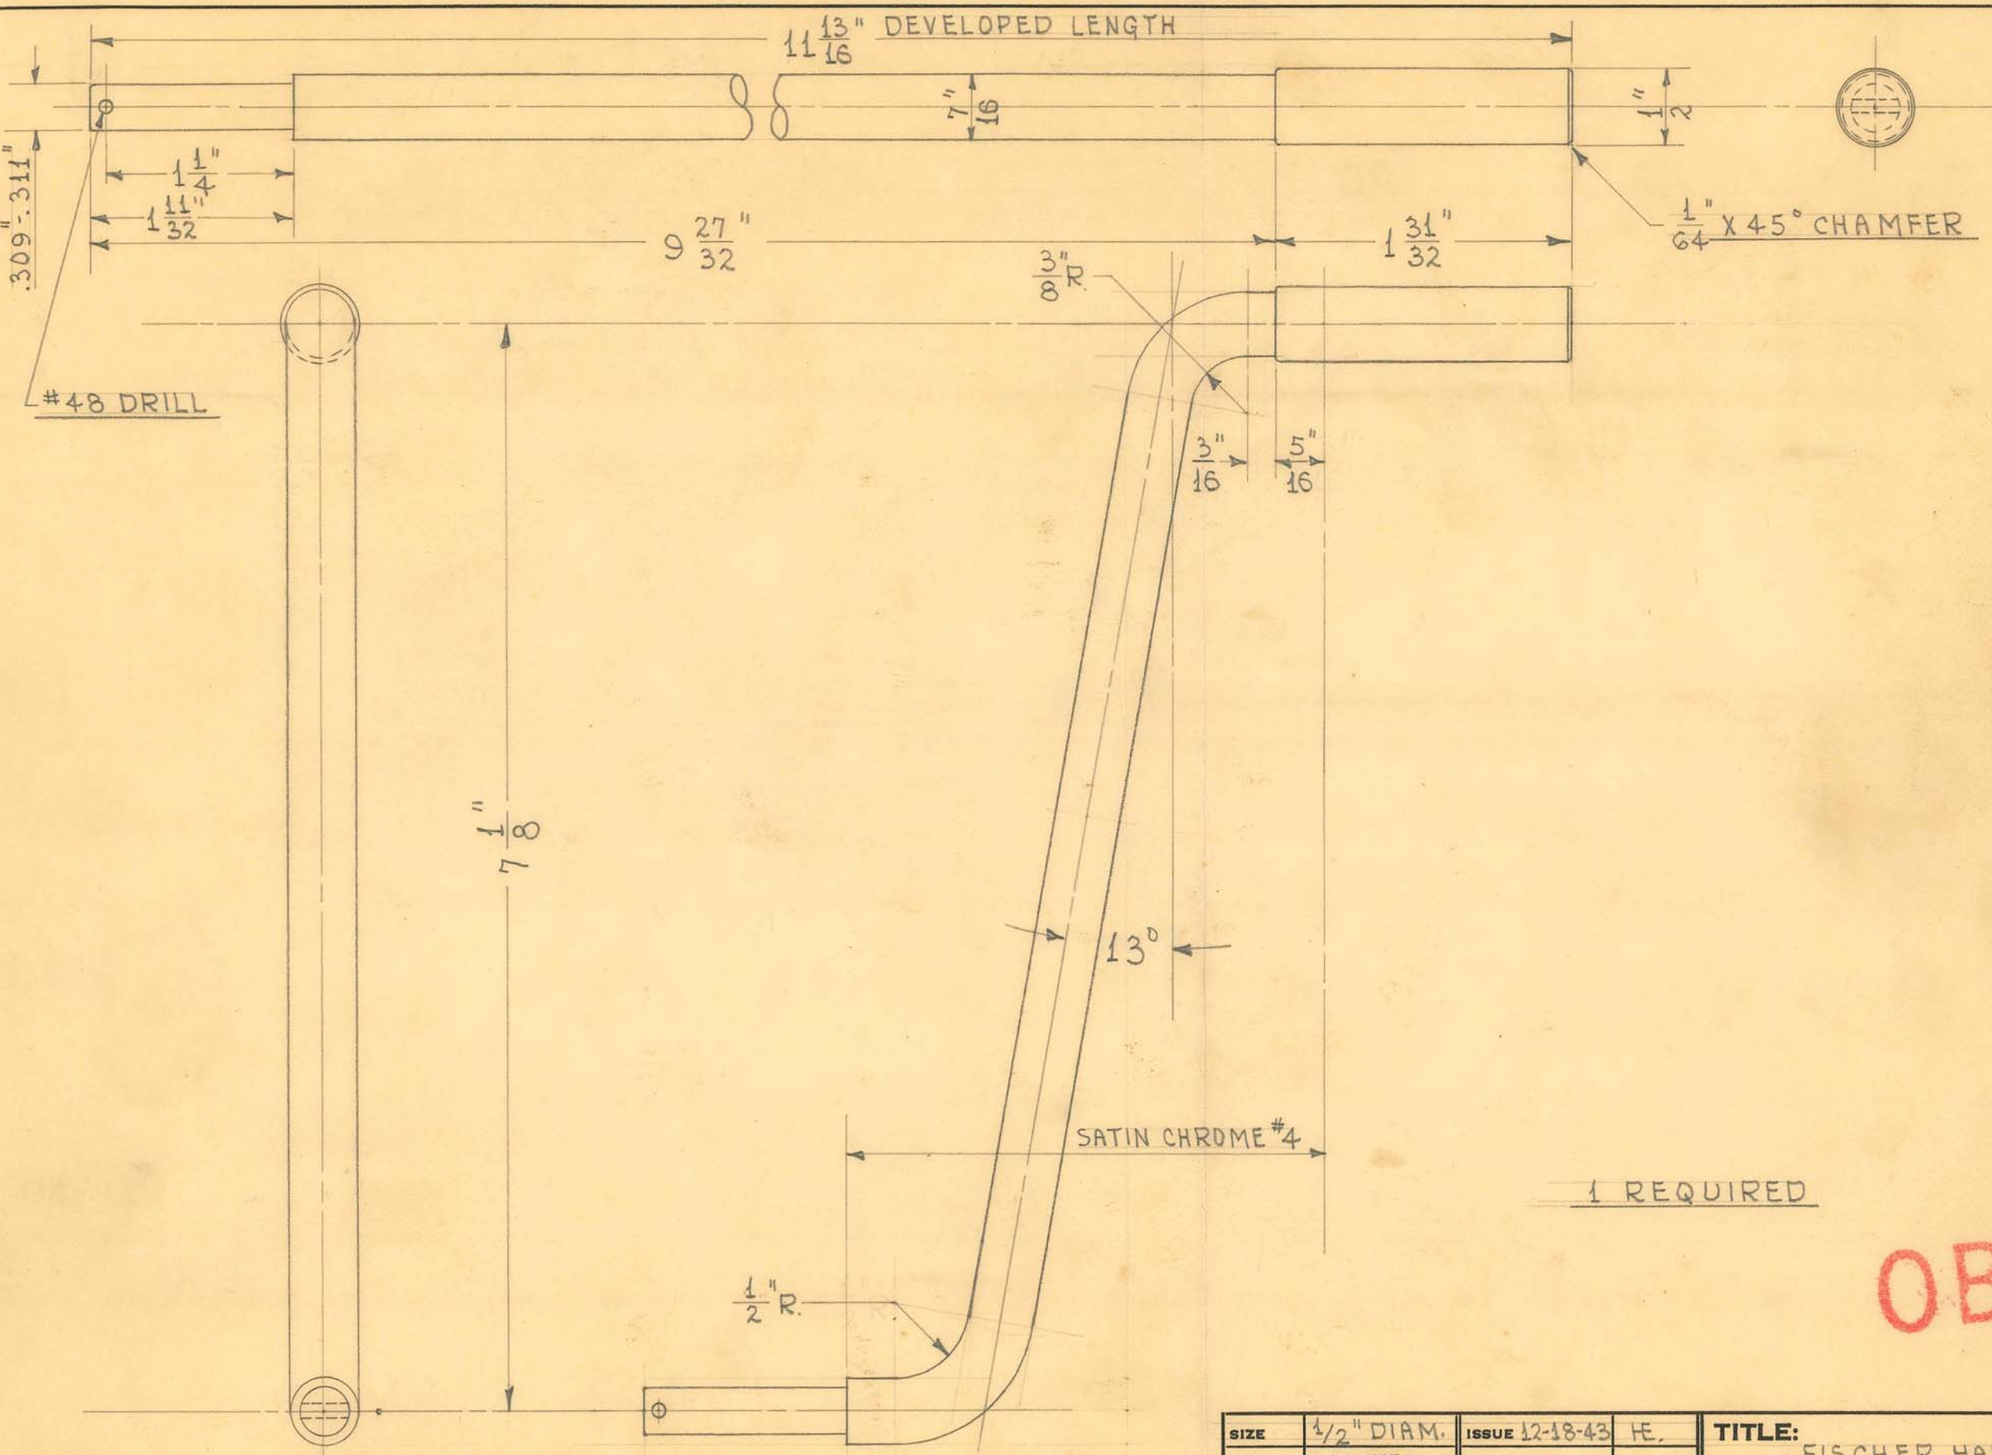

1 REQUIRED

OBSOLETE

SIZE	1/2" DIAM.	ISSUE 12-18-43	HE.
KIND	C.R. STEEL	CHANGED	
SHAPE	ROD	"	
FINISH	SEE ABOVE	"	
TEMP.		"	
PATT.		"	

TITLE: FISCHER HAND CRANK "NTM" X-RAY UNIT-
CRANK HANDLE

H. G. FISCHER & CO.
2338 WABANSIA AVE.
CHICAGO, ILL.

CAT. NO.

PART NO. 14244 1/2

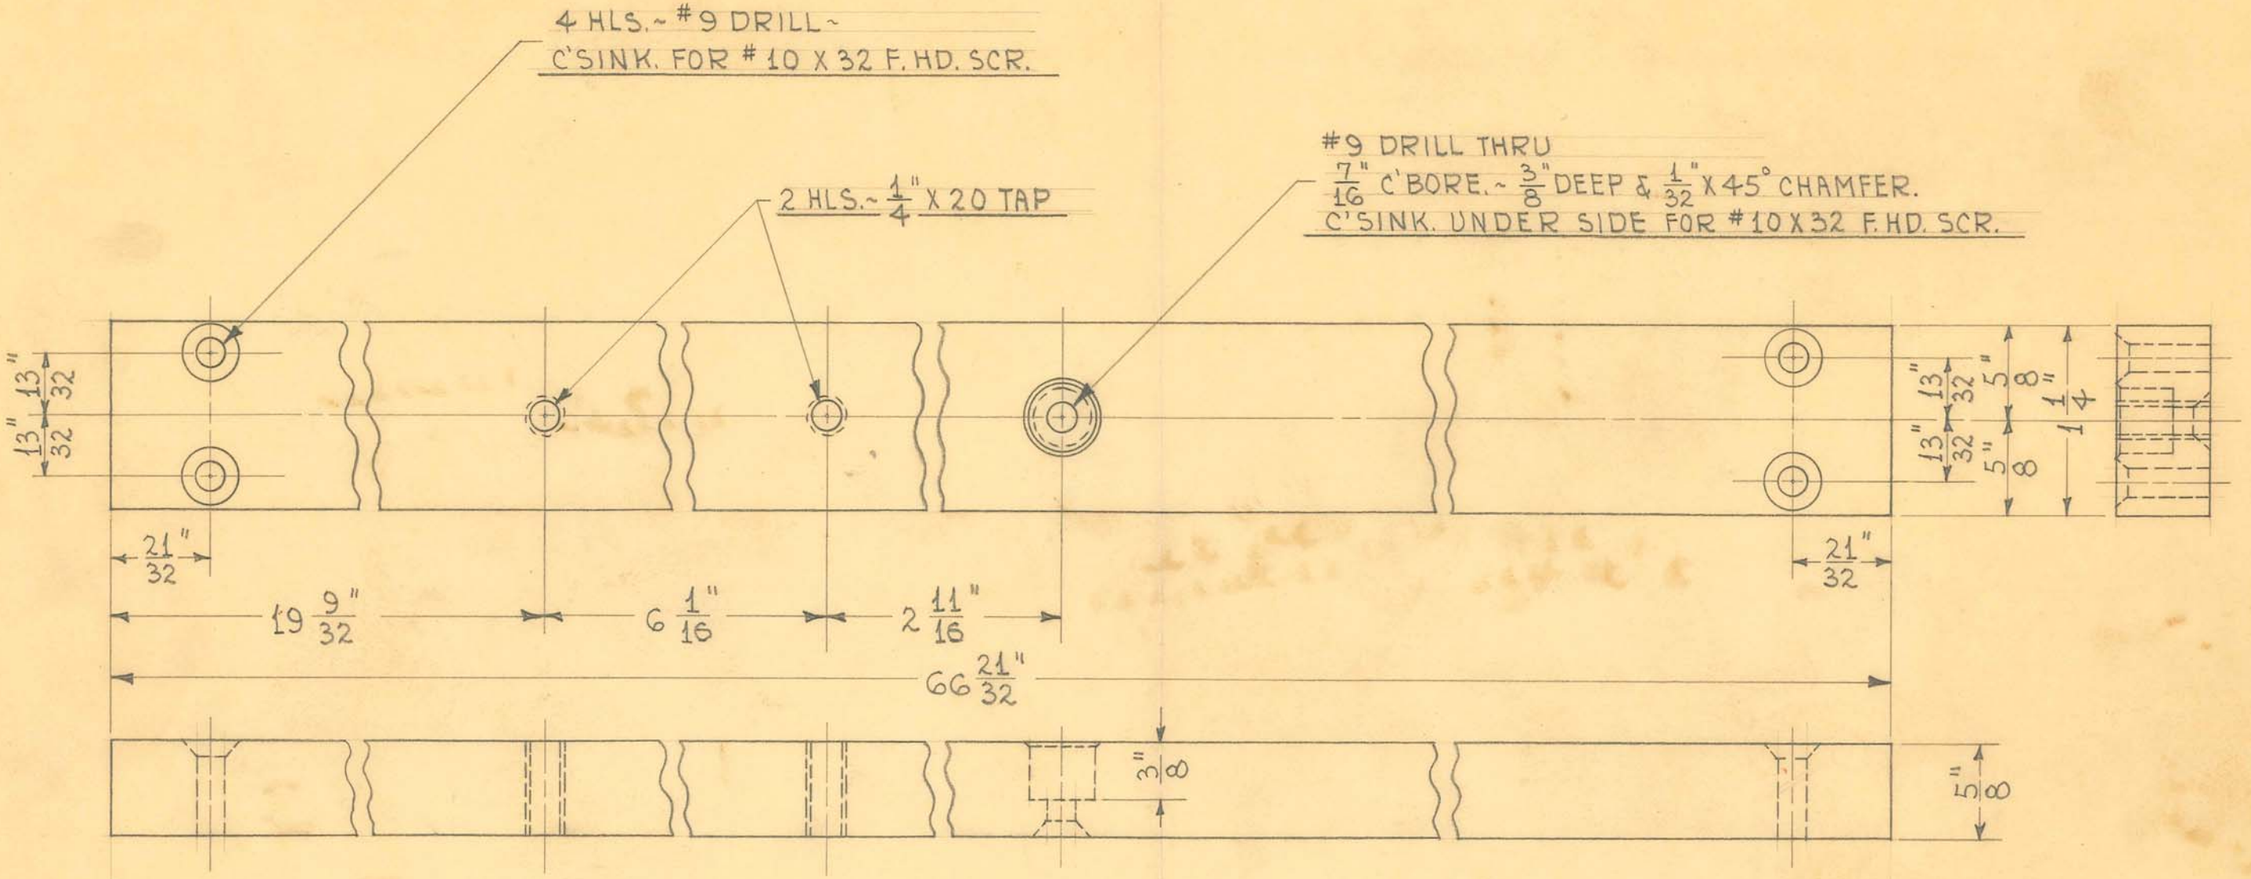

1 REQUIRED

OBSOLETE

* SATIN CHROME #4, SIDES
FACES & ENDS ~ PAINTED

SIZE	5/8" X 1 1/4"	ISSUE 12-17-43	HE.	TITLE: FISCHER HAND CRANK "NTM" X-RAY UNIT- UPRIGHT GUIDE BAR
KIND	C.R. STEEL	CHANGED		
SHAPE	BAR	"		
FINISH	*	"		
TEMP.		"		
PATT.		"		

H. G. FISCHER & CO.
2335 WABANSIA AVE.
CHICAGO, ILL.

CAT. NO.

PART NO. 14246 1/2

SATIN CHROME #4 - 4 STRIPS.

8 HLS. ~ #9 DRILL - C'SUNK. FOR #10X32 F. HD. SCREW.

8 HLS. ~ #10X32 TAP

CUT 4 SETS (2 EACH) OF "V" GROOVES $\frac{1}{32}$" DEEP WITH SPECIAL TOOL, $\frac{3}{8}$" EITHER SIDE OF CENTER OF C'SUNK. HOLES AS SHOWN.

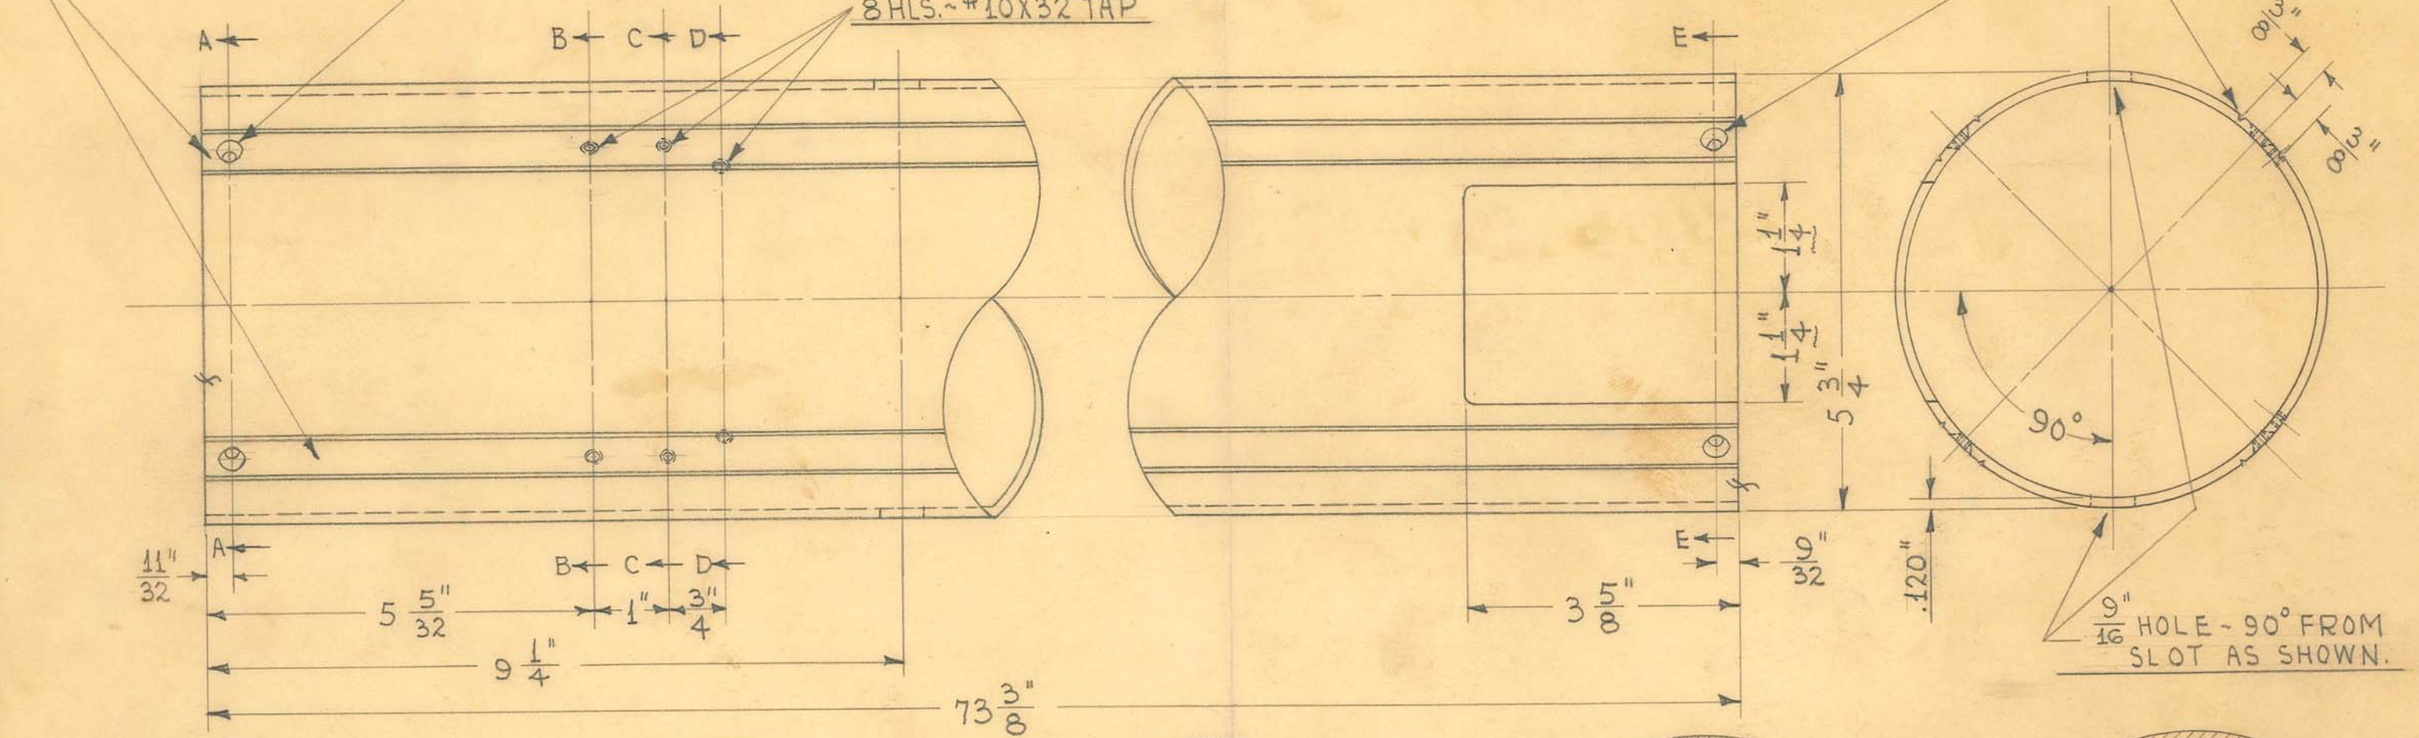

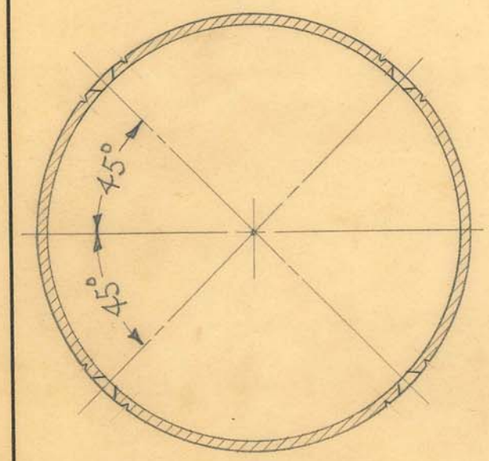

SECTION THRU A-A

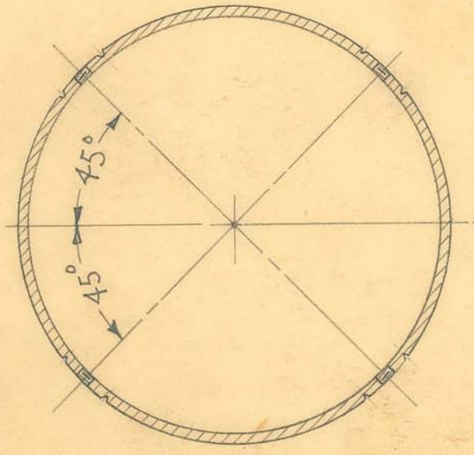

SECTION THRU B-B

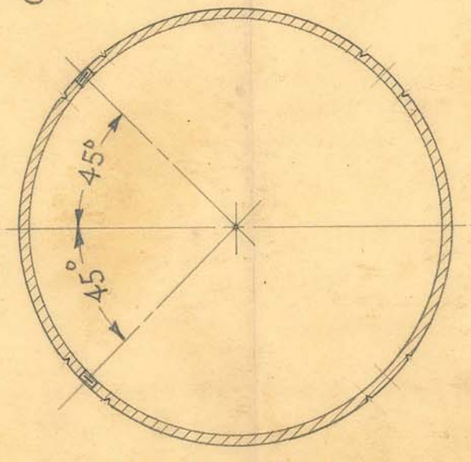

SECTION THRU C-C

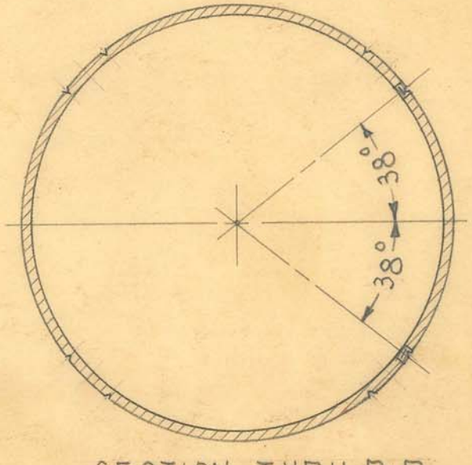

SECTION THRU D-D

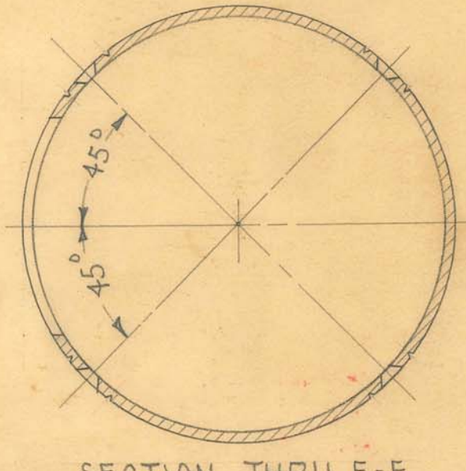

SECTION THRU E-E

* SATIN CHROME #4 AS SHOWN ABOVE & PAINTED.

$5\frac{3}{4}$" O.D. X #11GA. (.120") WALL SHELBY SEAMLESS STEEL TUBING

1 REQUIRED

SCALE: $\frac{1}{2}$" = 1"

SIZE	FROM 14301	ISSUE 12-20-43	HE.
KIND		CHANGED	
SHAPE		"	
FINISH	*	"	
TEMP.		"	
PATT.		"	

TITLE: FISCHER HAND CRANK "NTM" X-RAY UNIT ~ UPRIGHT TUBE

OBSOLETE

H. G. FISCHER & CO. 2335 WABANSIA AVE. CHICAGO, ILL.

CAT. NO.

PART NO. 14247

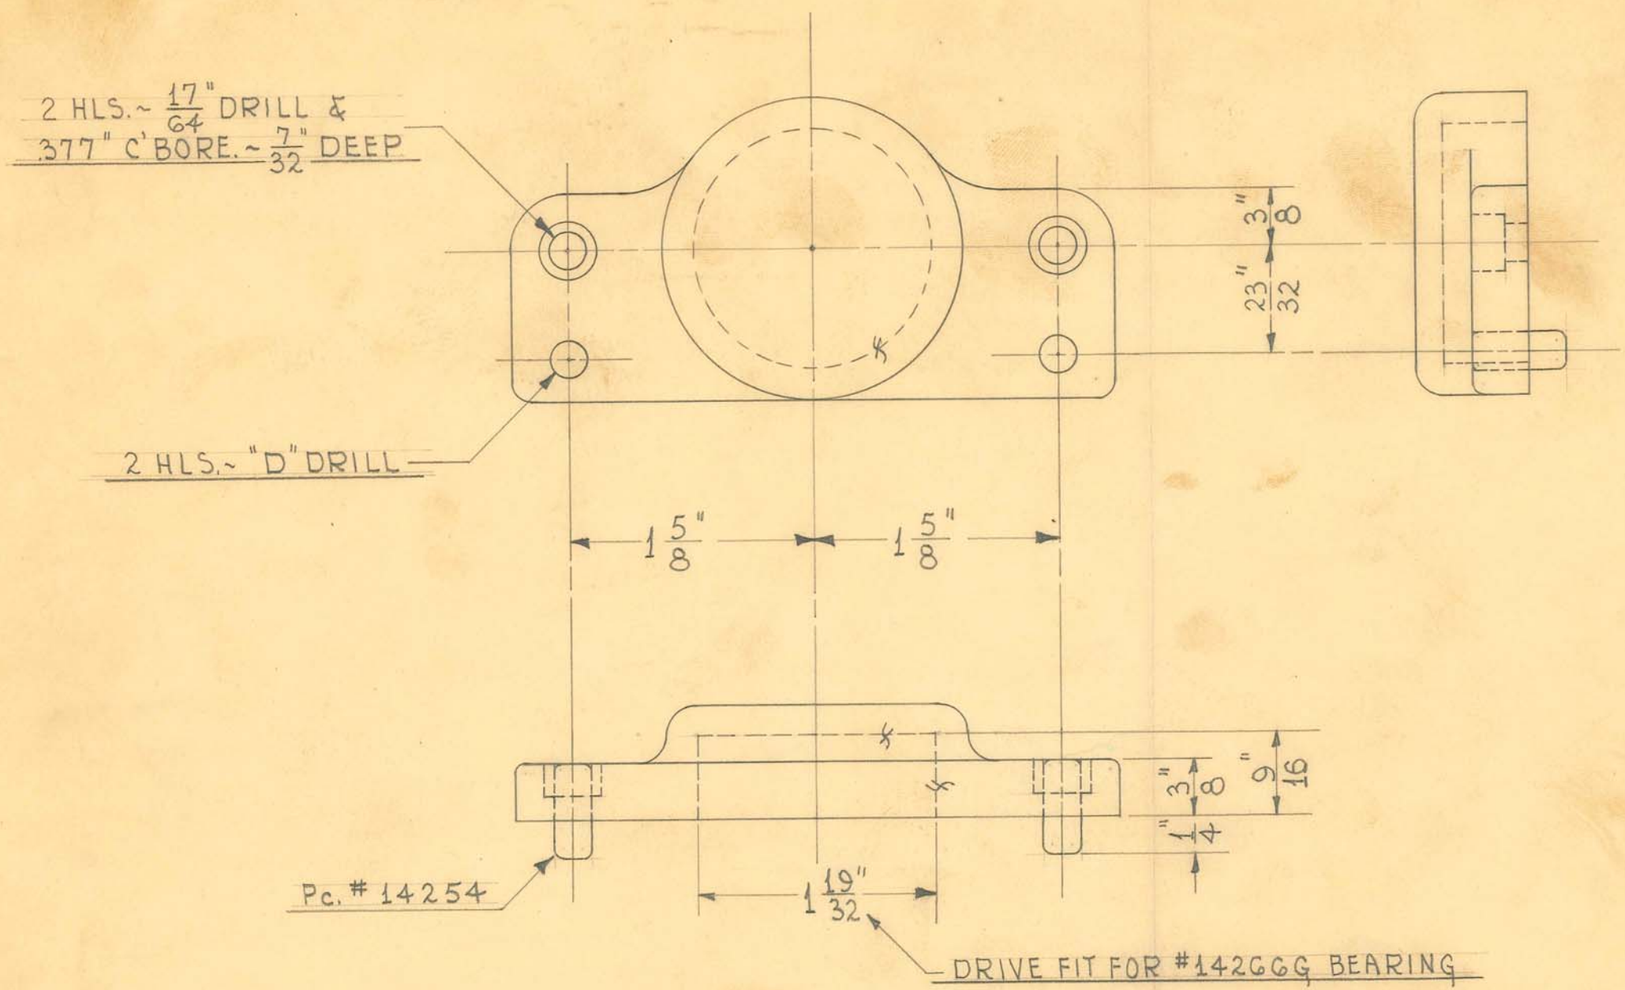

1 REQUIRED

OBSOLETE

SIZE		ISSUE 6-26-42	HE.	TITLE: FISCHER HAND CRANK "NTM" X-RAY UNIT- THRUST BEARING SUPPORT-FRONT
KIND	IRON CASTING	CHANGED		
SHAPE		"		
FINISH	PAINTED	"		
TEMP.		"		
PATT.	1898	"		

H. G. FISCHER & CO. 2338 WABANSIA AVE. CHICAGO, ILL.	CAT. NO.	PART NO. 14252G

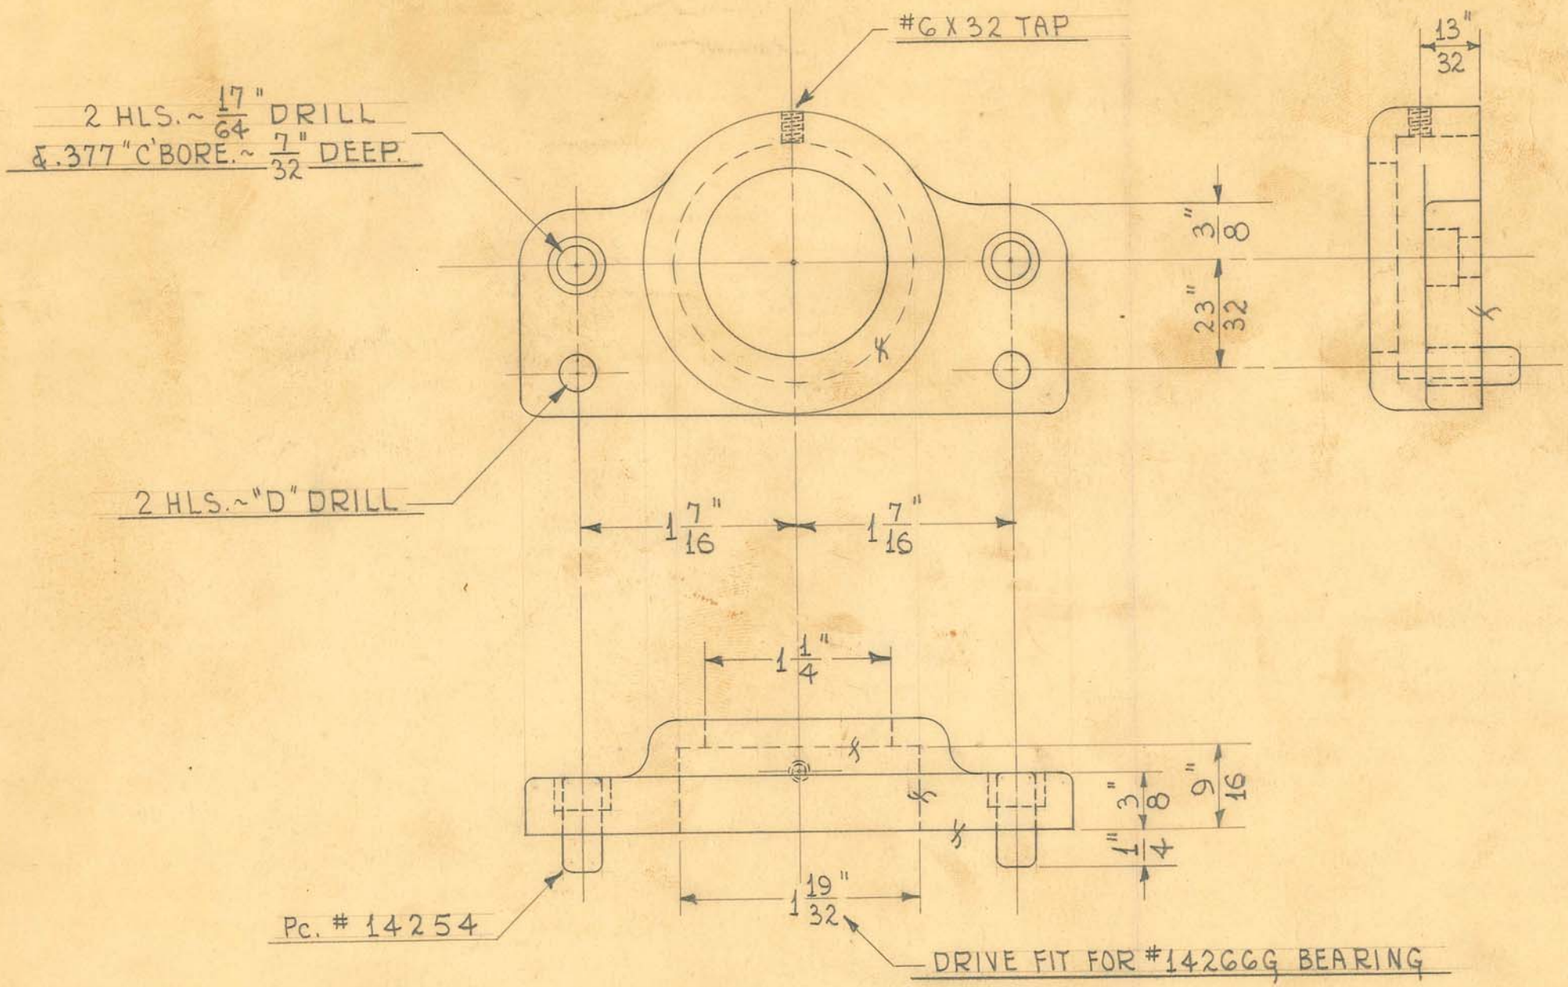

1 REQUIRED

OBSOLETE

SIZE		ISSUE 6-26-42	HE
KIND	IRON CASTING	CHANGED	
SHAPE		"	
FINISH	PAINTED	"	
TEMP.		"	
PATT.	1899	"	

TITLE: FISCHER HAND CRANK "NTM" X-RAY UNIT - THRUST BEARING SUPPORT - REAR

H. G. FISCHER & CO.
2335 WABANSIA AVE.
CHICAGO, ILL.

CAT. NO.

PART NO. 14253G

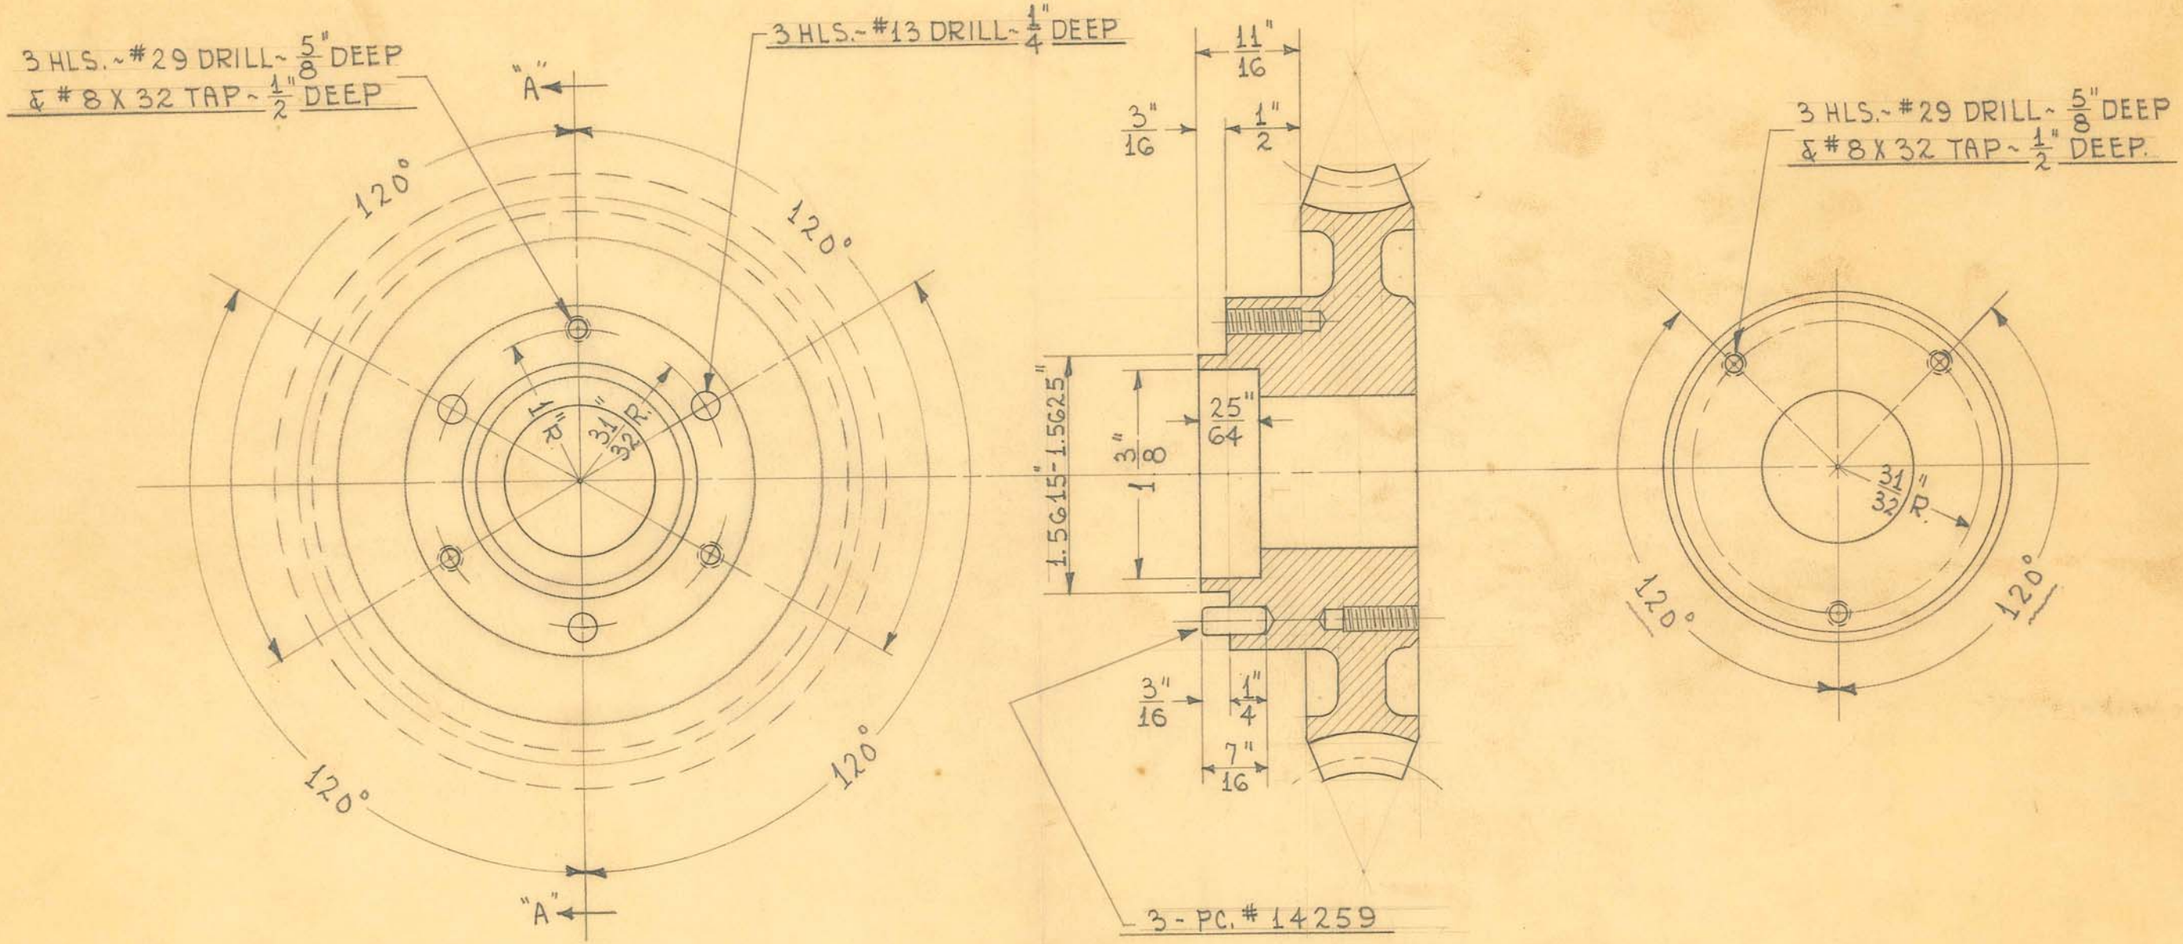

3 - PC. # 14259

SECTION "A"-"A"

1 REQUIRED

OBSOLETE

SIZE	FROM 14258	ISSUE 1-7-44	HE.
KIND		CHANGED	
SHAPE		"	
FINISH	WH. CHR. #3	"	
TEMP.		"	
PATT.		"	

TITLE: FISCHER HAND CRANK "NTM" X-RAY UNIT~ WORM WHEEL

H. G. FISCHER & CO.
2338 WABANSIA AVE.
CHICAGO, ILL.

CAT. NO.

PART NO. 14258G

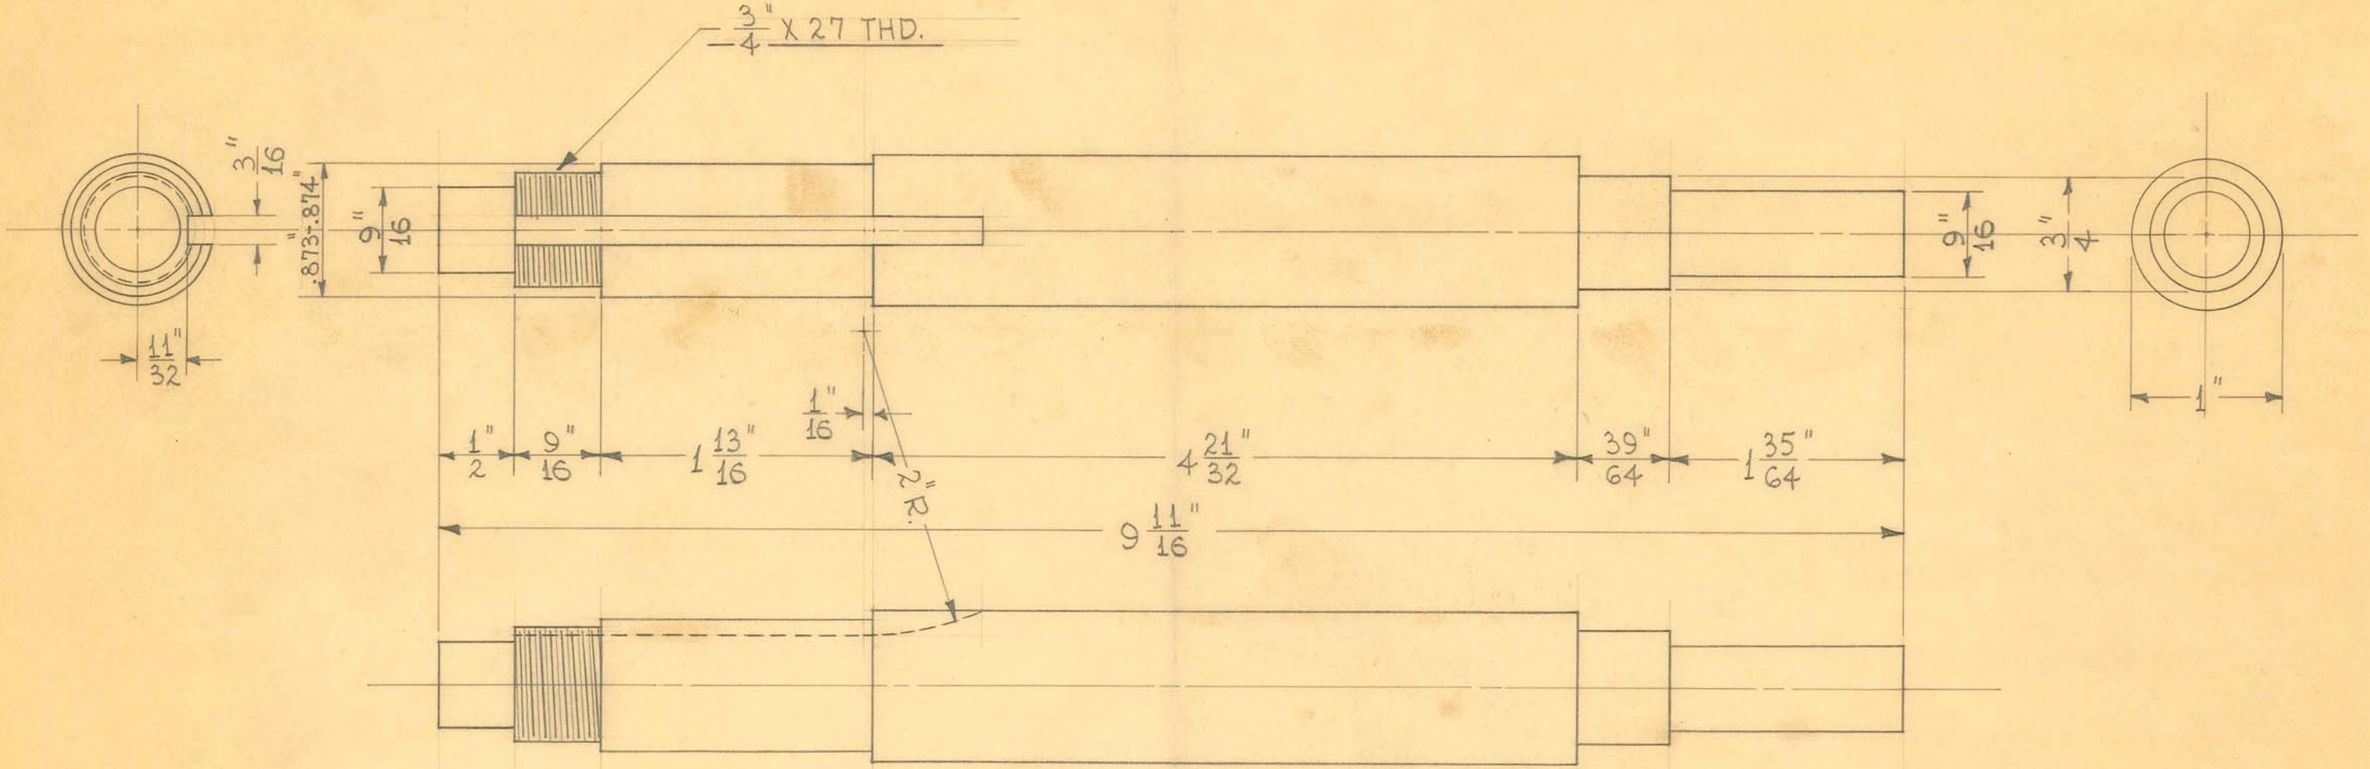

1 REQUIRED

OBSOLETE

* BLACK #80 ~ 1" DIAMETER ONLY.

SIZE	1" DIAM.	ISSUE 1-3-44	HE.
KIND	C.R. STEEL	CHANGED	
SHAPE	ROD	"	
FINISH	*	"	
TEMP.		"	
PATT.		"	

TITLE: FISCHER HAND CRANK "NTM" X-RAY UNIT~ WORM SHAFT

H. G. FISCHER & CO.
2335 WABANSIA AVE.
CHICAGO, ILL.

CAT. NO.

PART NO. 14261

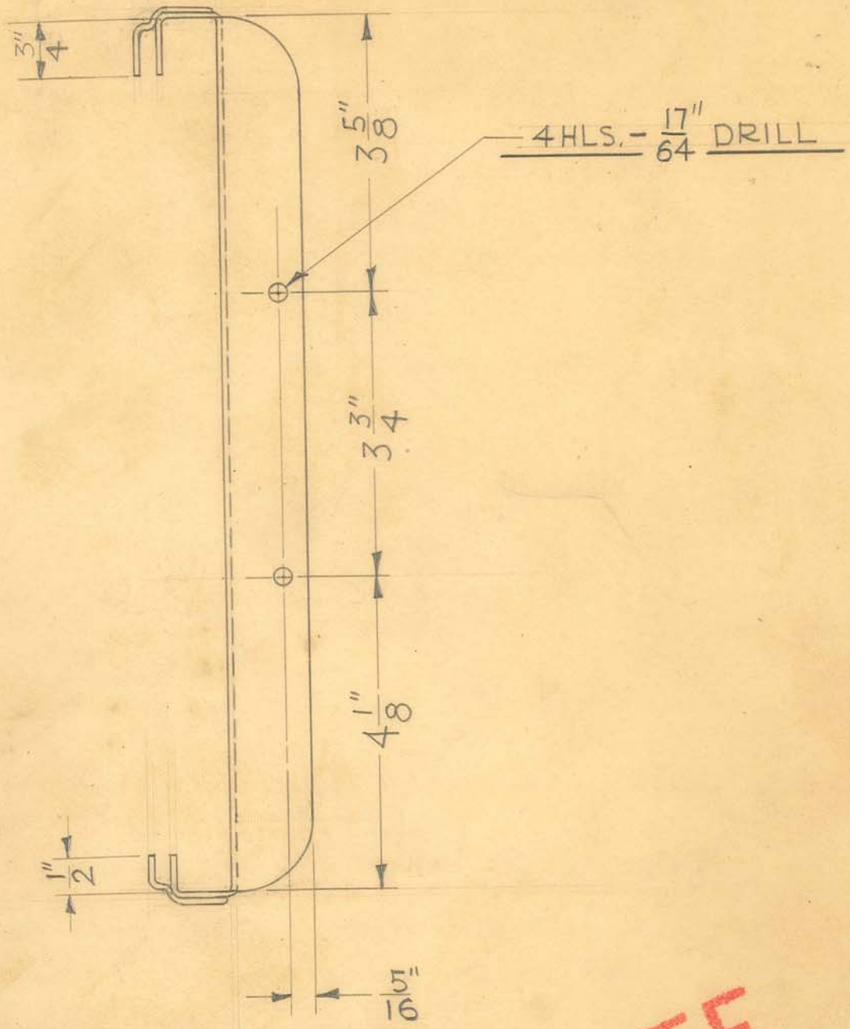

SCALE ~ 1/2" = 1"

1 REQUIRED

OBSOLETE 10-3-50 W. J.

SIZE	FROM 14288	ISSUE 9-10-41	J.V.W.	TITLE: TILTING CASSETTE & GRID HOLDER CASE - DRILLED
KIND		CHANGED		
SHAPE		"		
FINISH	CAD. #23	"		
TEMP.		"		
PATT.		"		

H. G. FISCHER & CO.
2335 WABANSIA AVE.
CHICAGO, ILL.

CAT. NO.

PART NO. 14288F

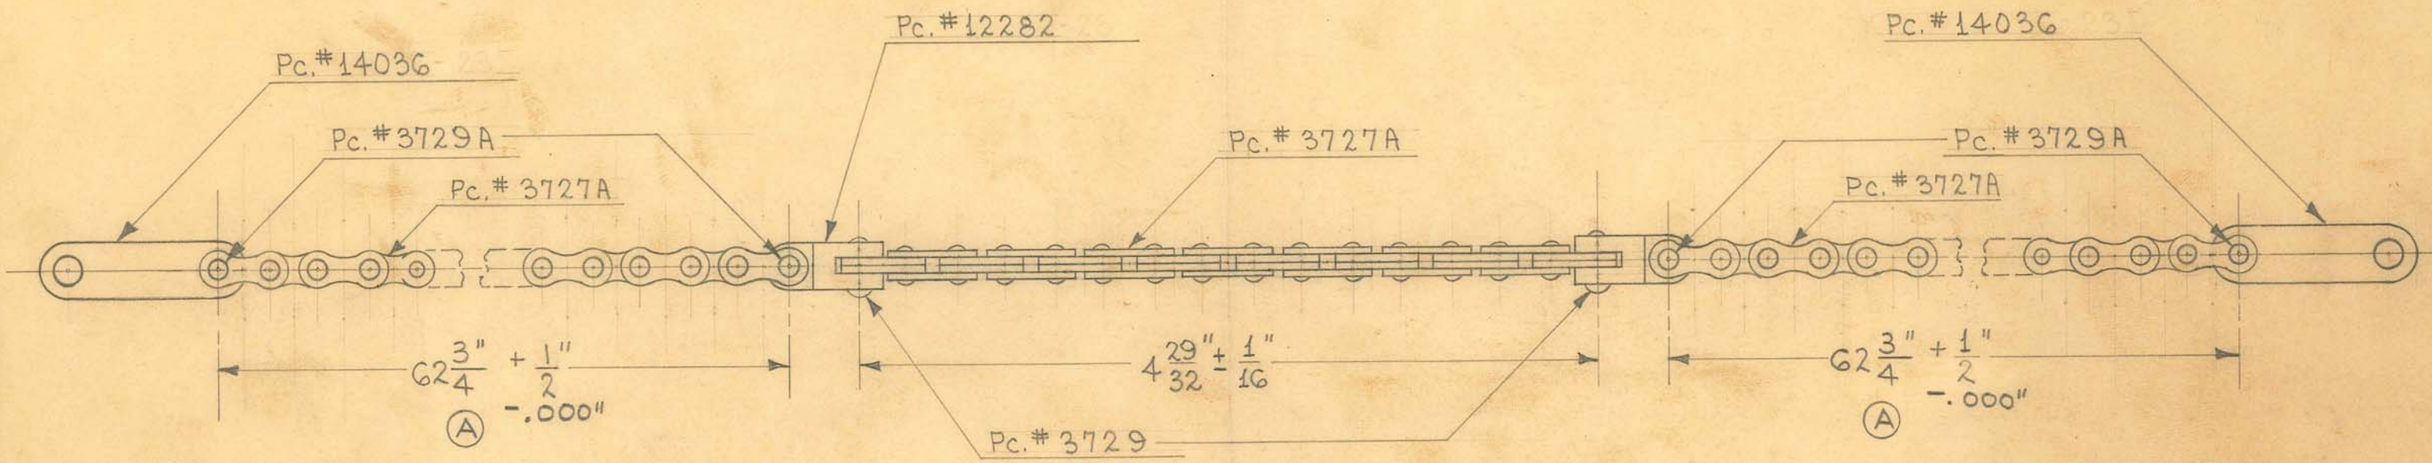

1 REQUIRED

OBSOLETE

REVISION		DATE	BY
A	Was $63\frac{1}{2}" \pm \frac{1}{8}"$	6-5-51	W.J.

SIZE		ISSUE 5-10-45	HE.
KIND		CHANGED	
SHAPE		"	
FINISH	WHITE CHR.#3	"	
TEMP.		"	
PATT.		"	

TITLE: FISCHER "NTM" X-RAY UNIT - COUNTERWEIGHT CHAIN ASSEMBLY

H. G. FISCHER & CO.
2335 WABANSIA AVE.
CHICAGO, ILL.

CAT. NO.

PART NO. 14291GA

8 HLS.-#9 DRILL C'SUNK. FOR #10X32 F. HD. SCREW.

8 HLS.-#10X32 TAP

CUT 4 SETS (2 EACH) OF "V" GROOVES $\frac{1}{32}$" DEEP WITH SPECIAL TOOL, $\frac{3}{8}$" EITHER SIDE OF CENTER OF C'SUNK. HOLES AS SHOWN

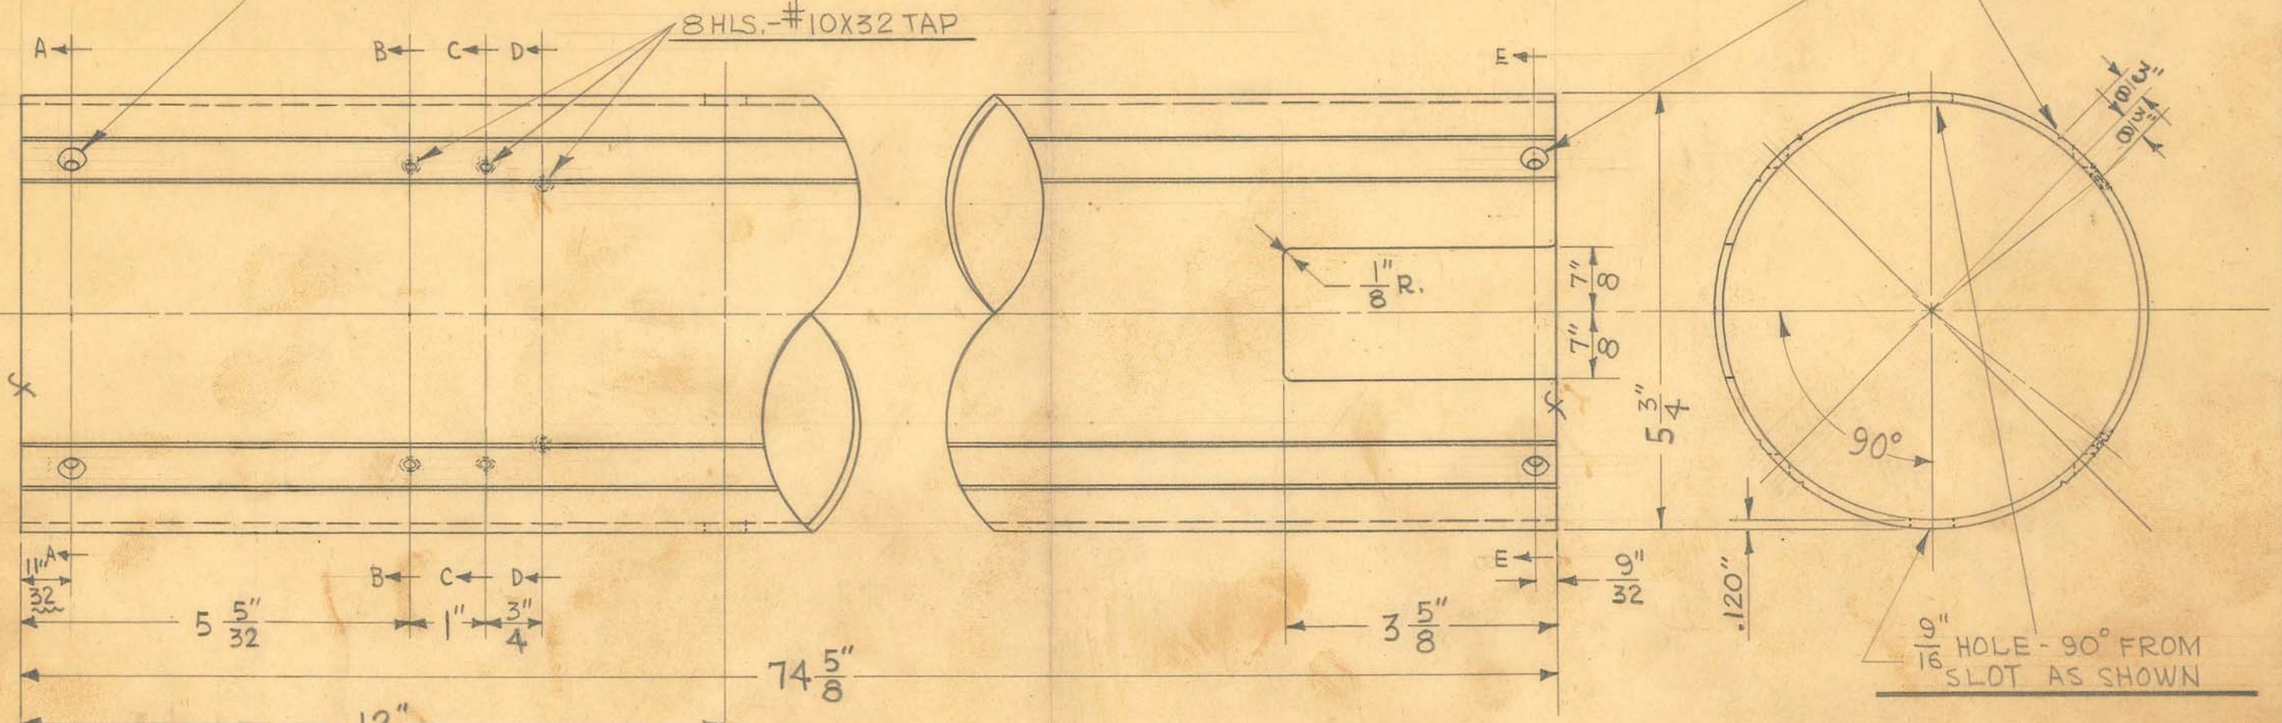

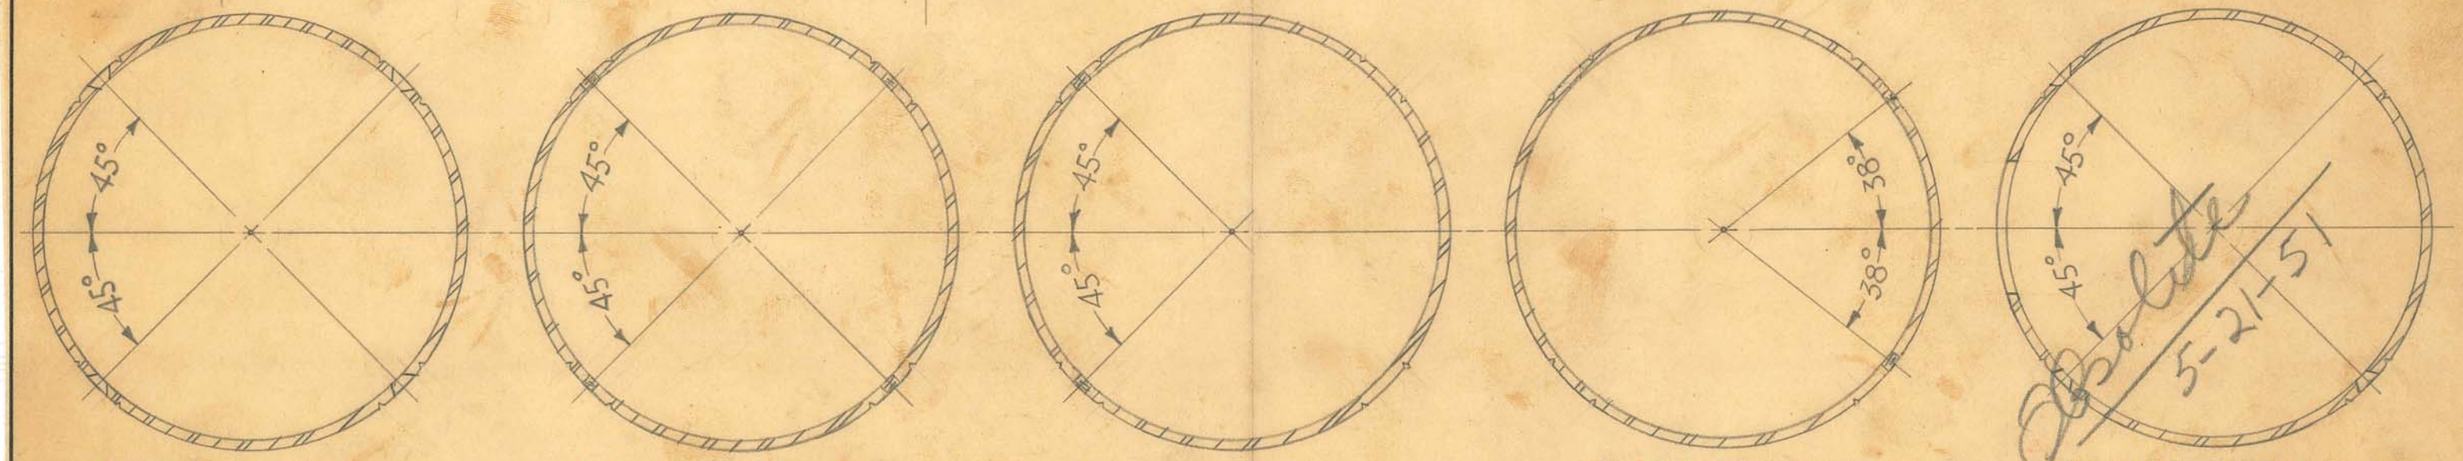

SECTION THRU A-A

SECTION THRU B-B

SECTION THRU C-C

SECTION THRU D-D

SECTION THRU E-E

Obsolete 5-21-51

5 $\frac{3}{4}$" O.D. X #11 GA. (.120") WALL SHELBY SEAMLESS STEEL TUBING

1 REQUIRED

SIZE		ISSUE 4-20-42	J.V.W.
KIND		CHANGED	
SHAPE		"	
FINISH		"	
TEMP.		"	
PATT.		"	

TITLE: FISCHER "NTM" SHOCKPROOF X-RAY APP. UPRIGHT TUBE

OBSOLETE

H. G. FISCHER & CO. 2335 WABANSIA AVE. CHICAGO, ILL.

CAT. NO.

PART NO. 14301F

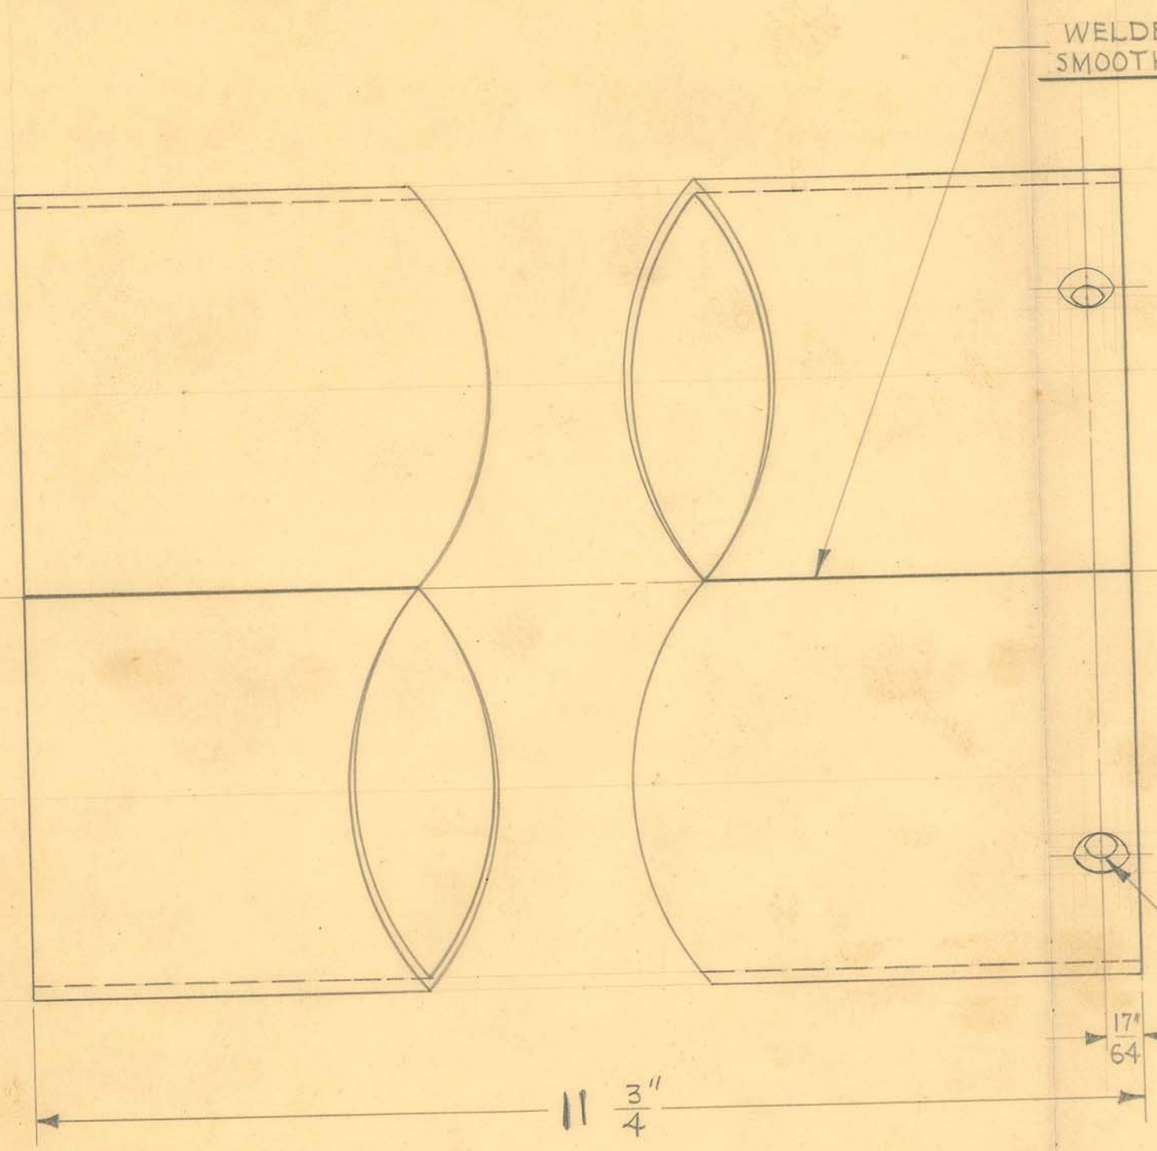

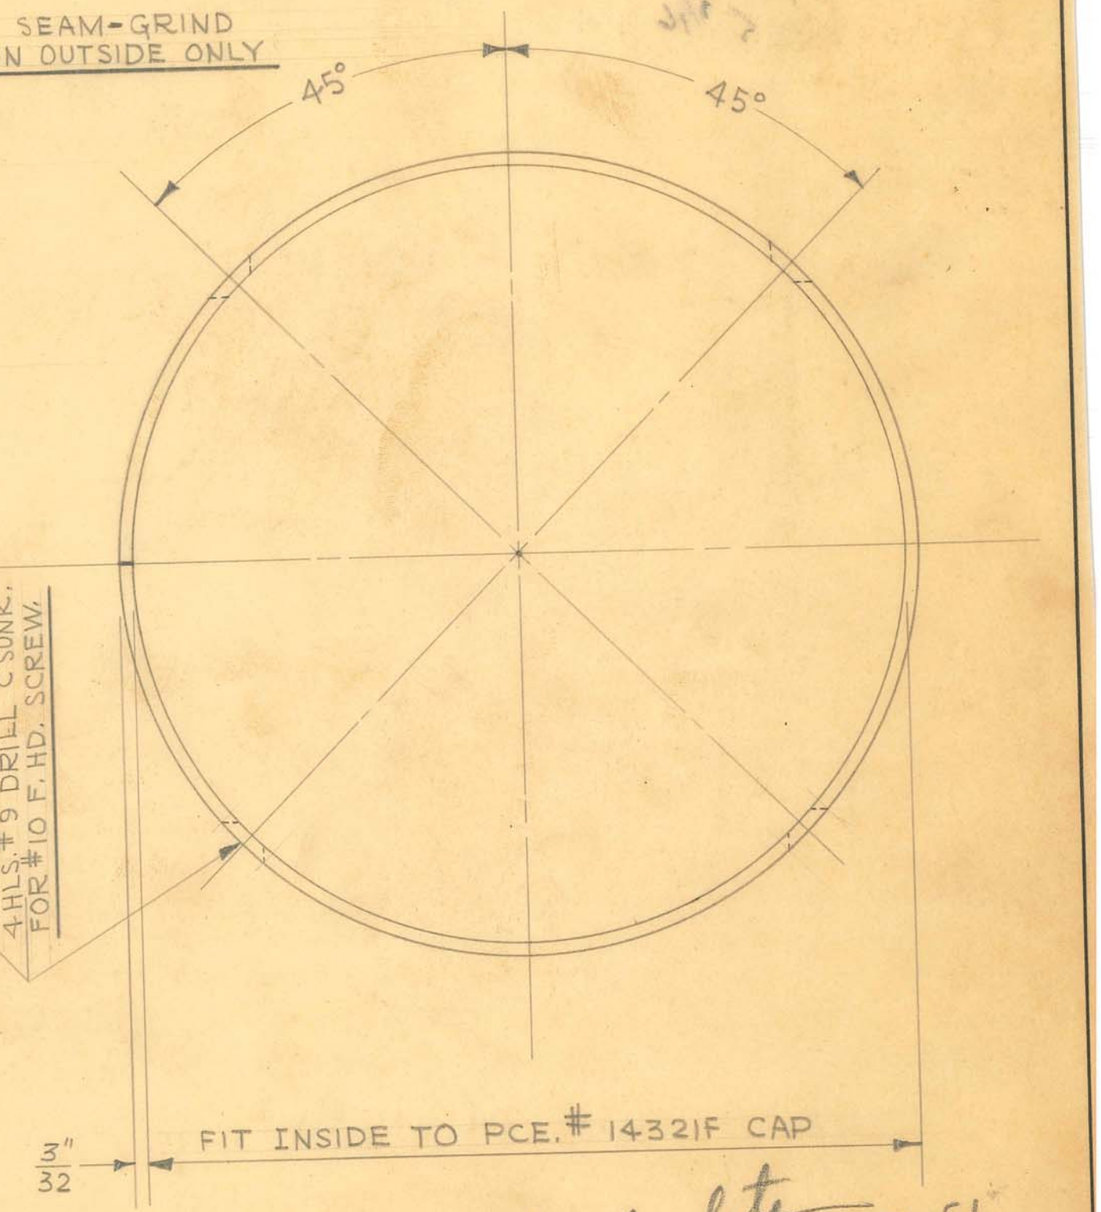

- 3/32" SHEET BLUE ANNEALED STEEL

1 REQUIRED

Obsolete 6-7-51

OBSOLETE

SIZE		ISSUE 7-15-42	J.V.W.	TITLE: FISCHER "NTM" SHOCKPROOF X-RAY COUNTERWEIGHT TUBE
KIND		CHANGED		
SHAPE		"		
FINISH		"		
TEMP.		"		
PATT.		"		

H. G. FISCHER & CO.
2335 WABANSIA AVE.
CHICAGO, ILL.

CAT. NO.

PART NO. 14302F

1 REQUIRED

OBSOLETE

TITLE: FISCHER MOBILE BEDSIDE UNIT
COUNTERWEIGHT TUBE

H. G. FISCHER & CO.
FRANKLIN PARK, ILLINOIS

PART NO. 14302A

PATTERN:
TOOLS: TOOL #7980
FINISH:
SCALE: FULL
MATERIAL: 5/4" O.D. X #11GA. (.120") WALL SEAMLESS STEEL TUBING
DATE: 6-6-51
DR. BY: J.V.W.
CH'K'D.:

DIMENSIONS
FRACTIONAL ± .015
DECIMAL ± .005
ANGULAR ± ½°
UNLESS OTHERWISE SPECIFIED

REVISION	DATE	BY

FOLDER #118

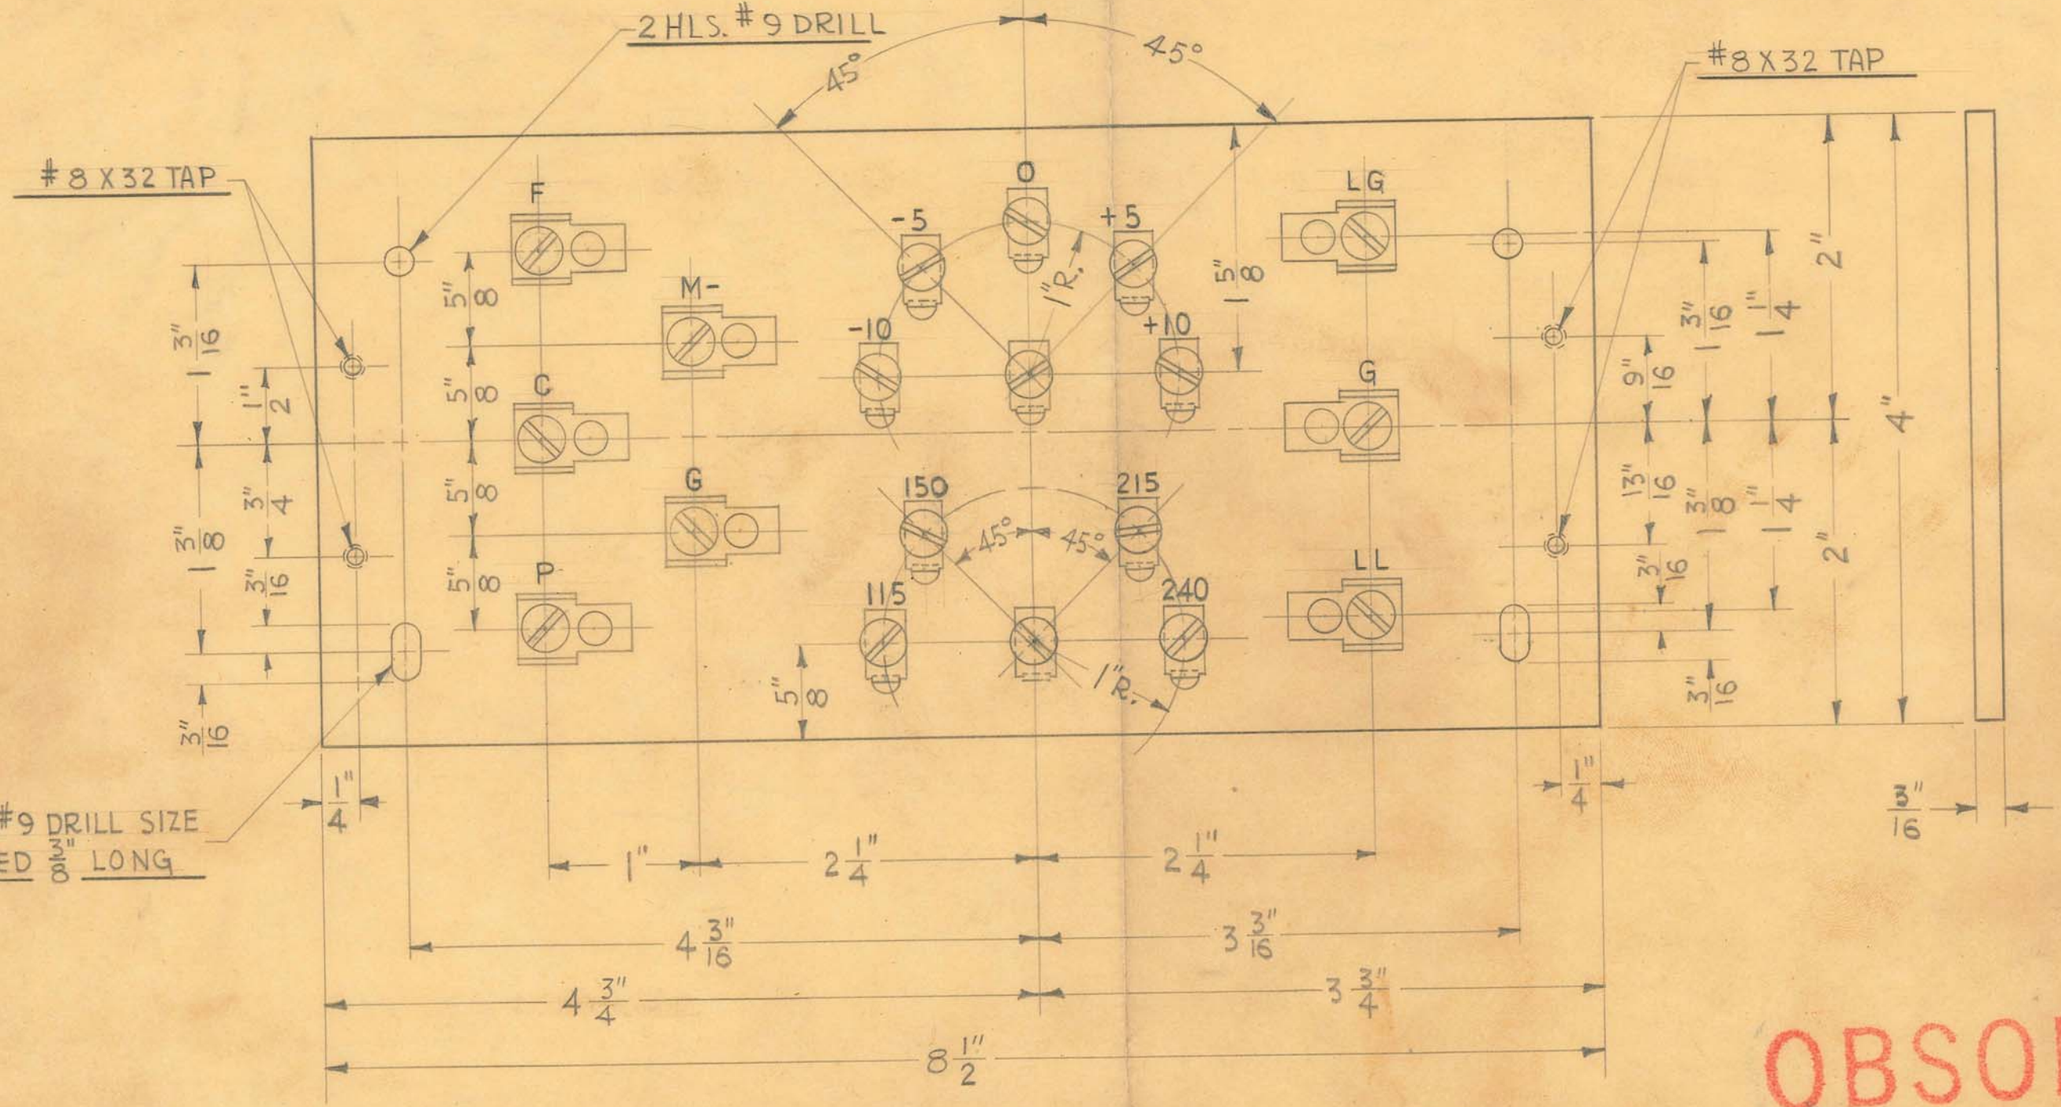

1 REQUIRED

SIZE		ISSUE 6-12-41	J.V.W.
KIND		CHANGED	
SHAPE		"	
FINISH		"	
TEMP.		"	
PATT.		"	

TITLE:
FISCHER "NTM" X-RAY UNIT
CONTROL BOX TERMINAL BOARD

H. G. FISCHER & CO.
2338 WABANSIA AVE.
CHICAGO, ILL.

CAT. NO.

PART NO. 14303G

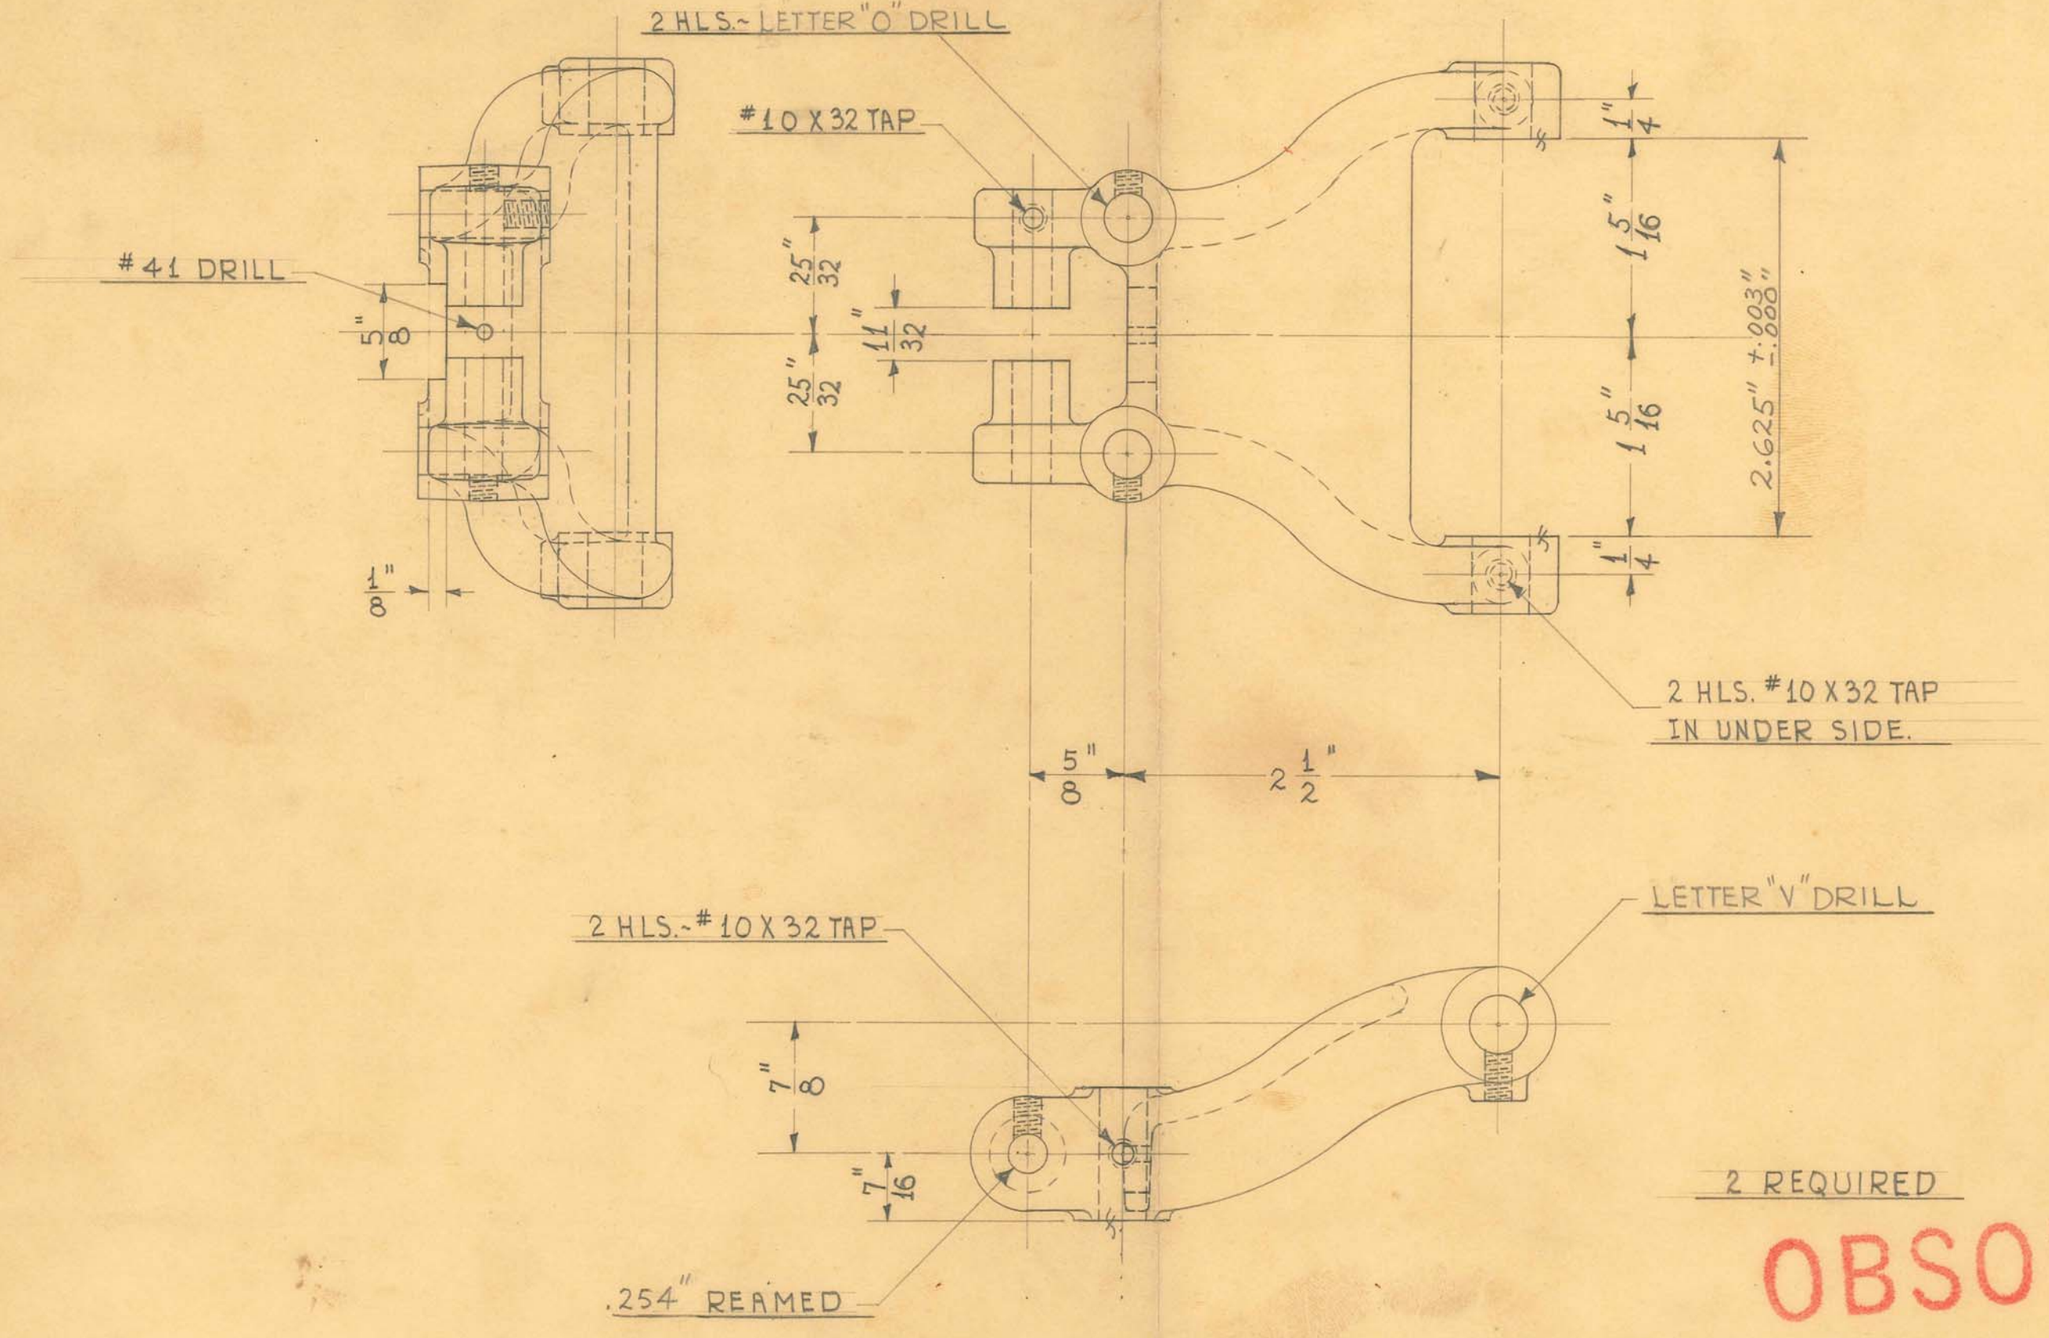

2 REQUIRED

OBSOLETE

SIZE		ISSUE 12-9-41	H.E.
KIND	IRON CASTING	CHANGED	
SHAPE		" 6-19-46	J.V.W.
FINISH	BLACK #49	"	
TEMP.		"	
PATT.	1826	"	

TITLE: "NTM" SHOCKPROOF X-RAY APPARATUS-
GUIDE RAIL BALL BEARING SUPP.

H. G. FISCHER & CO.
2335 WABANSIA AVE.
CHICAGO, ILL.

CAT. NO.

PART NO. 14304F

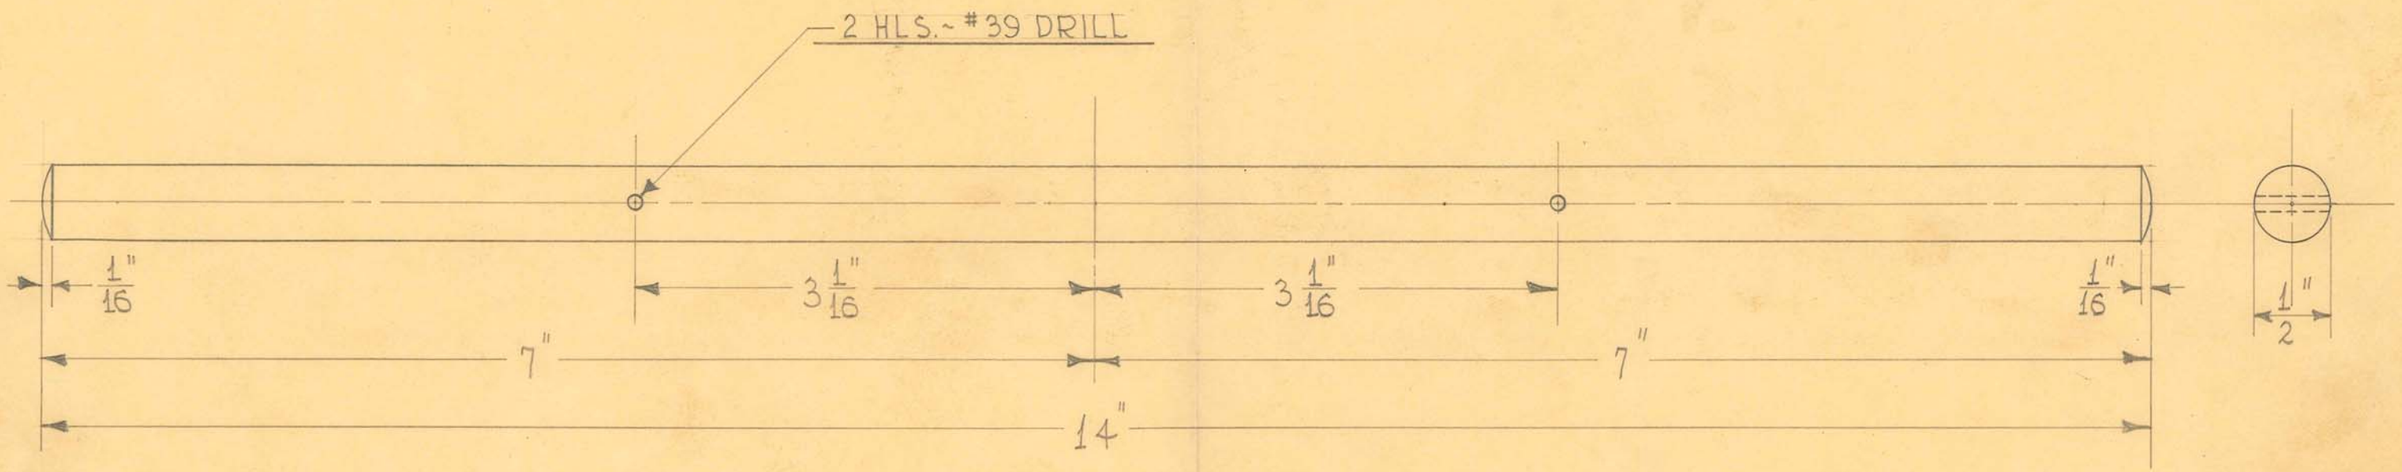

1 REQUIRED

OBSOLETE

SIZE	1/2" DIAM.	ISSUE 7-27-42	HE.
KIND	C.R.STEEL	CHANGED	
SHAPE	ROD	"	
FINISH		"	
TEMP.		"	

TITLE: FISCHER MOD. "NTM" SHOCKPROOF X-RAY APPARATUS ~ CWT. CLAMP ROD (FOR SHIPPING)

H. G. FISCHER & CO.
2335 WABANSIA AVE.

CAT. NO.

PART NO. 14314

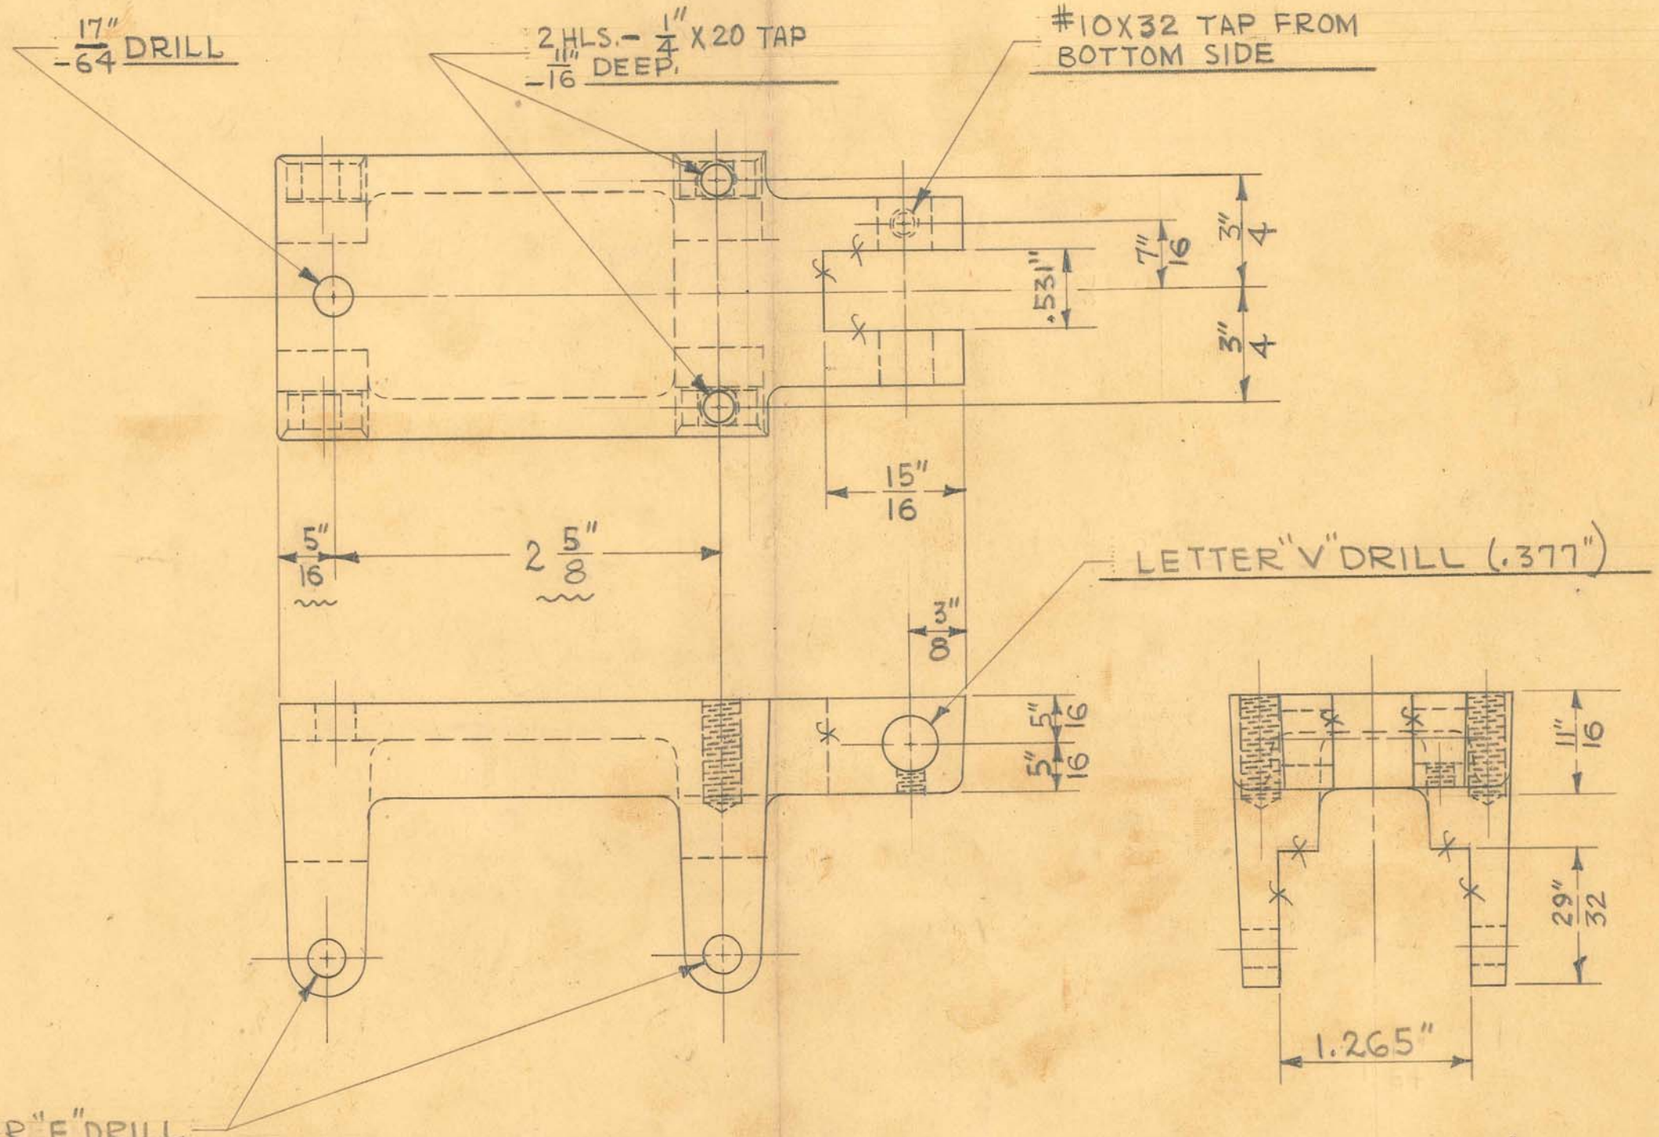

OBSOLETE

BLACK #80 BEFORE PAINTING

SIZE		ISSUE 4-4-42	J.V.W.	TITLE: FISCHER MOD "NTM" X-RAY UNIT VERT. COL. ROTATION LOCK- LOCK PIECE HOLDER
KIND	IRON CASTING	CHANGED		
SHAPE		" 5-22-51	J.V.W.	
FINISH	BLACK #80	"		
TEMP.		"		
PATT.	1803	"		

H. G. FISCHER & CO.
2335 WABANSIA AVE.
CHICAGO, ILL.

CAT. NO.

PART NO. 14319F

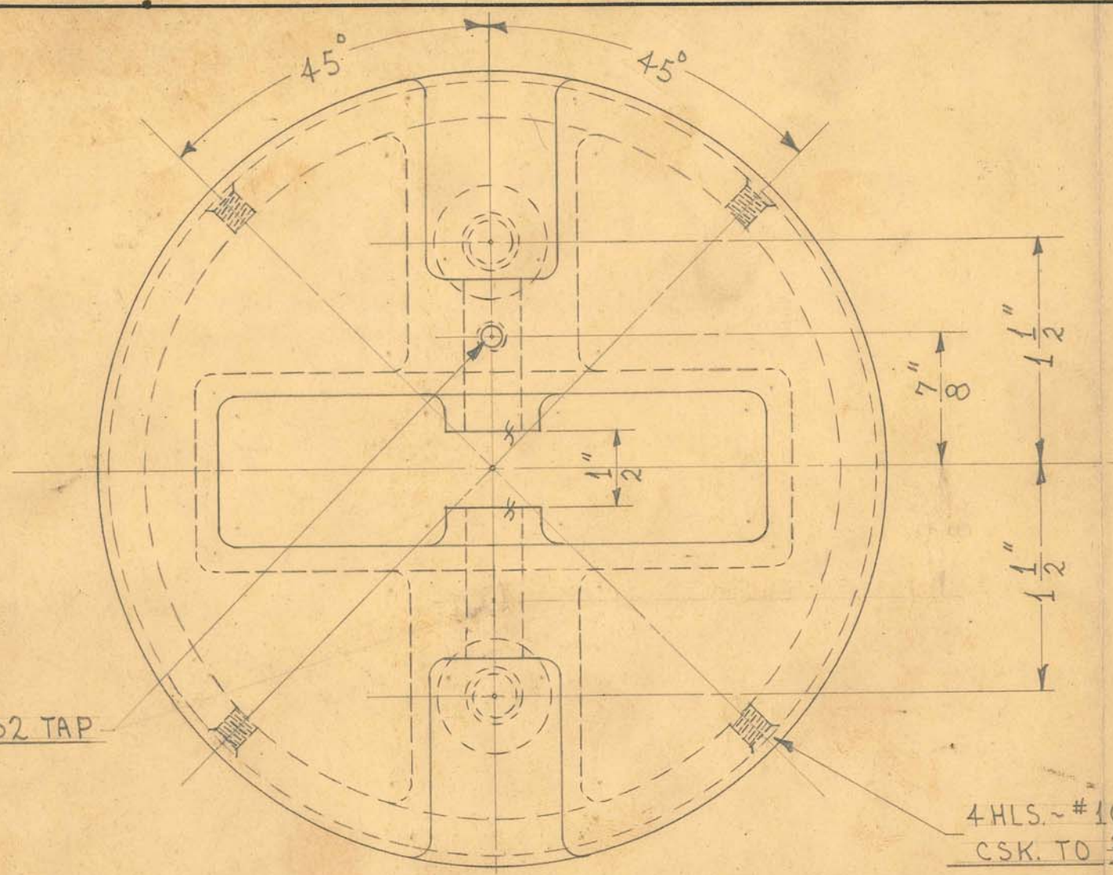

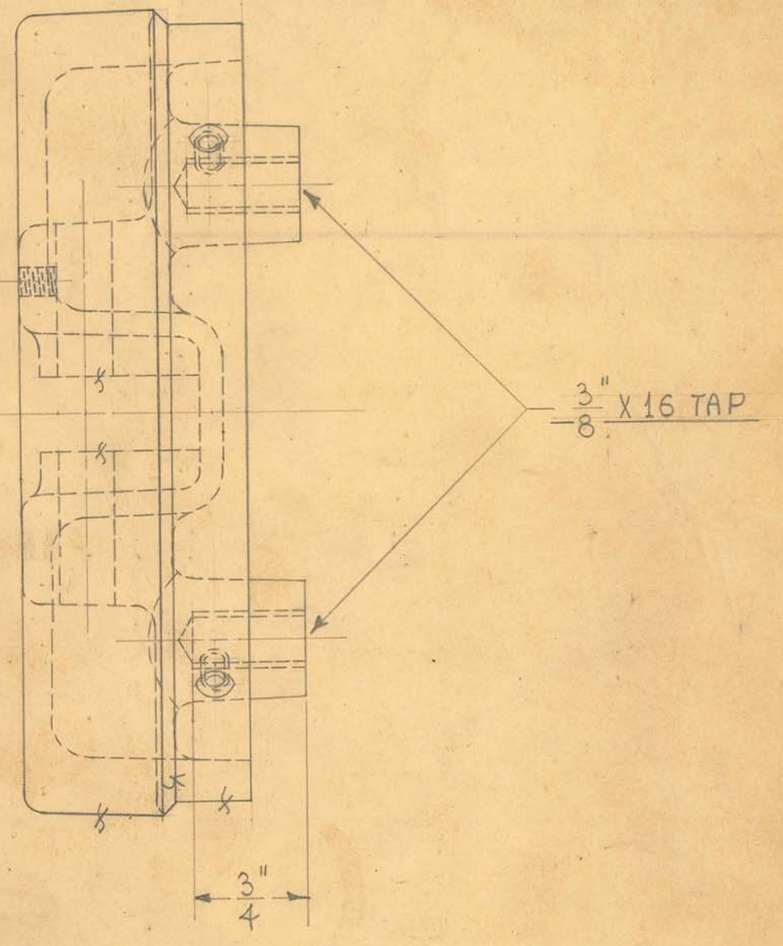

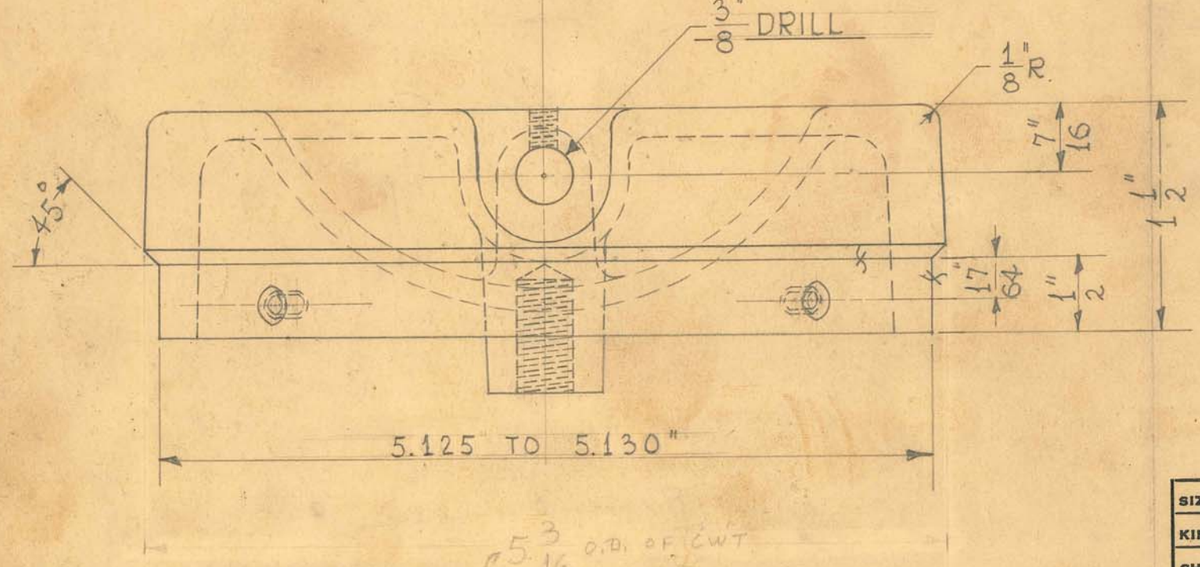

1 REQUIRED

OBSOLETE

6-7-57

SIZE		ISSUE 3-2-42	HE.
KIND	IRON CASTING	CHANGED	
SHAPE		"	
FINISH		"	
TEMP.		"	
PATT.	1806	"	

TITLE: "NTM" SHOCKPROOF X-RAY APPARATUS-
COUNTERWEIGHT TOP CAP.

H. G. FISCHER & CO.
2335 WABANSIA AVE.
CHICAGO, ILL.

CAT. NO.

PART NO. 14321F

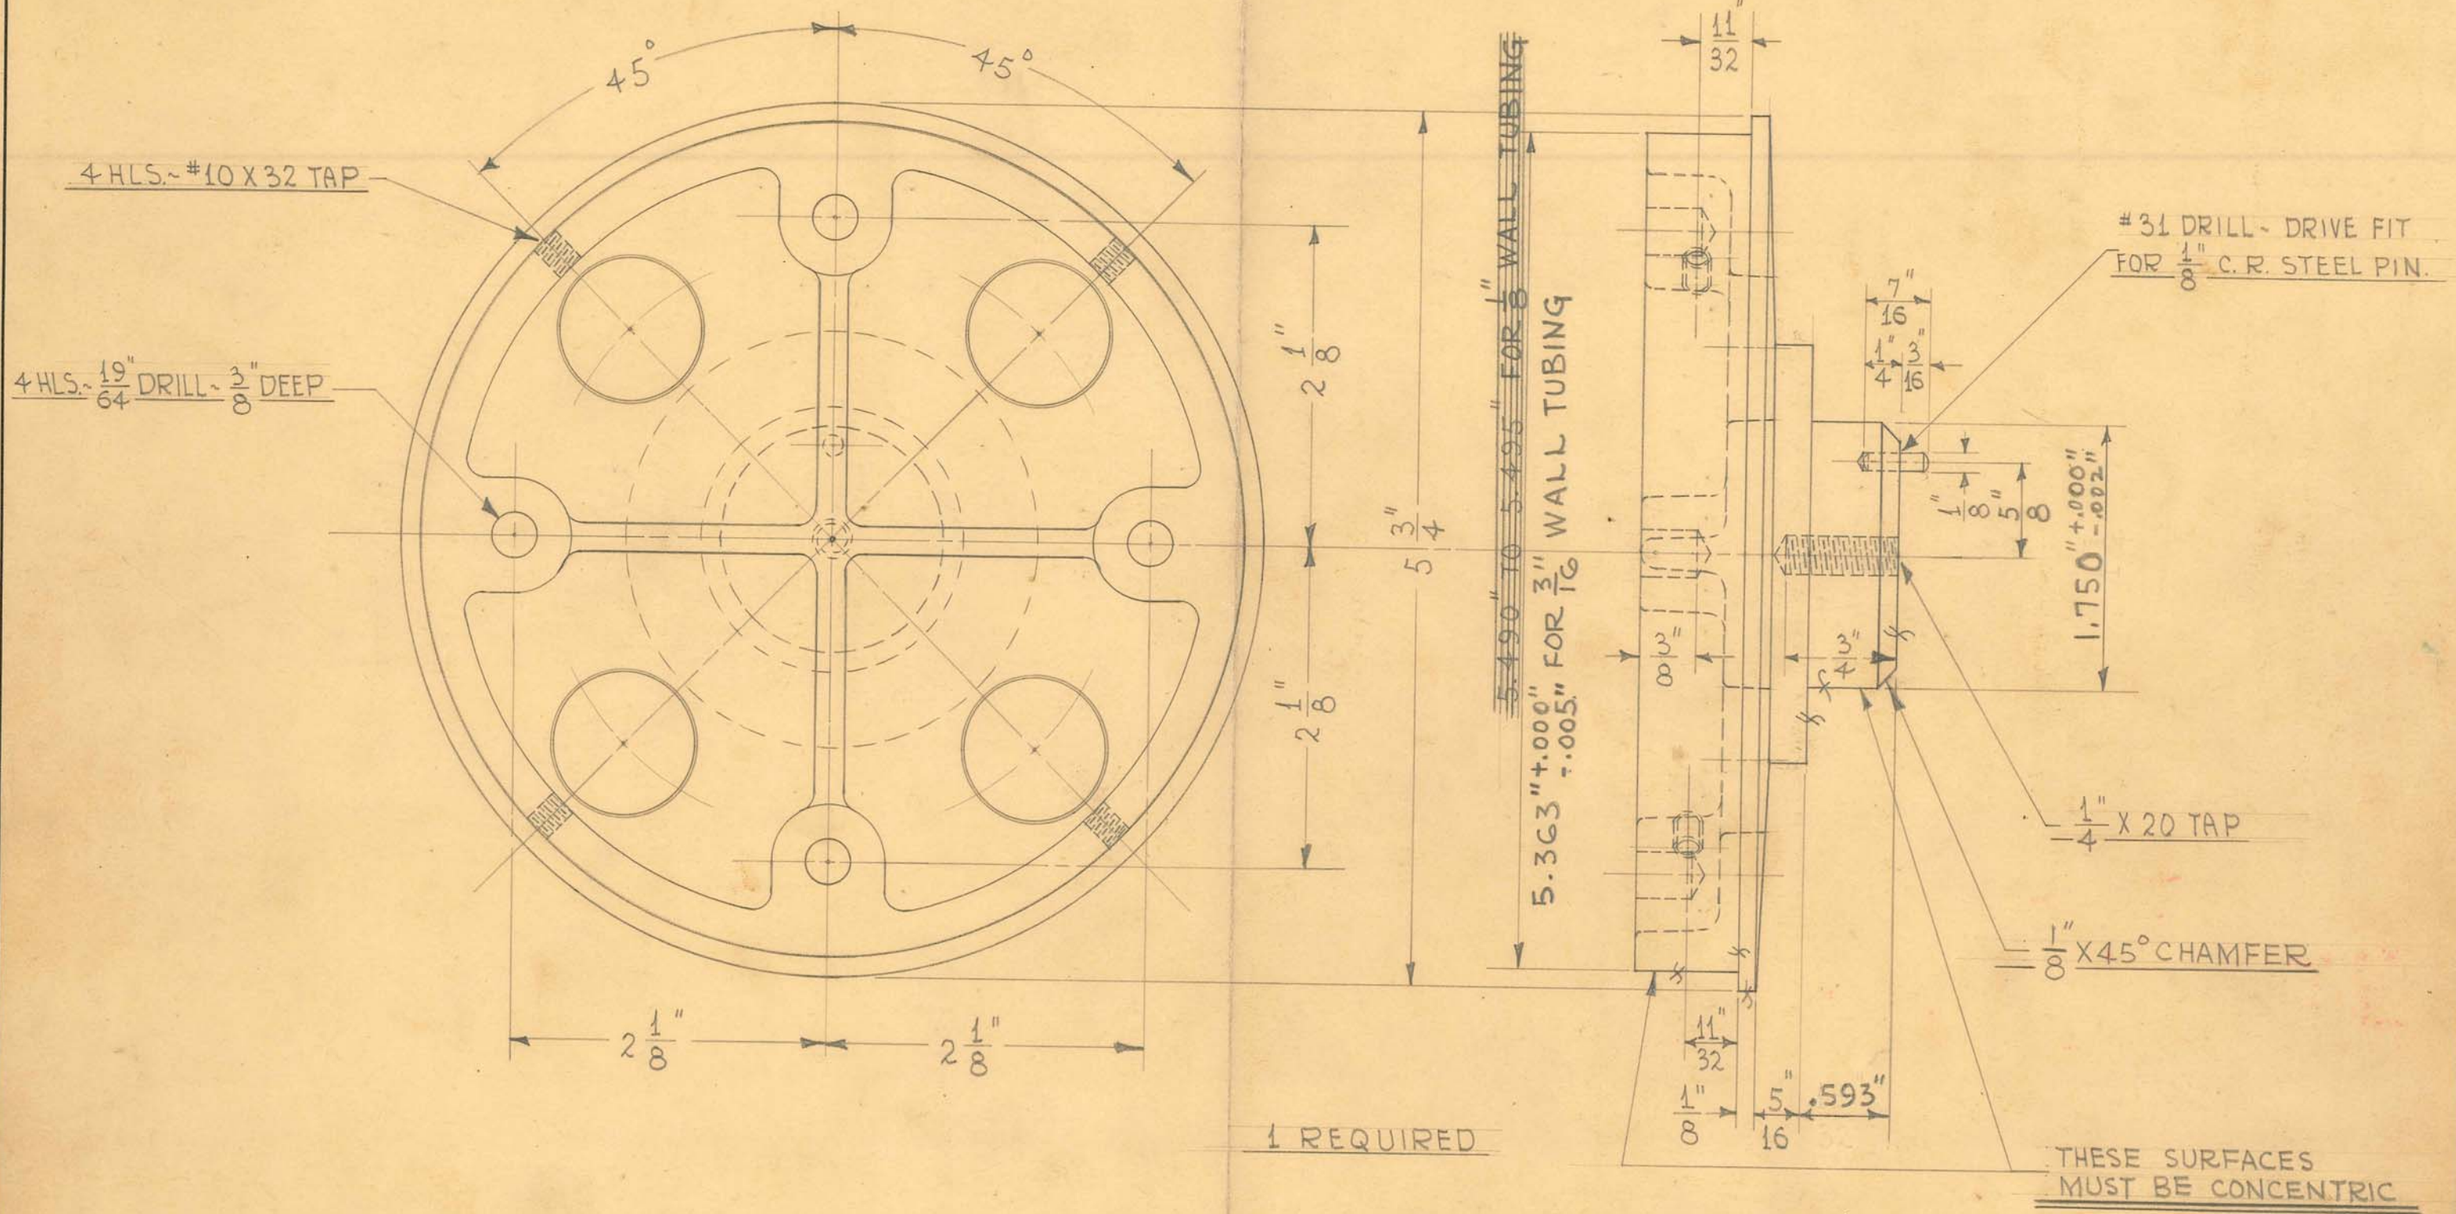

1 REQUIRED

SIZE	#80-10-10	ISSUE 2-27-42	H.E.	TITLE: "NTM" SHOCKPROOF X-RAY APPARATUS- UPRIGHT TUBE BEARING - LOWER
KIND	BRONZE CASTING	CHANGED		
SHAPE		" 5-21-51	J.V.W.	
FINISH		"		
TEMP.		"		
PATT.	1805	"		

H. G. FISCHER & CO.
2338 WABANSIA AVE.
CHICAGO, ILL.

CAT. NO.

PART NO. 14323G

OBSOLETE

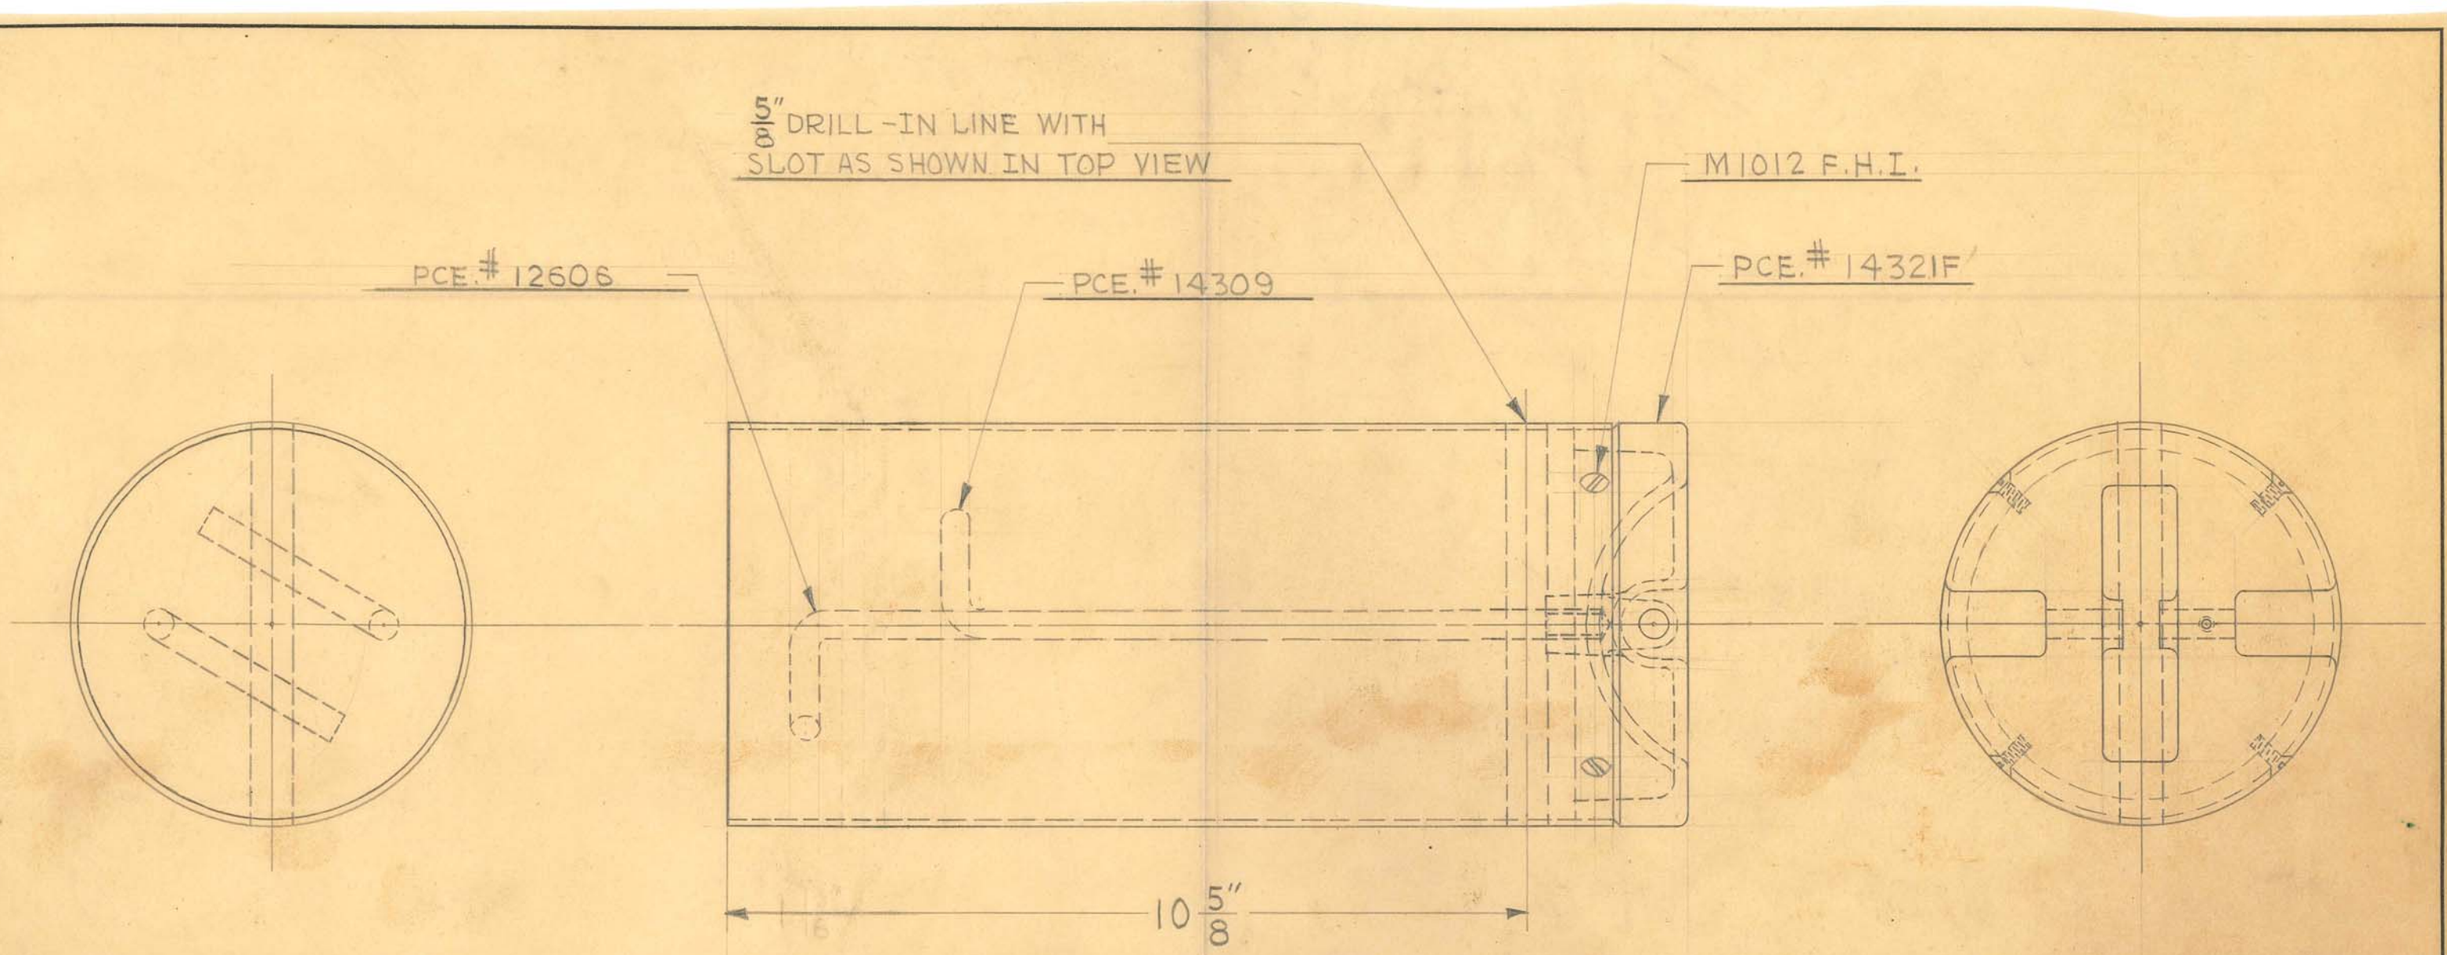

SCREW RODS INTO TOP CAP AS SHOWN.
FASTEN TUBE TO TOP CAP WITH #10X32 SCREWS.
FILL WITH LEAD TO TOP OF TUBE.

TOTAL WEIGHT AFTER DRILLING 5/8" HOLE - 106 LBS.

1 REQUIRED

OBSOLETE
XX Obsolete 6-7-51

SIZE		ISSUE 7-16-42	J.V.W.
KIND		CHANGED	
SHAPE		"	
FINISH		"	
TEMP.		"	

TITLE:
FISCHER "NTM" SHOCKPROOF X-RAY
COUNTERWEIGHT ASSEMBLY

H. G. FISCHER & CO.
2335 WABANSIA AVE.

CAT. NO.

PART NO. 14326G

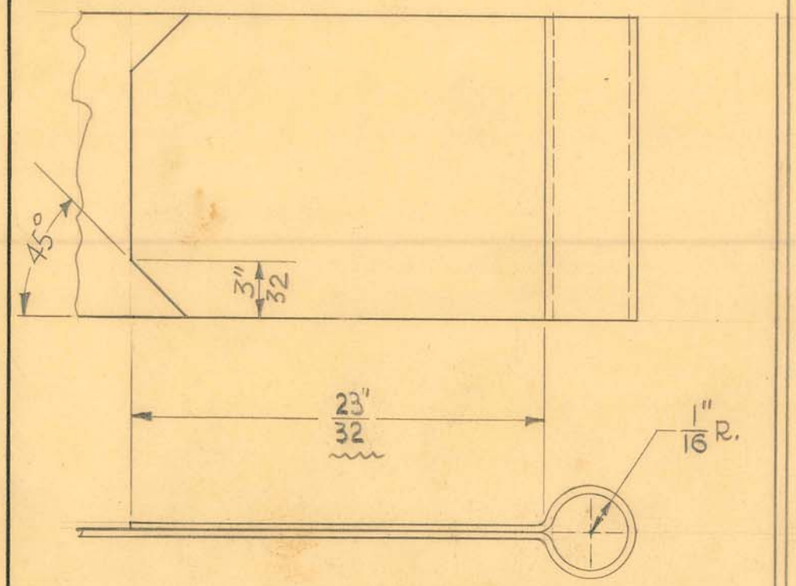

1

SCALE ÷ 1" = 1"/4

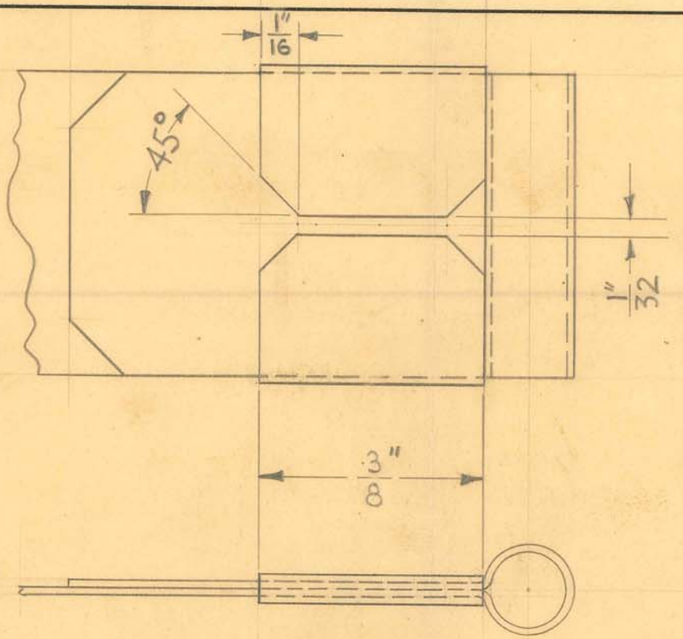

2

SCALE ÷ 1" = 1"/4

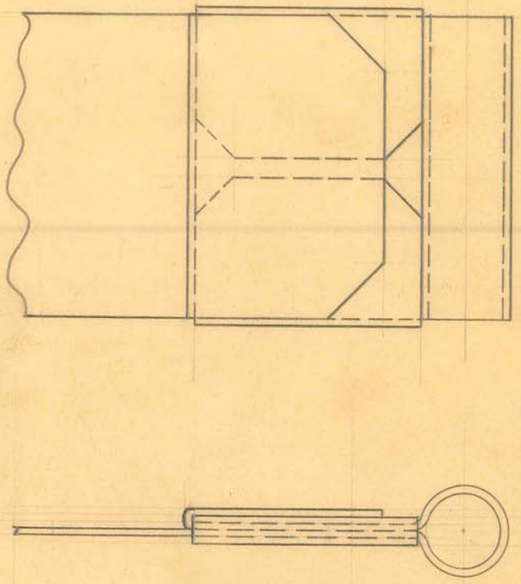

3

SCALE ÷ 1" = 1"/4

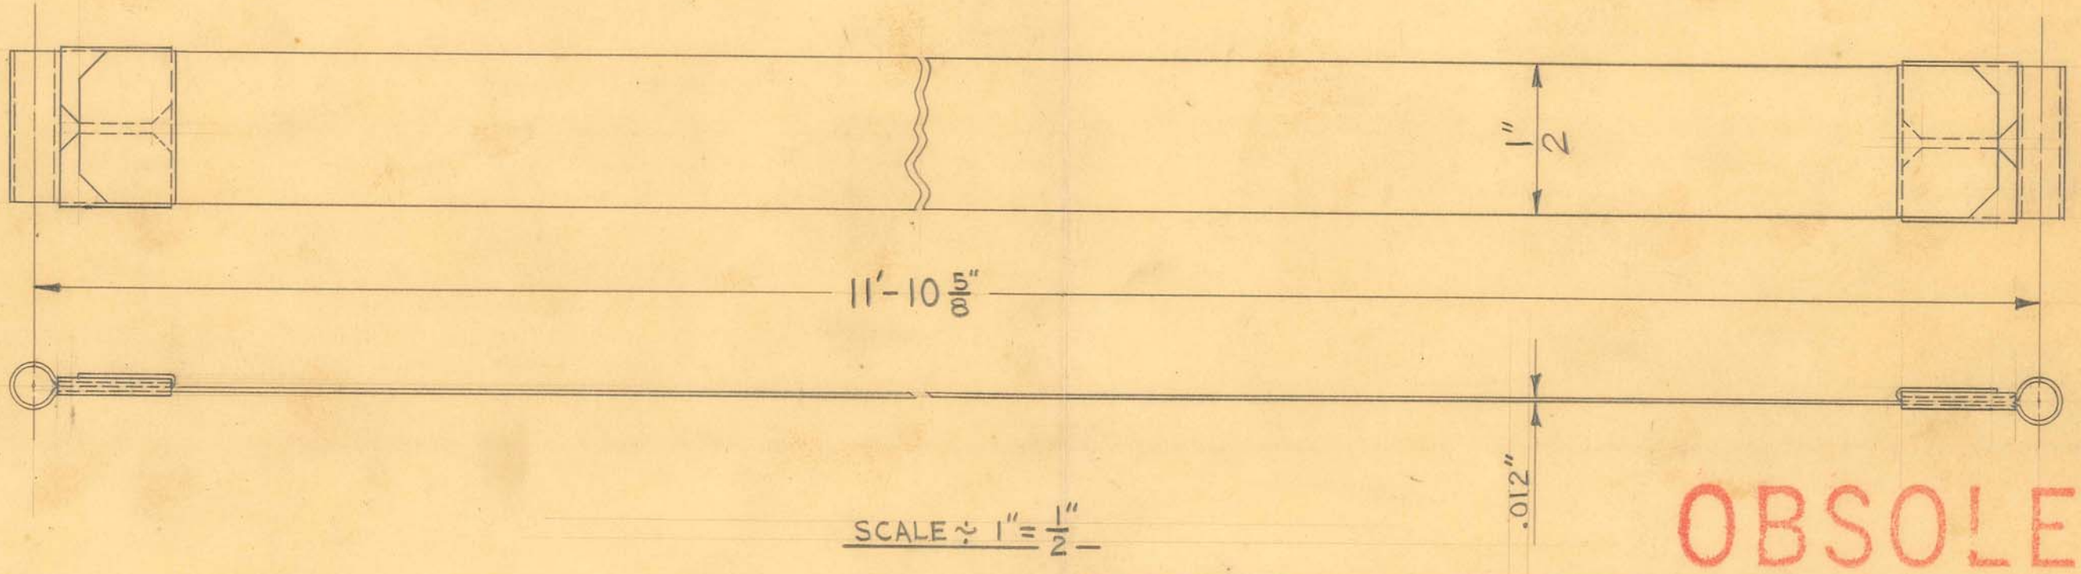

SCALE ÷ 1" = 1"/2

OBSOLETE

1 REQUIRED

SIZE	1/2" X .012"	ISSUE 5-8-42	J.V.W.
KIND	STEEL STRAP	CHANGED	
SHAPE		"	
FINISH		"	
TEMP.		"	
PATT.		"	

TITLE: FISCHER MOD. "GA-15" LIGHT MOBILE STAND PULLEY STRAP

H. G. FISCHER & CO.
2335 WABANSIA AVE.
CHICAGO, ILL.

CAT. NO.

PART NO. 14332G

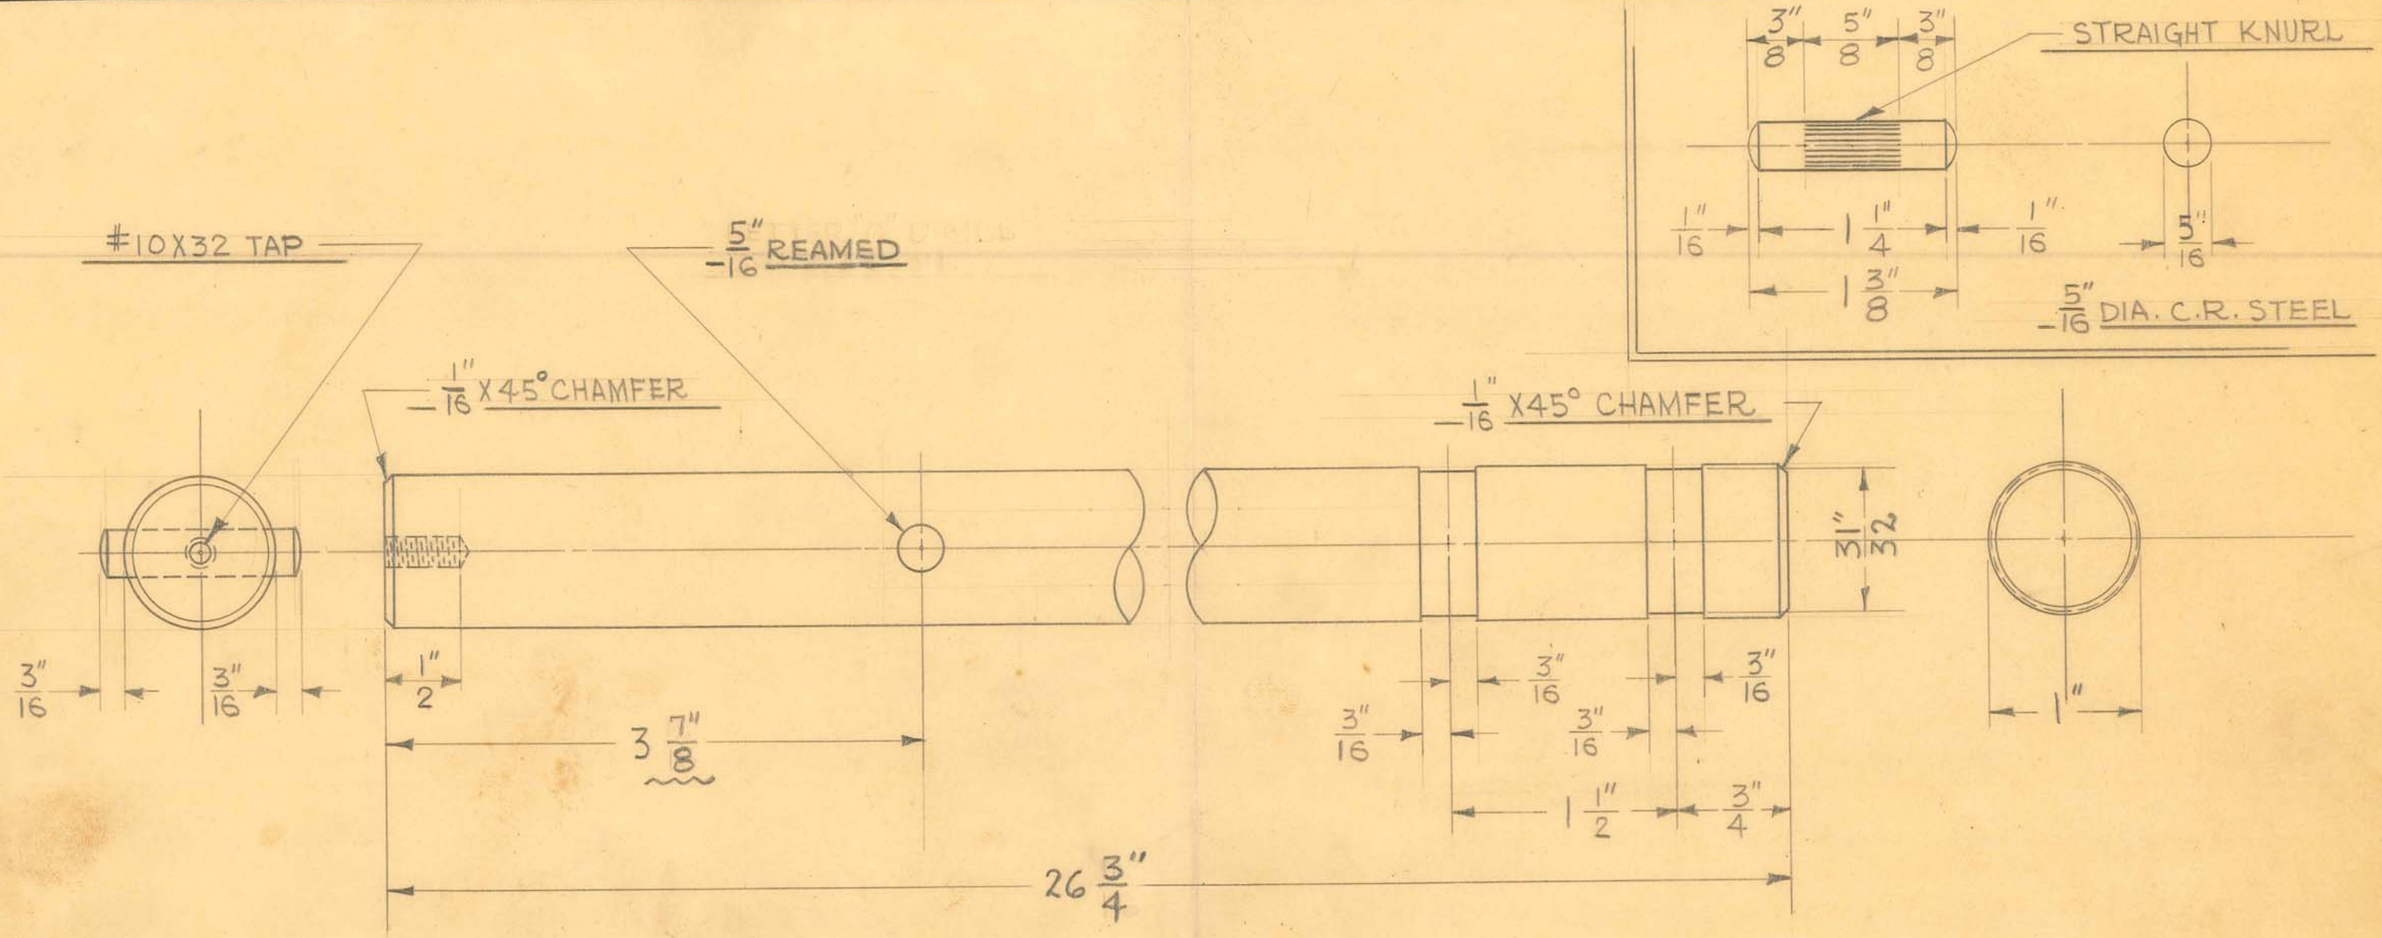

1 REQUIRED

OBSOLETE

SIZE	1" DIA.	ISSUE 5-13-42	J.V.W.
KIND	C.R. STEEL	CHANGED	
SHAPE		"	
FINISH	WH. CHR. #3	"	
TEMP.		"	

TITLE:
FISCHER MOD. "GA-15" LIGHT MOBILE STAND
CONTROL BOX SUPPORT ROD

H. G. FISCHER & CO.
2335 WABANSIA AVE.

CAT. NO.

PART NO. 14335G

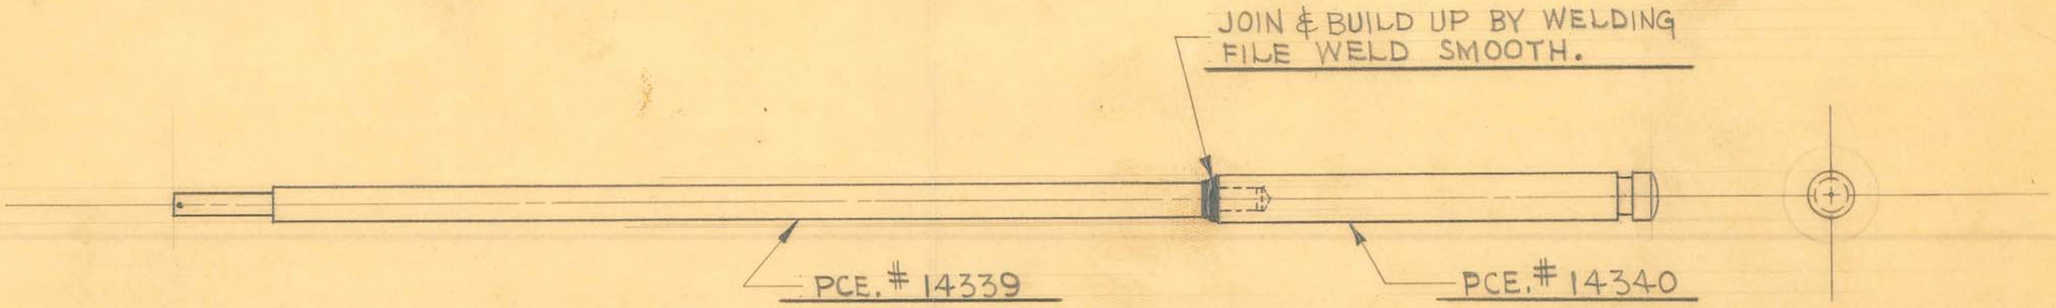

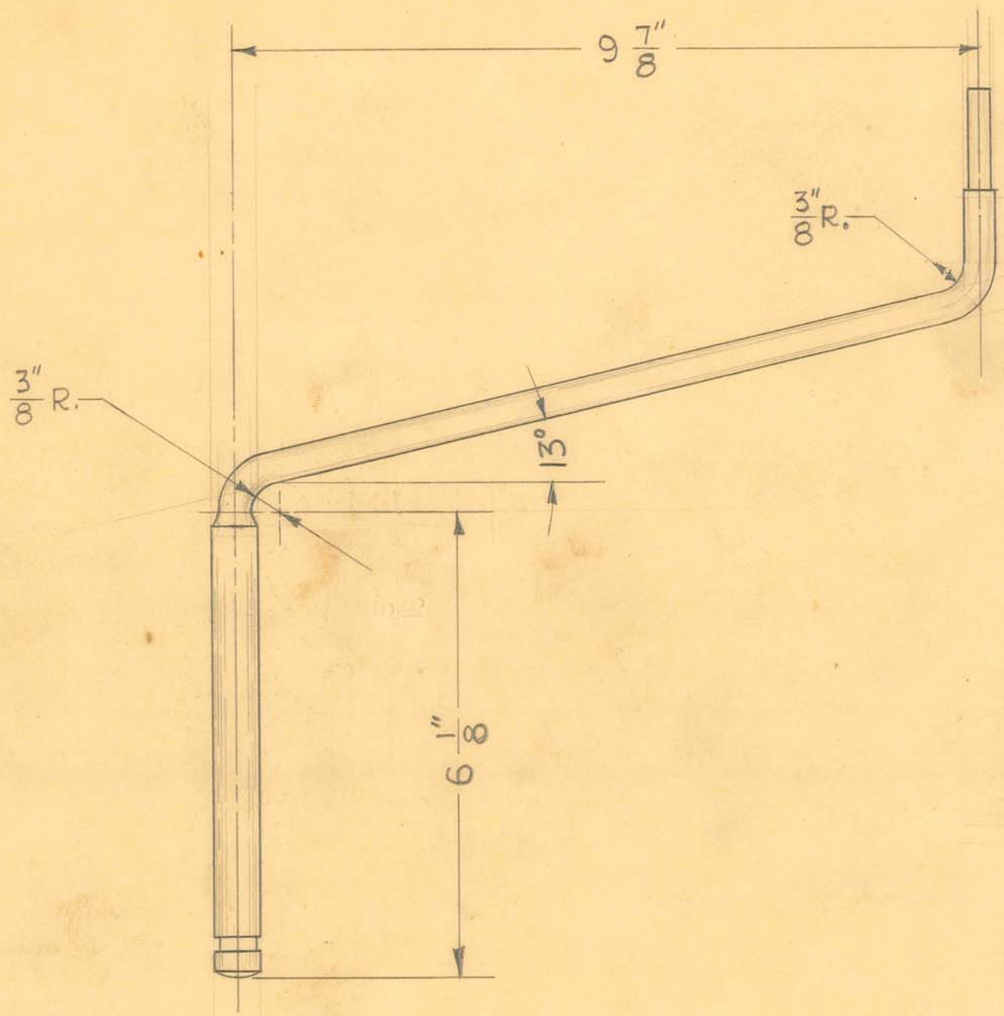

SCALE ÷ HALF SIZE

Note:
Chrome #2 Polish
7/16" Diameter Up To
1" of 5/8" Diameter

1 REQUIRED

OBSOLETE

SIZE		ISSUE 5-6-42	J.V.W.
KIND		CHANGED	
SHAPE		"	
FINISH		"	
TEMP.		"	

TITLE:
FISCHER MOD. "GA-15" LIGHT MOBILE STAND
CRANK HANDLE ASSEMBLY

H. G. FISCHER & CO.
2335 WABANSIA AVE.

CAT. NO.

PART NO. 14341G

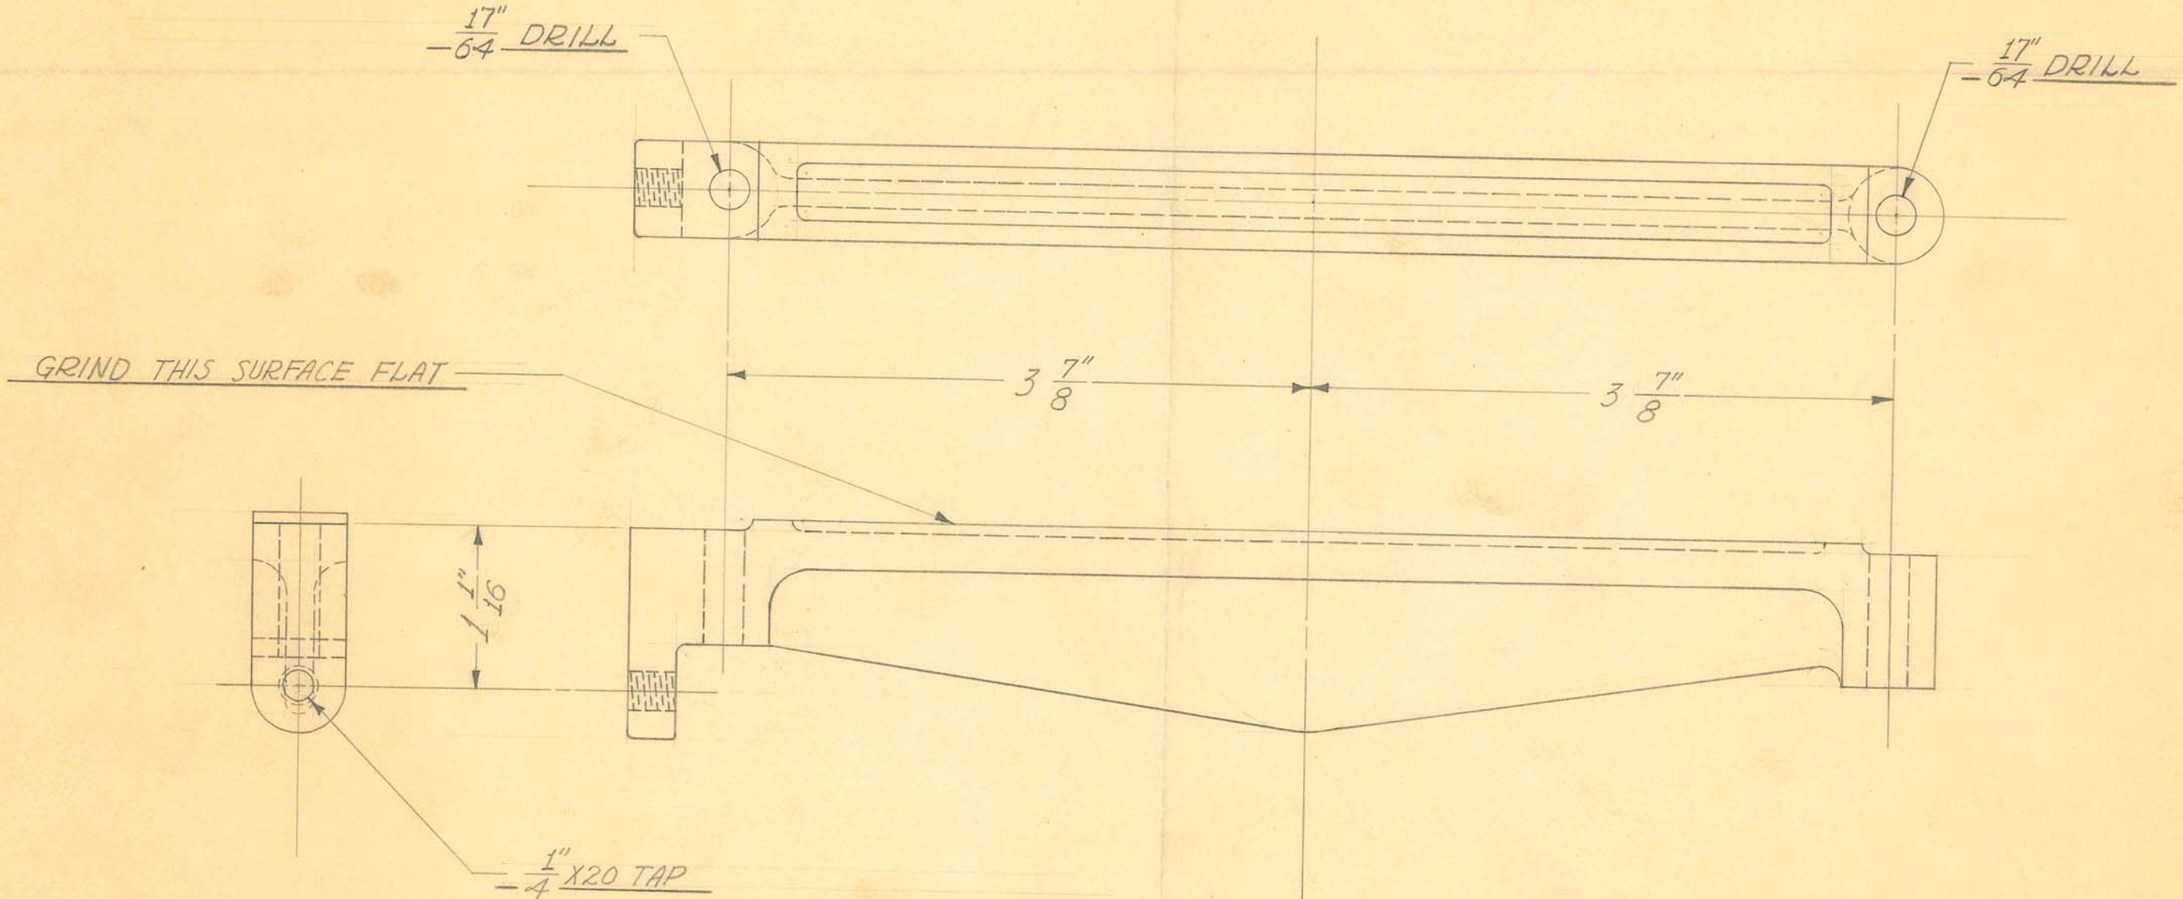

2 REQUIRED

OBSOLETE

SIZE		ISSUE 11-28-38	J.W.
KIND	IRON CASTING	CHANGED	
SHAPE		"	
FINISH	BLACK #80	"	
TEMP.		"	
PATT.	1309	"	

TITLE:
SHORT WAVE H.T. TRANSFORMER
SUPPORT-REAR (FOREIGN ORDERS)

H. G. FISCHER & CO.
2335 WABANSIA AVE.
CHICAGO, ILL.

CAT. NO.

PART NO. 9933

TITLE
FISCHER DELUXE "RF-250" X-RAY
AUTO TRANSF. CLAMP-LOWER

H. G. FISCHER & CO.
FRANKLIN PARK, ILLINOIS

DATE 10-7-48 DR. BY J.V.W. CH'K'D.

PART NO. 17107

REVISION	DATE	BY

PATTERN | FINISH | SCALE FULL

TOOLS
DRILL JIG TOOL # 9936

MATERIAL
$\frac{3}{8}$" X 1$\frac{1}{2}$" C.R. STEEL BAR

DIMENSIONS
FRACTIONAL ±.015
DECIMAL ±.005
ANGULAR ±½°
UNLESS OTHERWISE SPECIFIED

Obsolete

OBSOLETE

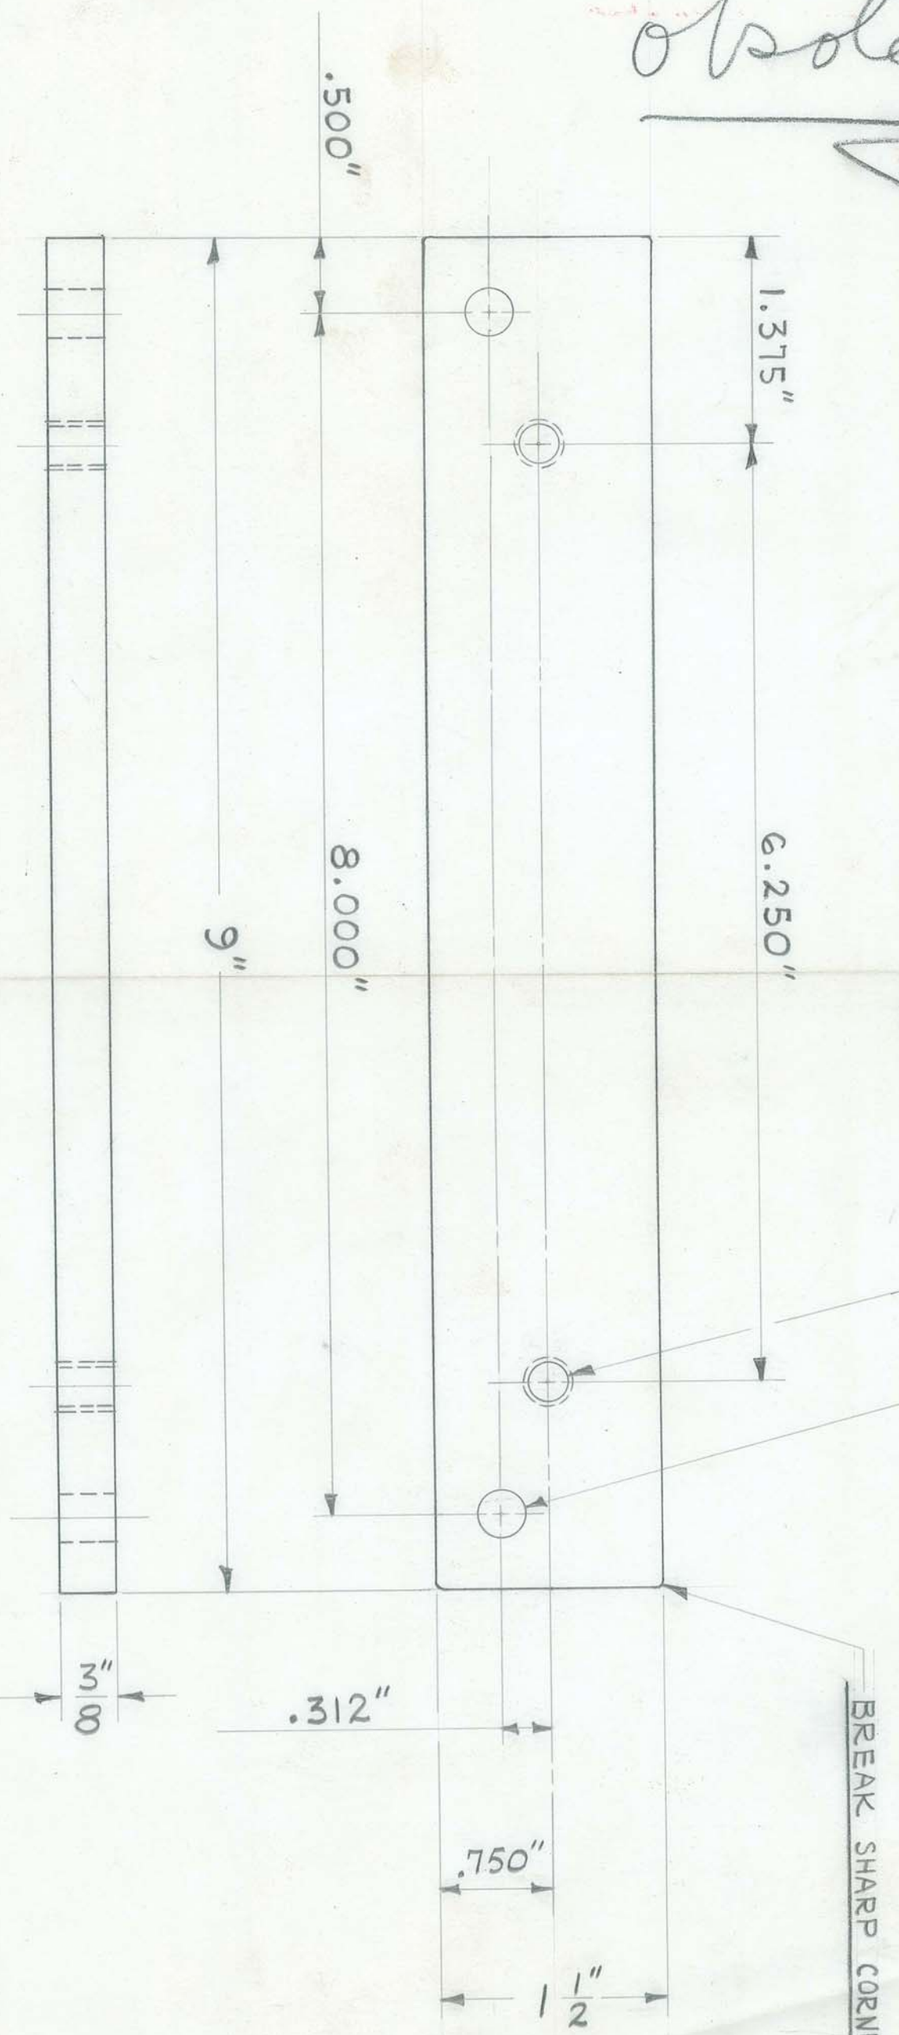

2 REQUIRED

673-217

TITLE
BRACKET

PATTERN	FINISH #316	SCALE ½"=1"

MATERIAL
11-GA. (.120) C.R.S.

TOOLS

H. G. FISCHER & CO.
FRANKLIN PARK, ILLINOIS

DATE 5-12-71 | DR. BY R.H.C. | CH'K'D. C.F.S.

PART NO. 169-786

DIMENSIONS—UNLESS OTHERWISE SPECIFIED:
FRACTIONAL ± .015 | DECIMAL ± .005 | ANGULAR ± 1/2°
THREAD CHAMFER
UP TO 5/16 D.-1/32 X 45°
3/8 D. & OVER - 1/16 X 45°
REMOVE ALL BURRS & SHARP CORNERS

USED ON	QTY.	USED ON	QTY.
208-427	2		

REVISION	DATE	BY

OBSOLETE
DATE 12/27/71
REFER TO REV. A
FOR DETAILS SEE E. C. O. # 1531
ENGINEER
DRAFTSMAN Andy P.

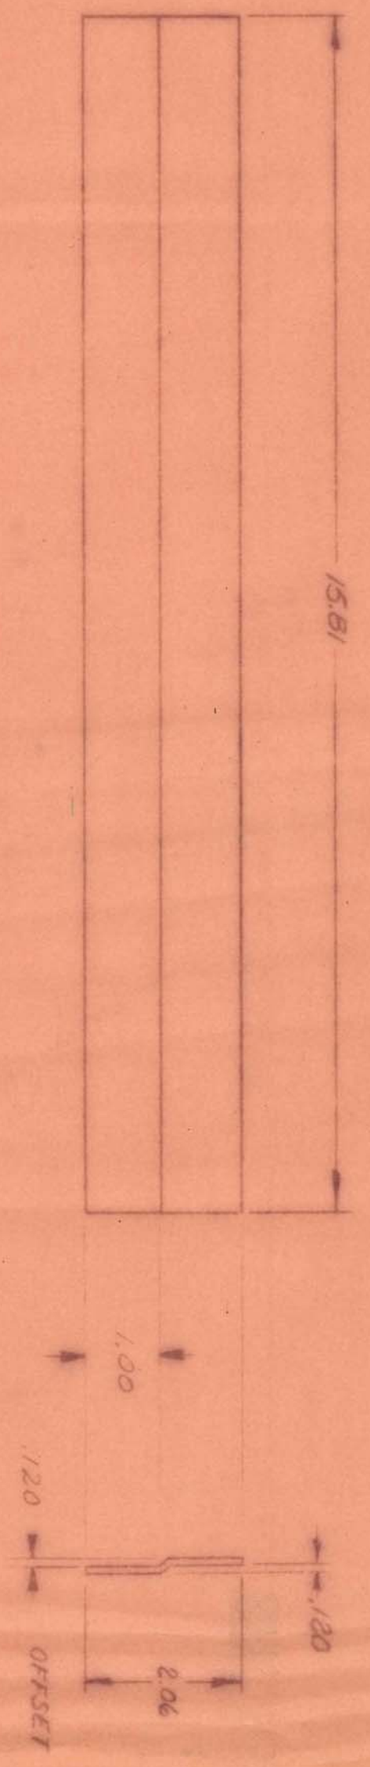

DO NOT SCALE DRAWING.

673-678

BRACE, CABINET

PATTERN	FINISH	SCALE
MATERIAL	16GA. (.060) SHEET C.R.S.	
TOOLS		

H. G. FISCHER & CO.
FRANKLIN PARK, ILLINOIS

PART NO. 169-784

DATE 3-27-71 | DR. BY RH | CH'K'D.

DIMENSIONS—UNLESS OTHERWISE SPECIFIED:
FRACTIONAL ± .015 | DECIMAL ± .005 | ANGULAR ± 1/2°
THREAD CHAMFER UP TO 5/16 D. - 1/32 X 45° | 3/8 D. & OVER - 1/16 X 45°

REMOVE ALL BURRS & SHARP CORNERS

USED ON	QTY.	USED ON	QTY.
208-427	1		

REVISION	DATE	BY
A1 WAS 3 V16 A2 WAS 3.341 E.C.O. 1332	9/16/71	AP

OBSOLETE
DATE 12-4-71
REFER TO REV. B
FOR DETAILS SEE E.C.O. # 1404
ENGINEER
DRAFTSMAN

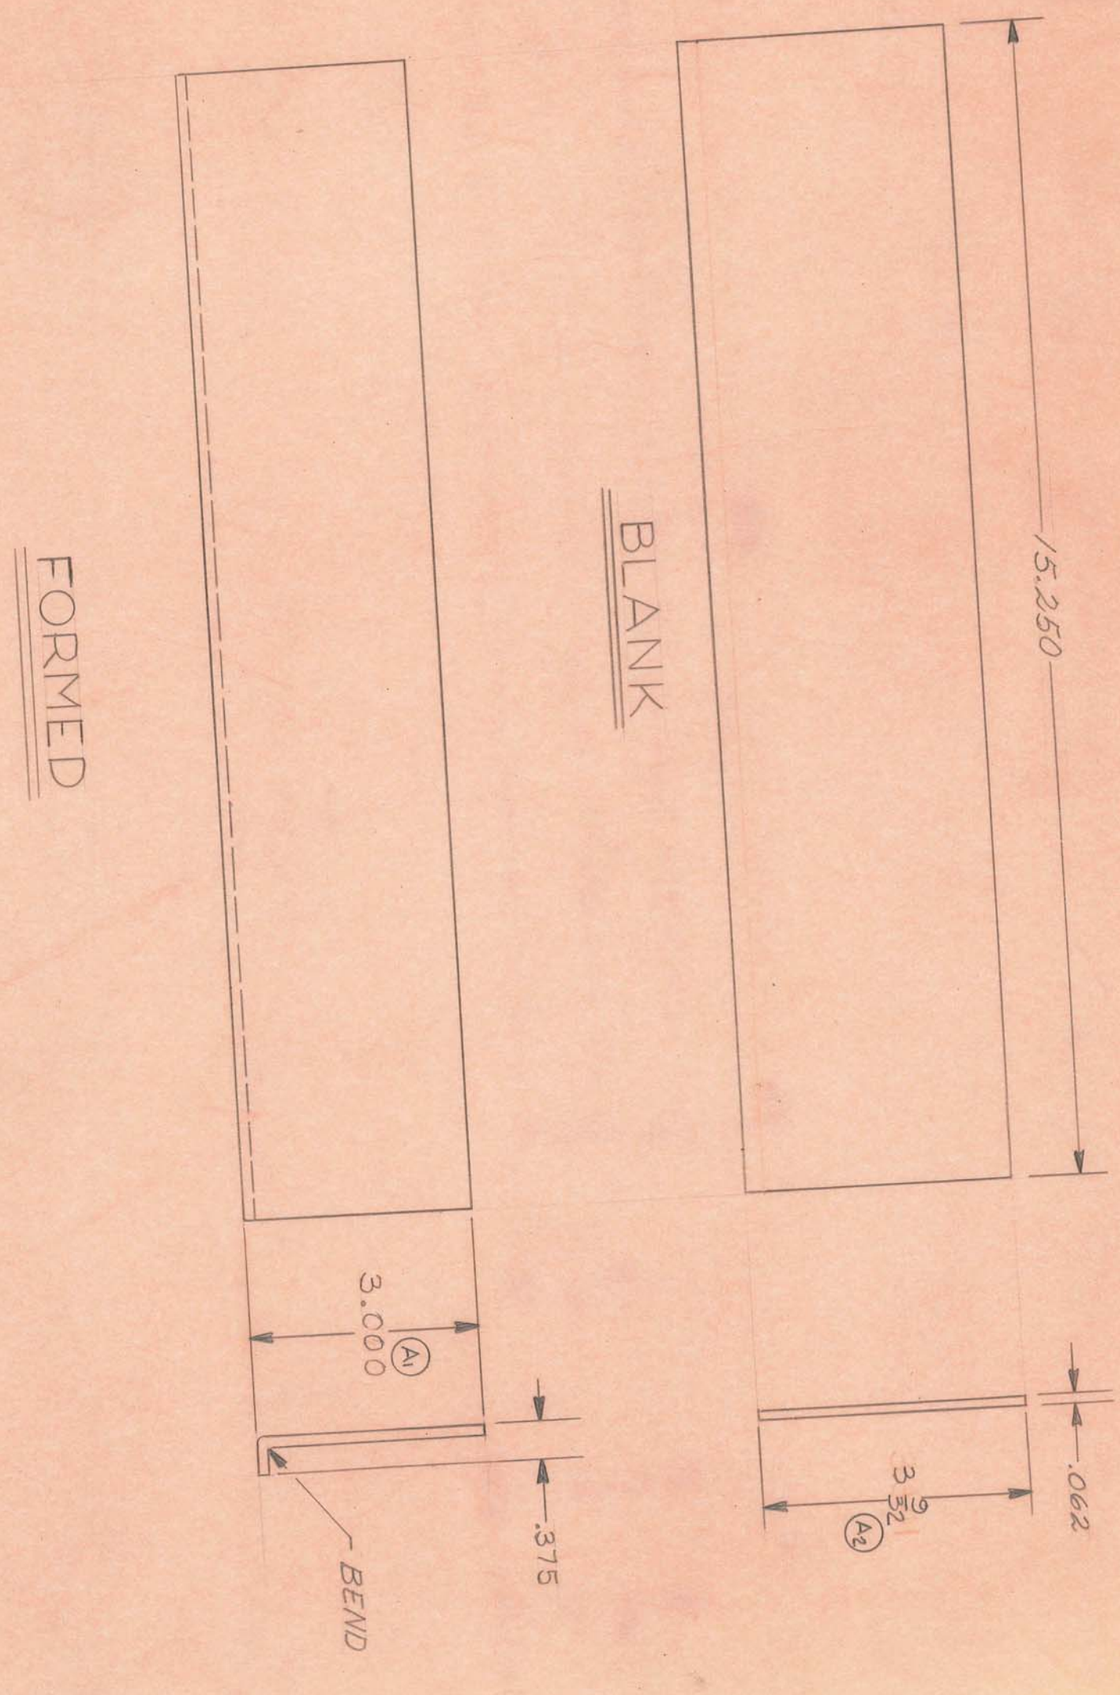

DO NOT SCALE DRAWING.

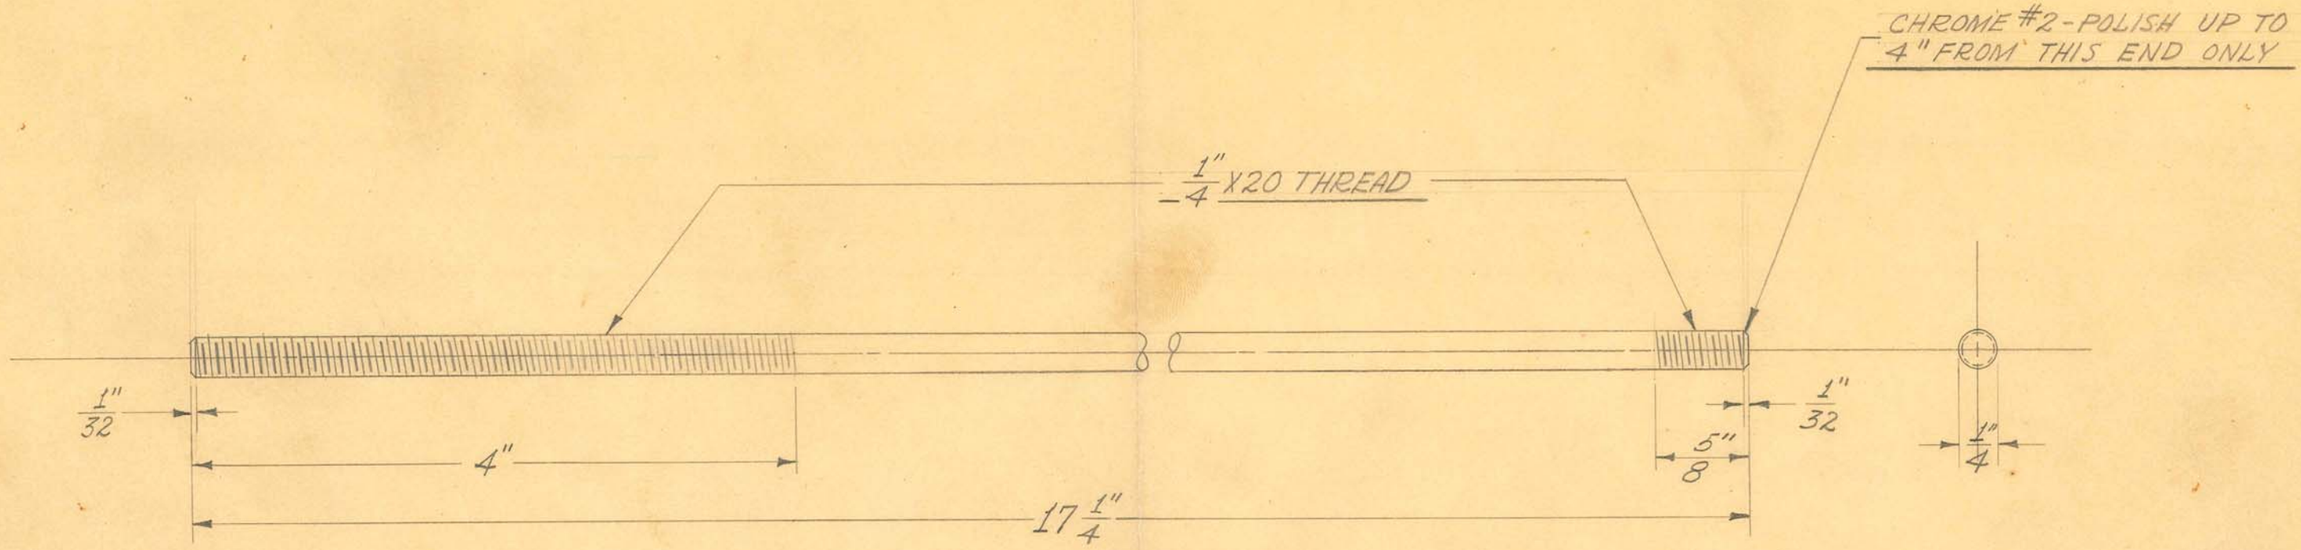

2 REQUIRED

OBSOLETE

Obsolete

SIZE	1/4" DIAM.	ISSUE 3-1-39	J.W.	TITLE: WALL MODEL DENTAL "X-RAY" UNIT COUNTER BALANCE ROD
KIND	C.R. STEEL	CHANGED 4-13-39	J.W.	
SHAPE	ROD	"		
FINISH	CHROME #2	"		
TEMP.		"		
PATT.		"		

H. G. FISCHER & CO.
2338 WABANSIA AVE.
CHICAGO, ILL.

CAT. NO.

PART NO. 12406A

TITLE FISCHER ADJUSTABLE CONDENSER ELECTRODE – CONDENSER PLATE

H. G. FISCHER & CO.
FRANKLIN PARK, ILLINOIS

DATE 3-5-53 | DR. BY J.V.W. | CH'K'D.

PART NO. 16217

REVISION	DATE	BY

PATTERN | FINISH | SCALE FULL

TOOLS 1" R. CORNER DIE #11887
BENDING FIX. #11873

MATERIAL .040" SHEET #52 SH34 MILL FINISH ALUMINUM

DIMENSIONS UNLESS OTHERWISE SPECIFIED
FRACTIONAL ± .015
DECIMAL ± .005
ANGULAR ± ½°

XX Obsolete 8-20-53

OBSOLETE

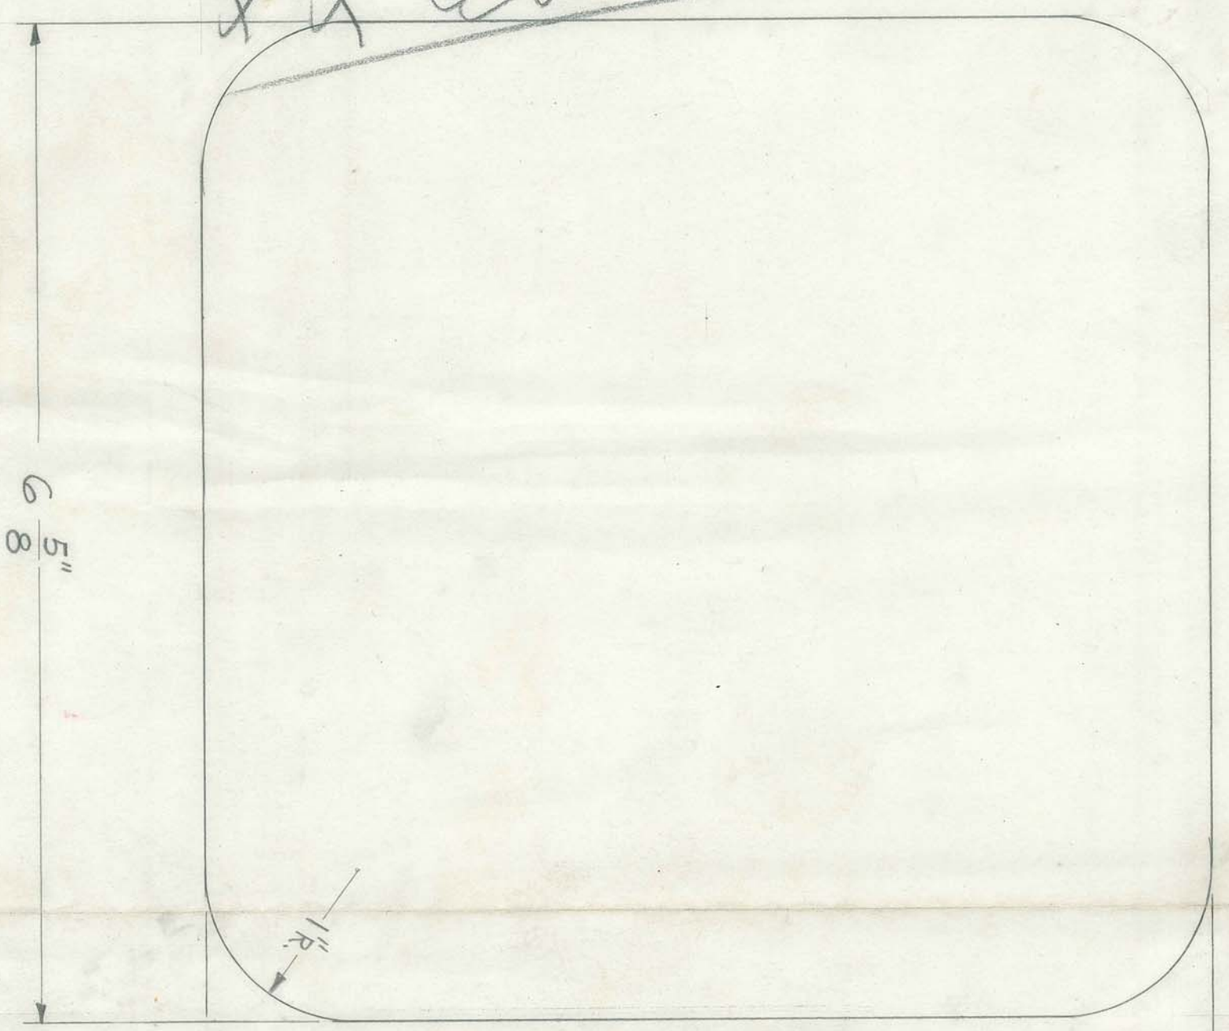

2 REQUIRED

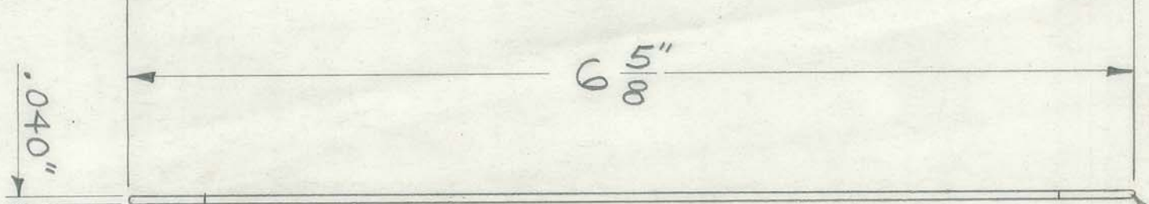

ROUND COMPLETE OUTSIDE EDGE IN ROUNDING MACHINE # R83

BEND IN FIXTURE

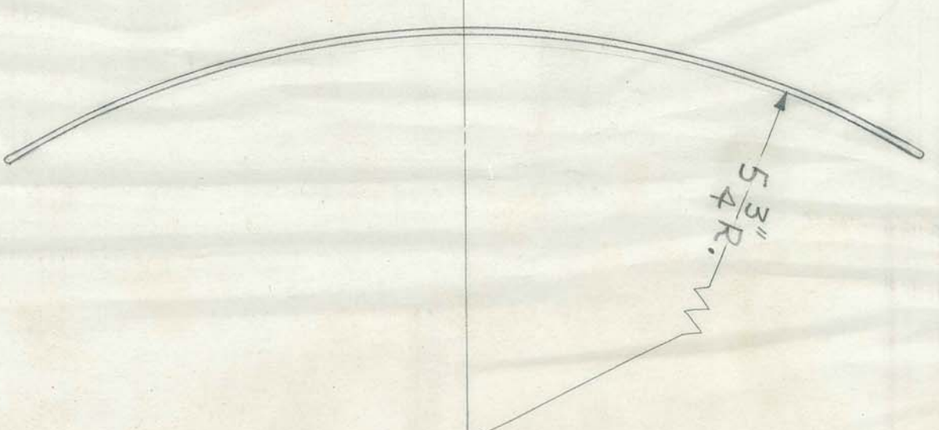

FOLDER #118

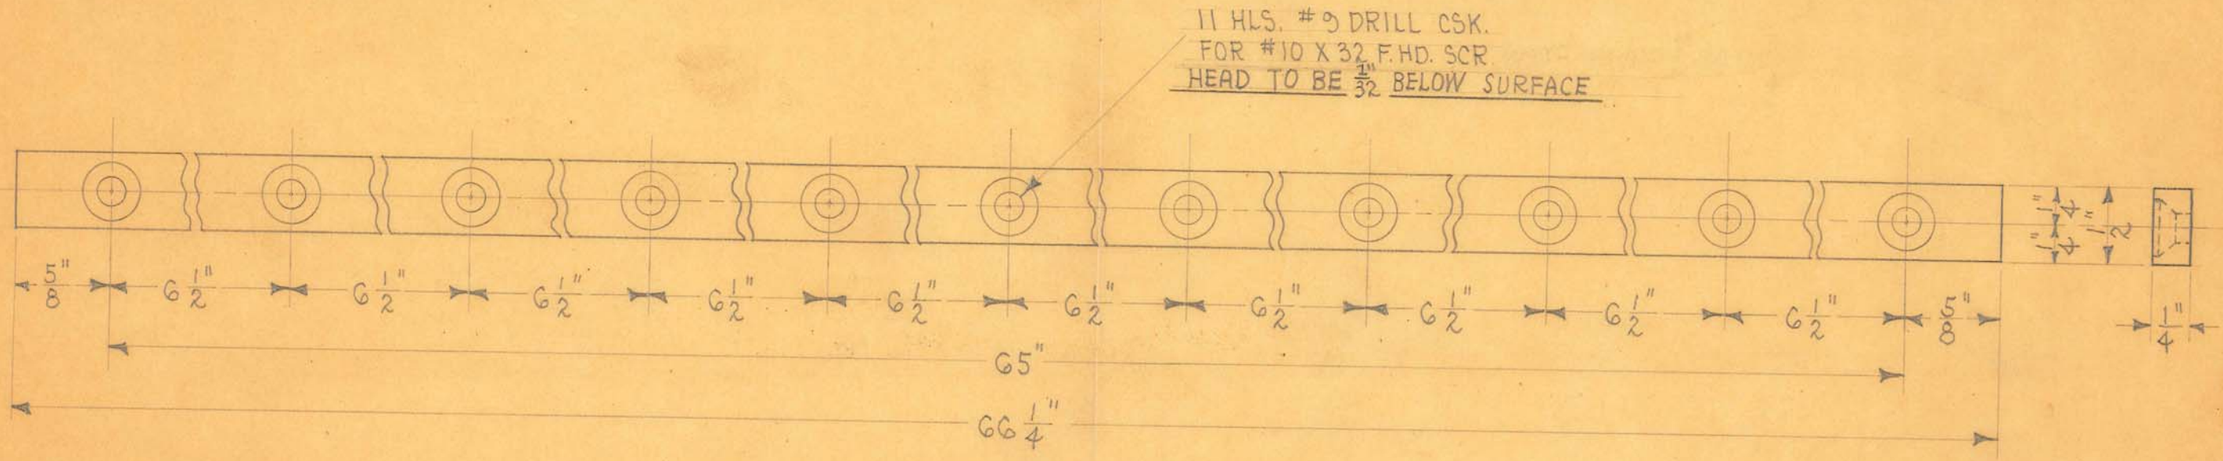

1 REQUIRED

OBSOLETE

SIZE	1/4" X 1/2"	ISSUE 7-9-35	H.E.	TITLE: MODEL "SP-CO" SHOCKPROOF RAD. UNIT VERTICAL GUIDE STRIP
KIND	C.R. STEEL	CHANGED 7-22-37	J.W.	
SHAPE		" "		
FINISH	CAD. #23	" "		
TEMP.		" "		
PATT.		" "		

H. G. FISCHER & CO.
2335 WABANSIA AVE.
CHICAGO, ILL.

CAT. NO.

PART NO. 9706

TITLE
FISCHER WALL FRAME TILTING BUCKY STAND
SUPP. FOR 14"X17" & 14"X36" BUCKY - LEFT

PATTERN | FINISH PAINTED | SCALE HALF

TOOLS
DRILL JIG #9973

MATERIAL
FROM 17796

H. G. FISCHER & CO.
FRANKLIN PARK, ILLINOIS

DATE 11-10-48 | DR. BY W. J. | CH'K'D.

DIMENSIONS
FRACTIONAL ± .015
DECIMAL ± .005
ANGULAR ± ½°
UNLESS OTHERWISE SPECIFIED

PART NO. 17796FA

REVISION	DATE	BY
A ALL HLS. CHANGED TO #18 DRILL	4-12-55	J.V.W.

obsolete

OBSOLETE

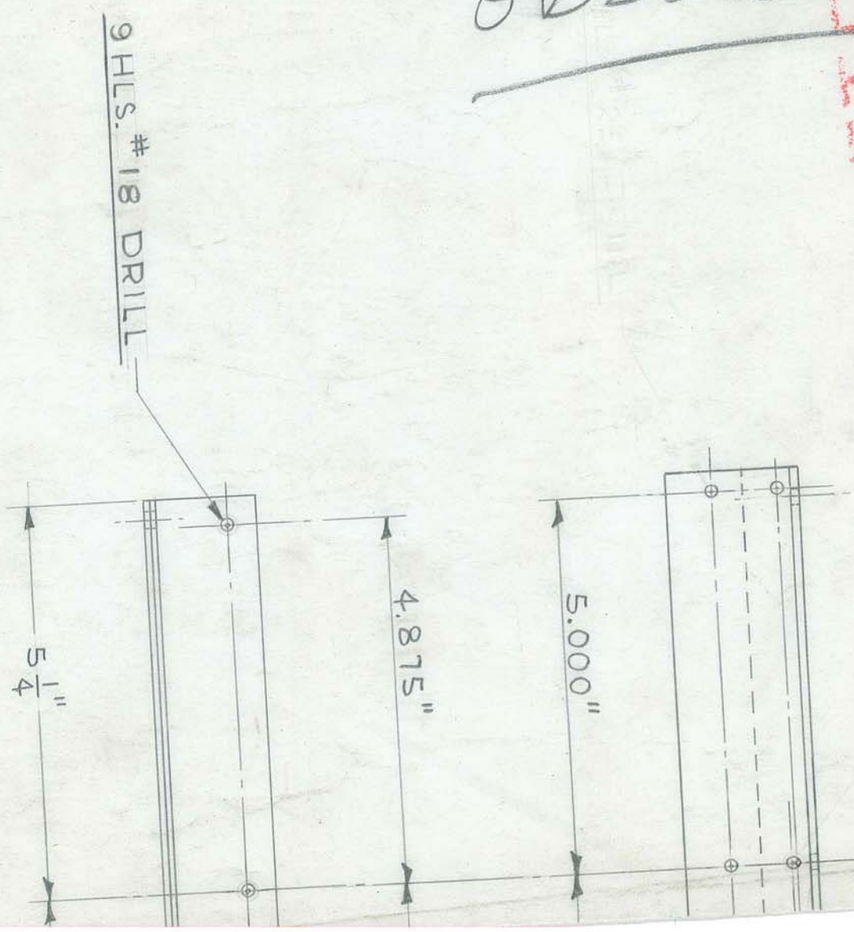

1 REQUI

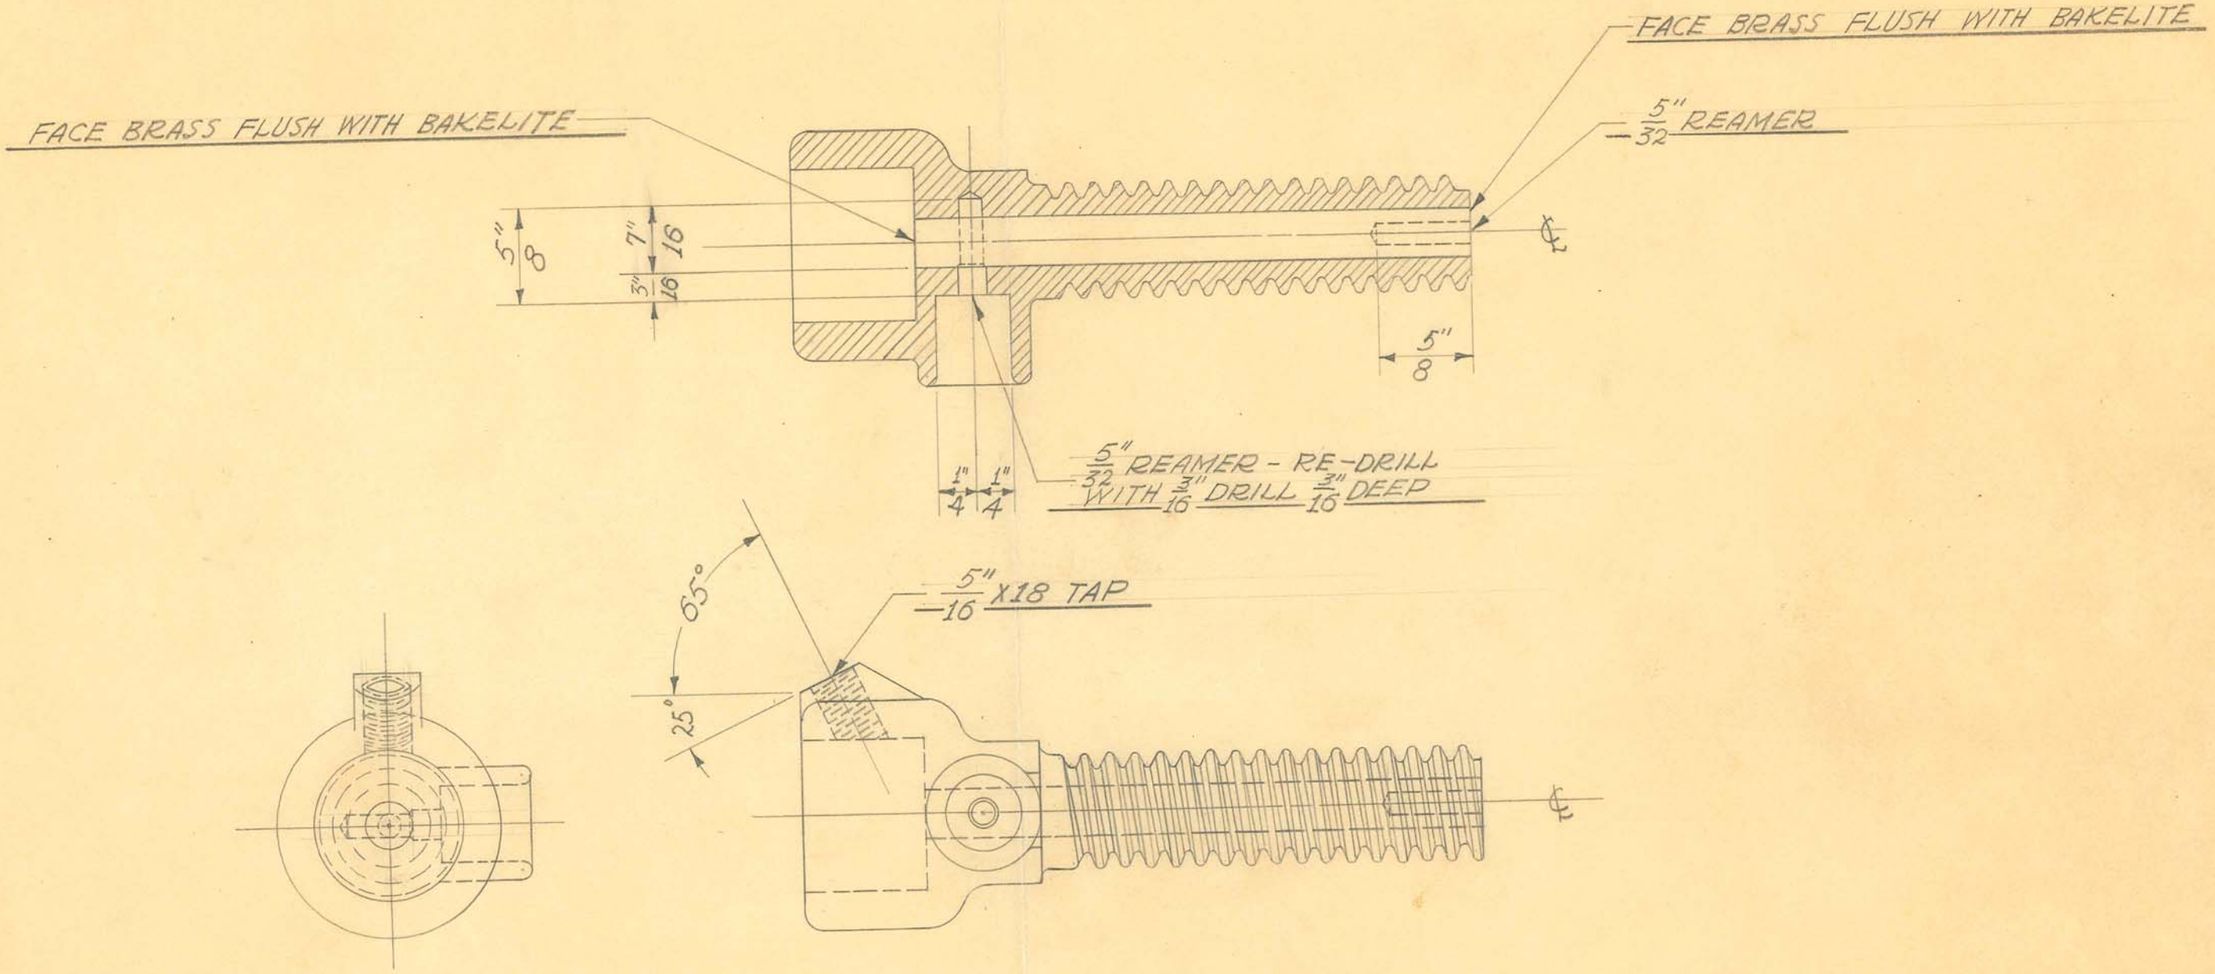

1 REQUIRED

OBSOLETE

SIZE	FROM 12117G	ISSUE 11-23-38	J.W.	TITLE: AIR-SPACED ELECTRODE ADJUSTING SCREW-FINISHED
KIND		CHANGED		
SHAPE		"		
FINISH		"		
TEMP.		"		
PATT.		"		

H. G. FISCHER & CO.
2335 WABANSIA AVE.
CHICAGO, ILL.

CAT. NO.

PART NO. 12117GF

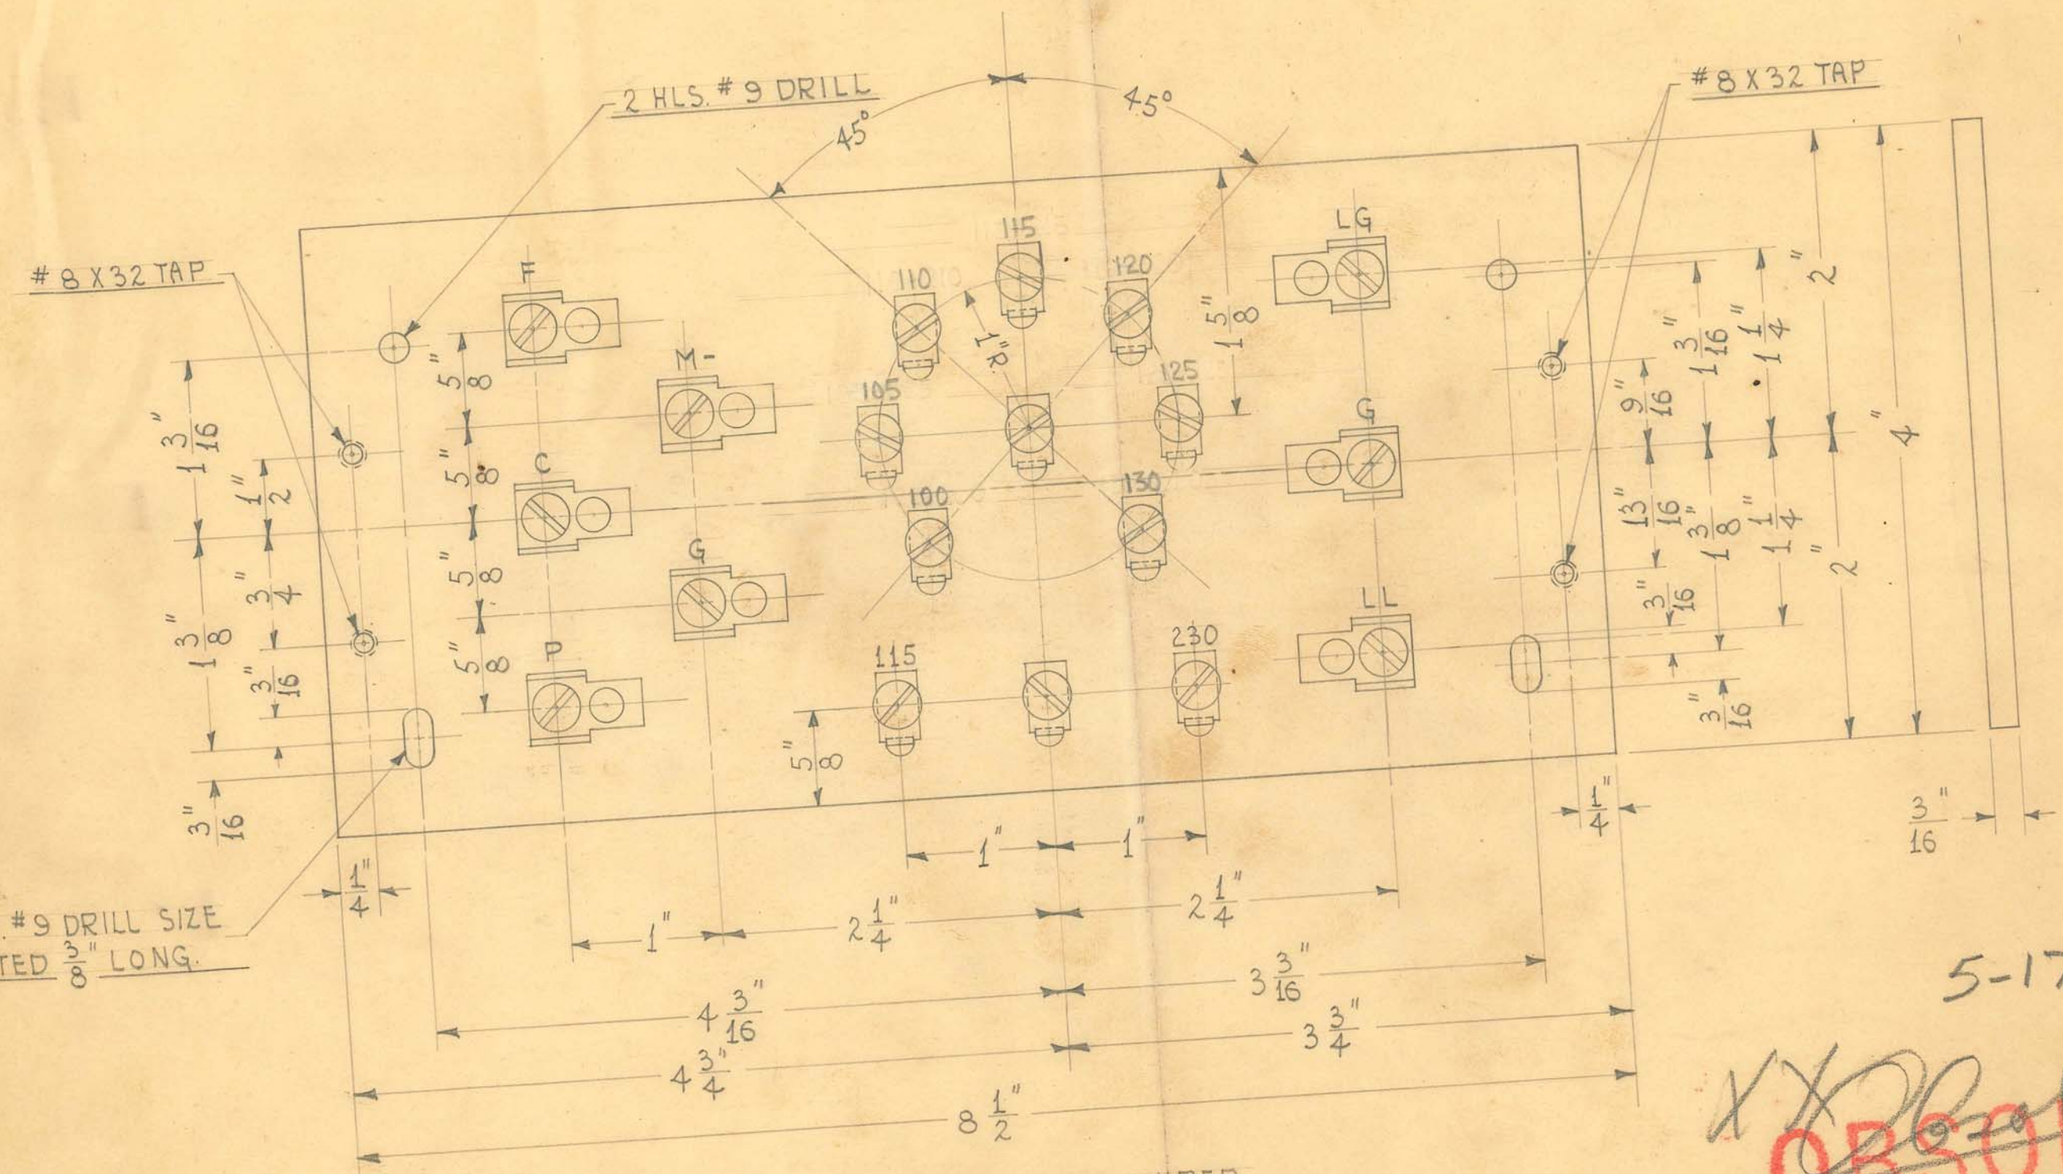

5-17-51

OBSOLETE

SIZE		ISSUE 5-1-41	H.
KIND		CHANGED	
SHAPE		"	
FINISH		"	
TEMP.		"	
PATT.		"	

TITLE: U.S. NAVY X-RAY UNIT- CONTROL BOX TERMINAL BOARD

H. G. FISCHER & CO.
2335 WABANSIA AVE.
CHICAGO, ILL.

CAT. NO.

PART NO. 14101G

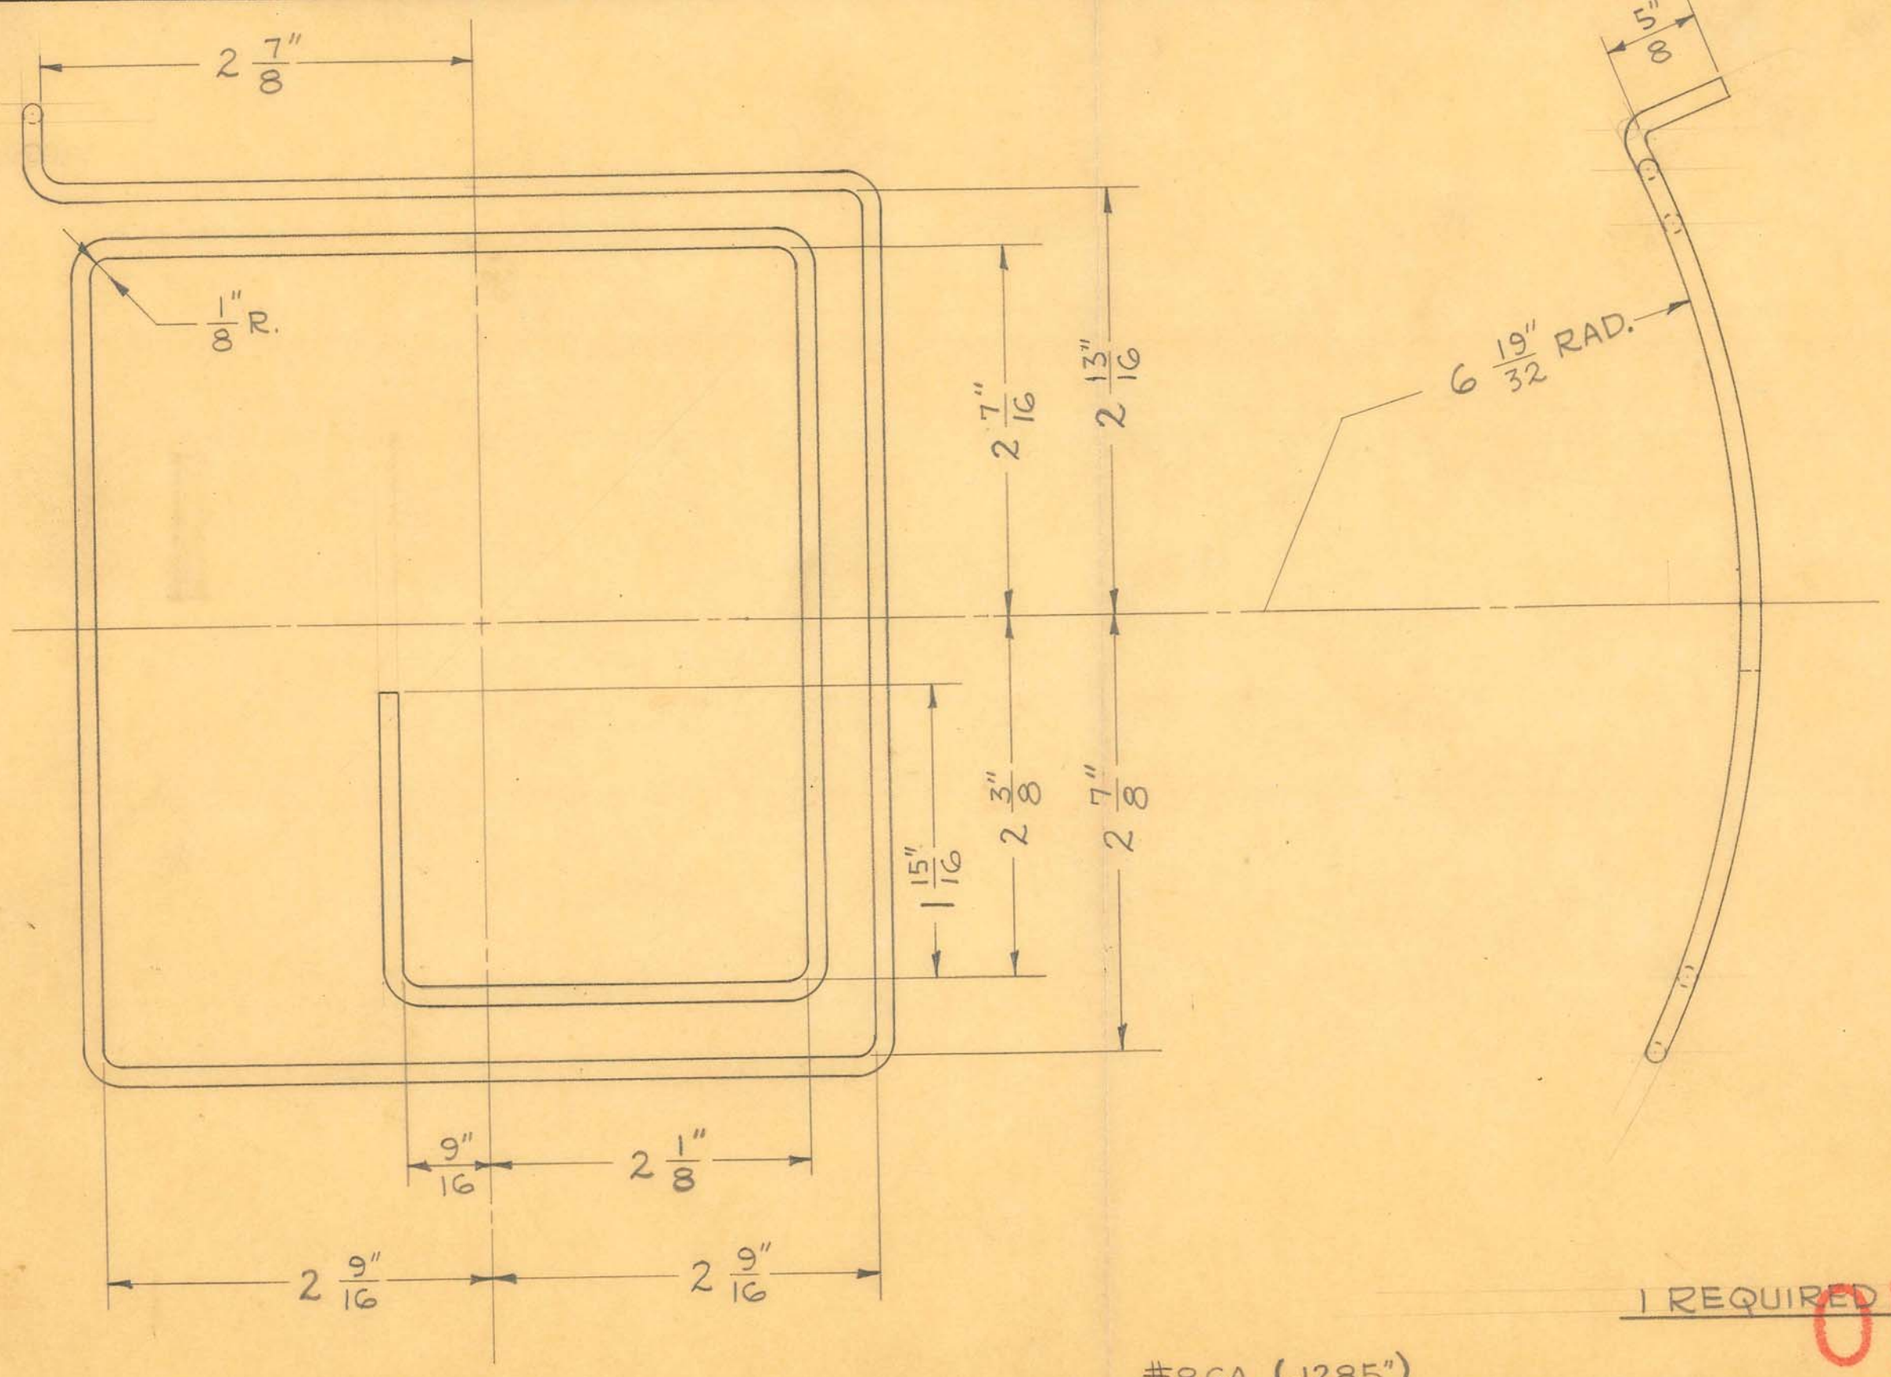

DEVELOPED LENGTH = 37 1/4"

1 REQUIRED

OBSOLETE

#8GA. (.1285")

SIZE	#8 BARE	ISSUE 2-11-46	J.V.W.
KIND	COPPER WIRE	CHANGED	
SHAPE		"	
FINISH		"	
TEMP.		"	
PATT.		"	

TITLE: FISCHER ADJUSTABLE INDUCTION ELECT. COIL - LEFT

H. G. FISCHER & CO.
2338 WABANSIA AVE.
CHICAGO, ILL.

CAT. NO.

PART NO. 15874

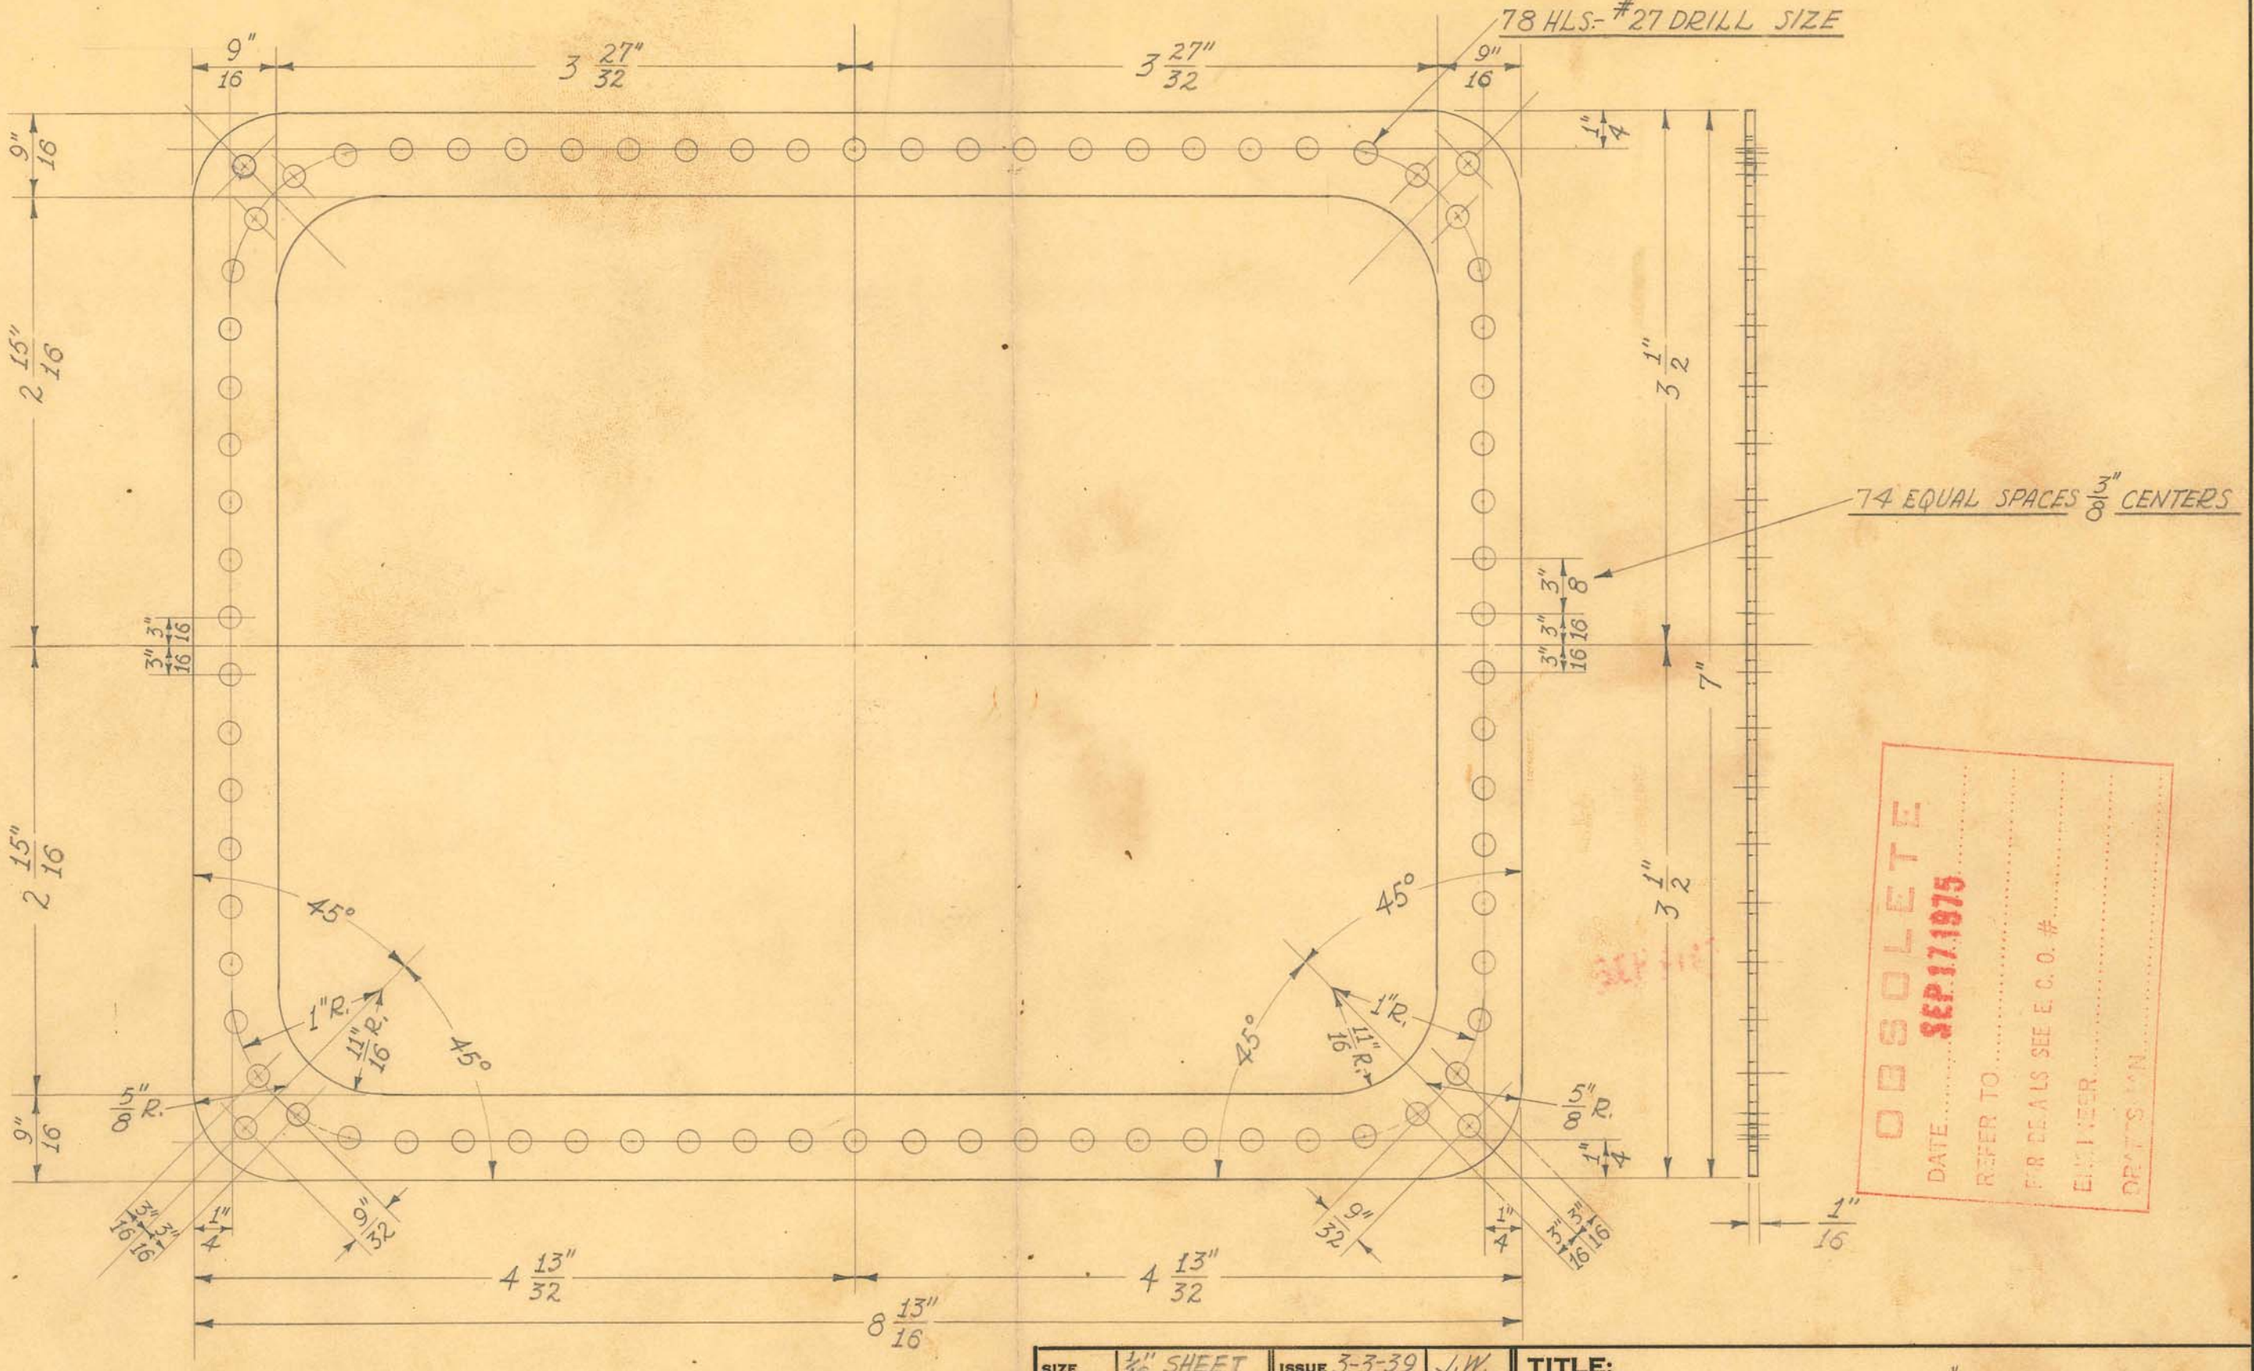

1 REQUIRED

OBSOLETE
DATE SEP.17.1975
REFER TO
FOR DETAILS SEE E.C.O. #
ENGINEER
DEPT'S ON

SIZE	1/16" SHEET	ISSUE 3-3-39	J.W.
KIND	HY-CAR	CHANGED 5-5-39	H.E.
[redacted]	CORK	" 6-20-39	J.W.
FINISH		"	
TEMP.		"	
PATT.		"	

TITLE:
WALL MODEL DENTAL "X-RAY" UNIT
TRANSFORMER TANK PANEL GASKET

H. G. FISCHER & CO.
2335 WABANSIA AVE.
CHICAGO, ILL.

CAT. NO.

PART NO. 12413

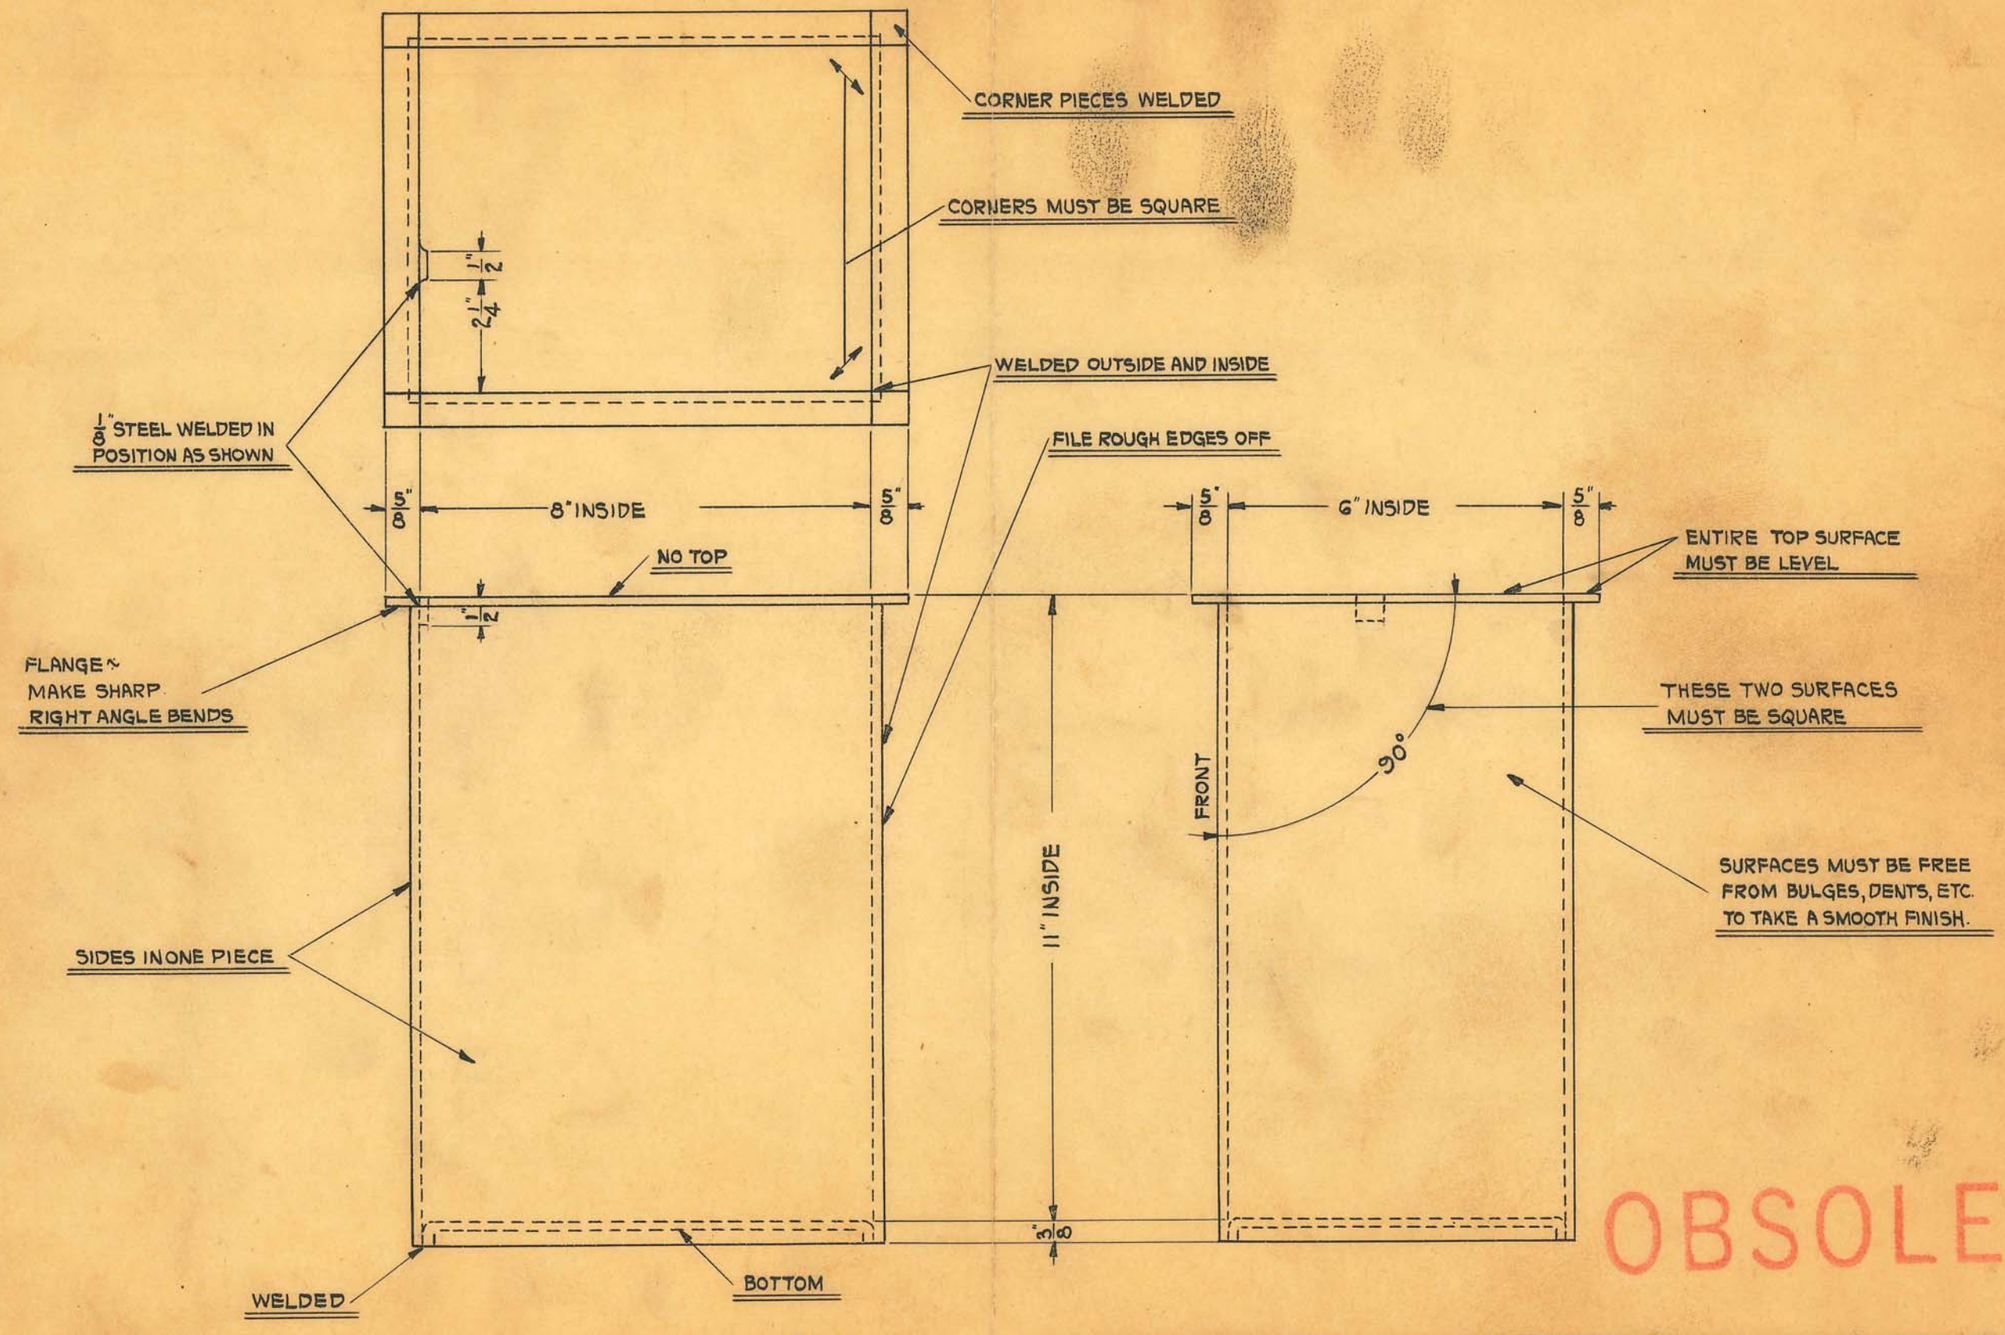

SCALE - 3/8" = 1"

OBSOLETE

WELDED - MUST BE OIL TIGHT.
TEST FOR LEAKS WITH KEROSENE.
GIVE OUTSIDE OF TANK KEROSENE
BATH TO KEEP FROM RUSTING.

SIZE	#16 U.S.S.GA.(.064")	ISSUE	11-25-29
KIND	FURNITURE STEEL	CHANGED	
SHAPE	STRIP	" "	
FINISH		" "	
TEMP.		" "	
PATT.		" "	

TITLE: TANK FOR HIGH TENSION TRANSFORMER FOR "DENTAL X" - 60 CYCLE

H. G. FISCHER & CO.
2335 WABANSIA AVE.
CHICAGO, ILL.

CAT. NO.

PART NO. 6186F

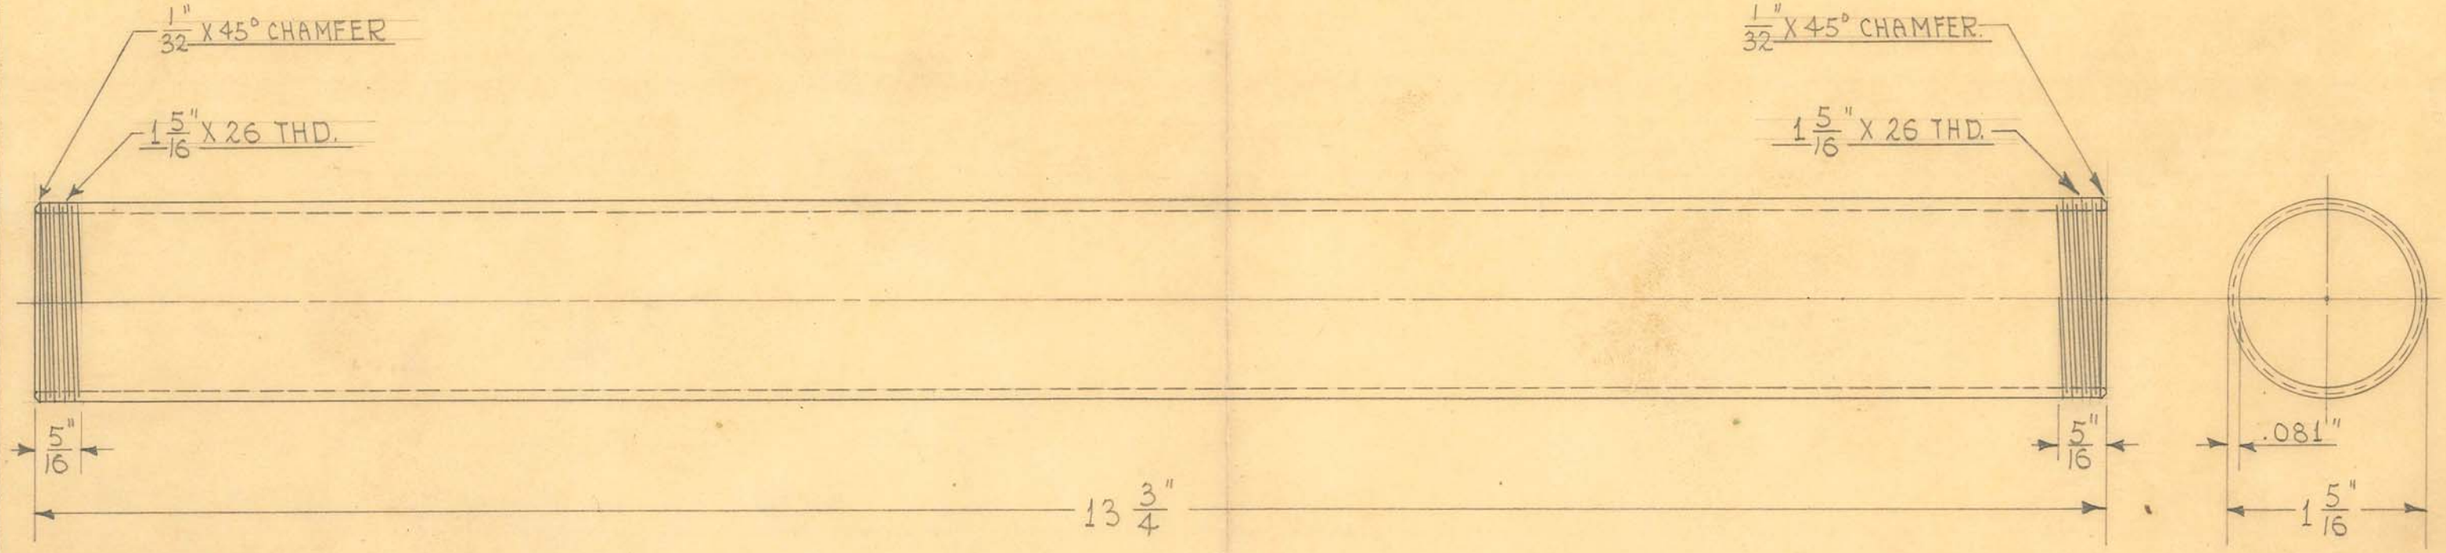

REMOVE BURR FROM INSIDE OF TUBE ON BOTH ENDS.

2 REQUIRED

OBSOLETE
SEP 17 1975
DATE.....
REFER TO.....
FOR DETAILS SEE E. C. O. #.....
ENGINEER.....
DRAFTSMAN.....

SIZE	1 5/16" O.D. X .081" W	ISSUE 1-31-40	HE.
KIND	BRASS TUBING	CHANGED	
SHAPE		"	
FINISH	PAINTED	"	
TEMP.		"	
PATT.		"	

TITLE: WALL MODEL DENTAL X-RAY UNIT - COUNTERBALANCE TUBE

H. G. FISCHER & CO.
2335 WABANSIA AVE.
CHICAGO, ILL.

CAT. NO.

PART NO. 12409B

B

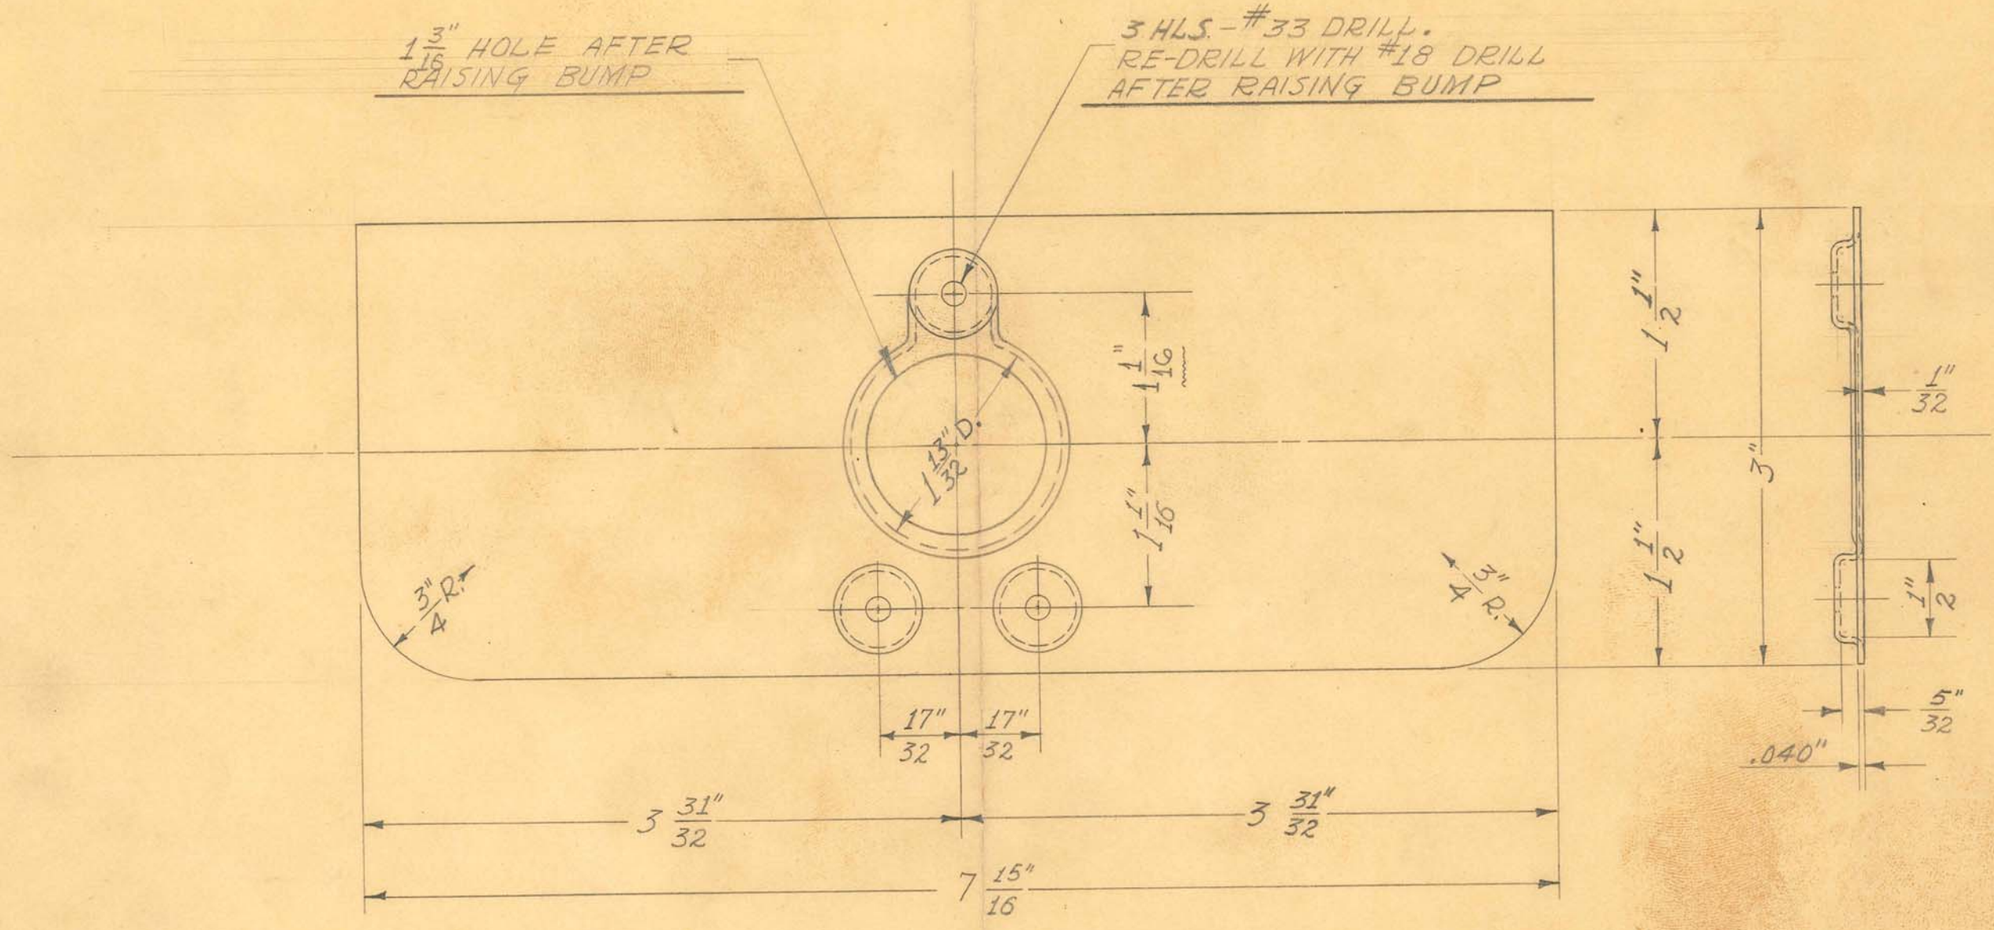

1 REQUIRED

OBSOLETE

Obsolete

SIZE	.040" SHEET	ISSUE 3-6-39	J.W.	TITLE: WALL MODEL DENTAL "X-RAY" UNIT TRANSF. - "X-RAY" TUBE SHIELD PLATE
KIND	LEAD	CHANGED 4-27-39	J.W.	
SHAPE		" 6-8-44	H.E.	
FINISH		"		
TEMP.		"		
PATT.		"		

H. G. FISCHER & CO.
2335 WABANSIA AVE.
CHICAGO, ILL.

CAT. NO.

PART NO. 12417CF

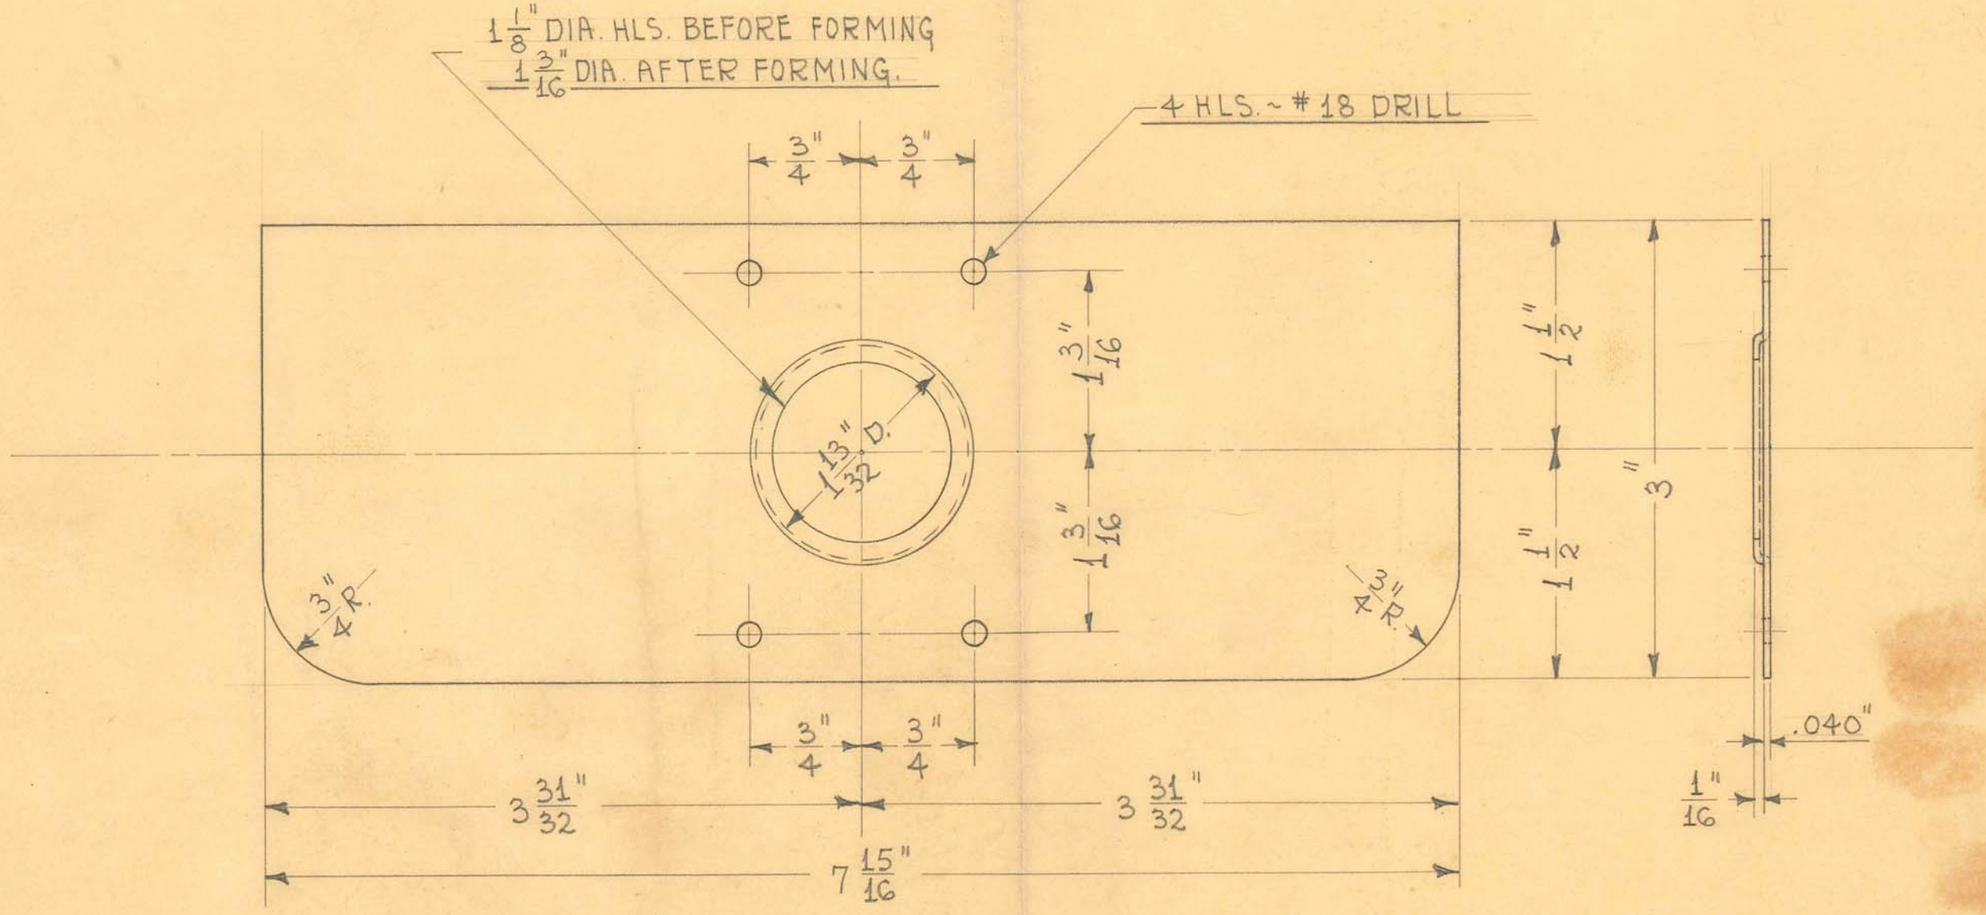

1 REQUIRED

OBSOLETE

SIZE	.040"	ISSUE 1-8-45	H.	TITLE: WALL MODEL DENTAL X-RAY UNIT ~ TRANSF. ~ "X-RAY" TUBE SHIELD PLATE
KIND	SHEET LEAD	CHANGED		
SHAPE		"		
FINISH		"		
TEMP.		"		
PATT.		"		

H. G. FISCHER & CO.
2335 WABANSIA AVE.
CHICAGO, ILL.

CAT. NO.

PART NO. 12417D

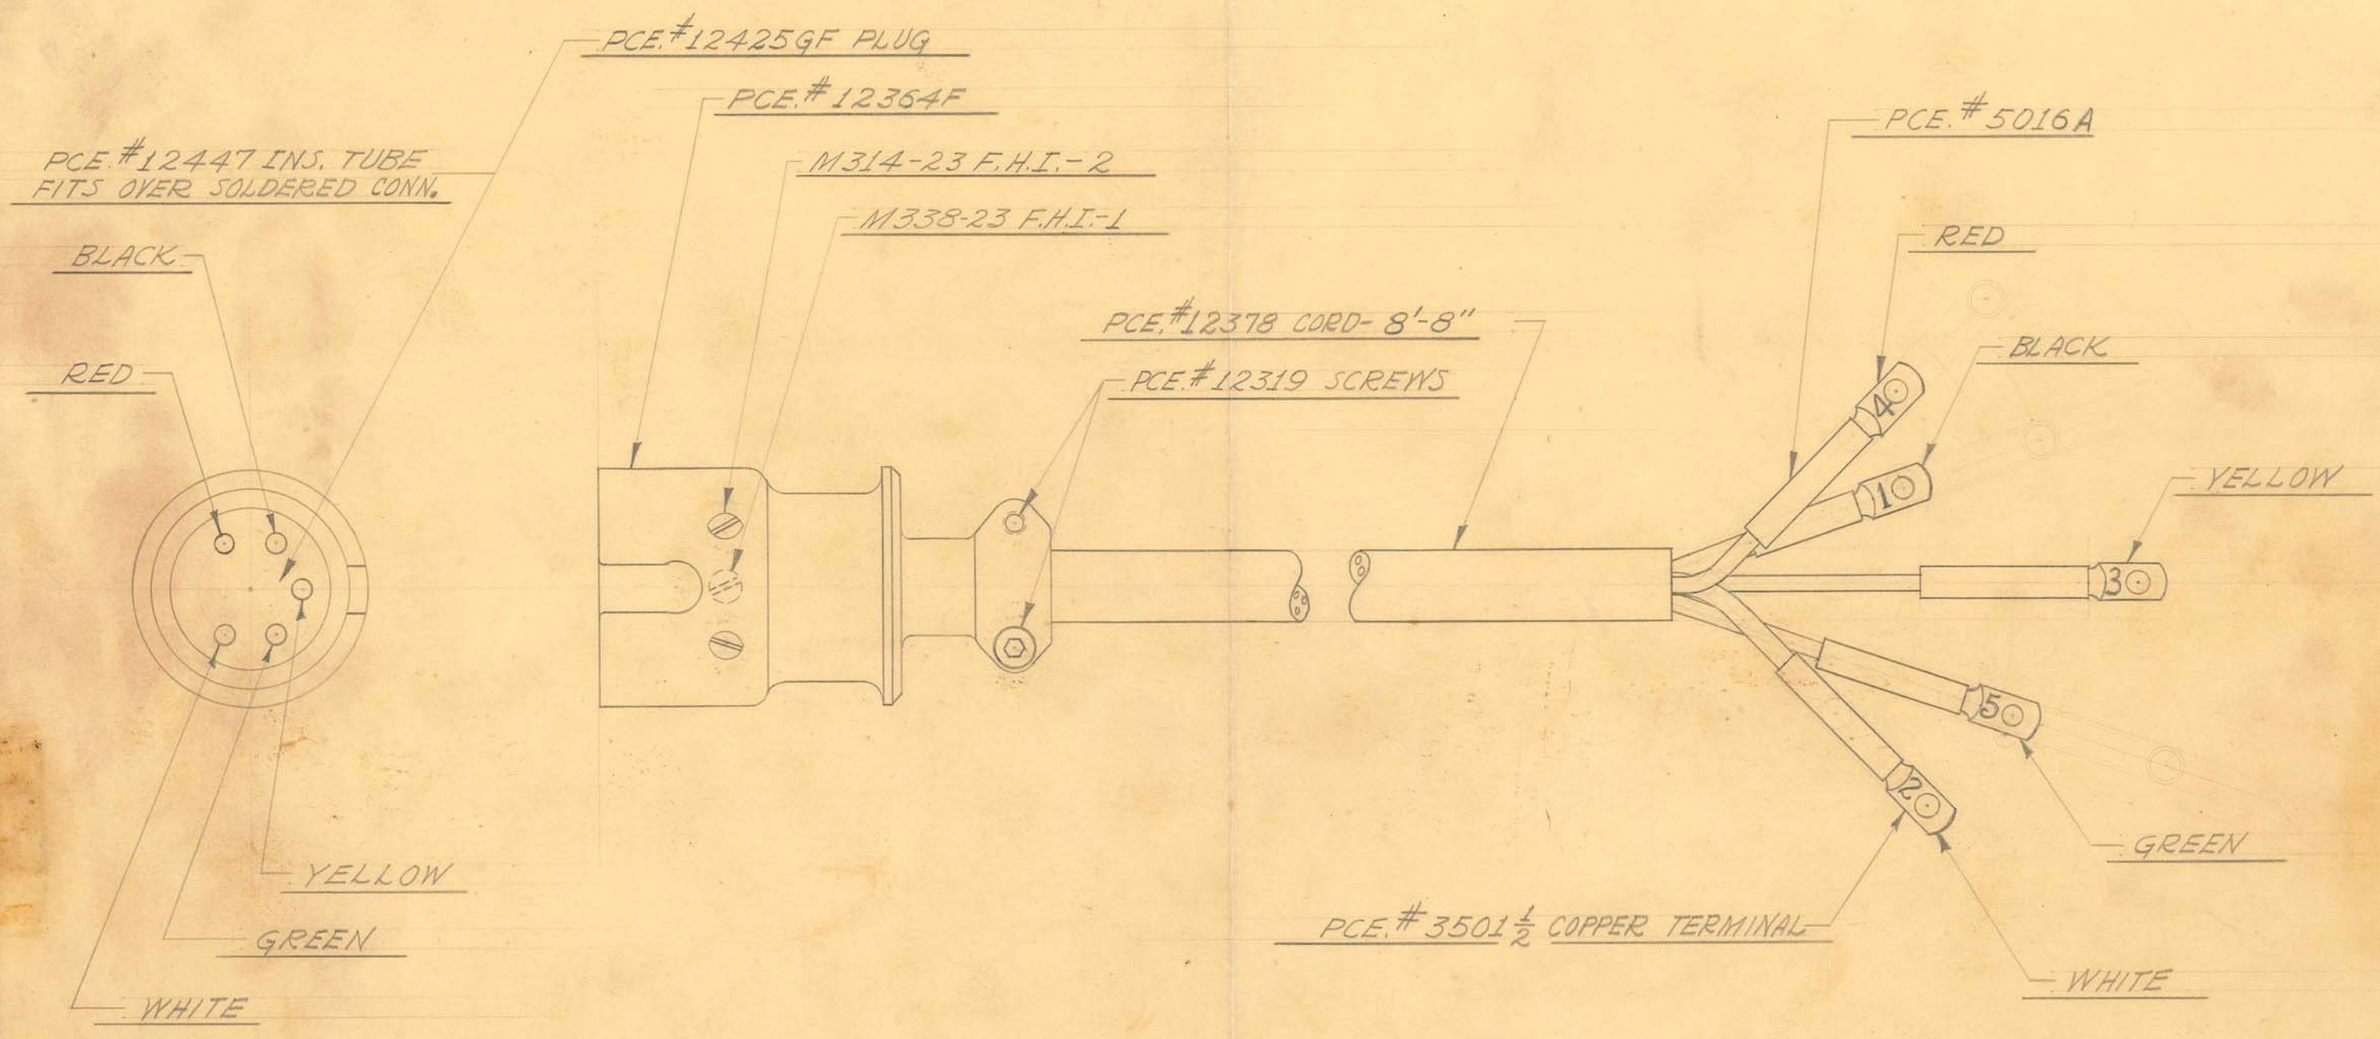

OBSOLETE

SIZE		ISSUE 10-9-40	J.V.W.	TITLE: FISCHER WALL MOD. DENTAL X-RAY UNIT- TRANSF. HEAD UPPER SWIVEL CONN. & CORD ASSEM.
KIND		CHANGED		
SHAPE		"		
FINISH		"		
TEMP.		"		H. G. FISCHER & CO. 2335 WABANSIA AVE. CHICAGO, ILL. — CAT. NO. — PART NO. 12437G
PATT.		"		

DEPT.	AMT.	ITEM NO.	NAME	PART NO. OR MATERIAL
P.S.	1	1	FEMALE RECEPT.	# 12426F
P.S.	5	2	FLOATING SOCKET	# 12434
P.S.	1	3	LOCATING WASHER	# 12428
P.S.	1	4	SCREW	M838-23 F.H.I.

DRAFTSMAN
ENGINEER
FOR DETAILS SEE E.C.O. #
REFER TO
DATE
OBSOLETE
SEP 17 1975

PART NO. 12438 G

REVISION	DATE	BY

H. G. FISCHER & CO.
FRANKLIN PARK, ILLINOIS

DATE 6-15-62 DR. BY R.E.W. CH'K'D. RCT

DIMENSIONS
FRACTIONAL ± .015
DECIMAL ± .005
ANGULAR ± ½°
UNLESS OTHERWISE SPECIFIED

SCALE DOUBLE SIZE

MATERIAL

FINISH

PATTERN

TOOLS

TITLE WALL MODEL DENTAL X TUBE HEAD
POWER-FEMALE RECEPTACLE